

DESIGN DATA
 1969 A.A.S.H.O. DESIGN SPECIFICATIONS
 DESIGN LOADING: HS-20
 $f_c = 1600$ P.S.I. $n = 8$
 $f_s = 24000$ P.S.I. REINFORCING STEEL,
 ASTM - A615, GRADE 60
 $f_s = 20,000$ P.S.I. STRUCT. STEEL, M.H.D. 3306

DECK AREA: 17,621 SQ. FT.

LIST OF SHEETS

NO.	DESCRIPTION
1	GENERAL PLAN & ELEVATION
2	BRIDGE LAYOUT
3	PART WEST ABUT. PLAN AND LAYOUT
4	WEST ABUT. - ELEVATION & FOOTING PLAN
5	WEST ABUT. - PART PLAN & DETAILS
6	WEST ABUT. - DETAILS
7	EAST ABUT. - PLAN & LAYOUT
8	EAST ABUT. - ELEV. & FOOTING PLAN
9	EAST ABUT. - DETAILS
10	PIER 1
11	PIER 2
12	PIER DETAILS
13	PREST'D. CONC. GIRDER TYPE 60-106
14	PREST'D. CONC. GIRDER TYPE 60-100
15	PREST'D. CONC. GIRDER TYPE 60-95
16	PREST'D. CONC. GIRDER TYPE 60-86
17	PREST'D. CONC. GIRDER TYPE 60-76
18	PREST'D. CONC. GIRDER TYPE 60-64
19	PREST'D. CONC. GIRDER TYPE 60-53
20	PREST'D. CONC. GIRDER TYPE 60-51
21	PART FRAMING PLAN - WEST
22	PART FRAMING PLAN - EAST
23	DIAPHRAGMS AND FRAMING DETAILS
24	PART DECK PLAN - WEST
25	PART DECK PLAN - EAST
26	DECK SECTION AND RAILING ELEVATIONS
27	SUBSTRUCTURE BAR LIST & EST. QUANT.
28	RAILING
29	SLOPE PAVING
30	DETAILS
31	DETAILS
32	DETAILS
33	DETAILS
34	BRIDGE SURVEY
35	SURVEY PLAN AND PROFILE

BENCH MARK ELEV. 874.34 (M.S.L. DATUM UNKNOWN)
 RAILROAD SPIKE IN 18" OAK TREE 90-FT. RT.
 OF 263+96 ON L.289

BATHER RINGROSE WOLFSLOD INC. ROSEVILLE, MINN.
 BAKKE & KOPP INC. MINNEAPOLIS, MINN.

I HEREBY CERTIFY THAT THIS PLAN WAS PREPARED BY ME OR UNDER MY DIRECT SUPERVISION AND THAT I AM A DULY REGISTERED PROFESSIONAL ENGINEER UNDER THE LAWS OF THE STATE OF MINNESOTA

SIGNED: Robert J. McSalin
 DATE: 11/3/71 REG. NO. 6452

ANOKA COUNTY STATE A10 HIGHWAY NO. 1
 STATE OF MINNESOTA
 DEPARTMENT OF HIGHWAYS

Bridge No. 02522
 COON RAPIDS BOULEVARD BY-PASS OVER EAST RIVER ROAD NORTHBOUND (C.S.A.H. 1) IN COON RAPIDS
 53'-89'-53" PRESTRESSED GIRDER SPANS
 72-FT. ROADWAY, 53'-17'-41" SKEW, 6'-FT. MEDIAN



GENERAL PLAN AND ELEVATION

SEC 26 T 31 N R 24 W
 CITY OF COON RAPIDS ANOKA COUNTY

APPROVED 12-21-71
 BRIDGE DESIGN AND PLANNING ENGINEER




ITEM NO.	2401.501	2401.501	2401.501	2401.501	2401.541	2401.543	2402.521	2402.583	2402.593	2402.594	2402.594	2405.501	2405.501	2405.501	2405.501	2405.501	2405.501	2405.501	2401.521	401.601	
ITEM	CONCRETE, MIX NO. 1A43	CONCRETE, MIX NO. 3Y43	CONCRETE, MIX NO. 3Y43 A	CONCRETE, MIX NO. 3Y4G A SPECIAL	REINFORCEMENT BARS	SPIRAL REINFORCEMENT	STRUCTURAL STEEL, (M.H.D. 3306)	ORNAMENTAL METAL RAILING	FIXED BEARING ASSEMBLIES TYPE 1	EXPANSION BRG. ASS'YS TYPE 1 (WITHOUT LUGS)	EXPANSION BRG. ASS'YS TYPE 1 (WITH LUGS)	PRESTRESSED CONCRETE GIRDER, TYPE 60-106	PRESTRESSED CONCRETE GIRDER, TYPE 60-100	PRESTRESSED CONCRETE GIRDER, TYPE 60-95	PRESTRESSED CONCRETE GIRDER, TYPE 60-86	PRESTRESSED CONCRETE GIRDER, TYPE 60-76	PRESTRESSED CONCRETE GIRDER, TYPE 60-64	PRESTRESSED CONCRETE GIRDER, TYPE 60-53	PRESTRESSED CONCRETE GIRDER, TYPE 60-51	STRUCTURE EXCAVATION CLASS E	SLOPE PAVING
UNIT	CU. YD.	CU. YD.	CU. YD.	CU. YD.	POUND	POUND	POUND	LIN. FT.	EACH	EACH	EACH	EACH	EACH	EACH	EACH	EACH	EACH	EACH	CU. YD.	SQ. YD.	
QUANTITY	732 (P)	621 (P)	669 (P)	57 (P)	274230 (P)	12450 (P)	2040	466	8	24	16	1	1	1	4	2	4	5	6	2070	1520 (P)

State Proj. No. S.A.P. 14-116-03 M.T.B. Sheet No. 1 of 35 Sheets

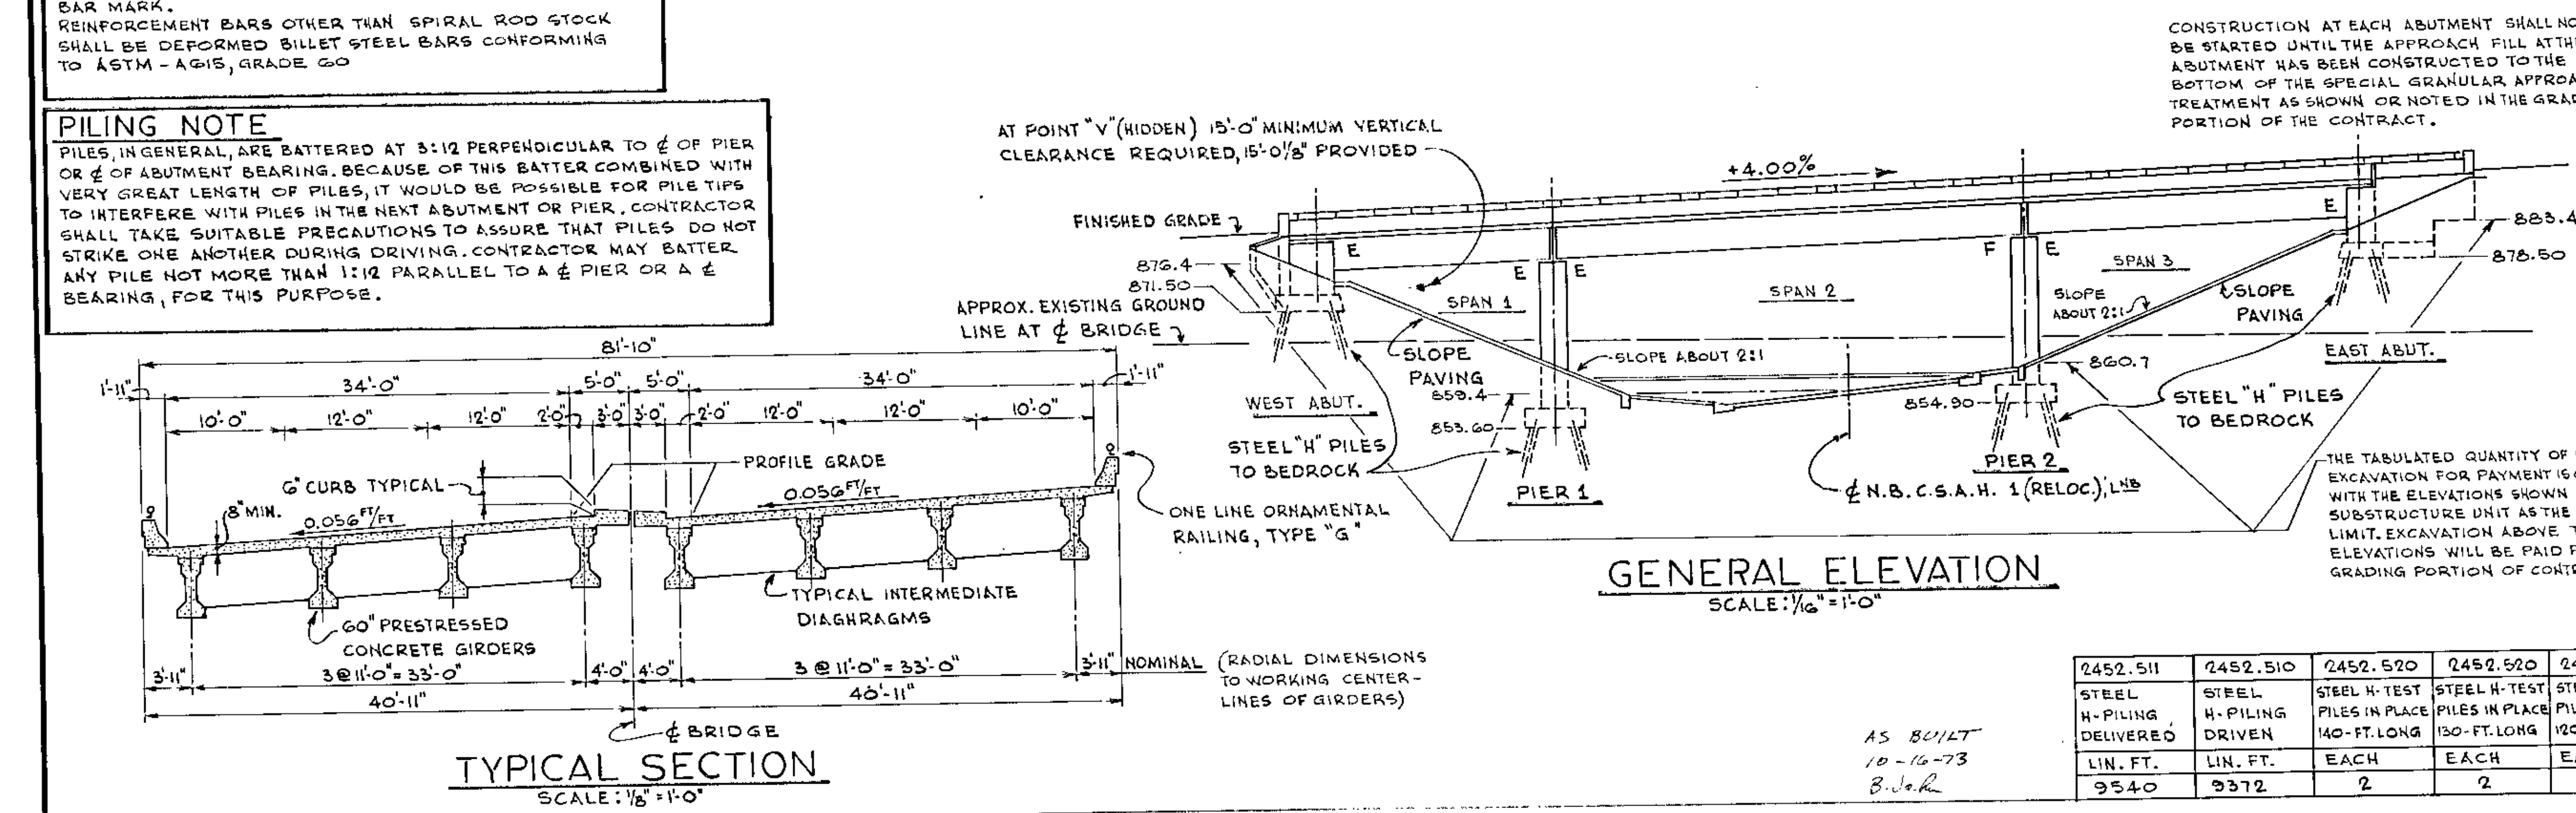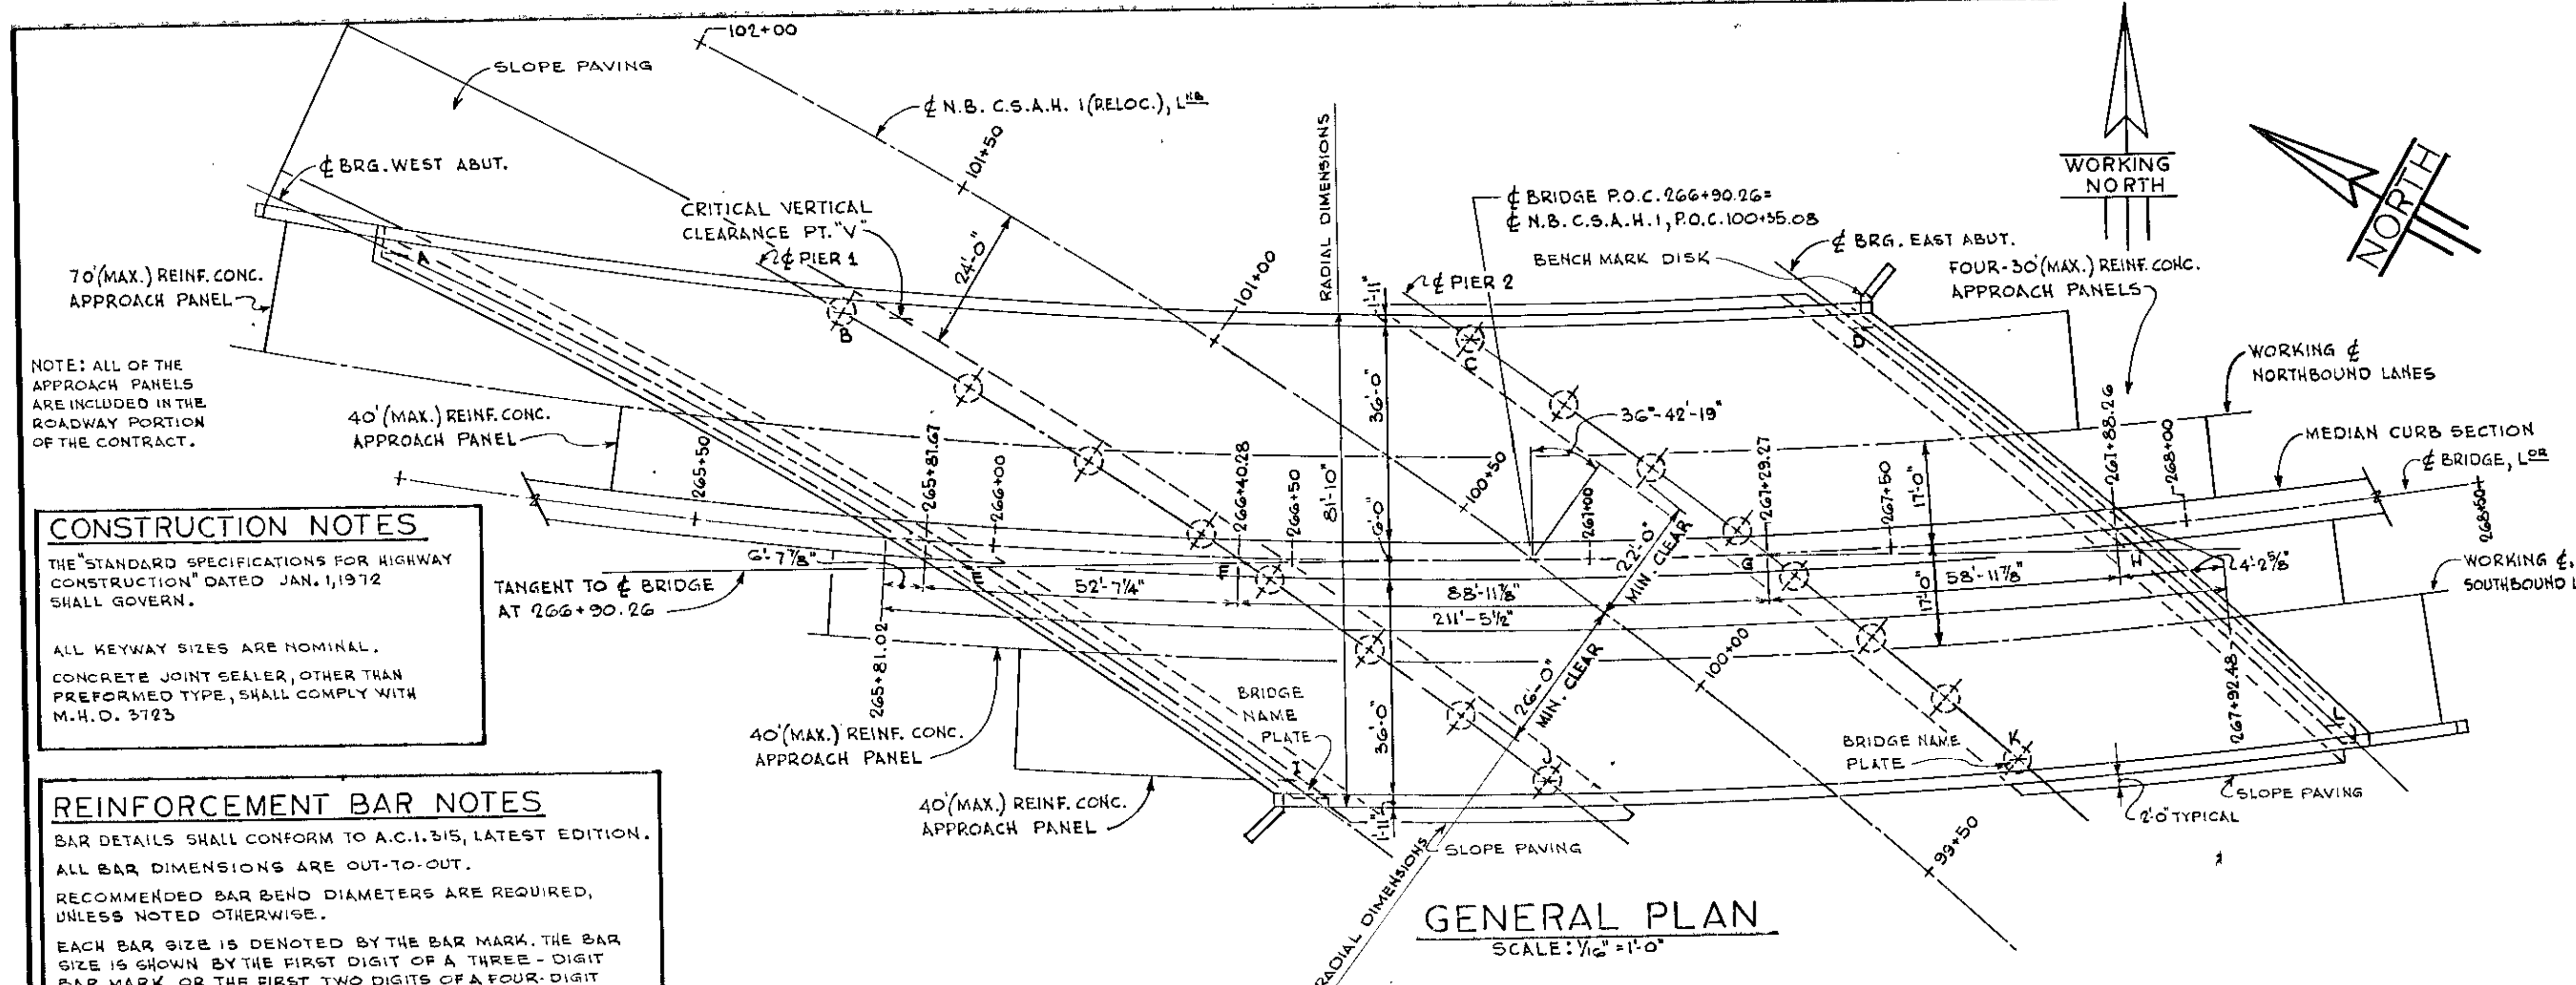

SCHEDULE OF QUANTITIES FOR ENTIRE BRIDGE


ITEM NO.	2401.501	2401.501	2401.501	2401.501	2401.541	2401.543	2402.521	2402.583	2402.593	2402.594	2402.594	2405.501	2405.501	2405.501	2405.501	2405.501	2405.501	2405.501	2401.521	401.601	
ITEM	CONCRETE, MIX NO. 1A43	CONCRETE, MIX NO. 3Y43	CONCRETE, MIX NO. 3Y43 A	CONCRETE, MIX NO. 3Y4G A SPECIAL	REINFORCEMENT BARS	SPIRAL REINFORCEMENT	STRUCTURAL STEEL, (M.H.D. 3306)	ORNAMENTAL METAL RAILING	FIXED BEARING ASSEMBLIES TYPE 1	EXPANSION BRG. ASS'YS TYPE 1 (WITHOUT LUGS)	EXPANSION BRG. ASS'YS TYPE 1 (WITH LUGS)	PRESTRESSED CONCRETE GIRDER, TYPE 60-106	PRESTRESSED CONCRETE GIRDER, TYPE 60-100	PRESTRESSED CONCRETE GIRDER, TYPE 60-95	PRESTRESSED CONCRETE GIRDER, TYPE 60-86	PRESTRESSED CONCRETE GIRDER, TYPE 60-76	PRESTRESSED CONCRETE GIRDER, TYPE 60-64	PRESTRESSED CONCRETE GIRDER, TYPE 60-53	PRESTRESSED CONCRETE GIRDER, TYPE 60-51	STRUCTURE EXCAVATION CLASS E	SLOPE PAVING
UNIT	CU. YD.	CU. YD.	CU. YD.	CU. YD.	POUND	POUND	POUND	LIN. FT.	EACH	EACH	EACH	EACH	EACH	EACH	EACH	EACH	EACH	EACH	CU. YD.	SQ. YD.	
QUANTITY	732 (P)	621 (P)	669 (P)	57 (P)	274230 (P)	12450 (P)	2040	466	8	24	16	1	1	1	4	2	4	5	6	2070	1520 (P)

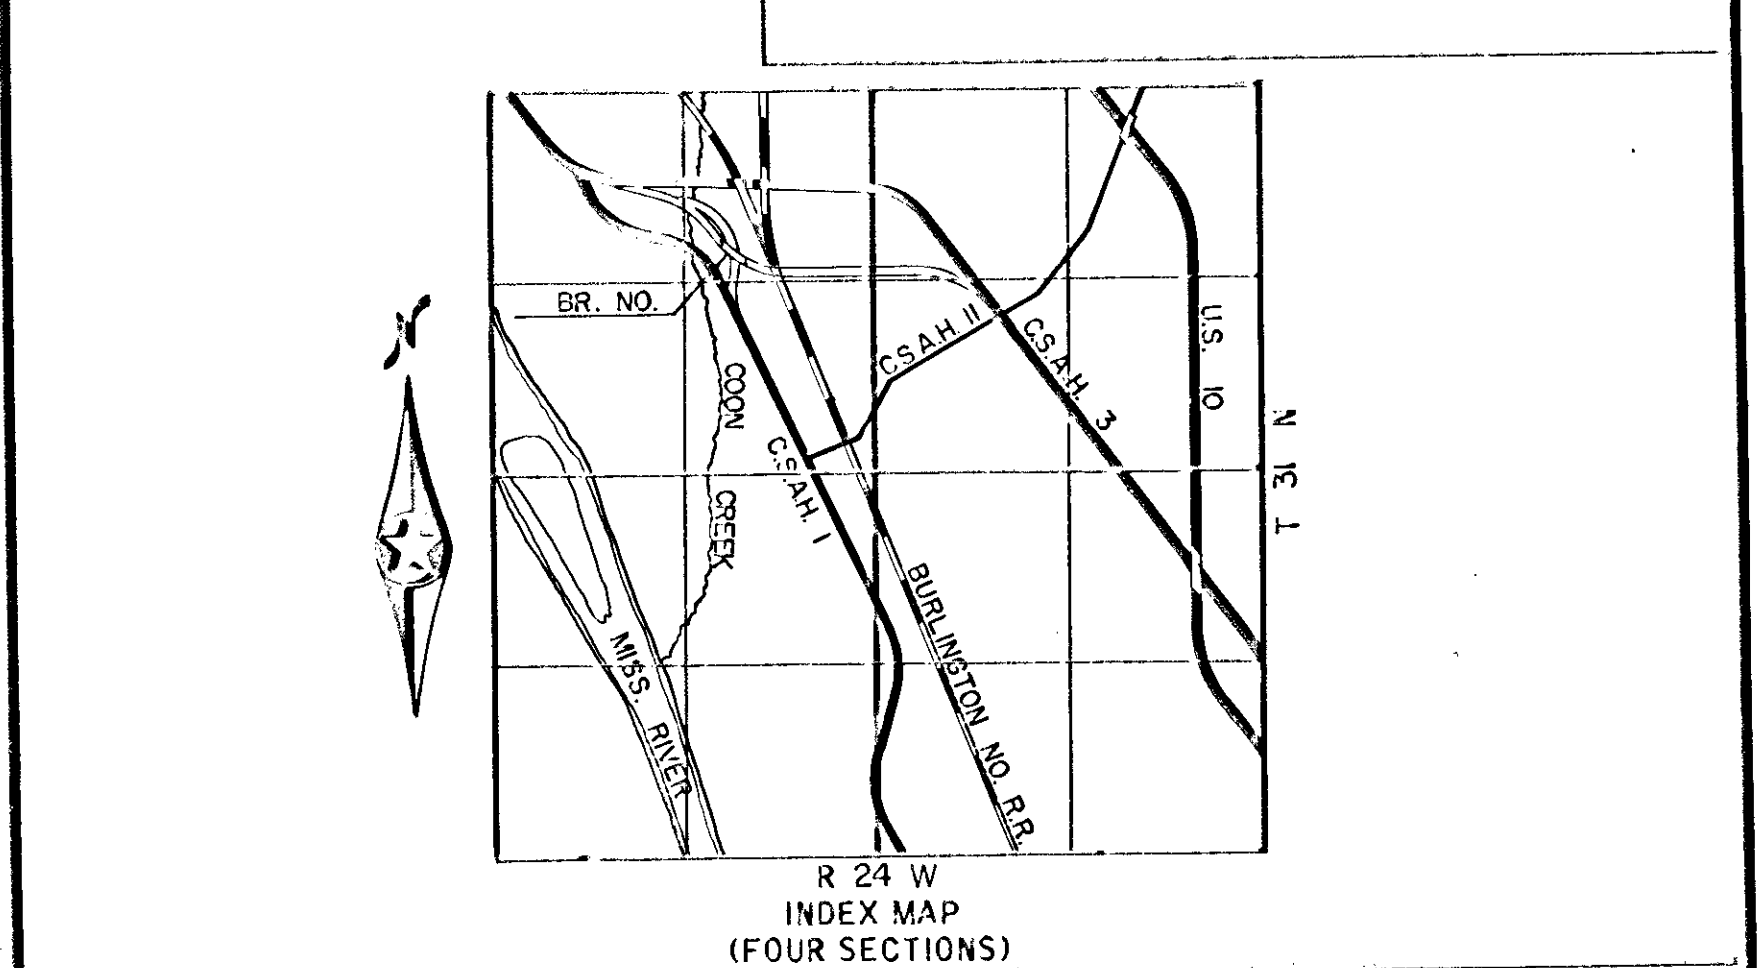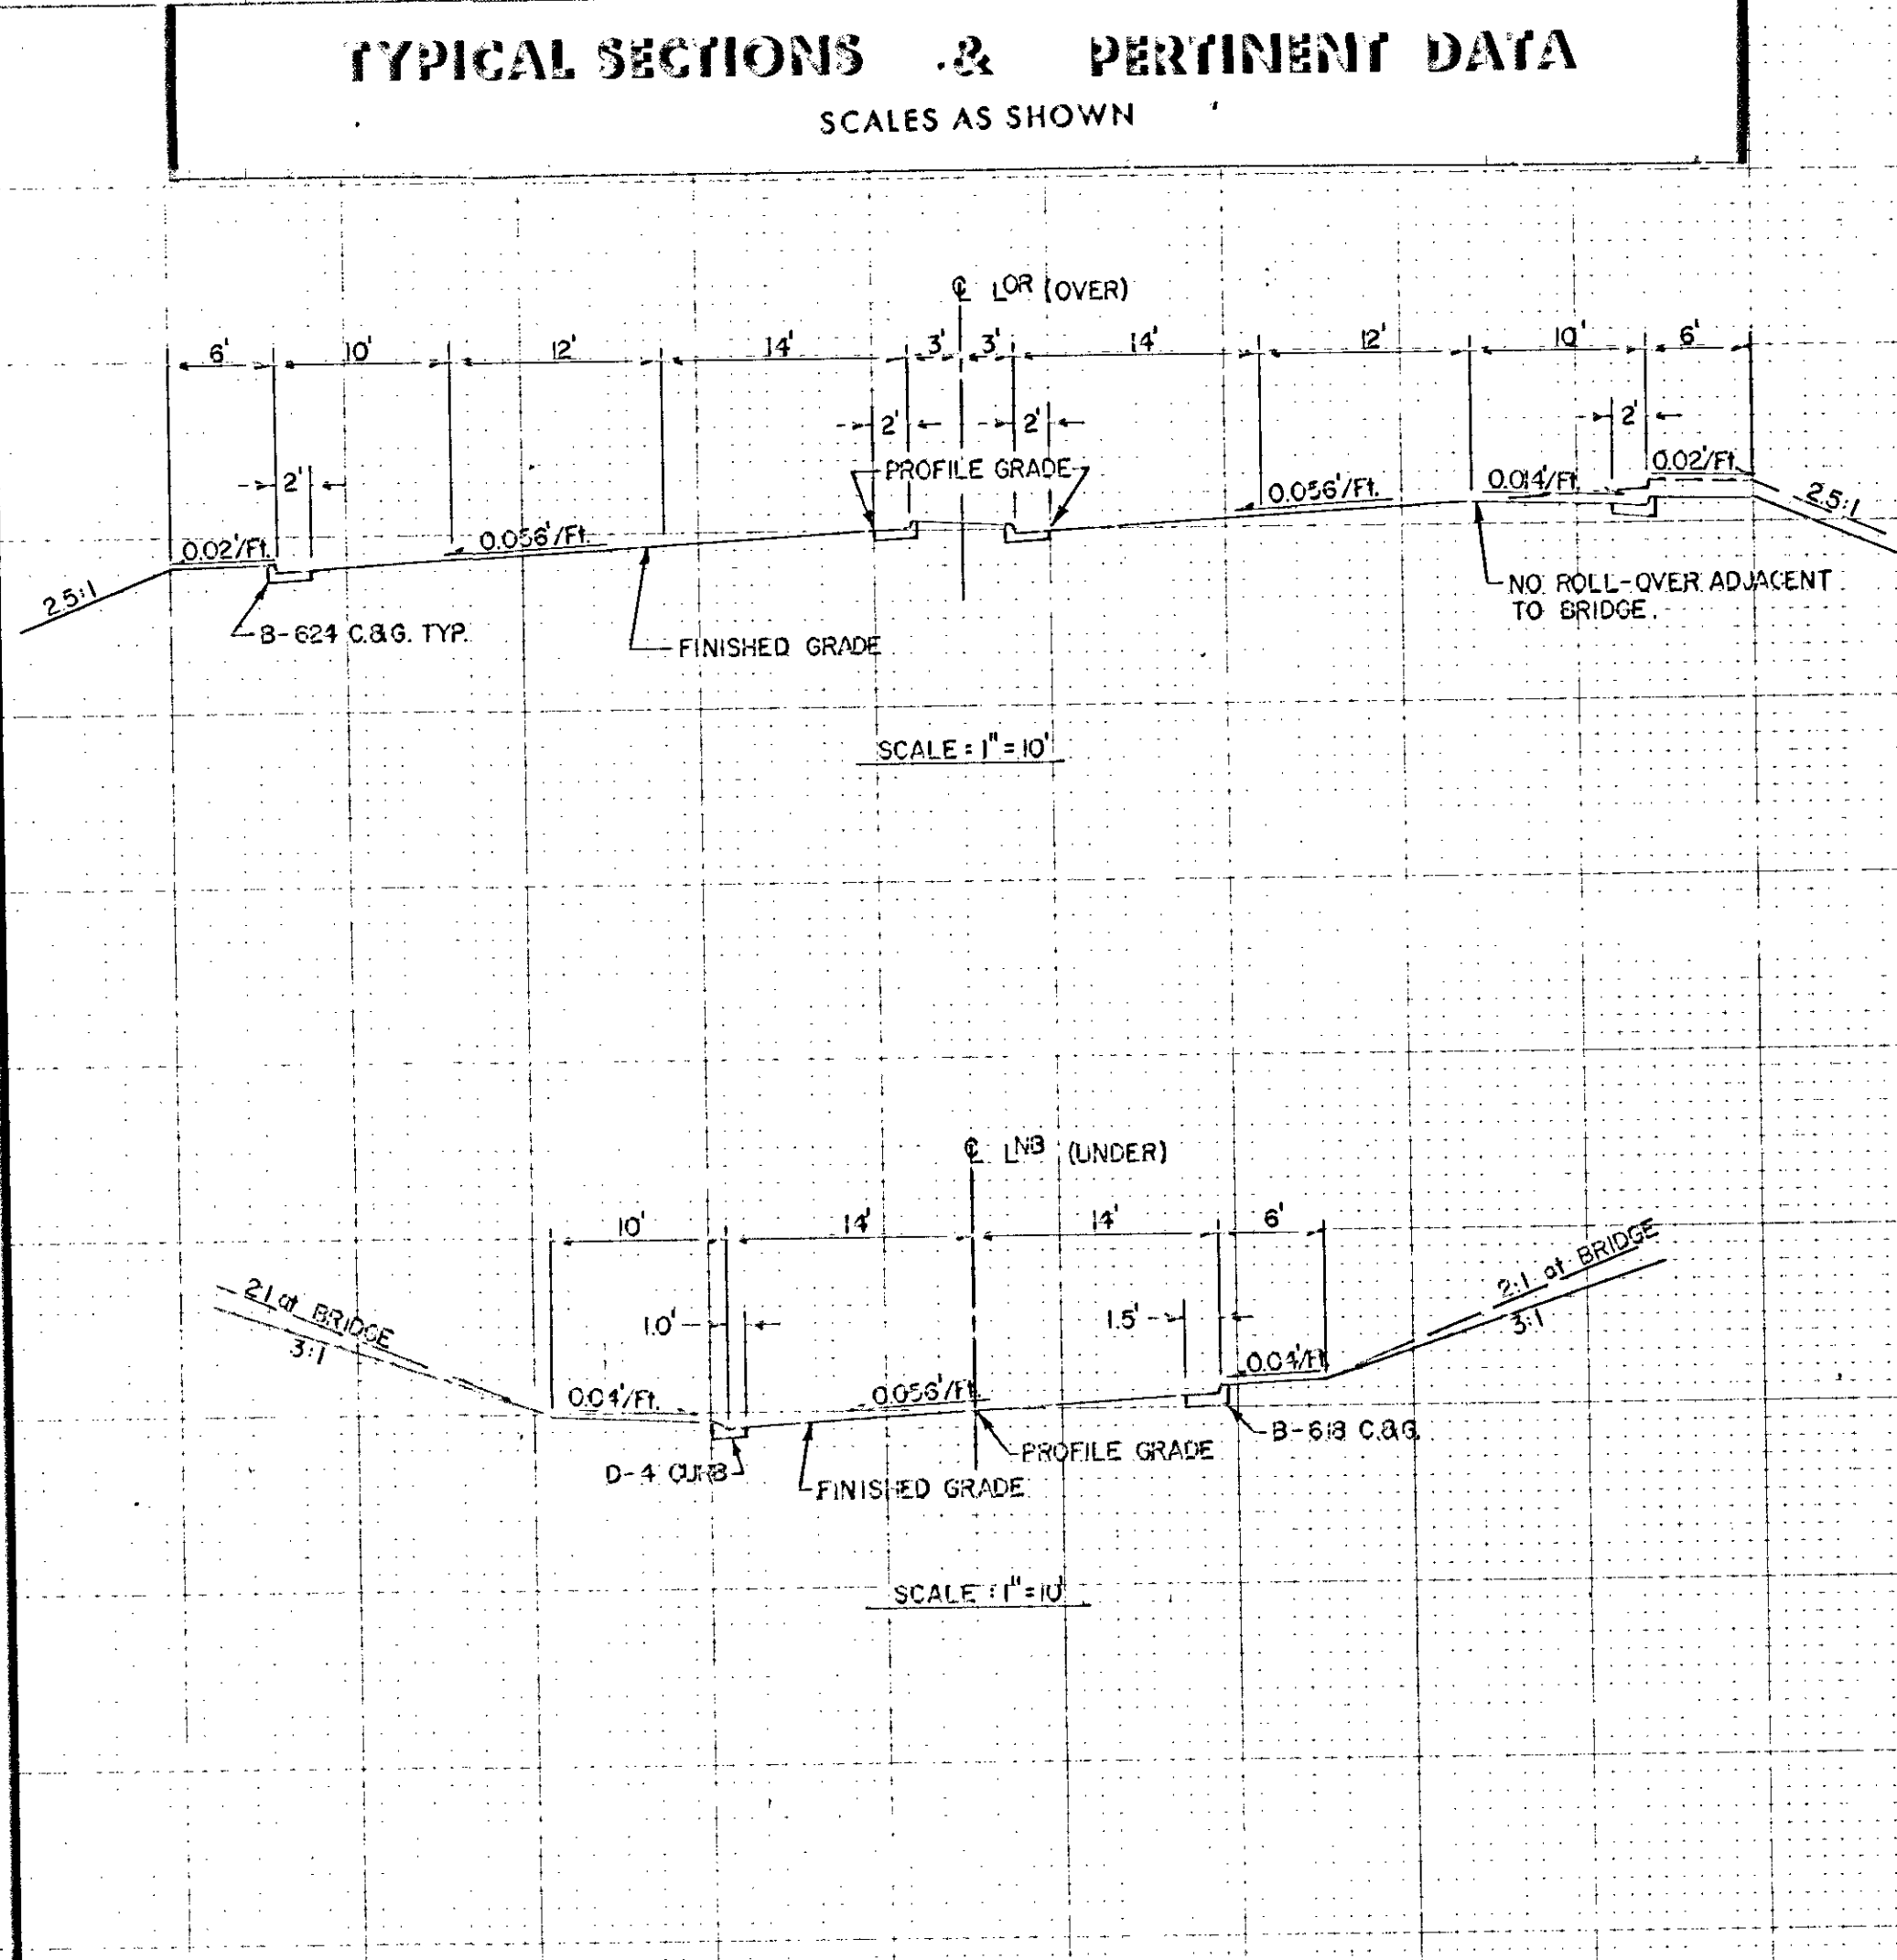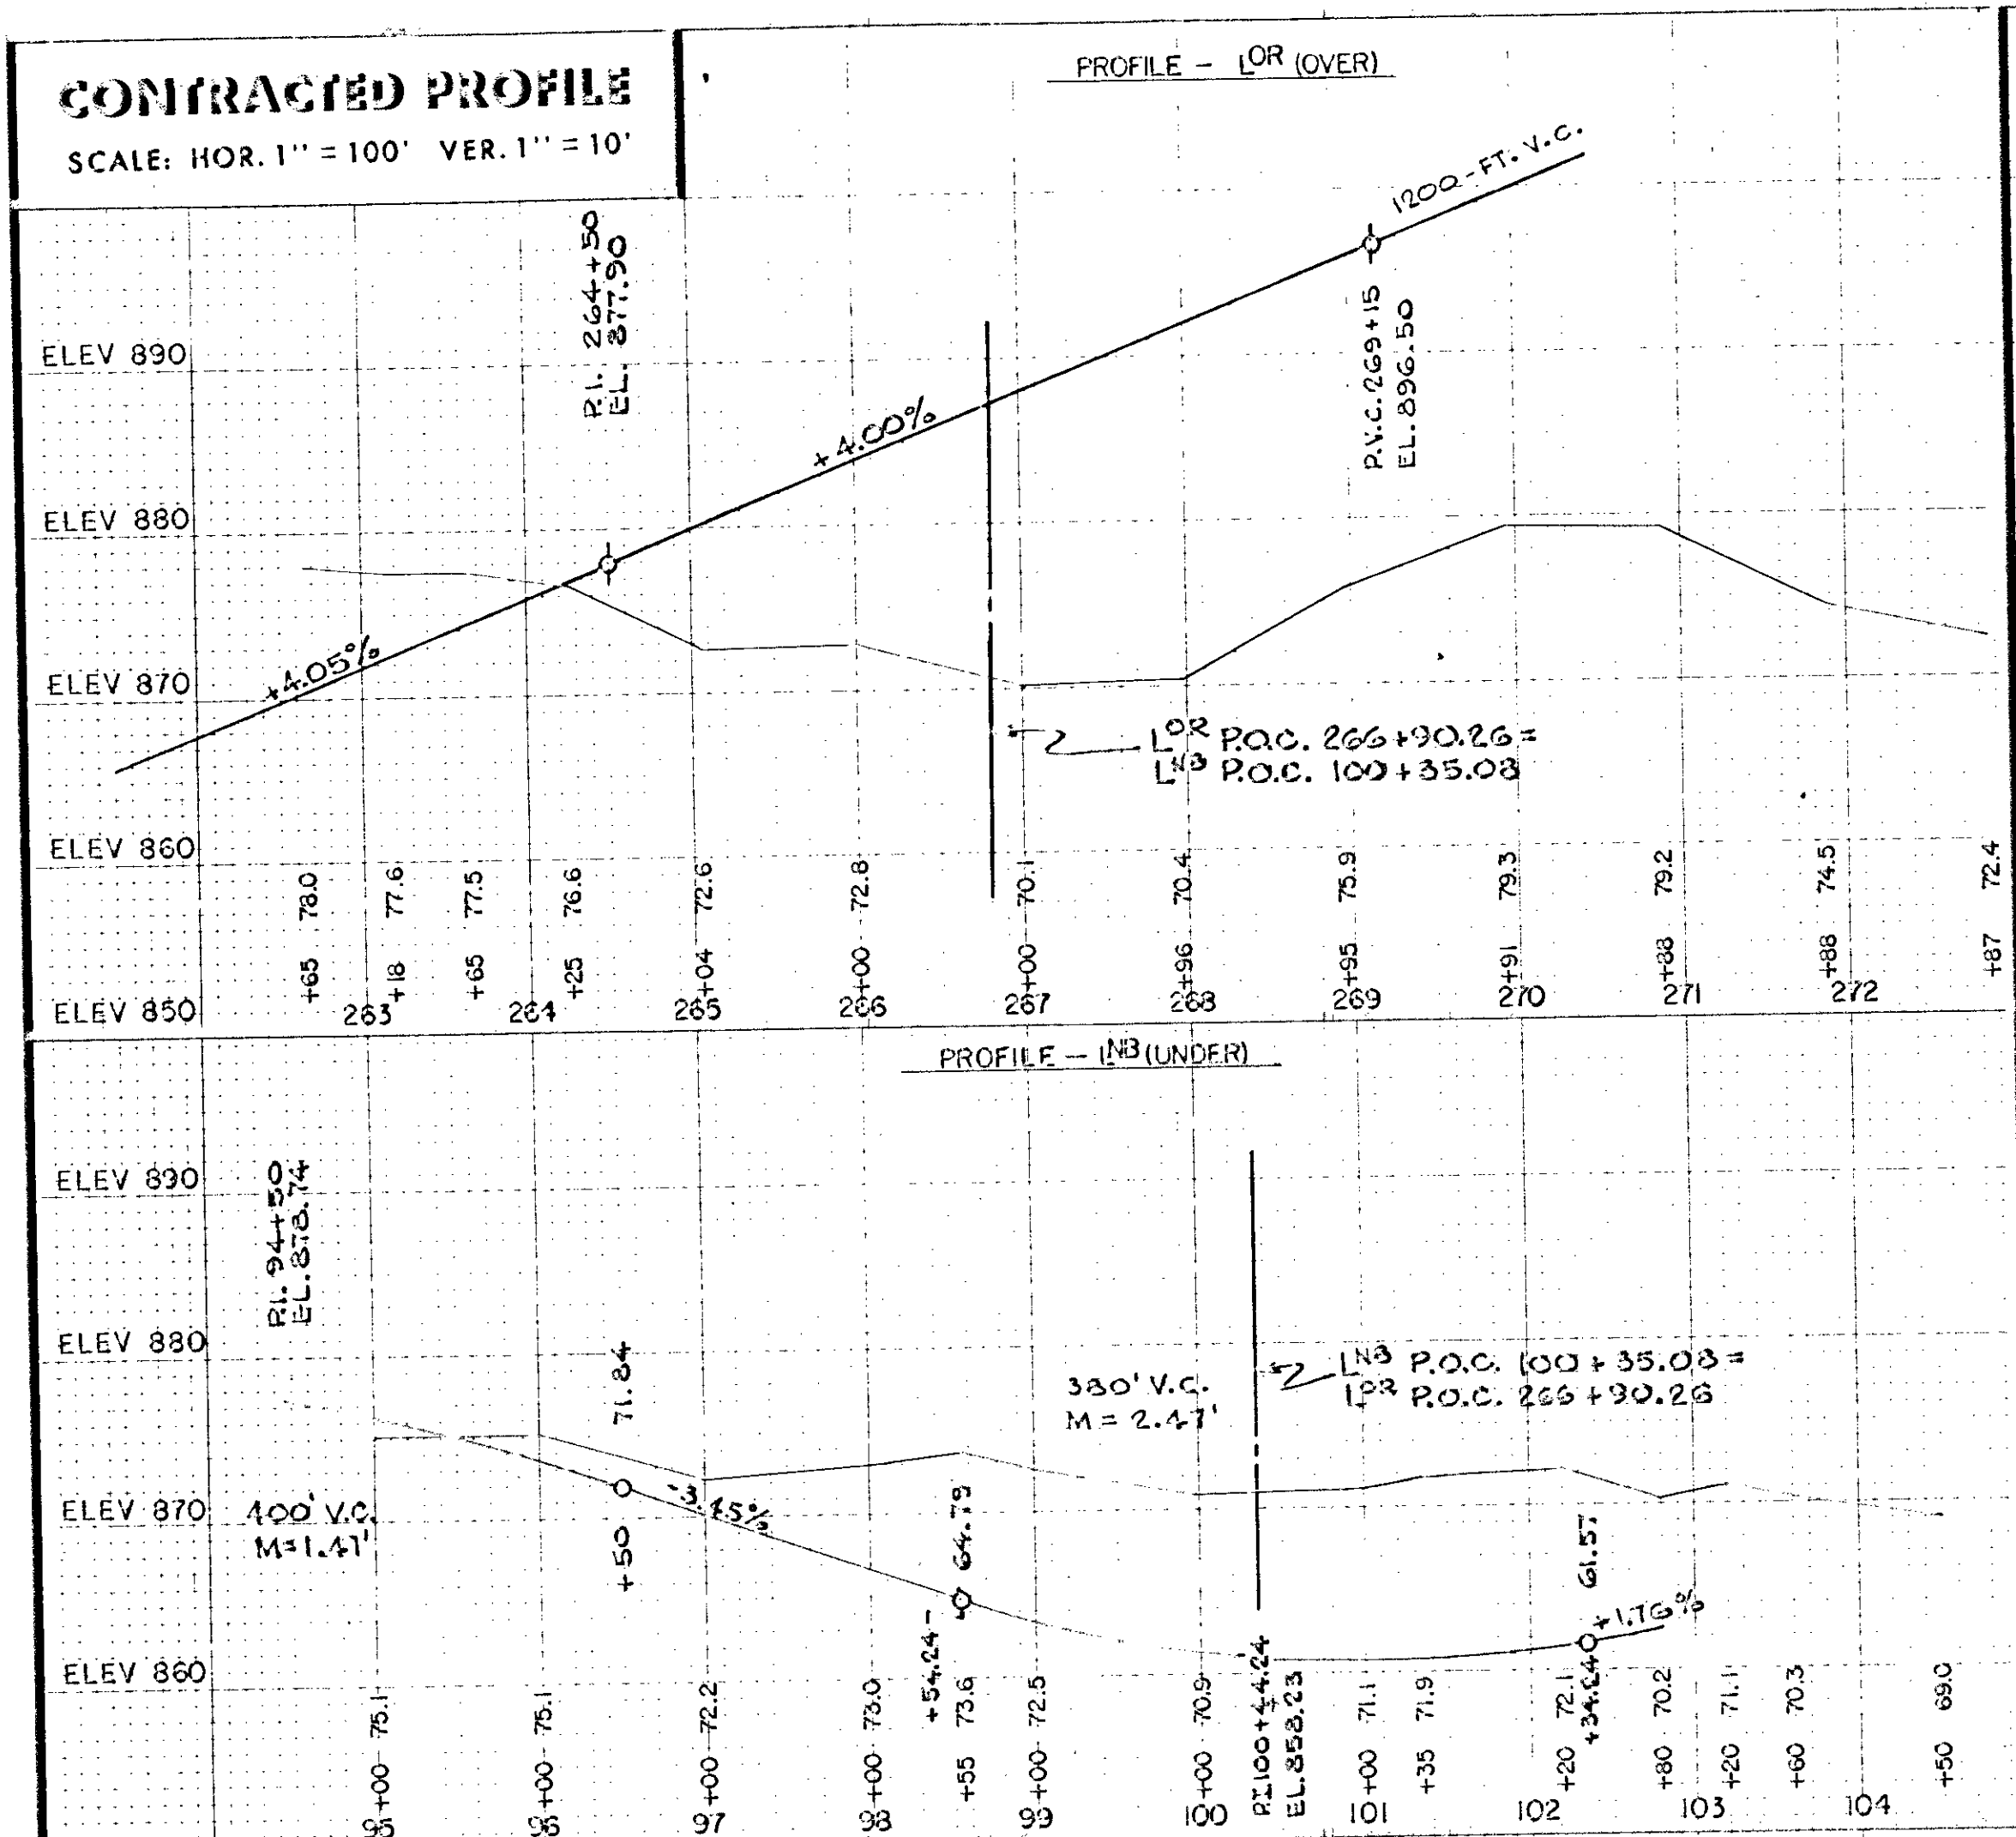

FOLLOW SEPARATE "INSTRUCTIONS FOR PREPARATION OF BRIDGE SURVEYS" WHEN MAKING BRIDGE SURVEYS.

DATA

- Preliminary recommendations of Engineer in charge of Bridge Survey:
 - a. Net span length and type of bridge: 53-89-59' PRESTRESSED CONCRETE GIRDER SPANS
 - b. Width of roadway on bridge: TWO-36 FT. ROADWAYS AND ONE-6 FT. MEDIAN
 - c. Number and width of side ditches, if any: NONE
 - d. Locate center of bridge at station: 266 + 90.26
 - e. If a skew bridge is recommended, the angle of skew should be: 53° - 17' - 41"
 - f. Is piling required? YES
- Special features: Waterfalls, dams, exceptional floods, ice, driftwood, sliding banks, logging, etc.
- Changes: In height or length from that of old bridge, and reasons why.
- Other bridges in vicinity:
 - a. Over some stream (particularly structures which carry high water without overflow of roadway); give location, length, height above water, net cross-sectional area at high water stage and estimated age.
 - b. Over or under some highway or railroad; give location, length, horizontal and vertical clearances and estimated age.
 - c. Reasons why these bridges are, or are not, fair indications of what length the proposed bridge should be.
- If structure is over a drainage ditch, is ditch gradient liable to be altered?
- Navigation clearances required, if any.
- Information and evidence in regard to high water stages was obtained as follows: NO
- Must contractor provide for traffic during construction of proposed bridge? NO
If so, by what means?

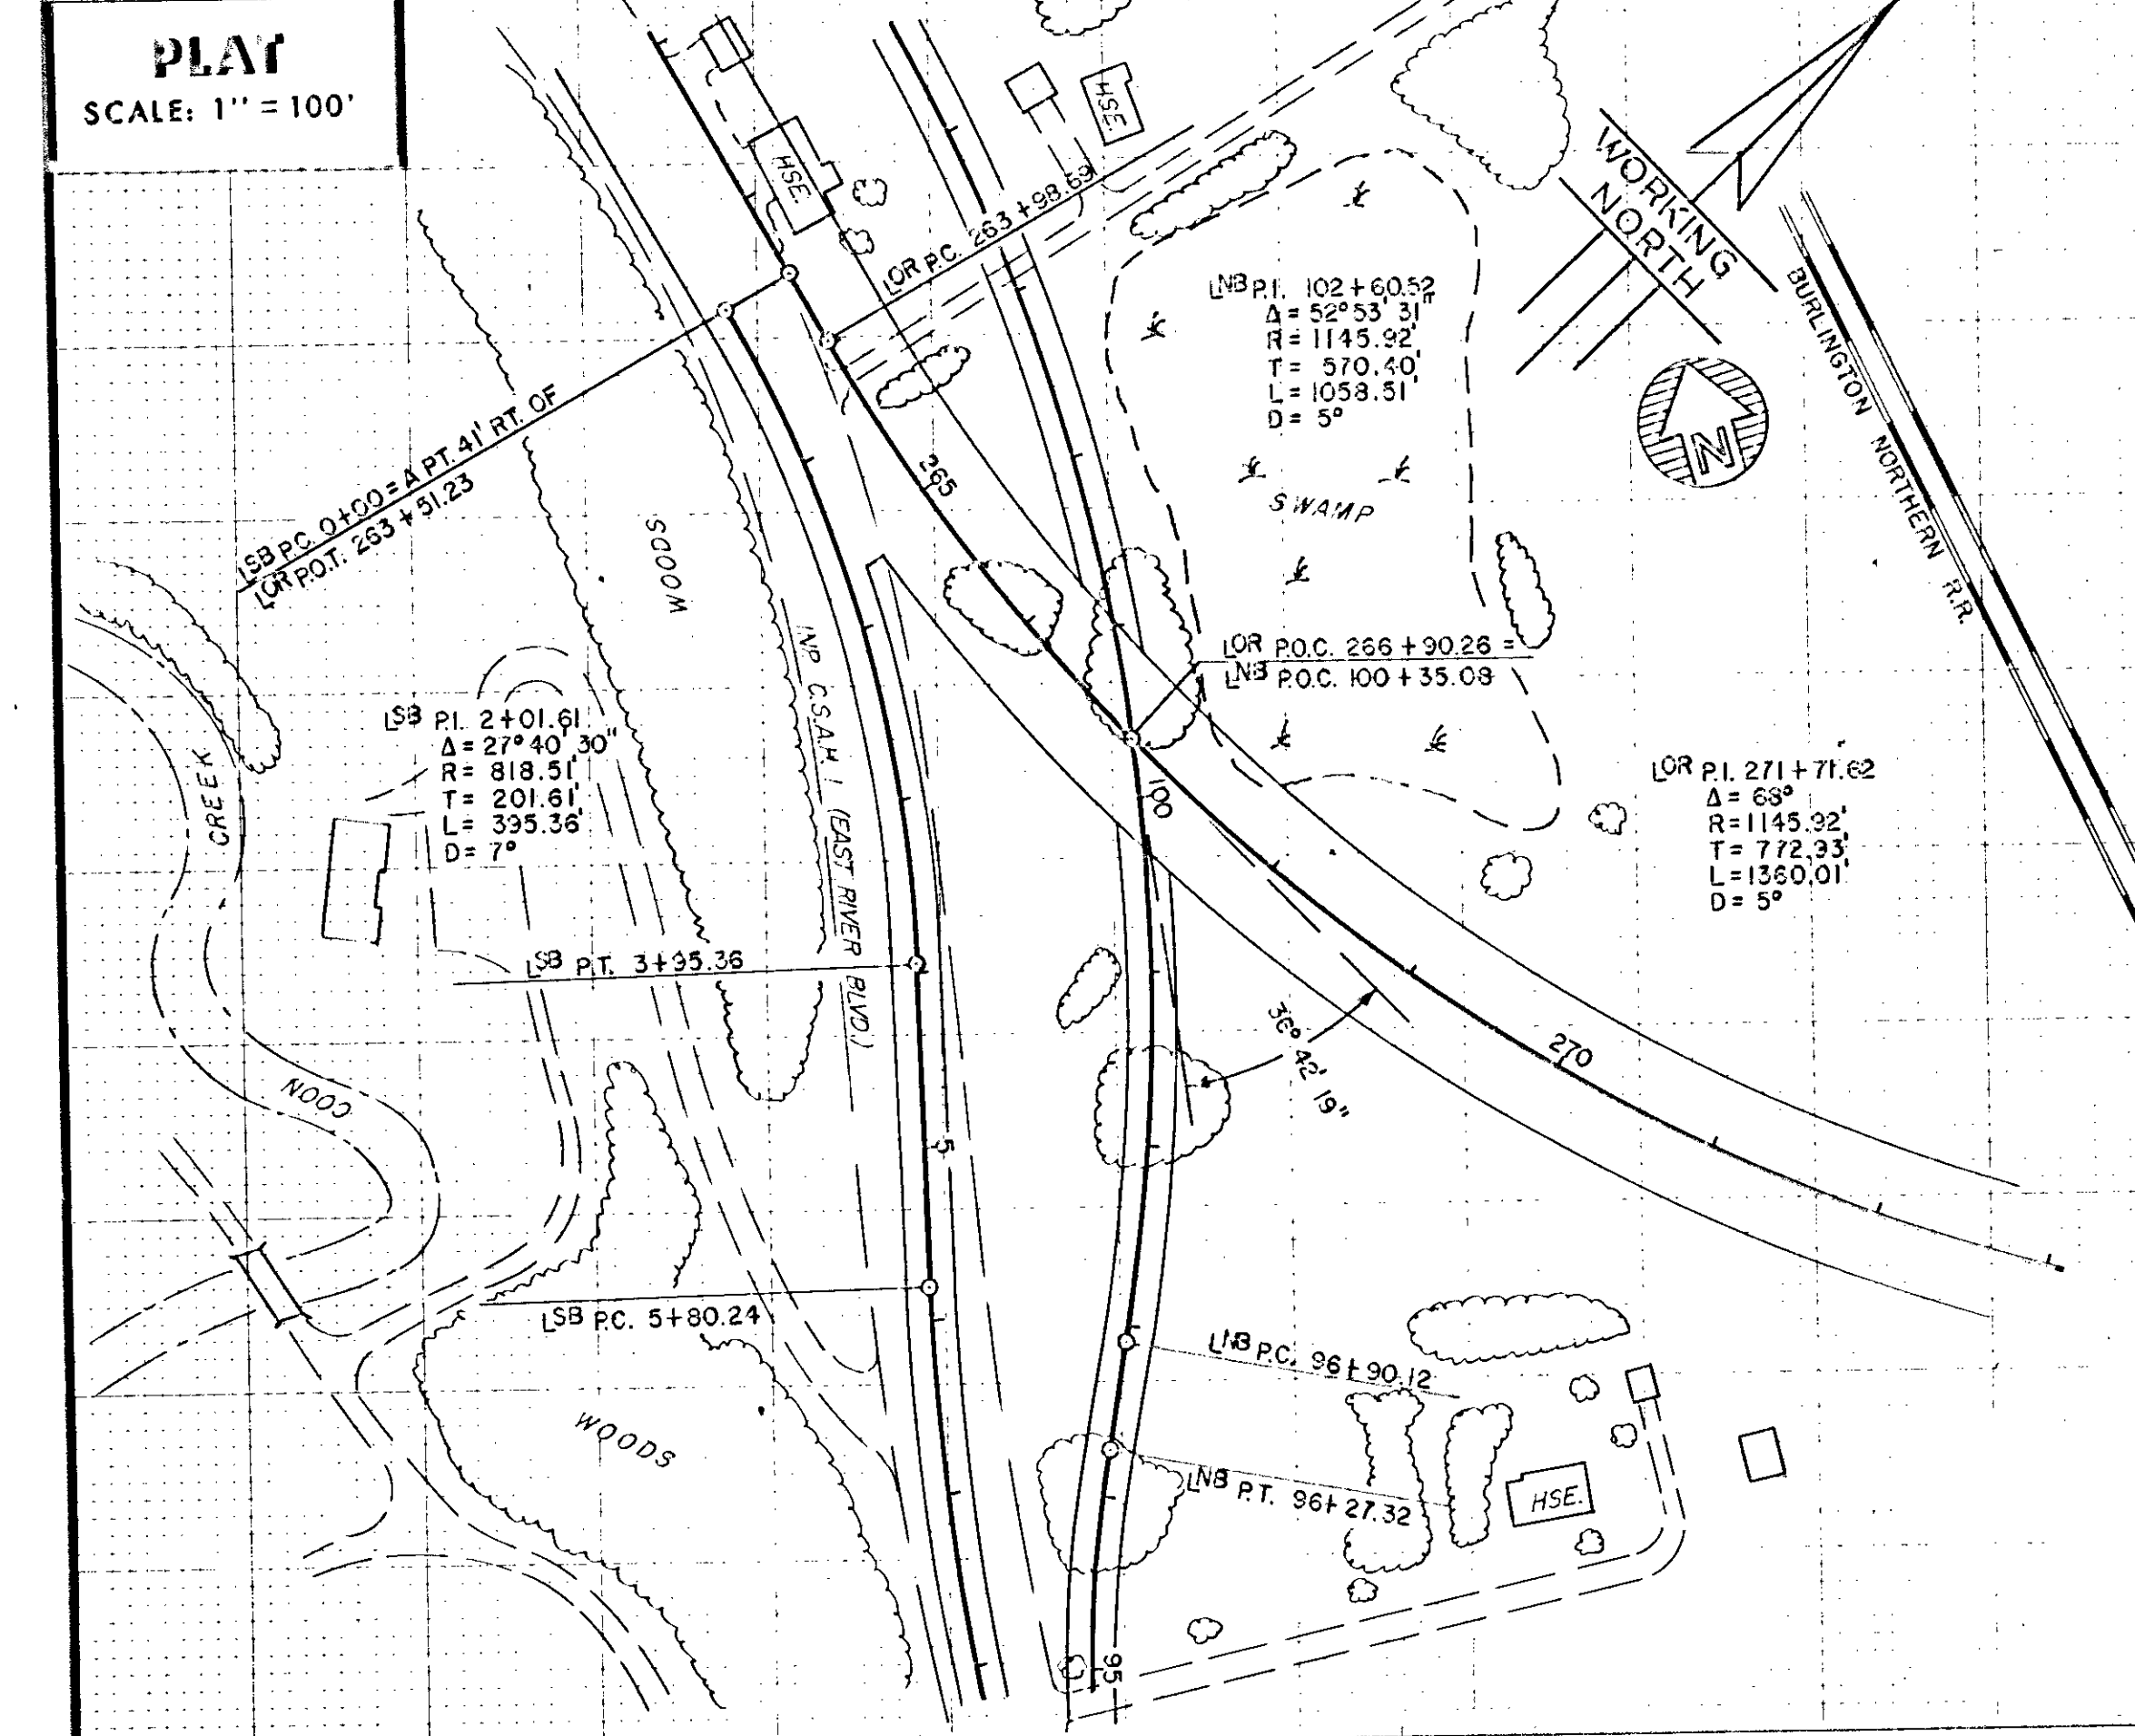

B.M. ELEV 874.34
RR. SPK. 18' OAK,
90' RT. LOR 263+96
(M.S.L. - 19 ADJ.)
(DATUM UNKNOWN)

SEE SHEET 35 OF 35 SHEETS FOR PLAN AND PROFILE


AS BUILT
10-16-73
B. Jahn

HIGH AND LOW WATER ELEVATIONS
Data obtained from..... reflects highest water elevation in the area of this construction to be..... and the lowest water elevation to be..... The above figures are for informational purposes only. The state neither warrants nor represents that these figures for high water and low water are in any way indicative of the high water or low water to be expected or encountered during this construction.

SHIPPING POINT
Proposed Bridge is IN THE CITY of COON RAPIDS which is the nearest Railroad shipping point.
(Give name of town, station or siding)

Date..... Project or County Engineer.....
Date..... District Engineer.....

STATE OF MINNESOTA
DEPARTMENT OF HIGHWAYS
BRIDGE SURVEY
FOR
PROPOSED BRIDGE LOCATED IN THE CITY OF COON RAPIDS ON C.S.A.H. NO. 1 (TOWN OR CITY) SEC. 26 TAP. 31 N. R. 24 W. CITY OF COON RAPIDS - ANOKA COUNTY
SURVEY MADE DURING MONTH OF DECEMBER 1970
SURVEY MADE BY J. MALONEY
BRIDGE NO. 02522

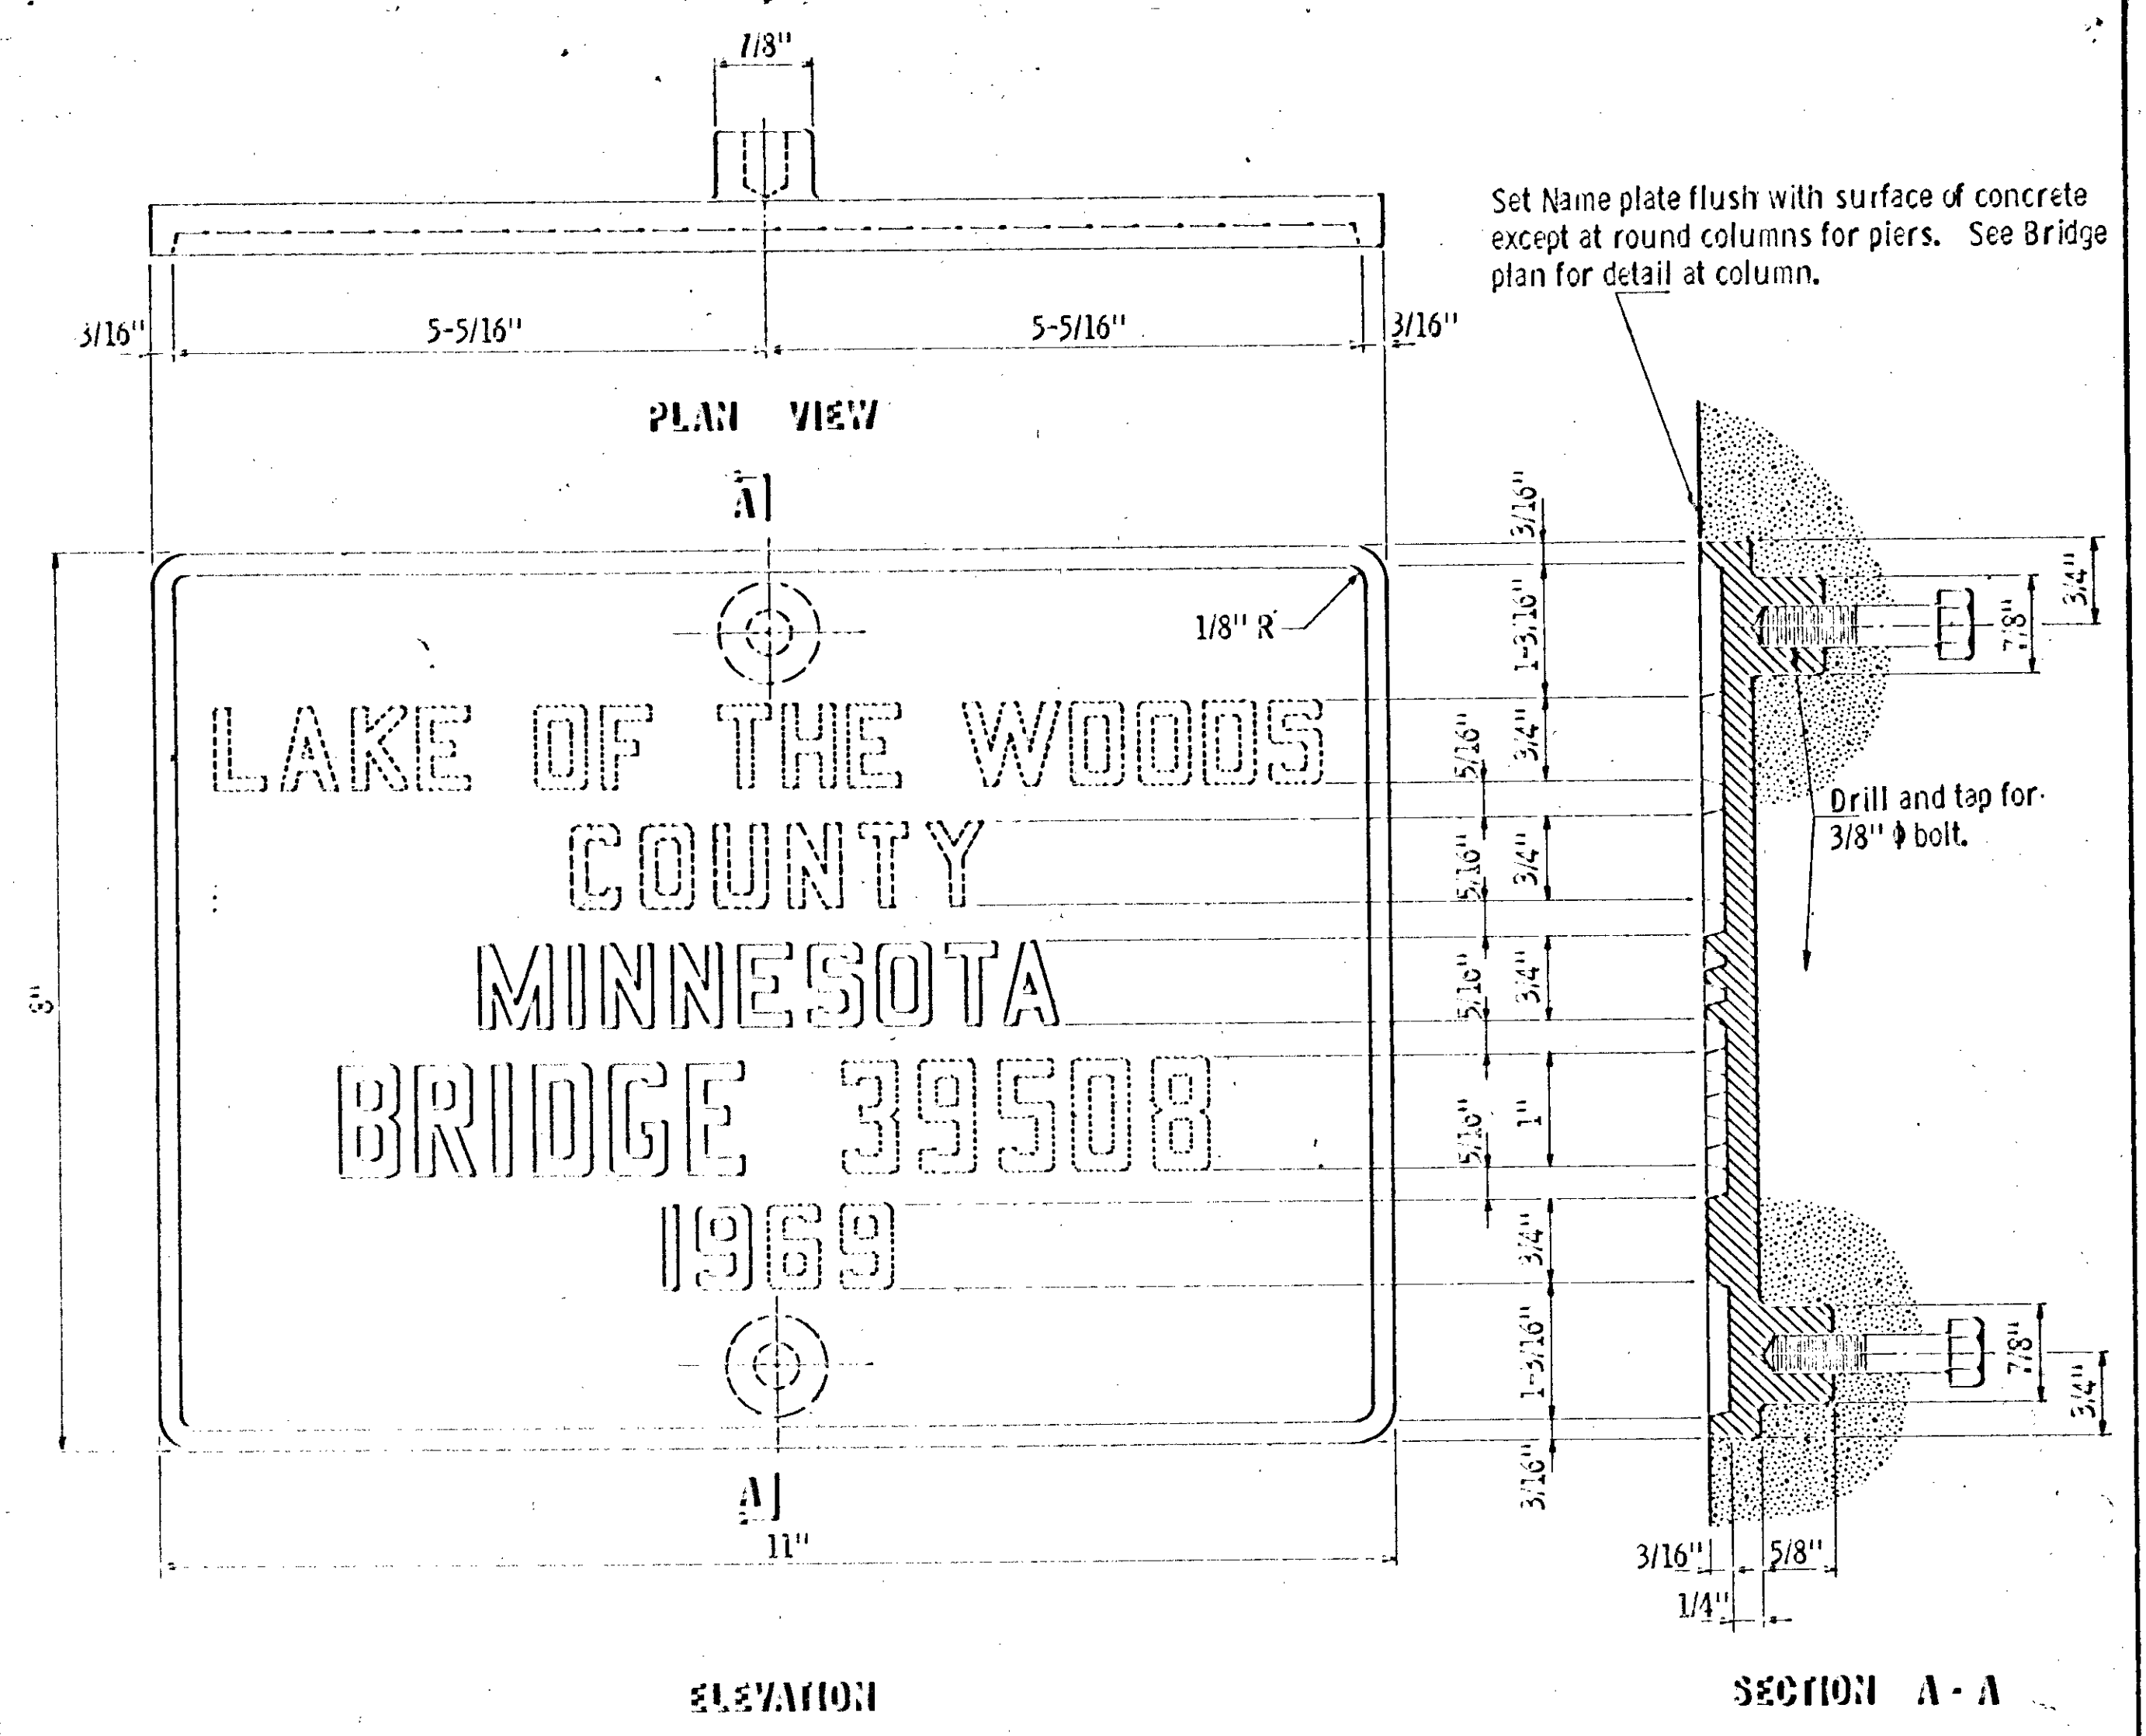

A B C D E F G H I J K L M N
 O P Q R S T U V W X Y Z
 1 2 3 4 5 6 7 8 9 0

NOTES:

Numbers and letters shall conform to those shown.

Draft on letters shall not be more than 3" in 12"

Horizontal spacing of letters shall produce a balanced layout in proportion to spacing shown.

Top surface of letters and frames shall be burnished.

Background of plate shall have a deep brown oxidized finish.

Furnish 2 steel bolts 3/8" φ x 3" long with each plate.

Plates ordered in pairs shall be cast from the same heat.

Numbers and letters shown dotted are to be obtained from Bridge plans.


All dimensions for 3/4" high letters and numbers shall be in direct proportion to those shown for the 1" high letters and numbers.

Specification reference:
2471.3H, 3327 (Bronze castings)


APPROVED July 1, 1969 <i>[Signature]</i> Design Standards Engineer ENGINEERING STANDARDS DIVISION	STATE OF MINNESOTA DEPARTMENT OF HIGHWAYS BRIDGE NAME PLATE COUNTY BRIDGES (STATE AID)	REVISION	DETAIL NO. 3103
---	--	----------	---------------------------

AS BUILT 10-16-73 B. J. [Signature]	TITLE: DETAILS	DES: M.H.D. CHK: R [Signature] OR: M.H.D. CHK: R [Signature] APPROVED: 12-31-71	Bridge No. 02522
---	-------------------	--	---------------------

Sheet No. 33 of 35 Sheets

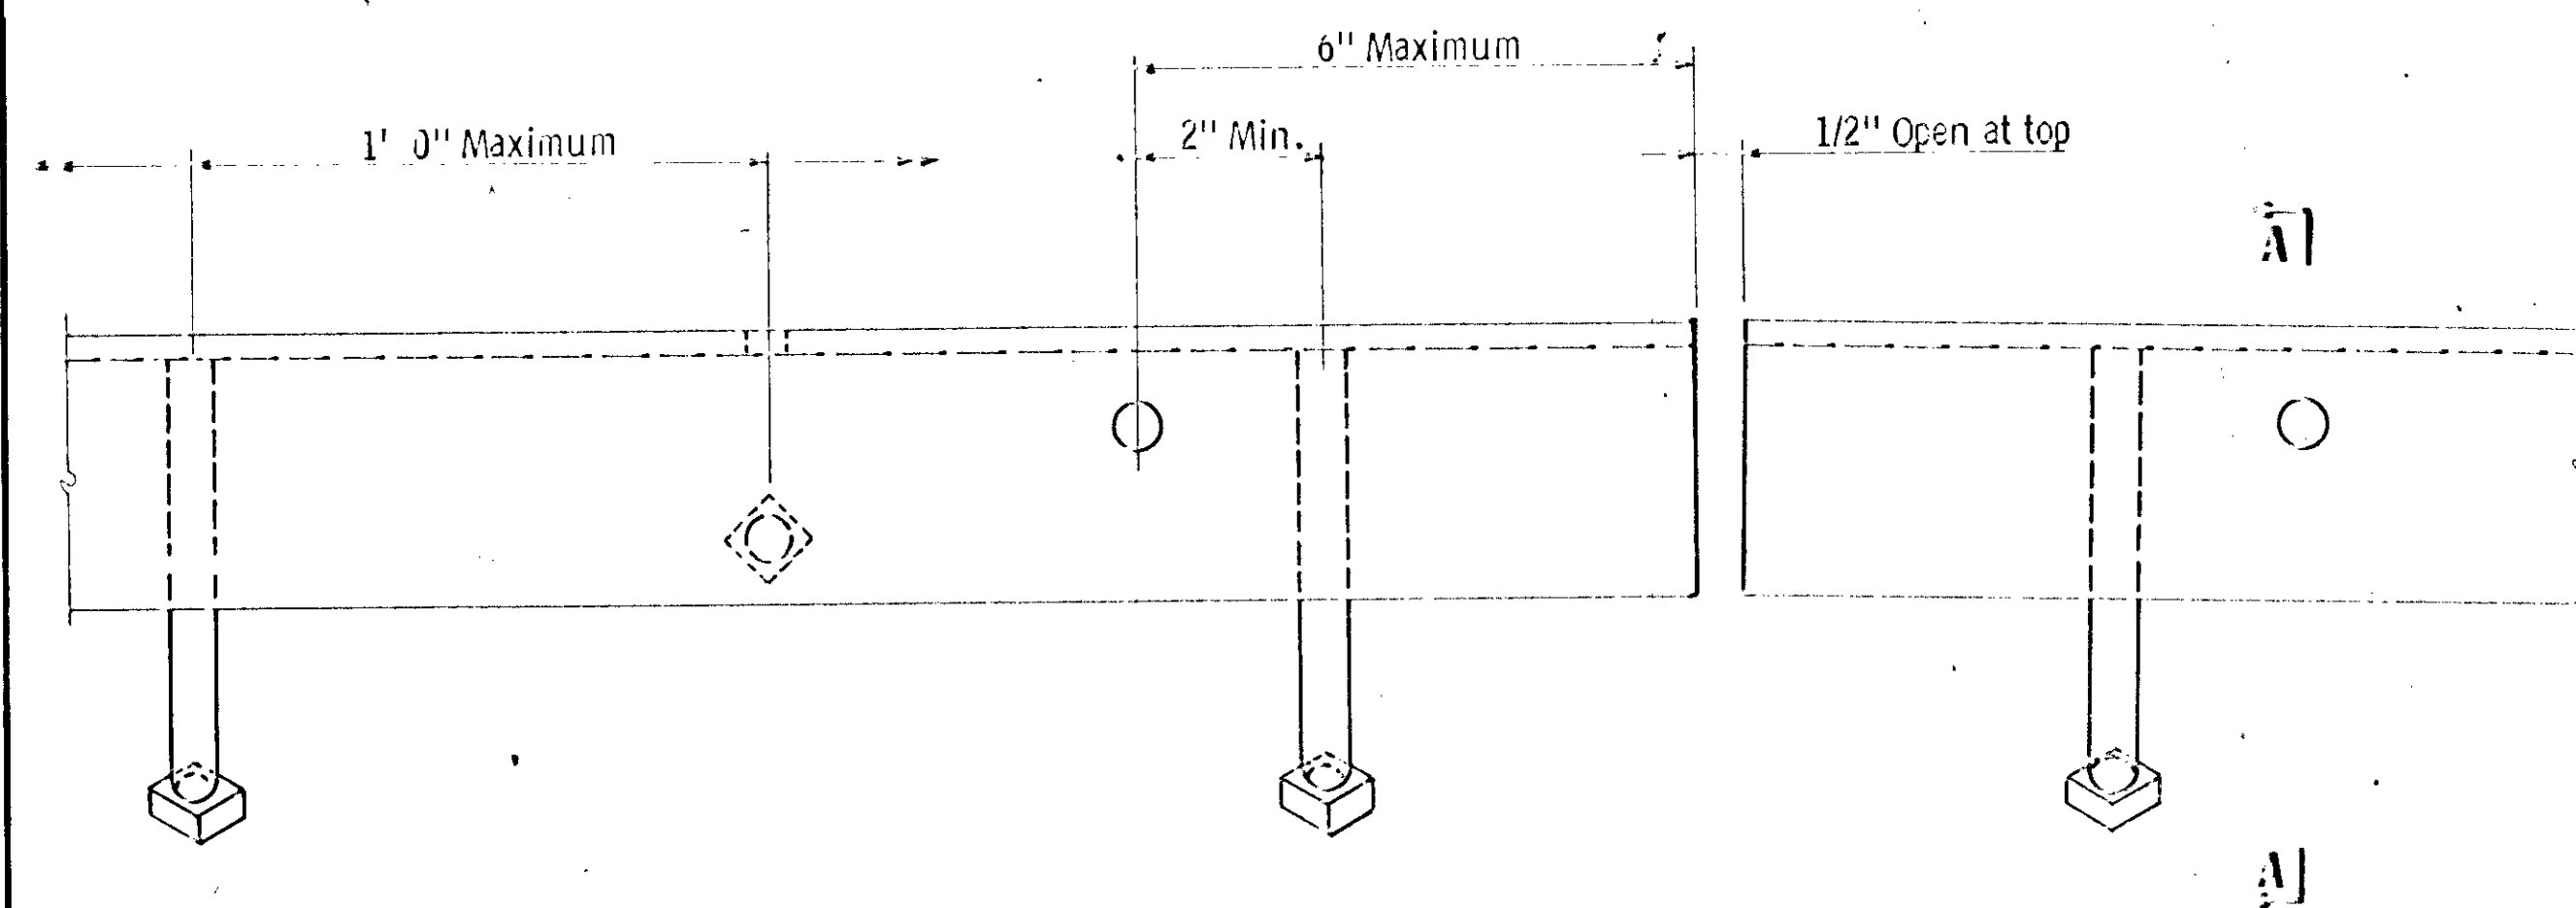

ELEVATION
(Concrete not shown)

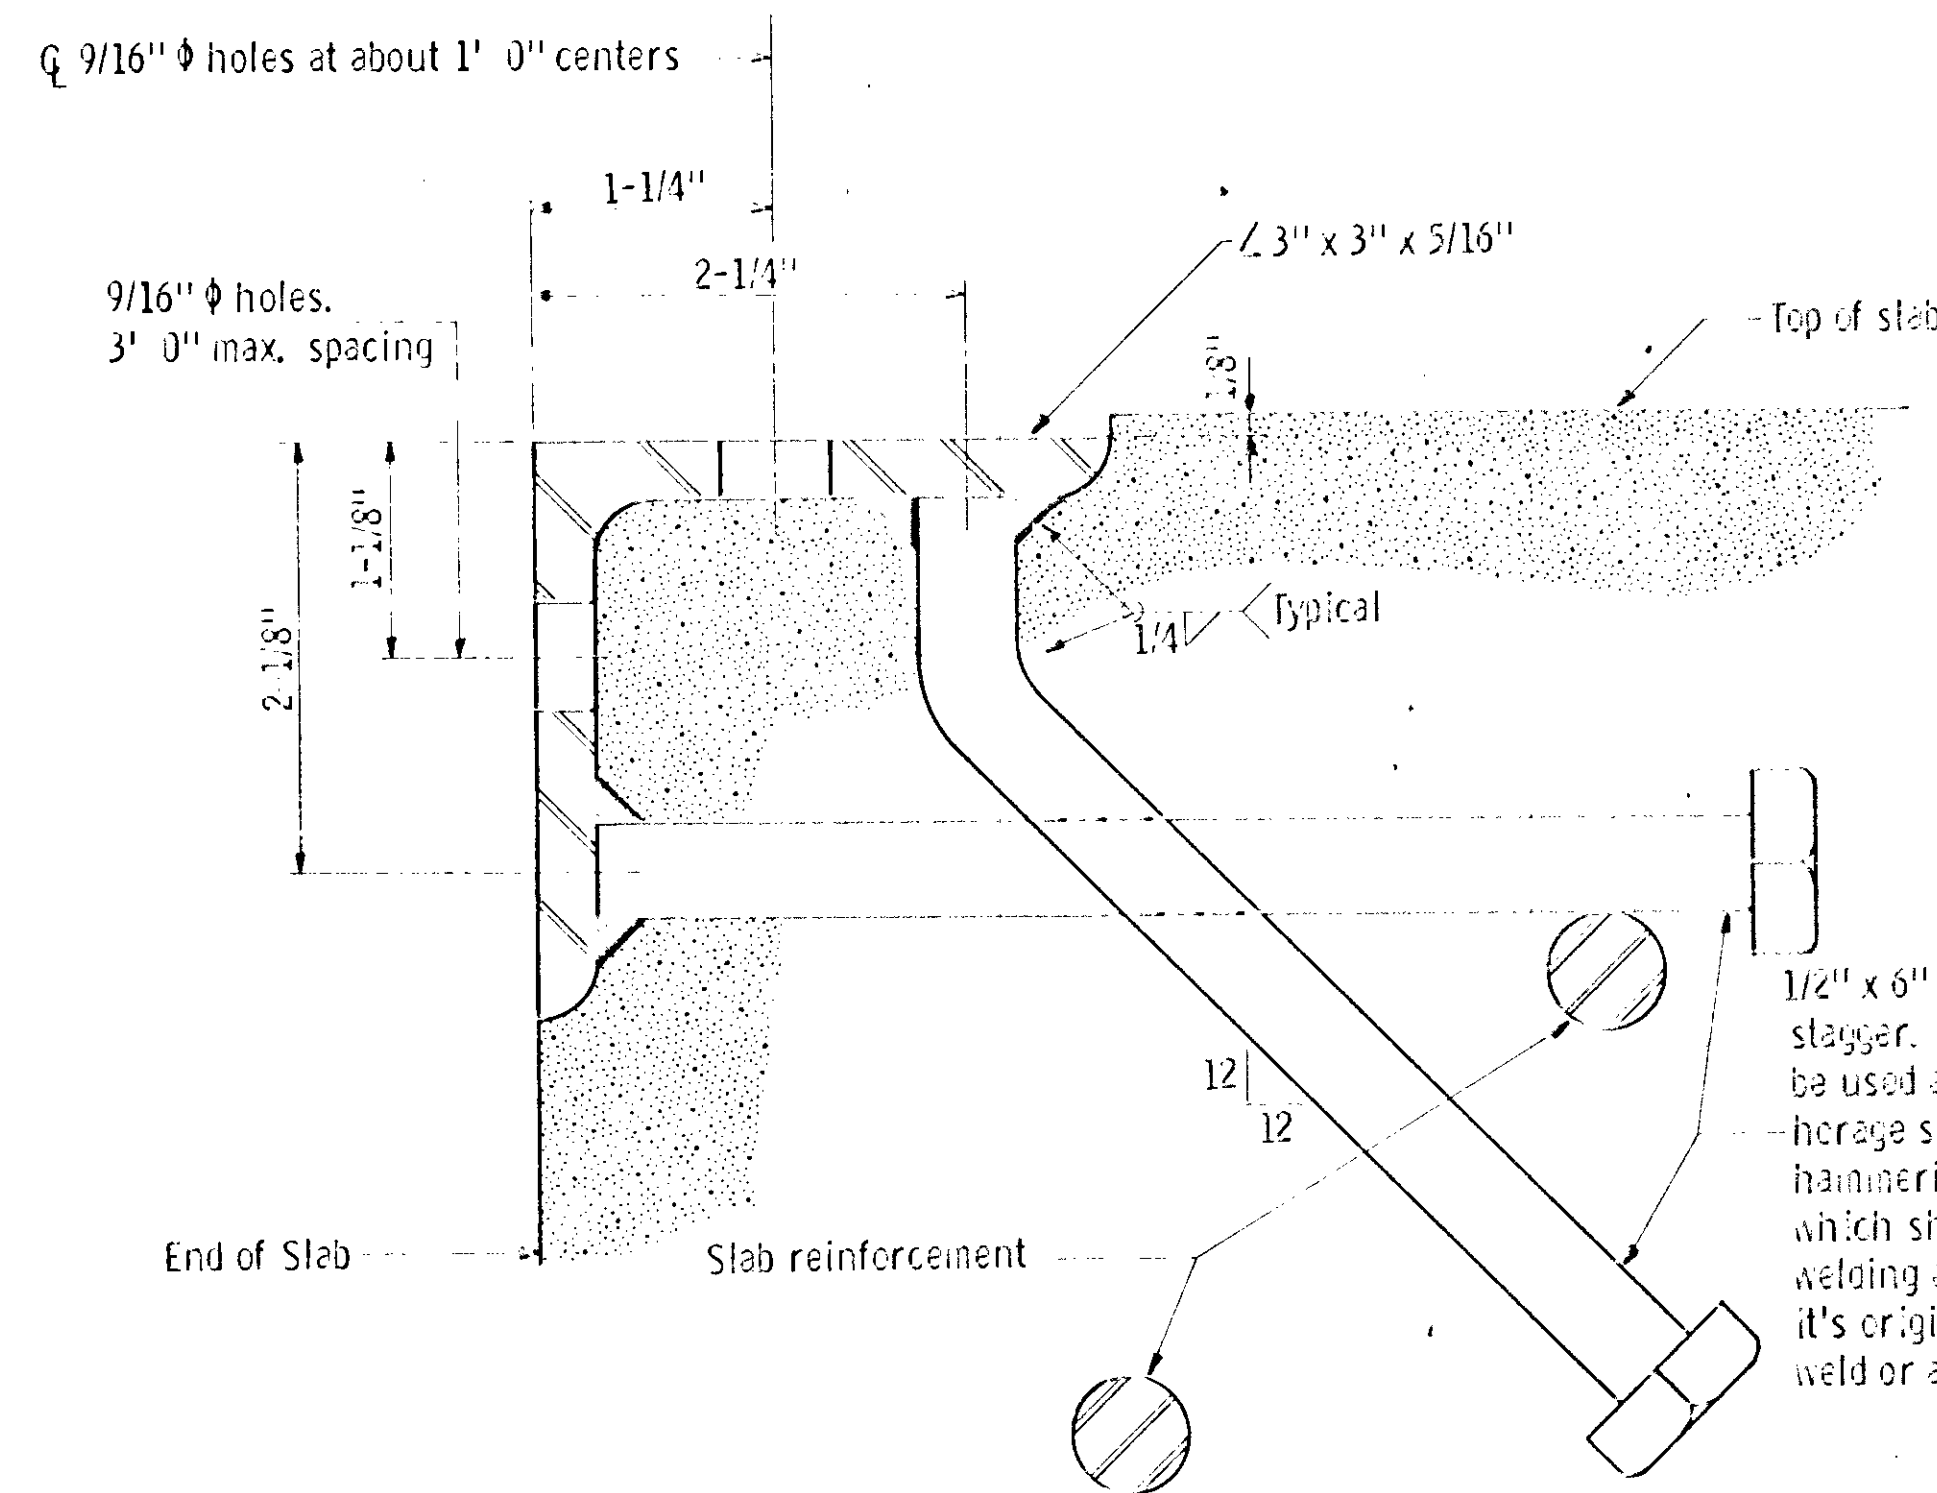

SECTION A - A

NOTE:


SEE DECK PLANS FOR LENGTHS AND RADII OF CURVATURE OF PROTECTION ANGLES. LENGTHS GIVEN ON DECK PLANS ARE HORIZONTAL DIMENSIONS, NOT SLOPE DIMENSIONS.

NOTES:


Angles shall extend full width of roadway between curbs with a 1/2" open joint at each break in crown profile. Maximum length 22 feet.

Material: Structural steel per M. H. D. 3306. Galvanize after fabrication per M. H. D. 3394


Set angle to proper grade and crown.

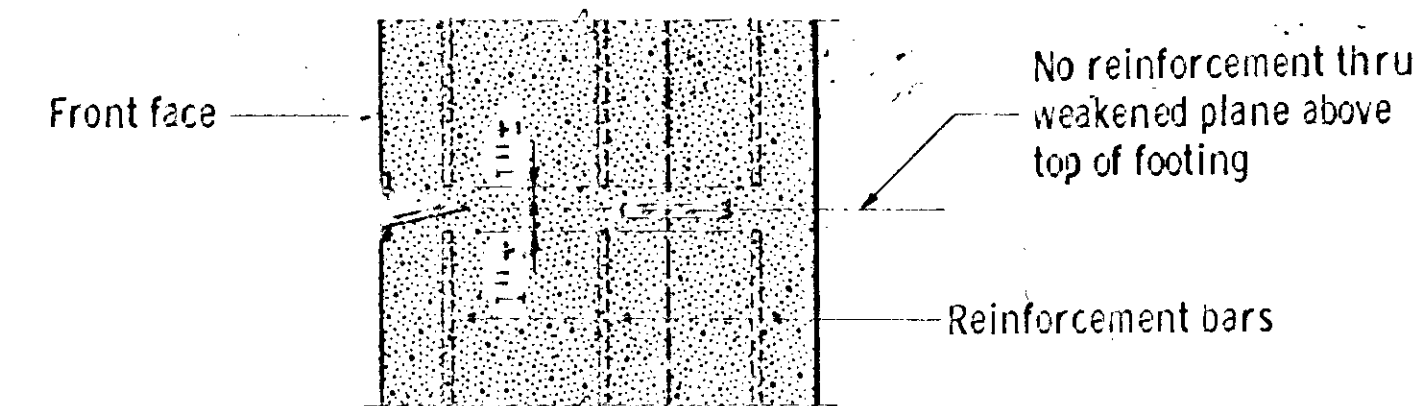


SECTION A - A

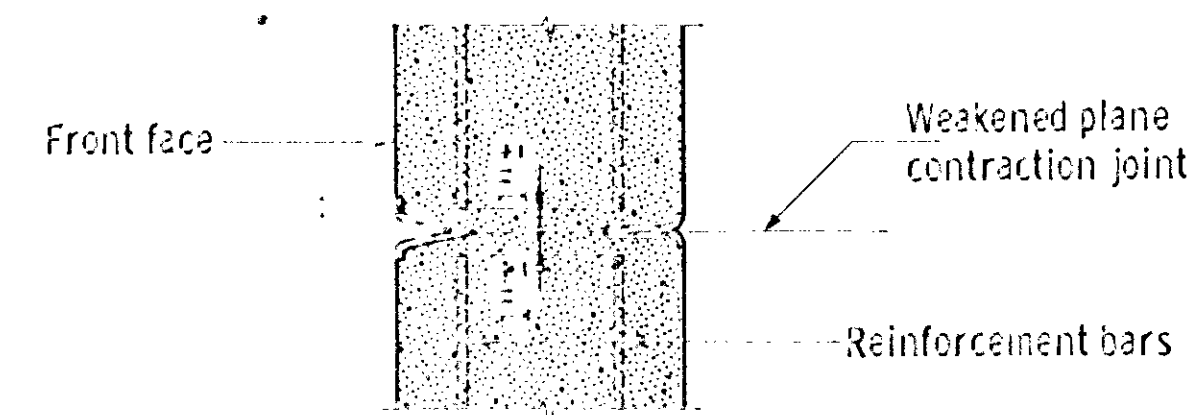

SECTION B - B

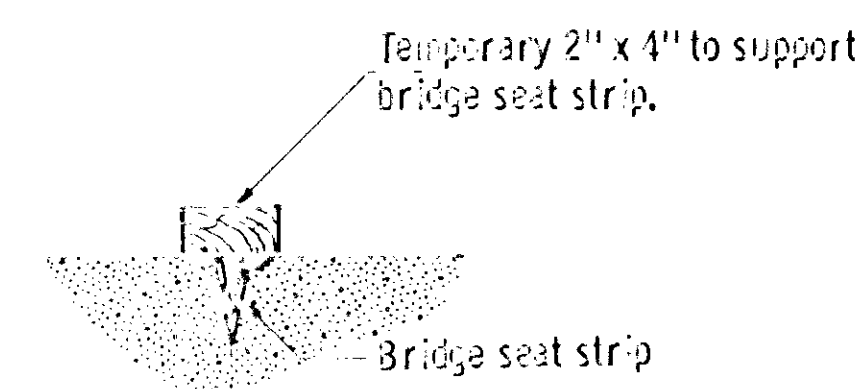


SECTION C - C

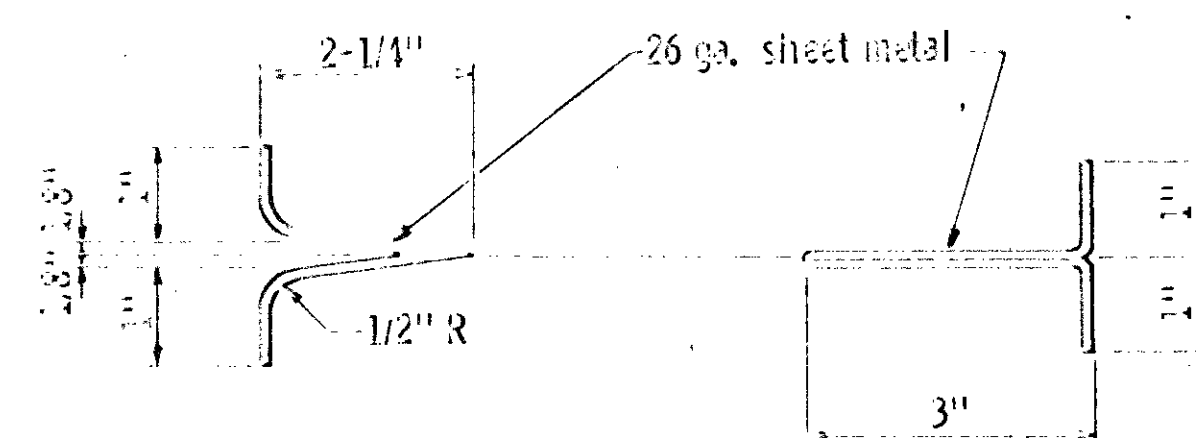


BRIDGE SEAT and FRONT STRIP
6" wide


BACK STRIP
8" wide

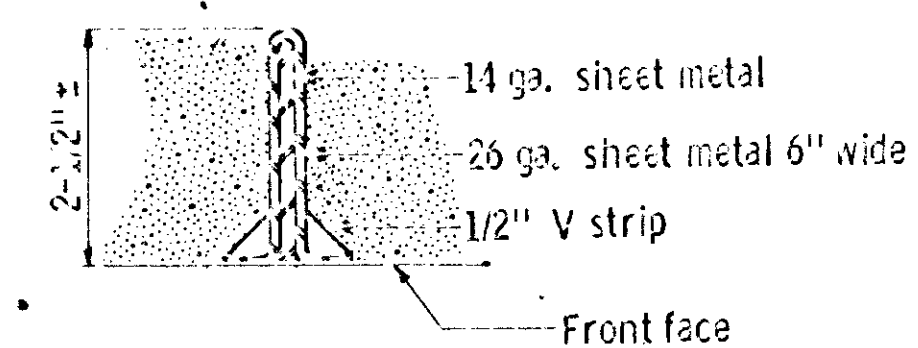


ALTERNATE BRIDGE SEAT and FRONT STRIP

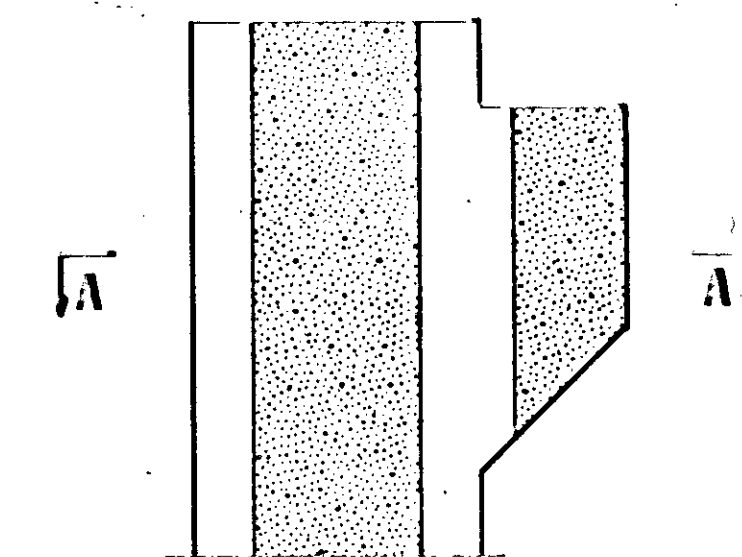

SECTION THRU PAVING BRACKET

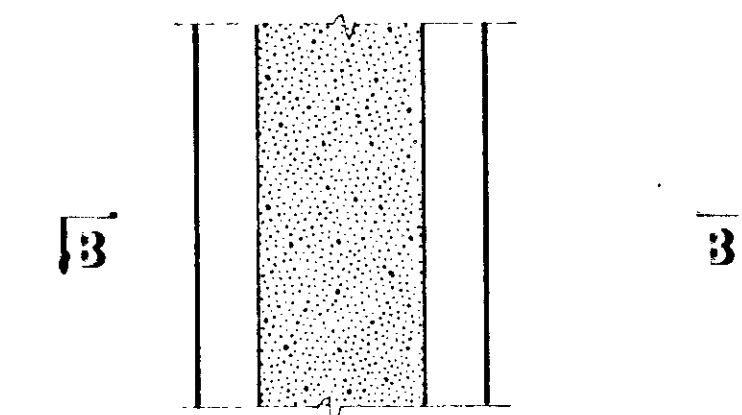

SECTION THRU WALL

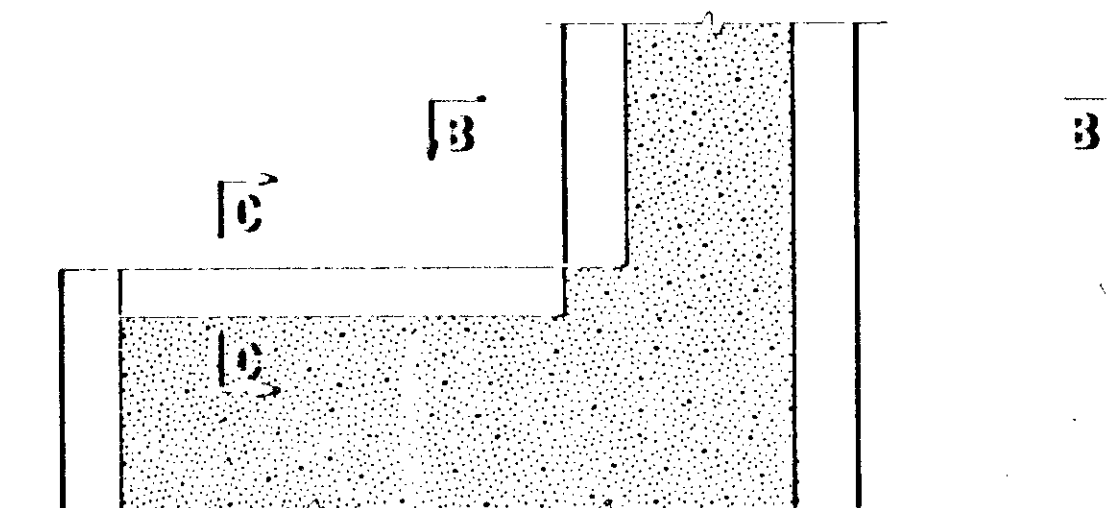

SECTION THRU BRIDGE SEAT

PART SECTION THRU ABUTMENT AT JOINT

NOTES:

The methods and materials indicated hereon shall be considered as suggested only. Variations will be permitted, subject to approval by the Engineer, but must provide dummy joints of a depth not less than the depth shown, and a width at the front face of the abutment of not greater than 5/16". The separation of the horizontal reinforcement bars shall be not less than 1-1/2" nor more than 3", centered as shown, regardless of the procedure used for forming the dummy joint.

Front and bridge seat strips shall be removed with forms, except if a suitable plastic or other durable material, satisfactory to the Engineer, is used, the material may be left in place. Back strip to remain in place.

Strips to be removed shall be oiled or greased as necessary to permit removal without spalling the concrete.

Metal strips to be galvanized sheet metal. Fasten to forms with 7/8" roofing nails about 6" centers.

All metal in front face to be oiled for easy removal.

Cost of forming joint to be included in price bid for other items.

APPROVED July 1, 1969
Design Standards Engineer
ENGINEERING STANDARDS DIVISION

STATE OF MINNESOTA
DEPARTMENT OF HIGHWAYS
**PROTECTION ANGLE
FOR END OF SLAB**

REVISION
DETAIL NO.

3551

APPROVED July 1, 1969
Design Standards Engineer
ENGINEERING STANDARDS DIVISION

STATE OF MINNESOTA
DEPARTMENT OF HIGHWAYS
CONTRACTION JOINT

REVISION
DETAIL NO.




3301

AS BUILT
10-16-73
B. John

TITLE:
DETAILS



DES: M.H.D.
CHK: R.M.S.
APPROVED: 12-31-77
Sheet No. 32 of 35 Sheets

DR: M.H.D.
CHK: R.M.S.
Bridge No.
02522

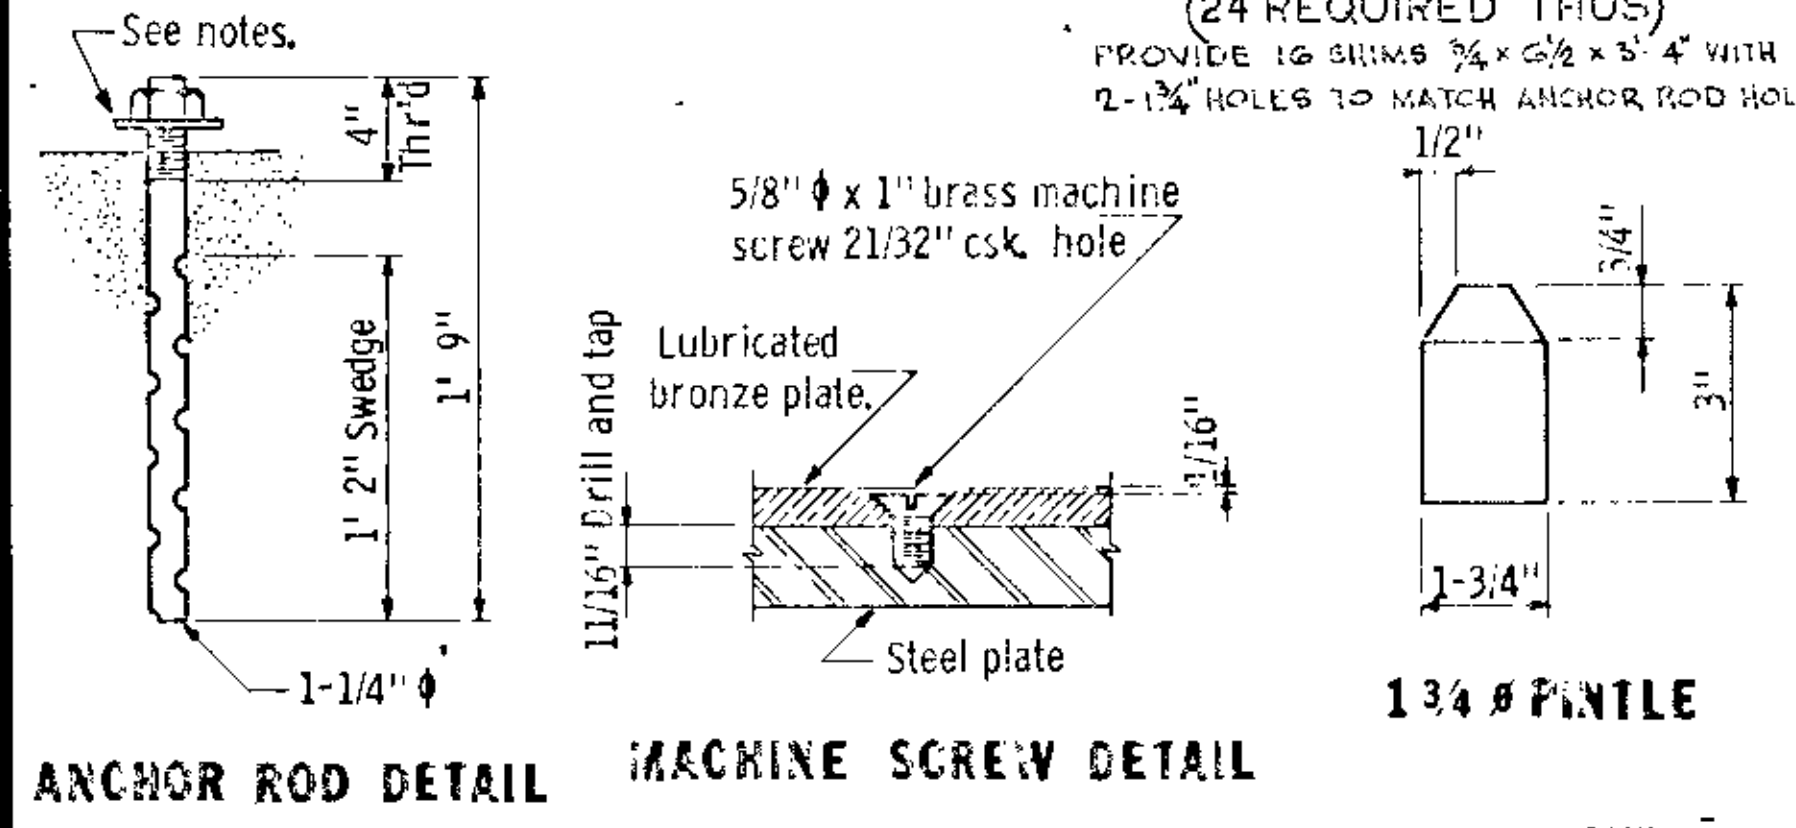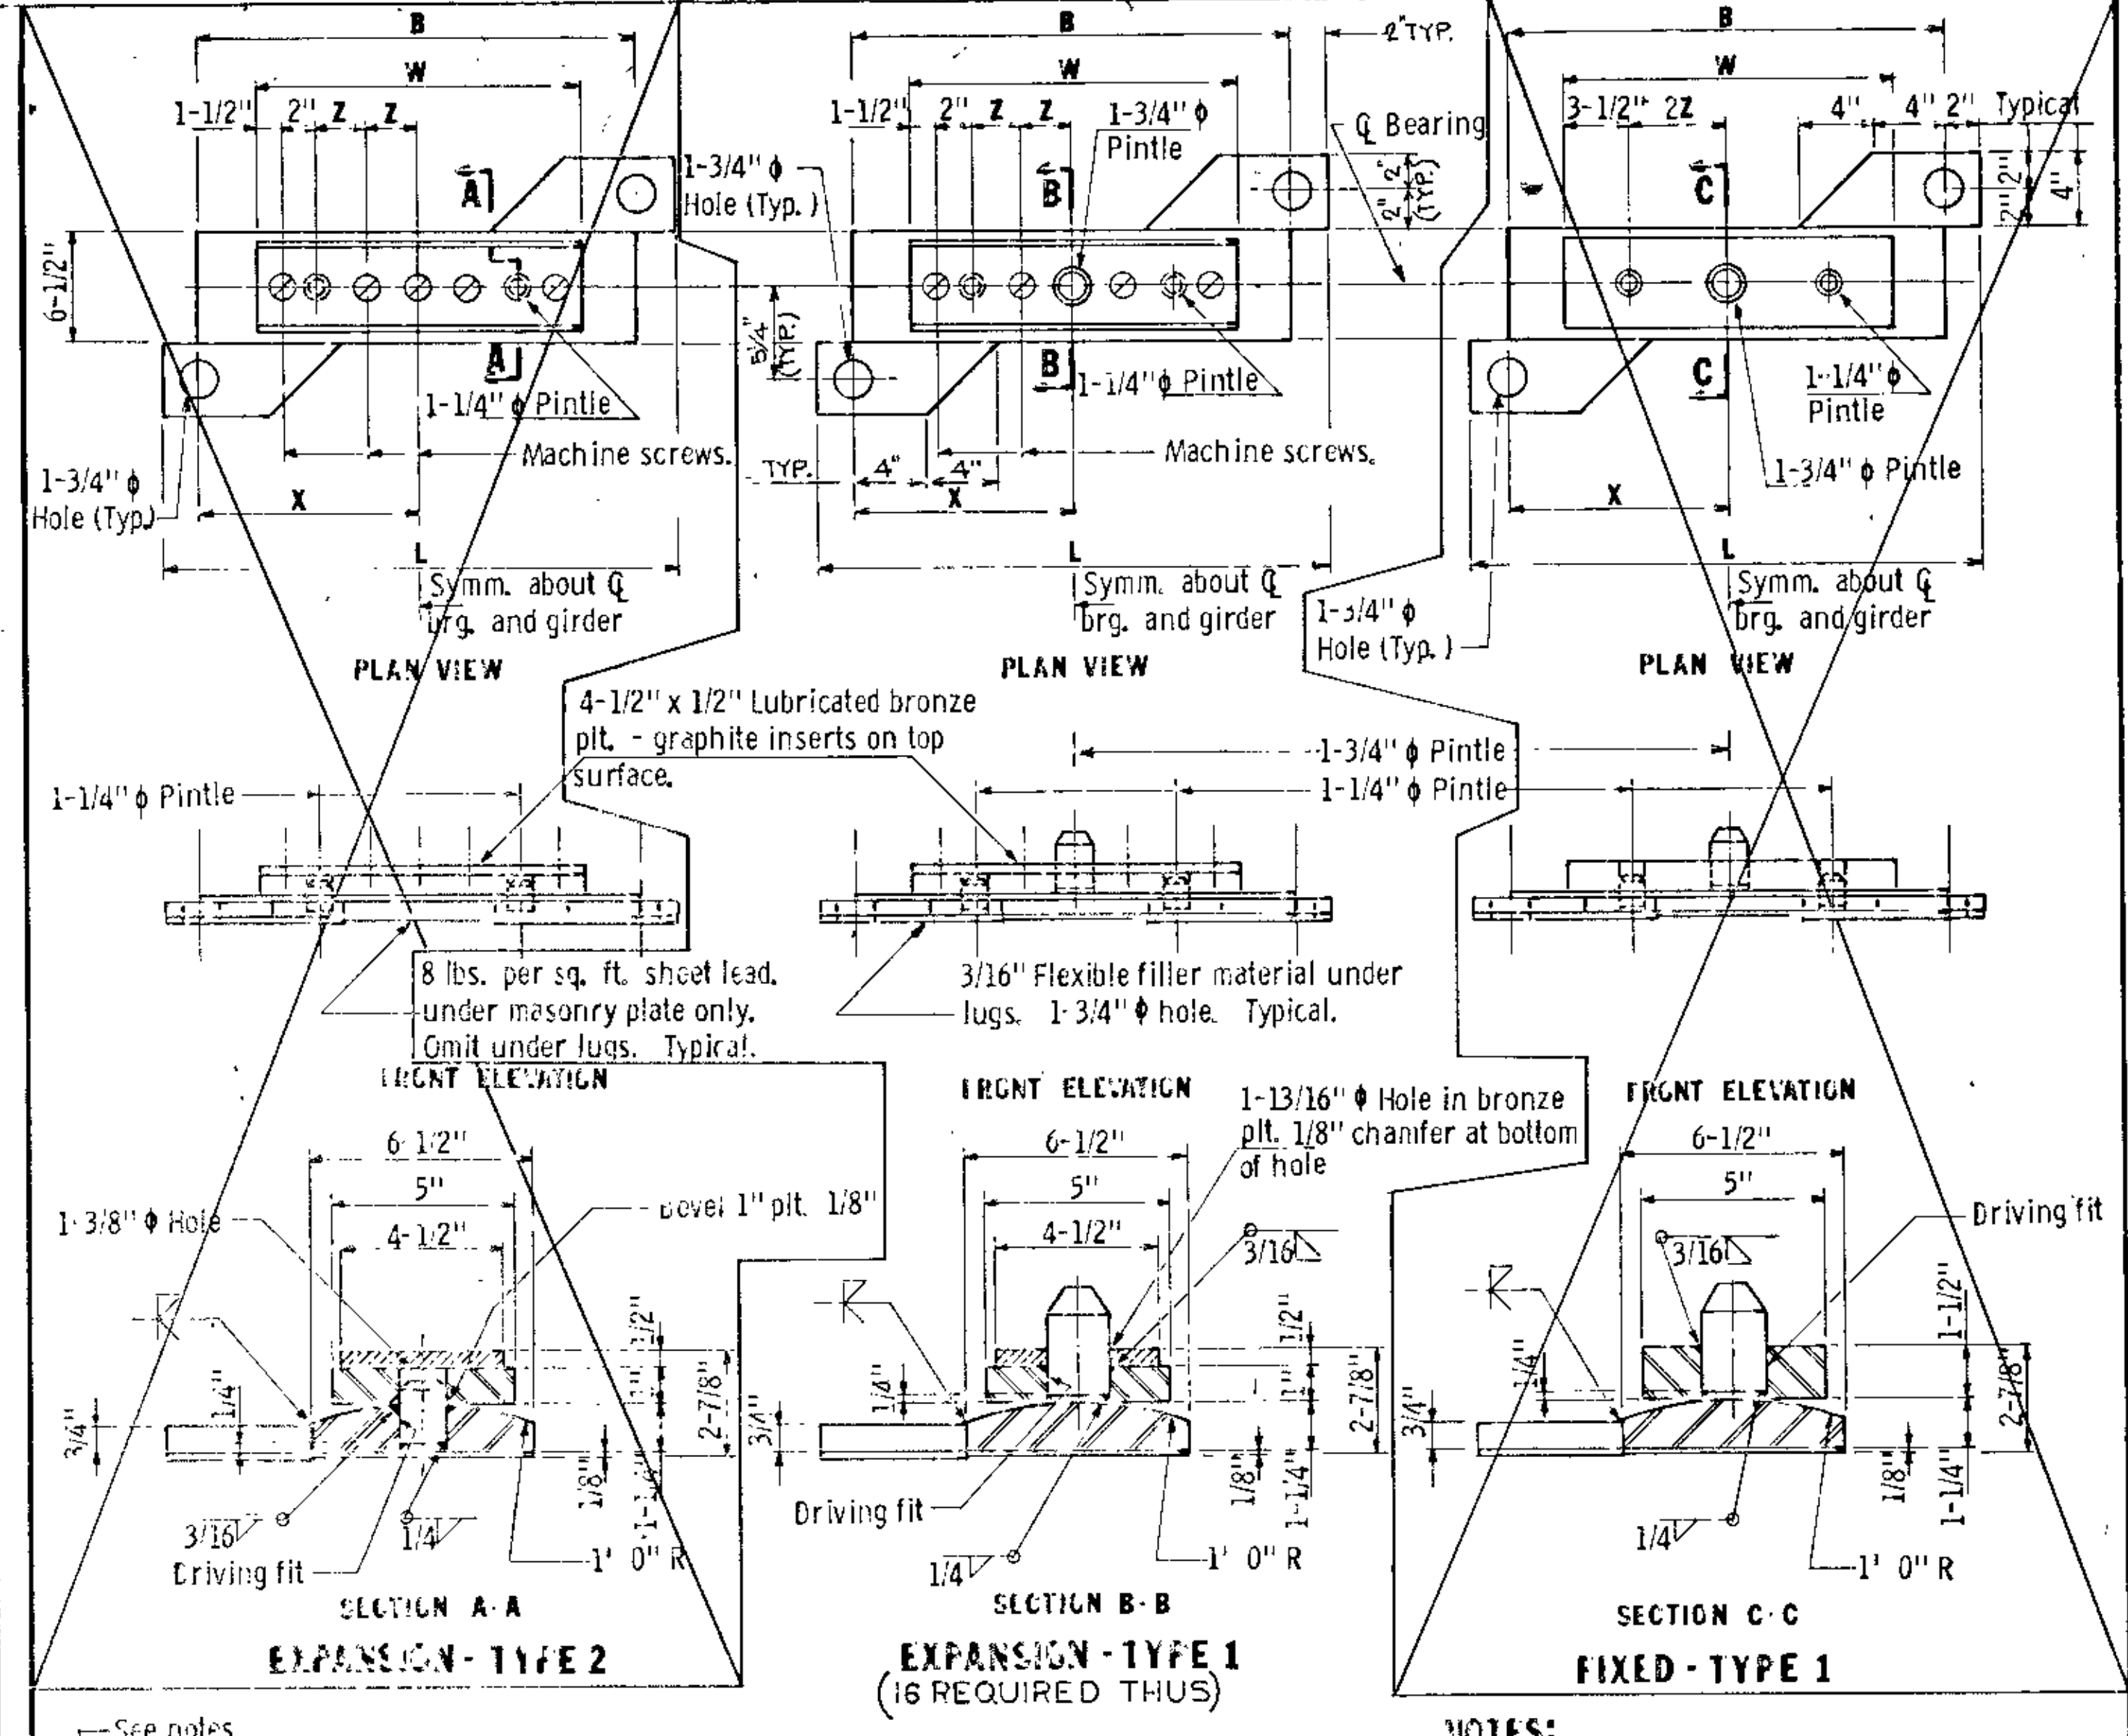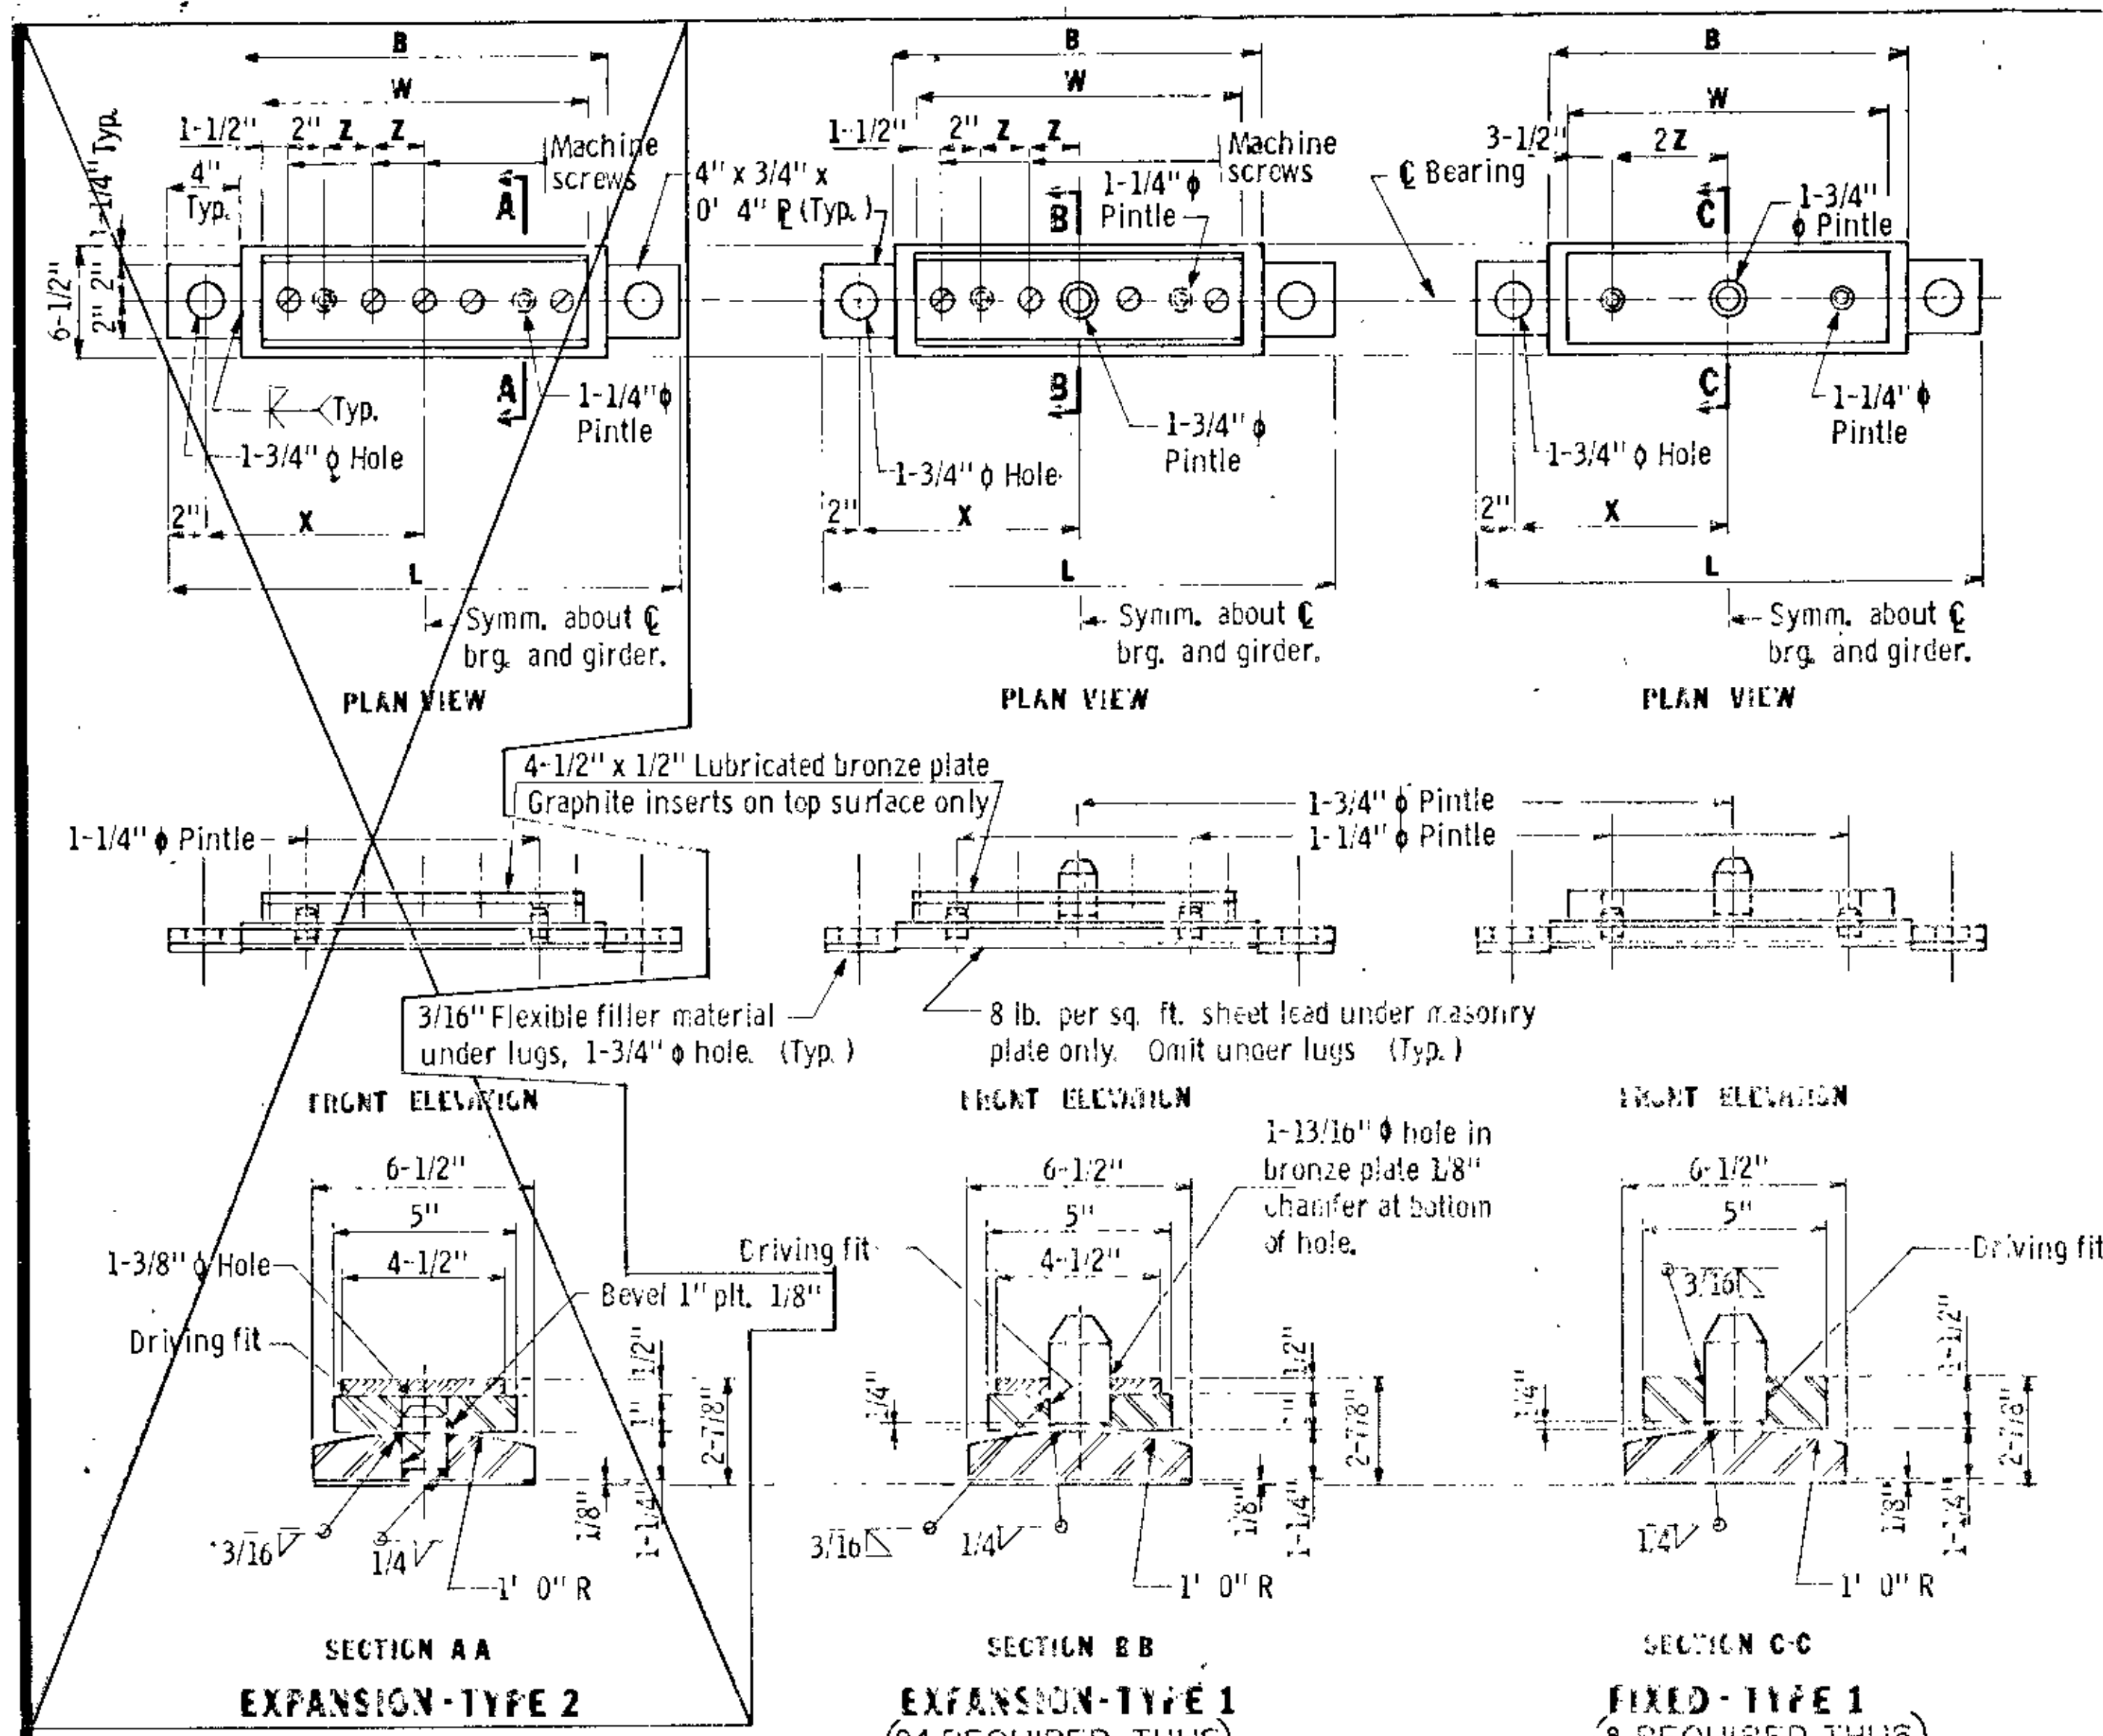


NOTES:
Lubricated bronze plates shall comply with M. H. D. 3329.
All plates except lubricated bronze shall comply with M. H. D. 3336.
Pintles shall comply with M. H. D. 3314, Type II.
Steel plates and pintles shall be galvanized per M. H. D. 3394. No paint. SHIMS SHALL ALSO BE GALVANIZED.
Anchor rods shall be galvanized per M. H. D. 3392. No paint, with one cut washer and nut. Anchor rods shall project 3/8" above nuts.



GIRDER TYPE	L	B	W	X	Z	LOAD (KIPS)	TOTAL MAX. DESIGN MOVEMENT
28"	2' 4"	1' 8"	1' 4"	1' 0"	2-1/4"	125	2-1/2"
36"	2' 6"	1' 10"	1' 6"	1' 1"	2-3/4"	140	2-1/2"
40" & 45"	2' 10"	2' 2"	1' 10"	1' 3"	3-3/4"	165	2-1/2"
54" & 60"	3' 4"	2' 8"	2' 2"	1' 6"	4-3/4"	205	2-1/2"

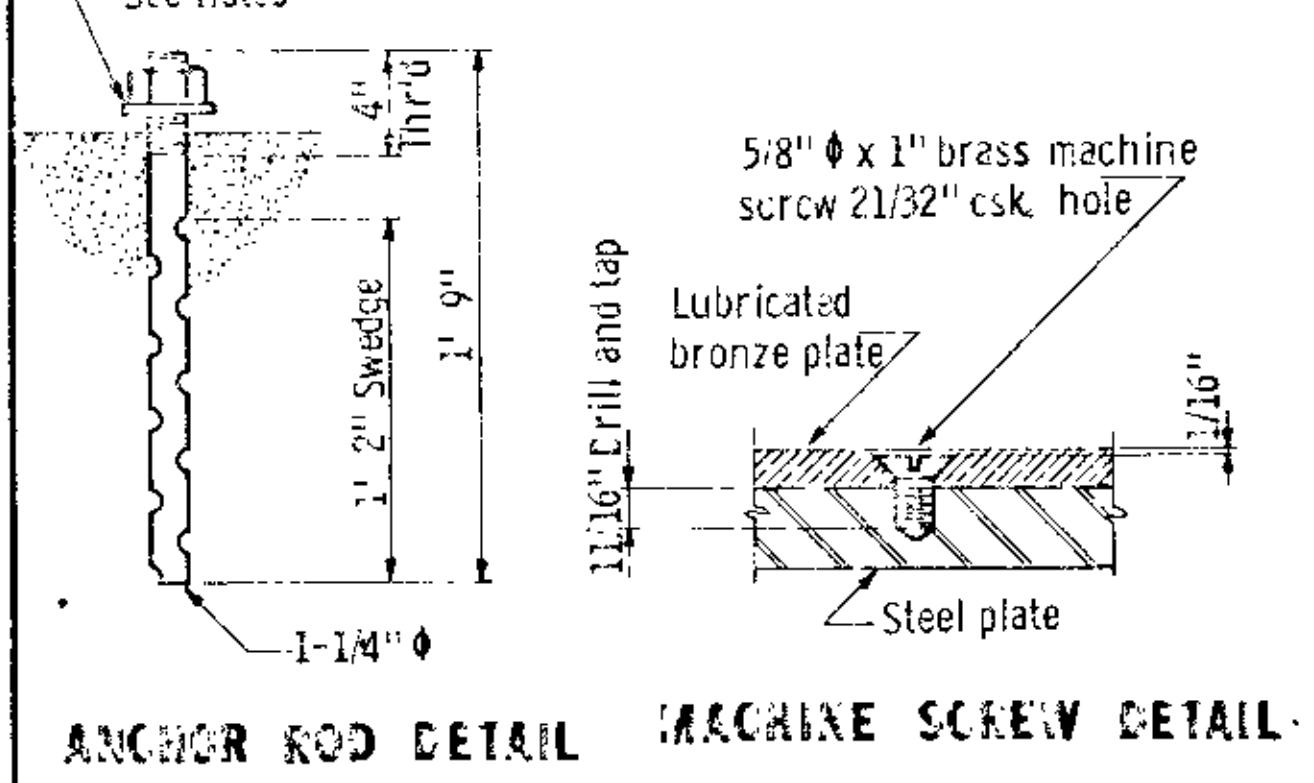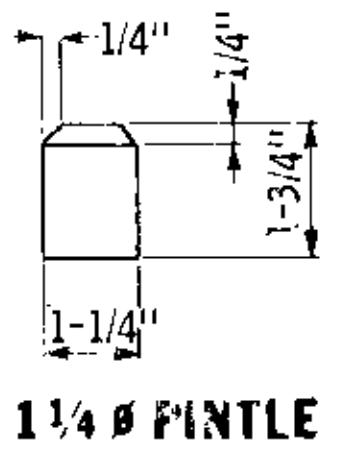

GIRDER TYPE	L	B	W	X	Z	LOAD (KIPS)	TOTAL MAX. DESIGN MOVEMENT
28"	2' 0"	1' 8"	1' 4"	1' 0"	2-1/4"	125	2-1/2"
36"	2' 2"	1' 10"	1' 6"	1' 1"	2-3/4"	140	2-1/2"
40" & 45"	2' 6"	2' 2"	1' 10"	1' 1"	3-3/4"	165	2-1/2"
54" & 60"	3' 0"	2' 8"	2' 2"	1' 4"	4-3/4"	205	2-1/2"


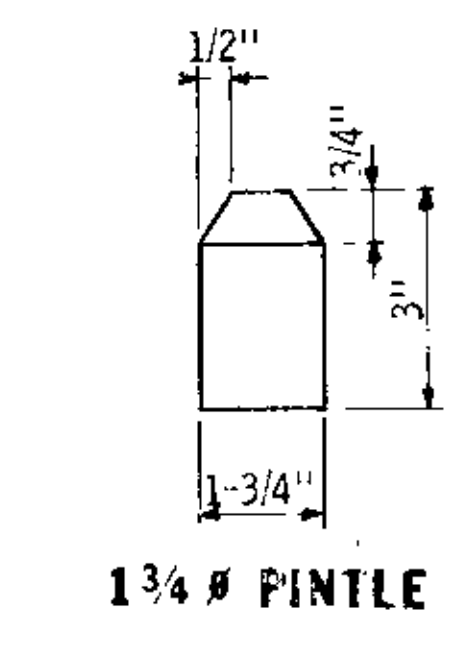


NOTES:
Lubricated bronze plates shall comply with M. H. D. 3329.
All plates except lubricated bronze shall comply with M. H. D. 3336.
Pintles shall comply with M. H. D. 3314, Type II.
Steel plates and pintles shall be galvanized per M. H. D. 3394. No paint.
Anchor rods shall be galvanized per M. H. D. 3392. No paint, with one cut washer and nut. Anchor rods shall project 3/8" above nuts.
Position of anchor rod lugs shown is for left skewers; for right skewers, lugs are to be reversed.
Finish center 3" on top of base plate to 250 Micro. A 1/16" tolerance in thickness will be permitted.
Scale weights shall be furnished in accordance with the requirements of M. H. D. 2471.3M1 and shall be listed on the shipping statements for the individual items.
Payment for bearing assembly shall include all material on this detail.

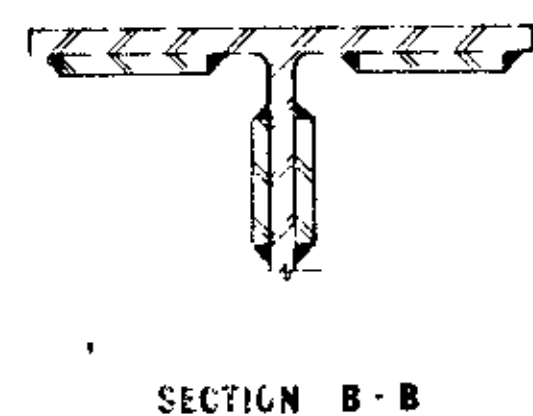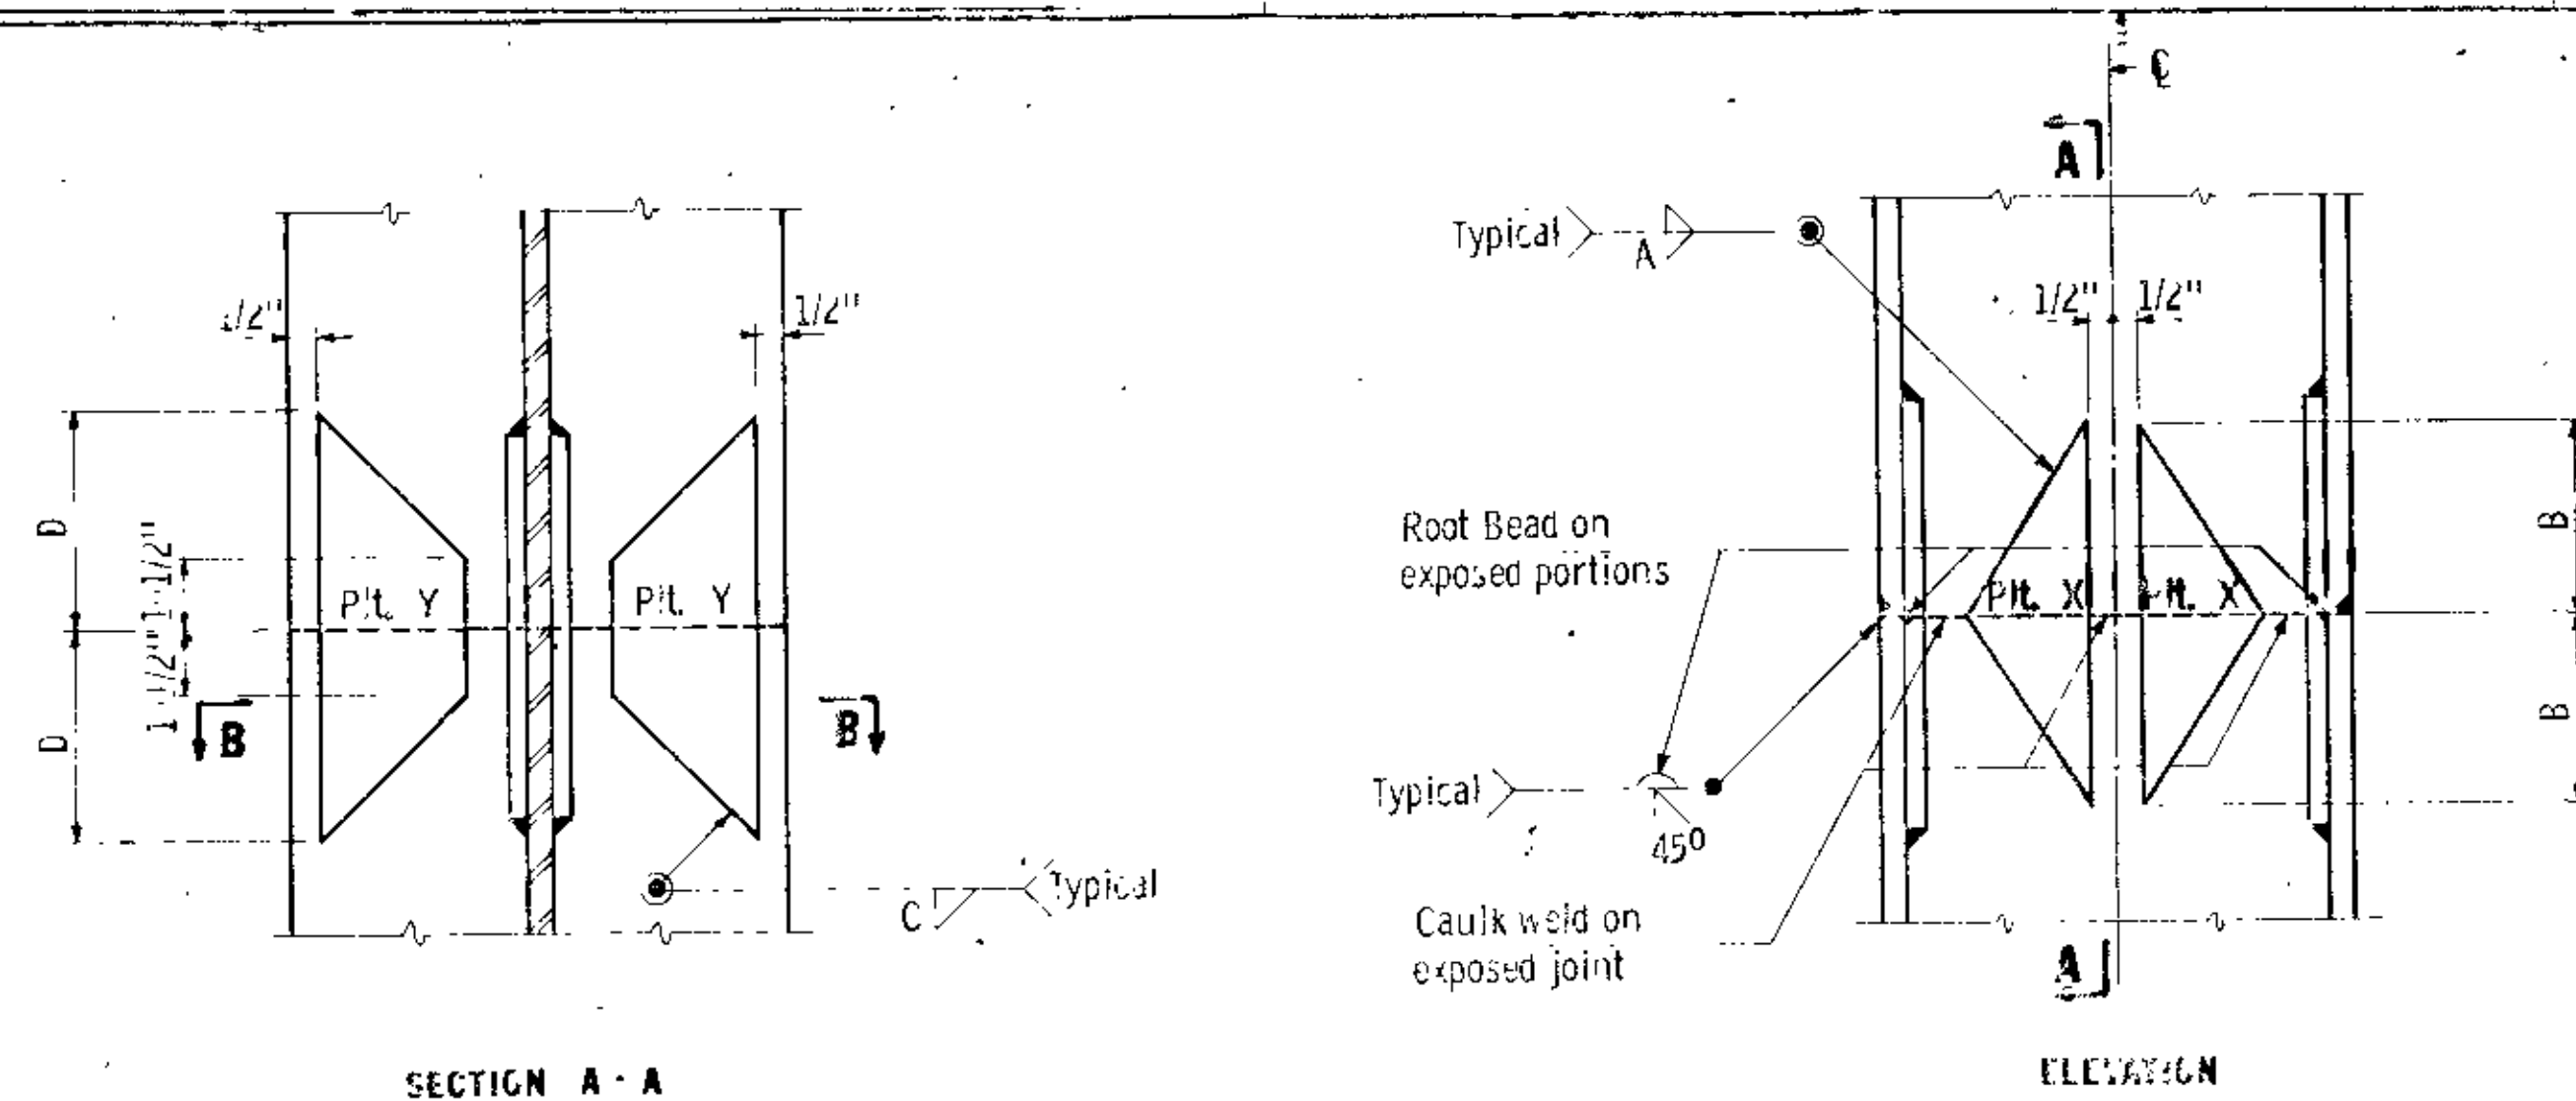


PILE SECTION	PLATE X		PLATE Y			
	Size	A	B	Size	C	D
10 BP 42	2 1/2 x 3/8	1 1/4	4	3 x 3/8	5/16	4
10 BP 57	2 1/2 x 1/2	5/16	4	3 x 1/2	5/16	5
12 BP 53	3 1/2 x 3/8	1 1/4	5	4 x 3/8	5/16	5
12 BP 74	3 1/2 x 1/2	5/16	6	4 x 1/2	5/16	6
14 BP 73	4 1/2 x 3/8	1 1/4	7	5 x 3/8	5/16	6
14 BP 89	4 1/2 x 7/16	5/16	7	5 x 1/2	5/16	7
14 BP 102	4 1/2 x 1/2	5/16	7	5 x 1/2	3/8	7
14 BP 117	4 1/2 x 9/16	3/8	7	5 x 3/8	3/8	8

PILE SPLICE

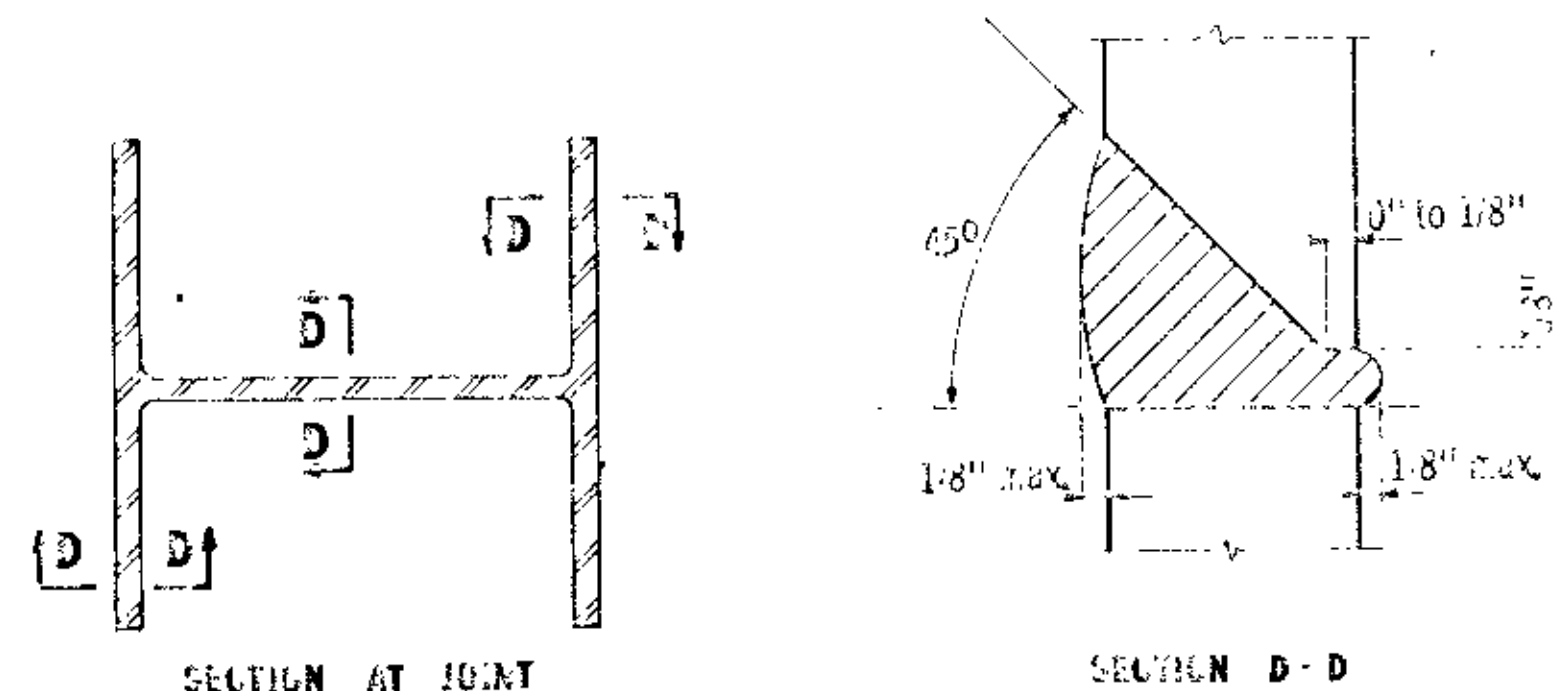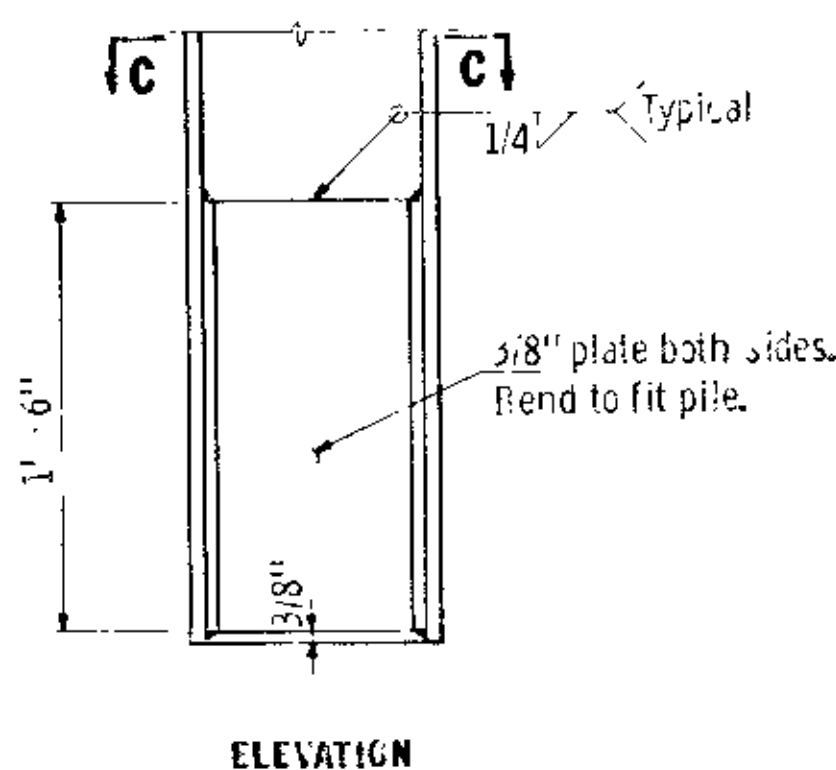

ALTERNATE 100% BUT WELDED PILE SPLICE

NOTES: Pile ends at splice to be square. Welding electrodes per M. H. D. 3339. With D.C. reverse polarity (electrode positive) only use A. S. T. M. classification E6010. With E.C. reverse polarity or AC use A. S. T. M. classification E6011. Where moisture control is properly enforced A. S. T. M. classification E6016 or E7016 may be used. Recommended moisture content, per cent of coating:
 E6010 3.0 to 5.0 % D. C. R. only
 E6011 2.0 to 4.0 % AC or D. C. R.
 E6016 Less than 0.4 % AC or D. C. R.
 E7016 Less than 0.4 % AC or D. C. R.
 All welding per M. H. D. 2471.3J.
 Steel plates per M. H. D. 3306.

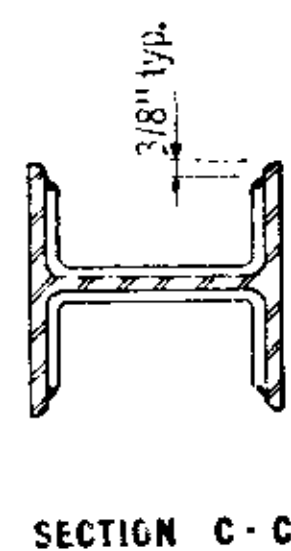


DETAIL OF PILE TIP REINFORCEMENT

APPROVED July 1, 1969
 Design Standards Engineer
 ENGINEERING STANDARDS DIVISION


STATE OF MINNESOTA
 DEPARTMENT OF HIGHWAYS
PILE SPLICE and TIP REINFORCEMENT
 STEEL H BEARING PILES 10" TO 14"

REVISION
 DETAIL NO.
B3202

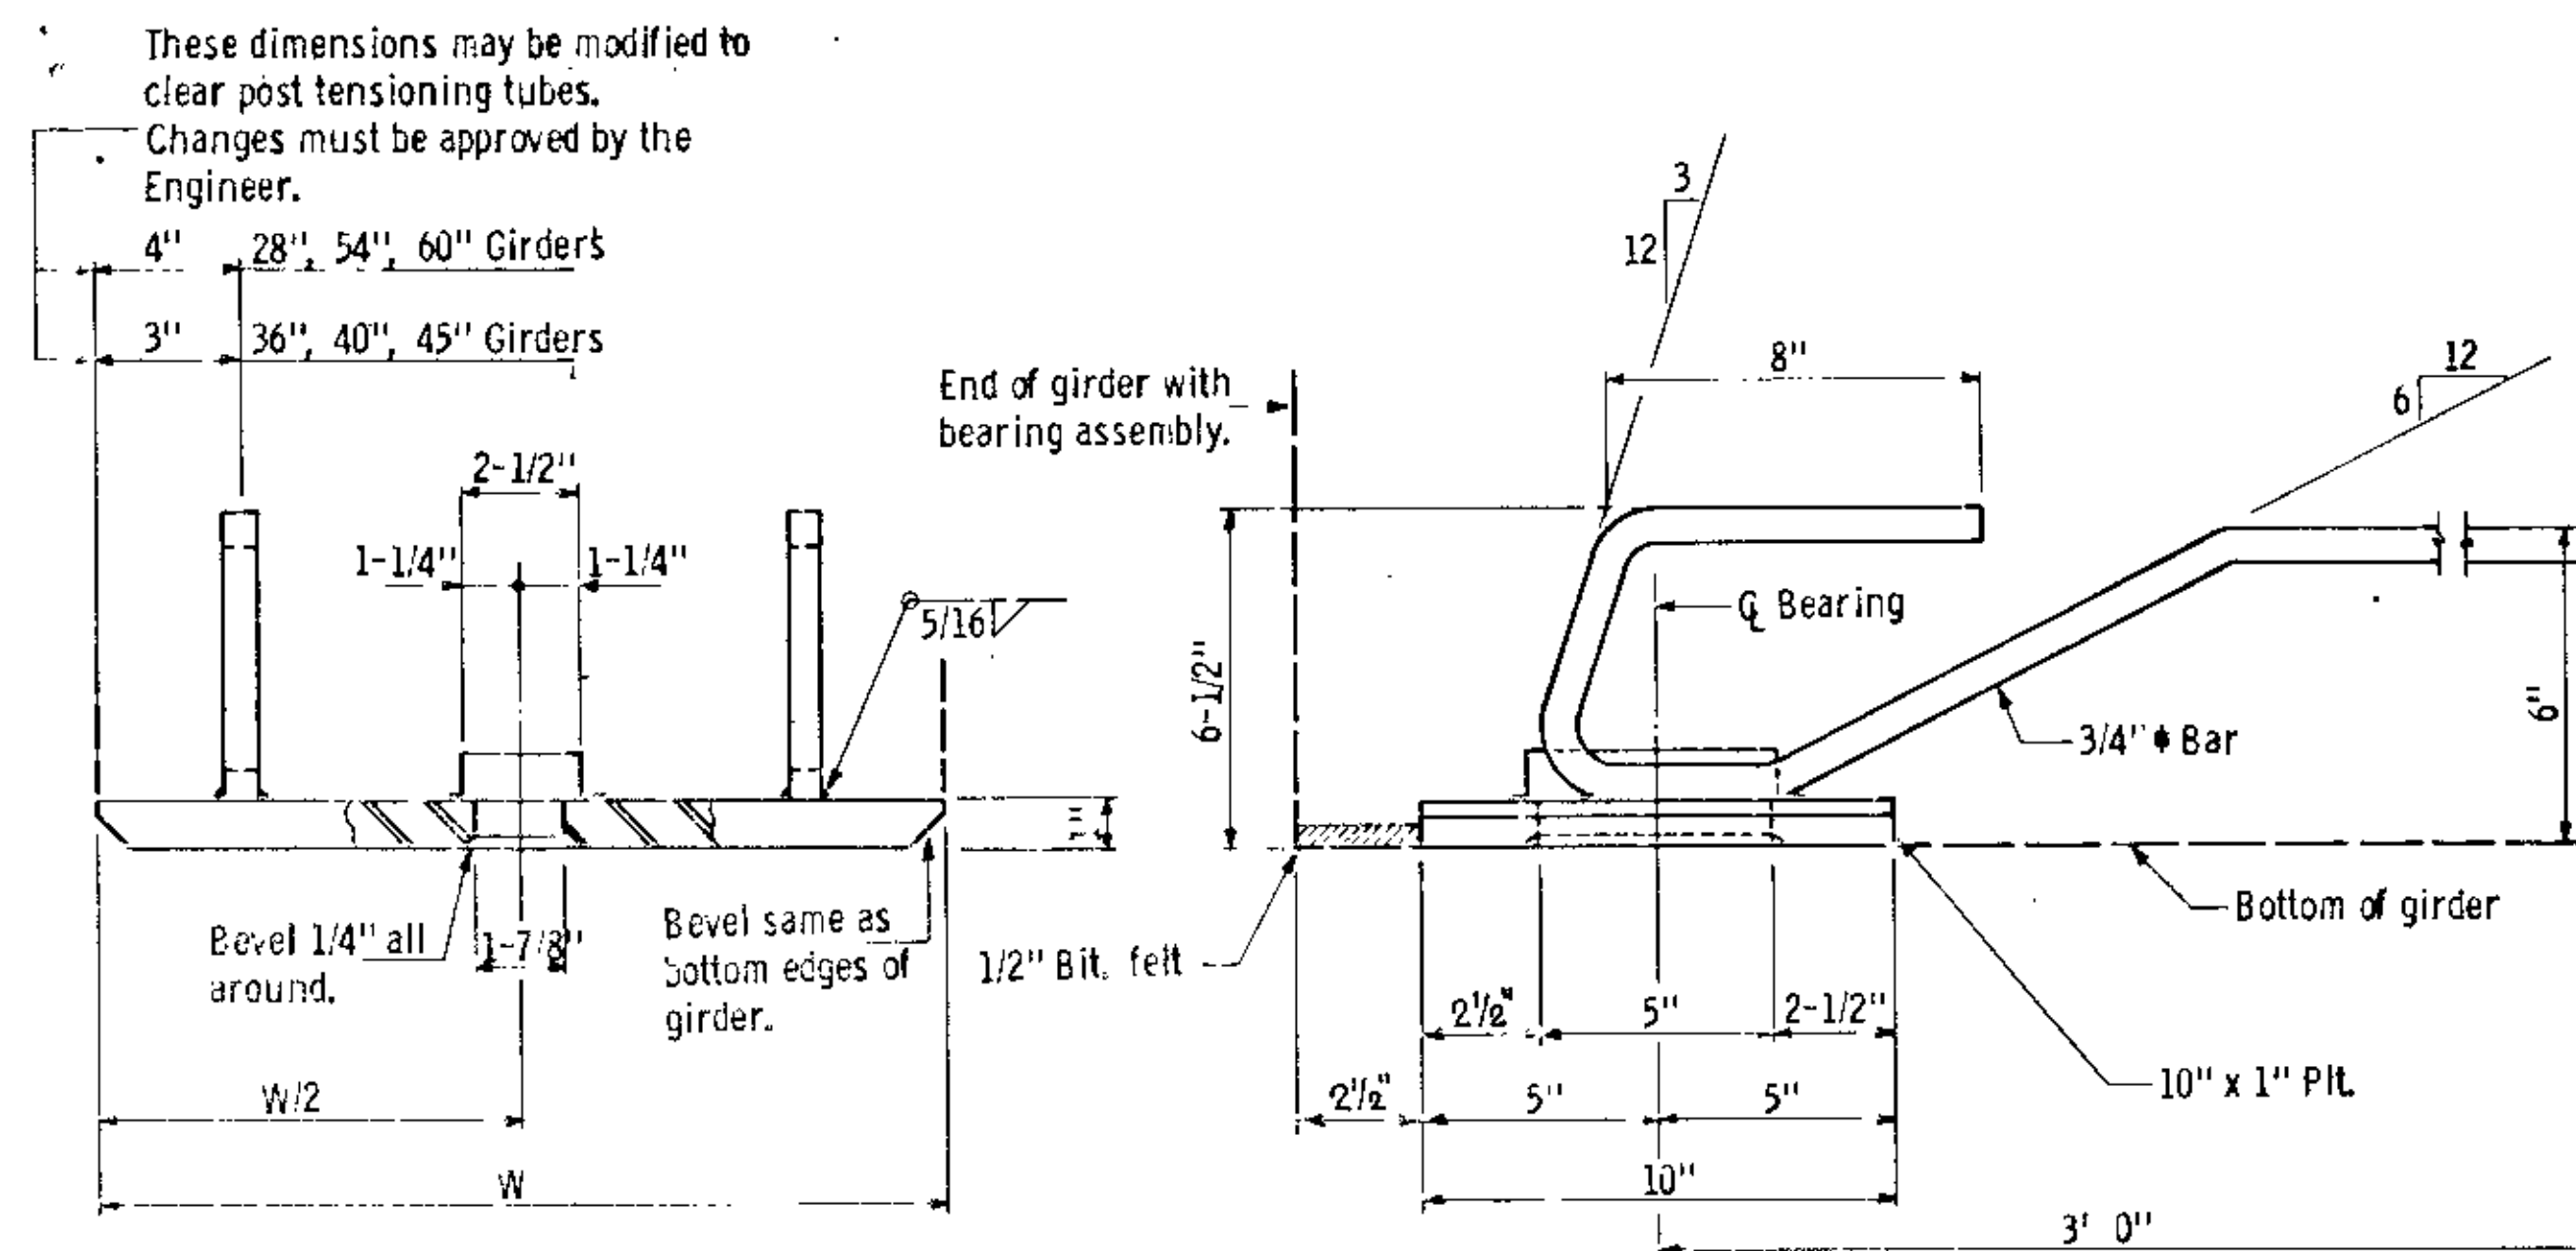

FRONT VIEW
 (Area at hole shown as a section).
 Dimension "W" to be the width at the bottom flange of the girder.

SIDE VIEW
 Showing placement in girder.

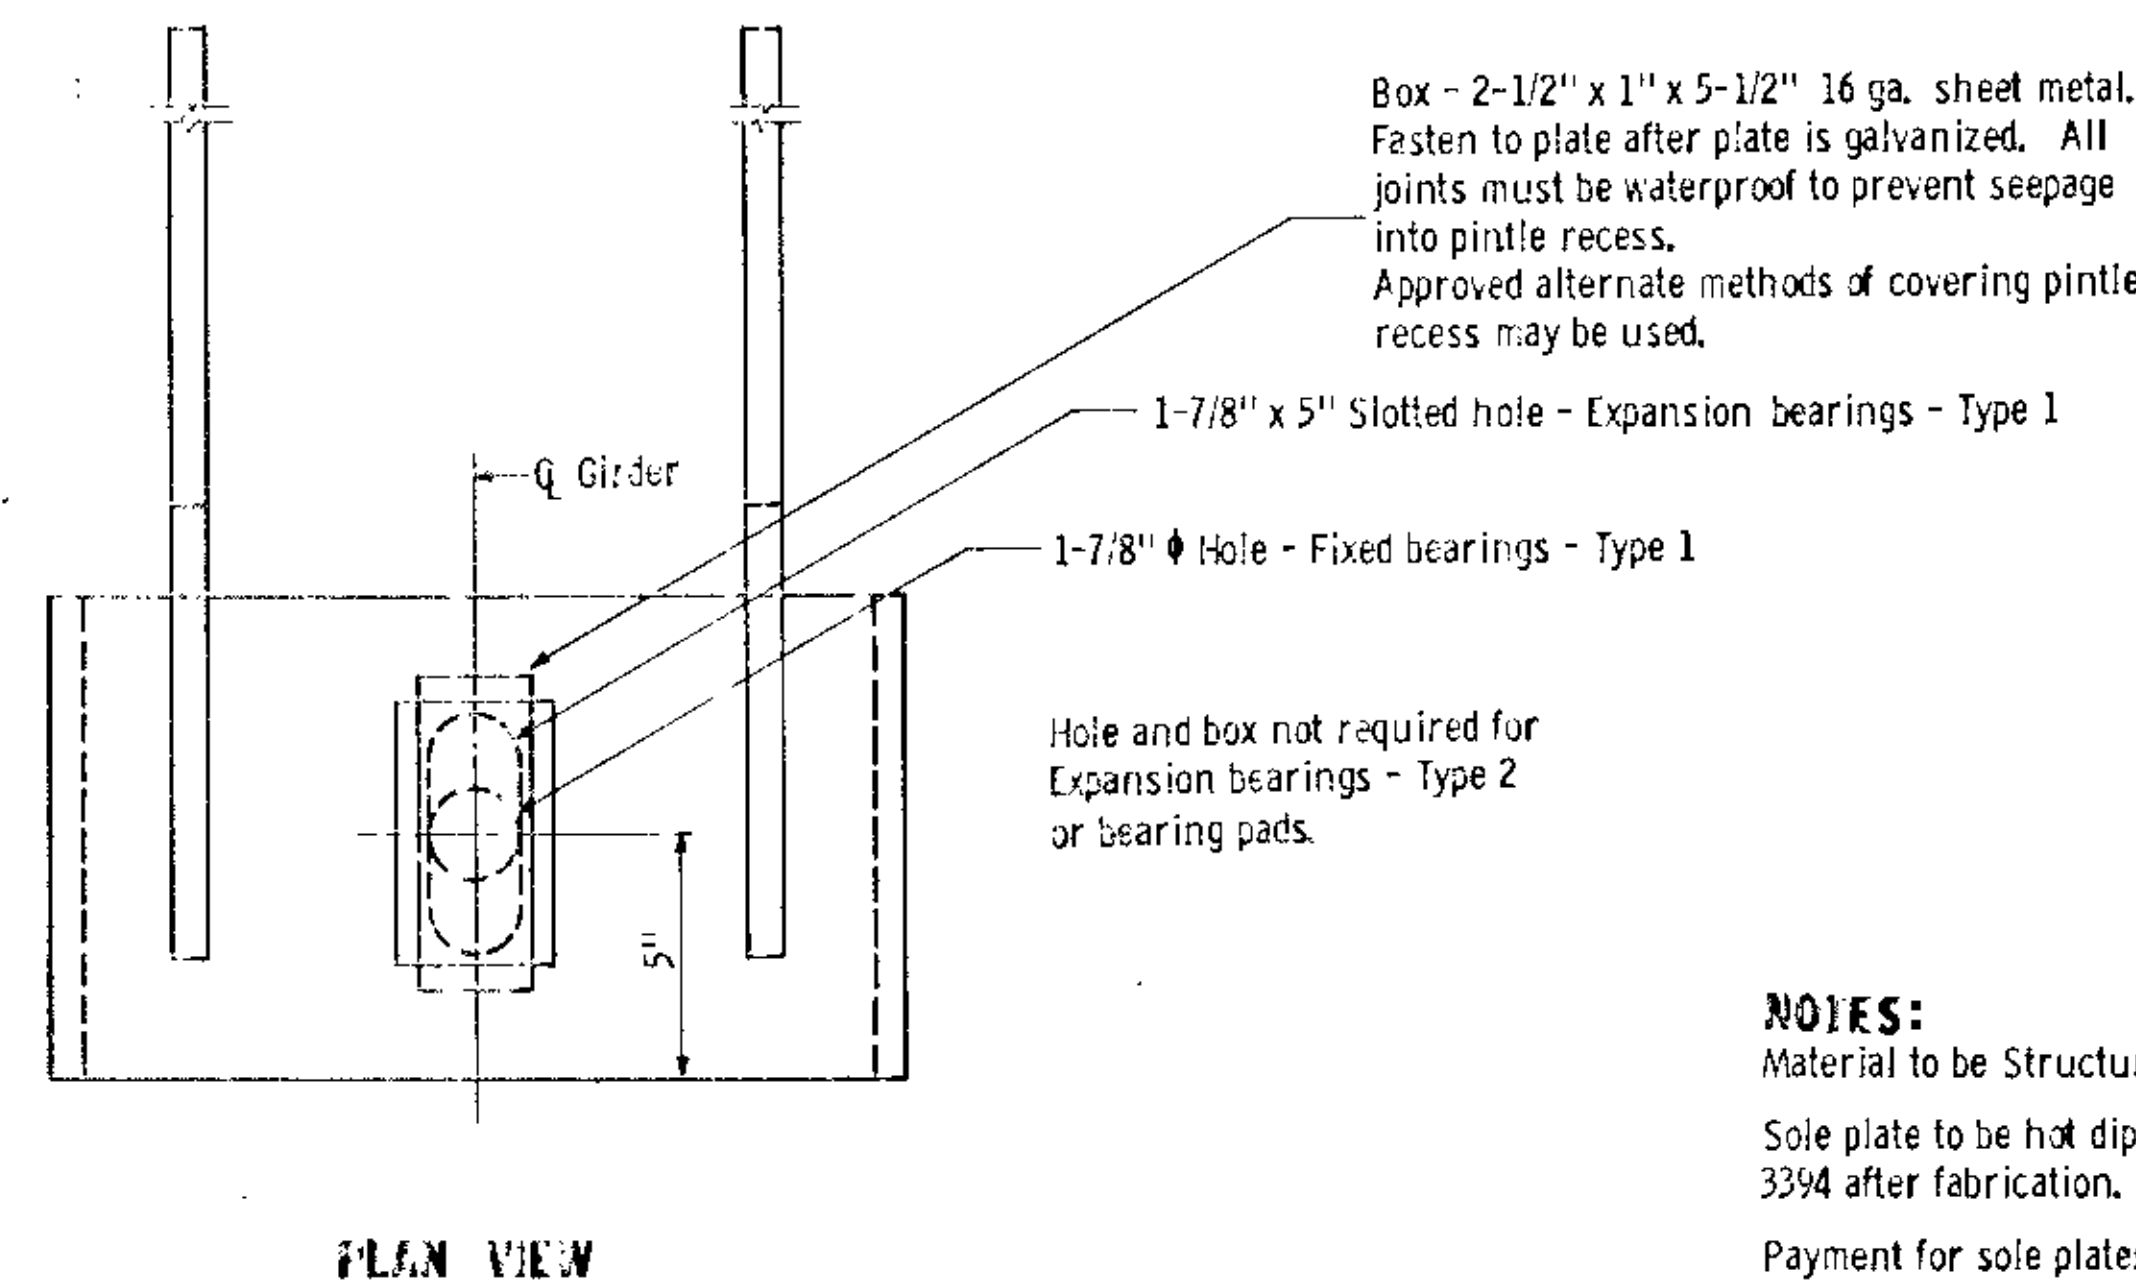

Box - 2-1/2" x 1" x 5-1/2" 16 ga. sheet metal. Fasten to plate after plate is galvanized. All joints must be waterproof to prevent seepage into pintle recess. Approved alternate methods of covering pintle recess may be used.

NOTES:
 Material to be Structural Steel per M. H. D. 3306.
 Sole plate to be hot dipped galvanized as per M. H. D. 3394 after fabrication.
 Payment for sole plates to be included in price bid for Prestressed Concrete Girders.

APPROVED Feb. 9, 1970
 Research and Standards Division

STATE OF MINNESOTA
 DEPARTMENT OF HIGHWAYS
SOLE PLATE
 PRESTRESSED CONCRETE GIRDERS

REVISION
 DETAIL NO.
B303

AS B0167
 10-16-73
 B. Ja. R.


TITLE:
DETAILS

DES: M. H. D. DR: M. H. D. APPROVED: 12-21-71
 CHK: R. J. M. CHK: R. J. M.
Sheet No. 30 of 35 Sheets

Bridge No.
02522

CONSTRUCTION NOTES


- The slope paving shall be constructed of cast-in-place concrete, in accordance with the applicable sections of MHD 2401, and the following:
- The concrete shall be Mix 3A34. The concrete slump may be adjusted, subject to approval of the Engineer, as may be necessary to obtain the desired results.
 - Metal reinforcement shall conform to ASTM A615 grade 60. Lap 36 diameters at splices.
 - The slopes shall conform to the section shown on the General Plan and Elevation sheet in these Plans, except as otherwise provided for below: In the event the Engineer determines that a deficiency in material exists on the approach embankments constructed by others, he may order that the dimensions shown for the berm (see upper left of Section A-A) be revised to the extent necessary to construct the slope without hauling additional material. Such revision should, however, be limited to a decrease of not more than three inches, as applied to the height and/or width of the berm. In the event additional fill is required in order to conform to the slope lines staked by the Engineer, on approach embankments completed by others, the cost of furnishing, hauling, placing and compacting additional material ordered by the Engineer will be paid for as Extra Work. In the event the Engineer determines that an excess of material is present on approach embankments completed by others, he may order that the width of the berm be increased to the extent necessary to utilize such material, but not by more than 1' - 6". Excess material, beyond that which is required to dress the slope to true lines and to the grades staked by the Engineer, shall be used as directed by the Engineer for purposes such as widening the shoulders adjacent to the sidewalks, flaring out these shoulders, and shaping up adjacent side slopes. The disposal of excess material, except material deposited by the Contractor during excavation for substructure units or related work, which can not be incorporated into the slopes as hereinbefore defined, and which the Engineer directs to be hauled from the site, will be paid for as Extra Work. Any revision in berm grades and dimensions should be applied uniformly for the full length of the berm. Compaction will be required.
 - Toe and side walls shall be in place before casting remainder of slope paving.
 - Slope paving shall, in general, be poured in equal alternate vertical strips with a maximum width of 6 ft. The strips shall be cut into sections by grooves spaced at equal distances not exceeding 6 ft, and shall be at right angles to the strips. Other patterns for strips and grooves will be considered if requested by the contractor. Subgrade shall be moist when concrete is placed.
 - The forms shall be set to accurate grade and alignment, and shall be rigidly supported. Deviations of greater than 1/4" from a ten-foot straight edge shall be corrected.
 - Care shall be taken in placement of concrete so as not to disturb the grade on which it is placed, or to contaminate the concrete.
 - Sufficient hand spading and/or tamping shall be done to secure a dense paving relatively free of voids and honeycomb.
 - The top surface shall be struck off immediately after placing the concrete. When the concrete has set sufficiently to hold its shape, it shall be struck off again, after which it shall be given a final finish by hand floating with a cork or wooden float. The finished appearance shall be reasonably smooth and uniform. The finished concrete shall not vary more than 3/8" from a ten-foot straight edge.
 - All edges shall be finished with an edger or 1/2" V strip. Grooves shall be cut using a sidewalk grooving tool. The trails left by the flanges of these tools shall be removed by floating.
 - The concrete shall be cured for at least 72 hours after casting by any of the methods outlined in MHD 2401.36, including membrane curing compound.
 - Reinforcement shall be supported on concrete bricks or mortar blocks, or other support satisfactory to the Engineer.
 - For correct position of abutment wings and piers, see bridge plans.
 - Where piers extend thru slope paving, provide 1/2" x 5" bit, felt around piers.
 - Slope paving will be measured by area of the top surface bounded by the outside edges of the toe wall and sidewalks and the front face of the abutment.
 - Payment for furnishing and placing the slope paving will be made as Item No. 401.601 at the Contract price per square yard, which price shall be compensation in full for all costs of furnishing all materials, equipment, tools, and labor necessary for the satisfactory completion of work, except as otherwise provided for in Item 3.
 - THE SLOPE OF THE SLOPE PAVING VARIES. USE "LAYOUTS FOR SLOPES 2:1 OR FLATTER," IN GENERAL FOR NORTHEAST, SOUTHWEST, AND SOUTHEAST CORNERS. USE "LAYOUTS FOR SLOPES STEEPER THAN 2:1," IN GENERAL FOR NORTHWEST CORNER. LIMITS OF SLOPE PAVING AS SHOWN ON SHEET 1 WILL GOVERN.

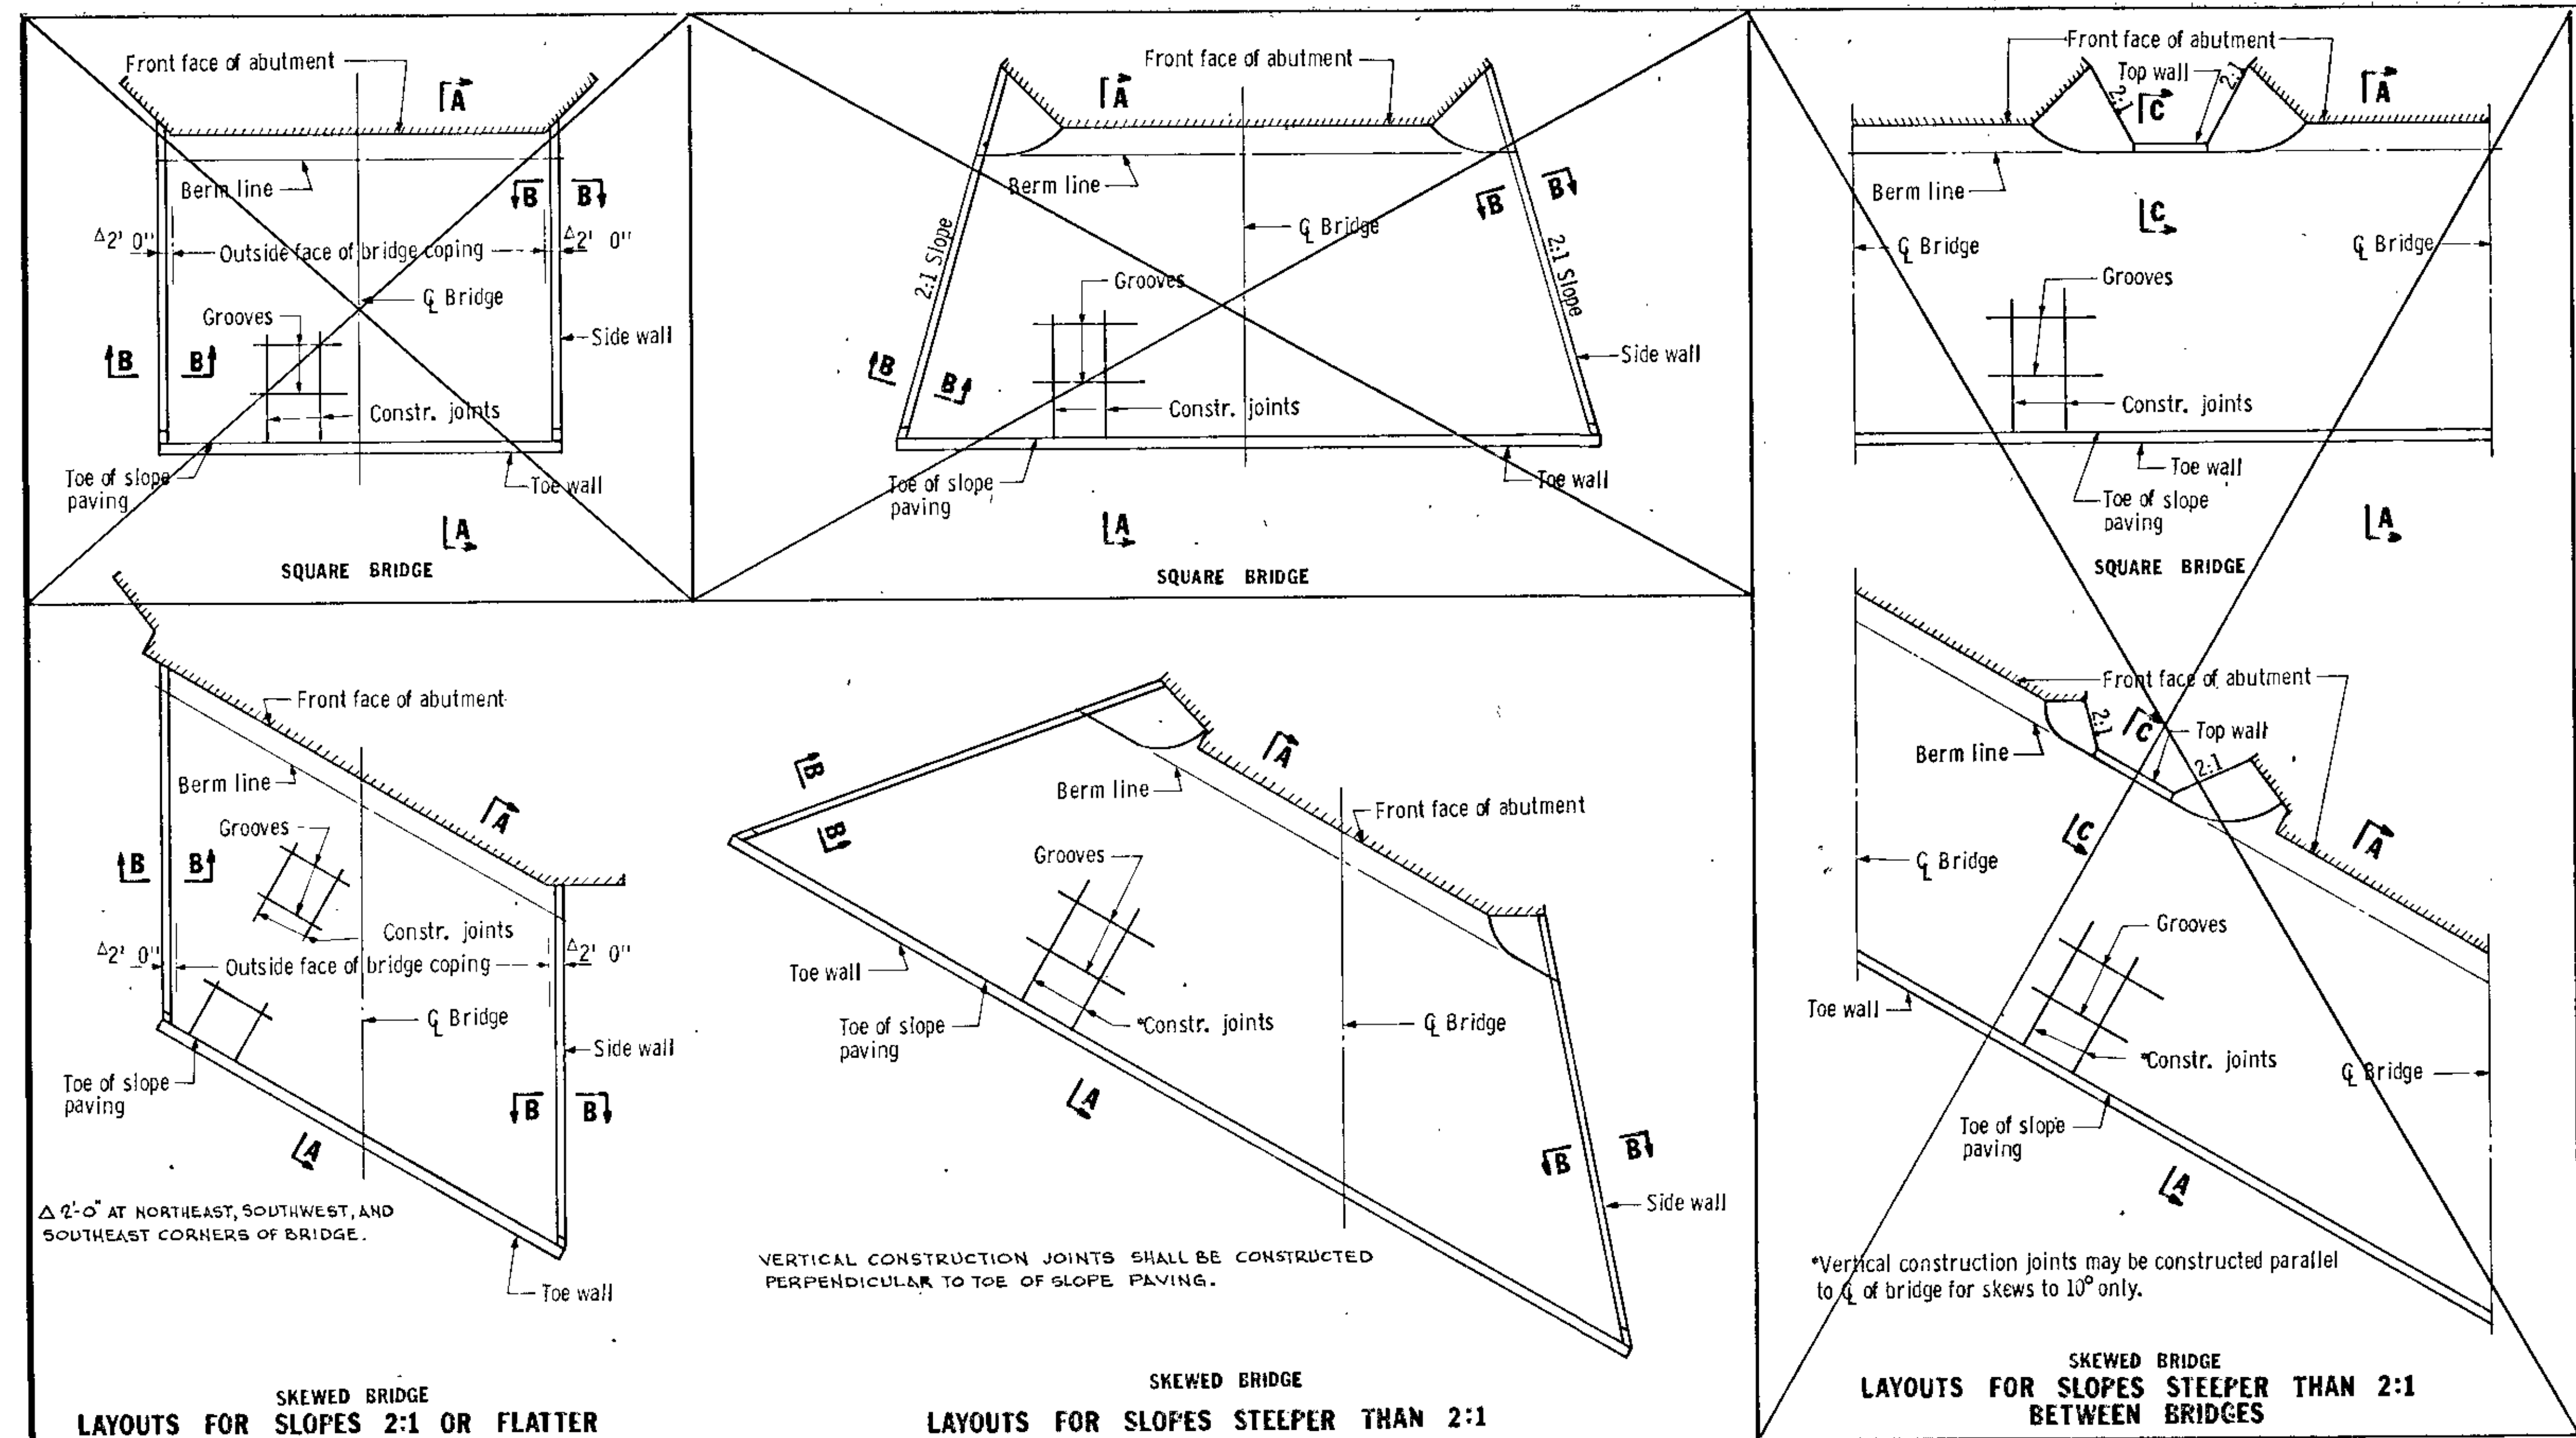

SKEWED BRIDGE LAYOUTS FOR SLOPES 2:1 OR FLATTER

SKEWED BRIDGE LAYOUTS FOR SLOPES STEEPER THAN 2:1

SKEWED BRIDGE LAYOUTS FOR SLOPES STEEPER THAN 2:1 BETWEEN BRIDGES

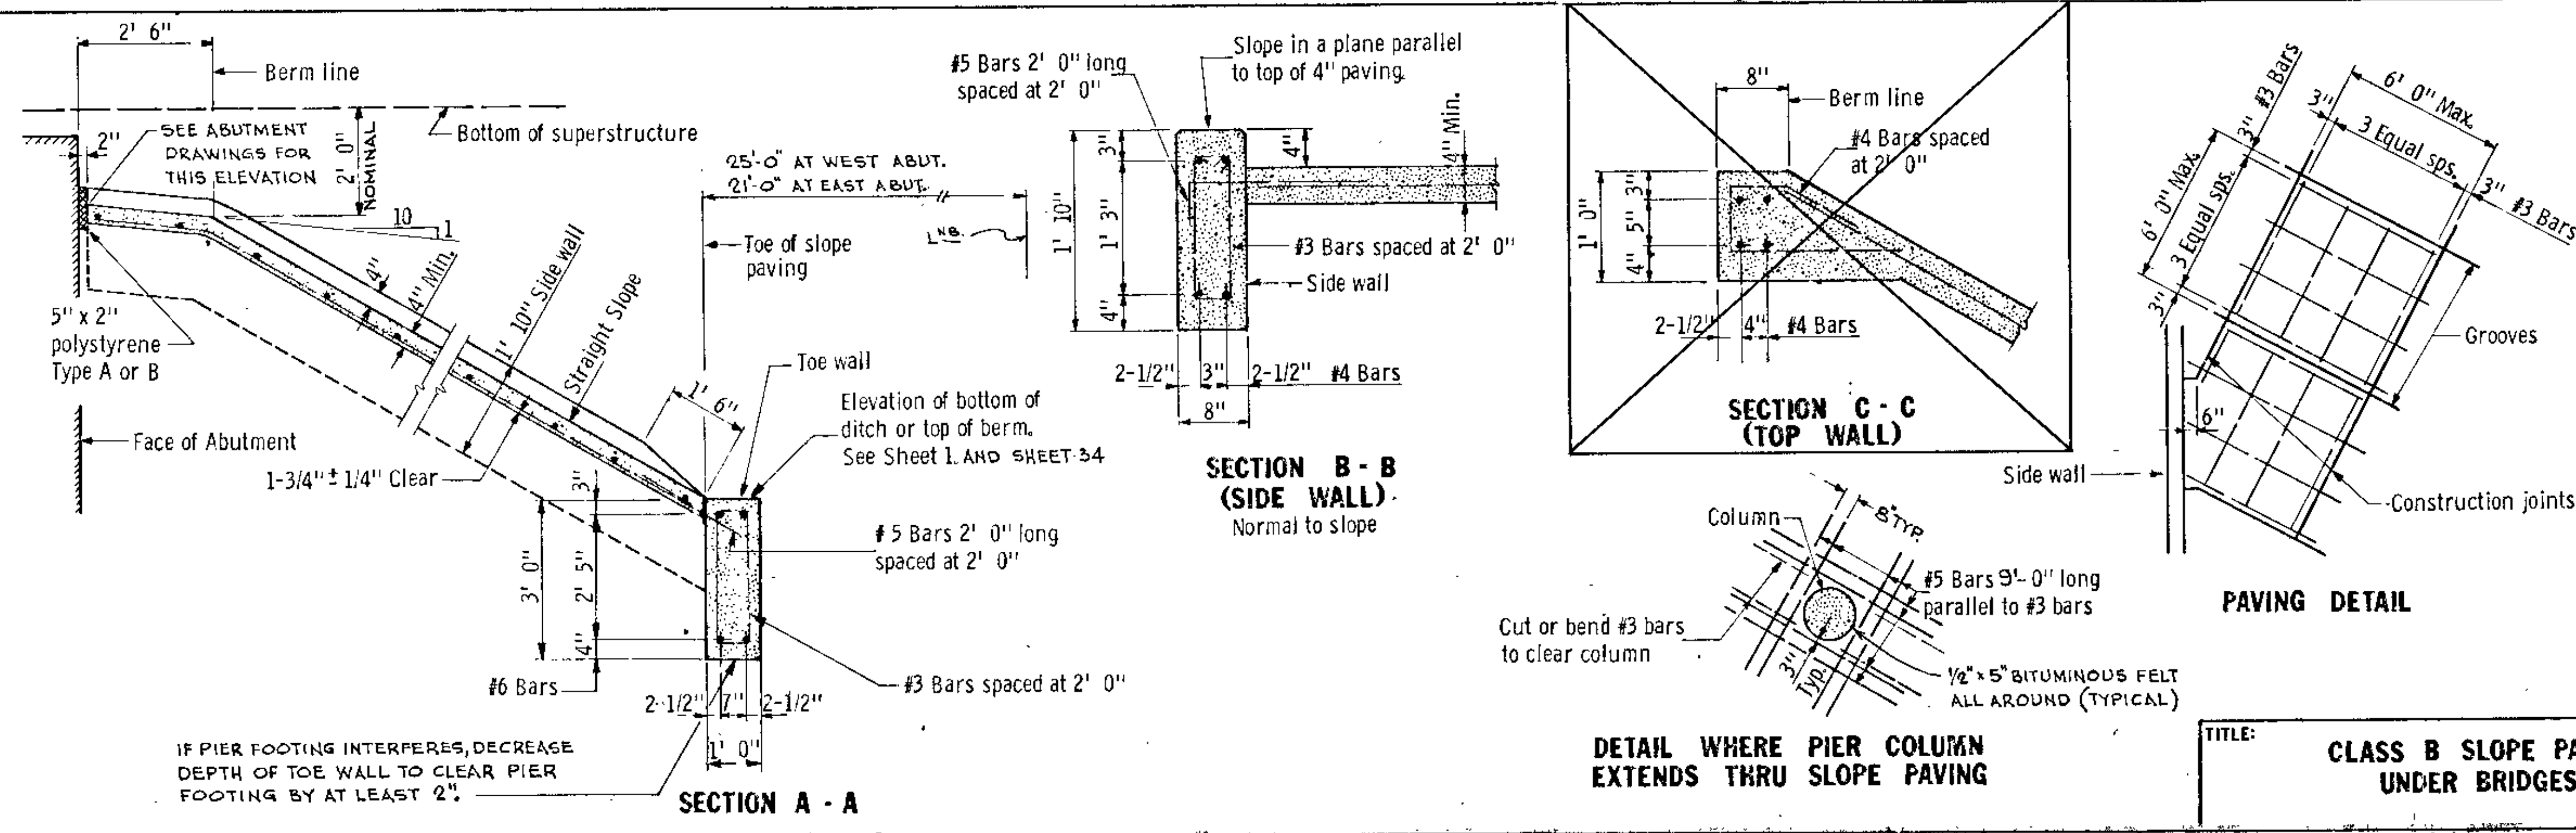

IF PIER FOOTING INTERFERES, DECREASE DEPTH OF TOE WALL TO CLEAR PIER FOOTING BY AT LEAST 2".

DETAIL WHERE PIER COLUMN EXTENDS THRU SLOPE PAVING





CLASS B SLOPE PAVING UNDER BRIDGES

DES: M.H.D. DR: M.H.D./W.K. APPROVED: 12-21-71
 CHK: R/W/S CHK: R/W/S
Sheet No. 29 of 35 Sheets





Bridge No. 02522

AS BUILT
 10-16-73
 B. J. J.


Fig. 5-397.301
 Jan. 11, 1971

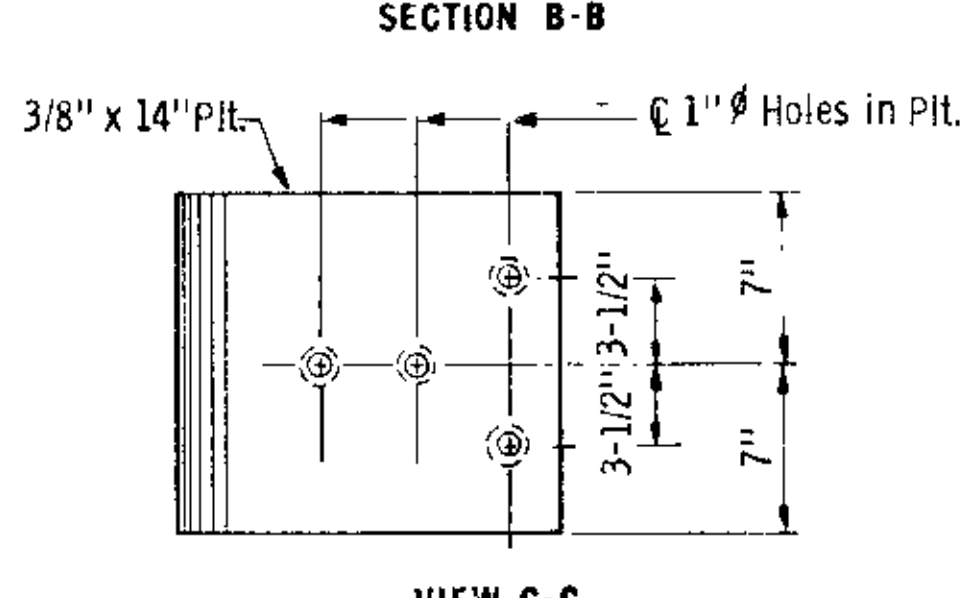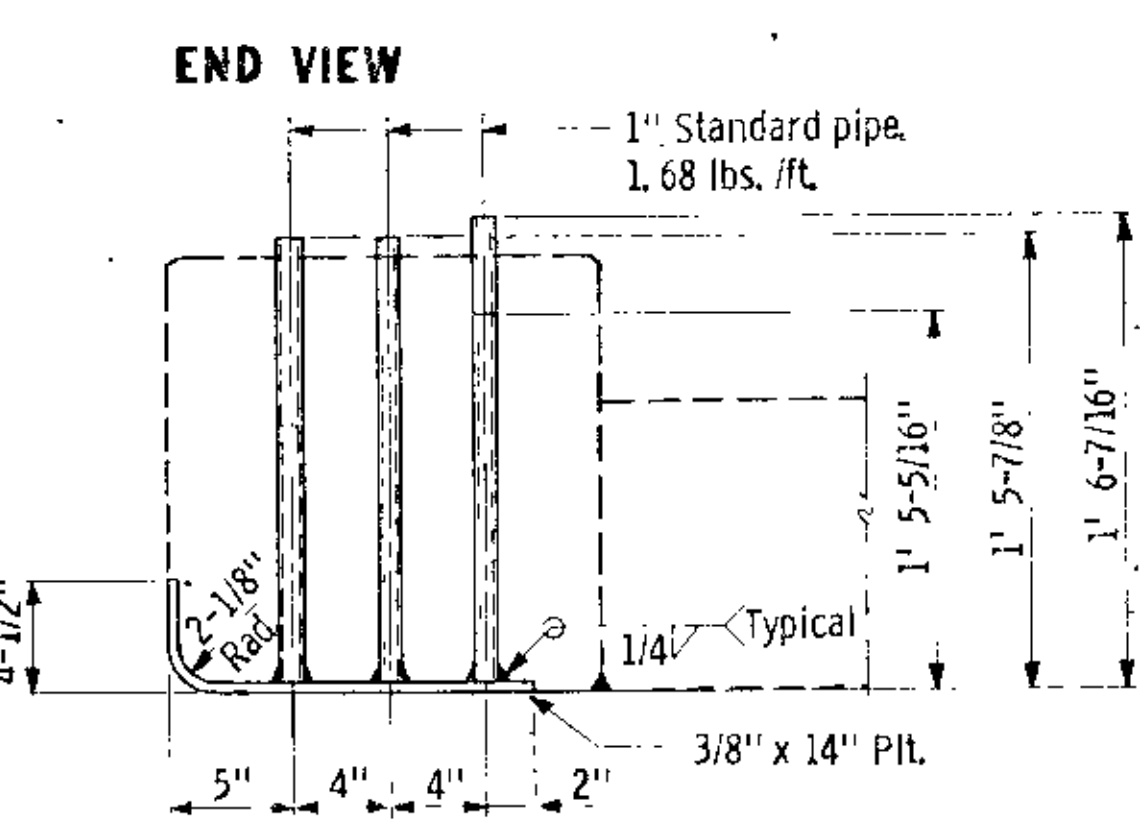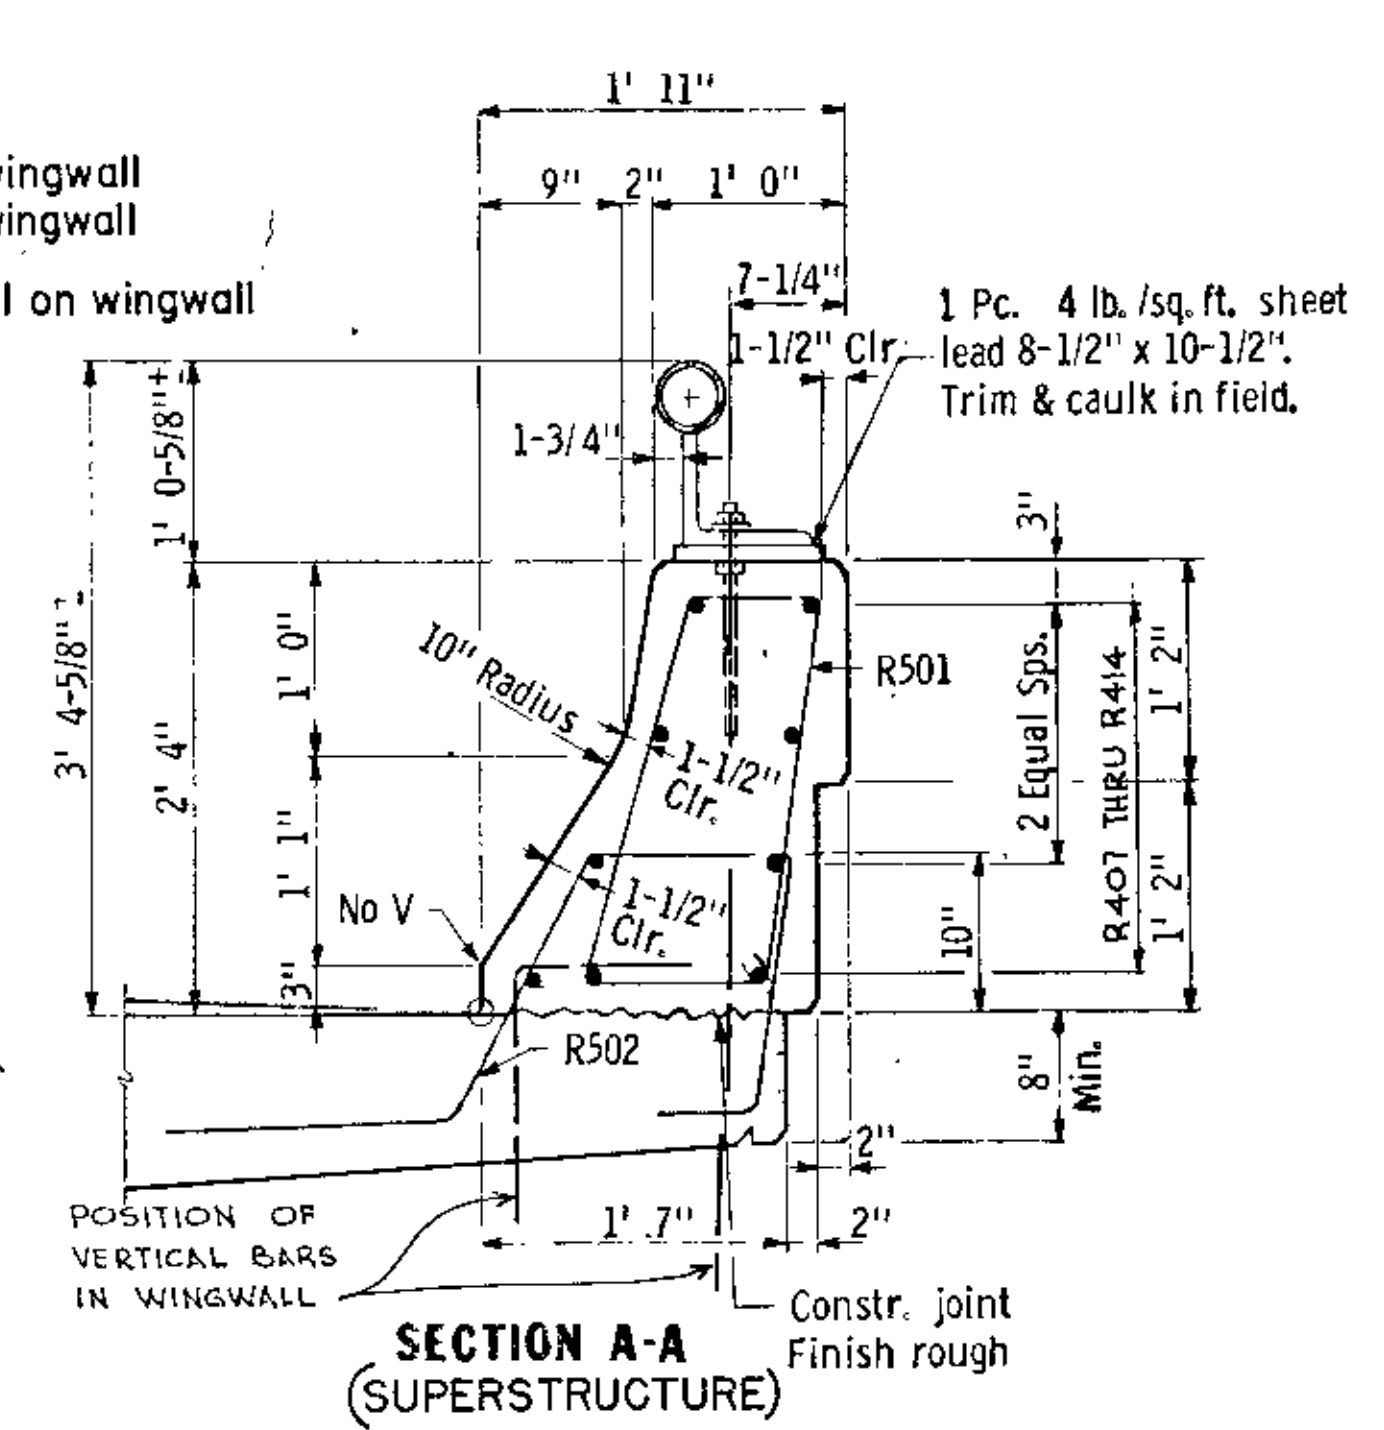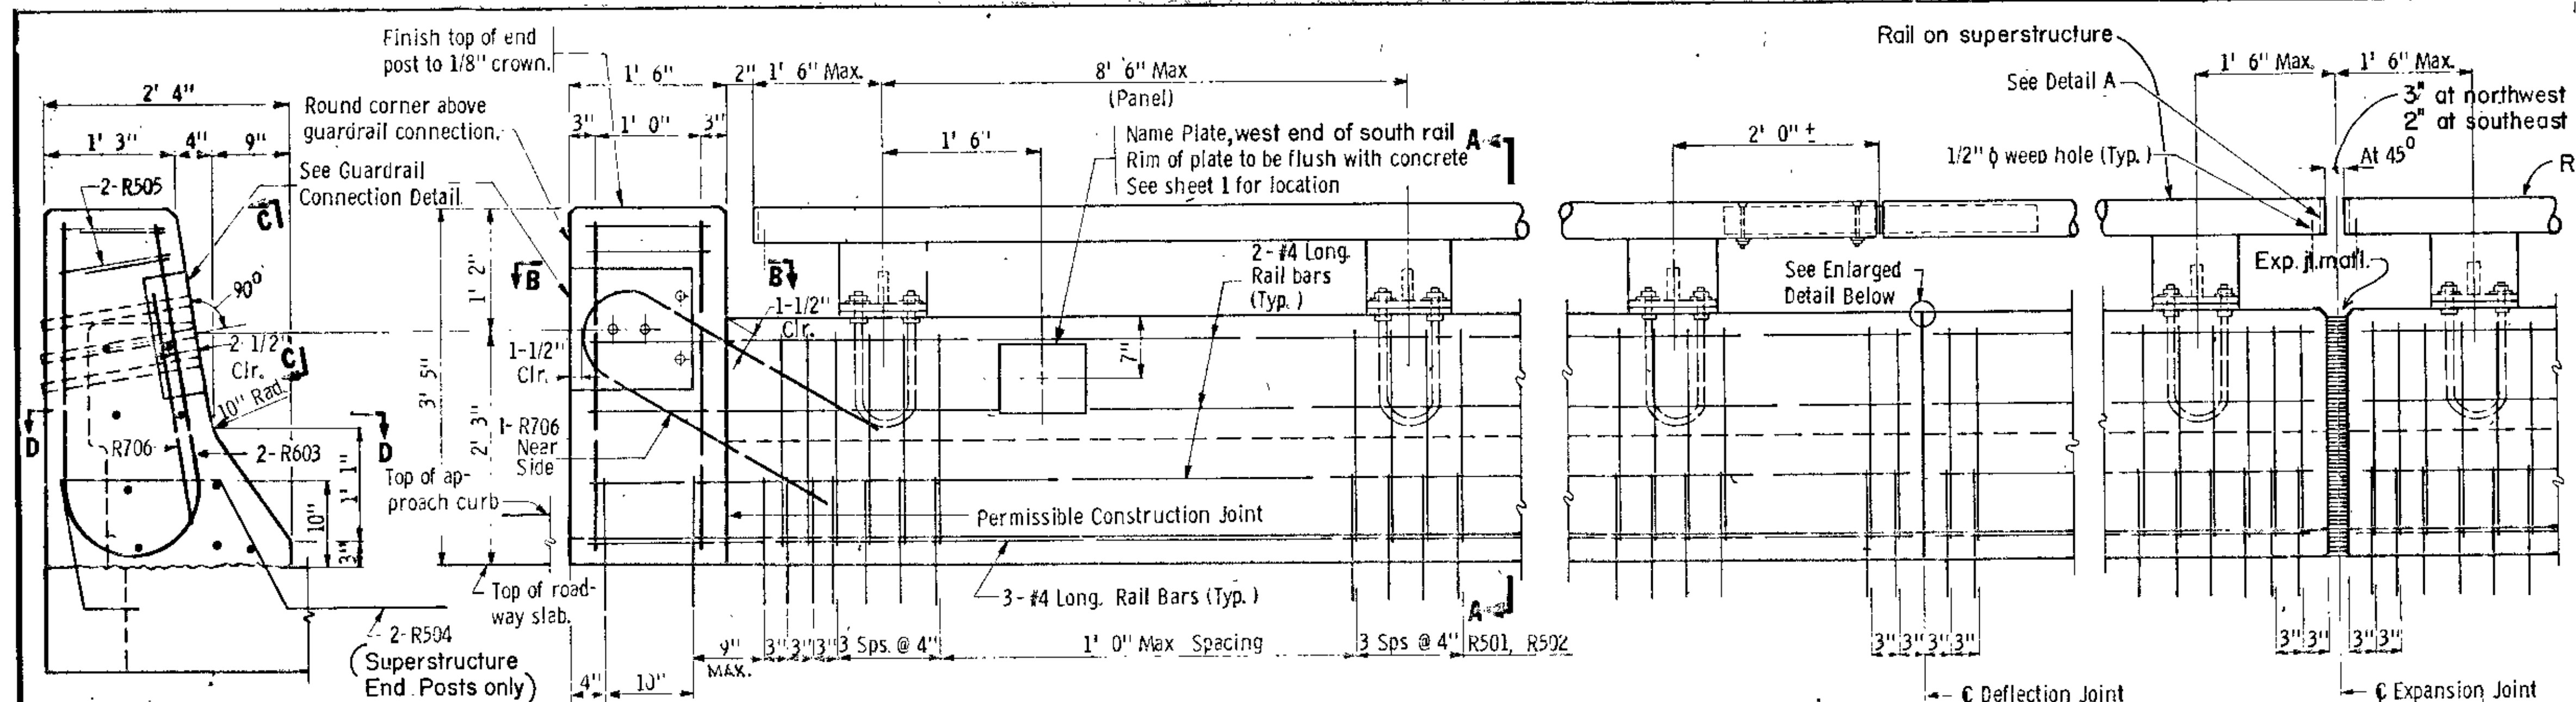



VIEW C-C
GUARDRAIL CONNECTION DETAIL
GALVANIZE AFTER FABRICATION PER M. H. D. 3394
Est. Wt. 37 Lbs.

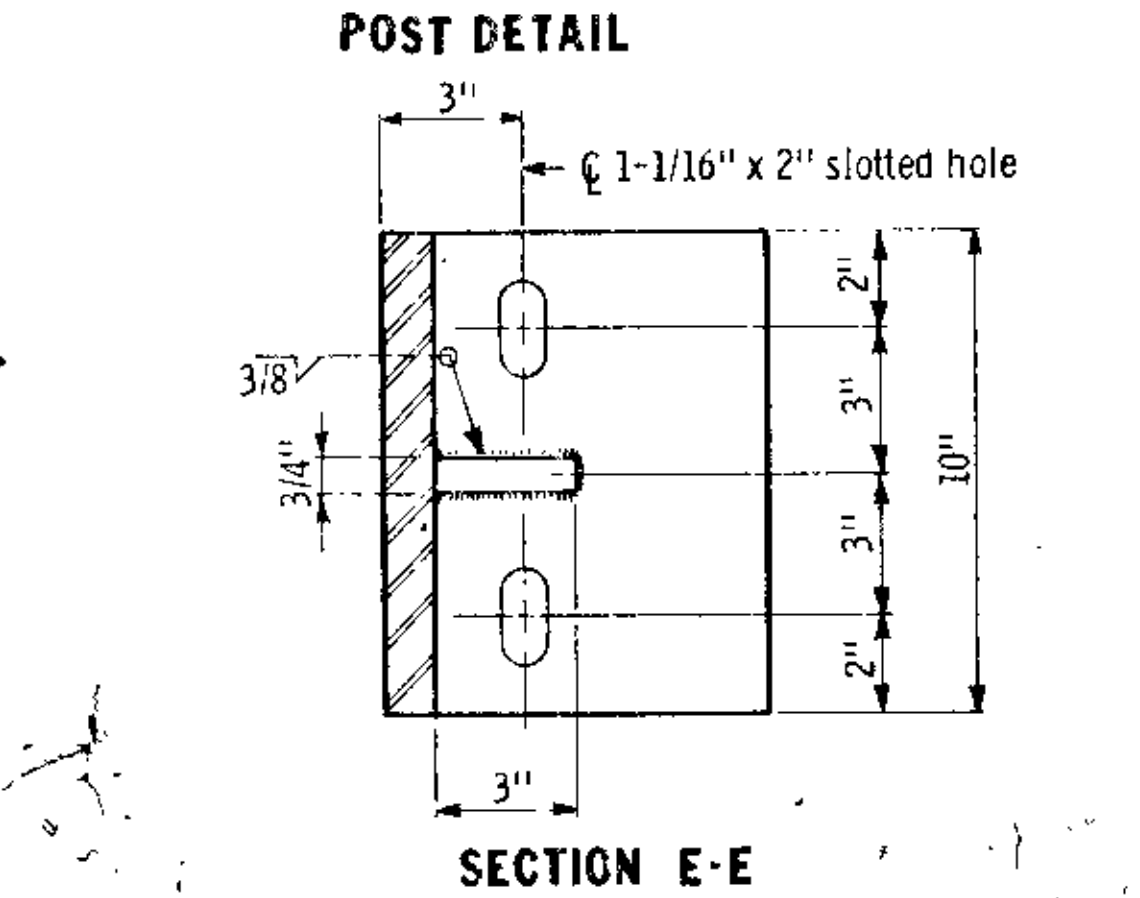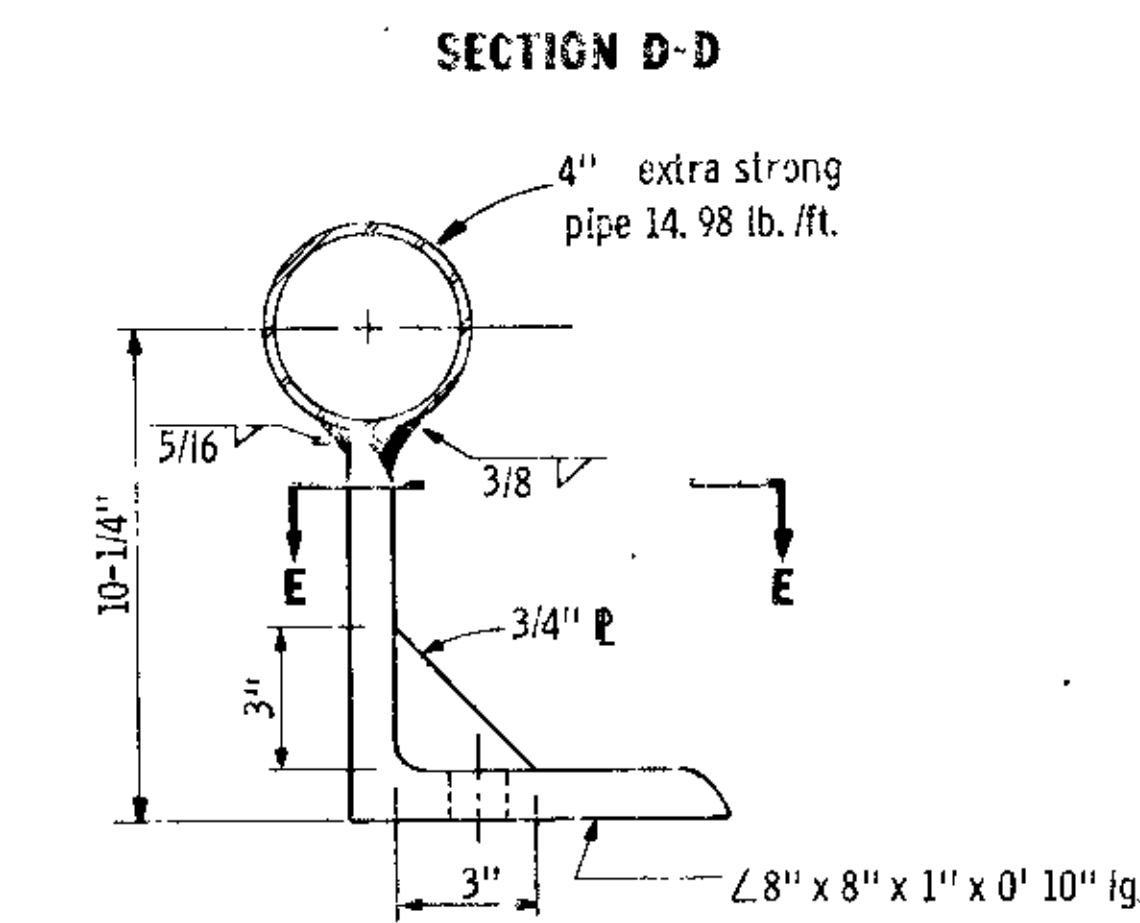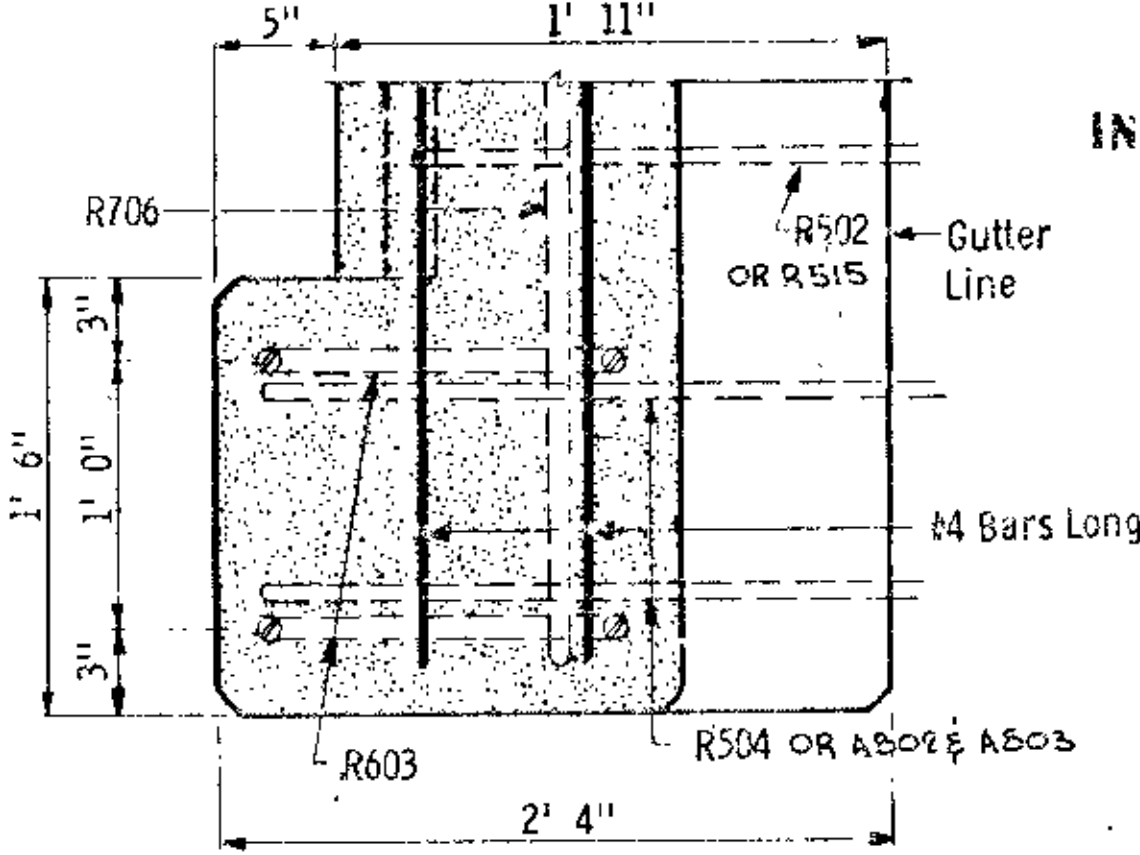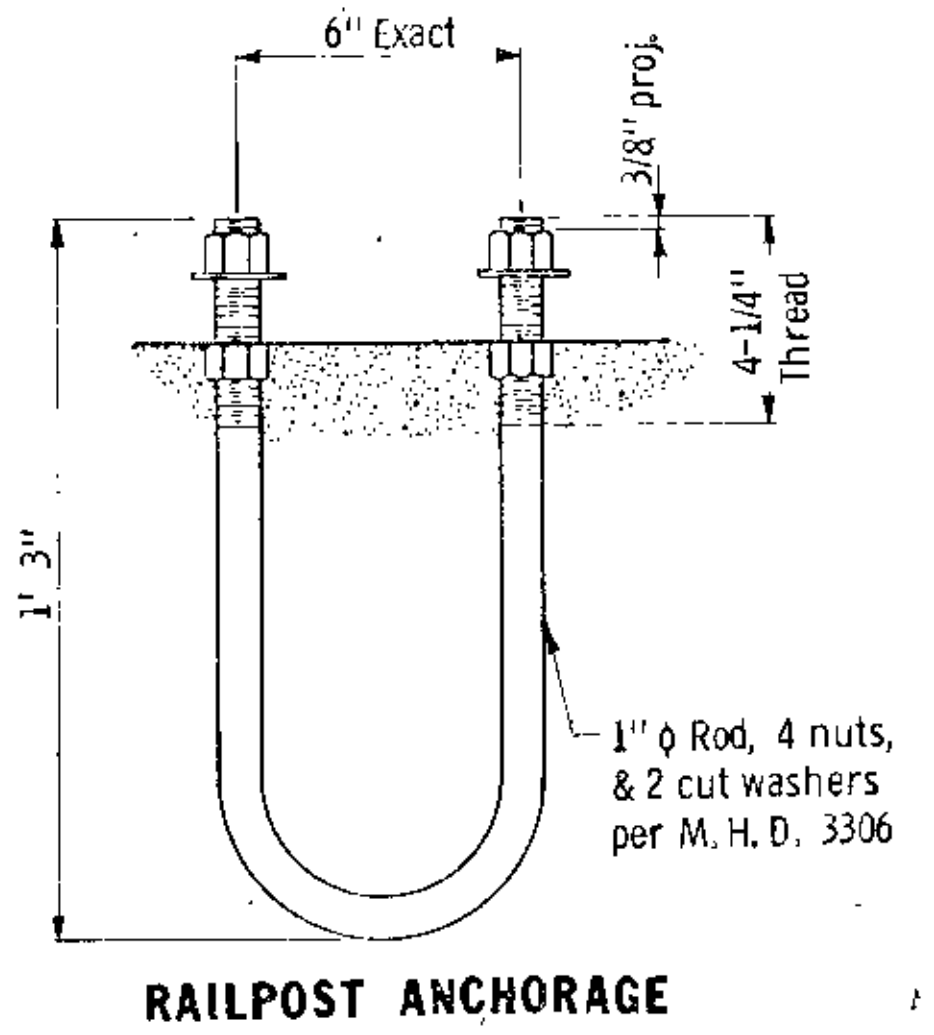

INSIDE ELEVATION OF RAILING

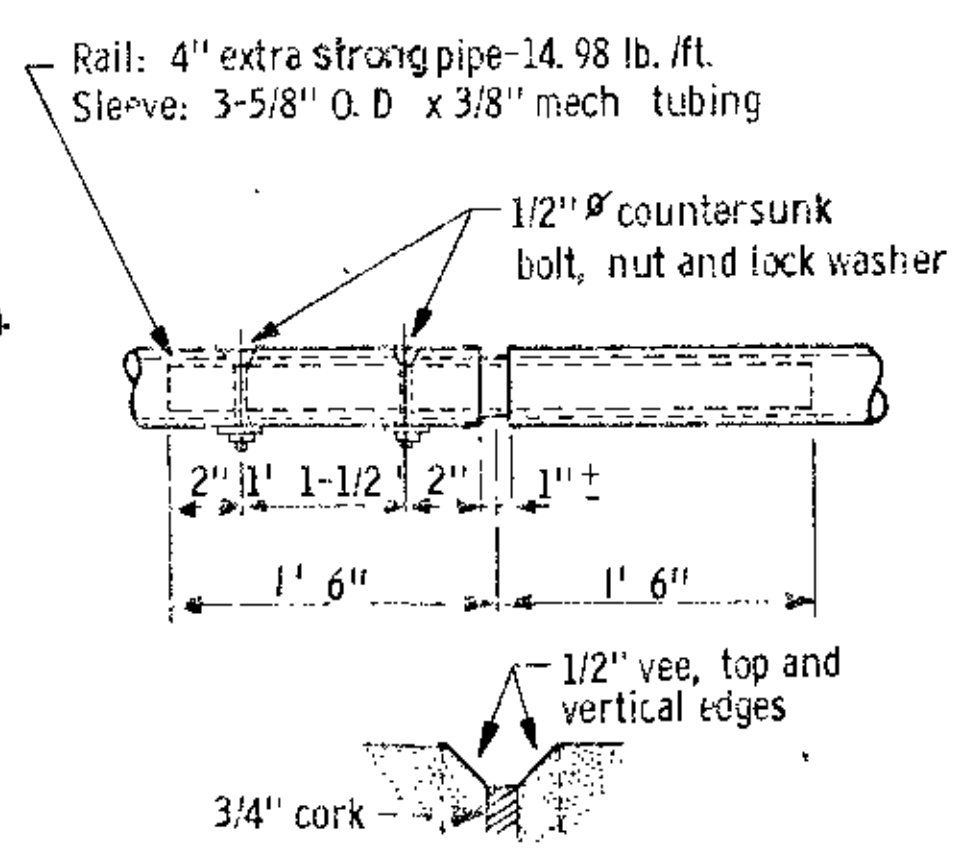

DEFLECTION JOINT DETAIL

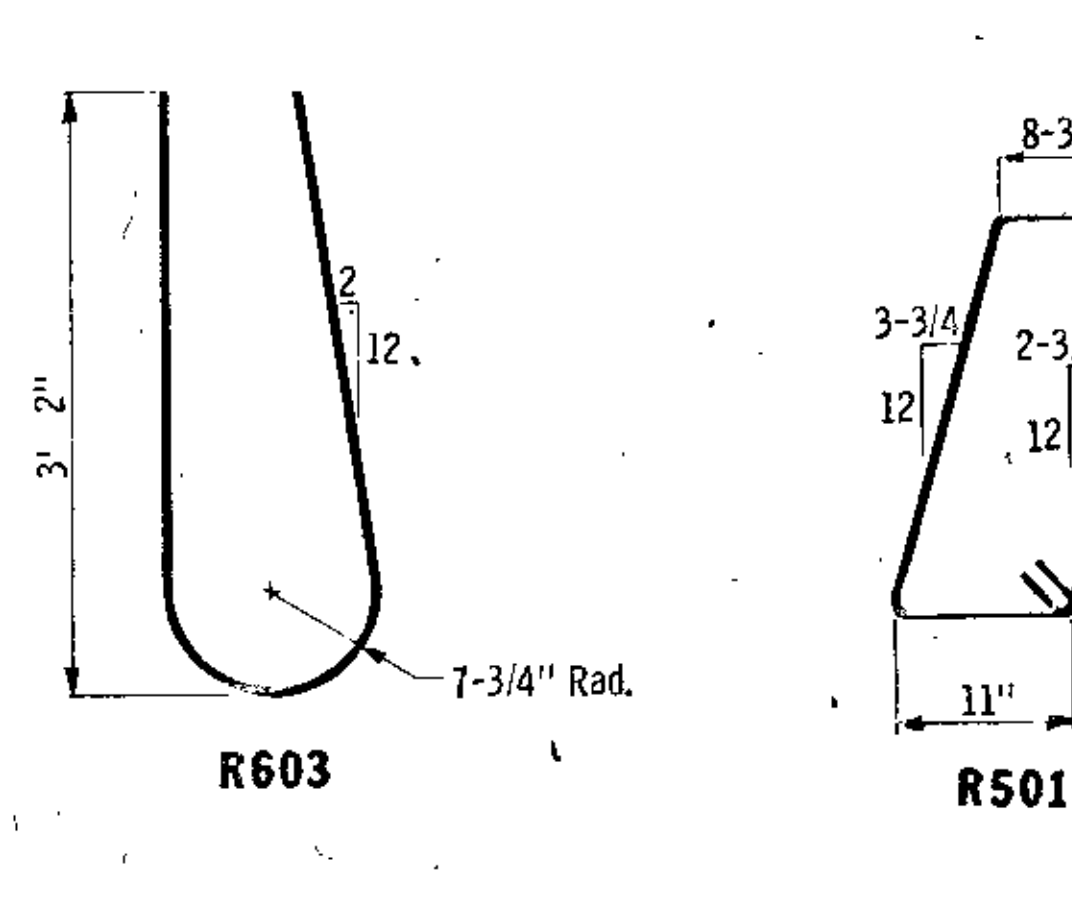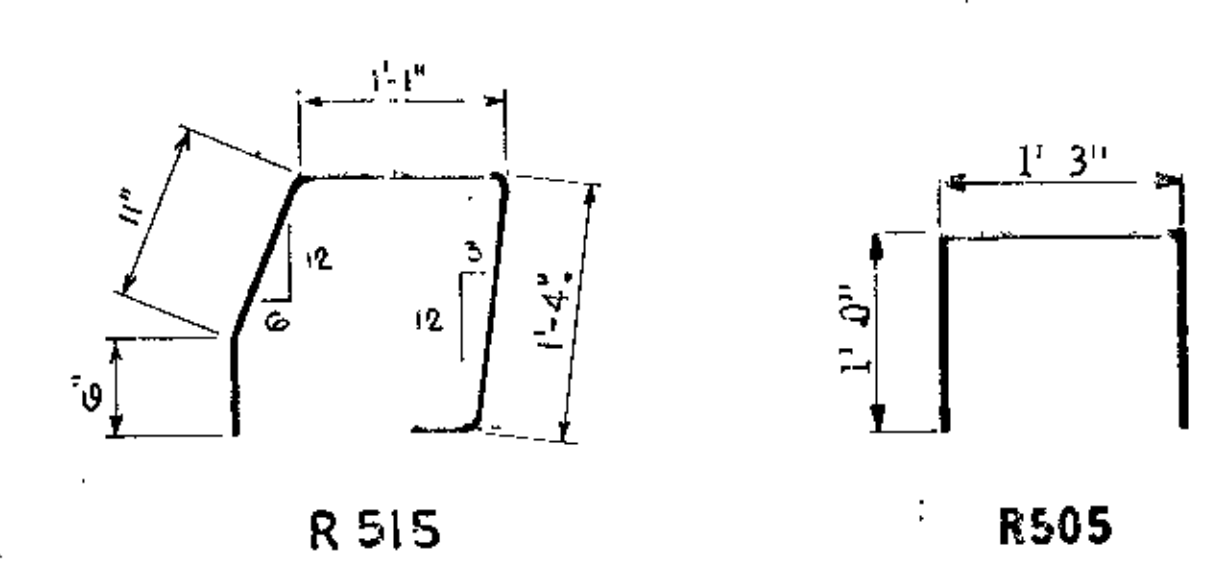

DEFLECTION JOINT

EXPANSION JOINT

BILL OF REINFORCEMENT FOR RAILING				
BAR	NO.	LENGTH	SHAPE	LOCATION
R501	692	6' 11"	Bent	Rail Vertical
R502	638	5' 10"	Bent	Rail Vertical
R603	8	7' 1"	Bent	End Vertical
R504	4	6' 3"	Bent	End Vertical
R505	16	3' 1"	Bent	End Long.
R706	4	6' 6"	Bent	End at G. R. Conn.
R407	9	18'-1"	STR.	RAIL, LONG. ABUT.
R408	9	15'-7"	STR.	RAIL, LONG. ABUT.
R409	9	26'-1"	STR.	RAIL, LONG.
R410	12	24'-1"	STR.	RAIL, LONG.
R411	9	26'-5"	STR.	RAIL, LONG.
R412	9	23'-10"	STR.	RAIL, LONG.
R413	54	22'-10"	STR.	RAIL, LONG.
R414	9	22'-5"	STR.	RAIL, LONG.
R515	54	4'-4"	BENT	WINGWALL RAIL

GENERAL NOTES

- Railbase to be Concrete Mix No. 3Y46A, special.
- Pipe shall comply with M. H. D. 3362. The 4" pipe shall have a minimum yield point of 35000 P. S. I.
- Structural steel shall comply with M. H. D. 3306.
- Finish all edges of railbase and end post with 1/2" vee, except where otherwise noted.
- Anchorage shall be accurately placed to provide correct alignment of railing. Set normal to grade.
- Galvanize pipe and structural steel per M. H. D. 3394 after fabrication. Galvanize bolts and anchorages per M. H. D. 3392.
- See superstructure sheet for joint spacing.
- Maximum spacing of concrete deflection joints shall be 30' 0". Railpipe deflection joints shall be placed in same panel as concrete deflection joints.
- Price bid for ornamental metal railing includes the post anchorages and all material above railbase. Guardrail connection to be included in weight of structural steel M. H. D. 3306.
- Length of ornamental metal railing for payment is measured end to end of pipe.
- Railing quantities are included in summary of quantities for superstructure, or in summary of quantities for abutments.

Fig. 5-397.109
AS BUILT
10-16-73
B. J. ...
June 2, 1971

SUMMARY OF QUANTITIES FOR SUPERSTRUCTURE

CONCRETE MIX NO. 3Y43 A	669 CU. YD.
CONCRETE MIX NO. 3Y46A (SPECIAL)	50 CU. YD.
REINFORCEMENT BARS	176,280 LBS.
STRUCTURAL STEEL (M.H.D. 3308)	2040 LBS.
ORNAMENTAL METAL RAILING (TYPE G)	433 LIN. FT.
FIXED BEARING ASSEMBLIES (TYPE 1)	8 UNITS
EXP. BEARING ASSEMBLIES (TYPE 1 WITHOUT LUGS)	24 UNITS
EXP. BEARING ASSEMBLIES (TYPE 1 WITH LUGS)	16 UNITS
PRESTRESSED CONCRETE GIRDERS: TYPE 60-106	1
TYPE 60-100	1
TYPE 60-95	1
TYPE 60-86	4
TYPE 60-76	2
TYPE 60-64	4
TYPE 60-59	5
TYPE 60-51	6
PREFORMED JOINT FILLER (SEE LIST)	
BRIDGE NAME PLATE (DETAIL B103)	ONE PLATE

QUANTITY NOTES

- THE ABOVE SUMMARY INCLUDES RAILING QUANTITIES, FOR THE PORTION OF RAILING ON THE SUPERSTRUCTURE.
- STRUCTURAL STEEL, AS TABULATED ABOVE, INCLUDES PROTECTION ANGLES AND GUARDRAIL CONNECTIONS.
- THE VOLUME OF CONCRETE MIX NO. 3Y43A, FOR PAYMENT, WILL BE COMPUTED USING AN AVERAGE STOOD HEIGHT OF 2".
- PREFORMED JOINT FILLER IS INCLUDED FOR PAYMENT WITH OTHER ITEMS.
- BRIDGE NAME PLATE IS INCLUDED FOR PAYMENT WITH OTHER ITEMS. NAME PLATE LETTERING:
CITY OF
COON RAPIDS
MINNESOTA
BRIDGE 02522
1972
- SIXTEEN SHIMS 3/4 x 1/2 x 3'-4", DRILLED FOR ANCHOR RODS, SHALL BE PROVIDED AND INCLUDED FOR PAYMENT WITH EXP. BEARING ASSEMBLIES (TYPE 1 WITHOUT LUGS).
- CONCRETE MIX NO. 3Y46A (SPECIAL) INCLUDES RAILBASES AND END POSTS.
- CONCRETE MIX NO. 3Y43A INCLUDES SLAB, MEDIAN, AND DIAPHRAGMS.


PREFORMED JOINT FILLER LIST

TYPE	NO.	SIZE	LOCATION	SEE SH. NO.
POLYSTYRENE	1	5' x 2' x ABT. 209 FT.	BET. SL. PV. & W. ABUT.	29
POLYSTYRENE	1	5' x 2' x ABT. 114 FT.	BET. SL. PV. & E. ABUT.	29
BIT. FELT	16	1/2" x 5' x ABT. 13 1/2 FT.	BET. SL. PV. & PIER COLS	29
BIT. FELT	1	1/2" x 16' x ABT. 175 FT.	ON W. ABUT. BACKWALL	21
BIT. FELT	1	1/2" x 16' x ABT. 6 FT.	ON W. ABUT. BACKWALL	21
BIT. FELT	1	1/2" x 16' x ABT. 113 FT.	ON E. ABUT. BACKWALL	21
POLYSTYRENE	1	1' x 4' x ABT. 212 FT.	ON E. OF MEDIAN	24
CORK	16	3/4" x 1'-9" (IRREG) x 2'-4"	DEFLECTION JTS. IN RAILING	28
CORK	1	1' x 15' x ABT. 19 FT.	BET. APP. SLAB & N.W. WING WALL	2
CORK	1	1' x 12' x ABT. 16 FT.	BET. APP. SLAB & E. WING WALL	2
CORK	1	5' x 1'-9" (IRREG) x 3'-4"	EXP. JT. RAILING @ N.W. WING WALL	2
CORK	1	2' x 1'-9" (IRREG) x 3'-8"	EXP. JT. RAILING @ S.E. WING WALL	2
CORK	1	3' x 15' x 4'-0"	BET. DECK & APP. SLAB - W. ABUT.	2
CORK	1	2' x 15' x ABT. 88 FT.	BET. DECK & APP. SLAB - N.W.	2
CORK	1	2' x 2' x ABT. 14 FT.	MEDIAN @ W. ABUT.	24
CORK	1	2' x 15' x ABT. 71 FT.	BET. DECK & APP. SLAB - S.W.	2
CORK	1	2' x 18' x ABT. 1 FT.	BET. WING & S.W. END POST	2
CORK	1	2' x 18' x ABT. 53 FT.	BET. DECK & APP. SLAB - N.E.	2
CORK	1	2' x 24' x ABT. 9 FT.	MEDIAN @ E. ABUT.	28
CORK	1	2' x 18' x ABT. 49 FT.	BET. DECK & APP. SLAB - S.E.	2
CORK	1	2' x 18' x ABT. 1 FT.	BET. WING & N.E. END POST	2

JOINT FILLER NOTES

- CORK SHALL COMPLY WITH M.H.D. 3702 AND A.A.S.H.O. M-153, TYPE 2
- SECURE CORK JOINT FILLER WITH 11 GAGE COPPER NAILS, OF SUITABLE LENGTH, AT ABOUT 18" CENTERS. CORK AND NAILS SHALL BE INCLUDED IN PRICE BID FOR OTHER ITEMS. TRIM CORK TO BOTTOM OF "Y" AND SEAL WITH CONCRETE JOINT SEALER.
- POLYSTYRENE SHALL BE TYPE A OR B. SEE SPECIAL PROVISIONS.
- BITUMINOUS FELT SHALL COMPLY WITH M.H.D. 3702
- THE JOINT FILLER LIST IS FOR THE CONTRACTOR'S CONVENIENCE ONLY. ANY ADDITIONAL JOINT FILLER REQUIRED AS SHOWN ON THE PLANS, SHALL BE FURNISHED BY THE CONTRACTOR WITH NO ADDITIONAL COMPENSATION.

BENDING DIAGRAMS

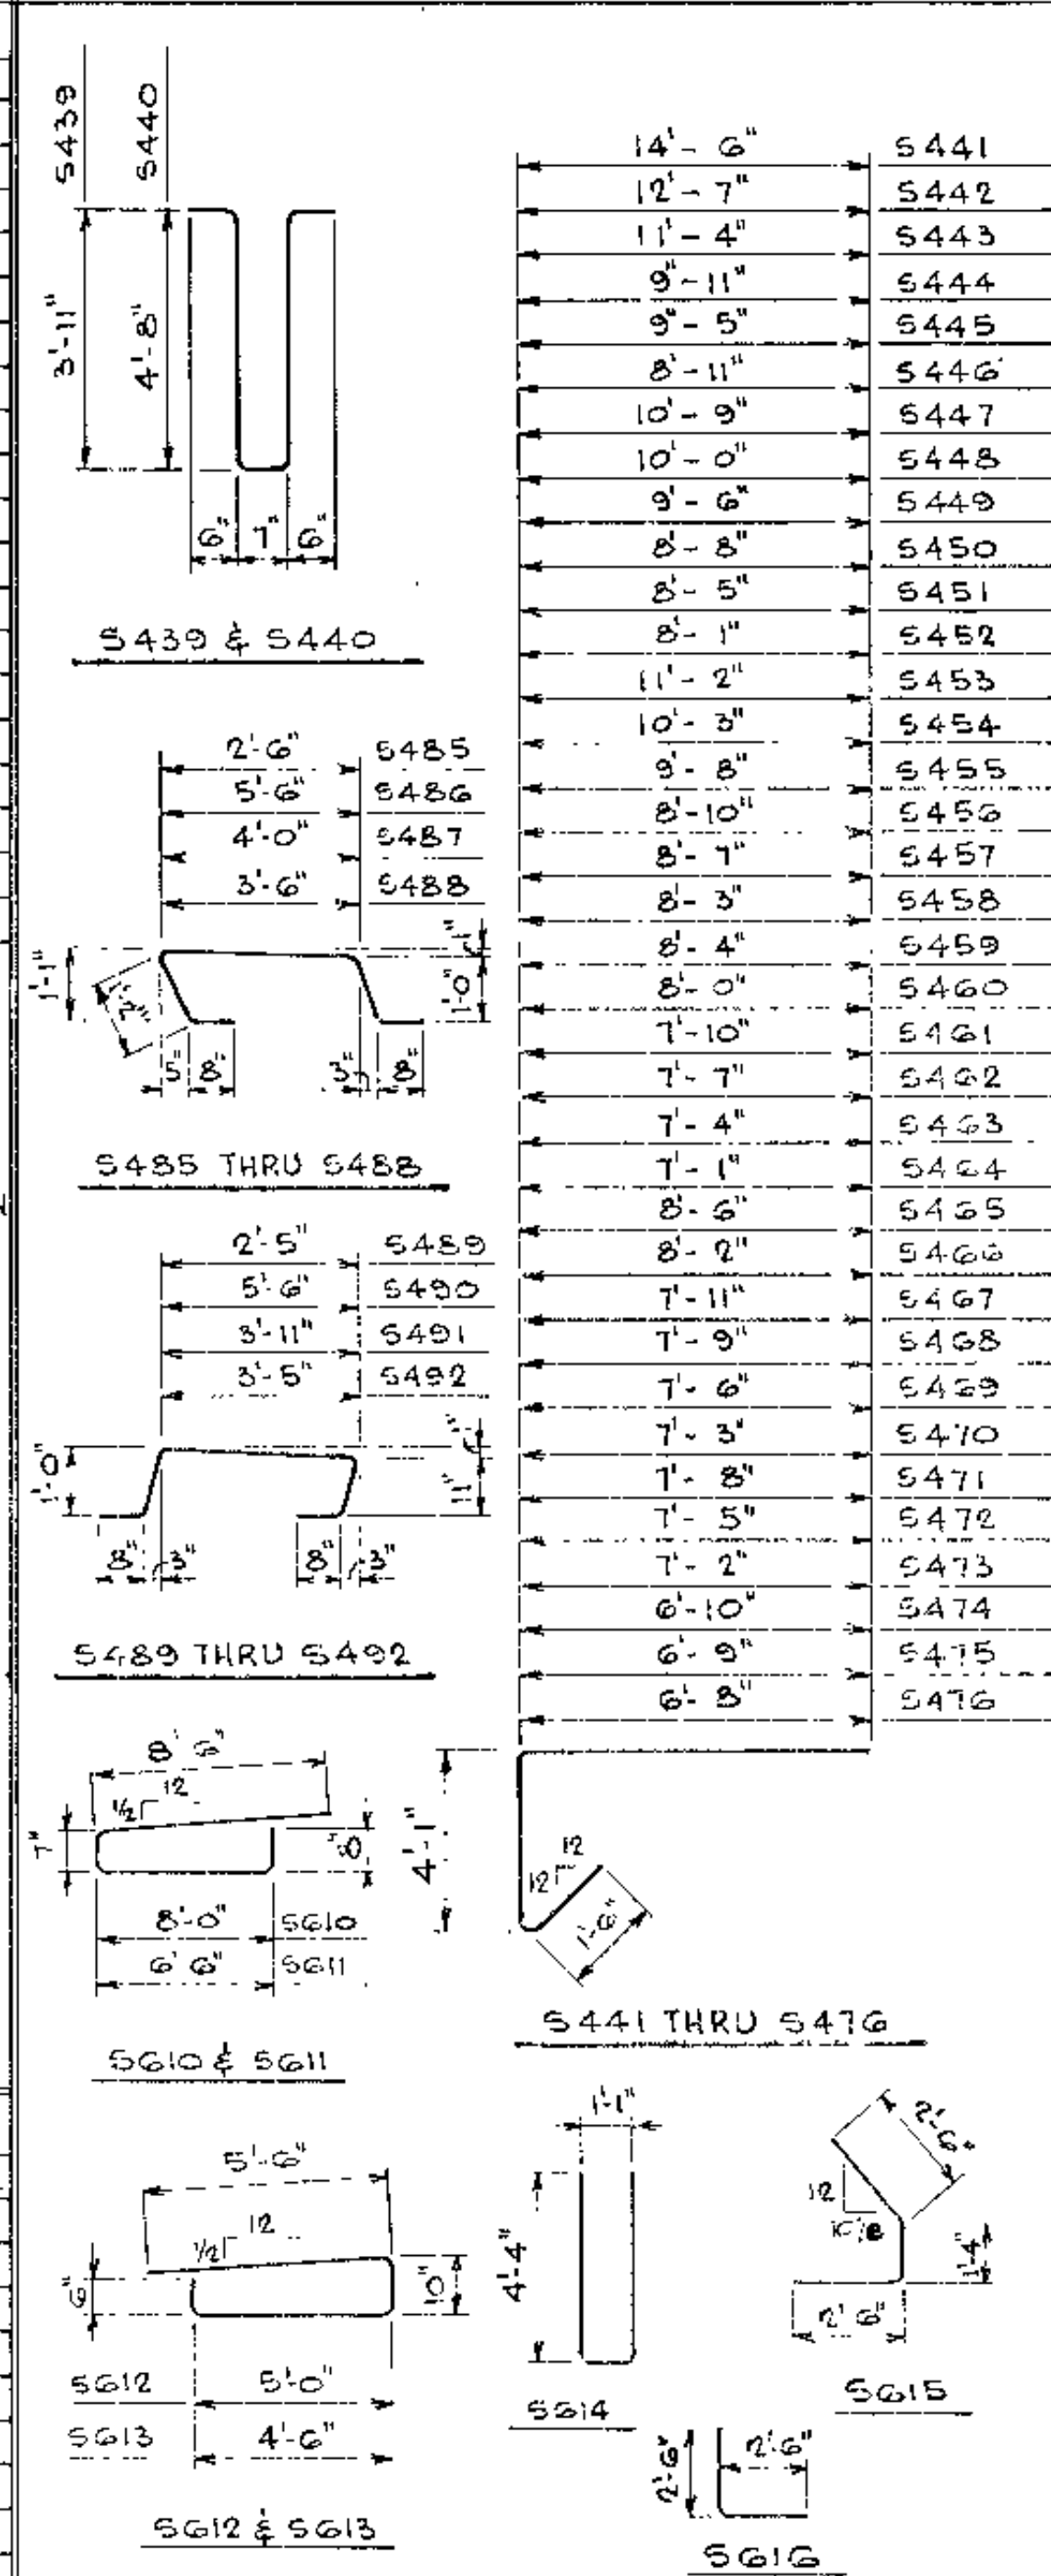

BILL OF REINFORCEMENT FOR SUPERSTRUCTURE

MARK	NUMBER	LENGTH	SHAPE	LOCATION
S439	531	9'-1"	J	END DIAPHS. TRANS.
S440	578	10'-7"	J	INT. DIAPHS. TRANS.
S441	4	19'-11"	J	DIAPH. DI LONG.
S442	4	18'-0"	J	" " " "
S443	4	16'-9"	J	" D3 "
S444	4	15'-4"	J	" D4 "
S445	4	14'-10"	J	" D5 "
S446	4	14'-4"	J	" D6 "
S447	4	16'-2"	J	" D7 "
S448	4	15'-5"	J	" D8 "
S449	4	14'-11"	J	" D9 "
S450	4	14'-1"	J	" D10 "
S451	4	13'-10"	J	" D11 "
S452	4	13'-6"	J	" D12 "
S453	4	16'-7"	J	" D13 "
S454	4	15'-3"	J	" D14 "
S455	4	15'-1"	J	" D15 "
S456	4	14'-3"	J	" D16 "
S457	4	14'-0"	J	" D17 "
S458	4	13'-3"	J	" D18 "
S459	4	13'-9"	J	" D19 "
S460	4	13'-5"	J	" D20 "
S461	4	13'-3"	J	" D21 "
S462	4	13'-0"	J	" D22 "
S463	4	10'-3"	J	" D23 "
S464	4	12'-6"	J	" D24 "
S465	4	13'-11"	J	" D25 "
S466	4	13'-7"	J	" D26 "
S467	4	13'-4"	J	" D27 "
S468	4	13'-2"	J	" D28 "
S469	4	12'-11"	J	" D29 "
S470	4	12'-8"	J	" D30 "
S471	4	13'-1"	J	" D31 "
S472	4	12'-10"	J	" D32 "
S473	4	12'-7"	J	" D33 "
S474	4	12'-3"	J	" D34 "
S475	4	12'-2"	J	" D35 "
S476	4	12'-1"	J	DIAPH. D36 LONG.
S485	205	8'-8"	J	MEDIAN, SOUTHBOUND LANE
S486	1	8'-8"	J	" " "
S487	1	7'-2"	J	" " "
S488	1	6'-8"	J	MEDIAN, SOUTHBOUND LANE
S489	209	5'-5"	J	MEDIAN, NORTHBOUND LANE
S490	1	8'-6"	J	" " "
S491	1	6'-11"	J	" " "
S492	1	6'-5"	J	MEDIAN, NORTHBOUND LANE
S610	65	17'-3"	J	SLAB END
S611	55	15'-9"	J	SLAB END
S612	55	11'-4"	J	SLAB END
S613	35	10'-10"	J	SLAB END
S614	4	9'-5"	J	SLAB CORNER
S615	2	6'-2"	J	SLAB CORNER
S616	2	4'-10"	J	SLAB CORNER
S301	208	43'-9"	J	SLAB, LONG. TOP
S302	NOTE 1	NOTE 1	J	" " "
S303	260	43'-1"	J	" " "
S304	NOTE 2	NOTE 2	J	SLAB, LONG. TOP
S401	2	31'-0"	J	DIAPH. DI LONG.
S402	2	26'-9"	J	" D2 "
S403	2	23'-11"	J	" D3 "
S404	2	20'-10"	J	" D4 "
S405	2	19'-7"	J	" D5 "
S406	2	18'-6"	J	" D6 "
S407	2	22'-11"	J	" D7 "
S408	2	21'-3"	J	" D8 "
S409	2	19'-11"	J	" D9 "
S410	2	18'-2"	J	" D10 "
S411	2	17'-4"	J	" D11 "
S412	2	16'-7"	J	" D12 "
S413	2	23'-3"	J	" D13 "
S414	2	21'-5"	J	" D14 "
S415	2	20'-0"	J	" D15 "
S416	2	18'-3"	J	" D16 "
S417	2	17'-6"	J	" D17 "
S418	2	16'-9"	J	" D18 "
S419	2	17'-3"	J	" D19 "
S420	2	16'-6"	J	" D20 "
S421	2	16'-0"	J	" D21 "
S422	2	15'-2"	J	" D22 "
S423	2	14'-9"	J	" D23 "
S424	2	14'-6"	J	" D24 "
S425	2	17'-5"	J	" D25 "
S426	2	16'-8"	J	" D26 "
S427	2	16'-2"	J	" D27 "
S428	2	15'-5"	J	" D28 "
S429	2	14'-11"	J	" D29 "
S430	2	14'-8"	J	" D30 "
S431	2	15'-4"	J	" D31 "
S432	2	14'-10"	J	" D32 "
S433	2	14'-1"	J	" D33 "
S434	2	13'-11"	J	" D34 "
S435	2	13'-9"	J	" D35 "
S436	2	13'-5"	J	DIAPH. D36 LONG.
S437	188	15'-0"	J	SLAB LONG. AT PIERS
S438	188	21'-0"	J	SLAB LONG. AT PIERS
S477	4	8'-2"	J	INT. DIAPH. LONG.
S478	8	8'-4"	J	" " "
S479	24	8'-6"	J	" " "
S480	26	8'-8"	J	" " "
S481	26	8'-10"	J	" " "
S482	16	9'-0"	J	" " "
S483	4	9'-2"	J	" " "
S484	4	9'-4"	J	INT. DIAPH. LONG.
S493	25	43'-6"	J	MEDIAN, SOUTHBOUND LANE
S494	25	44'-6"	J	MEDIAN, NORTHBOUND LANE
S501	4	9'-6"	J	INT. DIAPH. LONG.
S502	8	9'-8"	J	" " "
S503	24	9'-10"	J	" " "
S504	26	10'-0"	J	" " "
S505	28	10'-2"	J	" " "
S506	14	10'-4"	J	" " "
S507	4	10'-6"	J	" " "
S508	4	10'-8"	J	INT. DIAPH. LONG.
S509	212	44'-0"	J	SLAB, LONG. BOTTOM
S510	NOTE 3	NOTE 3	J	" " "
S511	265	43'-3"	J	" " "
S512	NOTE 4	NOTE 4	J	SLAB, LONG. BOTTOM
S601	1164	40'-0"	J	SLAB TRANSVERSE
S602	NOTE 5	NOTE 5	J	" " "
S603	NOTE 6	NOTE 6	J	" " "
S604	NOTE 7	NOTE 7	J	" " "
S605	NOTE 8	NOTE 8	J	SLAB TRANSVERSE
S606	4	31'-0"	J	SLAB END
S607	4	27'-6"	J	" " "
S608	4	41'-0"	J	" " "
S609	6	33'-0"	J	SLAB END
S801	2	19'-5"	J	DIAPH. D5 LONG.
S802	2	18'-4"	J	" D6 "
S803	2	19'-9"	J	" D9 "
S804	2	18'-0"	J	" D10 "
S805	2	17'-2"	J	" D11 "
S806	2	16'-5"	J	" D12 "
S807	2	19'-10"	J	" D15 "
S808	2	18'-1"	J	" D16 "
S809	2	17'-4"	J	" D17 "
S810	2	16'-7"	J	" D18 "
S811	2	17'-1"	J	" D19 "
S812	2	16'-4"	J	" D20 "
S813	2	15'-10"	J	" D21 "
S814	2	15'-0"	J	" D22 "
S815	2	14'-7"	J	" D23 "
S816	2	14'-4"	J	" D24 "
S817	2	17'-3"	J	" D25 "
S818	2	16'-6"	J	" D26 "
S819	2	16'-0"	J	" D27 "
S820	2	15'-3"	J	" D28 "
S821	2	14'-9"	J	" D29 "
S822	2	14'-6"	J	" D30 "
S823	2	15'-2"	J	" D31 "
S824	2	14'-8"	J	" D32 "
S825	2	14'-5"	J	" D33 "
S826	2	13'-9"	J	" D34 "
S827	2	13'-7"	J	" D35 "
S828	2	13'-3"	J	DIAPH. D36 LONG.
S829	4	8'-2"	J	INT. DIAPH. LONG.
S830	8	8'-4"	J	" " "
S831	24	8'-6"	J	" " "
S832	26	8'-8"	J	" " "
S833	26	8'-10"	J	" " "
S834	16	9'-0"	J	" " "
S835	4	9'-2"	J	" " "
S836	4	9'-4"	J	INT. DIAPH. LONG.
S901	2	23'-9"	J	DIAPH. D3 LONG.
S902	2	20'-8"	J	" D4 "
S903	2	22'-9"	J	" D7 "
S904	2	21'-1"	J	" D8 "
S905	2	23'-1"	J	" D13 "
S906	2	21'-3"	J	DIAPH. D14 LONG.
S1001	2	30'-10"	J	DIAPH. D1 LONG.
S1002	2	26'-1"	J	DIAPH. D2 LONG.
T601	32	7'-4"	J	DIAPH. THRU GIRDER
T801	12	7'-6"	J	" " "
T802	4	5'-0"	J	" " "
T803	12	5'-8"	J	" " "
T804	8	6'-6"	J	" " "
T805	8	7'-0"	J	" " "
T806	4	7'-8"	J	" " "
T807	12	9'-0"	J	" " "
T901	8	7'-8"	J	DIAPH. THRU GIRDER

NOTES



- FOR S302, NUMBER IS ONE SERIES OF 52 BARS; LENGTH VARIES FROM 18'-6" TO 44'-0" IN 6" INCREMENTS.
- FOR S304, NUMBER IS ONE SERIES OF 92 BARS; LENGTH VARIES FROM 9'-3" TO 43'-3" IN 8" INCREMENTS.
- FOR S510, NUMBER IS ONE SERIES OF 53 BARS; LENGTH VARIES FROM 18'-9" TO 44'-9" IN 6" INCREMENTS.
- FOR S512, NUMBER IS ONE SERIES OF 53 BARS; LENGTH VARIES FROM 9'-6" TO 44'-2" IN 8" INCREMENTS.
- FOR S602, NUMBER IS FOUR SERIES OF 72 BARS; LENGTH VARIES FROM 2'-8" TO 20'-5" IN 3" INCREMENTS.
- FOR S603, NUMBER IS FOUR SERIES OF 64 BARS; LENGTH VARIES FROM 2'-1 1/2" TO 21'-2" IN 3 1/2" INCREMENTS.
- FOR S604, NUMBER IS FOUR SERIES OF 110 BARS; LENGTH VARIES FROM 2'-6" TO 20'-8" IN 2" INCREMENTS.
- FOR S605, NUMBER IS FOUR SERIES OF 106 BARS; LENGTH VARIES FROM 3'-1 1/2" TO 21'-2" IN 1 1/2" INCREMENTS.

AS BUILT
10-16-13
B. J. L.

TITLE:
**SUPERSTRUCTURE BAR LIST
& ESTIMATED QUANTITIES**



DESIGNED BY: *[Signature]*
CHECKED BY: *[Signature]*
APPROVED BY: *[Signature]*
Sheet No. 27 of 35 Sheets

Bridge No. 02522

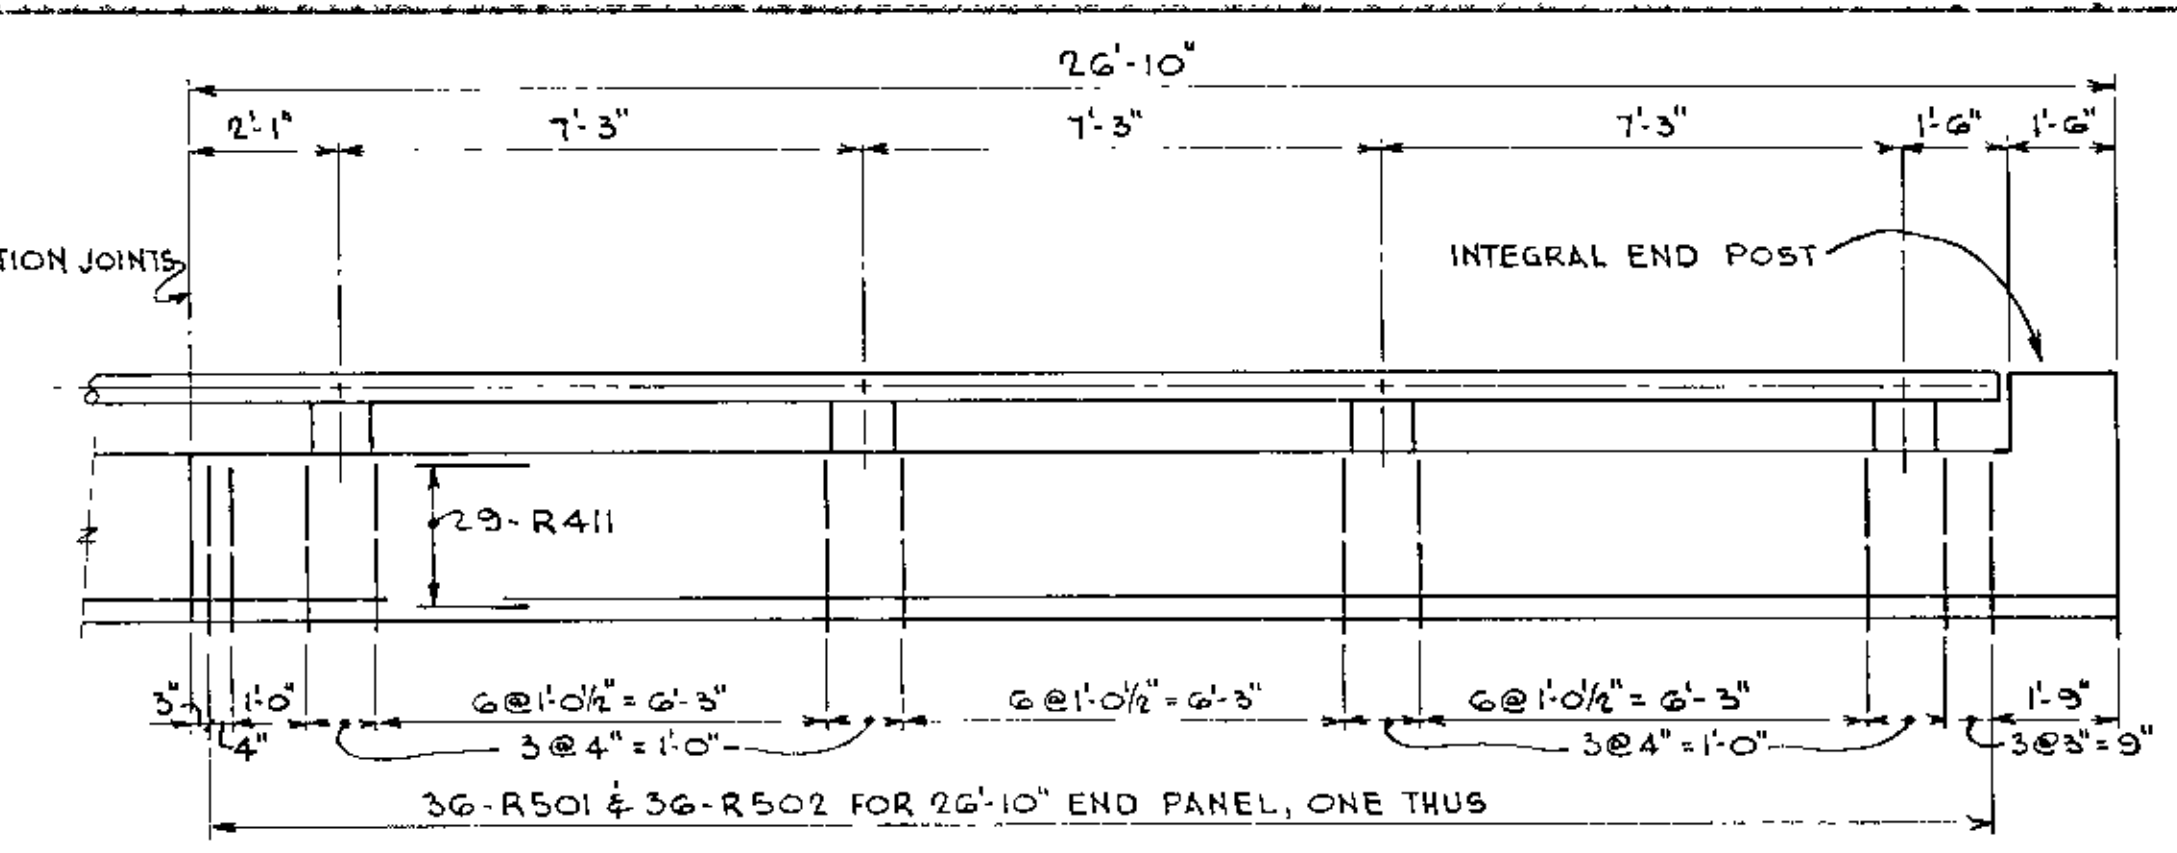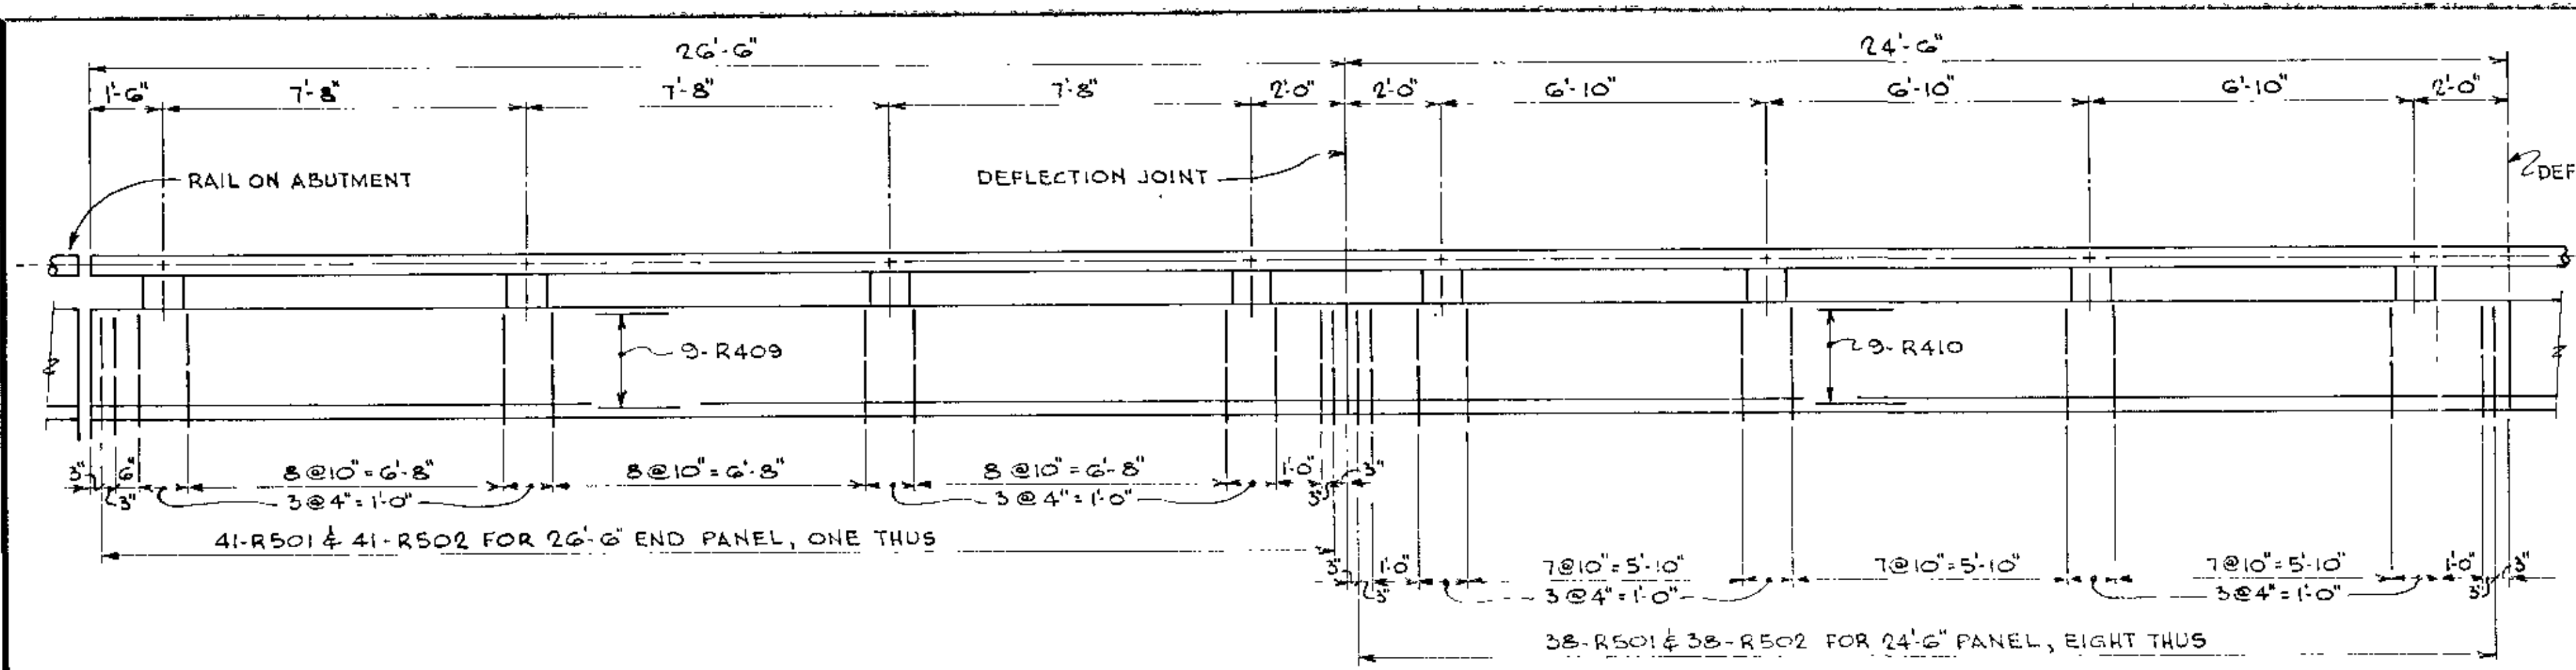


PARTIAL ELEVATION OF NORTH RAILING
(VIEWED TOWARD THE NORTH)
SCALE: 3/8"=1'-0"

- NOTES**
1. R501, R502, R409 THRU R414, ARE ALL INCLUDED IN BAR LIST FOR RAILING, SHEET 28
 2. SEE SECTION A-A, SHEET 28, FOR PLACEMENT OF BARS R501, R502, R409 THRU R414
 3. BARS FOR INTEGRAL END POSTS ARE BILLED ON ELEVATION VIEW AND END VIEW, SHEET 28, AND ARE INCLUDED IN BAR LIST FOR RAILING, SHEET 28.
 4. RAILBASES SHALL NOT BE PLACED UNTIL ENTIRE DECK SLAB HAS BEEN PLACED.

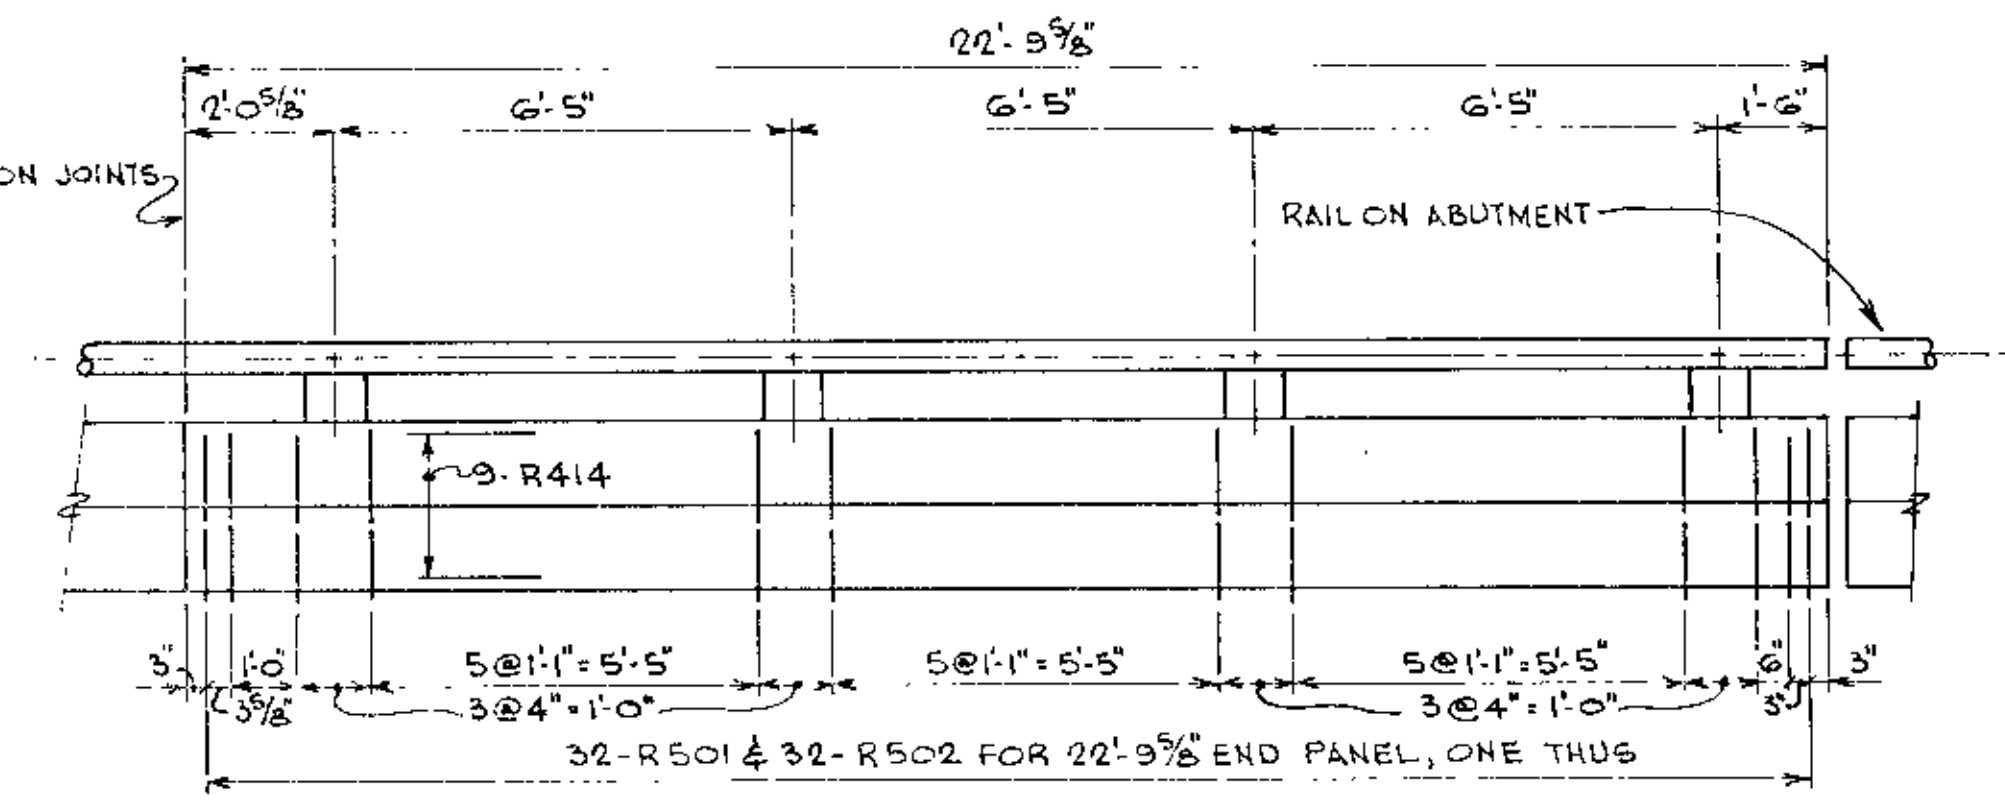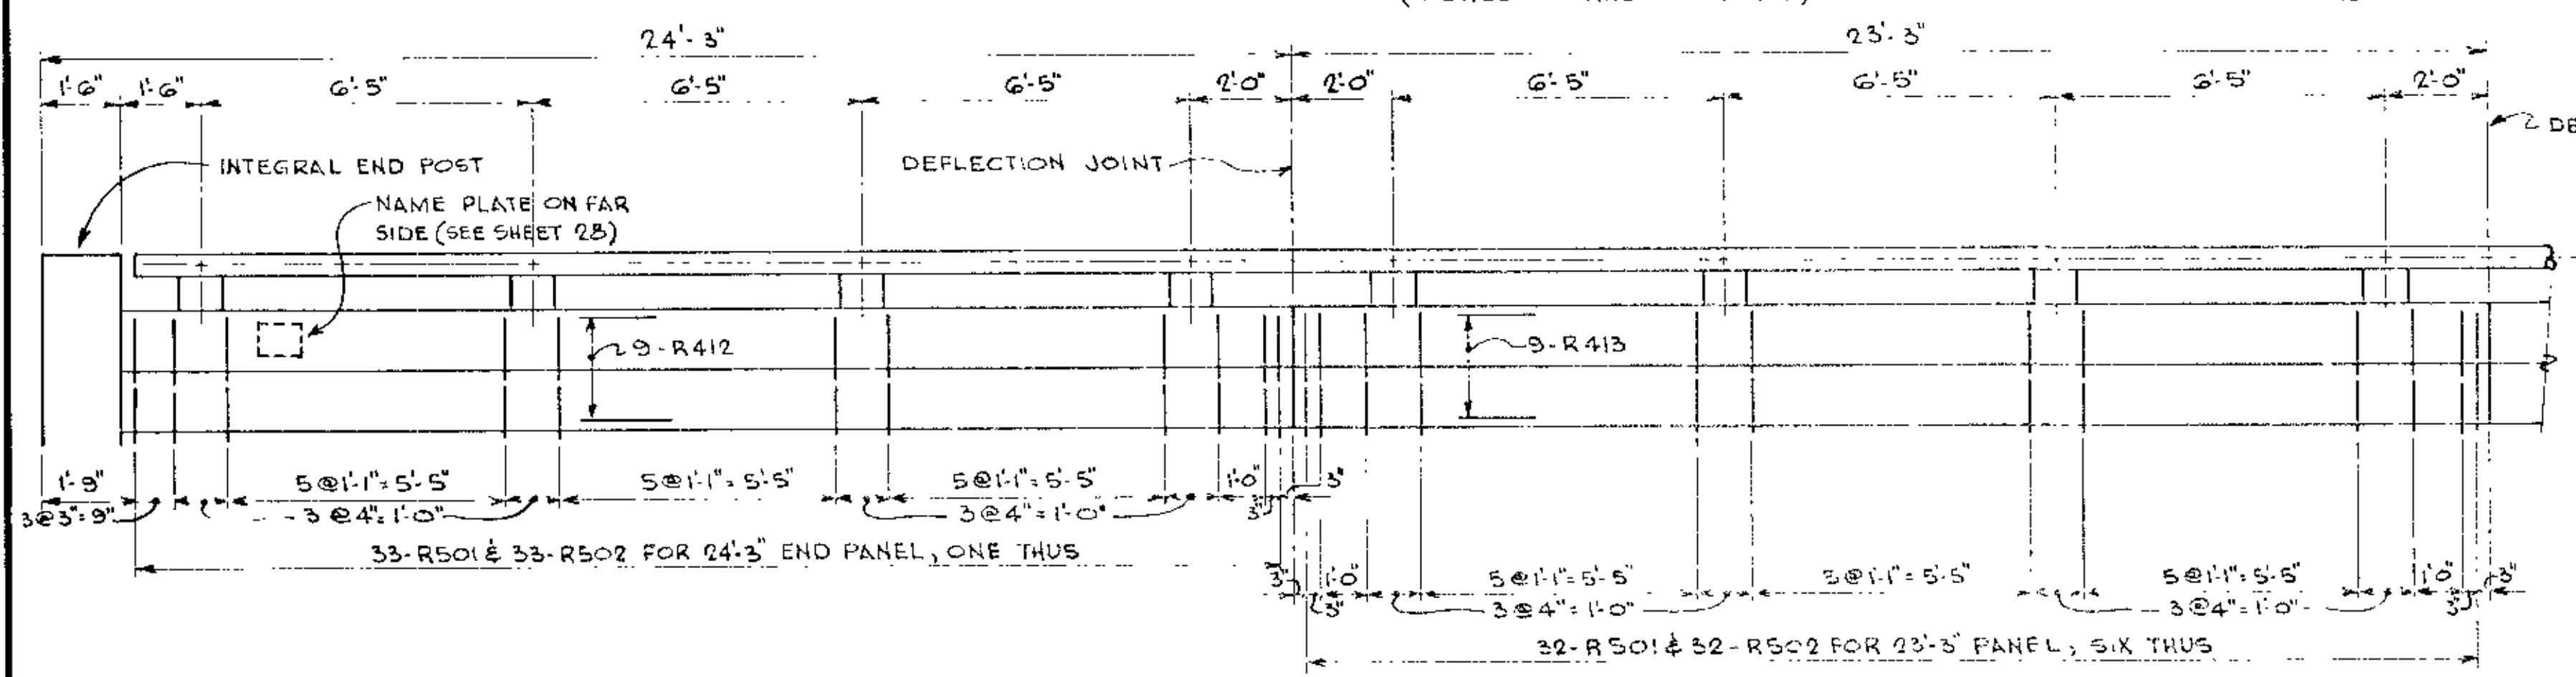



PARTIAL ELEVATION OF SOUTH RAILING
(VIEWED TOWARD THE NORTH)
SCALE: 3/8"=1'-0"

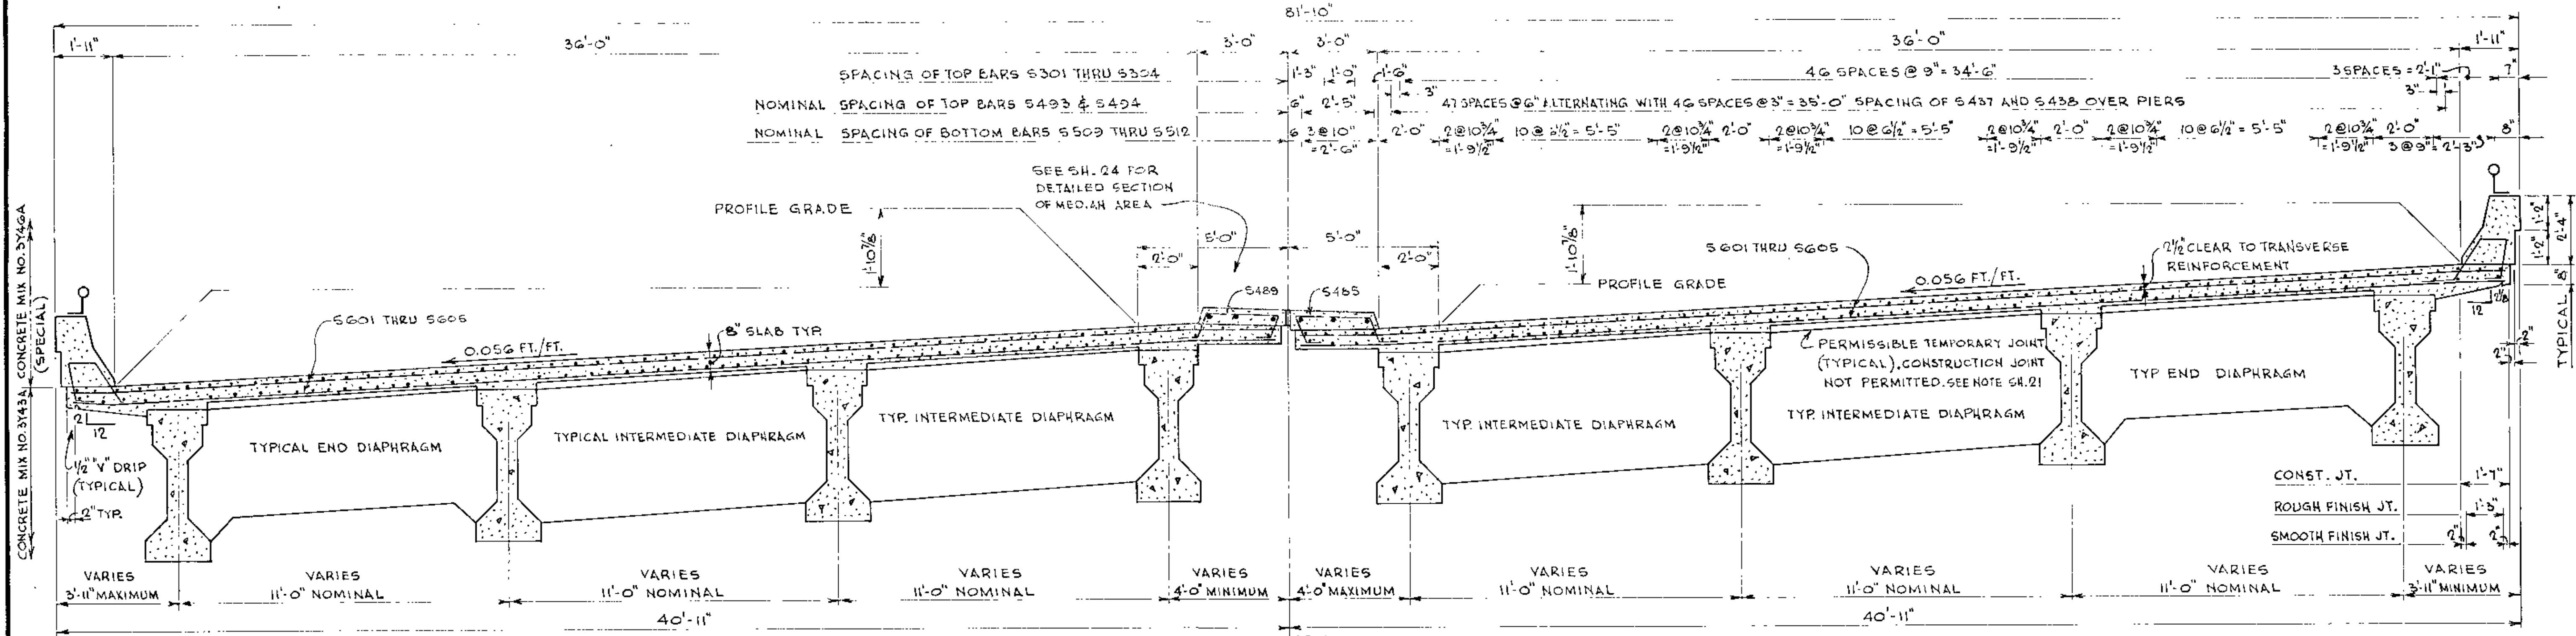

TYPICAL SECTION
SCALE: 3/8"=1'-0"

- NOTES**
1. SEE SECTION ALONG FASCIA GIRDER, SHEET 21, AND TABULATION, SHEET 23, FOR DIAPHRAGM BARS.
 2. ON TYPICAL SECTION, BAR SPACINGS ARE SYMMETRICAL ABOUT ϵ BRIDGE.
 3. WORK THIS SHEET WITH SHEETS 21 THRU 25, 27 AND 28.


DES: <i>RMM</i>	DR: W.K.	APPROVED:	Bridge No.
CHK: <i>MODY</i>	CHK: <i>RMM</i>		02522
AS BUILT 10-16-73 B. Jahn			Sheet No. 26 of 35 Sheets

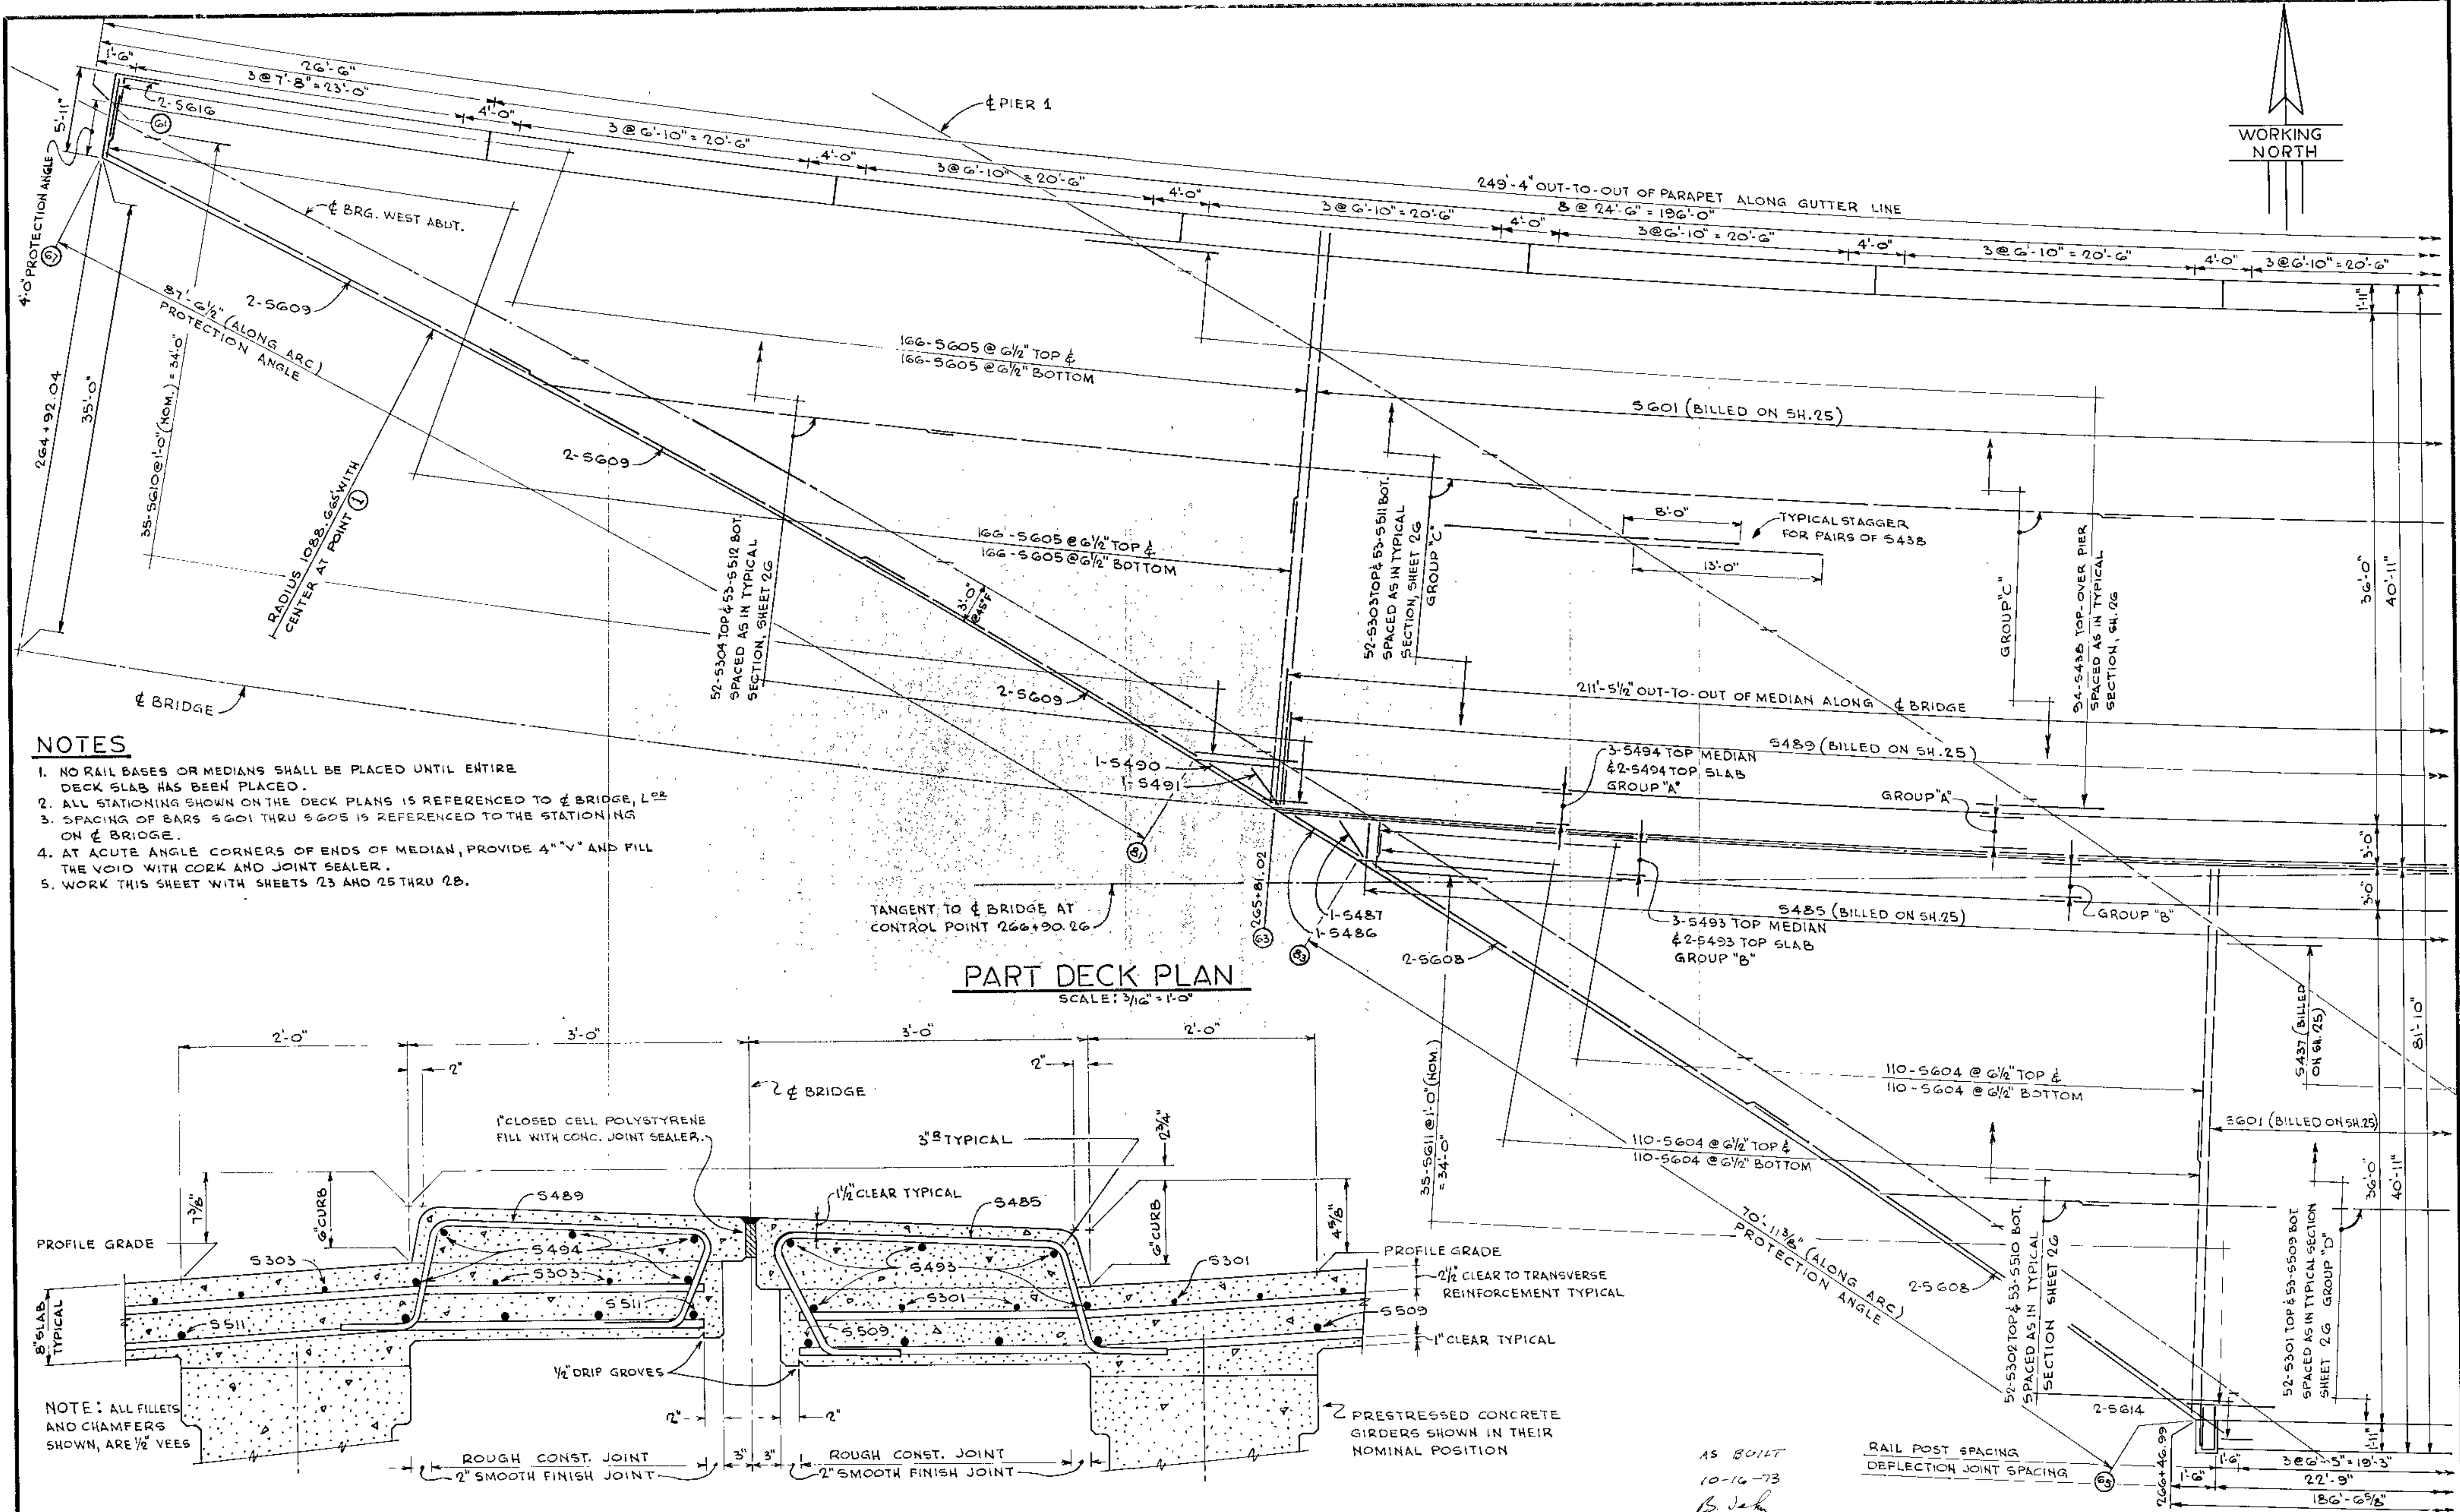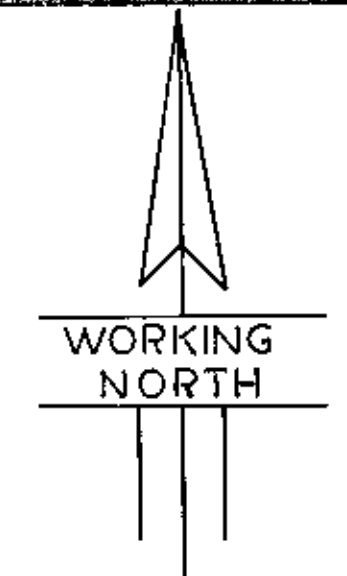

NOTES

1. NO RAIL BASES OR MEDIANS SHALL BE PLACED UNTIL ENTIRE DECK SLAB HAS BEEN PLACED.
2. ALL STATIONING SHOWN ON THE DECK PLANS IS REFERENCED TO ϕ BRIDGE, L².
3. SPACING OF BARS S601 THRU S605 IS REFERENCED TO THE STATIONING ON ϕ BRIDGE.
4. AT ACUTE ANGLE CORNERS OF ENDS OF MEDIAN, PROVIDE 4" V AND FILL THE VOID WITH CORK AND JOINT SEALER.
5. WORK THIS SHEET WITH SHEETS 23 AND 25 THRU 28.

PART DECK PLAN
SCALE: 3/16" = 1'-0"

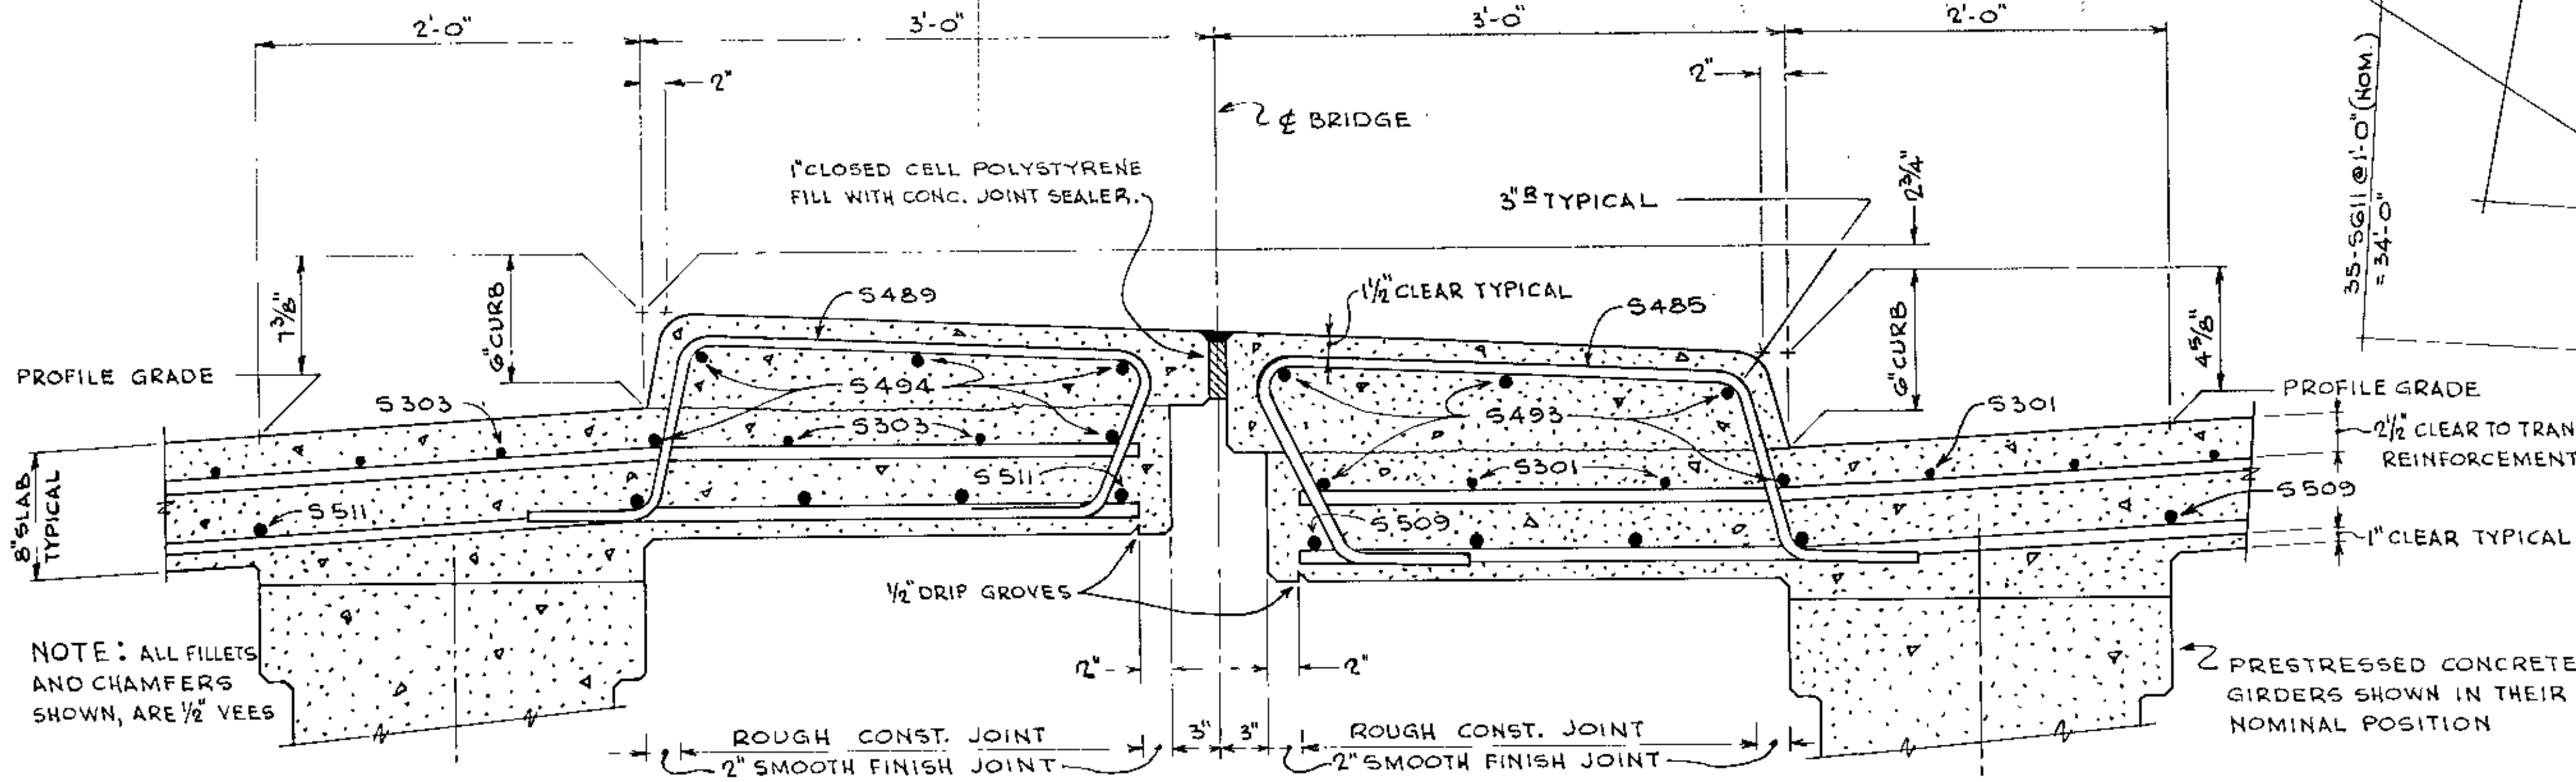

TYPICAL SECTION OF MEDIAN
SCALE: 1/2" = 1'-0"

AS BUILT
10-16-73
B. J. J.


RAIL POST SPACING
DEFLECTION JOINT SPACING

TITLE: **PART DECK PLAN - W.**

DES: R. M. J. CHK: M. O. D. DR: W. K. APPROVED: [Signature]

Sheet No. **24** of 35 Sheets

Bridge No. **02522**


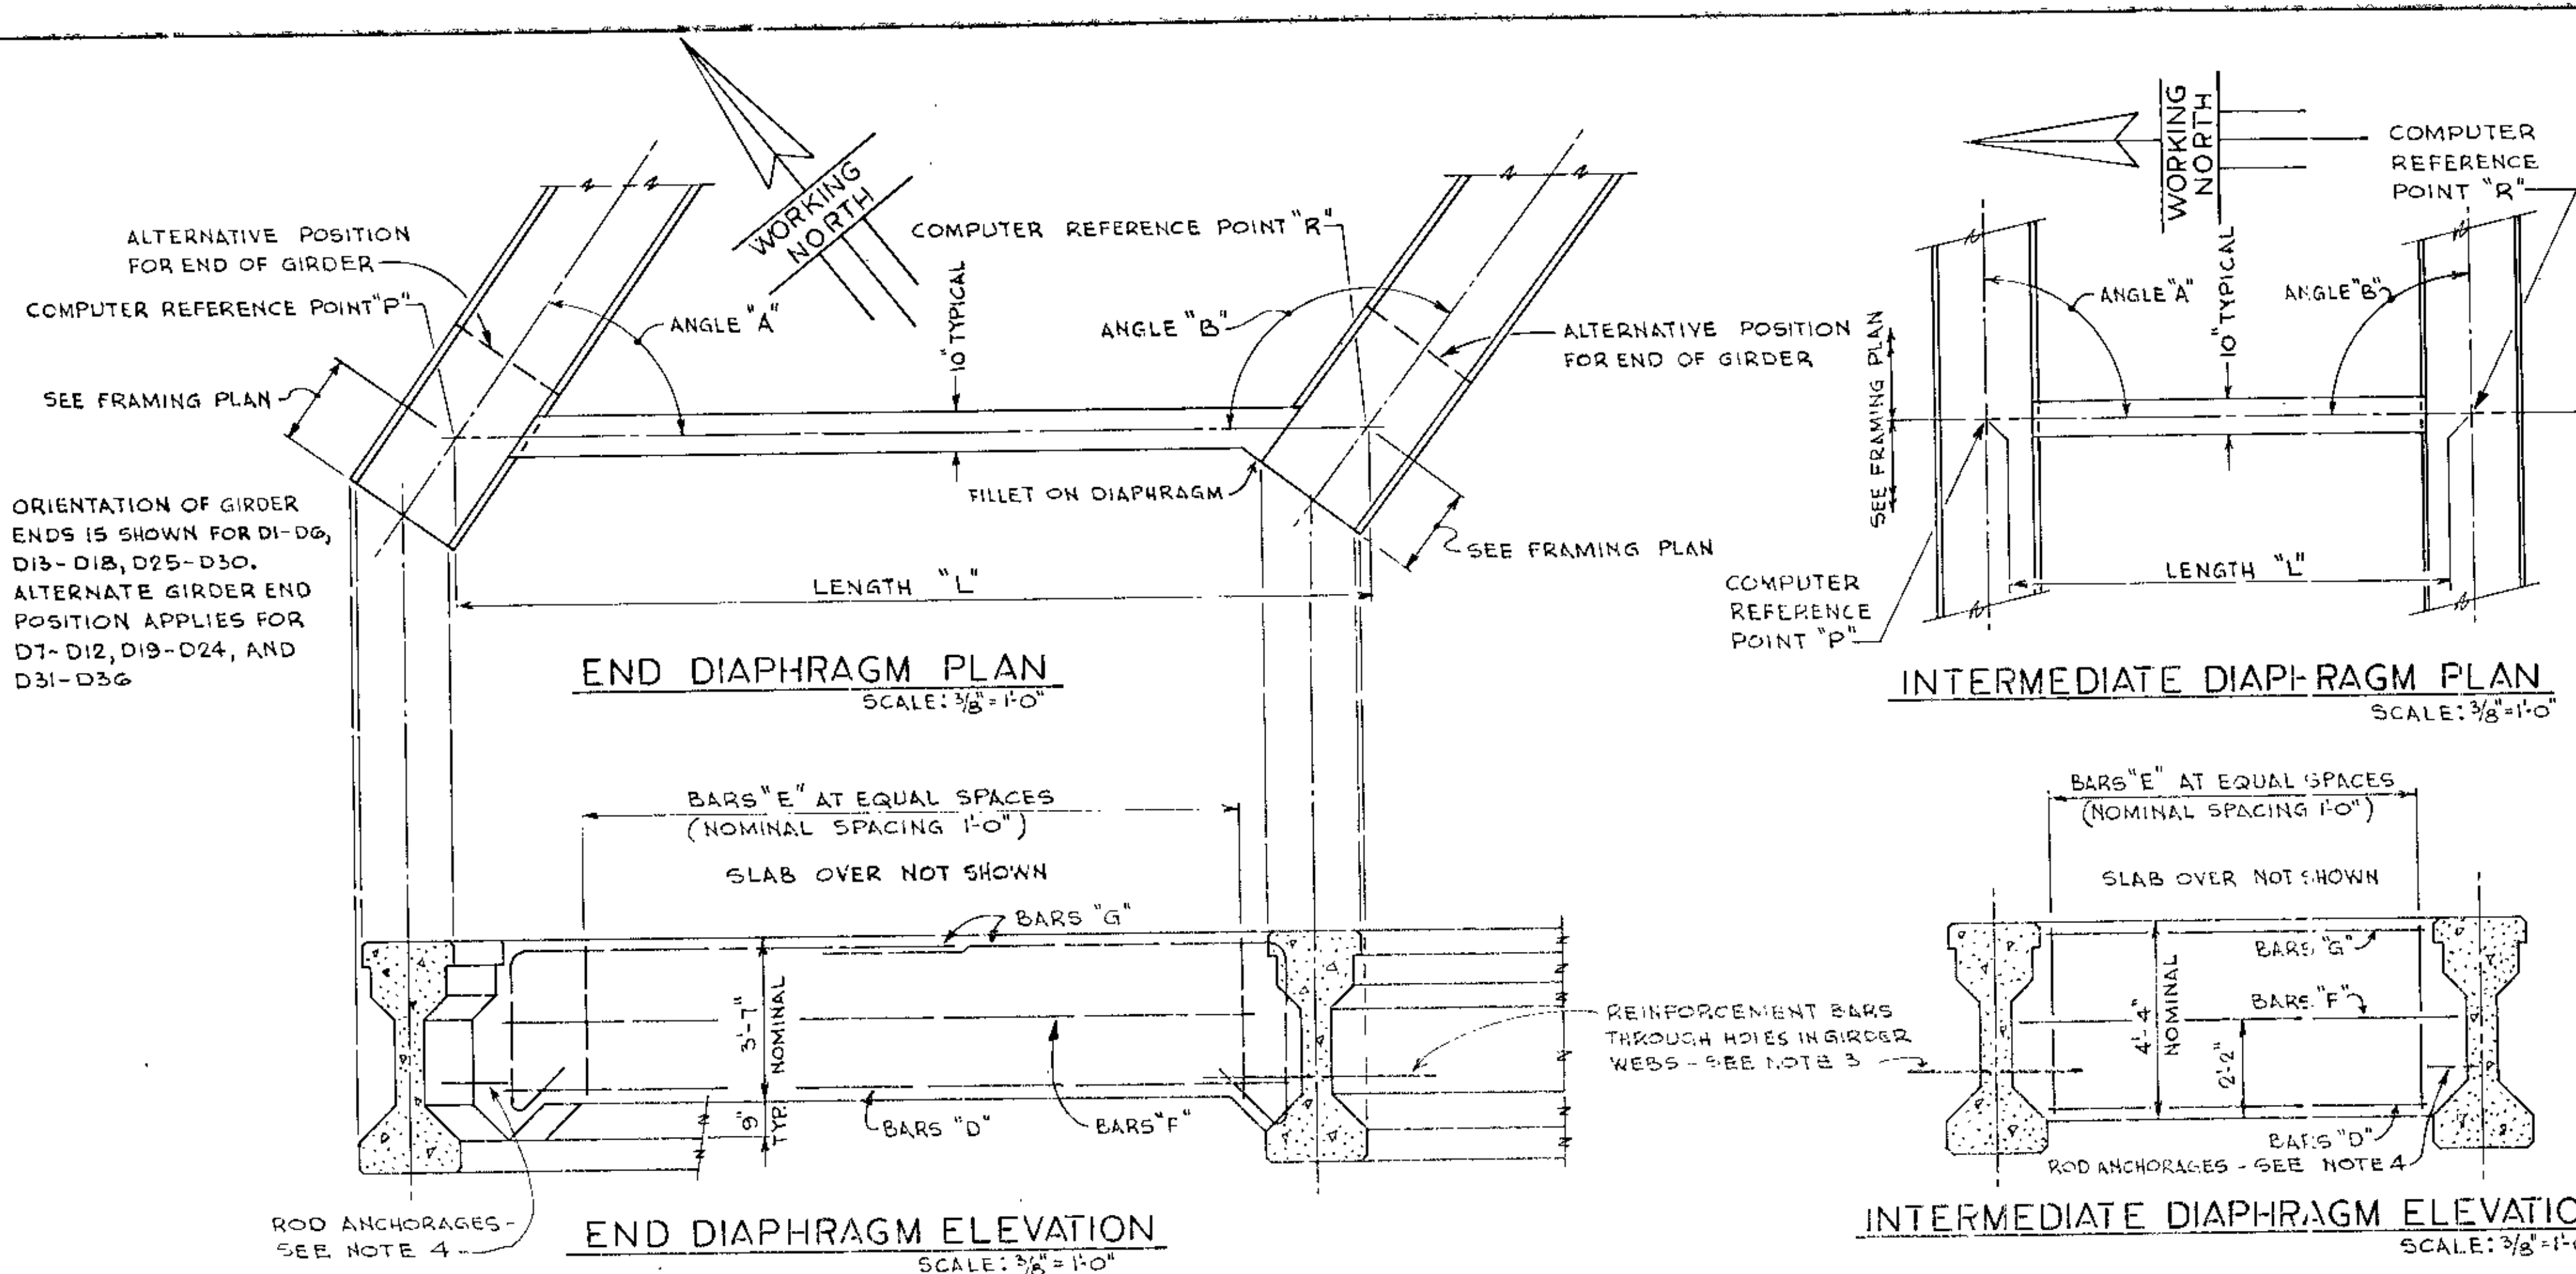


INTERMEDIATE DIAPHRAGM DATA									
DIAPHRAGM MARK	COMP. REF. POINT "P"	COMP. REF. POINT "R"	LENGTH "L"	ANGLE "A"	ANGLE "B"	BAR "D"	BAR "E"	BAR "F"	BAR "G"
D 37	201	206	11'-5 7/8"	90°-00'	88°-36'	2-5835	11-5440	2-5507	2-5483
D 38	202	207	11'-1 3/8"	90°-00'	88°-36'	2-5833	10-5440	2-5502	2-5478
D 39	203	208	10'-8 3/4"	90°-00'	88°-36'	2-5830	10-5440	2-5502	2-5478
D 40	208	209	11'-3 3/8"	91°-24'	87°-24'	2-5834	11-5440	2-5506	2-5482
D 41	204	210	10'-9 1/2"	90°-00'	88°-48'	2-5831	10-5440	2-5502	2-5478
D 42	210	211	11'-2 3/8"	91°-12'	87°-44'	2-5833	11-5440	2-5505	2-5481
D 43	205	212	10'-9 3/8"	90°-00'	88°-56'	2-5831	10-5440	2-5503	2-5479
D 44	217	213	11'-2 1/8"	89°-07'	90°-00'	2-5833	11-5440	2-5505	2-5481
D 45	218	219	10'-10 3/4"	90°-16'	90°-00'	2-5831	10-5440	2-5503	2-5479
D 46	219	214	11'-1 3/4"	89°-10'	90°-00'	2-5833	10-5440	2-5505	2-5481
D 47	220	221	10'-11 1/8"	88°-25'	90°-46'	2-5832	10-5440	2-5504	2-5480
D 48	221	215	11'-1 3/4"	89°-14'	90°-00'	2-5833	10-5440	2-5506	2-5482
D 49	222	216	10'-10 7/8"	89°-14'	90°-00'	2-5831	10-5440	2-5503	2-5479
D 50	223	220	11'-9"	90°-00'	88°-01'	2-5836	11-5440	2-5508	2-5484
D 51	224	231	11'-4 3/4"	90°-00'	88°-01'	2-5831	11-5440	2-5502	2-5478
D 52	231	235	11'-7 1/2"	90°-59'	88°-08'	2-5836	11-5440	2-5508	2-5484
D 53	225	232	11'-1"	90°-00'	88°-01'	2-5832	10-5440	2-5504	2-5480
D 54	232	236	11'-4 1/8"	90°-59'	88°-08'	2-5834	11-5440	2-5506	2-5482
D 55	236	240	11'-6 5/8"	91°-52'	87°-19'	2-5835	11-5440	2-5507	2-5483
D 56	226	233	10'-9 3/8"	90°-00'	89°-01'	2-5831	10-5440	2-5503	2-5479
D 57	233	237	11'-1"	90°-59'	88°-08'	2-5832	10-5440	2-5504	2-5480
D 58	237	241	11'-3 3/4"	91°-52'	87°-19'	2-5834	11-5440	2-5506	2-5482
D 59	227	234	10'-6"	90°-00'	88°-01'	2-5829	10-5440	2-5501	2-5477
D 60	234	238	10'-9 3/4"	90°-59'	88°-08'	2-5831	10-5440	2-5503	2-5479
D 61	238	242	11'-0 3/4"	91°-52'	87°-19'	2-5832	10-5440	2-5504	2-5480
D 62	228	239	10'-6 3/8"	90°-00'	89°-07'	2-5829	10-5440	2-5501	2-5477
D 63	239	243	10'-9 3/8"	90°-59'	88°-18'	2-5831	10-5440	2-5503	2-5479
D 64	229	244	10'-7 3/8"	90°-00'	89°-11'	2-5830	10-5440	2-5502	2-5478
D 65	250	245	11'-4 1/8"	89°-17'	90°-00'	2-5834	11-5440	2-5506	2-5482
D 66	251	252	11'-2 1/4"	88°-37'	90°-40'	2-5833	11-5440	2-5505	2-5481
D 67	252	246	11'-4"	89°-20'	90°-00'	2-5834	11-5440	2-5506	2-5482
D 68	253	254	10'-11 5/8"	87°-59'	91°-18'	2-5832	10-5440	2-5504	2-5480
D 69	254	255	11'-1 1/2"	88°-42'	90°-38'	2-5833	10-5440	2-5505	2-5481
D 70	255	247	11'-3"	89°-22'	90°-00'	2-5833	11-5440	2-5505	2-5481
D 71	256	257	10'-8 5/8"	87°-59'	91°-18'	2-5830	10-5440	2-5502	2-5478
D 72	257	258	10'-10 5/8"	88°-42'	90°-38'	2-5831	10-5440	2-5503	2-5479
D 73	258	248	11'-0 3/8"	89°-22'	90°-00'	2-5832	10-5440	2-5504	2-5480
D 74	259	249	10'-9 3/4"	89°-22'	90°-00'	2-5831	10-5440	2-5503	2-5479
D 75	260	265	11'-3 3/8"	90°-00'	89°-17'	2-5834	11-5440	2-5506	2-5482
D 76	261	266	11'-1 1/4"	90°-00'	89°-17'	2-5833	10-5440	2-5505	2-5481
D 77	266	267	11'-3"	90°-43'	88°-37'	2-5834	11-5440	2-5506	2-5482
D 78	262	268	10'-11 1/4"	90°-00'	89°-17'	2-5832	10-5440	2-5504	2-5480
D 79	268	269	11'-1 1/8"	90°-43'	88°-37'	2-5833	10-5440	2-5505	2-5481
D 80	269	270	11'-2 7/8"	91°-23'	87°-59'	2-5833	11-5440	2-5505	2-5481
D 81	263	271	10'-9"	90°-00'	89°-17'	2-5830	10-5440	2-5502	2-5478
D 82	271	272	10'-11 1/8"	90°-43'	88°-37'	2-5832	10-5440	2-5504	2-5480
D 83	272	273	11'-0 7/8"	91°-23'	87°-59'	2-5832	10-5440	2-5504	2-5480
D 84	264	274	10'-10 1/2"	90°-00'	89°-22'	2-5831	10-5440	2-5503	2-5479
D 85	279	275	11'-2"	89°-26'	90°-00'	2-5833	10-5440	2-5505	2-5481
D 86	280	281	10'-11 7/8"	88°-23'	91°-03'	2-5832	10-5440	2-5504	2-5480
D 87	281	282	11'-1"	88°-57'	90°-31'	2-5832	10-5440	2-5504	2-5480
D 88	282	276	11'-2 1/8"	89°-29'	90°-00'	2-5833	11-5440	2-5505	2-5481
D 89	283	284	10'-9 3/4"	88°-23'	91°-03'	2-5831	10-5440	2-5503	2-5479
D 90	284	285	10'-11 1/2"	88°-57'	90°-31'	2-5832	10-5440	2-5504	2-5480
D 91	285	277	11'-0 1/4"	89°-29'	90°-00'	2-5832	10-5440	2-5504	2-5480
D 92	286	278	10'-10 1/2"	89°-29'	90°-00'	2-5831	10-5440	2-5503	2-5479

END DIAPHRAGM DATA									
DIAPHRAGM MARK	COMP. REF. POINT "P"	COMP. REF. POINT "R"	LENGTH "L"	ANGLE "A"	ANGLE "B"	BAR "D"	BAR "E"	BAR "F"	BAR "G"
D 1	101	102	33'-7 1/8"	20°-04'	158°-32'	2-51001	25-5439	2-5401	4-5441
D 2	102	103	29'-0 3/8"	23°-06'	155°-41'	2-51002	21-5439	2-5402	4-5442
D 3	103	104	26'-0 7/8"	25°-46'	153°-10'	2-5901	19-5439	2-5403	4-5443
D 4	105	106	22'-7 3/4"	29°-47'	149°-19'	2-5902	17-5439	2-5404	4-5444
D 5	106	107	21'-3 3/8"	31°-50'	147°-20'	2-5801	16-5439	2-5405	4-5445
D 6	107	108	20'-1 3/4"	33°-45'	145°-29'	2-5802	15-5439	2-5406	4-5446
D 7	111	112	25'-2 7/8"	23°-38'	154°-58'	2-5903	18-5439	2-5407	4-5447
D 8	112	113	23'-3 1/2"	26°-16'	152°-32'	2-5904	18-5439	2-5408	4-5448
D 9	113	114	21'-9 1/2"	28°-36'	150°-20'	2-5803	16-5439	2-5409	4-5449
D 10	115	116	19'-10"	32°-10'	146°-56'	2-5804	15-5439	2-5410	4-5450
D 11	116	117	18'-11 1/2"	34°-03'	145°-08'	2-5805	14-5439	2-5411	4-5451
D 12	117	118	18'-2 5/8"	35°-49'	143°-25'	2-5806	14-5439	2-5412	4-5452
D 13	121	122	25'-2 1/8"	27°-56'	151°-06'	2-5905	19-5439	2-5413	4-5453
D 14	122	123	23'-2 3/4"	30°-09'	148°-58'	2-5906	18-5439	2-5414	4-5454
D 15	123	124	21'-5 3/4"	32°-12'	146°-59'	2-5807	16-5439	2-5415	4-5455
D 16	125	126	19'-9 1/2"	35°-26'	143°-51'	2-5808	15-5439	2-5416	4-5456
D 17	126	127	18'-11"	37°-09'	142°-11'	2-5809	14-5439	2-5417	4-5457
D 18	127	128	18'-2 1/8"	38°-46'	140°-36'	2-5810	14-5439	2-5418	4-5458
D 19	131	132	18'-11 1/8"	32°-36'	146°-26'	2-5811	14-5439	2-5419	4-5459
D 20	132	133	18'-2 3/8"	34°-28'	144°-38'	2-5812	14-5439	2-5420	4-5460
D 21	133	134	17'-6 3/4"	36°-14'	142°-57'	2-5813	13-5439	2-5421	4-5461
D 22	135	136	16'-7 3/4"	39°-01'	140°-16'	2-5814	13-5439	2-5422	4-5462
D 23	136	137	16'-2 3/8"	40°-32'	138°-48'	2-5815	12-5439	2-5423	4-5463
D 24	137	138	15'-9 3/8"	41°-59'	137°-24'	2-5816	12-5439	2-5424	4-5464
D 25	141	142	18'-10 1/2"	36°-48'	142°-29'	2-5817	14-5439	2-5425	4-5465
D 26	142	143	18'-13 1/4"	38°-26'	140°-54'	2-5818	14-5439	2-5426	4-5466
D 27	143	144	17'-6 1/4"	39°-59'	139°-23'	2-5819	13-5439	2-5427	4-5467
D 28	145	146	16'-7 3/8"	42°-31'	136°-55'	2-5820	13-5439	2-5428	4-5468
D 29	146	147	16'-2"	43°-53'	135°-34'	2-5821	12-5439	2-5429	4-5469
D 30	147	148	15'-9 1/4"	45°-13'	134°-17'	2-5822	12-5439	2-5430	4-5470
D 31	151	152	16'-8"	39°-20'	139°-56'	2-5823	13-5439	2-5431	4-5471
D 32	152	153	16'-2 5/8"	40°-50'	138°-30'	2-5824	12-5439	2-5432	4-5472
D 33	153	154	15'-9 1/8"	42°-16'	137°-06'	2-5825	12-5439	2-5433	4-5473
D 34	155	156	15'-2 3/8"	44°-35'	134°-50'	2-5826	11-5439	2-5434	4-5474
D 35	156	157	14'-11"	45°-52'	133°-35'	2-5827	11-5439	2-5435	4-5475
D 36	157	158	14'-7 3/4"	47°-07'	132°-23'	2-5828	11-5439	2-5436	4-5476

NOTES:

1. WORK THIS SHEET WITH SHEETS 21 AND 22
2. ALL REINFORCEMENT NOTED IN THESE TABLES IS INCLUDED IN BAR LIST ON SHEET 27.
3. REINFORCEMENT BARS THROUGH HOLES IN GIRDER WEBS ARE BILLED ON SHEETS 21 & 22. THEY ARE PREFIXED "T" AND ARE INCLUDED IN BAR LIST FOR SUPERSTRUCTURE, SH. 27.
4. ROD ANCHORAGES IN FACIA GIRDERS AND AT NON-CONTINUOUS DIAPHRAGMS IN INTERIOR GIRDERS, ARE DETAILED ON SHEETS 13 THRU 20, AND ARE BILLED ON SHEETS 21 & 22.

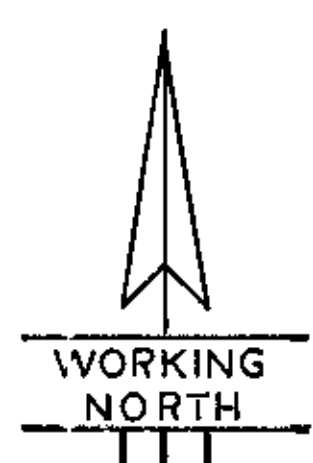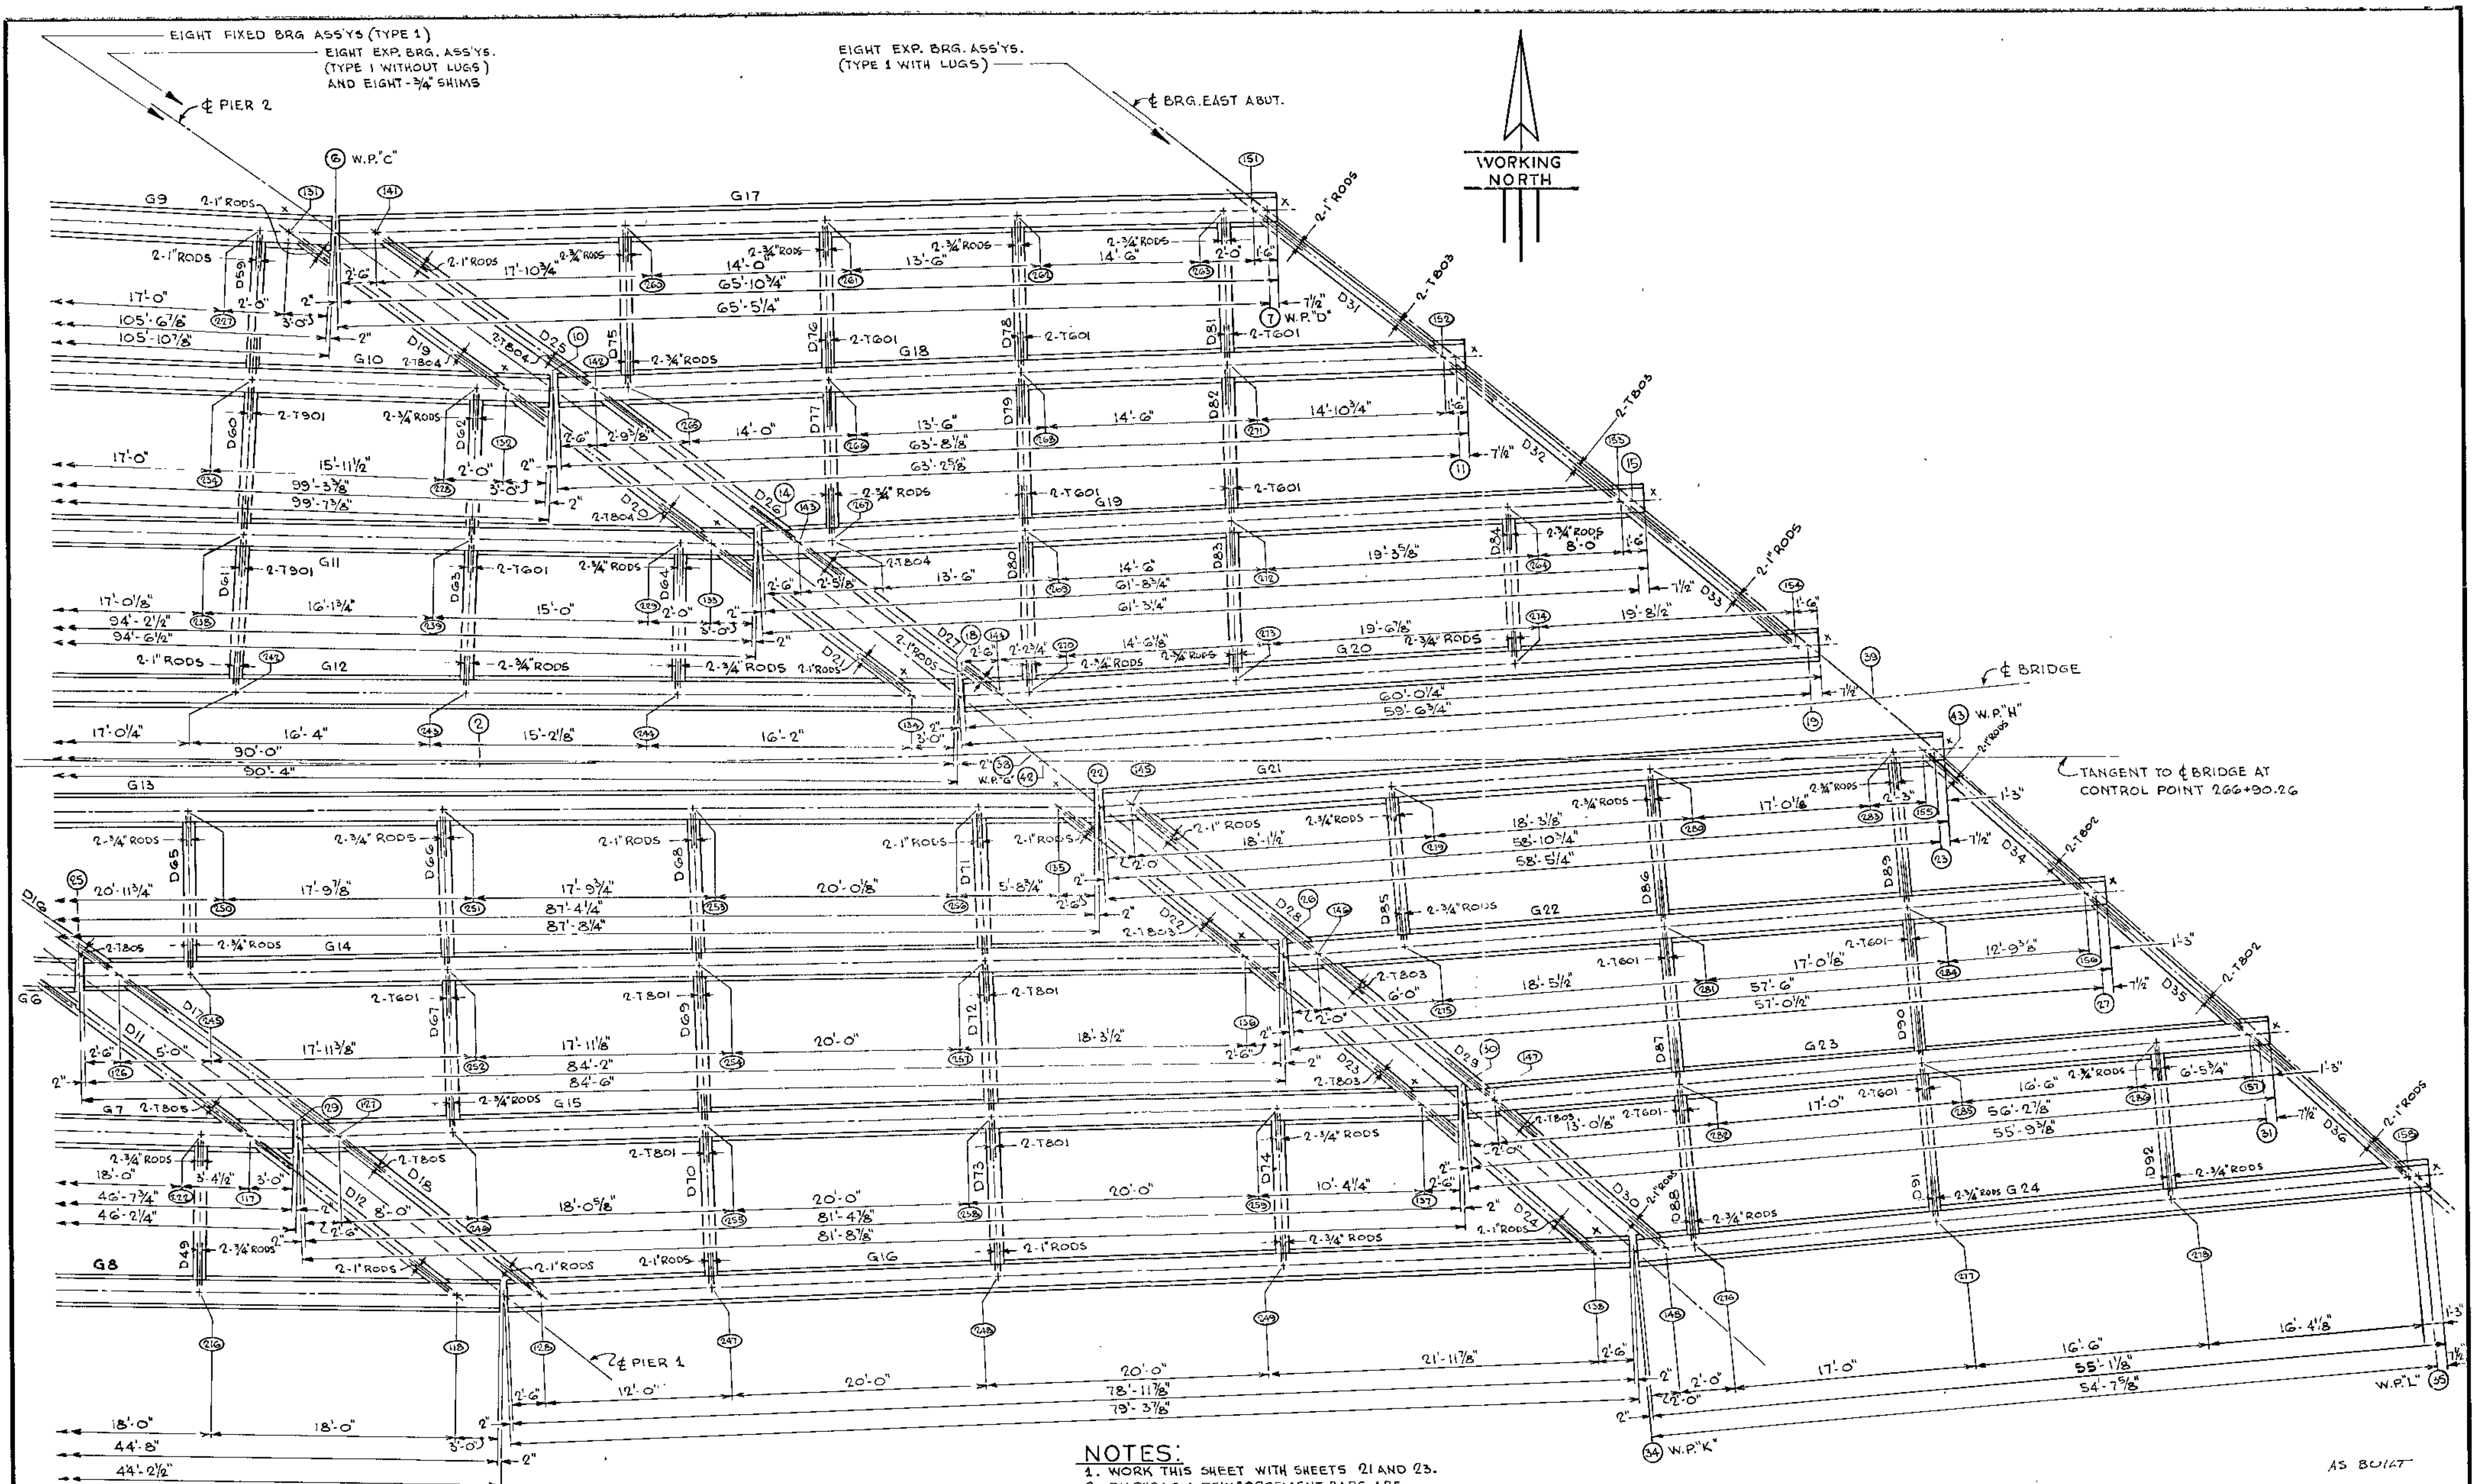

PART FRAMING PLAN
SCALE: 3/16" = 1'-0"

- NOTES:**
1. WORK THIS SHEET WITH SHEETS 21 AND 23.
 2. DIAPHRAGM REINFORCEMENT BARS ARE INCLUDED IN BAR LIST ON SHEET 27.
 3. ALL DIMENSIONS ON THIS PLAN ARE HORIZONTAL. SEE SHEETS 13 THRU 20 FOR TRUE LENGTHS OF GIRDERS ALONG SLOPE.
 4. THE "T" SERIES OF REINFORCEMENT BARS ARE DIAPHRAGM BARS THRU GIRDER WEBS, AND ARE INCLUDED IN BAR LIST FOR SUPERSTRUCTURE, SH. 27



TITLE: **PART FRAMING PLAN-E.**

DES: *[Signature]* DR. W. K. APPROVED:
 CHK: *[Signature]* MODY CHK: *[Signature]*

AS BUILT
 10-16-73
 B. J. [Signature]


Sheet No. 22 of 35 Sheets

Bridge No. 02522

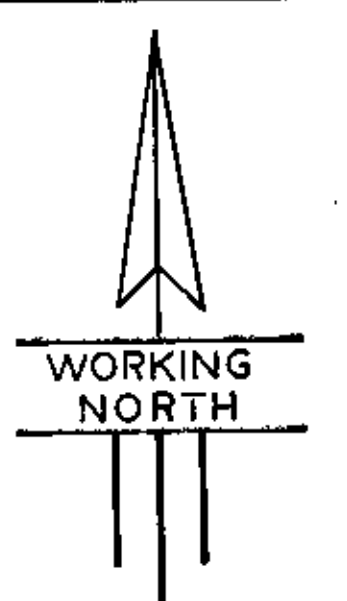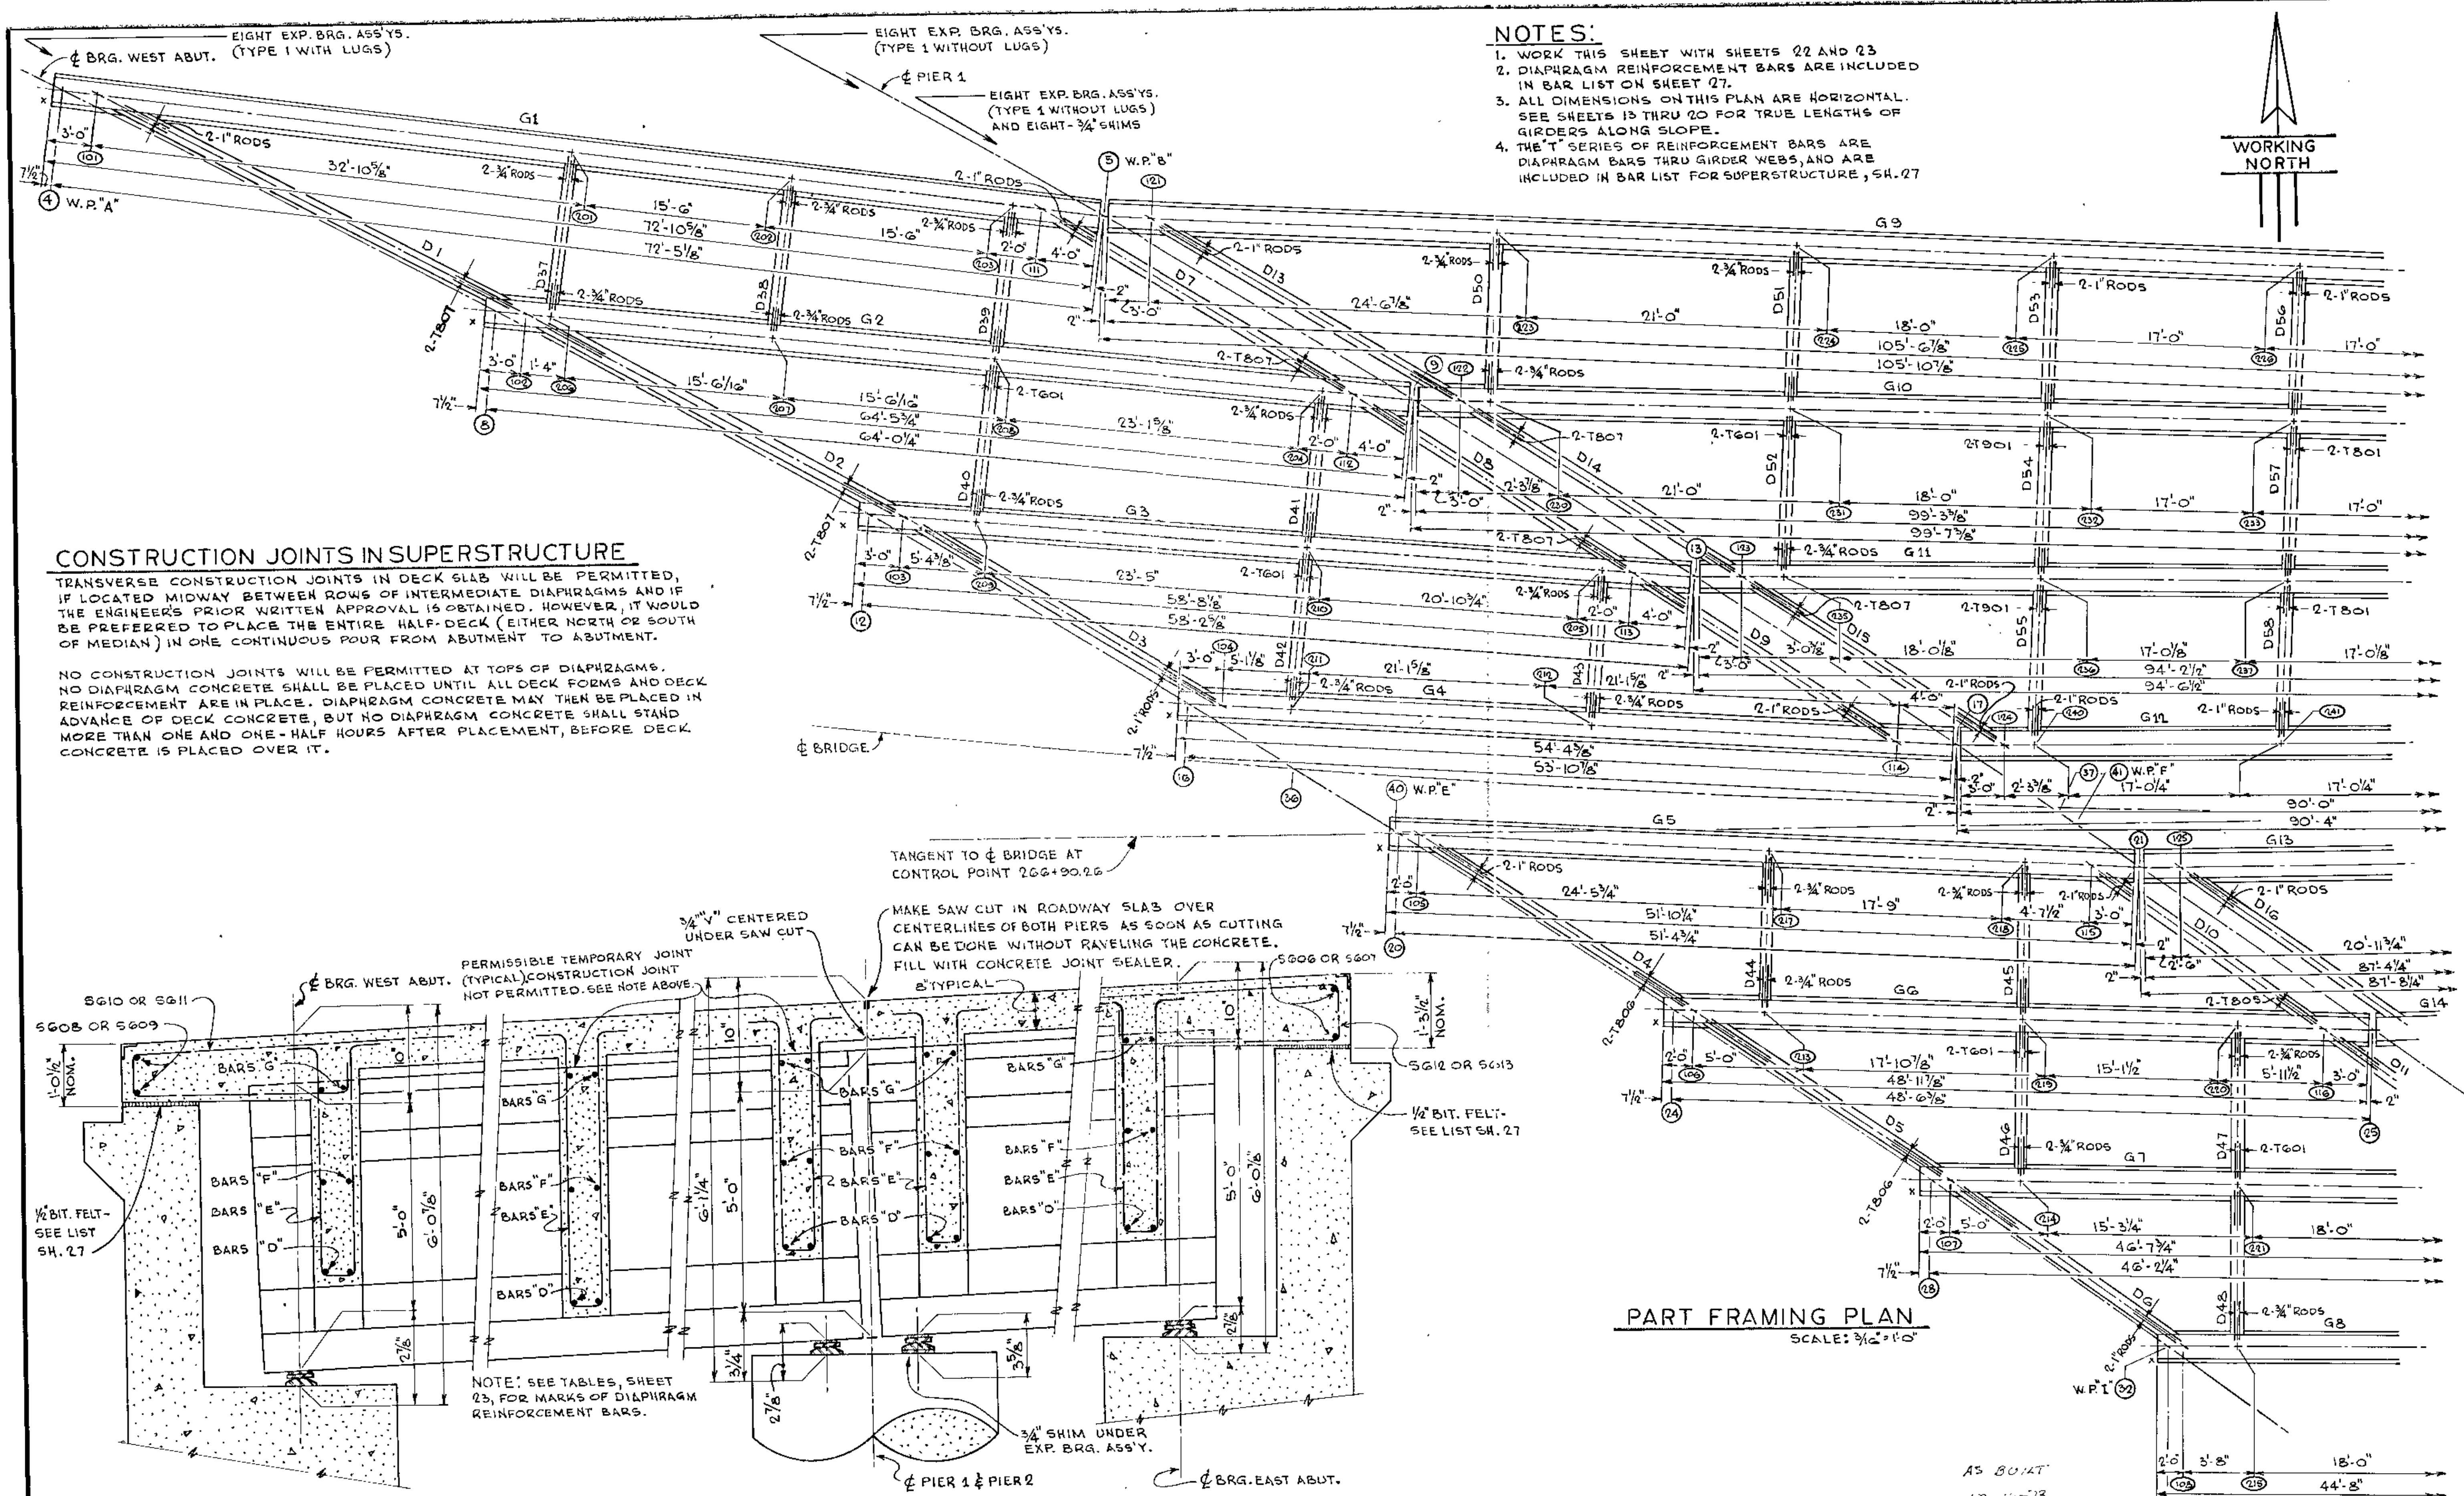

TITLE:	DES: <i>RM</i>	DR: W.K.	APPROVED:	Bridge No.
PART FRAMING PLAN - W	CHK: <i>MODY</i>	CHK: <i>RM</i>		02522
	Sheet No. 21	of 35 Sheets		

PROJECT NUMBER: P. 101
 DATE: 10-11-73
 B. Jahn

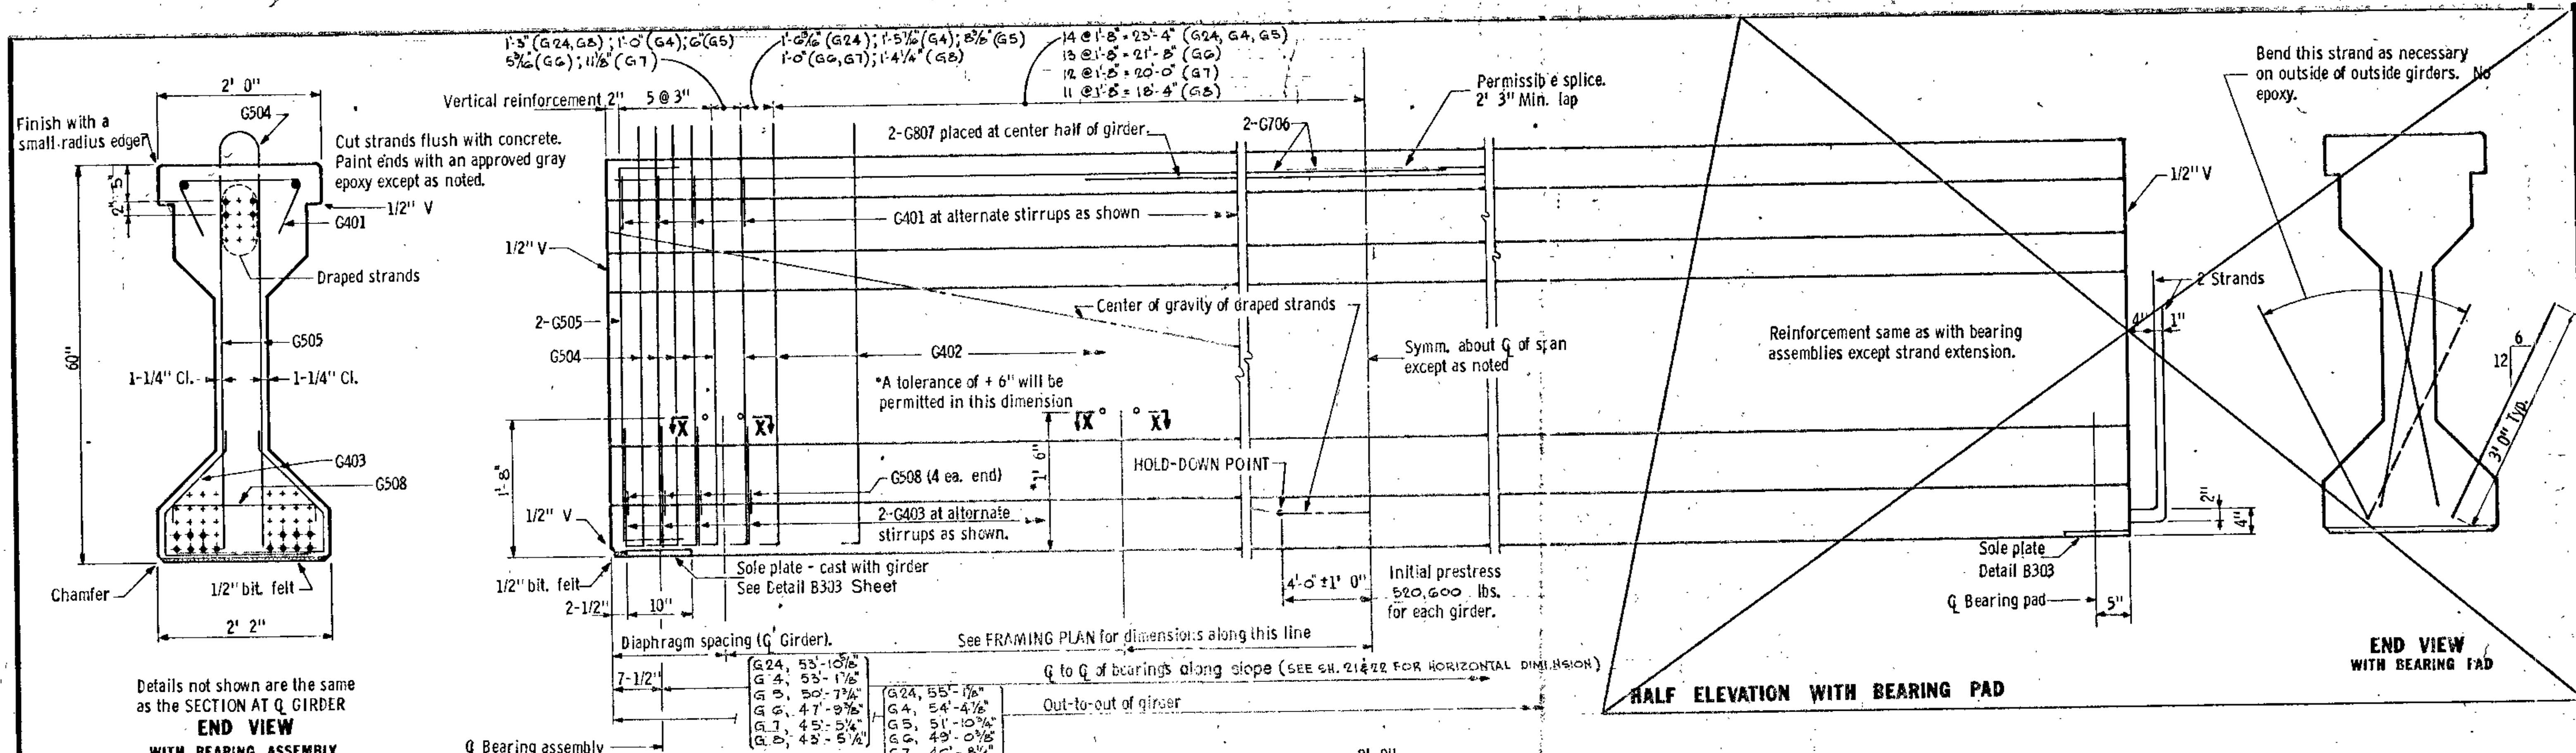

MINIMUM CONCRETE STRENGTH - P.S.I.

	①	③	f'cl	②	③	f'c
Computed Min. Concrete Strength	2080	2300				
Required Min. Concrete Strength	4500	5000				

① Minimum concrete strength at time of prestress transfer.
 ② Minimum concrete strength when curing can be discontinued and girder transported and installed.
 ③ Required minimum concrete strength shall be used. Computed minimum concrete strength is for information only.

Fig. 5-397.506
Oct. 15, 1969

Bridge No. 02522

DESIGNED BY: M.H.D./W.K. APPROVED: 12-21-71

CHKD BY: M.D.K. CHKD BY: M.H.D.

60" PRESTRESSED CONCRETE GIRDER (PRETENSIONED) TYPE 60-51

Sheet No. 20 of 35 Sheets

Y DISTANCES (IN INCHES)

	NO.	Q SPAN	END
Straight strands	14	2.80'	
Draped strands	4	6.00'	54.00"
Total strands	18	3.50'	

v = distance of Center of Gravity of strands from bottom of girder. All strands spaced 2" c-c, horizontally and vertically.







All strands 1/2" φ 270 kip, ultimate strength.


*A tolerance of ± 2" will be permitted in this dimension.

First digit of bar mark indicates bar size. AS BUILT 10-16-73 B. Jahn

GIRDERS G24, G4, G5, G6, G7, G8




60" PRESTRESSED CONCRETE GIRDER (PRETENSIONED) TYPE 60-51

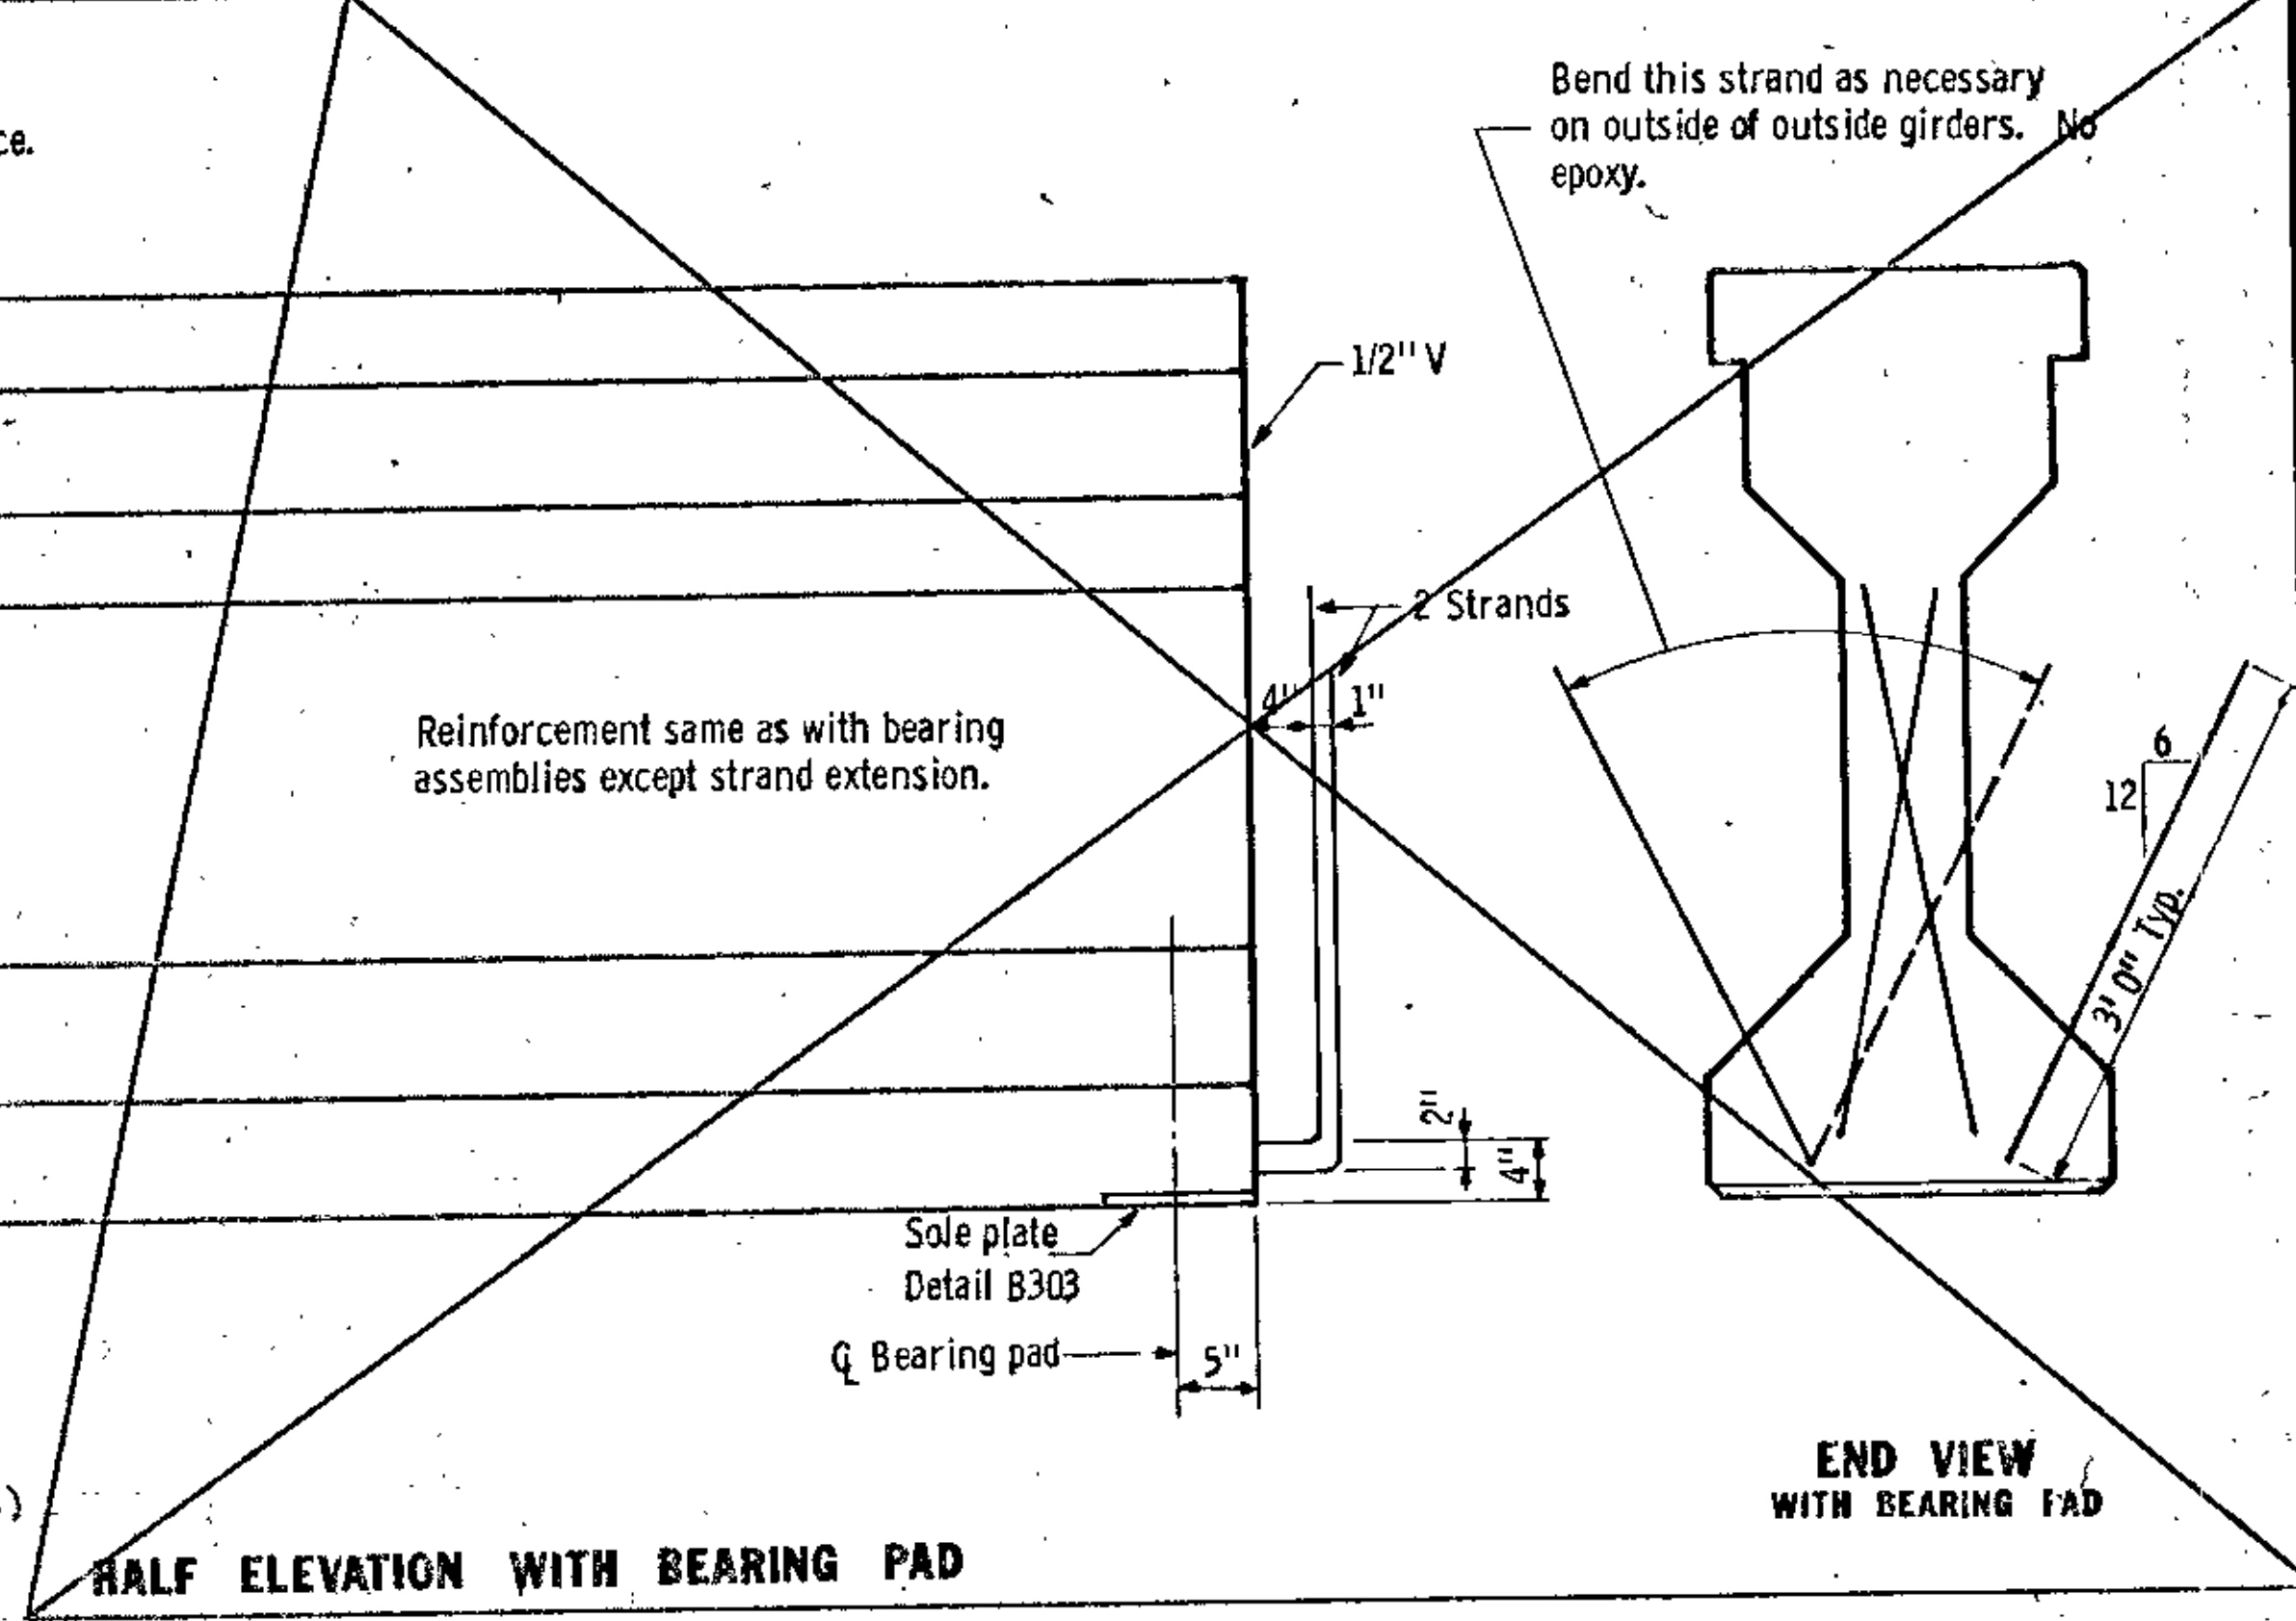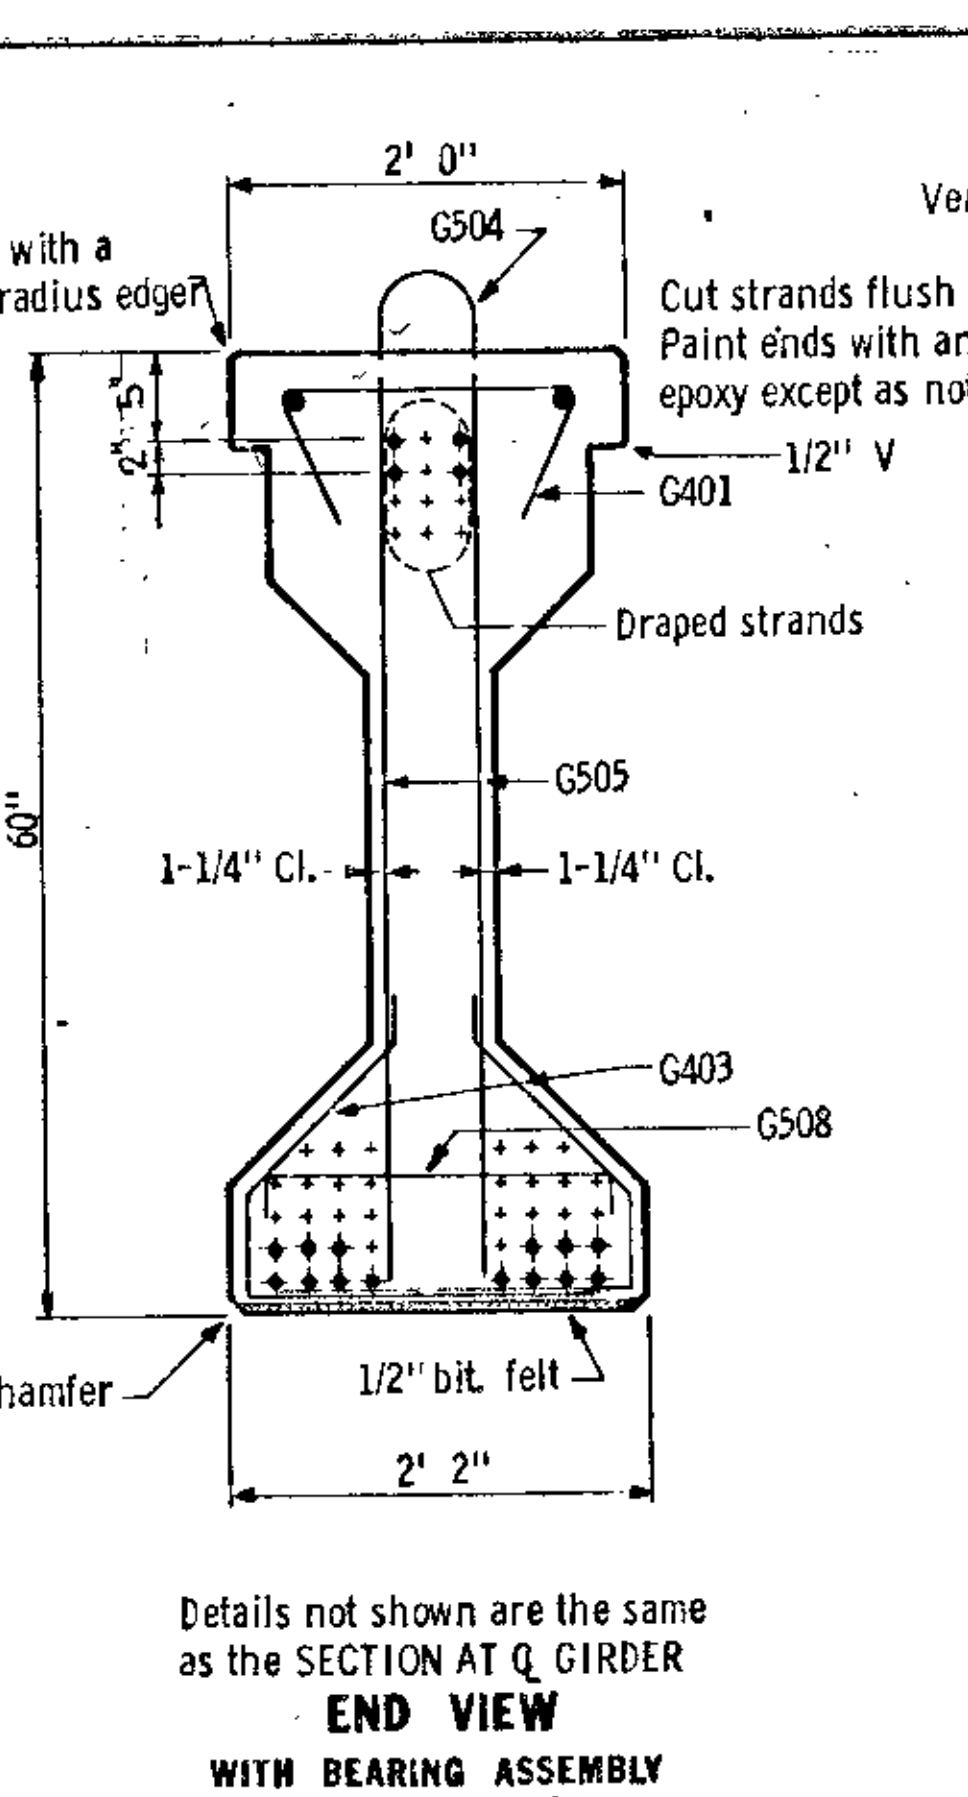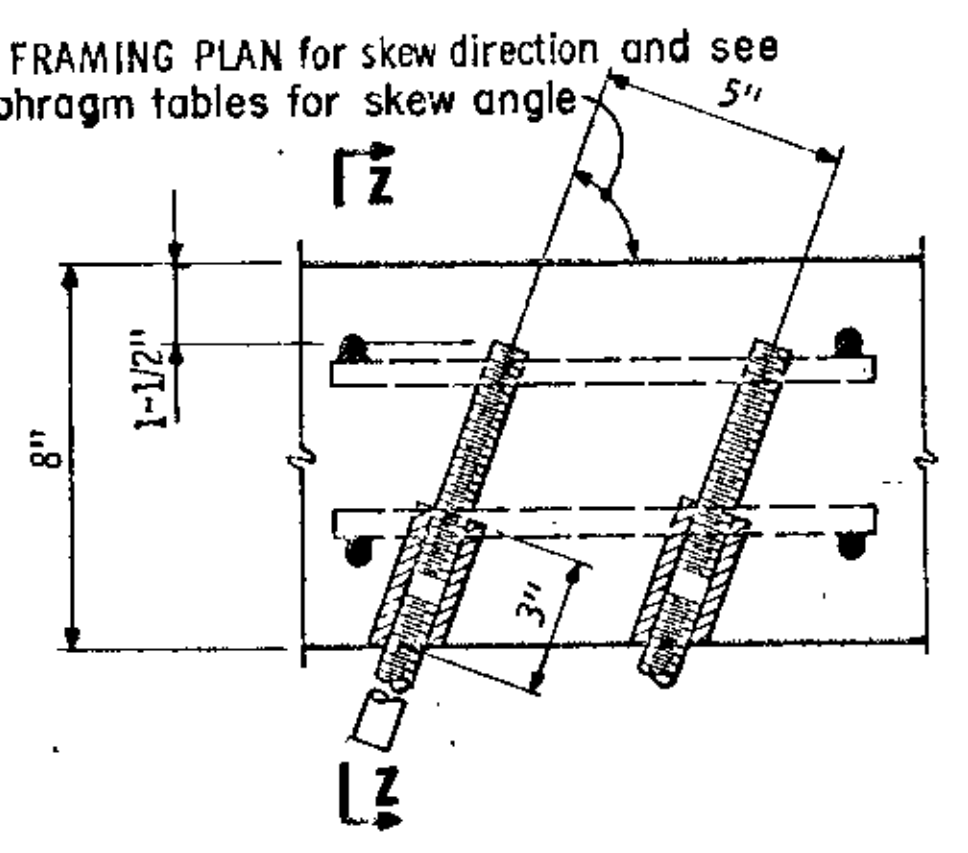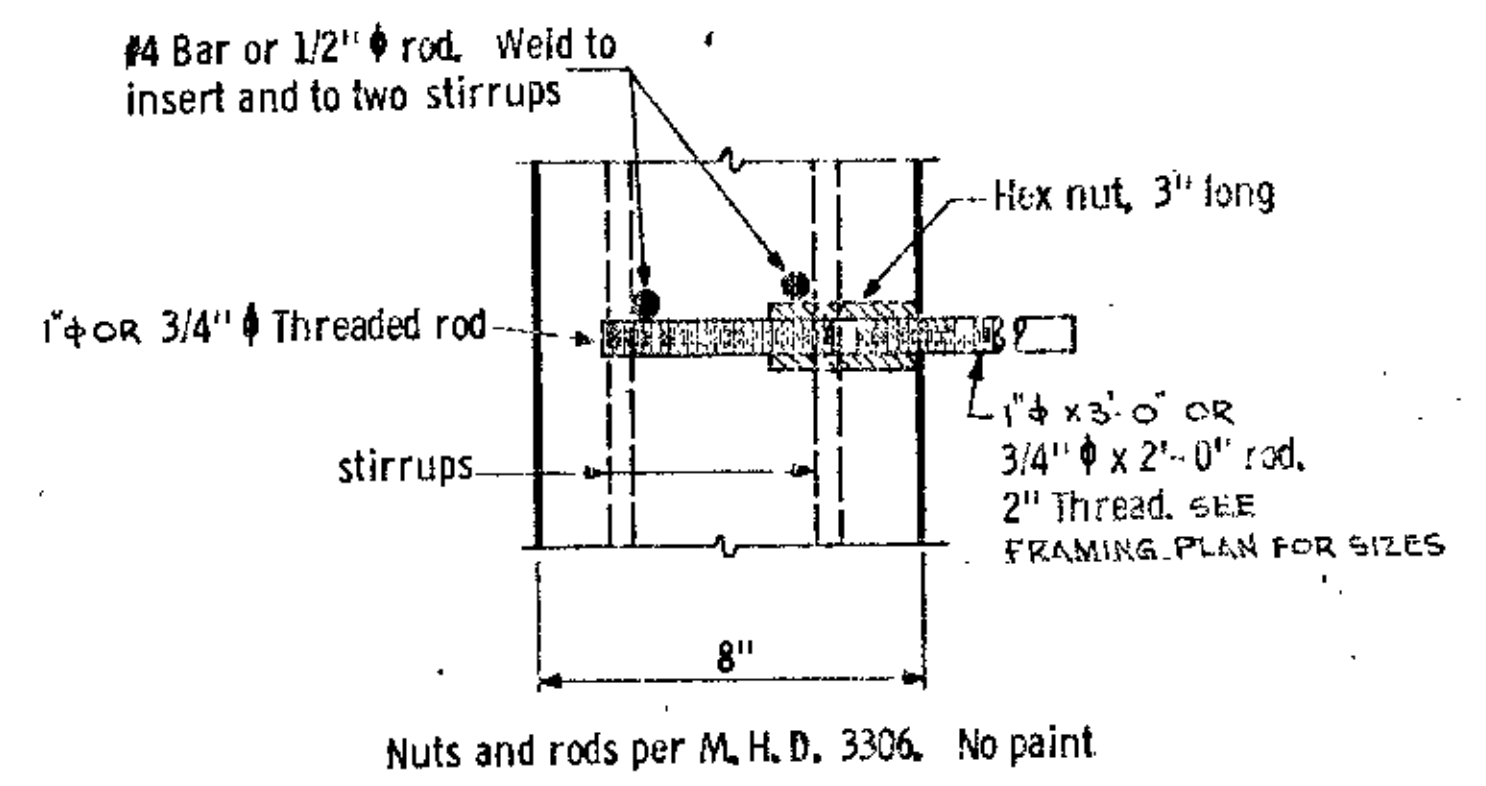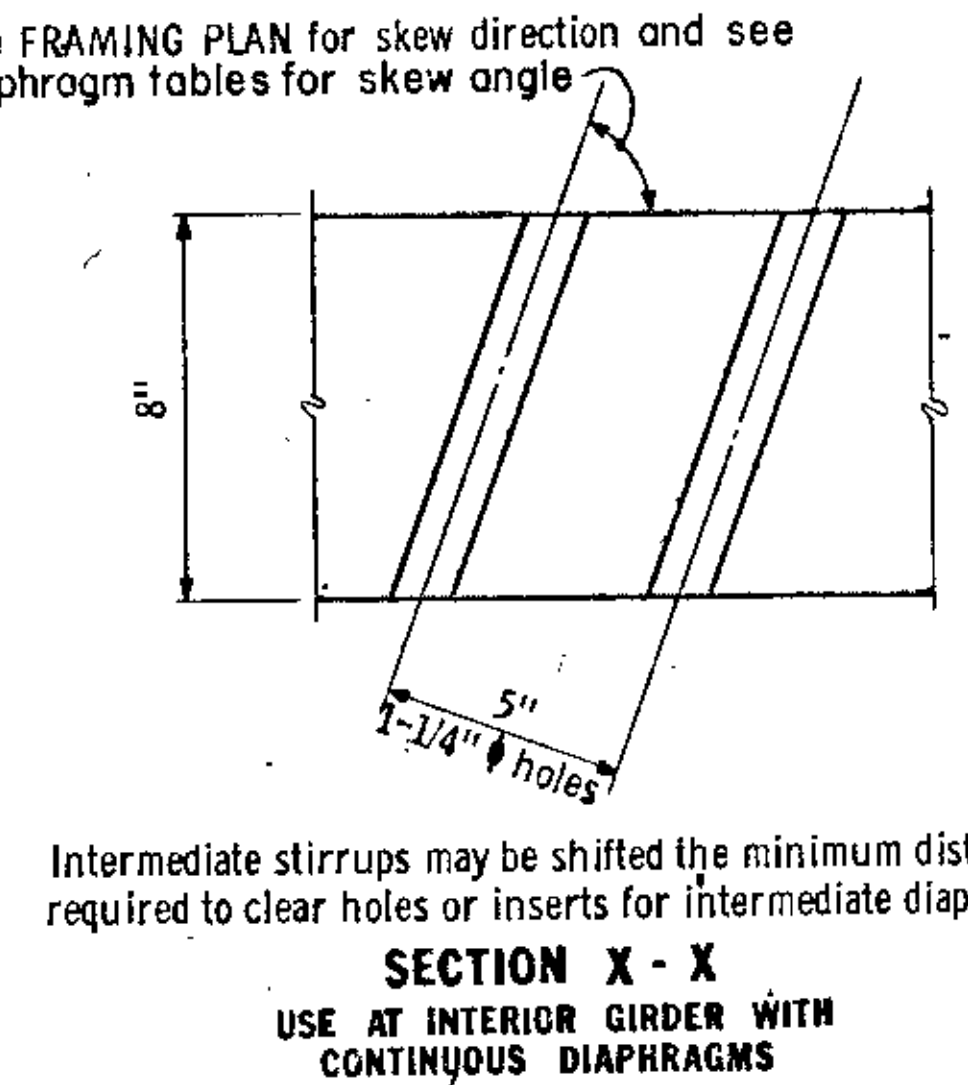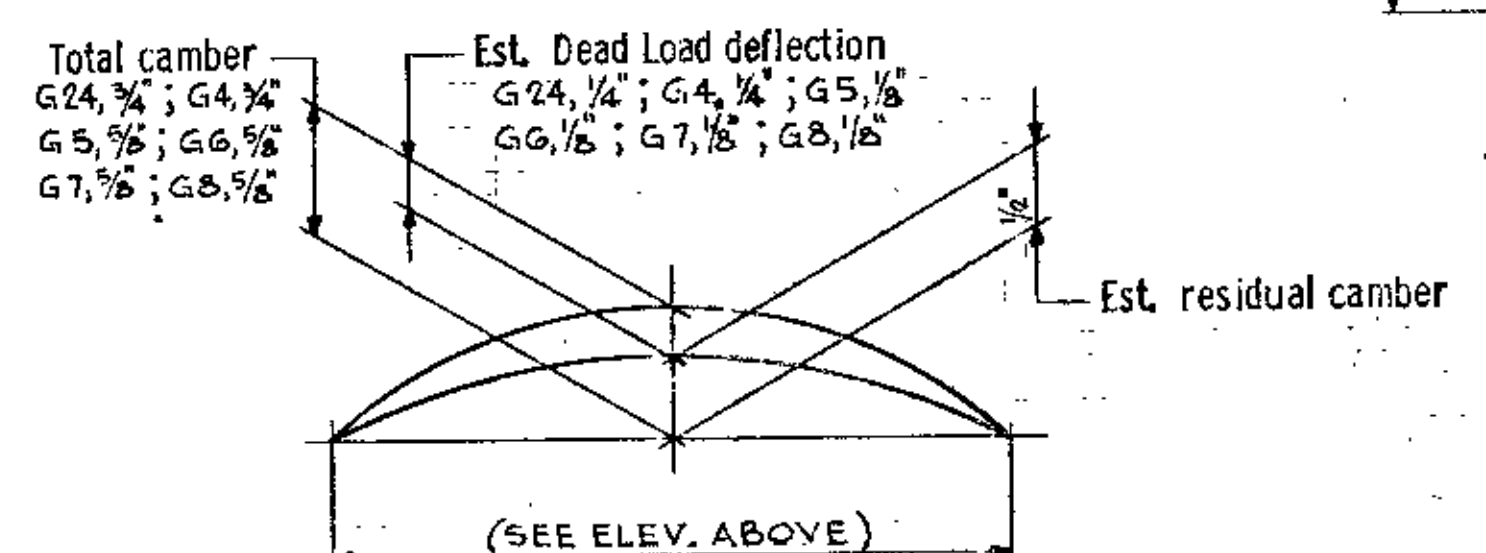

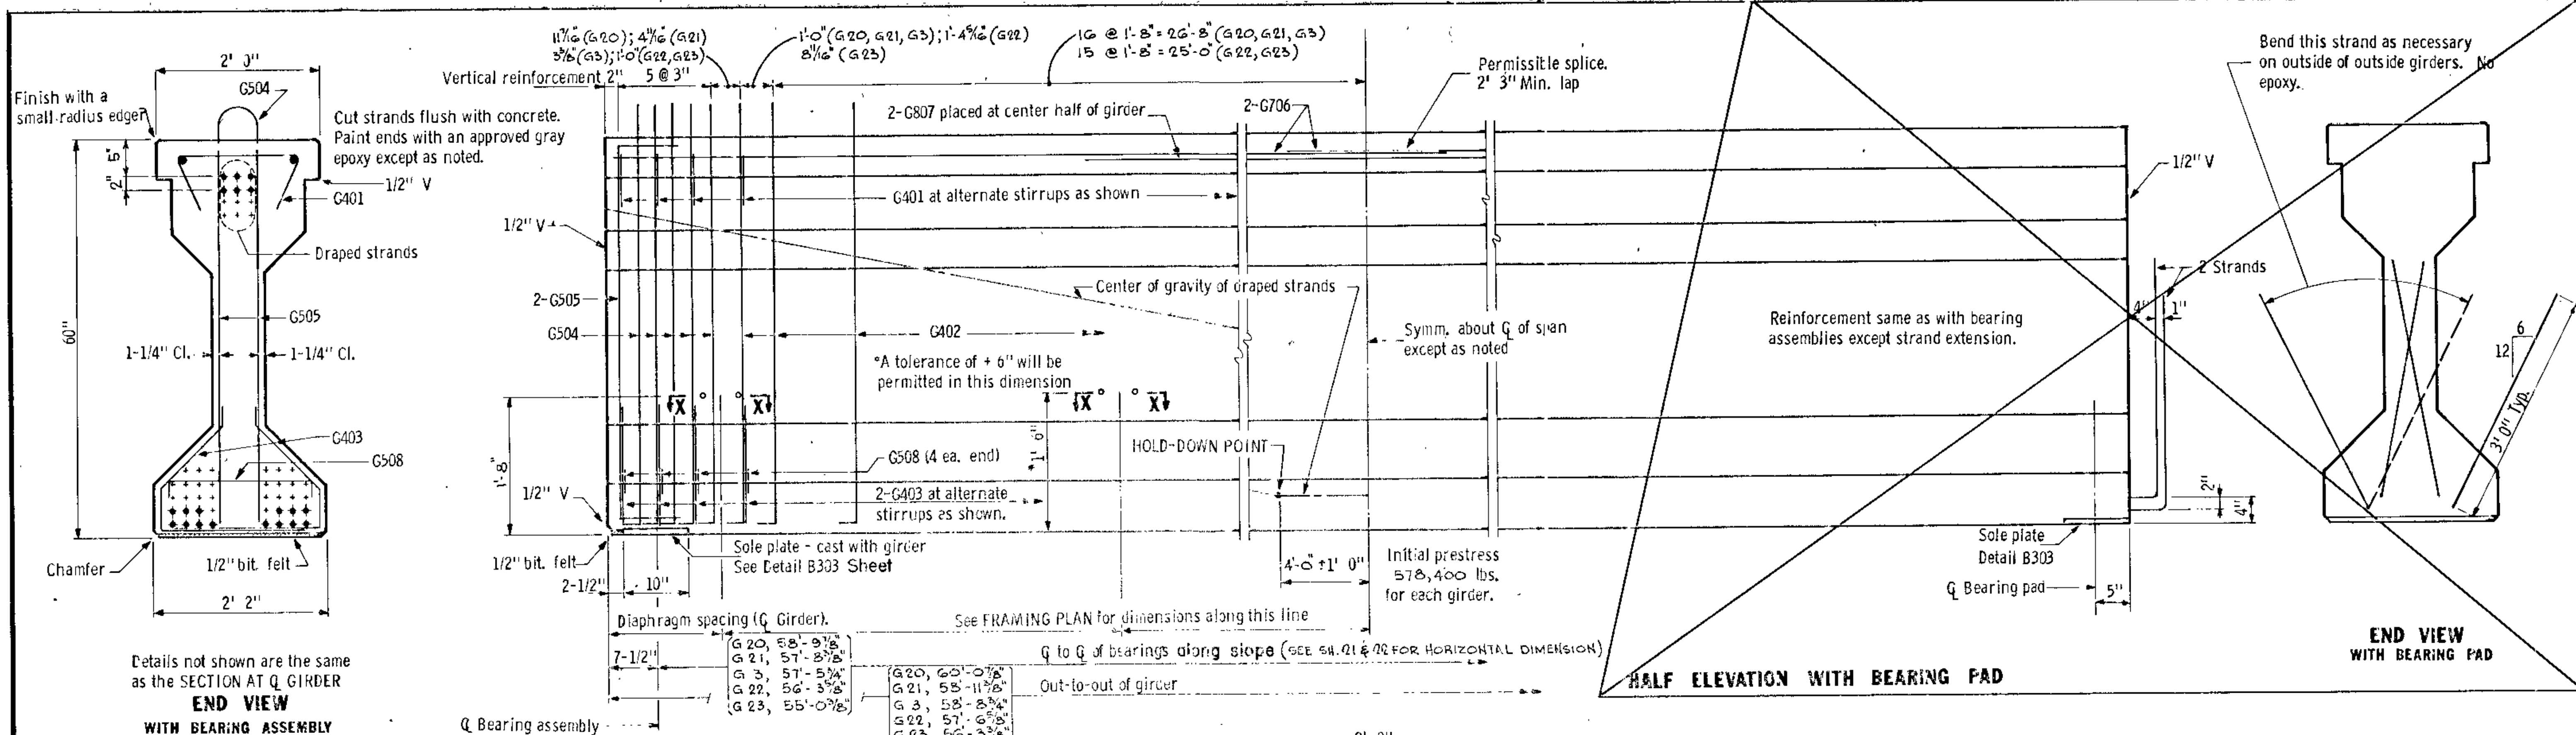

Details not shown are the same as the SECTION AT Q GIRDER

END VIEW WITH BEARING ASSEMBLY

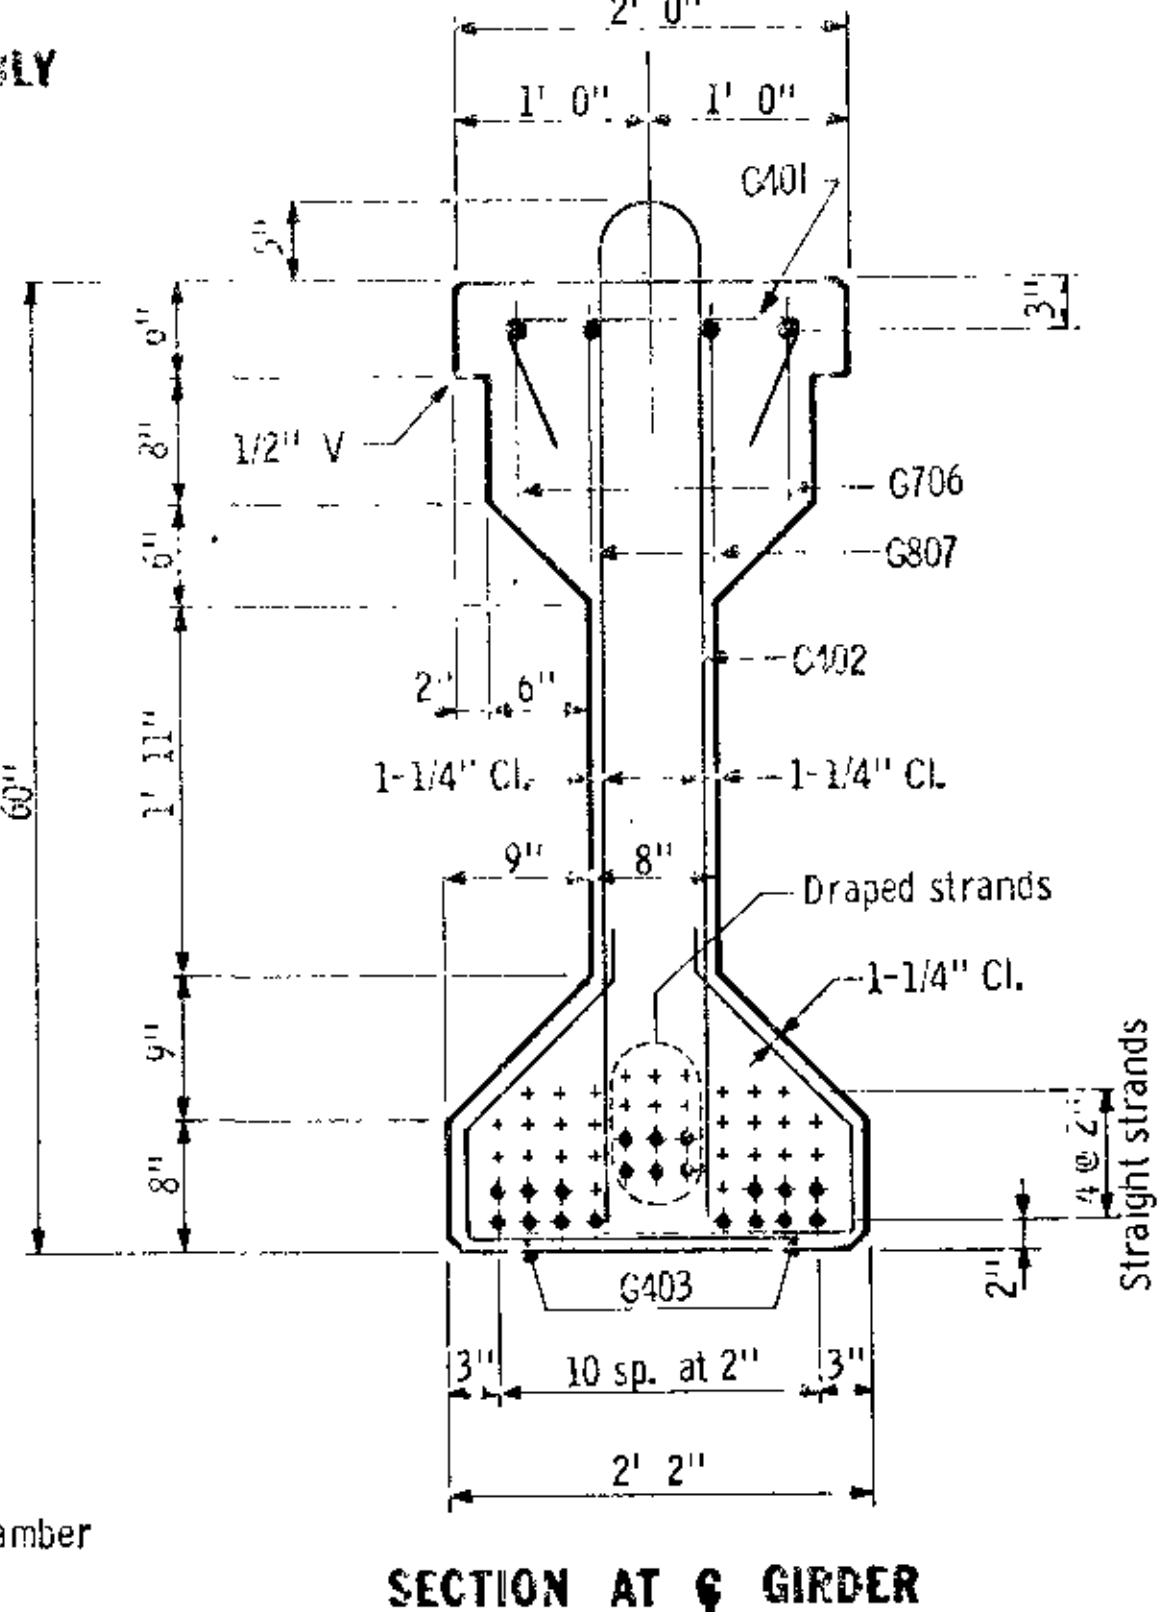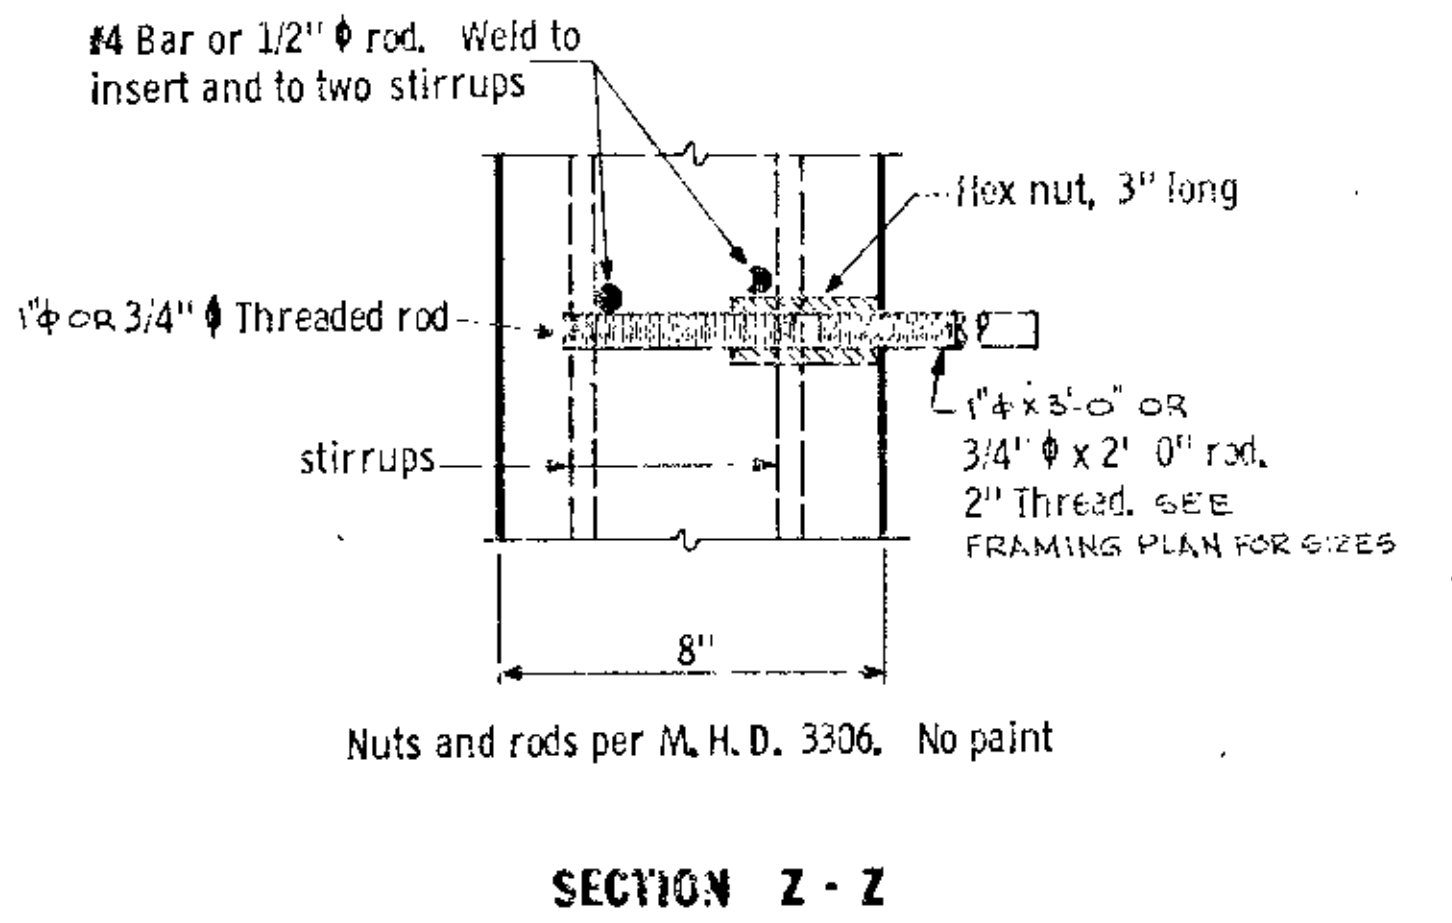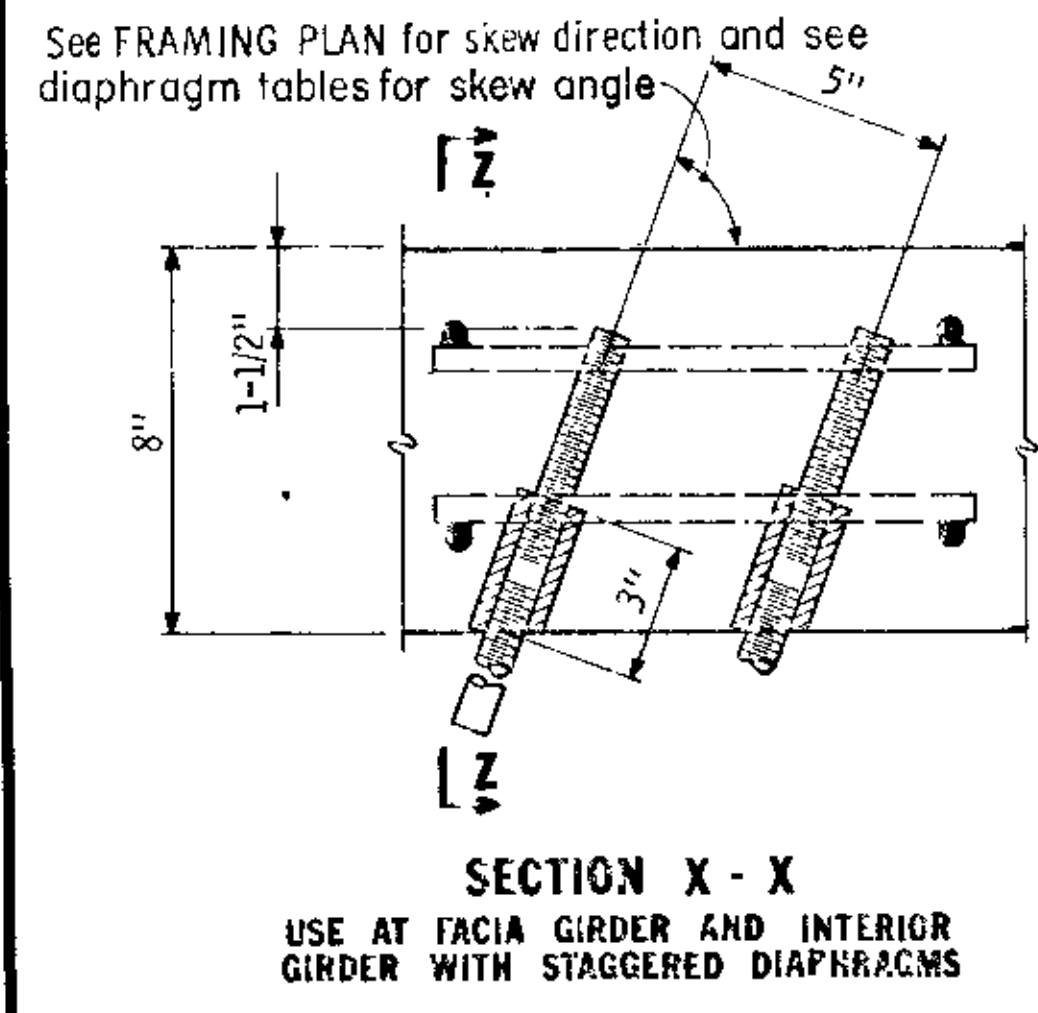


Y DISTANCES (IN INCHES)

	NO.	Q SPAN	END
Straight strands	14	2.86"	
Draped strands	6	6.00"	54.00"
Total strands	20	3.80"	

Y = distance of Center of Gravity of strands from bottom of girder. All strands spaced 2" c-c, horizontally and vertically.

All strands 1/2" φ 270 kip, ultimate strength.

*A tolerance of ± 2" will be permitted in this dimension.

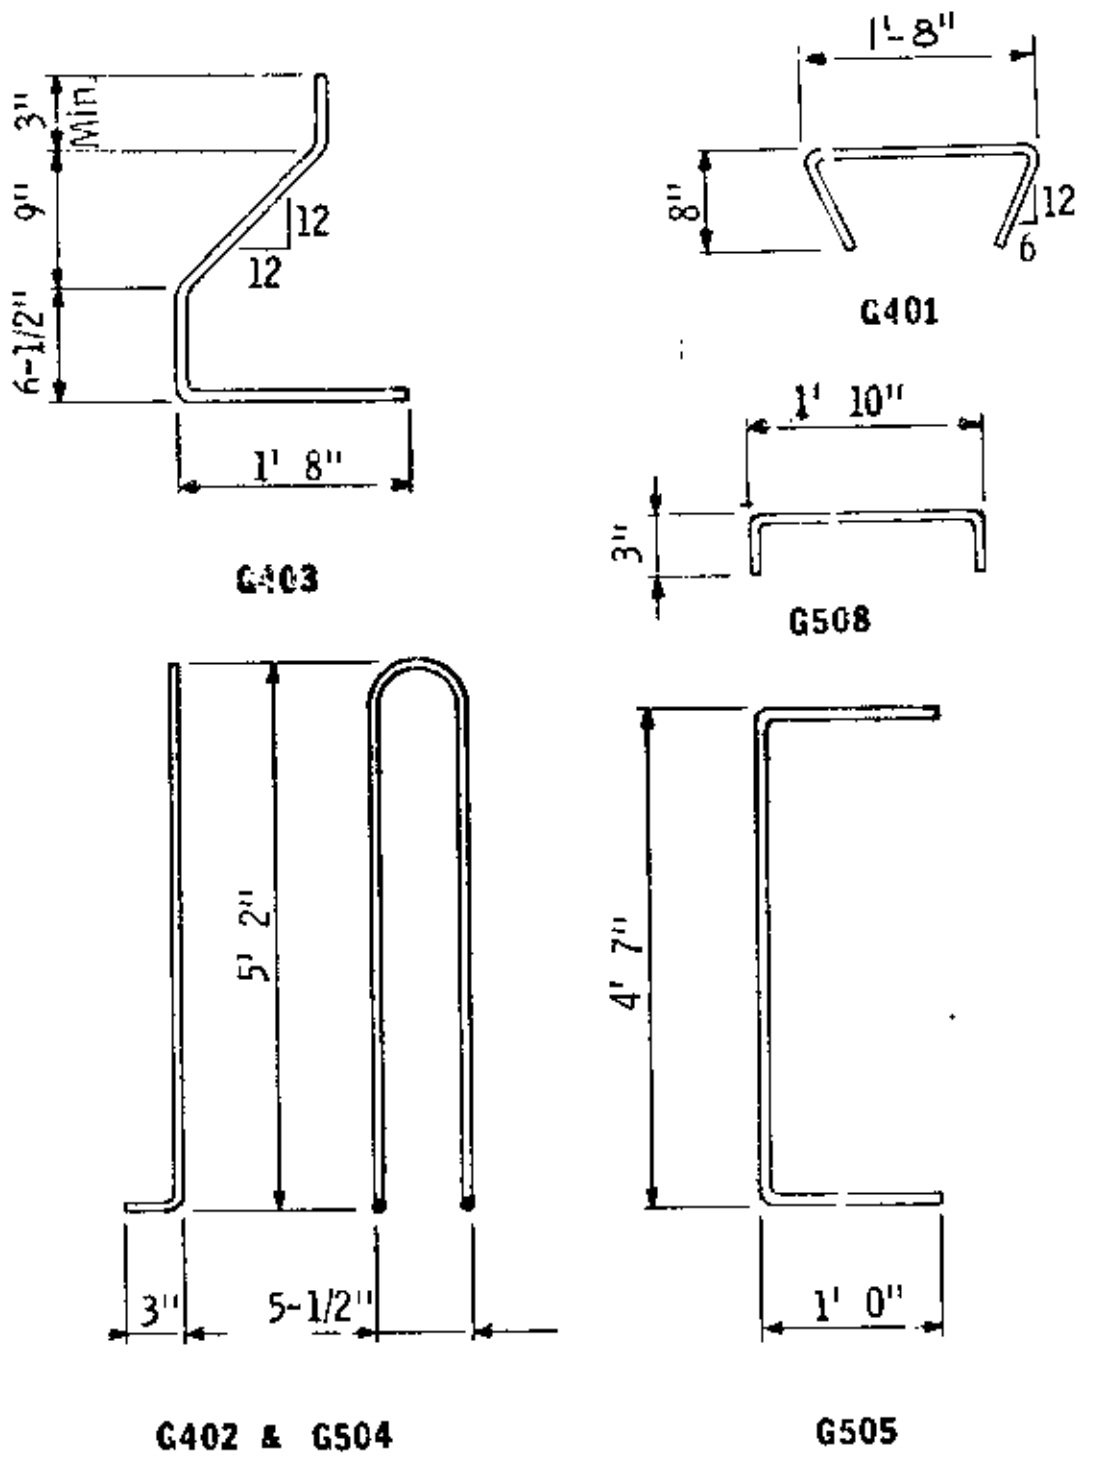

First digit of bar mark indicates bar size. AS BUILT 10-16-73 B. Jack

All bar dimensions are out-to-out.

GIRDERS G20, G21, G3, G22, G23

60" PRESTRESSED CONCRETE GIRDER (PRETENSIONED) TYPE 60-59

GENERAL NOTES:

Tops of girders shall be rough floated and broomed transversely for bond. Provide handling hooks or devices as required by Contractor. Hooks or devices provided will be subject to approval of Engineer and shall be installed within 4' 0" of the end of girder.

A modified strand pattern which does not change center of gravity of strands may be submitted to the Engineer for approval.

A post-tensioned girder may be used as an alternate for the pretensioned design shown. M. H. D. will have plans available for the post-tensioned alternate.

Each girder shall be marked, showing bridge number, casting date, and individual identification letters and numbers. Markings shall be made on the face of the girder, near the end, so located that they will be exposed after the end diaphragms have been cast. Facia girders shall be marked on an inside face. All markings shall be stencilled and be clearly legible. For location of girders, see framing plan.

All material and work shown or noted on this sheet shall be included in unit price bid for prestressed concrete girders. See M. H. D. 2405.

See framing plan for girder ends marked "X".

Approximate weight of girder G20, 29.2 TONS; G21, 28.7 TONS; G3, 28.6 TONS; G22, 28.0 TONS; G23, 27.4 TONS.

MINIMUM CONCRETE STRENGTH - P.S.I.

	① ③ f'ci	② ③ f'c
Computed Min. Concrete Strength	2120	2320
Required Min. Concrete Strength	4500	5000



- ① Minimum concrete strength at time of prestress transfer.
- ② Minimum concrete strength when curing can be discontinued and girder transported and installed.
- ③ Required minimum concrete strength shall be used. Computed minimum concrete strength is for information only.


DES: *[Signature]* DR: M.H.D./W.K. APPROVED: *[Signature]*
CHK: *[Signature]* MODY: *[Signature]* CHK: *[Signature]* 12-21-71

Bridge No. 02522

Sheet No. 19 of 35 Sheets

Fig. 5-397.506
Oct. 15, 1969

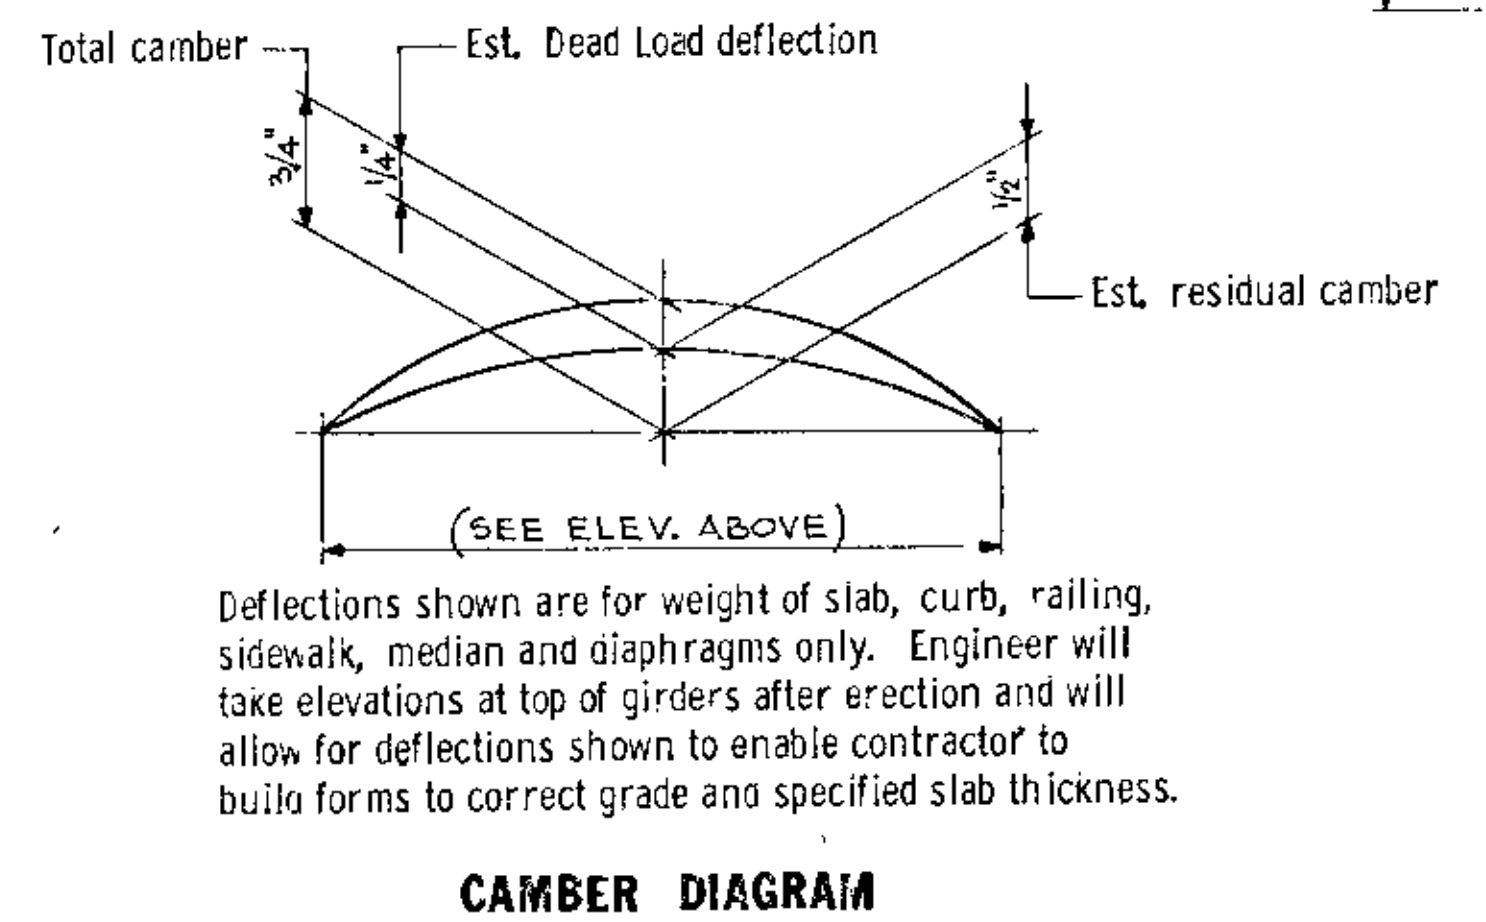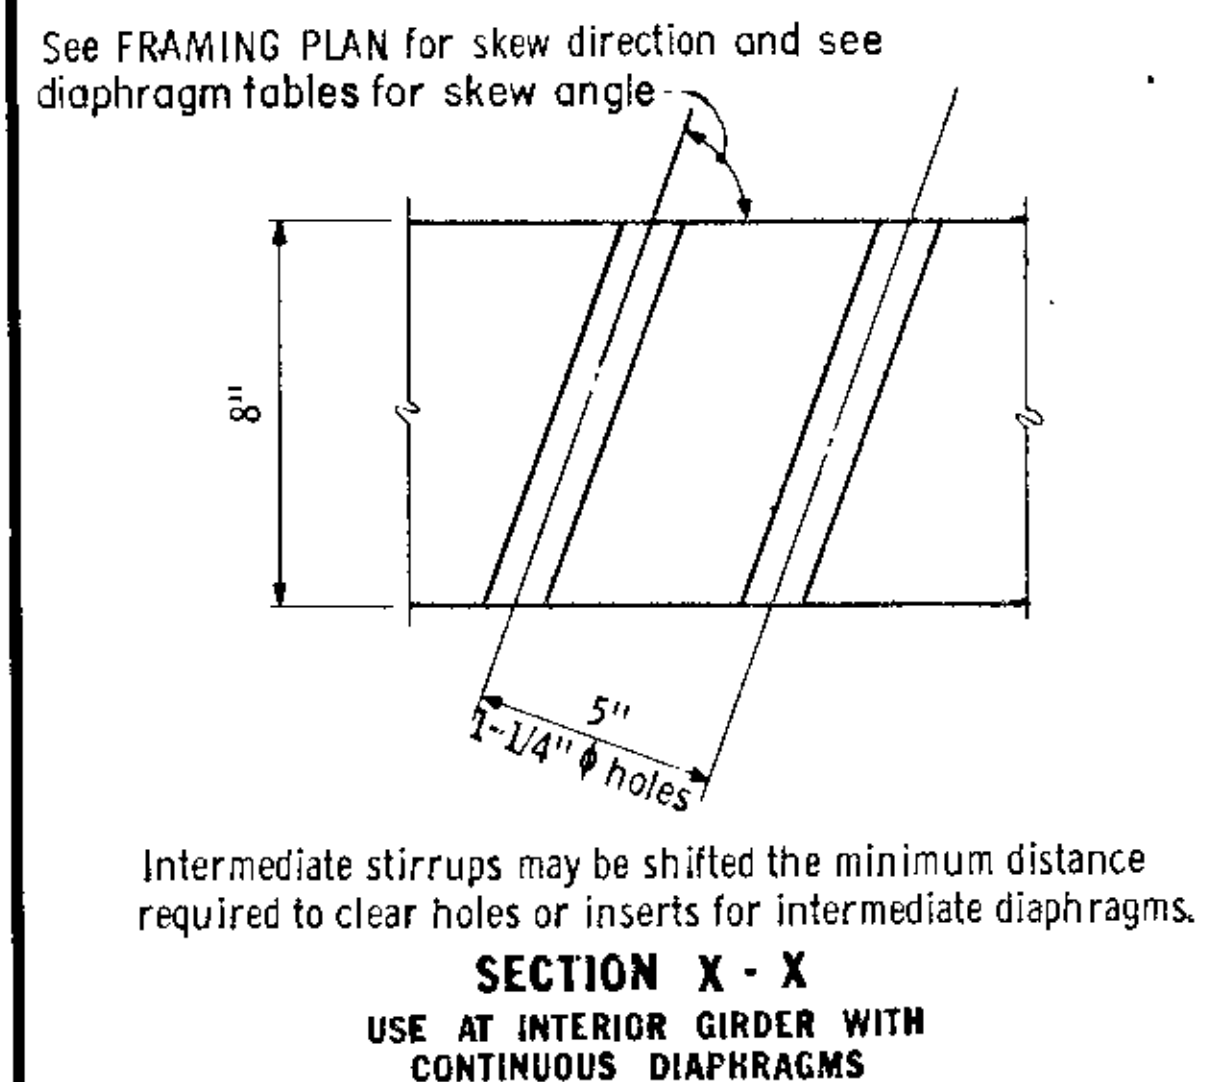


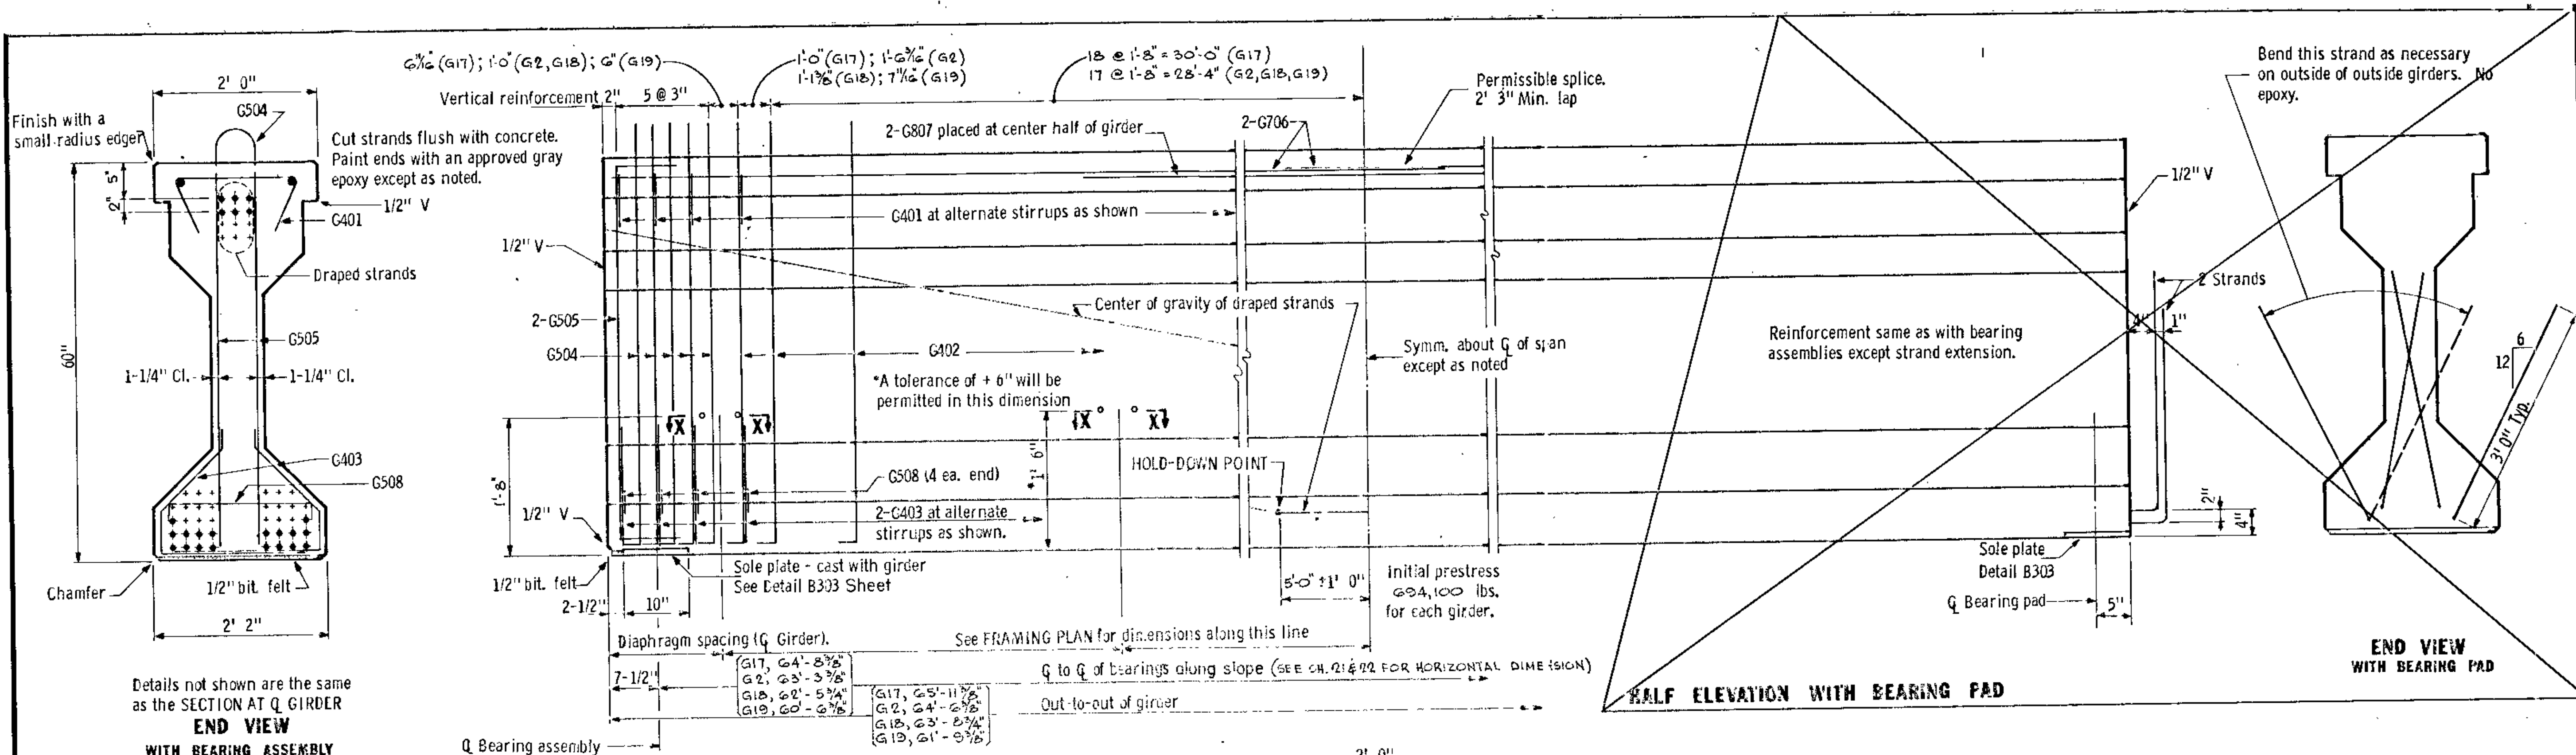


Details not shown are the same as the SECTION AT Q GIRDER
END VIEW WITH BEARING ASSEMBLY

HALF ELEVATION WITH BEARING ASSEMBLY

See FRAMING PLAN for skew direction and see diaphragm tables for skew angle

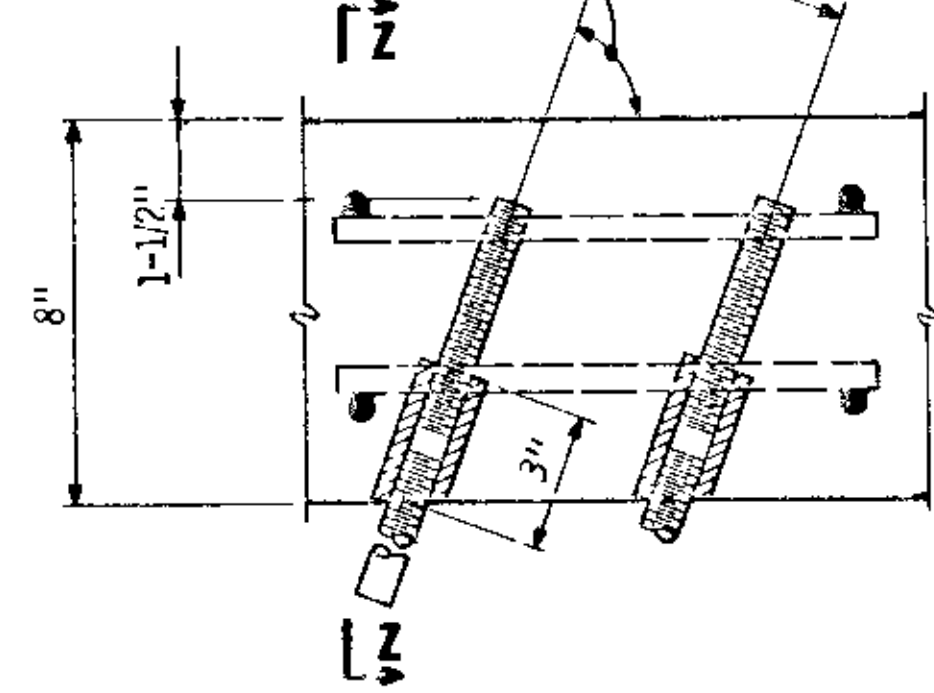


SECTION X - X
 USE AT FACIA GIRDER AND INTERIOR GIRDER WITH STAGGERED DIAPHRAGMS

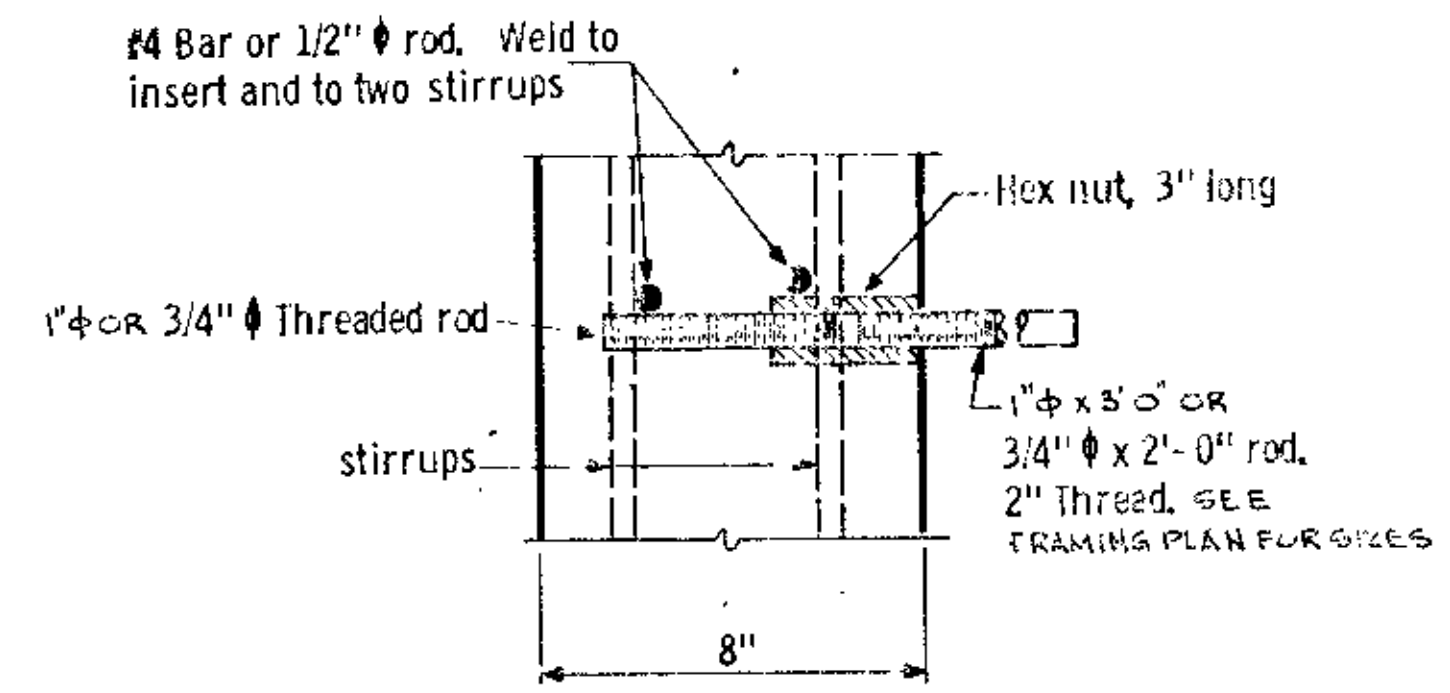


SECTION Z - Z


See FRAMING PLAN for skew direction and see diaphragm tables for skew angle

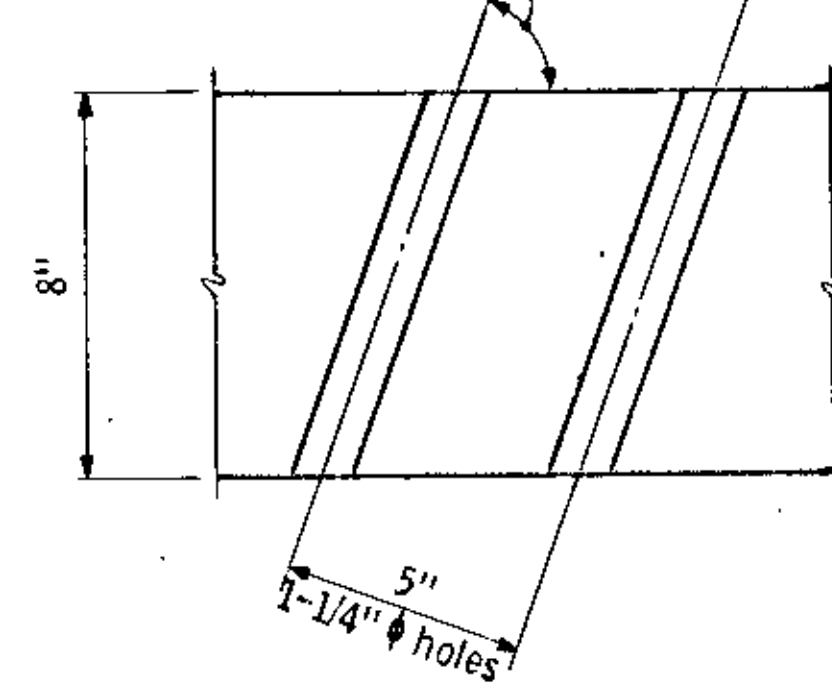

Intermediate stirrups may be shifted the minimum distance required to clear holes or inserts for intermediate diaphragms.
SECTION X - X
 USE AT INTERIOR GIRDER WITH CONTINUOUS DIAPHRAGMS

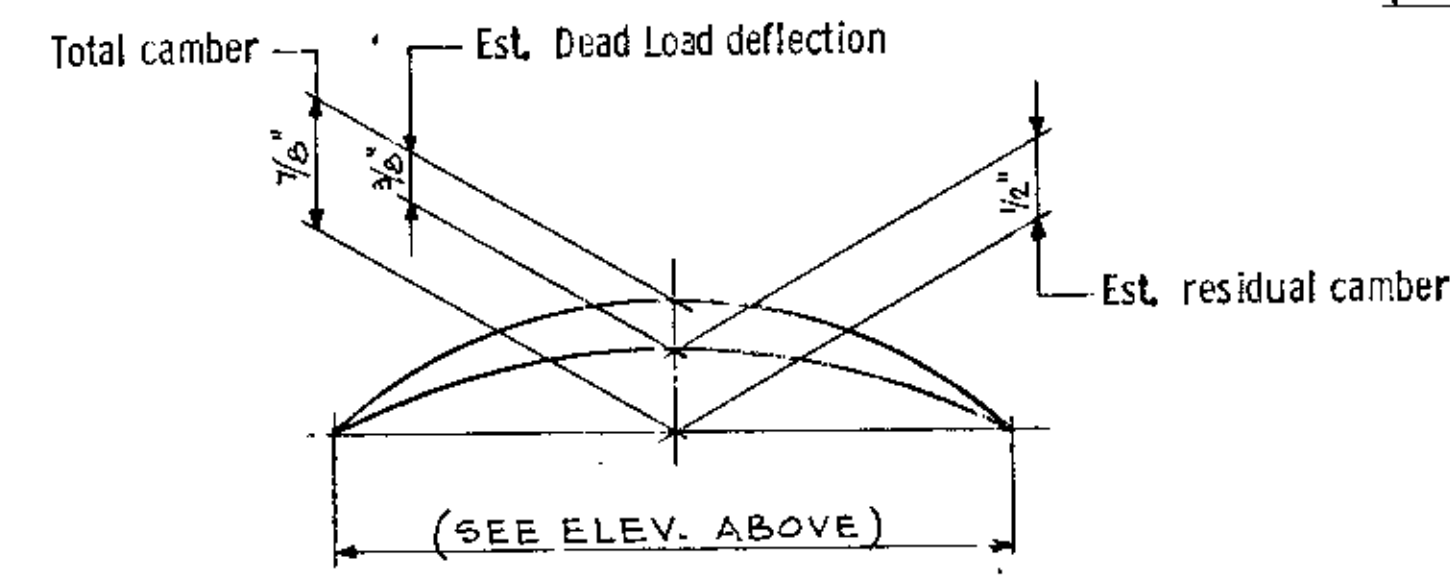

CAMBER DIAGRAM

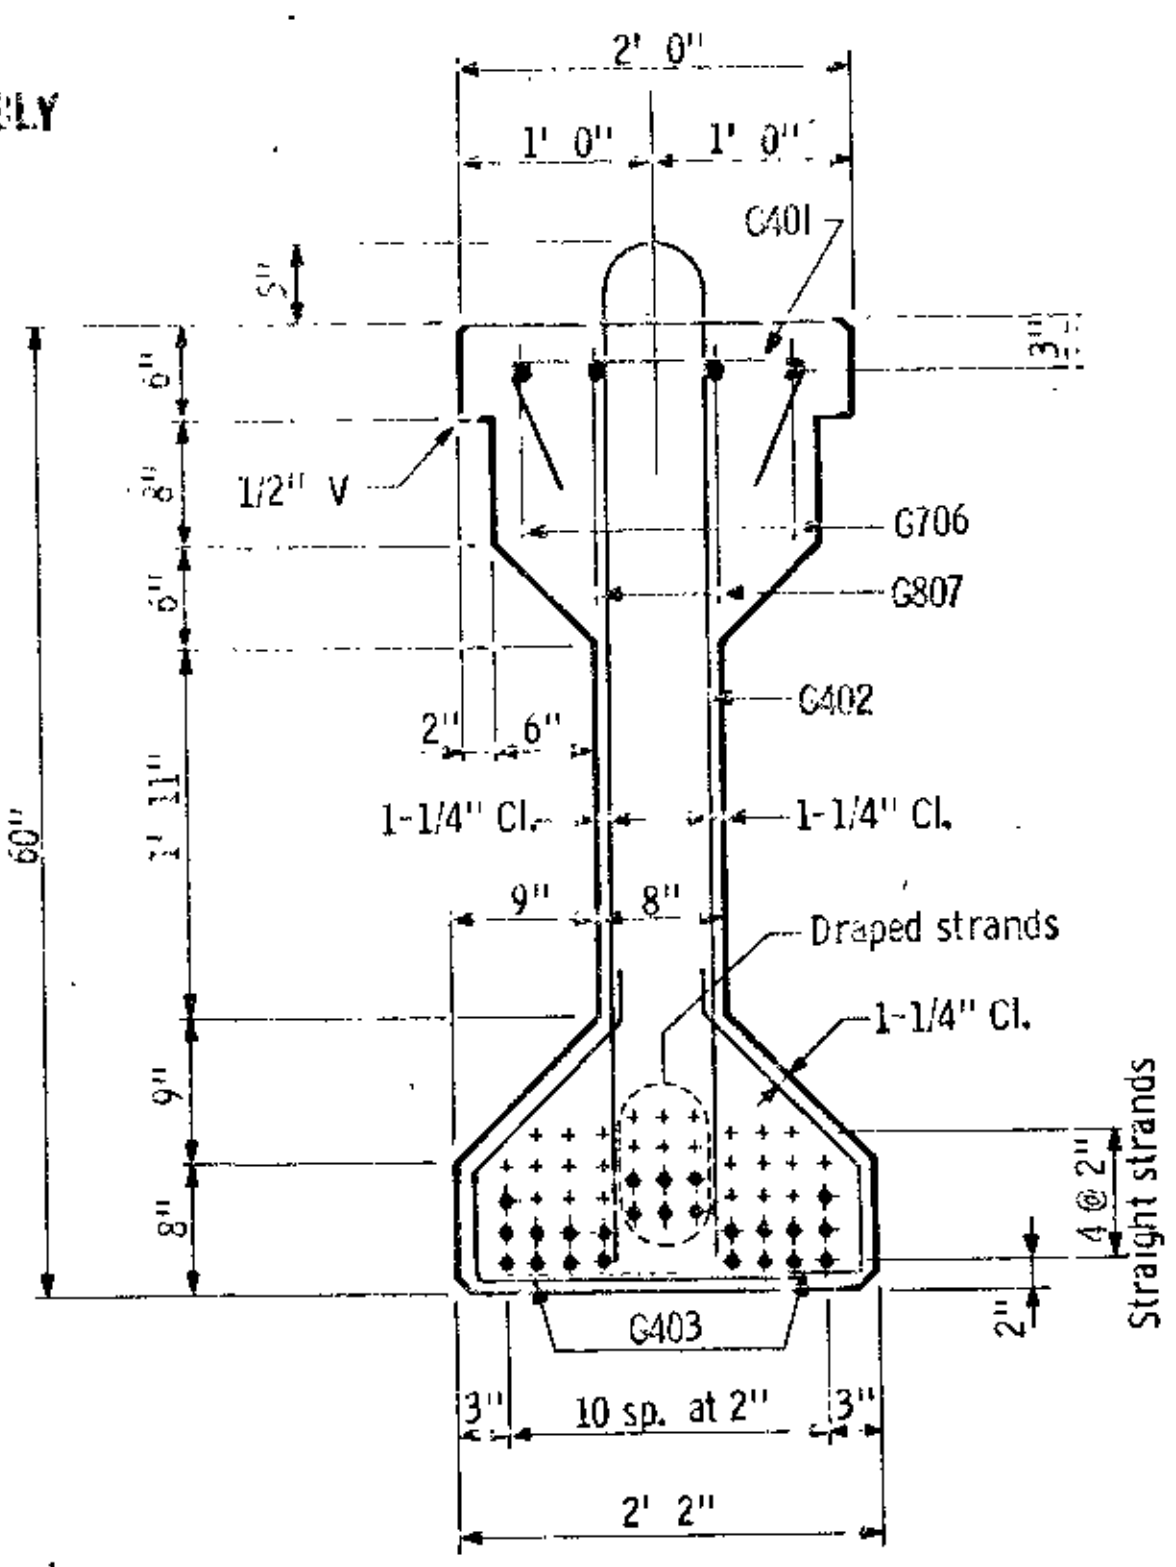


SECTION AT Q GIRDER

Y DISTANCES (IN INCHES)			
	NO.	Q SPAN	END
Straight strands	18	3.33"	
Draped strands	6	6.00"	64.00"
Total strands	24	4.00"	

Y = distance of Center of Gravity of strands from bottom of girder. All strands spaced 2" c-c, horizontally and vertically.

All strands 1/2" phi 270 kip, ultimate strength.
 A tolerance of +/- 2" will be permitted in this dimension.

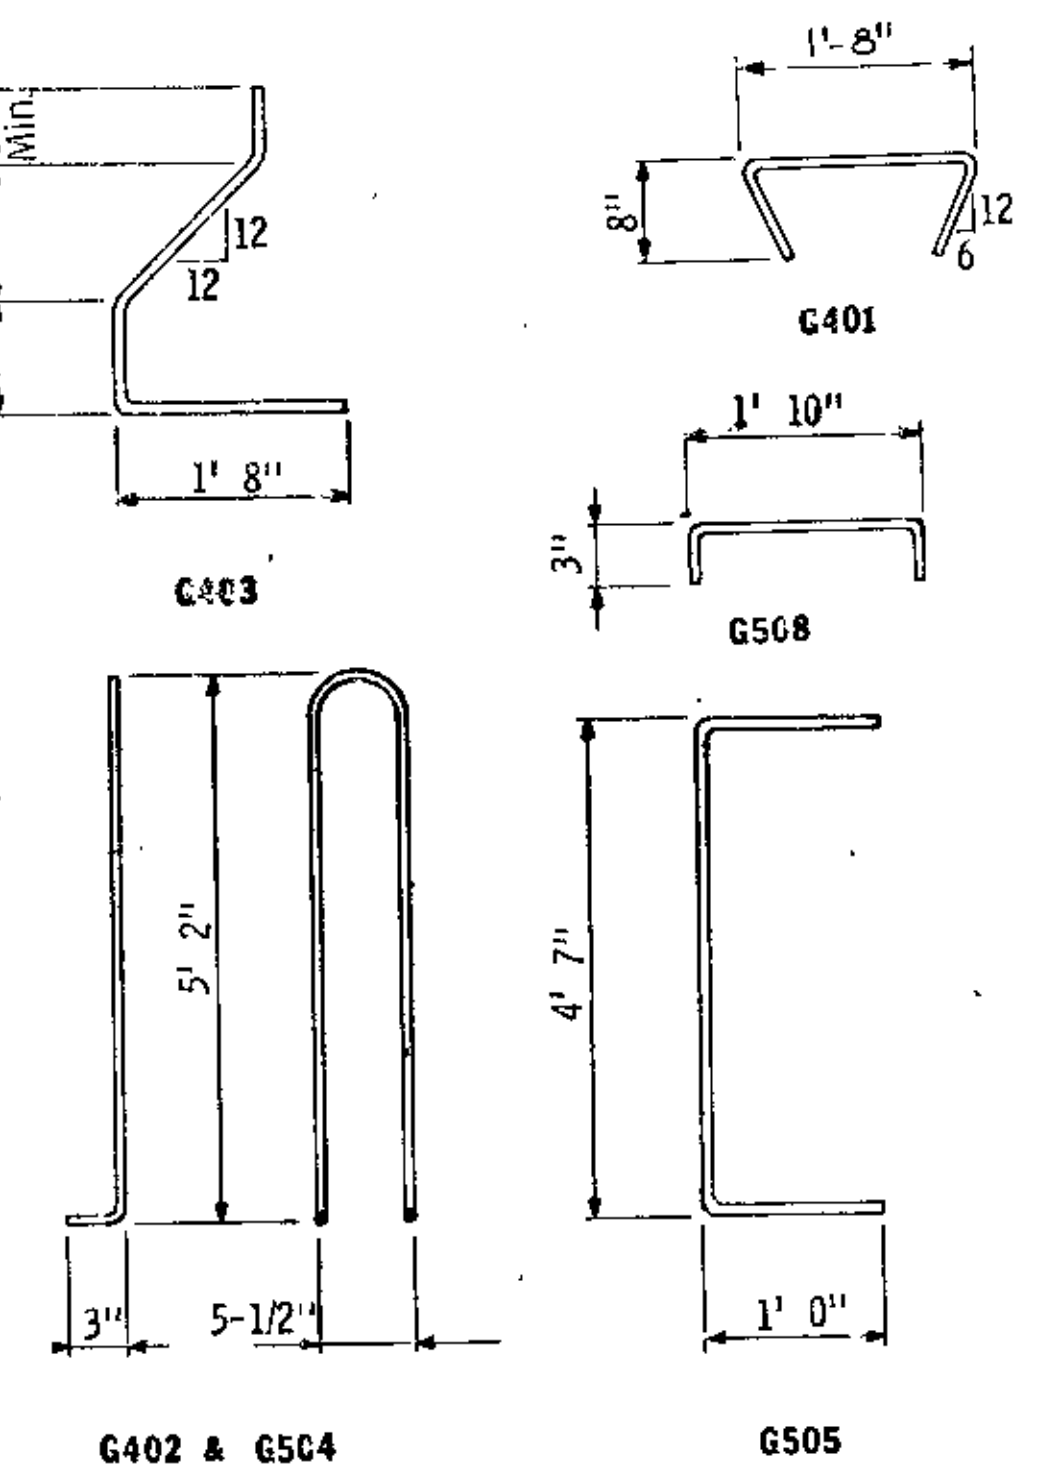

First digit of bar mark indicates bar size. All bar dimensions are out-to-out. *AS BUILT 10-16-73 B. J. A.*

GIRDERS G17, G2, G18, G19

60" PRESTRESSED CONCRETE GIRDER (PRETENSIONED) TYPE 60-64

GENERAL NOTES:

- Tops of girders shall be rough floated and broomed transversely for bond. Provide handling hooks or devices as required by Contractor. Hooks or devices provided will be subject to approval of Engineer and shall be installed within 4' 0" of the end of girder.
- A modified strand pattern which does not change center of gravity of strands may be submitted to the Engineer for approval.
- A post-tensioned girder may be used as an alternate for the pretensioned design shown. M.H.D. will have plans available for the post-tensioned alternate.
- Each girder shall be marked, showing bridge number, casting date, and individual identification letters and numbers. Markings shall be made on the face of the girder, near the end, so located that they will be exposed after the end diaphragms have been cast. Facia girders shall be marked on an inside face. All markings shall be stenciled and be clearly legible. For location of girders, see framing plan.

All material and work shown or noted on this sheet shall be included in unit price bid for prestressed concrete girders. See M.H.D. 2405. See framing plan for girder ends marked 'X'.


Approximate weight of girder G17, 32.1 TONS; G2, 31.4 TONS; G18, 31.0 TONS; G19, 30.1 TONS

MINIMUM CONCRETE STRENGTH - P.S.I.			
	①	②	③
Computed Min. Concrete Strength	2460	3270	5000
Required Min. Concrete Strength	4500	5000	




- ① Minimum concrete strength at time of prestress transfer.
- ② Minimum concrete strength when curing can be discontinued and girder transported and installed.
- ③ Required minimum concrete strength shall be used. Computed minimum concrete strength is for information only.

Fig. 5-397.506
 Oct. 15, 1969

DES: R/M/S	DR: M.H.D./W.K.	APPROVED: 12-21-71	Bridge No. 02522
CHK: M/M	CHK: M/M		

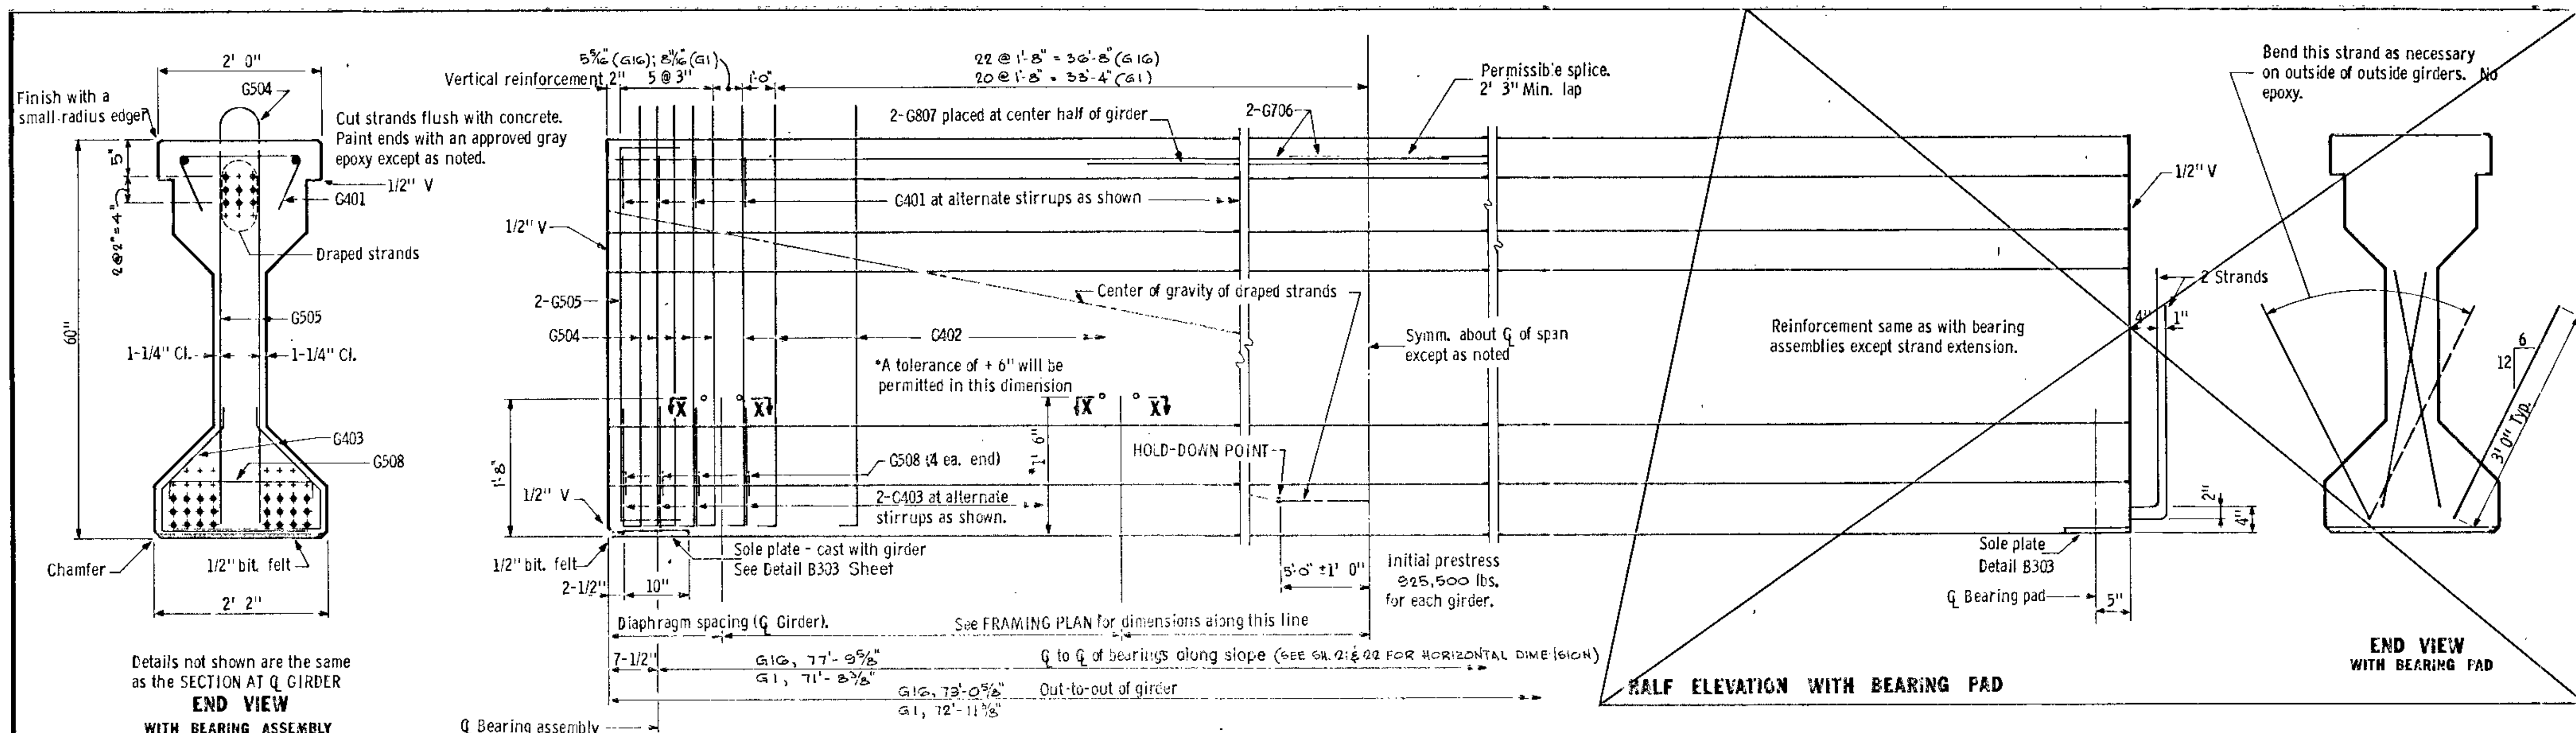


Details not shown are the same as the SECTION AT Q GIRDER WITH BEARING ASSEMBLY

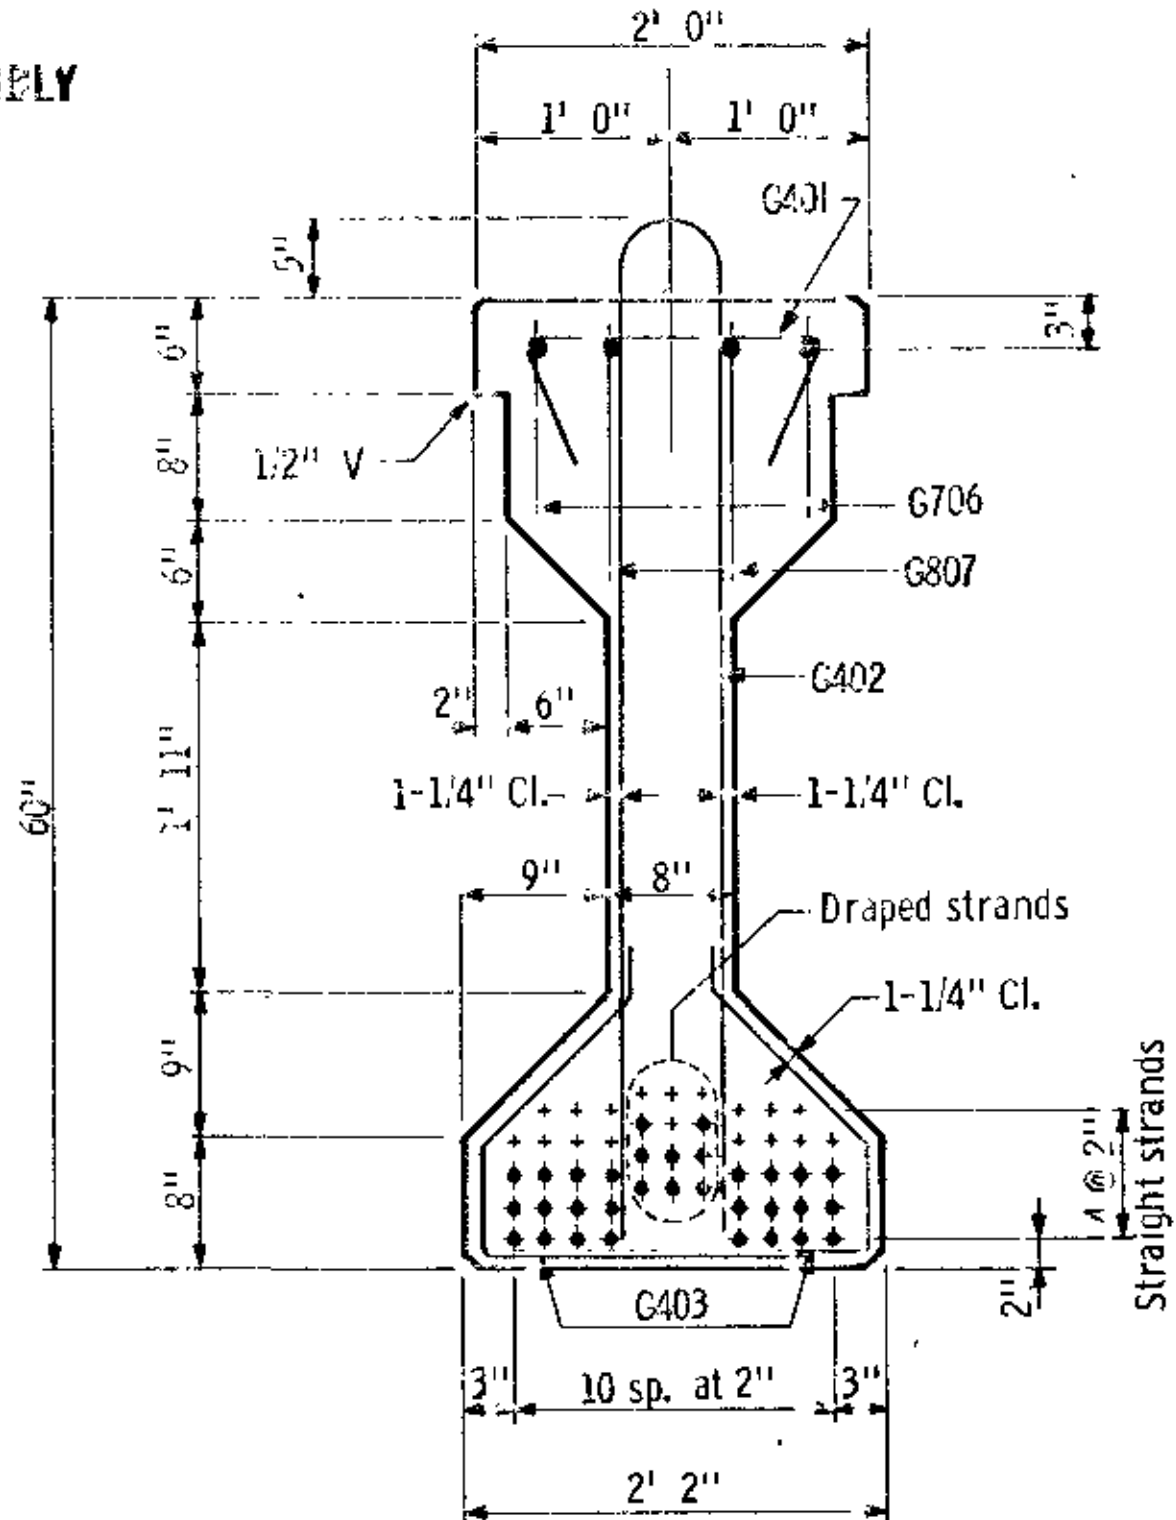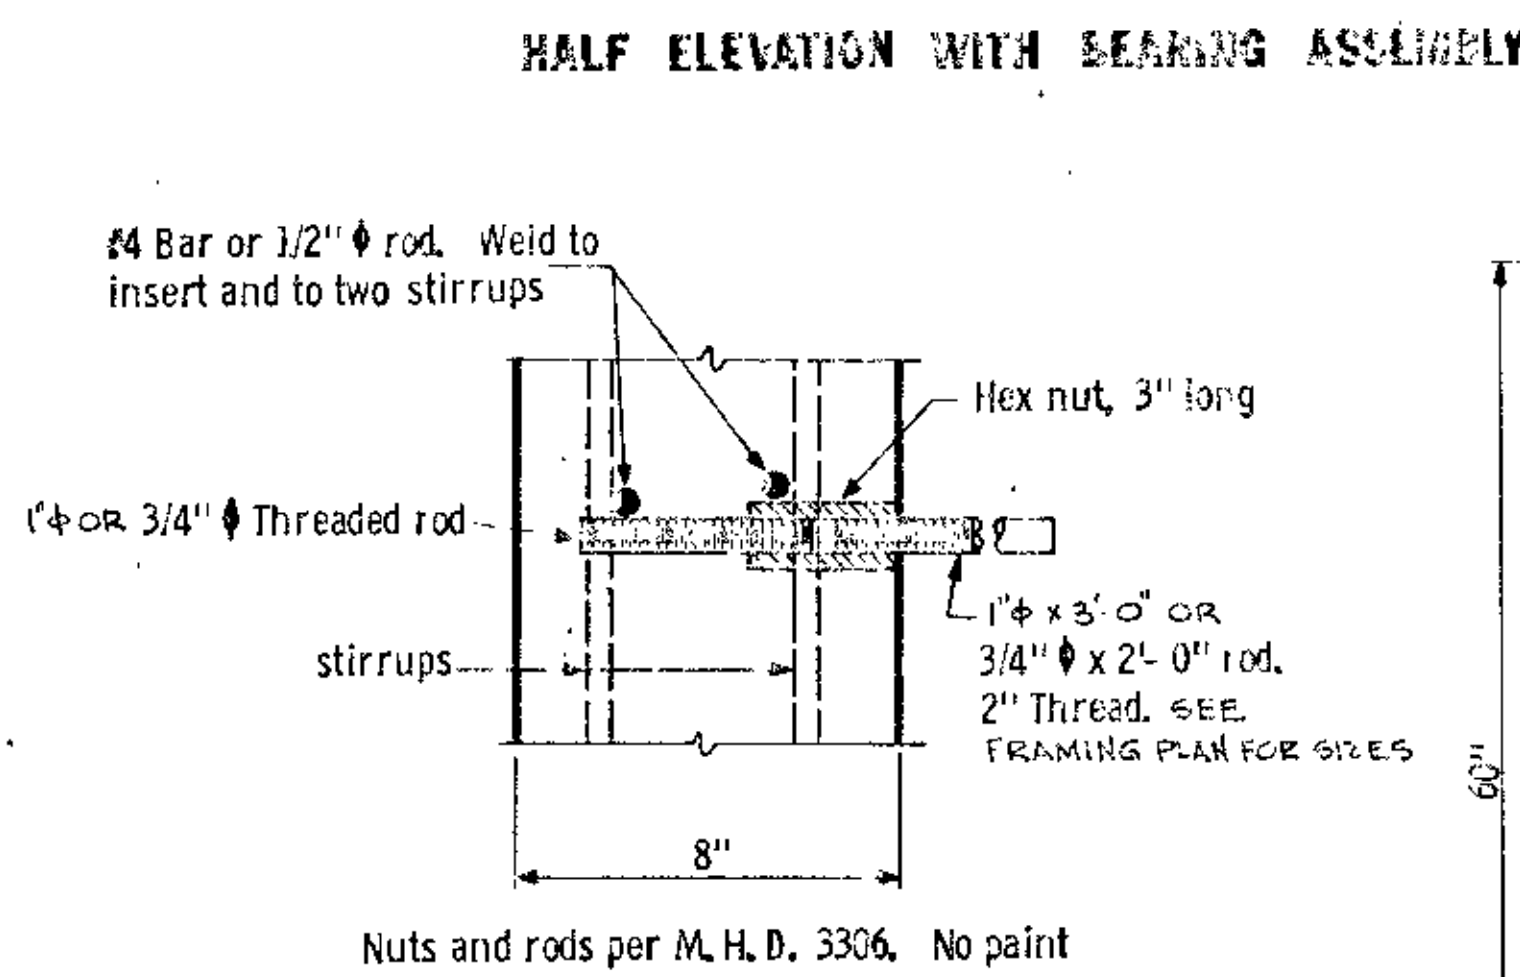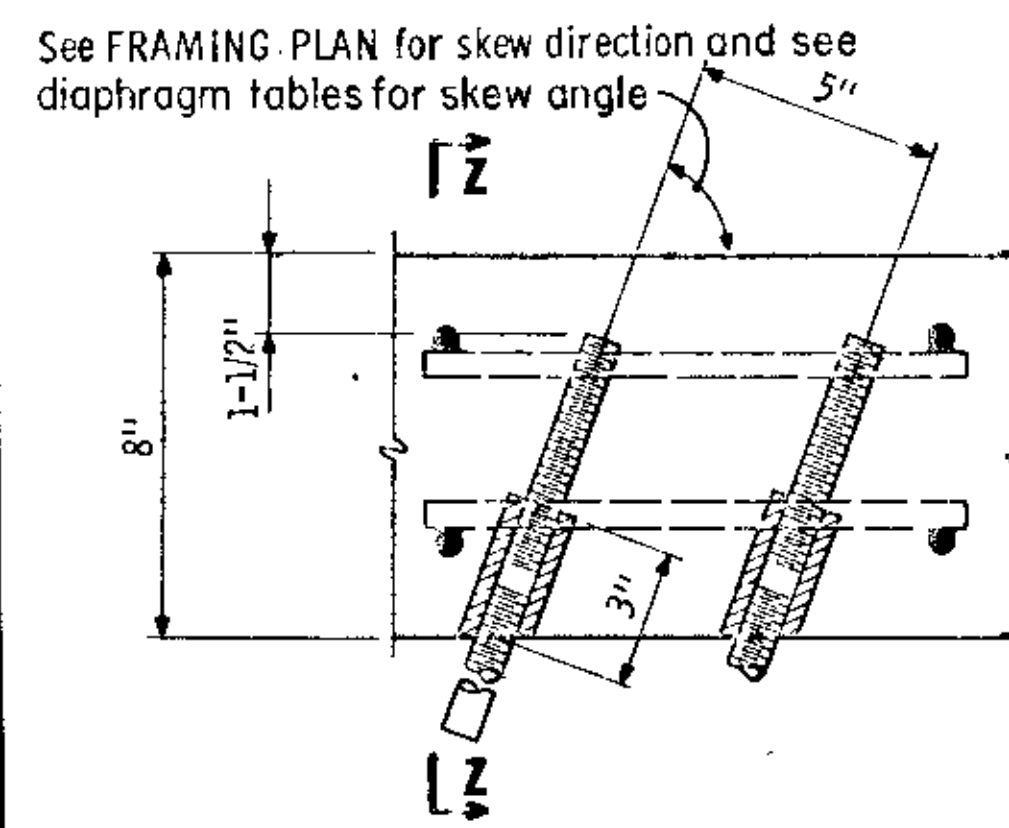

Y DISTANCES (IN INCHES)			
	NO.	Q SPAN	END
Straight strands	24	4.00"	
Draped strands	8	6.75"	52.75"
Total strands	32	4.69"	

Y - distance of Center of Gravity of strands from bottom of girder. All strands spaced 2" c-c, horizontally and vertically.
 All strands 1/2" φ 270 kip, ultimate strength.
 *A tolerance of ± 2" will be permitted in this dimension.

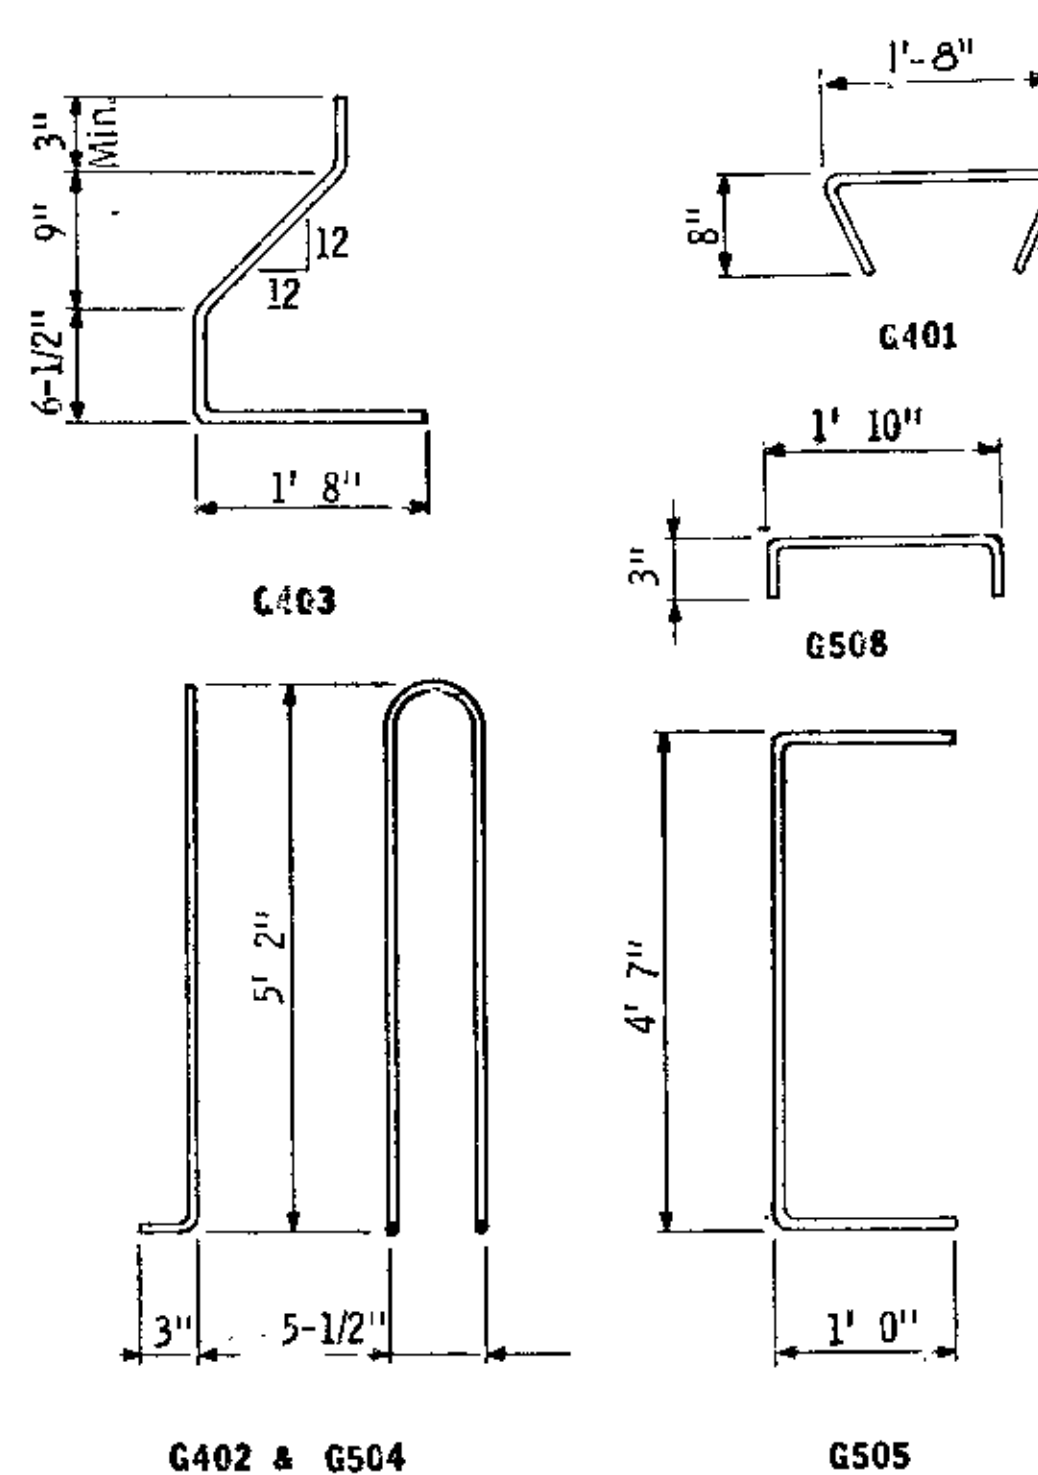

First digit of bar mark indicates bar size. All bar dimensions are out-to-out.
 AS BUILT
 10-16-73
 B. J. J.

GIRDERS G16, G1
 60" PRESTRESSED CONCRETE GIRDER (PRETENSIONED) TYPE 60-76

GENERAL NOTES:

Tops of girders shall be rough floated and broomed transversely for bond. Provide handling hooks or devices as required by Contractor. Hooks or devices provided will be subject to approval of Engineer and shall be installed within 4' 0" of the end of girder.

A modified strand pattern which does not change center of gravity of strands may be submitted to the Engineer for approval.

A post-tensioned girder may be used as an alternate for the pretensioned design shown. M. H. D. will have plans available for the post-tensioned alternate.

Each girder shall be marked, showing bridge number, casting date, and individual identification letters and numbers. Markings shall be made on the face of the girder, near the end, so located that they will be exposed after the end diaphragms have been cast. Facia girders shall be marked on an inside face. All markings shall be stenciled and be clearly legible. For location of girders, see framing plan.

All material and work shown or noted on this sheet shall be included in unit price bid for prestressed concrete girders. See M. H. D. 2405.

See framing plan for girder ends marked "X".



Approximate weight of girder G16, 38.5 TONS; G1, 35.5 TONS

MINIMUM CONCRETE STRENGTH - P.S.I.		
	① ③ f'ci	② ③ f'c
Computed Min. Concrete Strength	3240	4000
Required Min. Concrete Strength	4500	5000



- ① Minimum concrete strength at time of prestress transfer.
- ② Minimum concrete strength when curing can be discontinued and girder transported and installed.
- ③ Required minimum concrete strength shall be used. Computed minimum concrete strength is for information only.

Fig. 5-397.506
 Oct. 15, 1969


DES: (1) M. H. D. DR: M. H. D. / W. K. APPROVED: 12-21-71
 CHK: (1) M. H. D. CHK: (1) M. H. D.
 Bridge No. 02522
 Sheet No. 17 of 35 Sheets

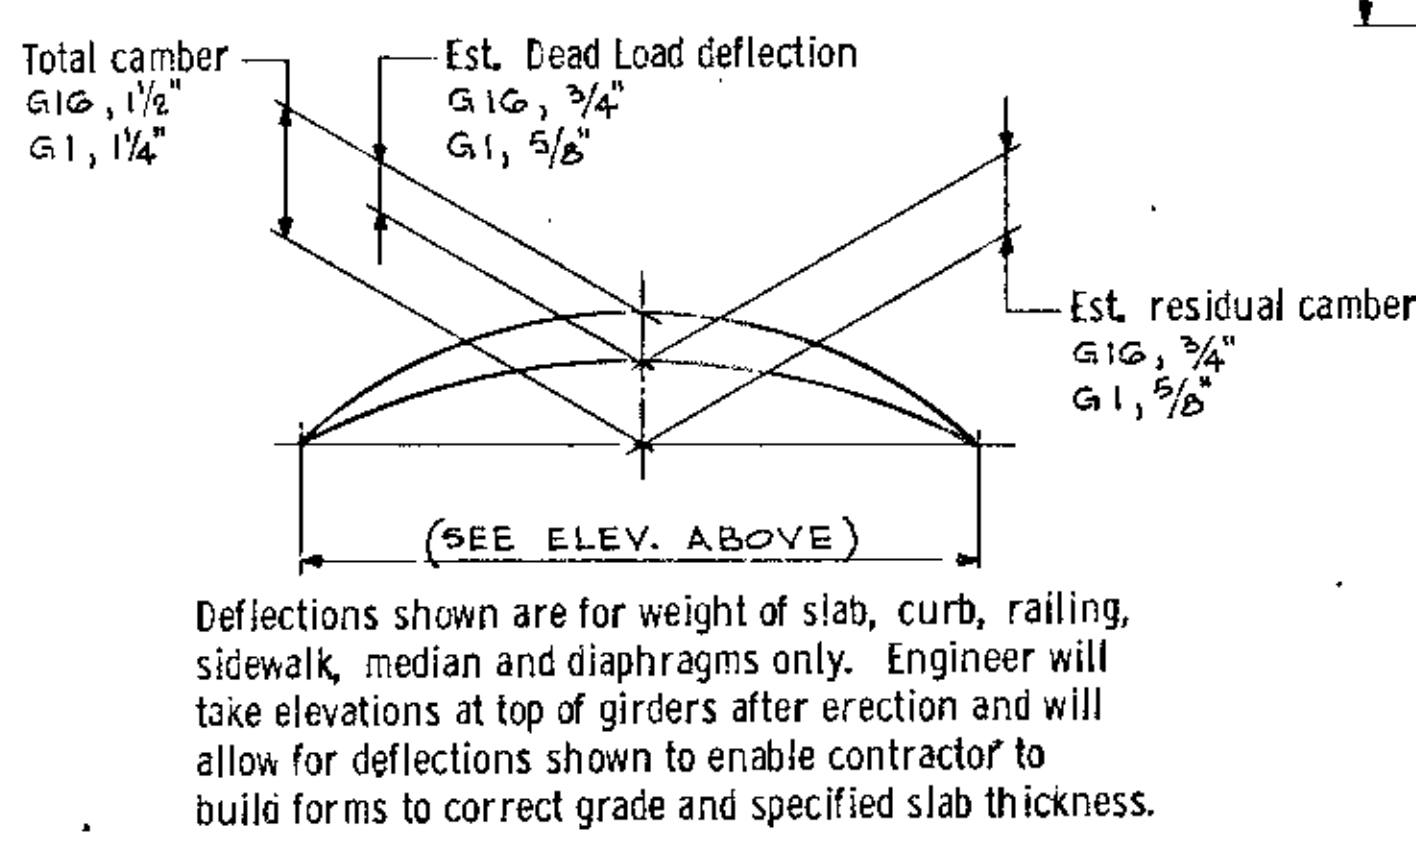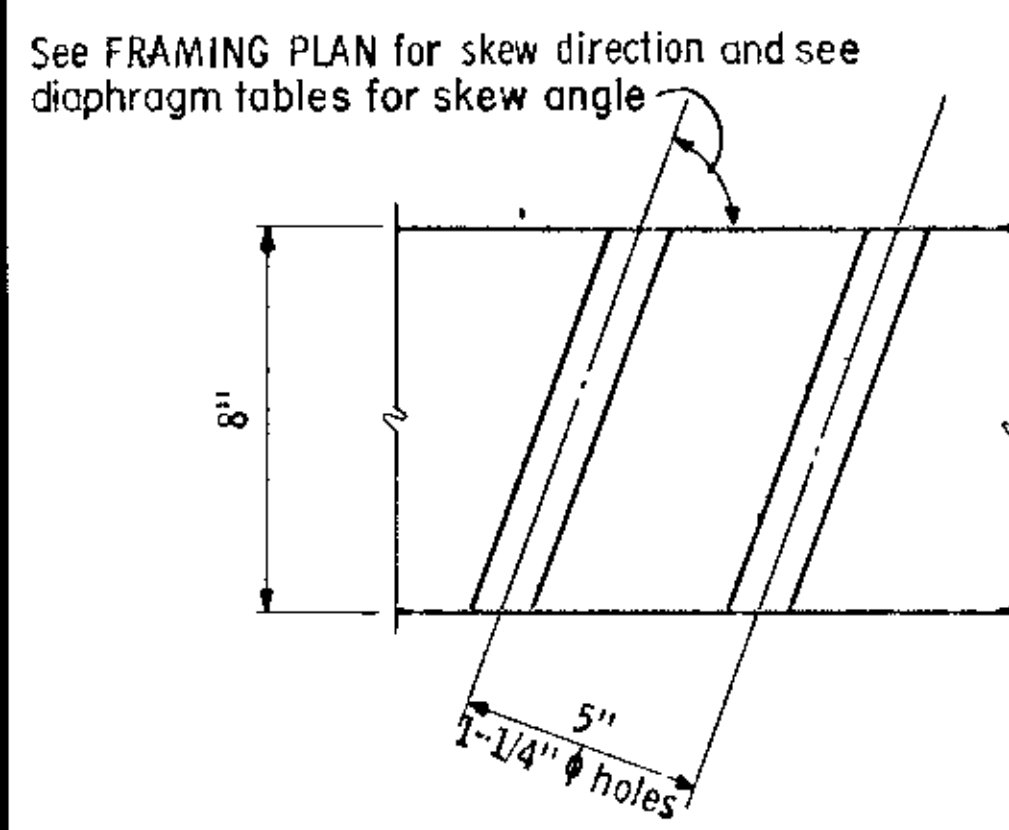


Intermediate stirrups may be shifted the minimum distance required to clear holes or inserts for intermediate diaphragms.

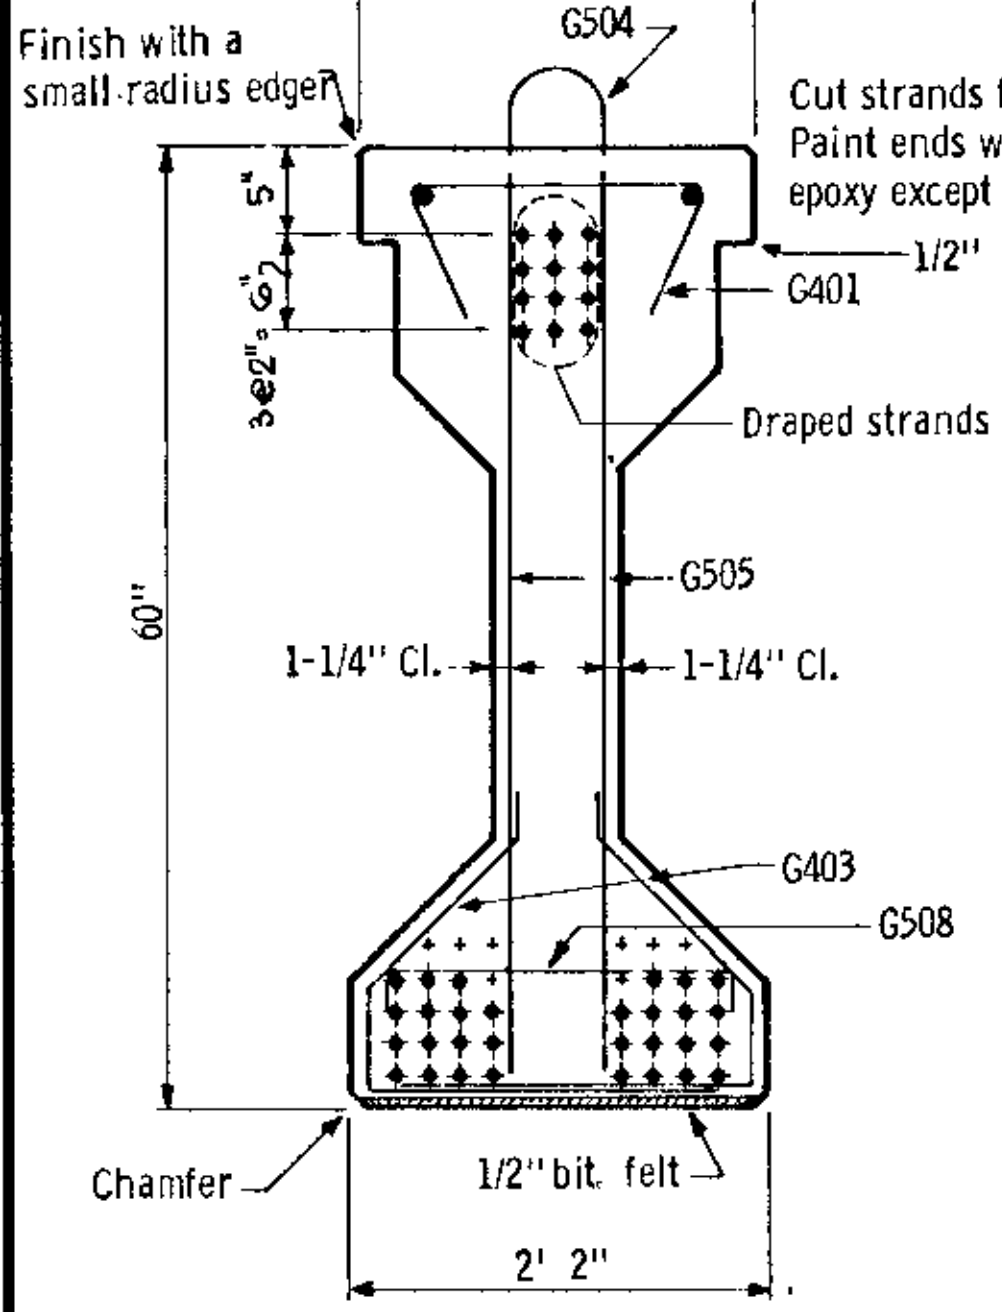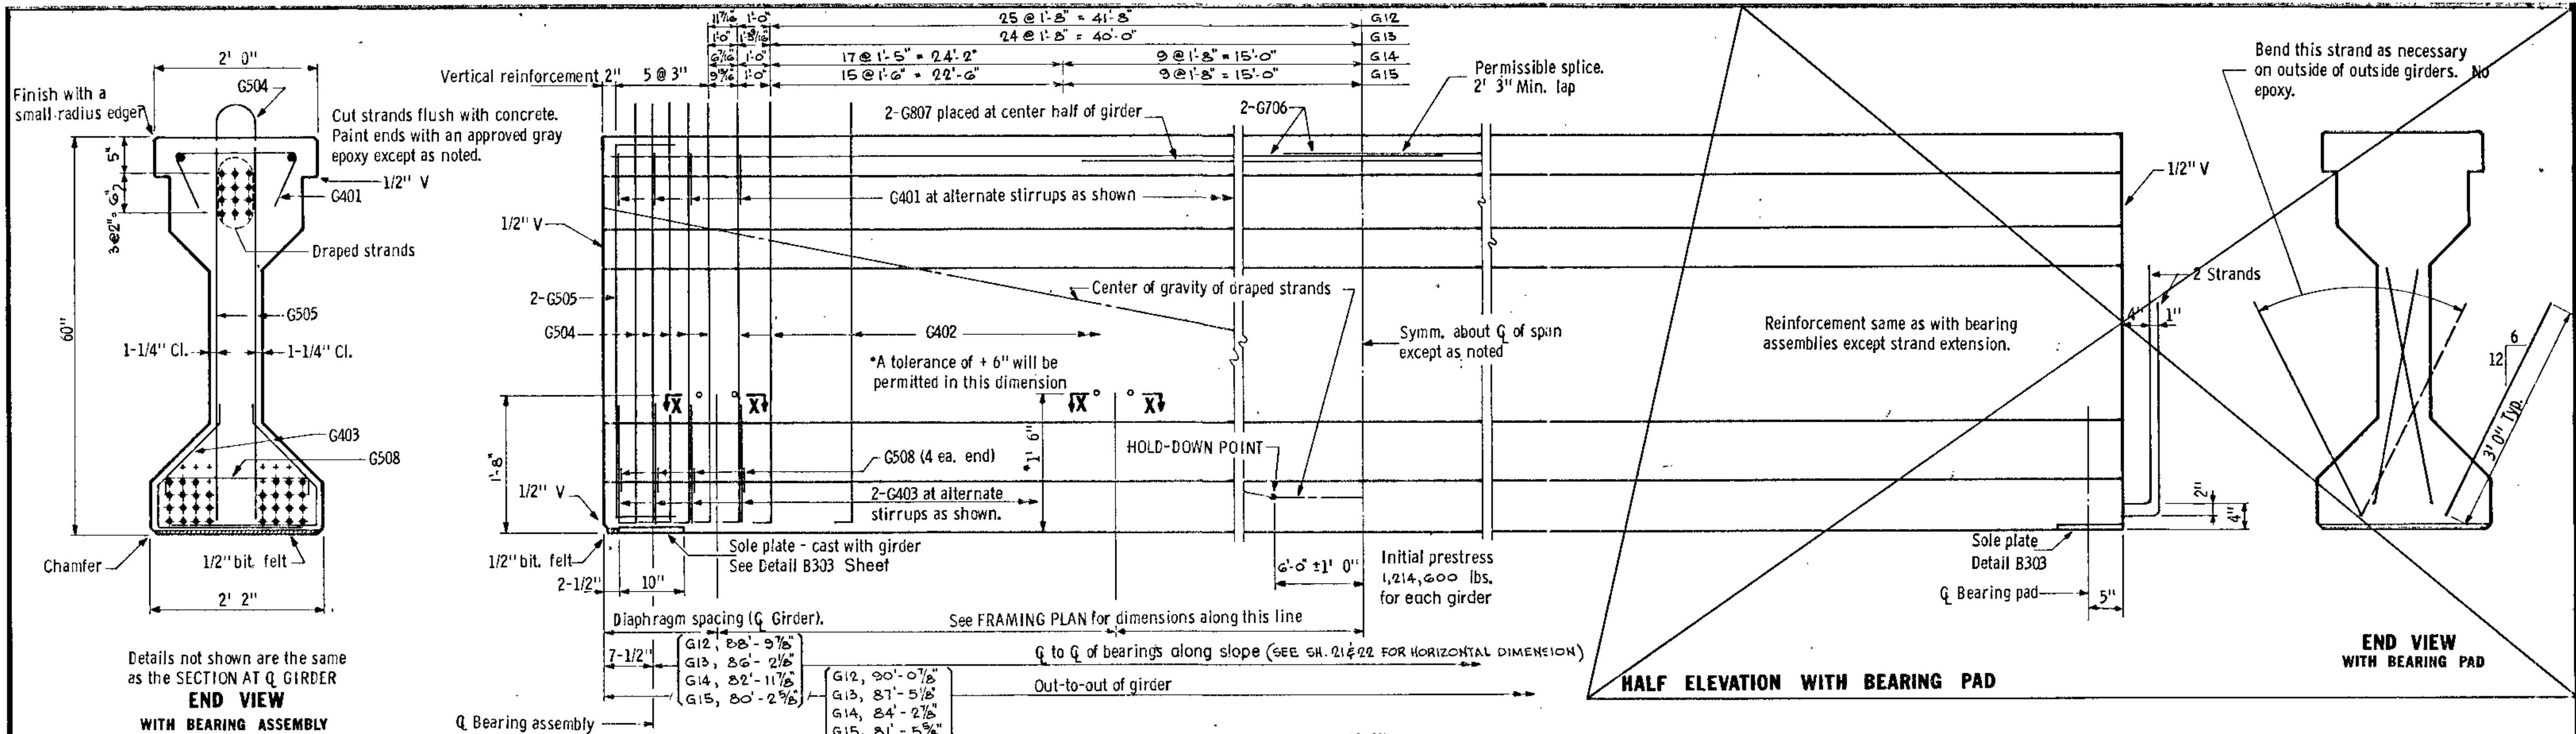


Details not shown are the same as the SECTION AT Q GIRDER
END VIEW WITH BEARING ASSEMBLY

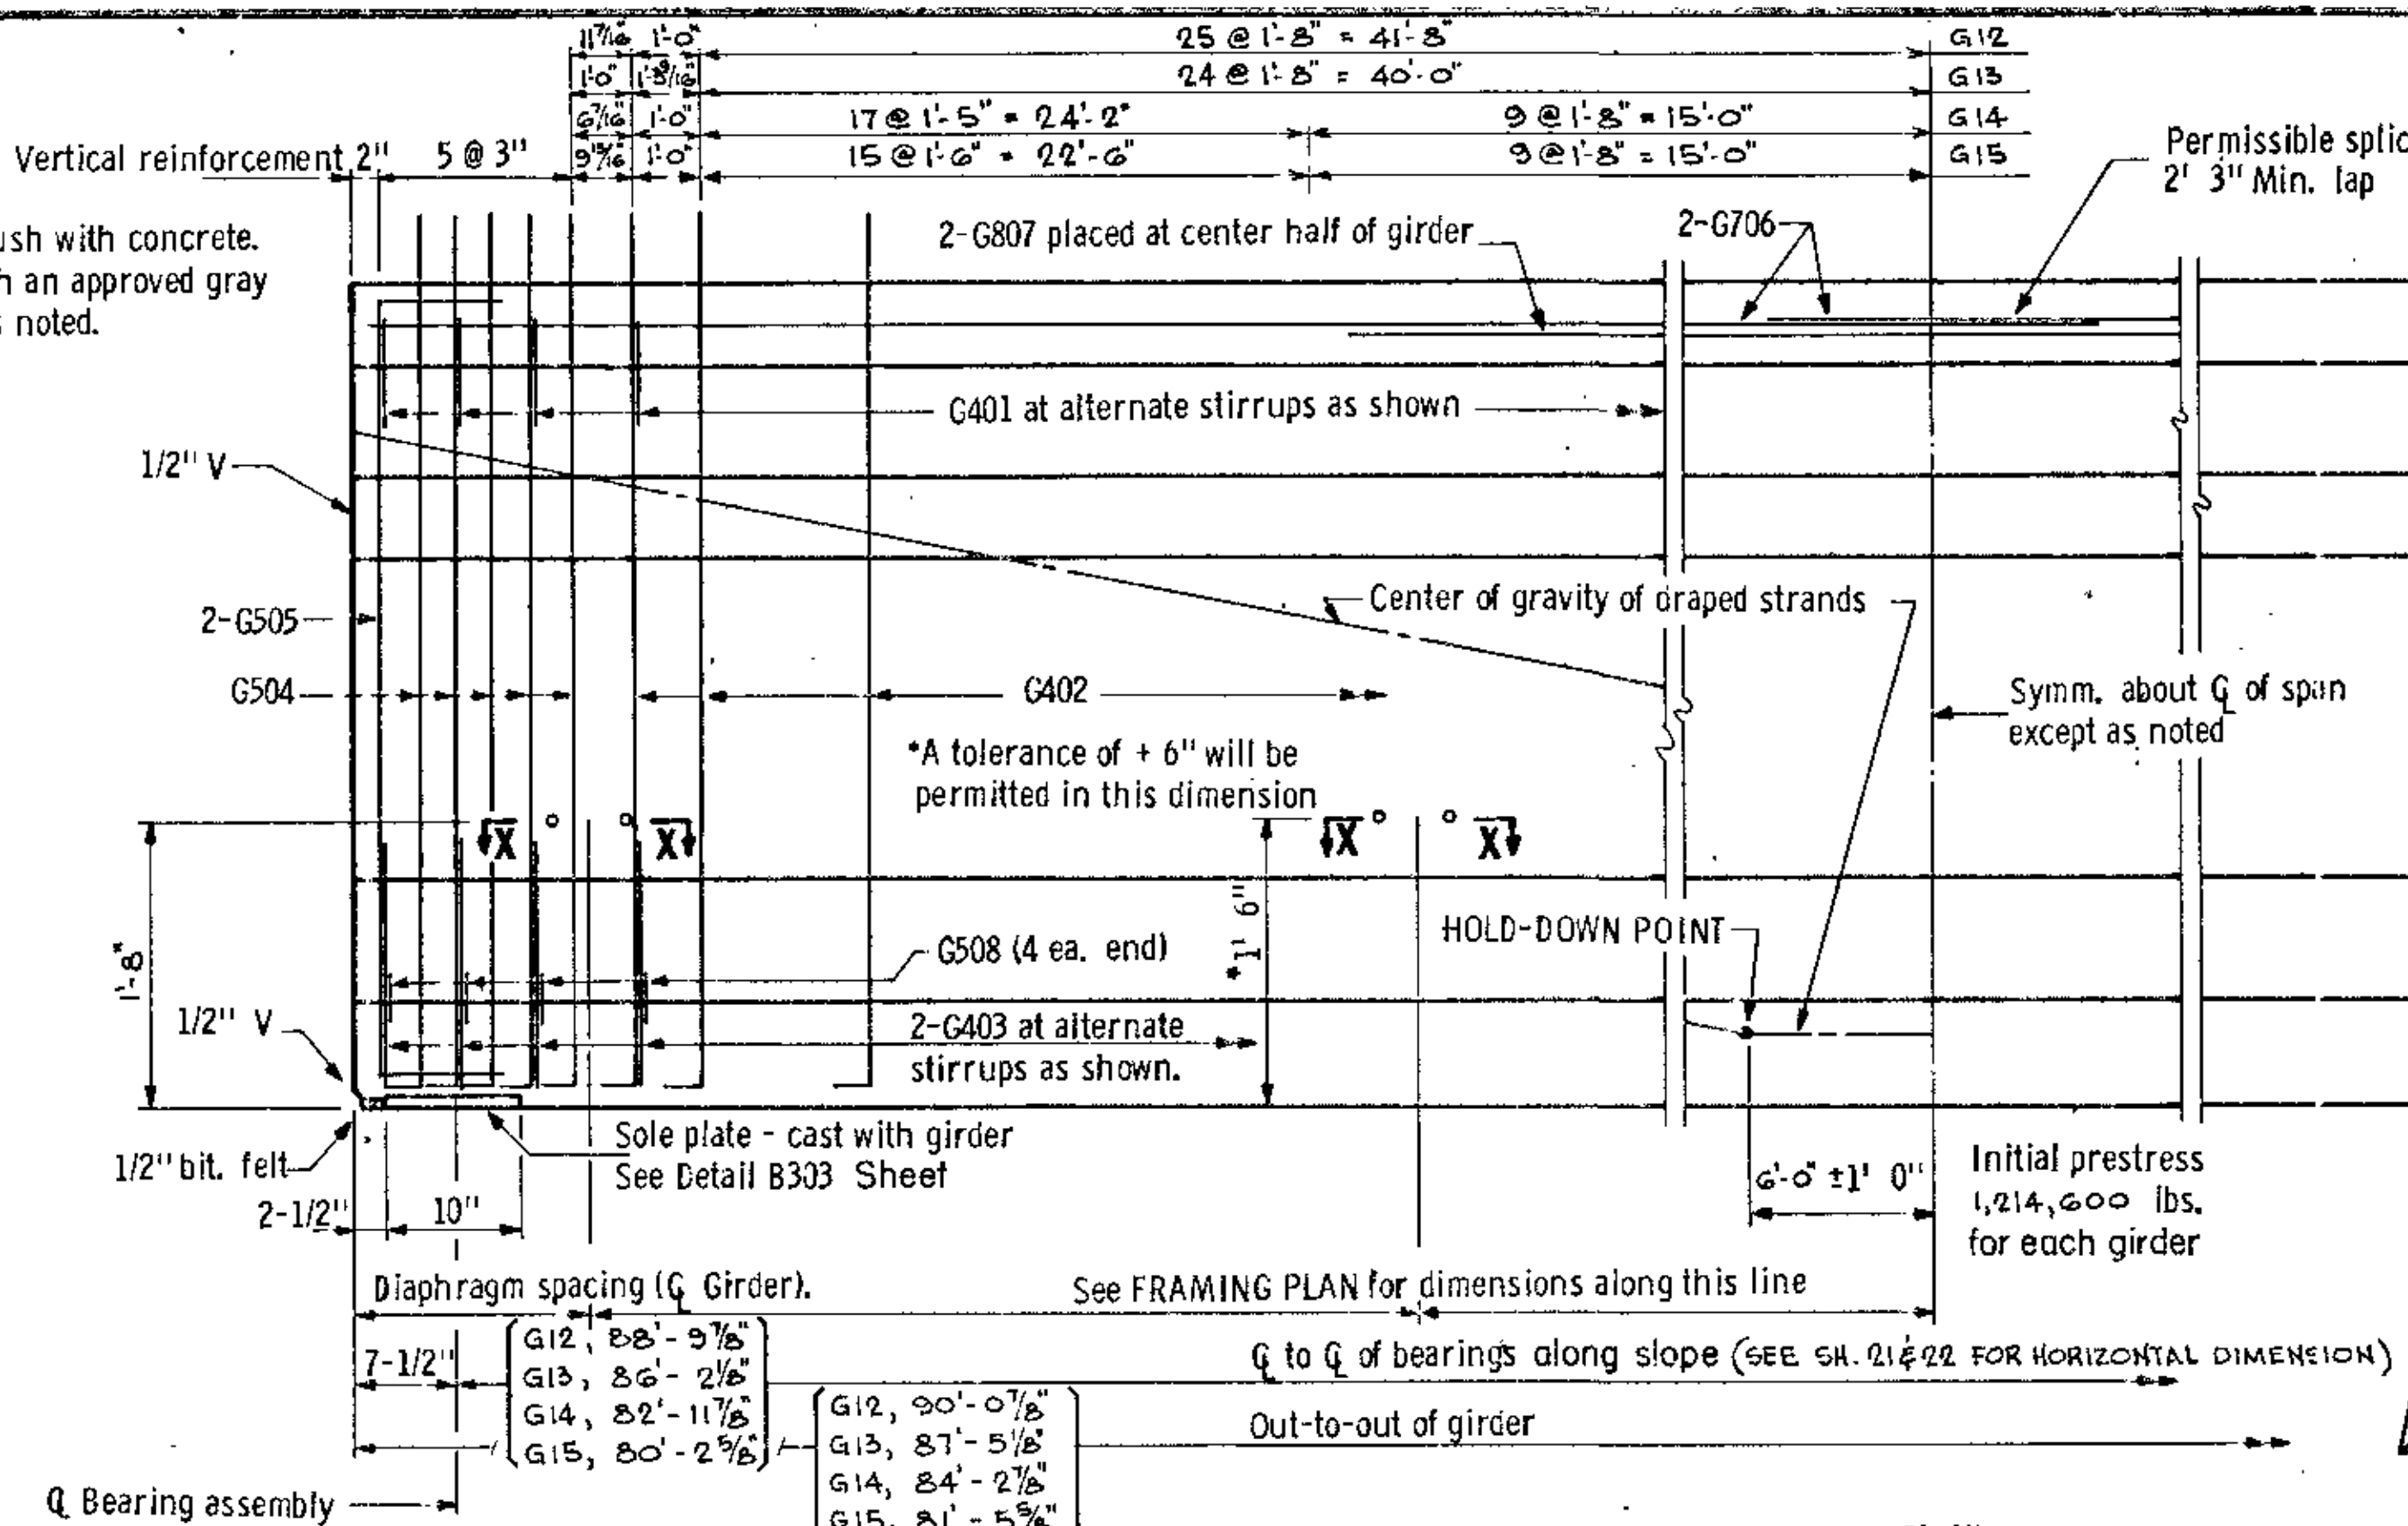


HALF ELEVATION WITH BEARING ASSEMBLY

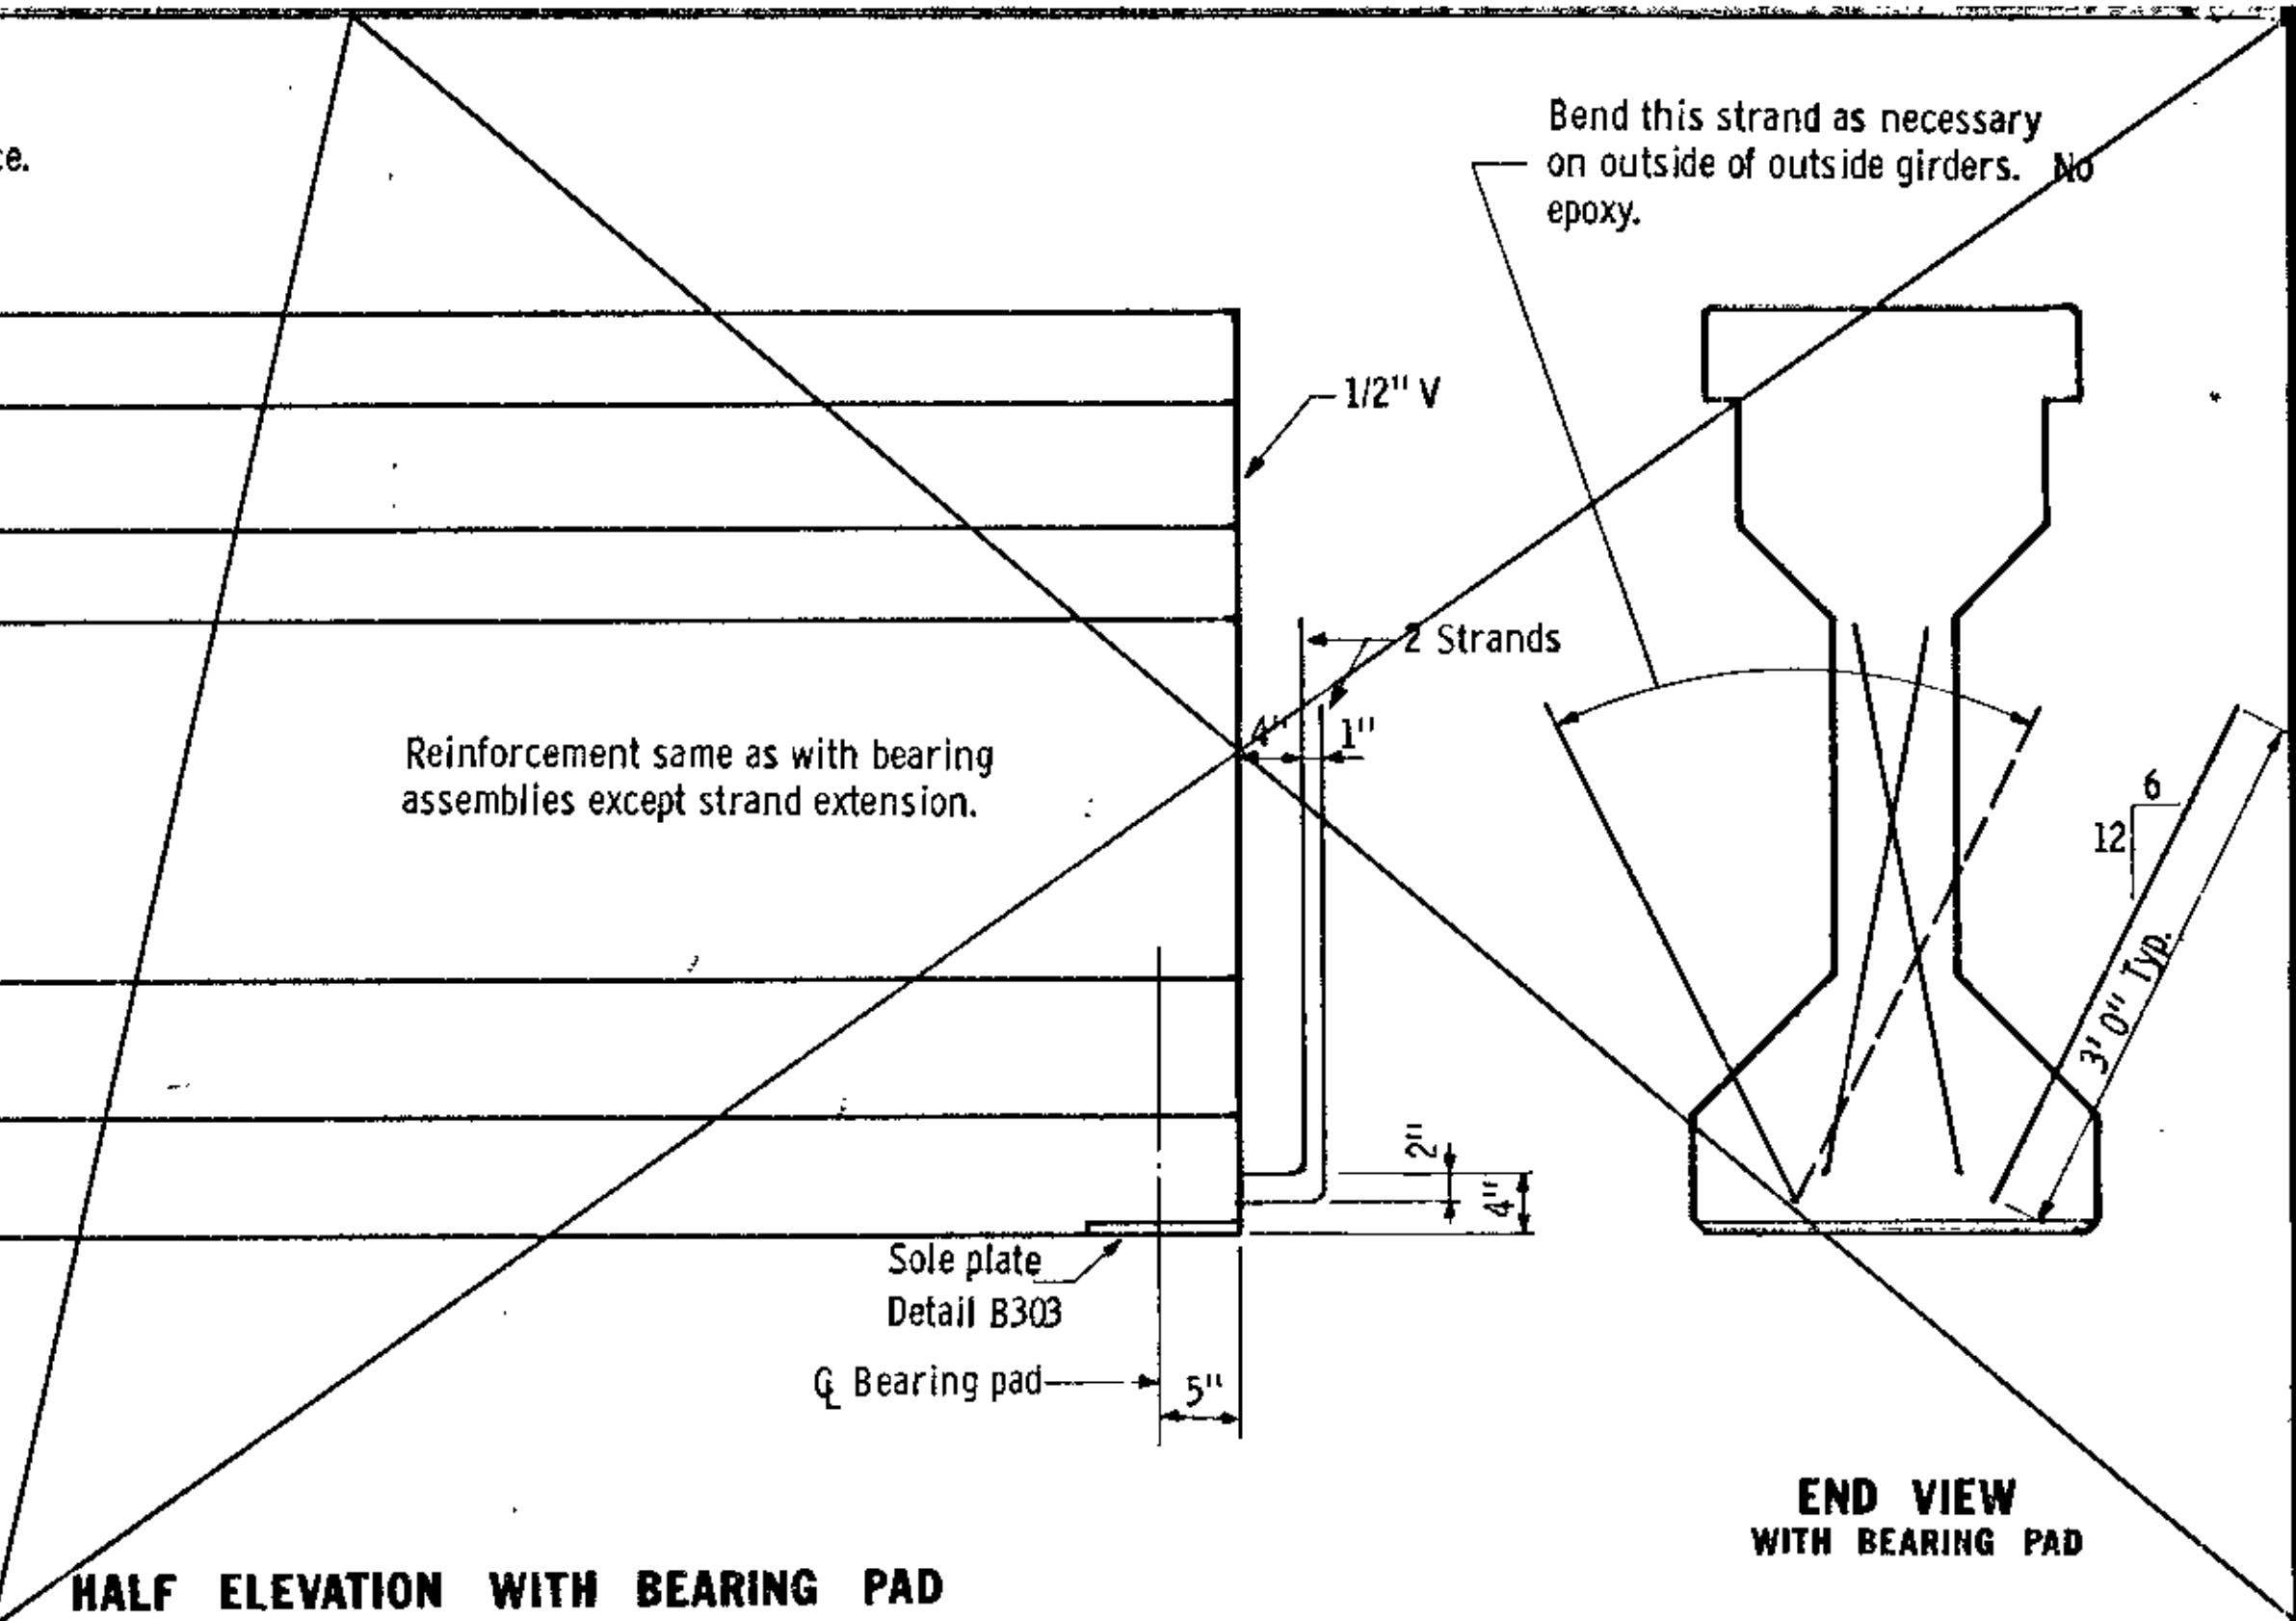


HALF ELEVATION WITH BEARING PAD

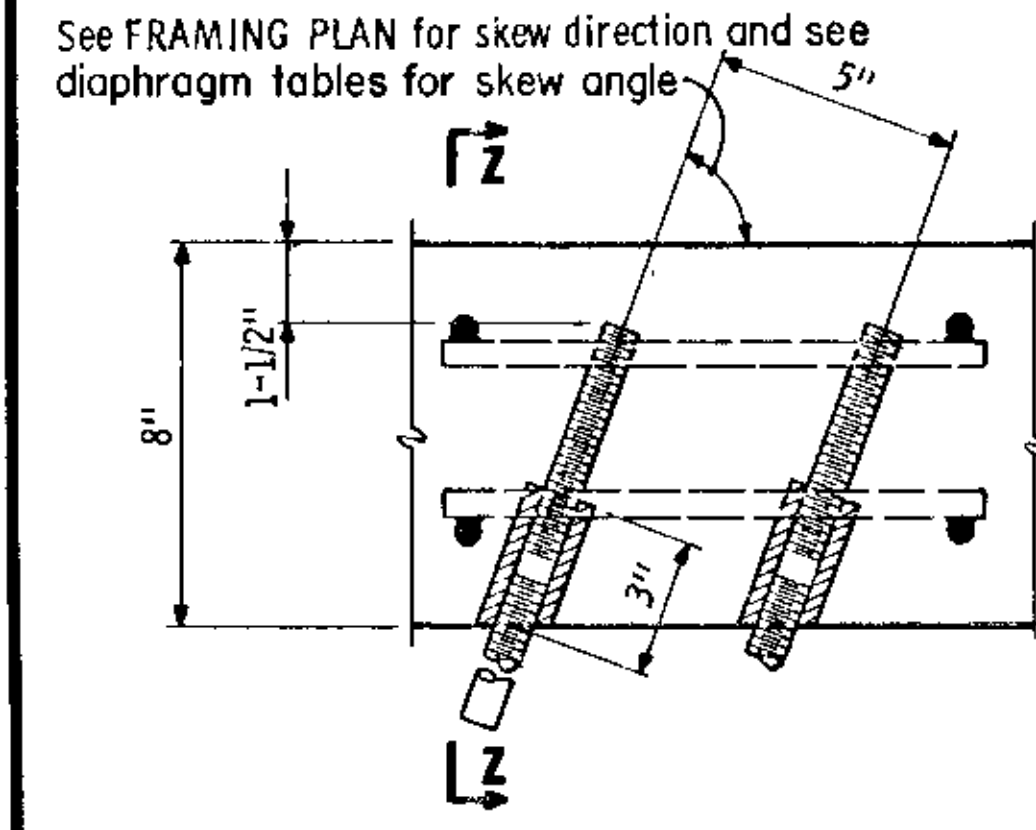


SECTION X - X
 USE AT FACIA GIRDER AND INTERIOR GIRDER WITH STAGGERED DIAPHRAGMS

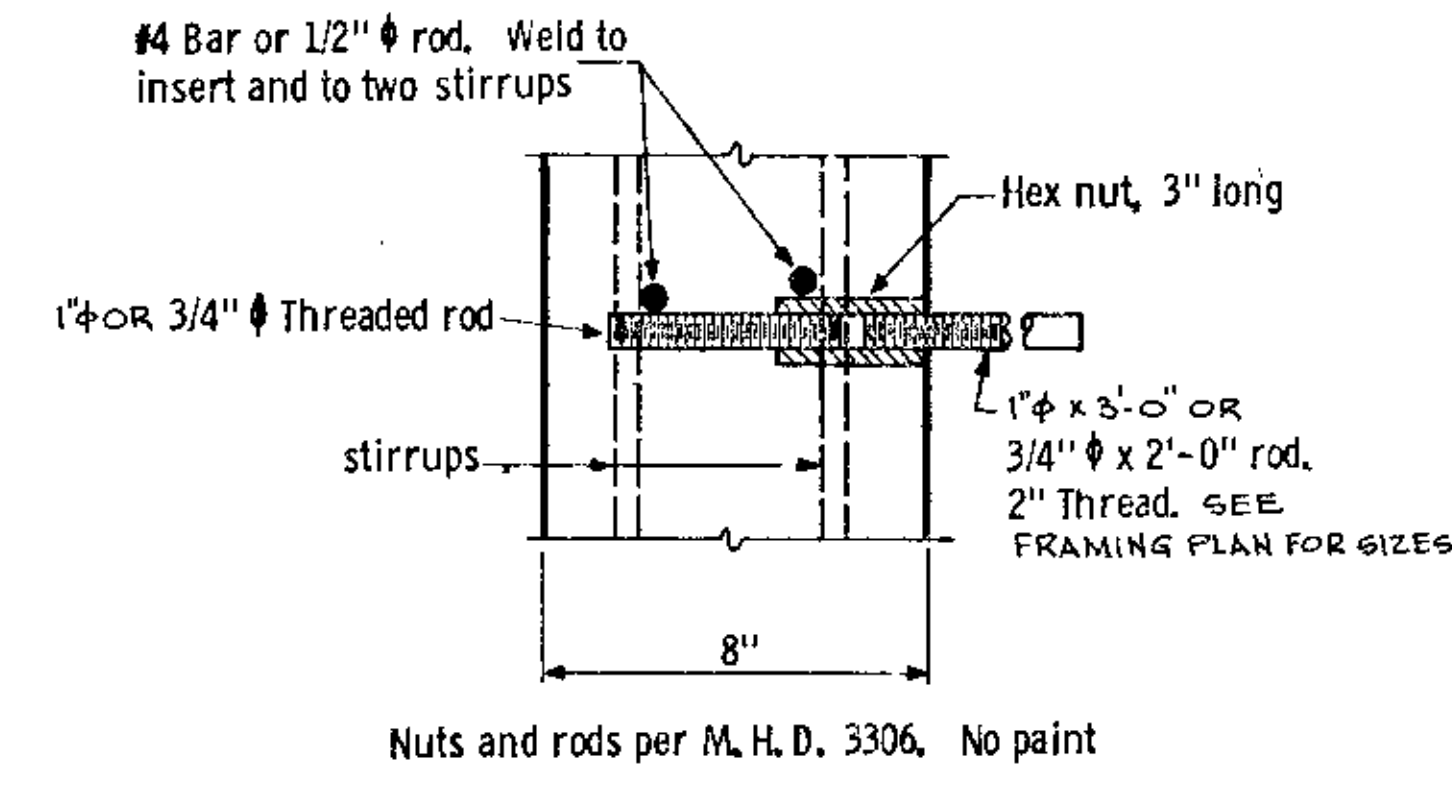


SECTION Z - Z

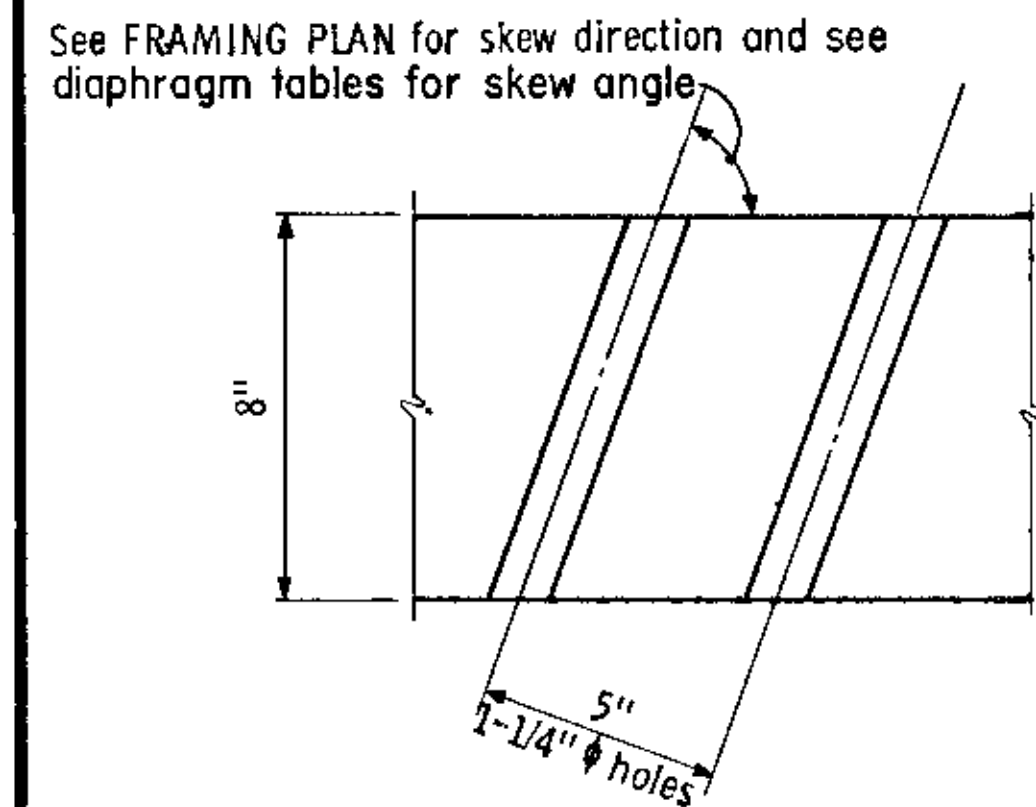


SECTION X - X
 USE AT INTERIOR GIRDER WITH CONTINUOUS DIAPHRAGMS

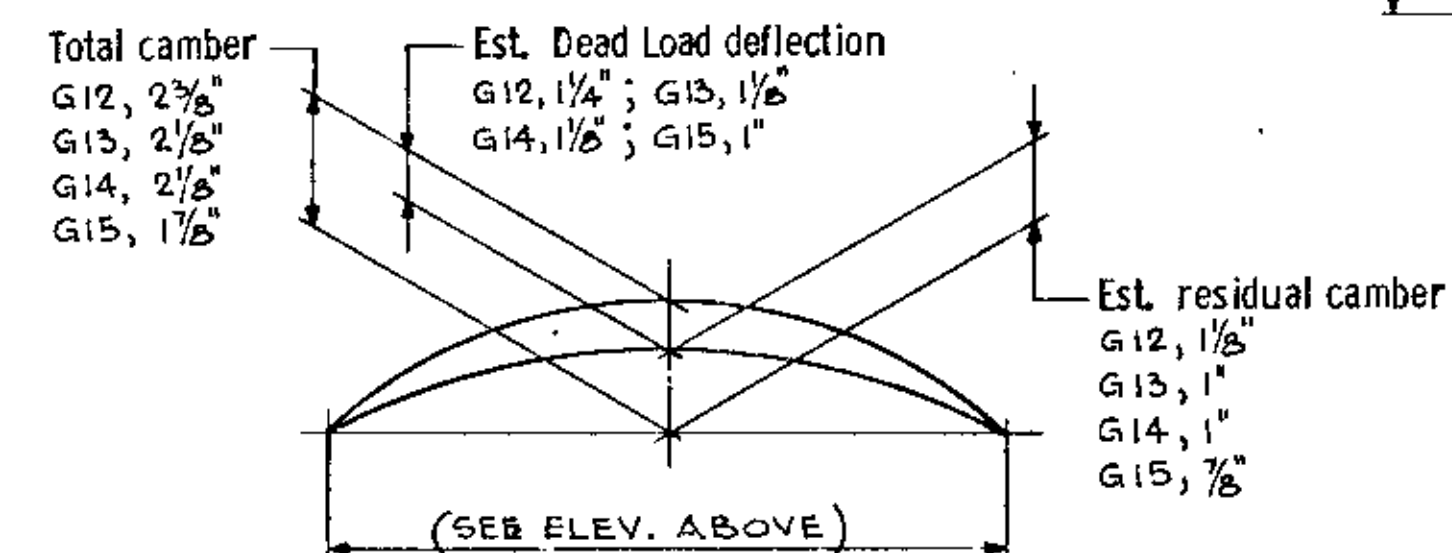

CAMBER DIAGRAM

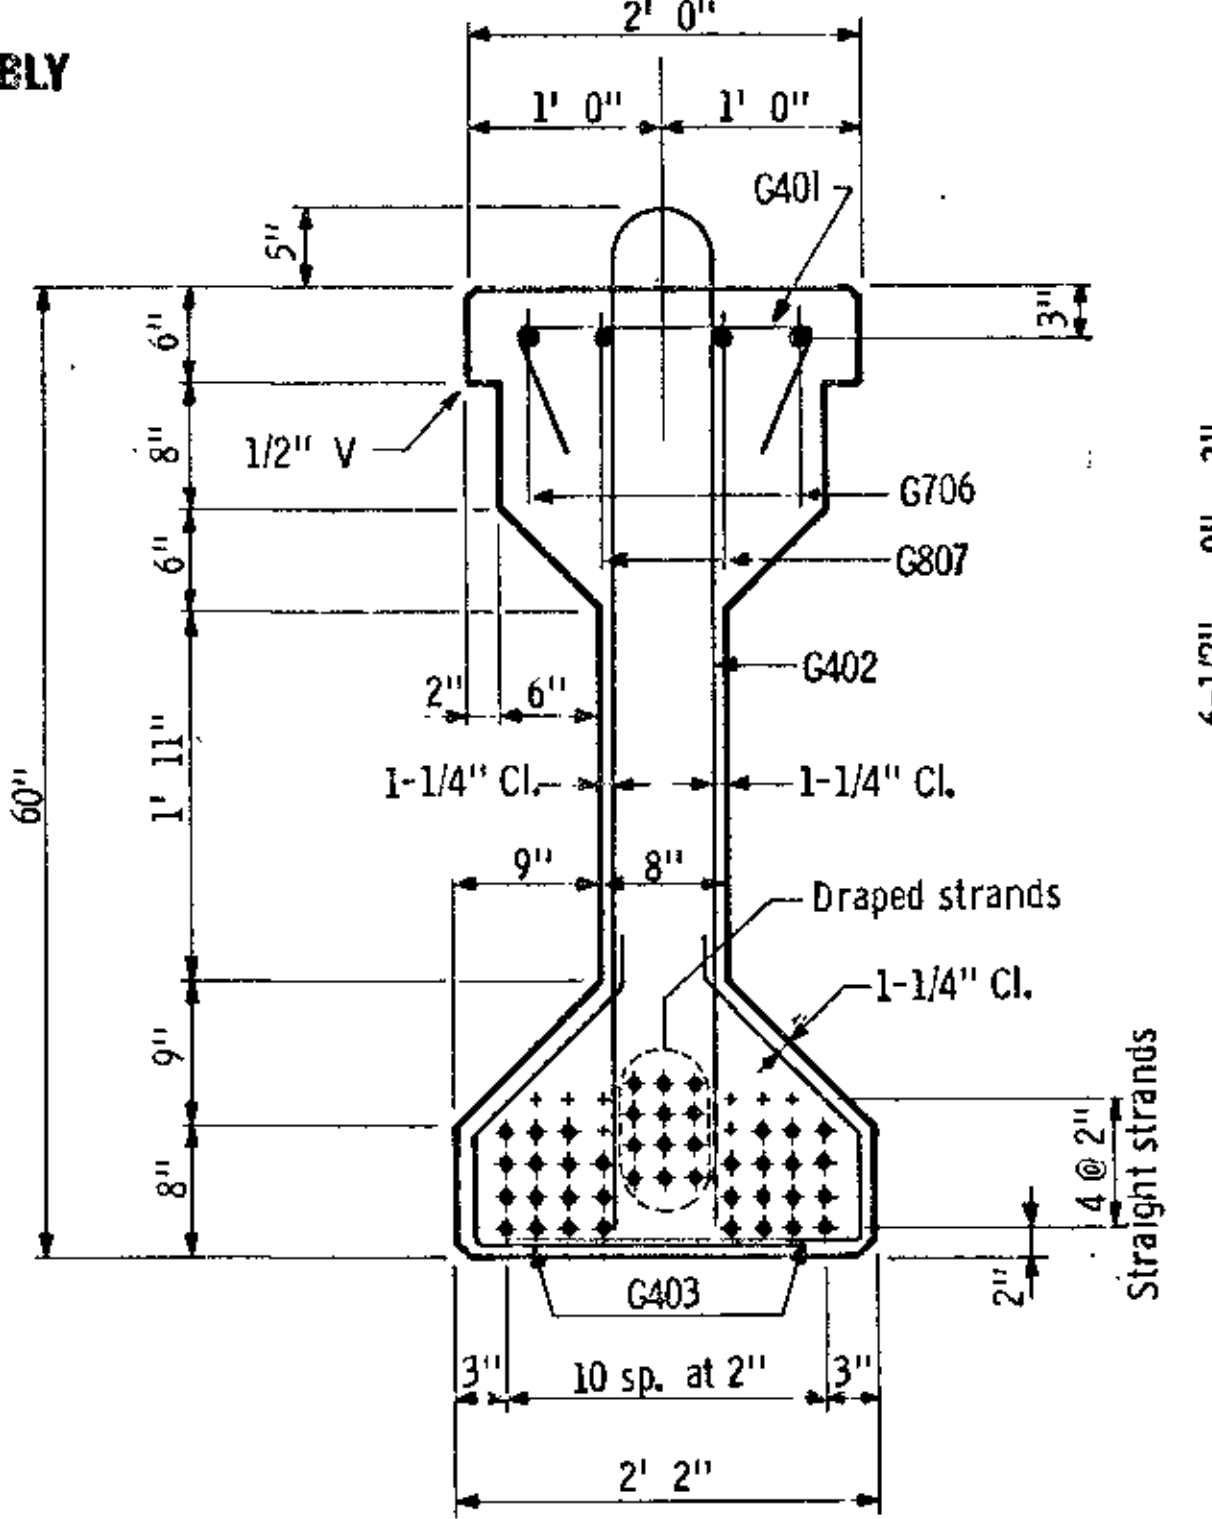

SECTION AT Q GIRDER

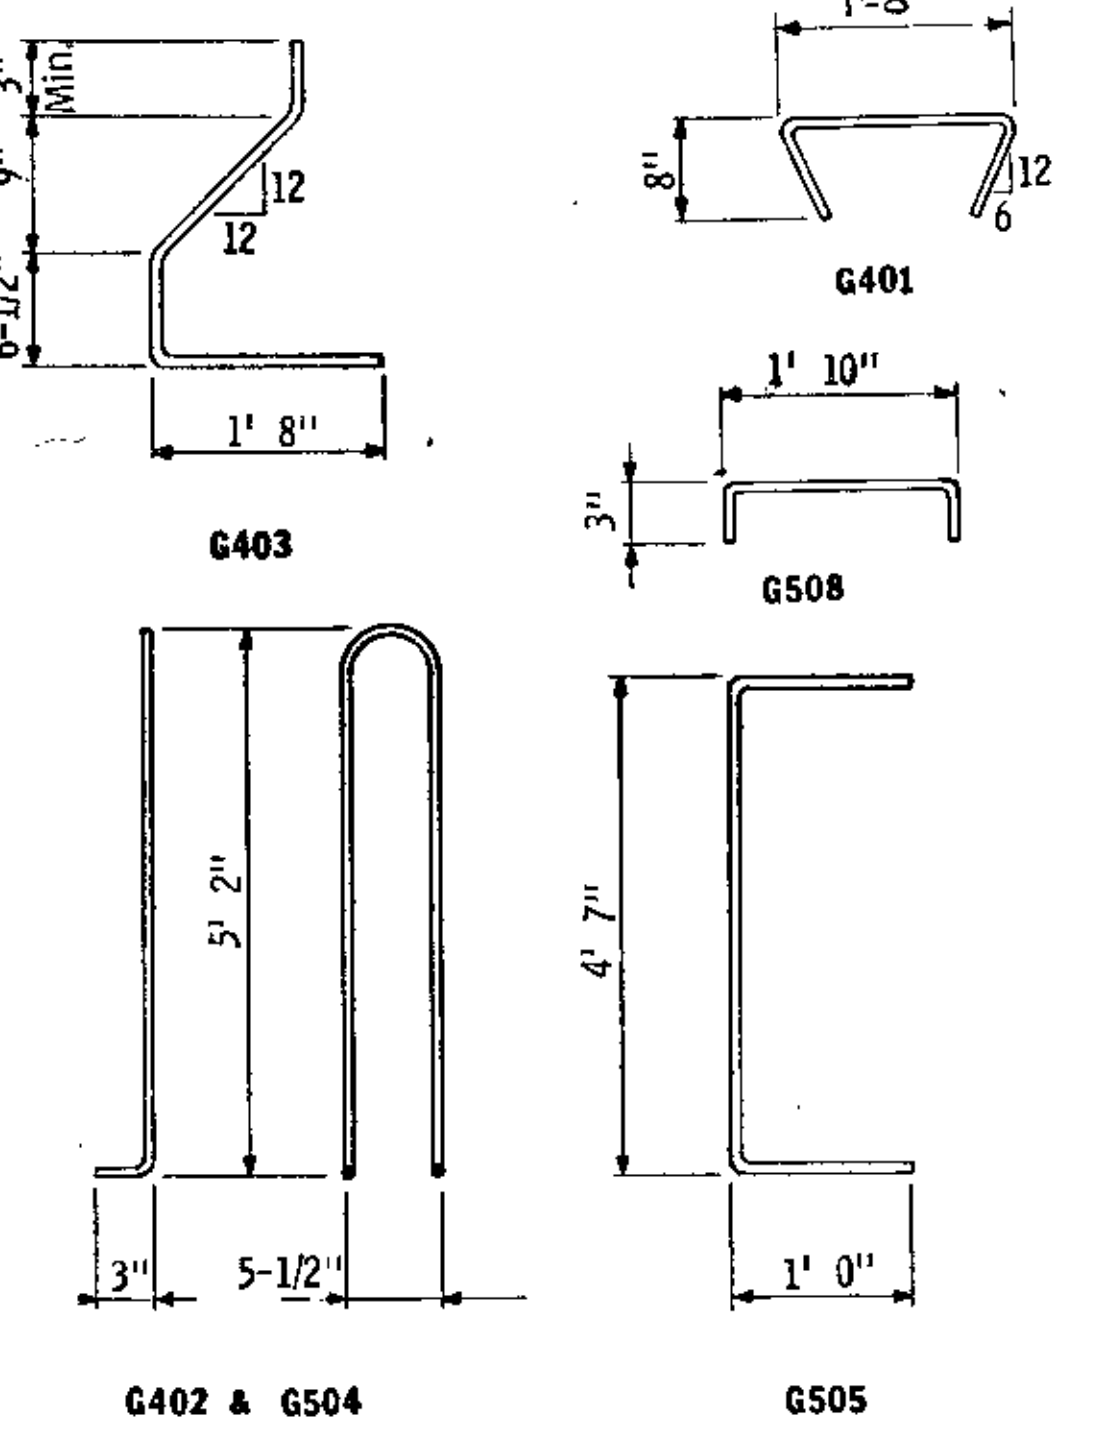

GENERAL NOTES:

- Tops of girders shall be rough floated and broomed transversely for bond. Provide handling hooks or devices as required by Contractor. Hooks or devices provided will be subject to approval of Engineer and shall be installed within 4' 0" of the end of girder.
- A modified strand pattern which does not change center of gravity of strands may be submitted to the Engineer for approval.
- A post-tensioned girder may be used as an alternate for the pretensioned design shown. M. H. D. will have plans available for the post-tensioned alternate.
- Each girder shall be marked, showing bridge number, casting date, and individual identification letters and numbers. Markings shall be made on the face of the girder, near the end, so located that they will be exposed after the end diaphragms have been cast. Facia girders shall be marked on an inside face. All markings shall be stenciled and be clearly legible. For location of girders, see framing plan.
- All material and work shown or noted on this sheet shall be included in unit price bid for prestressed concrete girders. See M. H. D. 2405. See framing plan for girder ends marked "X".
- Approximate weight of girder G12, 43.8 TONS; G13, 42.5 TONS; G14, 41.0 TONS; G15, 39.6 TONS

	① ③ f'ci	② ③ f'c
Computed Min. Concrete Strength	4160	4850
Required Min. Concrete Strength	4500	5000






- ① Minimum concrete strength at time of prestress transfer.
- ② Minimum concrete strength when curing can be discontinued and girder transported and installed.
- ③ Required minimum concrete strength shall be used. Computed minimum concrete strength is for information only.

Y = distance of Center of Gravity of strands from bottom of girder. All strands spaced 2" c-c, horizontally and vertically.
 All strands 1/2" φ 270 kip, ultimate strength.
 *A tolerance of ± 2" will be permitted in this dimension.

GIRDERS G12, G13, G14, G15
 First digit of bar mark indicates bar size. All bar dimensions are out-to-out.
 AS BUILT 10-10-73 B. Saha

TITLE: 60" PRESTRESSED CONCRETE GIRDER (PRETENSIONED) TYPE 60-86	DES: <i>[Signature]</i> CHK: <i>[Signature]</i>	DR: M.H.D./W.K. CHK: <i>[Signature]</i>	APPROVED: 12-21-71
--	--	--	-----------------------

Fig. 5-397.506
 Oct. 15, 1969

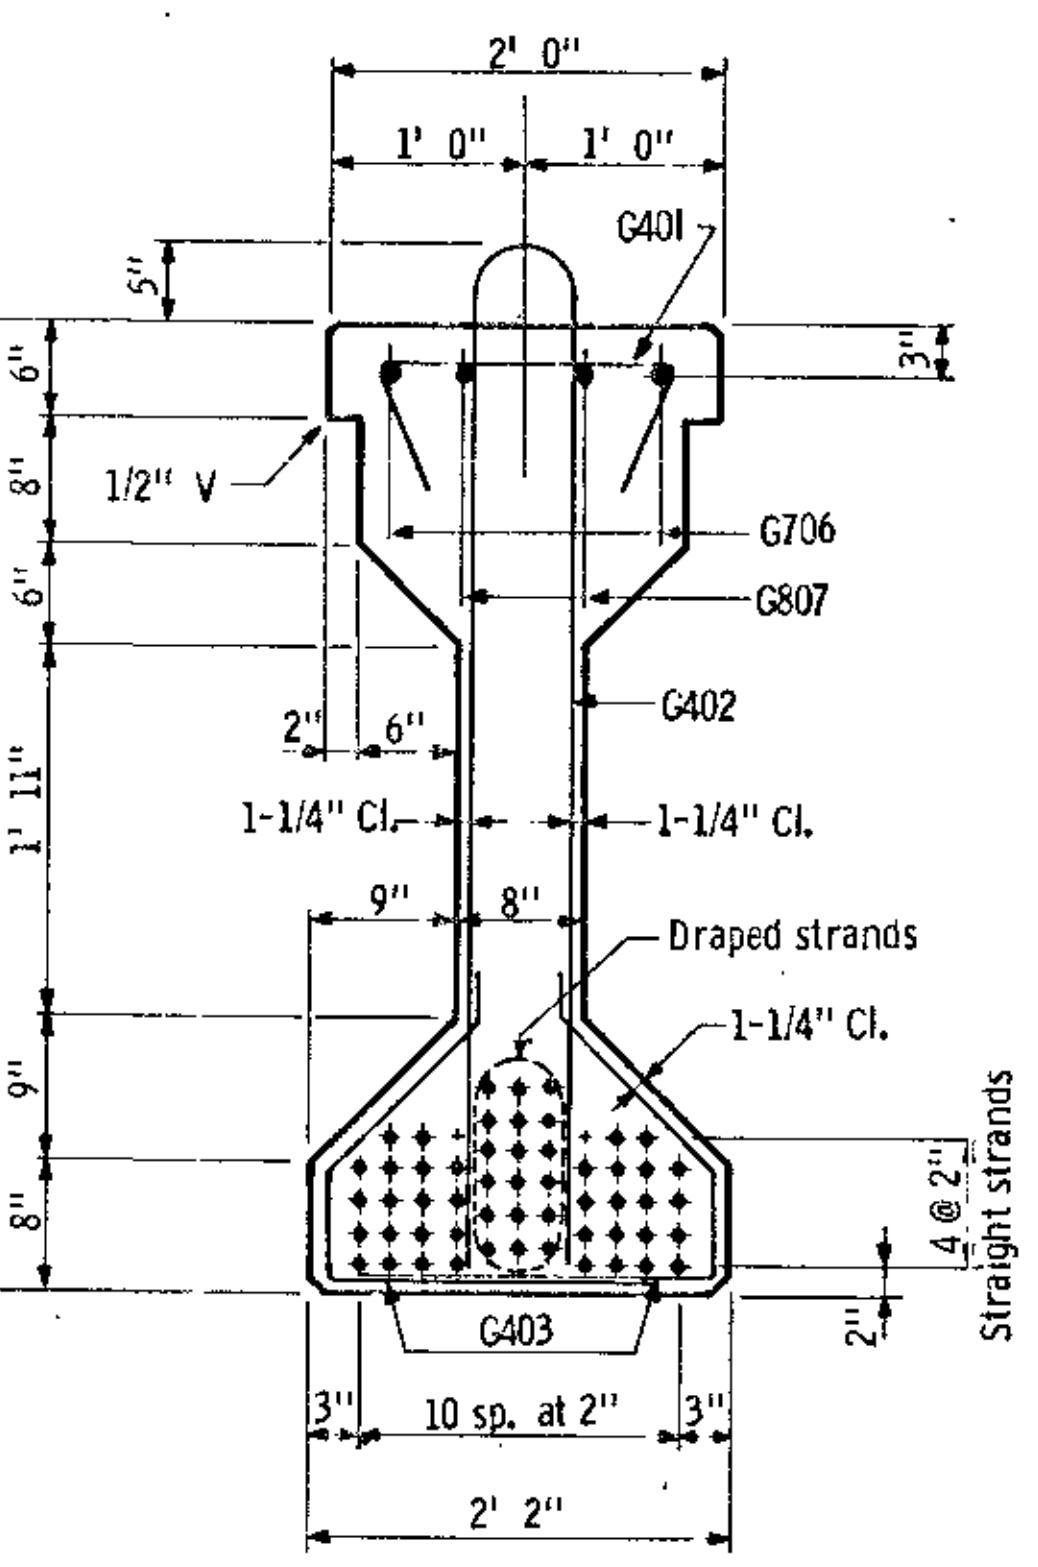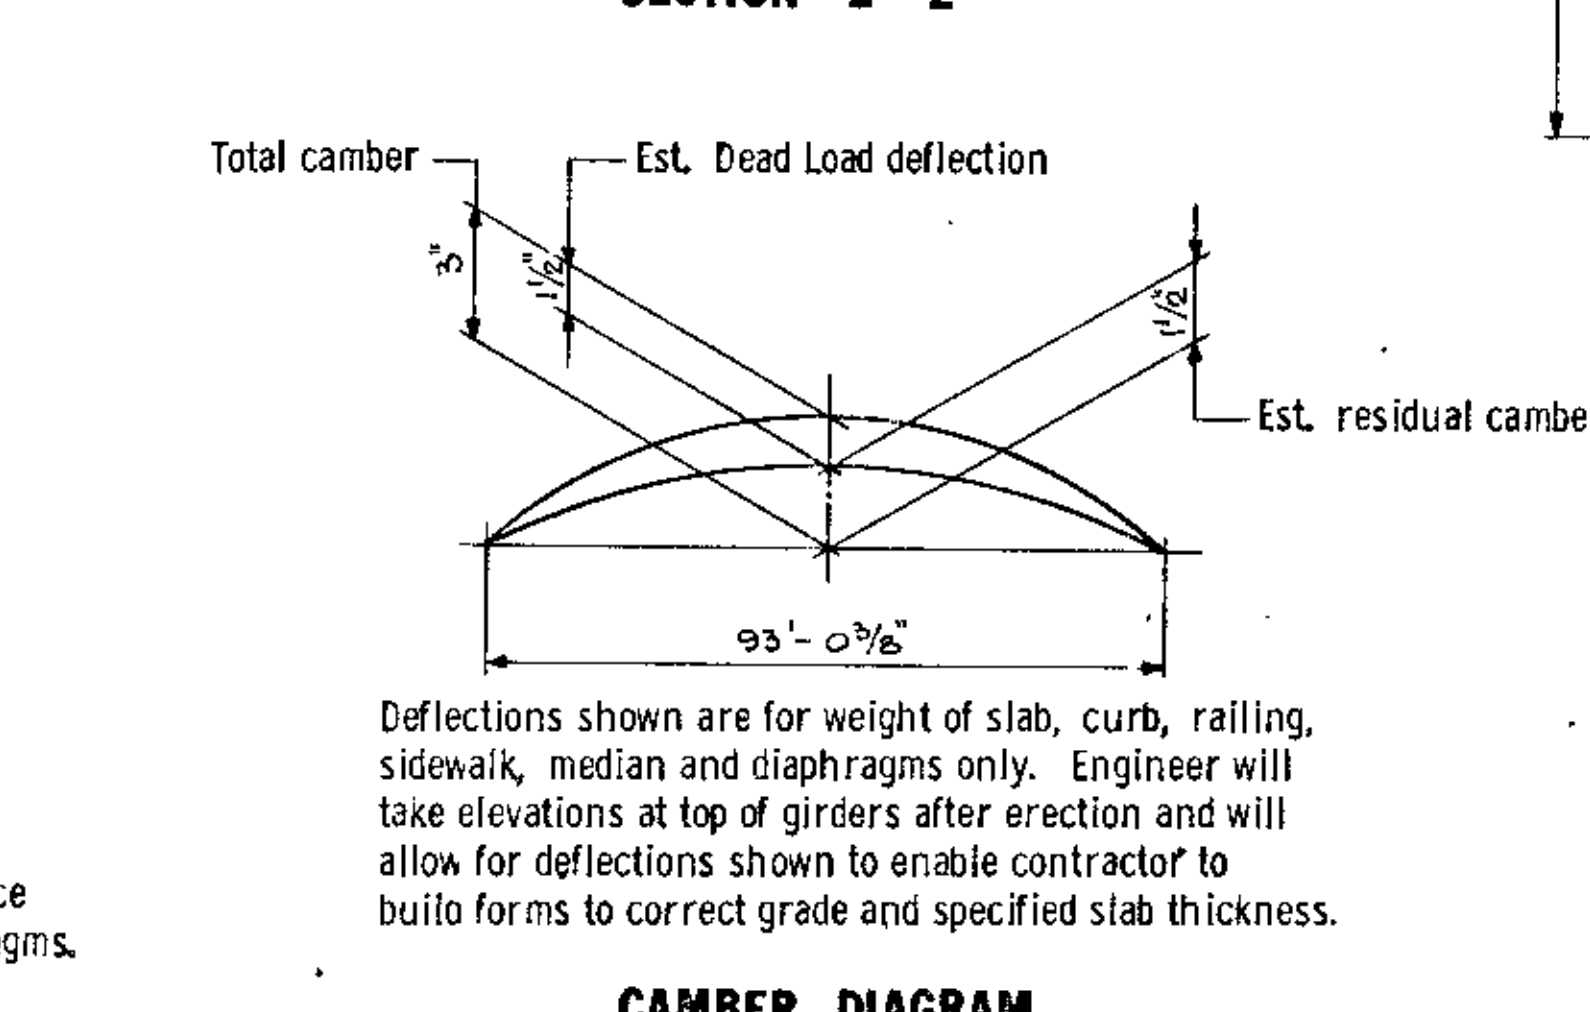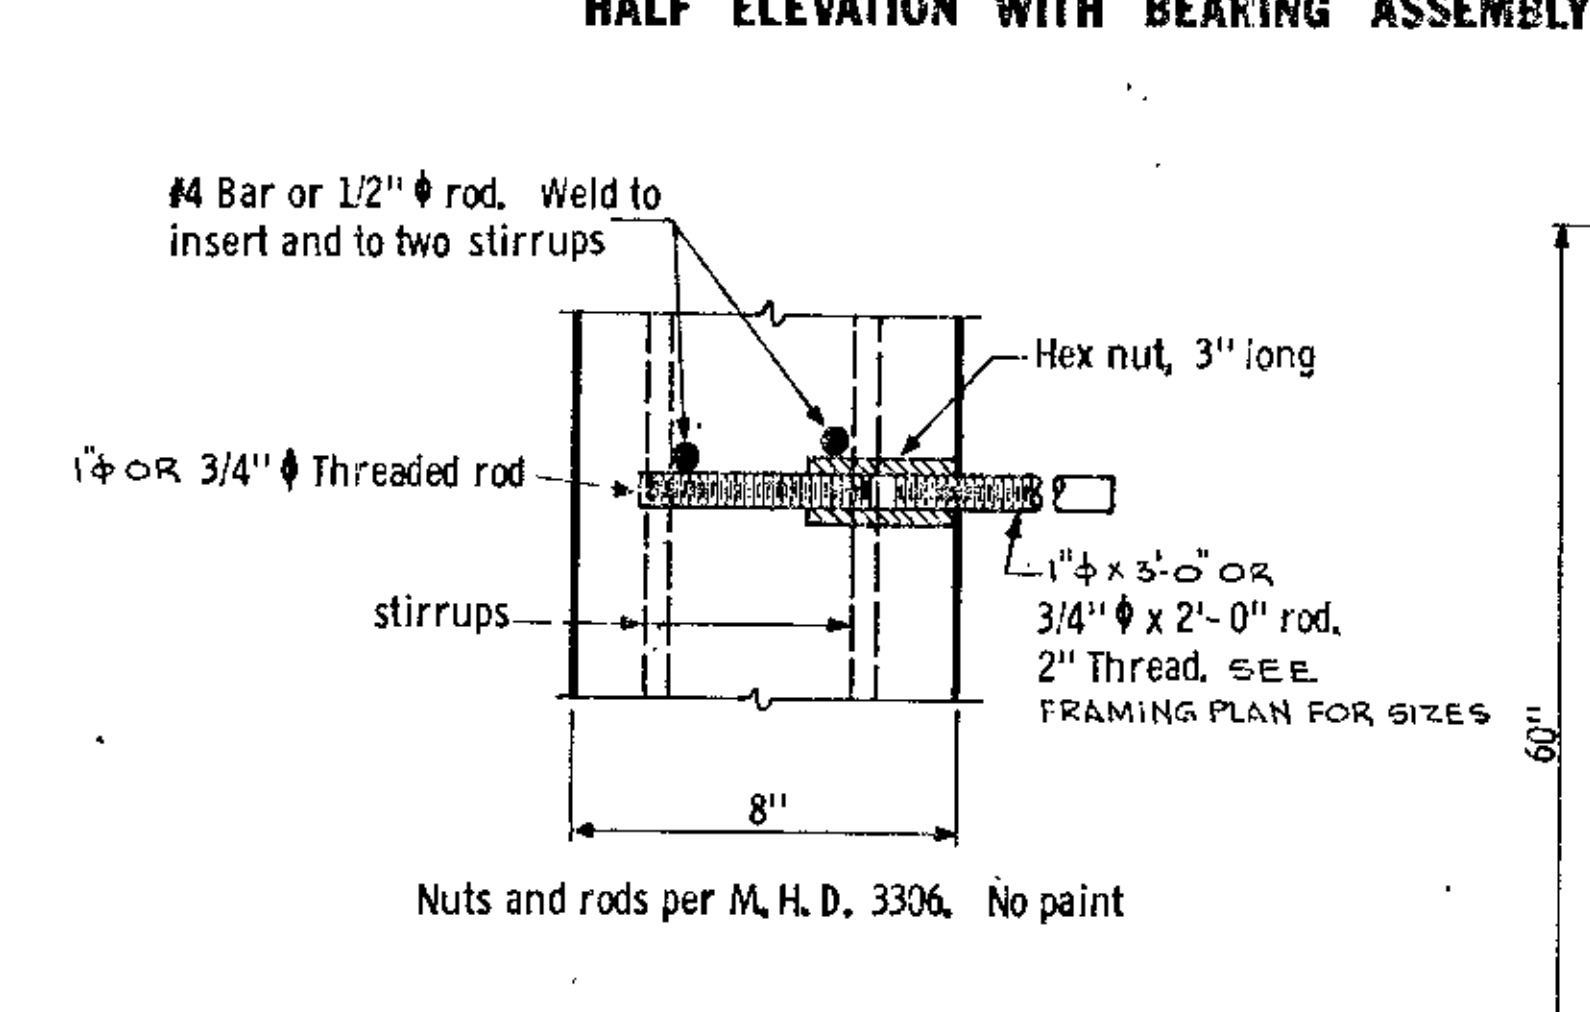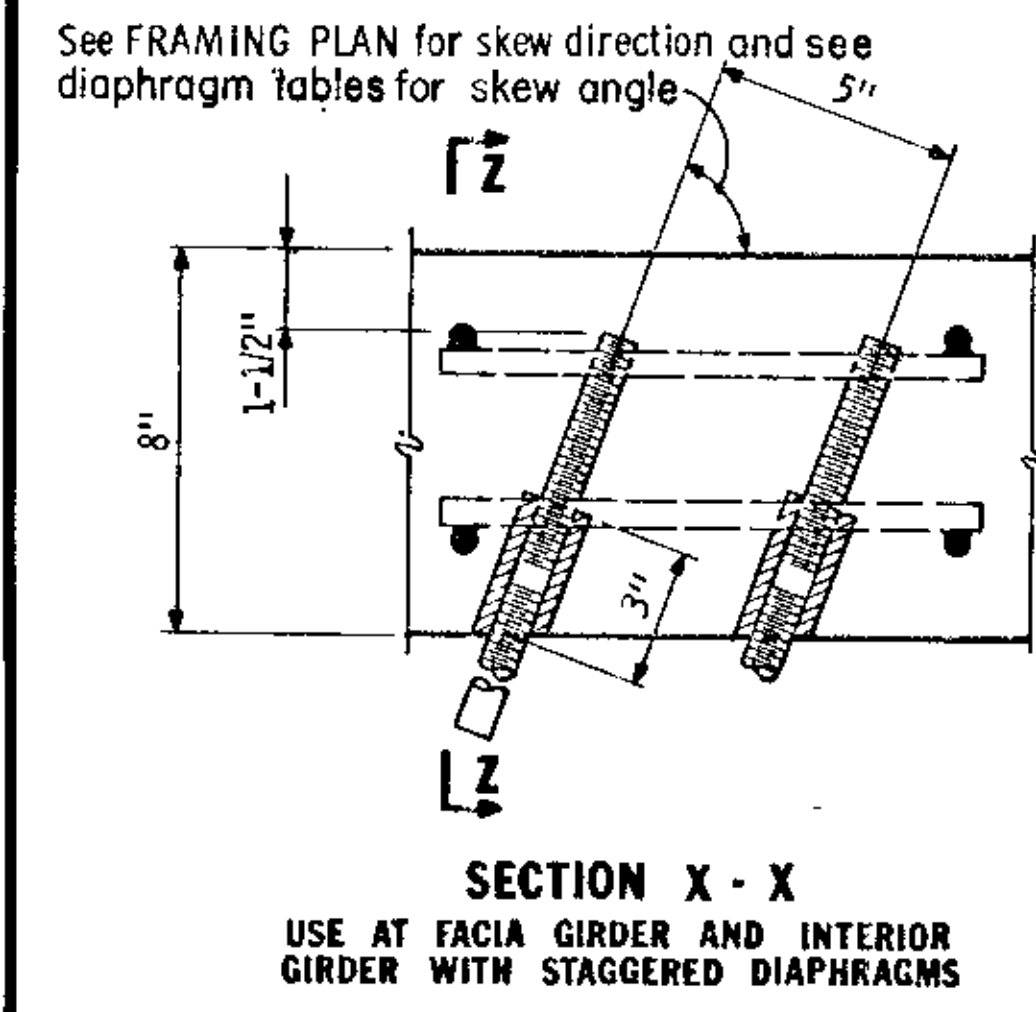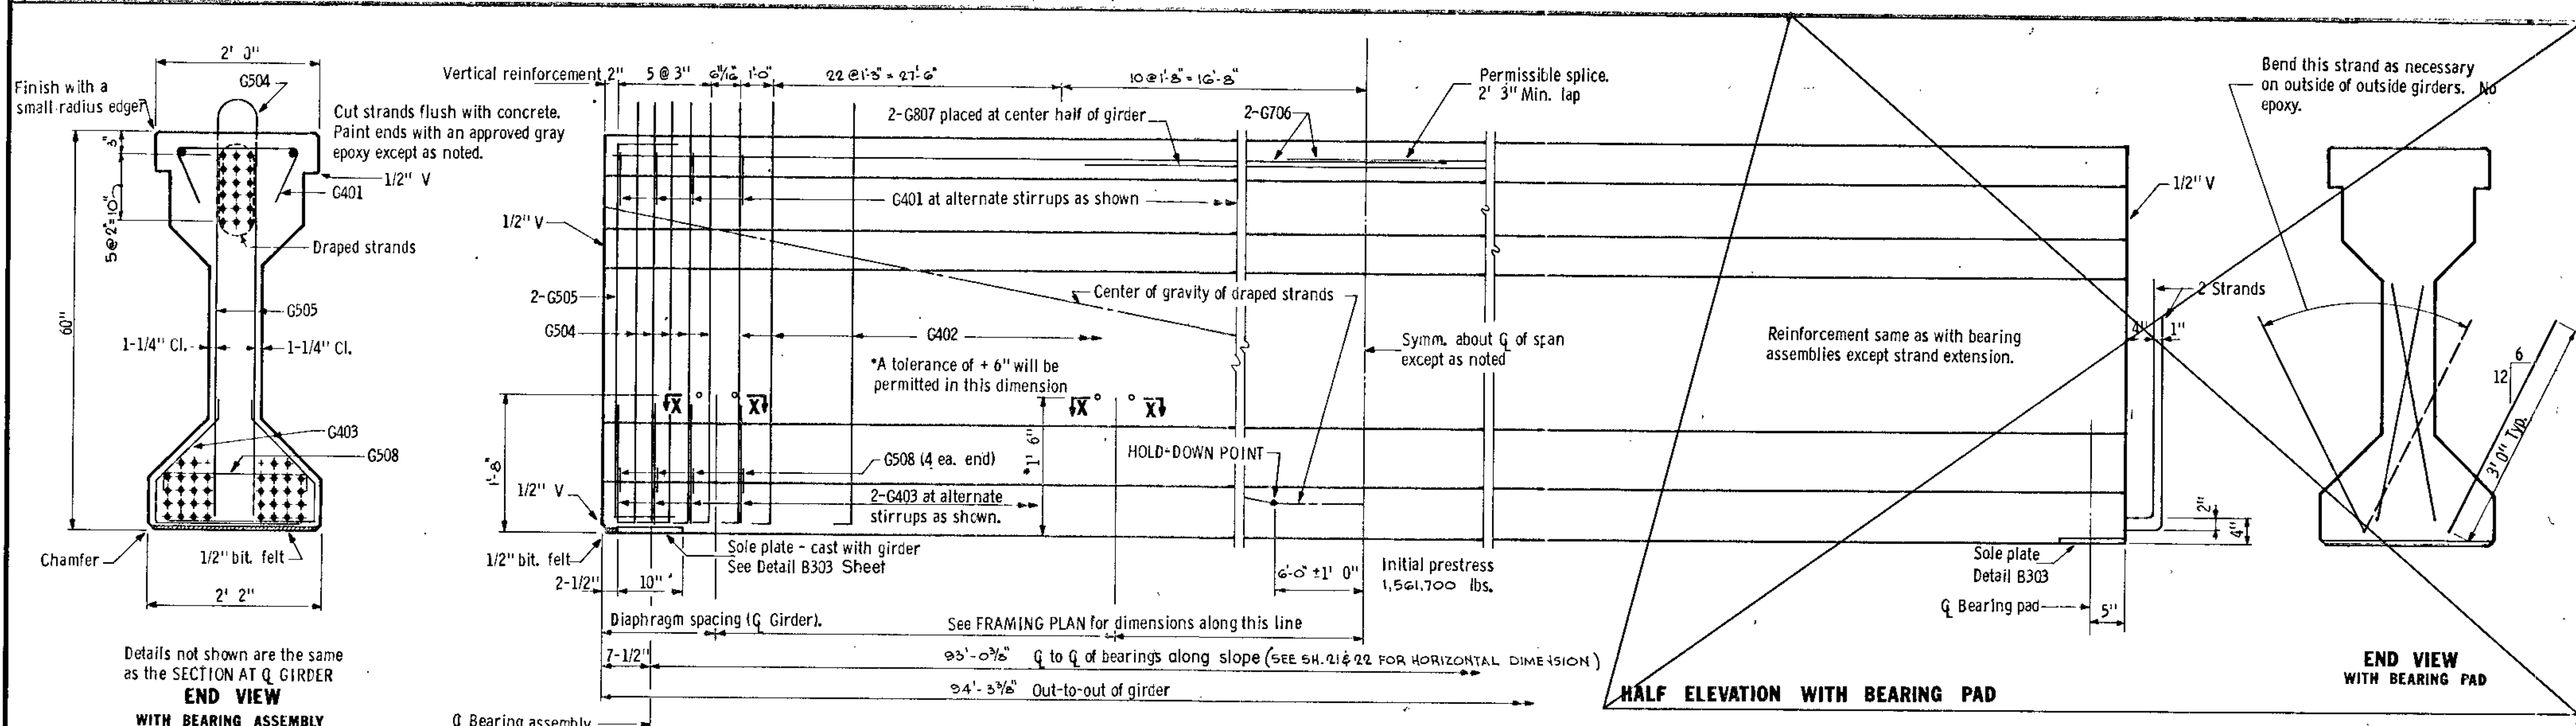


Y DISTANCES (IN INCHES)			
	NQ	Q SPAN	END
Straight strands	36	5.56"	
Draped strands	18	8.00"	52.00"
Total strands	54	6.37"	

Y = distance of Center of Gravity of strands from bottom of girder. All strands spaced 2" c-c, horizontally and vertically.

All strands 1/2" φ 270 kip, ultimate strength.

*A tolerance of ± 2" will be permitted in this dimension.

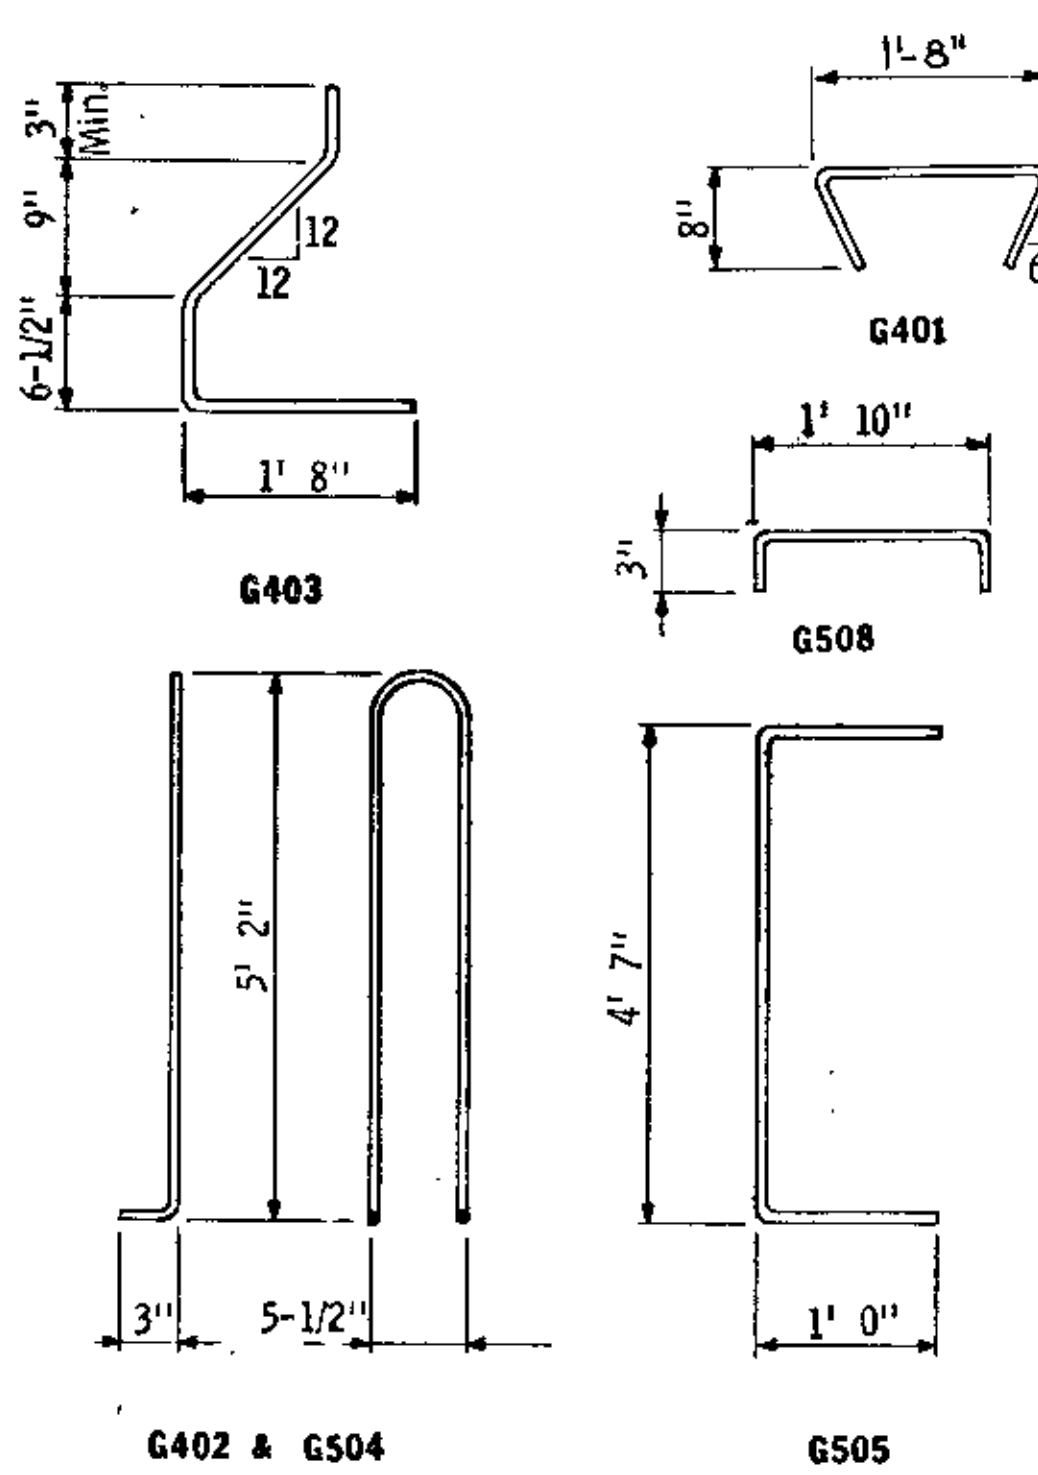

First digit of bar mark indicates bar size. All bar dimensions are out-to-out.

15 BUILT 10-16-73 B. Jahn

GIRDER G11

TITLE: 60" PRESTRESSED CONCRETE GIRDER (PRETENSIONED) TYPE 60-95

DES: [Signature] DR: M.H.D./N.K. APPROVED: [Signature] 12-21-71

CHK: MODY CHK: [Signature]

Sheet No. 15 of 35 Sheets

GENERAL NOTES:

Tops of girders shall be rough floated and broomed transversely for bond. Provide handling hooks or devices as required by Contractor. Hooks or devices provided will be subject to approval of Engineer and shall be installed within 4' 0" of the end of girder.

A modified strand pattern which does not change center of gravity of strands may be submitted to the Engineer for approval.

A post-tensioned girder may be used as an alternate for the pretensioned design shown. M. H. D. will have plans available for the post-tensioned alternate.

Each girder shall be marked, showing bridge number, casting date, and individual identification letters and numbers. Markings shall be made on the face of the girder, near the end, so located that they will be exposed after the end diaphragms have been cast. Facia girders shall be marked on an inside face. All markings shall be stenciled and be clearly legible. For location of girders, see framing plan.

All material and work shown or noted on this sheet shall be included in unit price bid for prestressed concrete girders. See M. H. D. 2405.

See framing plan for girder ends marked "X".








Approximate weight of girder 45.9 tons.

MINIMUM CONCRETE STRENGTH - P.S.I.		
	① f'ci	② ③ f'c
Computed Min. Concrete Strength	5530	5560
Required Min. Concrete Strength	5530	5560

- ① Minimum concrete strength at time of prestress transfer.
- ② Minimum concrete strength when curing can be discontinued and girder transported and installed.
- ③ Required minimum concrete strength shall be used. Computed minimum concrete strength is for information only.

Fig. 5-397.506
Oct. 15, 1969

Bridge No. 02522

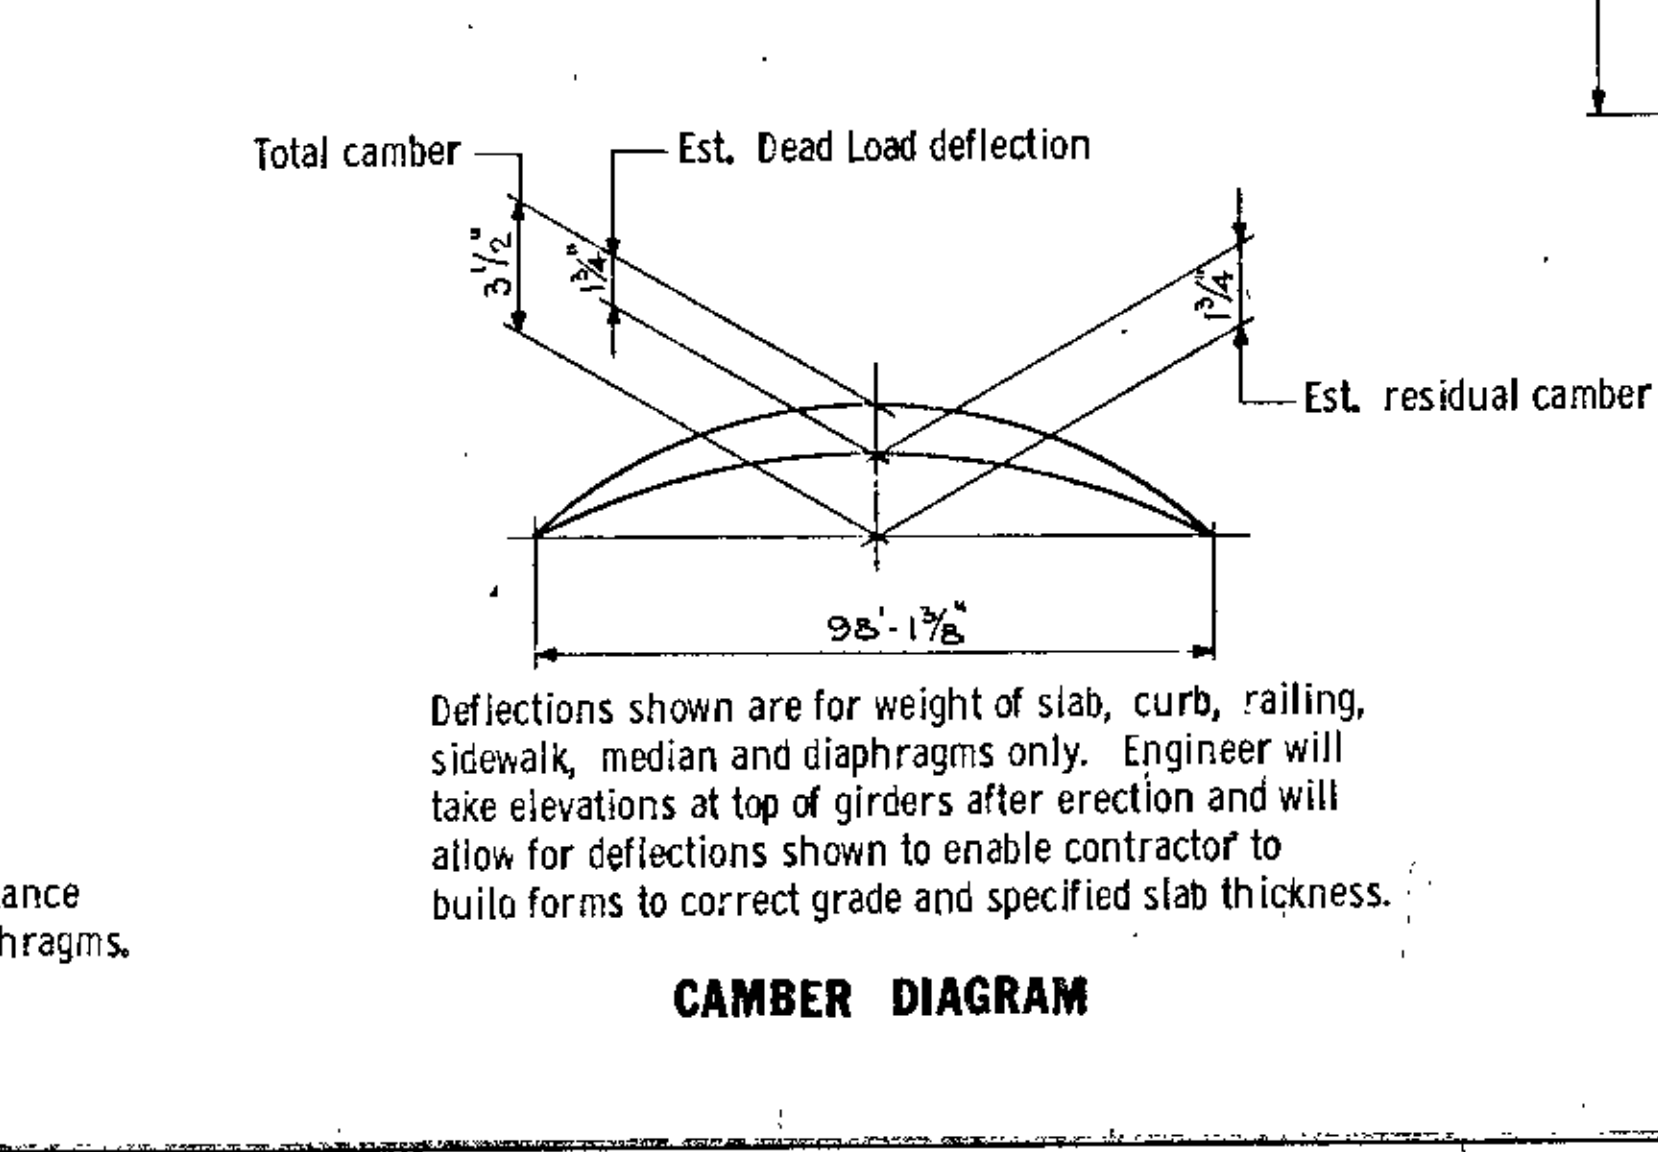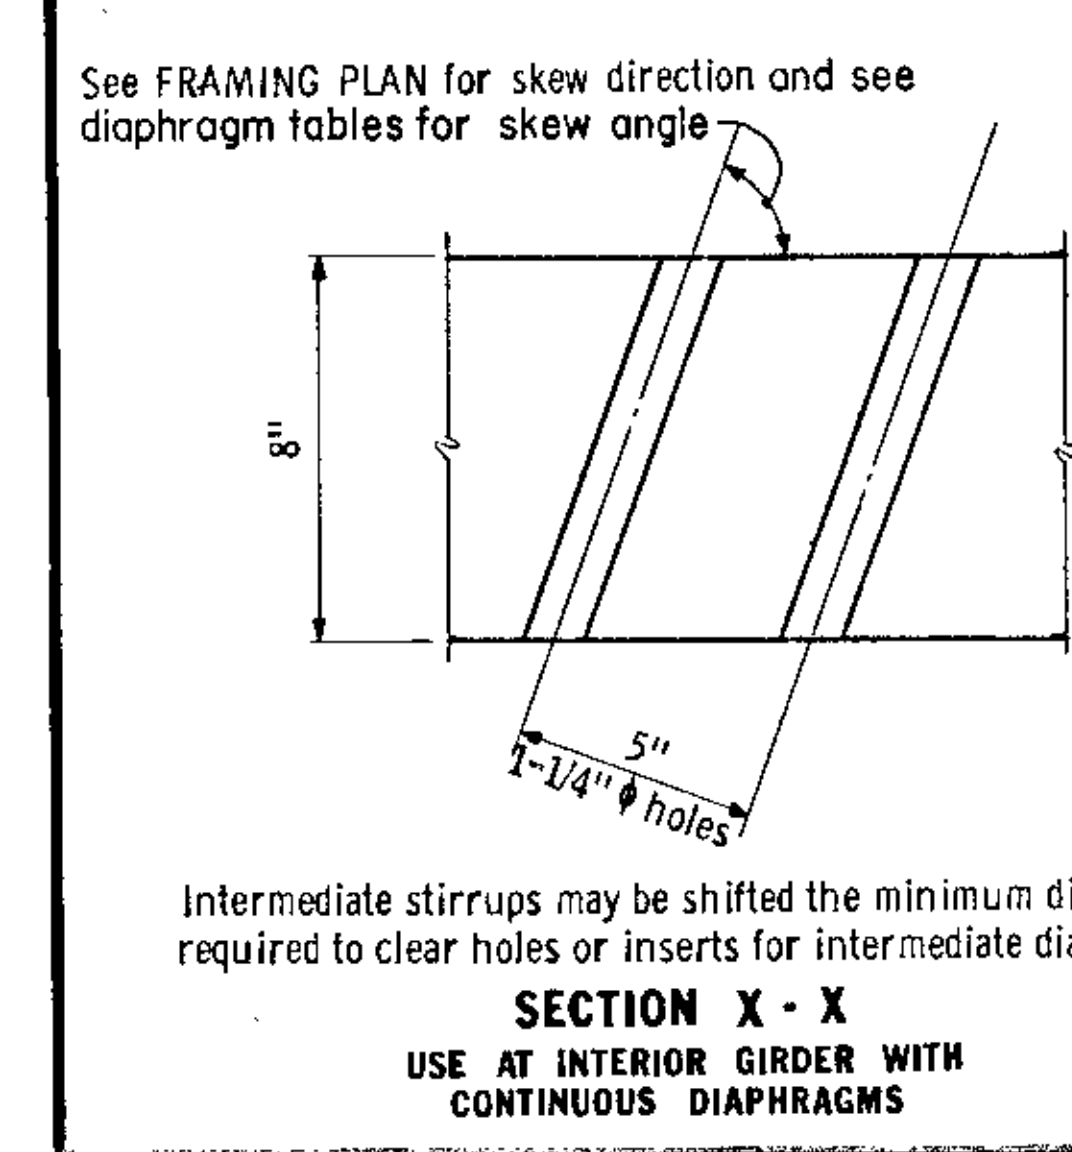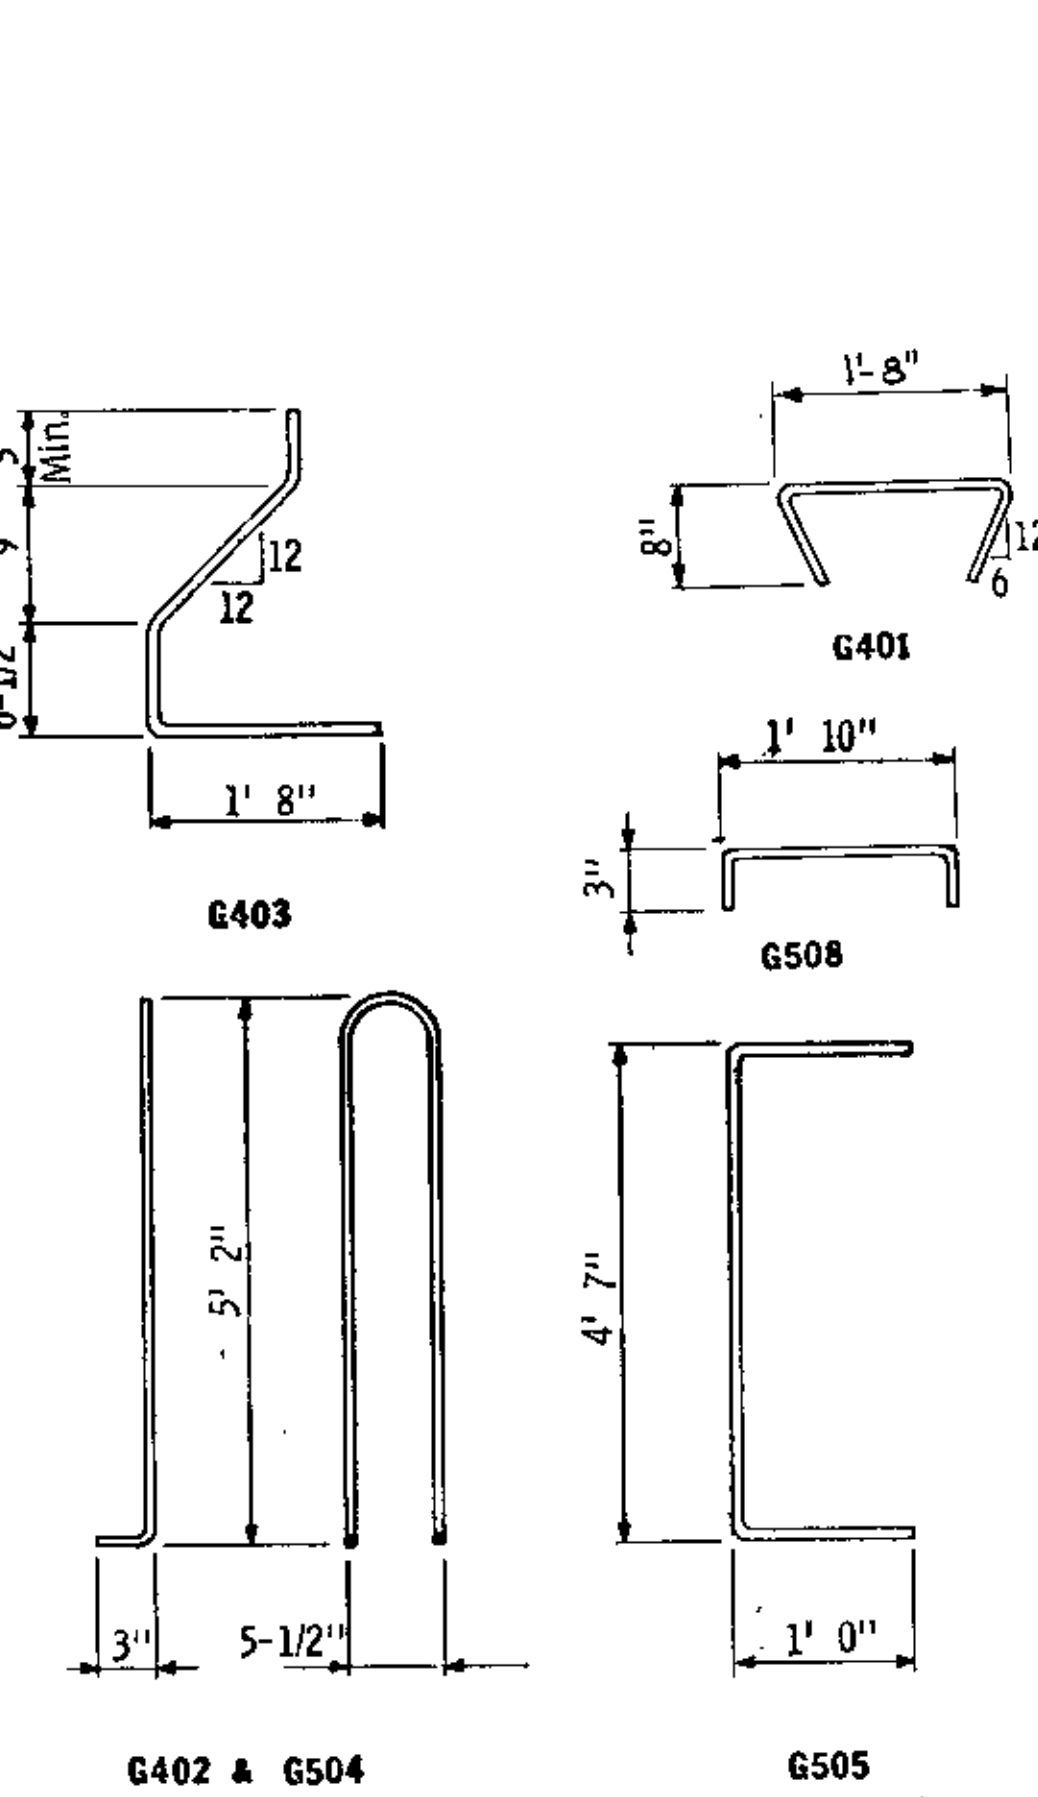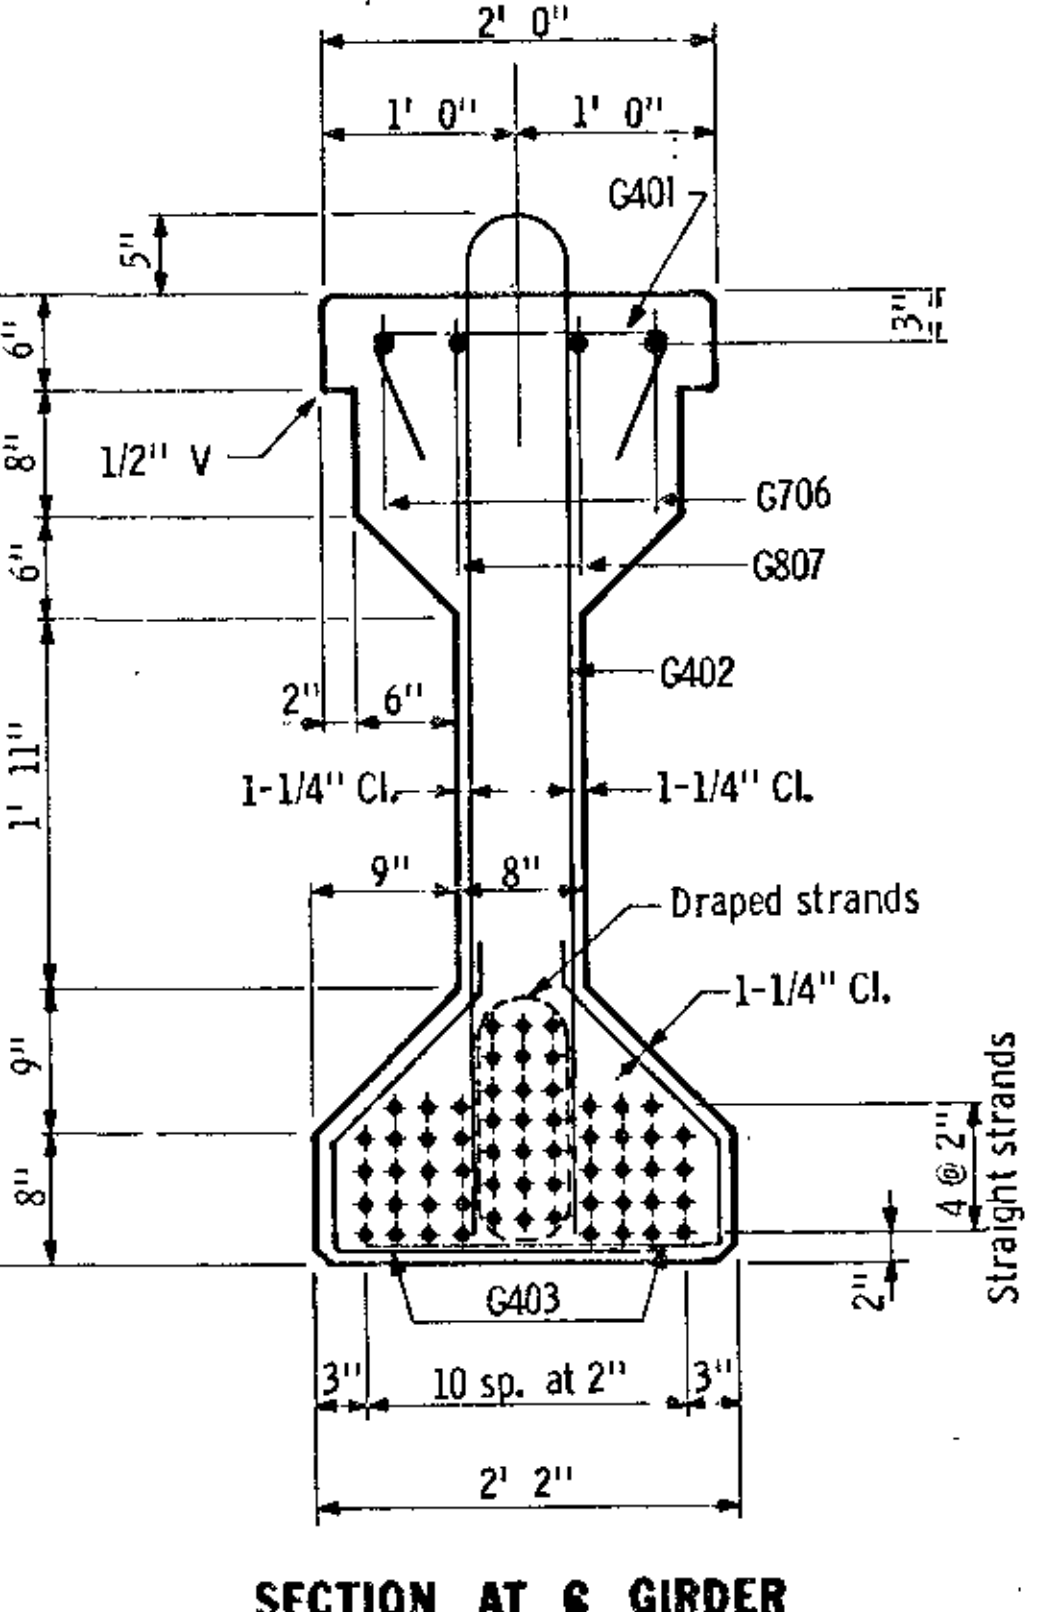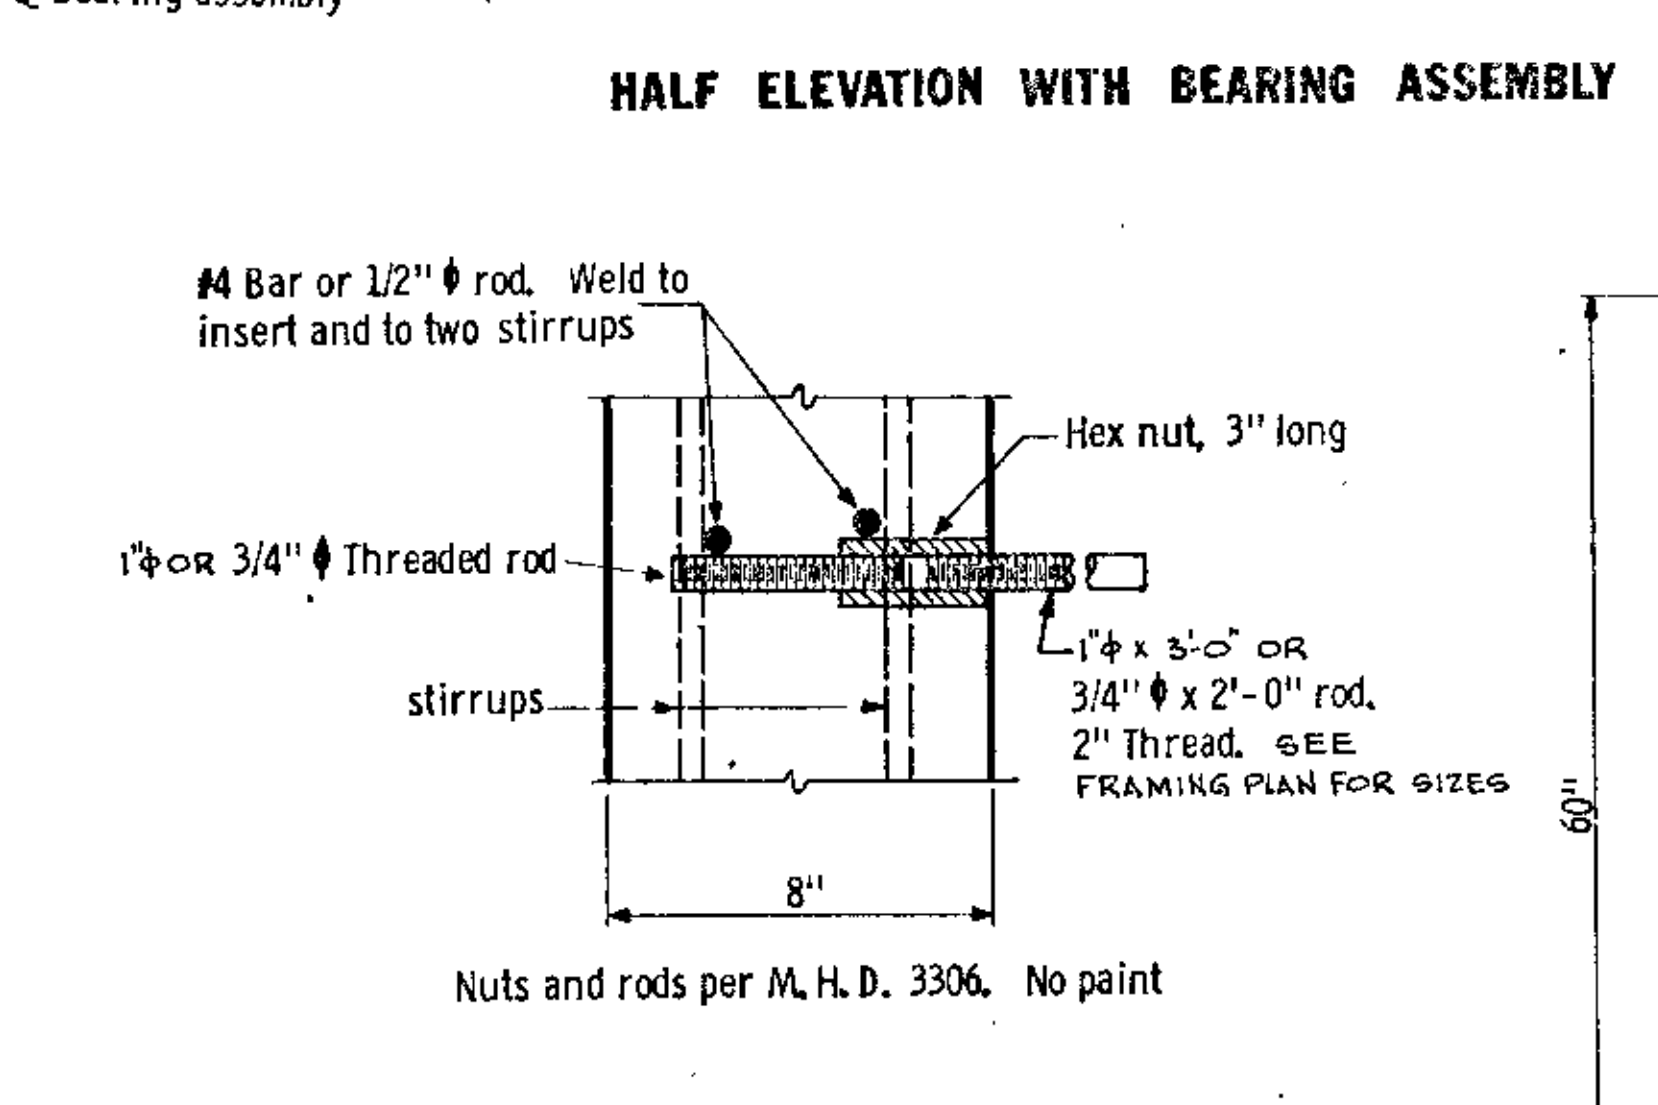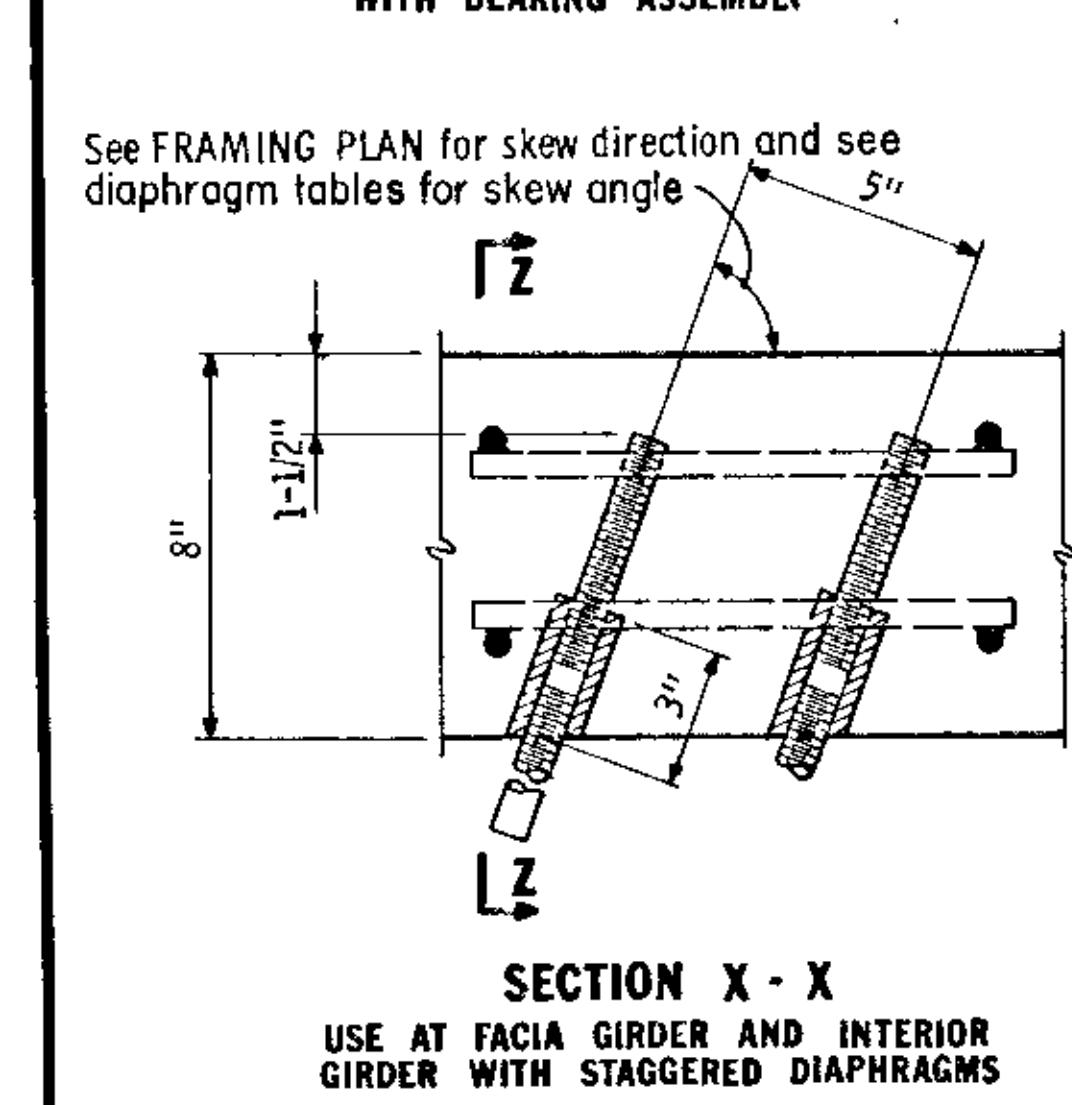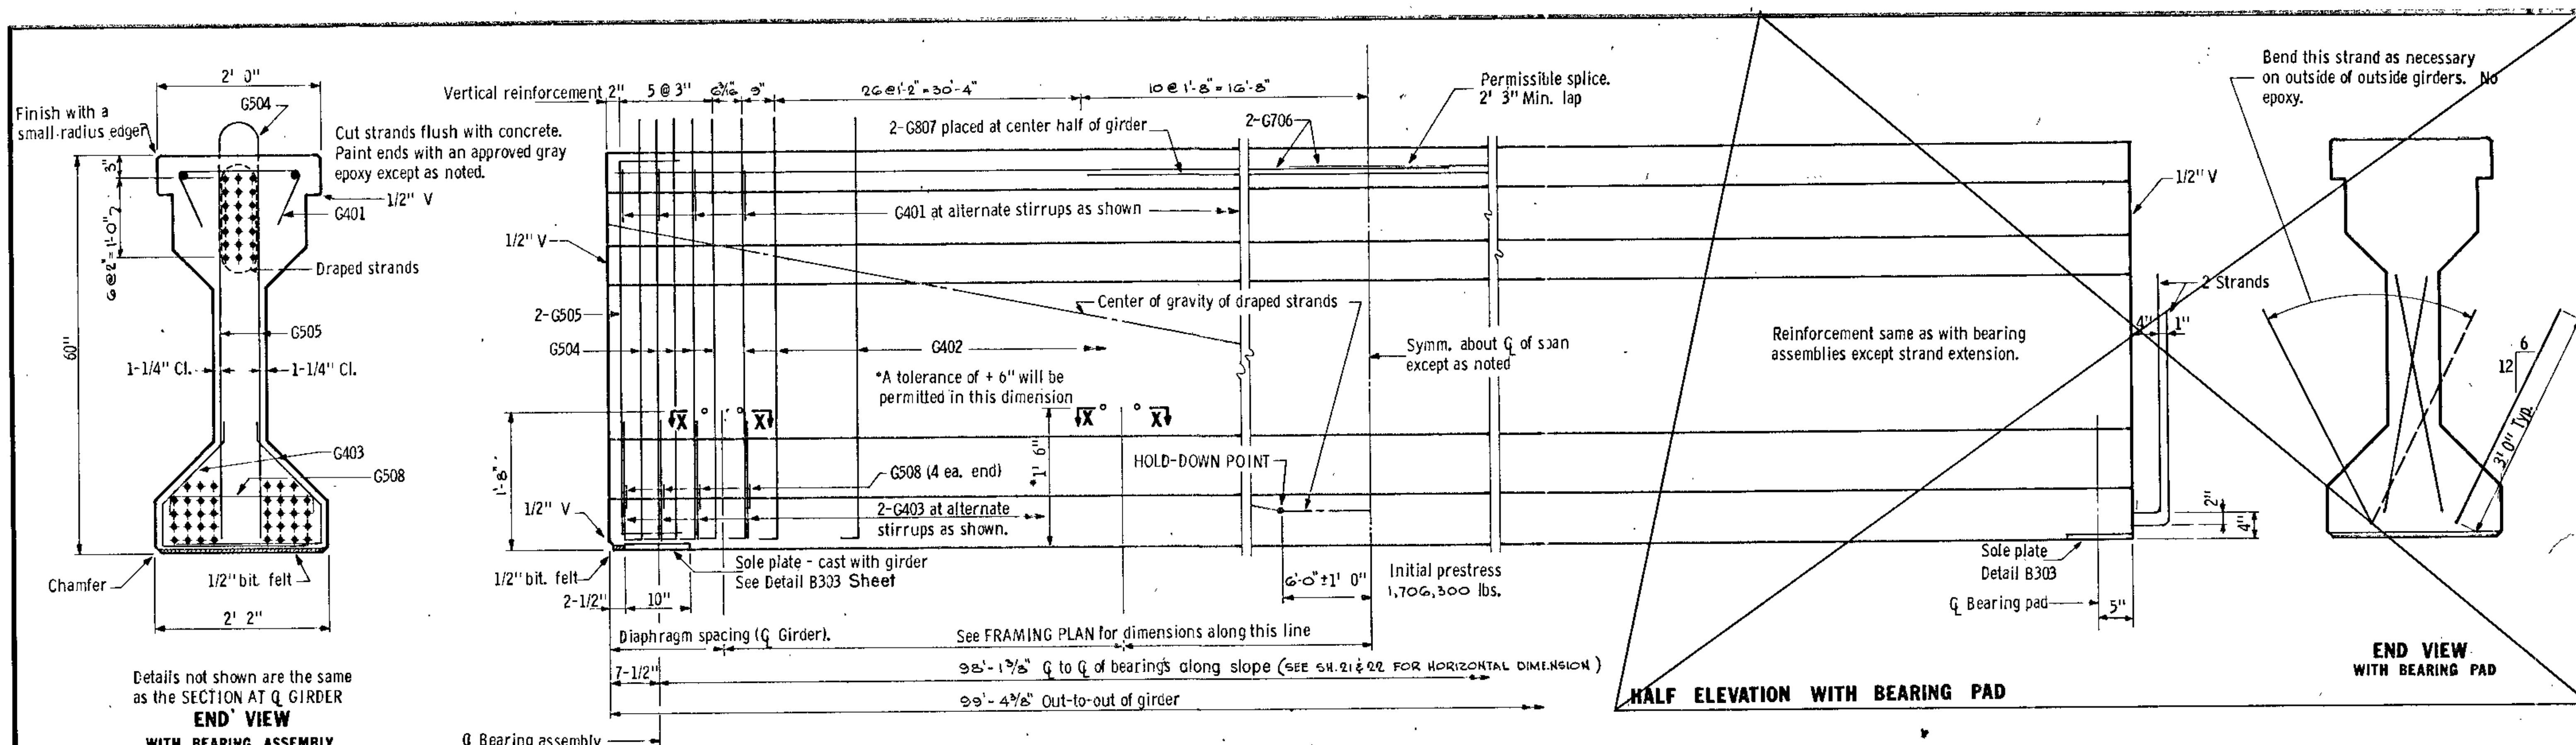

Y DISTANCES (IN INCHES)			
	NO.	Q SPAN	END
Straight strands	38	5.79'	
Draped strands	21	9.00'	51.00'
Total strands	59	6.93'	

Y = distance of Center of Gravity of strands from bottom of girder. All strands spaced 2" c-c, horizontally and vertically.

All strands 1/2" ϕ 270 kip, ultimate strength.

A tolerance of ± 2 " will be permitted in this dimension.

GENERAL NOTES:

Tops of girders shall be rough floated and broomed transversely for bond. Provide handling hooks or devices as required by Contractor. Hooks or devices provided will be subject to approval of Engineer and shall be installed within 4' 0" of the end of girder.

A modified strand pattern which does not change center of gravity of strands may be submitted to the Engineer for approval.

A post-tensioned girder may be used as an alternate for the pretensioned design shown. M. H. D. will have plans available for the post-tensioned alternate.

Each girder shall be marked, showing bridge number, casting date, and individual identification letters and numbers. Markings shall be made on the face of the girder, near the end, so located that they will be exposed after the end diaphragms have been cast. Facia girders shall be marked on an inside face. All markings shall be stencilled and be clearly legible. For location of girders, see framing plan.

All material and work shown or noted on this sheet shall be included in unit price bid for prestressed concrete girders. See M. H. D. 2405.

See framing plan for girder ends marked "X".

Approximate weight of girder 48.3 tons.

MINIMUM CONCRETE STRENGTH - P.S.I.		
	① ③ f'ci	② ③ f'c
Computed Min. Concrete Strength	5880	6000
Required Min. Concrete Strength	5880	6000

- Minimum concrete strength at time of prestress transfer.
- Minimum concrete strength when curing can be discontinued and girder transported and installed.
- Required minimum concrete strength shall be used. Computed minimum concrete strength is for information only.

GIRDER G 10







AS BUILT 10-10-73 B. Jal

60" PRESTRESSED CONCRETE GIRDER (PRETENSIONED) TYPE 60-100

TITLE:	DES: [Signature]	DR: M.H.D./W.K.	APPROVED:	Bridge No. 02522
CHK: [Signature]	MODY: [Signature]	CHK: [Signature]	12-21-71	

Sheet No. 14 of 35 Sheets

Fig. 5-397.506
Oct. 15, 1969

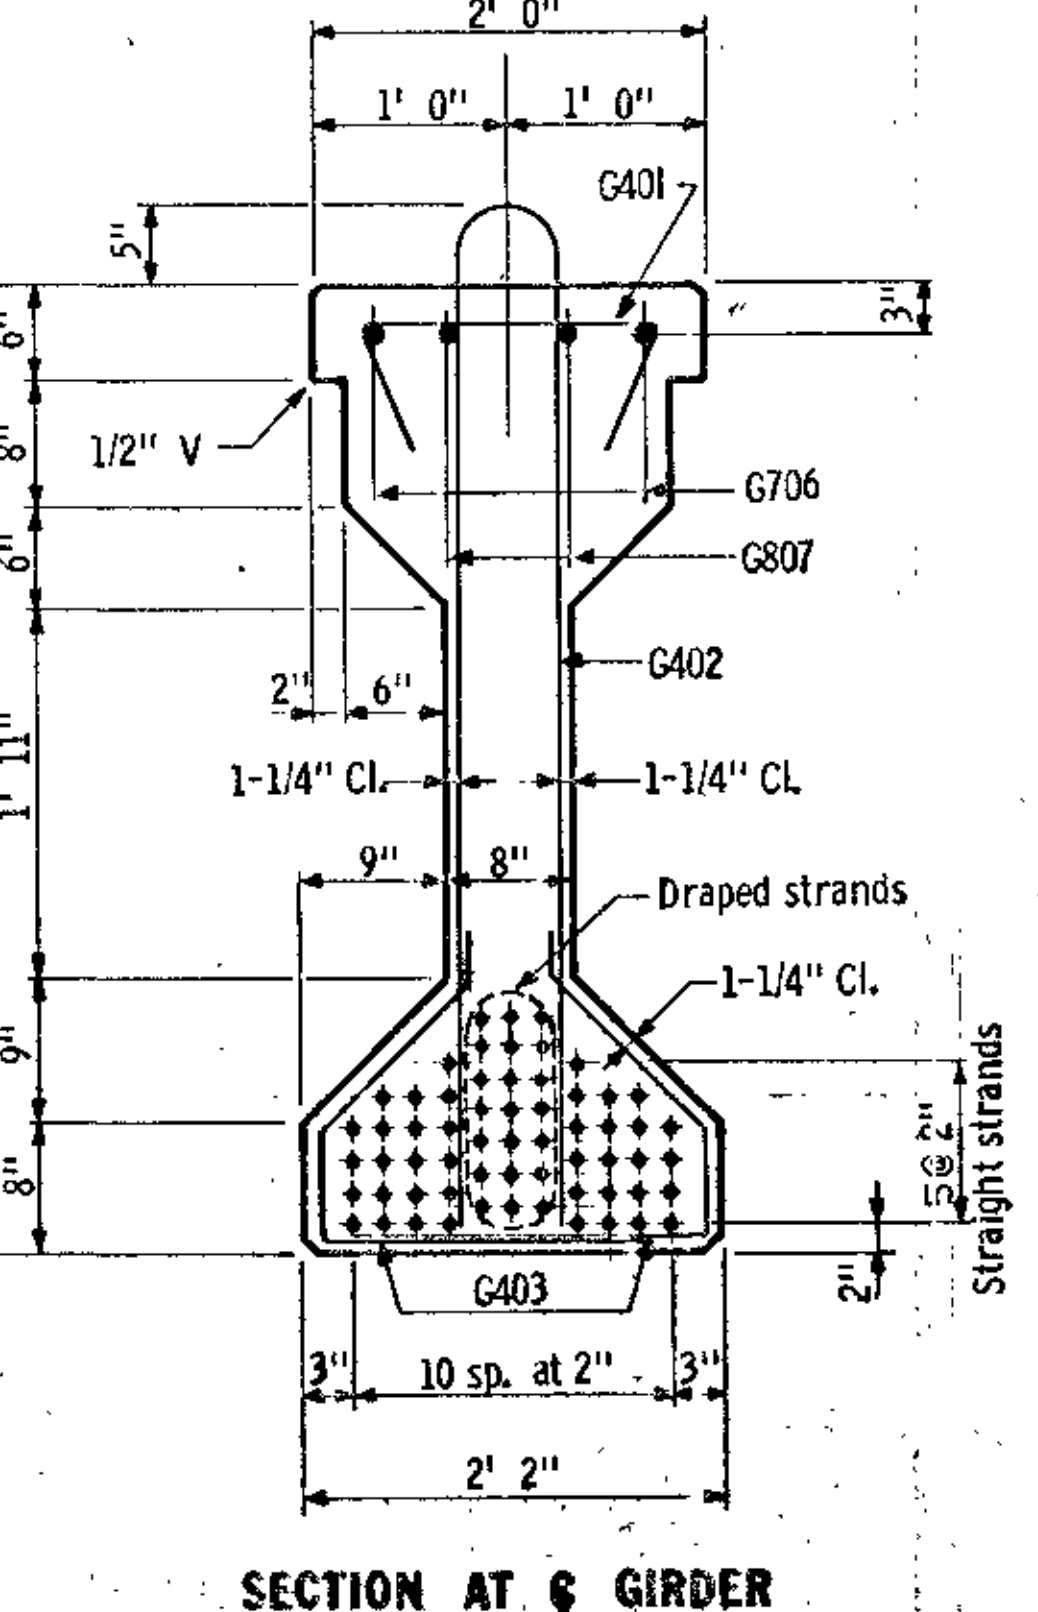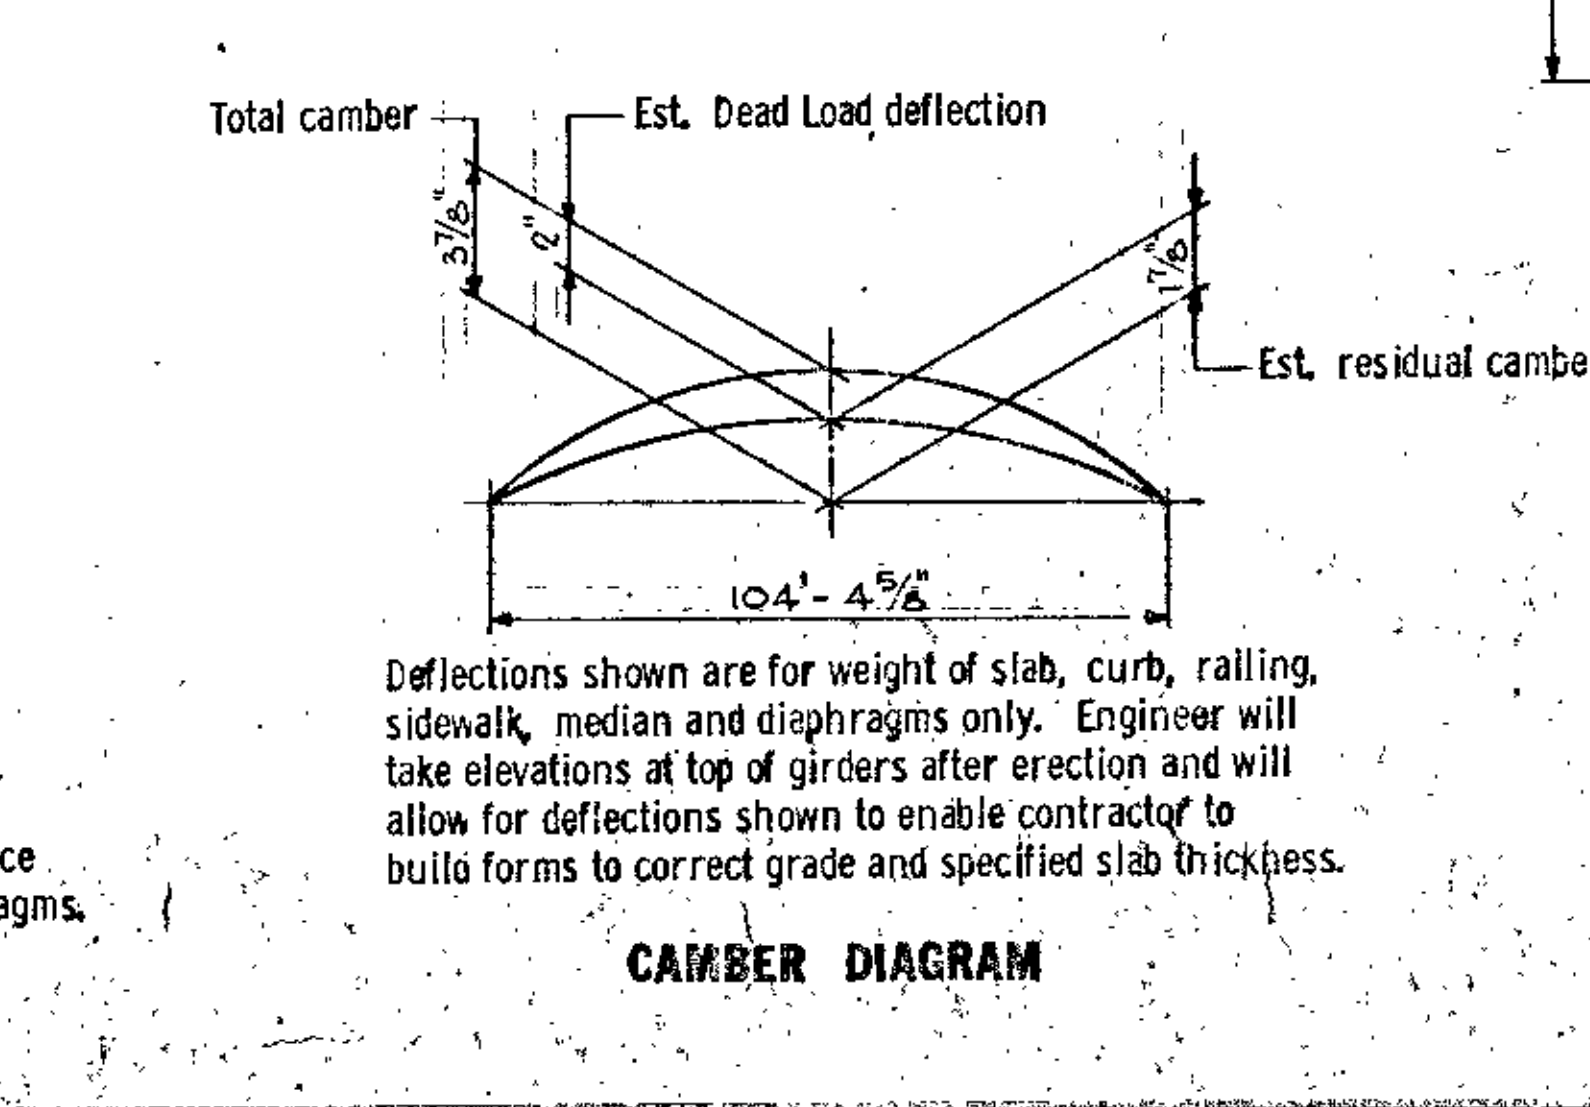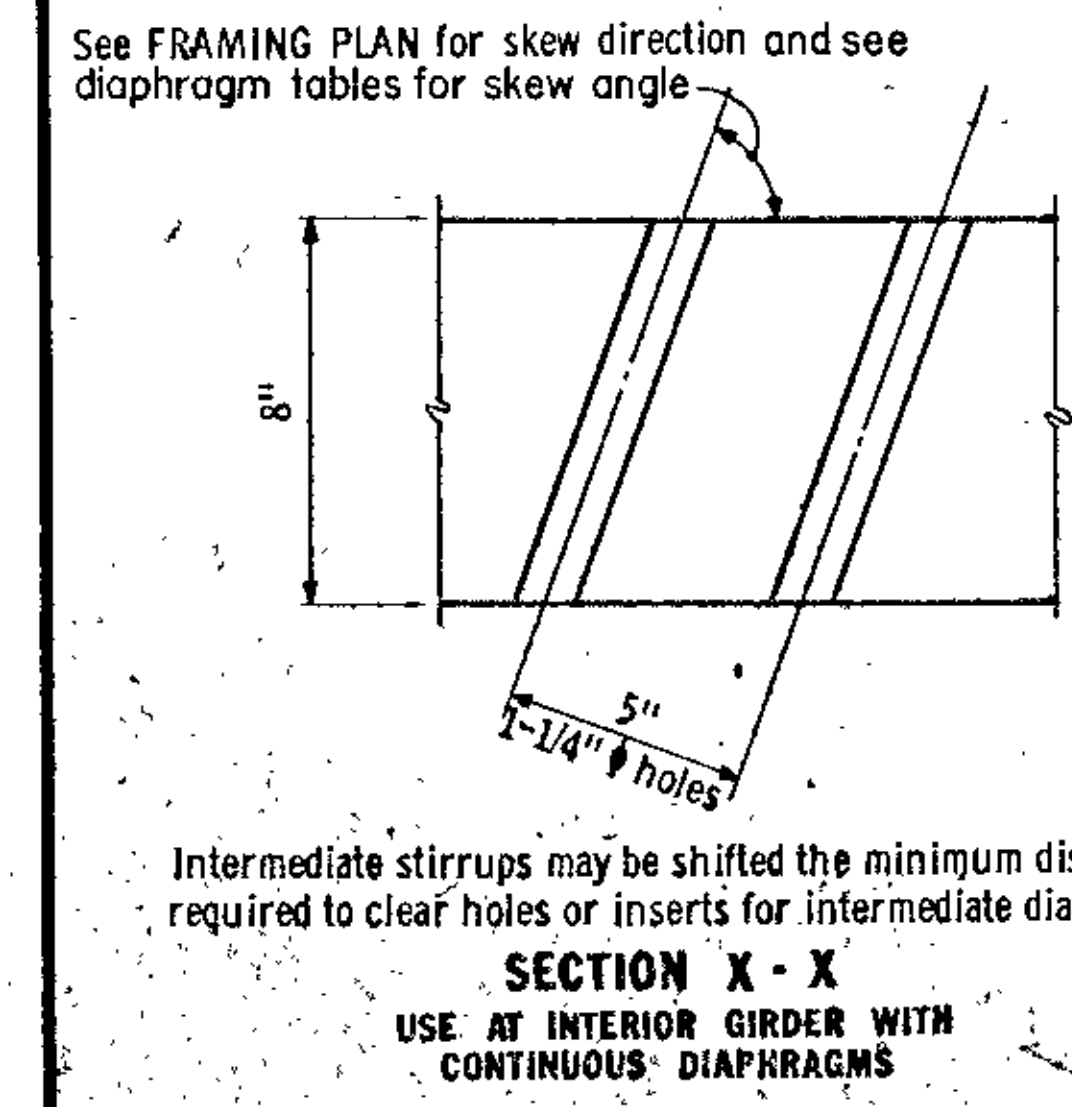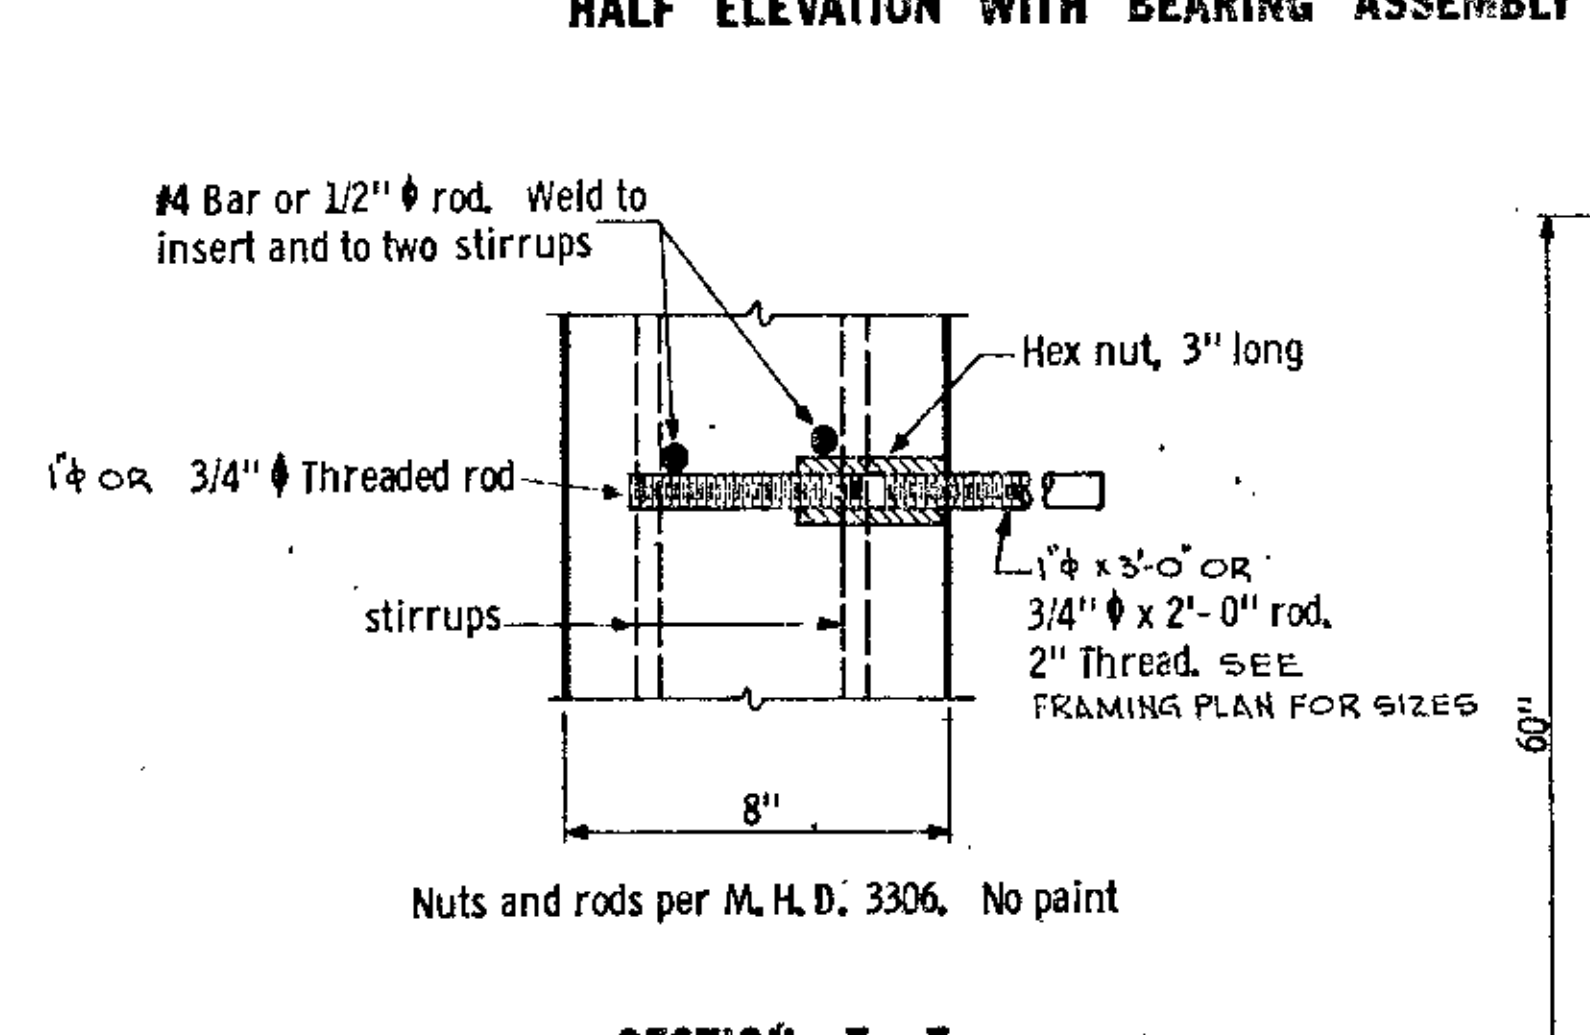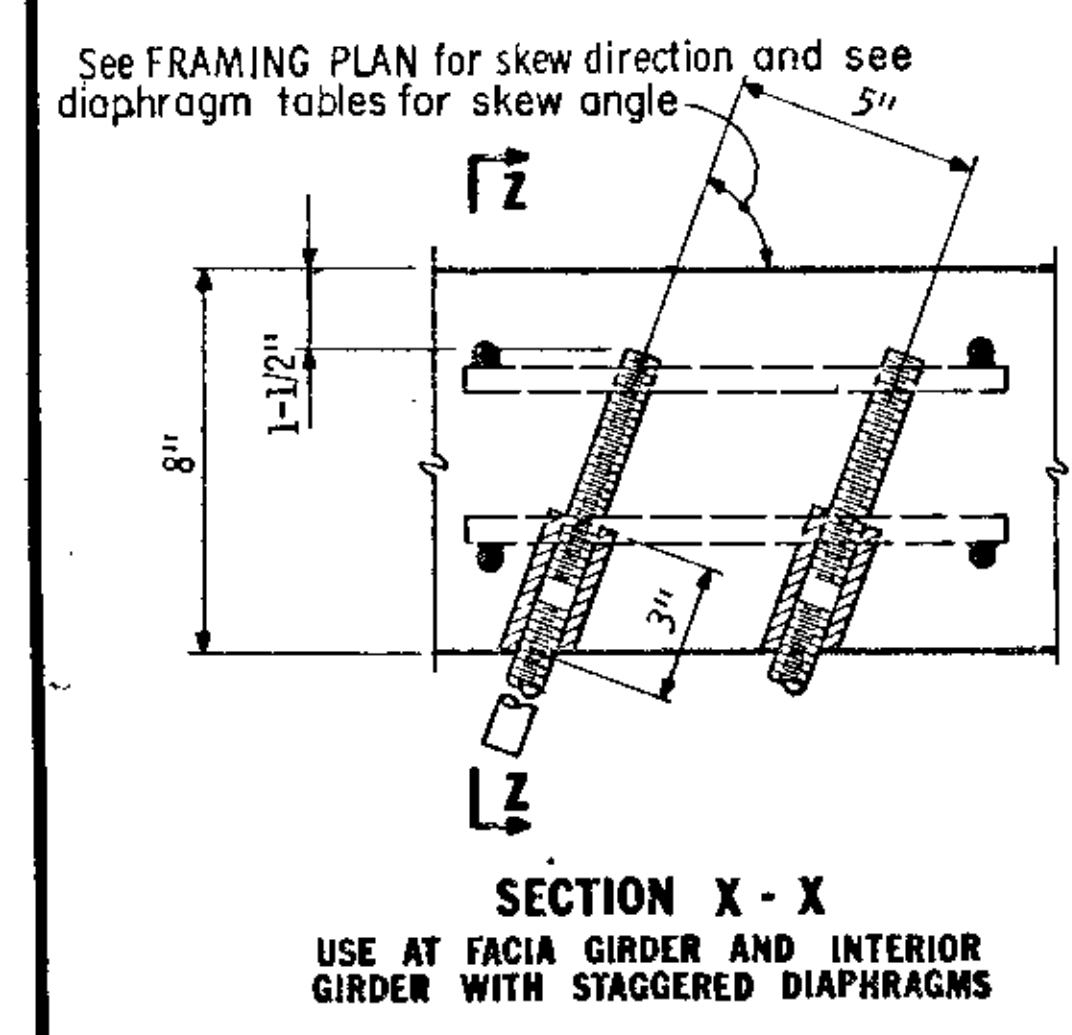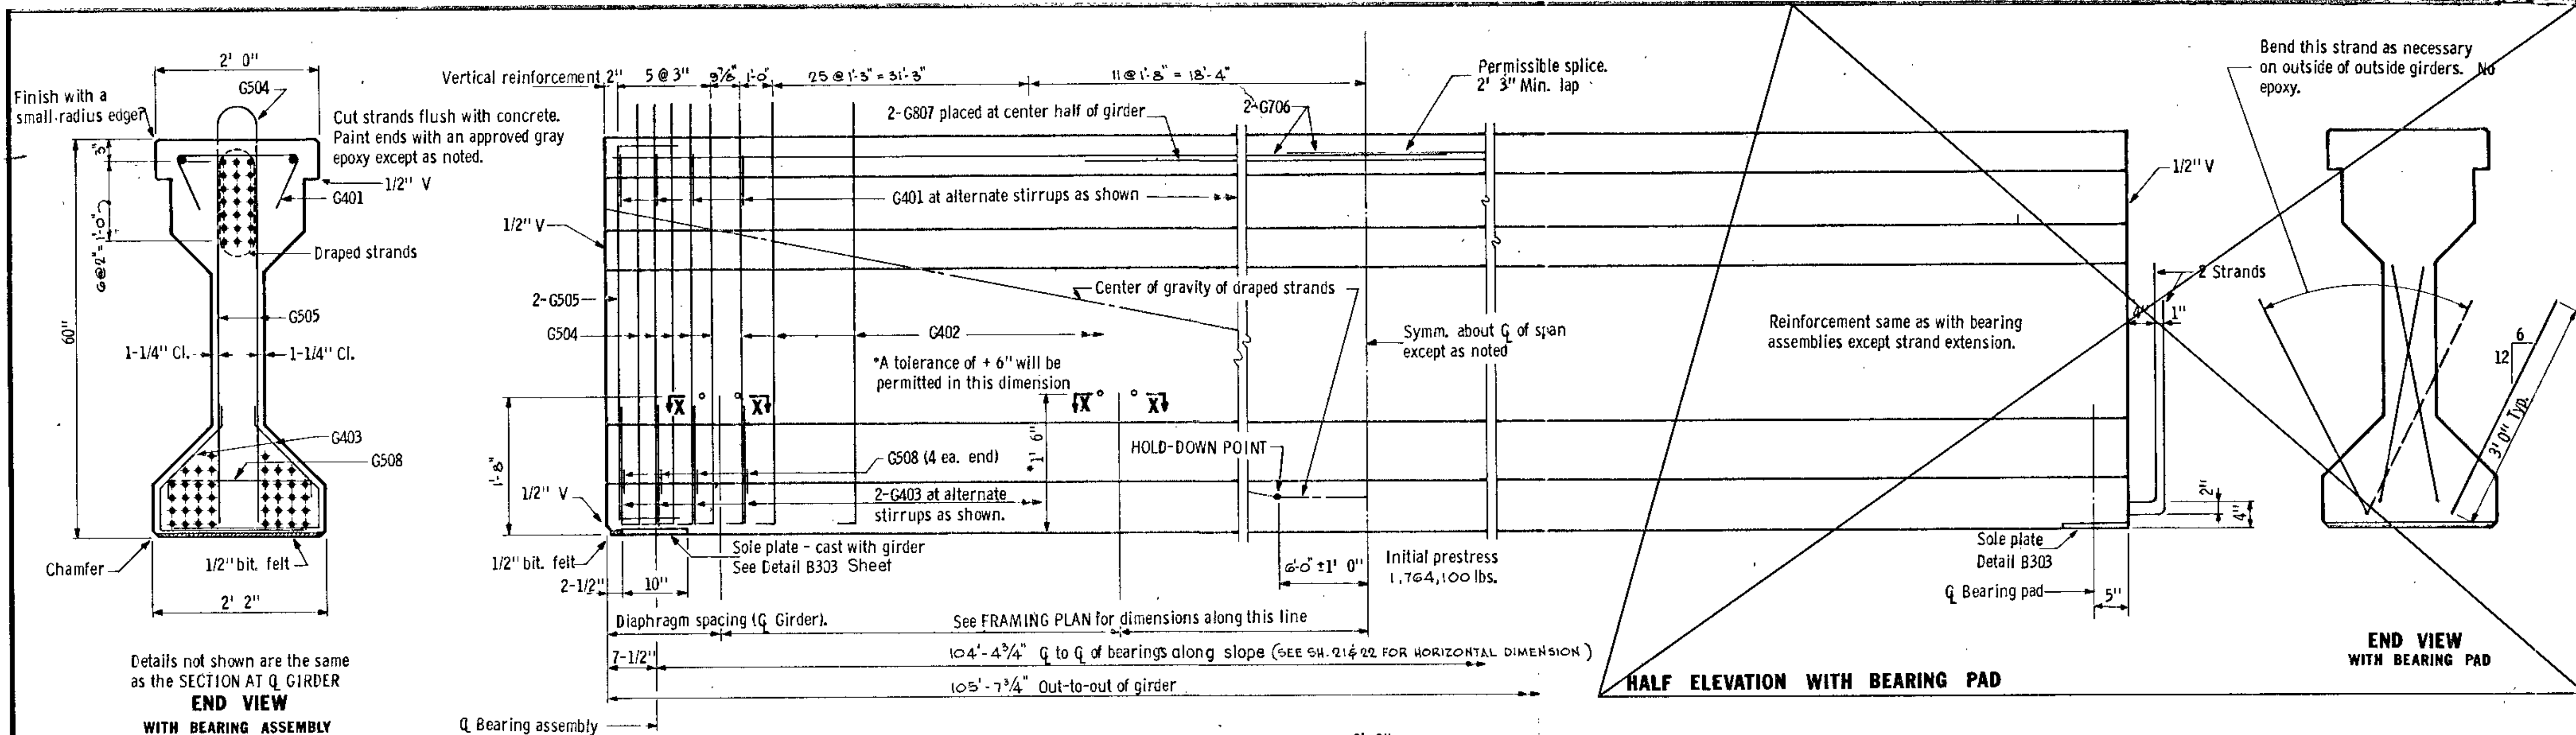


Y DISTANCES (IN INCHES)			
	NO.	Q SPAN	END
Straight strands	40	6.10"	
Draped strands	21	9.00"	51.00"
Total strands	61	7.10"	

Y = distance of Center of Gravity of strands from bottom of girder. All strands spaced 2" c-c, horizontally and vertically.

All strands 1/2" # 270 Rip, ultimate strength.

*A tolerance of ± 2" will be permitted in this dimension.

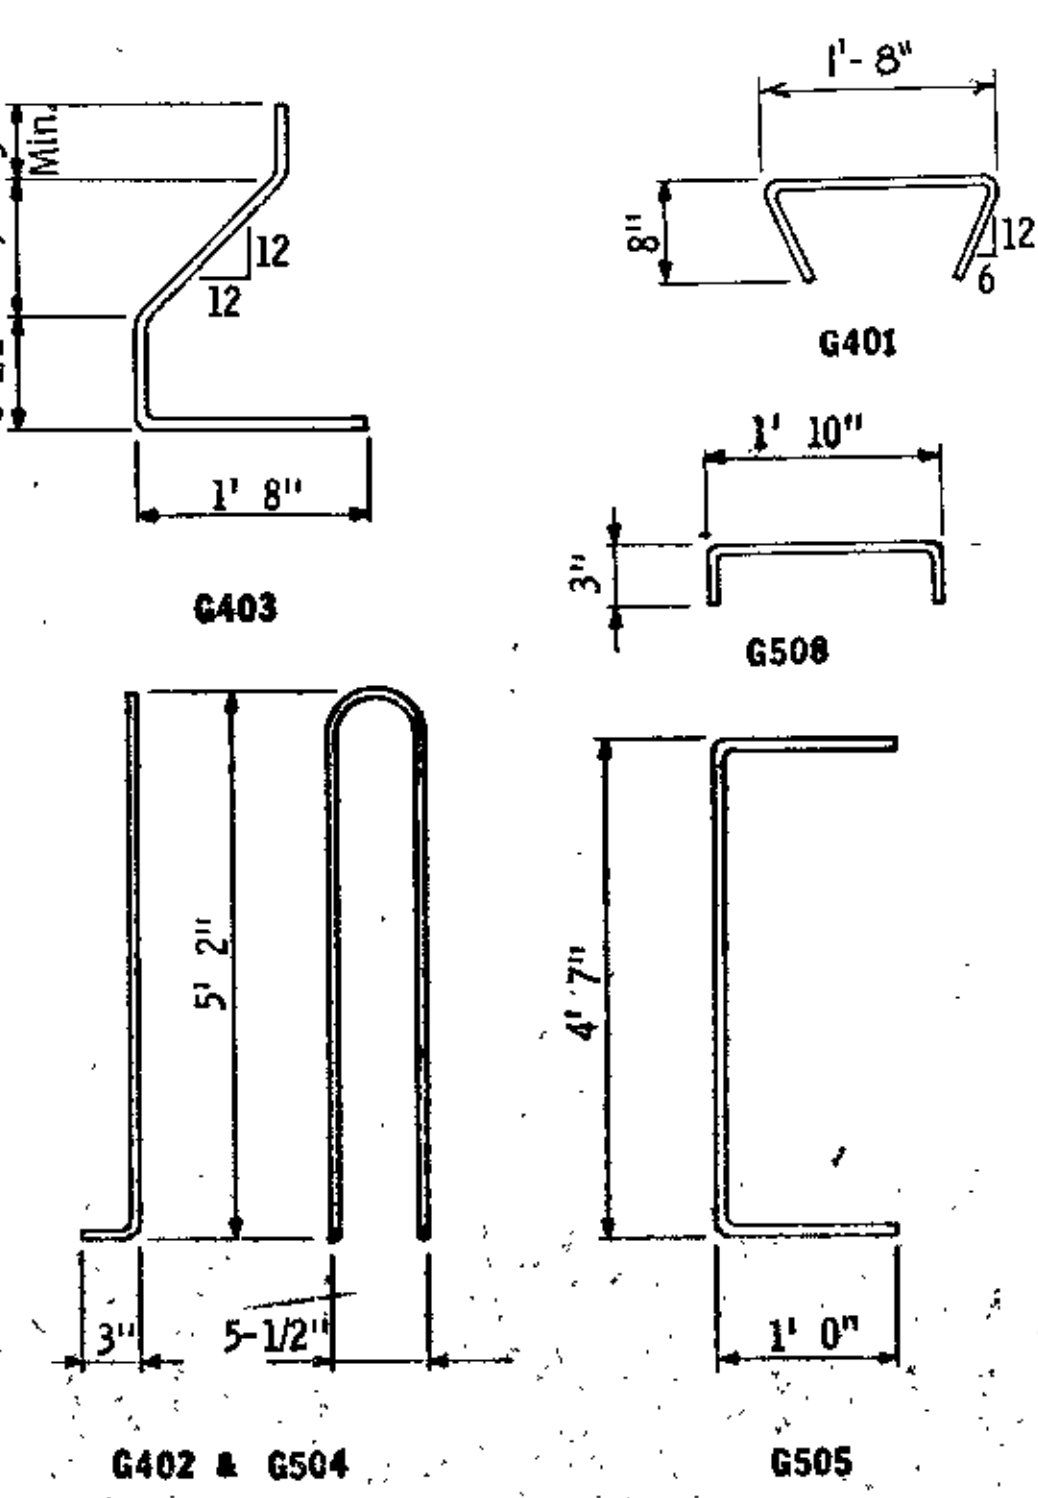

First digit of bar mark indicates bar size. All bar dimensions are out-to-out.

AS BUILT
10-16-73
B. Jahn

GIRDER G9

60" PRESTRESSED CONCRETE GIRDER (PRETENSIONED) TYPE 60 106

GENERAL NOTES:

Tops of girders shall be rough floated and broomed transversely for bond. Provide handling hooks or devices as required by Contractor. Hooks or devices provided will be subject to approval of Engineer and shall be installed within 4' 0" of the end of girder.

A modified strand pattern which does not change center of gravity of strands may be submitted to the Engineer for approval.

A post-tensioned girder may be used as an alternate for the pretensioned design shown. M. H. D. will have plans available for the post-tensioned alternate.

Each girder shall be marked, showing bridge number, casting date, and individual identification letters and numbers. Markings shall be made on the face of the girder, near the end, so located that they will be exposed after the end diaphragms have been cast. Facia girders shall be marked on an inside face. All markings shall be stencilled and be clearly legible. For location of girders, see framing plan.

All material and work shown or noted on this sheet shall be included in unit price bid for prestressed concrete girders. See M. H. D. 2405.

See framing plan for girder ends marked "X".

Approximate weight of girder 51.4 tons.

MINIMUM CONCRETE STRENGTH - P.S.I.						
	①	③	f'cf	②	③	f'c
Computed Min. Concrete Strength	5880		6000			6000
Required Min. Concrete Strength	5880		6000			6000

① Minimum concrete strength at time of prestress transfer.

② Minimum concrete strength when curing can be discontinued and girder transported and installed.

③ Required minimum concrete strength shall be used. Computed minimum concrete strength is for information only.

TITLE: 60" PRESTRESSED CONCRETE GIRDER (PRETENSIONED) TYPE 60 106

DES: M.H.D./W.K. DR: M.H.D./W.K. APPROVED: [Signature]


CHK: MDPY CNK: [Signature]

12-21-71


Sheet No. 13 of 35 Sheets

Fig. 5-397.506 Oct 15, 1979


Bridge Co. 02522

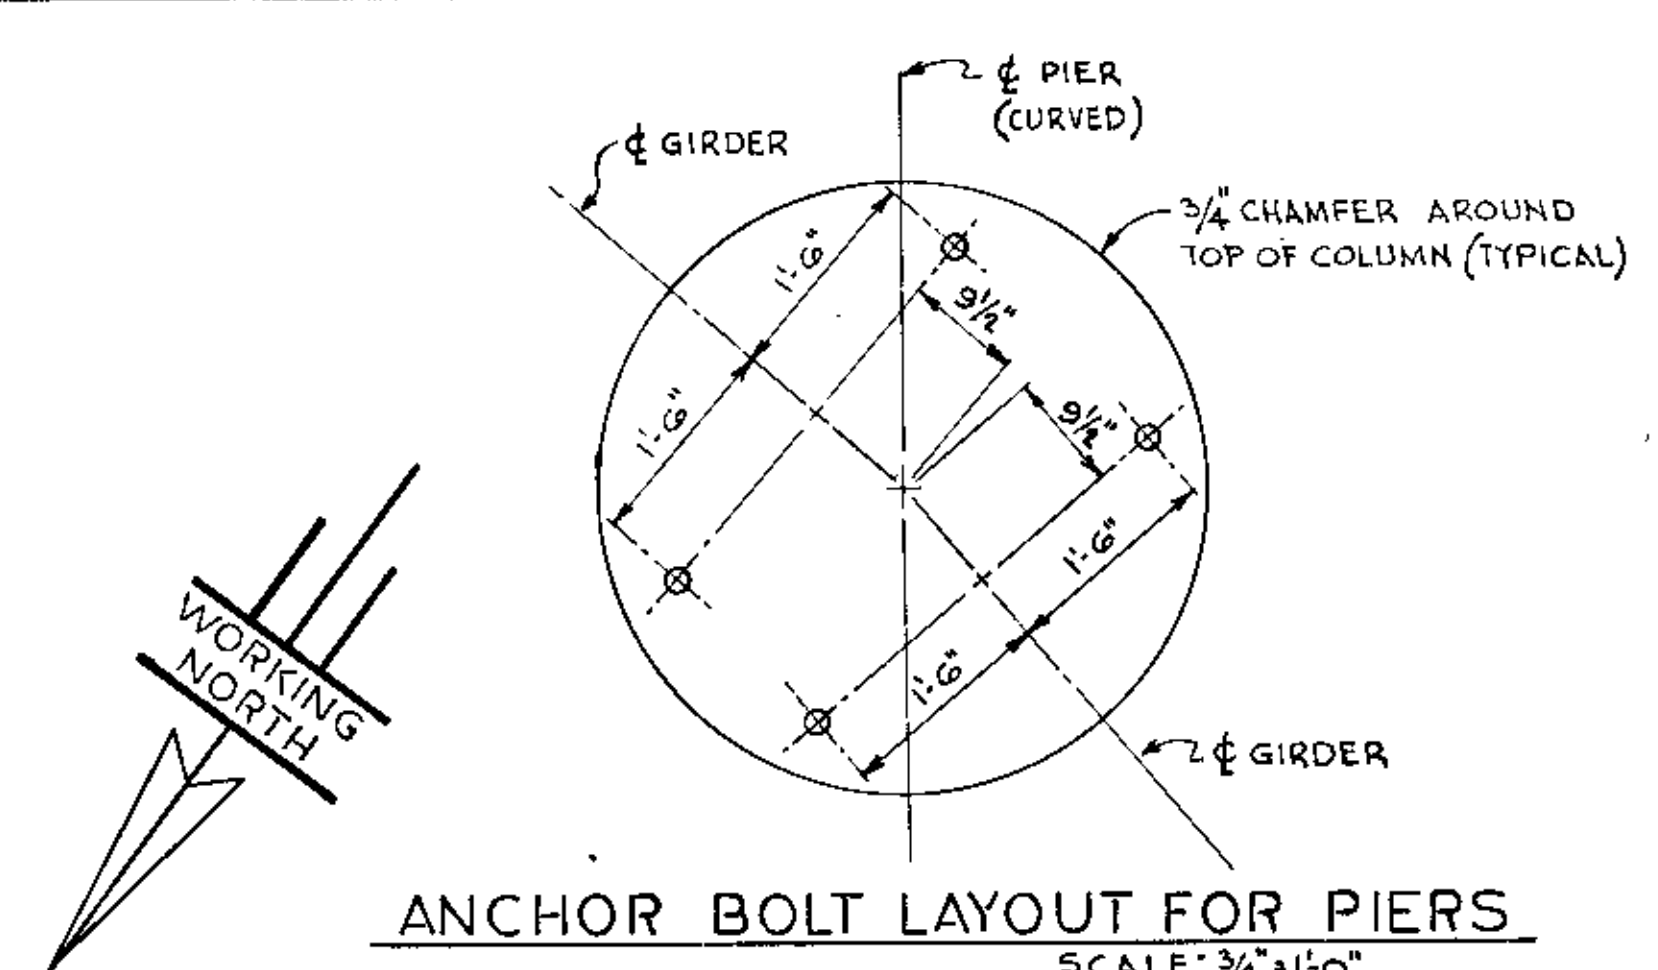

ANCHOR BOLT LAYOUT FOR PIERS
SCALE: 3/4" = 1'-0"

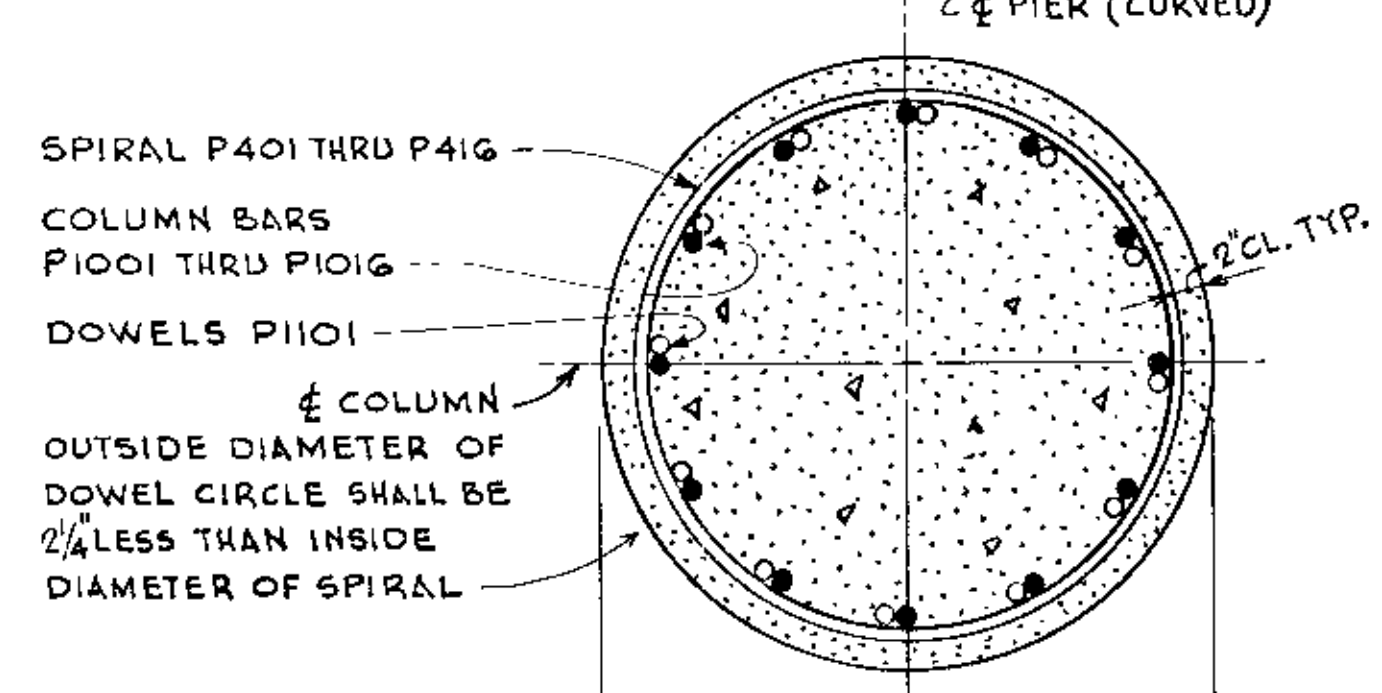

TYPICAL COLUMN SECTION
SCALE: 3/4" = 1'-0"

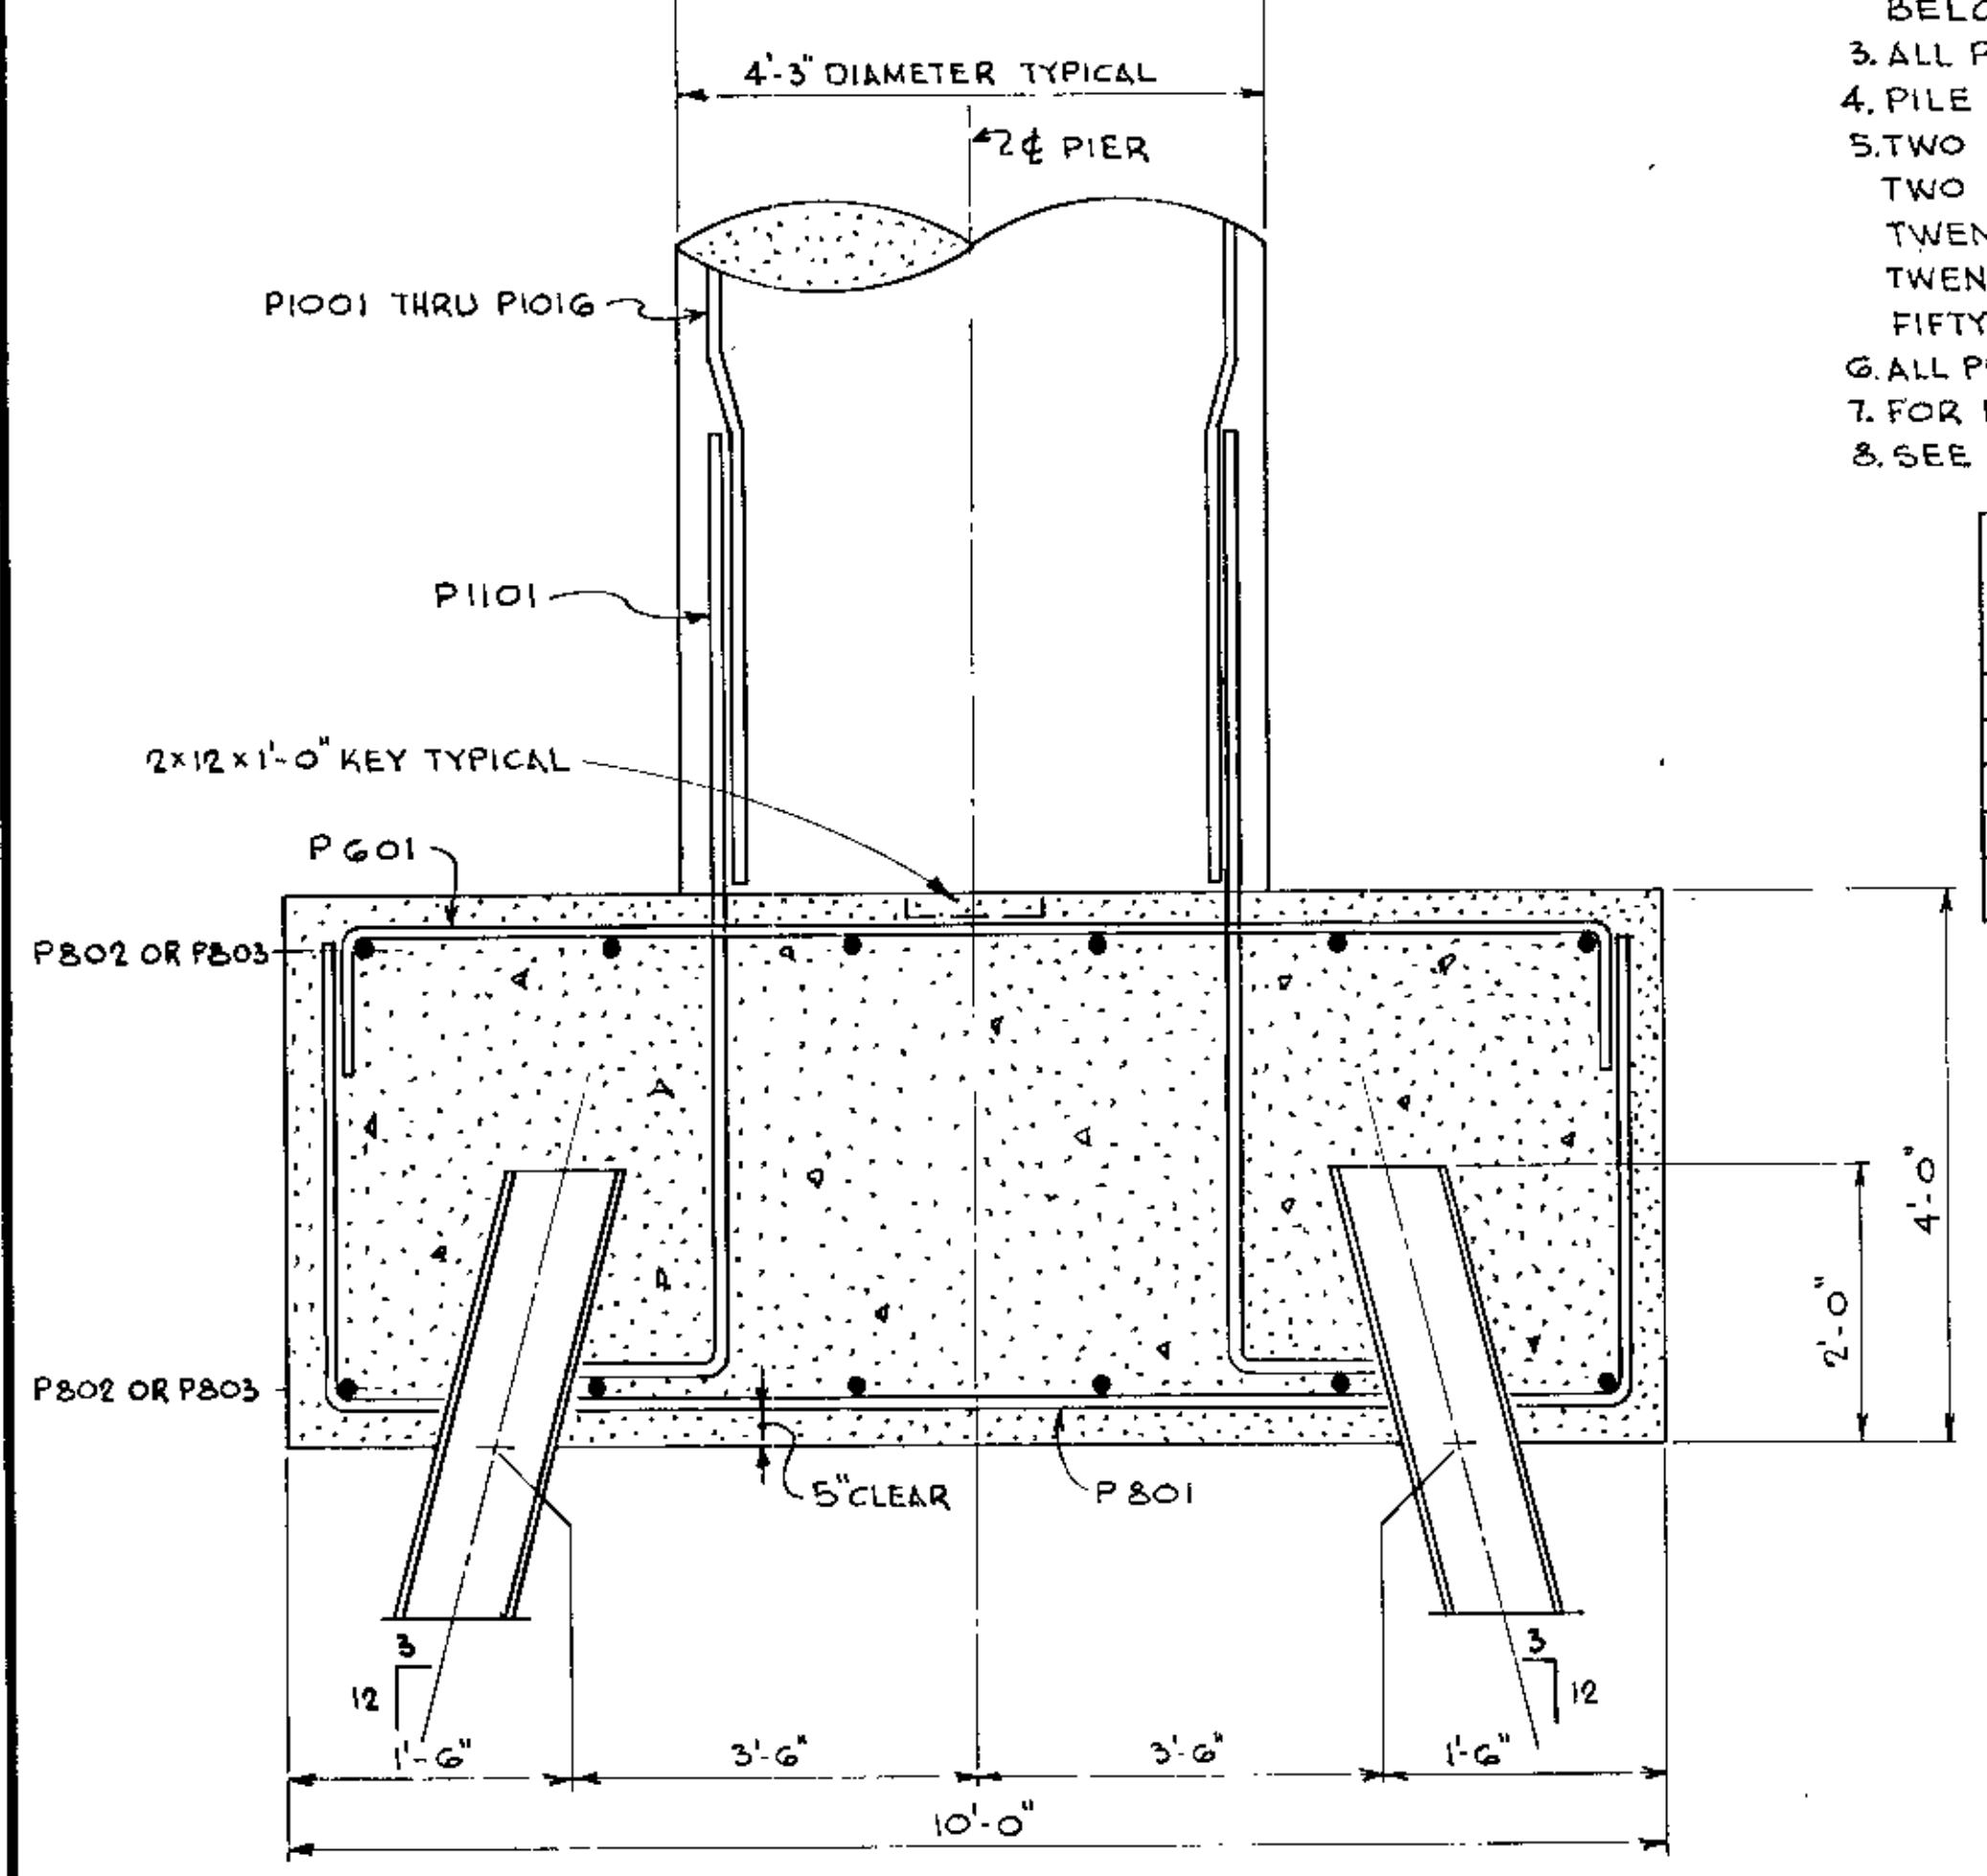

TYPICAL FOOTING SECTION
SCALE: 3/4" = 1'-0"

SUMMARY OF QUANTITIES FOR PIERS 1 AND 2

EXCAVATION, CLASS E	790 CU. YD.
CONCRETE, MIX NO 1A43	409 CU. YD.
CONCRETE, MIX NO 3Y43	192 CU. YD.
REINFORCEMENT BARS	51,640 LBS.
SPIRAL REINFORCEMENT	12,450 LBS.
FOUR STEEL TEST PILES 120 FT. LONG	
STEEL PILING DELIVERED	4,830 LIN. FT.
STEEL PILING DRIVEN	4,138 LIN. FT.
BRIDGE NAME PLATE	ONE

QUANTITY NOTES

1. THE TABULATED QUANTITIES FOR STEEL PILING, DELIVERED, AND FOR STEEL PILING, DRIVEN, DO NOT INCLUDE TEST PILES.
2. NO SPLICES IN TEST PILES OR MEASURED PILES WILL BE ELIGIBLE FOR EXTRA COMPENSATION, EXCEPT STRICTLY UNDER THE CONDITIONS OF M.H.D. 2452.5B
3. BRIDGE NAME PLATE IS INCLUDED FOR PAYMENT WITH OTHER ITEMS. NAME PLATE LETTERING:
CITY OF
COON RAPIDS
MINNESOTA
BRIDGE NO. 02522
1972



PILE NOTES

1. PILES SHALL BE BATTERED 3" PER FOOT IN THE DIRECTION SHOWN THUS: $\text{H} \rightarrow$
2. ESTIMATED PENETRATION IS TWO FEET LESS THAN LENGTH GIVEN BELOW.
3. ALL PILES ARE STEEL "H", 108P 57, CONFORMING TO M.H.D. 3372
4. PILE SPACING SHOWN IS AT BOTTOM OF FOOTING.
5. TWO STEEL TEST PILES 120-FT. LONG FOR PIER 1.
TWO STEEL TEST PILES 120-FT. LONG FOR PIER 2.
TWENTY-FOUR STEEL PILES 105-FT. LONG FOR PIER 1.
TWENTY-TWO STEEL PILES 105-FT. LONG FOR PIER 2.
FIFTY STEEL PILES, TOTAL FOR TWO PIERS.
6. ALL PILES SHALL BE DRIVEN TO REFUSAL ON BEDROCK.
7. FOR PILE SPLICES AND TIP REINFORCEMENT, SEE DETAIL B202, SHEET 30
8. SEE PILE NOTE, SHEET 1, FOR DEEP INTERFERENCE.


COMPUTED PILE LOADS TONS PER PILE

DEAD LOAD	68.7
LIVE LOAD	8.1
OVERTURNING	(NONE FOR GROUP I)
TOTAL *	76.8 / 100% = 76.8

* GROUP I - NO REDUCTION - SEE A.A.S.H.O. 1.2.22

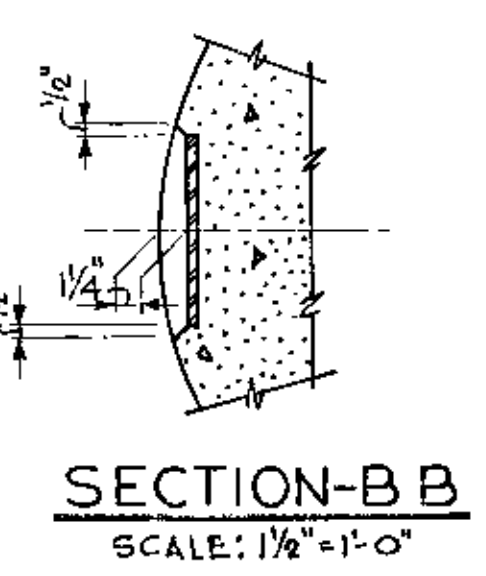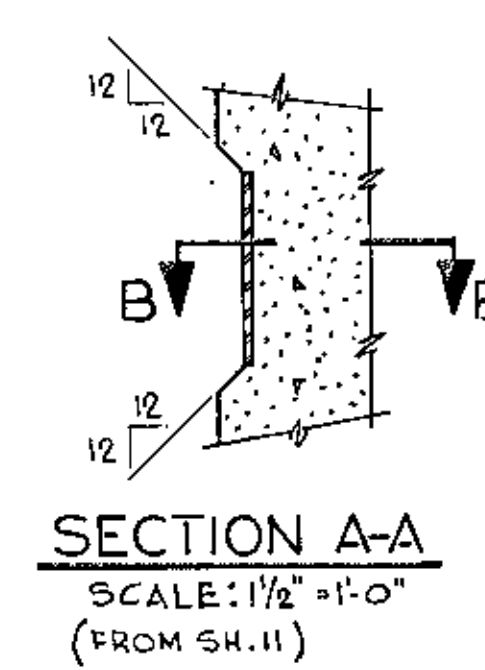

REINFORCEMENT BAR BENDING DIAGRAMS

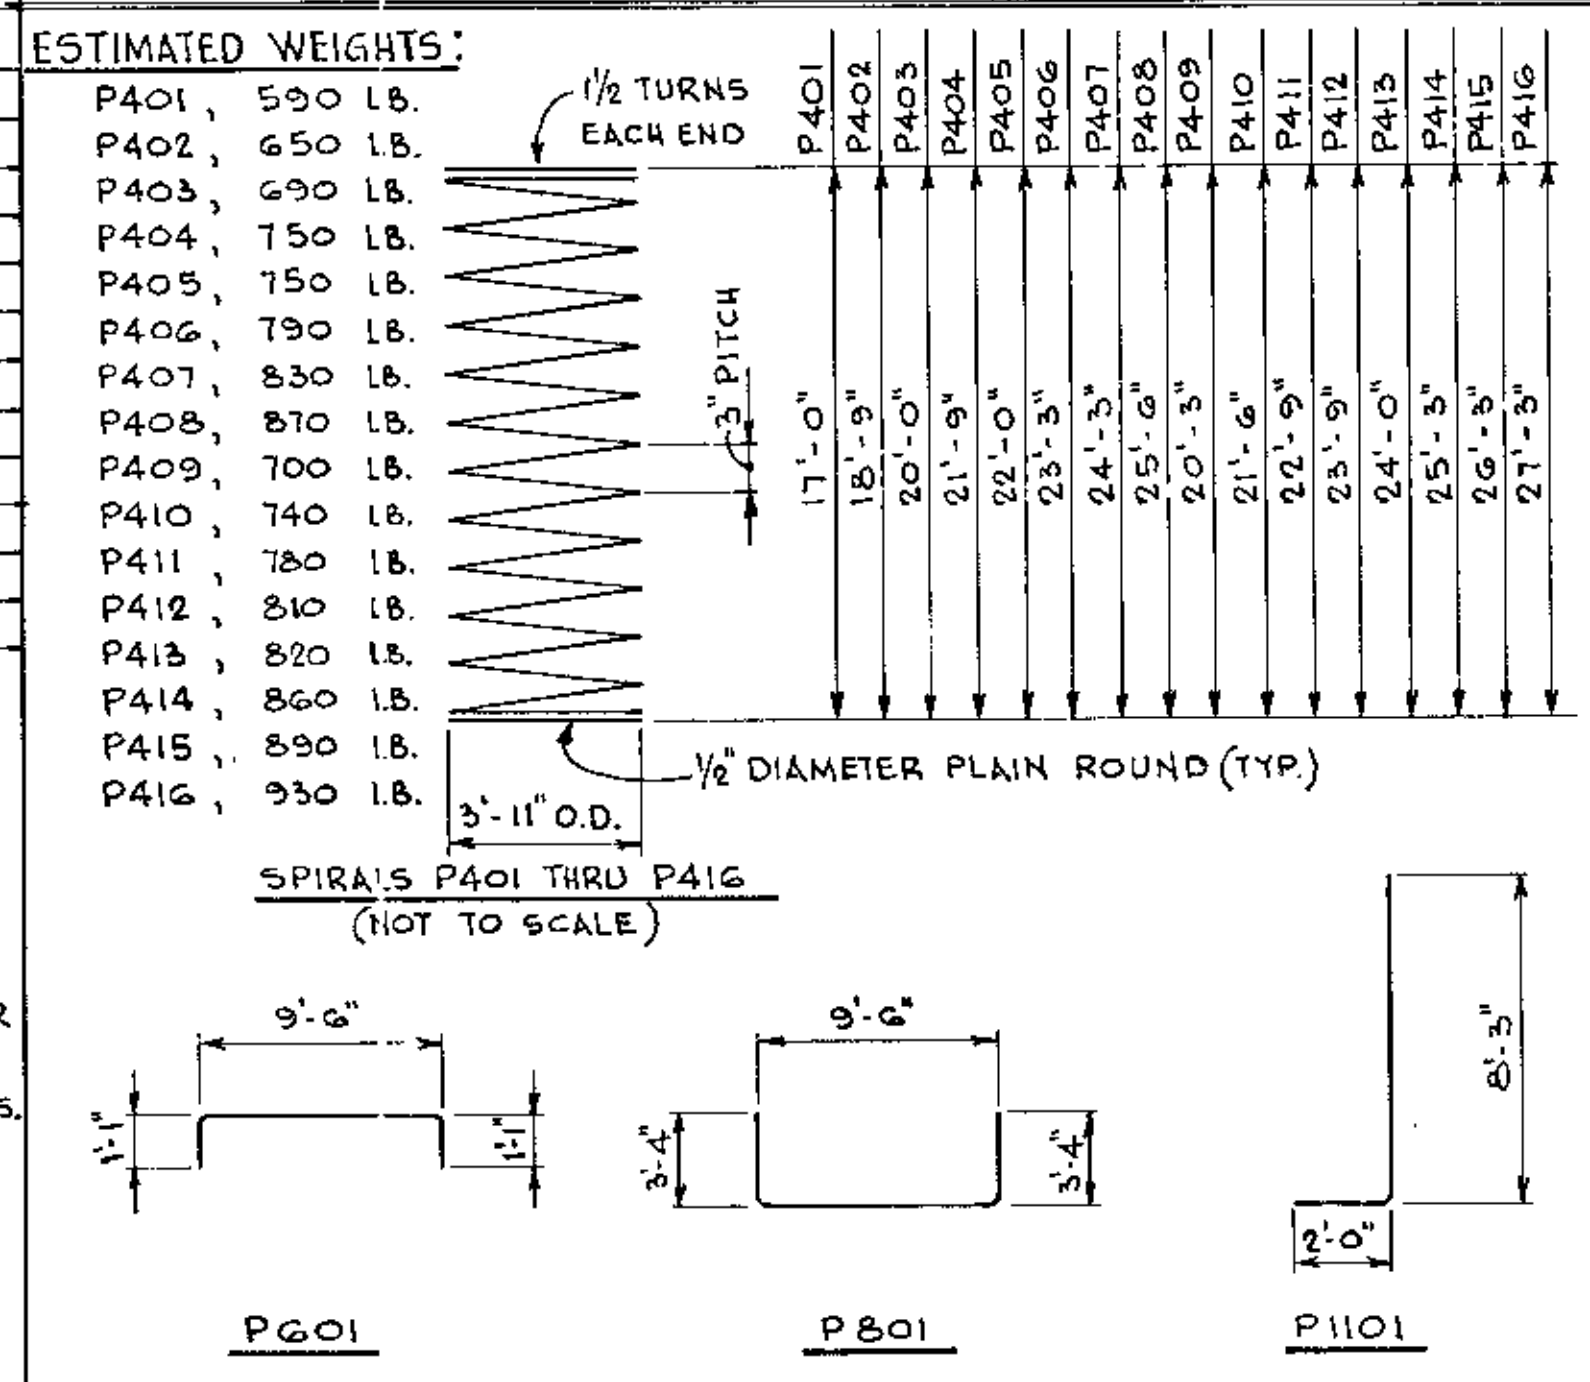

BILL OF REINFORCEMENT FOR PIERS

MARK	NUMBER	LENGTH	SHAPE	LOCATION
P401	1			COLUMN SPIRAL
P402	1			" "
P403	1			" "
P404	1			" "
P405	1			" "
P406	1			" "
P407	1			" "
P408	1			" "
P409	1			" "
P410	1			" "
P411	1			" "
P412	1			" "
P413	1			" "
P414	1			" "
P415	1			" "
P416	1			COLUMN SPIRAL
PG01	228	11'-4"		FOOTING, TRANS.
PB01	228	15'-10"		FOOTING, TRANS.
P1101	192	9'-11"		COLUMN DOWEL
P802	48	40'-0"		LONG PIER 1
P803	36	43'-6"		LONG PIER 2
P1001	12	17'-0"		COLUMN VERT.
P1002	12	18'-7"		" "
P1003	12	20'-0"		" "
P1004	12	21'-5"		" "
P1005	12	21'-10"		" "
P1006	12	23'-1"		" "
P1007	12	24'-3"		" "
P1008	12	25'-6"		" "
P1009	12	26'-1"		" "
P1010	12	27'-4"		" "
P1011	12	28'-7"		" "
P1012	12	29'-9"		" "
P1013	12	31'-0"		" "
P1014	12	32'-1"		" "
P1015	12	33'-2"		" "
P1016	12	34'-3"		COLUMN VERT.

NOTES:

1. WORK THIS SHEET WITH SHEETS 10 AND 11
2. SEE SHEET 31 FOR DETAIL OF 1/4" ANCHOR BOLT
3. COLUMN REINFORCEMENT SHALL BE CAREFULLY PLACED TO AVOID INTERFERENCE WITH THE DRILLING OF HOLES FOR ANCHOR BOLTS.
4. THE SUPERSTRUCTURE GIRDERS SHALL BE ERECTED IN FINAL POSITION PRIOR TO DRILLING ANCHOR BOLT HOLES AND PLACING ANCHOR BOLTS.


AS BUILT
10-16-73
B. J. J.

TITLE: PIER DETAILS


DES: R. J. M. DR: W. K. APPROVED:
CHK: M. O. D. CHK: R. J. M.
Sheet No. 12 of 35 Sheets Bridge No. 02522

NOTES:

1. WORK THIS SHEET WITH SHEETS 10 AND 12
2. SECTION A-A IS ON SHEET 12
3. P801, P803 AND P601 MAY BE SHIFTED SLIGHTLY TO CLEAR PILE HEADS.
4. P1101 DOWELS MAY BE ROTATED AS NECESSARY TO CLEAR PILE HEADS.

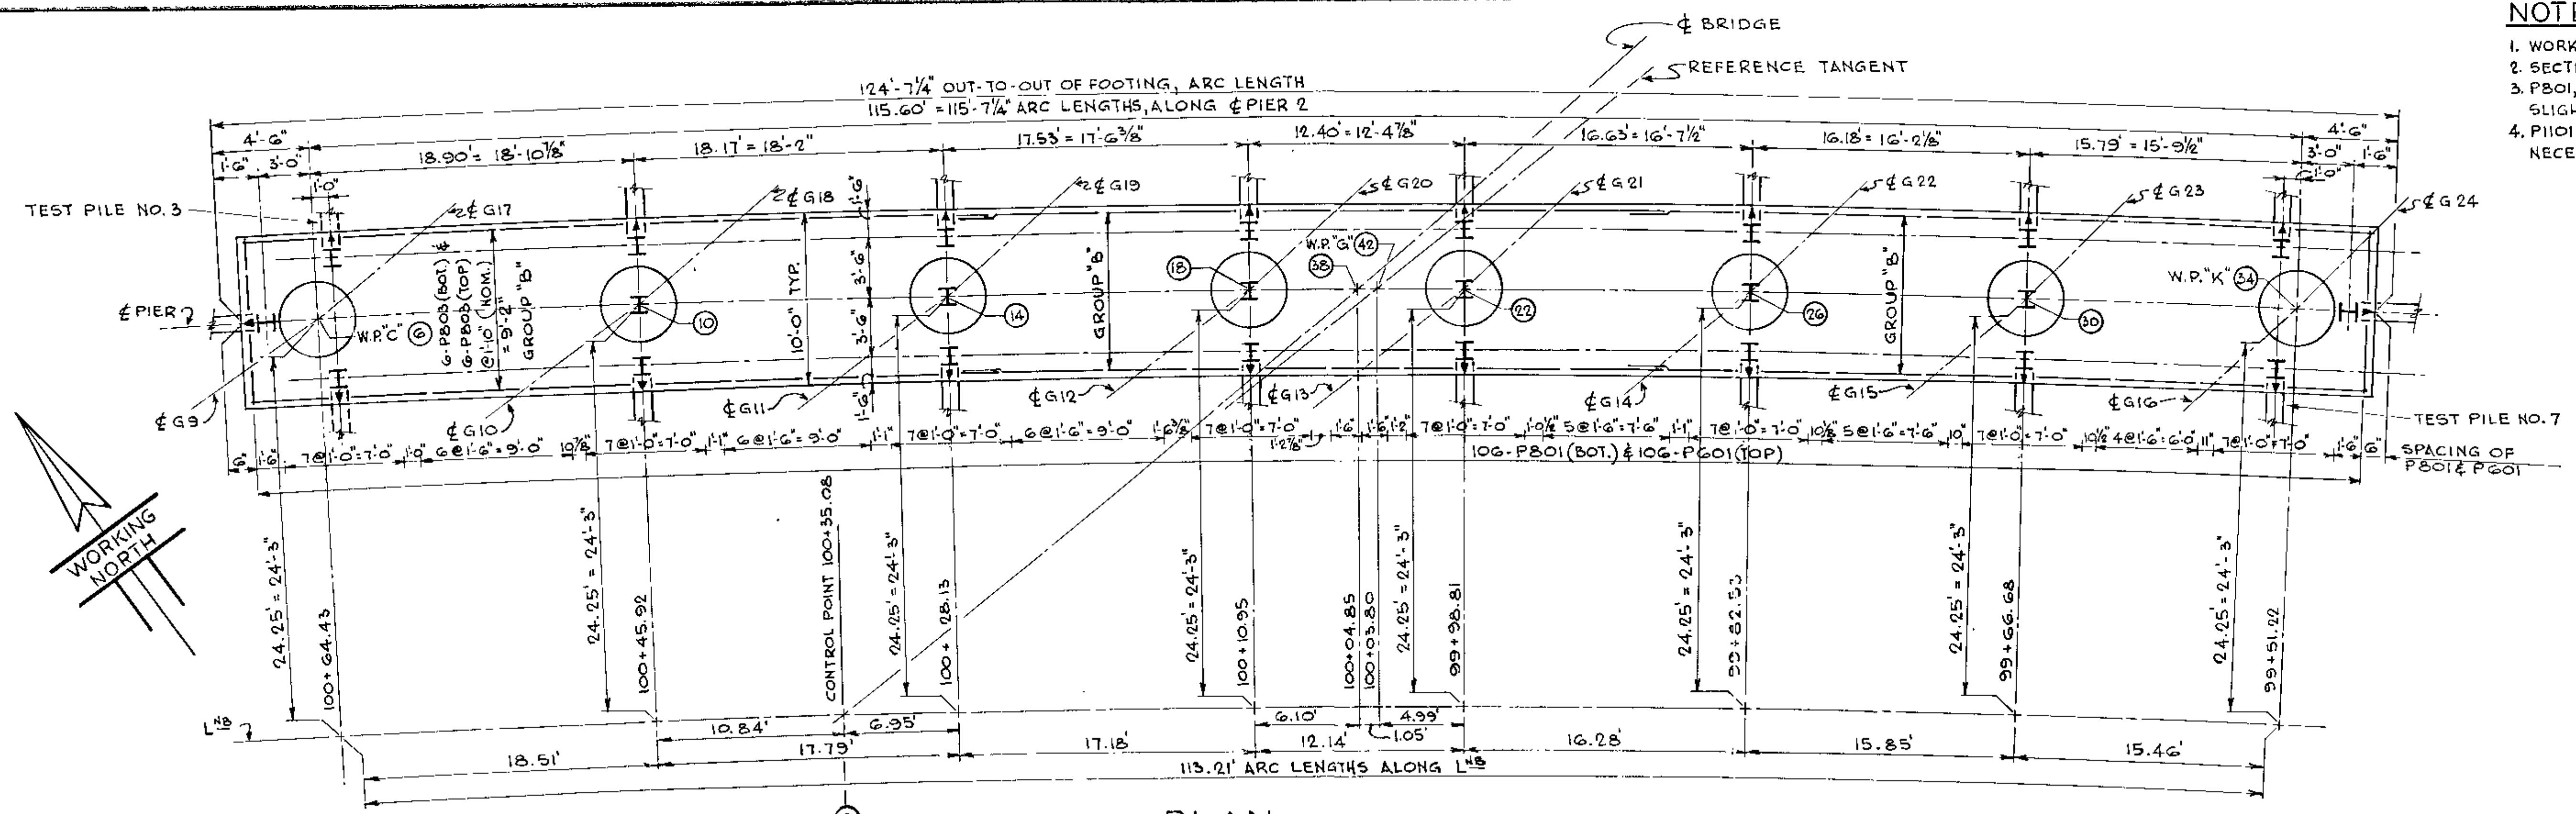


PLAN
SCALE: 3/16" = 1'-0"

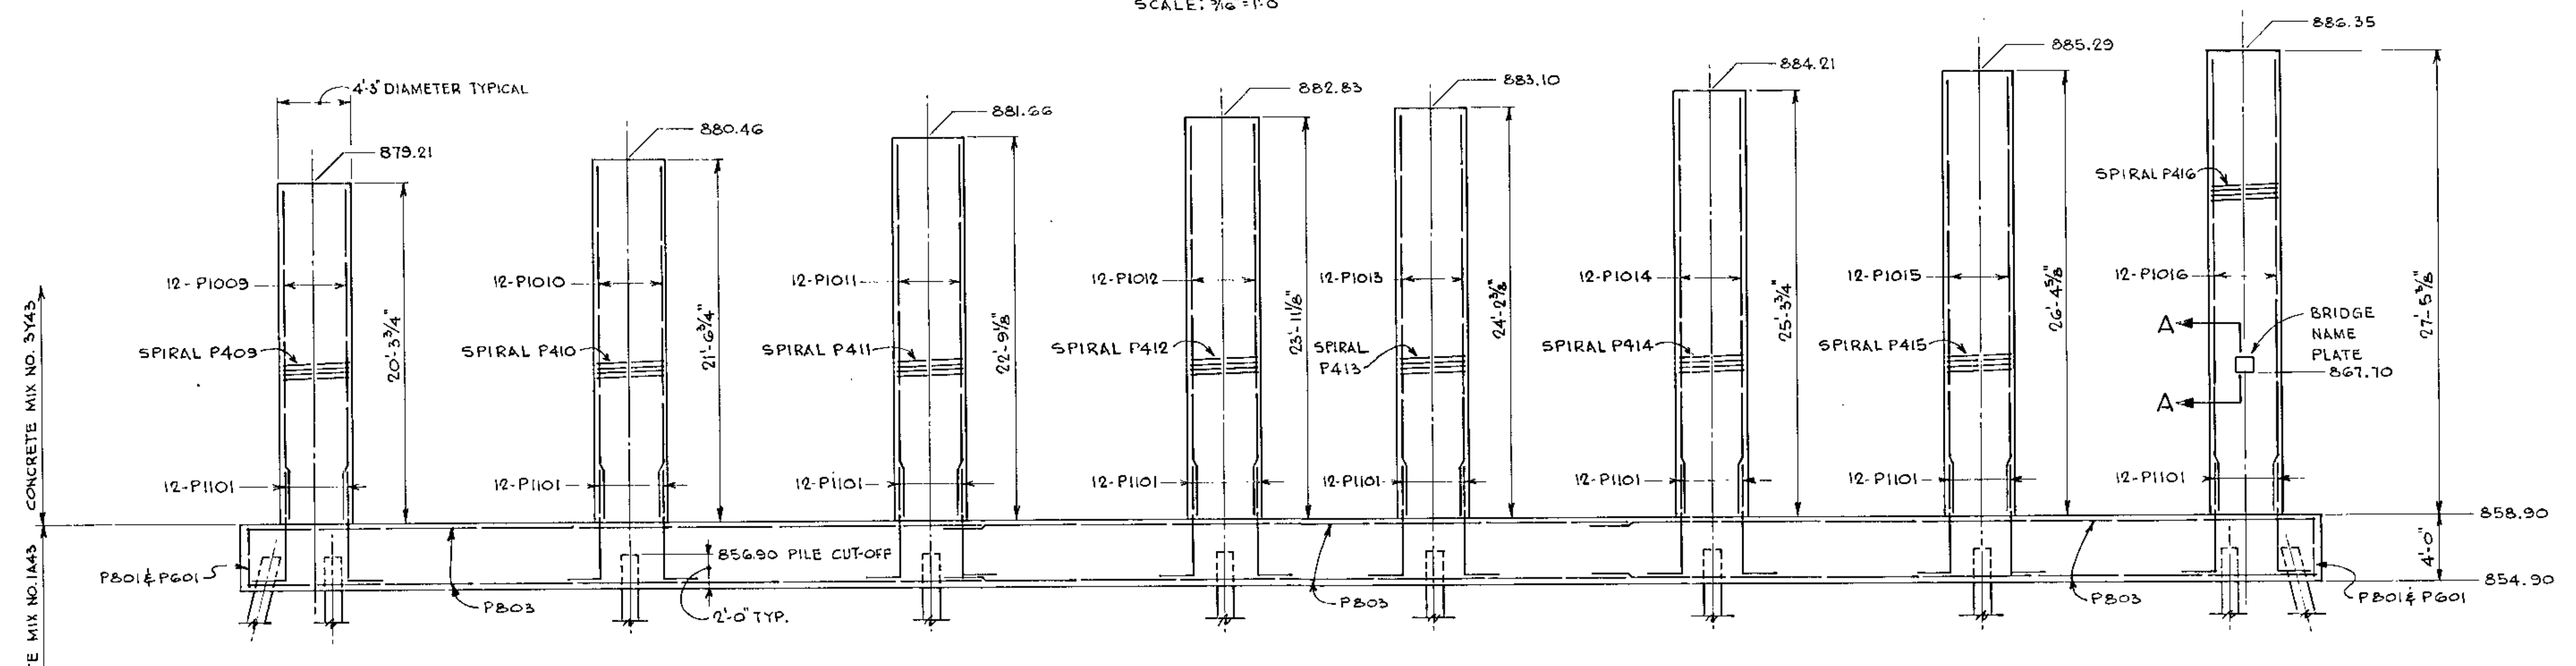


ELEVATION
SCALE: 3/16" = 1'-0"

AS BUILT
10-16-73
B. Jahn

TITLE: PIER 2		DES: R. M. J.	DR: W. K.	APPROVED:	Bridge No. 02522
		CHK: M. O. Y.	CHK: B. J.		Sheet No. 11 of 35 Sheets

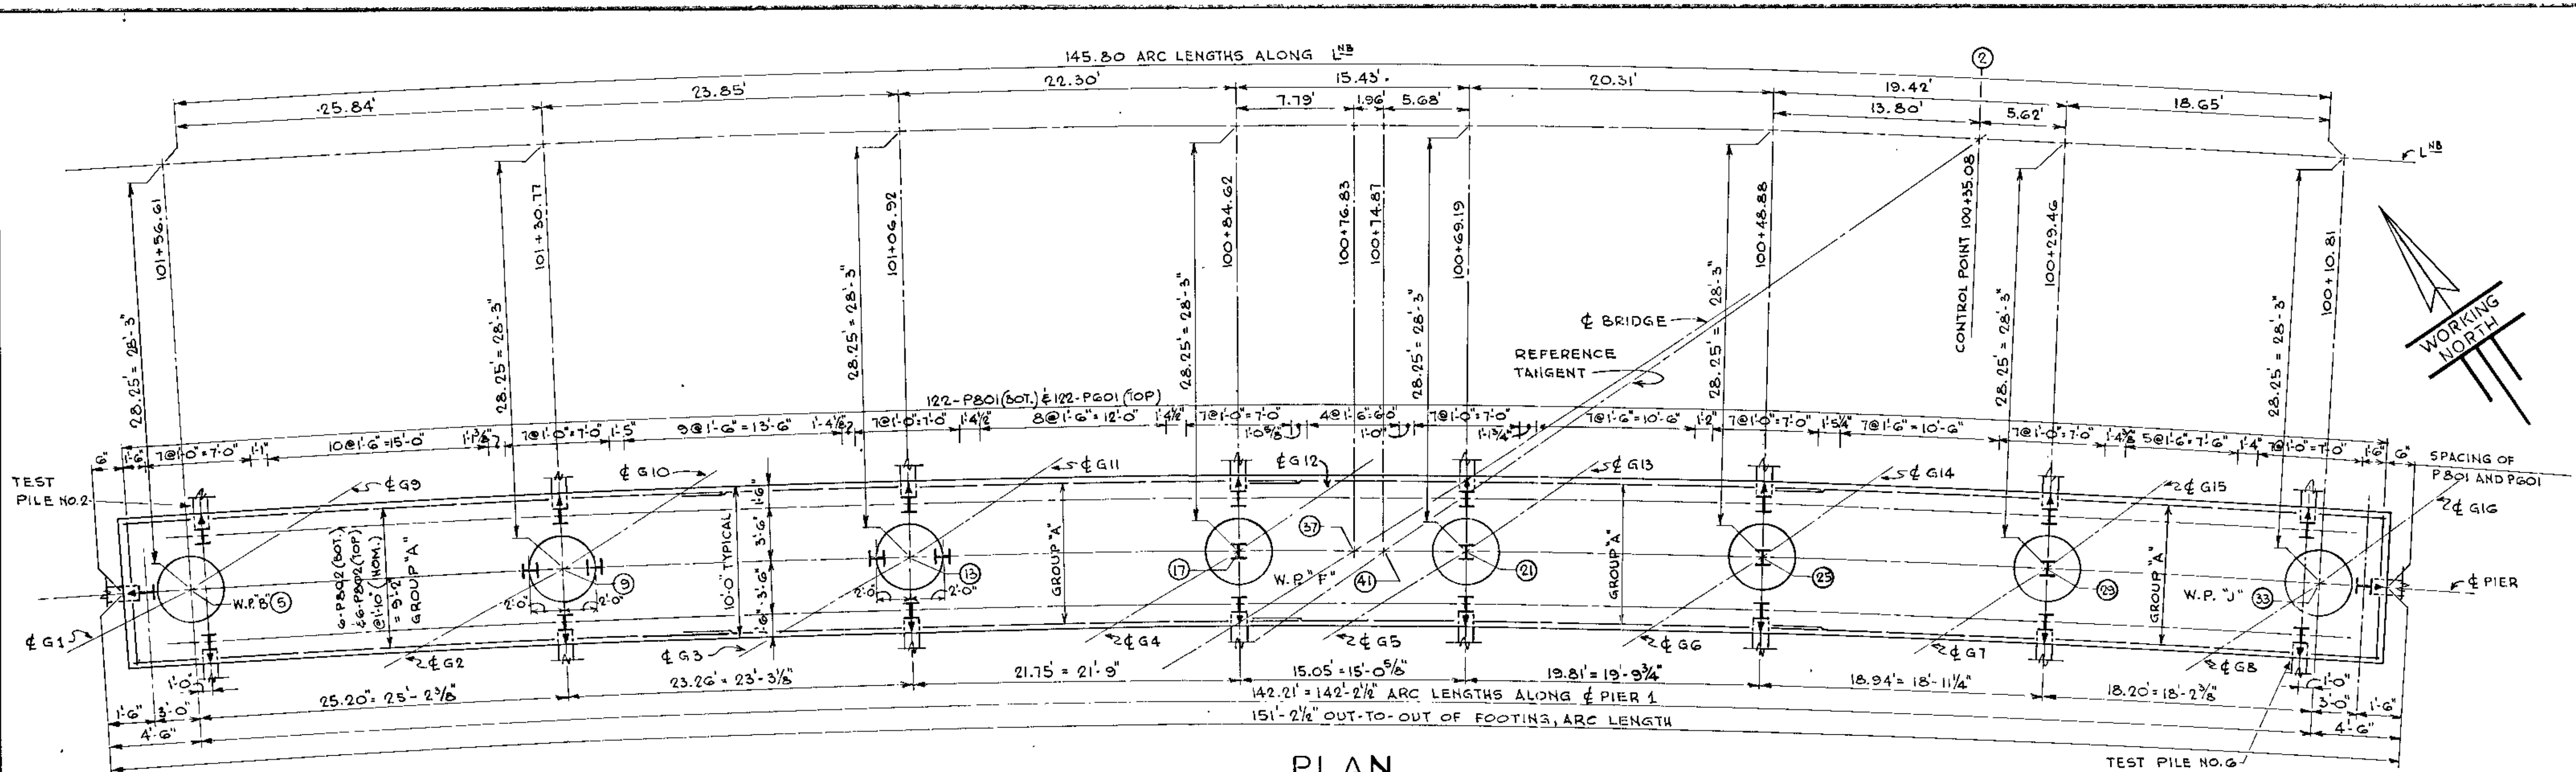

PLAN
SCALE: 3/16" = 1'-0"

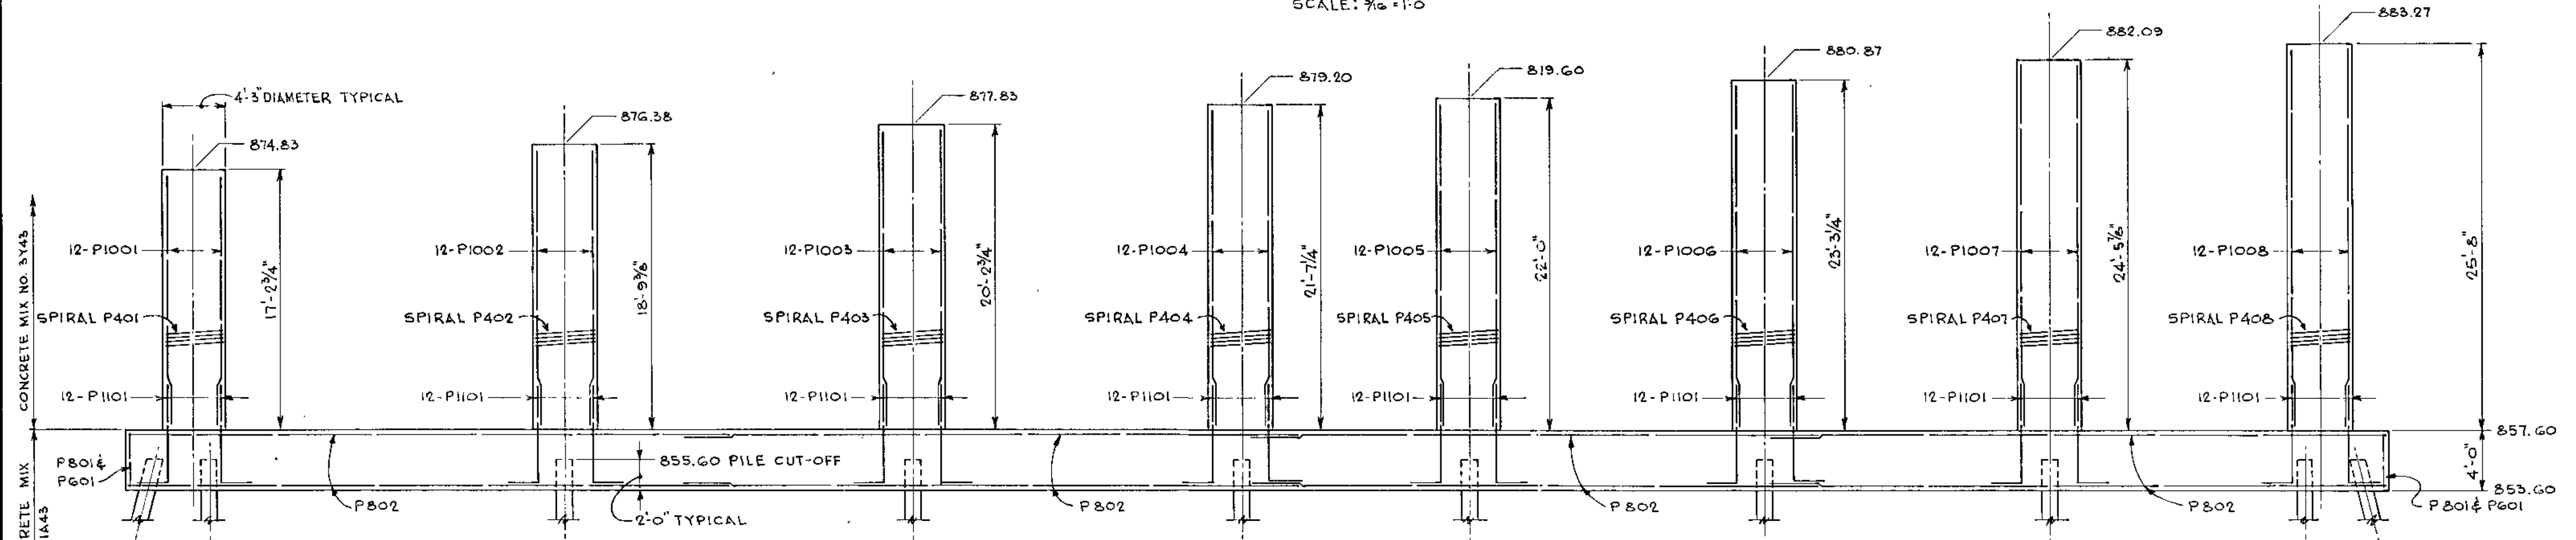

ELEVATION
SCALE: 3/16" = 1'-0"

NOTES:

1. WORK THIS SHEET WITH SHEETS 11 AND 12
2. P801, P802 AND P601 MAY BE SHIFTED SLIGHTLY TO CLEAR PILE HEADS
3. P1101 DOWELS MAY BE ROTATED AS NECESSARY TO CLEAR PILE HEADS


AS BUILT
10-16-73
B. Jahn

TITLE:	DES: <i>[Signature]</i>	DR: W.K.	APPROVED:	Bridge No.
PIER 1,	CHK: MODY	CHK: <i>[Signature]</i>		02522
Sheet No. 10 of 35 Sheets				

REINFORCEMENT BAR NOTES



1. FOR A TO B, NUMBER IS TWO SERIES OF SEVEN BARS; LENGTH VARIES FROM 3'-0" TO 17'-0" IN 1'-4" INCREMENTS.
2. FOR A TO C, NUMBER IS TWO SERIES OF SEVEN BARS; LENGTH VARIES FROM 5'-0" TO 3'-0" IN 5" INCREMENTS.
3. BAR LOCATION ABBREVIATIONS:
 E.F. EACH FACE
 N.F. NEAR FACE
 F.F. FAR FACE
 T. TOP
 B. BOTTOM

REINFORCEMENT BAR BENDING DIAGRAMS

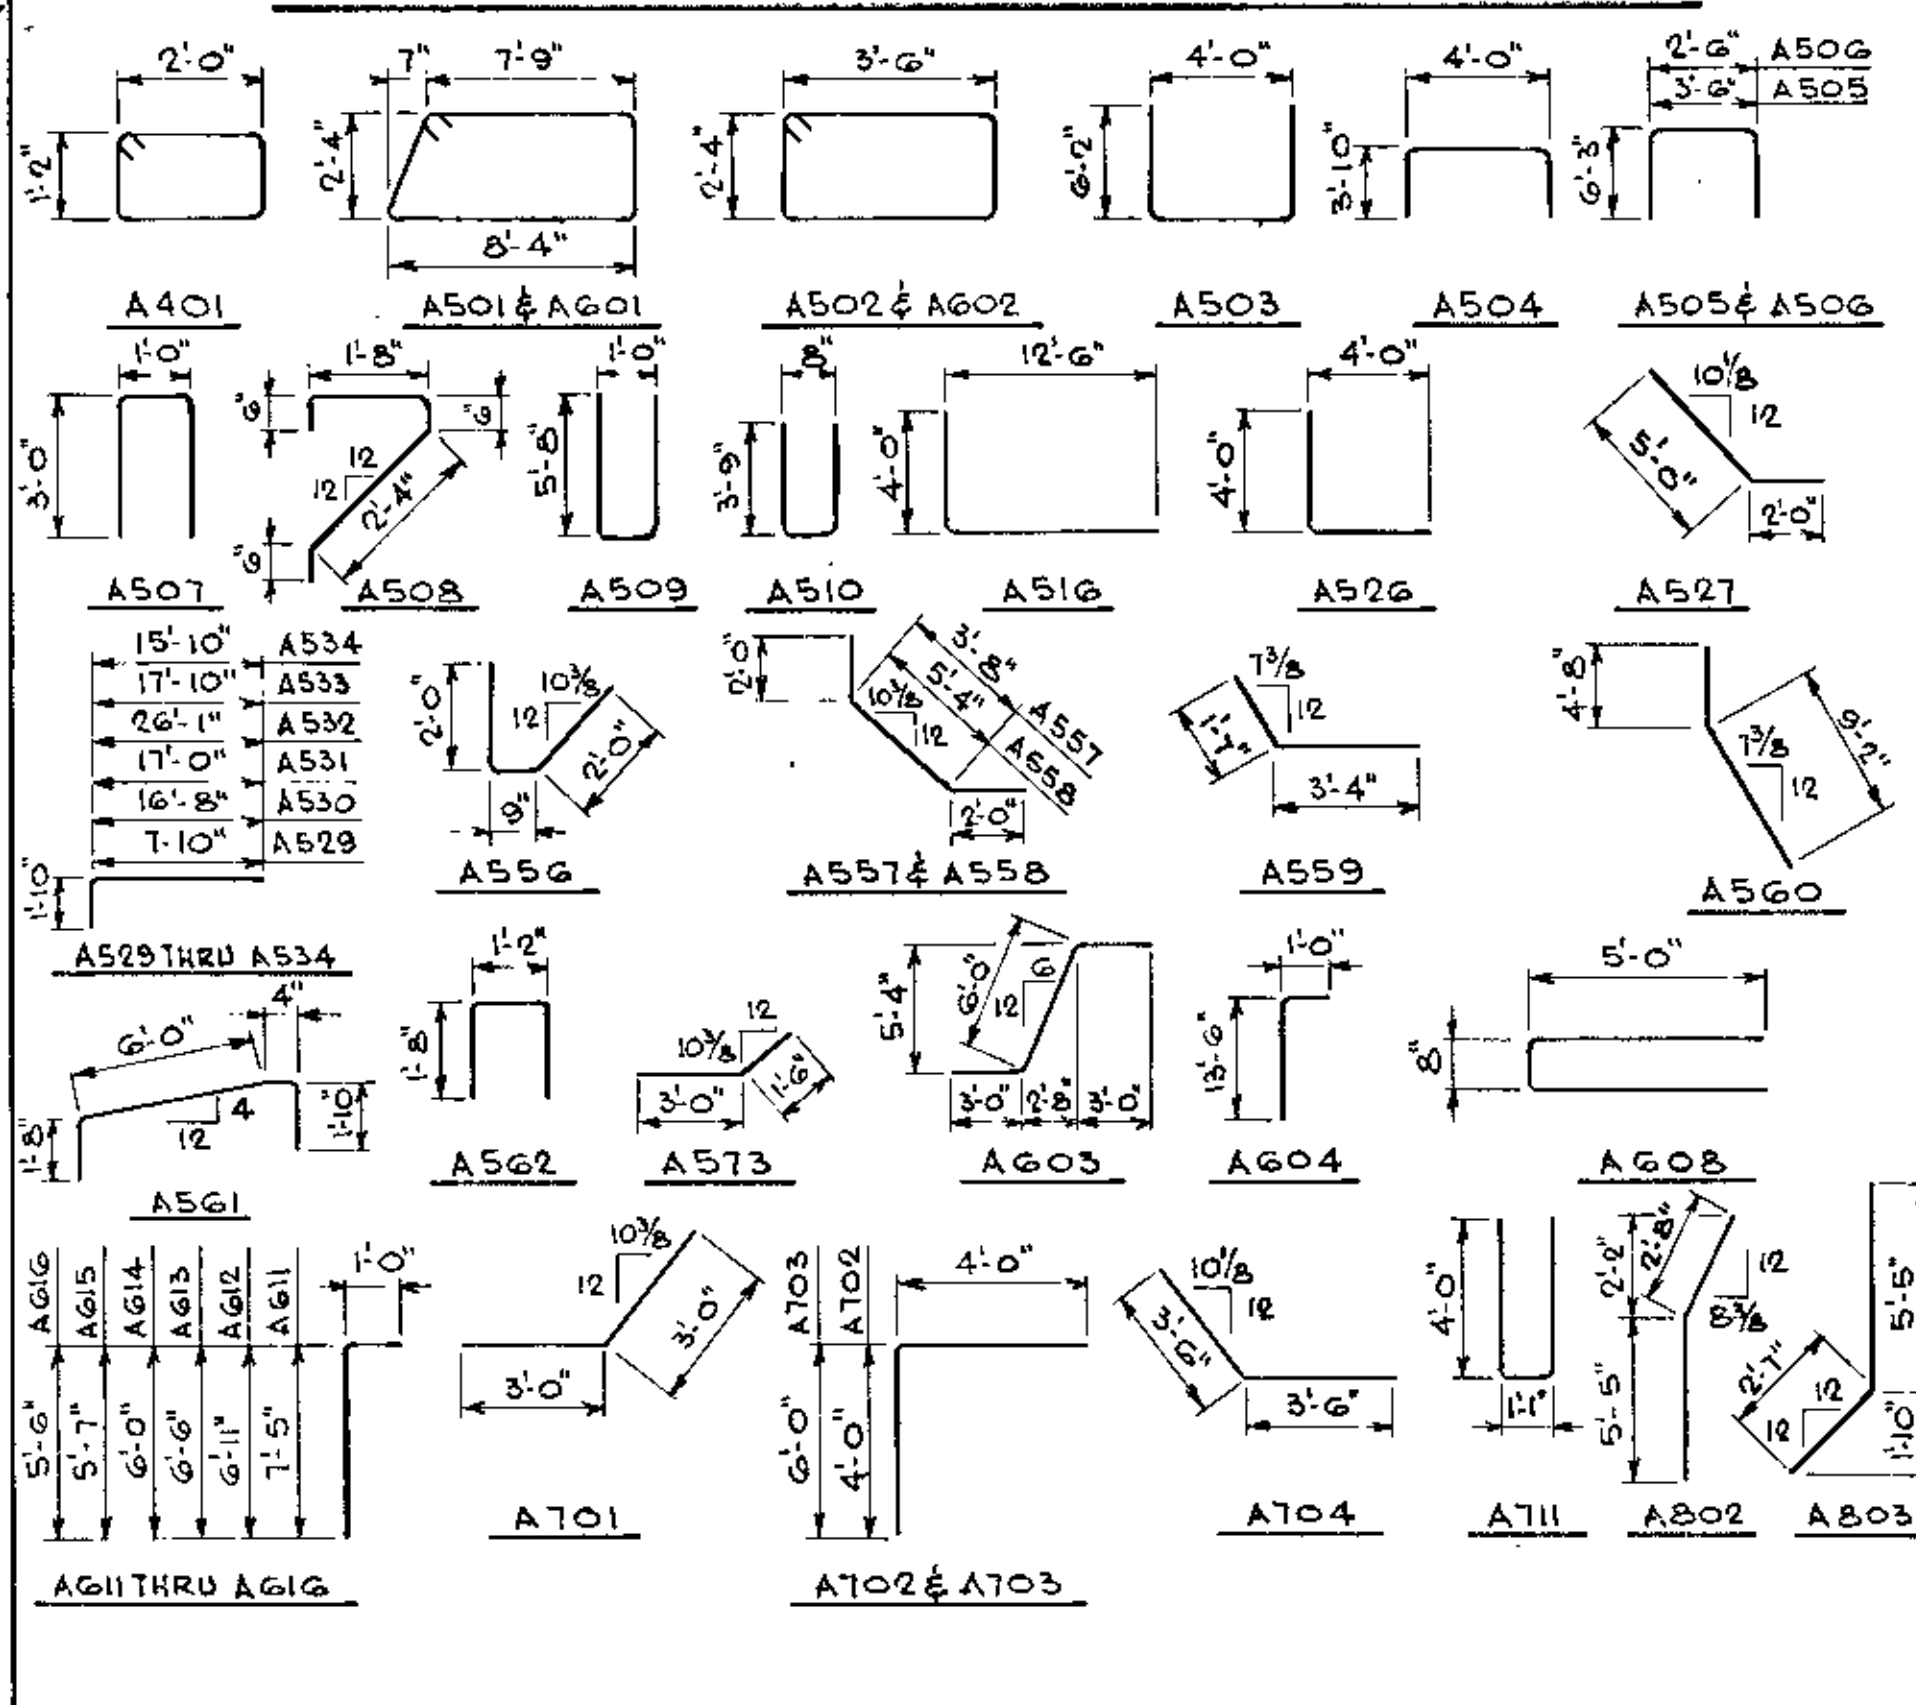





BILL OF REINFORCEMENT FOR EAST ABUTMENT

MARK	NUMBER	LENGTH	SHAPE	LOCATION	MARK	NUMBER	LENGTH	SHAPE	LOCATION	MARK	NUMBER	LENGTH	SHAPE	LOCATION
A501	68	21'-7"	[Shape]	FOOTING TRANS.	A401	5	6'-11"	[Shape]	END POST TIES	A511	8	14'-10"	[Shape]	WINGWALL VERT.
A502	5	12'-5"	[Shape]	WING FTG. TRANS.						A512	10	12'-1"	[Shape]	WINGWALL VERT.
A503	88	18'-2"	[Shape]	ABUT. VERT.						A513	4	21'-2"	[Shape]	WINGWALL HORIZ.
A504	126	11'-6"	[Shape]	SEAT TRANS.	A601	32	21'-6"	[Shape]	FOOTING TRANS.	A514	4	18'-8"	[Shape]	WINGWALL HORIZ.
A505	1	15'-10"	[Shape]	SEAT TRANS.	A602	4	12'-4"	[Shape]	WING FTG. TRANS.	A515	6	5'-0"	[Shape]	WINGWALL HORIZ.
A506	1	14'-10"	[Shape]	SEAT TRANS.	A603	24	12'-0"	[Shape]	FOOTING STEPS					
A507	111	6'-10"	[Shape]	TOP BACKWALL	A604	8	14'-4"	[Shape]	WINGWALL VERT.	A517	1	14'-6"	[Shape]	WINGWALL HORIZ.
A508	111	5'-3"	[Shape]	BRACKET						A518	1	16'-6"	[Shape]	WINGWALL HORIZ.
A509	111	12'-2"	[Shape]	BACKWALL VERT.	A608	2	10'-6"	[Shape]	TOP WINGWALL	A519	2	9'-0"	[Shape]	WINGWALL FILLET
A510	11	8'-0"	[Shape]	WINGWALL DOWELS						A520	1	8'-8"	[Shape]	WINGWALL VERT.
					A611	1	8'-3"	[Shape]	WINGWALL VERT.	A521	1	8'-2"	[Shape]	WINGWALL VERT.
A516	7	16'-5"	[Shape]	WINGWALL HORIZ.	A612	1	7'-9"	[Shape]	WINGWALL VERT.	A522	1	7'-9"	[Shape]	WINGWALL VERT.
A526	6	7'-11"	[Shape]	WINGWALL CORNER	A613	1	7'-4"	[Shape]	WINGWALL VERT.	A523	1	7'-3"	[Shape]	WINGWALL VERT.
A527	13	7'-0"	[Shape]	WINGWALL CORNER	A614	1	6'-10"	[Shape]	WINGWALL VERT.	A524	1	6'-10"	[Shape]	WINGWALL VERT.
A529	3	9'-7"	[Shape]	TOP OF SEAT	A615	1	6'-5"	[Shape]	WINGWALL VERT.	A525	2	6'-9"	[Shape]	WINGWALL VERT.
A530	3	18'-5"	[Shape]	TOP OF SEAT	A616	2	6'-4"	[Shape]	WINGWALL VERT.					
A531	3	18'-9"	[Shape]	TOP OF SEAT						A528	2	4'-10"	[Shape]	FILLET VERT.
A532	3	21'-10"	[Shape]	TOP OF SEAT	A701	2	6'-0"	[Shape]	FTG. CORNER	A535	3	2'-0"	[Shape]	TOP OF SEAT
A533	3	19'-7"	[Shape]	TOP OF SEAT	A702	2	7'-10"	[Shape]	FTG. CORNER	A536	4	36'-5"	[Shape]	ABUT. HORIZ.
A534	3	17'-7"	[Shape]	TOP OF SEAT	A703	2	9'-10"	[Shape]	FTG. CORNER	A537	4	39'-5"	[Shape]	ABUT. HORIZ.
					A704	2	7'-0"	[Shape]	FTG. CORNER	A538	1	21'-6"	[Shape]	ABUT. HORIZ.
A556	7	4'-7"	[Shape]	CORNER OF WING						A539	1	24'-6"	[Shape]	ABUT. HORIZ.
A557	12	7'-8"	[Shape]	CORNER OF WING						A540	1	6'-10"	[Shape]	ABUT. HORIZ.
A558	12	9'-4"	[Shape]	CORNER OF WING	A802	2	8'-1"	[Shape]	END POST DOWEL	A541	1	9'-10"	[Shape]	ABUT. HORIZ.
A559	2	4'-11"	[Shape]	WING DOWEL	A803	2	8'-0"	[Shape]	END POST DOWEL	A542	8	41'-11"	[Shape]	ABUT. HORIZ.
A560	2	13'-10"	[Shape]	WING EDGE						A543	2	28'-1"	[Shape]	ABUT. HORIZ.
A561	2	9'-8"	[Shape]	WING EDGE						A544	4	33'-10"	[Shape]	ABUT. HORIZ.
A562	2	4'-4"	[Shape]	TOP OF WING						A545	4	30'-0"	[Shape]	ABUT. HORIZ.
										A546	2	15'-10"	[Shape]	ABUT. HORIZ.
A573	12	4'-6"	[Shape]	CORNER OF WING						A547	8	38'-4"	[Shape]	BACKWALL HORIZ.

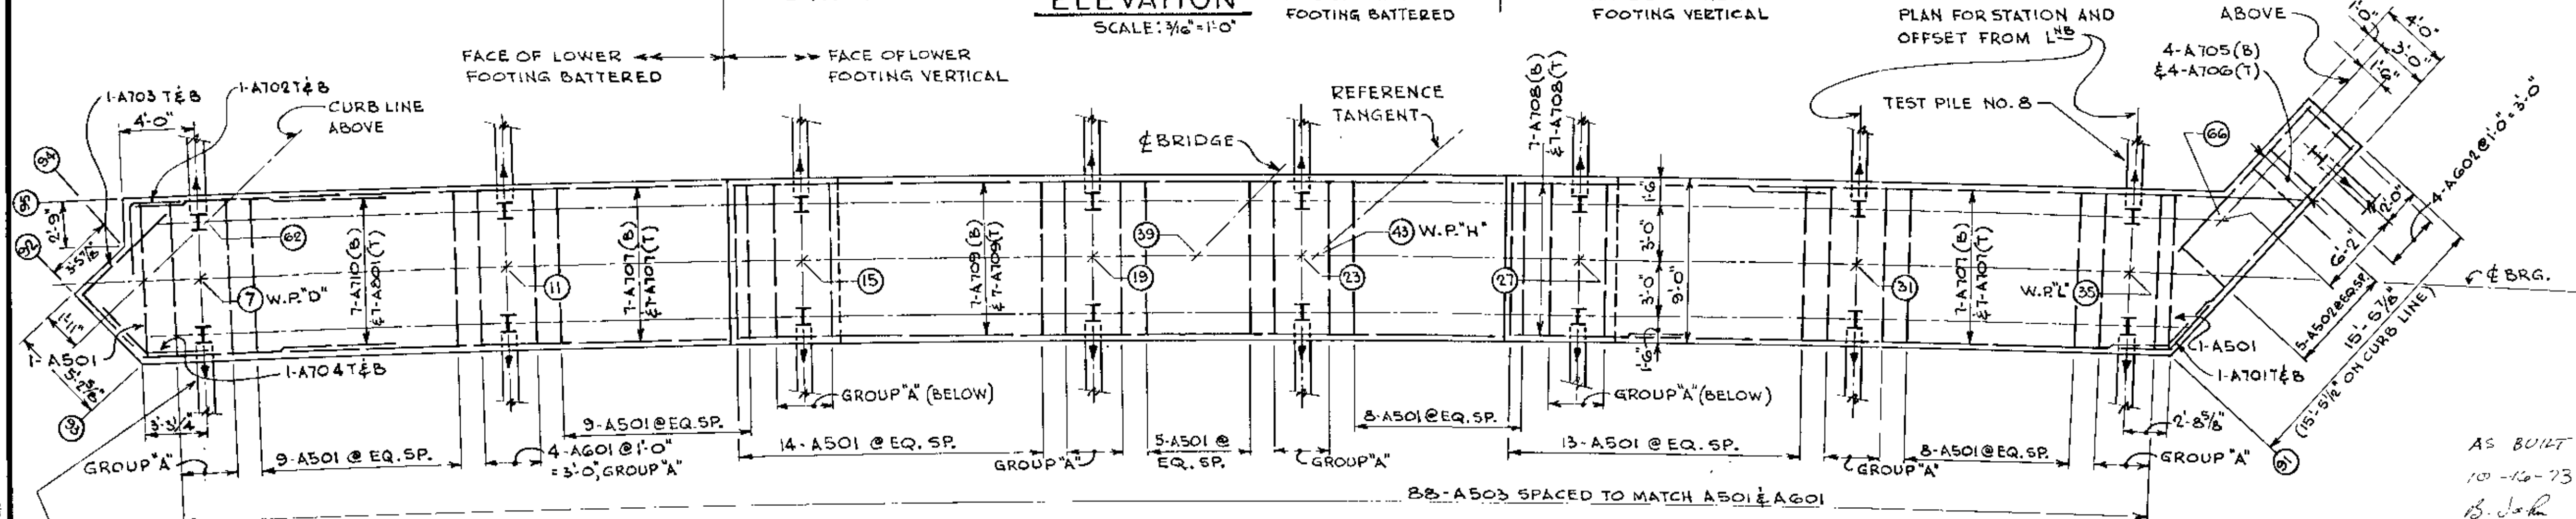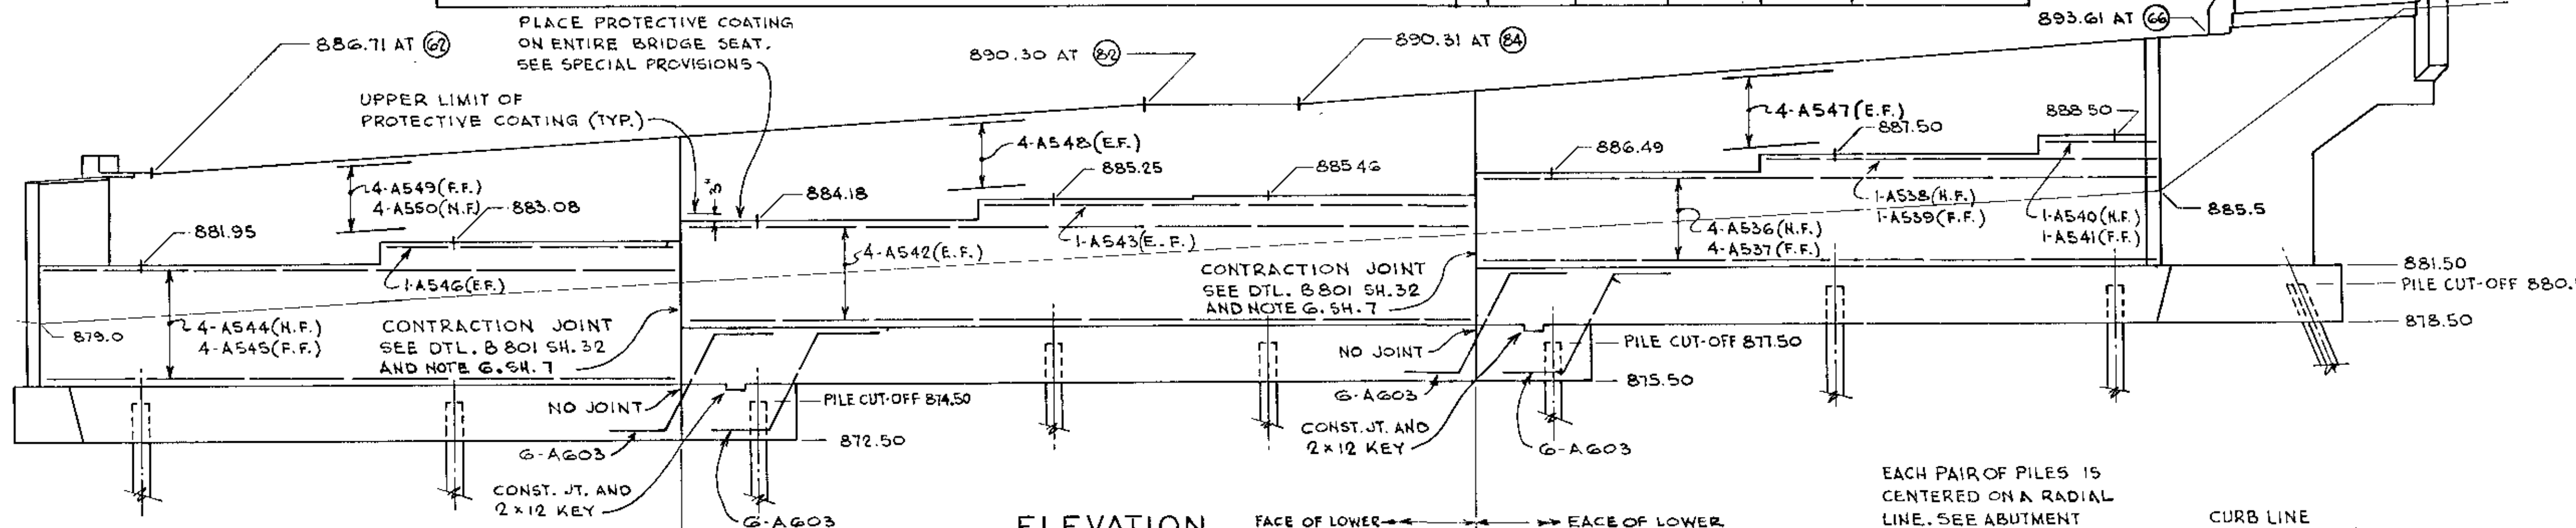

COMPUTED PILE LOADS TONS PER PILE		
ITEM	FRONT ROW	BACK ROW
DEAD LOAD	49.4	69.8
LIVE LOAD	15.7	15.7
OVERTURNING	10.4	-10.4
TOTAL	75.5	75.1

- PILE NOTES:**
1. ALL PILES SHALL BE BATTERED 3" PER FOOT IN THE DIRECTION SHOWN THUS = \rightarrow
 2. ESTIMATED PENETRATION IS TWO FEET LESS THAN LENGTH GIVEN BELOW.
 3. ALL PILES ARE STEEL "H", 106P57, CONFORMING TO M. H. D. 3372
 4. PILE SPACING SHOWN IS AT BOTTOM OF FOOTING.
 5. TWO STEEL TEST PILES 140-FT. LONG. FIFTEEN STEEL PILES 130-FT. LONG.
 6. ALL PILES SHALL BE DRIVEN TO REFUSAL ON BEDROCK.
 7. FOR PILE SPLICES, AND TIP REINFORCEMENT, SEE DETAIL B202, SHEET 30.
 8. SEE PILE NOTE, SHEET 1, FOR DEEP INTERFERENCE.




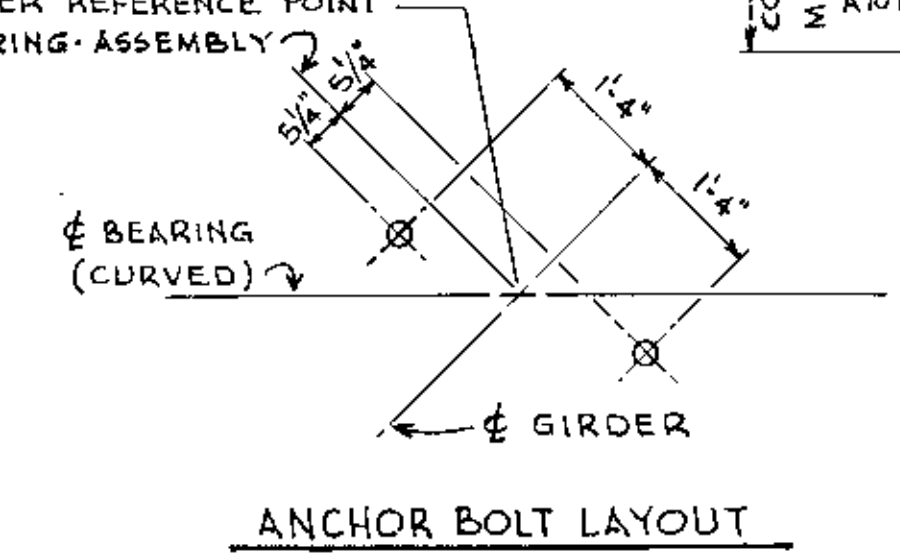
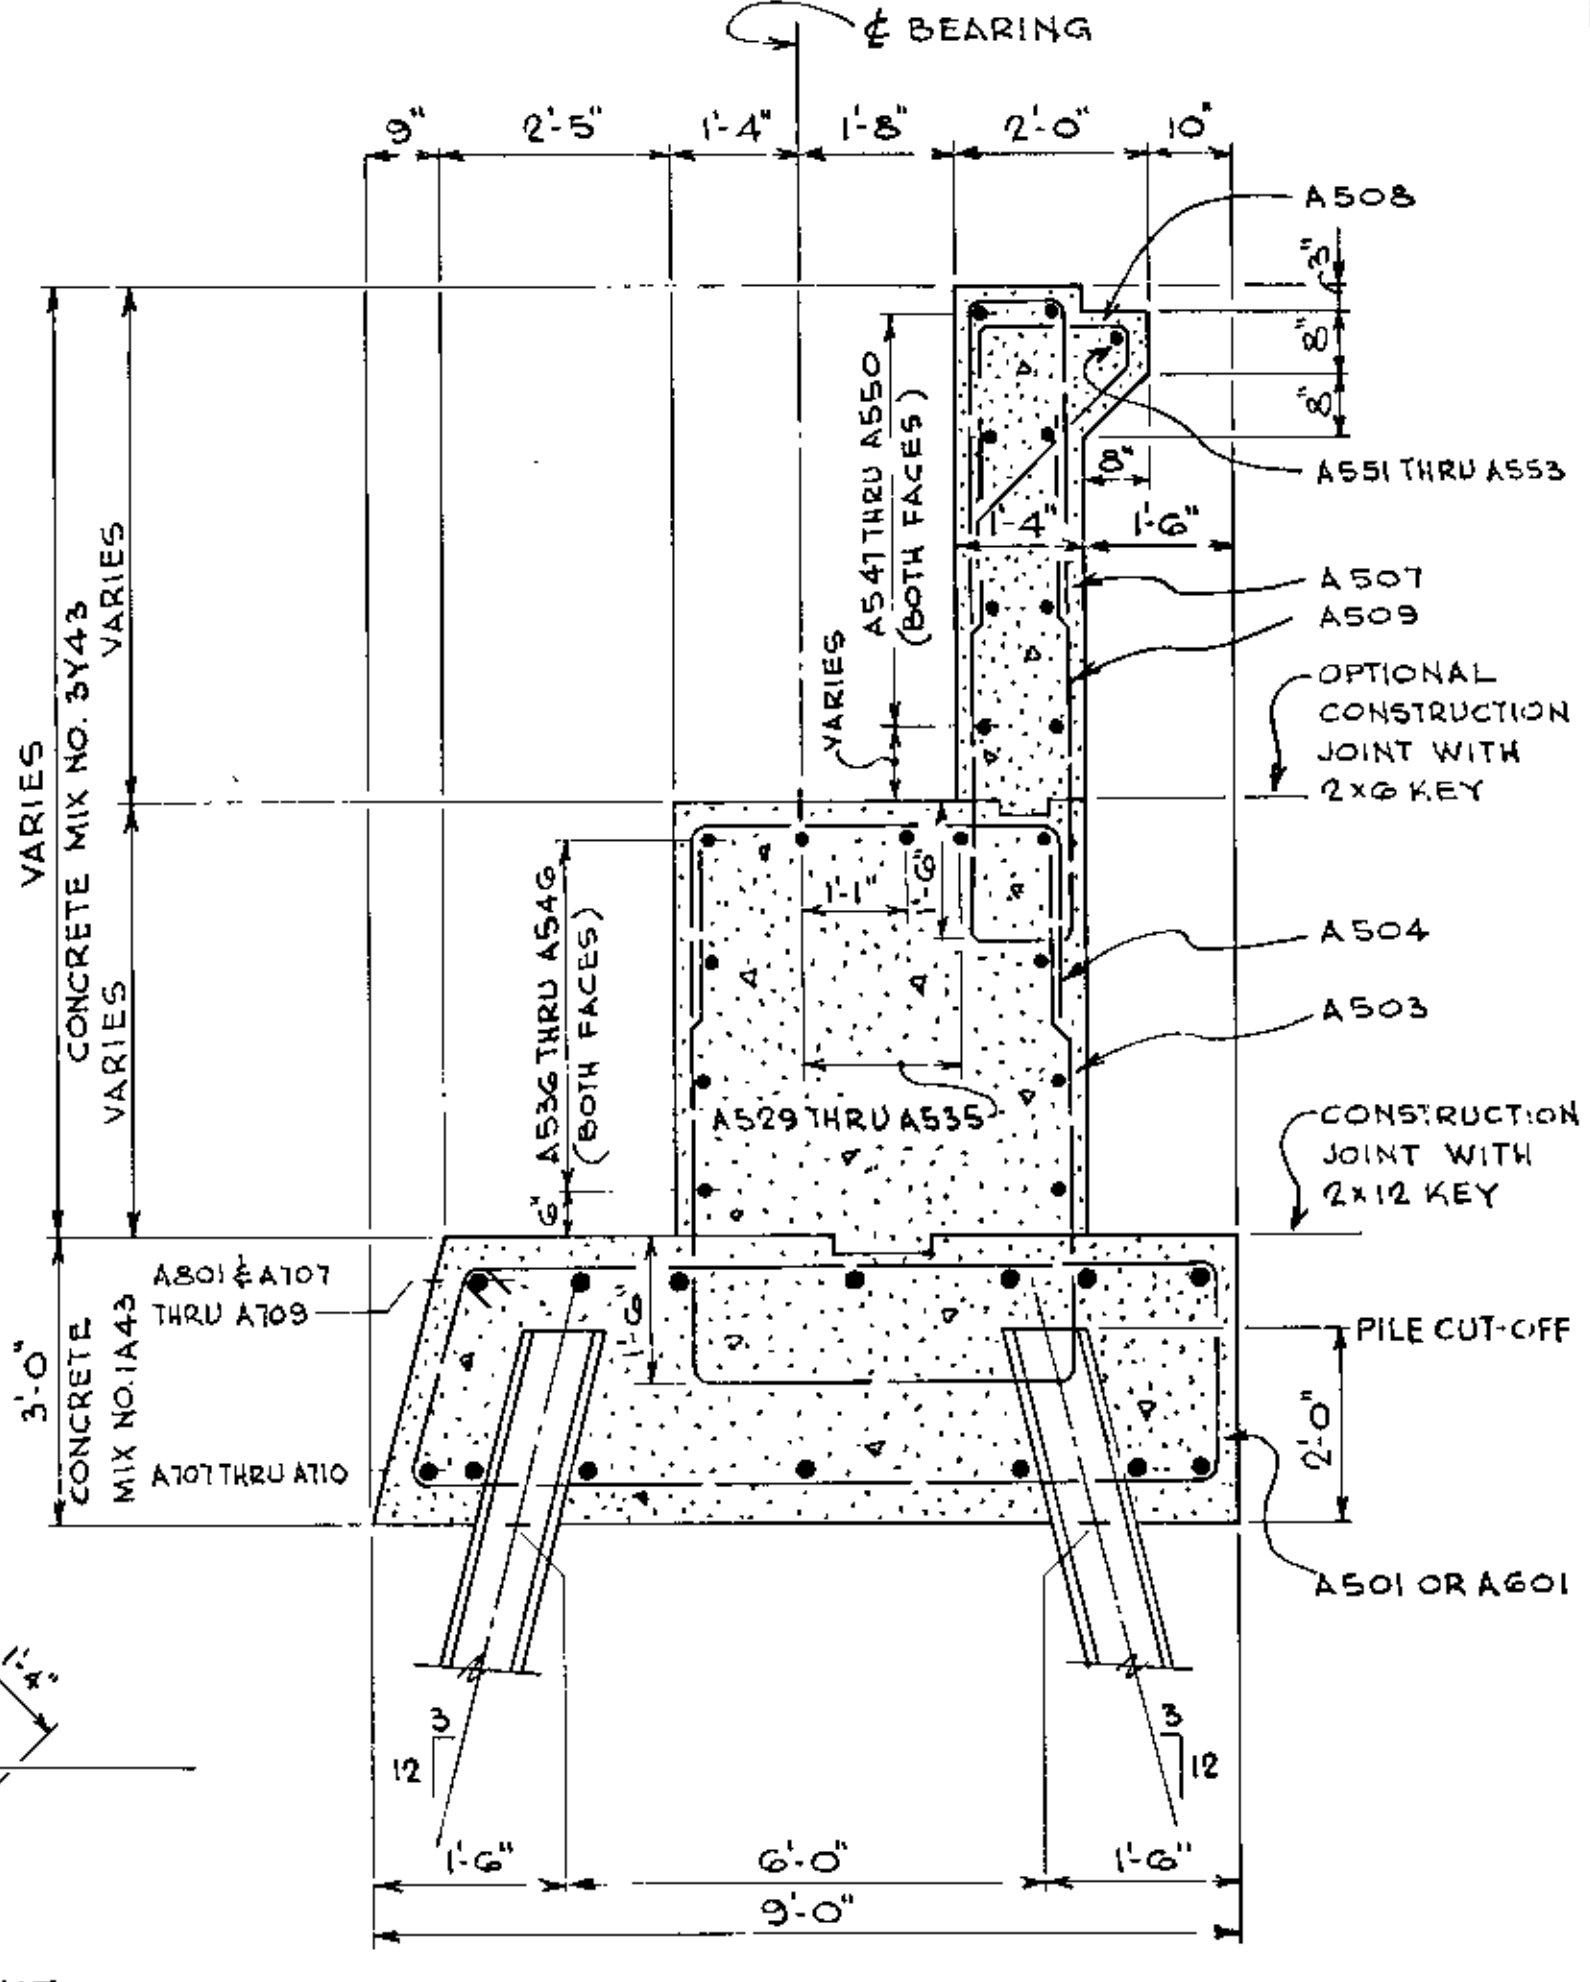
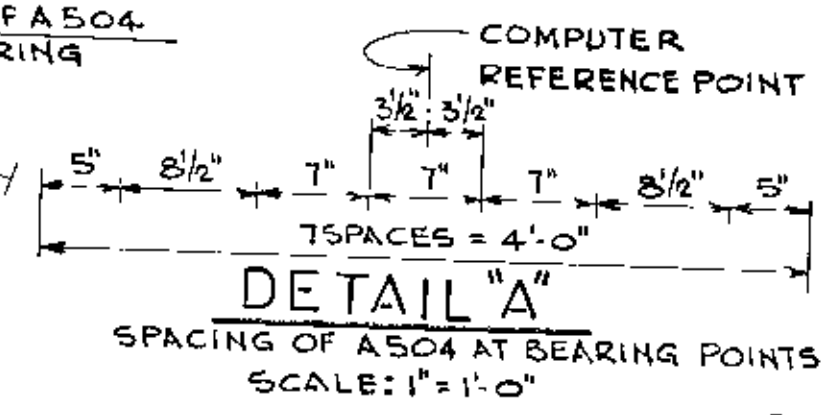
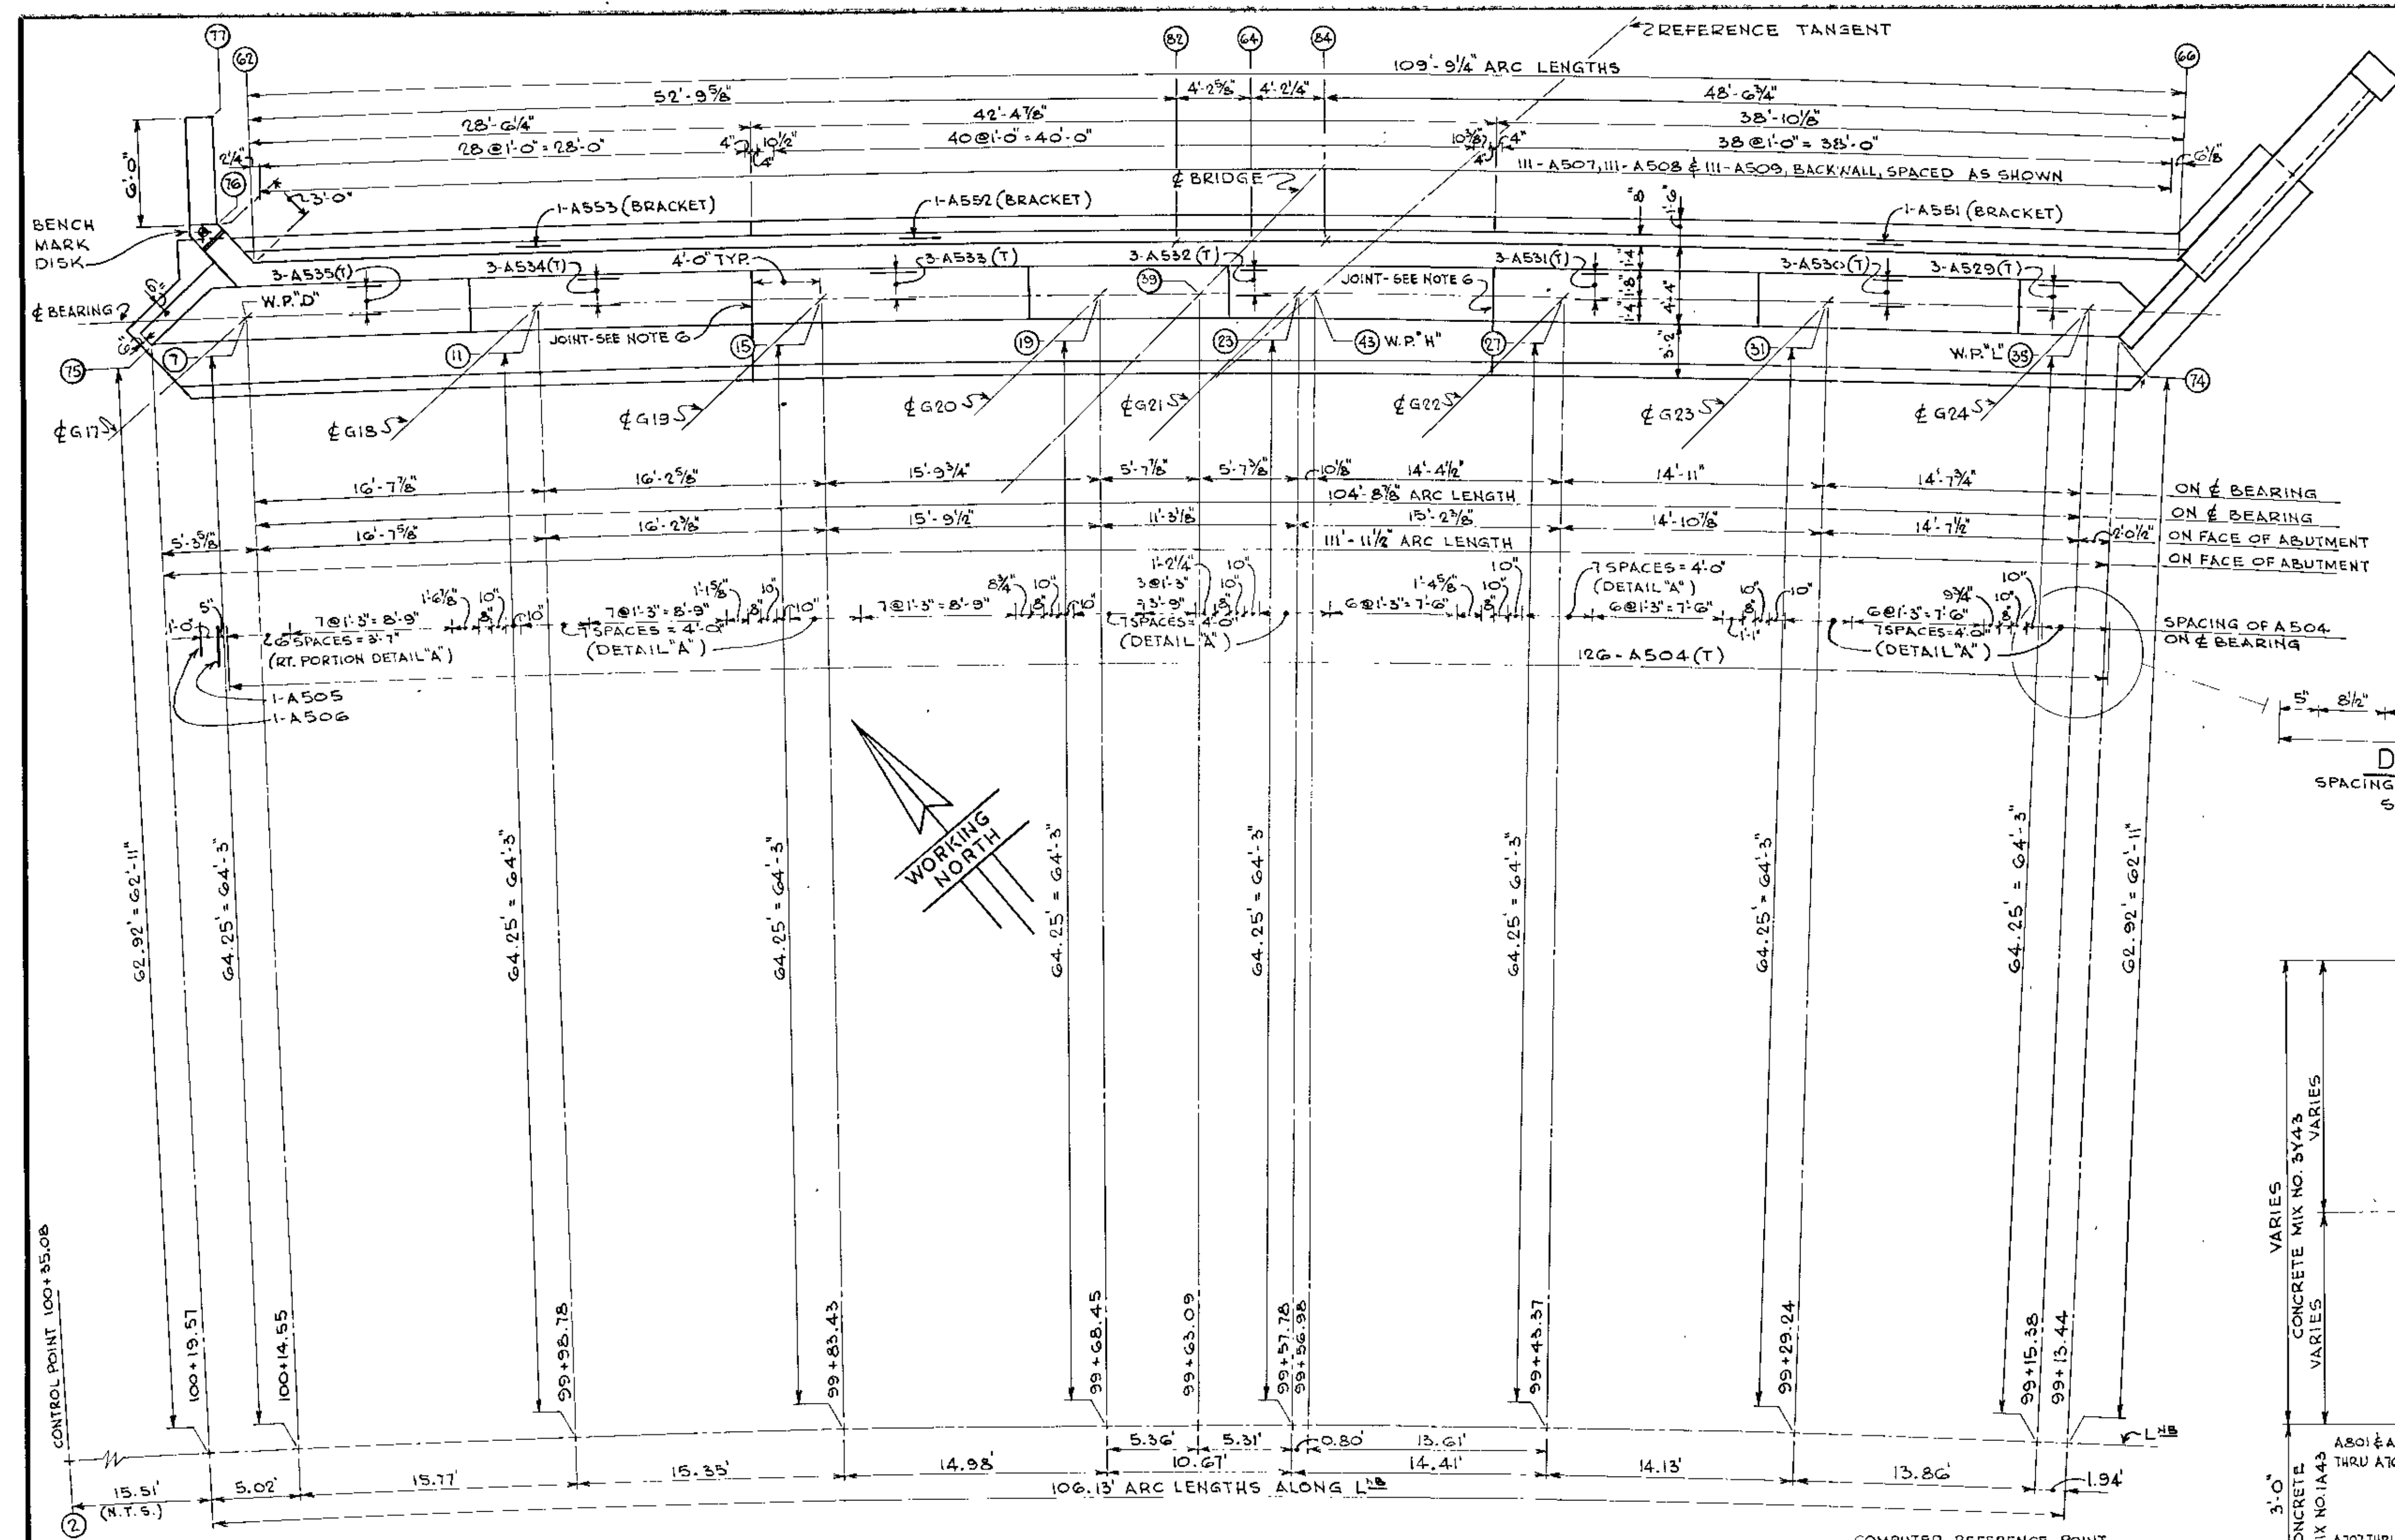


ABUTMENT PLAN AND LAYOUT
SCALE: 3/16" = 1'-0"

SUMMARY OF QUANTITIES FOR EAST ABUTMENT	
STRUCTURE EXCAVATION, CLASS E	440 CU.YD.
CONCRETE, MIX NO. 1A43	126 CU.YD.
CONCRETE, MIX NO. 3Y43	164 CU.YD.
CONCRETE, MIX NO. 3Y46A, SPECIAL	3 CU.YD.
REINFORCEMENT BARS	18,550 LBS.
TWO STEEL TEST PILES IN PLACE 140-FT. LONG	
STEEL PILING DELIVERED	1,950 LIN.FT.
STEEL PILING DRIVEN	1,920 LIN.FT.
ORNAMENTAL METAL RAILING (TYPE G)	15 LIN.FT.
BENCH MARK DISK	ONE UNIT

- QUANTITY NOTES:**
1. THIS SUMMARY INCLUDES RAILING CONCRETE, FOR THE PORTION OF RAILING ON THE SOUTHEAST WINGWALL.
 2. THE TABULATED QUANTITIES FOR STEEL PILING, DELIVERED, AND FOR STEEL PILING, DRIVEN, DO NOT INCLUDE TEST PILES.
 3. NO SPLICES IN TEST PILES OR MEASURED PILES WILL BE ELIGIBLE FOR EXTRA COMPENSATION, EXCEPT STRICTLY UNDER THE CONDITIONS OF M.H.D. 2452.5B.
 4. THE OWNER WILL FURNISH THE BENCH MARK DISK. PAYMENT FOR PLACING WILL BE INCLUDED IN PRICE BID FOR OTHER ITEMS. SEE STANDARD PLATE NO. 9301 (NOT INCLUDED IN THESE DRAWINGS) FOR PLACING.

- NOTES:**
1. WORK THIS SHEET WITH SHEETS 8 AND 9.
 2. SEE SHEET 31 FOR DETAIL OF 1 1/4" ANCHOR BOLT.
 3. BRIDGE SEAT REINFORCEMENT SHALL BE CAREFULLY PLACED TO AVOID INTERFERENCE WITH THE DRILLING OF HOLES FOR ANCHOR BOLTS.
 4. THE SUPERSTRUCTURE GIRDERS SHALL BE ERECTED IN FINAL POSITION PRIOR TO DRILLING ANCHOR BOLT HOLES AND PLACING ANCHOR BOLTS.
 5. REFER TO SHEET 28 FOR DIMENSIONS OF RAILING, DIMENSIONS OF END POST, AND DETAIL OF GUARD RAIL ANCHOR. ANCHOR IS STRUCTURAL STEEL, INCLUDED WITH SUPERSTRUCTURE QUANTITIES.
 6. EITHER, OR BOTH, OF THE TWO CONTRACTION JOINTS MAY BE A CONSTRUCTION JOINT. USE 2x4 VERTICAL KEY FULL HEIGHT FROM TOP OF FOOTING TO TOP OF BACKWALL.

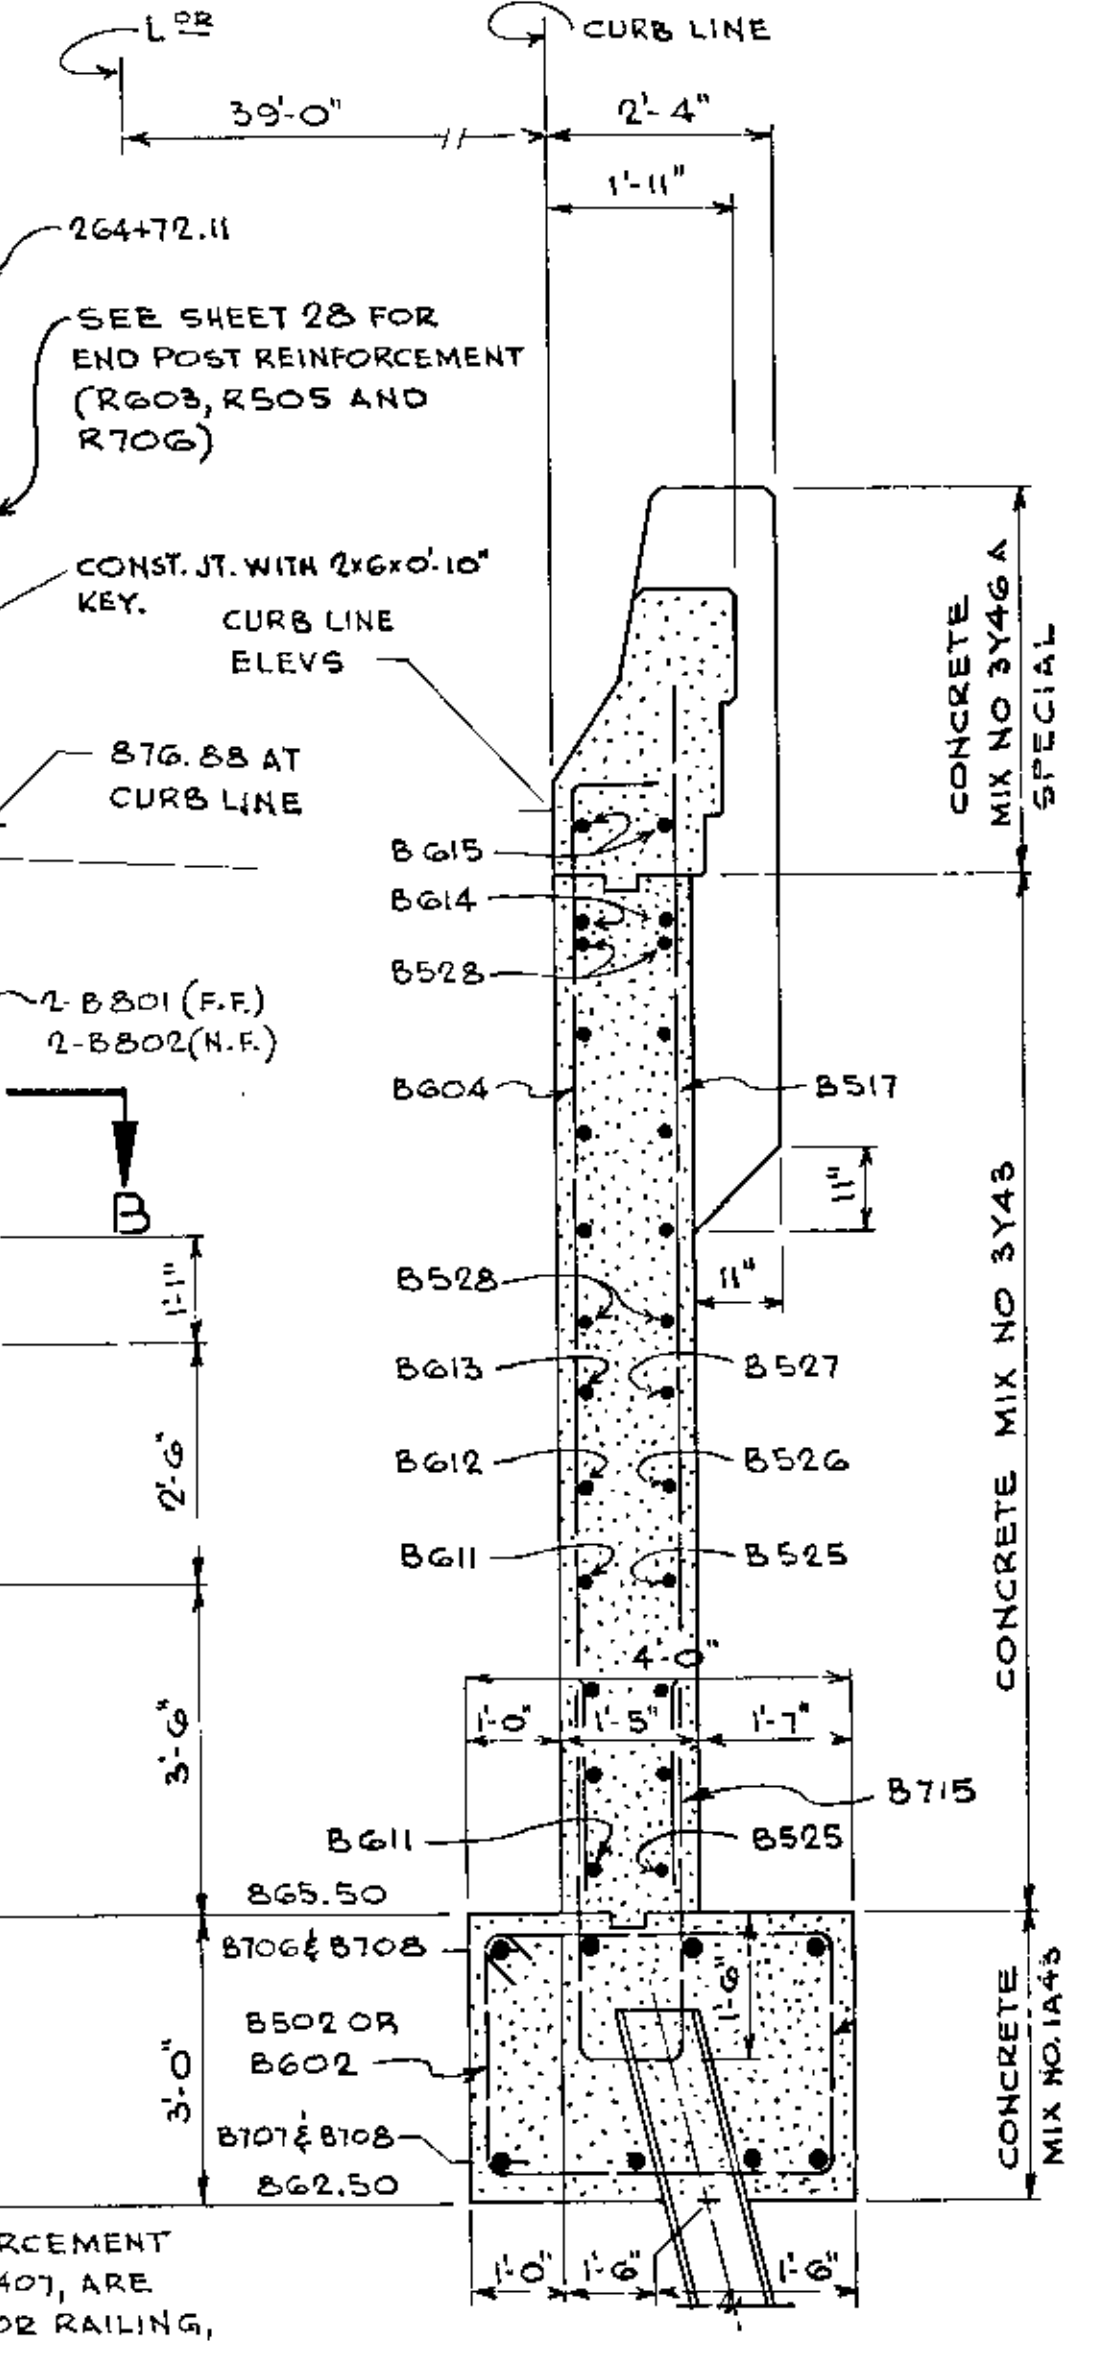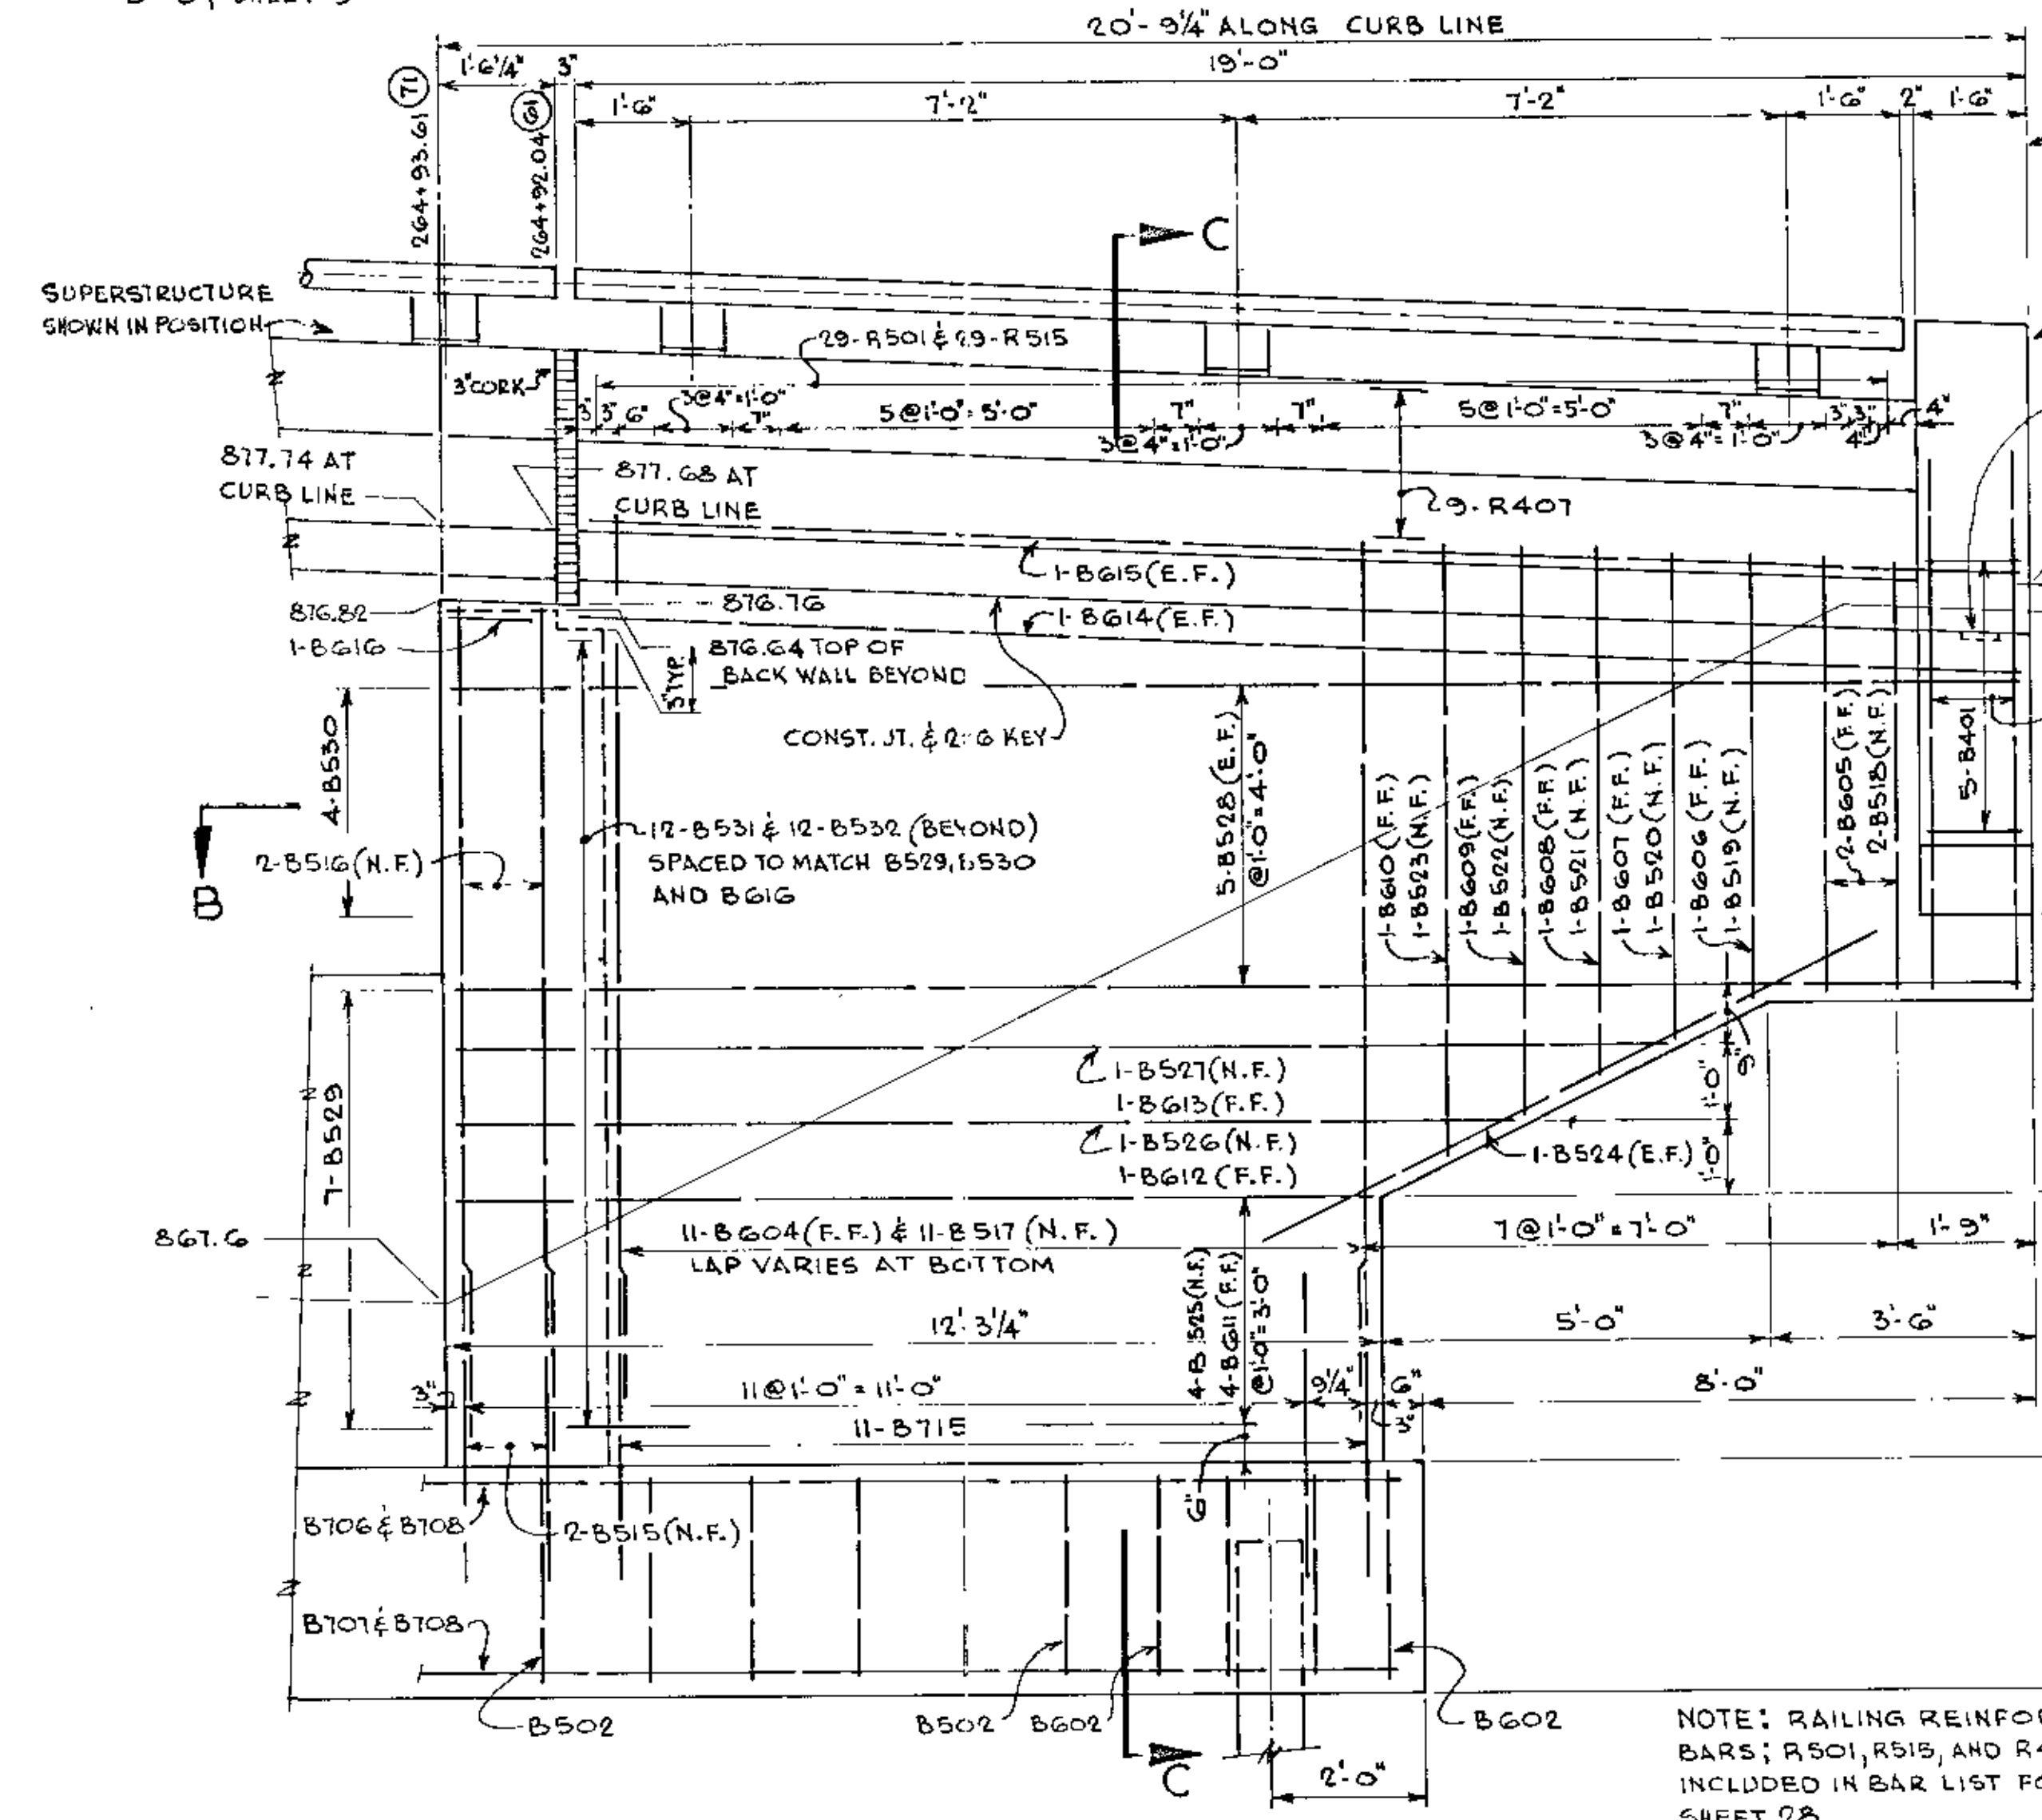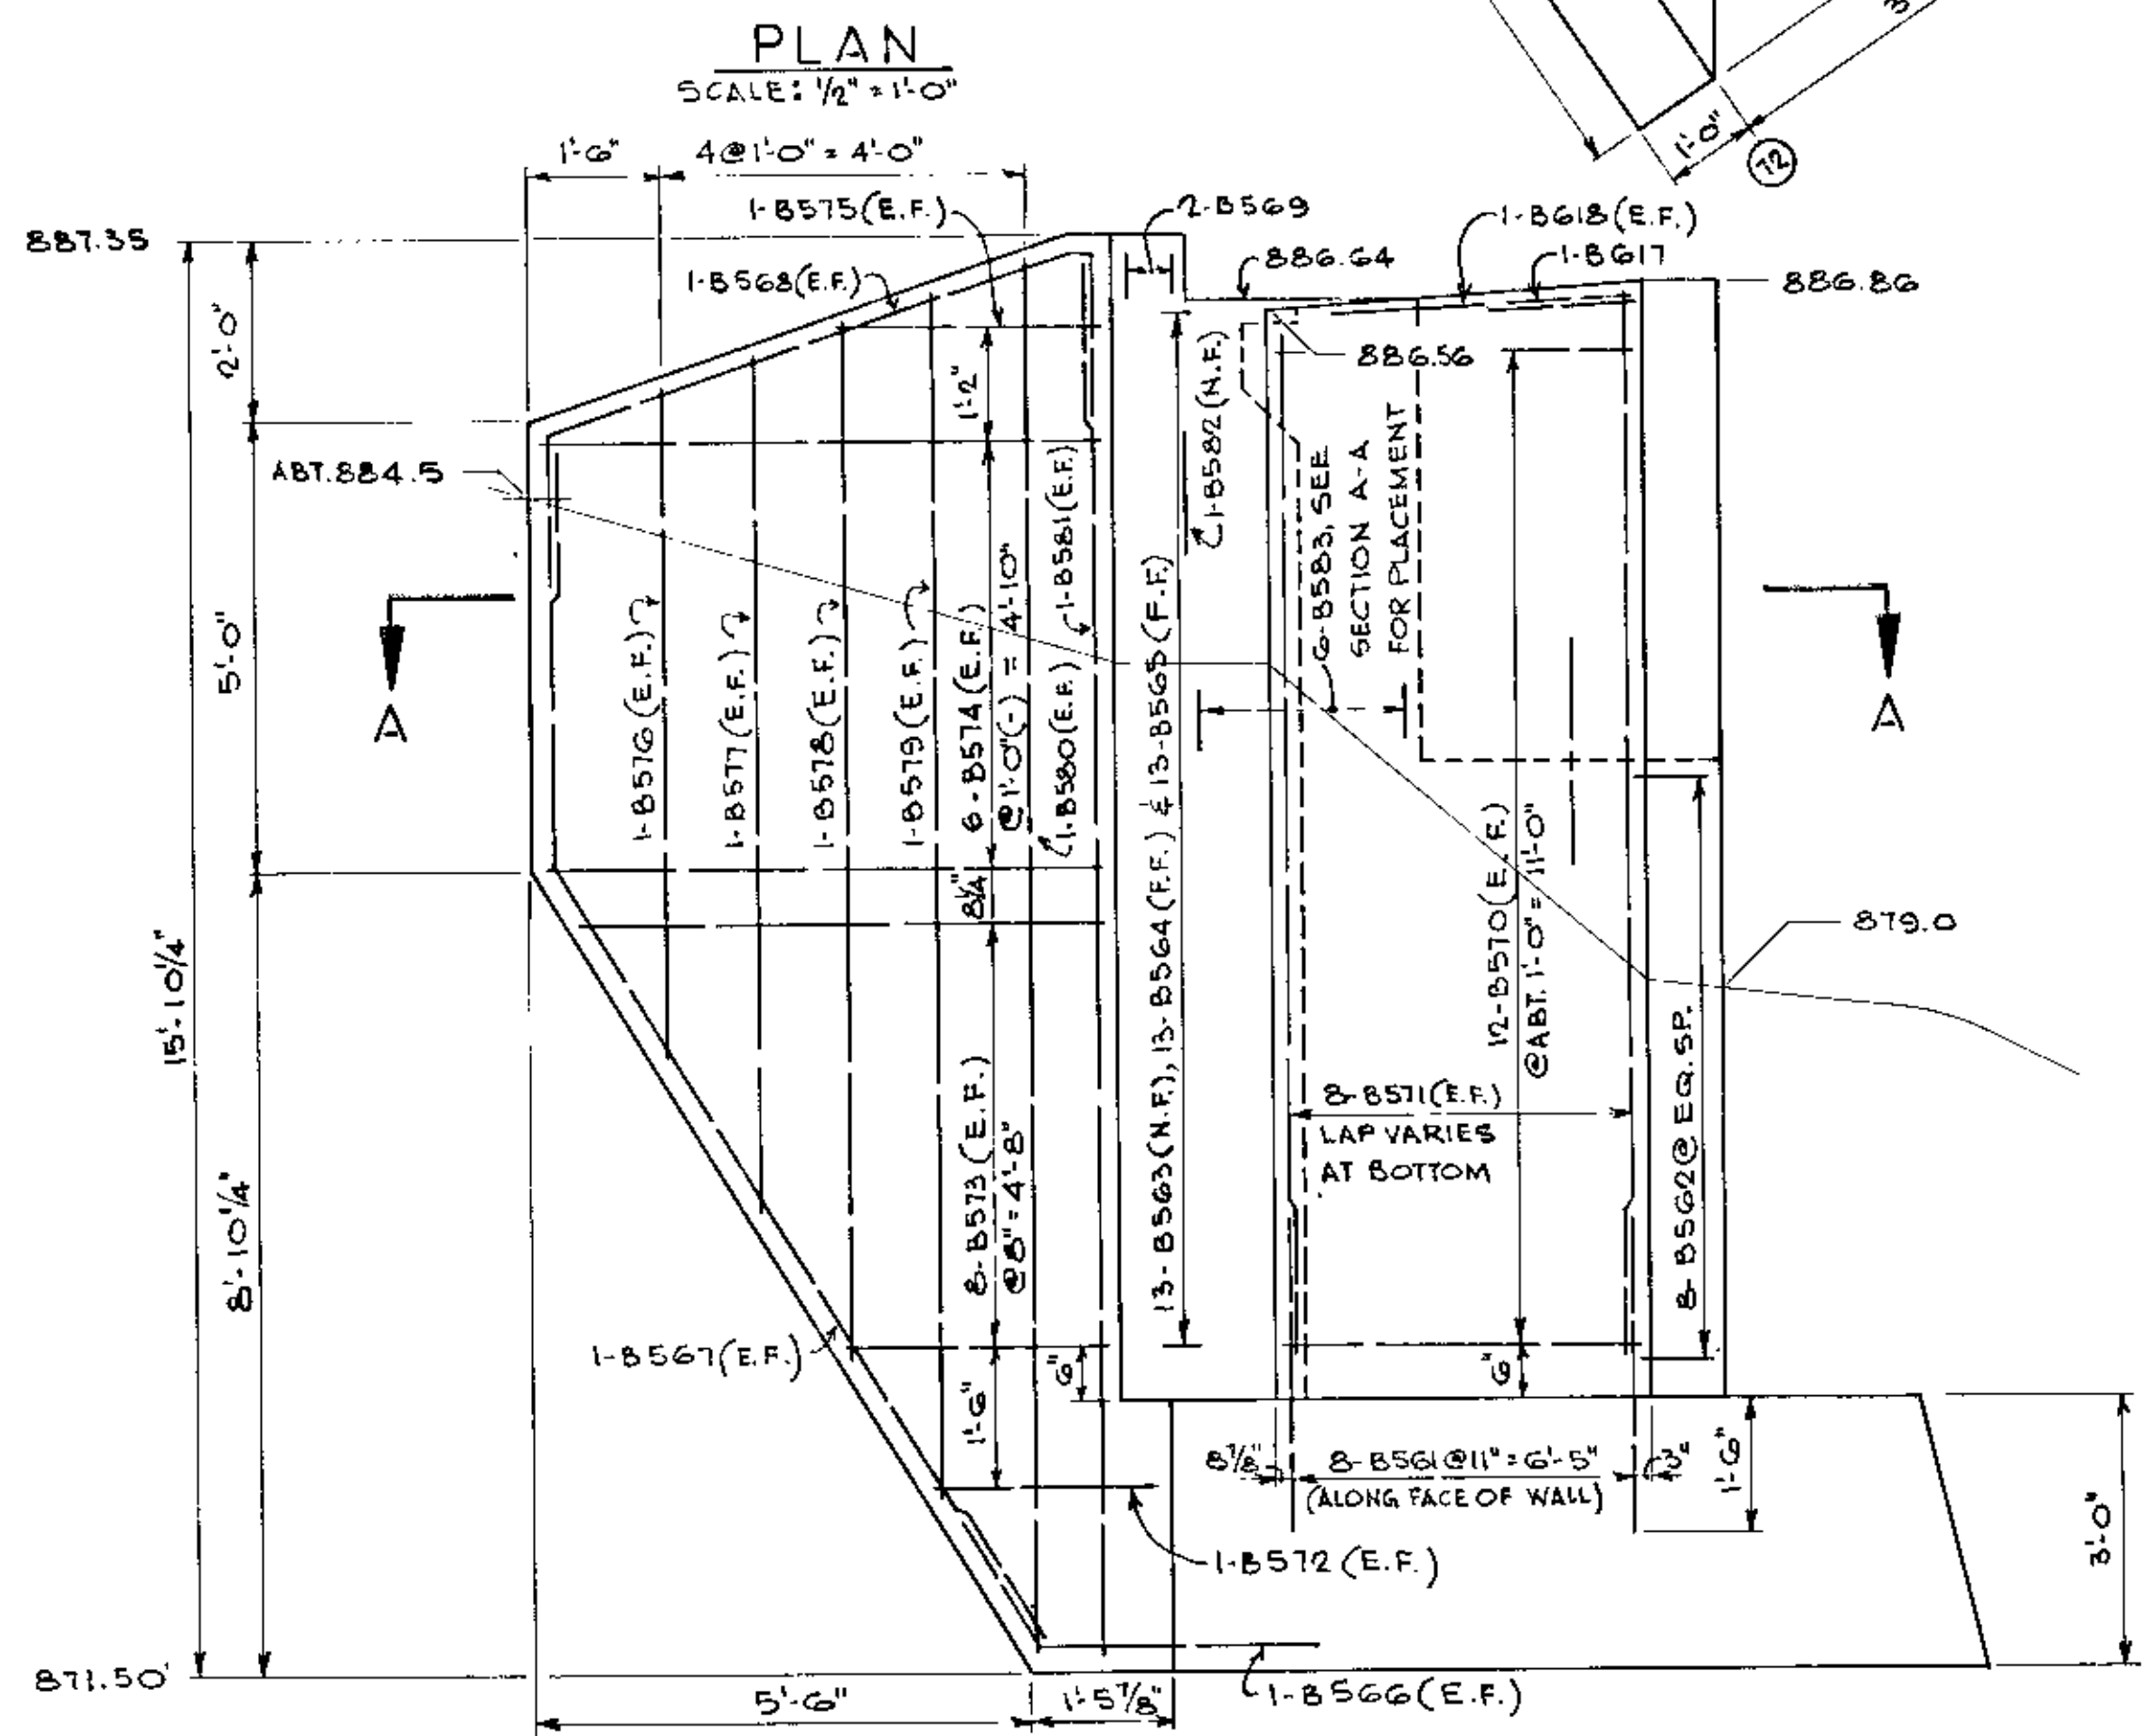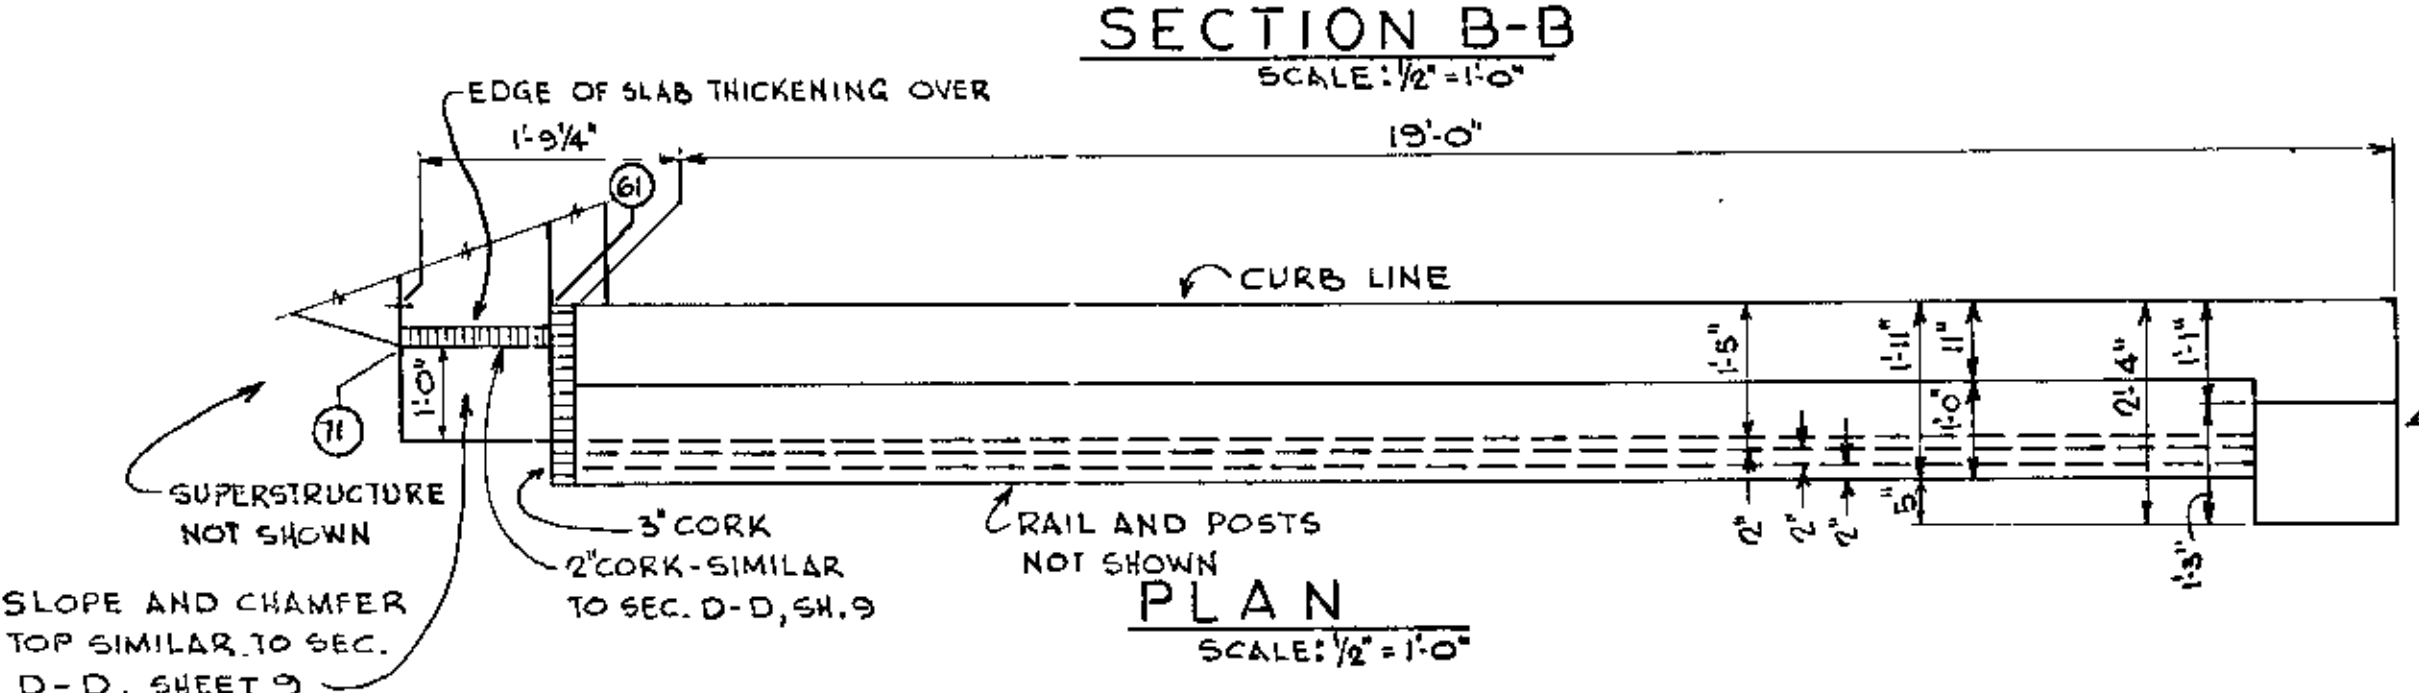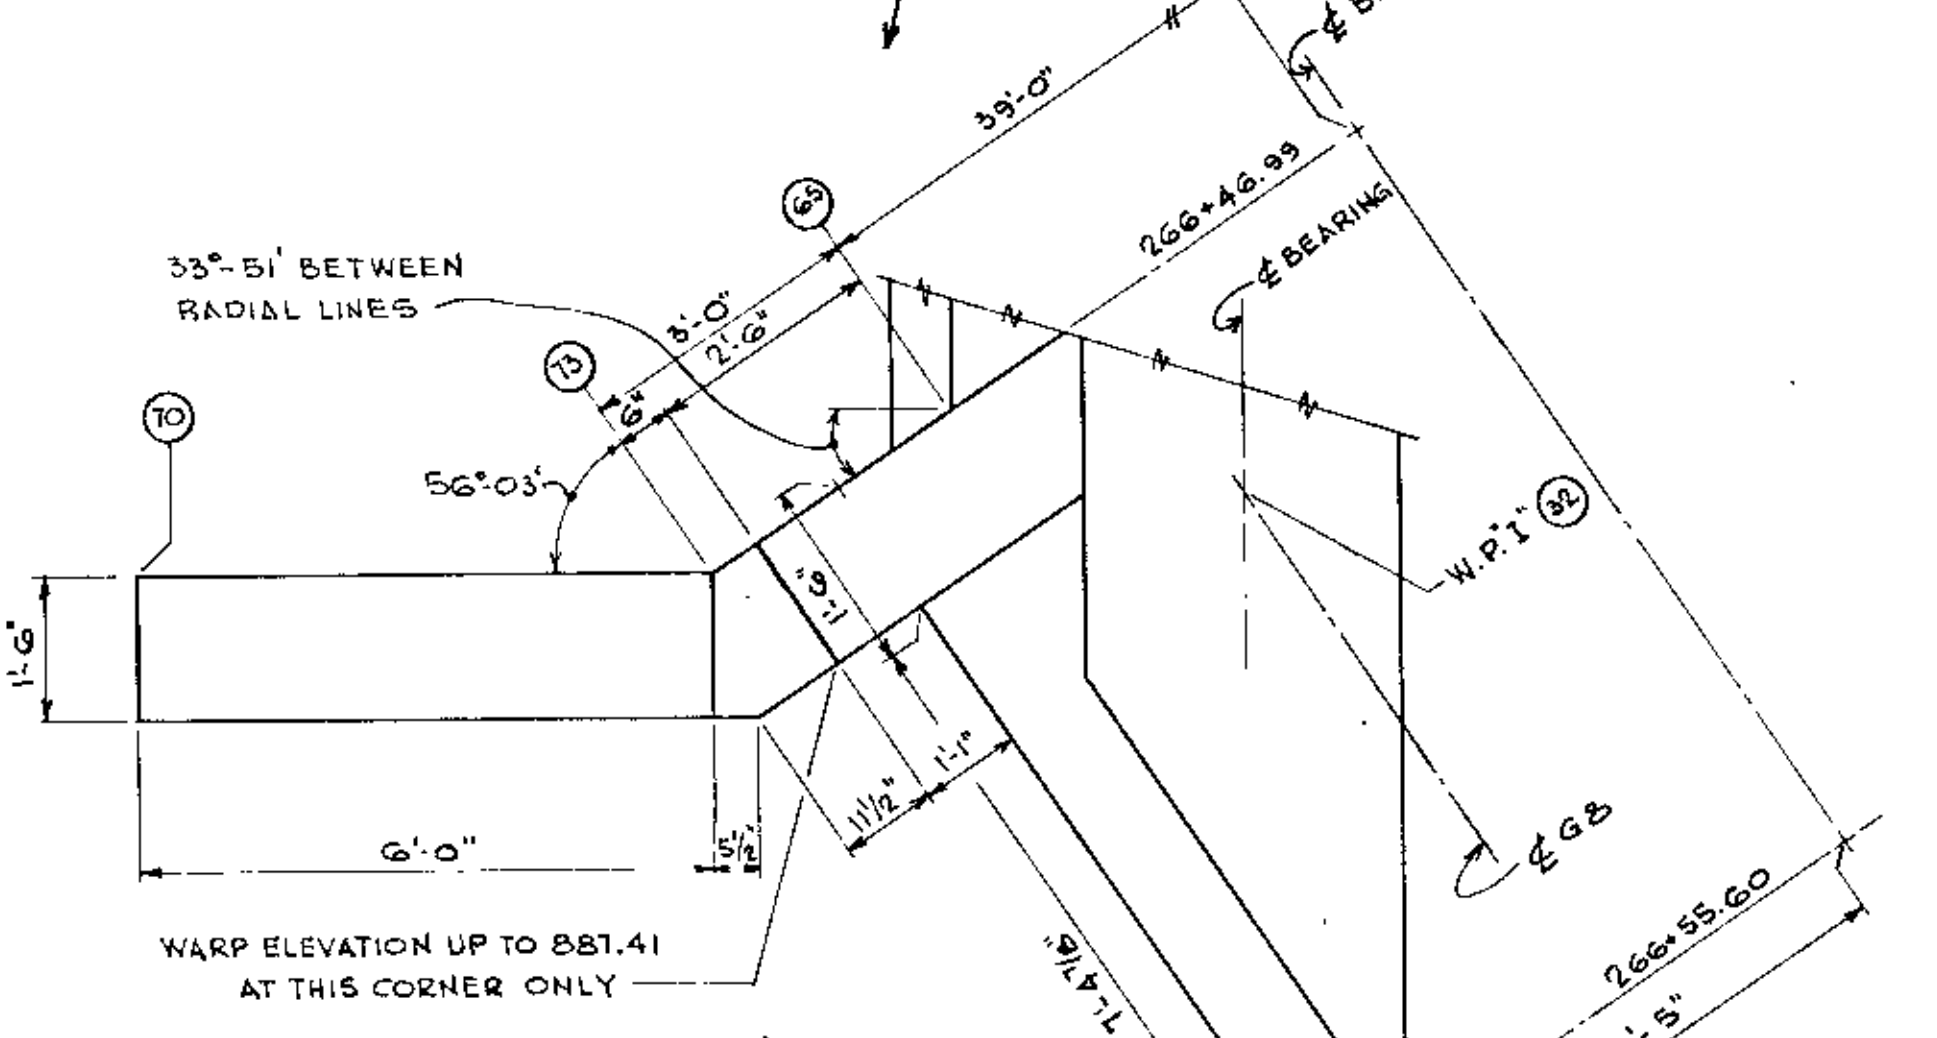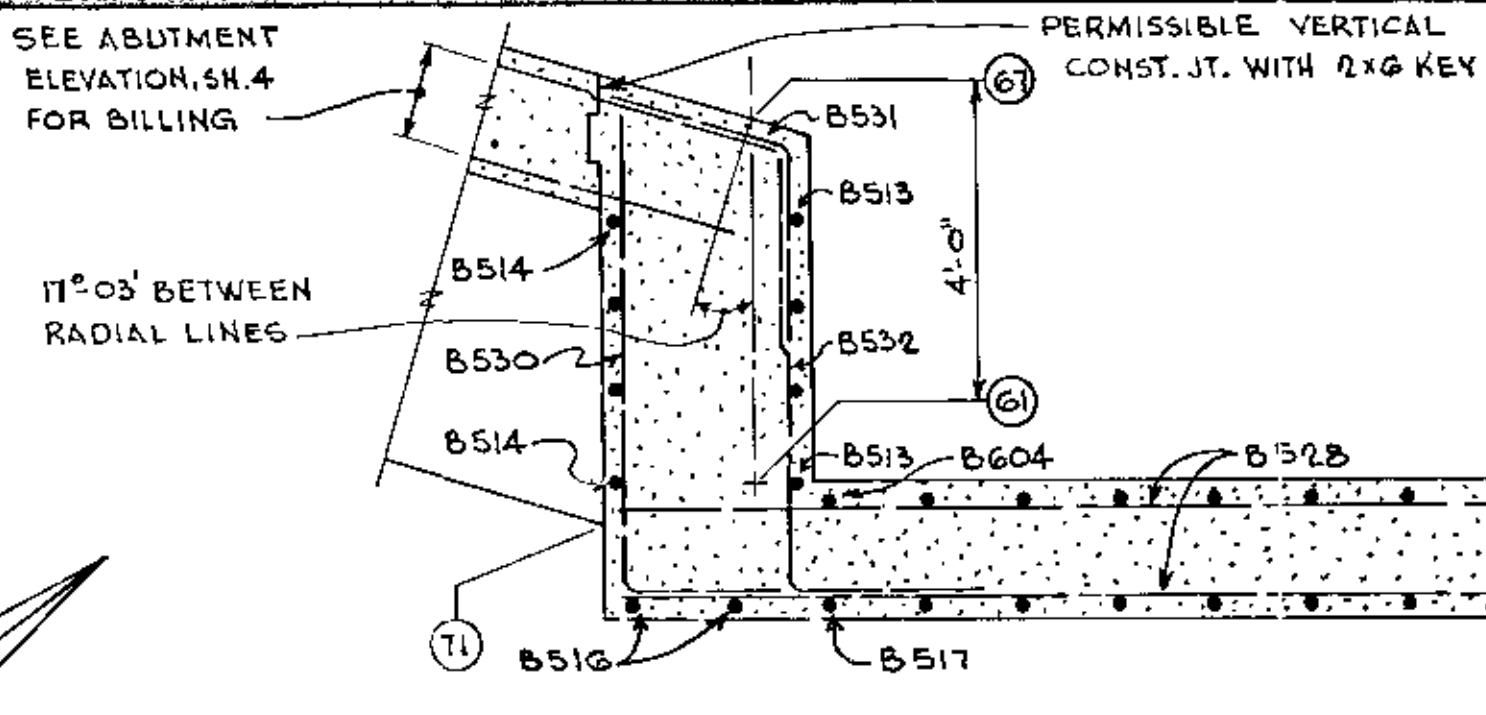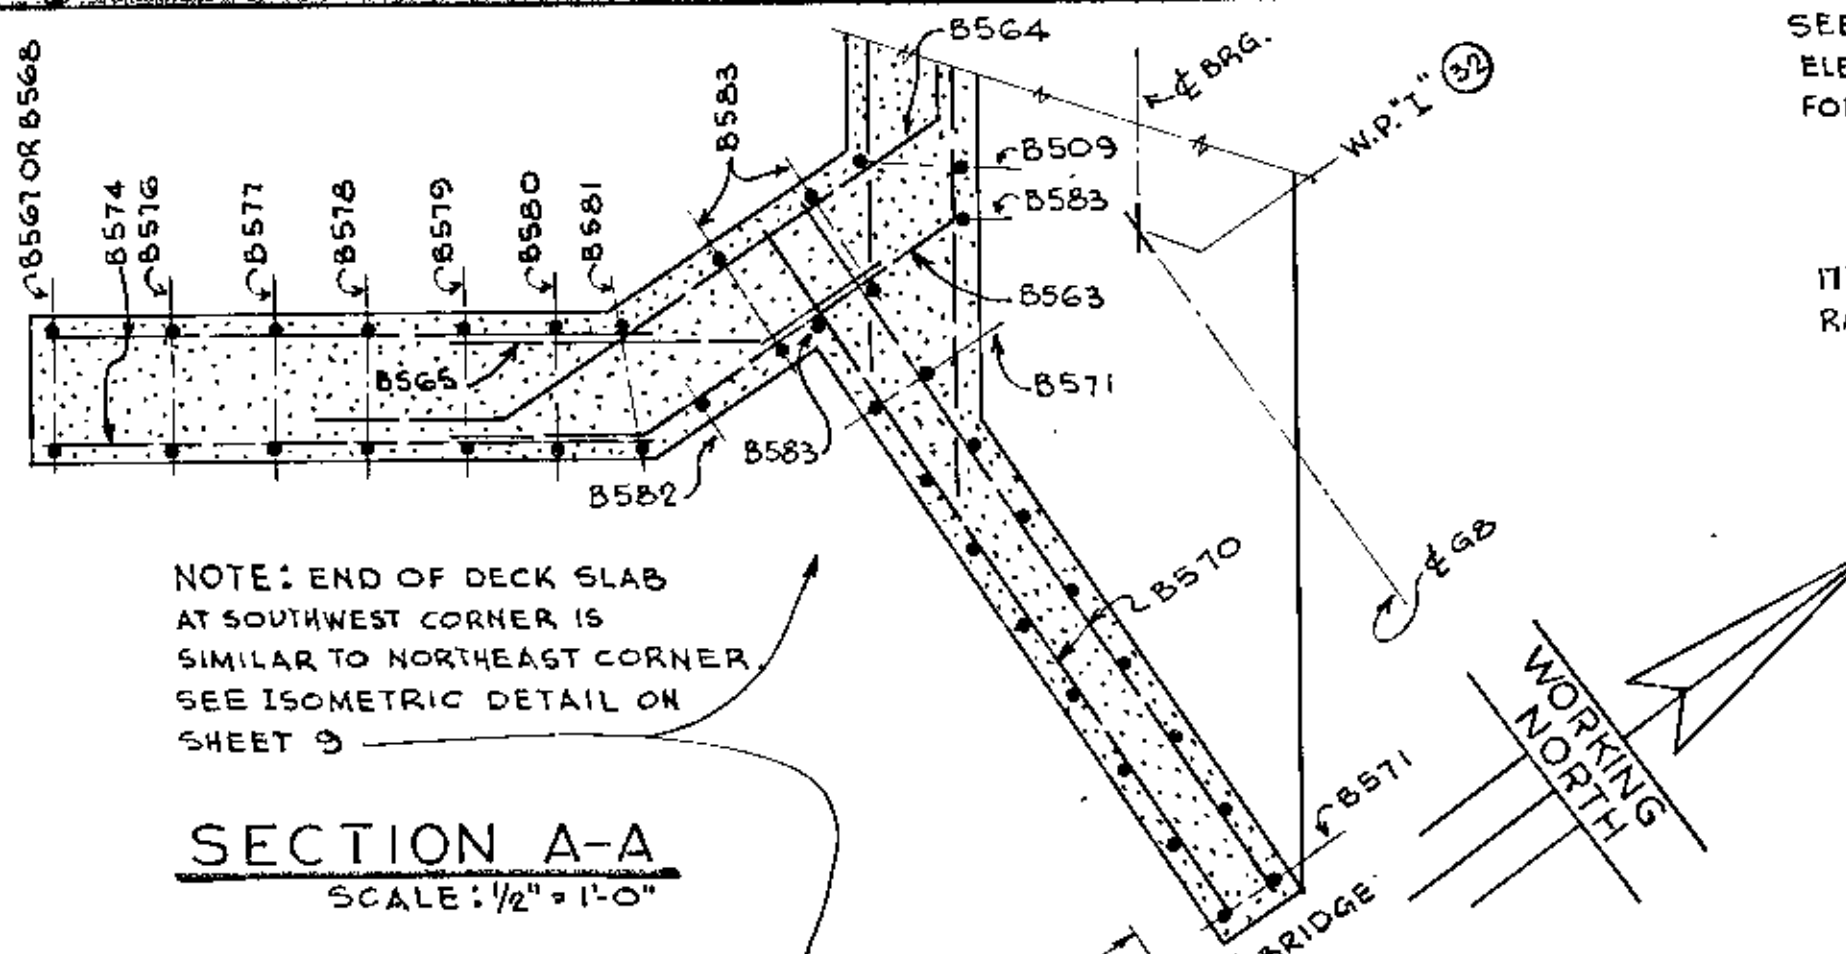

SOUTHWEST WINGWALL ELEVATION
SCALE: 1/2" = 1'-0"

NORTHWEST WINGWALL ELEVATION
SCALE: 1/2" = 1'-0"


SECTION C-C
SCALE: 1/2" = 1'-0"

AS BUILT
10-10-73
B. Jahn

TITLE: WEST ABUTMENT-DETAILS

DES. *RM* DR. W.K. APPROVED: _____
CHK. *MOPY* CHK. *RM*
Sheet No. 6 of 35 Sheets


Bridge No. 02522

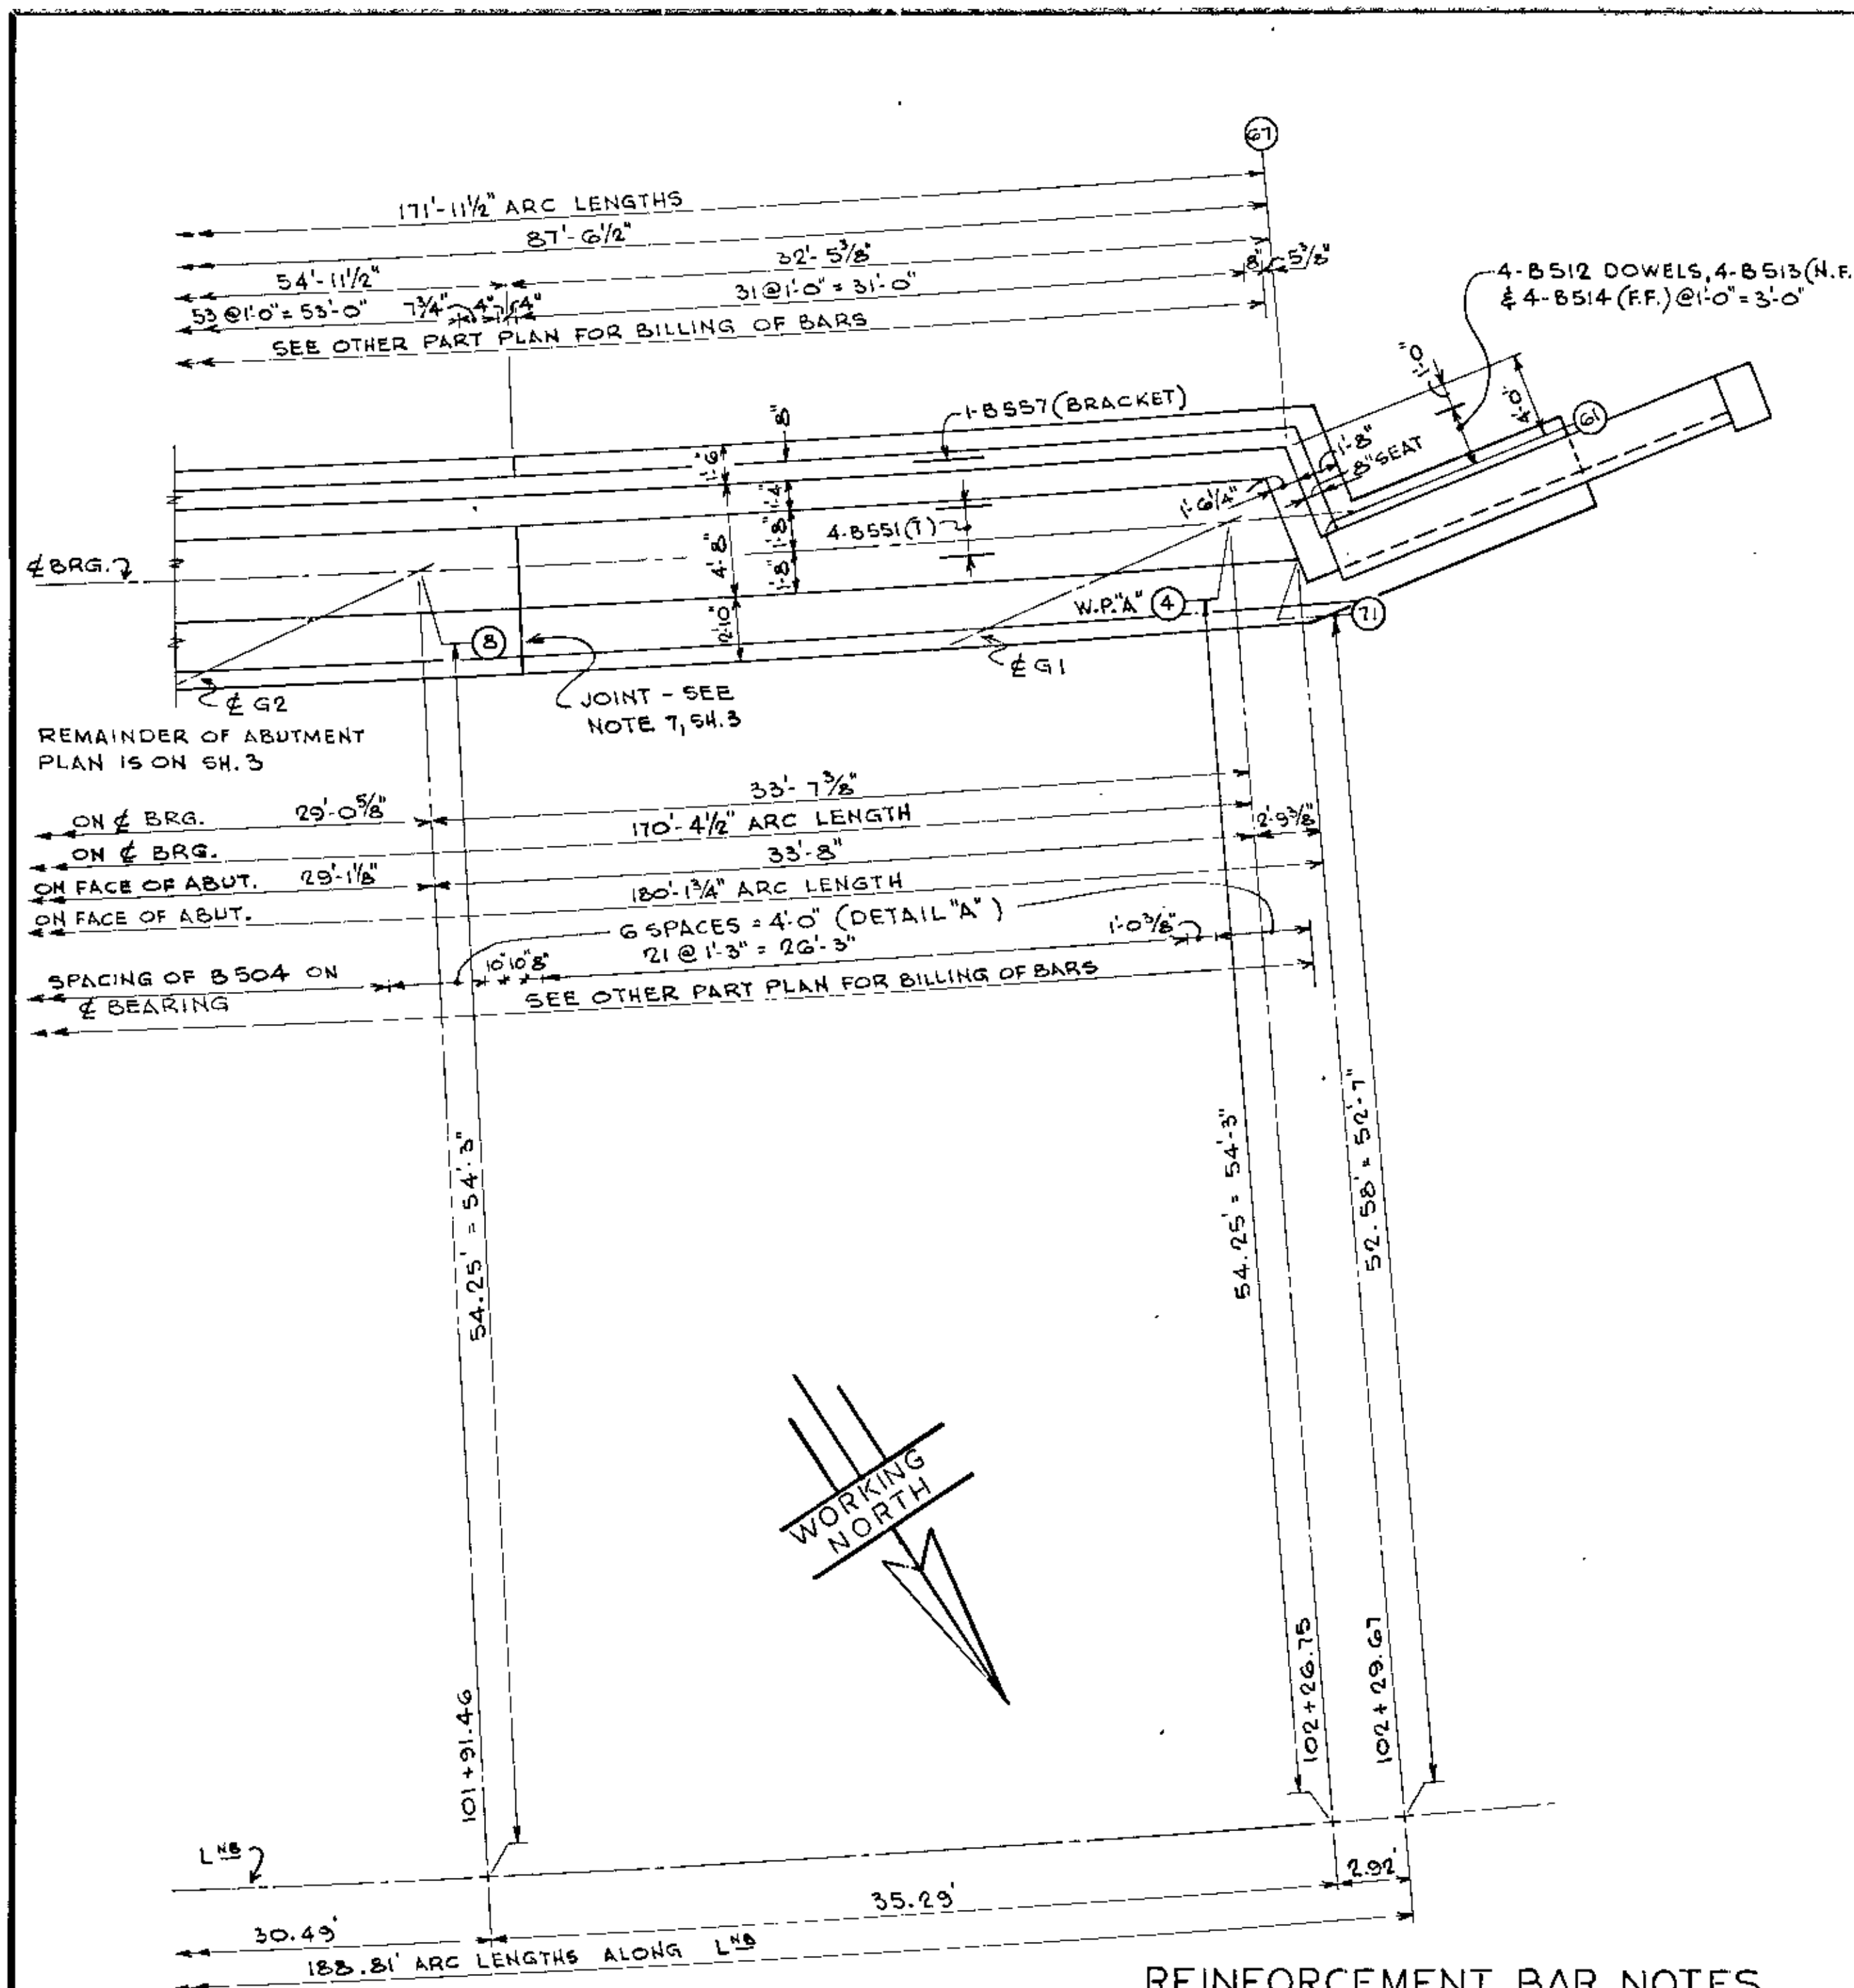

PART ABUTMENT PLAN AND LAYOUT
SCALE: 3/16" = 1'-0"

- REINFORCEMENT BAR NOTES**
- FOR B544, NUMBER IS ONE SERIES OF FOUR BARS; LENGTH VARIES FROM 8'-6" TO 12'-0" IN 1'-2" INCREMENTS.
 - FOR B573, NUMBER IS TWO SERIES OF EIGHT BARS; LENGTH VARIES FROM 2'-9" TO 5'-8" IN 5" INCREMENTS.
 - BAR LOCATION ABBREVIATIONS:
E. F. EACH FACE
N. F. NEAR FACE
F. F. FAR FACE
T. TOP
B. BOTTOM

REINFORCEMENT BAR BENDING DIAGRAMS

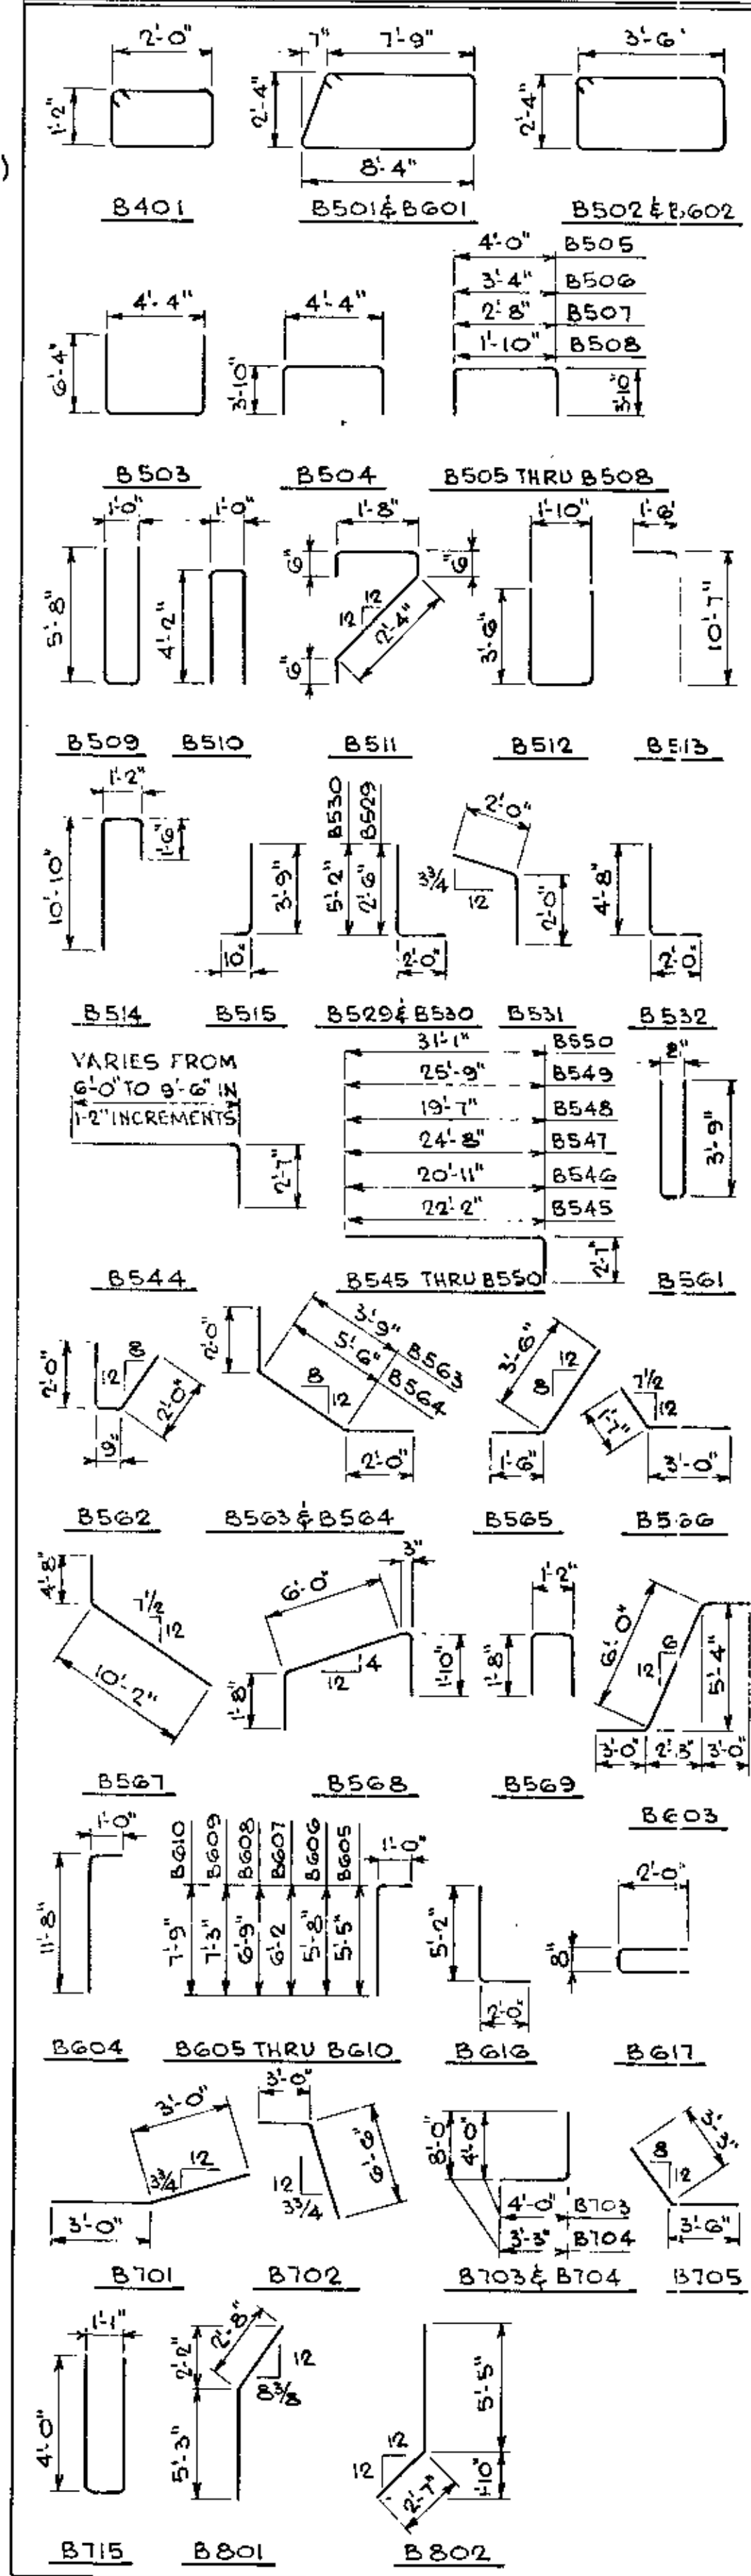






BILL OF REINFORCEMENT FOR WEST ABUTMENT


MARK	NUMBER	LENGTH	SHAPE	LOCATION	MARK	NUMBER	LENGTH	SHAPE	LOCATION
B401	5	6'-11"	[Diagram]	END POST TIES	B516	2	11'-0"	[Diagram]	WINGWALL VERT.
B501	114	21'-7"	[Diagram]	FOOTING, TRANS.	B517	11	15'-0"	[Diagram]	WINGWALL VERT.
B502	6	12'-5"	[Diagram]	WING FTG. TRANS.	B518	2	6'-9"	[Diagram]	WINGWALL VERT.
B503	138	10'-10"	[Diagram]	ABUT. VERT.	B519	1	7'-0"	[Diagram]	WINGWALL VERT.
B504	170	11'-10"	[Diagram]	SEAT TRANS.	B520	1	7'-6"	[Diagram]	WINGWALL VERT.
B505	1	11'-6"	[Diagram]	SEAT TRANS.	B521	1	8'-1"	[Diagram]	WINGWALL VERT.
B506	1	10'-10"	[Diagram]	SEAT TRANS.	B522	1	8'-7"	[Diagram]	WINGWALL VERT.
B507	1	10'-2"	[Diagram]	SEAT TRANS.	B523	1	9'-1"	[Diagram]	WINGWALL VERT.
B508	1	9'-4"	[Diagram]	SEAT TRANS.	B524	2	9'-0"	[Diagram]	WINGWALL FILLET
B509	175	12'-2"	[Diagram]	BACKWALL VERT.	B525	4	11'-10"	[Diagram]	WINGWALL HORIZ.
B510	175	9'-2"	[Diagram]	TOP BACKWALL	B526	1	15'-10"	[Diagram]	WINGWALL HOR. Z.
B511	175	5'-3"	[Diagram]	BRACKET	B527	1	15'-10"	[Diagram]	WINGWALL HOR. Z.
B512	4	8'-8"	[Diagram]	DOWEL	B528	10	20'-4"	[Diagram]	WINGWALL HOR. Z.
B513	4	12'-0"	[Diagram]	BACKWALL VERT.	B533	4	34'-0"	[Diagram]	ABUT. HORIZ.
B514	4	13'-4"	[Diagram]	BACKWALL VERT.	B534	4	32'-1"	[Diagram]	ABUT. HORIZ.
B515	2	4'-6"	[Diagram]	WINGWALL DOWEL	B535	2	25'-9"	[Diagram]	ABUT. HORIZ.
B529	7	4'-5"	[Diagram]	WINGWALL CORNER	B536	16	28'-5"	[Diagram]	ABUT. HORIZ.
B530	4	7'-1"	[Diagram]	WINGWALL CORNER	B537	2	20'-11"	[Diagram]	ABUT. HORIZ.
B531	12	4'-0"	[Diagram]	WINGWALL CORNER	B538	2	43'-8"	[Diagram]	ABUT. HORIZ.
B532	12	6'-7"	[Diagram]	WINGWALL CORNER	B539	16	31'-7"	[Diagram]	ABUT. HORIZ.
B544	(NOTE 1)	(NOTE 1)	[Diagram]	TOP OF SEAT	B540	1	10'-4"	[Diagram]	ABUT. HORIZ.
B545	4	24'-8"	[Diagram]	TOP OF SEAT	B541	1	5'-0"	[Diagram]	ABUT. HORIZ.
B546	4	23'-5"	[Diagram]	TOP OF SEAT	B542	4	30'-6"	[Diagram]	ABUT. HORIZ.
B547	4	21'-2"	[Diagram]	TOP OF SEAT	B543	4	25'-2"	[Diagram]	ABUT. HORIZ.
B548	4	22'-1"	[Diagram]	TOP OF SEAT	B551	4	33'-0"	[Diagram]	TOP OF SEAT
B549	4	28'-3"	[Diagram]	TOP OF SEAT	B552	8	32'-9"	[Diagram]	BACKWALL HORIZ.
B550	4	33'-7"	[Diagram]	TOP OF SEAT	B553	16	28'-2"	[Diagram]	BACKWALL HORIZ.
B561	8	8'-0"	[Diagram]	WINGWALL DOWEL	B554	16	31'-6"	[Diagram]	BACKWALL HORIZ.
B562	8	4'-7"	[Diagram]	CORNER OF WING	B555	4	26'-8"	[Diagram]	BACKWALL HORIZ.
B563	13	7'-8"	[Diagram]	CORNER OF WING	B556	4	25'-0"	[Diagram]	BACKWALL HORIZ.
B564	13	9'-5"	[Diagram]	CORNER OF WING	B557	1	32'-7"	[Diagram]	BRACKET
B565	13	5'-0"	[Diagram]	CORNER OF WING	B558	2	28'-1"	[Diagram]	BRACKET
B566	2	4'-7"	[Diagram]	WING DOWEL	B559	2	31'-3"	[Diagram]	BRACKET
B567	2	14'-10"	[Diagram]	WING EDGE	B560	1	24'-6"	[Diagram]	BRACKET
B568	2	9'-7"	[Diagram]	WING EDGE	B570	24	8'-6"	[Diagram]	WING, HORIZ.
B569	2	4'-4"	[Diagram]	TOP OF WING	B571	16	11'-10"	[Diagram]	WING, VERT.
B601	40	21'-6"	[Diagram]	FOOTING, TRANS.	B572	2	0'-6"	[Diagram]	WING, HORIZ.
B602	4	12'-4"	[Diagram]	WING FTG. TRANS.	B573	(NOTE 2)	(NOTE 2)	[Diagram]	WING, HORIZ.
B603	36	12'-0"	[Diagram]	FOOTING STEPS	B574	12	6'-1"	[Diagram]	WING, HORIZ.
B604	11	12'-6"	[Diagram]	WINGWALL VERT.	B575	2	3'-1"	[Diagram]	WING, HORIZ.
B605	2	6'-3"	[Diagram]	WINGWALL VERT.	B576	2	7'-5"	[Diagram]	WING, VERT.
B606	1	6'-6"	[Diagram]	WINGWALL VERT.	B577	2	9'-4"	[Diagram]	WING, VERT.
B607	1	7'-0"	[Diagram]	WINGWALL VERT.	B578	2	11'-3"	[Diagram]	WING, VERT.
B608	1	7'-7"	[Diagram]	WINGWALL VERT.	B579	2	13'-3"	[Diagram]	WING, VERT.
B609	1	8'-1"	[Diagram]	WINGWALL VERT.	B580	2	15'-2"	[Diagram]	WING, VERT.
B610	1	8'-7"	[Diagram]	WINGWALL VERT.	B581	2	15'-4"	[Diagram]	WING, VERT.
B616	1	7'-0"	[Diagram]	WINGWALL CORNER	B582	1	12'-6"	[Diagram]	WING, VERT.
B617	1	4'-6"	[Diagram]	TOP WINGWALL	B583	6	11'-11"	[Diagram]	WING, VERT.
B701	2	6'-0"	[Diagram]	FOOTING CORNER	B611	4	11'-10"	[Diagram]	WINGWALL HORIZ.
B702	2	9'-6"	[Diagram]	FOOTING CORNER	B612	1	13'-10"	[Diagram]	WINGWALL HORIZ.
B703	2	7'-10"	[Diagram]	FOOTING CORNER	B613	1	15'-10"	[Diagram]	WINGWALL HORIZ.
B704	2	11'-1"	[Diagram]	FOOTING CORNER	B614	2	20'-4"	[Diagram]	WINGWALL HORIZ.
B705	2	6'-9"	[Diagram]	FOOTING CORNER	B615	2	18'-8"	[Diagram]	WINGWALL HORIZ.
B715	11	8'-9"	[Diagram]	WINGWALL DOWEL	B618	2	8'-6"	[Diagram]	WINGWALL HOR. Z.
B801	2	7'-11"	[Diagram]	END POST DOWEL	B706	1	11'-4"	[Diagram]	WING FOOTING
B802	2	8'-0"	[Diagram]	END POST DOWEL	B707	1	13'-9"	[Diagram]	WING FOOTING
B803	2	8'-0"	[Diagram]	END POST DOWEL	B708	6	15'-6"	[Diagram]	WING FOOTING
B804	2	8'-0"	[Diagram]	END POST DOWEL	B709	14	30'-0"	[Diagram]	FOOTING LONG
B805	2	8'-0"	[Diagram]	END POST DOWEL	B710	14	13'-1"	[Diagram]	FOOTING LONG
B806	2	8'-0"	[Diagram]	END POST DOWEL	B711	28	31'-7"	[Diagram]	FOOTING LONG
B807	2	8'-0"	[Diagram]	END POST DOWEL	B712	28	34'-10"	[Diagram]	FOOTING LONG
B808	2	8'-0"	[Diagram]	END POST DOWEL	B713	14	20'-0"	[Diagram]	FOOTING LONG
B809	2	8'-0"	[Diagram]	END POST DOWEL	B714	1	14'-2"	[Diagram]	FTG. LONG. BOT.
B810	2	8'-0"	[Diagram]	END POST DOWEL	B901	7	14'-10"	[Diagram]	FTG. LONG. TOP

AS BUILT
10-16-73
B. J. J.

TITLE: WEST ABUTMENT PART PLAN AND DETAILS

DES: R. M. J. DR. W. K. APPROVED: [Signature]
CHK: M. D. Y. CHK: [Signature]
Sheet No. 5 of 35 Sheets Bridge No. 02522

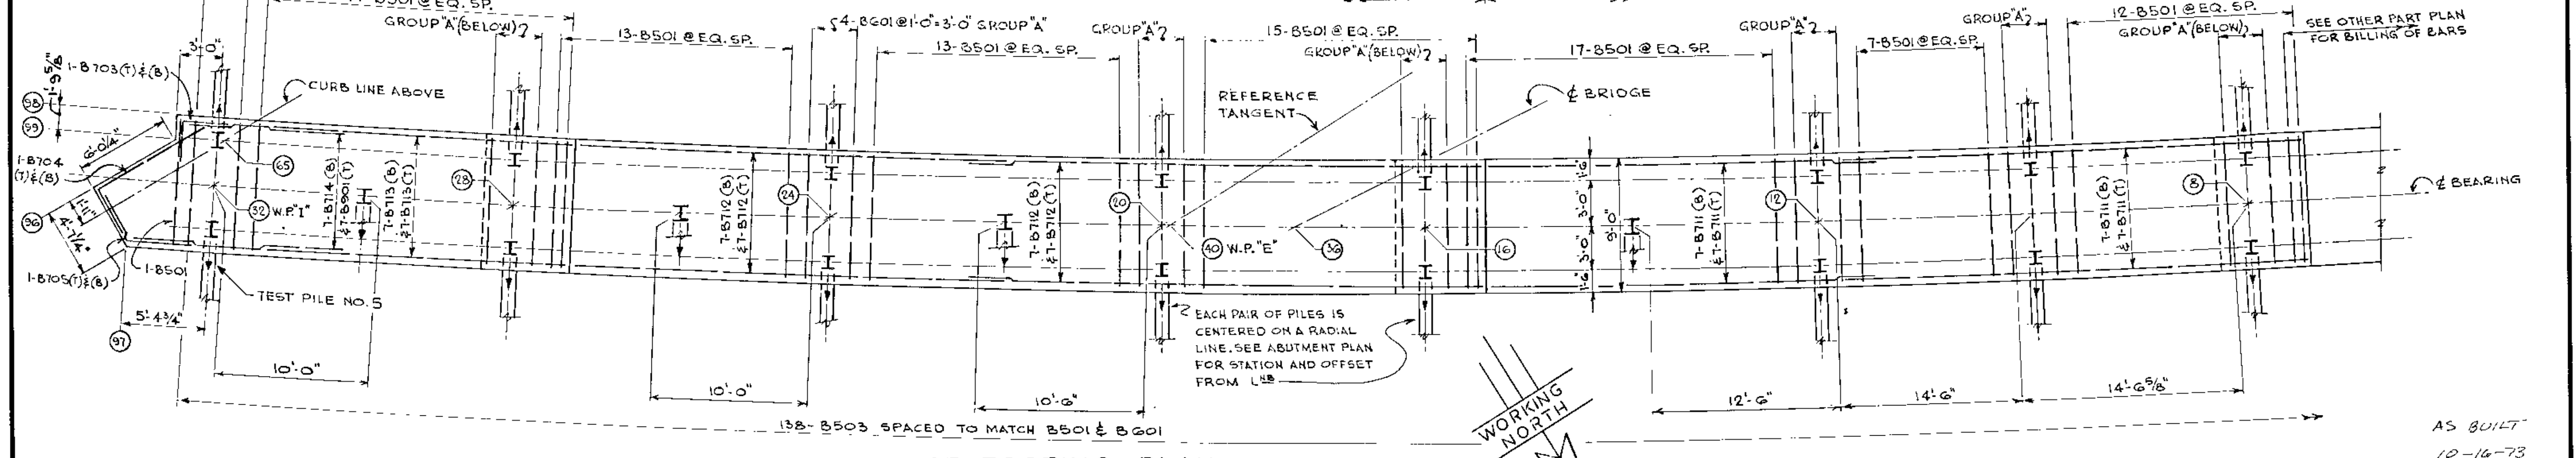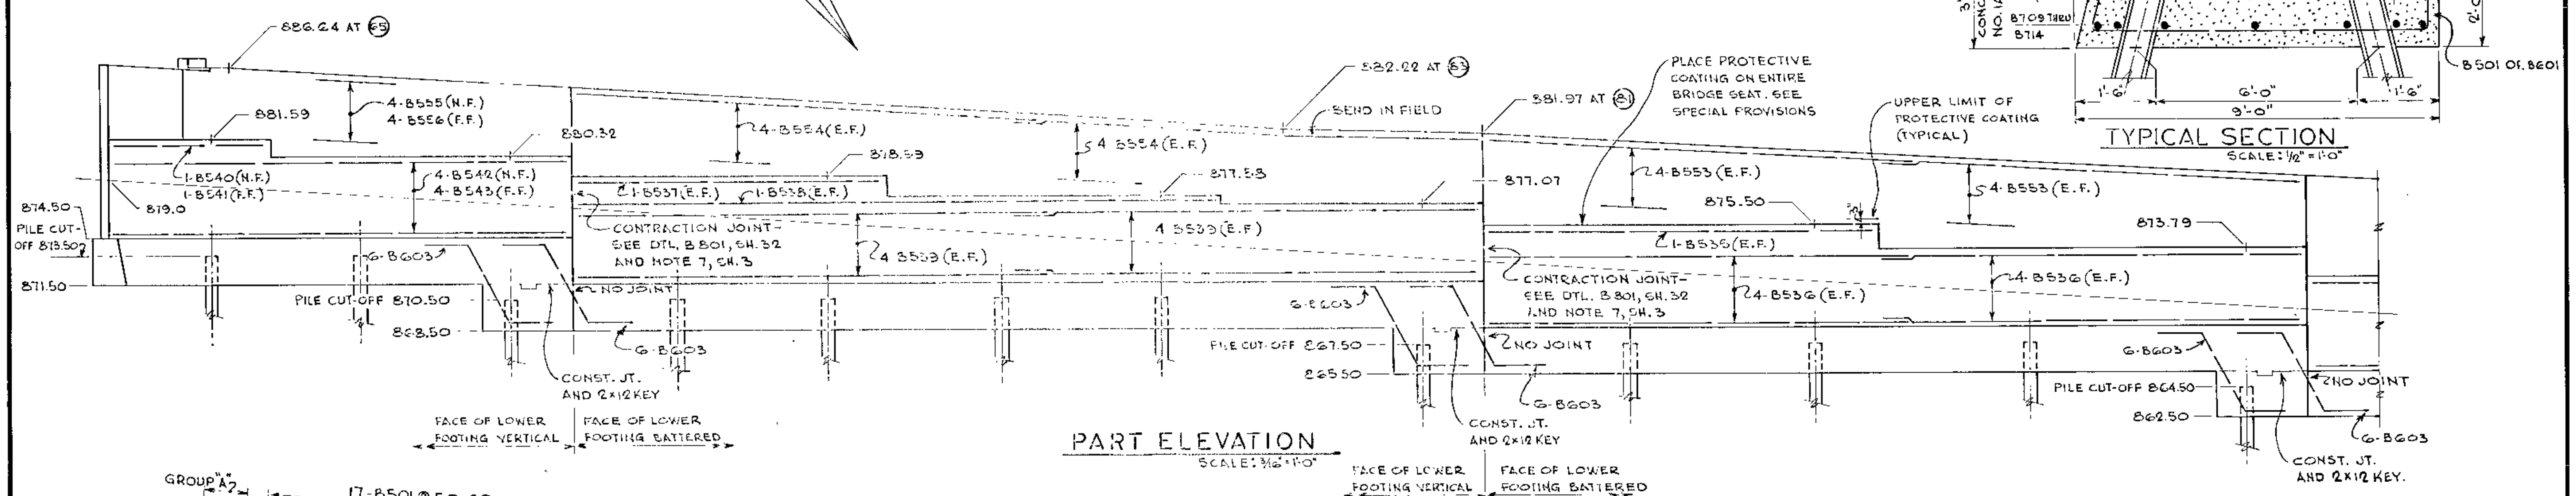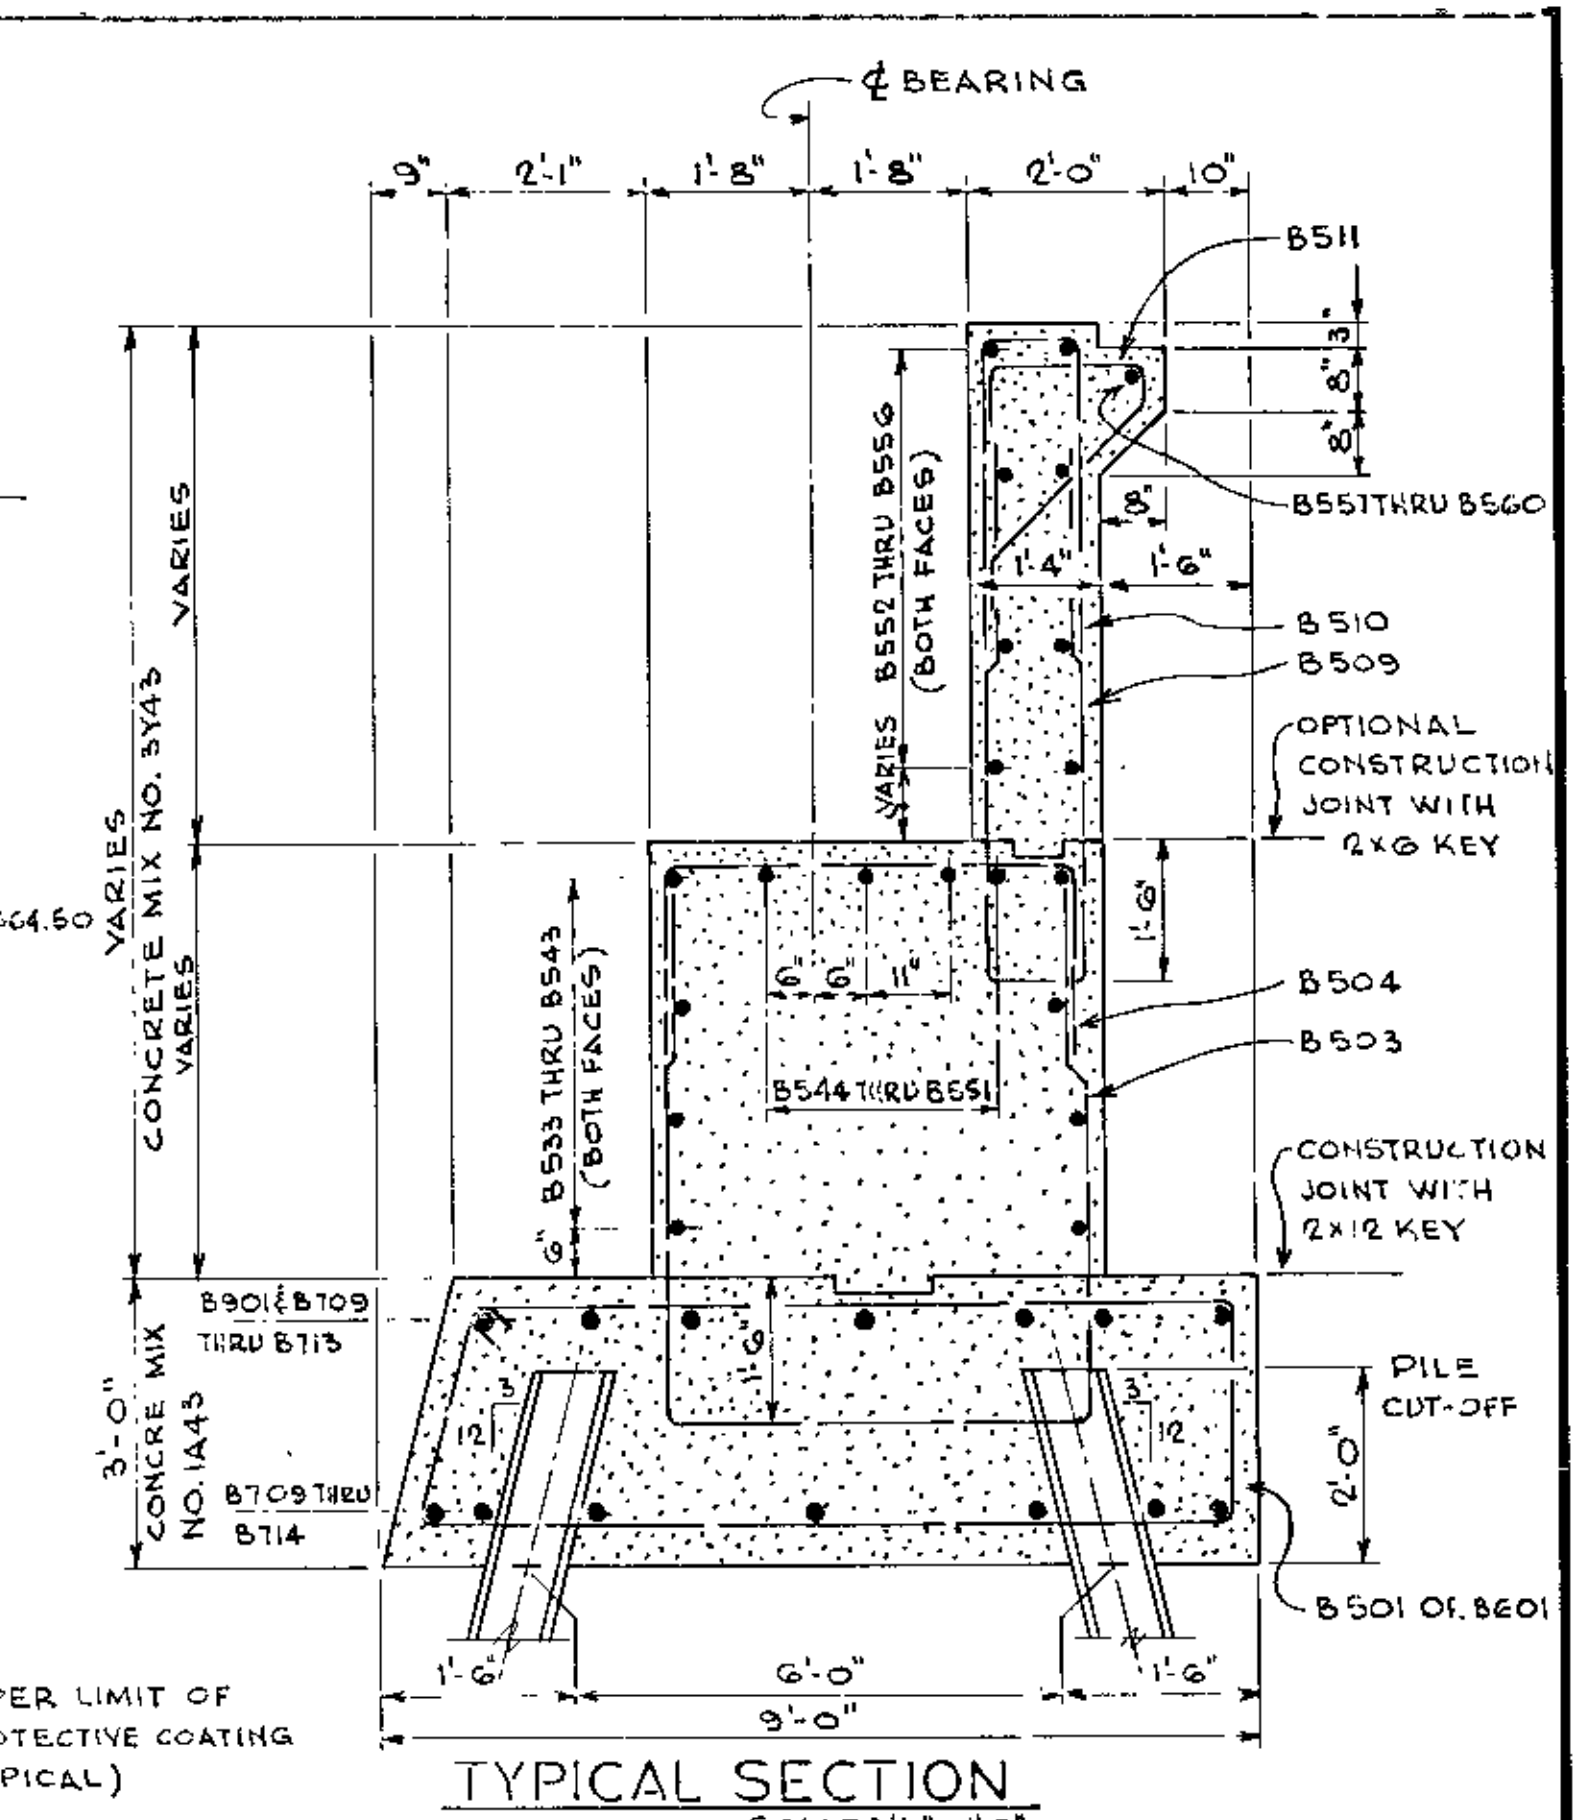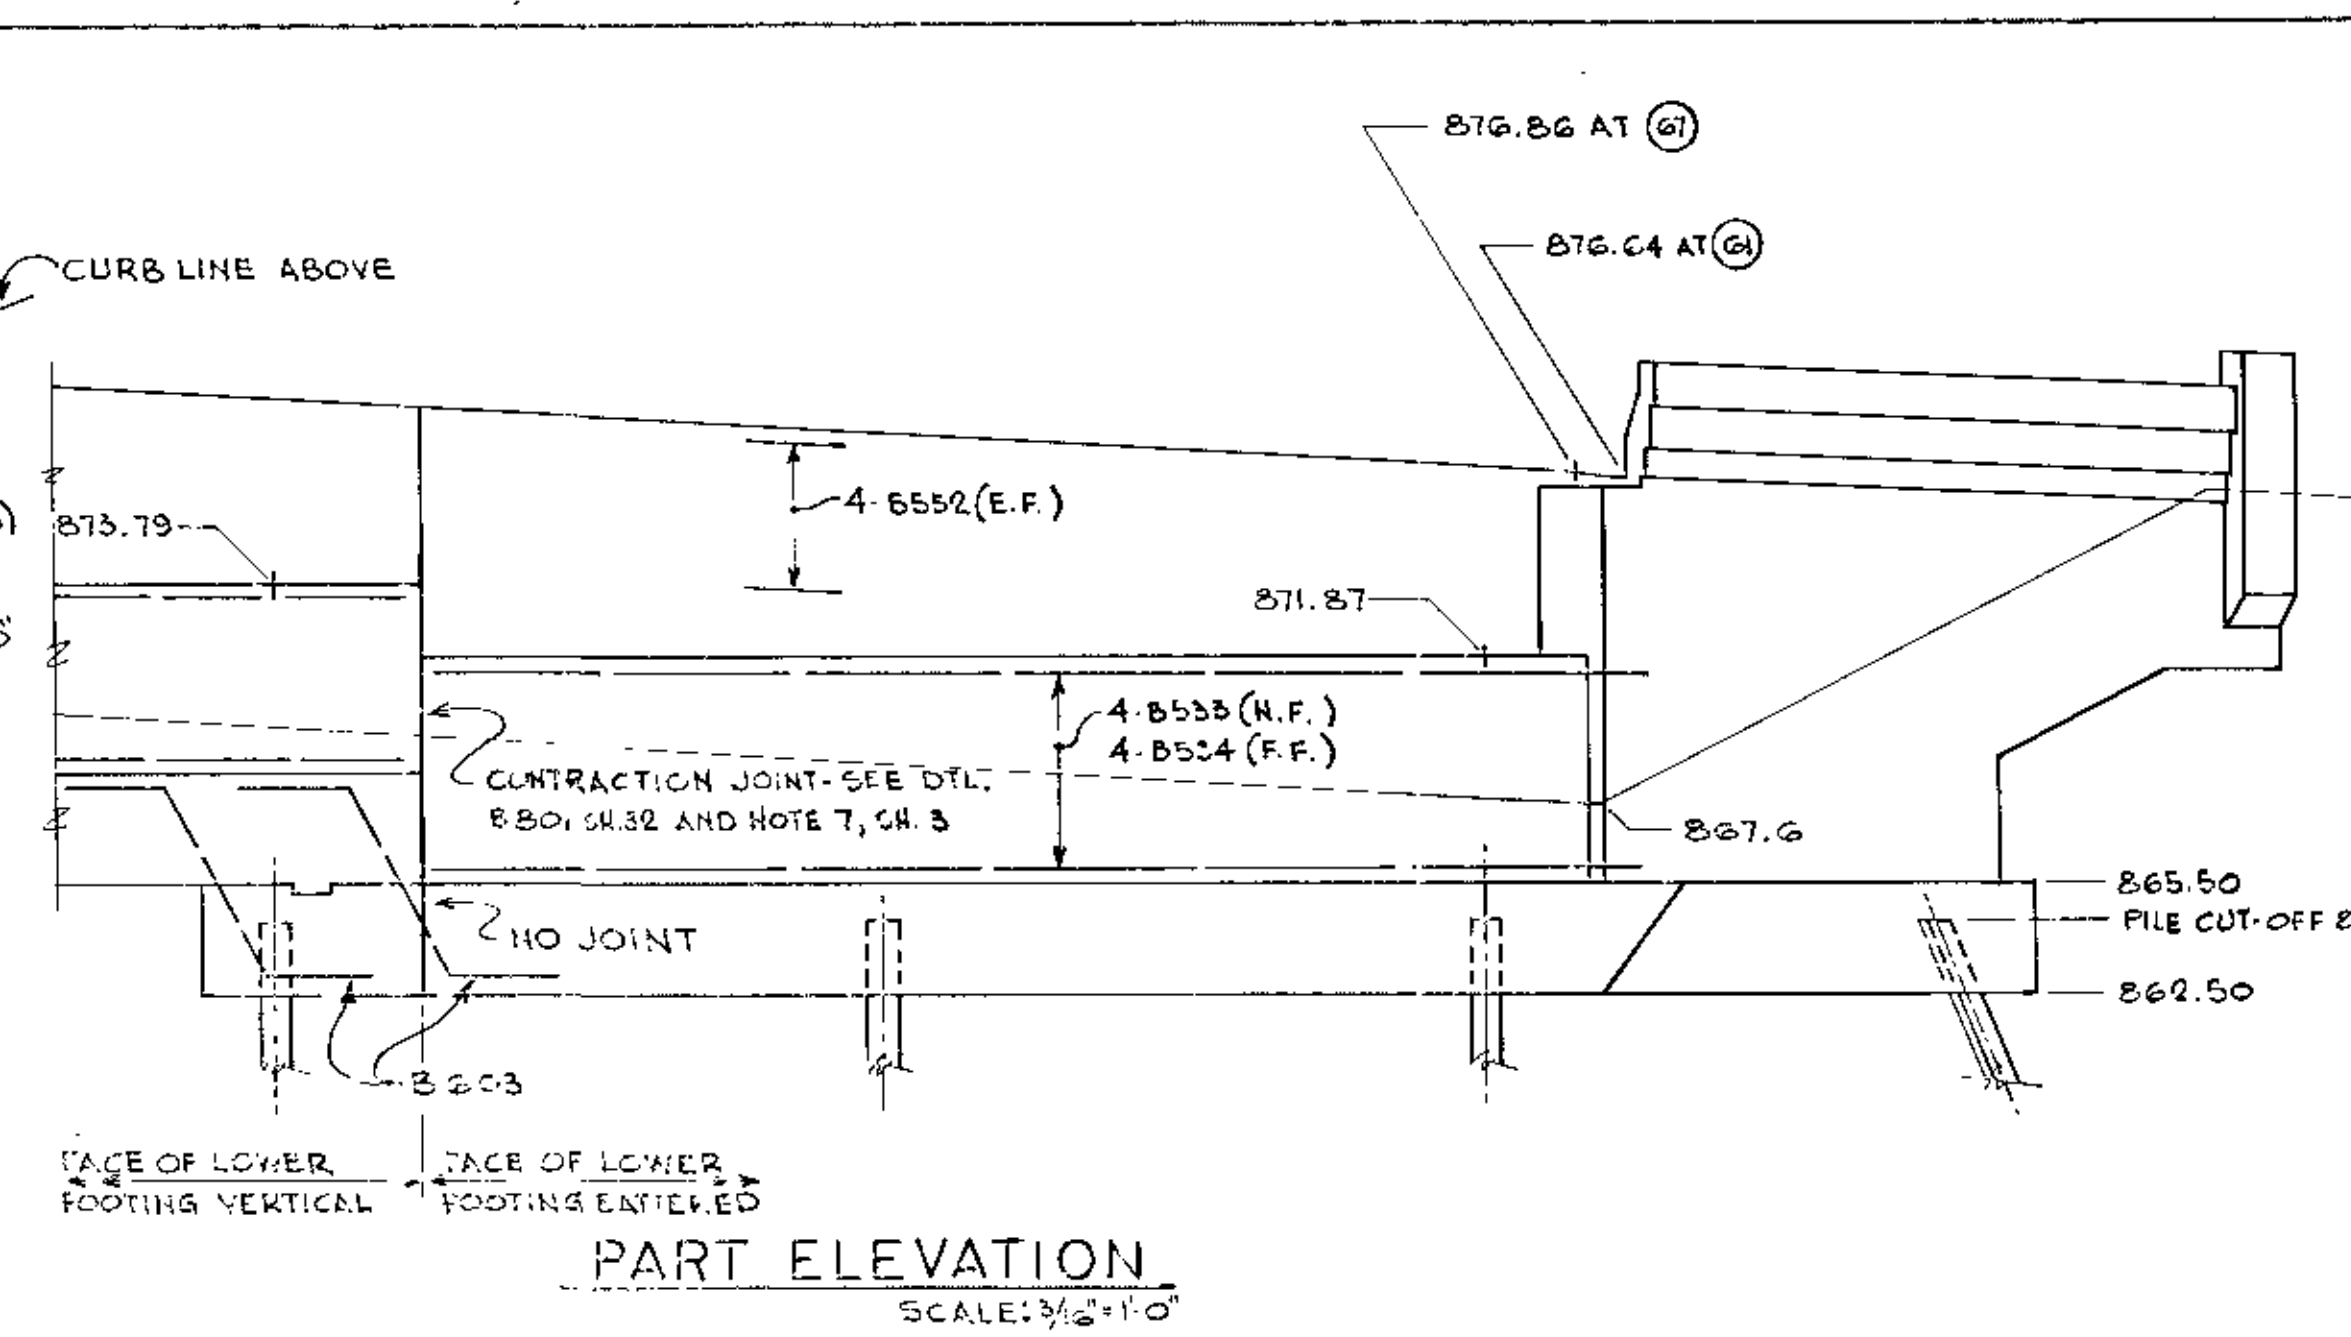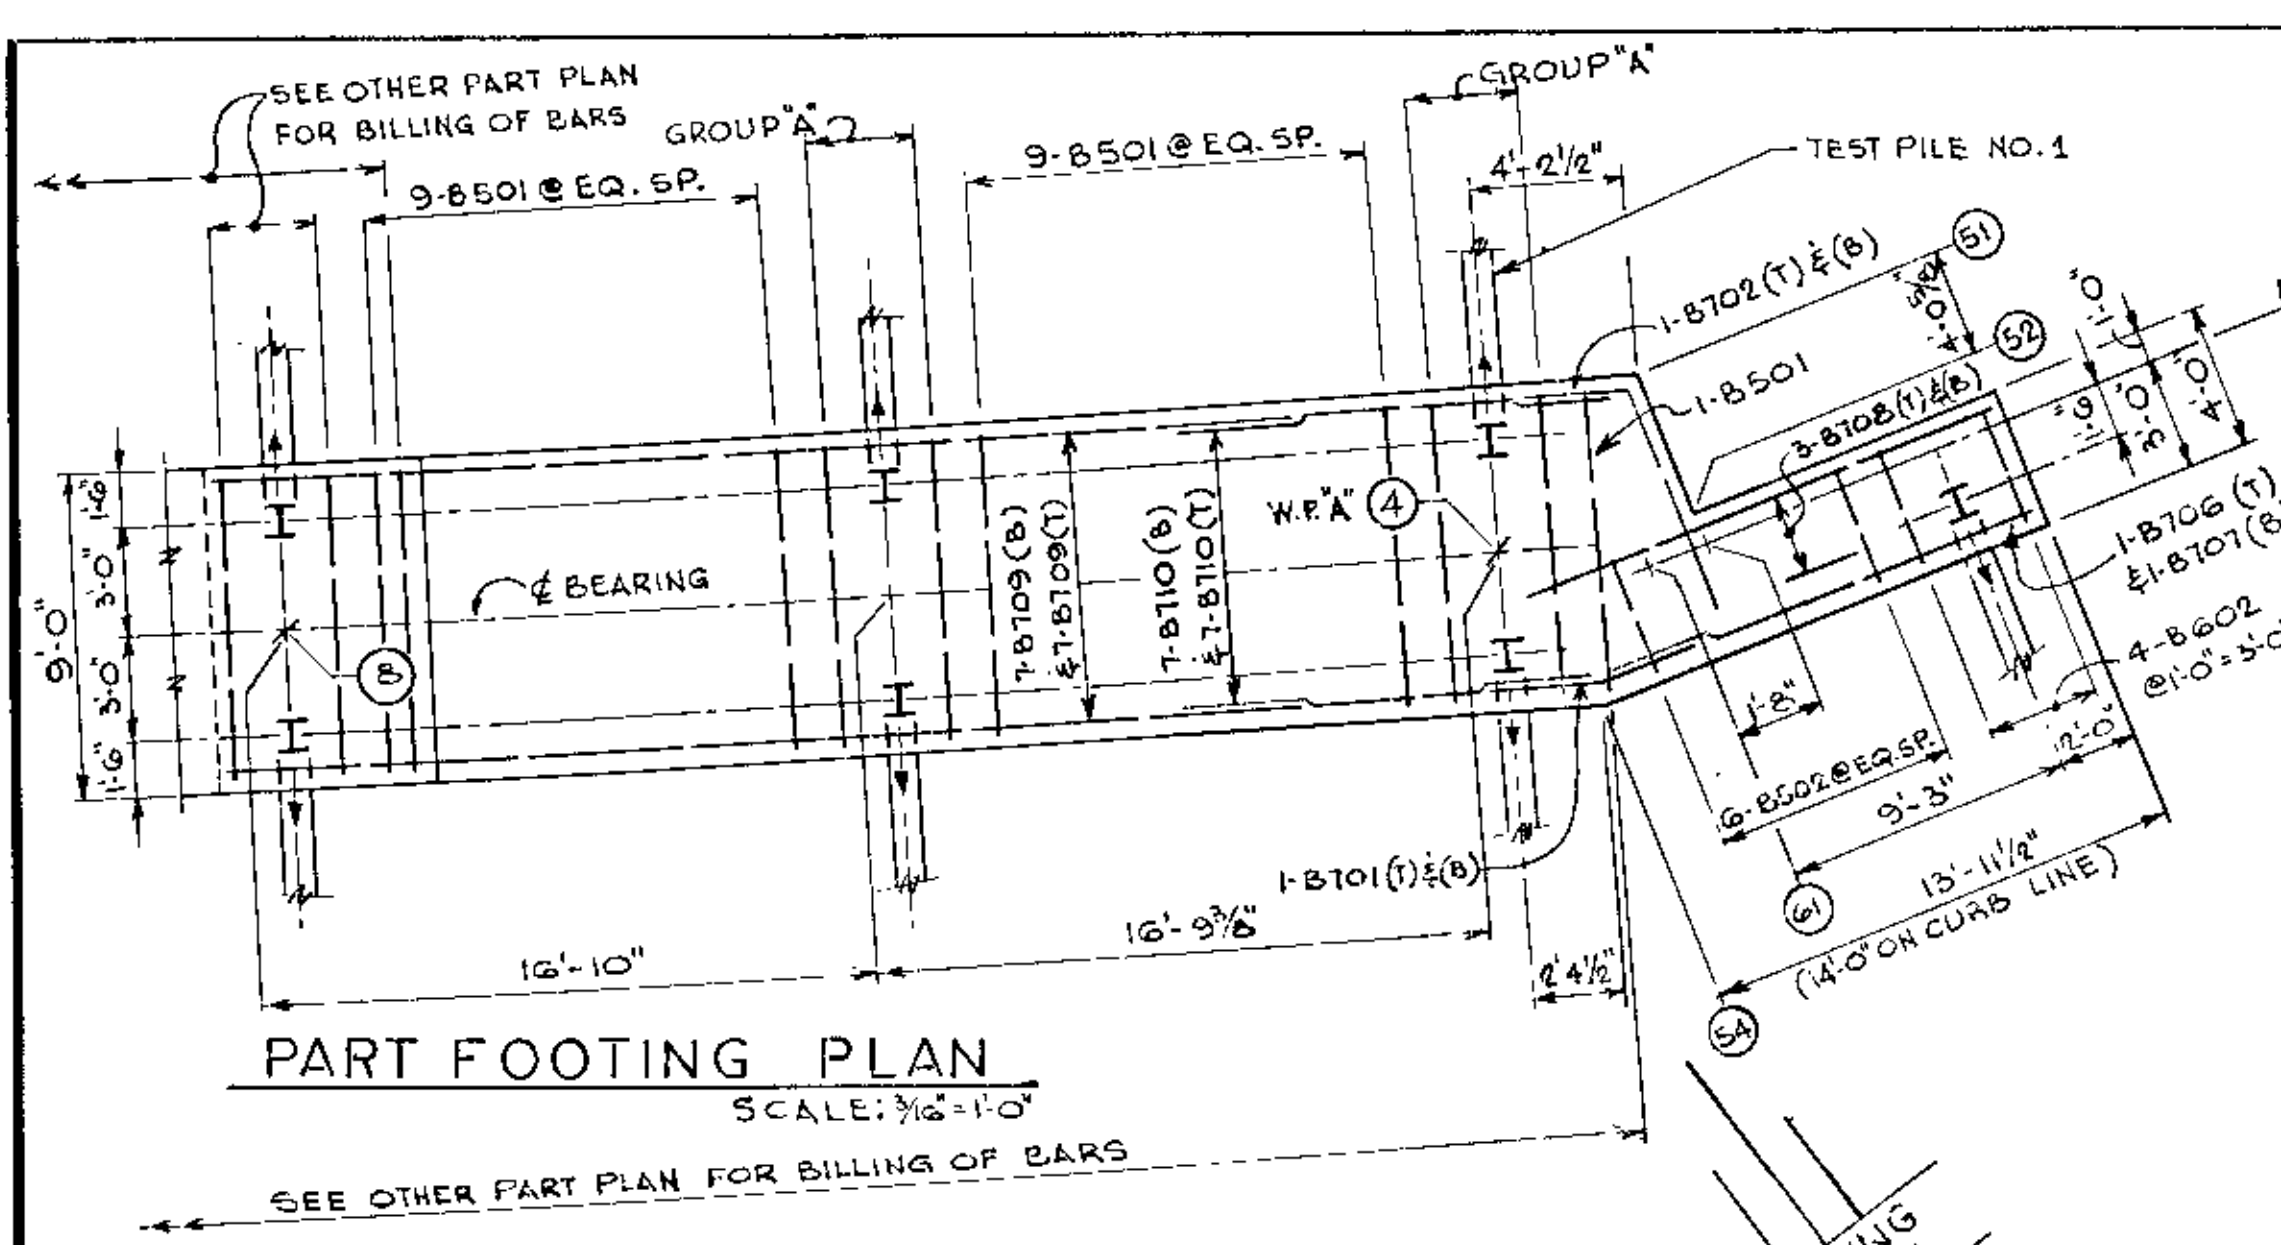

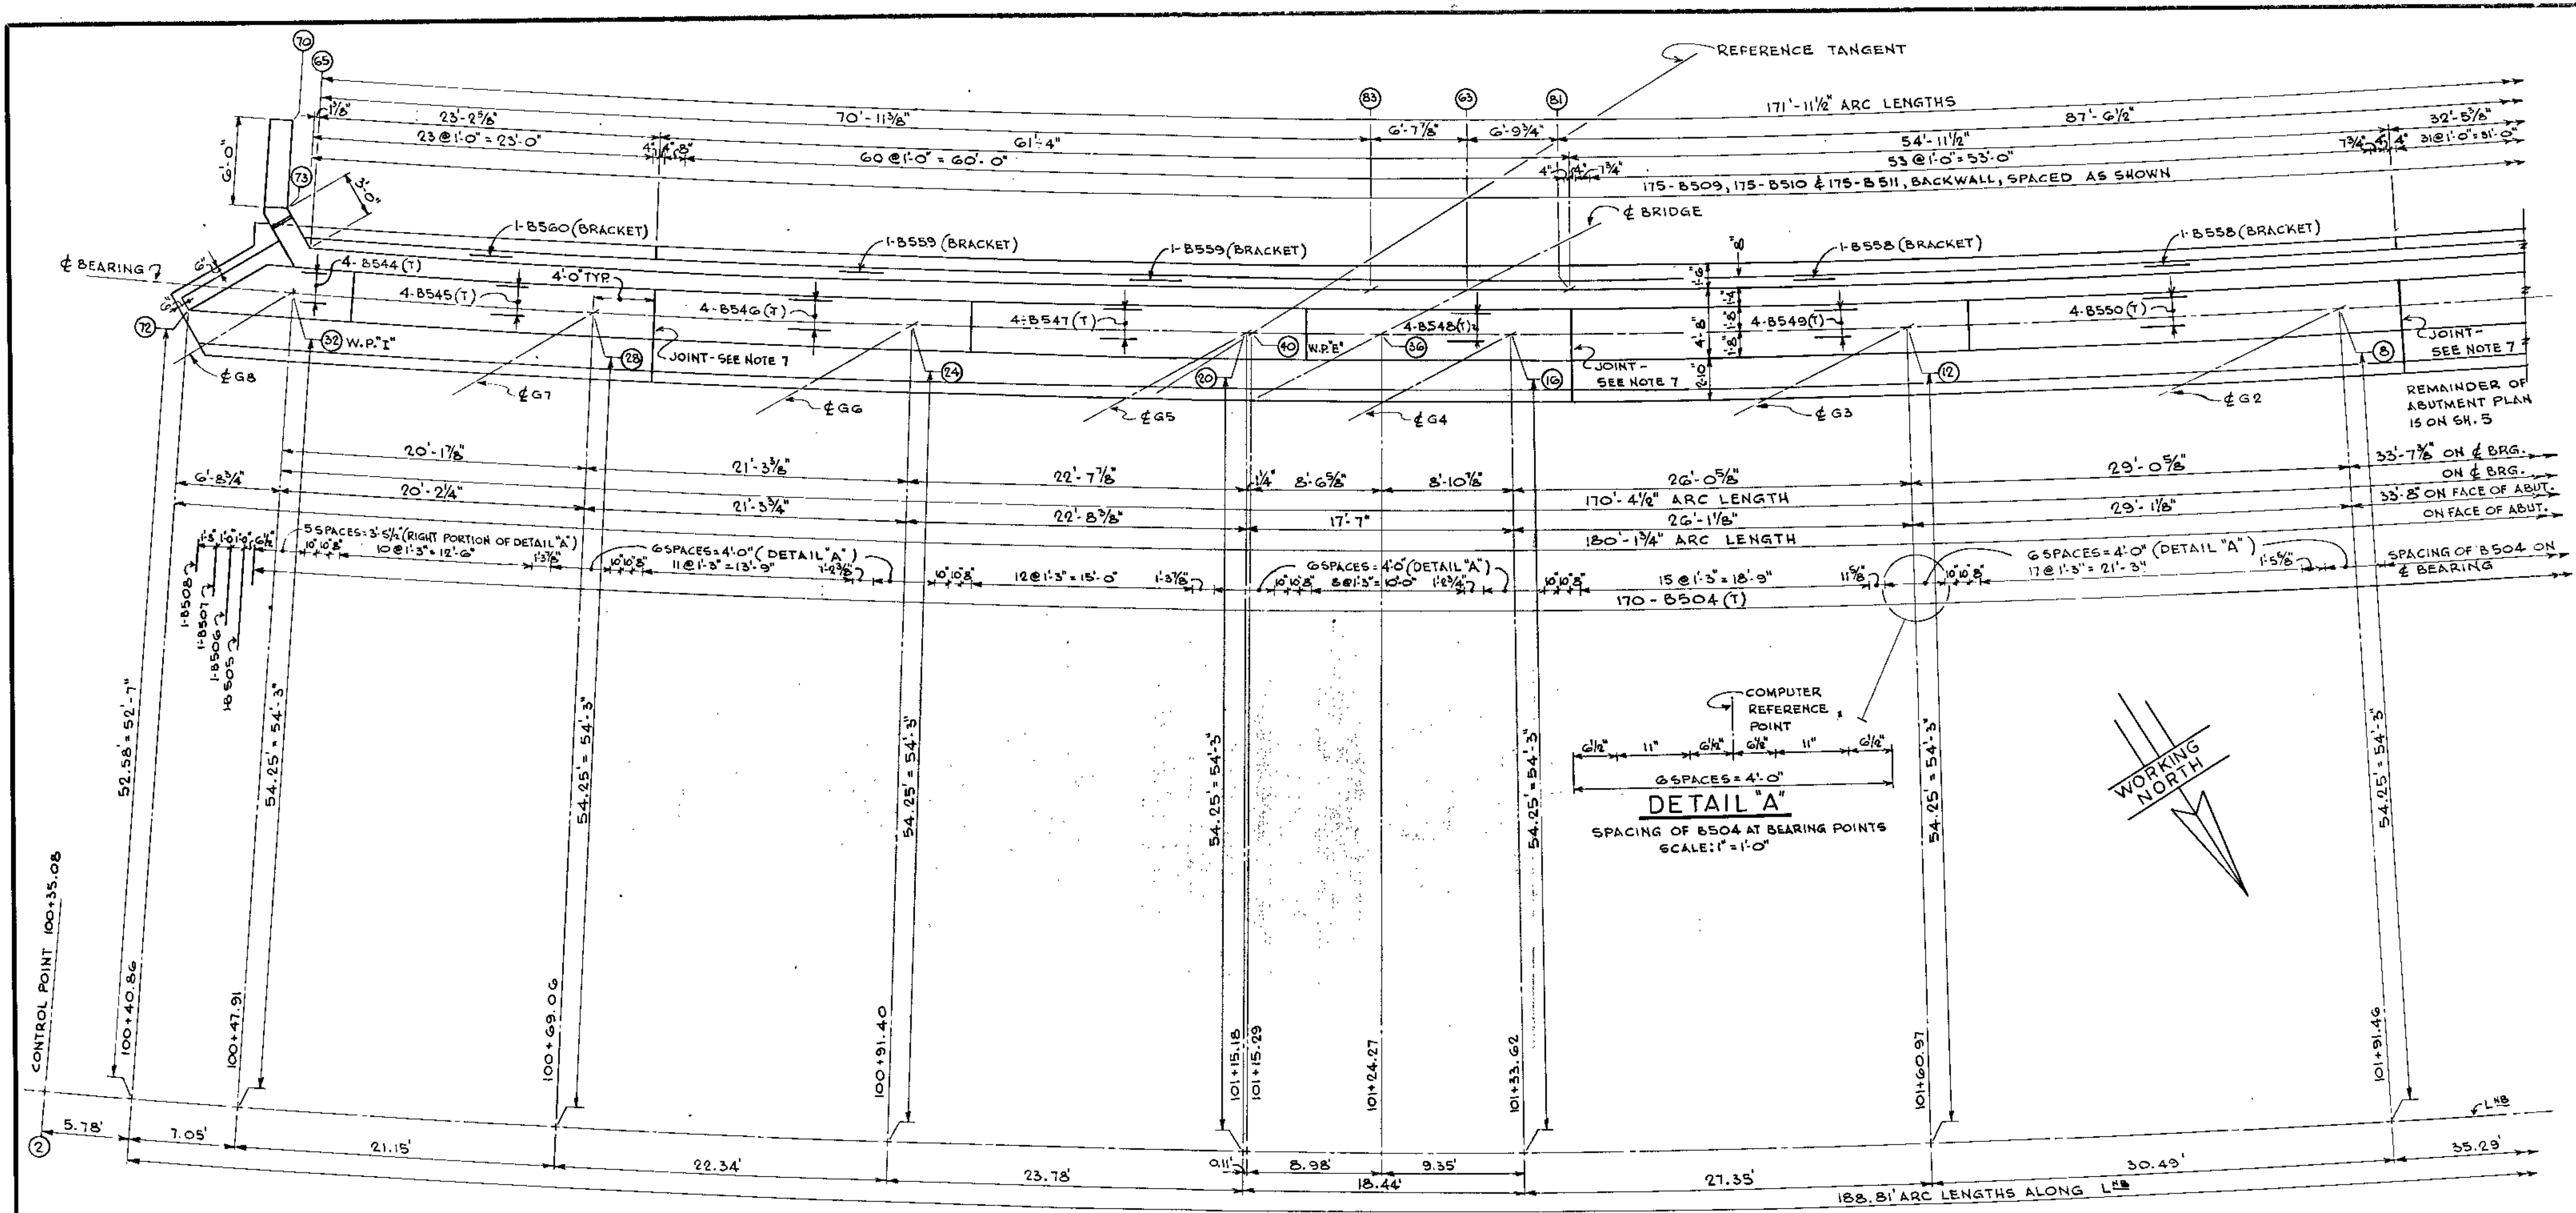

PART ABUTMENT PLAN AND LAYOUT
SCALE: 3/16" = 1'-0"

SUMMARY OF QUANTITIES FOR WEST ABUTMENT	
STRUCTURE EXCAVATION, CLASS E	840 CU.YD.
CONCRETE, MIX NO. 1A43	197 CU.YD.
CONCRETE, MIX NO. 3Y43	265 CU.YD.
CONCRETE, MIX NO. 3Y4GA, SPECIAL	4 CU.YD.
REINFORCEMENT BARS	27,820 LBS.
TWO STEEL TEST PILES IN PLACE, 130-FT. LONG	
STEEL PILING DELIVERED	2,760 LIN. FT.
STEEL PILING DRIVEN	2,714 LIN. FT.
ORNAMENTAL METAL RAILING (TYPE G)	18 LIN. FT.

- QUANTITY NOTES:**
- THIS SUMMARY INCLUDES RAILING CONCRETE, FOR THE PORTION OF RAILING ON THE NORTHWEST WINGWALL.
 - THE TABULATED QUANTITIES FOR STEEL PILING, DELIVERED AND FOR STEEL PILING, DRIVEN, DO NOT INCLUDE TEST PILES.
 - NO SPLICES IN TEST PILES OR MEASURED PILES WILL BE ELIGIBLE FOR EXTRA COMPENSATION, EXCEPT STRICTLY UNDER THE CONDITIONS OF M.H.D. 2452.5B


- NOTES**
- WORK THIS SHEET WITH SHEETS 4, 5 & 6.
 - SEE SHEET 31 FOR DETAIL OF 1/4" ANCHOR BOLT.
 - SEE SHEET 7 FOR ANCHOR BOLT LAYOUT.
 - BRIDGE SEAT REINFORCEMENT SHALL BE CAREFULLY PLACED TO AVOID INTERFERENCE WITH THE DRILLING OF HOLES FOR ANCHOR BOLTS.
 - THE SUPERSTRUCTURE GIRDERS SHALL BE ERECTED IN FINAL POSITION PRIOR TO DRILLING ANCHOR BOLT HOLES AND PLACING ANCHOR BOLTS.
 - REFER TO SHEET 28 FOR DIMENSIONS OF RAILING, DIMENSIONS OF END POST, AND DETAIL OF GUARD RAIL ANCHOR. ANCHOR IS STRUCTURAL STEEL, INCLUDED WITH SUPERSTRUCTURE QUANTITIES.
 - ANY, OR ALL, OF THE THREE CONTRACTION JOINTS MAY BE A CONSTRUCTION JOINT. USE 2x4 VERTICAL KEY FULL HEIGHT FROM TOP OF FOOTING TO TOP OF BACKWALL.

- PILE NOTES**
- ALL PILES SHALL BE BATTERED 3" PER FOOT IN THE DIRECTION SHOWN THUS: \rightarrow
 - ESTIMATED PENETRATION IS TWO FEET LESS THAN LENGTH GIVEN BELOW.
 - ALL PILES ARE STEEL "H", 10 SP 57, CONFORMING TO M.H.D. 3372.
 - PILE SPACING SHOWN IS AT BOTTOM OF FOOTING.
 - TWO STEEL TEST PILES 130-FT. LONG. TWENTY-THREE STEEL PILES 120-FT. LONG. TWENTY-FIVE STEEL PILES, TOTAL FOR WEST ABUTMENT.
 - ALL PILES SHALL BE DRIVEN TO REFUSAL ON BEDROCK.
 - FOR PILE SPLICES AND TIP REINFORCEMENT, SEE DETAIL B202, SHEET 30.
 - SEE PILE NOTE, SHEET 4, FOR DEEP INTERFERENCE.

COMPUTED PILE LOADS TONS PER PILE		
ITEM	FRONT ROW	BACK ROW
DEAD LOAD	45.5	74.0
LIVE LOAD	14.6	14.6
OVERTURNING	14.6	-14.6
TOTAL	74.9	74.2


AS BUILT
10-16-73
B. Jahn

TITLE: PART WEST ABUTMENT PLAN AND LAYOUT	DES: <i>R/mcs</i> CHK: <i>MODY</i>	DR: W.K. CHK: <i>R/mcs</i>	APPROVED:	Bridge No. 02522
Sheet No. 3 of 35 Sheets				

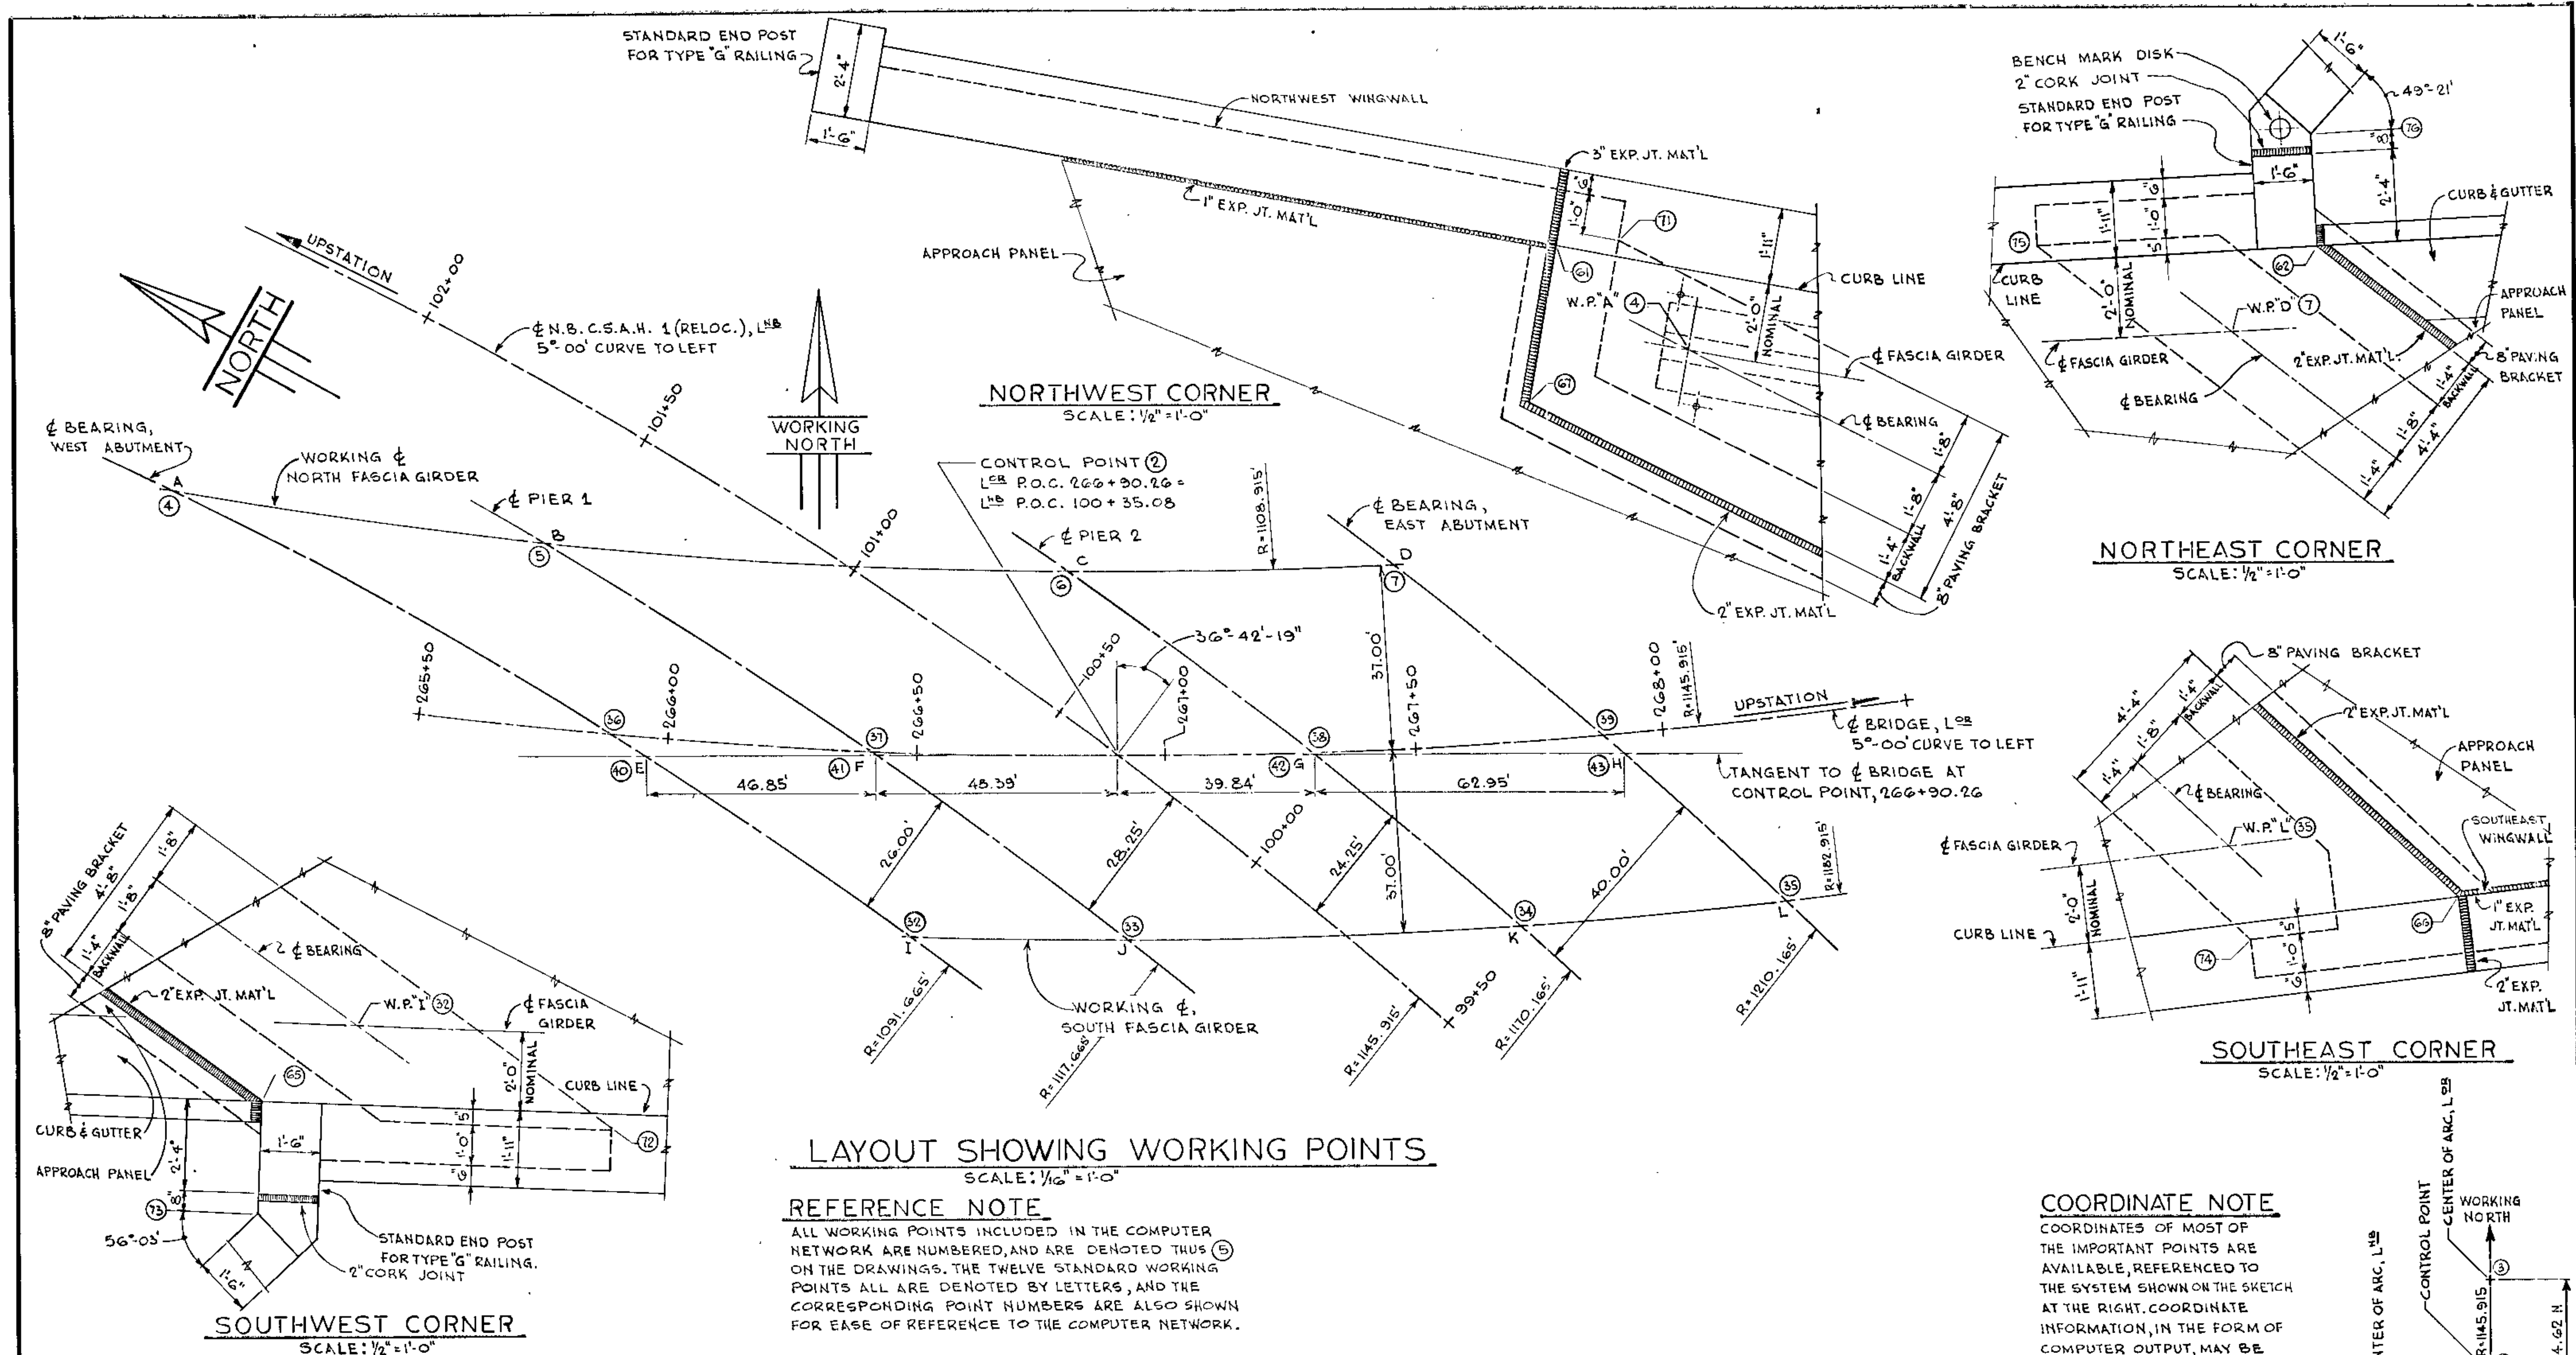

LAYOUT SHOWING WORKING POINTS
SCALE: 1/16" = 1'-0"

REFERENCE NOTE
ALL WORKING POINTS INCLUDED IN THE COMPUTER NETWORK ARE NUMBERED, AND ARE DENOTED THUS (5) ON THE DRAWINGS. THE TWELVE STANDARD WORKING POINTS ALL ARE DENOTED BY LETTERS, AND THE CORRESPONDING POINT NUMBERS ARE ALSO SHOWN FOR EASE OF REFERENCE TO THE COMPUTER NETWORK.

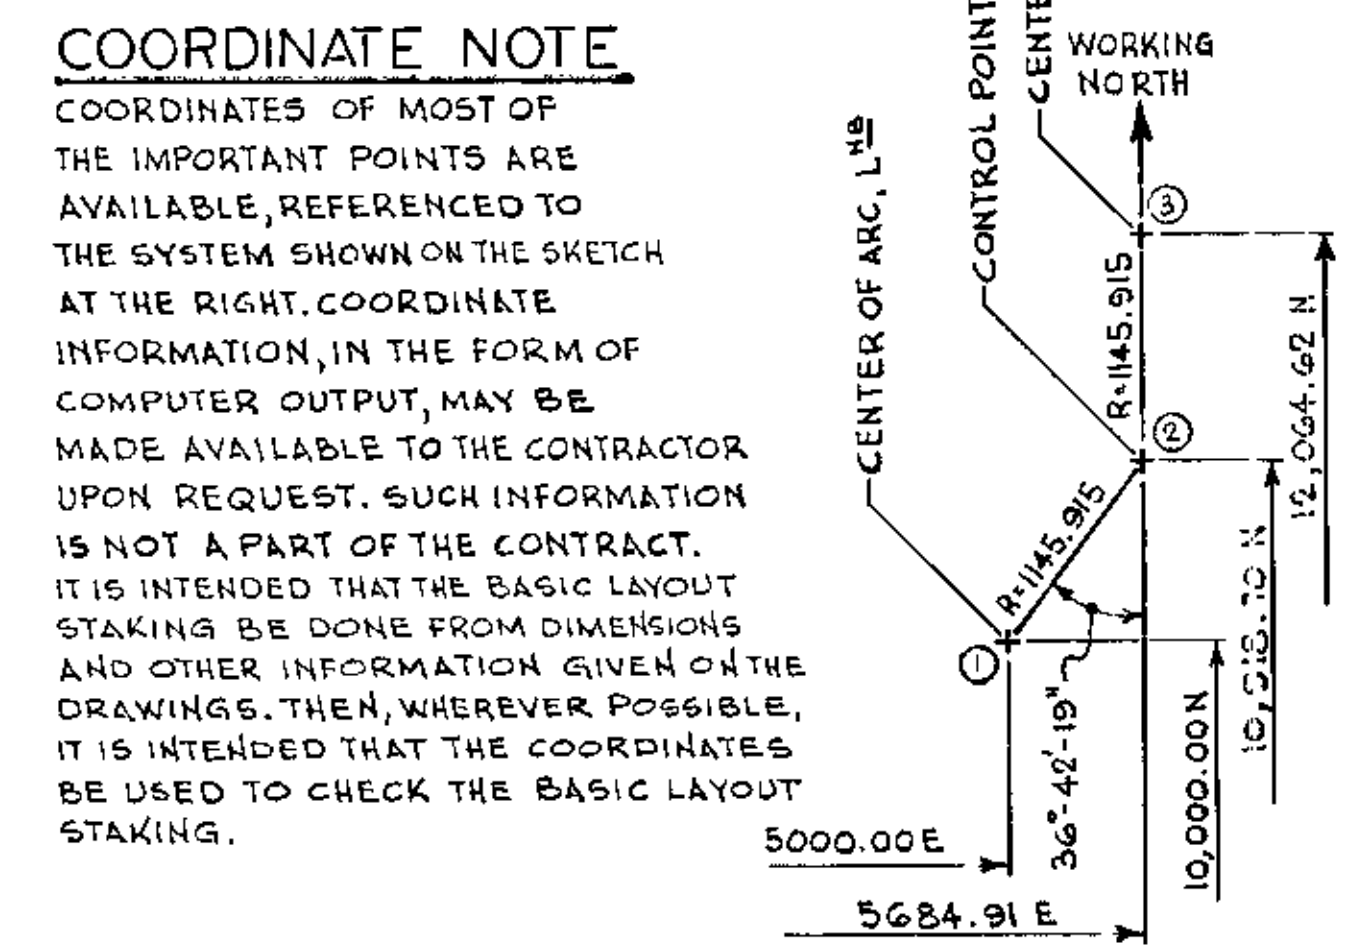


COORDINATE NOTE
COORDINATES OF MOST OF THE IMPORTANT POINTS ARE AVAILABLE, REFERENCED TO THE SYSTEM SHOWN ON THE SKETCH AT THE RIGHT. COORDINATE INFORMATION, IN THE FORM OF COMPUTER OUTPUT, MAY BE MADE AVAILABLE TO THE CONTRACTOR UPON REQUEST. SUCH INFORMATION IS NOT A PART OF THE CONTRACT. IT IS INTENDED THAT THE BASIC LAYOUT STAKING BE DONE FROM DIMENSIONS AND OTHER INFORMATION GIVEN ON THE DRAWINGS. THEN, WHEREVER POSSIBLE, IT IS INTENDED THAT THE COORDINATES BE USED TO CHECK THE BASIC LAYOUT STAKING.

AS BUILT
10-12-73
B. J. J.

POINT	STATION	DIMENSIONS BETWEEN WORKING POINTS												ELEVATIONS			
		A(4)	B(5)	C(6)	D(7)	E(8)	F(9)	G(10)	H(11)	I(12)	J(13)	K(14)	L(15)	TOP OF SLAB EL.	SLAB TO BR. SEAT	BRIDGE SEAT EL.	
A(4)	264+95.84																
B(5)	265+70.70	72.43															
C(6)	266+80.18		105.90														
D(7)	267+47.81			65.44													
E(8)	265+95.24	106.14															
F(9)	266+41.90	148.59	79.71			46.85											
G(10)	267+30.09		161.18	61.91				88.23									
H(11)	267+92.78			118.49	60.79				62.95								
I(12)	266+49.31	170.21	107.92	80.17		64.19											
J(13)	266+92.14	209.47	142.11	74.96	92.58	103.99	62.47			44.21							
K(14)	267+69.00	282.25	211.33	115.56	76.97		134.05	53.69			79.32						
L(15)	268+21.93		261.30	159.76	104.70			100.13	43.94								

SCALE: 1" = 10'

WORKING NORTH

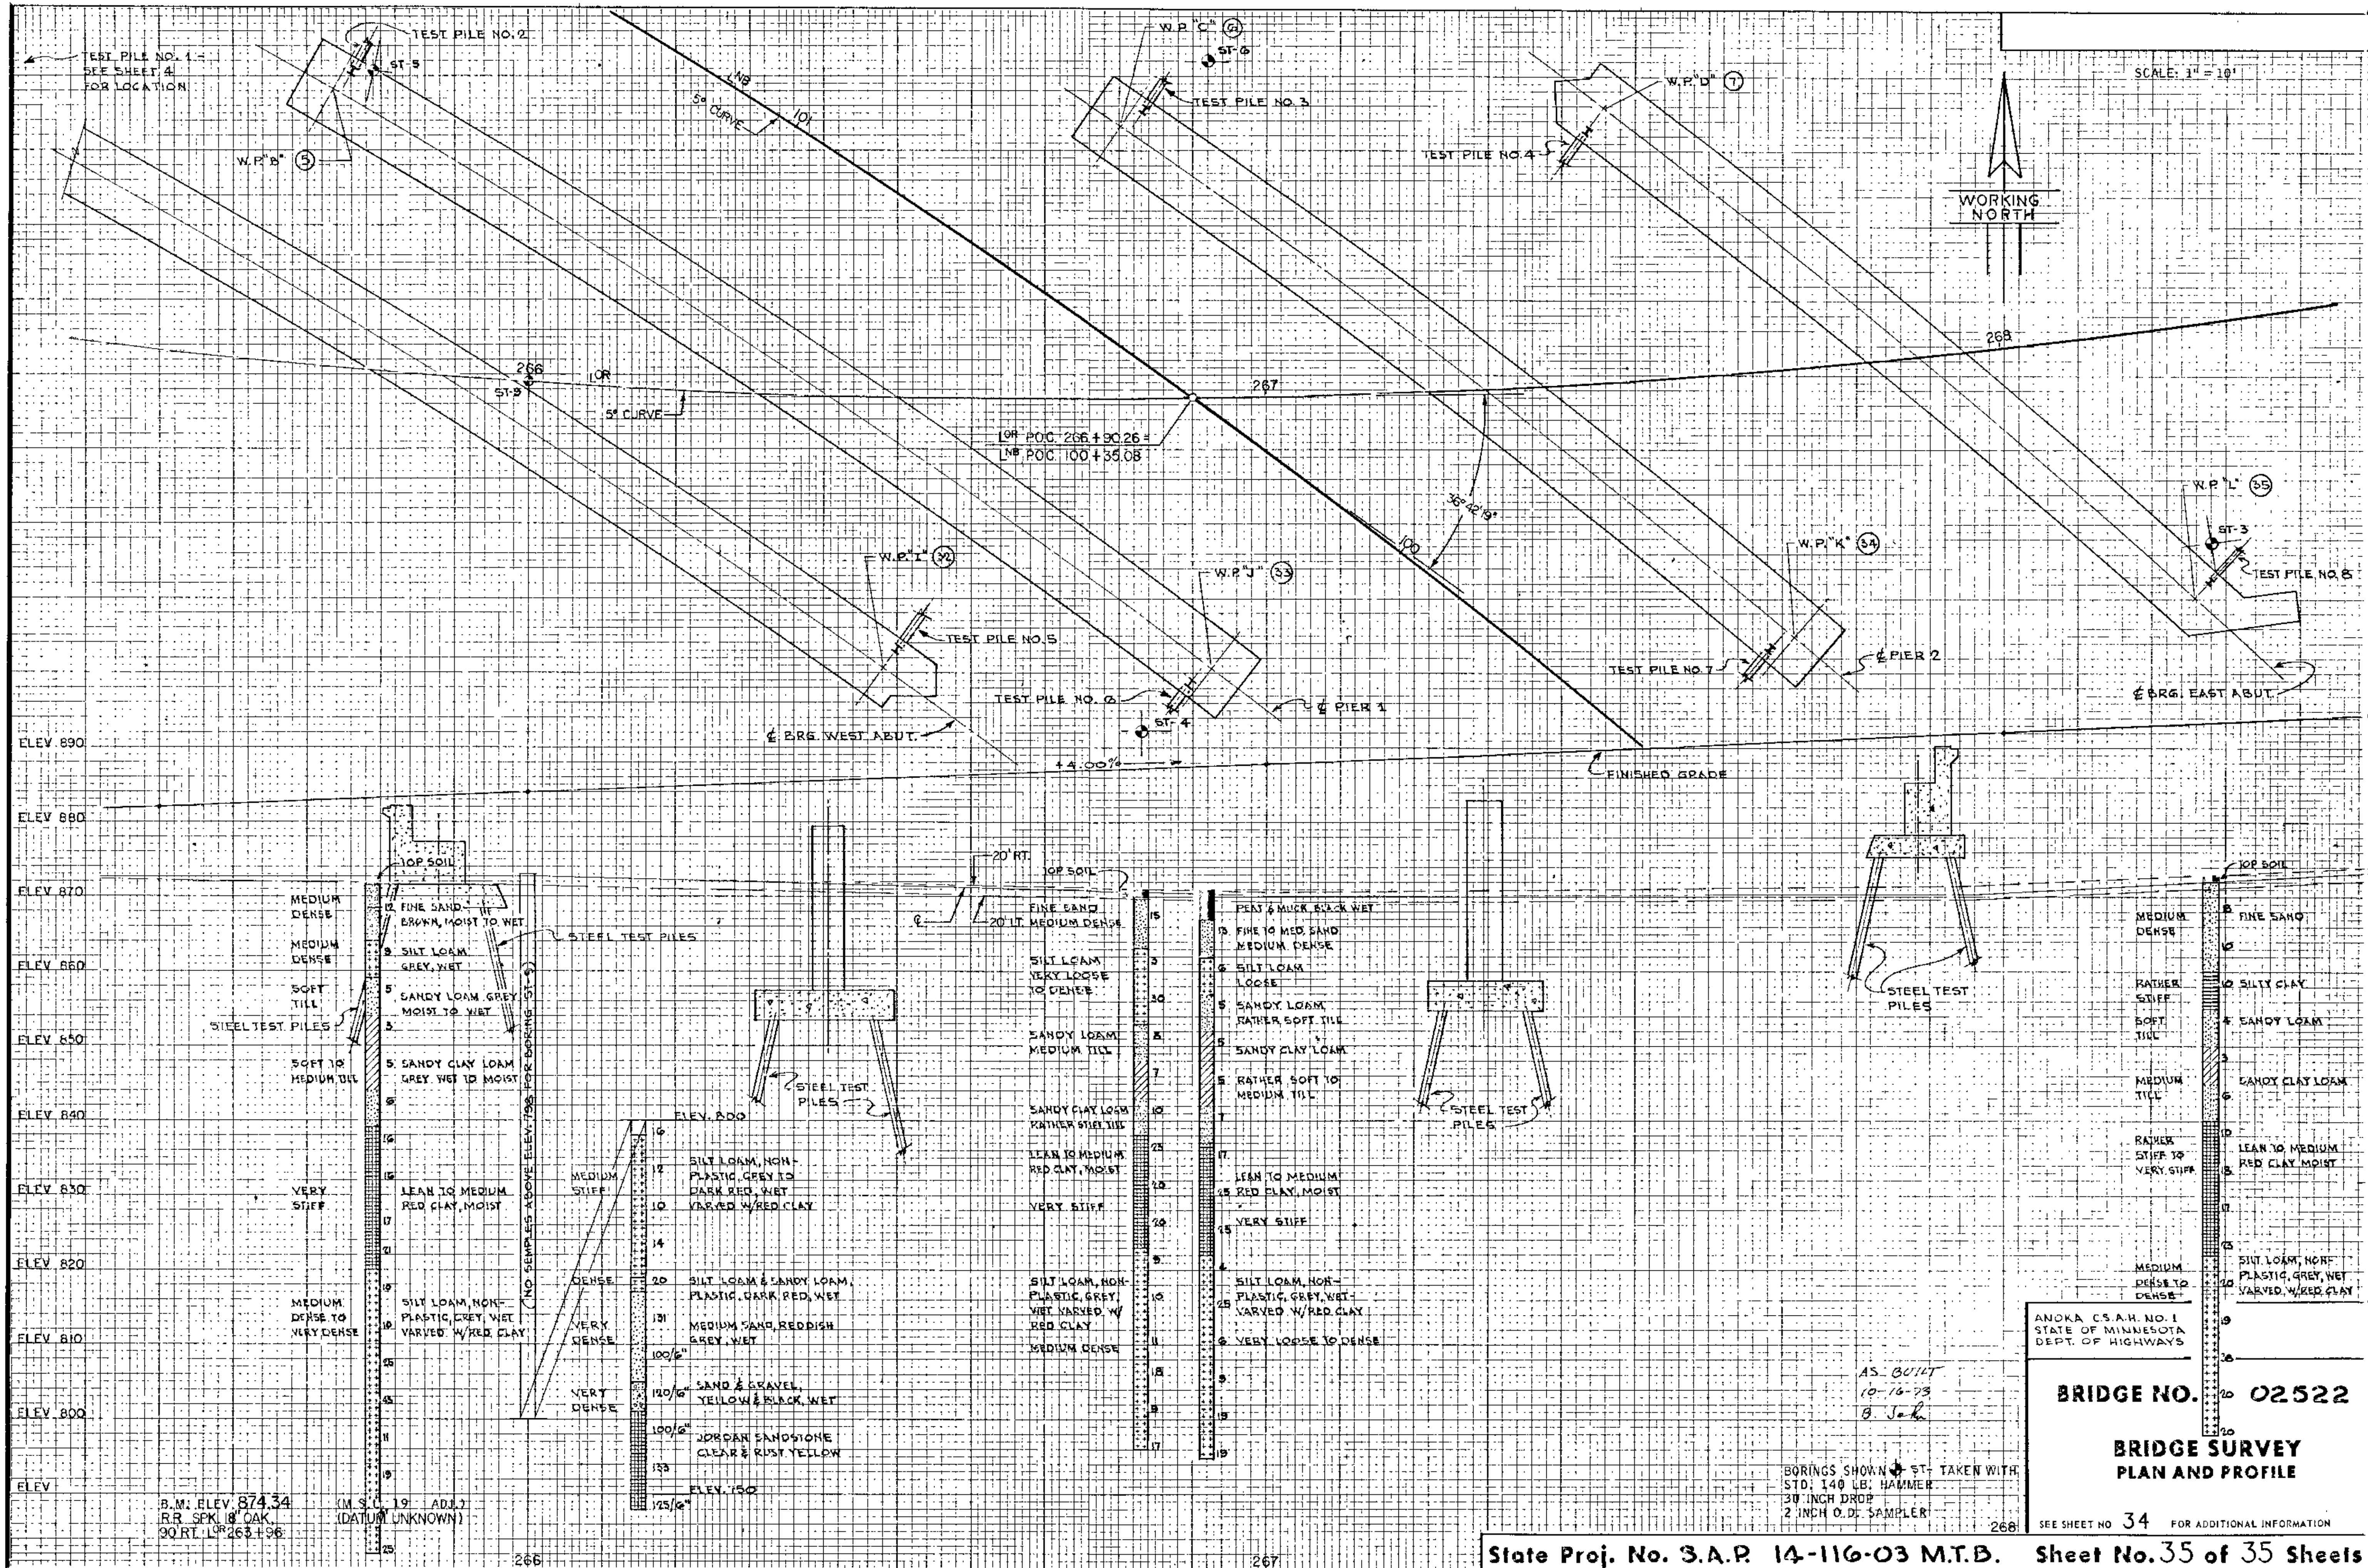

B.M. ELEV. 874.34
 I.R.R. SPK. 18 OAK
 90 RT. L.P. 263+96
 (M.S. 19 ADJ.)
 (DATUM UNKNOWN)

BORINGS SHOWN ST- TAKEN WITH
 STD. 140 LB. HAMMER
 30 INCH DROP
 2 INCH O.D. SAMPLER

ANOKA C.S.A.H. NO. 1
 STATE OF MINNESOTA
 DEPT. OF HIGHWAYS

BRIDGE NO. 02522

BRIDGE SURVEY
 PLAN AND PROFILE

SEE SHEET NO 34 FOR ADDITIONAL INFORMATION

Bridge Survey Sheet (Sheet 2 of 2)