
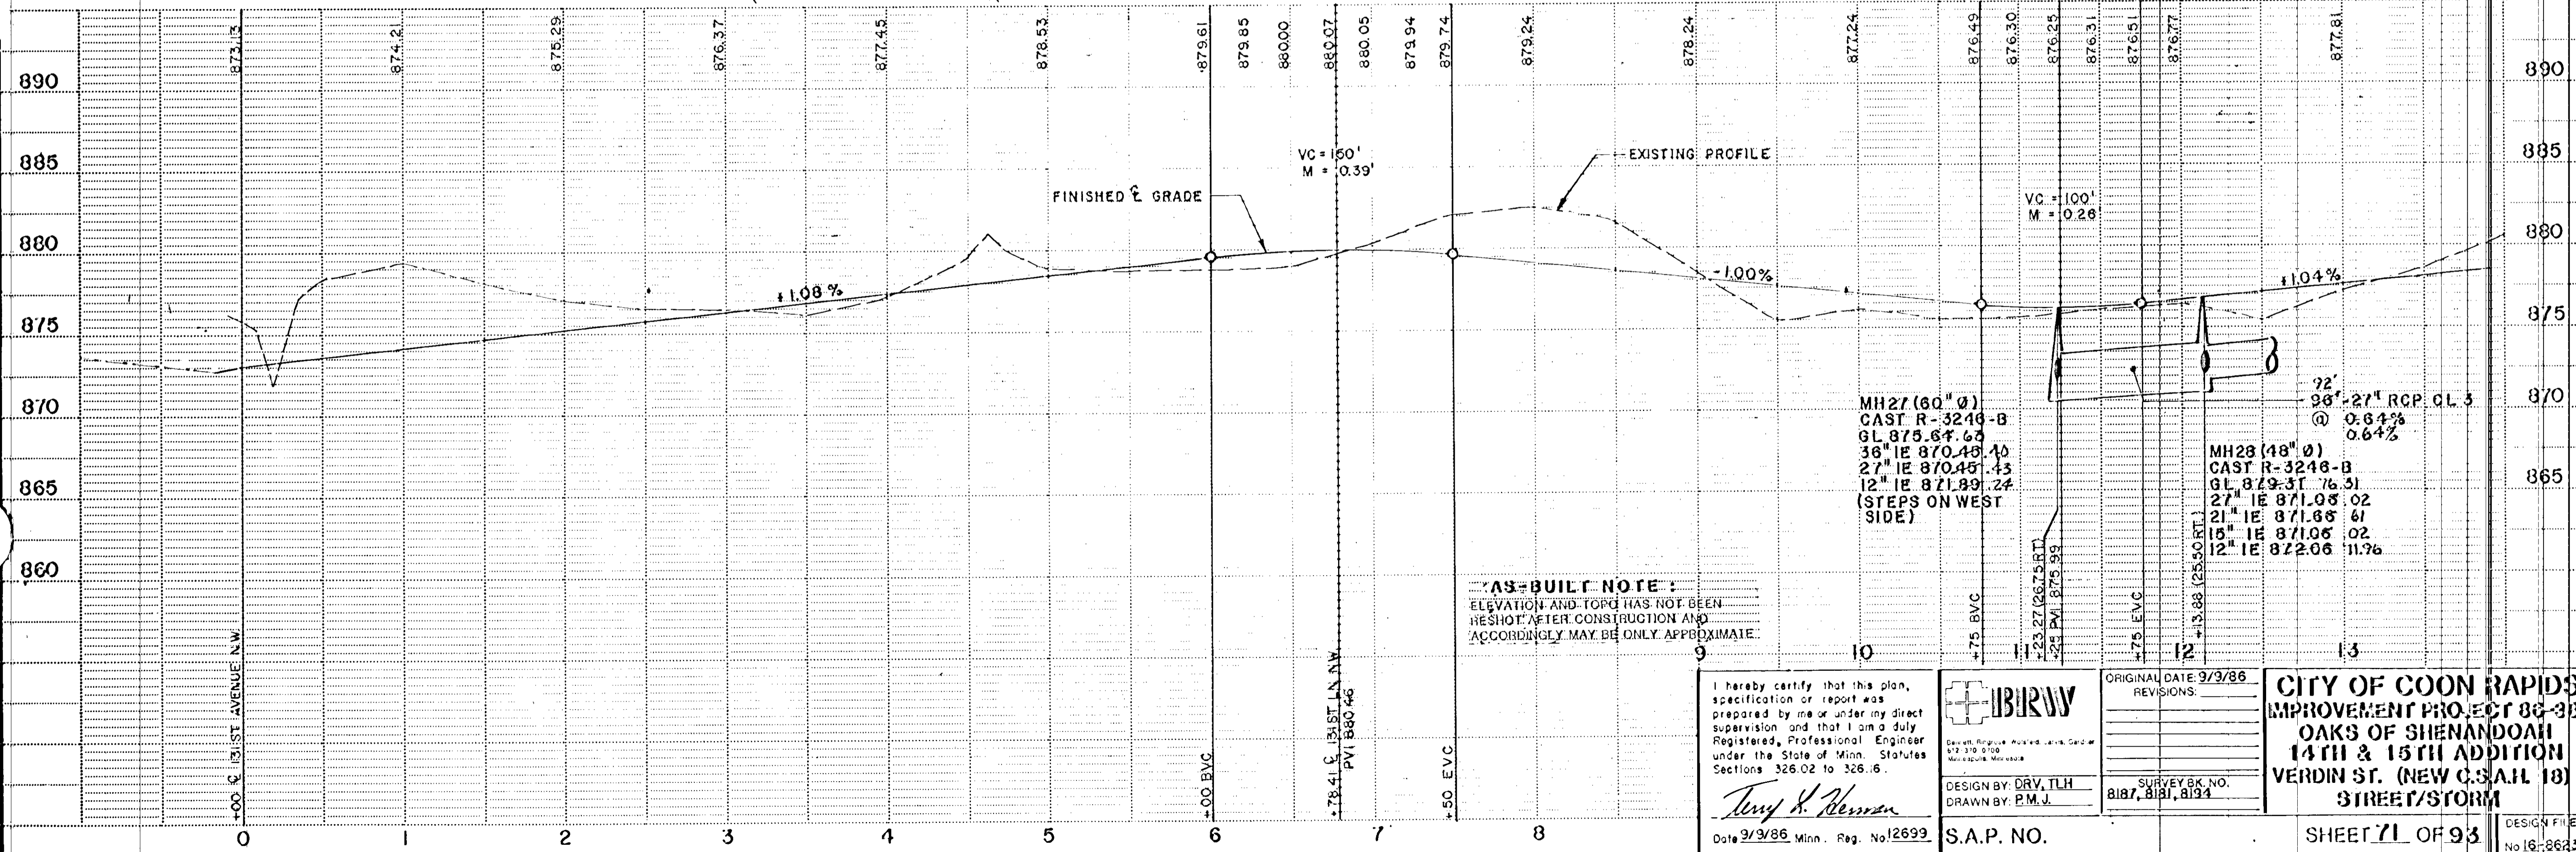


VERDIN STREET N.W. (NEW C.S.A.H. 18)

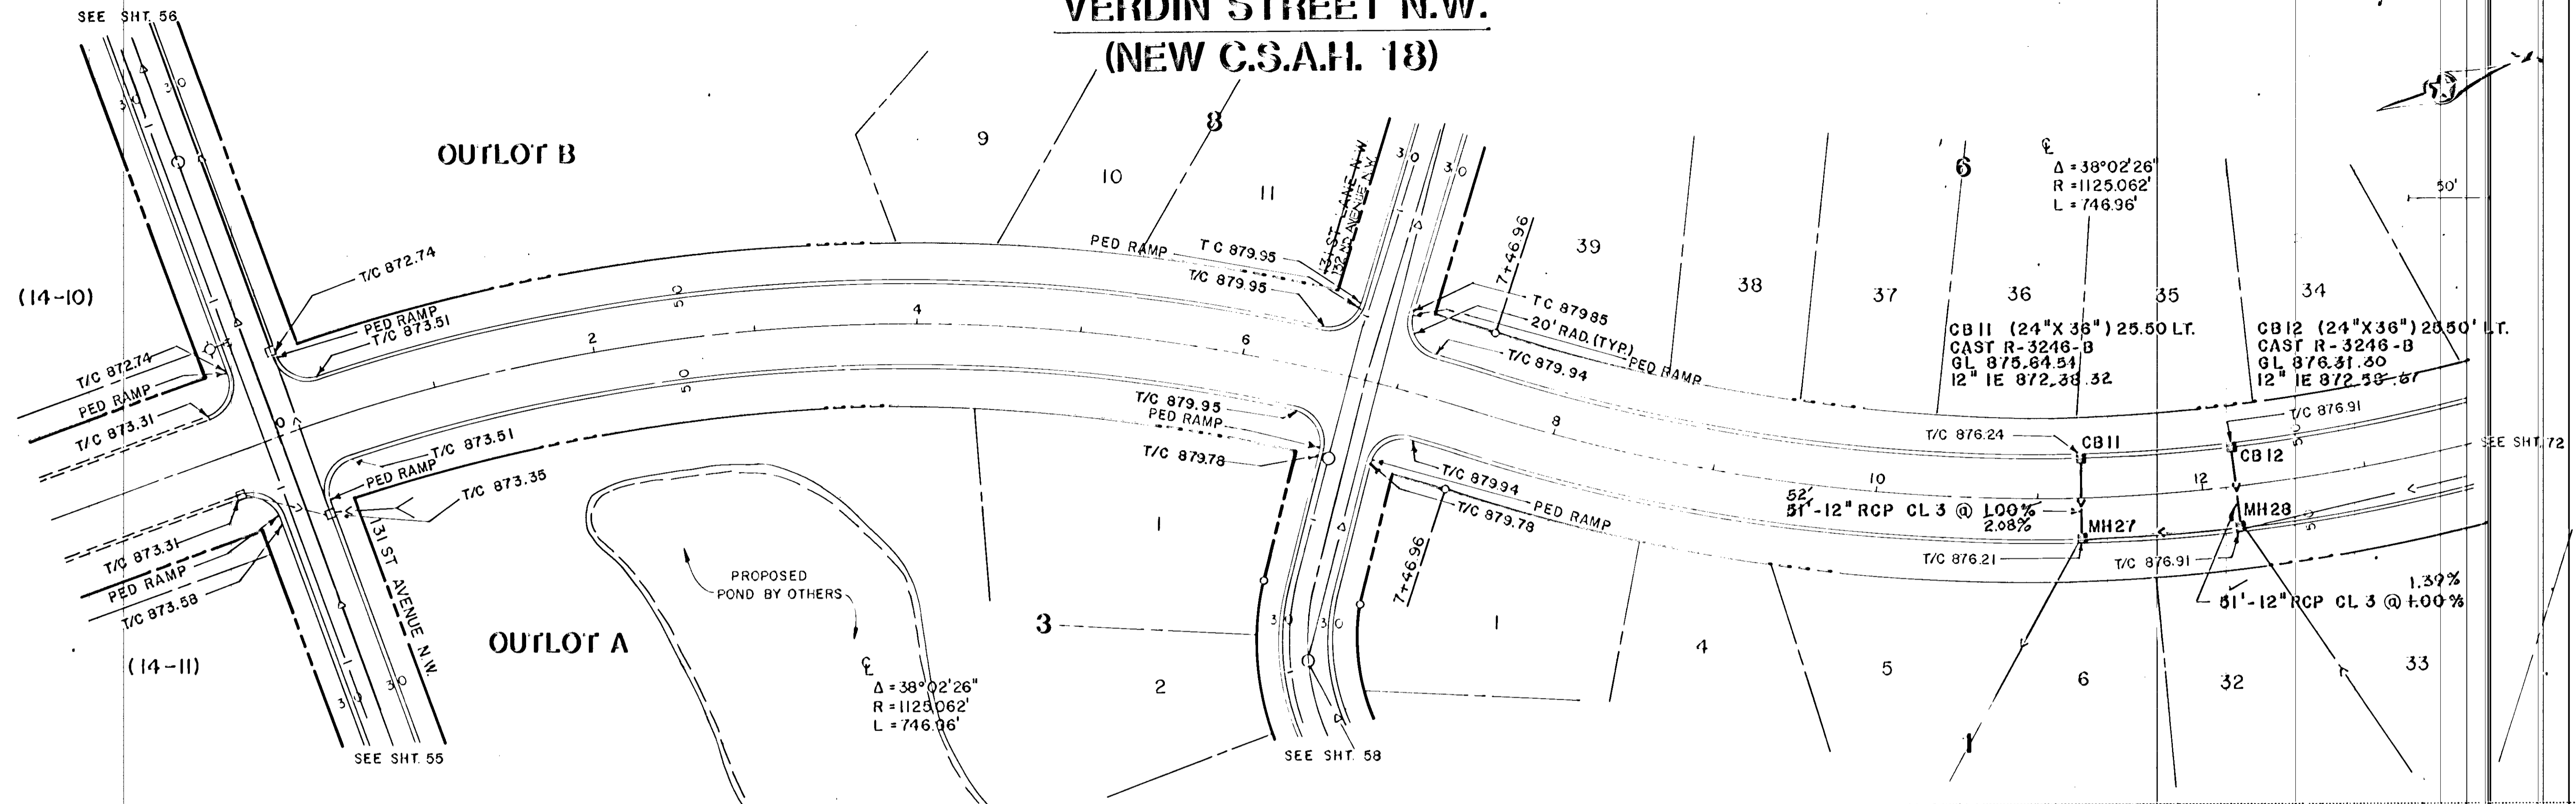

I hereby certify that this plan, specification or report was prepared by me or under my direct supervision and that I am a duly Registered Professional Engineer under the State of Minn. Statutes Sections 326.02 to 326.16.

Tony H. Herman
Date 9/3/86 Minn. Reg. No. 2699

IBIBOV
DESIGN BY: DRV, TLH
DRAWN BY: P.M.J.

ORIGINAL DATE: 9/9/86

REVISIONS:



SURVEY BK. NO. 8187, 8181, 8194

CITY OF COON RAPIDS
IMPROVEMENT PROJECT 86-33
OAKS OF SHENANDOAH
14TH & 15TH ADDITION
VERDIN ST. (NEW C.S.A.H. 18)
STREET/STORM

S.A.P. NO. SHEET 71 OF 93

As-Built 7-18-87 SSS

VERDIN STREET N.W. (NEW C.S.A.H. 18)

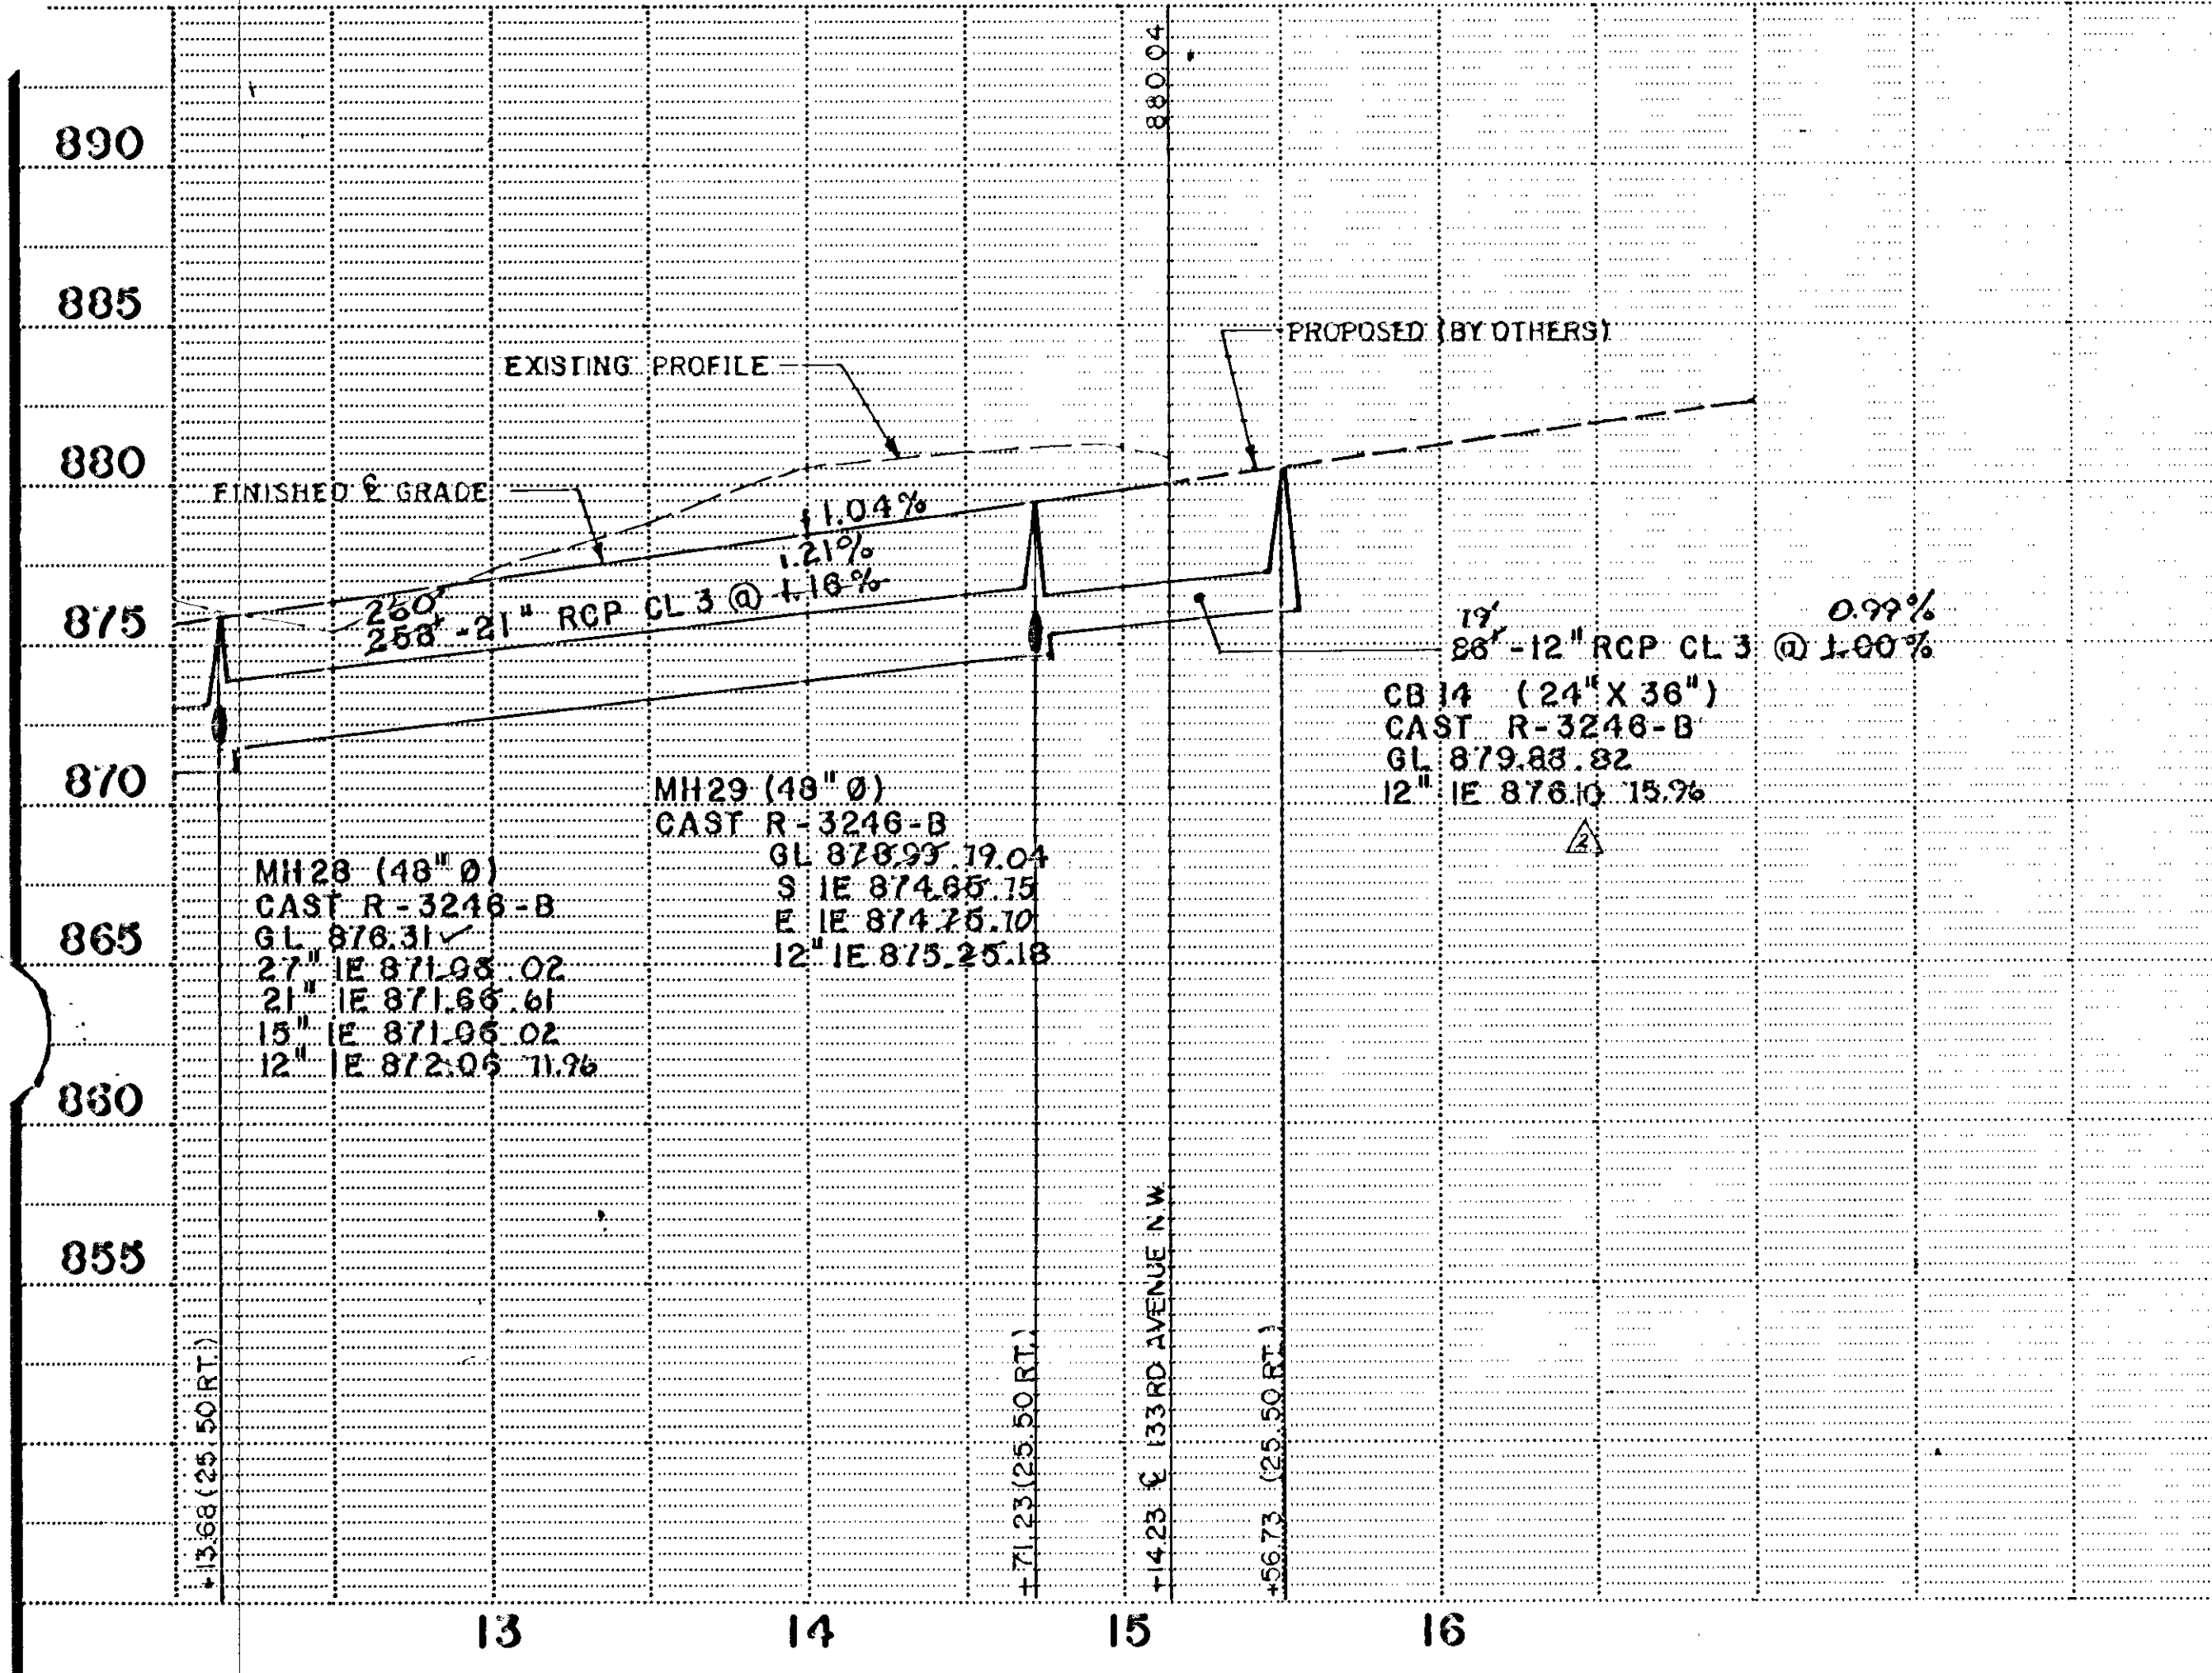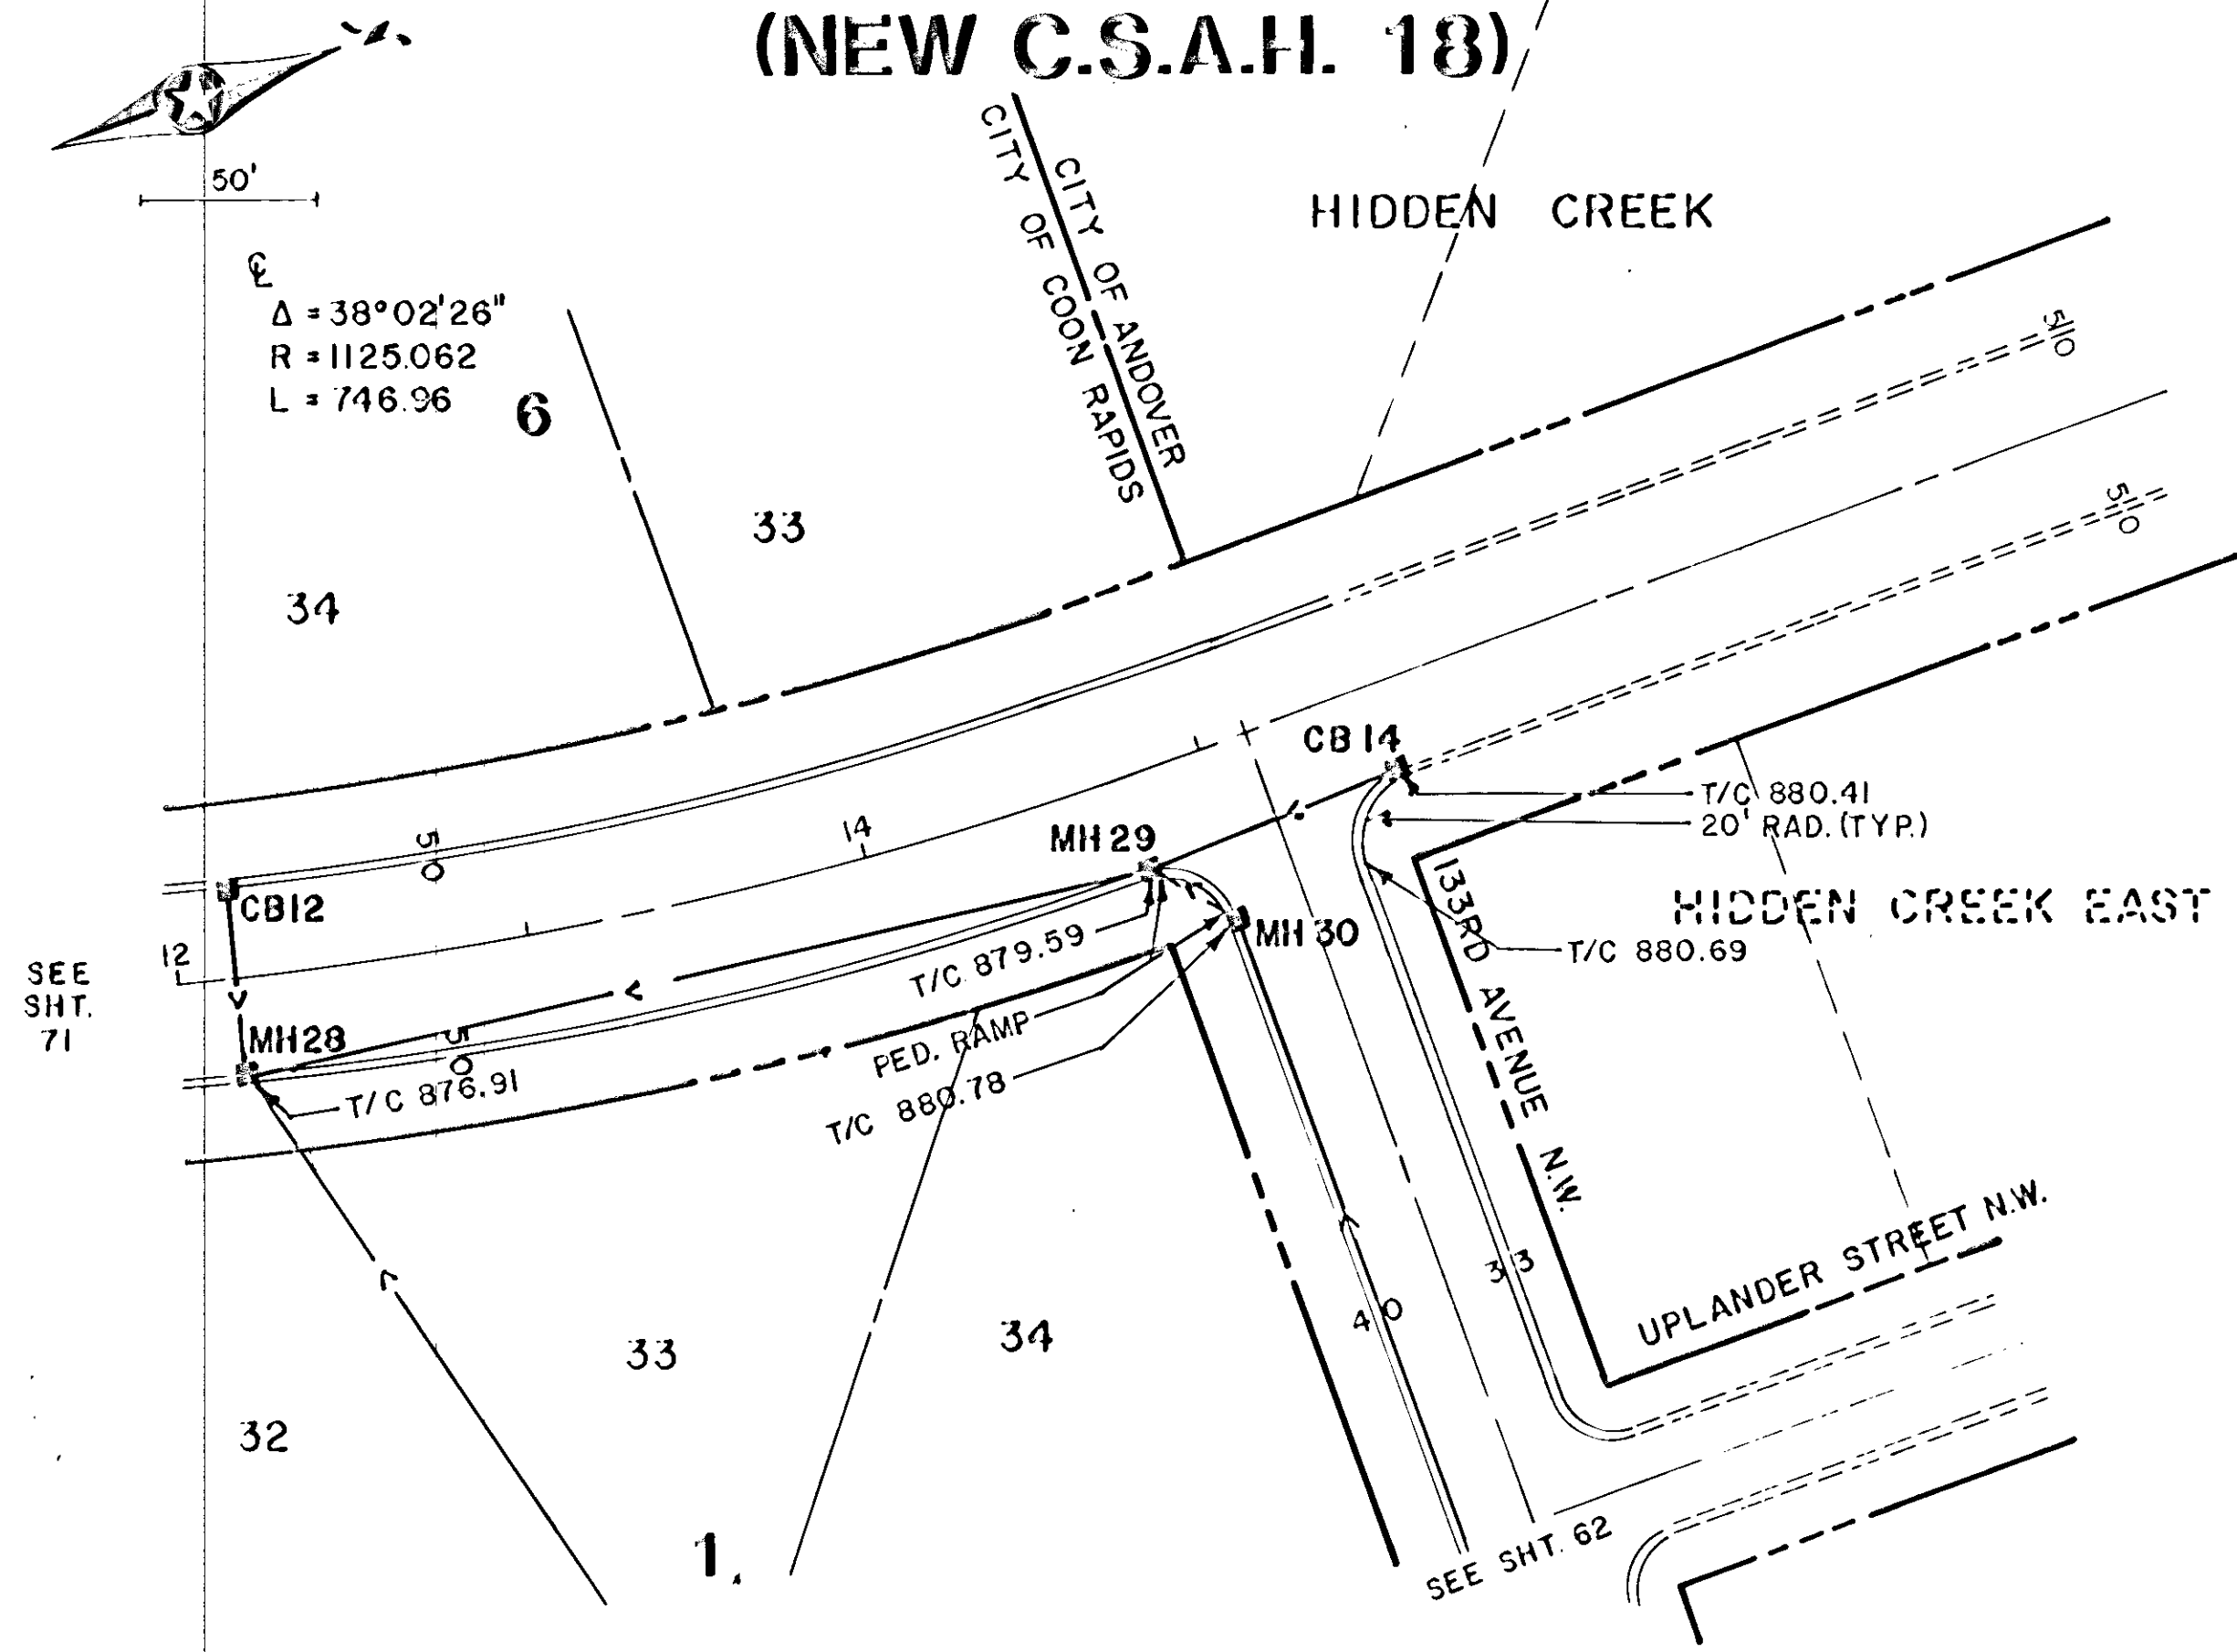

AS-BUILT NOTE:
ELEVATION AND TOPO HAS NOT BEEN
RESHOT AFTER CONSTRUCTION AND
ACCORDINGLY MAY BE ONLY APPROXIMATE

I hereby certify that this plan, specification or report was prepared by me or under my direct supervision and that I am a duly Registered Professional Engineer under the State of Minn. Statutes Sections 326.02 to 326.16.


Tony H. Heunen
Date 9/9/86 Minn. Reg. No. 12699

LIBBY
DESIGN BY: DRV, TLH
DRAWN BY: P.M.J.

ORIGINAL DATE 9/9/86
REVISIONS
By: *Grady & Allan*
Date: 4/15/87

SUBJECT NO. 8187, 881, 8194


CITY OF COON RAPIDS
IMPROVEMENT PROJECT 86-38
OAKS OF SHENANDOAH
14TH & 15TH ADDITION
VERDIN ST. (NEW C.S.A.H. 18)
STREET/STORM

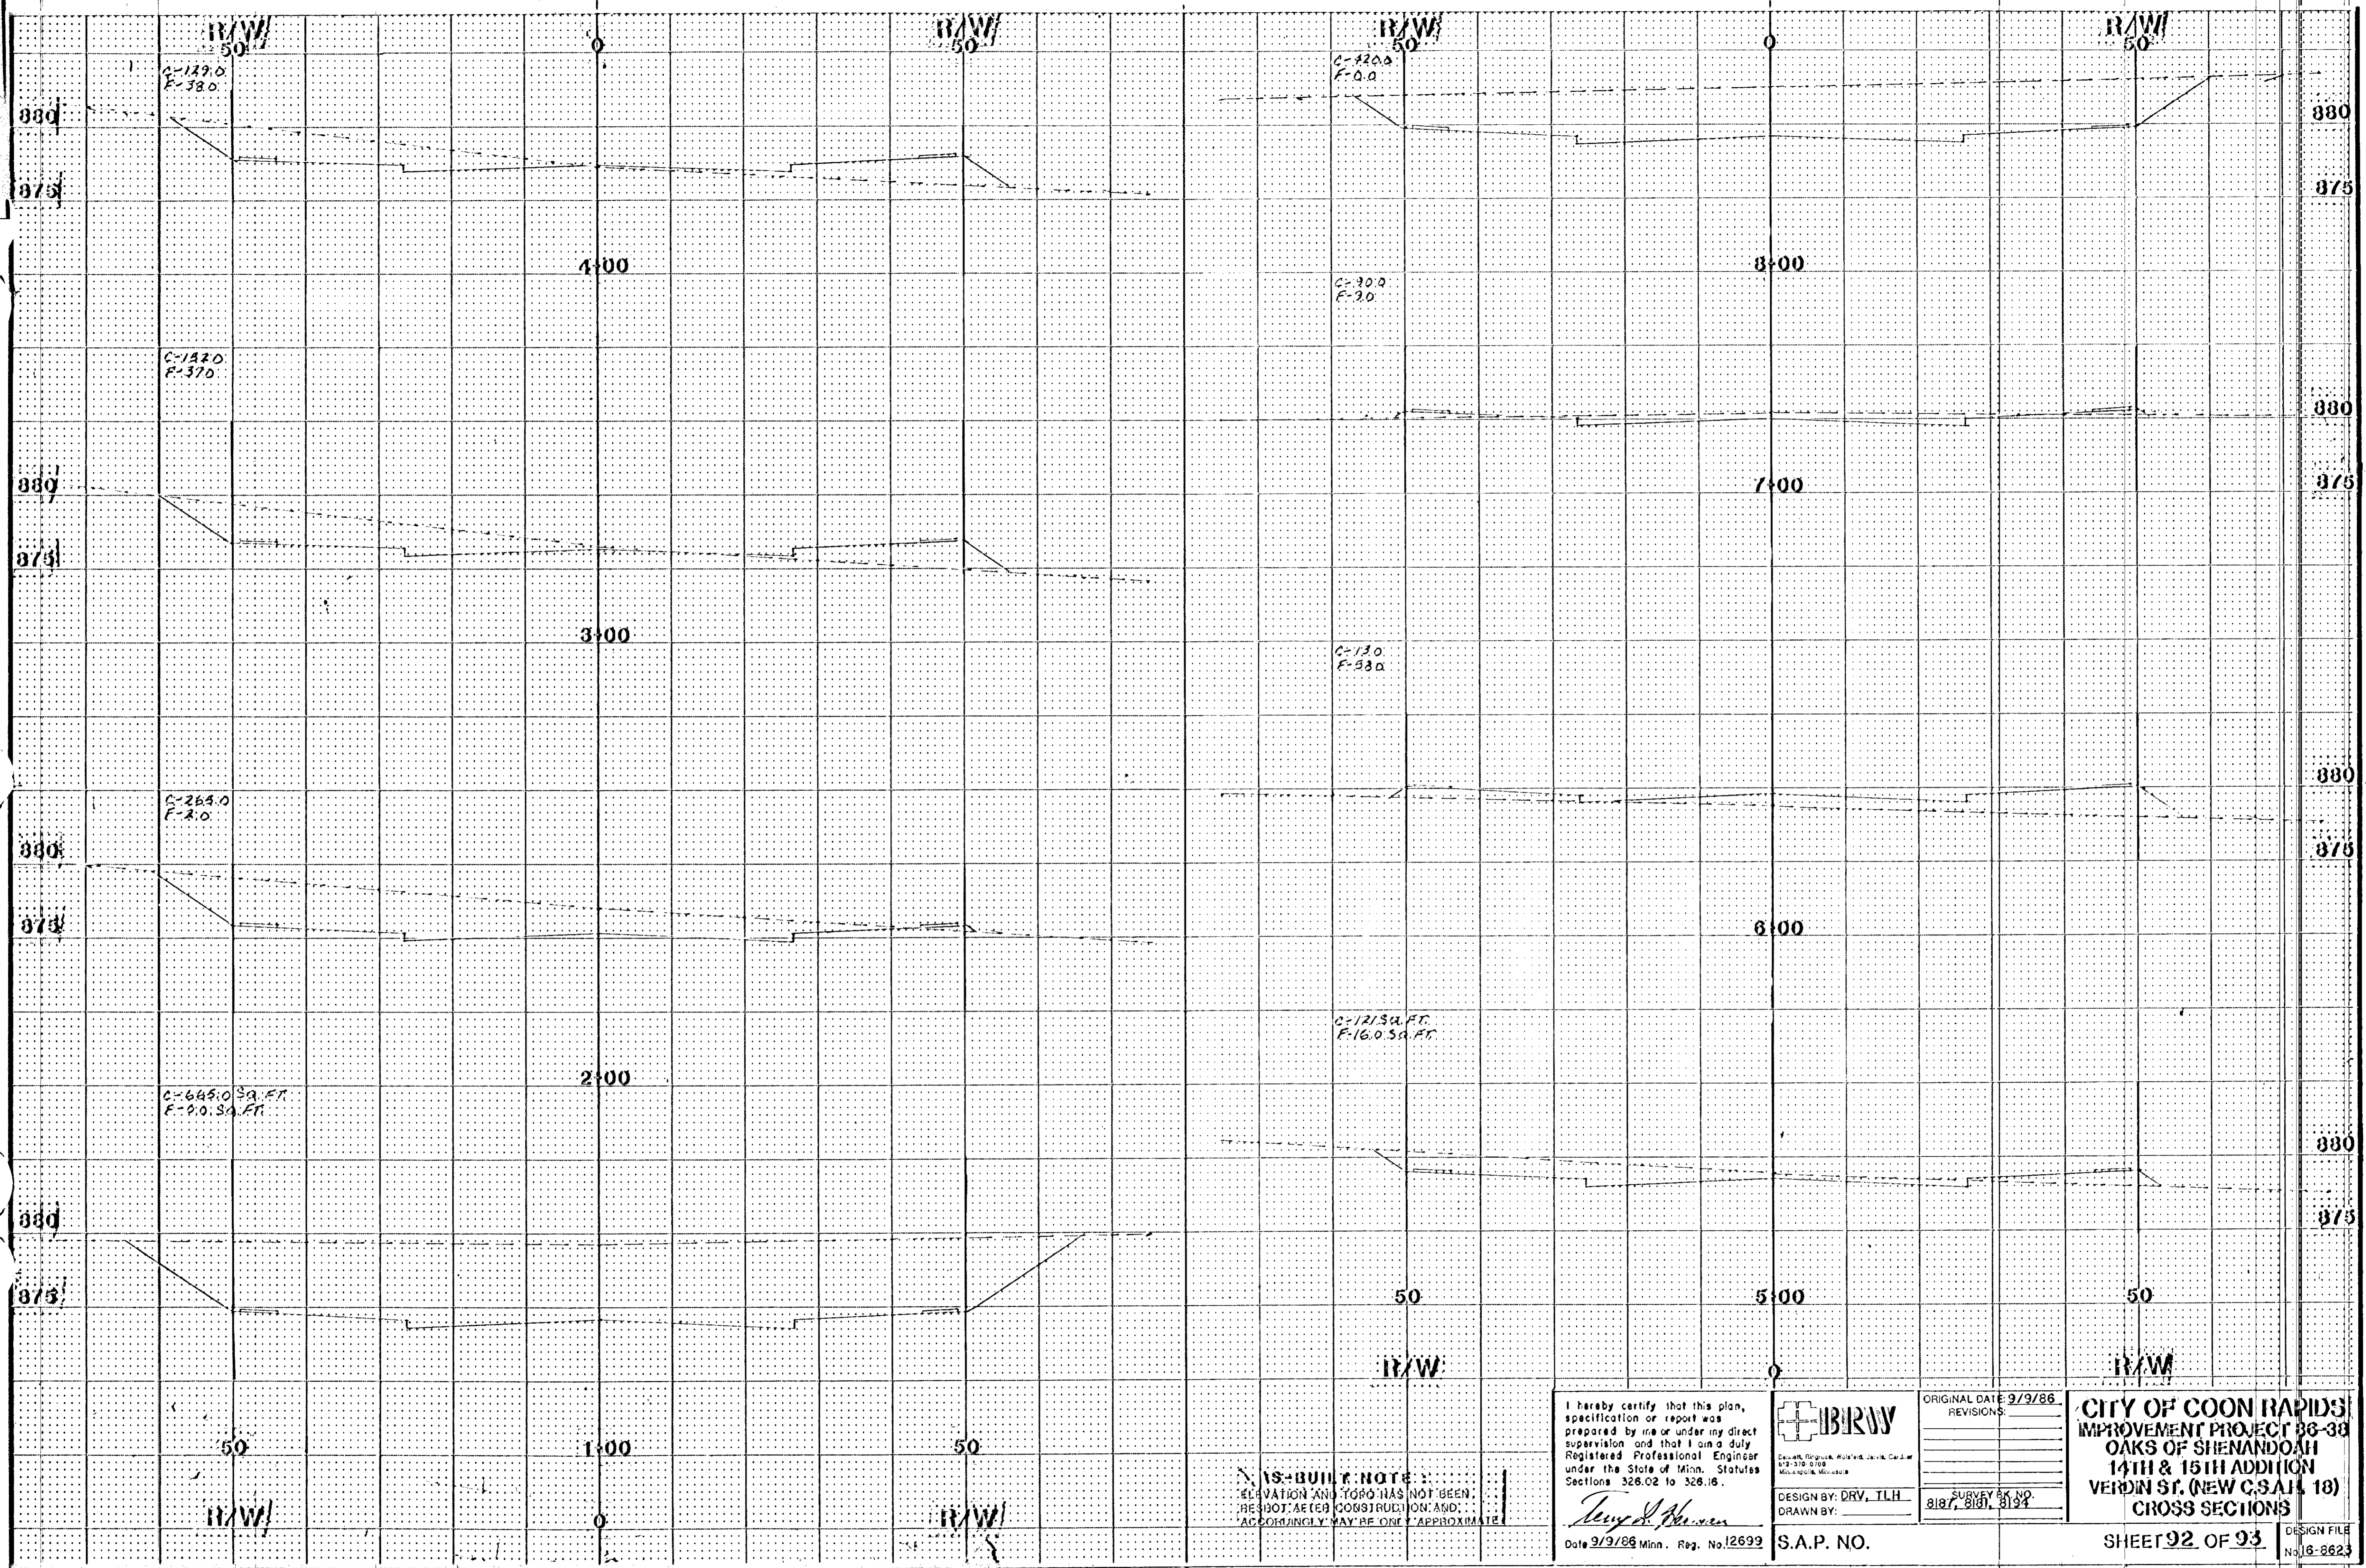

AS-BUILT NOTE:
 ELEVATION AND TORSO HAS NOT BEEN
 REBUILT AFTER CONSTRUCTION AND
 ACCURACIALLY MAY BE ONLY APPROXIMATE

I hereby certify that this plan, specification or report was prepared by me or under my direct supervision and that I am a duly Registered Professional Engineer under the State of Minn. Statutes Sections 326.02 to 326.16.

Henry J. Peterson
 Date 9/9/86 Minn. Reg. No. 12699

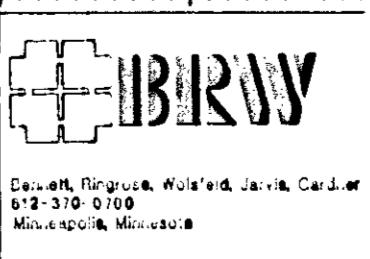

DESIGN BY: DRV, TLH
 DRAWN BY:

ORIGINAL DATE: 9/9/86
 REVISIONS:
 SURVEY BY NO:
 8187, 8188, 8194

CITY OF COON RAPIDS
 IMPROVEMENT PROJECT 88-38
 OAKS OF SHENANDOAH
 14TH & 15TH ADDITION
 VERDIN ST. (NEW C.S.A.H. 18)
 CROSS SECTIONS

