
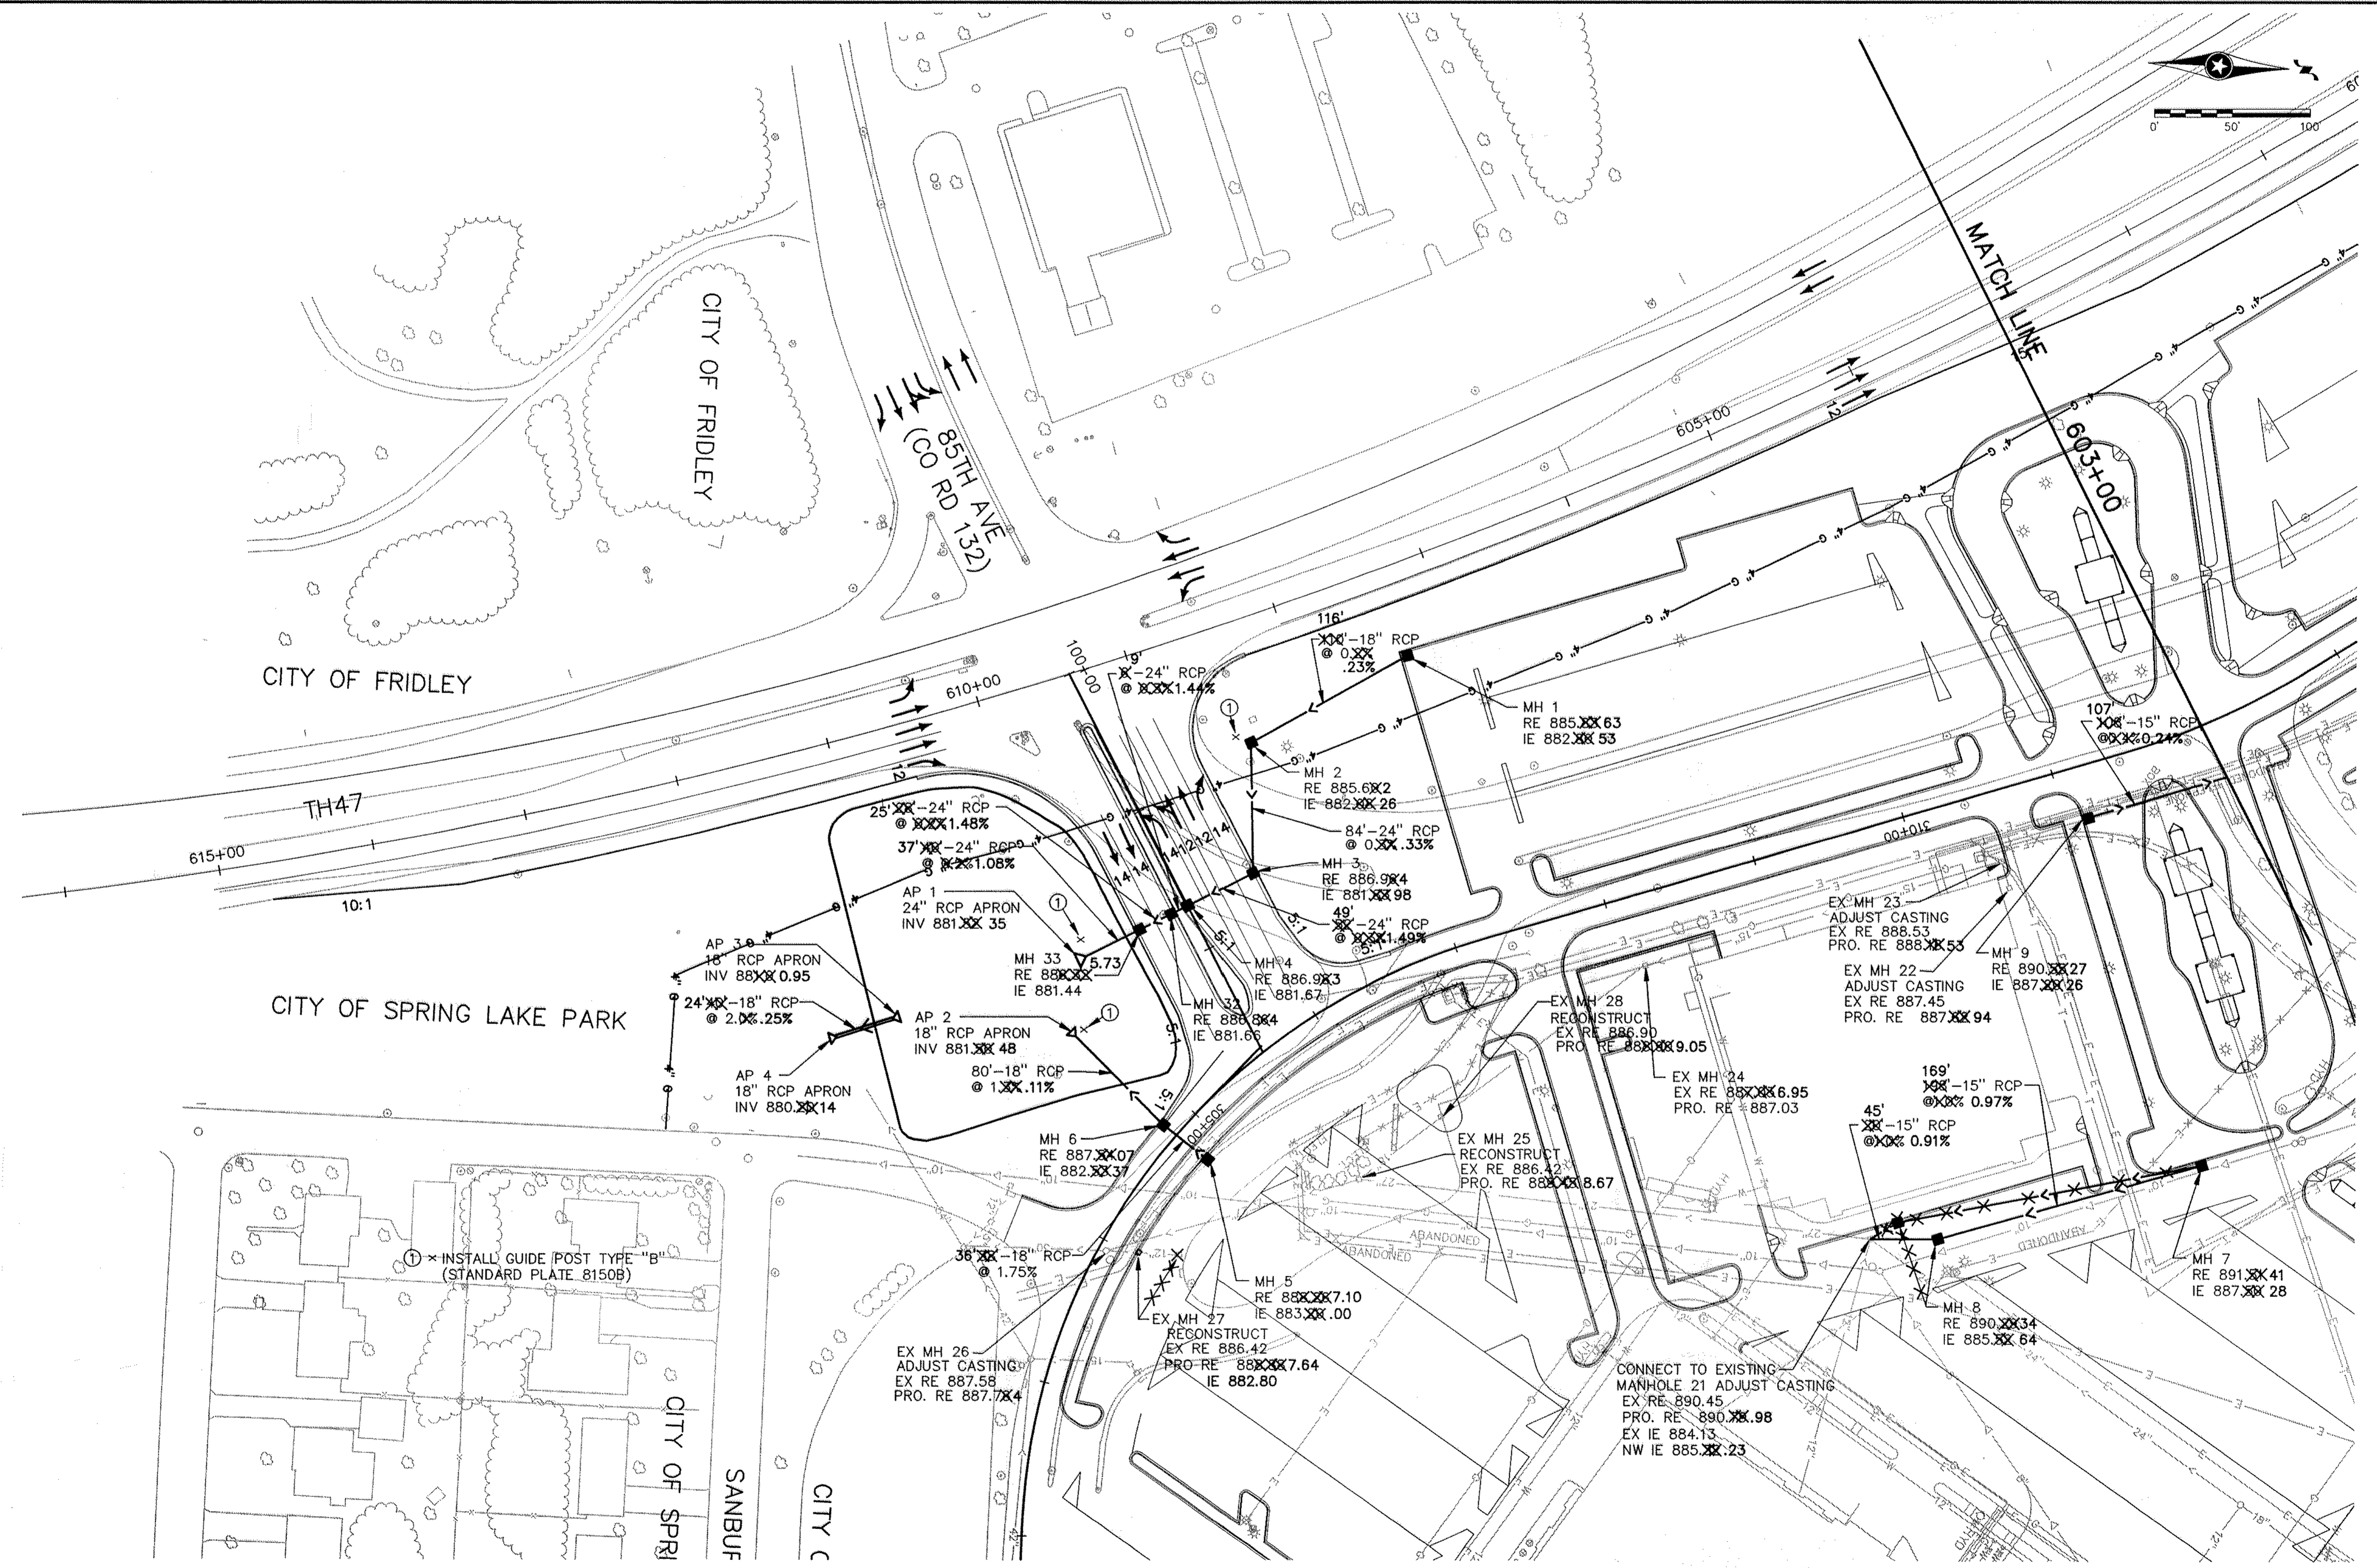


DRAWING NAME: DRAIN.DWG PLOT DATE: 1-17-97 (AS BUILT)

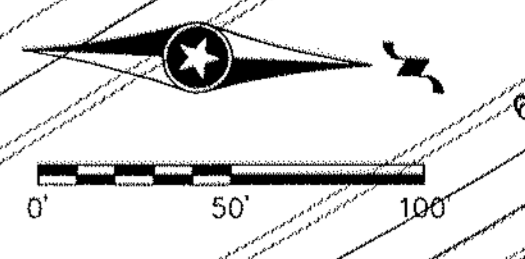

INSTALL GUIDE POST TYPE "B" (STANDARD PLATE 8150B)

REVISION NO.	AS NOTED	SCALE	AS NOTED	EXPLANATION
DATE	DESIGN BY:	PLAN BY:	CHECKED BY:	AS BUILT
01-07-97	JMB	JMB	JMB	
	TJC			
	COMING:			
	CHECKED BY:	RECORD COPY BY:	DATE	
			10-14-94	

I HEREBY CERTIFY THAT THIS PLAN, SPECIFICATION OR REPORT WAS MADE BY ME OR UNDER MY DIRECT SUPERVISION AND THAT I AM A DULY REGISTERED PROFESSIONAL ENGINEER UNDER THE LAWS OF THE STATE OF MINNESOTA.

DATE: Feb 7, 1997 REG. NO. 10453

BRW
 PLANNING • TRANSPORTATION • ENGINEERING • URBAN DESIGN
 Treacher Square, 700 Third Street South, Minneapolis, MN 55415