


DRAWING NAME: DRNPRO.DWG PLOT DATE: 1-15-97 (AS BUILT)

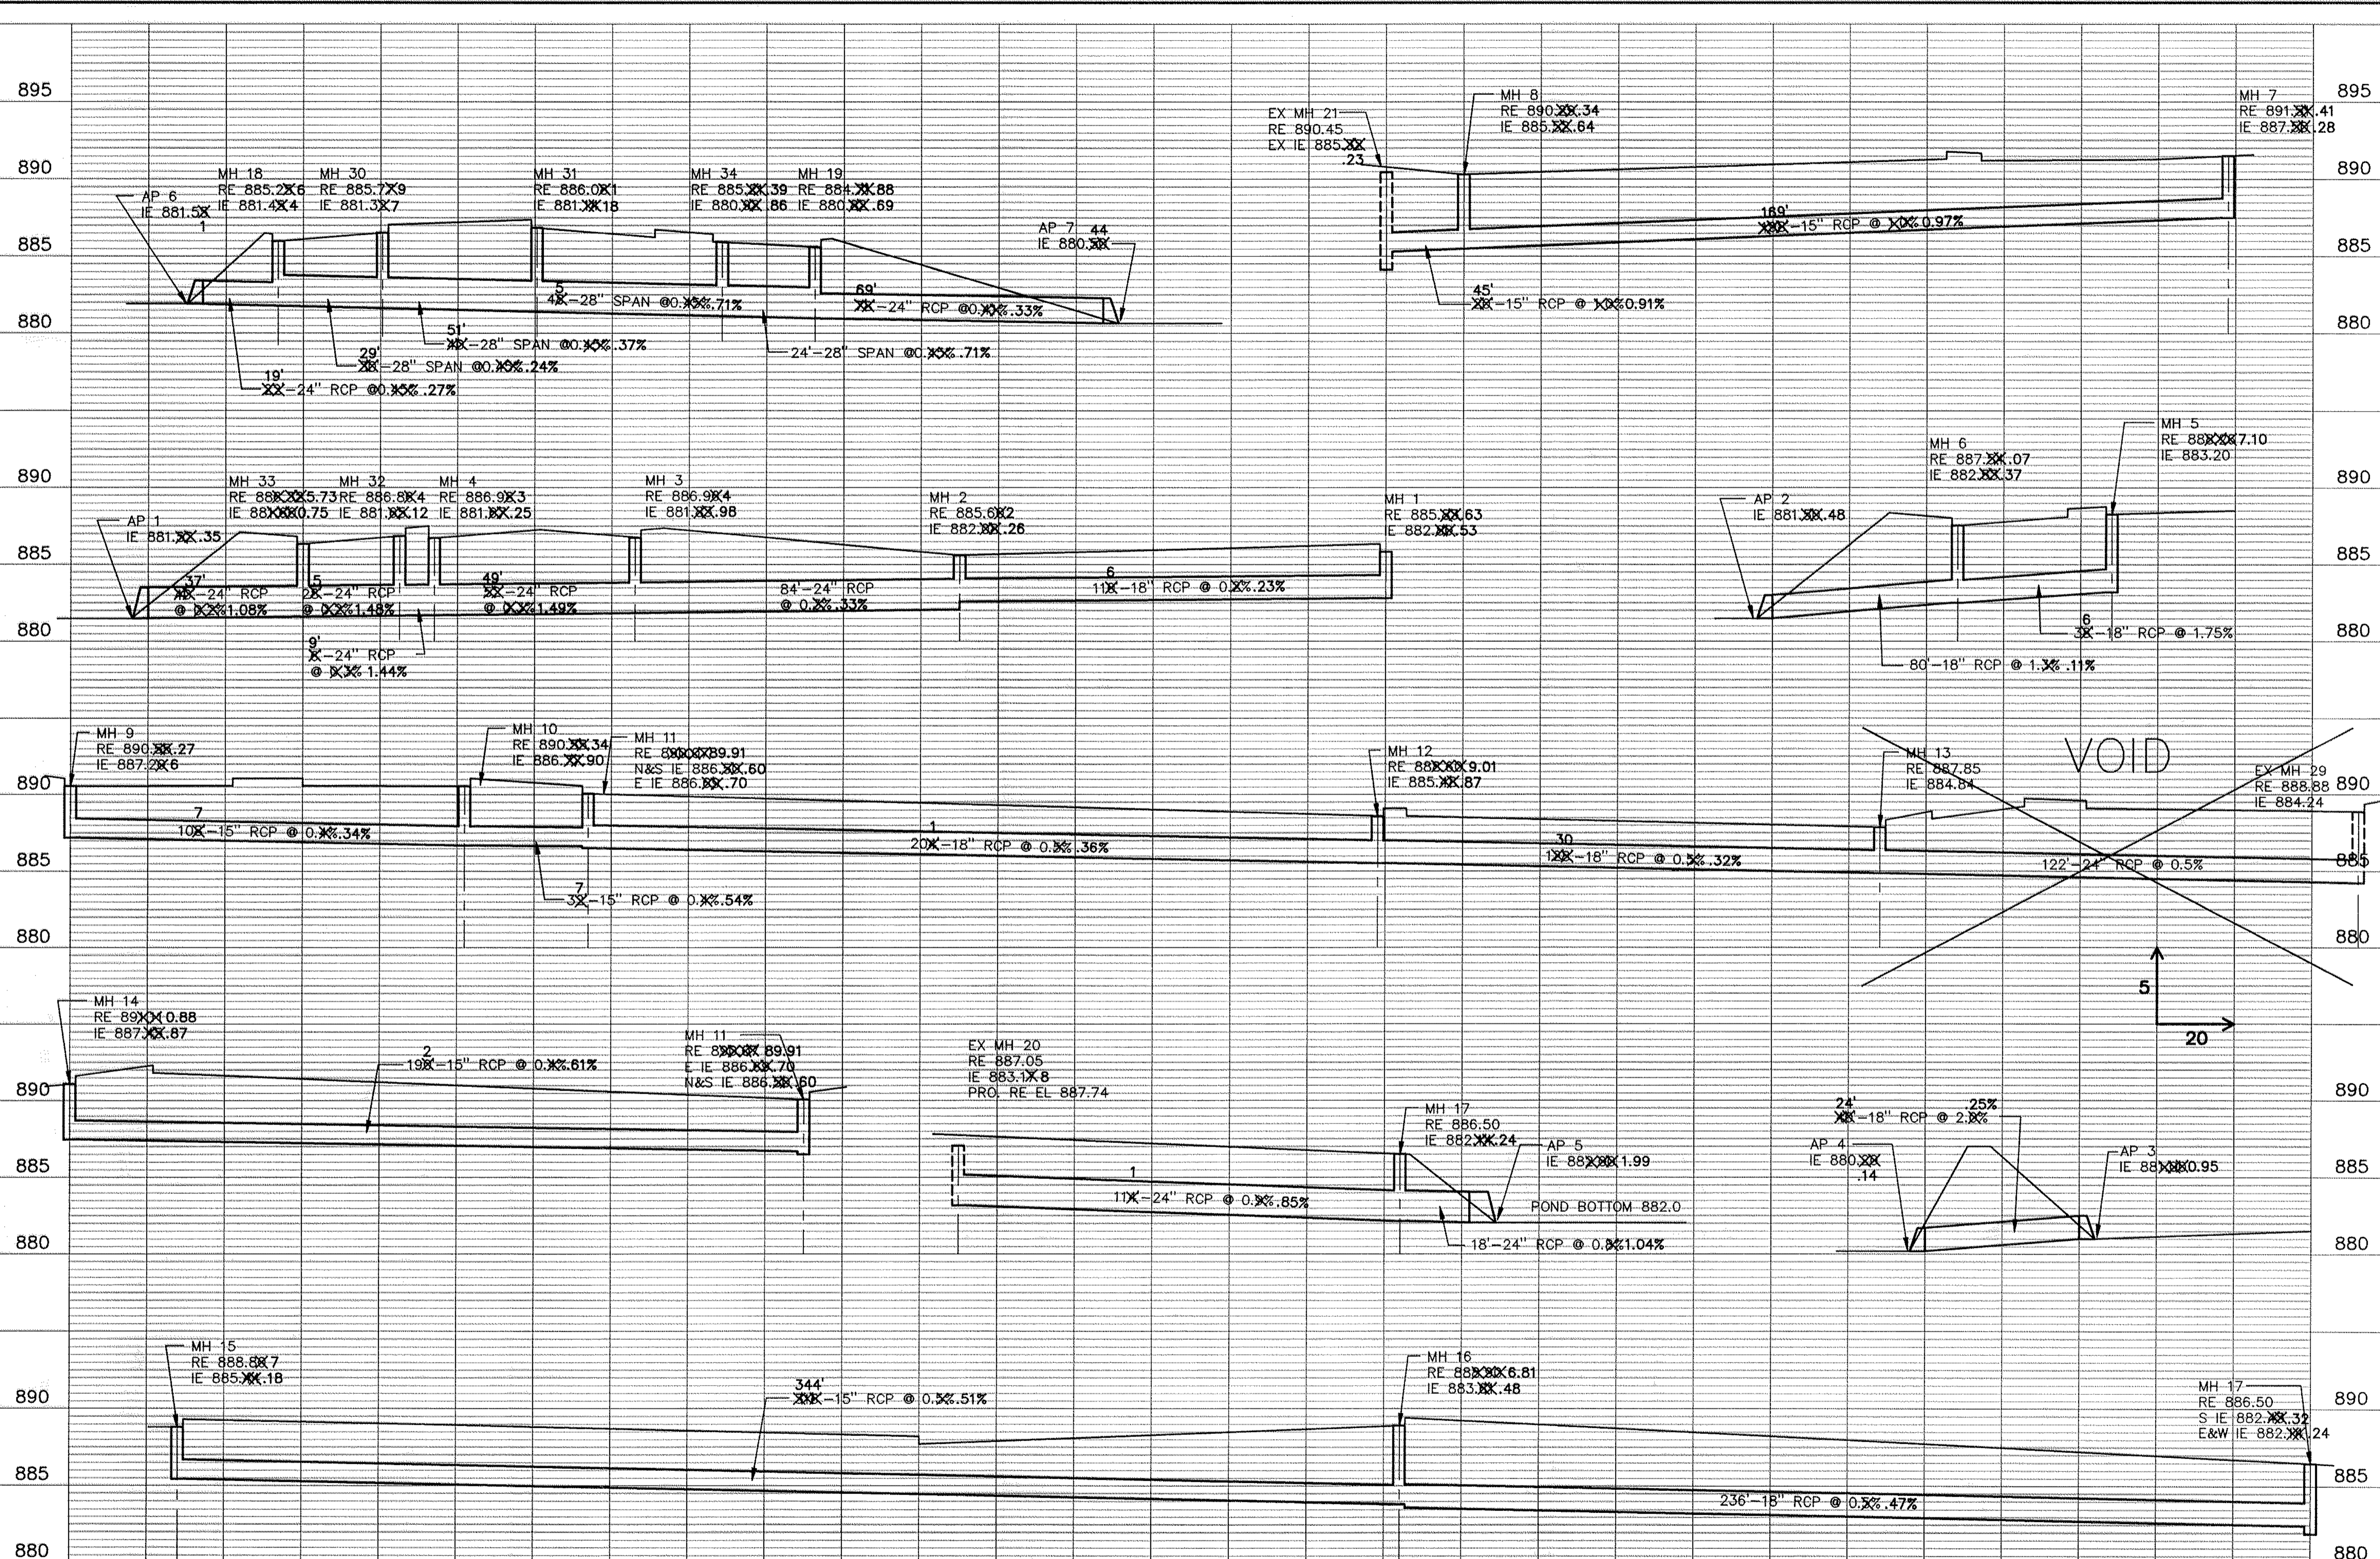

REVISION NO.	AS BUILT	EXPLANATION
DATE	01-09-97	
SCALE	AS NOTED	
PLAN BY	JMB	DESIGN BY
CHECKED BY	JMB	TUG
COMING		
RECORD COPY BY		DATE
		10-14-94
I HEREBY CERTIFY THAT THIS PLAN, SPECIFICATION OR REPORT WAS MADE BY ME OR UNDER MY DIRECT SUPERVISION AND THAT I AM A DULY REGISTERED PROFESSIONAL ENGINEER UNDER THE LAWS OF THE STATE OF MINNESOTA. <i>Dawn P. O'Neil</i> DATE Feb 07, 1997 REG. NO. 10453		
BRW PLANNING • TRANSPORTATION • ENGINEERING • URBAN DESIGN <small>Thresher Square, 700 Third Street South, Mpls., MN 55415</small>		