


DRAWING NAME: SIGN2.DWG PLOT DATE: 1-20-97

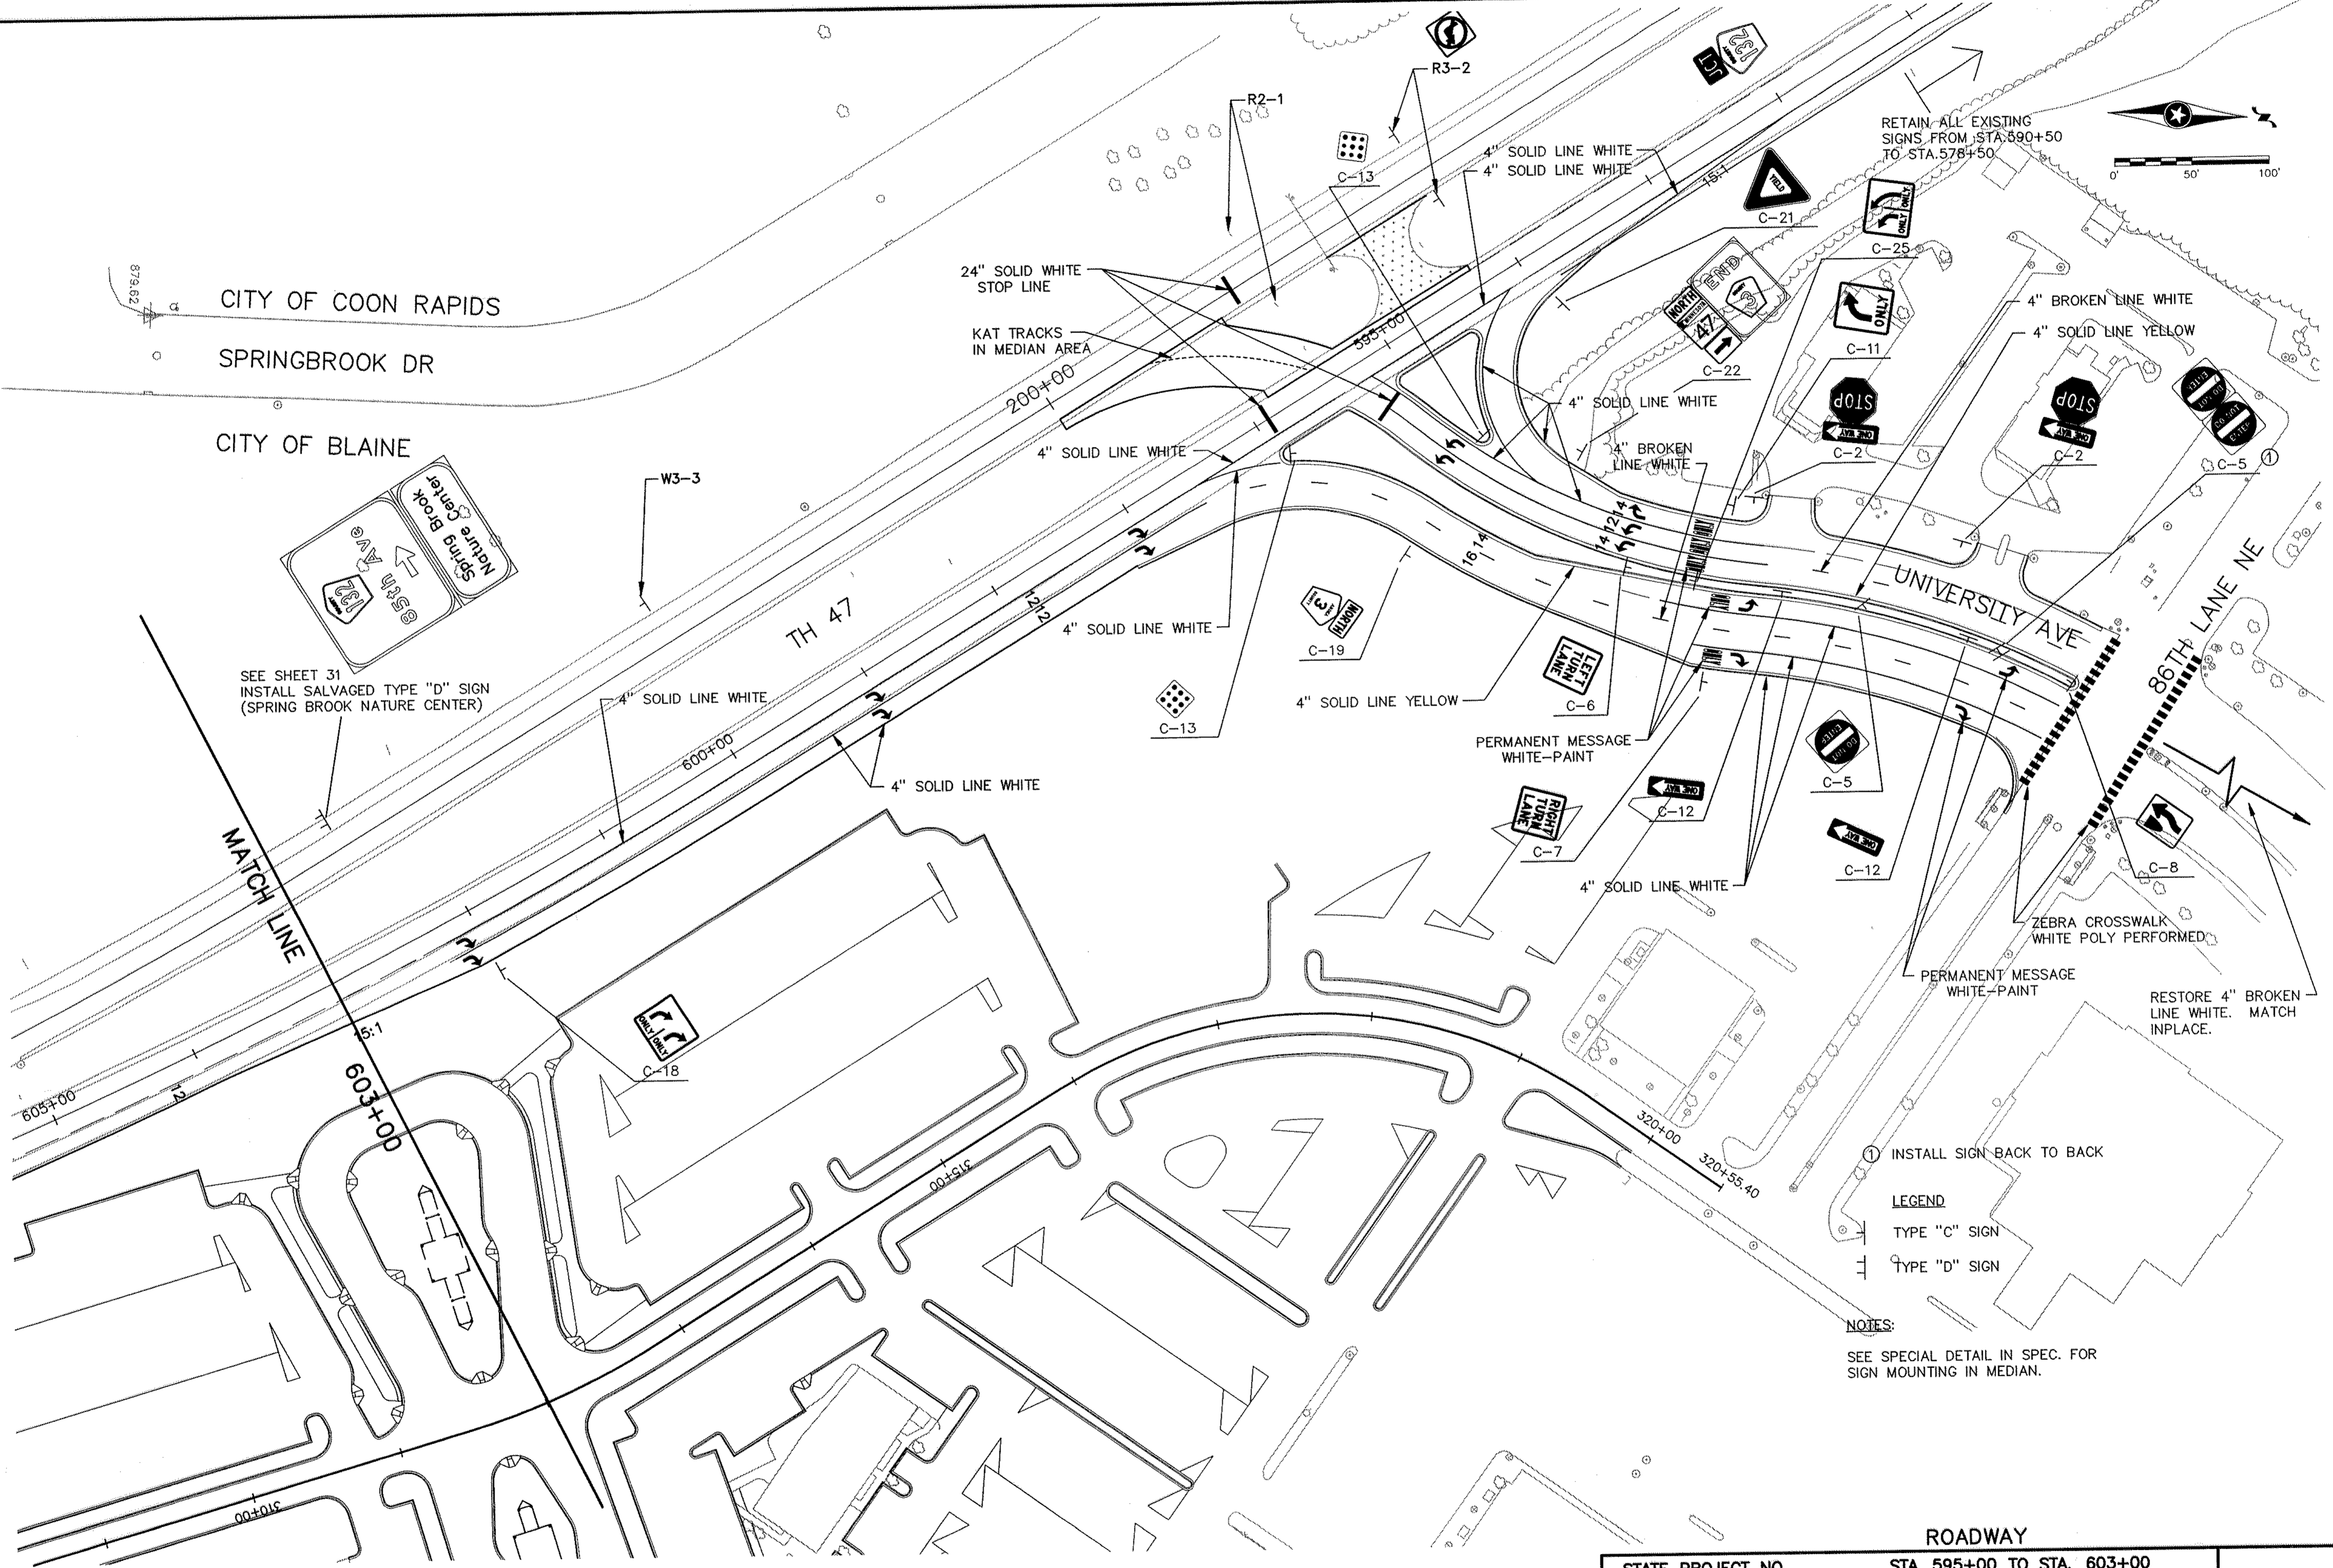

CITY OF COON RAPIDS
 SPRINGBROOK DR

CITY OF BLAINE

SEE SHEET 31
 INSTALL SALVAGED TYPE "D" SIGN
 (SPRING BROOK NATURE CENTER)

RETAIN ALL EXISTING
 SIGNS FROM STA. 590+50
 TO STA. 578+50

UNIVERSITY AVE

86TH LANE NE

PERMANENT MESSAGE
 WHITE-PAINT

RESTORE 4" BROKEN
 LINE WHITE. MATCH
 INPLACE.

- ① INSTALL SIGN BACK TO BACK
- LEGEND
 ○ TYPE "C" SIGN
 □ TYPE "D" SIGN

NOTES:
 SEE SPECIAL DETAIL IN SPEC. FOR
 SIGN MOUNTING IN MEDIAN.

ROADWAY

STATE PROJECT NO.
 02-600-11

STA. 595+00 TO STA. 603+00
 PERMANENT SIGNING AND STRIPING

SHEET 94 OF 140 SHEETS

EXPLANATION	REVISION NO.	DATE
AS BUILT	01-14-97	
SCALE: AS NOTED	DESIGN BY:	DATE
PLAN BY: JMB	TUG	10-14-94
CHECKED BY: COMMING		
RECORD COPY BY:		
I HEREBY CERTIFY THAT THIS PLAN, SPECIFICATION OR REPORT WAS MADE BY ME OR UNDER MY DIRECT SUPERVISION AND THAT I AM A REGISTERED PROFESSIONAL ENGINEER UNDER THE LAWS OF THE STATE OF MINNESOTA.		
DATE: Feb 1997 REC. NO. 10453		

BRW
 TRANSPORTATION • ENGINEERING • URBAN DESIGN
 Threehr Square, 700 Third Street South, Minneapolis, MN 55415