

MINNESOTA DEPARTMENT OF TRANSPORTATION

CONSTRUCTION PLAN FOR GRADING, BITUMINOUS, CONC. C.&G., STORM SEWER, CHANNELIZATION, & SIGNALS

LOCATED ON OSBORNE ROAD, CSAH. 8 FROM E. RIVER ROAD, CSAH. 1 TO COMMERCE LANE
 LOCATED ON EAST RIVER ROAD, CSAH. 1 FROM LOGAN PARKWAY TO CRAIG WAY NE.
 STATE PROJ. NO. 02-608-07 STATE PROJ. NO. 02-601-33
 MINN. PROJ. NO. _____ MINN. PROJ. NO. _____

GROSS LENGTH 1,675.00 FEET 0.317 MILES
 BRIDGES-LENGTH _____ FEET _____ MILES
 EXCEPTIONS-LENGTH _____ FEET _____ MILES
 NET LENGTH 1,675.00 FEET 0.317 MILES
 MILE POINT _____ NA. TO MILE POINT _____ NA.



GROSS LENGTH 2,737.46 FEET 0.518 MILES
 BRIDGES-LENGTH _____ FEET _____ MILES
 EXCEPTIONS-LENGTH _____ FEET _____ MILES
 NET LENGTH 2,737.46 FEET 0.518 MILES
 MILE POINT _____ NA. TO MILE POINT _____ NA.

MINN. PROJ. NO. CRP 0088 (056) CRP 0088(057)
 MINN. PROJ. NO. M 5110 (002) M 5007 (011)

GOVERNING SPECIFICATIONS
 THE 1983 EDITION OF THE MINNESOTA DEPARTMENT OF TRANSPORTATION "STANDARD SPECIFICATION FOR CONSTRUCTION"

INDEX

SHEET NO. 1	TITLE SHEET & LAYOUT MAP
" NO. 2	ESTIMATED QUAN. & SPECIAL DETAILS
" NO. 3	STANDARD PLATES & DRIVEWAY CONST. DETAILS
" NO. 4-5	TYPICAL SECTIONS
" NO. 6-7	MISC. QUAN., CHARTS & CONST. DETAILS
" NO. 8	STORM SEWER CHART
" NO. 9	ALIGN. INFO.
" NO. 10-11	OSBORNE PLAN & PROFILE
" NO. 12-14	E.R.R. PLAN & PROFILE
" NO. 15-16	OSBORNE R/W PLAN
" NO. 17-19	E.R.R. R/W PLAN
" NO. 20	75 TH. WAY CUL-DE-SAC CONST.
" NO. 21-22	RETENTION POND CONST. DETAILS - CITY OF FRID.
" NO. 23	SUPERELEVATION
" NO. 24-26	OSBORNE X-SECTIONS
" NO. 27-33	E.R.R. X-SECTIONS
" NO. 34-37	PERMANENT SIGNING & STRIPING
" NO. 38-53	TRAFFIC CONTROL PLAN - PHASE I, II & III
" NO. 54-55	TRAFFIC CONTROL PLAN - PHASE IV
" NO. 56-58	SIGNAL PLAN

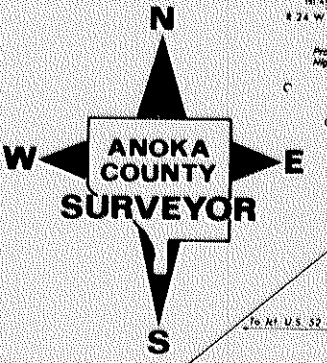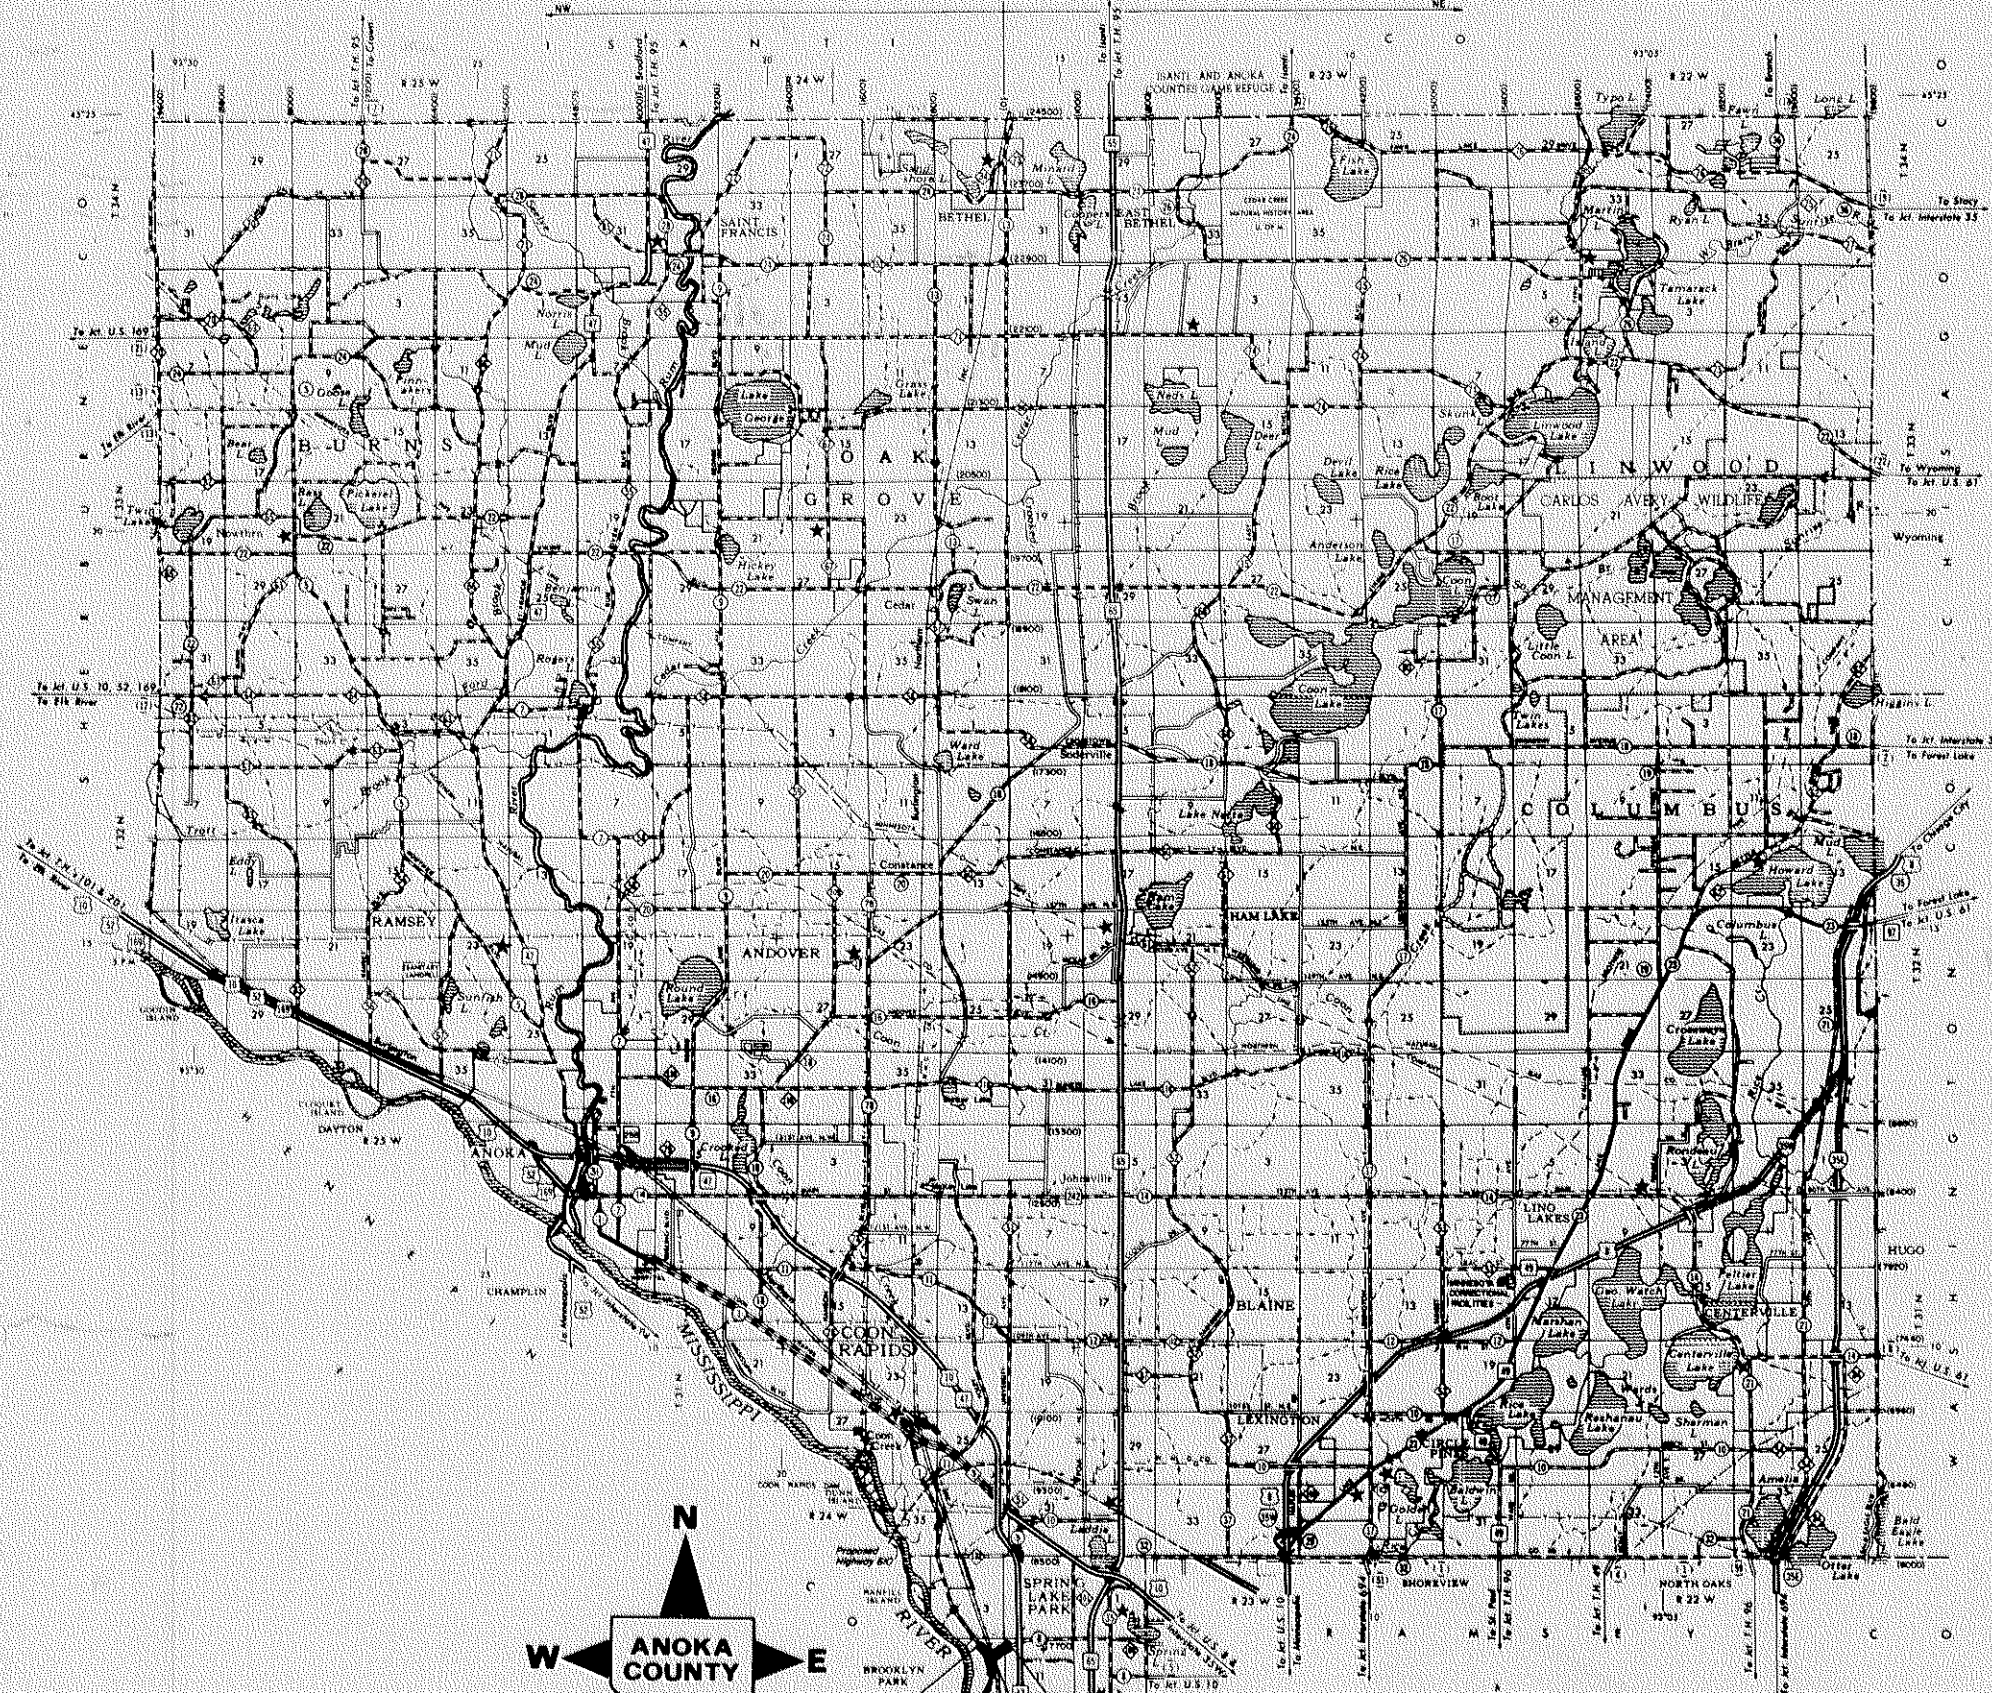

GENERAL HIGHWAY MAP
ANOKA COUNTY
 MINNESOTA

SCALE

INDEX MAP	2.68 MI.
PLAN & PROFILE	HORIZ. 50'
	VERT. 5'
CROSS SECTIONS	10'
SIGNAL	30'

END PROJECT SP 02-601-33
 STA. 118+95.00

S.B. POT. 105+46.35 =
 S.B. POT. 105+64.57

OR POT. 105+57.03 =
 OR POT. 105+64.57

N.B. POT. 105+67.60 =
 N.B. POT. 105+64.57

BEGIN PROJECT SP 02-601-33
 STA. 91+50.00


END PROJECT SP 02-608-07
 STA. 215+95.00

OR PT. 218+17.70 =
 SURV. POT. 218+21.79

BEGIN PROJECT SP 02-608-07
 STA. 199+20.00

DESIGN DATA

Functional Classification	MINOR ARTERIAL	No. of Parking Lanes	0
No. of Traffic Lanes	4	Ton Design	9
ADT (Current Year)	#1 - 25,700 #8 - 6,800	Shoulder Width	#1 - 8' #8 - 0'
ADT (Future Year)	#1 - 41,120 #8 - 10,880	Design Speed	#8 - 35 MPH
DHV (Design Hr. Vol.)	_____	Based on	STOPPING
D (Directional Distr.)	_____ %	Sight Distance	_____
T (Heavy Commercial)	#1 - 1,100 #8 - 1,100	Height of eye	3.50'
Soil Factor	A-3, 50%	Height of object	0.50'
		Design Speed not achieved at:	
		STA. _____ TO STA. _____	MPH _____
		STA. _____ TO STA. _____	MPH _____

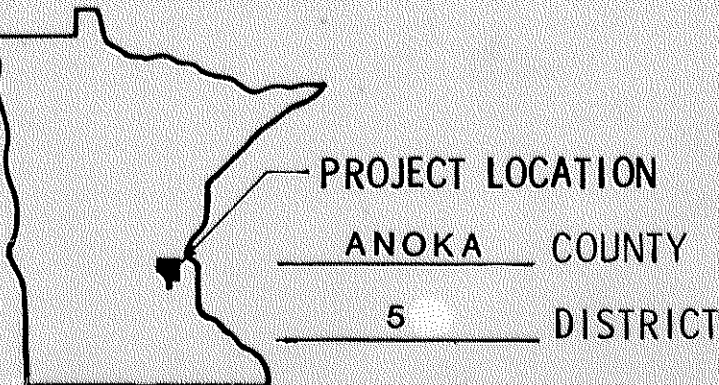

S.P. 127-332-02 (M.S.A.S. 332)
 SIGNAL SYSTEM AT
 CSAH 1 AND CSAH 8

I HEREBY CERTIFY THAT THIS PLAN WAS PREPARED BY ME OR UNDER MY DIRECT SUPERVISION AND THAT I AM A DULY REGISTERED PROFESSIONAL ENGINEER UNDER THE LAWS OF THE STATE OF MINNESOTA.
 DATE Feb. 15, 1988 REG. NO. 6549 ENGR. Eric K. Lund
 COUNTY ENGINEER

DESIGN SQUAD _____

Recommended for Approval CEW Wipfelbaum 7/15/88
 DISTRICT STATE AID ENGINEER

Recommended for Approval Julio Skallman 6/30/88
 STATE AID PLANS & SPECIFICATIONS ENGINEER

Approved 6/20/88 Justin M. Yon
 STATE AID ENGINEER

DEPARTMENT OF TRANSPORTATION
 FEDERAL HIGHWAY ADMINISTRATION
APPROVED
 DIVISION ADMINISTRATOR _____ DATE _____

I HEREBY CERTIFY THAT THE FINAL FIELD REVISIONS, IF ANY, OF THIS PLAN WERE MADE BY ME OR UNDER MY DIRECT SUPERVISION AND THAT I AM A DULY REGISTERED PROFESSIONAL ENGINEER UNDER THE LAWS OF THE STATE OF MINNESOTA.

DATE _____ REG. NO. _____

STATE AID PROJ. NO. _____ COUNTY PROJ. NO. _____
 STATE PROJ. NO. 02-608-07 02-601-33 & 127-332-02 SHEET NO. 1 OF 58 SHEETS

STATEMENT OF ESTIMATED QUANTITIES

ITEM NO.	ITEM	UNIT	SP 02-601-33		SP 02-608-07		NON-PARTICIPATING	STORM S. TOTAL PART.	TOTAL EST. QUAN.	TOTAL FINAL QUAN.
			EST.	FINAL	EST.	FINAL				
2021.501	MOBILIZATION	LUMP SUM	0.5	0.5						
2031.501	FIELD OFFICE TYPE-D	EACH	0.5	0.5						
19	2101.501	CLEARING					0.1	62		
	2101.502	CLEARING	52	10				0.9		
19	2101.506	GRUBBING					0.1	0.9		
	2101.507	GRUBBING	39	9				48		
	2104.501	REMOVE CURB & GUTTER	470	45				515		
	2104.501	REMOVE SEWER PIPE (STORM)	528	56				584		
	2104.501	REMOVE FENCE	306					306		
1	2104.505	REMOVE BITUMINOUS PAVEMENT	30					30		
	2104.505	REMOVE CONCRETE PAVEMENT	45					45		
	2104.505	REMOVE TRENCH PAVEMENT	11					11		
	2104.509	REMOVE MANHOLES OR CATCH BASINS	10					10		
	2104.511	SAVING CONCRETE PAVEMENT	24					24		
	2104.513	SAVING BITUMINOUS PAVEMENT	931	1263				2194		
	2104.521	SALVAGE WOODEN FENCE	386					386		
	2104.523	SALVAGE CASTINGS	6	3				9		
	2104.523	SALVAGE CONCRETE APRONS	1					1		
	2104.521	SALVAGE WOVEN WIRE FENCE	71					71		
15	2105.501	COMMON EXCAVATION	20200 (P)	3310 (P)			569 (P)	24079 (P)		
15	2105.525	TOPSOIL BORROW (LV)	767	376			62	1205		
2	2130.501	WATER	M-GALLONS	50	50			100		
3	2211.503	AGGREGATE BASE PLACED CLASS SA	CU.YD.	3459 (P)	733 (P)			4192 (P)		
	2301.501	CONCRETE PAVEMENT	SQ YD	637 (P)				637 (P)		
	2301.511	STRUCTURAL CONCRETE	CU YD	77 (P)				77 (P)		
4	2301.529	REINFORCEMENT BARS	POUND	2193				2193		
5	2301.536	DOWEL BAR ASSEMBLIES	LN FT	64				64		
5	2301.513	STRUCTURAL CONCRETE HE	CU YD	64 (P)				64 (P)		
	2331.504	BITUMINOUS MATERIAL FOR MIXTURE	TON	380	135			515		
	2331.510	BINDER COURSE MIXTURE	TON	2400	1035			3435		
	2331.512	LEVELING COURSE MIXTURE	TON	375				375		
	2331.514	BASE COURSE MIXTURE	TON	4765	1132			5897		
7	2331.531	TEMPORARY LANE MARKING	RD. STA.	484	182			666		
9	0331.601	2" THICK BIT WEARING COURSE MIXTURE	SQ.YD.	252	1410			1662		
14	2231.501	BITUMINOUS PATCHING MIXTURE	TON	71	20			91		
	2341.504	BITUMINOUS MATERIAL FOR MIXTURE	TON	118	58			176		
10	2341.508	WEARING COURSE MIXTURE	TON	1820	885			2705		
	2357.502	BITUMINOUS MATERIAL FOR TACK COAT	GALLON	3230	1400			4630		
	2503.511	60" RC PIPE SEWER CL IV	LN.FT.	78				78		
	2503.541	12" RC PIPE SEWER DES 3006 CL III	LN.FT.	177	153			340		
	2503.541	15" RC PIPE SEWER DES 3006	LN.FT.	349	396			745		
	2503.541	15" RC PIPE SEWER DES 3006 CL III	LN.FT.	784	153			937		
	2503.541	21" RC PIPE SEWER DES 3006	LN.FT.	117				117		
	2503.573	INSTALL CONCRETE APRON	EACH	1				1		
	0504.602	RELOCATE HYDRANT	EACH	5				5		
	0504.602	ADJUST VALVE BOX-WATER	EACH	8	4			12		
11	2506.506	CONSTRUCT MANHOLES DESIGN A DR F	LN FT	9.1				9.1	9.1	
	2506.506	CONSTRUCT MANHOLES DESIGN C DR G	LN FT	5.3	4.7			10	10	
11	2506.506	CONSTRUCT MANHOLES DESIGN B-4019	LN FT	13.3				13.3	13.3	
	2506.507	CONSTRUCT CATCH BASINS DESIGN A DR F	LN FT	18.9				18.9	18.9	
11	2506.507	CONSTRUCT CATCH BASINS DESIGN C DR G	LN FT	81.1	29.9			111	111	
	2506.507	CONSTRUCT CATCH BASINS DESIGN H	LN FT	7.2				7.2	7.2	
	2506.511	RECONSTRUCT MANHOLES	LN FT	5.5				5.5	5.5	
	2506.516	CASTING ASSEMBLIES	EACH	21	8			29	29	
	2506.521	INSTALL CASTINGS	EACH	1	2			3	3	
	2506.522	ADJUST FRAME AND RING CASTINGS	EACH	16	2			18	18	
	0506.602	CONSTRUCT CONTROL STRUCTURE A	EACH					1	1	
20	2511.507	GRADED RIPRAP	CU YD	37				37	37	
	2521.501	4" CONCRETE WALK	SQ FT	1915				1915		
	2521.501	6" CONCRETE WALK	SQ FT	60				60		
	2531.501	CONCRETE CURB & GUTTER DESIGN B-612	LN FT	3624	312			3936		
	2531.501	CONCRETE CURB & GUTTER DESIGN B-618	LN FT	5453	2718			8171		
18	0531.602	CONCRETE DRAINAGE FLUME	SQ YD	20				20		
	2531.507	6" CONCRETE DRIVEWAY PAVEMENT	SQ YD	135	22			157		
	2531.507	8" CONCRETE DRIVEWAY PAVEMENT	SQ YD	121	115			236		
	0531.602	CONCRETE MEDIAN NOSE-SPECIAL	EACH	3				3		
	0564.602	PAVEMENT MESSAGE (ONLY) PAINT	EACH	10	3			13		
	0411.603	CONSTRUCT STONE RETAINING WALL	SQ FT	846				846		
	0564.602	PAVEMENT MESSAGE (RR CROSSING) PAINT	EACH	4				4		
	2557.501	WIRE FENCE DESIGN 60-9322	LN FT	188				188		
	0557.603	INSTALL WOODEN FENCE	LN FT	315				315		
	0557.603	INSTALL WOVEN WIRE FENCE	LN FT	71				71		
21	0563.601	TRAFFIC CONTROL (STAGE 1)	LUMP SUM	0.5	0.5			1		
21	0563.601	TRAFFIC CONTROL (STAGE 2)	LUMP SUM	0.5	0.5			1		
21	0563.601	TRAFFIC CONTROL (STAGE 3)	LUMP SUM	0.5	0.5			1		
21	0563.601	TRAFFIC CONTROL (STAGE 4)	LUMP SUM	0.5	0.5			1		

21 REFERRED TO AS PHASE 1, 2, 3 & 4 IN THE PLANS.

STATEMENT OF ESTIMATED QUANTITIES (CONT.)

ITEM NO.	ITEM	UNIT	SP 02-601-33		SP 02-608-07		NON-PARTICIPATING	STORM S. TOTAL PART.	TOTAL EST. QUAN.	TOTAL FINAL QUAN.
			EST.	FINAL	EST.	FINAL				
2564.531	F & I SIGN PANELS TYPE C	SQ FT	524	154					678	
2564.513	CONCRETE FOOTING	EACH	25	5					30	
0564.602	PAVEMENT MESSAGE (LT. ARROW) PAINT	EACH	4	1					5	
0564.603	4" SOLID LINE YELLOW-PAINT	LN FT	3600	305					3905	
0564.603	4" SOLID LINE WHITE-PAINT	LN FT	8195	3430					11625	
0564.603	4" DOUBLE SOLID LINE YELLOW-PAINT	LN FT	2490	1720					4210	
0564.603	4" STOP LINE WHITE-PAINT	LN FT	478	353					831	
0564.603	4" BROKEN LINE WHITE-PAINT	LN FT	1260	520					1810	
0564.602	PAVEMENT MESSAGE (RT. ARROW) PAINT	EACH	5	1					6	
2565.511	FULL T ACT T CONTROL SIGNAL SYSTEM	SIG SYS	1						1	
0564.602	PAVEMENT MESSAGE (THRU ARROW) PAINT	EACH	1						1	
13	2573.501	BALE CHECK	EACH	32					32	
17	0564.602	PAVEMENT MESSAGE (RT.-THRU ARROW) PAINT	EACH	1					1	
18	2575.505	SODDING	SQ YD	6300	4700		820		11820	
	2575.531	COMMERCIAL FERT. ANALYSIS 10-10-10	TON	0.37	0.24		0.04		0.65	
ALTERNATE II-1										
	0531.604	SPECIAL MEDIAN (BRICK)	SQ YD	377	45				422	
	2531.503	CONCRETE MEDIAN	SQ YD	875					875	
ALTERNATE II-2										
	0531.604	SPECIAL MEDIAN (BRICK)	SQ YD	1252	45				1297	
ALTERNATE II-3										
	2105.525	TOPSOIL BORROW (LV)	CU YD	146					146	
	0531.604	SPECIAL MEDIAN (BRICK)	SQ YD	377	45				422	
	2575.505	SODDING	SQ YD	875					875	
	2575.531	COMMERCIAL FERT ANALYSIS 10-10-10	TON	.05					.05	

- 1 FOR MEDIAN CONST. ON OSBORNE WAY.
- 2 TO BE USED AS DIRECTED BY THE ENGINEER FOR DUST CONTROL WITHIN THE PROJECT LIMITS.
- 3 INCLUDES 219 CU.YD FOR STREET APPROACHES.
- 4 FOR CONSTRUCTION OF BUS PADS.
- 5 FOR PROTECTION OF 60" WATER CONDUITS.
- 6 INCLUDES 160 TON FOR STREET APPROACHES.
- 7 INCLUDES 310 TON FOR STREET APPROACHES
- 8 INCLUDES 2341 WEARING COURSE
- 9 PROVIDED FOR DRIVEWAY RESTORATION (373 SY) AND BIKEWAY CONST.(1300 SY). PAYMENT BY SQ YD INCLUDES BITUMINOUS MATERIAL FOR MIXTURE AND 3" THICK (COMPACTED THICKNESS) AGGREGATE BASE.
- 10 INCLUDES 120 TON FOR STREET APPROACHES.
- 11 STEPS REQUIRED.
- 12 FOR SURFACE DRAINAGE OF CUL DE SAC AT 75 TH. WAY
- 13 FOR TEMPORARY EROSION CONTROL LT. SB 100'00 TO 100+50.
- 14 BIT. MATERIAL SHALL BE USED FOR TEMPORARY TRENCH RESTORATION TO CARRY TRAFFIC.
- 15 THICKNESS SHALL BE A MINIMUM OF 2" (COMPACTED).
- 16 INCLUDES 569 CY FOR RETENTION POND CONST.
- 17 INCLUDES 62 CY FOR RETENTION POND TURF ESTABLISHMENT.
- 18 INCLUDES 820 SY OF SDD FOR RETENTION POND CONST.
- 19 INCLUDES .04 TONS FOR RETENTION POND CONST.
- 20 INCLUDES 0.10 ACRES FOR RETENTION POND CONST.
- 21 THE CONTRACTOR SHALL PLACE A FILTER MATERIAL UNDER THE RIPRAP. IT WILL BE THE CONTRACTOR'S OPTION TO USE EITHER A GRANULAR FILTER MATERIAL (PLACED TO A 10" DEPTH) OR A GEOTEXTILE FILTER MATERIAL. FILTER MATERIAL, OF EITHER TYPE USED, WILL BE CONSIDERED TO BE INCIDENTAL TO RIPRAP CONSTRUCTION AND NO DIRECT COMPENSATION WILL BE MADE THEREFOR.
- 22 USED FOR CROSSWALK DELINEATIONS ALSO.

23 2 LEGS OF THE SIGNAL SYSTEM ARE ON S.P. 02-601-33, 1 LEG OF THE SIGNAL SYSTEM IS ON S.P. 02-608-07 AND 1 LEG OF THE SIGNAL SYSTEM IS ON S.P. 127-332-02.

SPECIAL DETAILS

INPLACE TOPSOIL SHALL BE SALVAGED AND USED TO THE FULLEST EXTENT POSSIBLE PRIOR TO THE USE OF TOPSOIL BORROW ON AREAS DISTURBED BY CONSTRUCTION OPERATIONS. SALVAGE OF INPLACE TOPSOIL FOR USE IN TURF ESTABLISHMENT SHALL BE CONSIDERED TO BE INCIDENTAL TO COMMON EXCAVATION AND NO DIRECT COMPENSATION WILL BE MADE THEREFOR. REMOVE BITUMINOUS PAVEMENT ITEM IS FOR REMOVAL OF BITUMINOUS IN MEDIAN CONSTRUCTION AREA ON OSBORNE WAY. ANY OTHER BITUMINOUS REMOVAL IS INCLUDED WITH COMMON EXCAVATION FOR PAYMENT. DISPOSAL OF ANY EXCESS MATERIAL SHALL BE THE RESPONSIBILITY OF THE CONTRACTOR AND SHALL BE DISPOSED OF IN ACCORDANCE WITH THE PROVISIONS OF 2104.

HEAVY CONSTRUCTION EQUIPMENT WILL NOT BE ALLOWED TO CROSS OVER OR WORK ON THE 60" WATER CONDUITS IN AREAS THAT DO NOT HAVE 8" REINFORCED CONCRETE PAVEMENT PROTECTION. THE CONTRACTOR SHALL EMPLOY EQUIPMENT AND CONSTRUCTION METHODS INCLUDING HAND LABOR AS NECESSARY TO ACCOMPLISH THE WORK AS PLANNED OVER THE 60" WATER CONDUITS WITHOUT DAMAGE TO THE UTILITY.

BASIS OF PLANNED QUANTITIES

- 2331 PLANT MIXED BASE COURSE BITUMINOUS MIXTURE 110 LBS./SQ.YD./1' THICK BITUMINOUS MATERIAL FOR MIXTURE 5.3% BY WT.
- 2331 PLANT MIXED BINDER COURSE BITUMINOUS MIXTURE 110 LBS./SQ.YD./1' THICK BITUMINOUS MATERIAL FOR MIXTURE 5.3% BY WT.
- 2341 PLANT MIXED WEARING COURSE BITUMINOUS MIXTURE 110 LBS./SQ.YD./1' THICK BITUMINOUS MATERIAL FOR MIXTURE 6.5% BY WT.
- 2357 BITUMINOUS MATERIAL FOR TACK COAT 0.05 GAL. PER SQ.YD.
- 2575 COMMERCIAL FERTILIZER ANALYSIS 10-10-10, 500# PER ACRE ON ALL SDD AREAS

EARTHWORK SUMMARY

S.P. 02-601-33

EXCAVATION (CU.YD.)			
20,769	COMMON SUBCUT FOR COMPACTION	12,668	(1) EXCESS 5,178
	RETENTION POND	7,532	(1) EXCESS 324
		569	

EMBANKMENT (CU.YD.)			
15,591	REGULAR FILL (150% SHRINKAGE)	= 3,926	
	SUBCUT (150% SHRINKAGE)	=11,298	
767	RETENTION POND (150% SHRINK.)	368	
	TOPSOIL BORROW (2) (3)		

S.P. 02-608-07




EXCAVATION (CU.YD.)			
3,310	COMMON SUBCUT FOR COMPACTION	1,980	(1) EXCESS 587
		1,330	

EMBANKMENT (CU.YD.)			
2,723	REGULAR FILL (150% SHRINKAGE)	728	
	SUBCUT (150% SHRINKAGE)	1,995	
376	TOPSOIL BORROW (2)	376	

NOTE: EXISTING BITUMINOUS PAVEMENT (REGARDLESS OF THICKNESS) IS INCLUDED IN COMMON EXCAVATION QUANTITIES FOR PAYMENT AND SHALL BECOME


DRIVEWAY CONSTRUCTION

CONCRETE APRON DETAIL

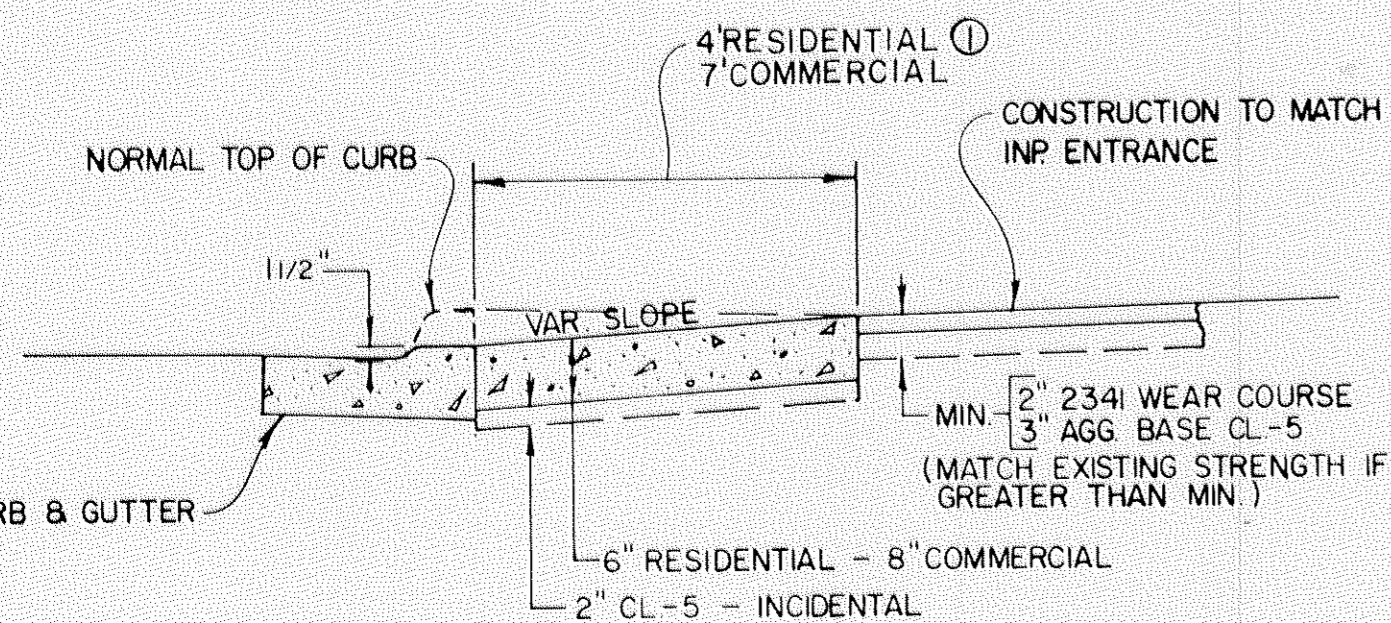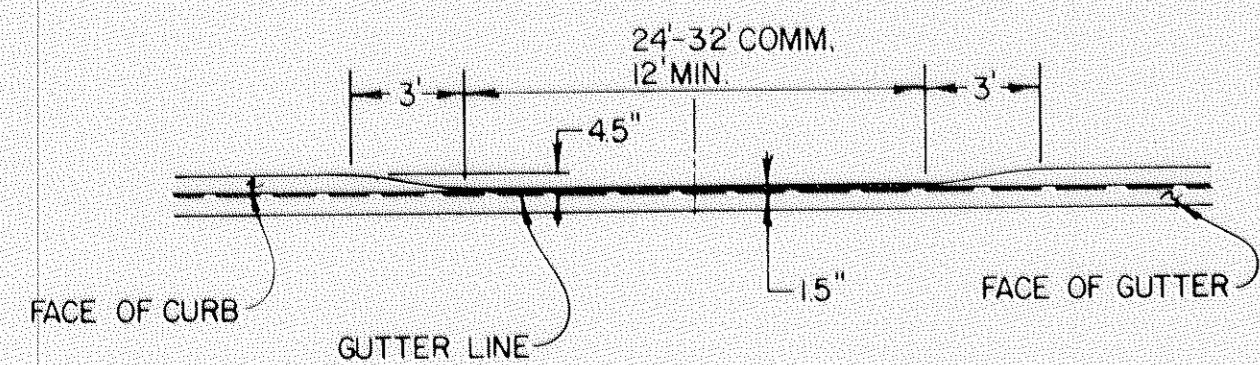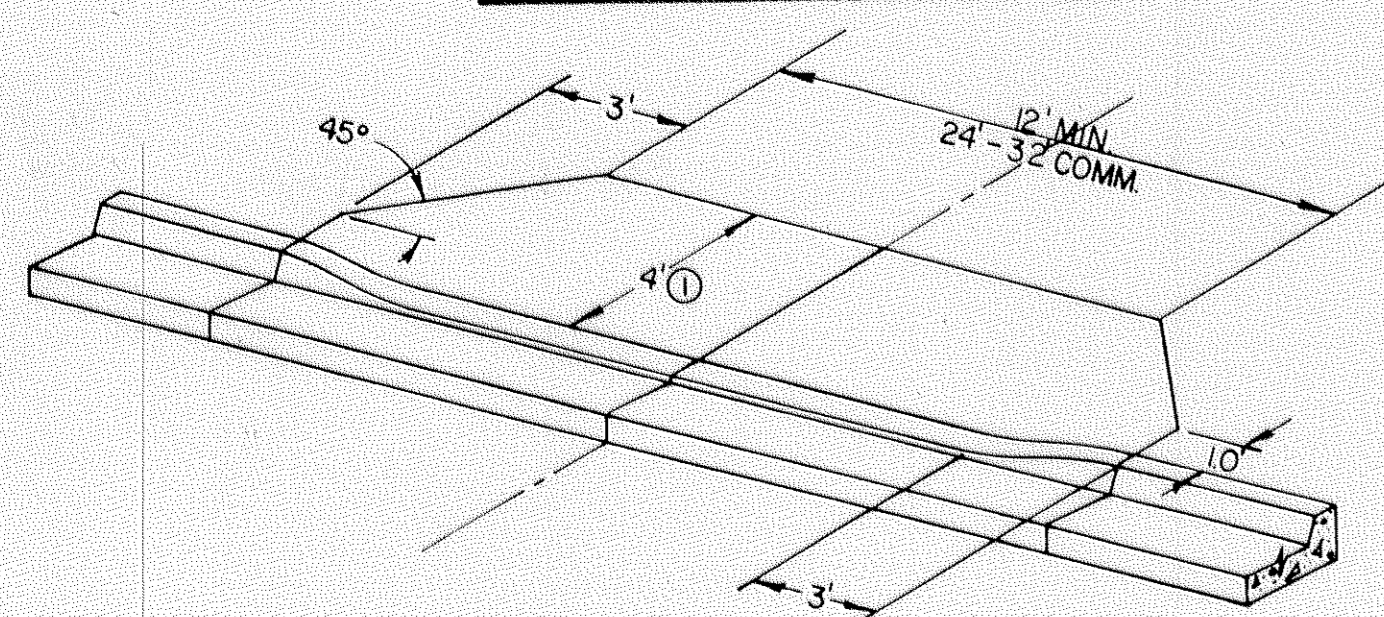


① MAY BE VARIABLE IN SIDEWALK AREAS. EXTEND CONC. APRON TO MATCH SIDEWALK.

NOTE: ALSO SEE STD. PLATE NO. 7035

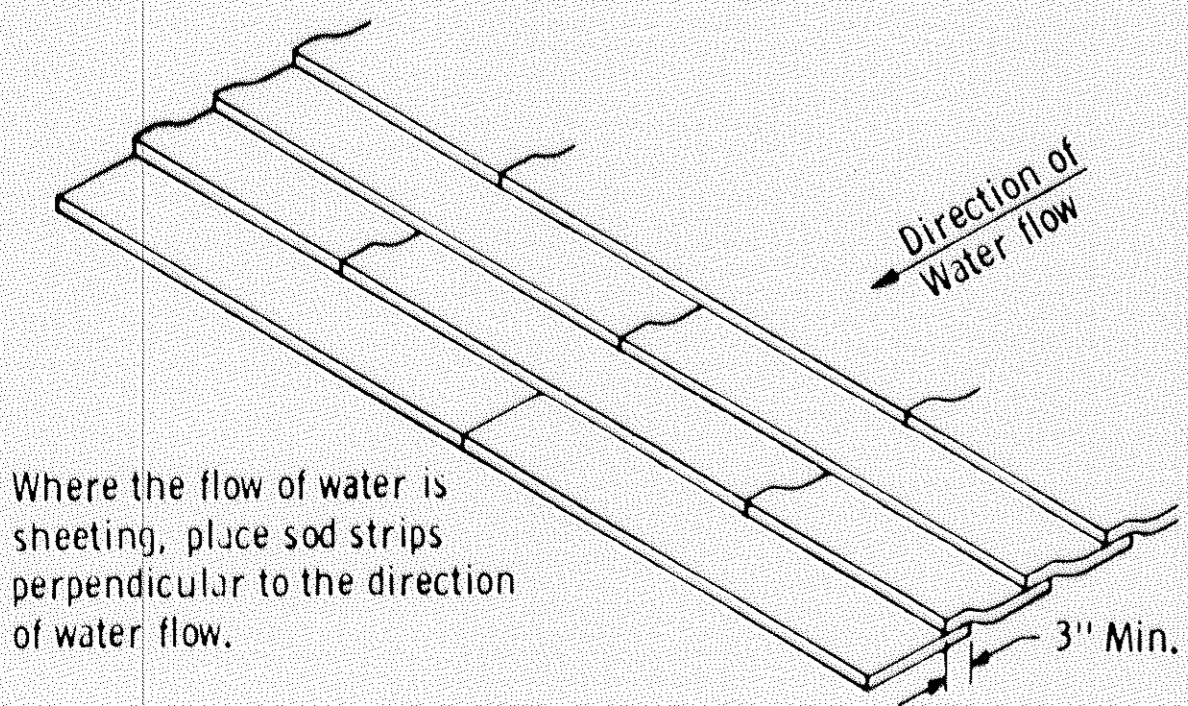


SHINGLING SOD

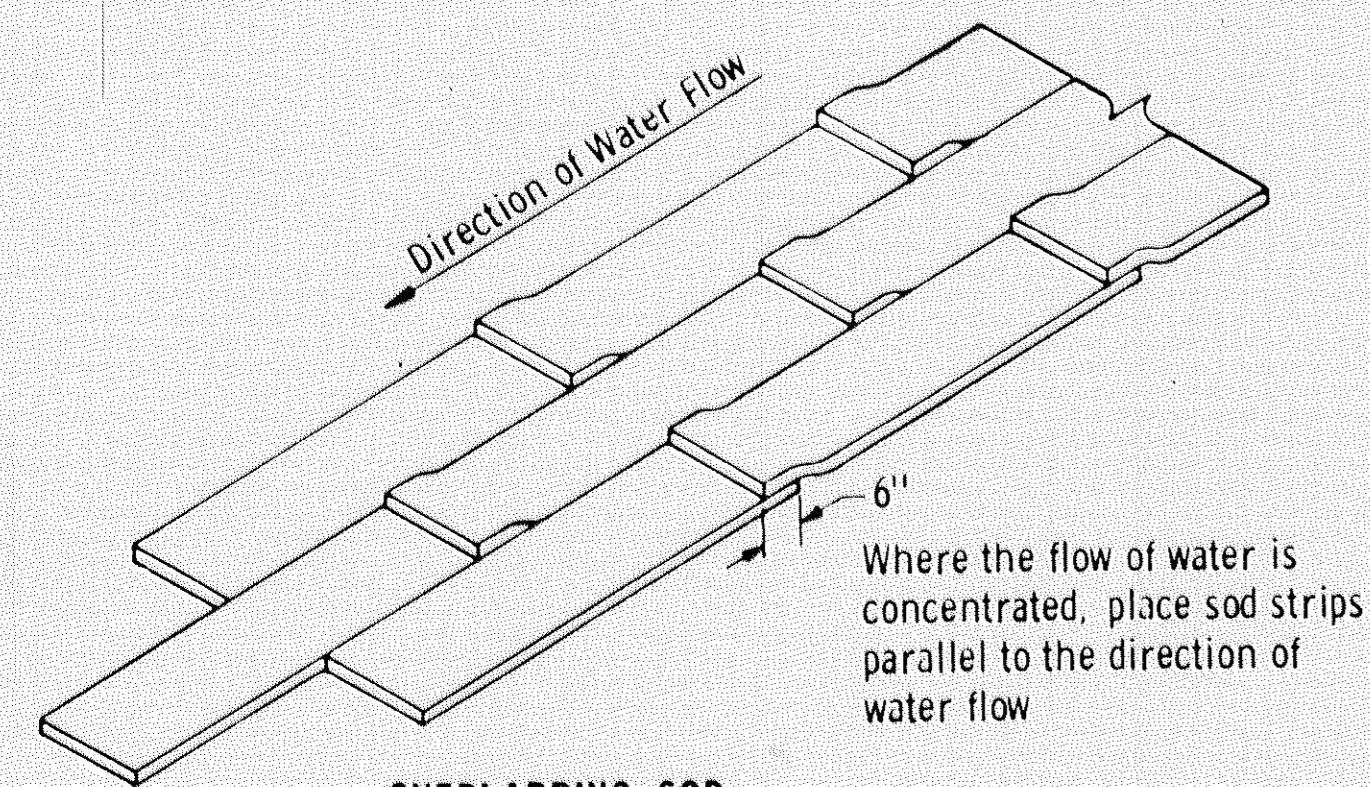


OVERLAPPING SOD


SPECIAL SOD PLACEMENT TECHNIQUES

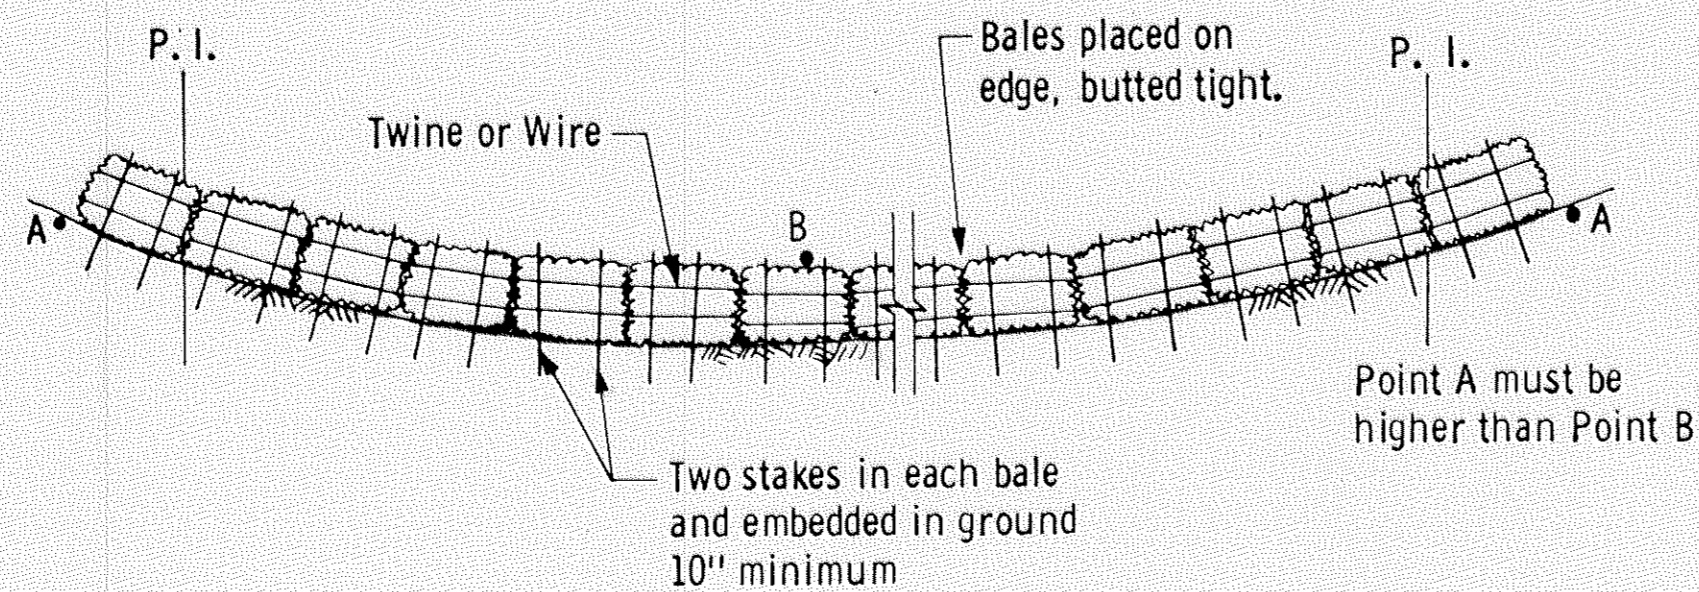

BALE HAY OR STRAW DITCH CHECK

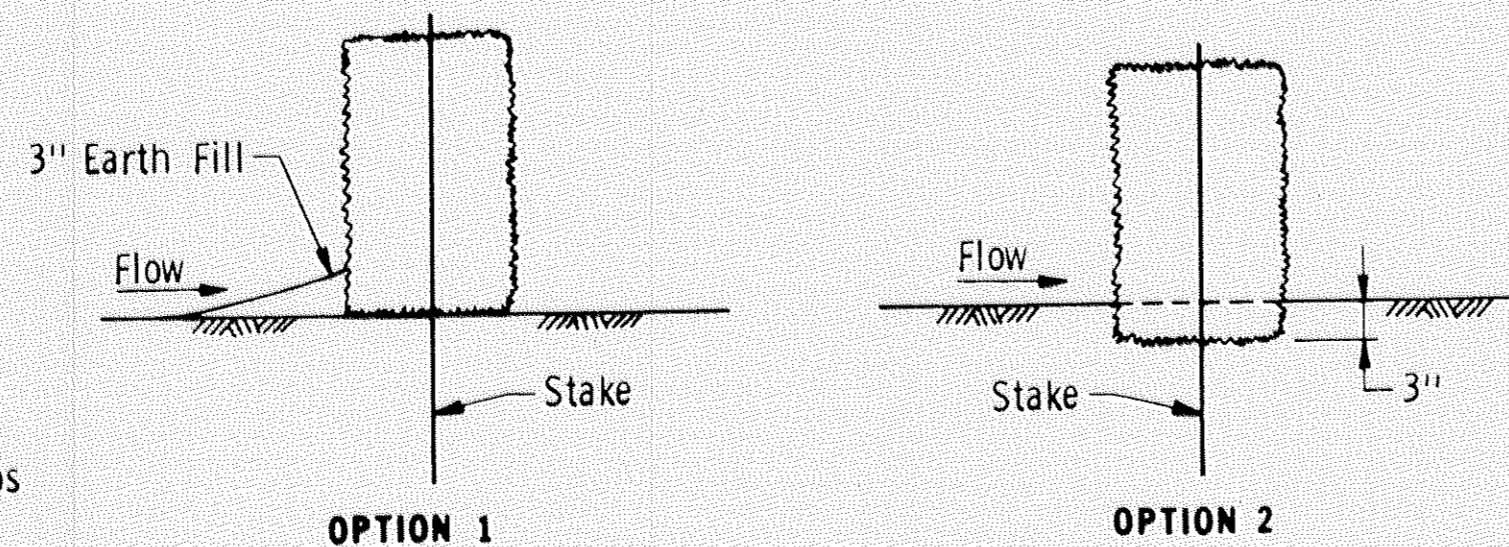


DITCH CHECK SECTIONS

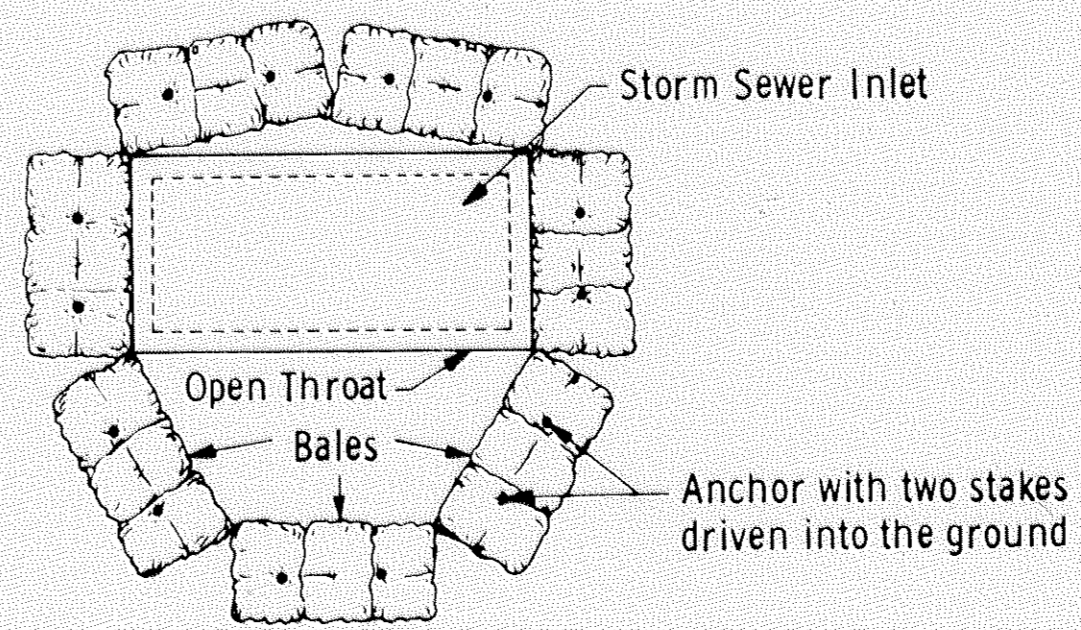

BALE DIVERSION TO PROTECT STORM SEWER INLETS

RETAINING WALL DETAIL

- ② LSB STA 96+50 TO LSB STA 99+20 LT.
- ① LEB STA 203+12 TO LEB STA 203+30 RT.
- ① LWB STA 203+20 TO LWB STA 203+54 LT
- ① LEB STA 204+80 TO LEB STA 205+50 RT.

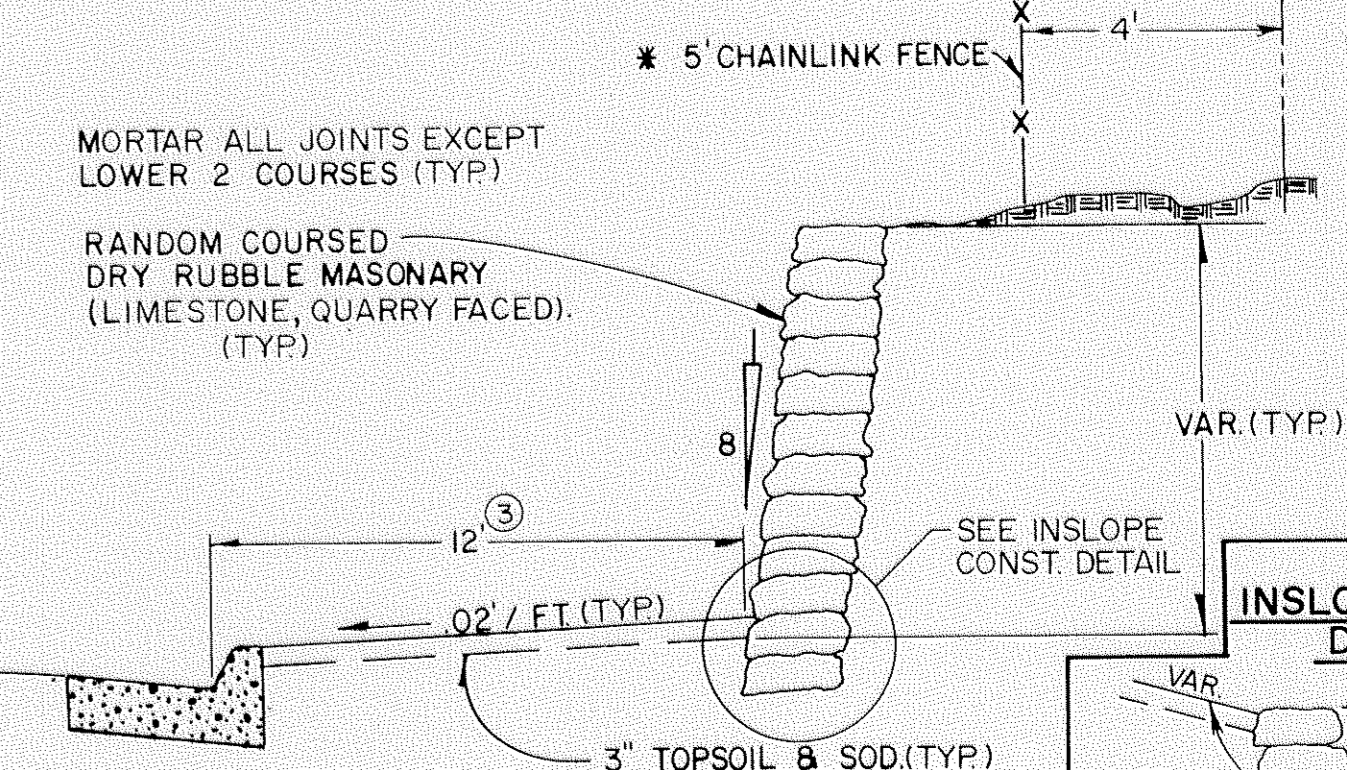

- ① SEE OSBORNE CROSS SECTIONS FOR INSLOPE WALL CONSTRUCTION. FACE OF WALL TO BE CONST. 1.0' INSIDE R/W LINE. SEE INSLOPE CONST. DETAIL.
- ② FENCE INSTALLED AT THIS LOCATION ONLY.
- ③ SEE X-SECTIONS FOR DIST. IN INSLOPE CONST. AREAS.

* STA. 97+32 TO STA. 99+20, F&I FENCE. SEE FENCE CHART.




STATION	ADDRESS	REMARKS	REMOVE		CONCRETE DRIVEWAY PAVEMENT				BIT PAVEMENT								
			CONCRETE	BITUMINOUS	APRON SQ. YDS.			DRIVEWAY SQ. YDS.			DRIVEWAY SQ. YDS.						
					WIDTH	6"	8"	WIDTH	REPLMT	NEW	WIDTH	REPLMT	NEW				
SP 02-601-33			S.Y.	① S.Y.													
NB93+43 RT. NB94+10 RT. NB94+59 RT.	7315 7315 7321	12' BIT. 12' BIT. 10' BIT.			12'	7.0						12'	11				
NB95+99 RT. SB97+22 LT. NB97+75 RT. NB100+46 RT.	7335	12' BIT. 12' SAND COMMERCIAL ENT. COMMERCIAL ENT.			12'	7.0						12'	17				
NB101+26 RT. NB102+00 RT. NB105+53 RT. NB107+06 RT.	7501	COMMERCIAL ENT. COMMERCIAL ENT. 12' SAND 12' SAND			32'	30.2						32'	36				
NB108+12 RT. SB108+84 LT. NB108+88 RT. NB109+77 RT.	7505 7505 7505 7509	12' SAND 20' BIT. (REMOVE, NO ENT. REQ.) 10' SAND 10' SAND			12'	7.0											
SB110+52 LT. NB110+81 RT. NB111+78 RT. NB112+84 RT.	7513 7517 7517 7525	18' SAND (REMOVE, NO ENT. REQ.) 10' BIT. 12' SAND 10' BIT.			12'	7.0						10'	12				
NB113+91 RT. SB114+02 LT. NB114+74 RT. SB115+38 LT.	7601 7619 7619 7619	10' SAND 16' SAND 12' SAND 12' BIT.			12'	7.0						12'	8				
NB115+69 RT. NB115+89 RT. NB116+93 RT. NB118+40 RT.	7627 7637 7649 7661	10' SAND 11' BIT. 16' BIT. 12' SAND			12'	7.0						11'	7				
TOTALS FOR SP 02-601-33					135	121						252					
SP 02-608-07																	
EB20+60 RT. WB20+45 LT.		COMMERCIAL ENT. 15' BIT.			32'	30.2						15'	15				
EB202+65 RT. WB202+62 LT. WB202+92 LT. EB202+66 RT.		COMMERCIAL ENT. 12' BIT. 12' SAND COMMERCIAL ENT. REMOVE CONC. TO 11 1ST JOINTS/CONST. CONC. APRON TO MATCH			32'	30.2						32'	39				
L 213+34 RT.		COMMERCIAL ENT.			32'	30.2						32'	36				
TOTALS FOR SP 02-608-07					11	22	115					110					

① BITUMINOUS REMOVAL INCIDENTAL TO COMMON EXCAVATION






REVISIONS			
DATE	BY	DATE	BY

S.A.P. 02-608-07 & S.P. 02-601-33 C.P.



C.S.A.H. 8 - OSBORNE ROAD
 GRADING, BASE & BITUMINOUS SECTION
 STA. 207+50.0 - STA. 215+95.0

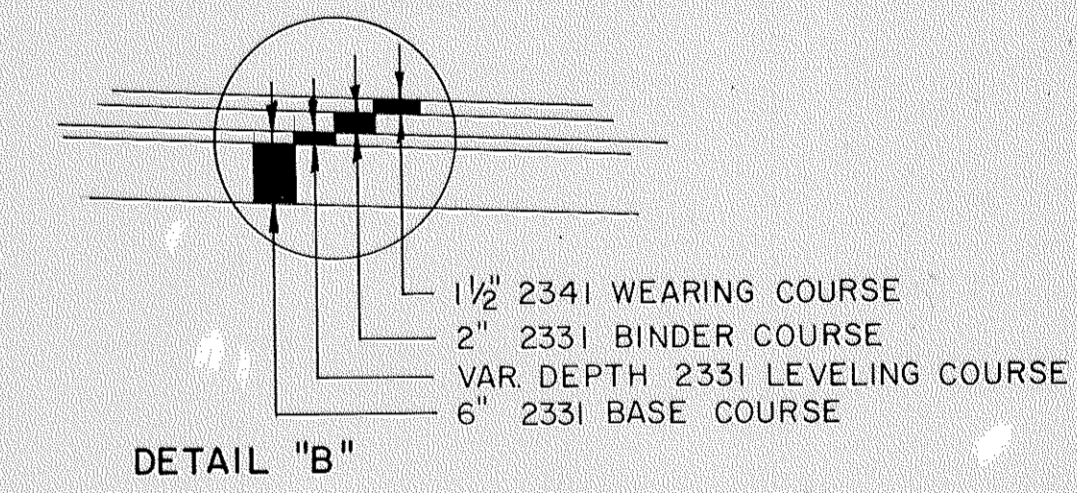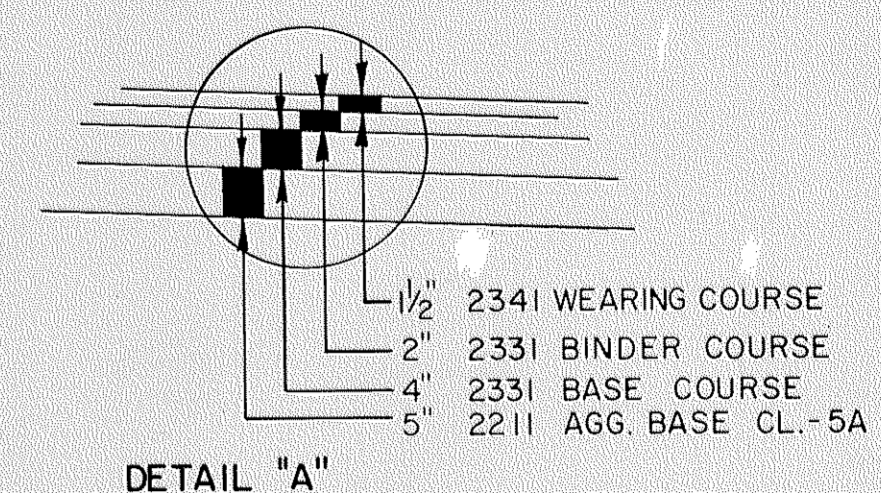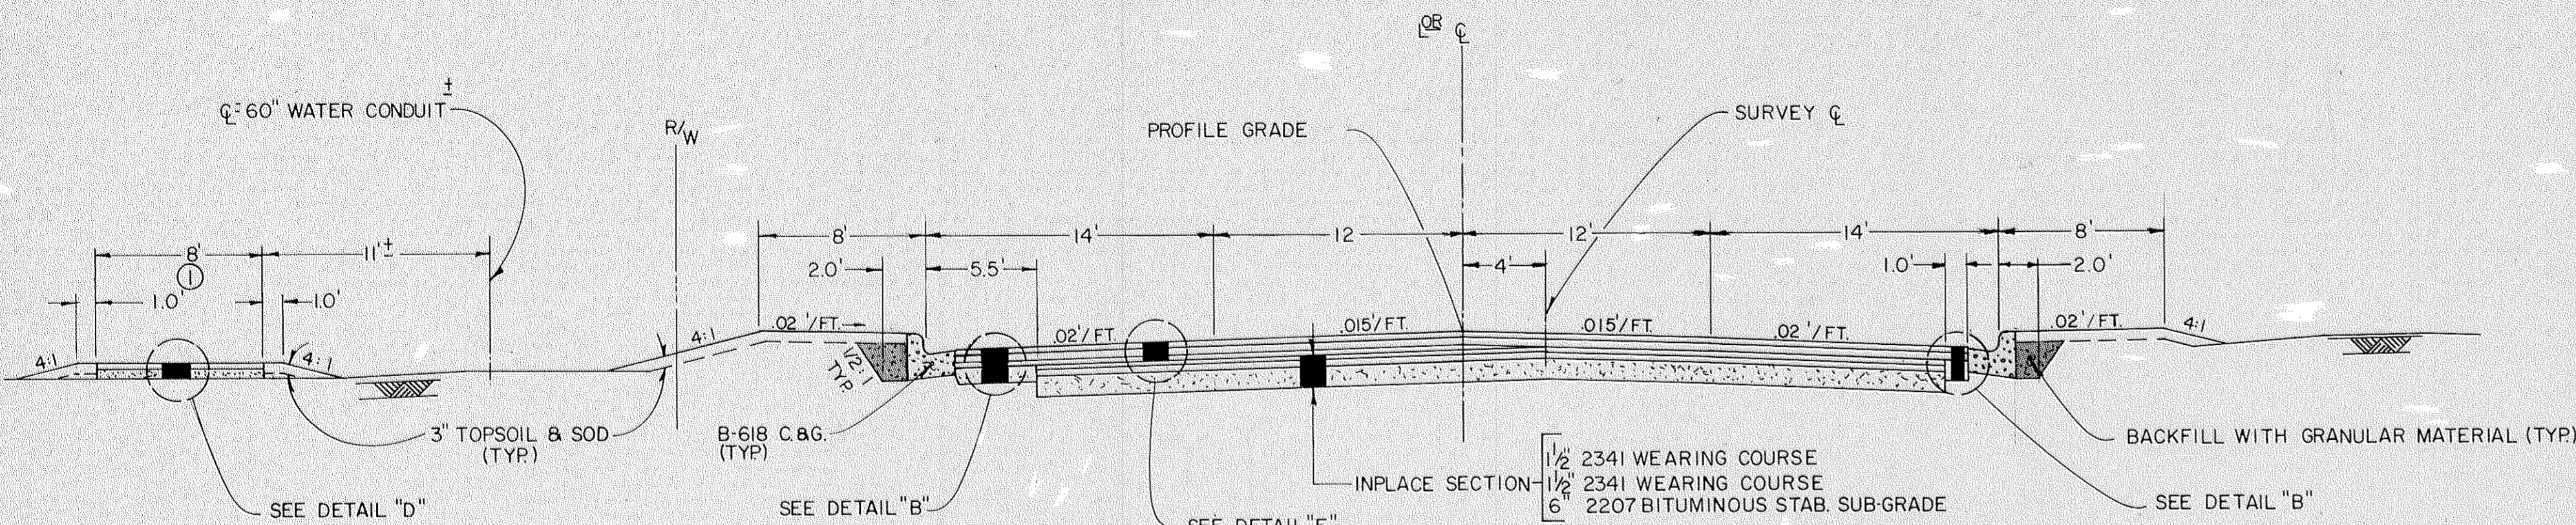

C.S.A.H. 8 - OSBORNE ROAD
 GRADING, BASE & BITUMINOUS SECTION
 STA. 200+80.0 - STA. 202+40.0

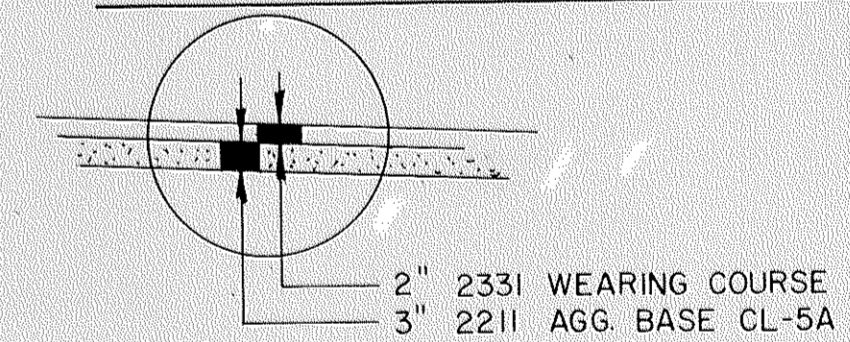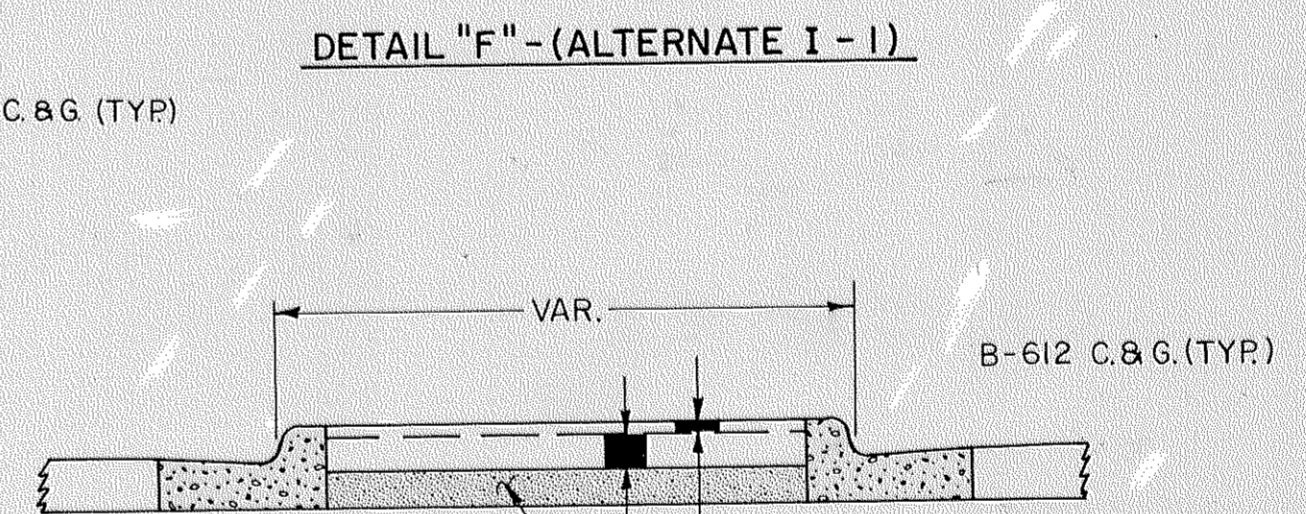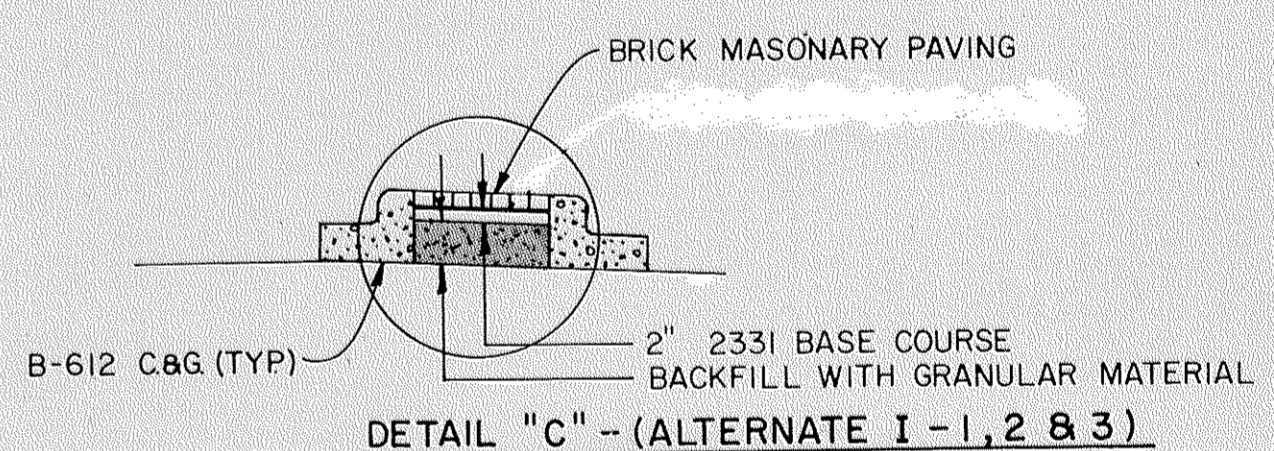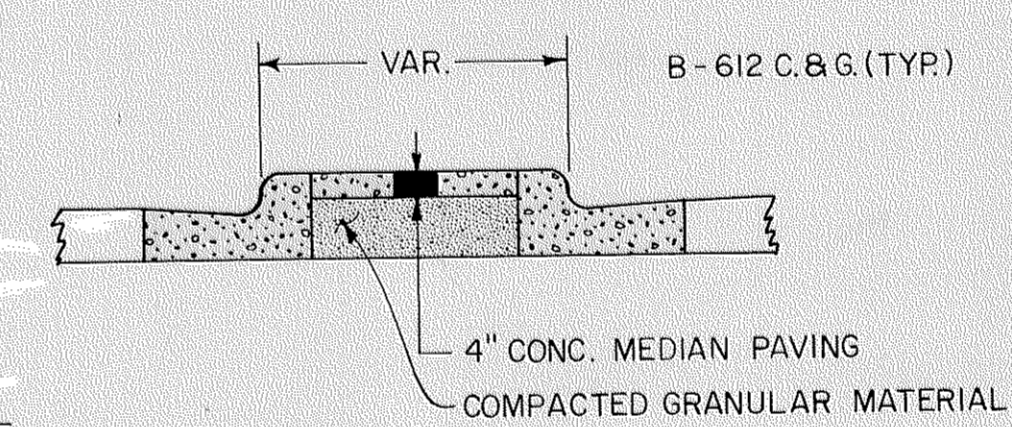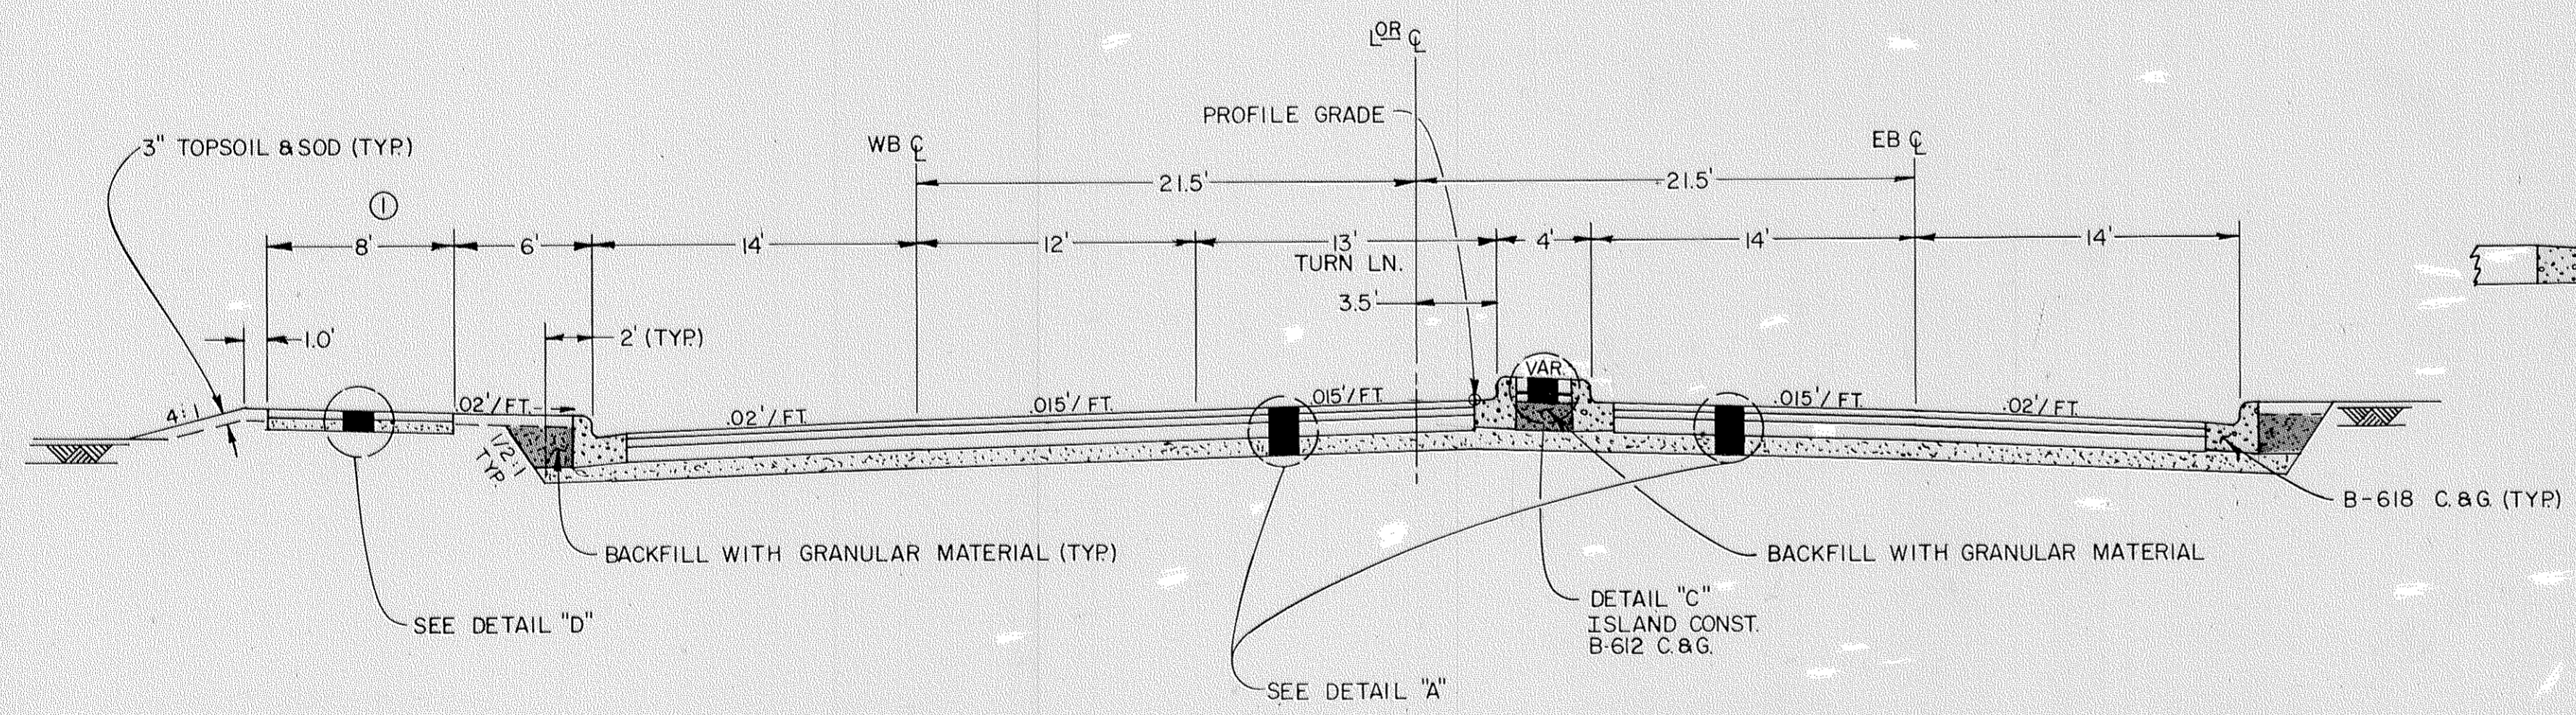


C.S.A.H. 8 - OSBORNE ROAD
 GRADING, BASE & BITUMINOUS SECTION
 STA. 202+400 - STA. 207+500

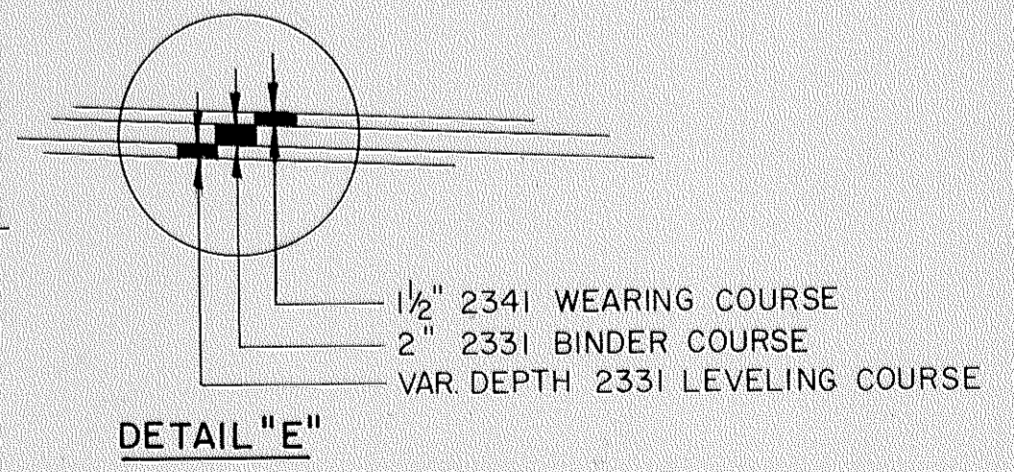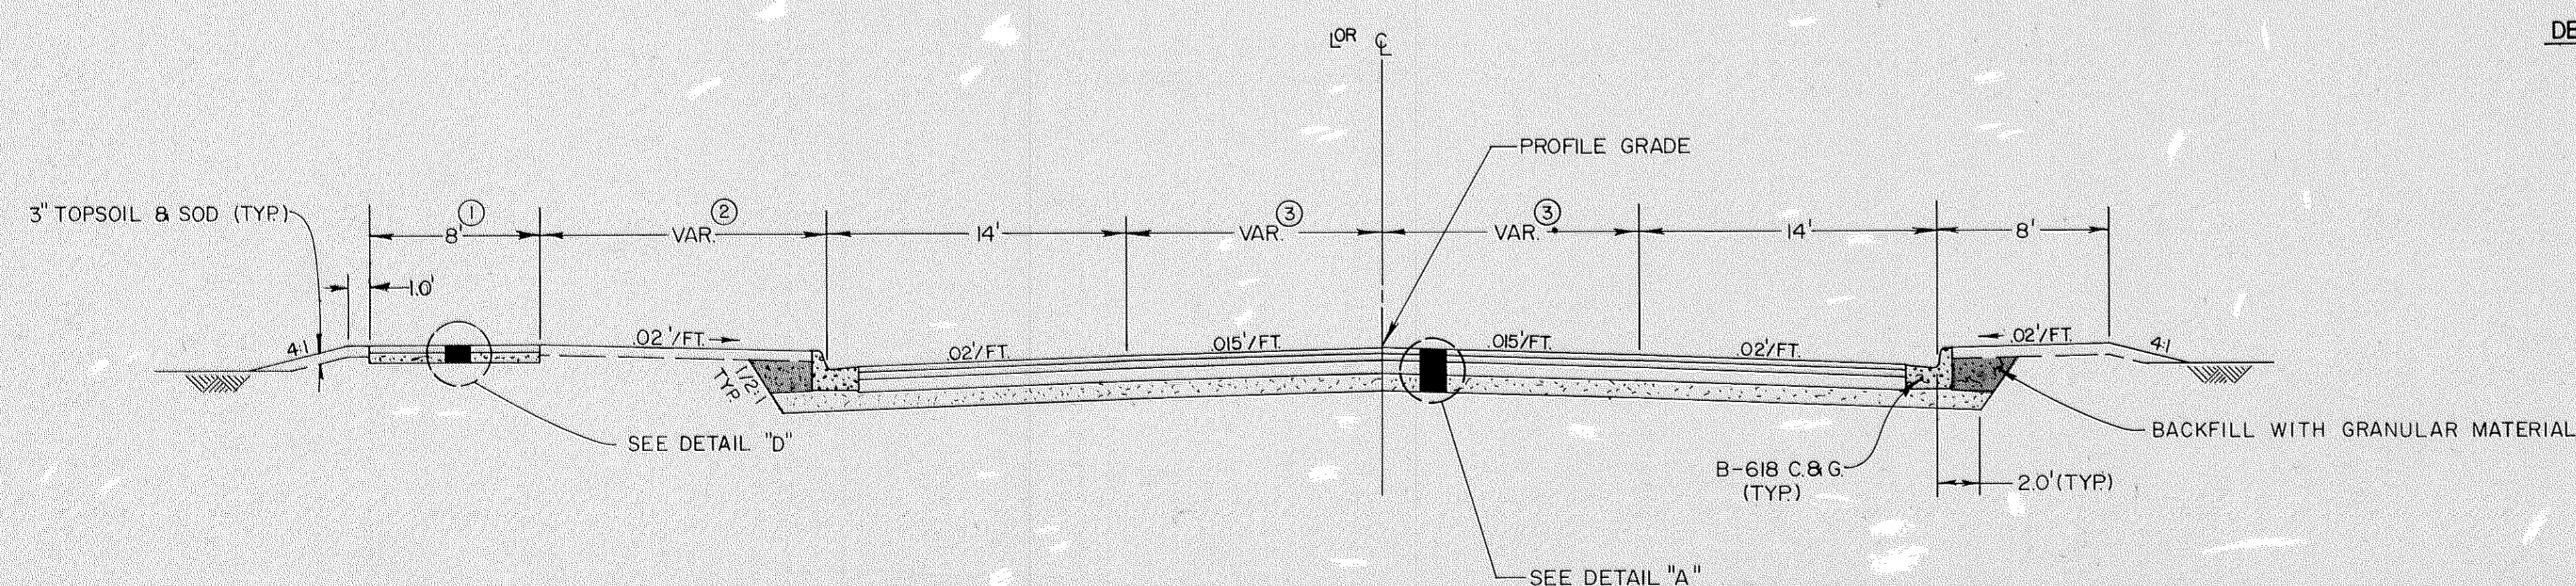


- ① BIKE PATH - SEE PLAN & PROFILE SHEETS FOR CONSTRUCTION LOCATIONS.
- ② 6' STA. W.B. 202+40 TO STA 203+45
- ③ TAPERS FROM 21.5' - 12' SEE PLAN & PROFILE SHEETS FOR GEOMETRICS.









C.S.A.H. 1- EAST RIVER ROAD
GRADING, BASE & BITUMINOUS SECTION
 STA. SB. 95+85.0 - STA. NB. 115+31.0

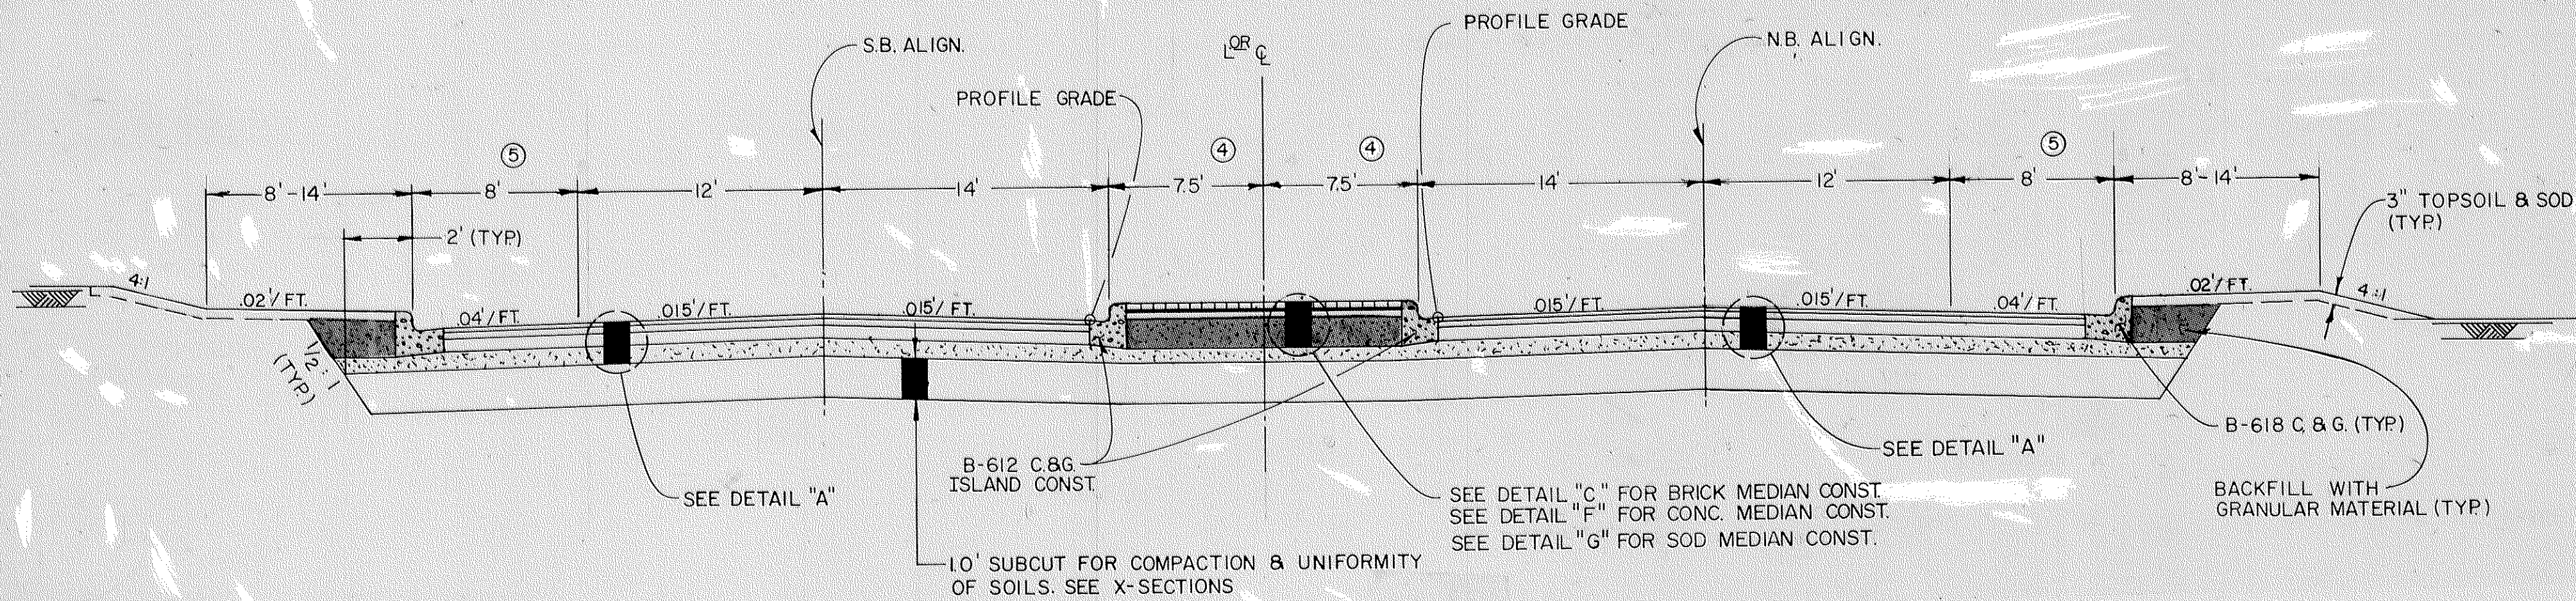



TAPER CONSTRUCTION
C.S.A.H. 1 EAST RIVER RD.
GRADING, BASE & BITUMINOUS SECTION
 STA. 94+00.0 TO STA. 95+85.0
 STA. 115+31.0 TO STA. 118+95.0

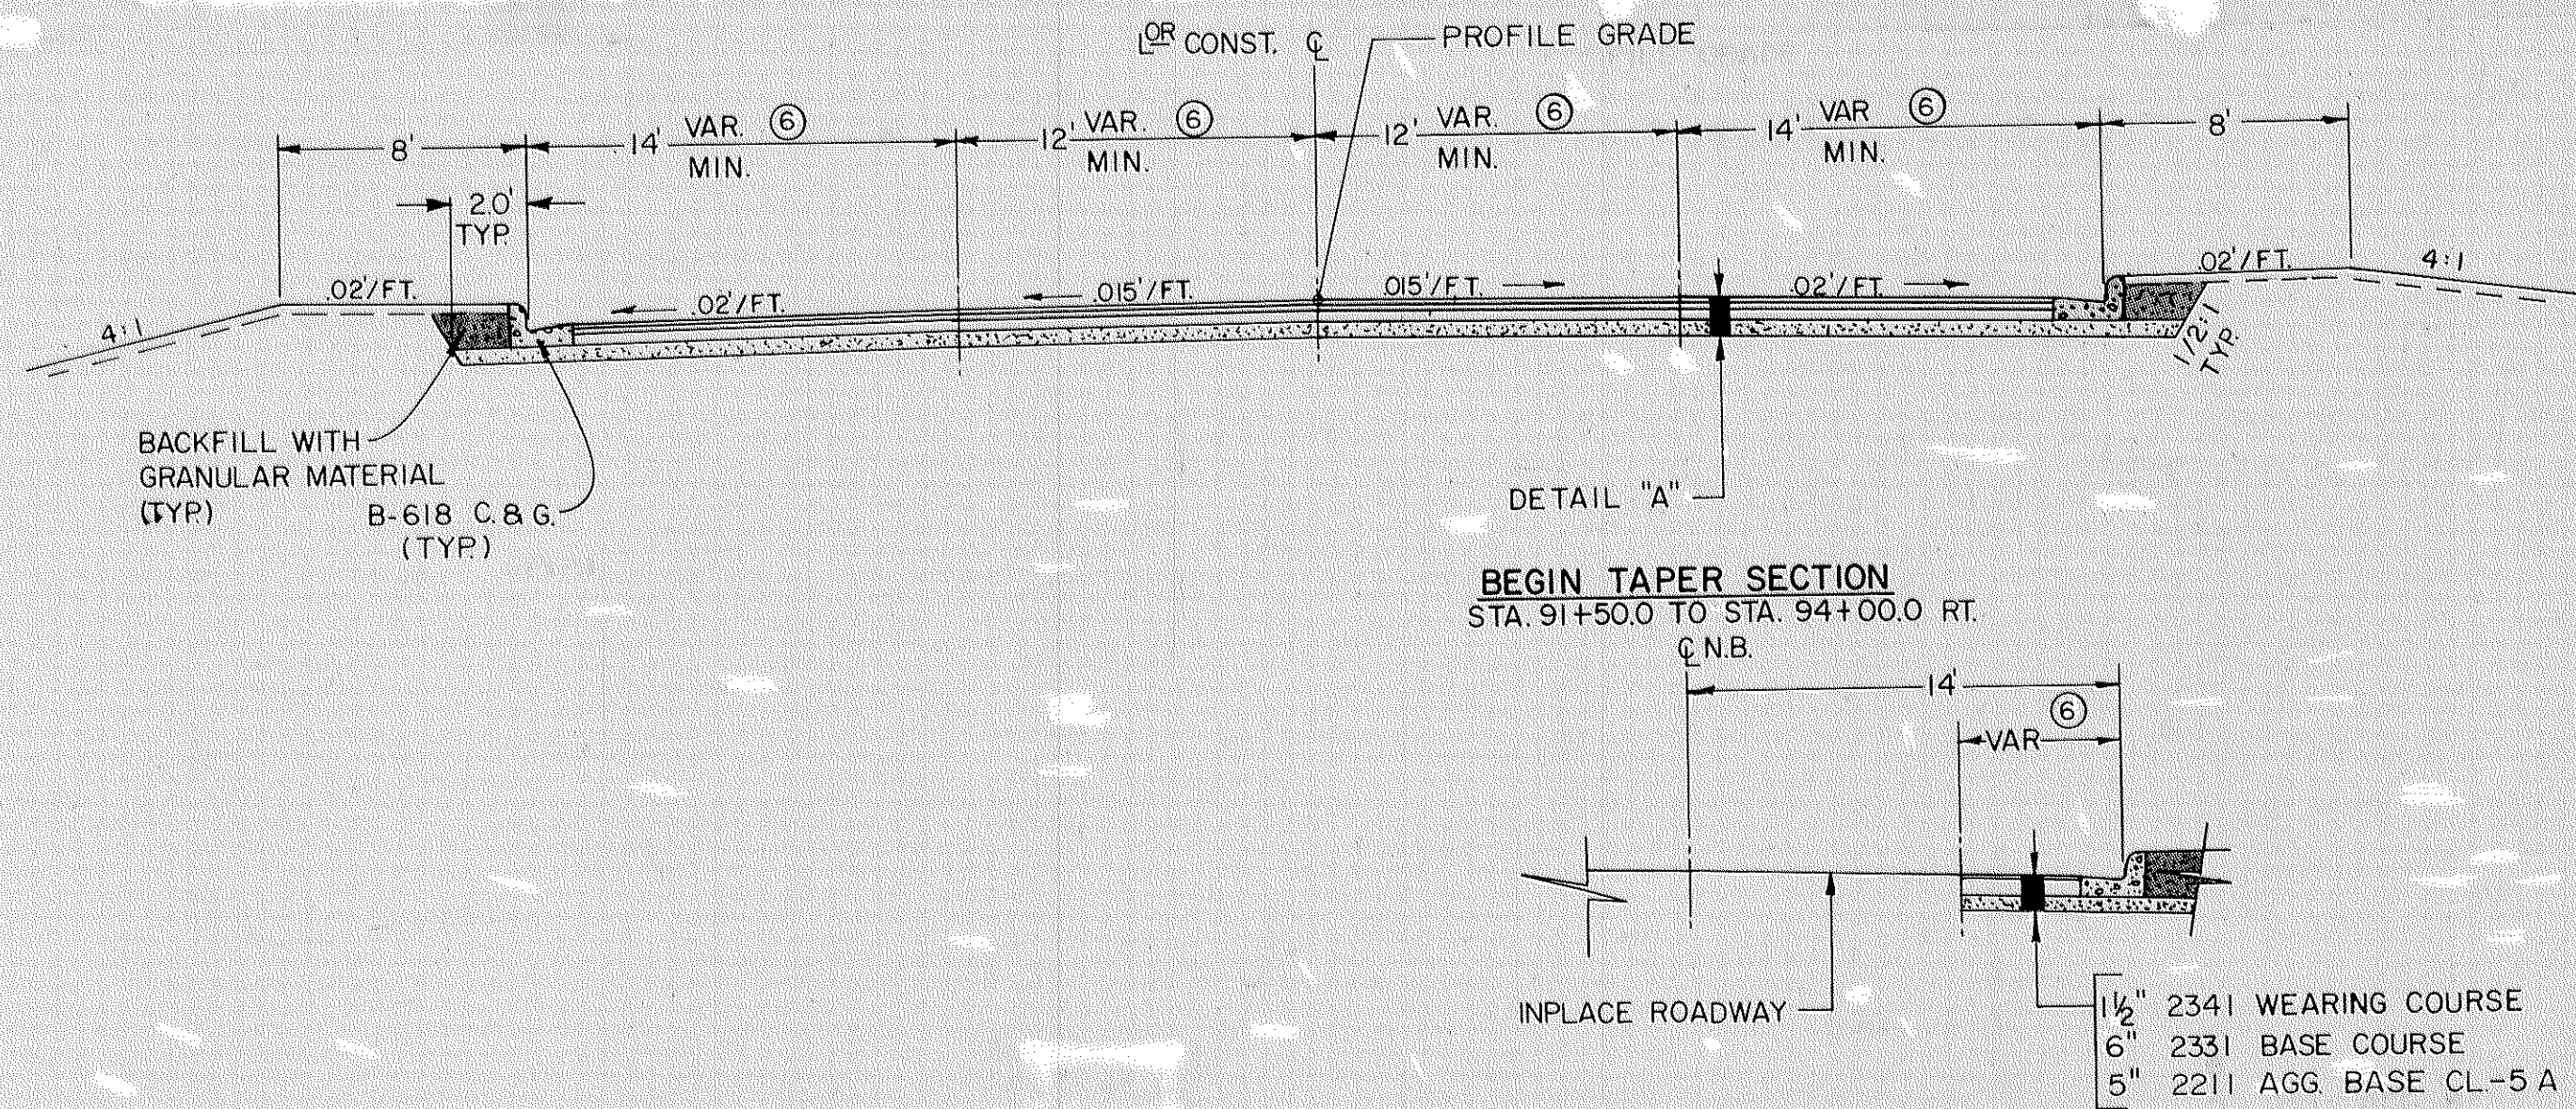

TURN LANE CONSTRUCTION
 SEE PLAN SHEETS FOR LOCATIONS & TAPERS

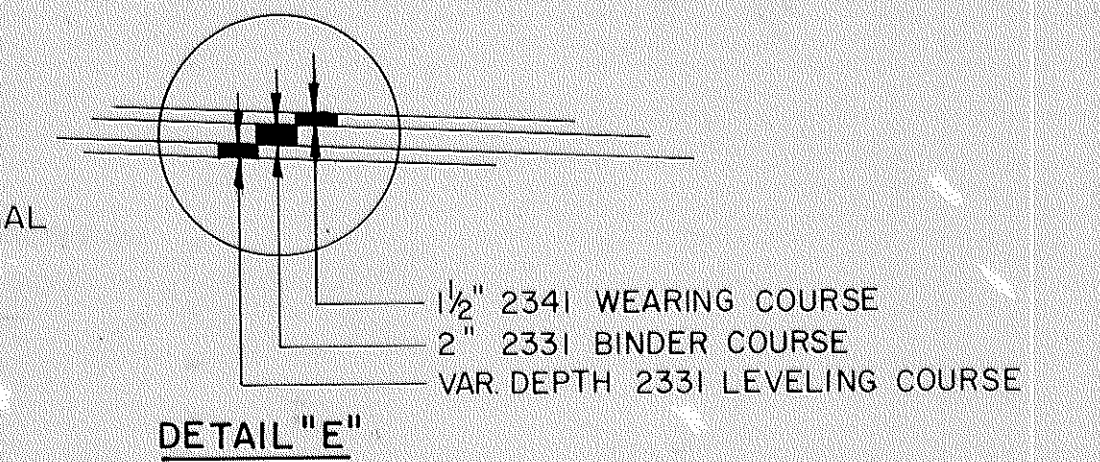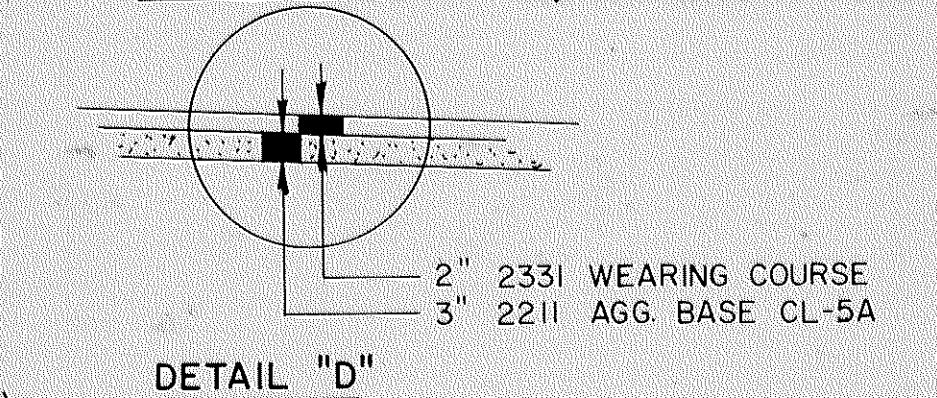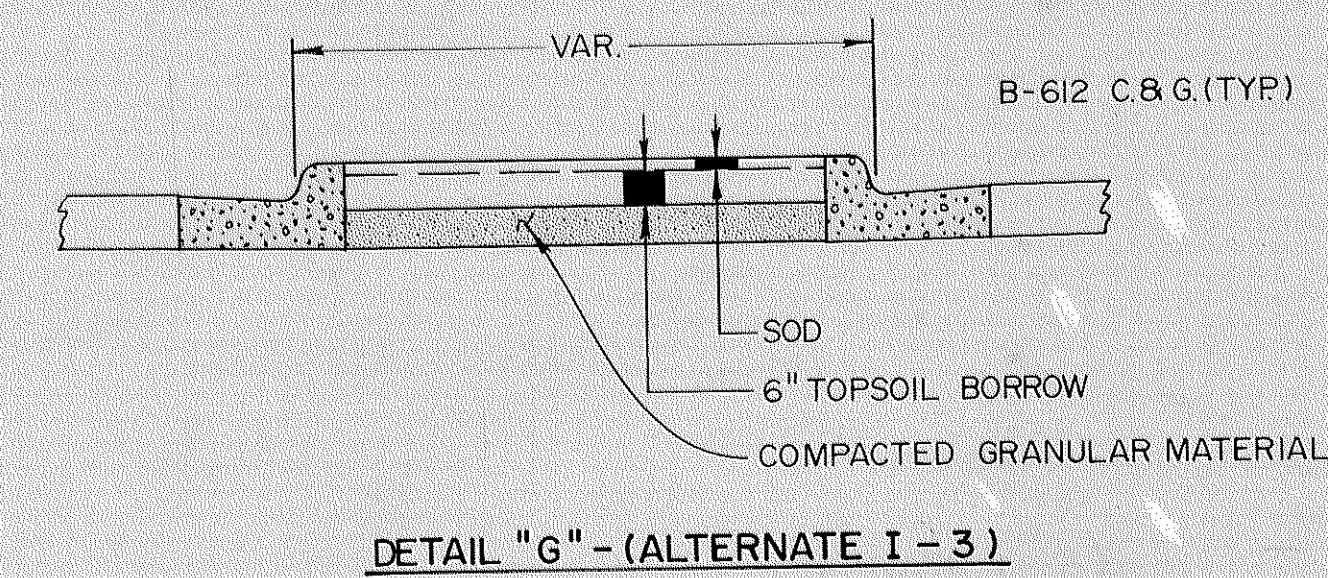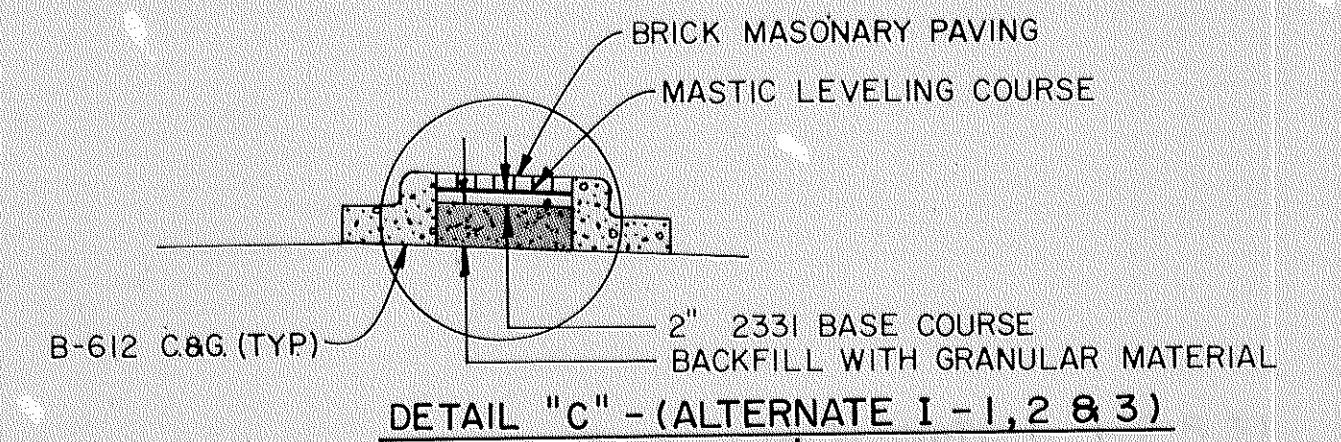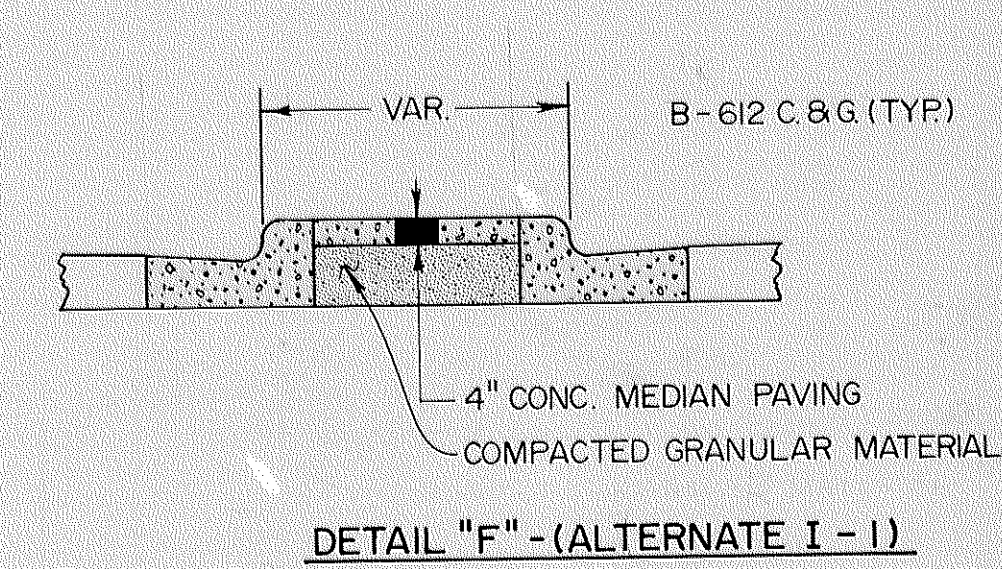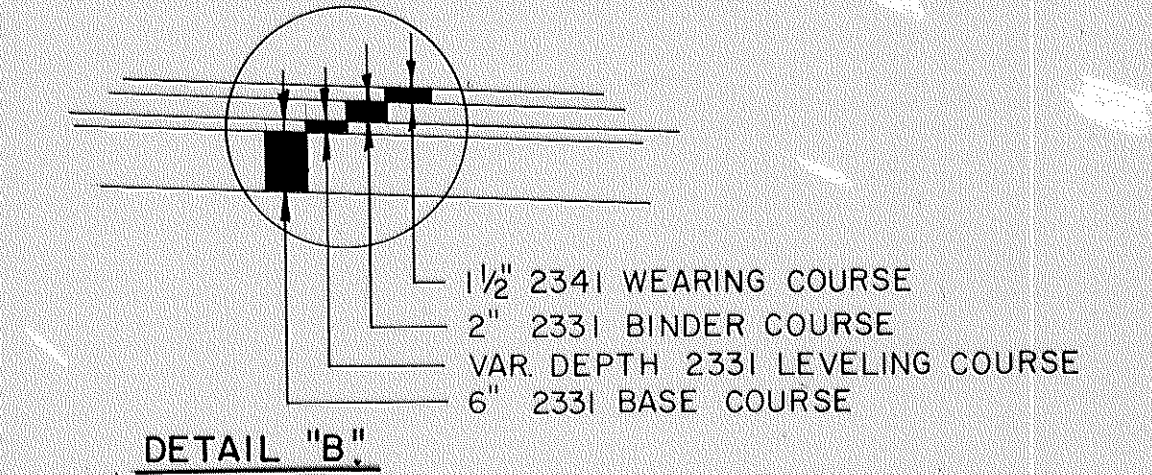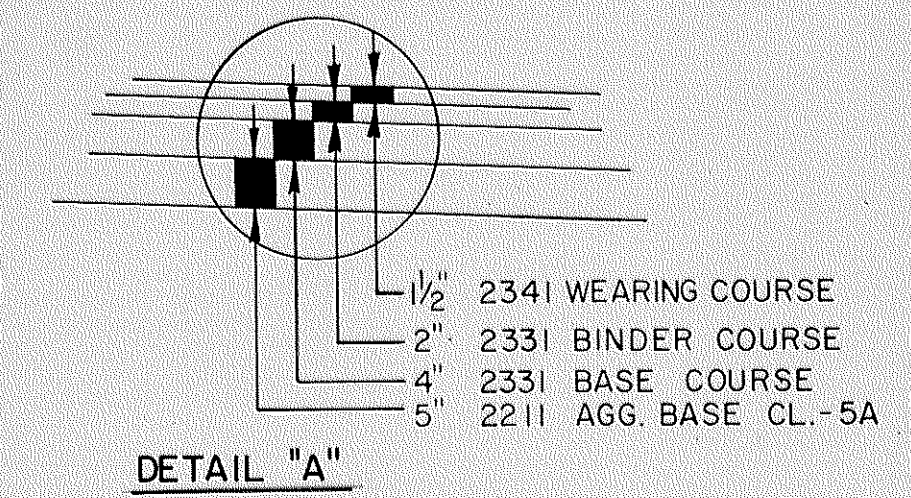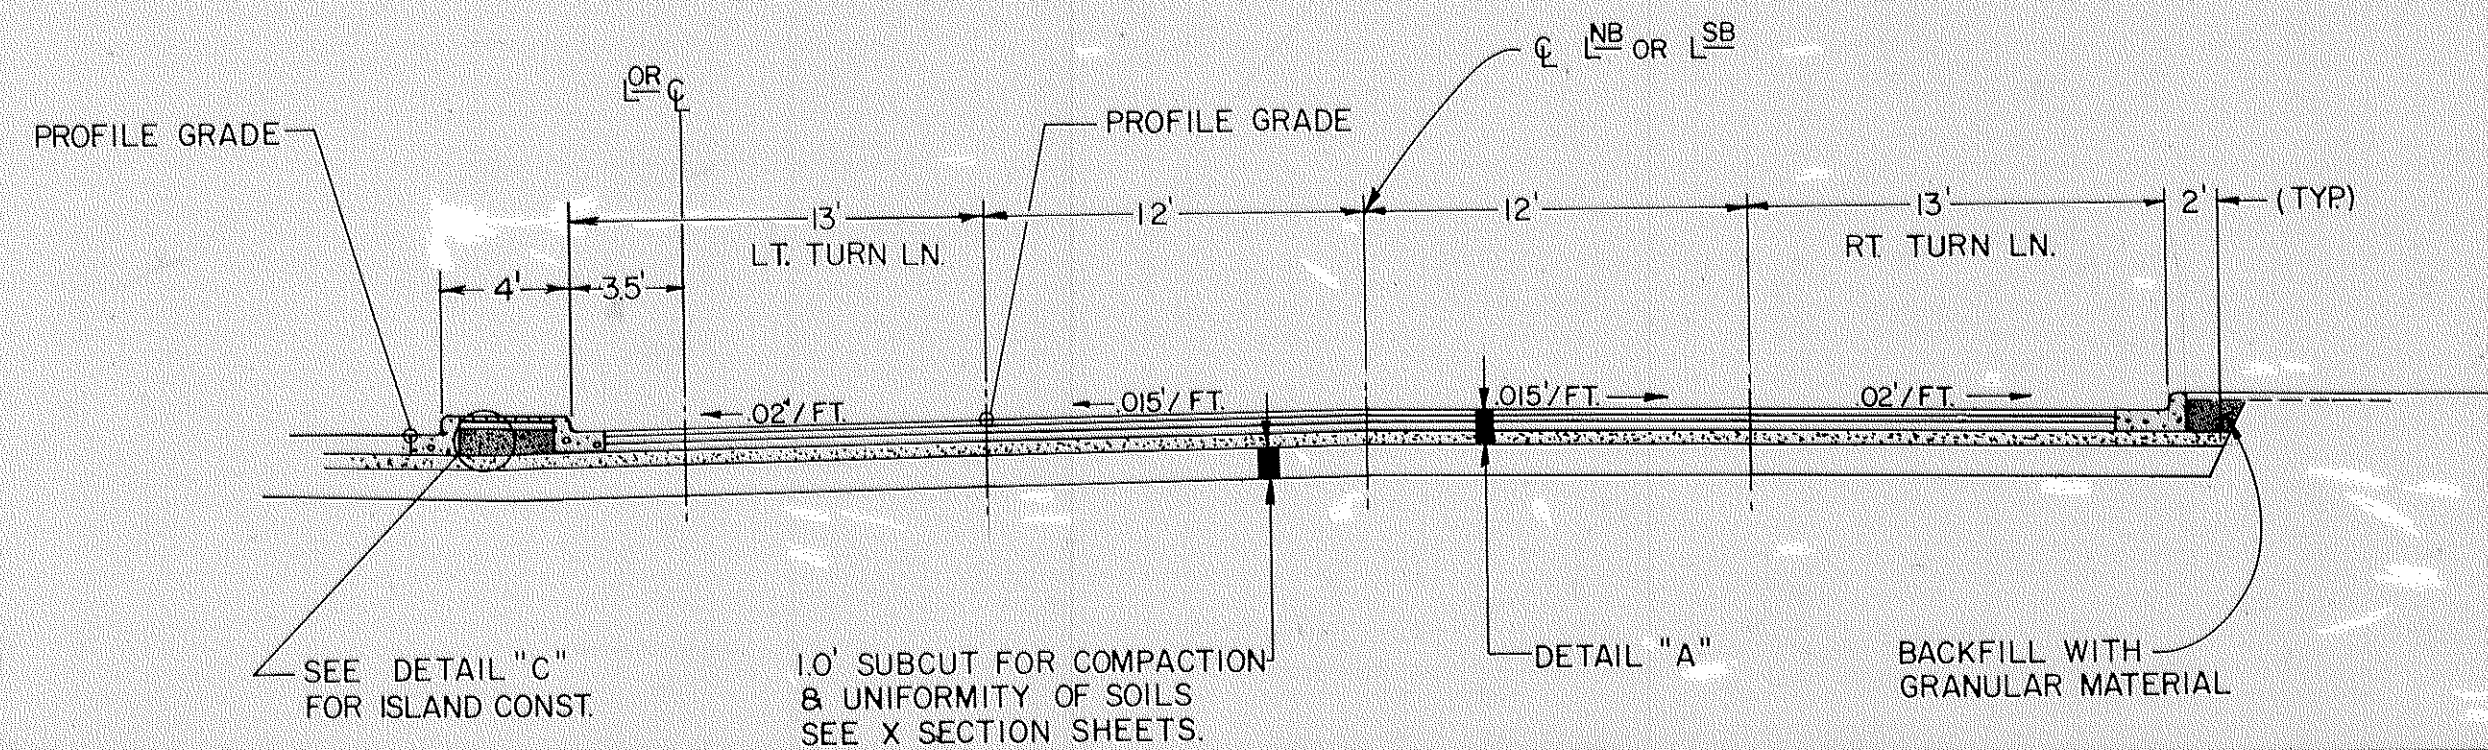

- ④ VAR. IN TRANSITION CONSTRUCTION AREAS.
- ⑤ 13' IN BUS PAD CONSTRUCTION AREAS. VARIES FROM 2'-8' IN TRANSITION AREAS. SEE PLAN & PROFILE SHEETS GEOMETRICS.
- ⑥ SEE PLAN & PROFILE SHEETS FOR GEOMETRICS.

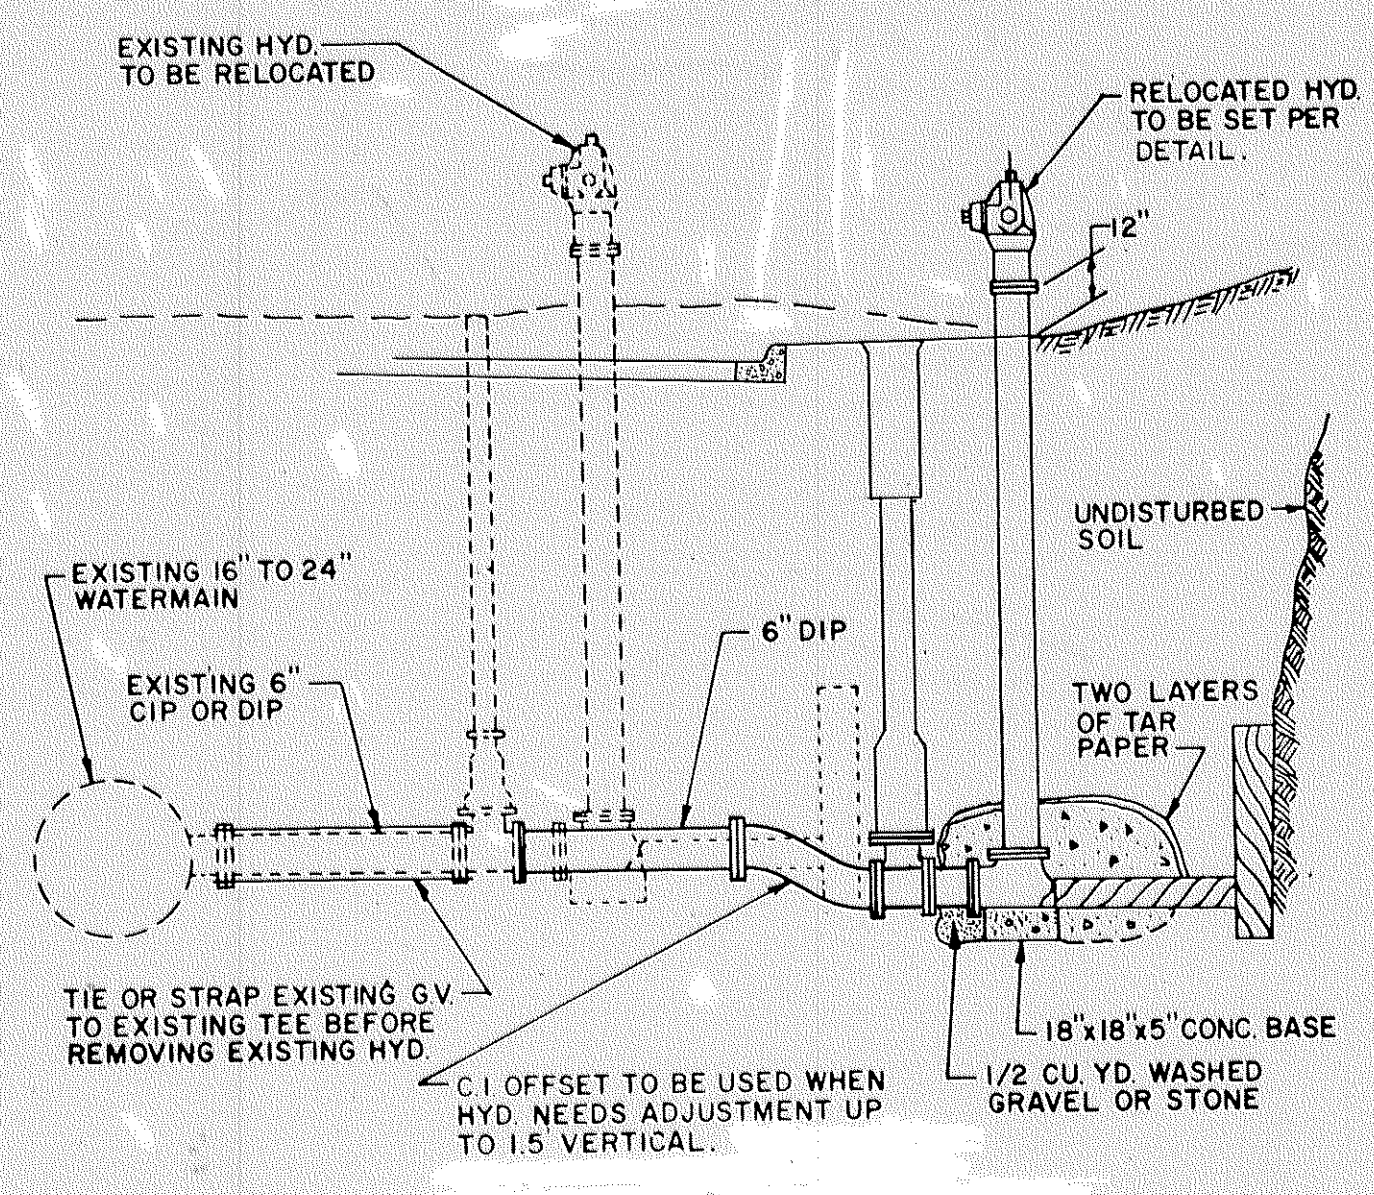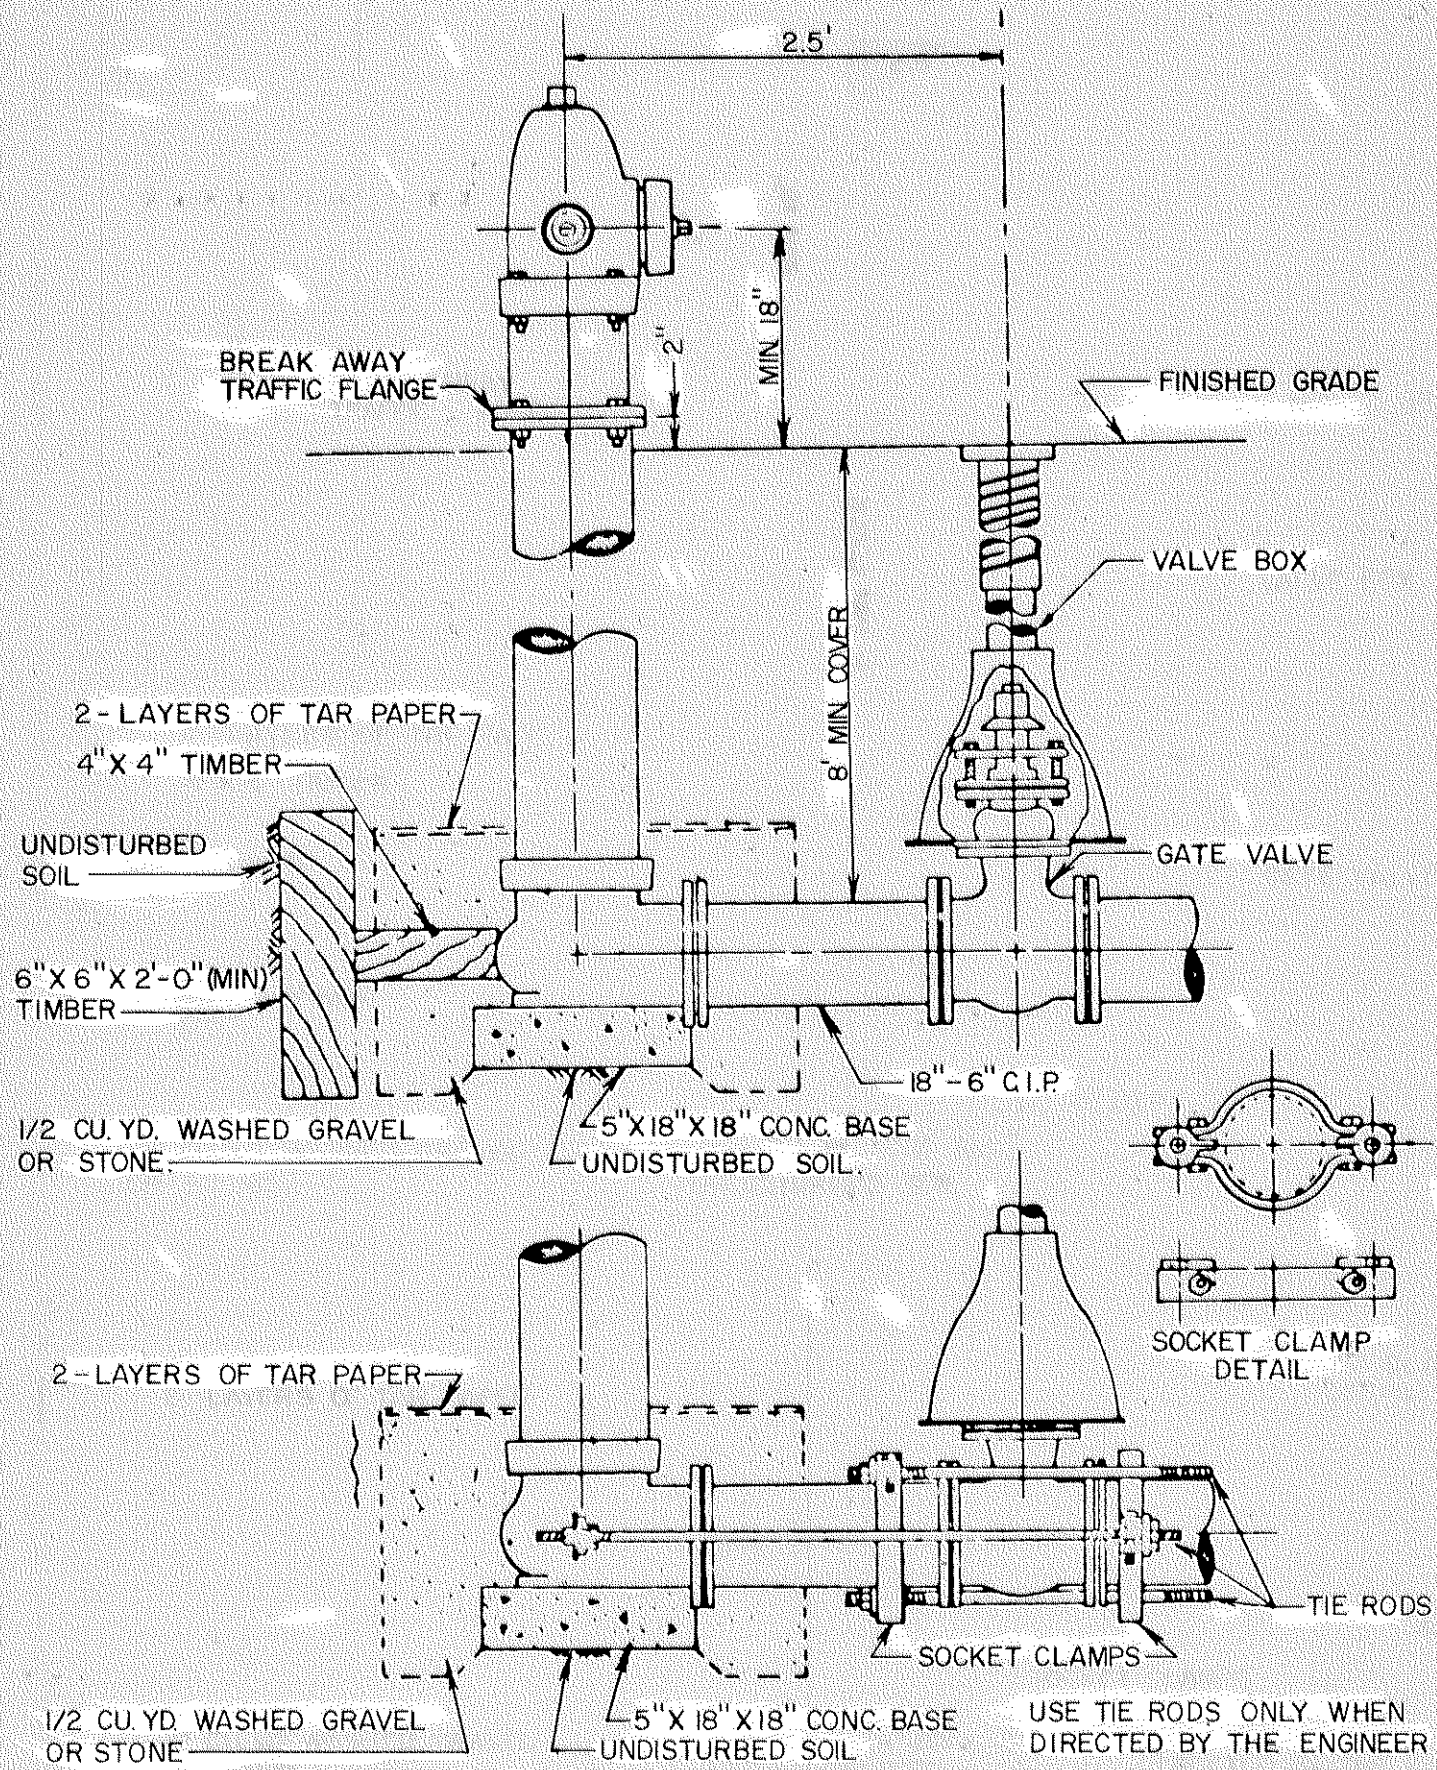

NOTE: HYDRANT RELOCATION SHALL INCLUDE ALL TOOLS, MATERIALS AND LABOR TO SECURE THE EXISTING GATE VALVE TO THE EXISTING TEE, REMOVE AND RELOCATE THE EXISTING HYDRANT WITHOUT SHUTTING DOWN THE EXISTING WATERMAIN. CONSTRUCT ACCORDING TO DETAILS AS SHOWN AND IN ACCORDANCE WITH THE CITY OF FRIDLEYS REQUIREMENTS.

FENCING						
STATION	LOC.	SALVAGE	INSTALL	F & I	REMOVE	REMARKS
SB 95+79 TO 97+11	16' LT.	71'	71'		113	WOVEN WIRE INSTALL FROM STA 95+79-96+50
SB 97+32 TO 99+20	39' LT.			188'		DES. 60-9322 INSTALL ALONG TOP OF RET. WALL
SB 102+73 TO 103+21	6' LT.				116'	CHAIN LINK FENCE
SB 107+80 TO 108+57	18' LT.				77'	WOOD FENCE
SB 111+16 TO 112+00	37' LT.	95'	84'			WOOD FENCE
SB 113+06 TO 113+88	38' LT.	88'	82'			WOOD FENCE
SB 114+27 TO 115+26	26' LT.	135'	101'			WOOD FENCE
SB 115+52 TO 116+00	26' LT.	68'	48'			WOOD FENCE
TOTAL		457'	386'	188'	306'	

CLEARING AND GRUBBING				
STATION (TO STATION)	LOC.	CLEARING TREE	GRUBBING TREE	ACRE
SP 02-608-07				
WB 202+08	7' LT.	1	1	
WB 202+16	31' LT.	3	1	
WB 202+36	27' LT.	1	1	
WB 202+43	14' LT.	1	1	
WB 202+54	24' LT.	1	1	
WB 202 72	14' LT.	1	1	
WB 202+76	14' LT.	1	1	
WB 203+45	20' LT.	1	1	
WB 203+47	28' LT.	1	1	
TOTALS		10	9	

TYPICAL HYDRANT SETTING DETAIL

HYDRANT RELOCATION DETAIL

HYDRANT RELOCATION		
SP 02-601-33		
LOCATION	NEW LOCATION	REMARKS
NB 96+50 7' RT.	NB 96+50 27' RT.	
SB 101+55 3' LT.	SB 101+55 27' LT.	
SB 107+45 27' LT.	SB 107+45 30' LT.	
SB 112+40 35' LT.	SB 112+40 38' LT.	
SB 116+10 32' LT.	SB 116+10 42' LT.	

MISCELLANEOUS REMOVAL							
STA. TO STA.	LOC.	DESCRIPTION	UNIT				ABANDON
			LIN FT	SQ YD	CU YD	STRUCT	
SP 02-601-33							
NB 97+95 TO 98+15	15' RT.	CONC. CURB	20				
NB 100+28	25' RT.	CONC. CURB	10				
SB 101+73	19' LT.	CONC. CURB & GUTTER	35				
SB 102+00	9' LT.	CONC. CURB & GUTTER	55				
SB 102+15	8' LT.	CONC. PAVEMENT		45			
NB 102+20 TO 104+20	28' RT.	CONC. CURB & GUTTER	220				
NB 103+90 TO 104+20	11' RT.	CONC. CURB & GUTTER (ISLAND)	80				
SB 104+48	32' LT.	CONC. CURB & GUTTER	20				
SB 104+98	30' LT.	CONC. CURB & GUTTER	30				
SP 02-608-07							
192+19 TO 199+60	LT.	REMOVE BIT. PAVEMENT FOR MEDIAN		30			
EB 202+95	13' RT.	CONC. CURB	10				
EB 206+66	13' RT.	CONC. PAVEMENT		11			
FOR 213+16	32' RT.	CONC. CURB	10				
FOR 213+54	37' RT.	CONC. CURB	5				
FOR 215+90	60' RT.	CONC. CURB & GUTTER	20				
FOR 209+10	LT. & RT.	TRENCH PAVEMENT		83			



SAWING PAVEMENT			
STATION	LOCATION	SAW BIT. PAVEMENT	SAW CONG. PAVEMENT
SP 02-601-33			
NB 92+55	ENT. RT.	16	
NB 93+43	ENT. RT.	12	
94+00	LT. & RT.	52	
NB 94+10	ENT. RT.	12	
NB 94+59	ENT. RT.	10	
SB 95+55	GLEN CREEK RD. LT.	30	
NB 95+99	ENT. RT.	12	
NB 96+80 TO 98+00	BIT. LOT. RT.	120	
NB 100+46	ENT. RT.	35	
NB 101+10 TO 102+18	ENT. RT.	108	
SB 101+95	TALMAGE WAY LT.	35	
SB 104+75	OSBORNE WAY LT.	100	
SB 107+25	75TH WAY LT.	24	
NB 110+81	ENT. RT.	10	
SB 112+60	RICKARD RD. LT.	36	
NB 112+84	ENT. RT.	10	
NB 115+69	ENT. RT.	11	
SB 116+25	GRAIG WAY LT.	32	
NB 116+93	ENT. RT.	16	
NB 91+50 TO 94+00	RT.	250	
TOTAL		931	
SP 02-608-07			
EB 201+25 TO 201+78	ENT. RT.	53	
WB 201+45	ENT. RT.	15	
EB 202+30 TO 203+00	BIT. LOT. RT.	70	
WB 202+62	ENT. LT.	12	
EB 206+66	ENT. RT.		24
207+50	LT. & RT.	46	
207+50 TO 215+85	23' RT.	835	
FOR 209+03	LT. & RT.	50	
FOR 209+18	LT. & RT.	50	
213+34	ENT. RT.	32	
215+85	LT. & RT.	100	
TOTAL		1263	24

VALVE BOX - WATER		
SP 02-601-33		
STATION	LOCATION	REMARKS
SB 95+44	10' LT.	
NB 100+67	37' RT.	
NB 100+70	36' RT.	
SB 101+71	11' RT.	
NB 104+12	22' RT.	
NB 104+26	15' RT.	
SB 107+32	11' LT.	
SB 116+22	18' LT.	
SP 02-608-07		
EB 205+33	3' LT.	
L 208+13	12' RT.	
L 213+97	13' RT.	
L 214+05	12' RT.	
TOTAL 12		

STATION (TO STATION)	LOC.	CLEARING TREE	GRUBBING TREE	ACRE
SP 02-601-33				
94+09	37' LT.	2	1	
94+26	37' LT.	2	1	
94+36	37' LT.	1	1	
95+04	48' LT.	1	1	
SB 96+85 TO 101+66	13'-38' LT	0.70	0.70	
SB 102+35	18' LT.	1	1	
SB 102+40	10' LT.	1	1	
SB 102+50	3' LT.	1	1	
SB 103+08	13' LT.	1	1	
SB 103+14	10' LT.	1	1	
SB 103+19	14' LT.	1	1	
SB 103+21	12' LT.	1	1	
SB 103+45 TO 104+20	20' TO 40' LT	0.10	0.10	
SB 105+69	28' LT.	9	1	
SB 106+17	27' LT.	1	1	
SB 106+56	25' LT.	1	1	
NB 107+44	21' RT.	1	1	
NB 107+75	21' RT.	1	1	
SB 108+11	30' LT.	1	1	
NB 110+21	10' RT.	2	1	
NB 110+28	10' RT.	1	1	
NB 110+94	18' RT.	1	1	
NB 110+94	26' RT.	1	1	
NB 111+92	8' RT.	1	1	
NB 111+92	11' RT.	1	1	
NB 111+92	17' RT.	1	1	
SB 112+15	38' LT.	1	1	
SB 113+03	35' LT.	1	1	
SB 113+08	35' LT.	1	1	
SB 113+09	37' LT.	1	1	
SB 113+38	37' LT.	1	1	
SB 113+83	29' LT.	1	1	
SB 114+42	31' LT.	1	1	
NB 115+03	14' RT.	4	1	
SB 115+13	24' LT.	1	1	
SB 115+18	25' LT.	1	1	
SB 115+50	26' LT.	1	1	
116+77	31' LT.	1	1	
95+25 TO 95+73	47' RT.	3	3	
TOTALS		52	39	.80

REINFORCED CONCRETE PAVEMENT
FOR
WATERMAIN PROTECTION
SCALE 1"=10'



Fed. Project No. _____

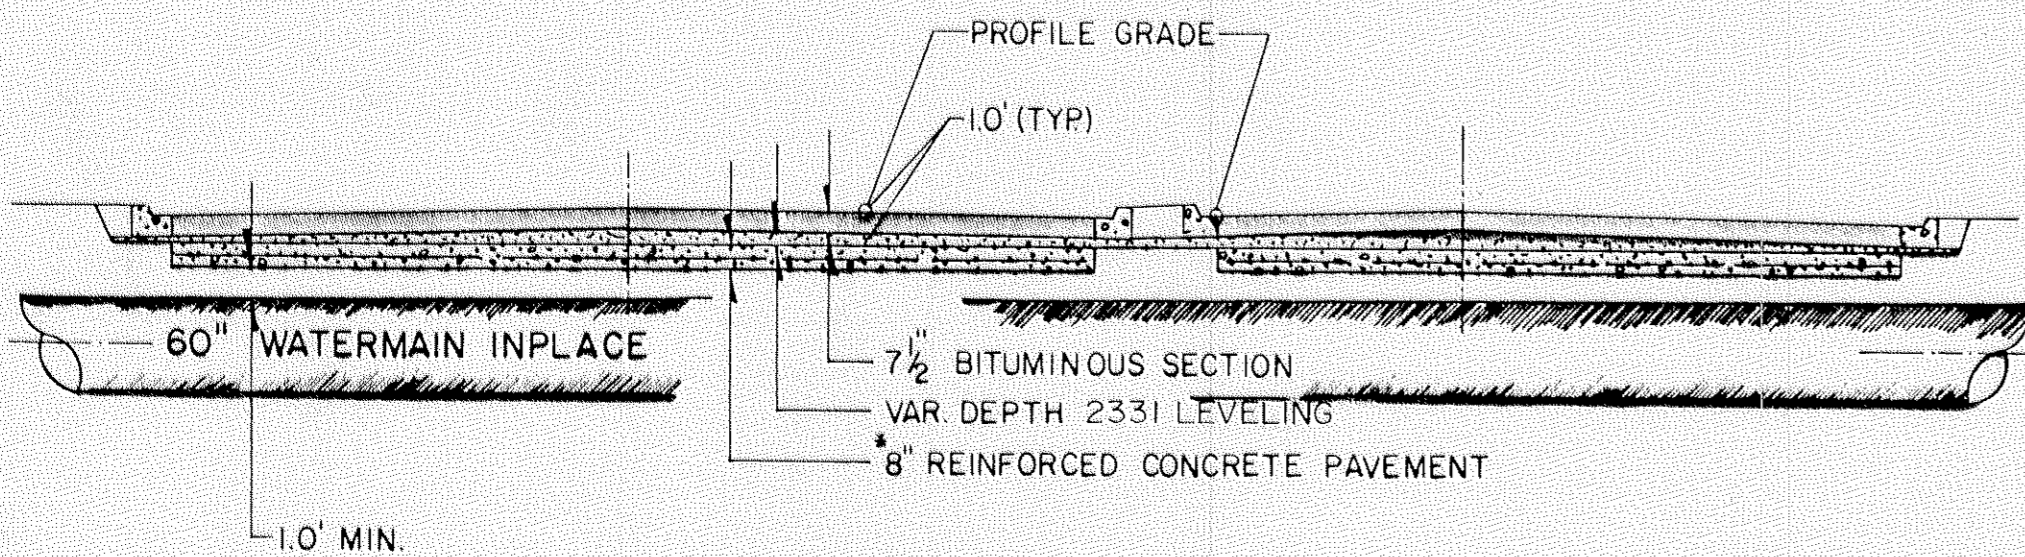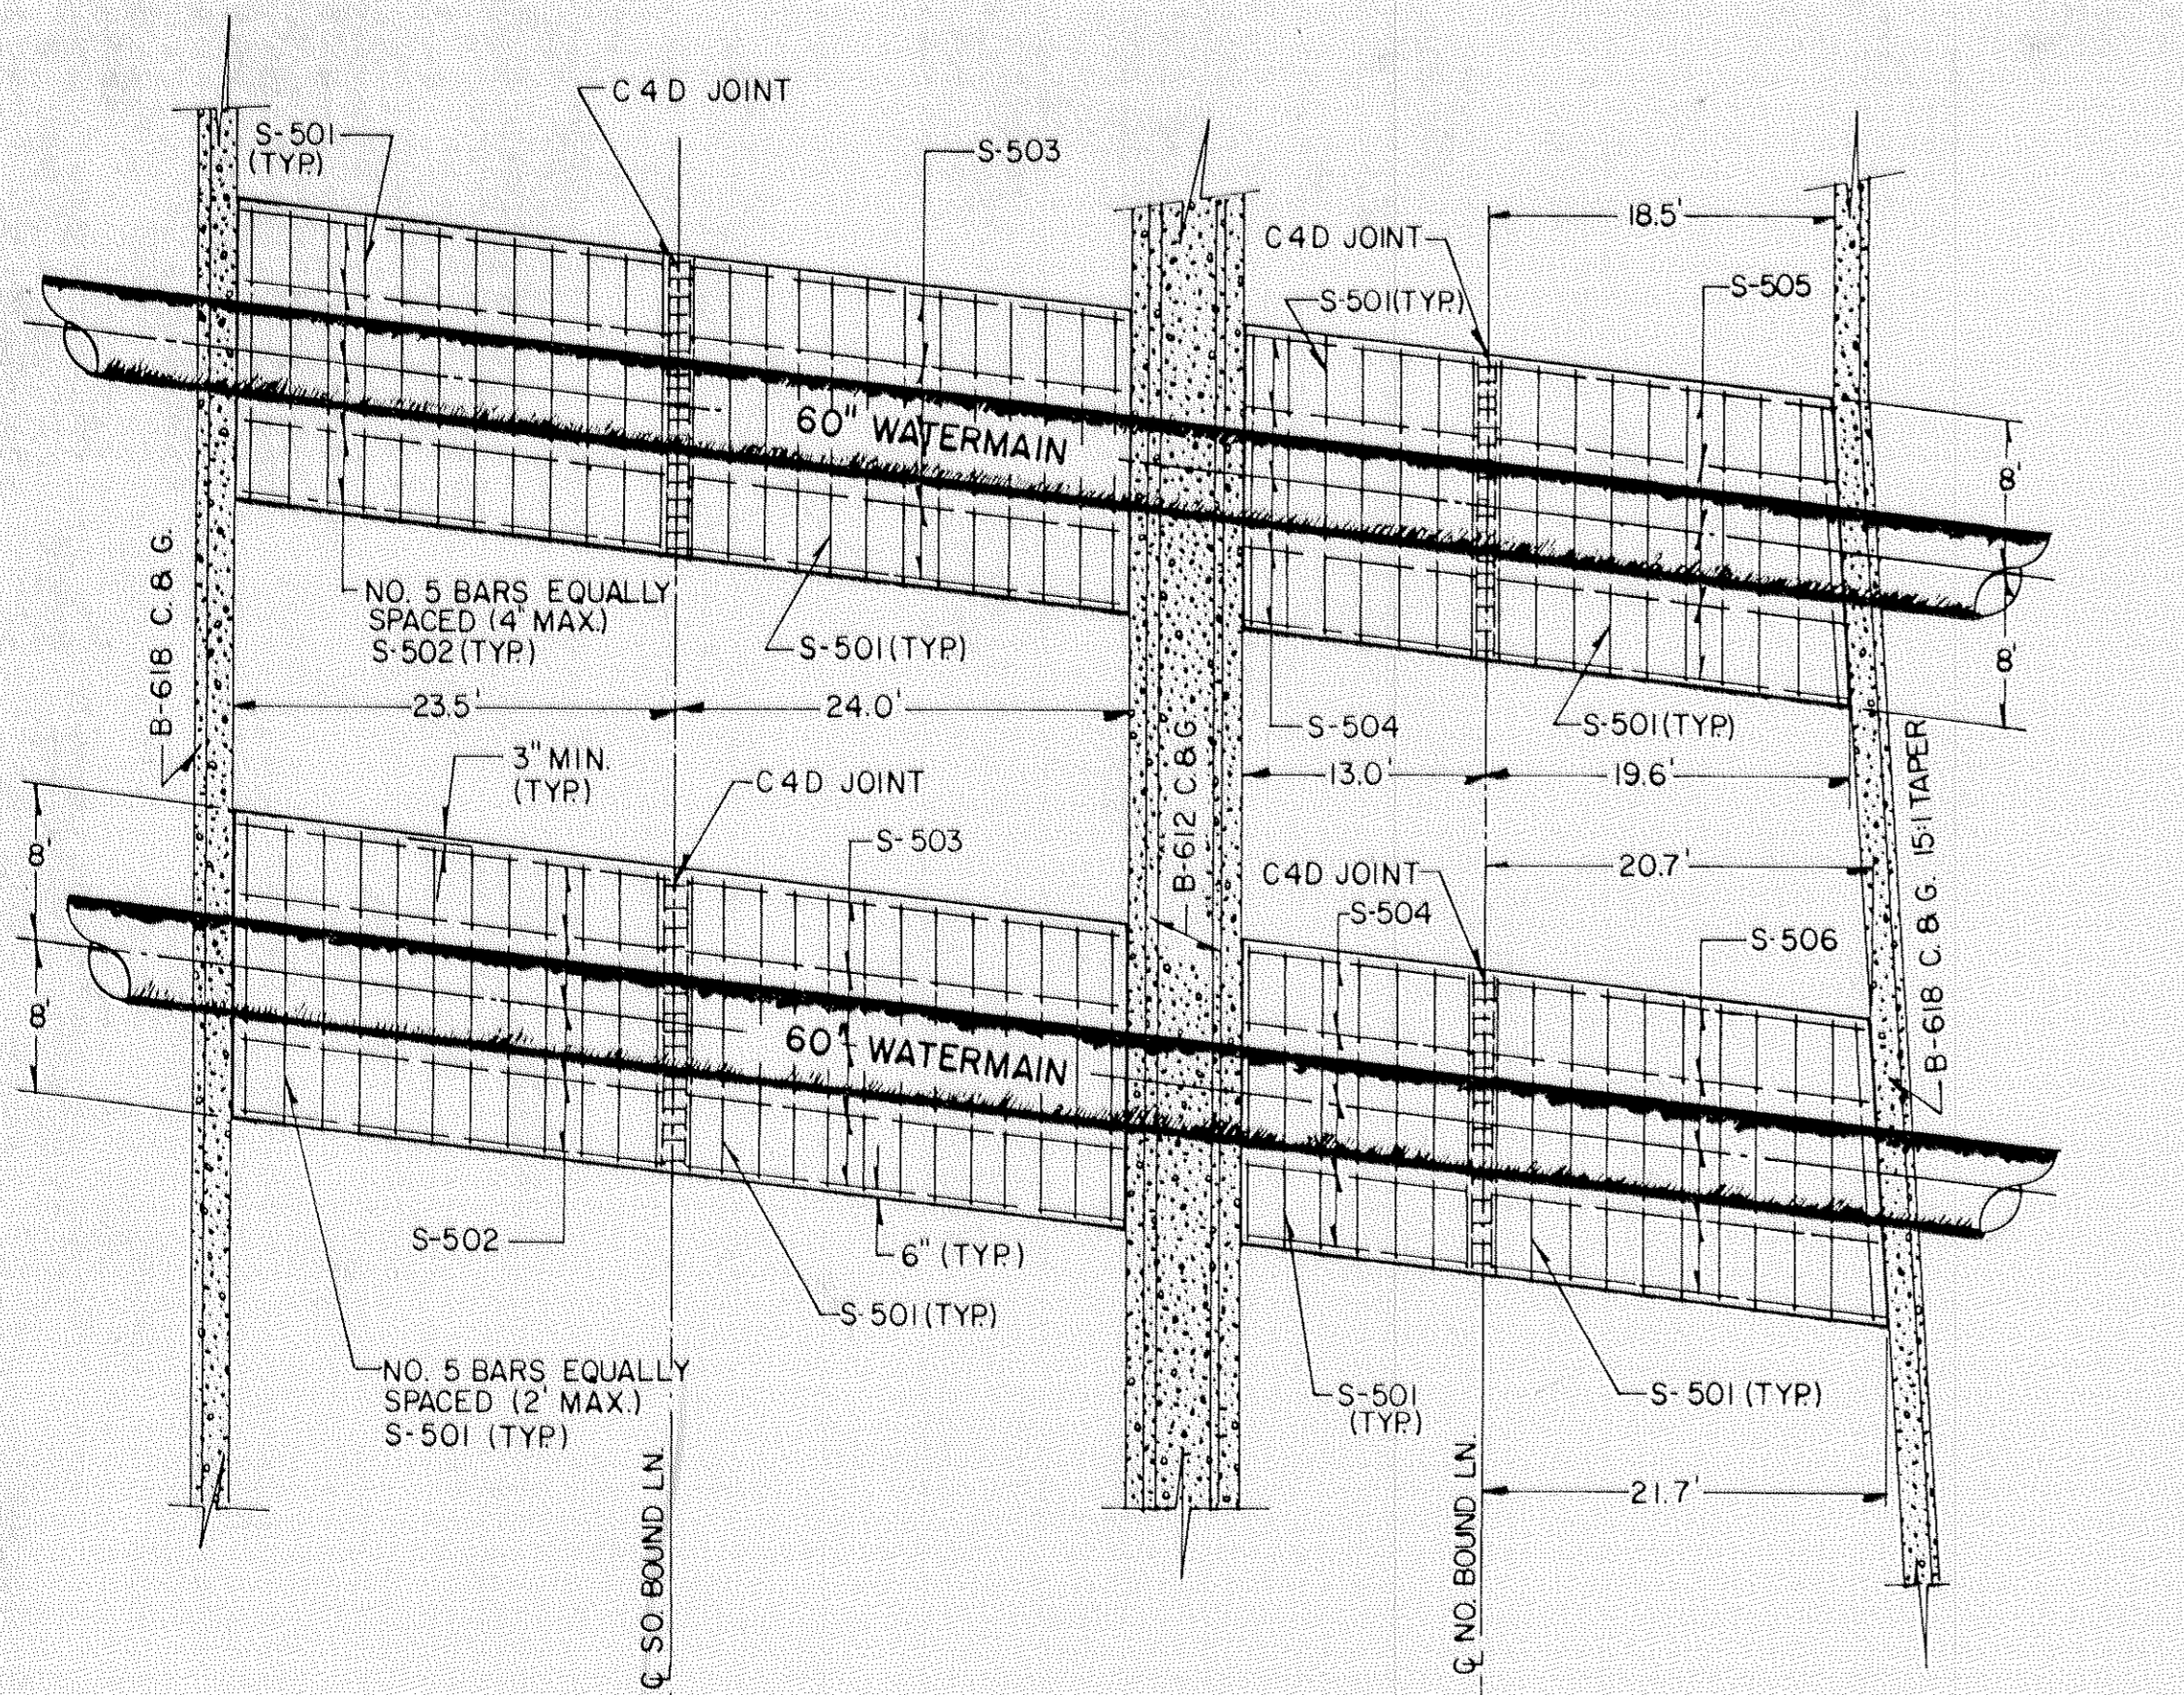

* NOTE:
CONCRETE SHALL BE HIGH EARLY STRENGTH


BILL OF REINFORCEMENT FOR CONCRETE PAVEMENT			
BAR	NO.	LENGTH	SHAPE
S 501	85	15'-6"	STRAIGHT
S 502	10	23'-0"	STRAIGHT
S 503	10	23'-6"	STRAIGHT
S 504	10	12'-6"	STRAIGHT
S 505	5	18'-0" TO 19'-0"	STRAIGHT
S 506	5	20'-0" TO 21'-0"	STRAIGHT

MEDIAN NOSE DETAIL

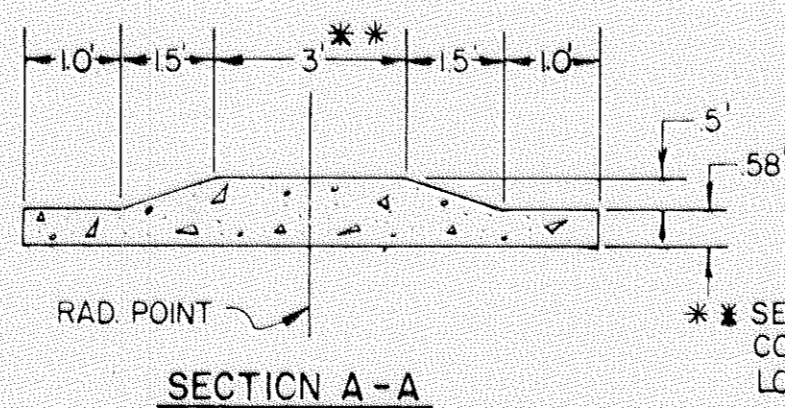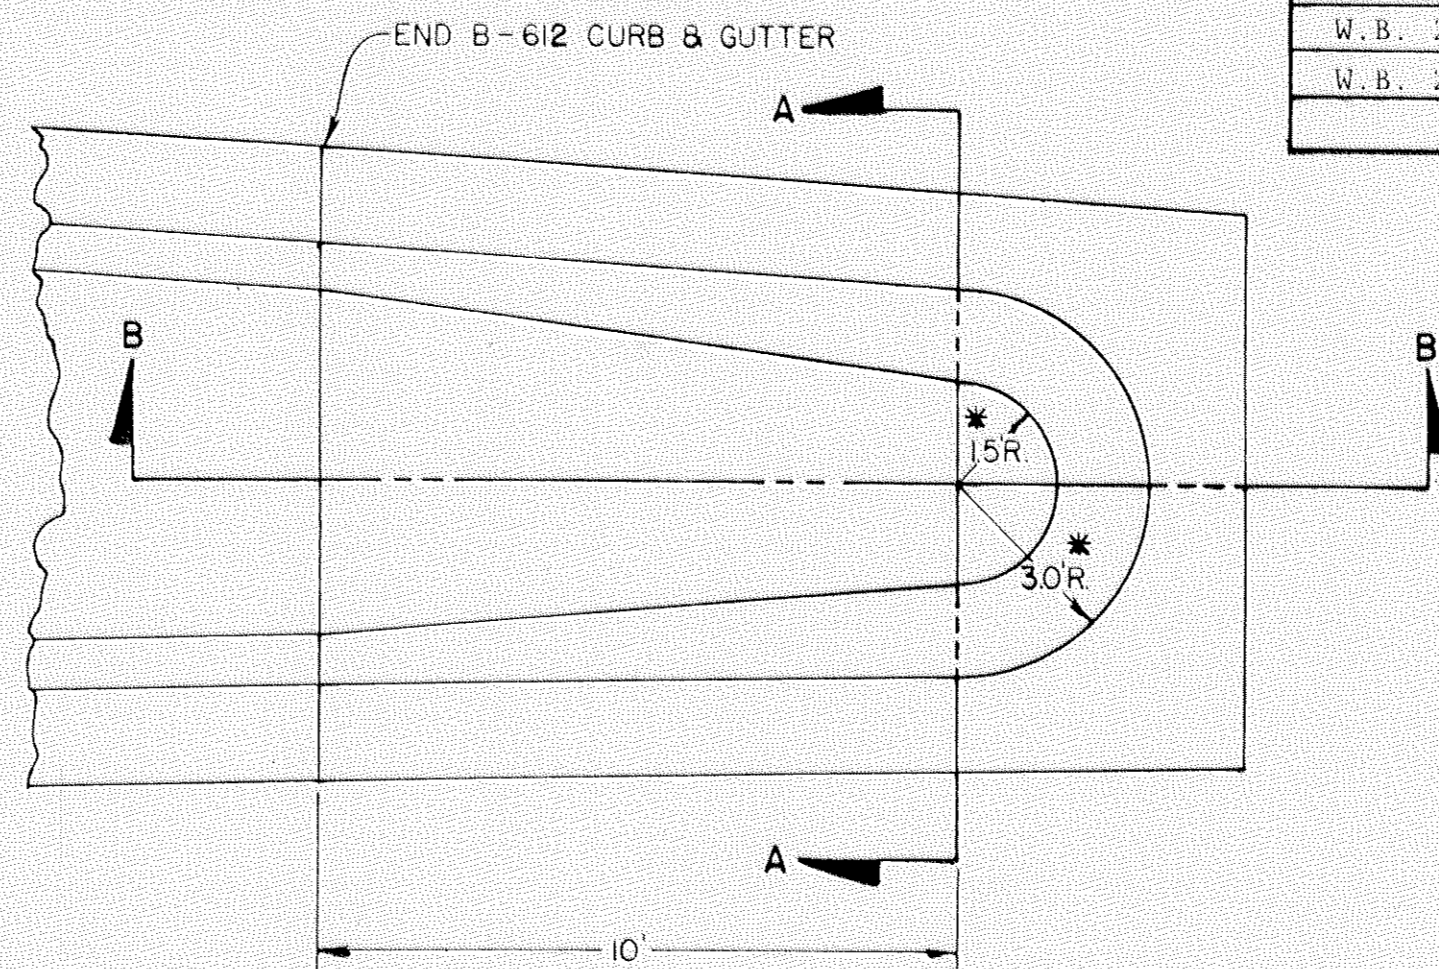


** SEE PLAN & PROFILE SHEETS FOR CONST. DETAILS & MODIFIED DIMS. LOCATIONS- STA 95+85, STA 115+31, STA 112+84

SECTION B-B

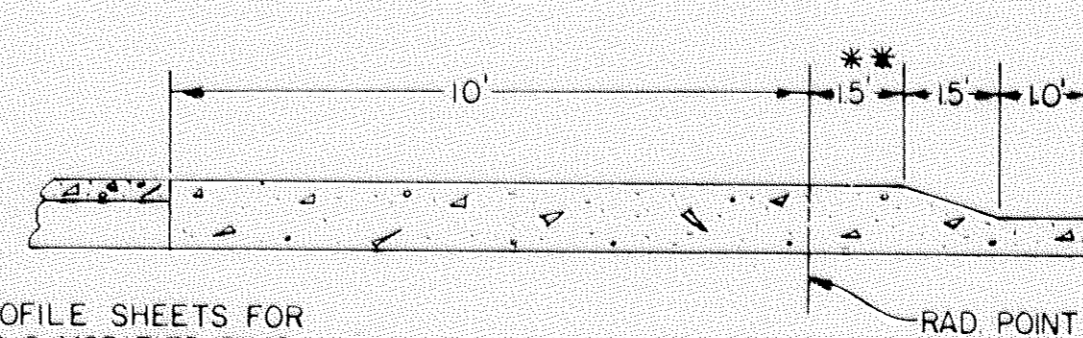

STATION TO STATION	LOC.	CURB, CURB AND GUTTER, MEDIAN, SIDEWALK, ETC.													
		CURB & GUTTER		CONC PAVEMENT		SIDEWALK		MEDIAN							
		B-612	B-618	REINF.	REINF.	4"	6"	CONC.	ALT I-1		ALT I-2		ALT I-3		
						NOSE	MEDIAN	MEDIAN	MEDIAN	MEDIAN	MEDIAN	SOD	TOPSOIL		
		LIN. FT	LIN. FT	SQ. YD.	SQ. YD.	SQ. FT.	SQ. FT.	EACH	SQ. YD.	SQ. YD.	SQ. YD.	SQ. YD.	SQ. YD.	CU. YD.	
S.P. 02-601-33								1							
S.B. 95+81 - 95+95	MEDIAN														
S.B. 95+95 - 104+13	MEDIAN	1645													
N.B. 104+30	RT.	70													
S.B. 104+75	LT.	85													
N.B. 105+45 - 112+27	MEDIAN	1364													
S.B. 112+94 - 115+21	MEDIAN	460													
N.B. 112+80 - 112+94	MEDIAN														
N.B. 115+21 - 115+35	MEDIAN														
N.B. 91+50 - 104+30	RT.		1305												
N.B. 105+07 - 105+70	RT.		80												
N.B. 105+70 - 106+30	RT.		60	87											
N.B. 106+30 - 112+05	RT.		575												
N.B. 112+05 - 112+65	RT.		60	87											
N.B. 112+65 - 118+85	RT.		620												
S.B. 94+05 - 95+40	LT.		164												
S.B. 95+67 - 101+80	LT.		647												
S.B. 102+10 - 103+60	LT.		165												
S.B. 103+60 - 104+20	LT.		60	87											
S.B. 104+20 - 104+55	LT.		45												
S.B. 105+00 - 111+55	LT.		655												
S.B. 111+55 - 112+15	LT.		60	87											
S.B. 112+15 - 112+47	LT.		60												
S.B. 112+80 - 116+15	LT.		370												
116+40 - 118+95	LT.		270												
CUL DE SAC (75th WAY)	LT.		257												
S.B. 95+95 - 100+10	MEDIAN								593	593			593	99	
S.B. 100+10 - 104+13	MEDIAN								153	153	153				
N.B. 105+47 - 112+25	MEDIAN								201	201	201				
N.B. 104+27 - 104+47	ISLAND								11	11	11				
N.B. 112+84 - N.B. 115+00	MEDIAN								282	282			282	47	
OSBORNE WAY	MEDIAN								12	12	12				
S.B. 103+60 - 104+48	LT.					480									
N.B. 105+15 - 105+46	RT.					170									
N.B. 105+46 - 105+58	RT.						60								
N.B. 105+58 - 106+30	RT.							415							
S.B. 111+55 - 112+40	LT.							550							
N.B. 112+05 - 112+65	RT.							300							
106+68	LT. & RT.			144.5											
107+01	LT. & RT.			144.5											
S.P. 02-608-07															
E.B. 200+90 - 202+40	MEDIAN	312							45	45	45				
E.B. 201+20 - 203+35	RT.		215												
E.B. 204+75 - 215+85	RT.		1145												
W.B. 201+07 - 203+45	LT.		238												
W.B. 204+80 - 215+85	LT.		1120												
TOTALS =		3936	8171	289	348	1915	60	3	422	875	1297	422	875	146	

CONCRETE BUS PAD

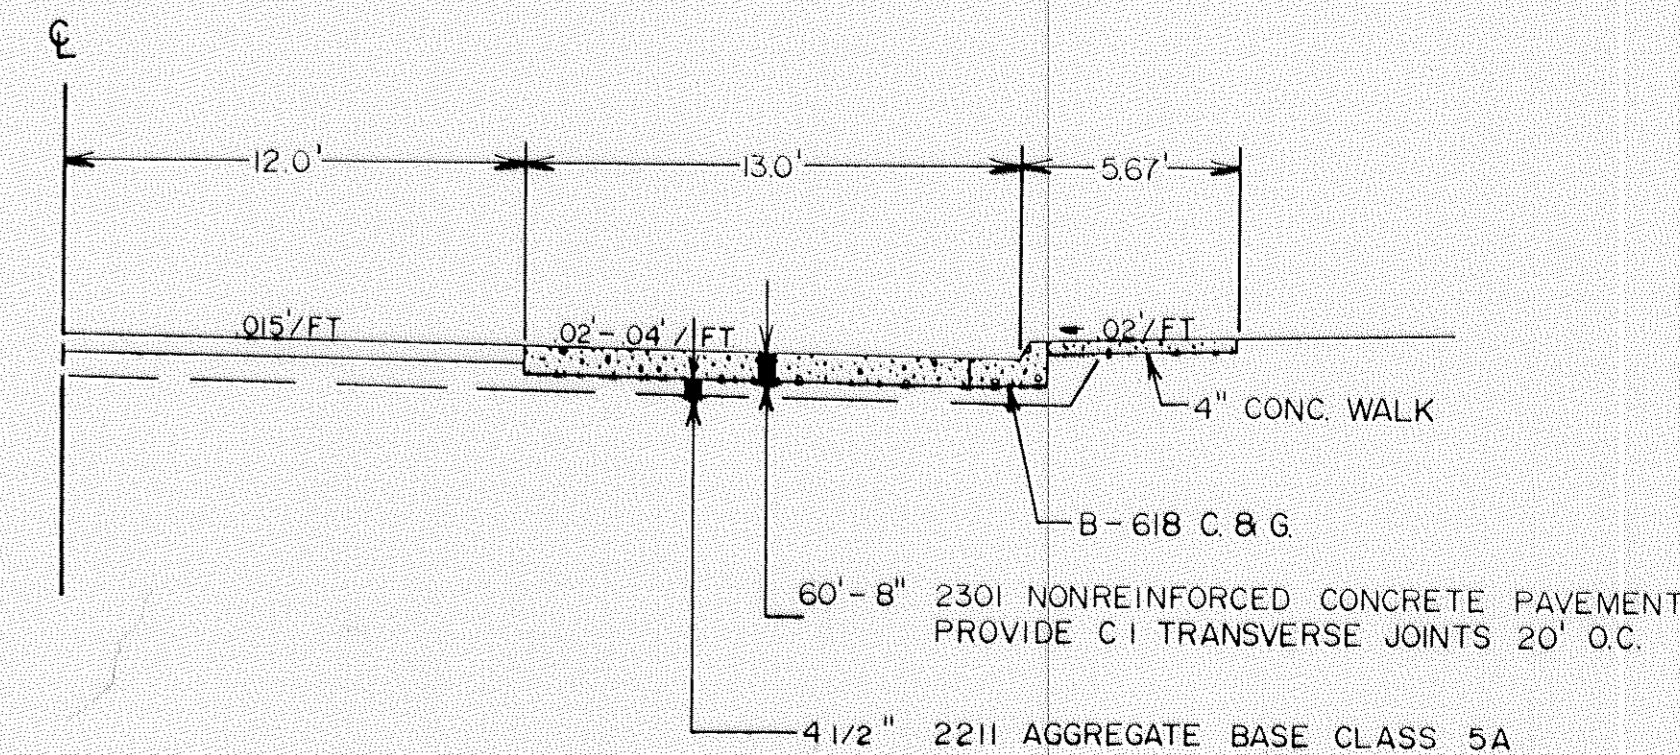

REVISIONS

DATE BY DATE BY

S.A.P. 02-601-33 S.P.02-608-07 C.P.


STORM SEWER CONST.

NO.	STA.	LOC.	REMARKS	TYPE	DESIGN	LIN. FT.	REMOVE SEWER PIPE	TOP	OUTLET	DRAINS TO	F&I CASTING ASSEMBLY	F. & I. R.C.P. SEWER						
												12" CL III	15" CL II	15" CL III	21" CL II	60" CL III		
1	NB 93+97	16.1' RT		CB	C OR G	5.1 5.3		856.59	851.29	CB 2	B							
2	SB 95+15	12.9' LT		CB	C OR G	5.0 5.2		855.78	850.61	CB 3	B							
3	SB 98+57	23.9' LT		CB	C OR G	5.7 5.7		852.04	846.20	CB 6	B							
4	NB 98+66	12.9' LT		CB	C OR G	5.4 5.4		854.12	848.58	CB 3	B	54'						
5	NB 98+66	18.9' RT		CB	C OR G	5.6 5.9		855.37	849.64	CB 4	B	32'						
6	SB 99+96	18.9' RT		CB	A OR F	5.5 6.4		850.94	844.25	MH 7	B					35' 32'		
7	SB100+29	29' LT	SALVAGE & INSTALL 60" RCP APRON	MH	A OR F	5.1 9.8		851.30	829.00	DITCH	A						78' 86'	
8	SB100+84	18.9' LT		CB	A OR F	5.7 6.2		850.44	844.15	MH 7	B							
9	NB101+16	23.9' LT		CB	A OR F	6.3 6.9		852.05	845.58	CB 13	B	38'						
10	NB100+94	23.9' RT		CB	C OR G	5.3		853.70	848.24	MH 10A	B	24' 25'						
10A	NB100+90	50' RT	MH INPL. (TO REMAIN INPL.)	MH				852.73	847.38	DITCH								
11	NB100+92	26' LT	CB INPL. REMOVE C.B. STRUCT.	CB			18"x46' CMP			DITCH								
12	SB100+75	8' RT	MH INPL. SALVAGE CASTING, REMOVE M.H. STRUCT.	MH			15"x40' CMP			DITCH								
13	SB100+95	18.9' LT		CB	C OR G	5.0		850.43	844.37	CB 8	B						11'	
14	SB101+55	7' RT	CB INPL. REMOVE C.B. STRUCT.	CB			15"x80' CMP			MH 12								
15	SB101+46	18.9' LT		CB	C OR G	5.3		850.57	845.08	CB 13	B						51' 49'	
16	SB101+70	25' LT	CB INPL. REMOVE C.B. STRUCT.	CB			15"x37' CMP			CB 14								
17	SB101+75	35' LT	CB INPL. REMOVE C.B. STRUCT.	CB			15"x 8' CMP			CB 16								
18	SB101+80	47' LT		CB/MH	C OR G	5.1 5.7		851.75	846.47	CB 15	B A					44' 46'		
19	SB102+16	55' LT		CB/MH	C OR G	5.2 5.6		852.40	847.01	CB 18	B A					34' 35'		
20	SB102+04	21' LT	CB INPL. REMOVE C.B. STRUCT.	CB			15"x30' CMP			CB 17								
21	SB102+37	10' LT		MH	C OR G	5.3 5.0		852.39	847.22	CB 15	A					91' 92'		
22	SB102+46	23.9' LT		CB	C OR G	4.0 4.4		851.85	847.65	MH 21	B	15' 17'						
23	SB102+90	2' LT	MH INPL. (TO REMAIN) ADJ. CASTING	MH			15"x90' RCP	853.45	848.17	MH 21						53' 56'		
24	SB104+51	15' LT	MH INPL. (TO REMAIN) ADJ. CASTING	MH				855.40	850.45	MH 23							83' 81'	
25	SB105+34	23.9' LT		CB	C OR G	4.7 4.9		855.94	851.11	MH 24	B							
26	SB106+59	23.9' LT		CB	C OR G	5.0		857.11	851.97	CB 25	B					107' 112'		
26A	SB106+60	38' LT		CB	C OR G	4.8 4.4		857.30	852.36	CB 26	B	14'						
27	NB103+68	20' RT	MH INPL. SALVAGE CASTING, RECONSTRUCT 55', INSTALL CASTING	MH				854.60	849.64	MH 10A								
28	NB104+06	37' RT	LOCATE IN 60' RAD.	CB	C OR G	4.4 4.3		854.54	849.96	MH 27	B					43'		
29	NB104+10	51' RT	C.B. INPL. SALVAGE CASTING, REMOVE C.B. STRUCT.	CB			12"x38' RCP			MH 31								
30	EB201+17	23' RT	LOCATE IN 60' RAD.	CB	C OR G	4.6 4.4		855.00	850.18	CB 28	B					30' 34'		
31	NB104+41	28' RT	MH INPL. SALVAGE CASTING, REMOVE MH STRUCT.	MH			15"x73' RCP			MH 27								
32	NB104+67	40' RT	CB INPL. SALVAGE CASTING, REMOVE C.B. STRUCT.	CB			12"x29' RCP			MH 31								
33	NB104+93	6' RT	CB INPL. SALVAGE CASTING, REMOVE C.B. STRUCT.	CB			12"x57' RCP			MH 31								
34	WB201+08	12.9' LT		CB	C OR G	4.3		855.17	850.66	CB 30	B					80'		
35	WB201+19	12.9' LT		CB	C OR G	4.1 4.3		855.28	851.02	CB 34	B	11'						
36	NB105+67	23.9' RT		CB	C OR G	4.7		856.02	851.10	CB 34	B					73'		
37	NB105+67	12.9' LT		CB	C OR G	4.6 4.8		856.48	851.72	CB 36	B	37'						
38	SB105+46	23.9' RT		CB	C OR G	4.1 4.4		856.05	851.78	CB 37	B	6'						
39	L 205+08	27' RT	CB INPL. SALVAGE CAST. REMOVE CB STRUCT. CONST. MH	MH	C OR G	4.7 4.5		860.79	856.16	INPL. 15" RCP	A							
40	205+19	23' LT	CB INPL. SALVAGE CAST. REMOVE CB STRUCT.	CB			15"x46' RCP			CB 39								
41	EB205+63	12.9' RT	INSTALL CE CASTING FROM # 39	CB	C OR G	3.9 4.1		860.41	856.36	MH 39						41' 39'		
42	WB205+40	12.9' LT	INSTALL CB CASTING FROM # 40	CB	H C OR G	3.4 4.0		860.41	856.84	CB 41		55'				55'		
43	L 209+05	24.9' RT		CB	C OR G	4.2 4.0		861.82	857.43	CB 41	B					355' 372'		
44	L 209+25	24.9' LT		CB	H C OR G	3.8 4.5		861.90	857.90	CB 43	B	54'						
45	115+76	27' RT	CB INPL. SALVAGE CASTING, REMOVE CB STRUCT.	CB			12"x10'			MH 46								
46	115+88	25' RT	MH INPL. (TO REMAIN) ADJUST CASTING	MH														
							TOTALS	584'			29 30	340' 311'	745' 828'	932' 933'	117' 116'	78' 86'		
19A	SB 102+30	LT.	TALMADGE WAY CUL-DE-SAC	CB	H	3.7				MH 19	B	23						


CASTING ASSEMBLIES			
ASSEMBLY	ITEM	CASTING NO.	QUANTITY
A	FRAME COVER	700-7 712	3
B	FRAME GRATE CURB BOX	801 810 821-B	26

ADJ. FRAME & RING CASTINGS		
SP 02-601-33		
STATION	LOCATION	REMARKS
NB 92+92	12' RT.	SAN. SEWER
NB 92+92	20' RT.	SAN. SEWER
NB 94+18	10' RT.	SAN. SEWER
NB 95+55	6' RT.	SAN. SEWER
NB 98+52	23' RT.	SAN. SEWER
NB 100+02	32' RT.	SAN. SEWER
NB 101+75	25' RT.	SAN. SEWER
SB 101+80	7' LT.	SAN. SEWER
SB 102+90	2' LT.	STORM SEWER
NB 104+34	12' RT.	SAN. SEWER
SB 104+51	15' LT.	STORM SEWER
NB 107+35	1' RT.	SAN. SEWER
NB 110+59	11' LT.	SAN. SEWER
NB 113+82	9' LT.	SAN. SEWER
NB 116+38	9' RT.	SAN. SEWER
118+82	28' RT.	SAN. SEWER
SP 02-608-07		
WB 205+24	5' LT.	SAN. SEWER
213+70	29' RT.	N.S.P. ADJ. BY OTHERS
215+88	25' RT.	STORM SEWER
TOTAL		18

EAST RIVER ROAD ALIGNMENT - S.P. 02-601-33

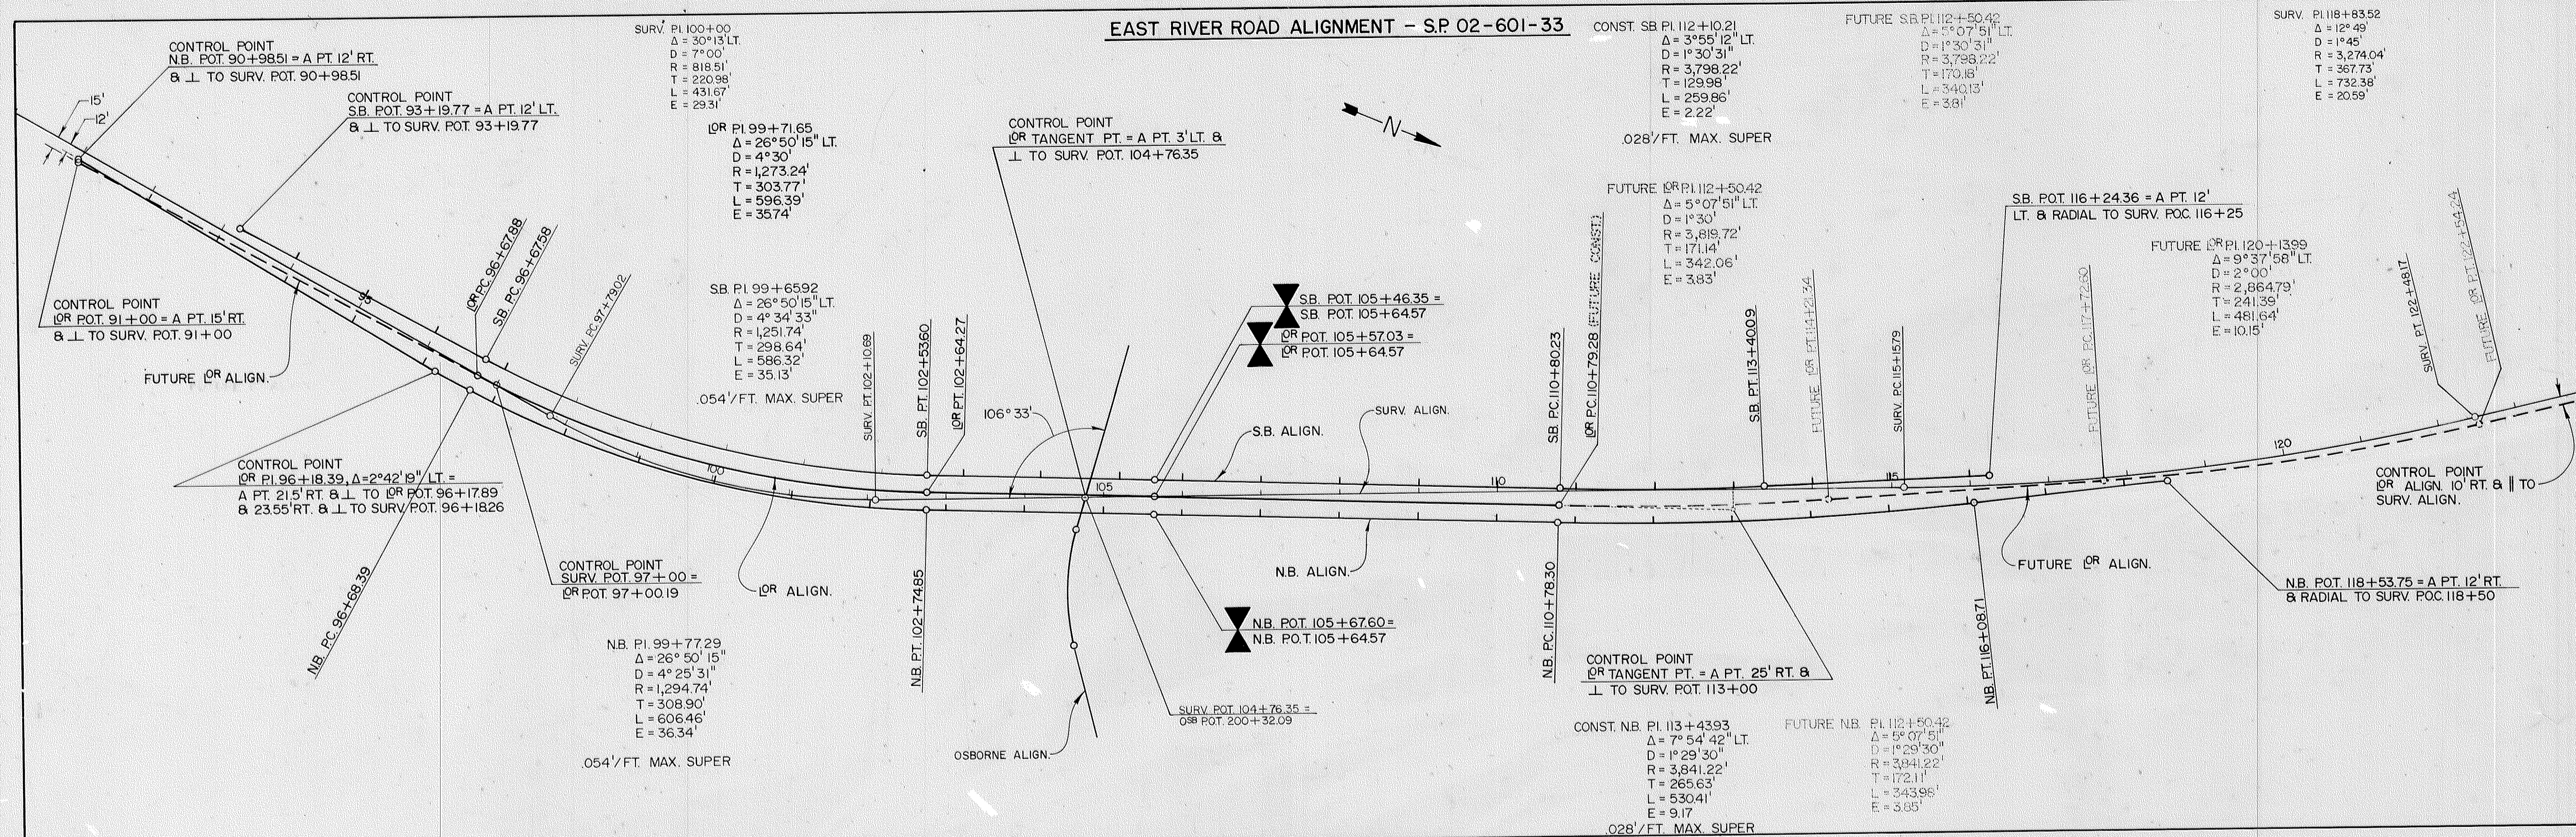

OSBORNE ROAD ALIGNMENT - S.P. 02-608-07

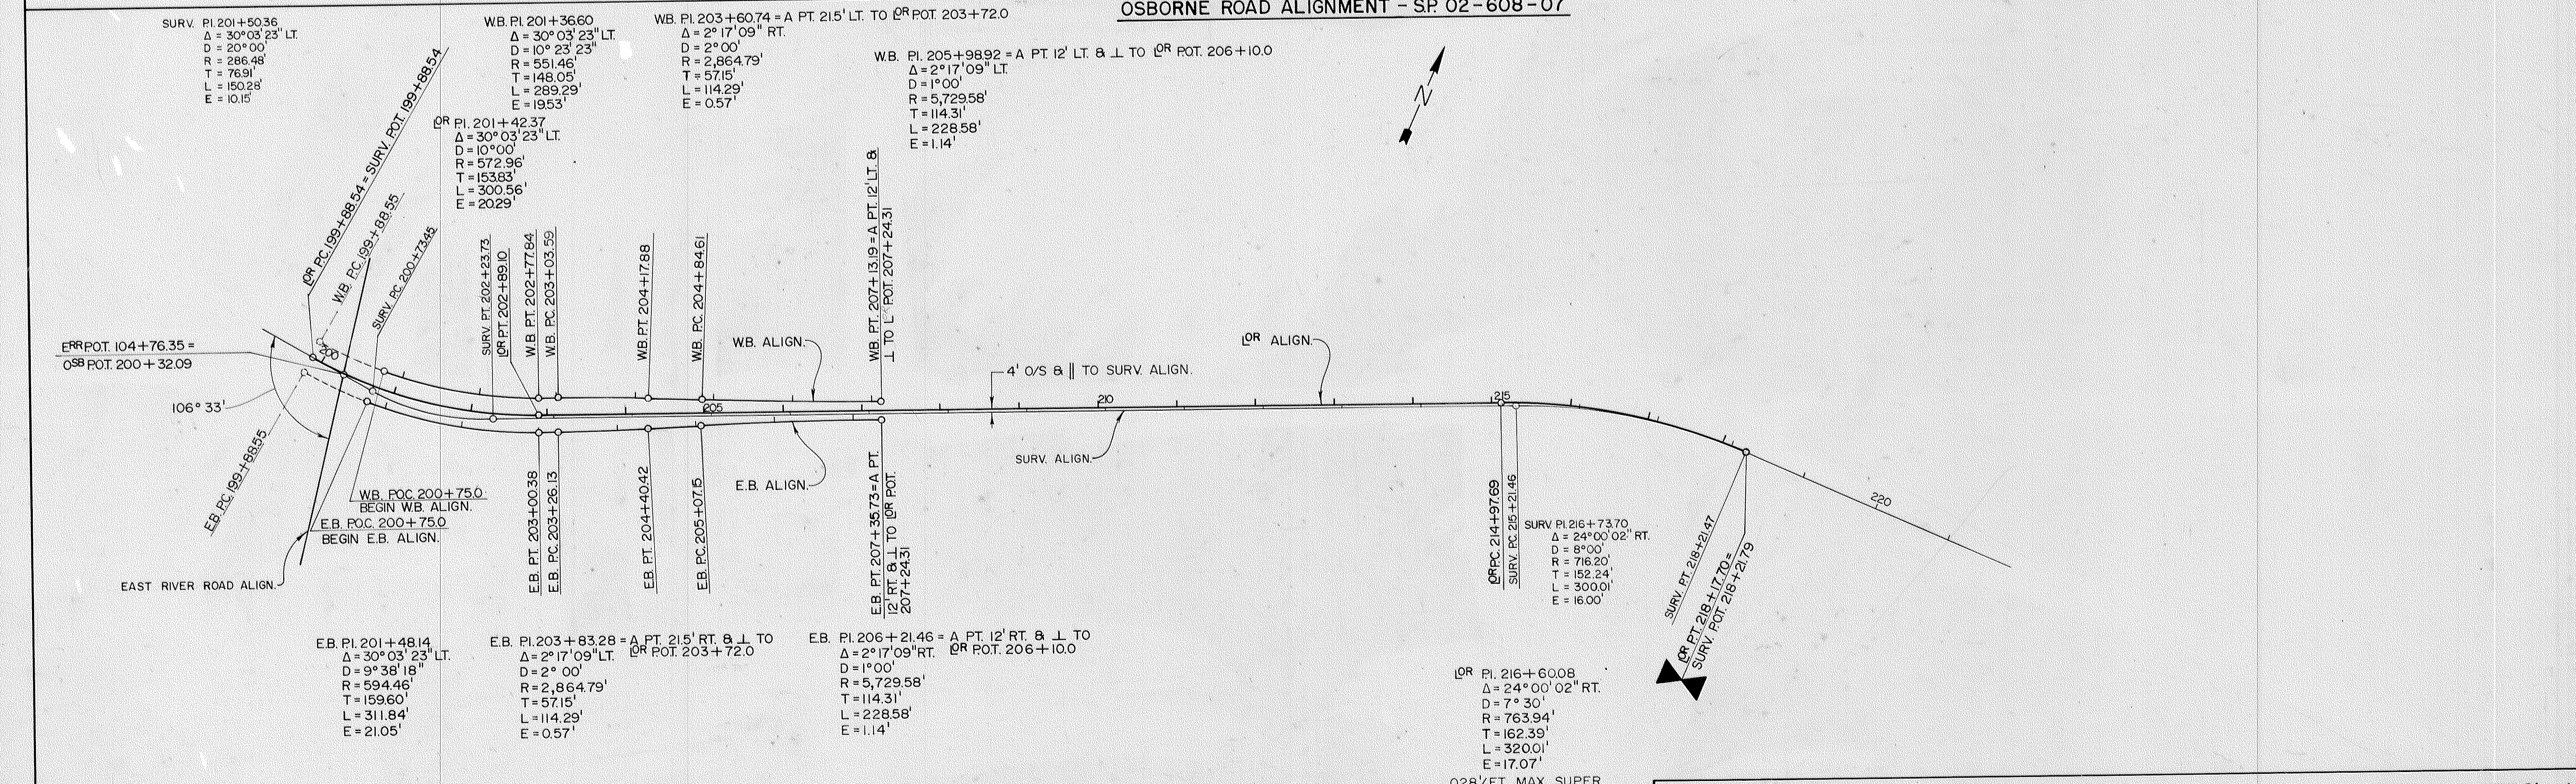

OSB PI 201+50.36
 $\Delta = 30^\circ 03' 23''$ LT
 $D = 20^\circ 00'$
 $R = 286.48$
 $T = 76.91'$
 $L = 150.28'$
 $E = 10.15'$


CAUTION: HEAVY EQUIPMENT WILL NOT BE ALLOWED TO CROSS OR WORK OVER 60" WATER CONDUIT.

BEGIN PROJECT S.P. 02-608-07
 STA. 199+20

ERR POT. 104+76.35 =
 OSB POT. 200+32.09

\triangle DENOTES PED. RAMP LOCATIONS

BM 1 ELEV 859.07
 TOP HYD SE COR
 ERR POT. 104+76.35

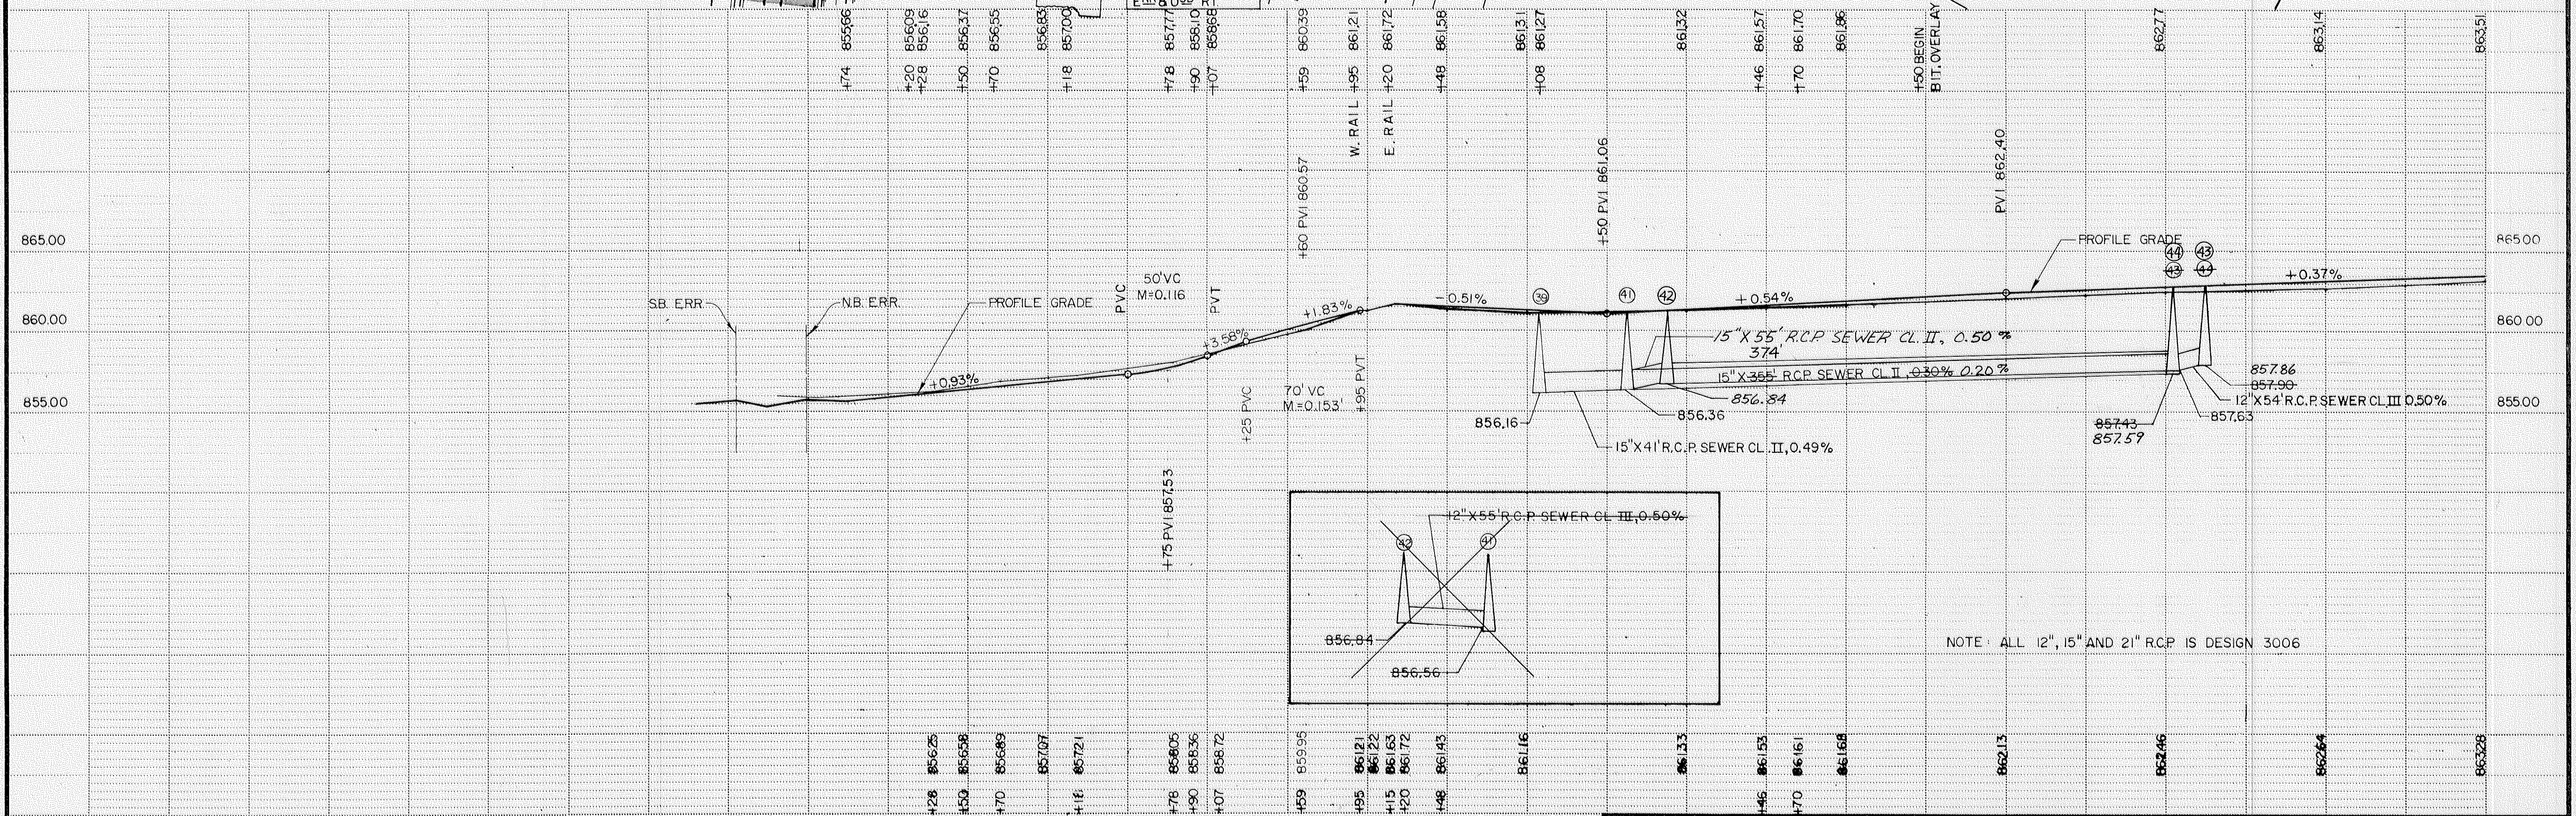



NOTE: ALL 12", 15" AND 21" R.C.P. IS DESIGN 3006

RECORD COPY
 3-21-89

State Proj. No. 02-608-07

Sheet No. 10 of 58 Sheets

CAUTION: HEAVY EQUIPMENT WILL NOT BE ALLOWED TO CROSS OR WORK OVER 60" WATER CONDUITS.

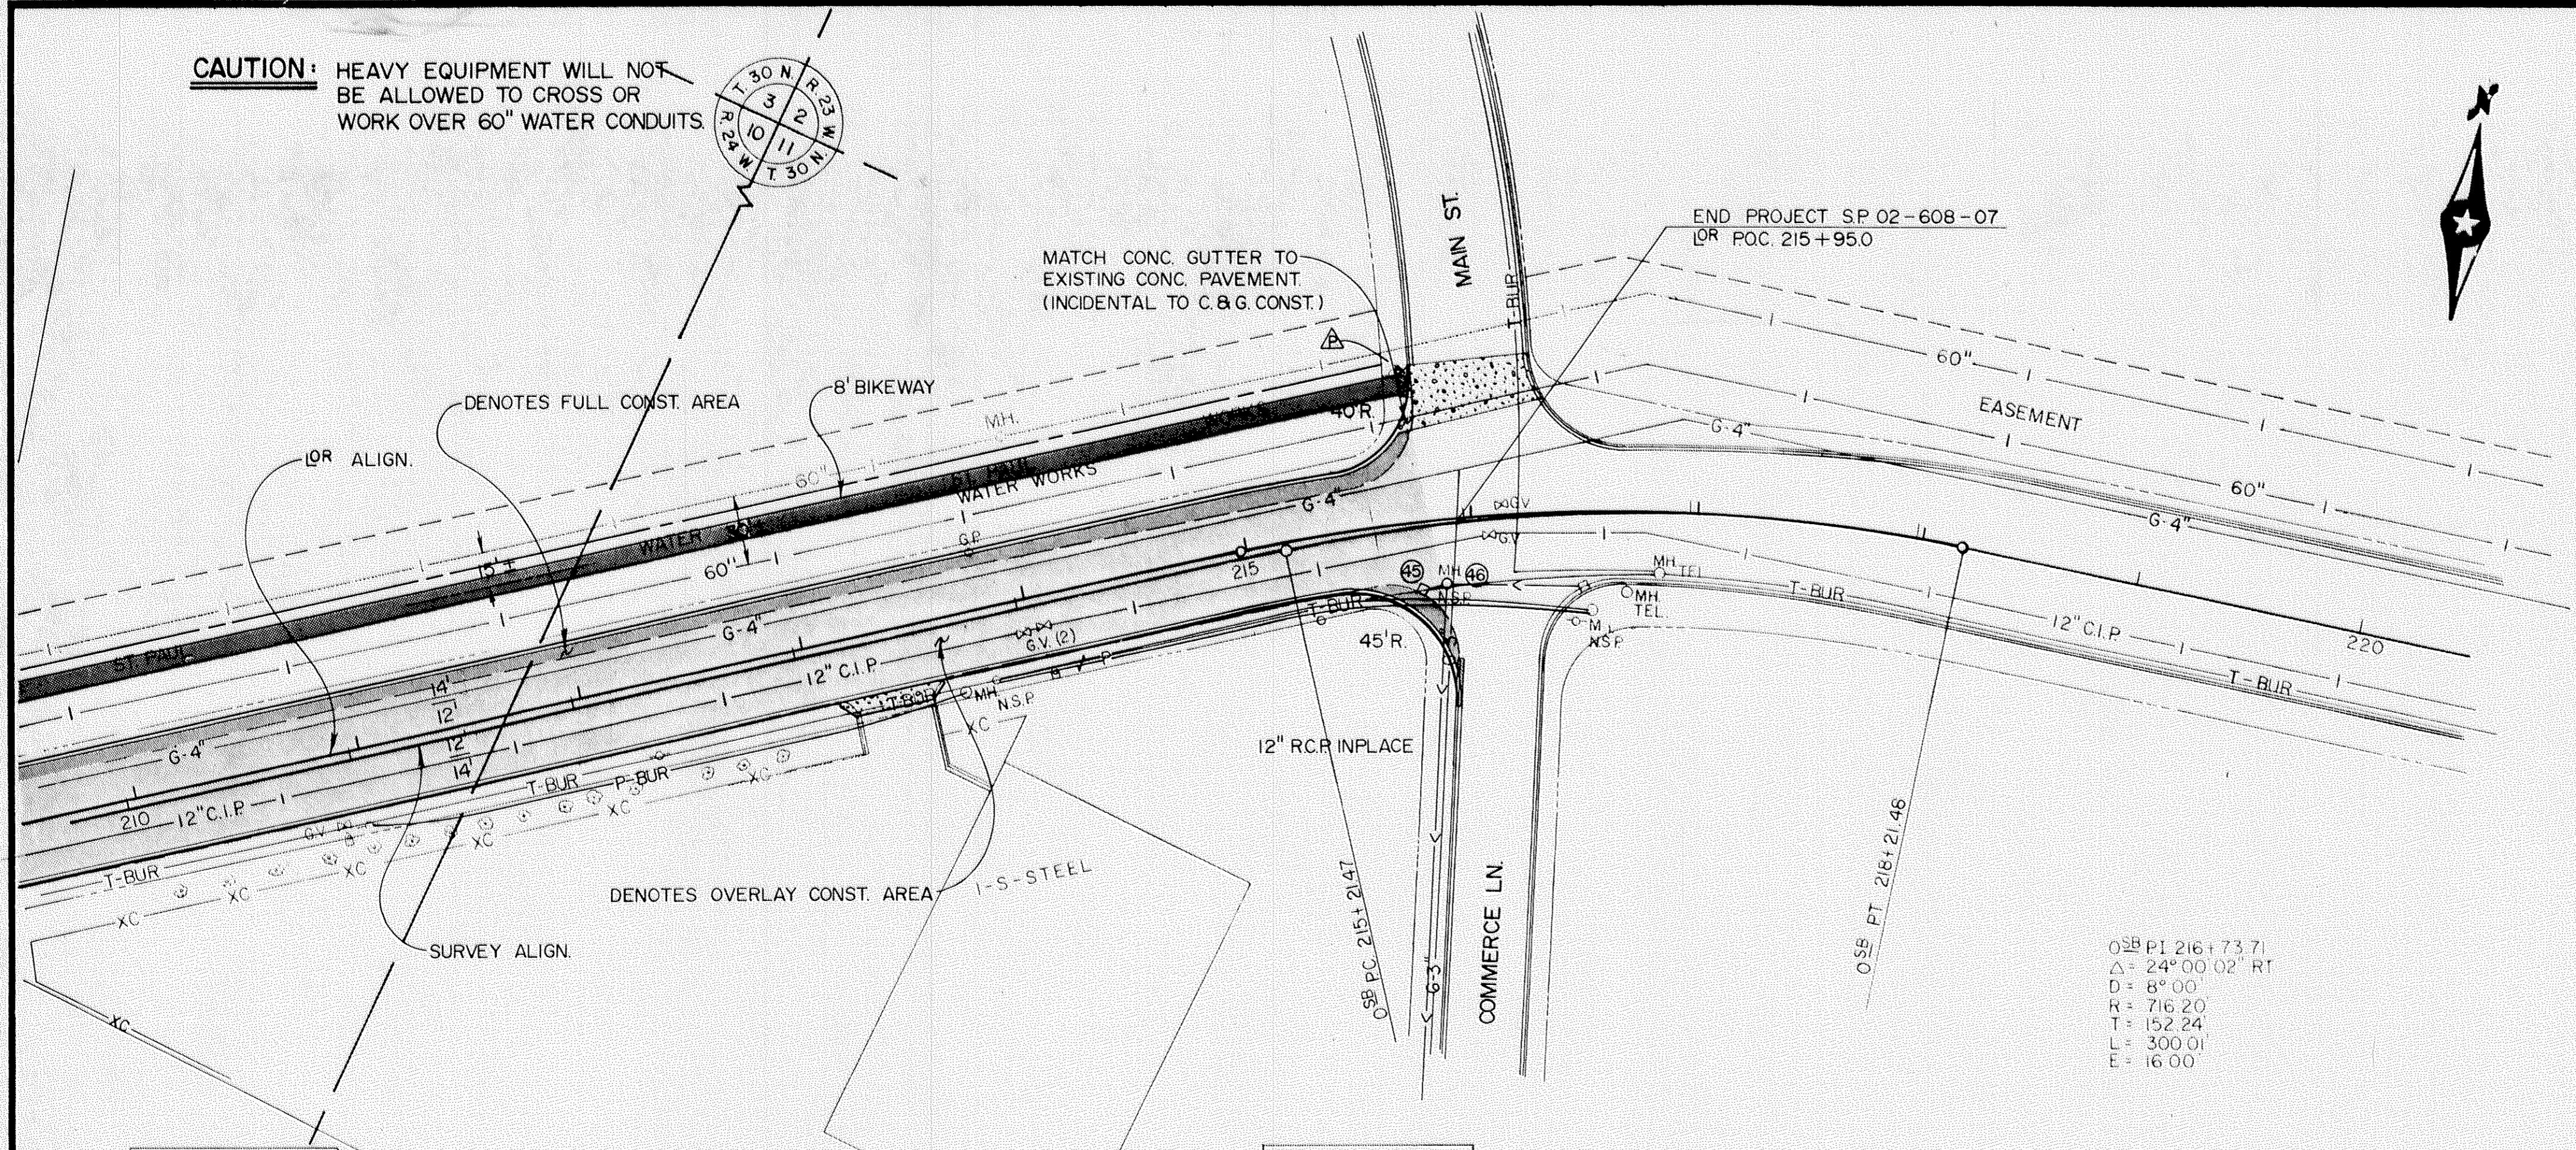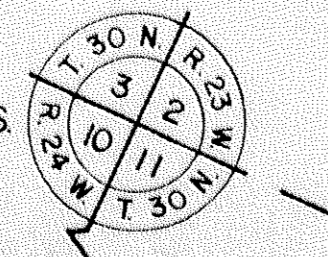


END PROJECT SP 02-608-07
OR POC 215+95.0

OSB PI 216+73.71
Δ = 24° 00' 02" RT
D = 8° 00'
R = 716.20
T = 152.24
L = 300.01
E = 16.00

△ DENOTES PED. RAMP LOCATIONS


BM 2 ELEV. 867.09
TOP HYD.
STA. 210+194 h: 30'

BM 3 ELEV. 873.02
TOP HYD.
STA. 214+10 RT 30'

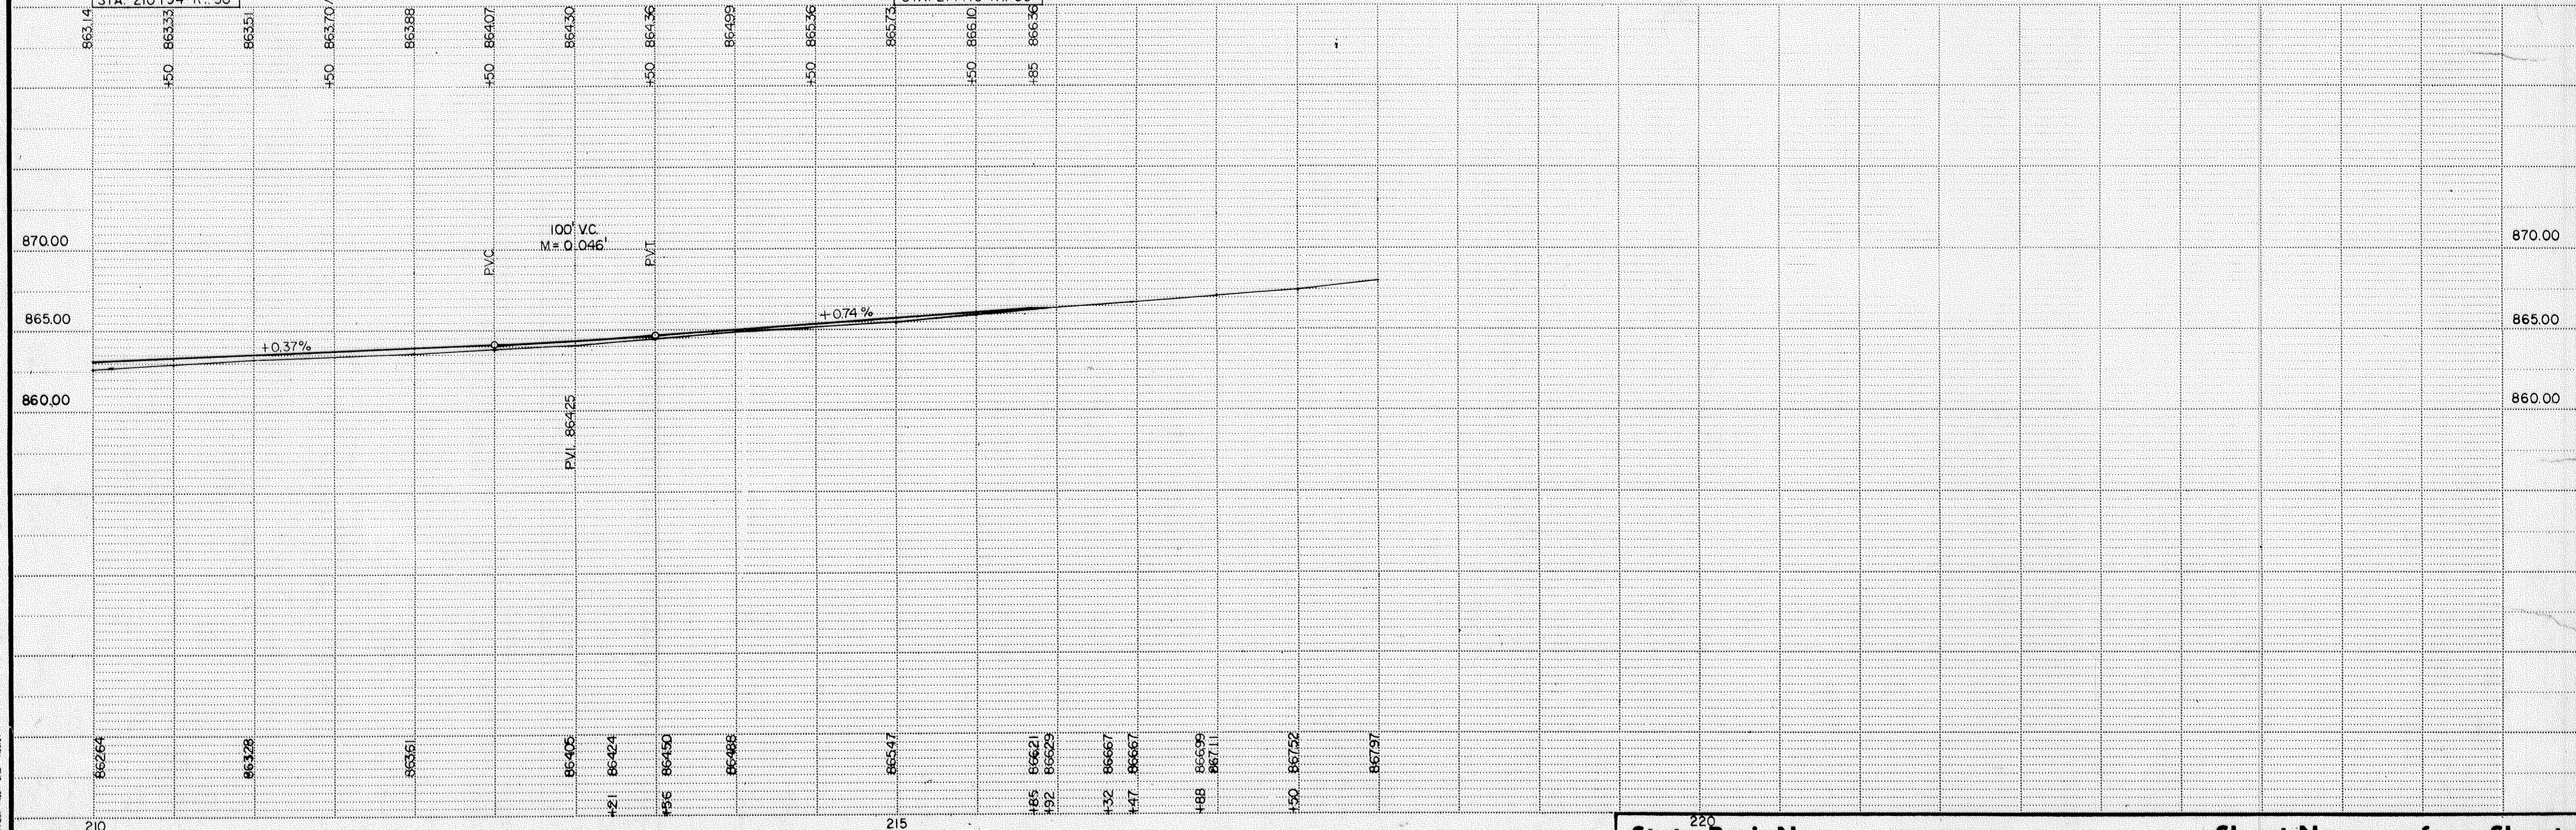


PI 86+27.30
 $\Delta = 17^\circ 36'$
 $D = 5^\circ 00'$
 $R = 1,145.92'$
 $T = 117.40'$
 $L = 352.00'$
 $E = 13.65'$

ERR PI 100+00
 $\Delta = 30^\circ 3'$
 $D = 7^\circ 00'$
 $R = 815.51'$
 $T = 220.98'$
 $L = 431.67'$
 $E = 29.31'$

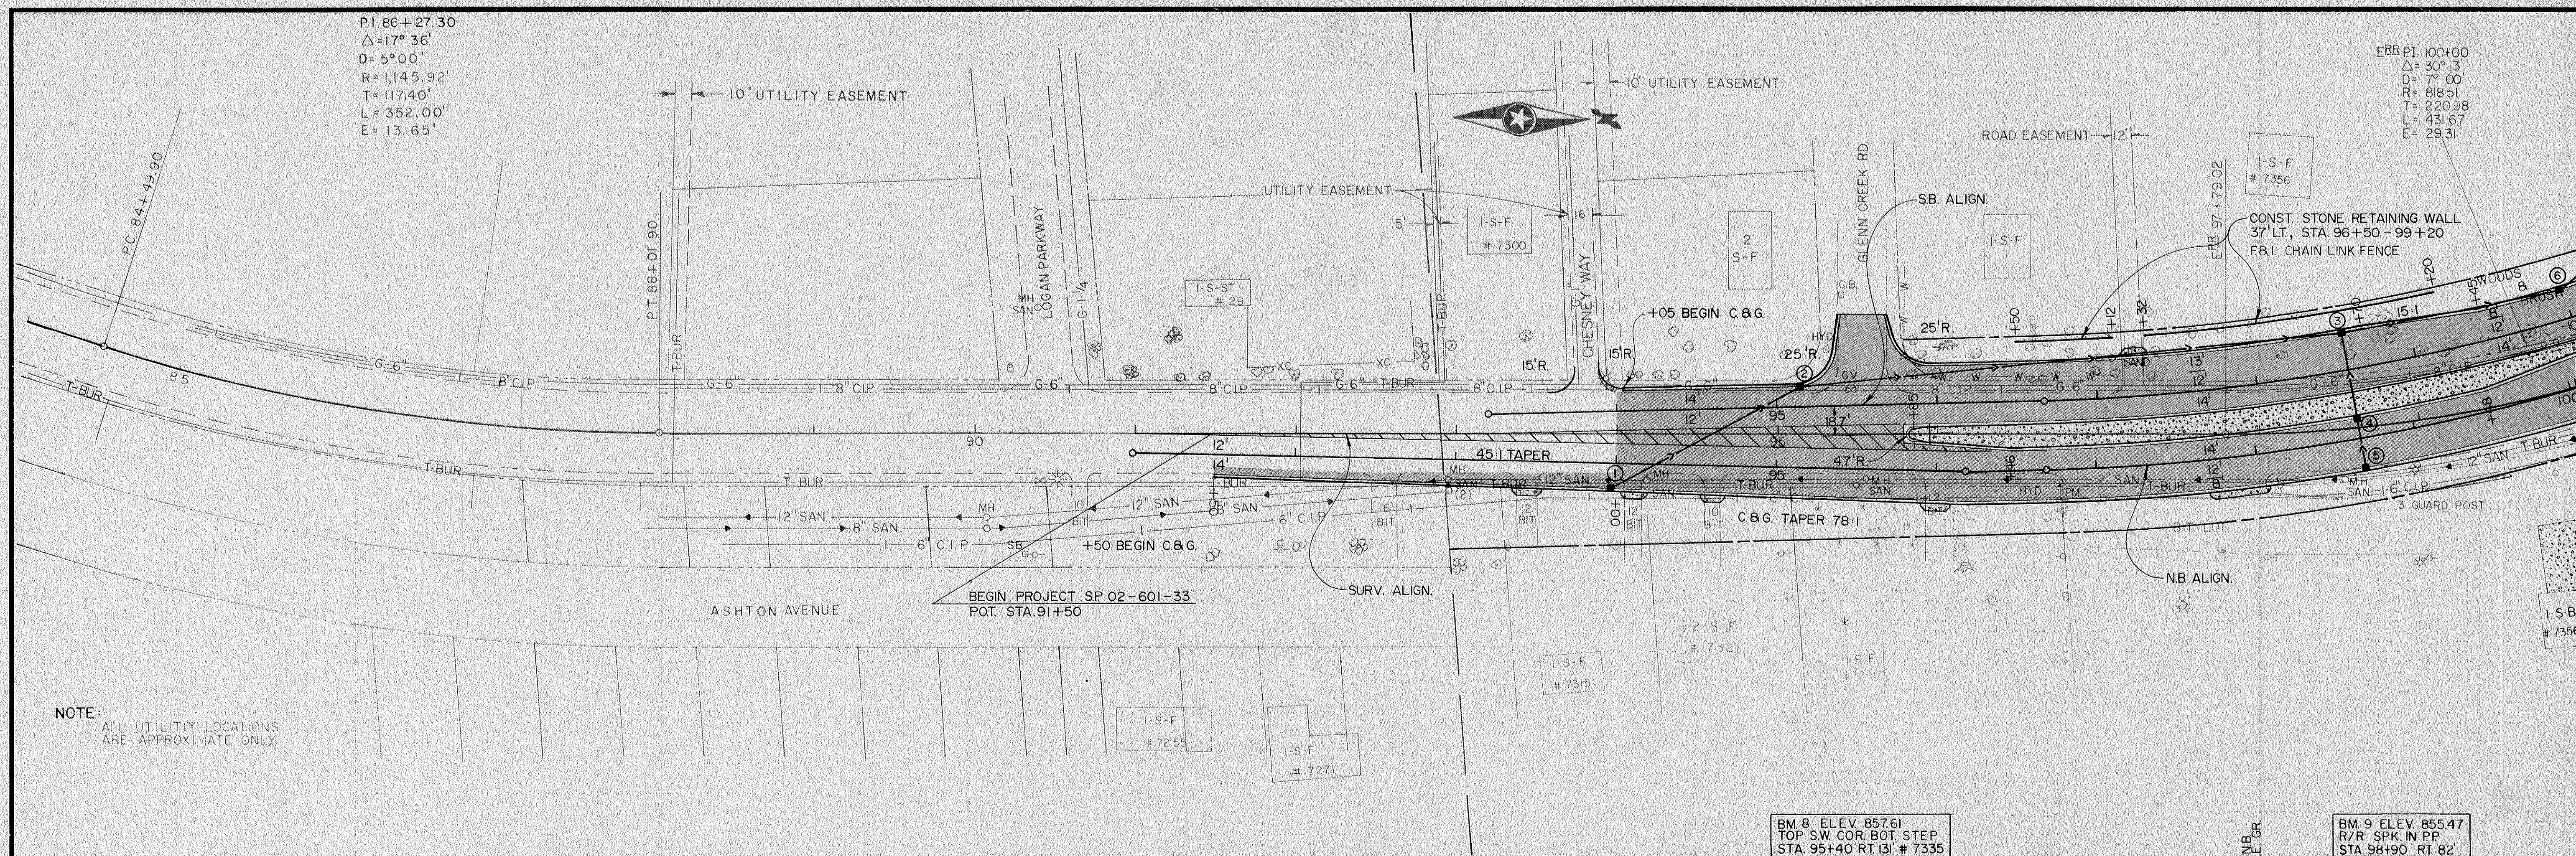

NOTE:
 ALL UTILITY LOCATIONS
 ARE APPROXIMATE ONLY

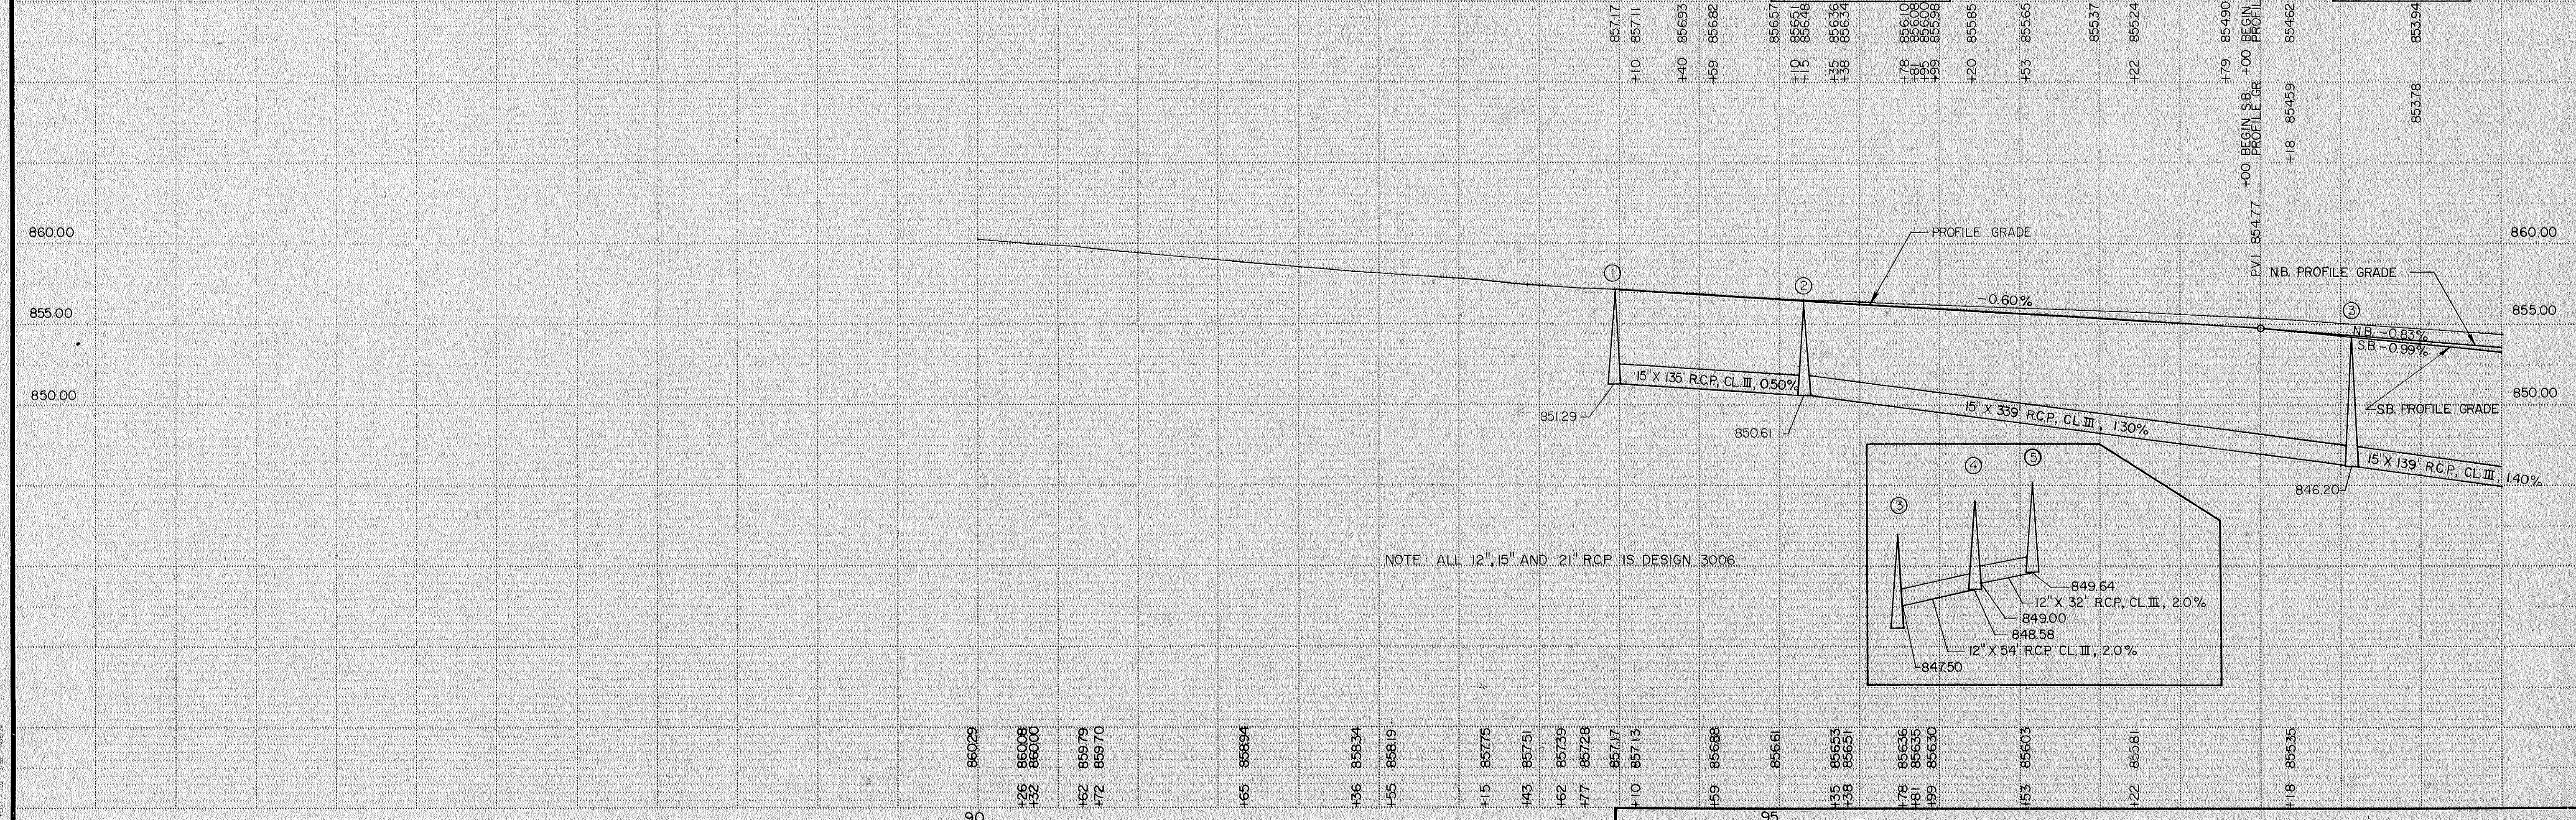



NOTE: ALL 12", 15" AND 21" R.C.P. IS DESIGN 3006

BM 12 ELEV. 231.99
DBL SPK IN PP
STA. 111+50 LT. 37'

ERR. P.I. 100+00
Δ = 30° 13'
D = 7° 00'
T = 618.61'
R = 220.98'
E = 431.67'
T = 29.31'

TALMADGE REVISED TO
INCLUDE CUL-DE-SAC
& C.B. 19A

CAUTION: HEAVY EQUIPMENT WILL NOT
BE ALLOWED TO CROSS OR
WORK OVER 60" WATER CONDUITS
PRIOR TO CONST. OF 8" REINFORCED
CONCRETE PAVEMENT PROTECTION.
SEE SHEET NO. 20 FOR CUL-DE-SAC CONST.

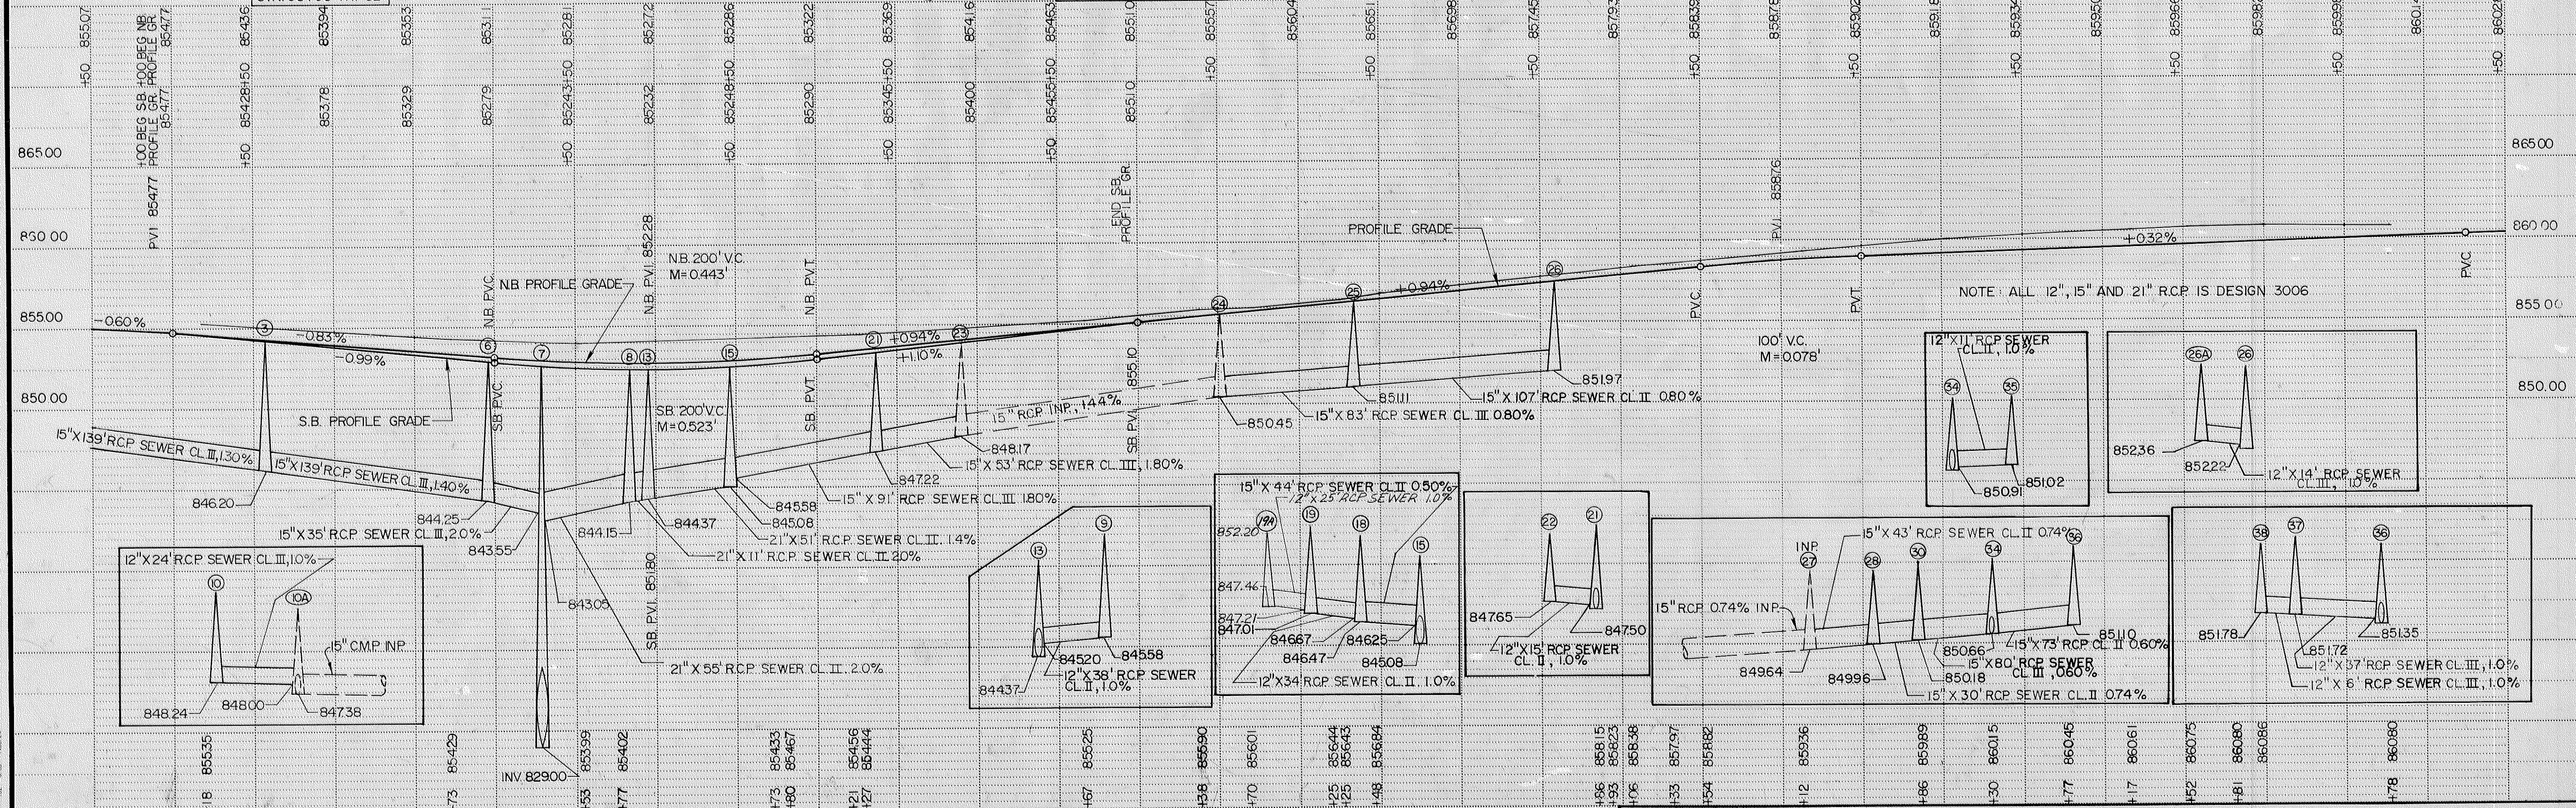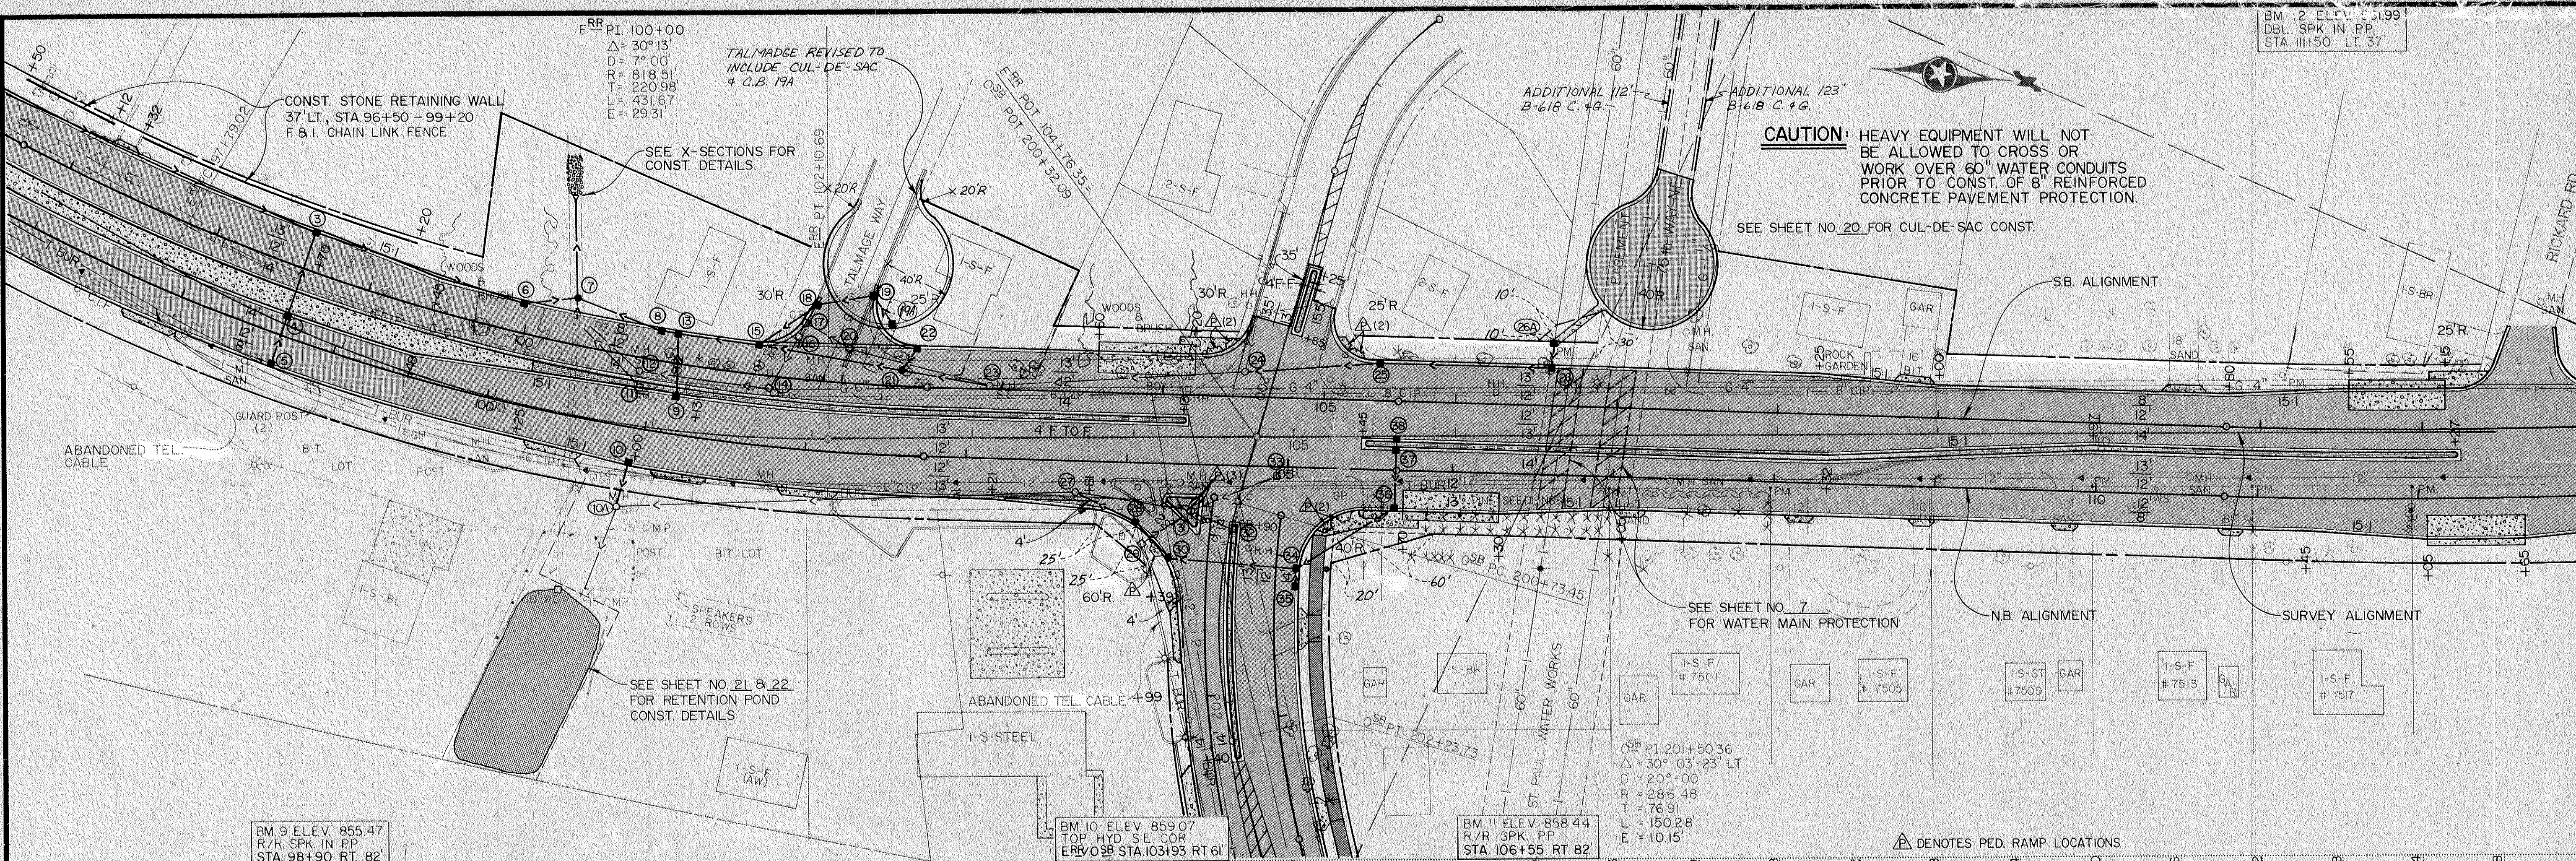


RECORD COPY
3-21-89 14

State Proj. No. 02-601-33


Sheet No. 13 of 58 Sheets

BM. 12 ELEV. 861.99
 DBL. SPK. IN P.P.
 STA. 111+50 LT. 37'



P.I. 118+84.01
 $\Delta = 12 \times 49' LT$
 $D = 1^\circ 45'$
 $R = 3,274.04'$
 $T = 367.72'$
 $L = 732.38'$
 $E = 20.59'$

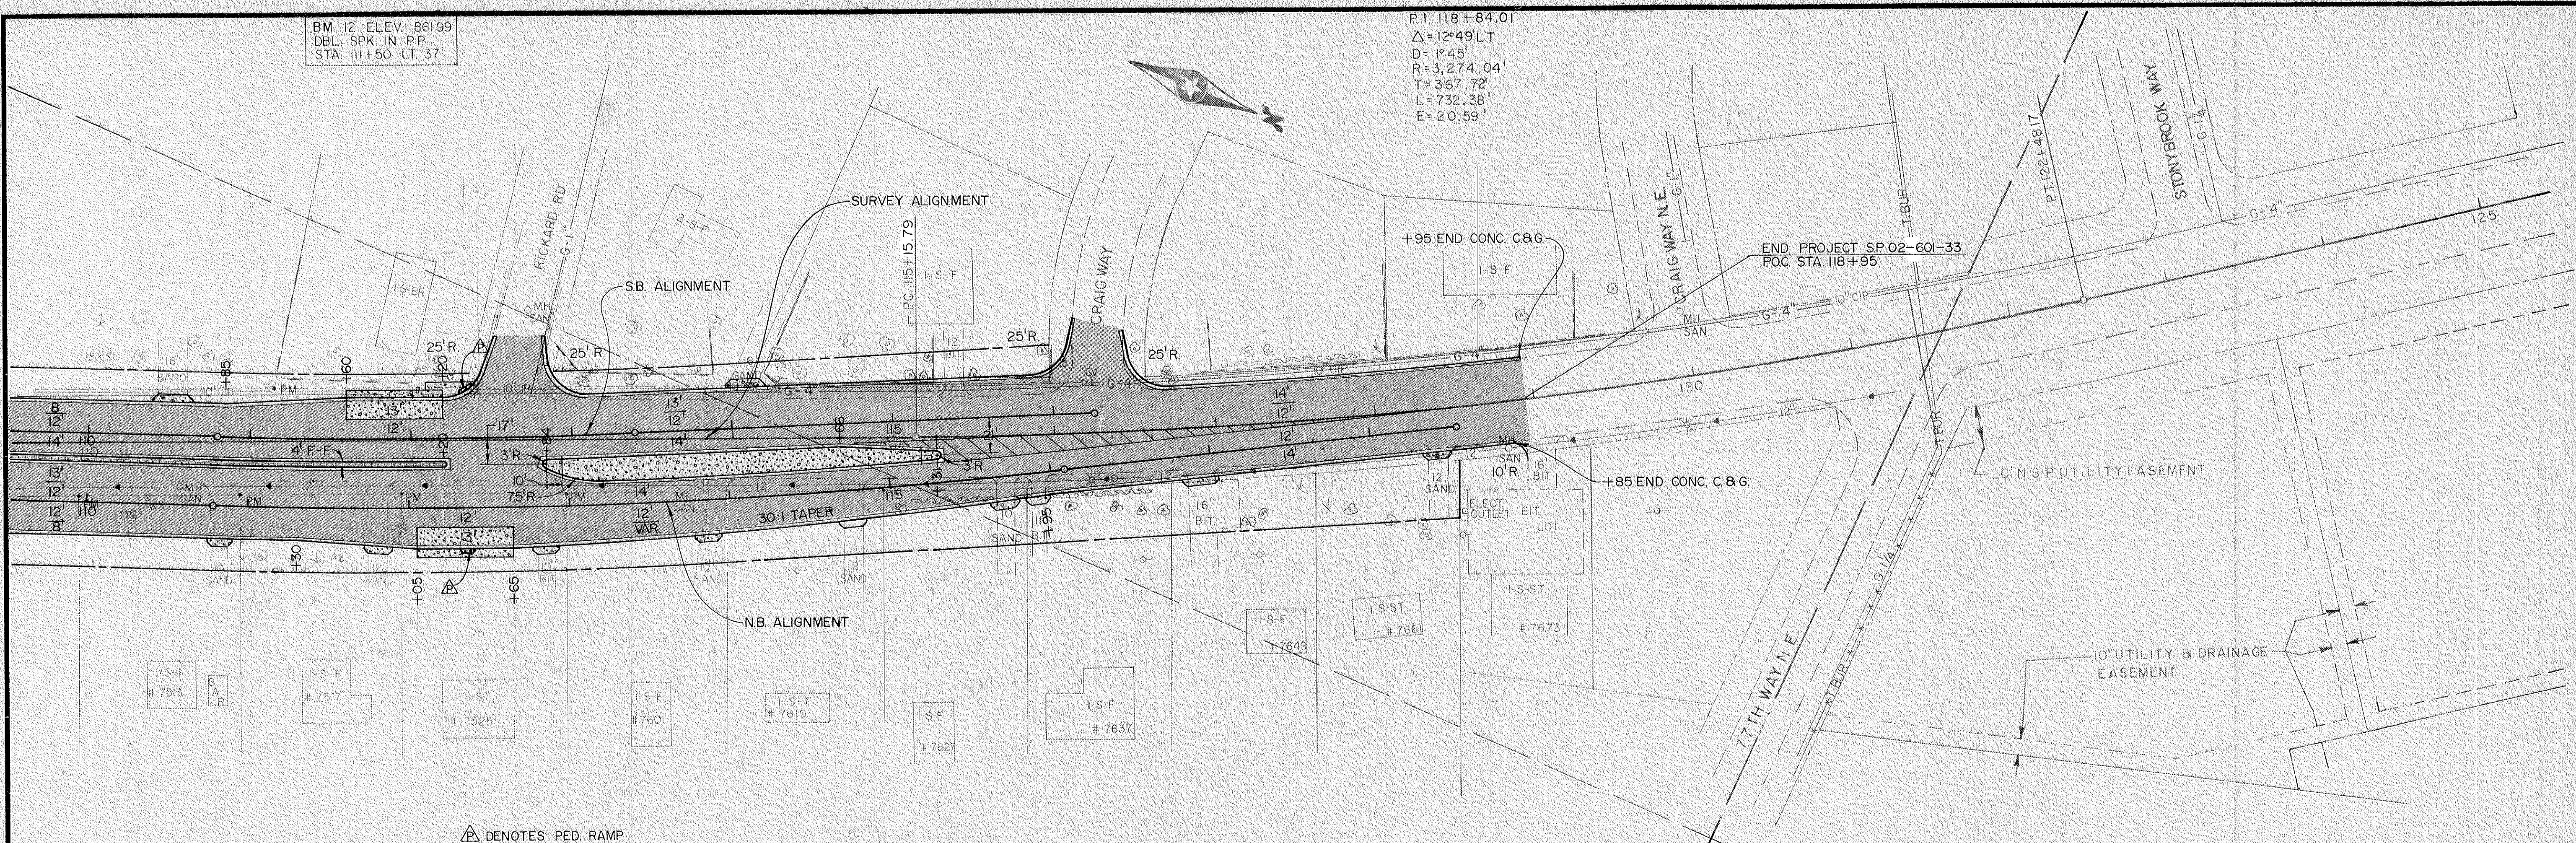


△ DENOTES PED. RAMP

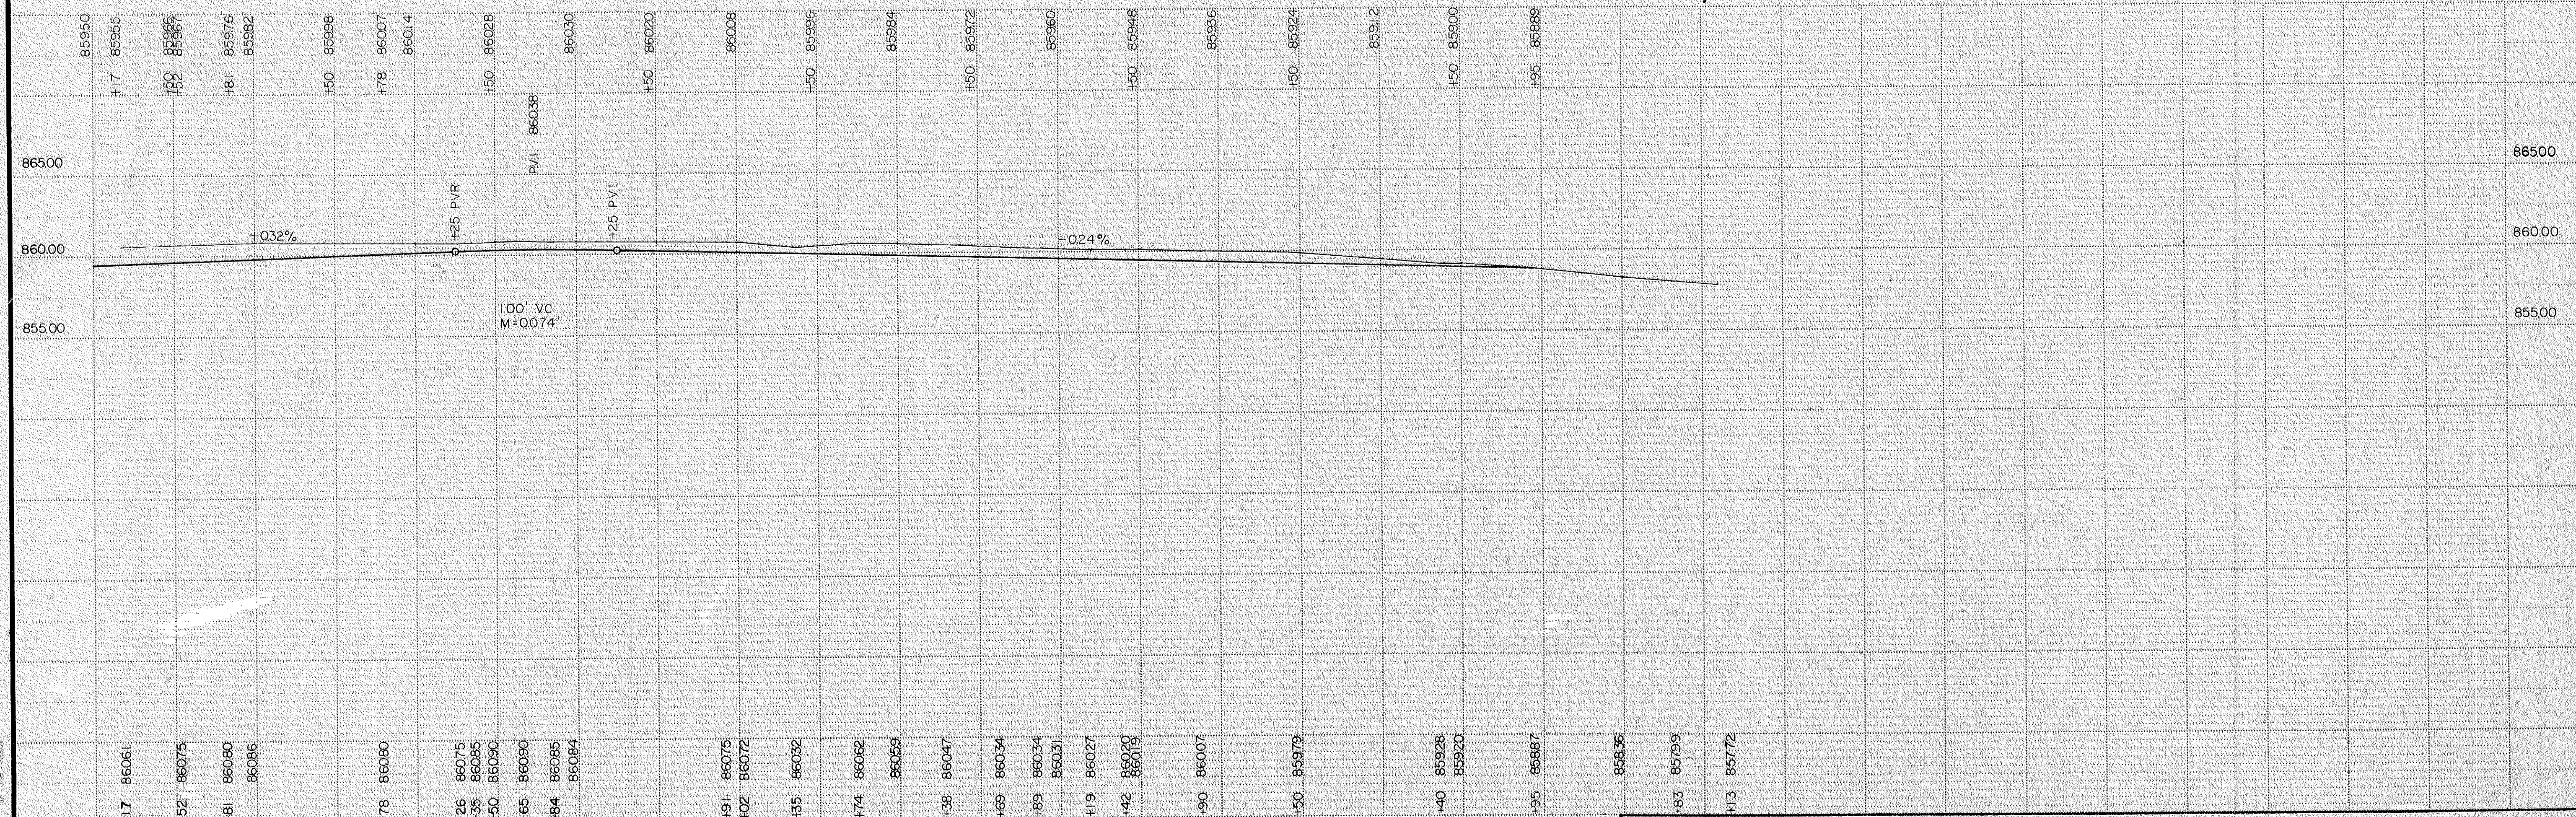

OSB PI 201+50.36
 $\Delta = 30^\circ 03' 23''$ LT
 D = 20° 00'
 R = 286.48
 T = 76.91'
 L = 150.28'
 E = 10.15'

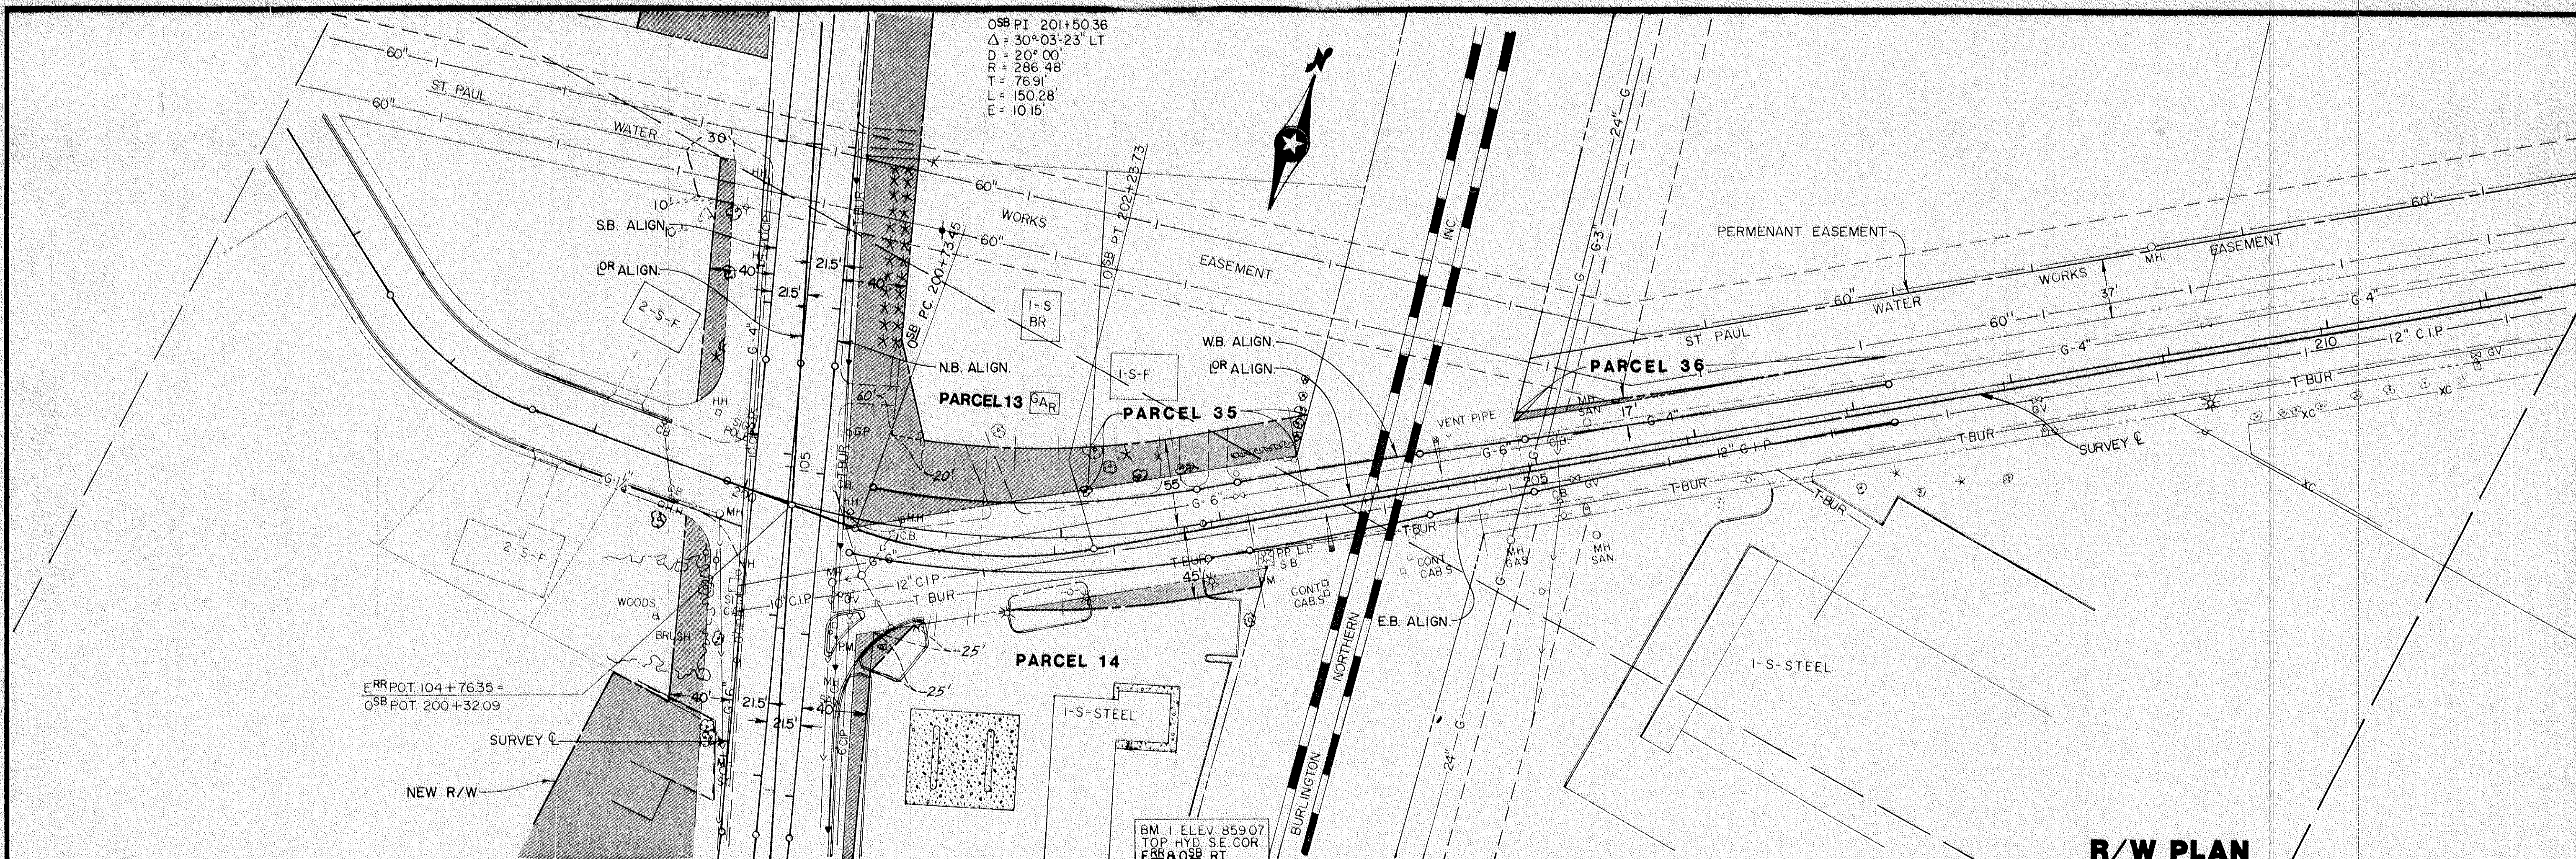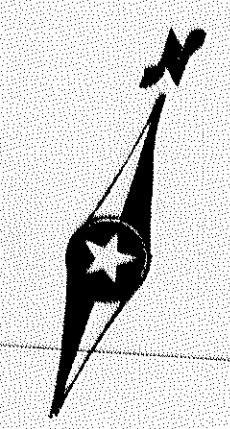


R/W PLAN

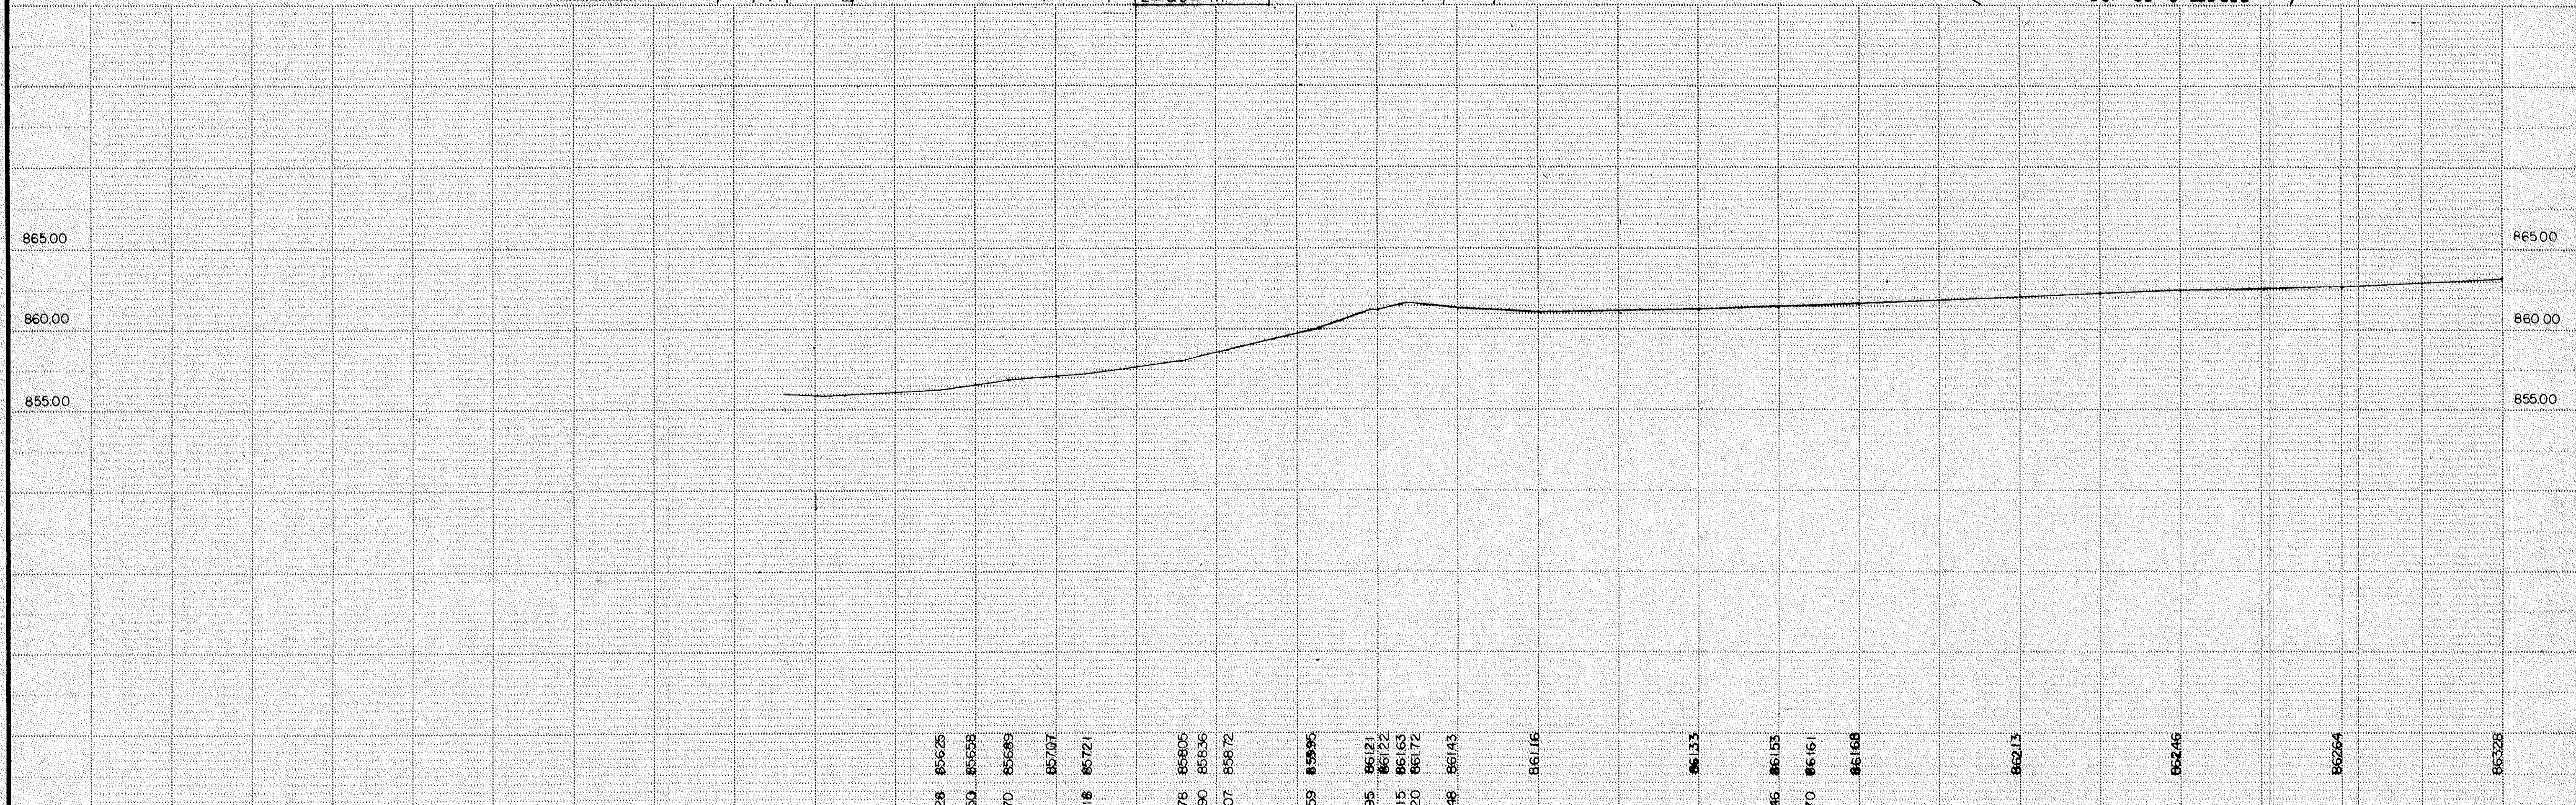

+28	856.25	+76	858.05	+159	859.95	+246	861.33	+333	861.53	+420	861.68	+507	862.13	+594	862.46	+681	862.64	+768	862.83
+50	856.58	+78	858.36	+166	860.26	+253	861.64	+340	861.84	+427	862.09	+514	862.54	+601	862.87	+688	863.05	+775	863.24
+70	856.89	+98	858.67	+186	860.56	+273	861.94	+360	862.14	+447	862.39	+534	862.84	+621	863.17	+708	863.35	+795	863.54
+90	857.21	+118	858.99	+204	860.99	+291	862.37	+378	862.57	+465	862.82	+552	863.27	+639	863.60	+726	863.78	+813	863.97
+118	857.21	+146	859.00	+222	861.00	+309	862.38	+396	862.58	+483	862.83	+570	863.28	+657	863.61	+744	863.79	+831	863.98
+146	857.21	+174	859.00	+240	861.00	+327	862.38	+414	862.58	+501	862.83	+588	863.28	+675	863.61	+762	863.79	+849	863.98
+174	857.21	+202	859.00	+258	861.00	+345	862.38	+432	862.58	+519	862.83	+606	863.28	+693	863.61	+780	863.79	+867	863.98
+202	857.21	+230	859.00	+276	861.00	+363	862.38	+450	862.58	+537	862.83	+624	863.28	+711	863.61	+798	863.79	+885	863.98
+230	857.21	+258	859.00	+294	861.00	+381	862.38	+468	862.58	+555	862.83	+642	863.28	+729	863.61	+816	863.79	+903	863.98
+258	857.21	+286	859.00	+312	861.00	+400	862.38	+486	862.58	+573	862.83	+660	863.28	+747	863.61	+834	863.79	+921	863.98
+286	857.21	+314	859.00	+330	861.00	+418	862.38	+504	862.58	+591	862.83	+678	863.28	+765	863.61	+852	863.79	+939	863.98
+314	857.21	+342	859.00	+348	861.00	+436	862.38	+522	862.58	+609	862.83	+696	863.28	+783	863.61	+870	863.79	+957	863.98
+342	857.21	+370	859.00	+366	861.00	+454	862.38	+540	862.58	+627	862.83	+714	863.28	+801	863.61	+888	863.79	+975	863.98
+370	857.21	+398	859.00	+384	861.00	+472	862.38	+558	862.58	+645	862.83	+732	863.28	+819	863.61	+906	863.79	+993	863.98
+398	857.21	+426	859.00	+402	861.00	+490	862.38	+576	862.58	+663	862.83	+750	863.28	+837	863.61	+924	863.79	+1011	863.98
+426	857.21	+454	859.00	+420	861.00	+508	862.38	+594	862.58	+681	862.83	+768	863.28	+855	863.61	+942	863.79	+1029	863.98
+454	857.21	+482	859.00	+438	861.00	+526	862.38	+612	862.58	+700	862.83	+787	863.28	+874	863.61	+961	863.79	+1047	863.98
+482	857.21	+510	859.00	+456	861.00	+544	862.38	+630	862.58	+718	862.83	+805	863.28	+892	863.61	+979	863.79	+1065	863.98
+510	857.21	+538	859.00	+474	861.00	+562	862.38	+648	862.58	+736	862.83	+823	863.28	+910	863.61	+997	863.79	+1083	863.98
+538	857.21	+566	859.00	+492	861.00	+580	862.38	+666	862.58	+754	862.83	+841	863.28	+927	863.61	+1014	863.79	+1101	863.98
+566	857.21	+594	859.00	+510	861.00	+598	862.38	+684	862.58	+772	862.83	+859	863.28	+944	863.61	+1031	863.79	+1119	863.98
+594	857.21	+622	859.00	+528	861.00	+616	862.38	+702	862.58	+790	862.83	+877	863.28	+966	863.61	+1050	863.79	+1137	863.98
+622	857.21	+650	859.00	+546	861.00	+634	862.38	+720	862.58	+808	862.83	+895	863.28	+984	863.61	+1069	863.79	+1155	863.98
+650	857.21	+678	859.00	+564	861.00	+652	862.38	+738	862.58	+826	862.83	+913	863.28	+1002	863.61	+1088	863.79	+1173	863.98
+678	857.21	+706	859.00	+582	861.00	+670	862.38	+756	862.58	+844	862.83	+931	863.28	+1020	863.61	+1106	863.79	+1191	863.98
+706	857.21	+734	859.00	+600	861.00	+688	862.38	+774	862.58	+862	862.83	+949	863.28	+1038	863.61	+1124	863.79	+1209	863.98
+734	857.21	+762	859.00	+618	861.00	+706	862.38	+792	862.58	+880	862.83	+967	863.28	+1056	863.61	+1142	863.79	+1227	863.98
+762	857.21	+790	859.00	+636	861.00	+724	862.38	+810	862.58	+900	862.83	+985	863.28	+1074	863.61	+1160	863.79	+1245	863.98
+790	857.21	+818	859.00	+654	861.00	+742	862.38	+828	862.58	+918	862.83	+1003	863.28	+1092	863.61	+1178	863.79	+1263	863.98
+818	857.21	+846	859.00	+672	861.00	+760	862.38	+846	862.58	+936	862.83	+1021	863.28	+1110	863.61	+1196	863.79	+1281	863.98
+846	857.21	+874	859.00	+690	861.00	+778	862.38	+864	862.58	+954	862.83	+1039	863.28	+1128	863.61	+1214	863.79	+1300	863.98
+874	857.21	+902	859.00	+708	861.00	+796	862.38	+882	862.58	+972	862.83	+1057	863.28	+1146	863.61	+1232	863.79	+1318	863.98
+902	857.21	+930	859.00	+726	861.00	+814	862.38	+900	862.58	+990	862.83	+1075	863.28	+1164	863.61	+1250	863.79	+1336	863.98
+930	857.21	+958	859.00	+744	861.00	+832	862.38	+918	862.58	+1008	862.83	+1093	863.28	+1172	863.61	+1268	863.79	+1354	863.98
+958	857.21	+986	859.00	+762	861.00	+850	862.38	+936	862.58	+1026	862.83	+1111	863.28	+1190	863.61	+1286	863.79	+1372	863.98
+986	857.21	+1014	859.00	+780	861.00	+868	862.38	+954	862.58	+1044	862.83	+1129	863.28	+1208	863.61	+1304	863.79	+1390	863.98
+1014	857.21	+1042	859.00	+798	861.00	+886	862.38	+972	862.58	+1062	862.83	+1147	863.28	+1226	863.61	+1322	863.79	+1408	863.98
+1042	857.21	+1070	859.00	+816	861.00	+904	862.38	+990	862.58	+1080	862.83	+1165	863.28	+1244	863.61	+1340	863.79	+1426	863.98
+1070	857.21	+1098	859.00	+834	861.00	+922	862.38	+1008	862.58	+1100	862.83	+1183	863.28	+1262	863.61	+1358	863.79	+1444	863.98
+1098	857.21	+1126	859.00	+852	861.00	+940	862.38	+1026	862.58	+1118	862.83	+1201	863.28	+1280	863.61	+1376	863.79	+1462	863.98
+1126	857.21	+1154	859.00	+870	861.00	+958	862.38	+1044	862.58	+1136	862.83	+1219	863.28	+1300	863.61	+1394	863.79	+1480	863.98
+1154	857.21	+1182	859.00	+888	861.00	+976	862.38	+1062	862.58	+1154	862.83	+1237	863.28	+1318	863.61	+1412	863.79	+1500	863.98
+1182	857.21	+1210	859.00	+906	861.00	+994	862.38	+1080	862.58	+1172	862.83	+1255	863.28	+1336	863.61	+1430	863.79	+1518	863.98
+1210	857.21	+1238	859.00	+924	861.00	+1012	862.38	+1098	862.58	+1190	862.83	+1273	863.28	+1354	863.61	+1448	863.79	+1536	863.98
+1238	857.21	+1266	859.00	+942	861.00	+1030	862.38	+1116	862.58	+1200	862.83	+1291	863.28	+1372	863.61	+1466	863.79	+1554	863.98
+1266	857.21	+1294	859.00	+960	861.00	+1048	862.38	+1134	862.58	+1218	862.83	+1309	863.28	+1390	863.61	+1484	863.79	+1572	863.98
+1294	857.21	+1322	859.00	+978	861.00	+1066	862.38	+1152	862.58	+1236	862.83	+1327	863.28	+1408	863.61	+1502	863.79	+1590	863.98
+1322	857.21	+1350	859.00	+996	861.00	+1084	862.38	+1170	862.58	+1254	862.83	+1345	863.28	+1426	863.61	+1520	863.79	+1608	863.98
+1350	857.21	+1378	859.00	+1014	861.00	+1102	862.38	+1188	862.58	+1272	862.83	+1363	863.28	+1444	863.61	+1538	863.79	+1626	863.98
+1378	857.21	+1406	859.00	+1032	861.00	+1120	862.38	+1206	862.58	+1290	862.83	+1381	863.28	+1462	863.61	+1556	863.79	+1644	863.98
+1406	857.21	+1434	859.00	+1050	861.00	+1138	862.38	+1224	862.58	+1308	862.83	+1399	863.28	+1480	863.61	+1574	863.79	+1662	863.98
+1434	857.21	+1462	859.00	+1068	861.00	+1156	862.38	+1242	862.58	+1326	862.83	+1407	863.28	+1500	863.61	+1592	863.79	+1680	863.98
+1462	857.21	+1490	859.00	+1086	861.00	+1174	862.38	+1260	862.5										

P.I. 86+27.30
 $\Delta = 17^\circ 36'$
 $D = 5^\circ 00'$
 $R = 1,145.92'$
 $T = 117.40'$
 $L = 352.00'$
 $E = 13.65'$

E.R.R. PI 100+00
 $\Delta = 30^\circ 13'$
 $D = 7^\circ 00'$
 $R = 888.51'$
 $T = 220.98'$
 $L = 431.67'$
 $E = 29.31'$

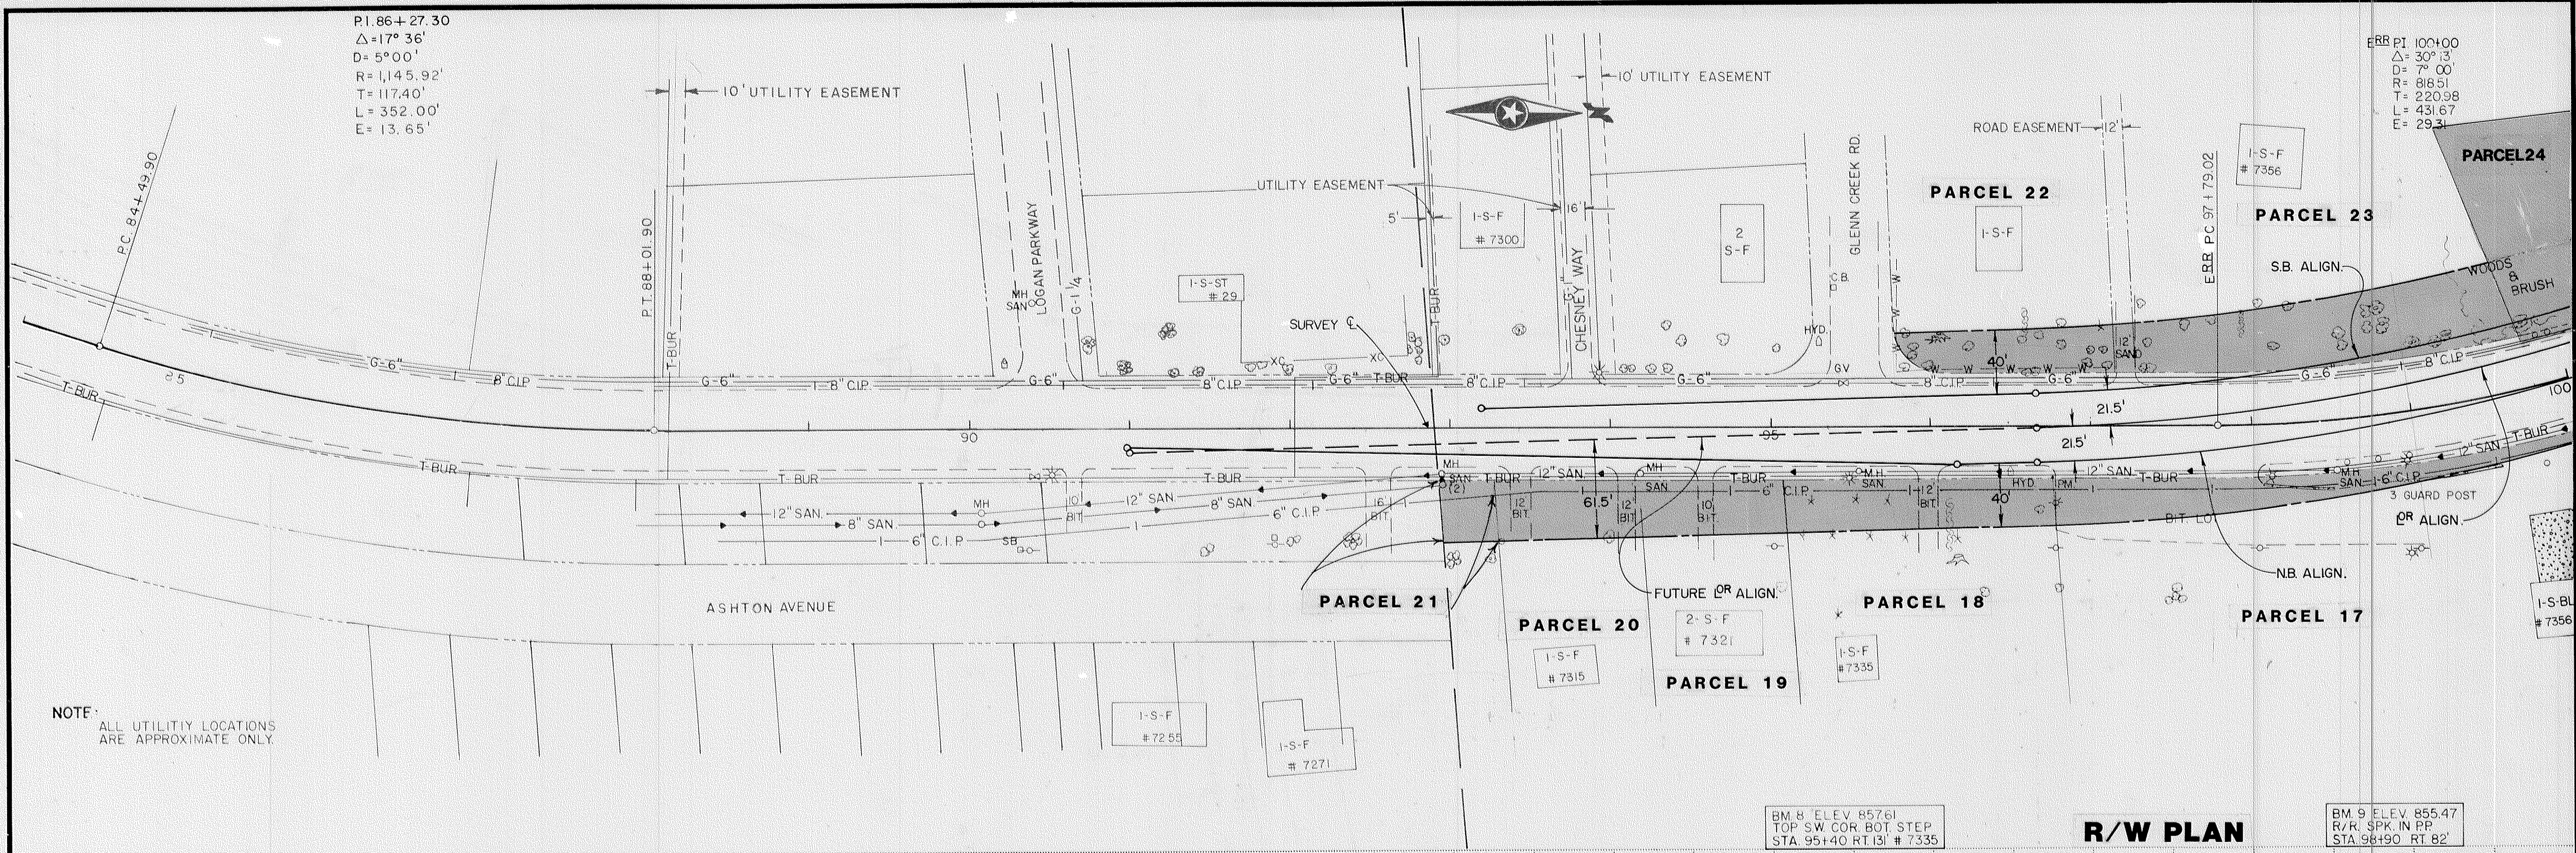


NOTE:
 ALL UTILITY LOCATIONS
 ARE APPROXIMATE ONLY.

BM 8 ELEV 857.61
 TOP SW COR. BOT. STEP
 STA 95+40 RT 131' # 7335

R/W PLAN

BM 9 ELEV 855.47
 R/R. SPK. IN PP.
 STA 98+90 RT 82'

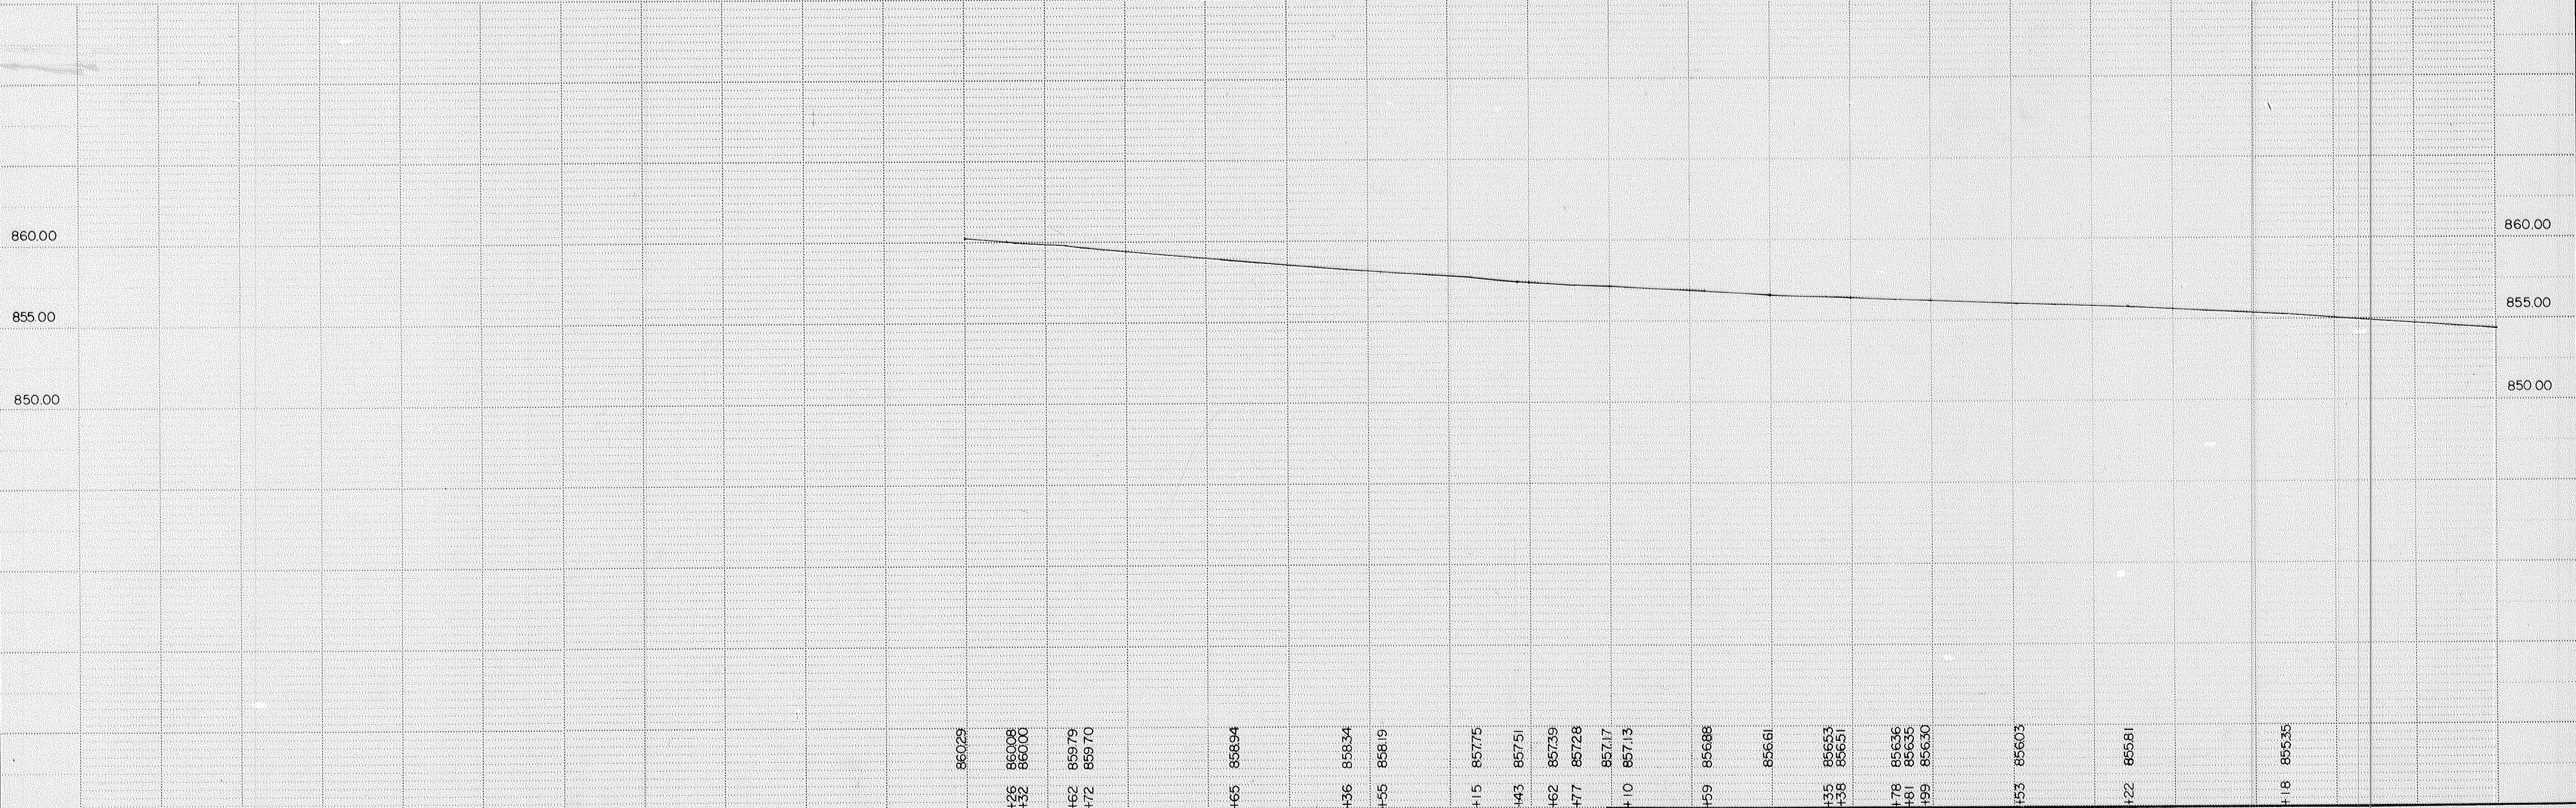

90	860.29	860.08	860.00	859.79	859.70	858.94	858.34	858.19	857.75	857.51	857.39	857.28	857.17	857.13	856.88	856.61	856.53	856.51	856.36	856.35	856.30	856.03	855.81	855.35
	+26	+32	+62	+72	+65	+36	+55	+15	+43	+62	+77	+10	+59	+35	+78	+81	+99	+53	+22	+18				

BM 12 ELEV 861.99
 DBL SPK IN PP
 STA. 111+50 LT. 37'

ERR PT. 100+100
 $\Delta = 30^\circ 13'$
 $D = 77.00'$
 $R = 818.51'$
 $T = 220.98'$
 $L = 431.67'$
 $E = 29.31'$

ERR PT. 104+76.35
 OSB PT. 200+32.09


ERR PT. 102+10.69

OSB PT. 201+50.36
 $\Delta = 30^\circ 03' 23''$ LT
 $D = 20^\circ 00'$
 $R = 286.48'$
 $T = 76.91'$
 $L = 150.28'$
 $E = 10.15'$


BM 9 ELEV. 855.47
 R/R SPK. IN PP
 STA. 98+90 RT. 82'

BM 10 ELEV 859.07
 TOP HYD. SE. COR
 ERR OSB STA. 103+93 RT. 61'

BM 11 ELEV 858.44
 R/R SPK. PP
 STA. 106+55 RT. 82'

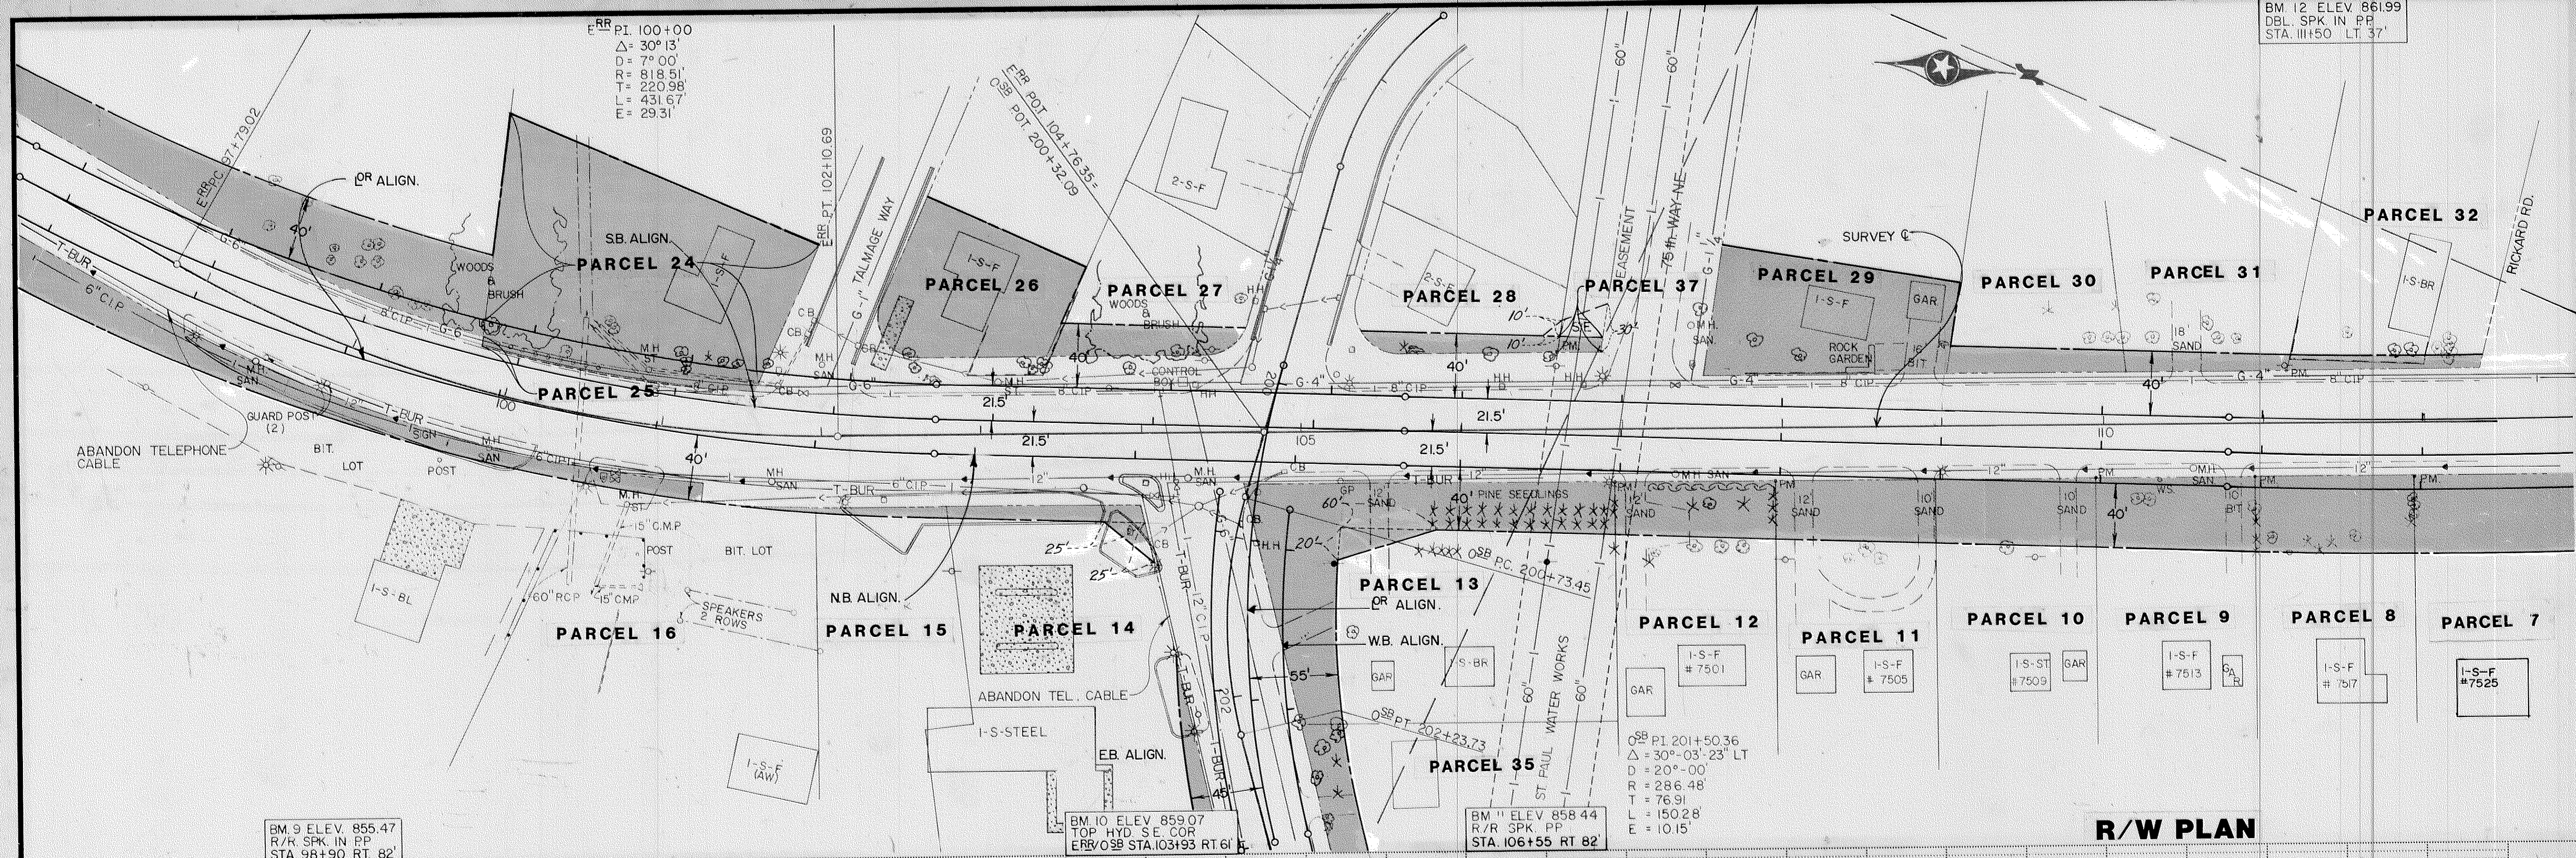


R/W PLAN

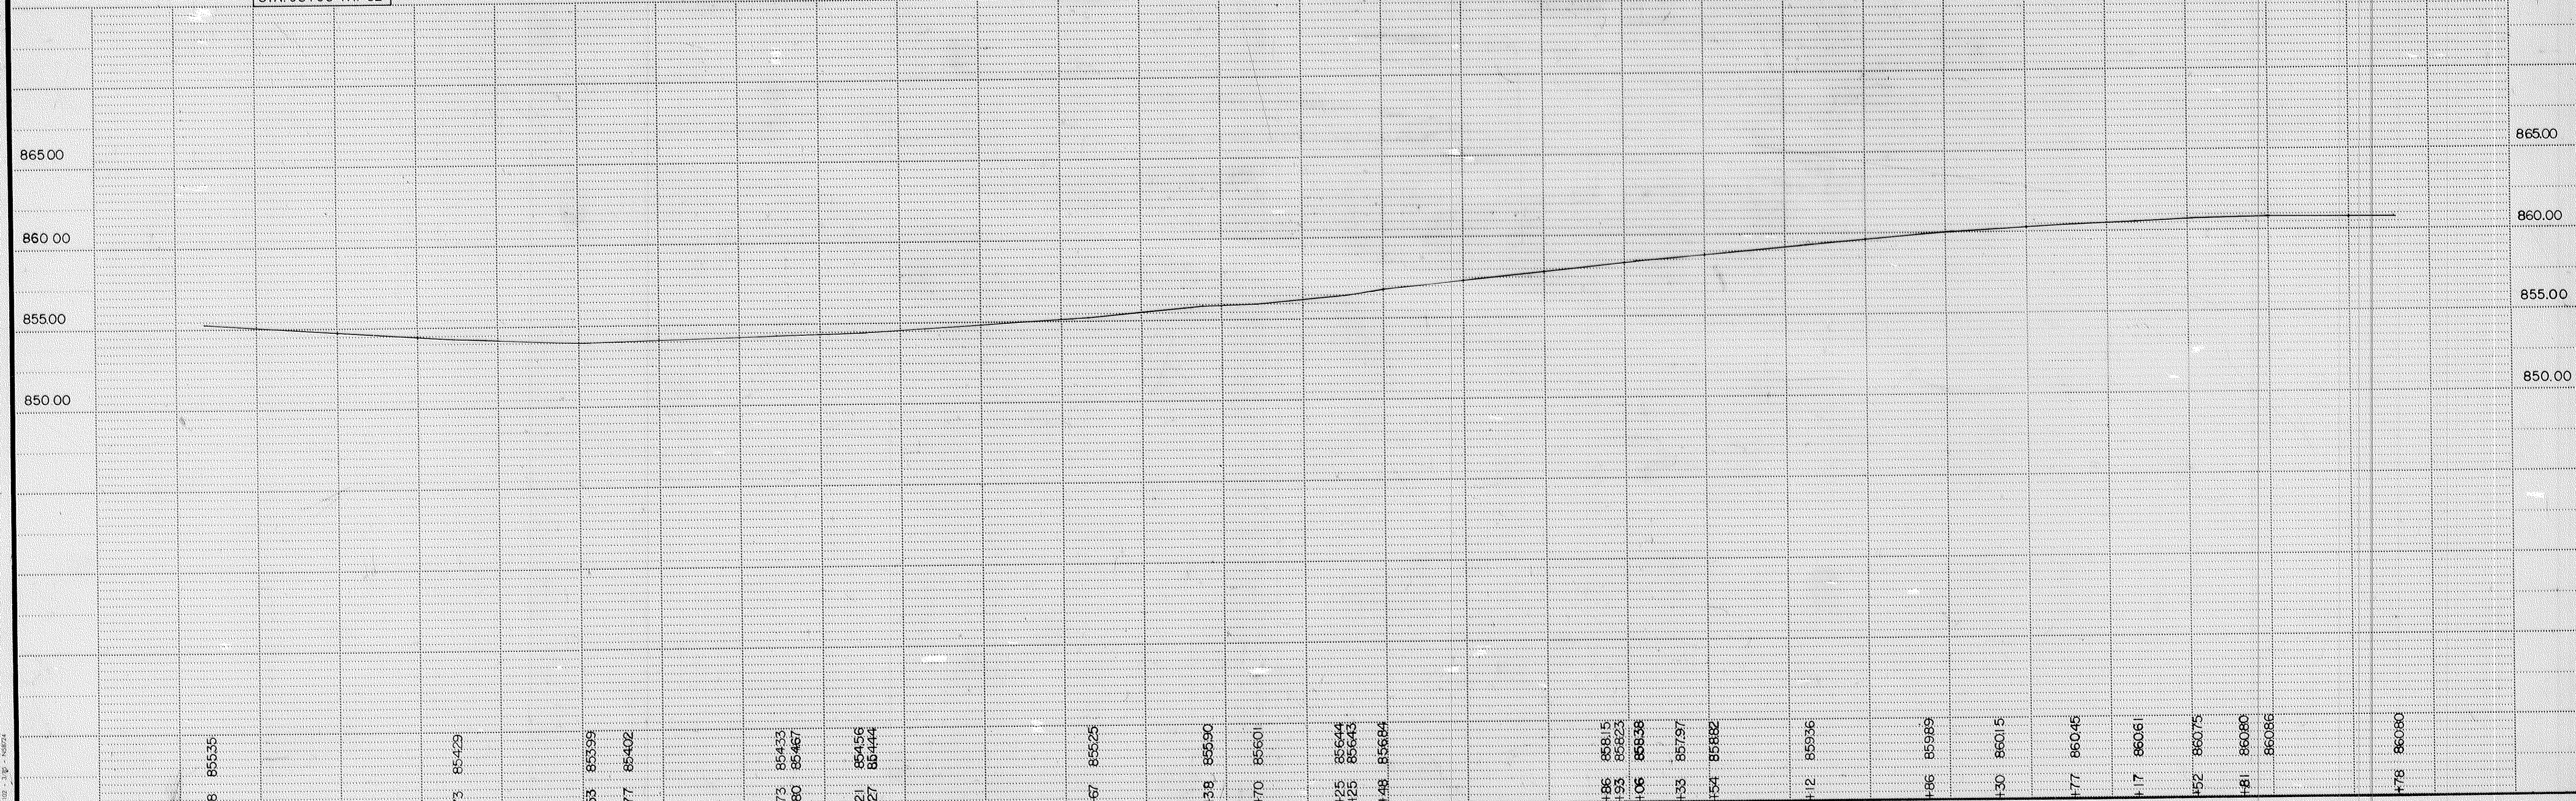


#16	855.35	#73	854.29	#53	853.99	#77	854.02	#21	854.56	#67	856.25	#39	856.90	#70	856.01	#25	856.44	#48	856.84	#86	858.15	#12	859.36	#66	859.89	#30	860.15	#77	860.45	#17	860.61	#52	860.75	#81	860.80	#78	860.80
-----	--------	-----	--------	-----	--------	-----	--------	-----	--------	-----	--------	-----	--------	-----	--------	-----	--------	-----	--------	-----	--------	-----	--------	-----	--------	-----	--------	-----	--------	-----	--------	-----	--------	-----	--------	-----	--------

BM 12 ELEV. 861.99
 DBL. SPK. IN P.P.
 STA. 111+50 LT. 37'





P.I. 118+84.01
 $\Delta = 12^\circ 49' LT$
 $D = 1^\circ 45'$
 $R = 3,274.04'$
 $T = 367.72'$
 $L = 732.38'$
 $E = 20.69'$

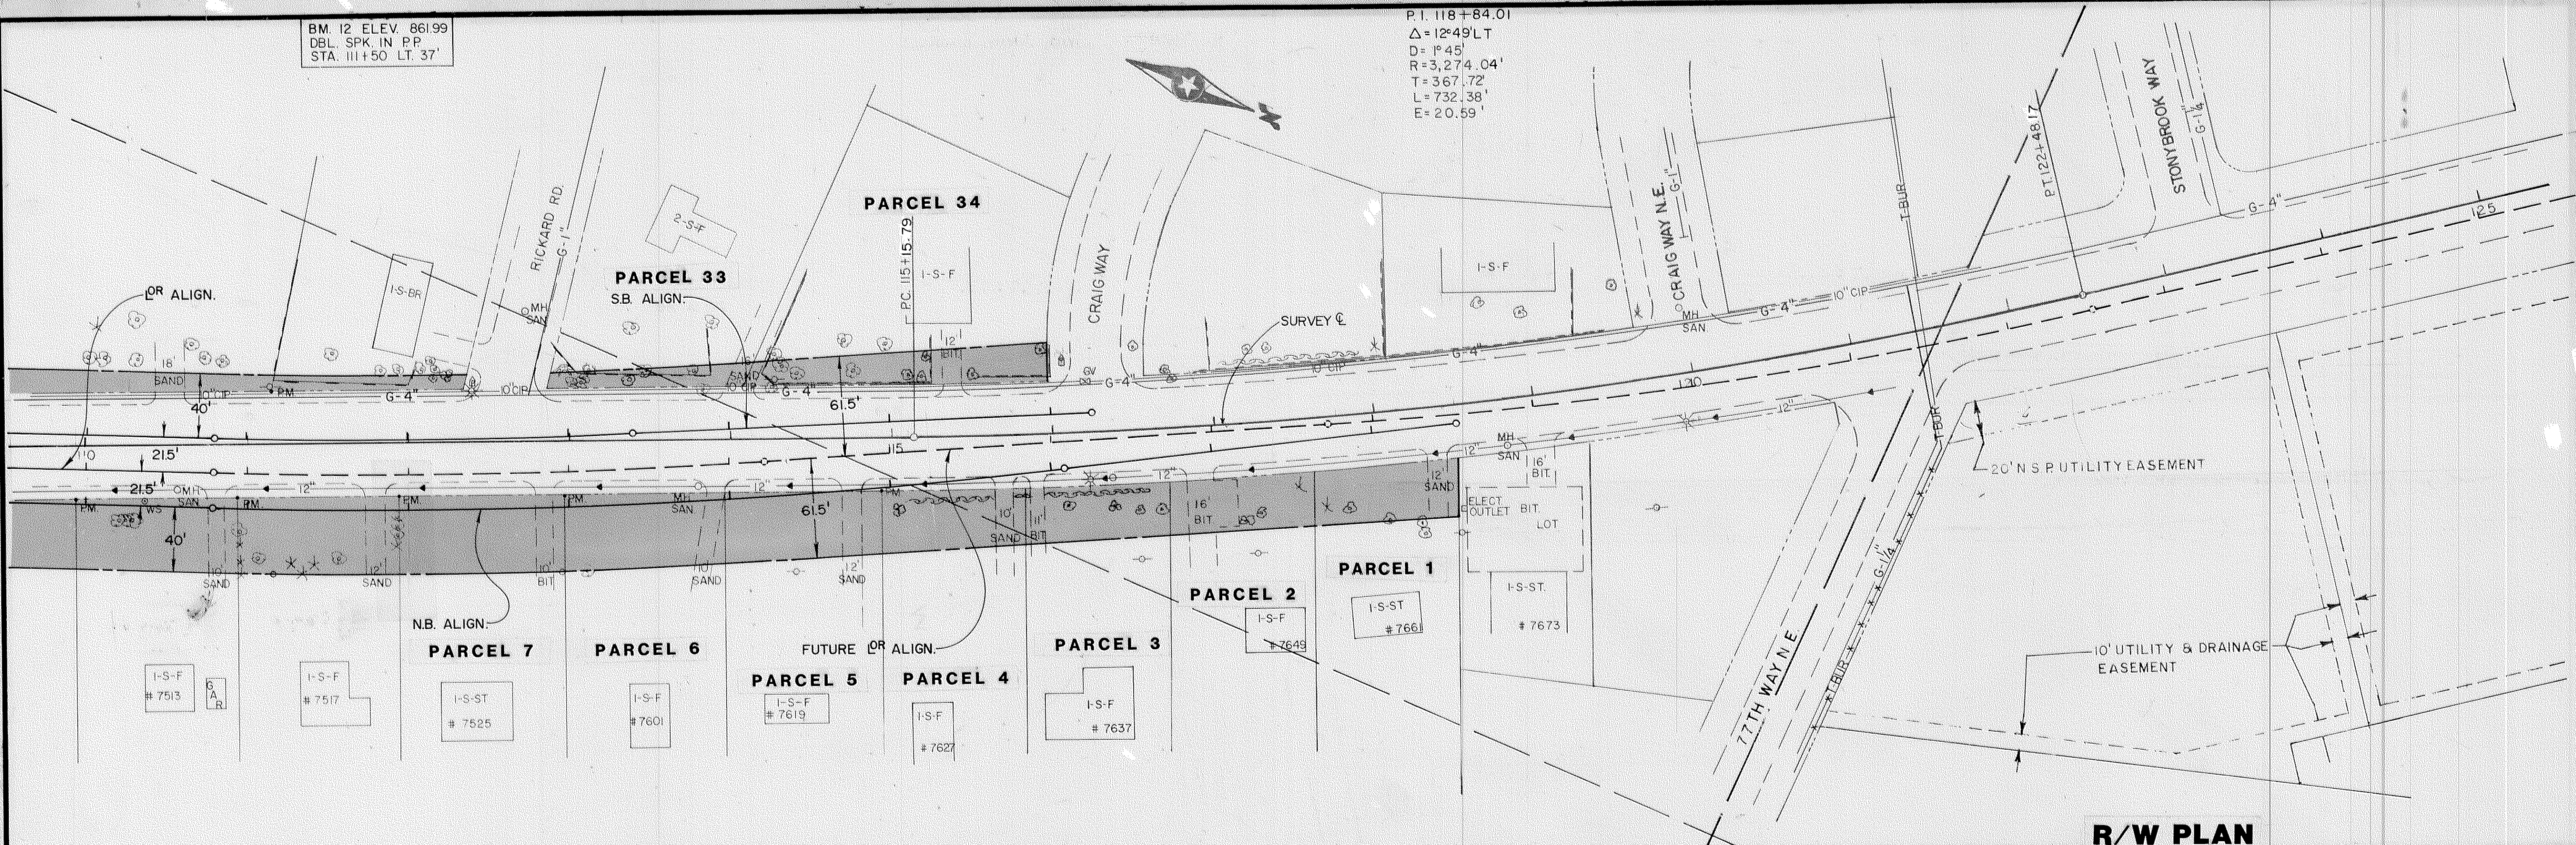


R/W PLAN

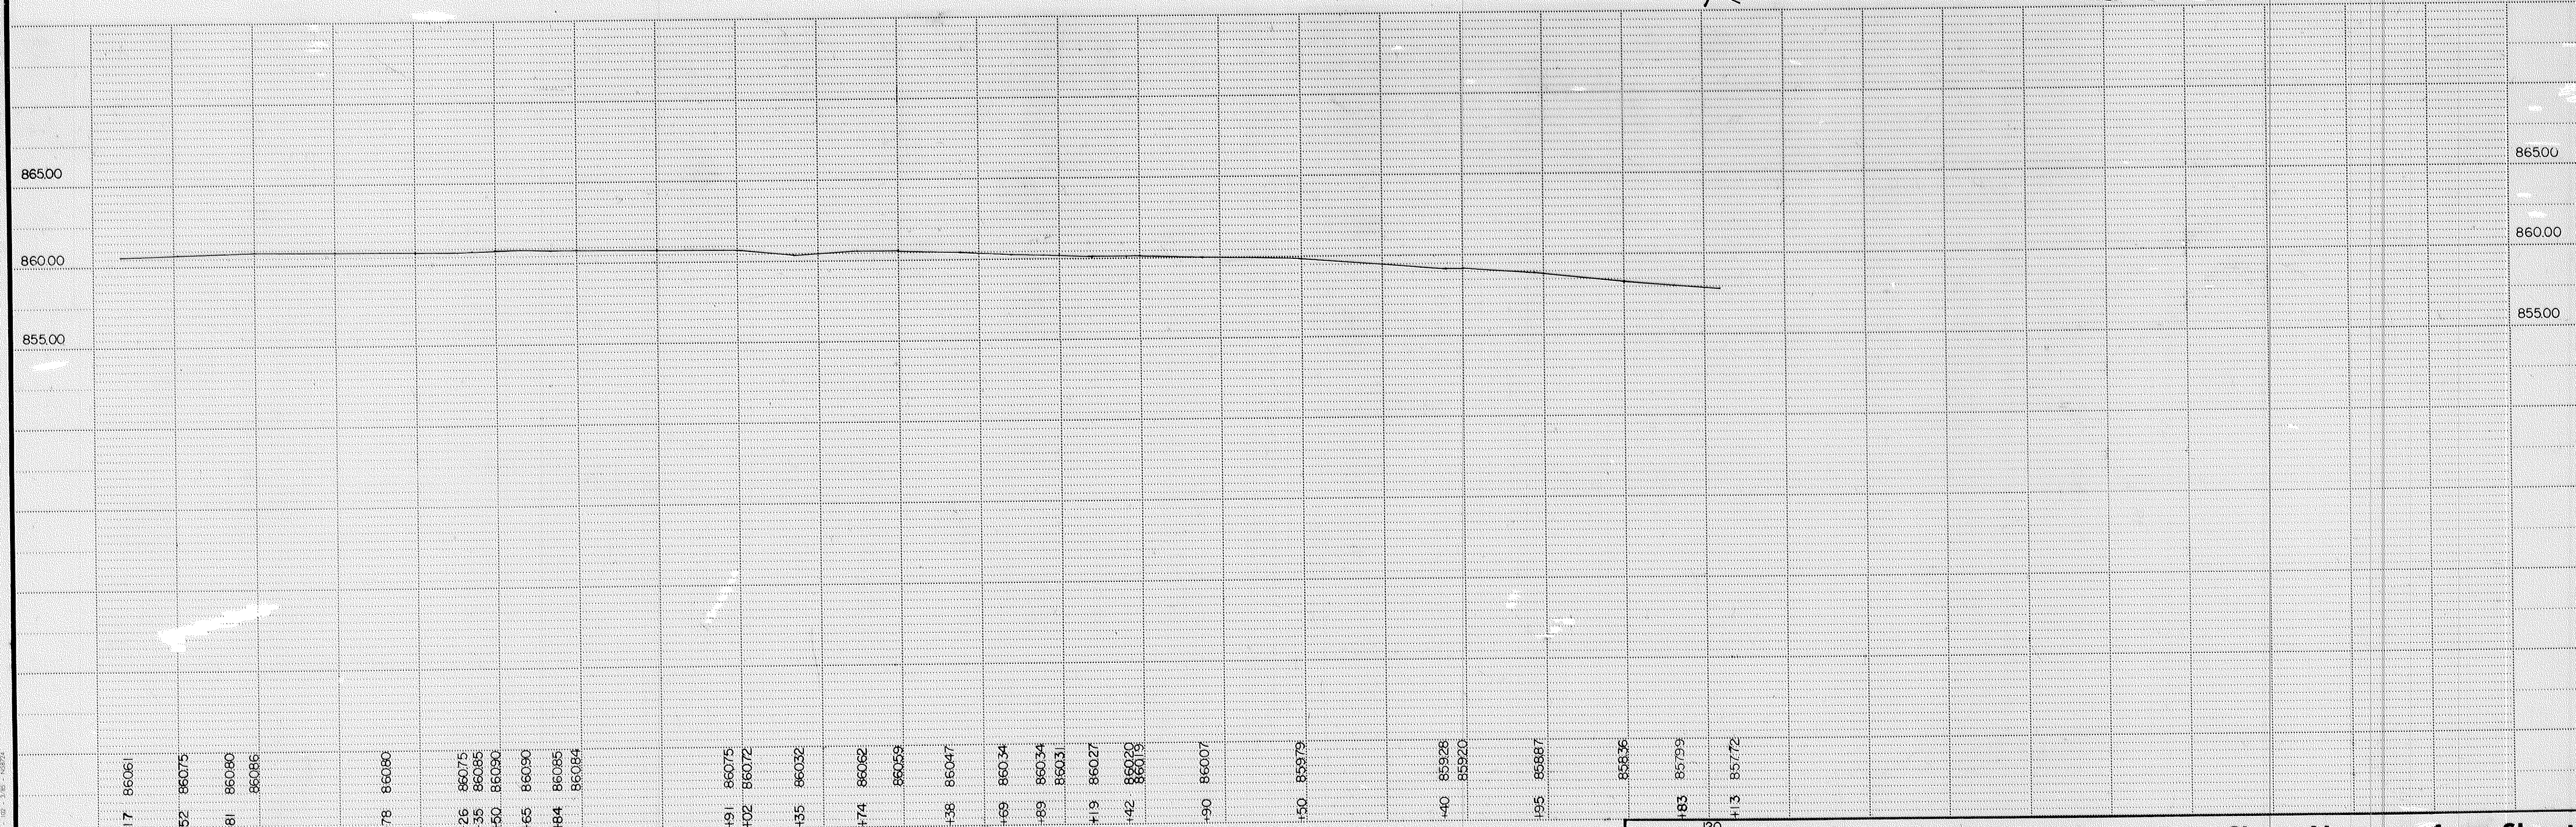

EXCAVATION **EMBANKMENT**
SUB-TOTALS CU.YDS. CU.YDS. SUB-TOTALS

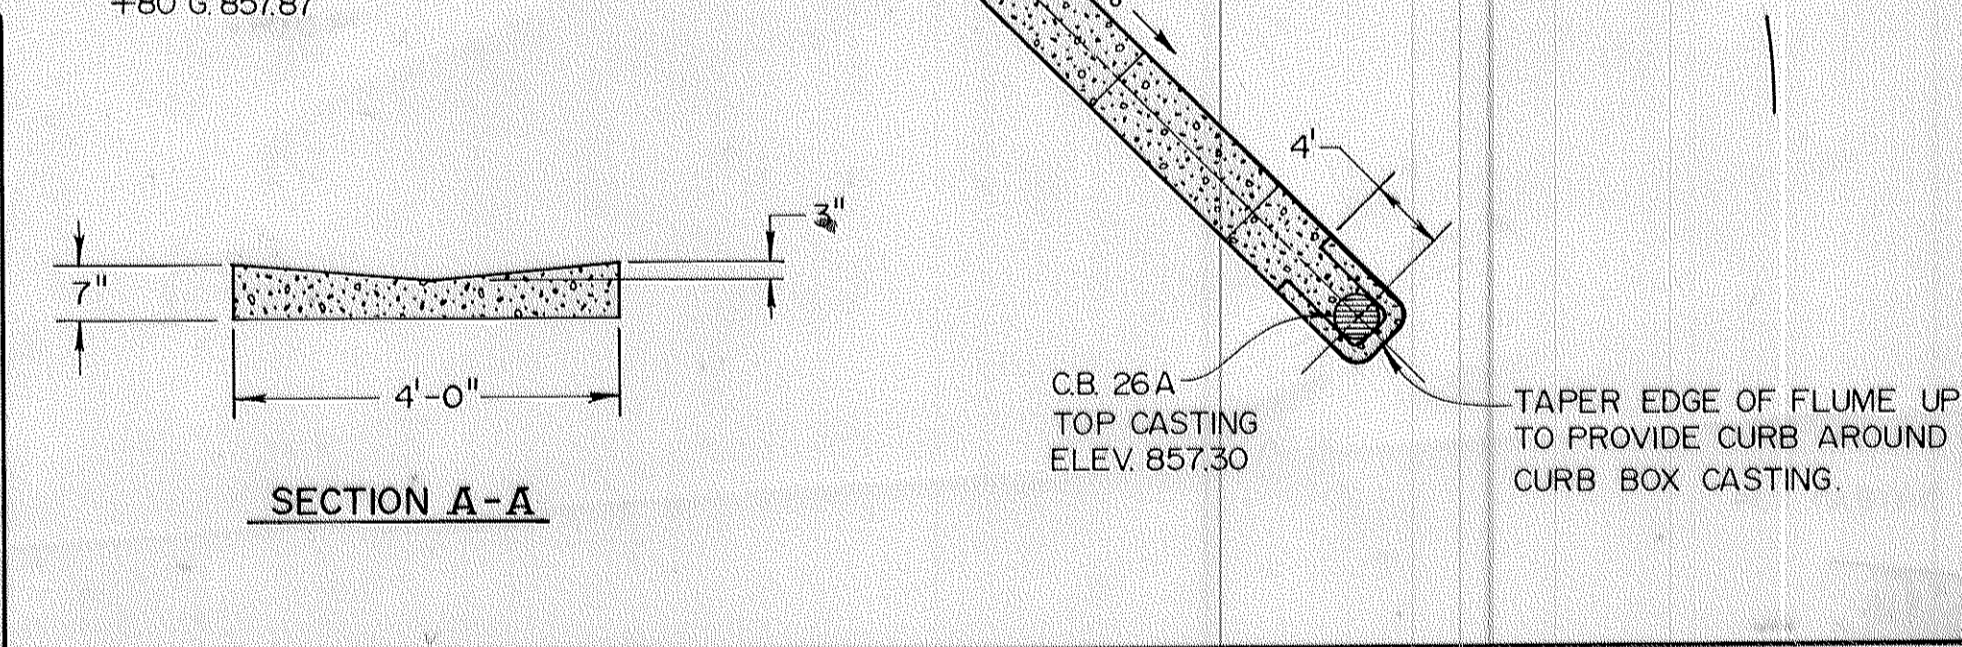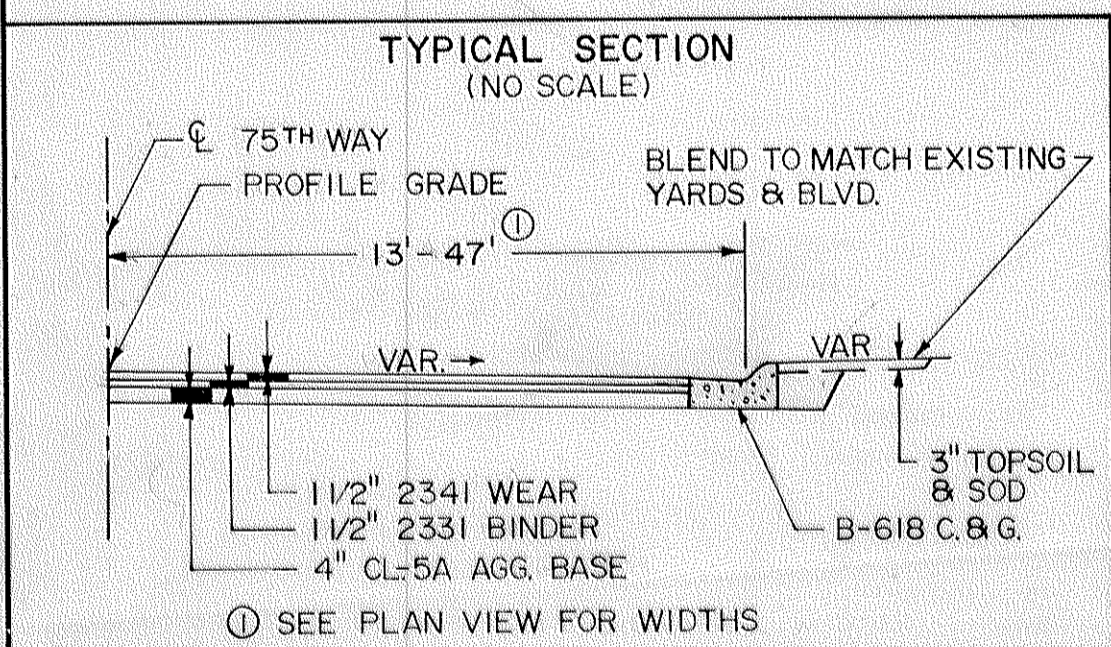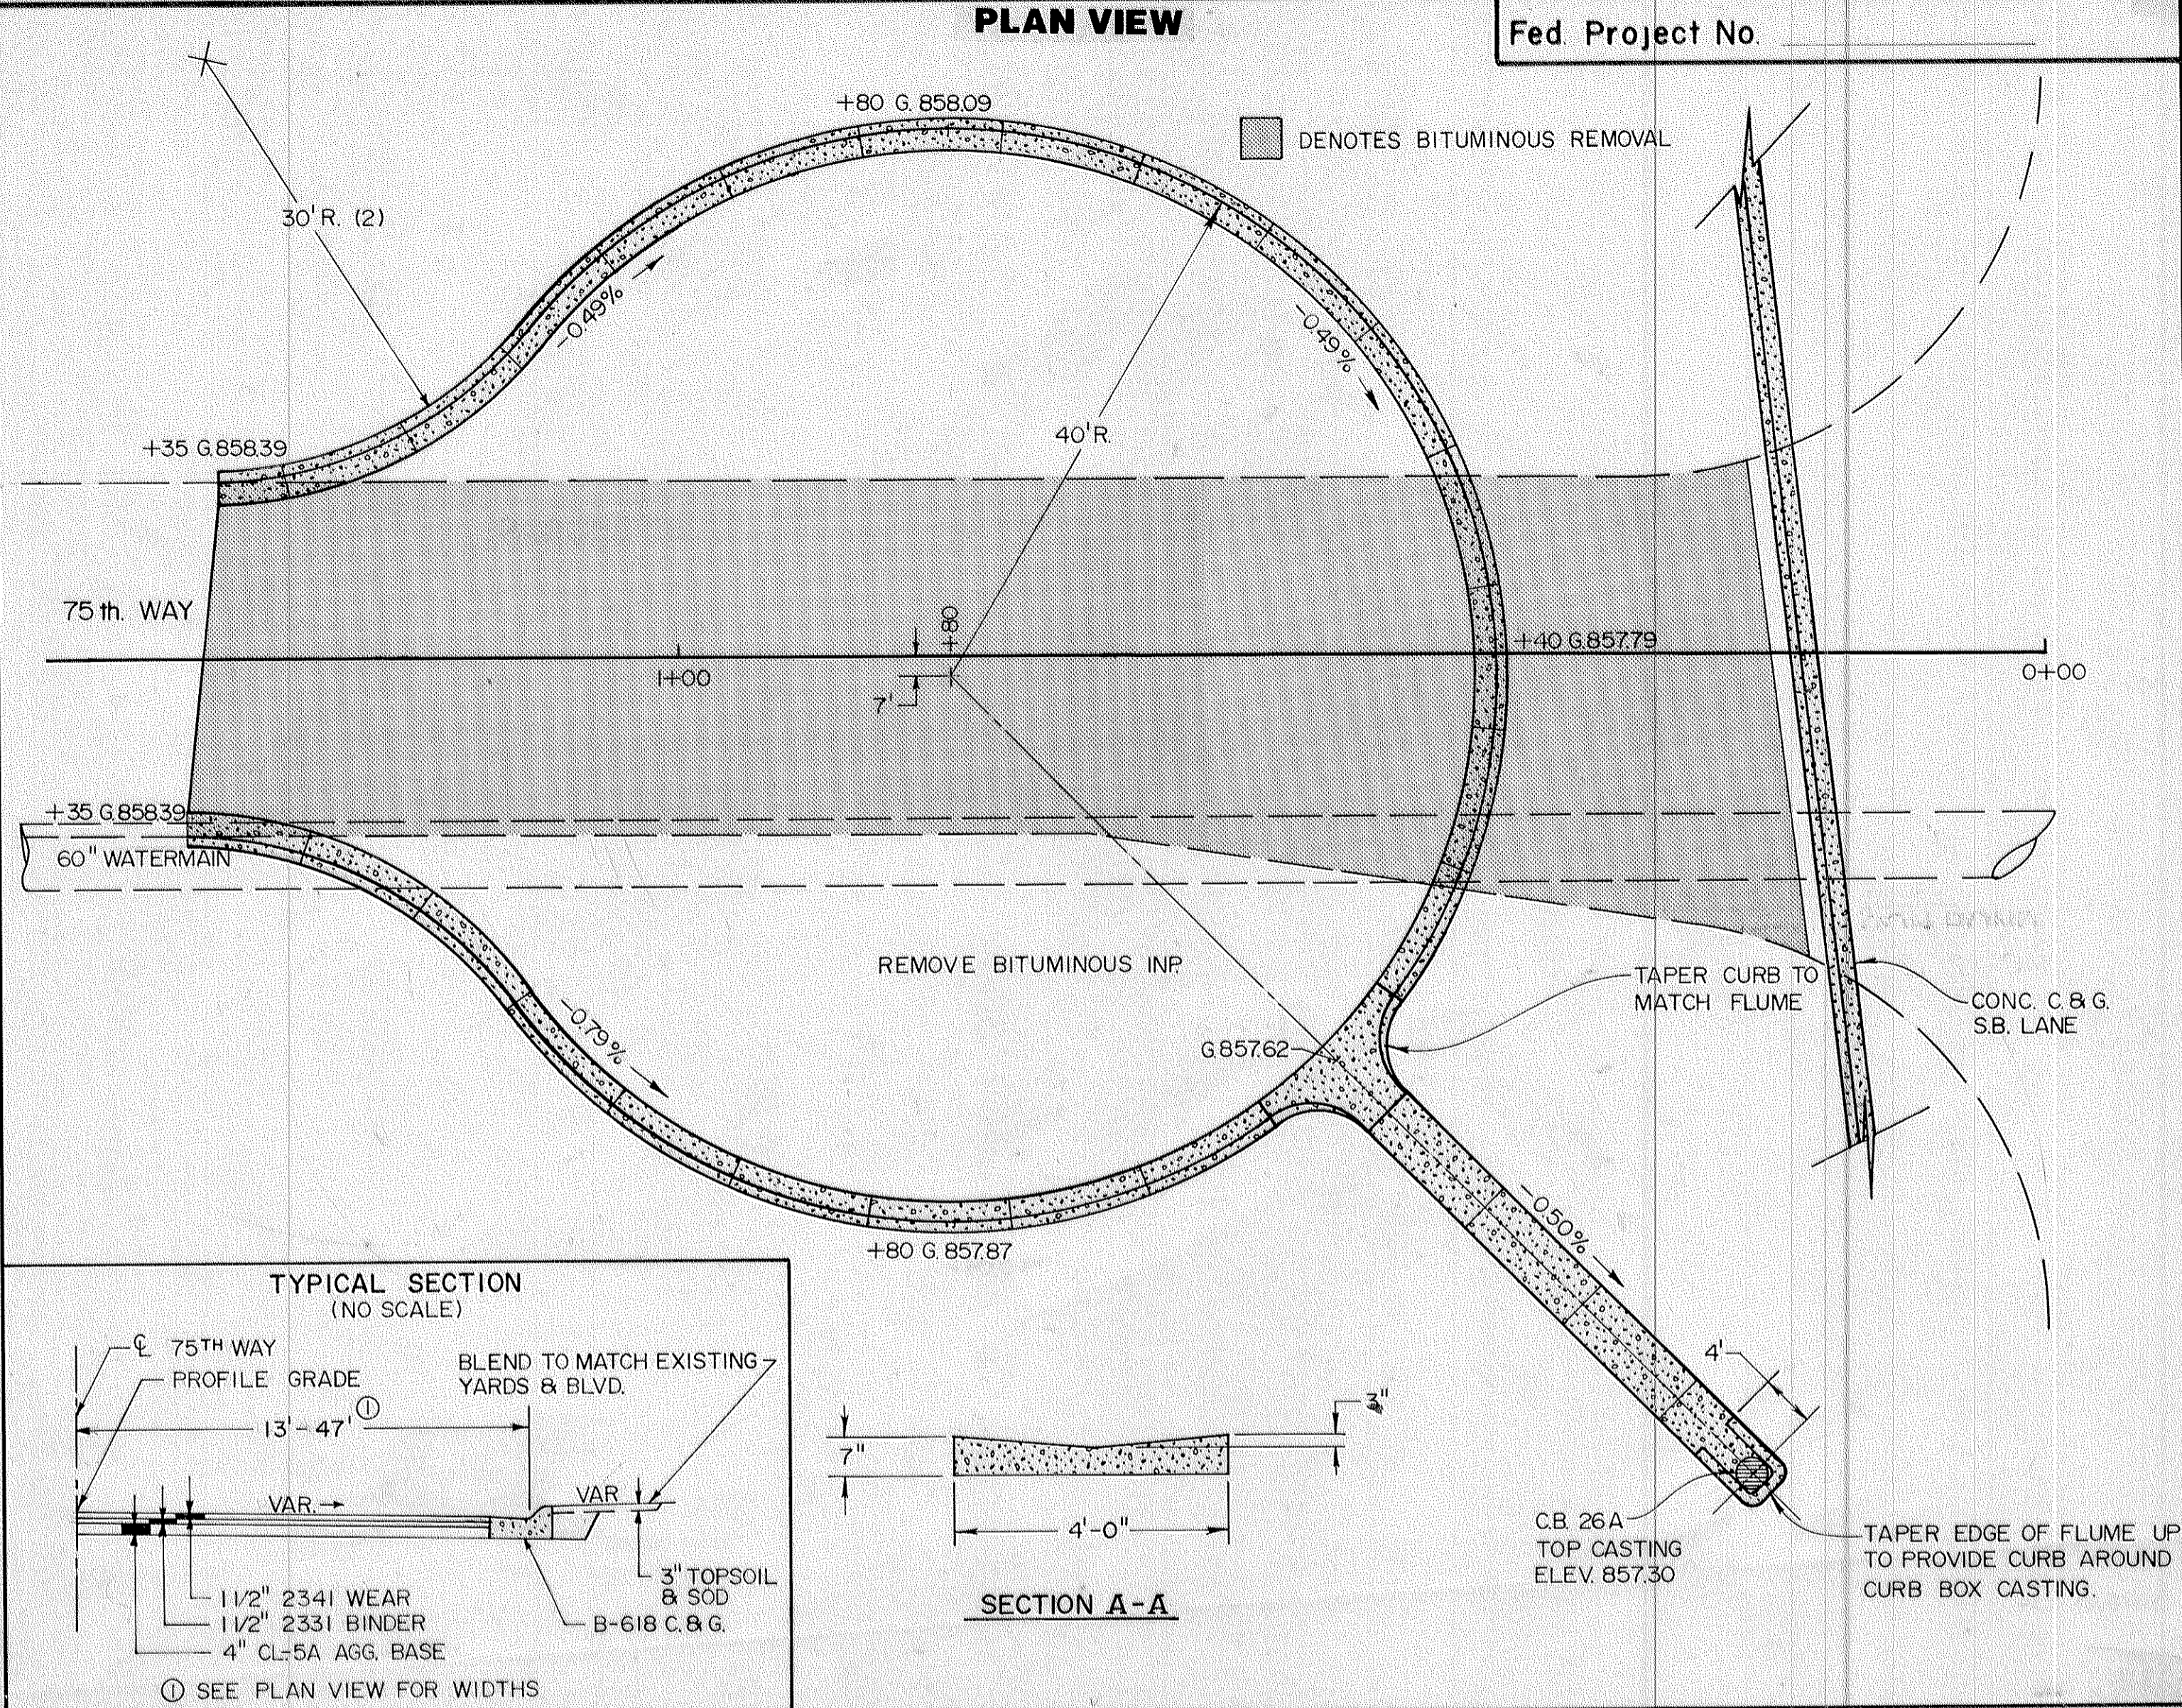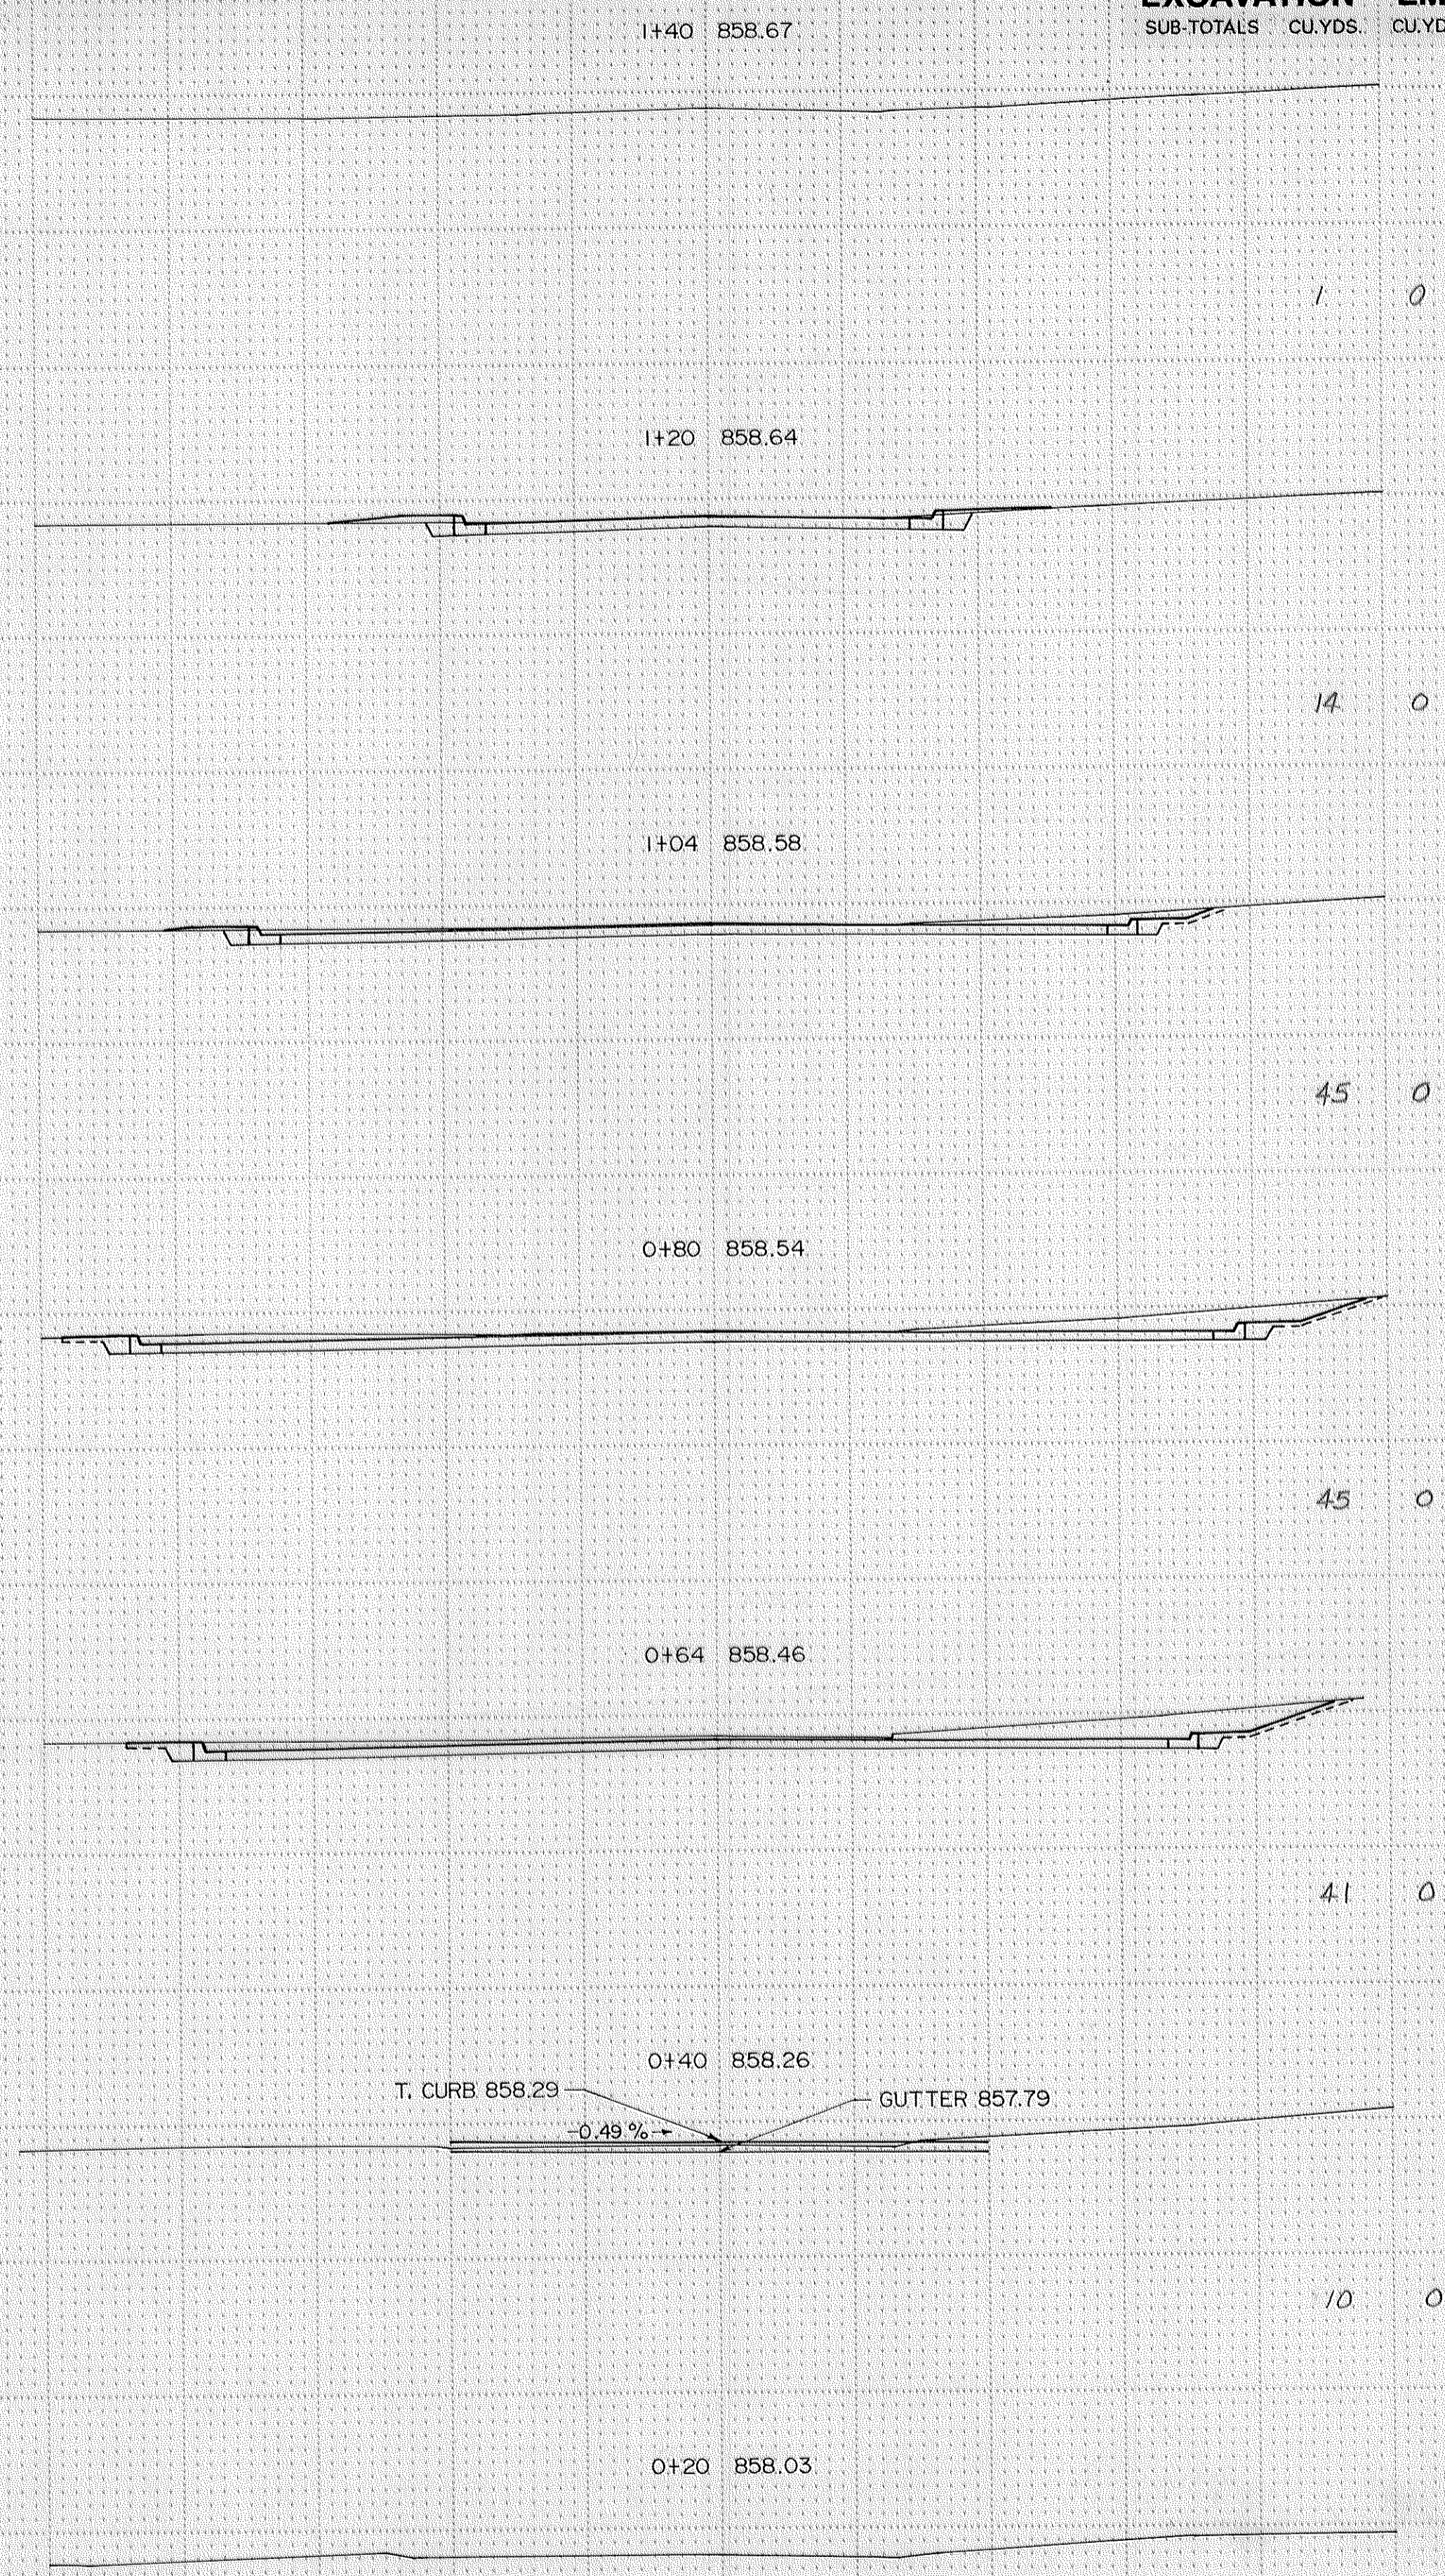

PROFILE VIEW

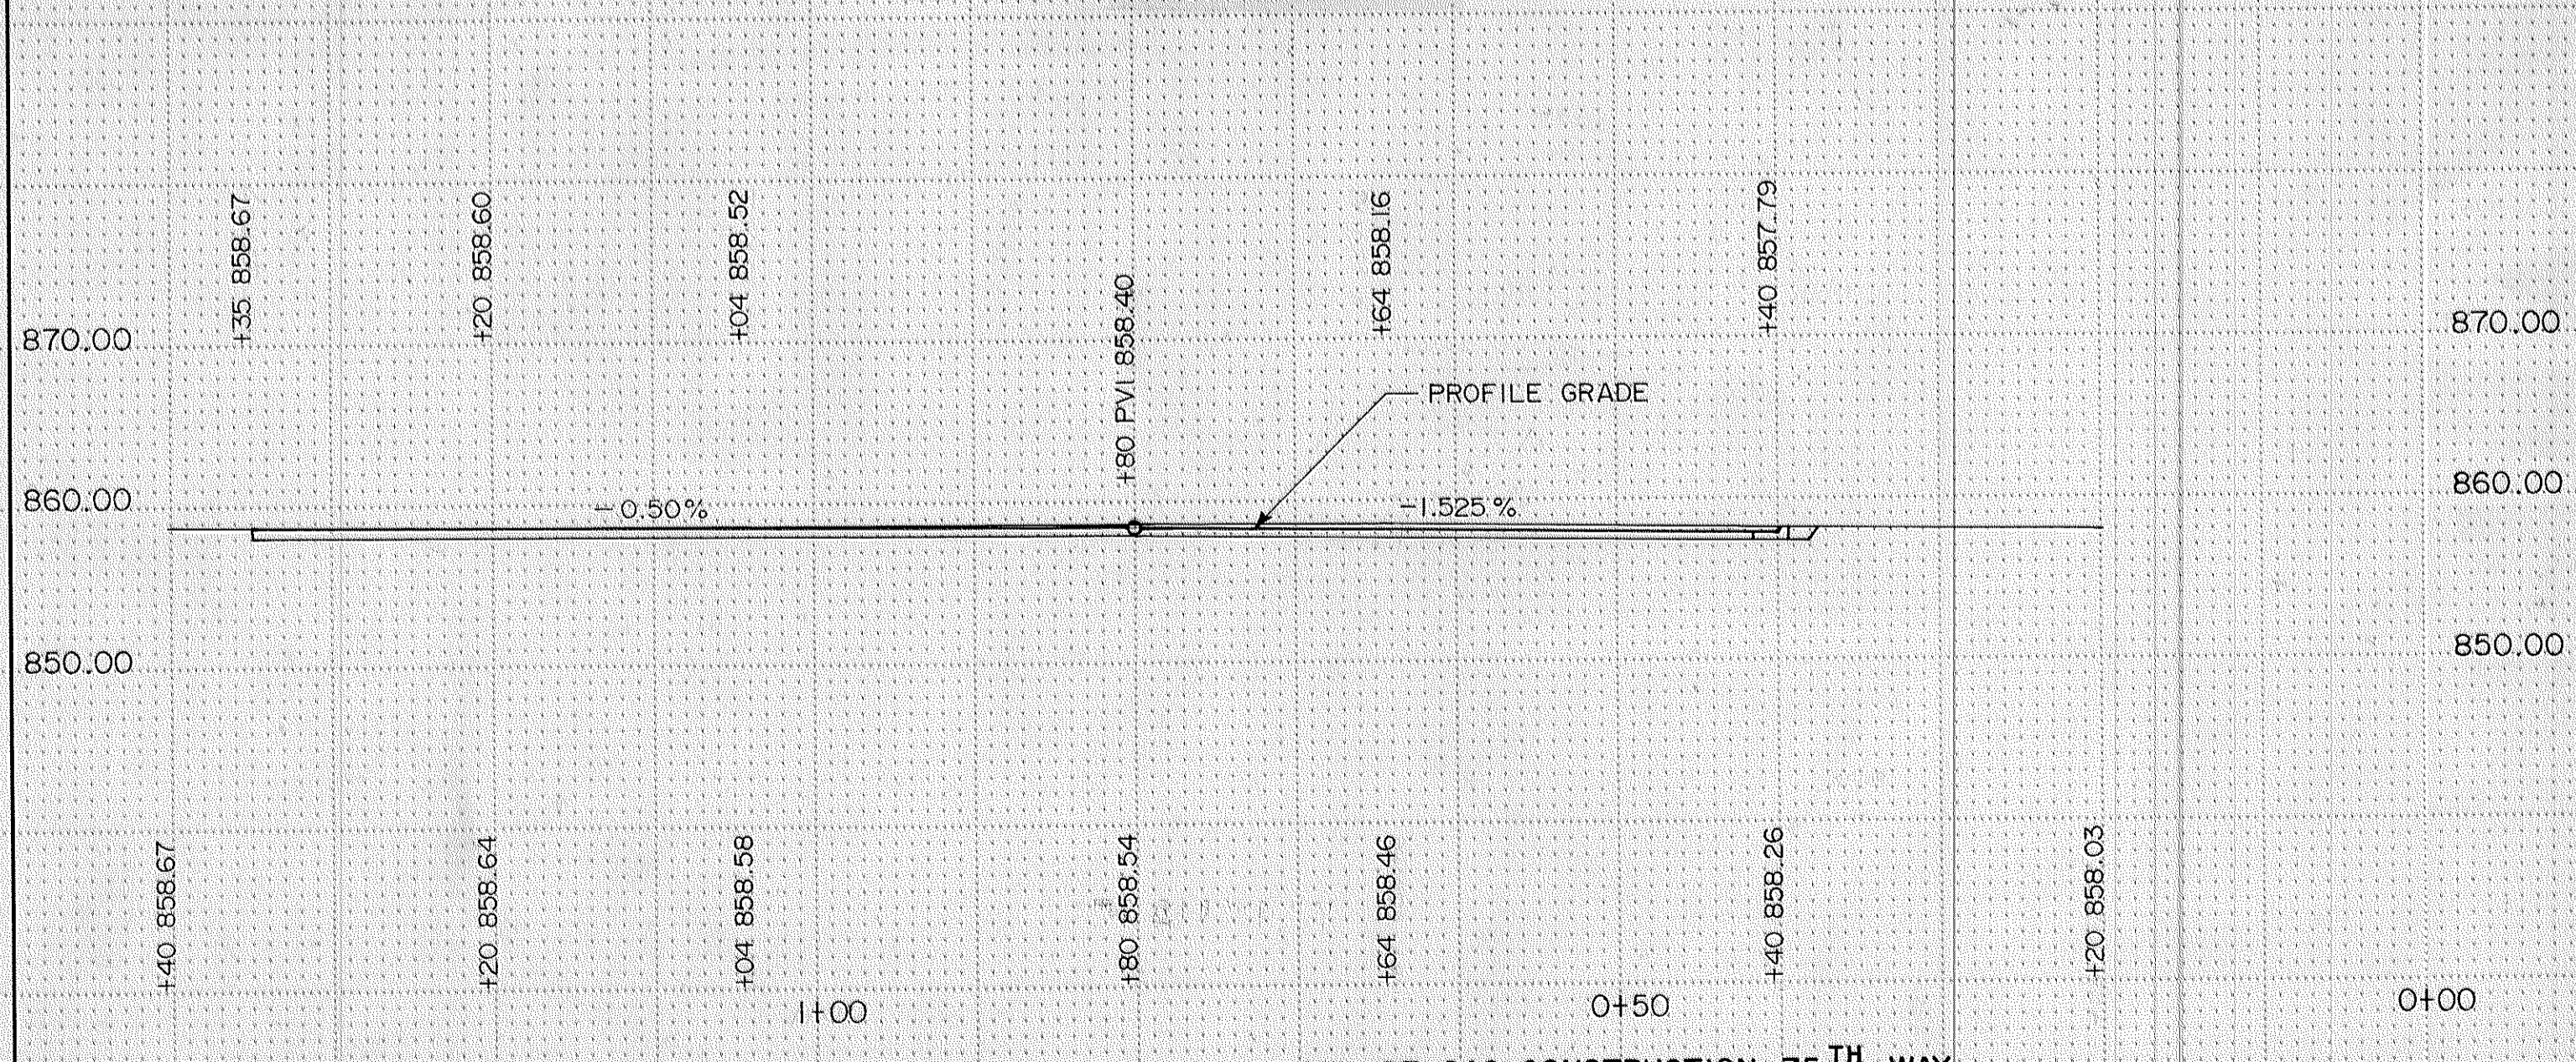


REVISIONS			
DATE	BY	DATE	BY

S.A.P. S.P. 02-601-33C.P.


EXCAVATION EMBANKMENT

SUB-TOTALS CU.YDS. CU.YDS. SUB-TOTALS

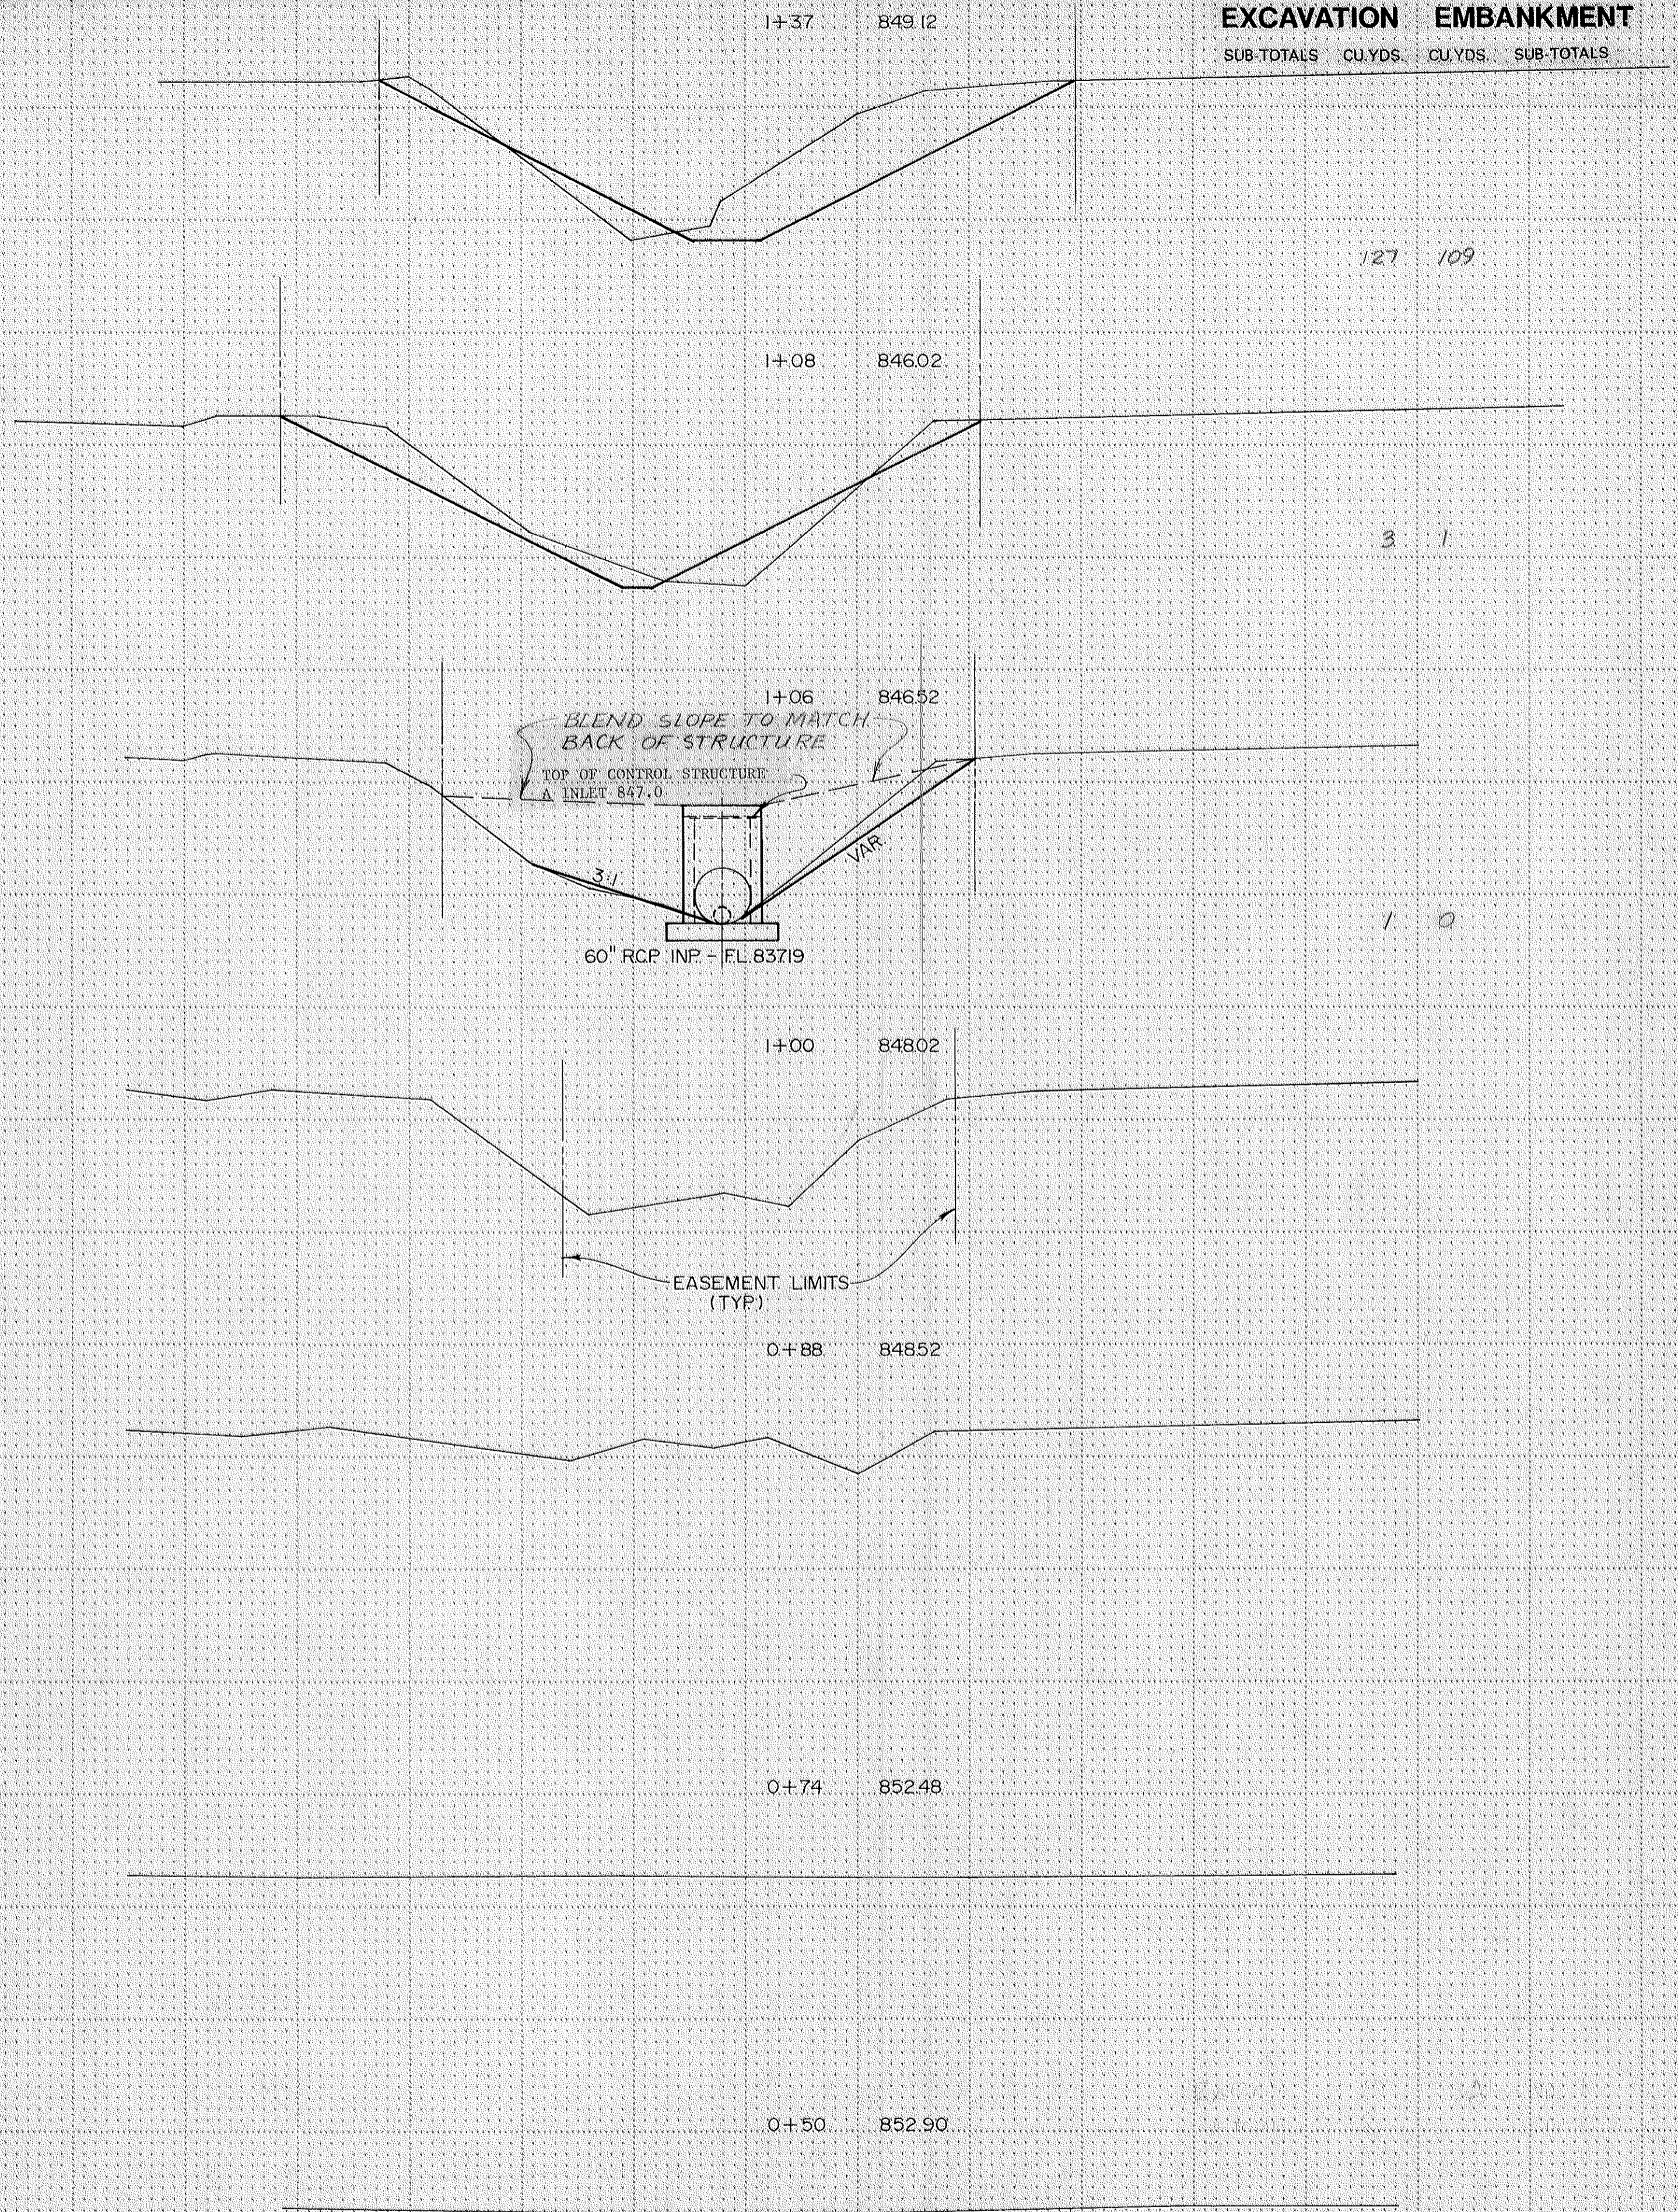

Fed. Project No. _____


PLAN VIEW

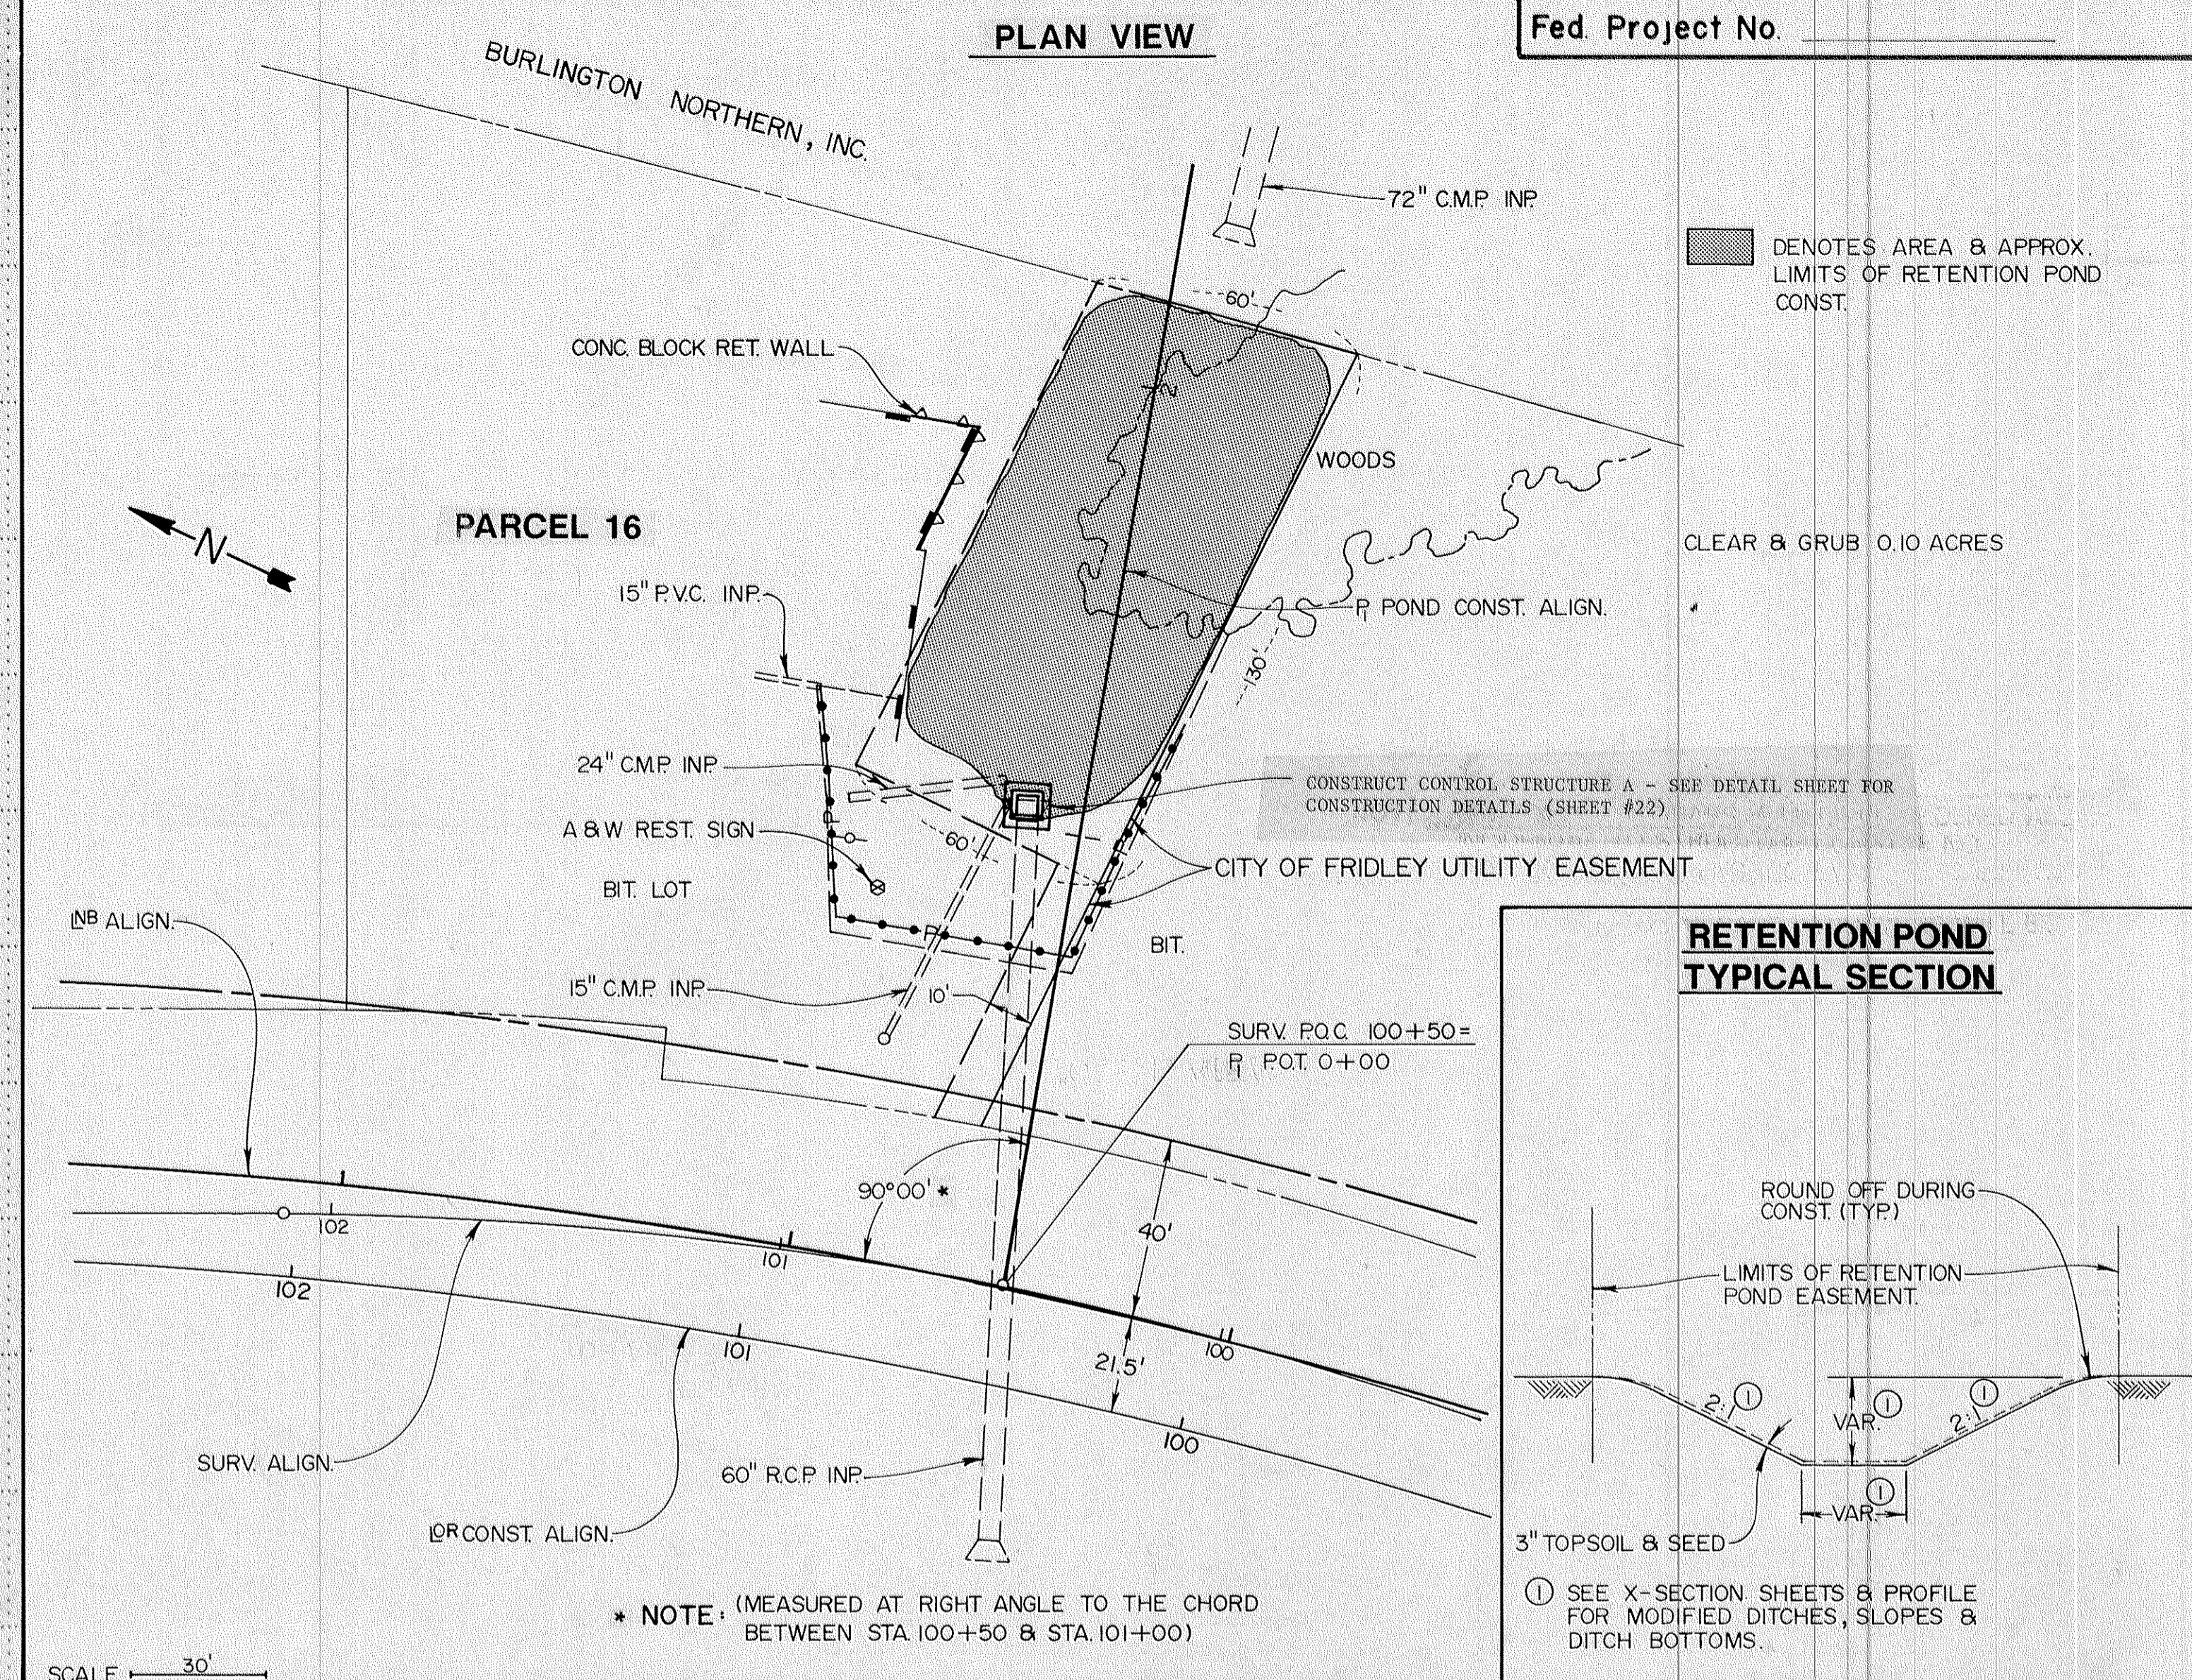


DENOTES AREA & APPROX. LIMITS OF RETENTION POND CONST.

CLEAR & GRUB 0.10 ACRES

RETENTION POND TYPICAL SECTION

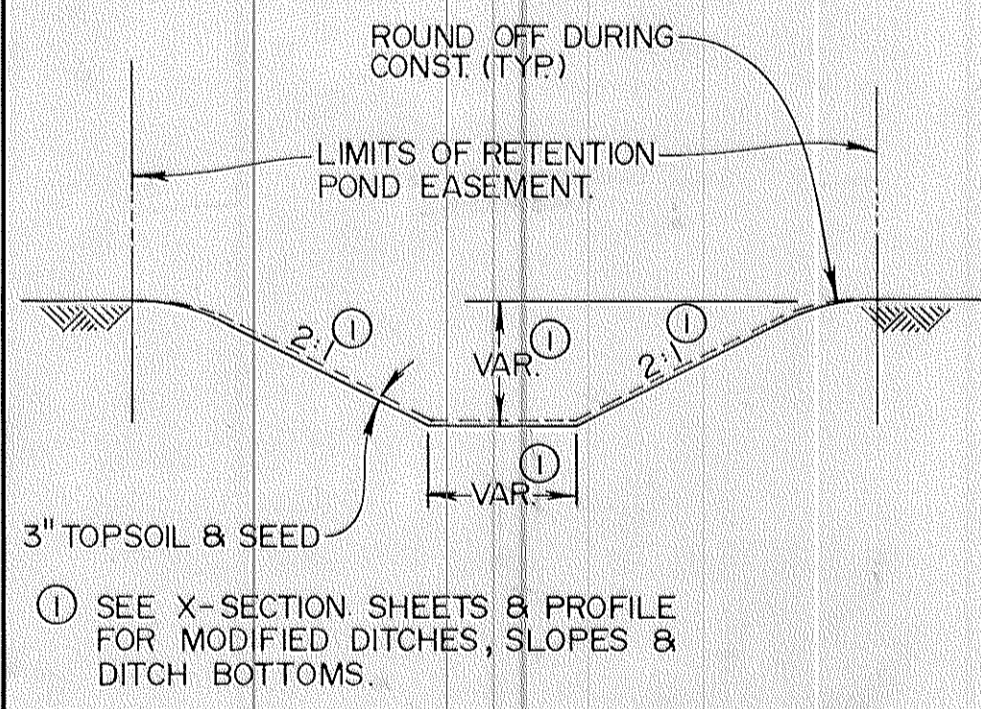

PROFILE VIEW

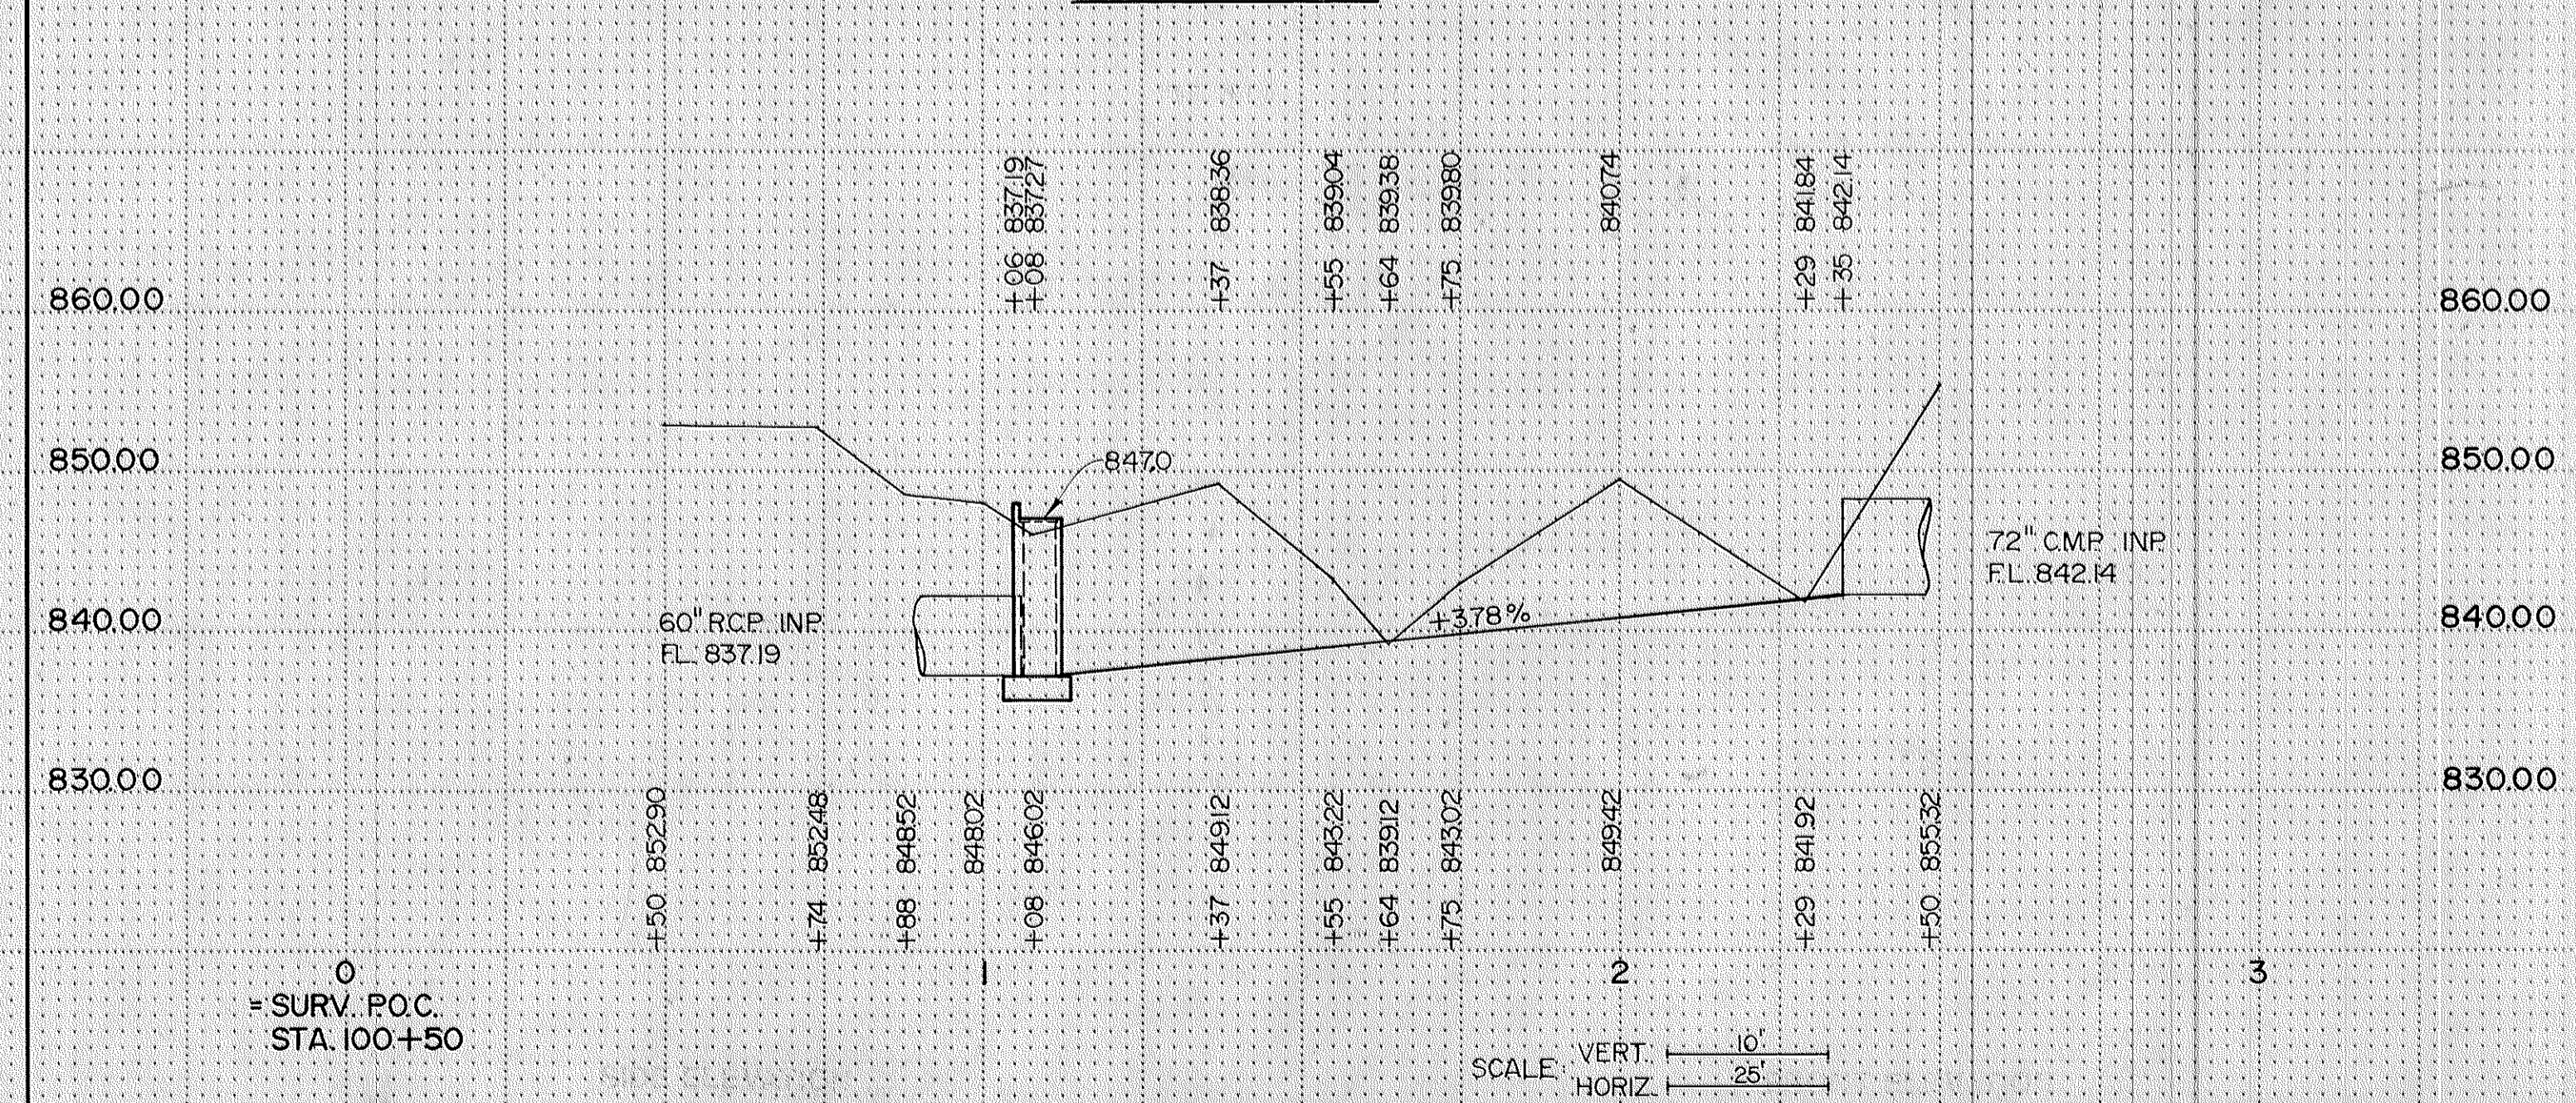

REVISIONS			
DATE	BY	DATE	BY

RETENTION POND CONSTRUCTION DETAILS

EXCAVATION EMBANKMENT

SUB-TOTALS CU.YDS. CU.YDS. SUB-TOTALS

2+50 85532

2+35 84575

72" C.M.P. INP
FL. 842.14

2+29 84192

BLEND TO MATCH EXISTING DITCH
& END CONST. STA. 2+19

2+00 84942

80 8

190 15

1+75 84302

45 7

1+64 83912


27 8

1+55 84322

96 15


UTILITY EASEMENT LIMITS
(TYP.)

CONTROL STRUCTURE A CONSTRUCTION DETAILS

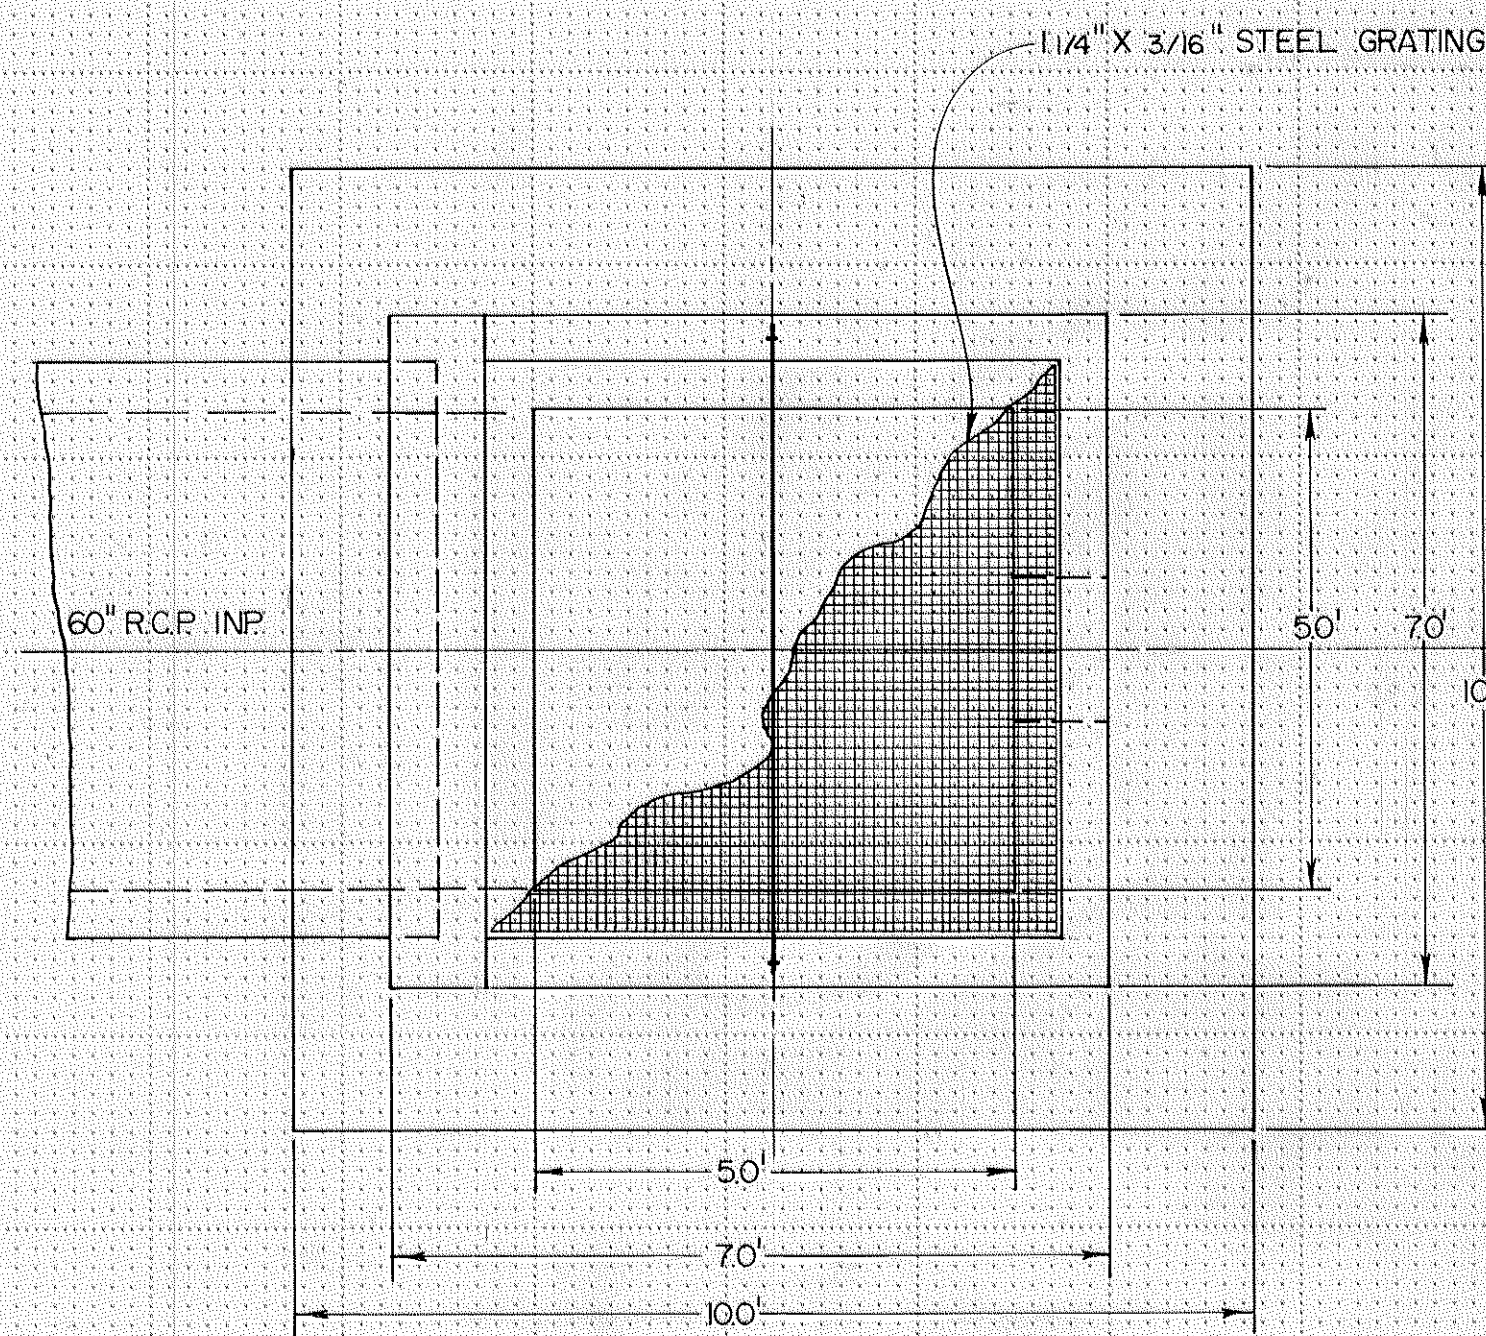

TOP VIEW

NOTE: REINFORCEMENT BARS WILL BE CONSIDERED AS INCIDENTAL TO STRUCTURE CONST. & NO ADDITIONAL COMPENSATION WILL BE MADE.
AN EQUIVALENT PRECAST STRUCTURE WILL BE CONSIDERED ACCEPTABLE.

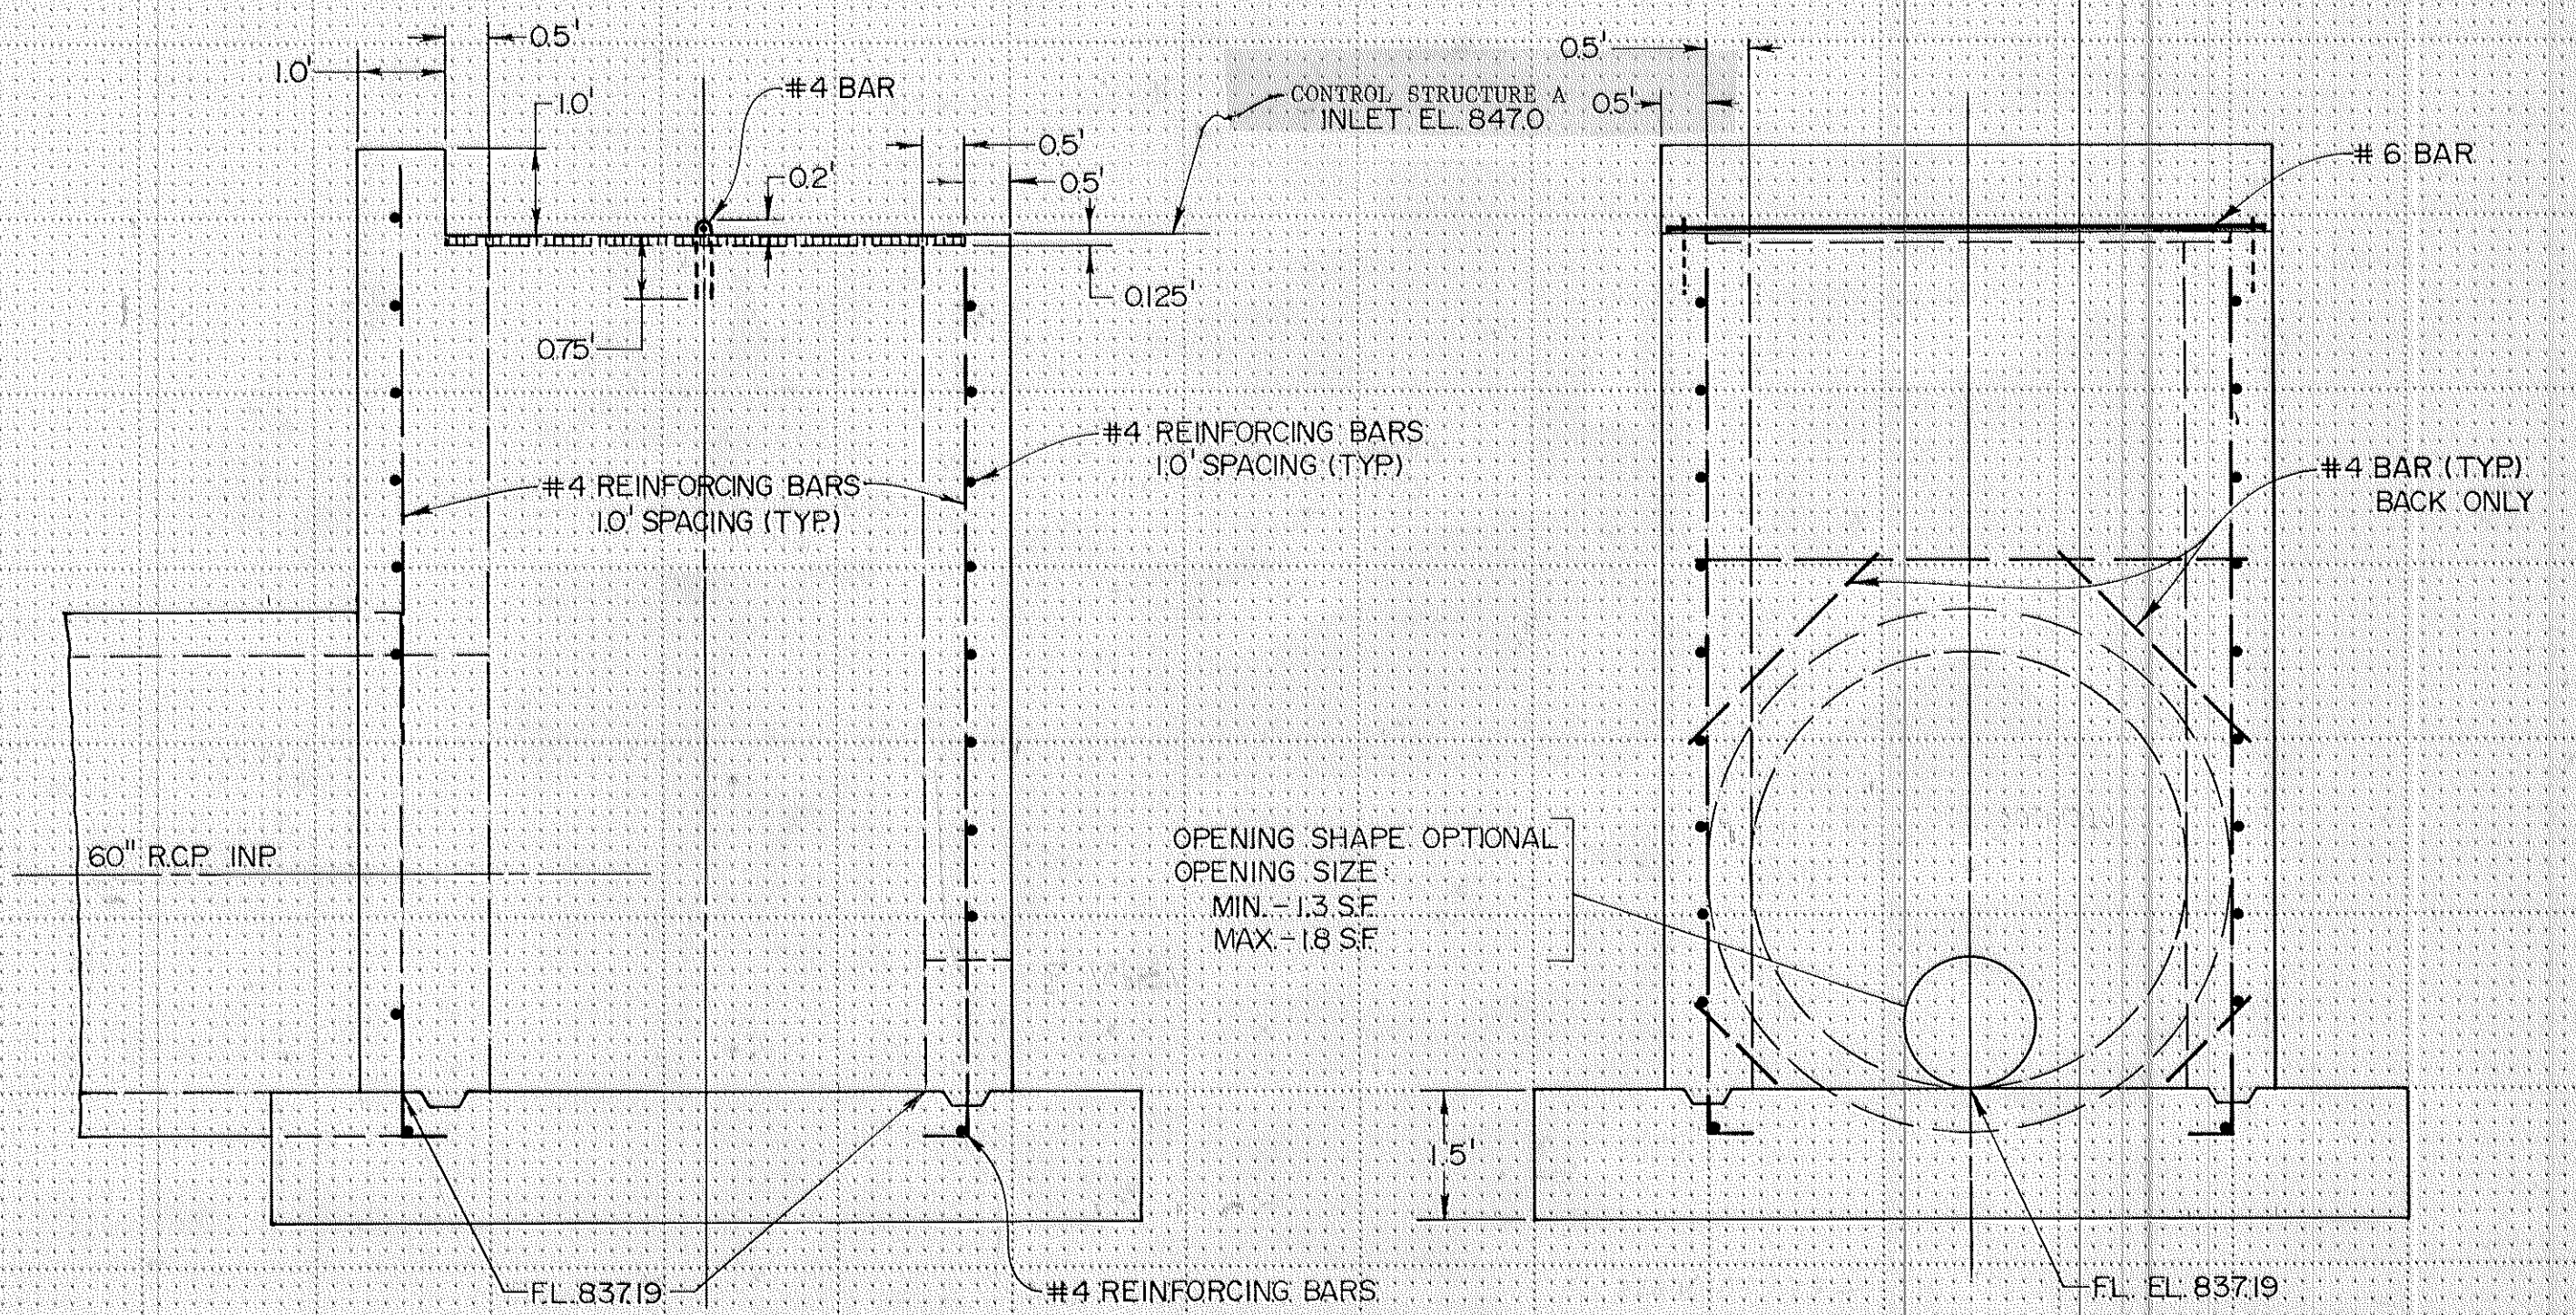

SIDE ELEVATION

FRONT ELEVATION



RETENTION POND CONSTRUCTION DETAILS

State Proj. No. S. P. 02 - 601 - 33

Sheet No. 22 of 58 Sheets



TYPICAL SECTION IN SUPERELEVATION

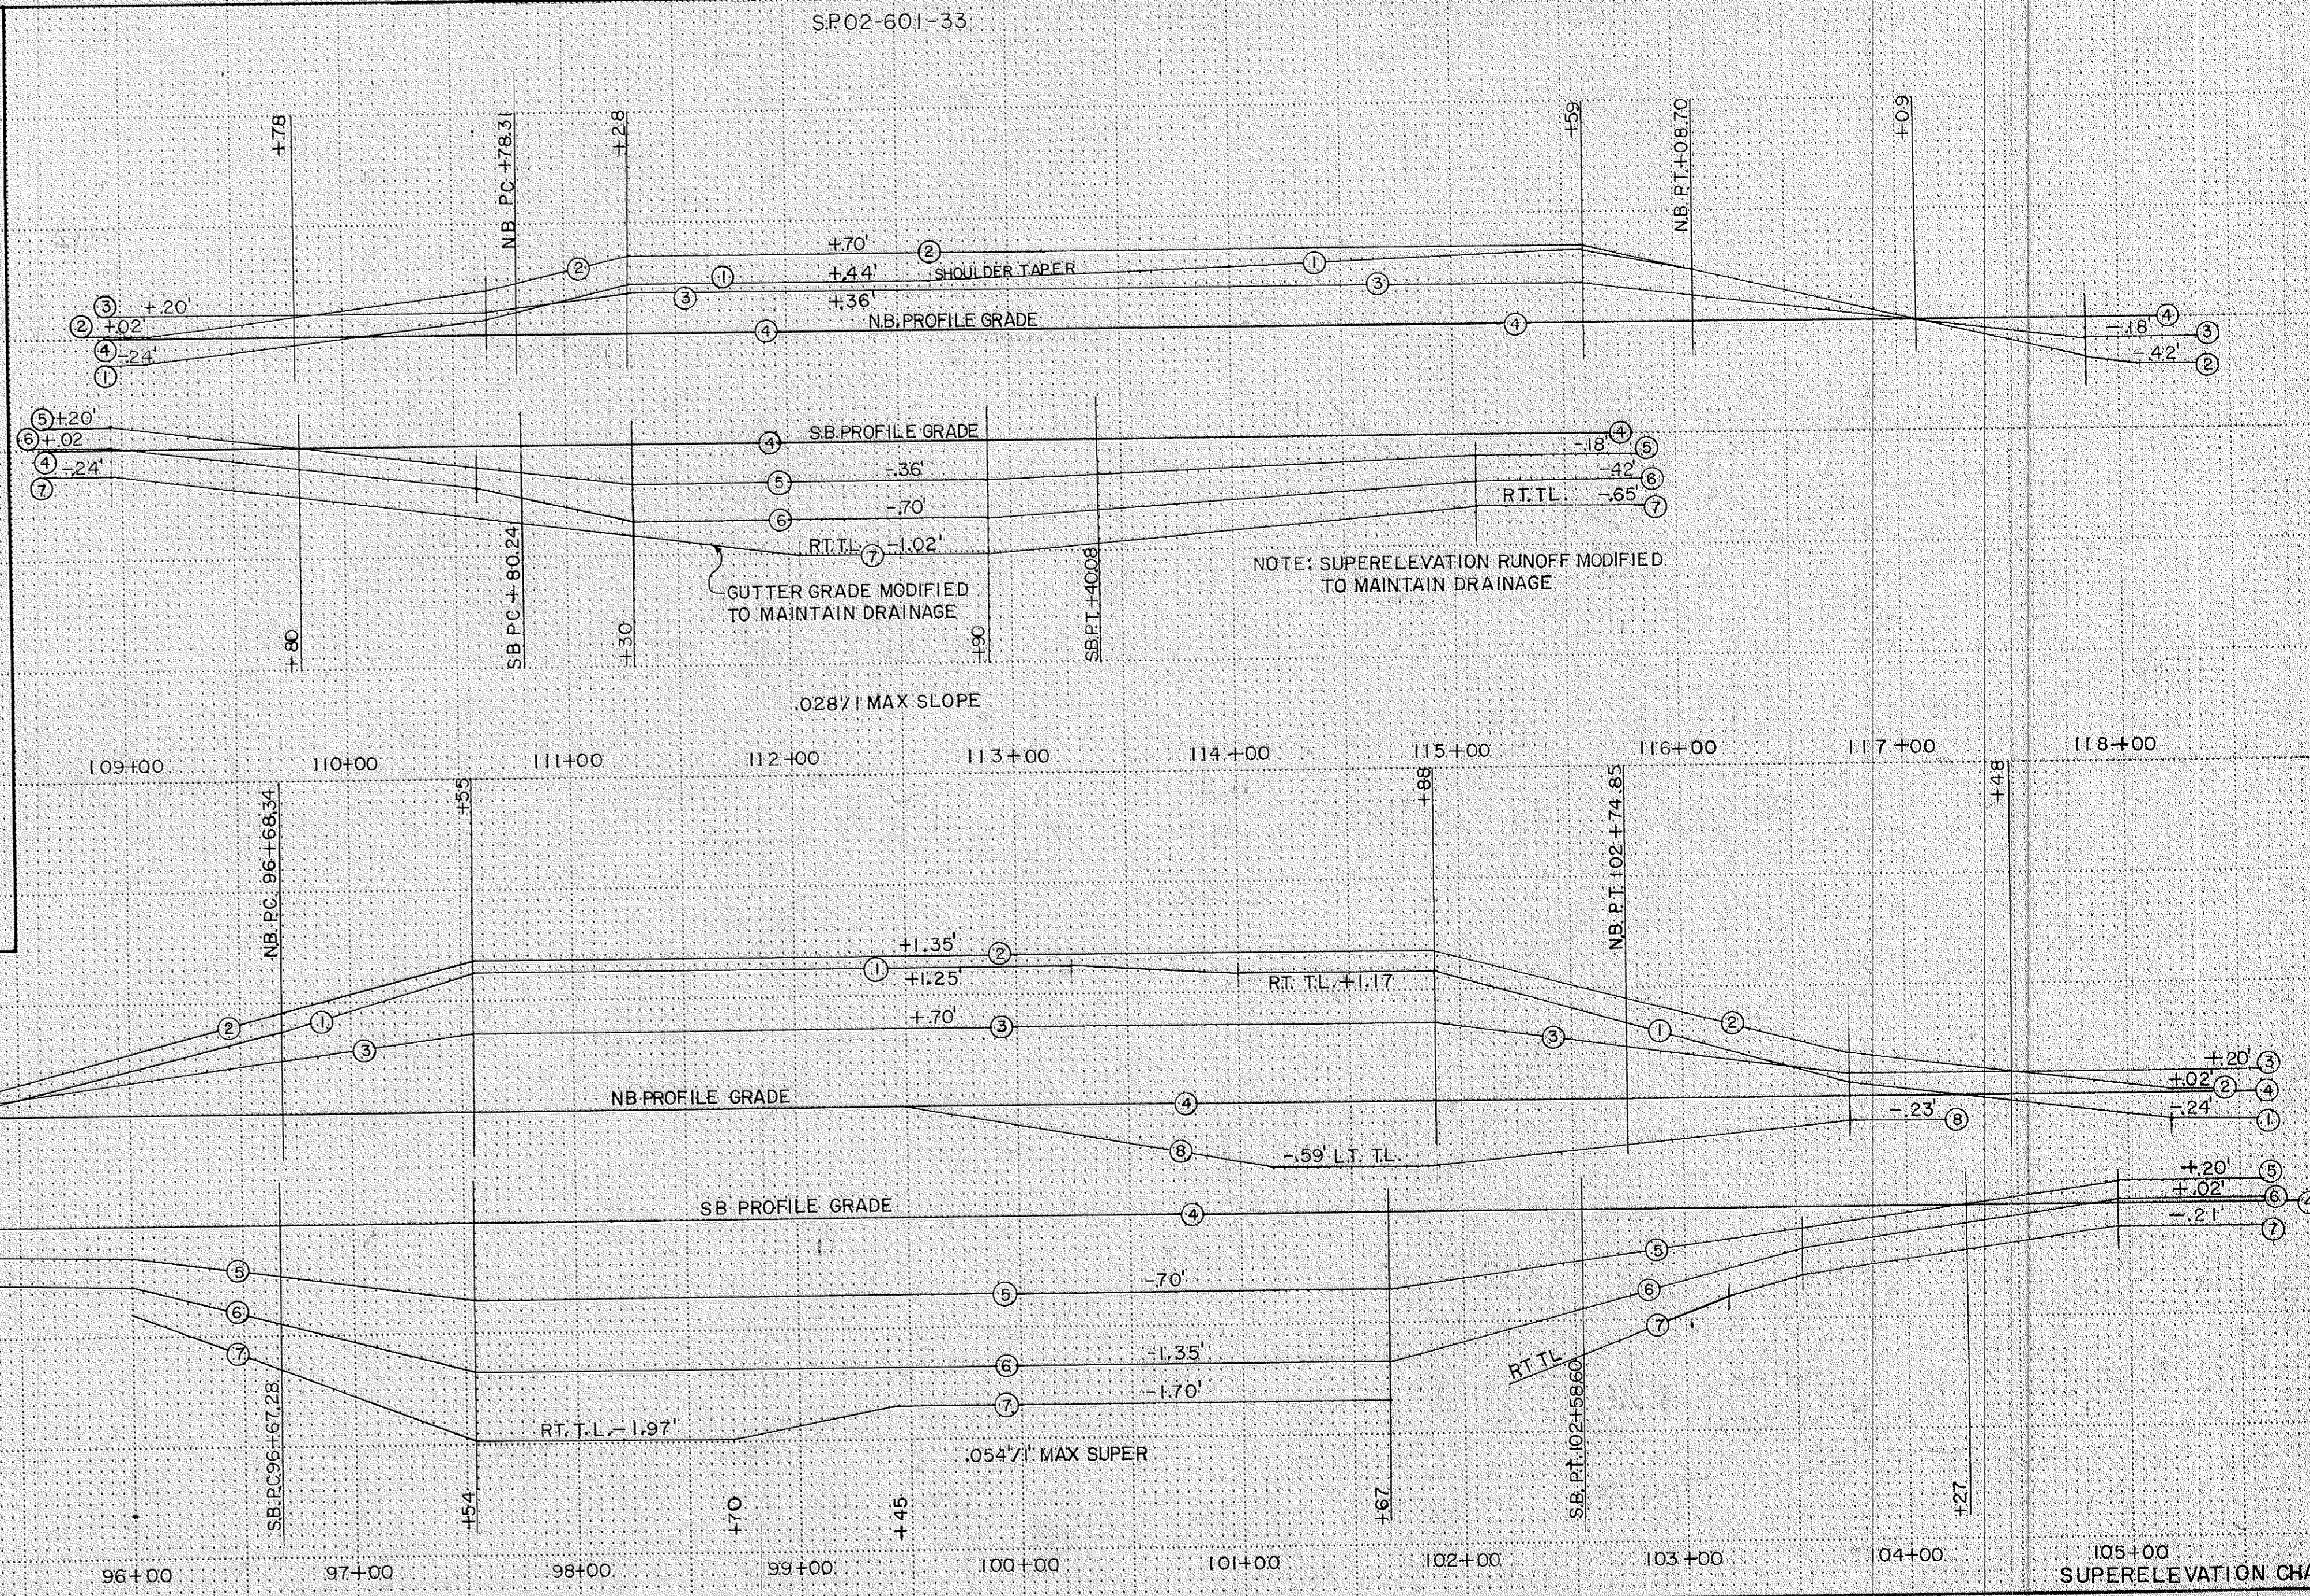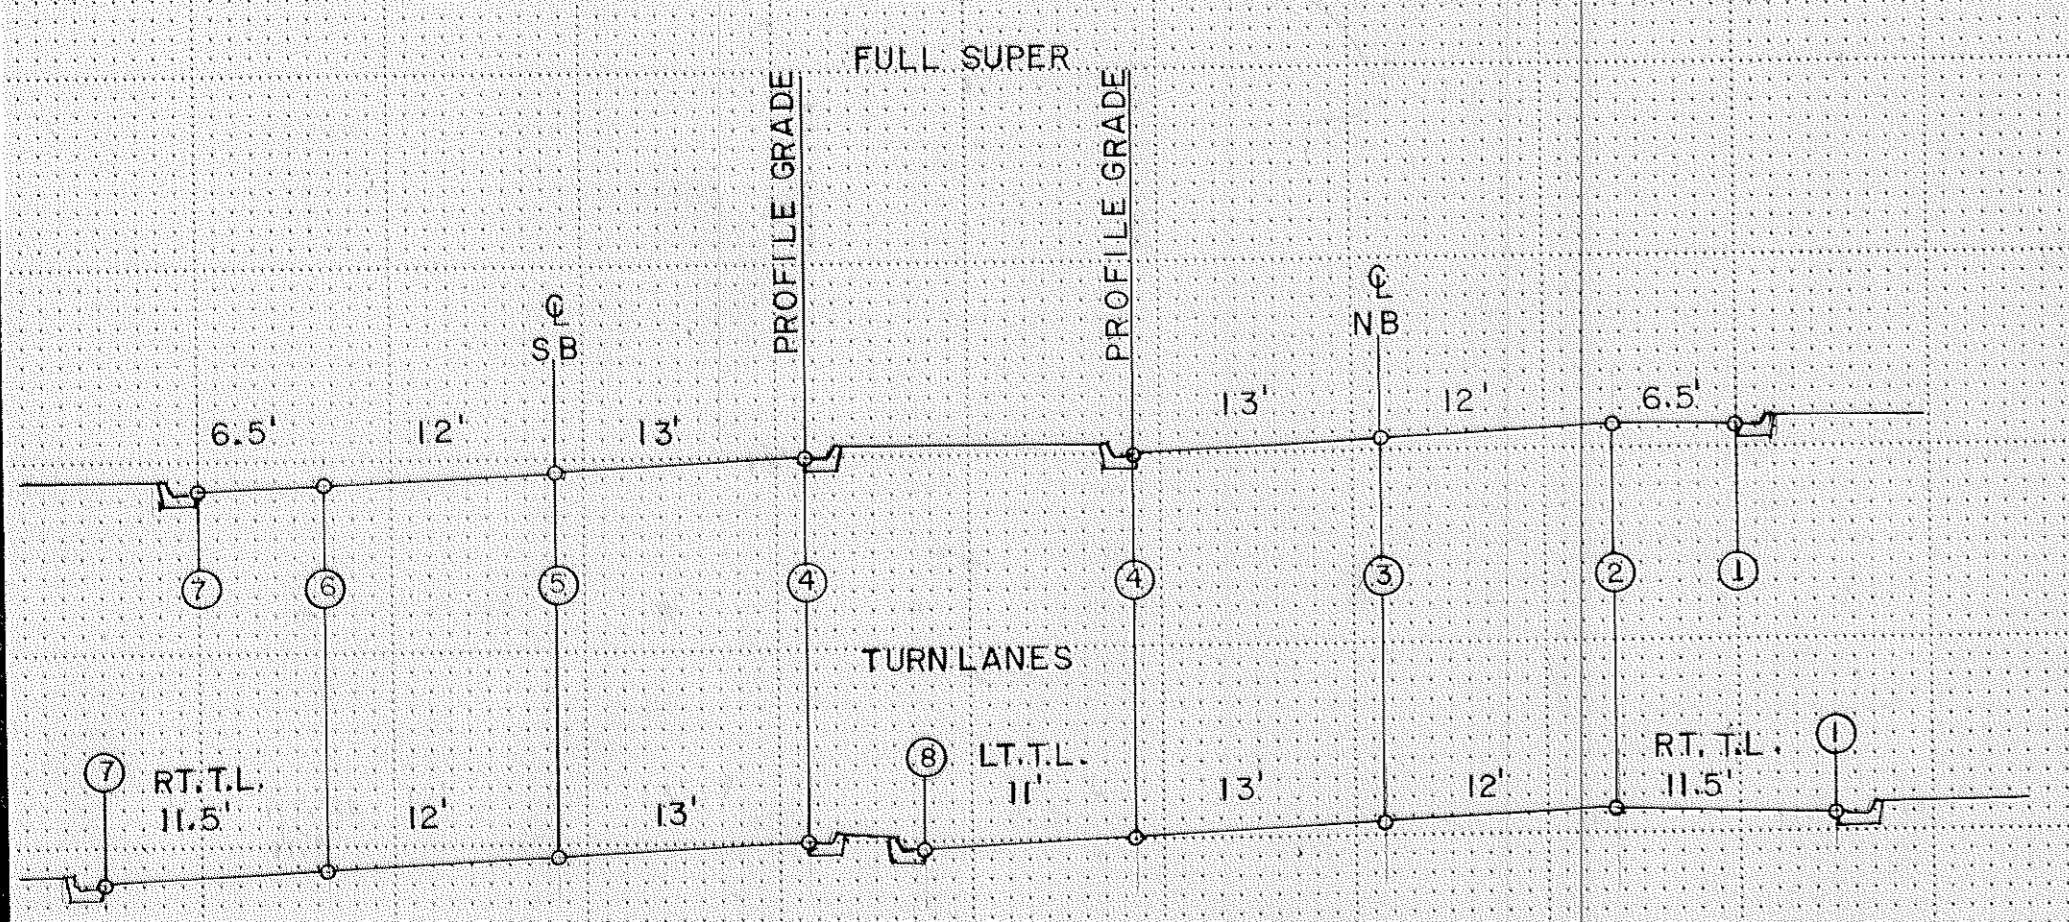



TELEPHONE CROSS SECTION - 10/16/02

EXCAVATION EMBANKMENT

SUB TOTALS CU CU SUB TOTALS
YDS. YDS.

EXCAVATION EMBANKMENT

SUB TOTALS CU CU SUB TOTALS
YDS. YDS.

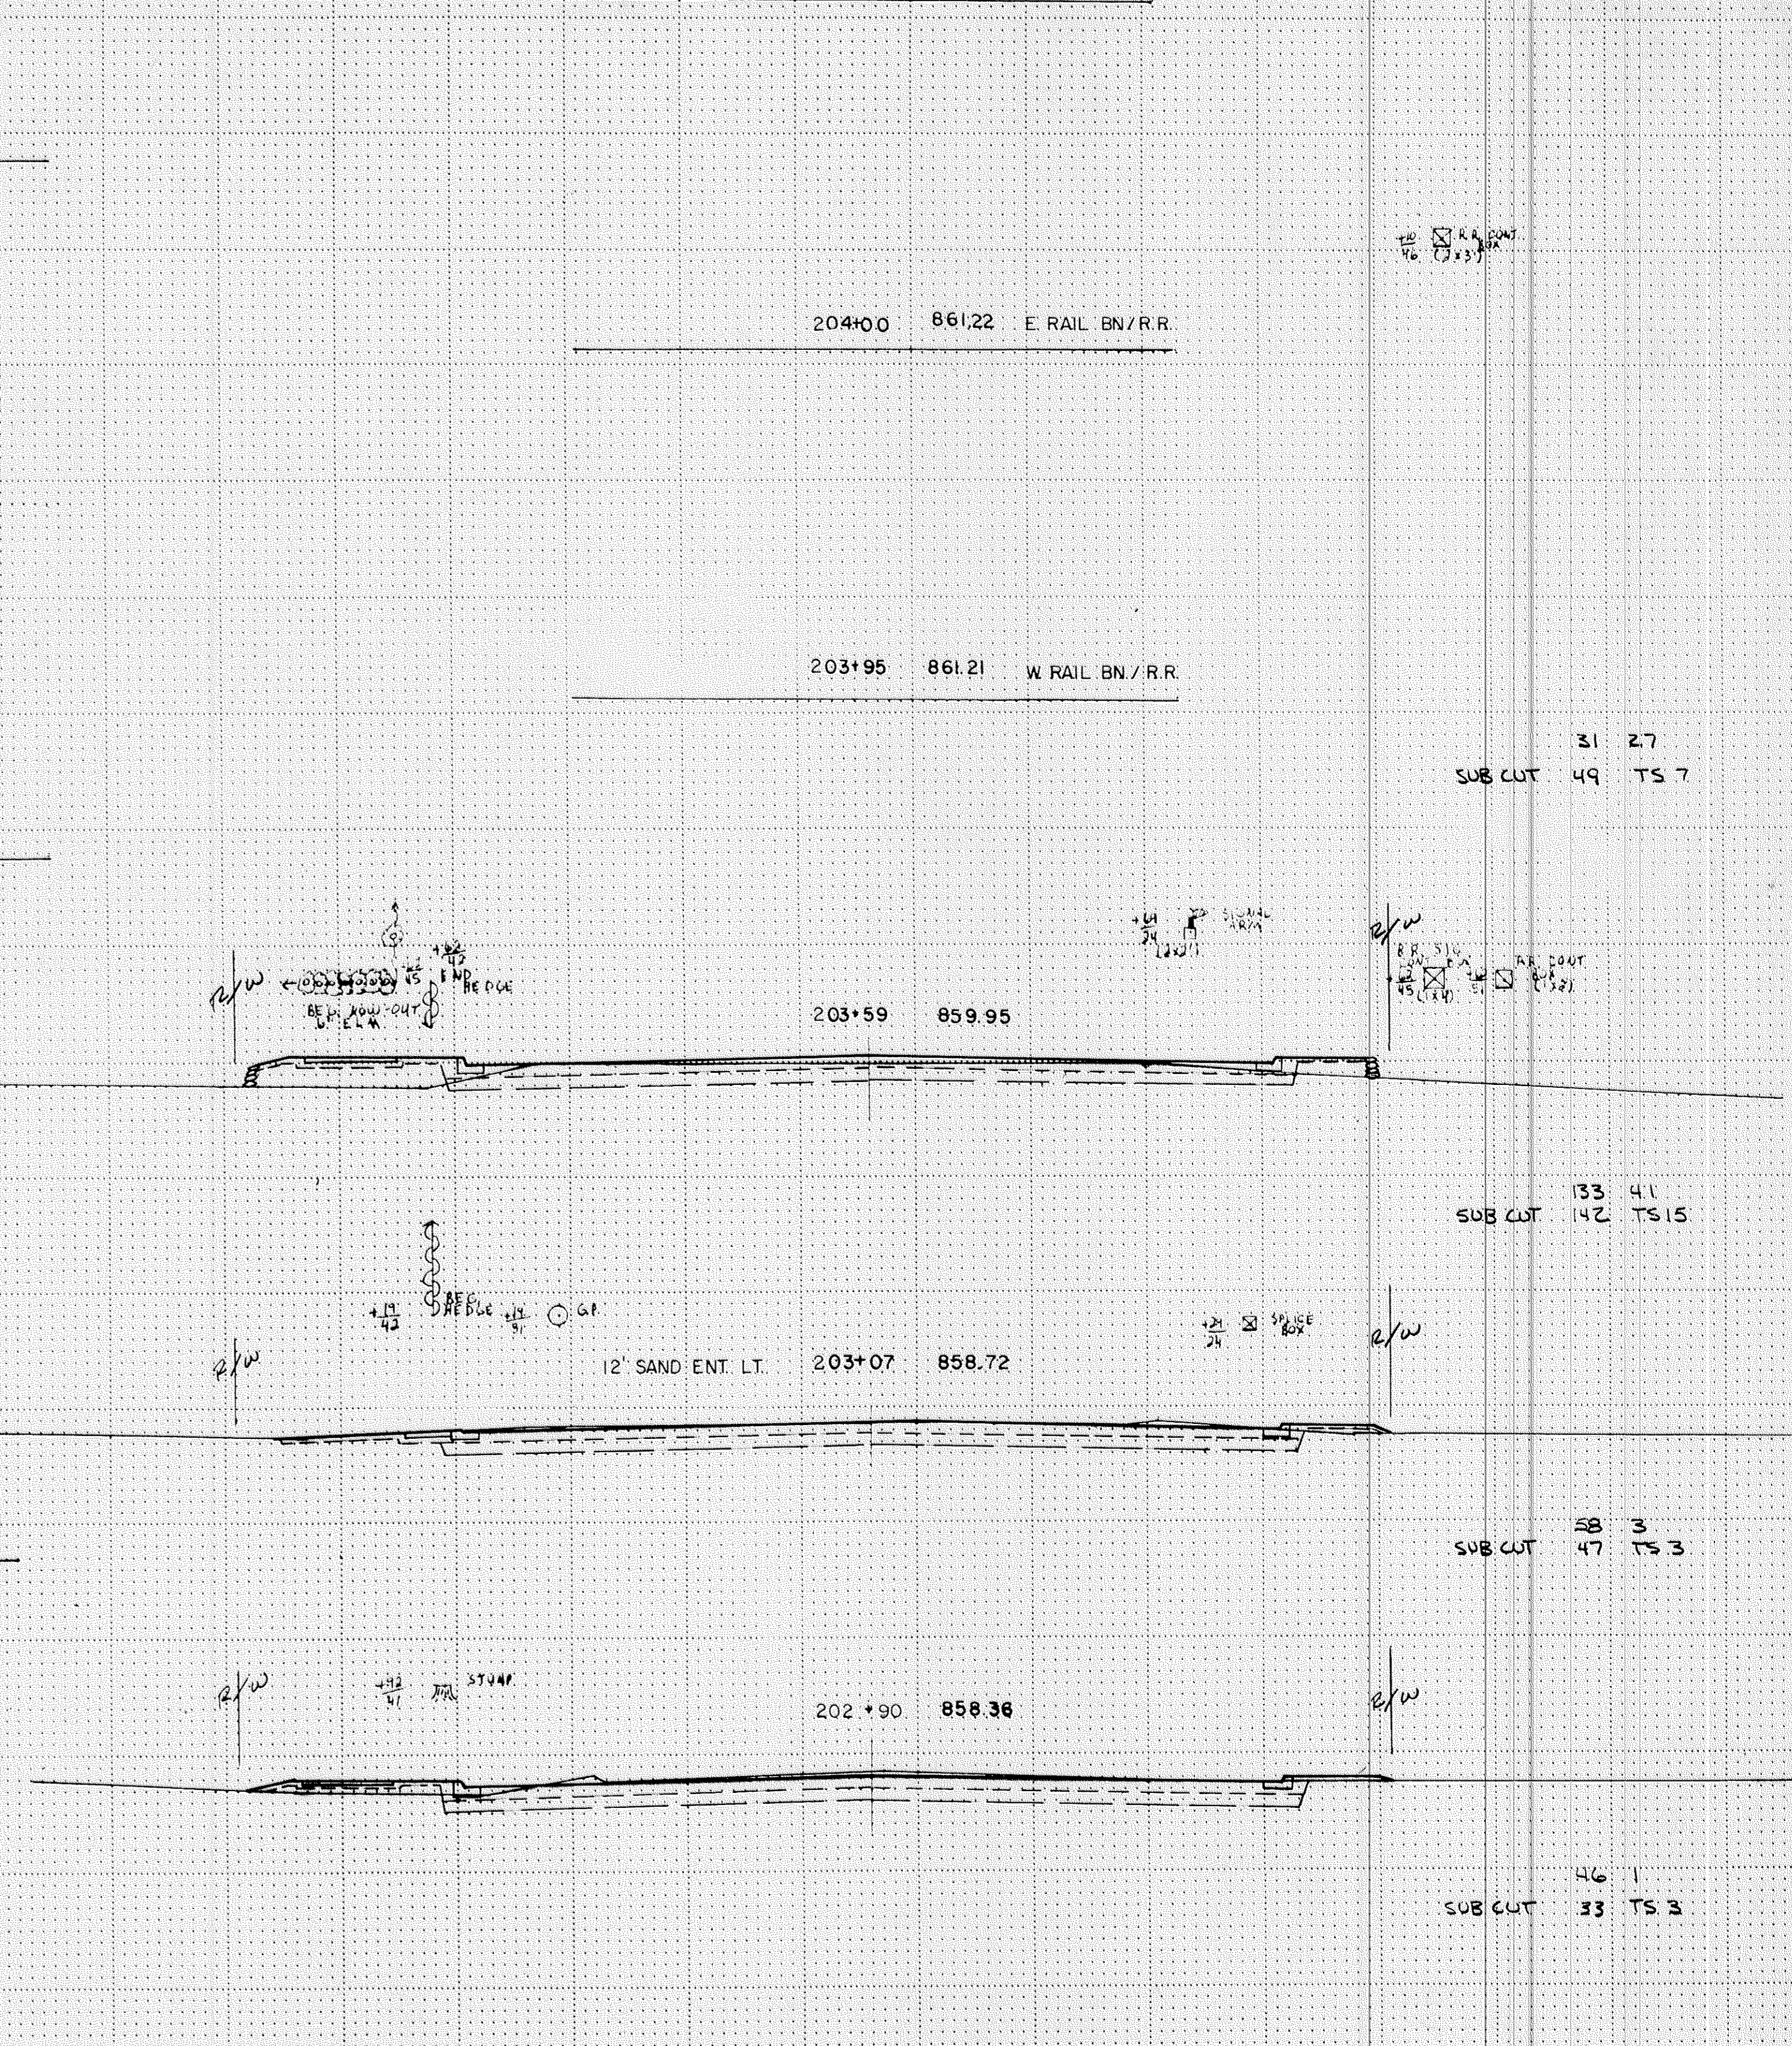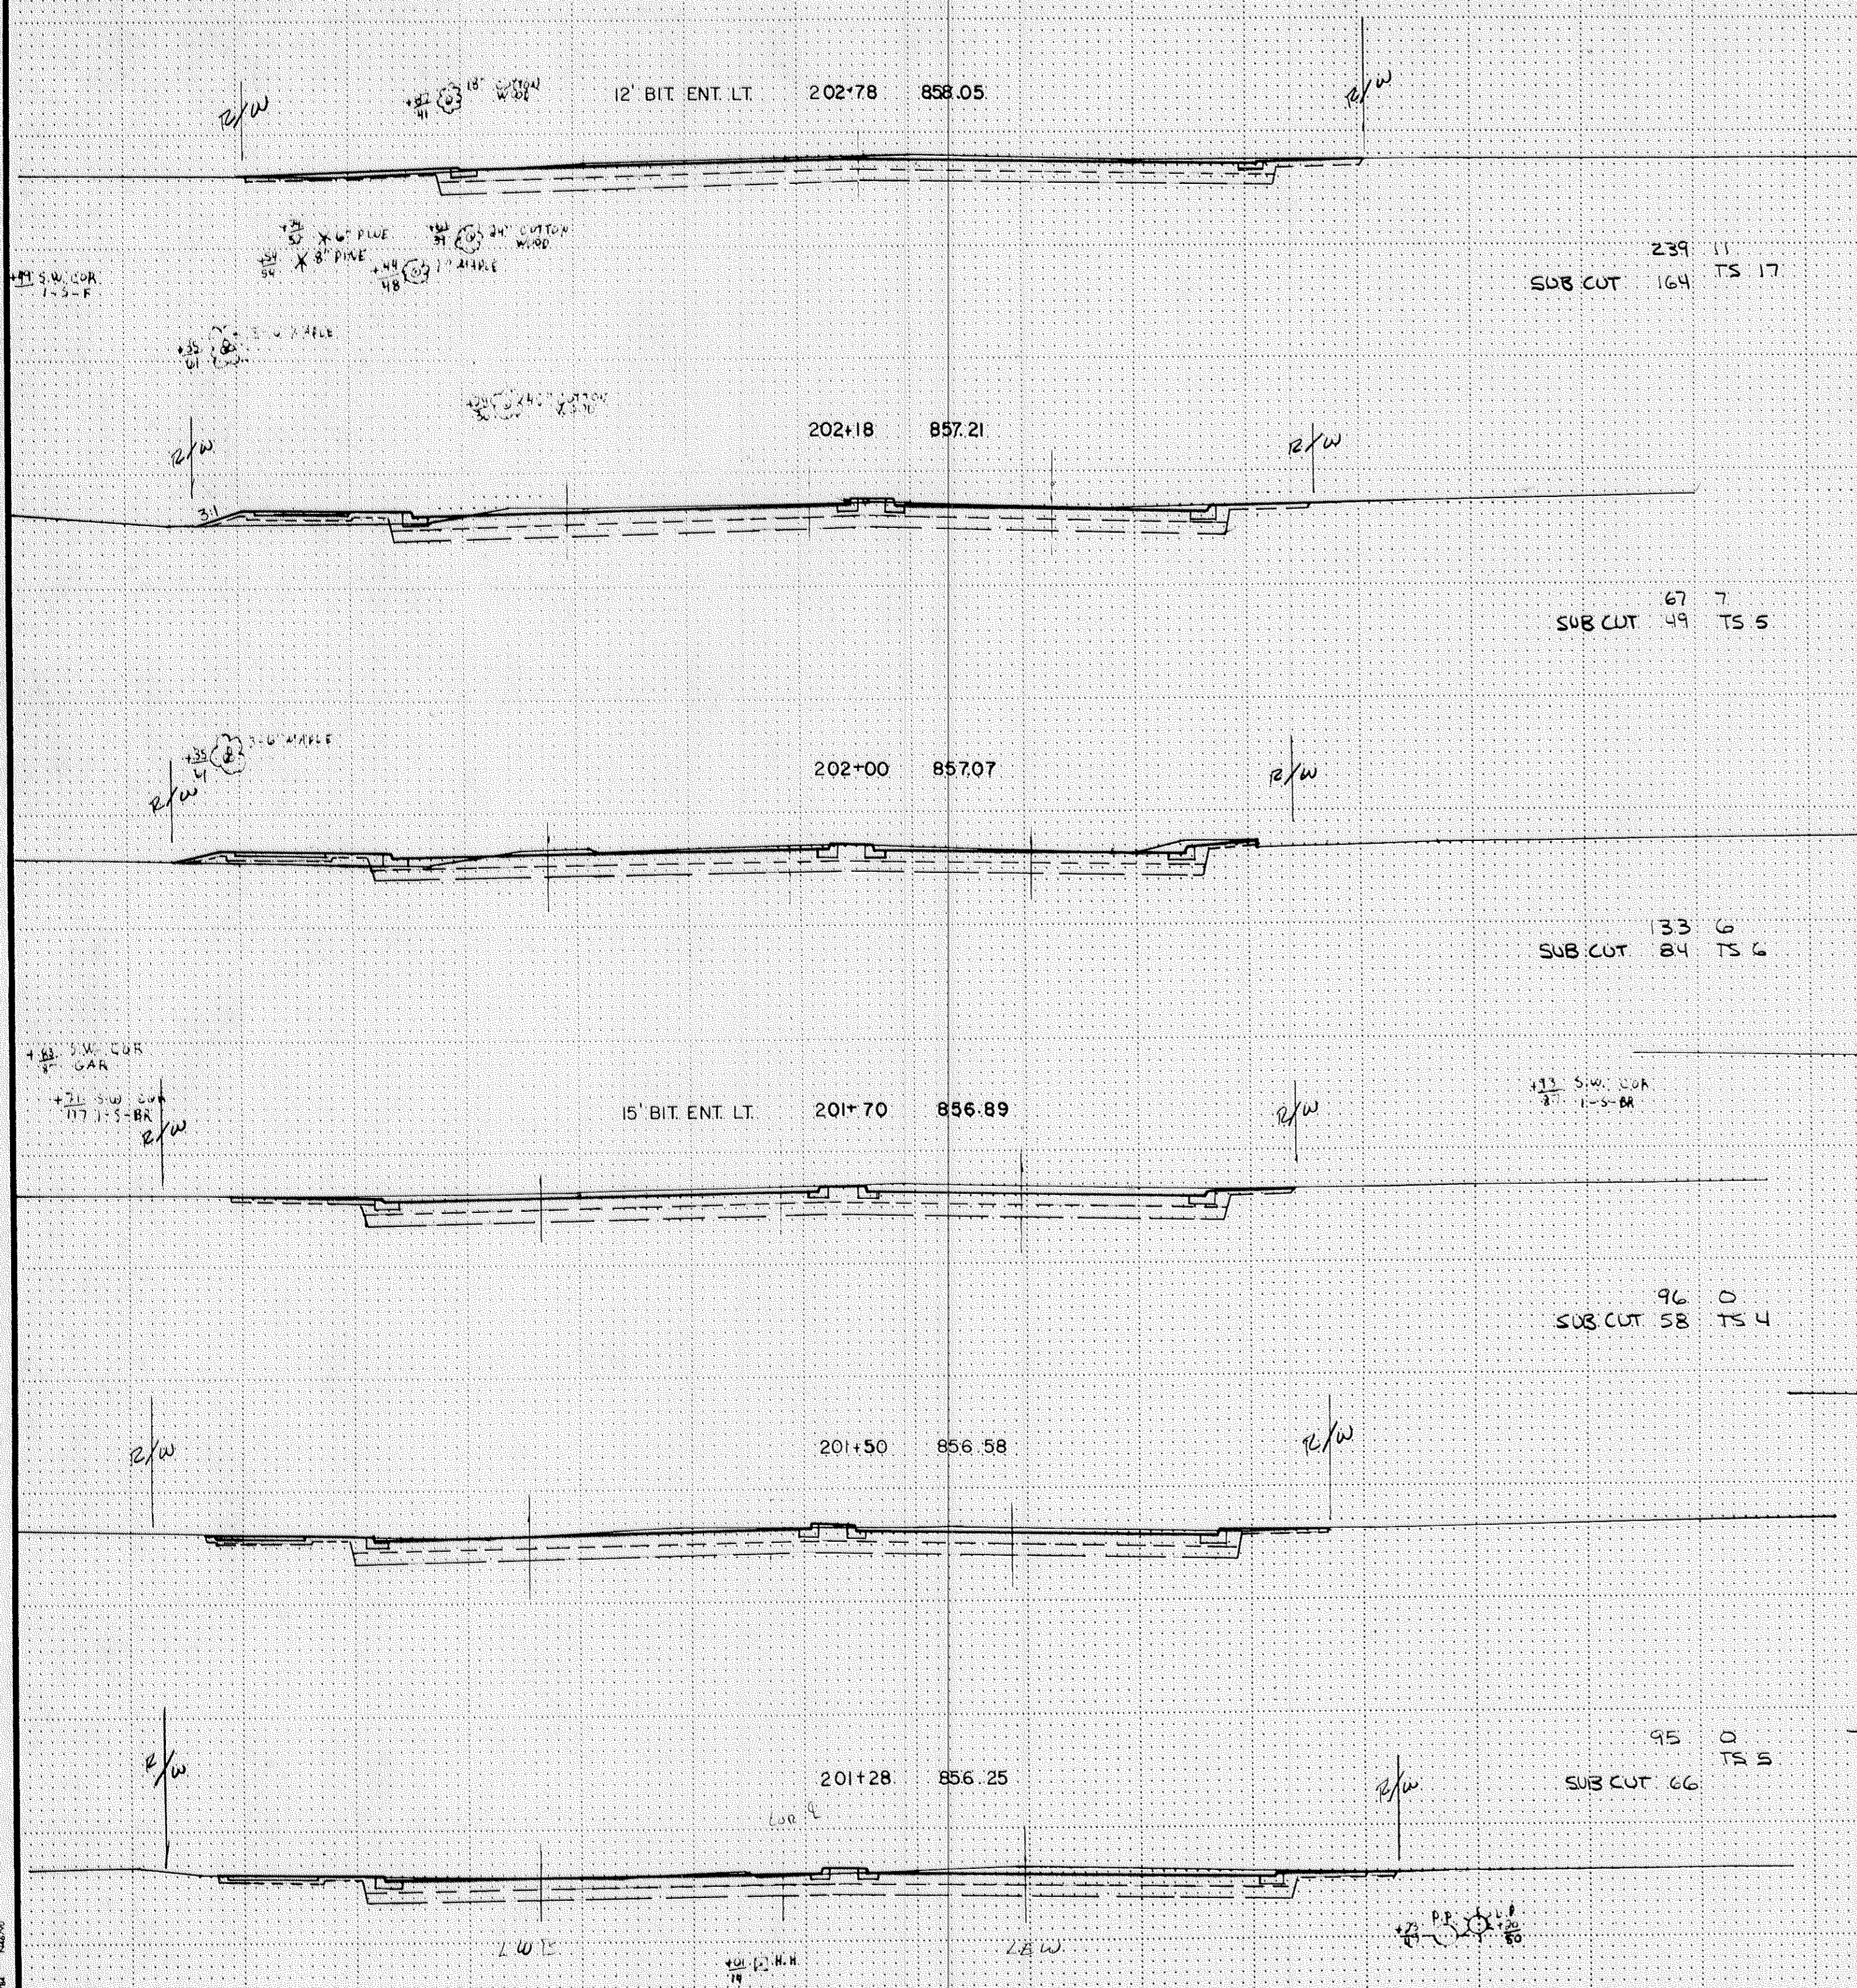

SUB CUT 239 11
164 TS 17

SUB CUT 67 7
49 TS 5

SUB CUT 133 6
84 TS 6

SUB CUT 96 0
58 TS 4

SUB CUT 95 0
66 TS 5

204+15 861.63 W RAIL BN/R.R.

204+00 861.22 E. RAIL BN/R.R.

203+95 861.21 W RAIL BN/R.R.

203+59 859.95

12' SAND ENT. LT. 203+07 858.72

202+90 858.36

TS 17

SUB CUT 31 2.7
49 TS 7

SUB CUT 133 4.1
142 TS 15

SUB CUT 58 3
47 TS 3

SUB CUT 46 1
33 TS 3

STA. 201+28 TO STA. 204+15

EXCAVATION EMBANKMENT

EXCAVATION EMBANKMENT

Sub Totals Sub Totals

Cu. Cu. Sub Totals
Yds. Yds. Yds.

206+70 861.61 E. EDGE BIT ENT. RT.

212+00 863.61

206+46 861.53 W. EDGE BIT ENT. RT.

211+00 863.28

206+00 861.33

210+00 862.64

205+00 861.16

209+00 862.46

204+48 861.43

208+00 862.13

204+20 861.72 E. RAIL BN./R.R.

207+00 861.68

231 50
SUBCUT 222 TS 30

118 61
SUBCUT 127 TS 21

36 20
SUBCUT 35 TS 6

39 33
TS 33


33 63
TS 33

41 43
TS 31

41 15
TS 30

140 11
SUBCUT 50 TS 26

259 7
SUBCUT 204 TS 20

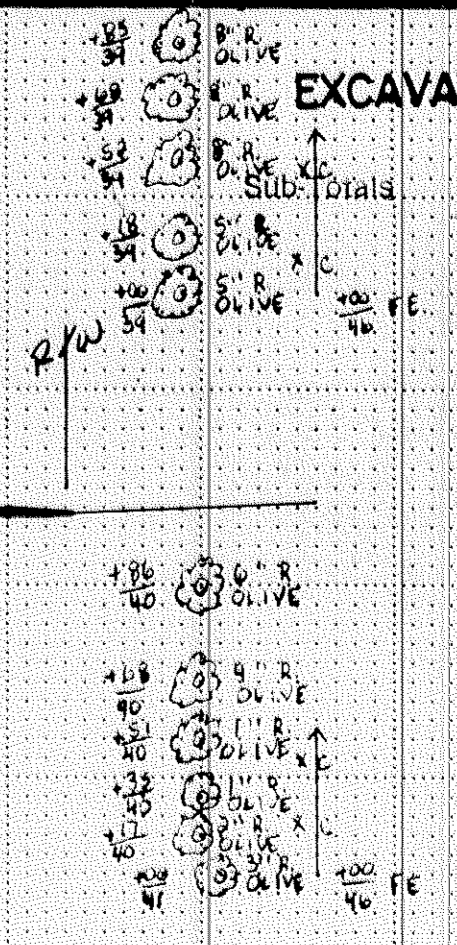

R/W

R/W

PERMANENT EASEMENT

PERMANENT EASEMENT

BEGIN BIT OVERLAY SECTION AT STA. 207+50.



STA 204+20 TO STA. 212+00

EXCAVATION EMBANKMENT

EXCAVATION EMBANKMENT

SUB TOTALS CU CU SUB TOTALS
YDS YDS YDS

SUB TOTALS CU CU SUB TOTALS
YDS YDS YDS

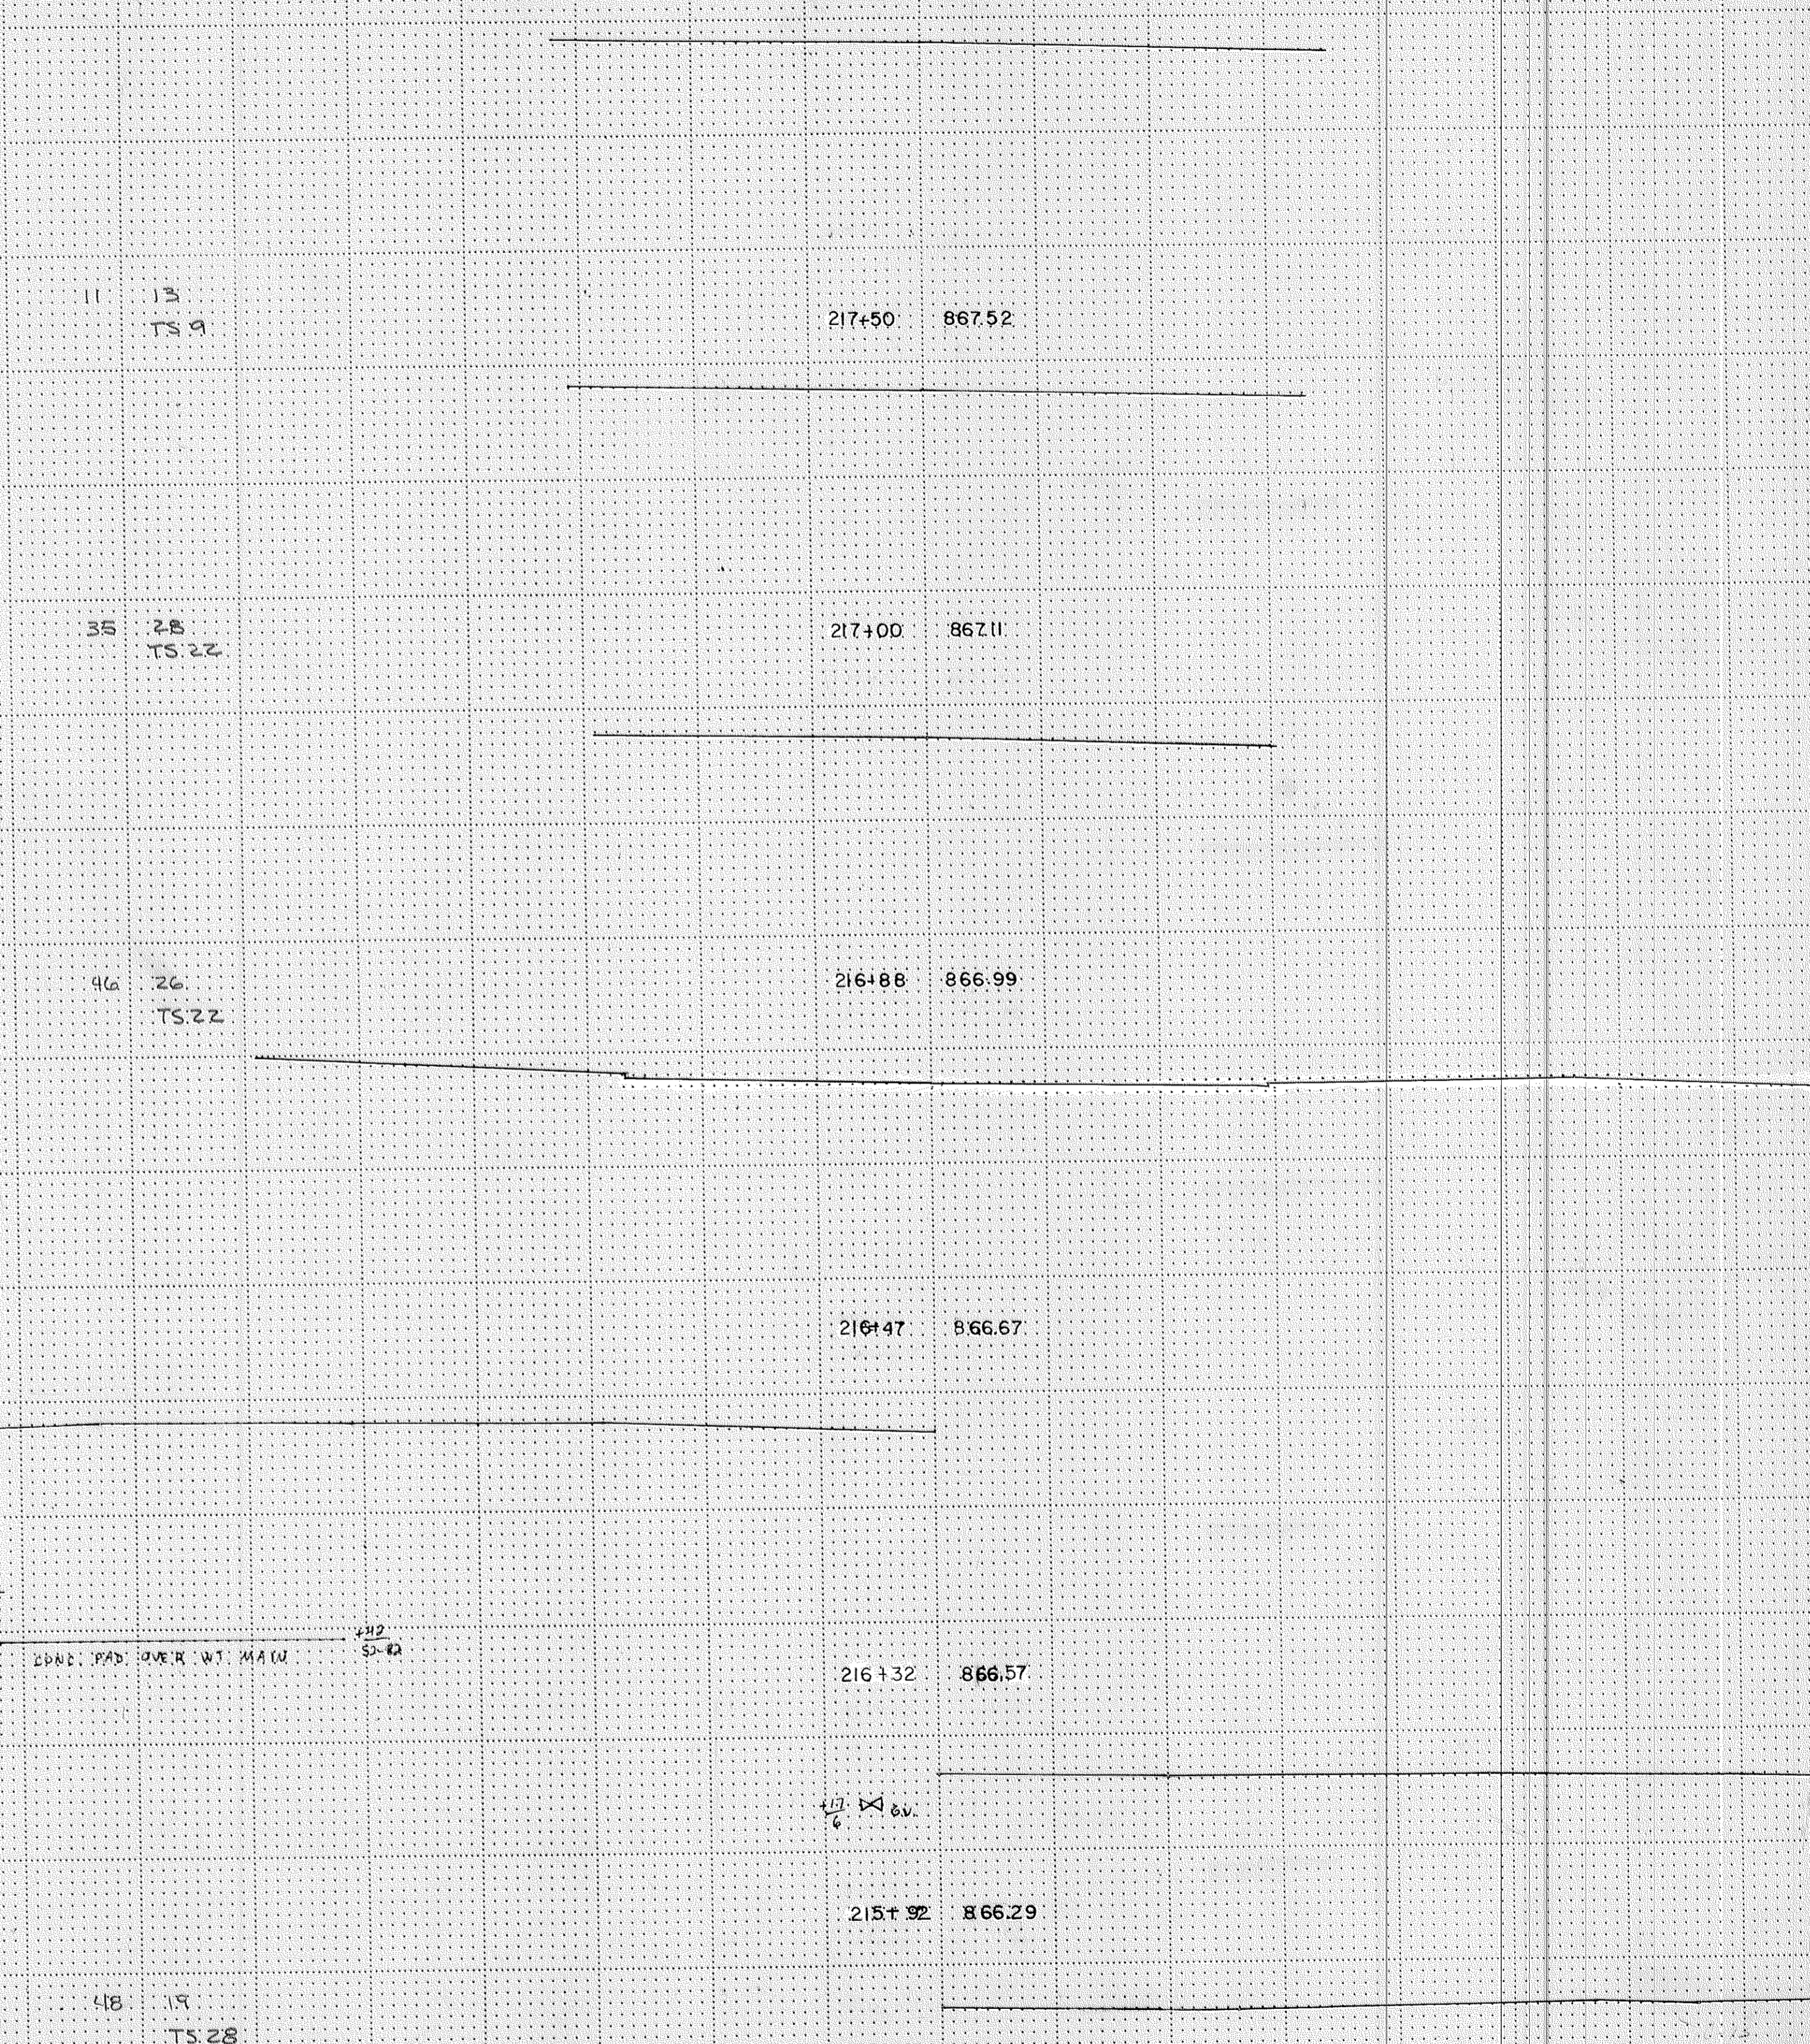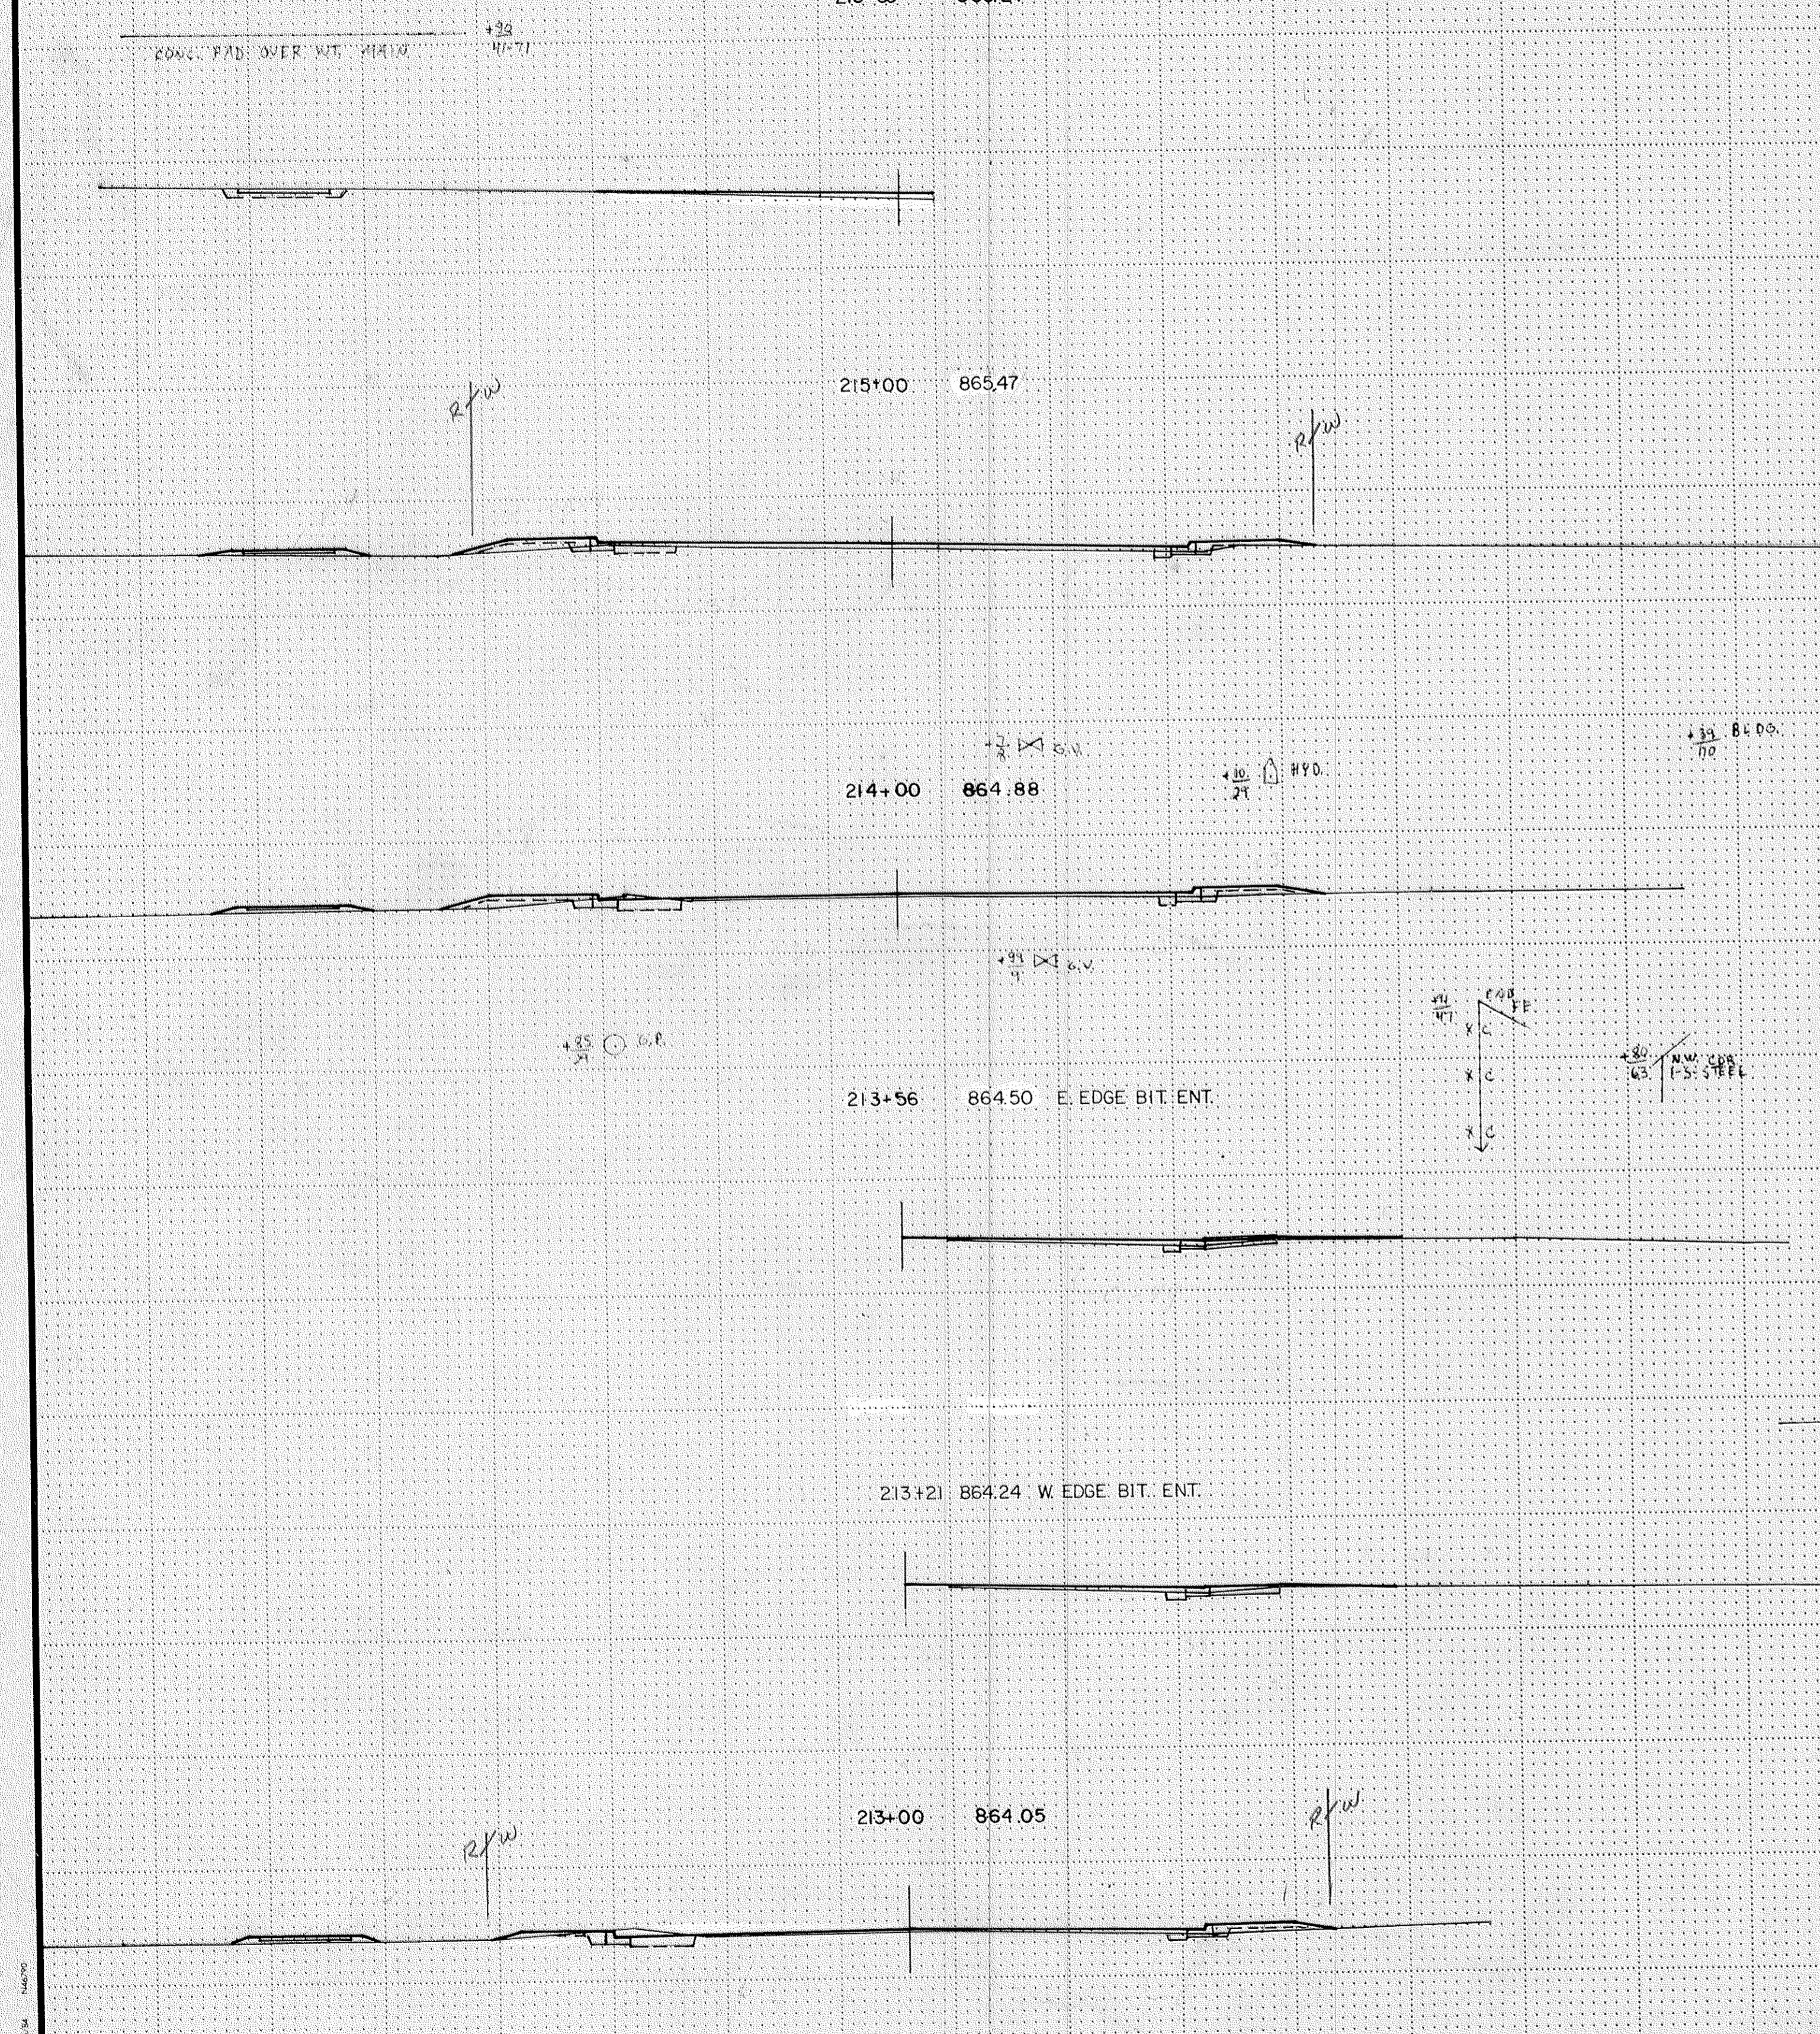


STA. 213+00. TO STA. 218+00.

EXCAVATION EMBANKMENT

Sub-Totals	Cu. Yds.	Cu. Yds.	Sub-Totals
	1	0	TS 1

EXCAVATION EMBANKMENT

Sub-Totals	Cu. Yds.	Cu. Yds.	Sub-Totals
	21	0	TS 3
	23	0	TS 4
	14	0	TS 4

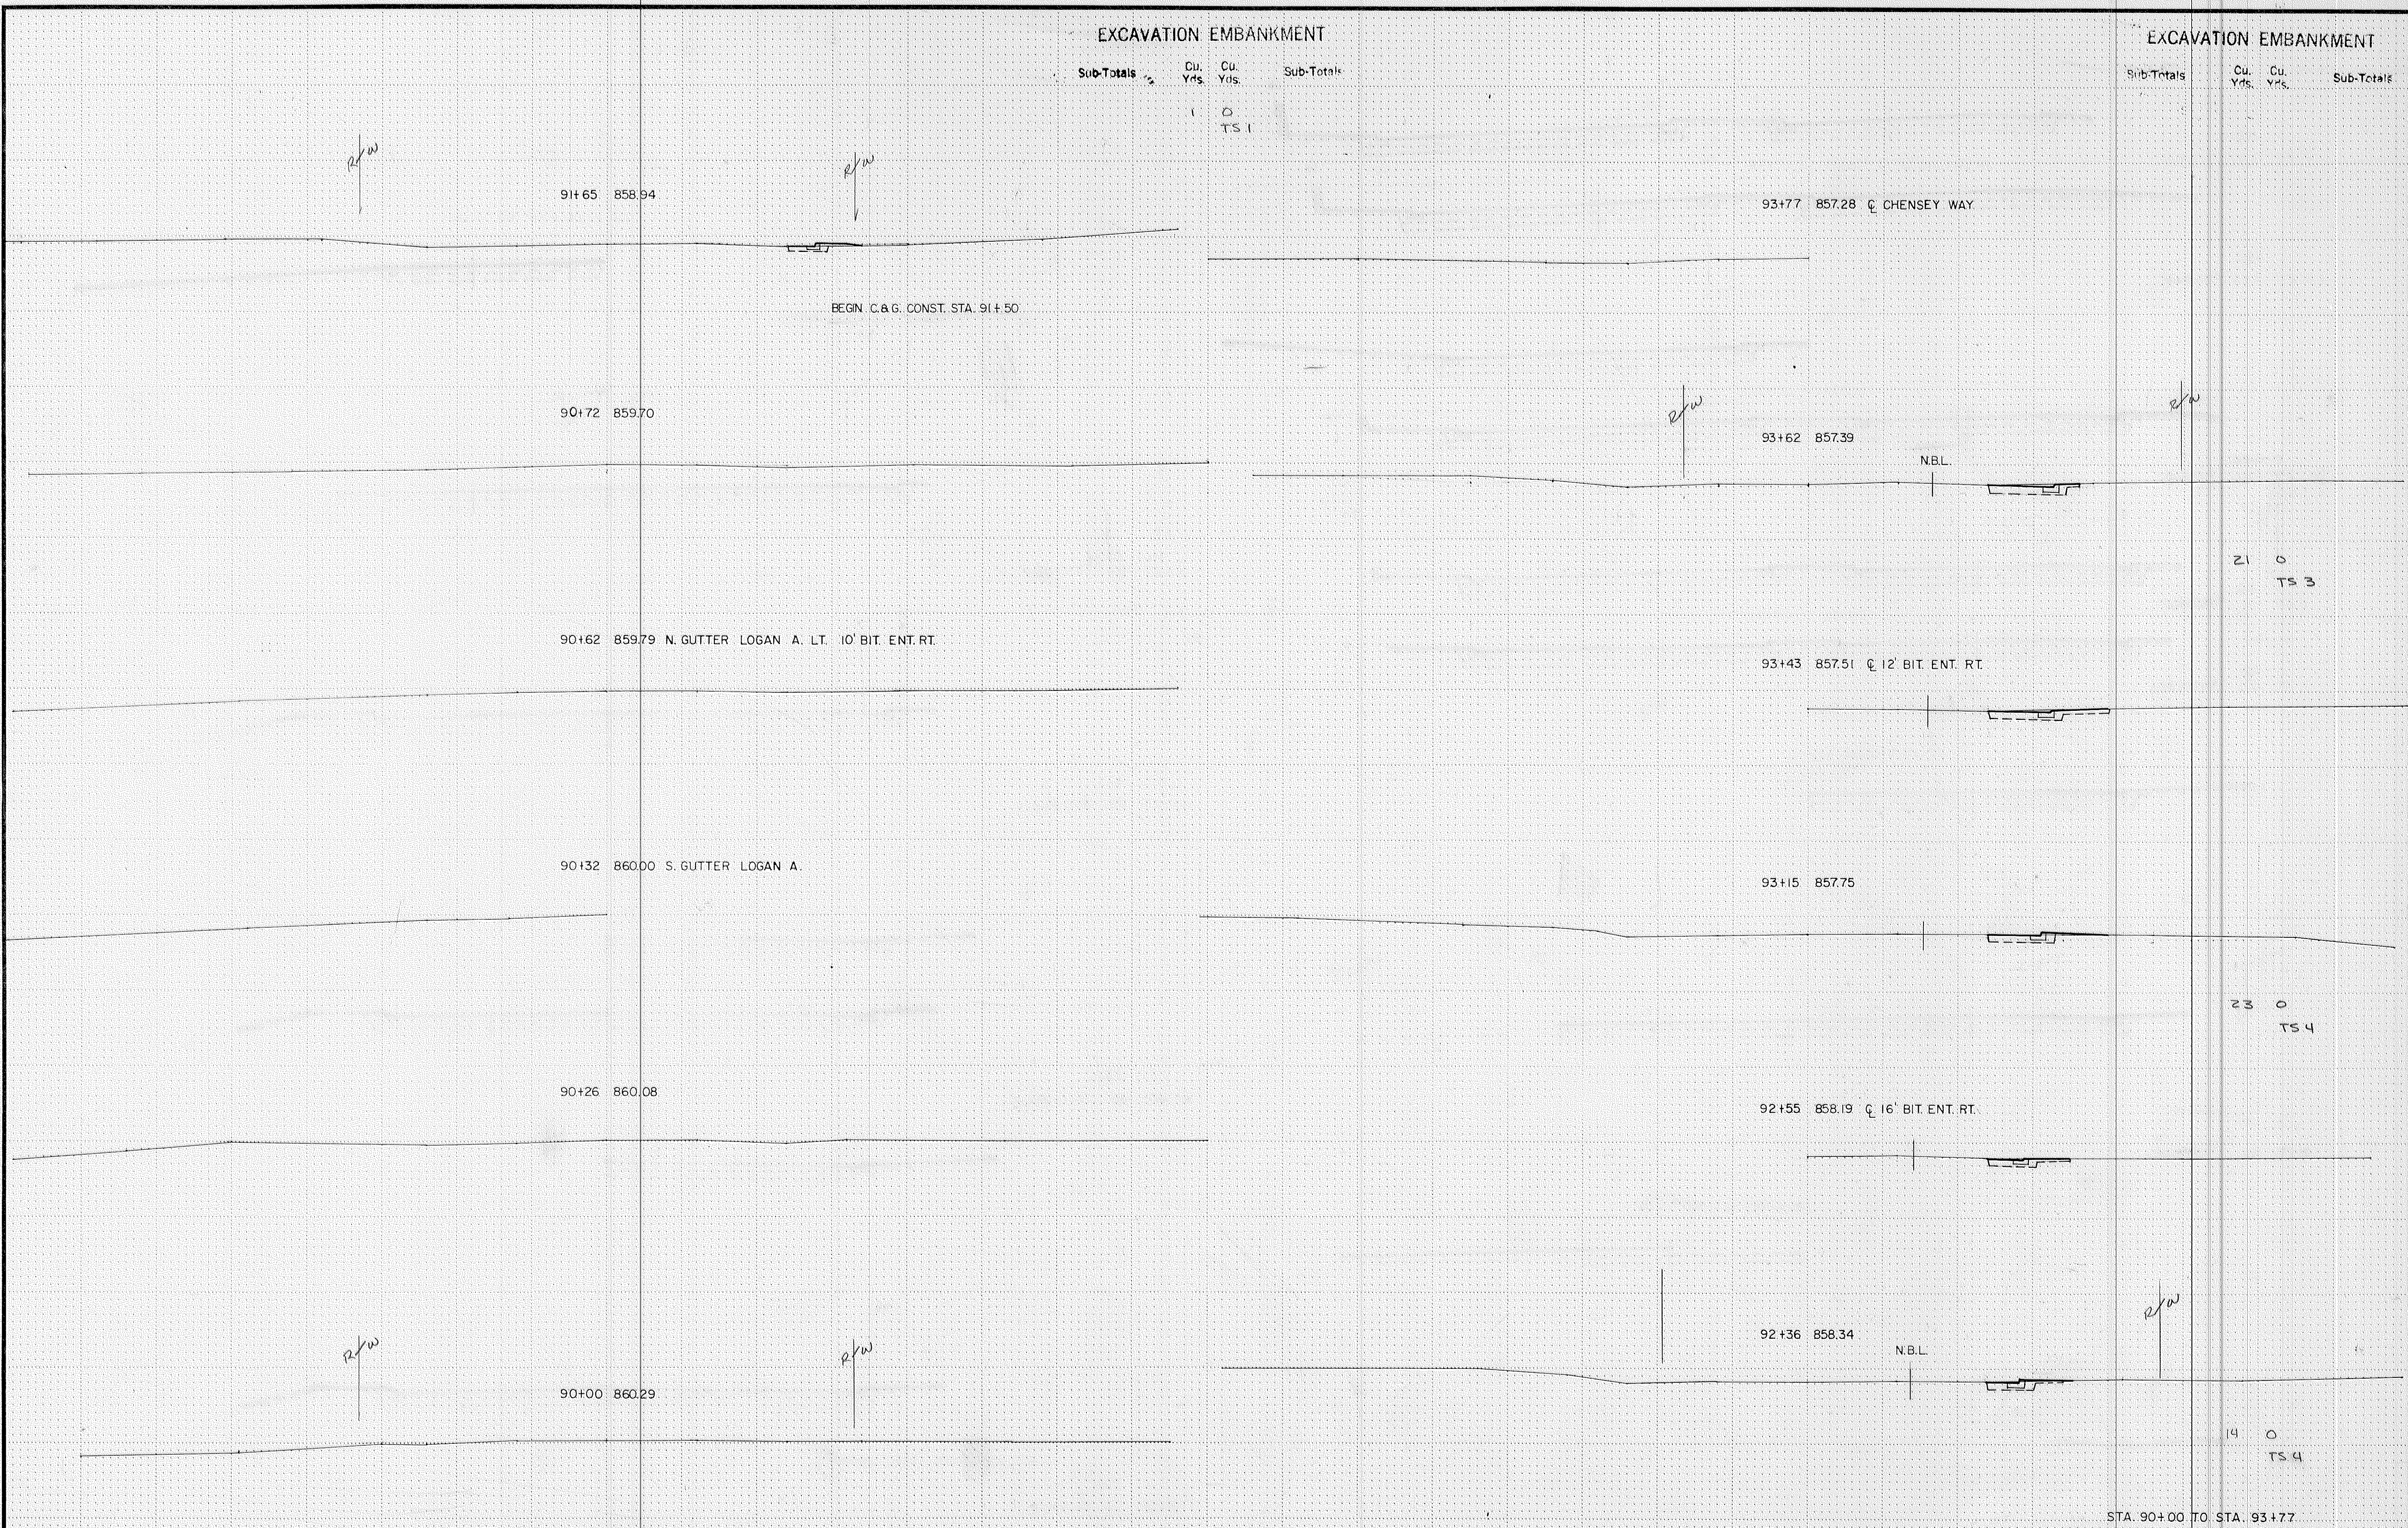

91+65 858.94

93+77 857.28 C CHENSEY WAY

BEGIN C.&G. CONST. STA. 91+50

90+72 859.70

93+62 857.39

N.B.L.

90+62 859.79 N. GUTTER LOGAN A. LT. 10' BIT. ENT. RT.

93+43 857.51 C 12' BIT. ENT. RT.

21 0
TS 3

90+32 860.00 S. GUTTER LOGAN A.

93+15 857.75

23 0
TS 4

90+26 860.08

92+55 858.19 C 16' BIT. ENT. RT.

90+00 860.29

92+36 858.34

N.B.L.

14 0
TS 4



STA. 90+00 TO STA. 93+77

EXCAVATION EMBANKMENT

EXCAVATION EMBANKMENT

Sub-Totals Cu. Yds. Cu. Yds. Sub-Totals

Sub-Totals Cu. Yds. Cu. Yds. Sub-Totals

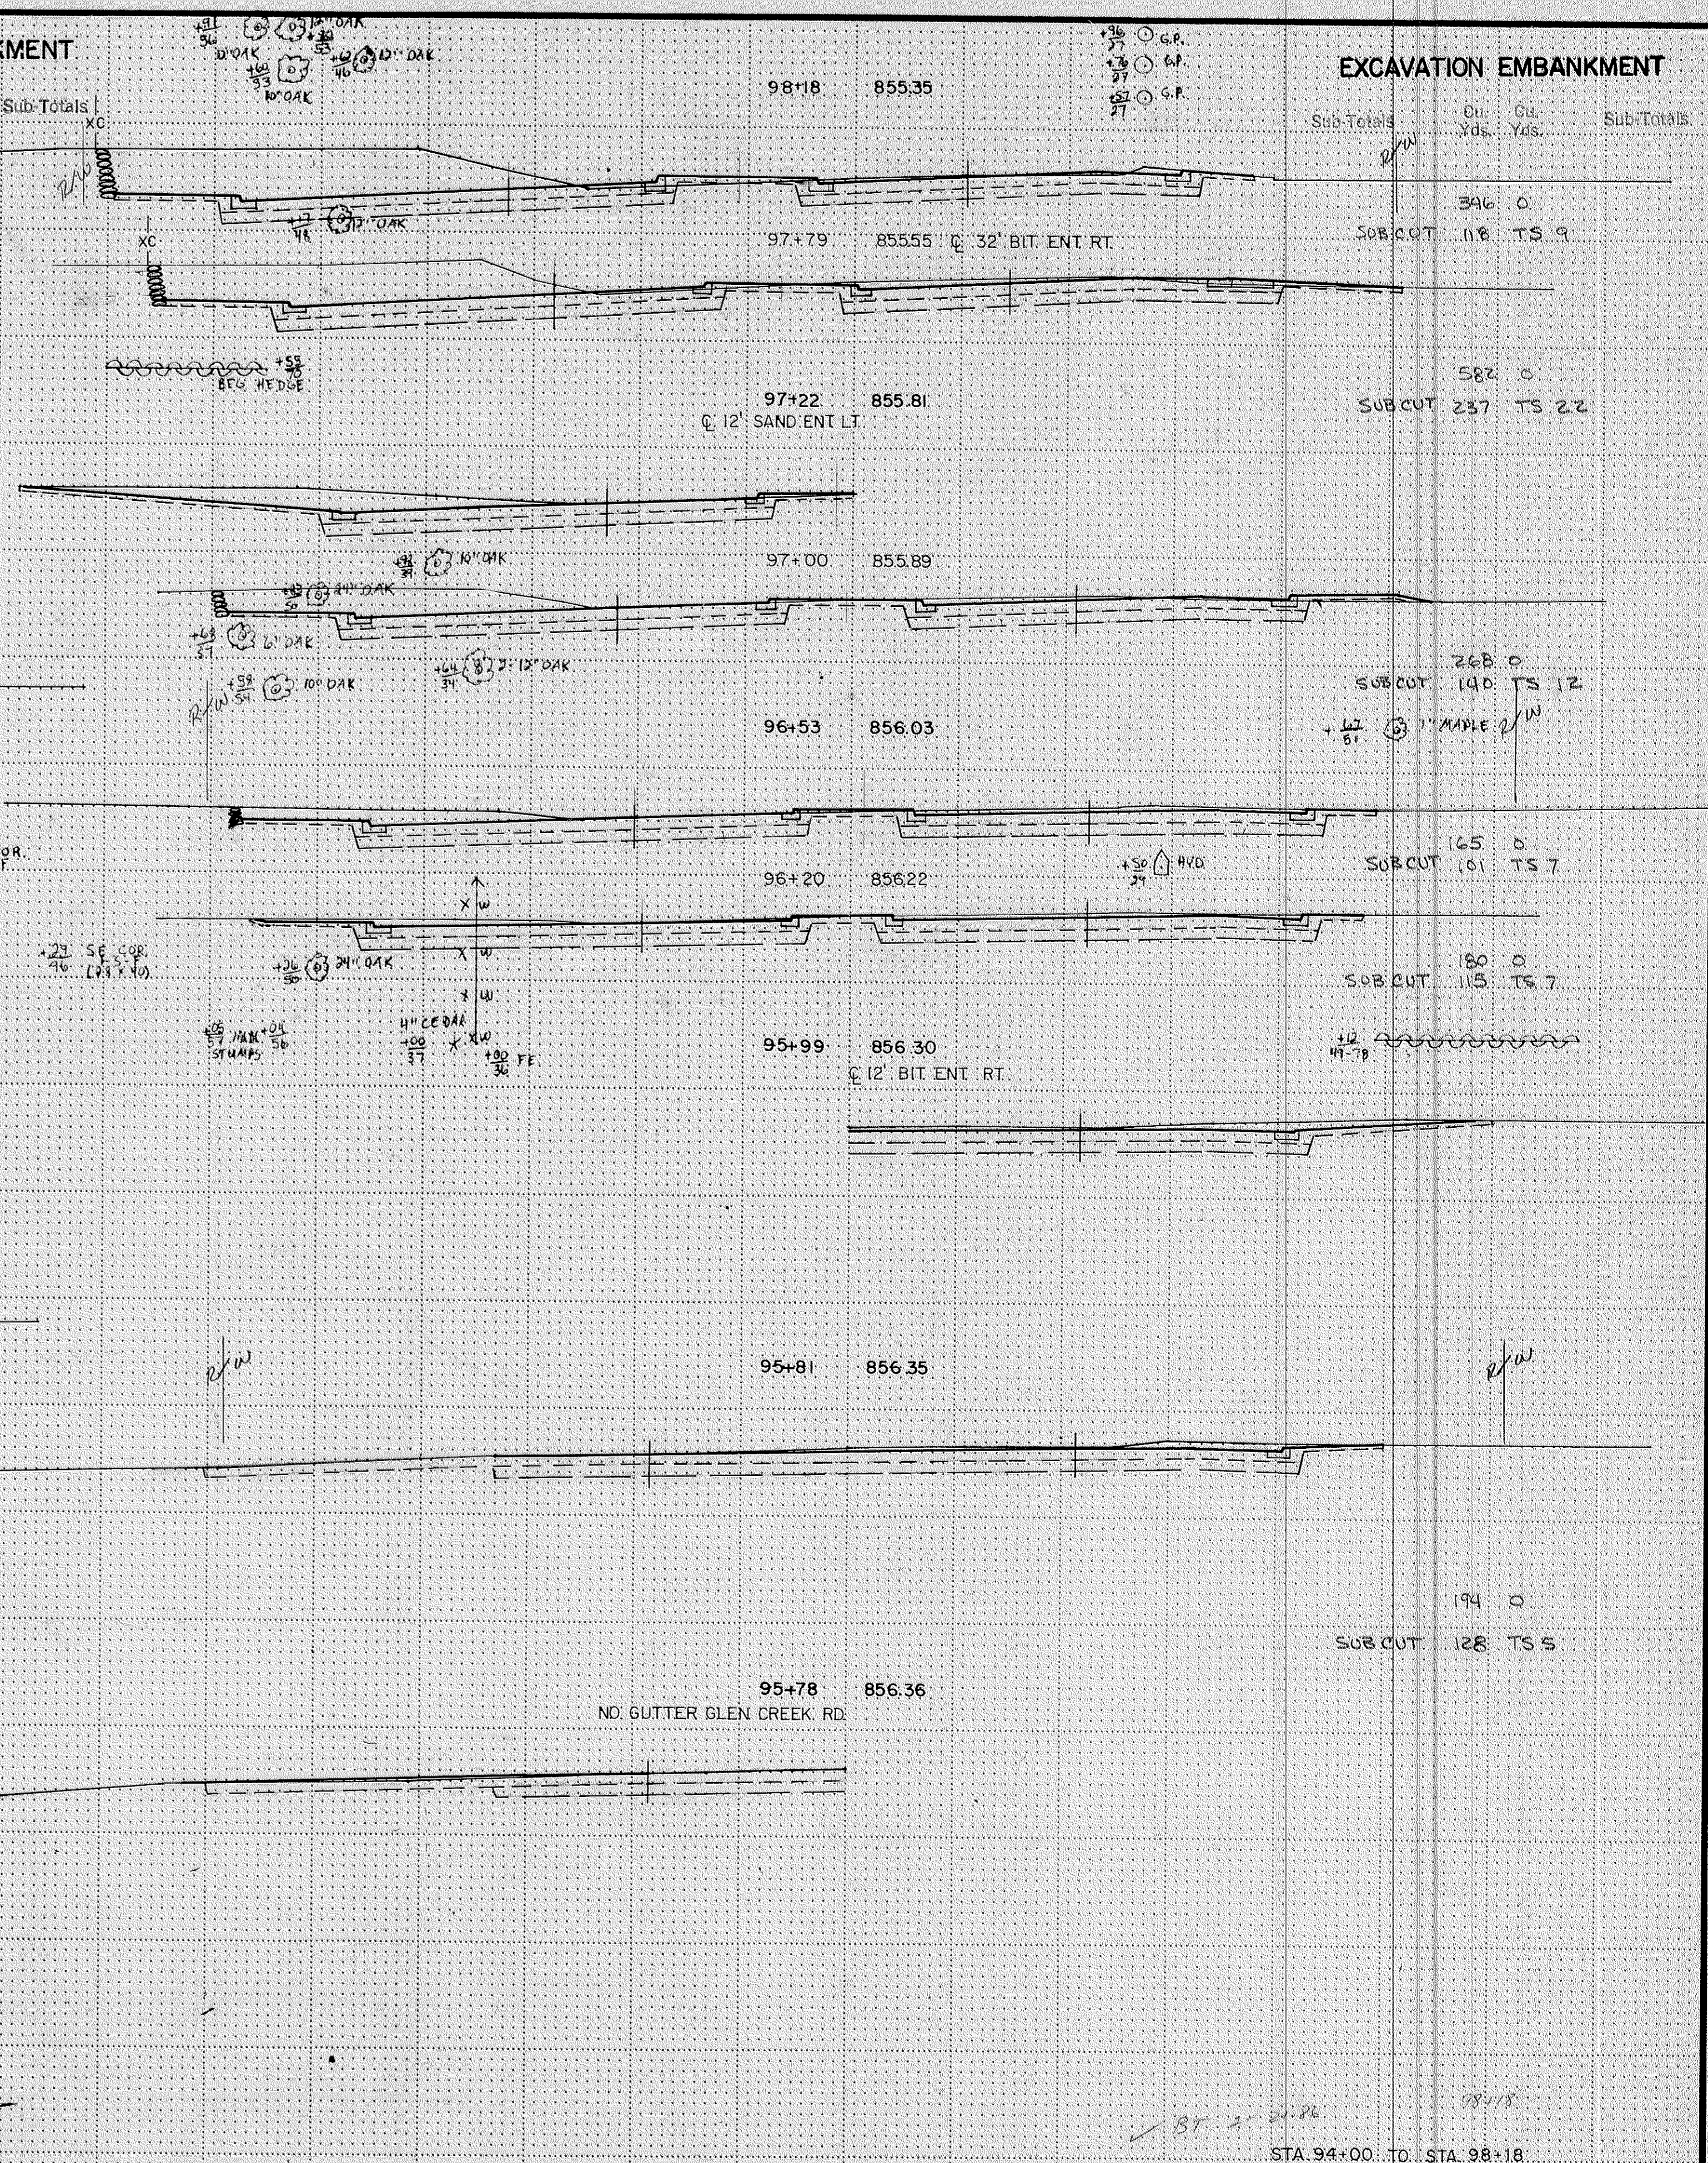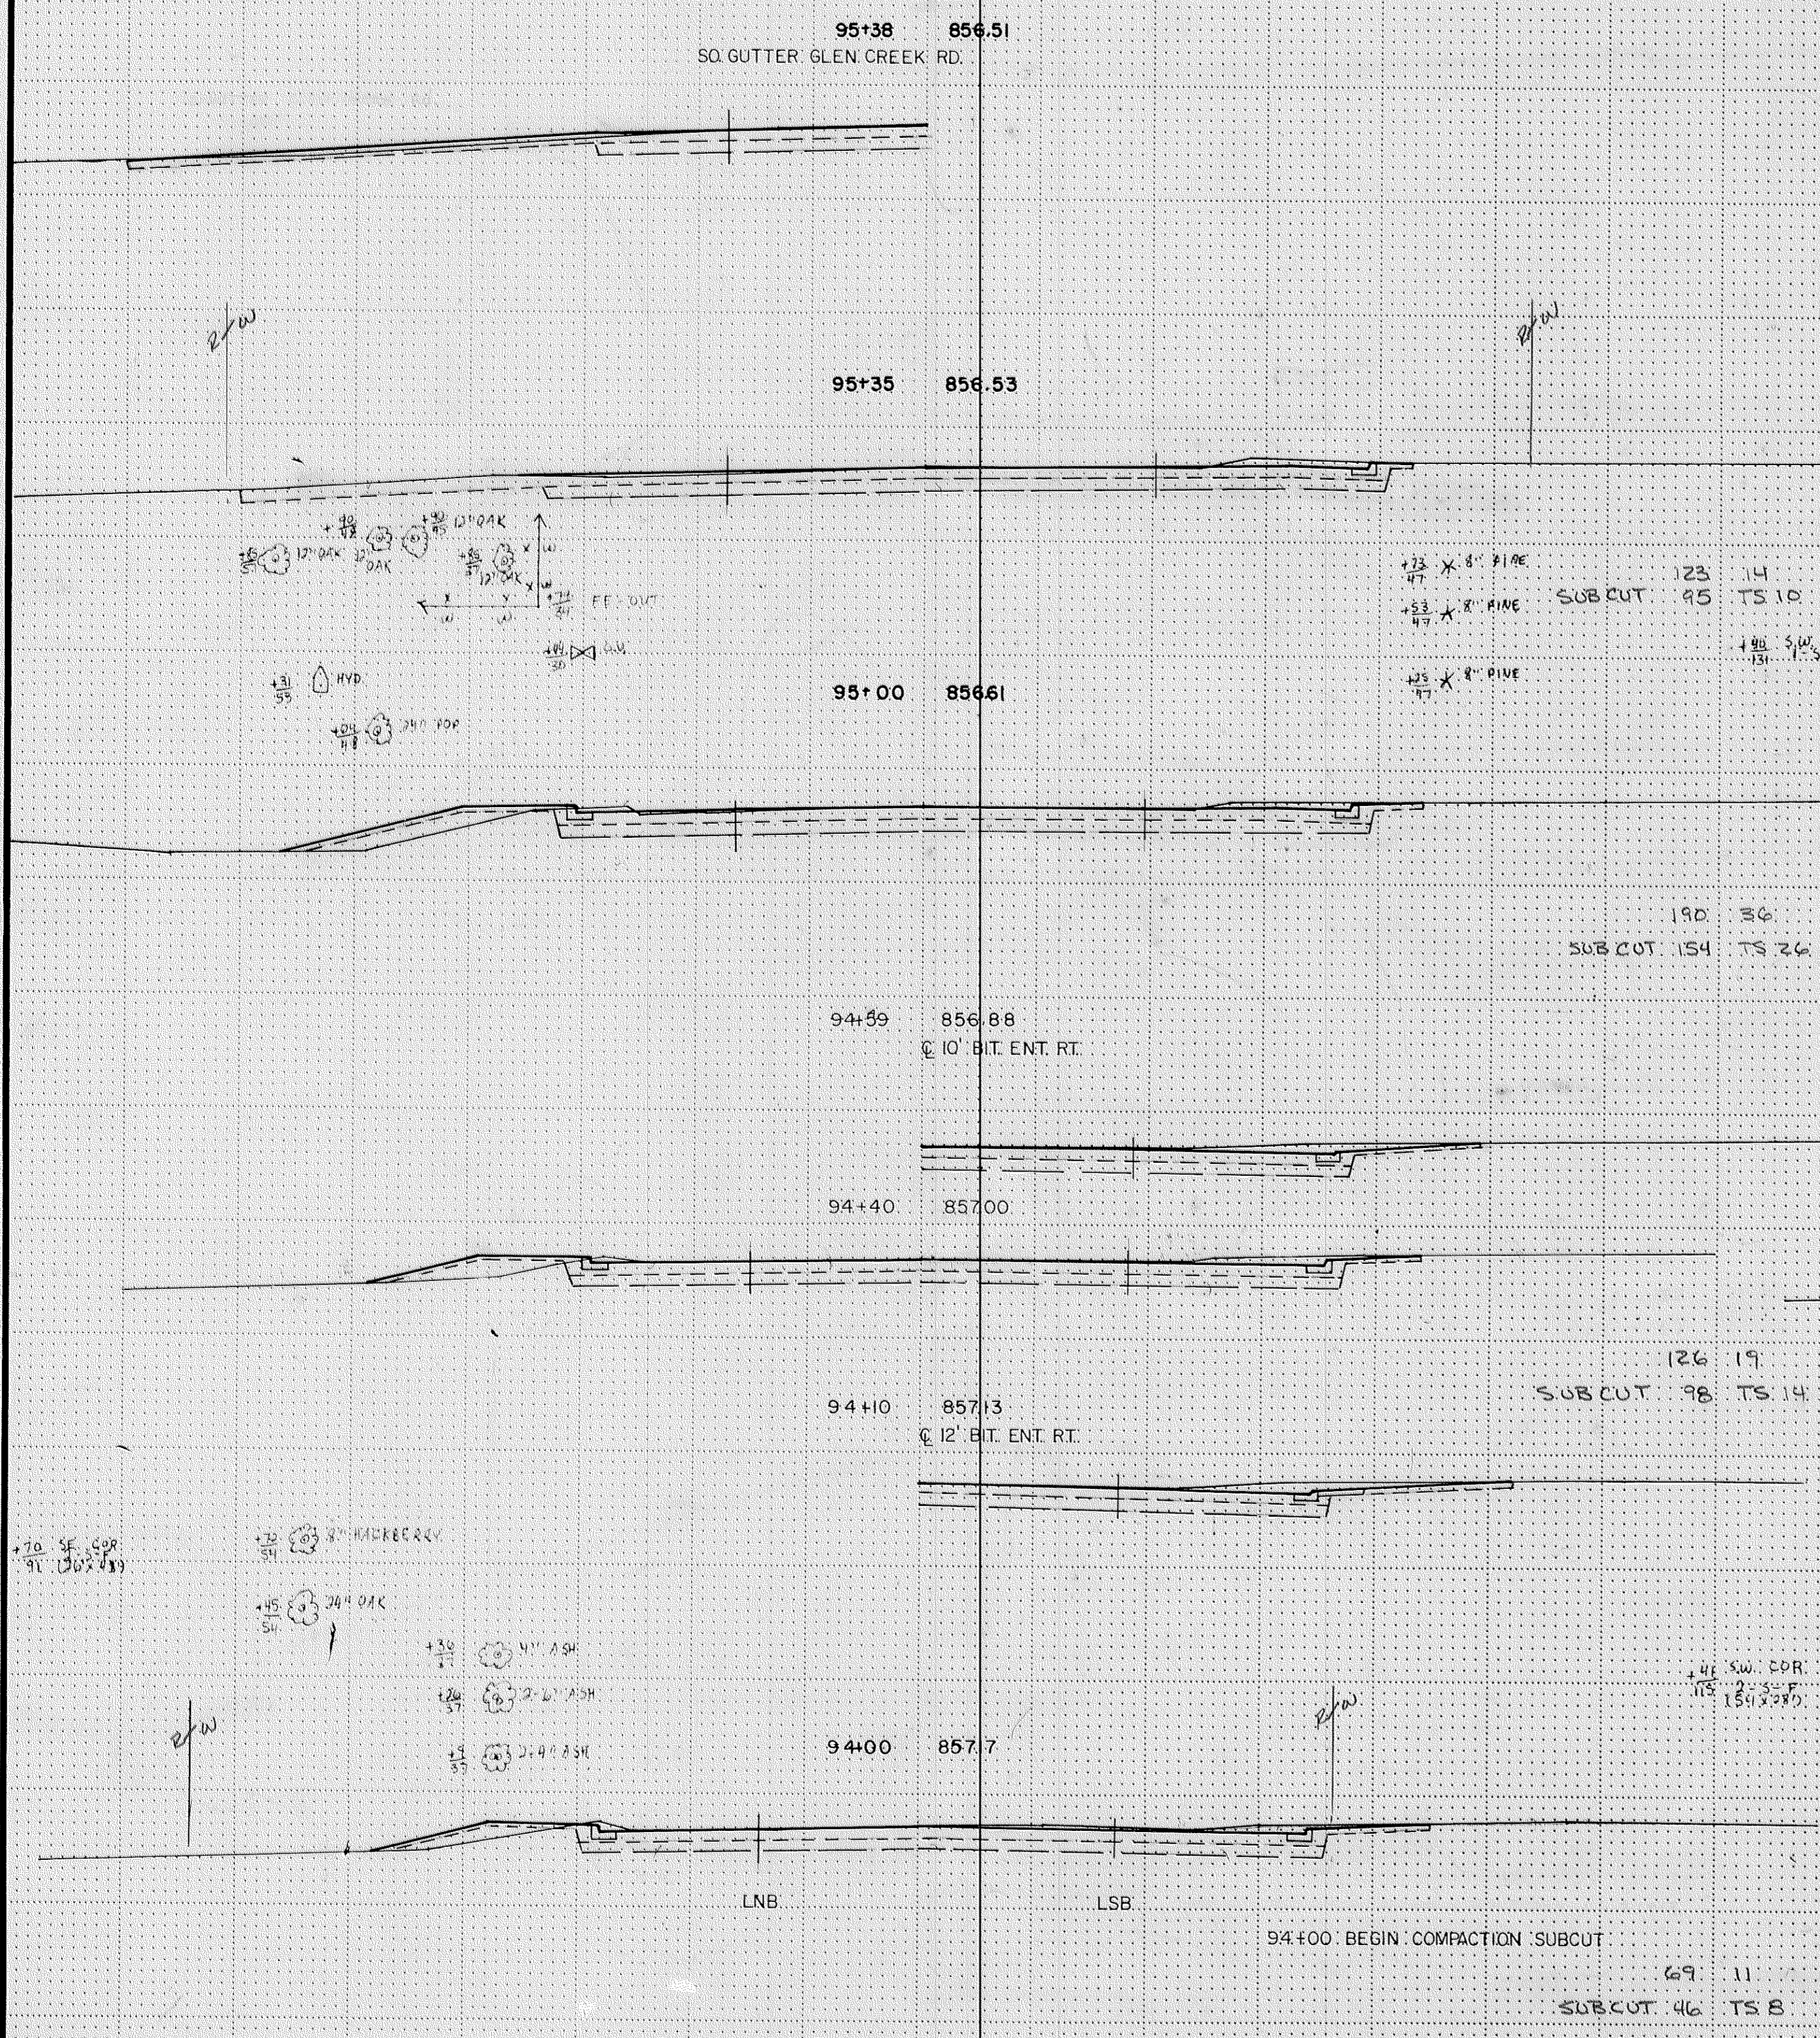

123 X 8\"/>

190 36
SUB CUT 154 TS 26

126 19
SUB CUT 98 TS 14

69 11
SUB CUT 46 TS 8

98+18 855.35

97+79 855.55 C. 32' BIT. ENT. RT.

97+22 855.81
C. 12' SAND ENT. LT.

97+00 855.89

96+53 856.03

96+20 856.22

95+99 856.30
C. 12' BIT. ENT. RT.

95+81 856.35

95+78 856.36
NO GUTTER GLEN CREEK RD.

346 0

SUB CUT 118 TS 9

582 0

SUB CUT 237 TS 22

268 0

SUB CUT 140 TS 12

65 0

SUB CUT 61 TS 7

180 0

SUB CUT 115 TS 7

194 0


SUB CUT 128 TS 5

94+00 BEGIN COMPACTION SUBCUT

STA 94+00 TO STA 98+18

EXCAVATION EMBANKMENT

Sub-Totals Cu. Yds. Cu. Yds. Sub-Totals

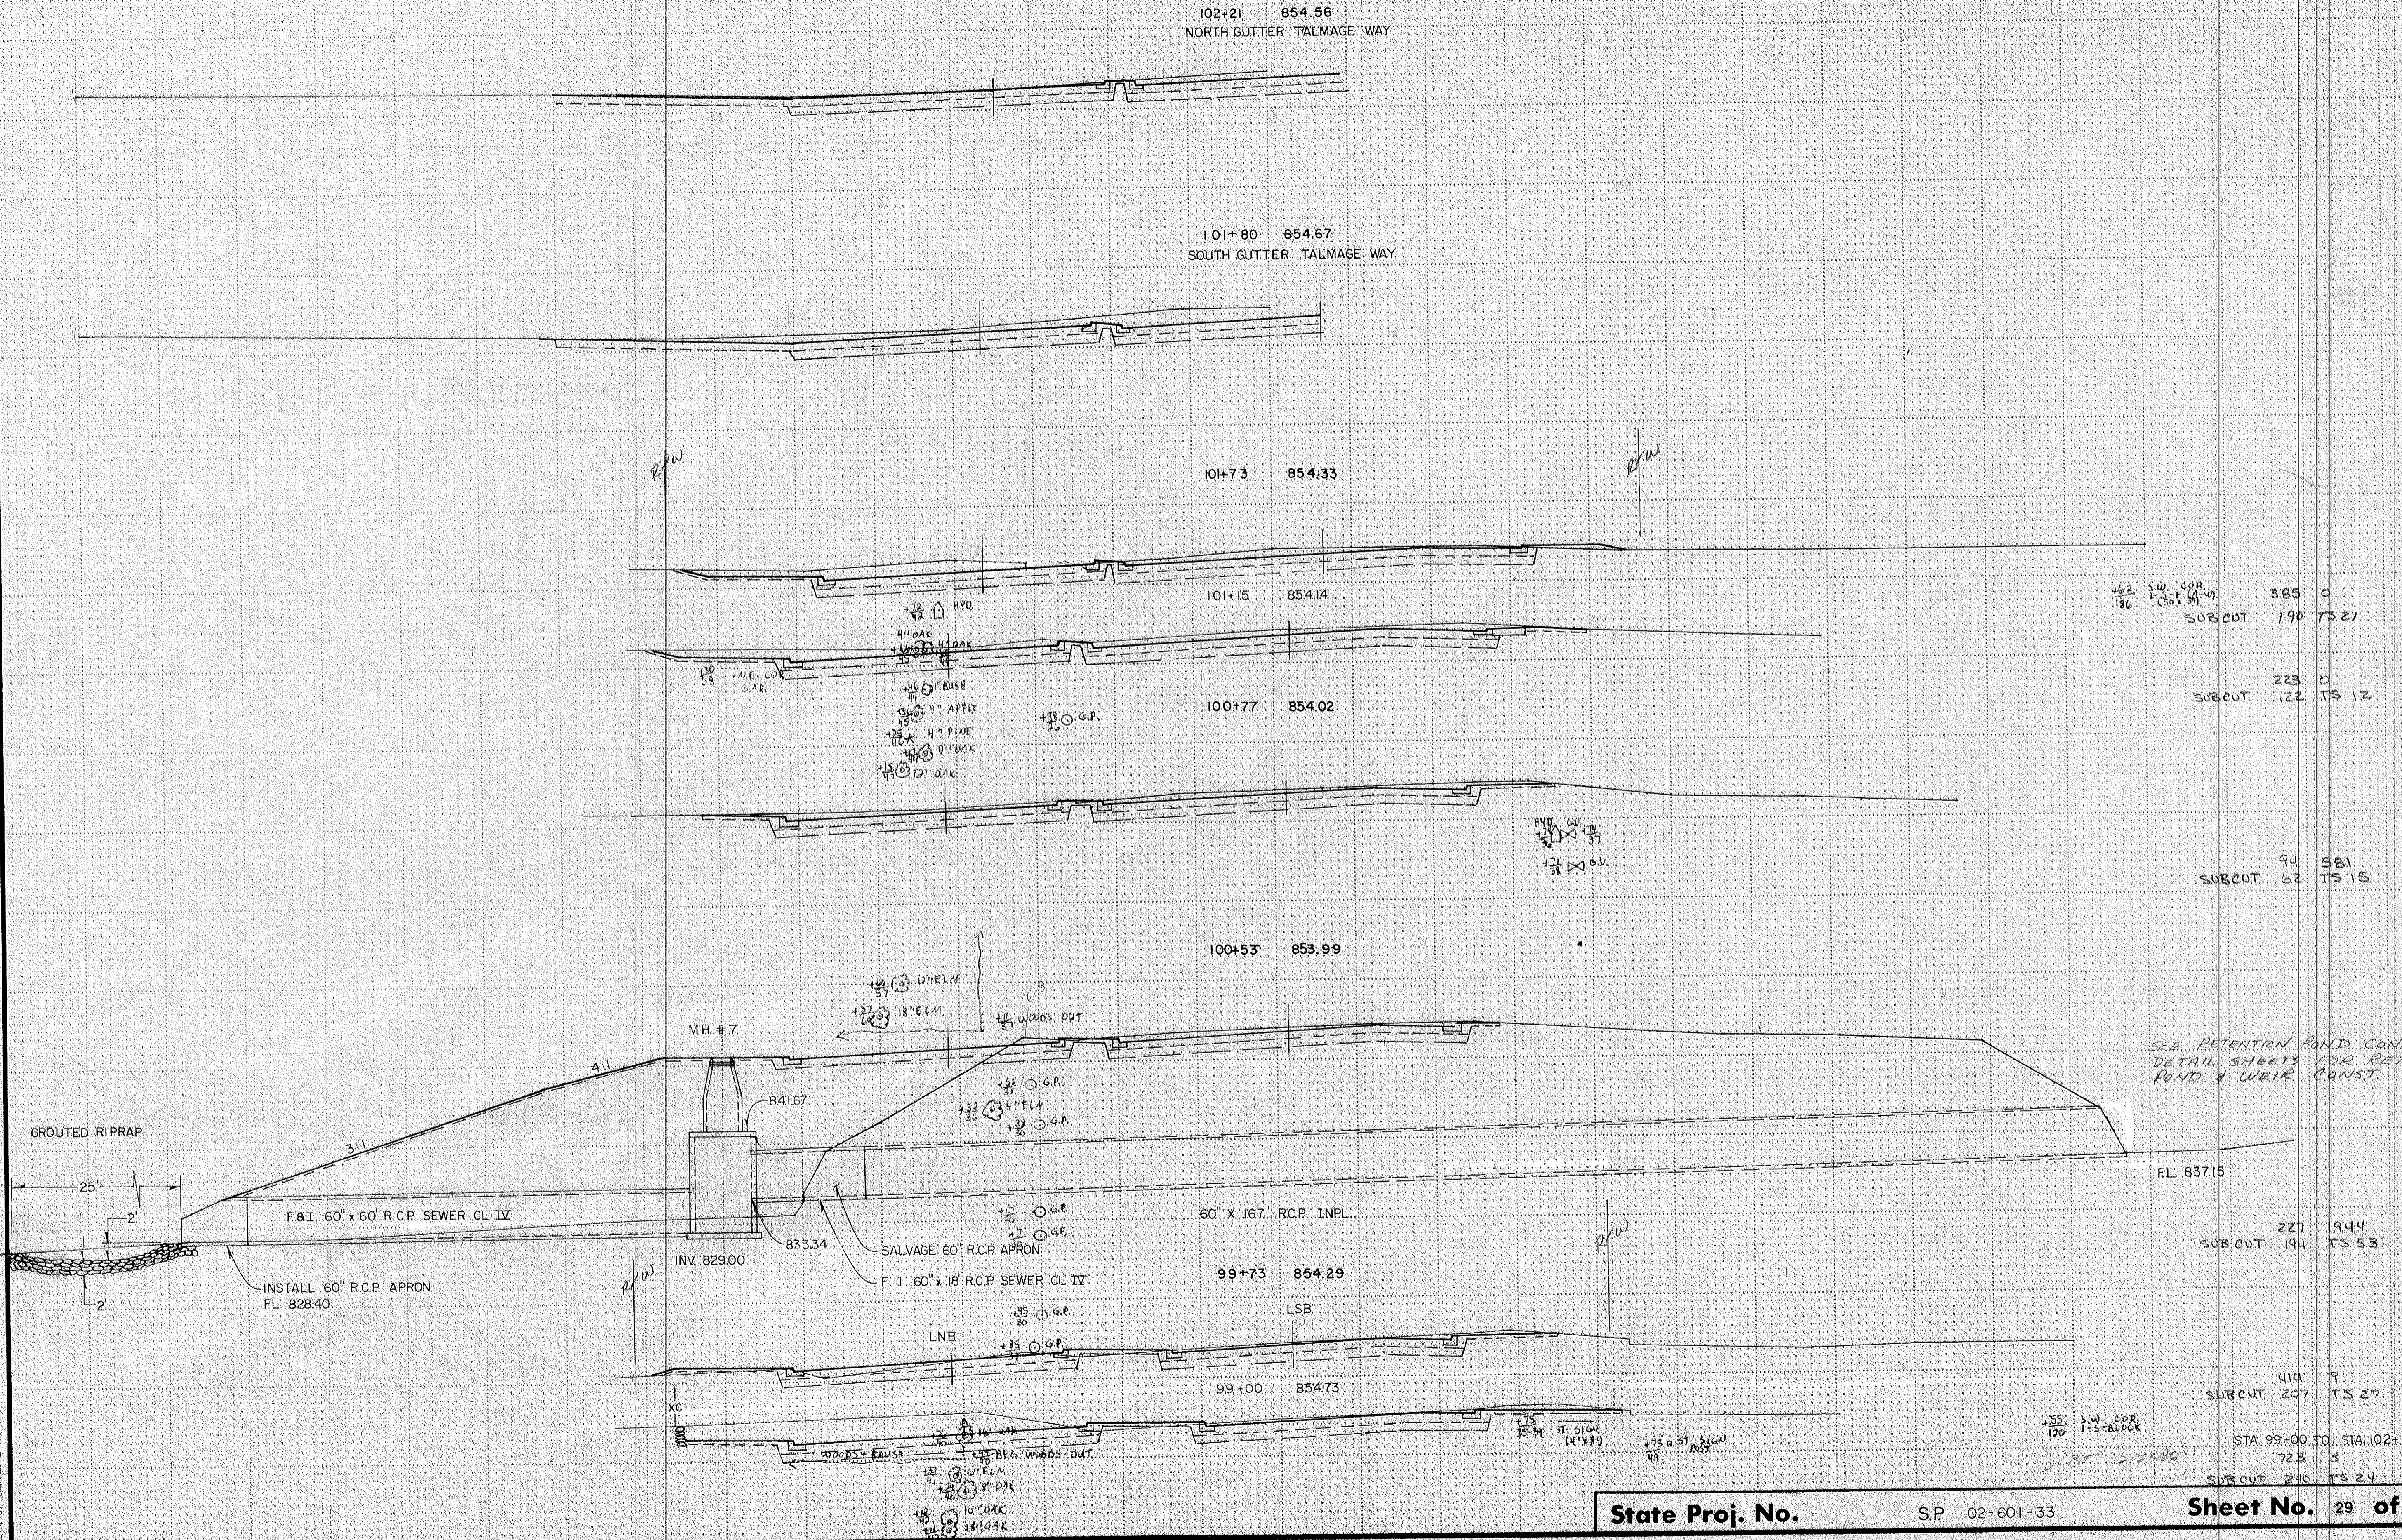

162 SW COR (50' x 50')
SUBCUT 190 TS 21

SUBCUT 223 TS 12

94 SUBCUT 62 TS 15

SEE RETENTION POND CONST. DETAIL SHEETS FOR RETENTION POND & WEIR CONST.

227 SUBCUT 194 TS 53

414 SUBCUT 297 TS 27

155 SW COR 1:3 BLACK
SUBCUT 210 TS 24

EXCAVATION EMBANKMENT

EXCAVATION EMBANKMENT

Sub-Totals Cu. Yds. Cb. Yds. Sub-Totals

Sub-Totals Cu. Yds. Cb. Yds. Sub-Totals

+88 SW COR
185 (30x30)

283 0
SUB CUT 225 TS 16
+26 SW COR
149 (24x30)

285 0
SUB CUT 191 TS 5

107+53 85863
NO GUTTER 75th WAY

105+20 85644
NO GUTTER OSBORNE WAY

107+06 85838
12" SAND ENT. RT.

104+70 85601
SO. GUTTER OSBORNE WAY

106+93 85823
SO. GUTTER 75th WAY

104+38 85590

163 0
SUB CUT 105 TS 2

106+86 85815

318 0
SUB CUT 242 TS 12

103+67 85525

328 0
SUB CUT 235 TS 16

106+00 85735

376 0
SUB CUT 293 TS 14

103+00 85472

418 0
SUB CUT 253 TS 15

105+48 85684
12" SAND ENT. RT.

344 0
SUB CUT 271 TS 11

102+27 85444
LNB LSB

334 0
SUB CUT 181 TS 13

STA. 102+27 TO STA. 107+54

REG ADJUST-LS PINE
106
1 STUMP

101
102
103
101
102
103
WOODS + BRUSH
+35 W DAK
+31 END PE-OUT
+24 W DAK
+20 W DAK
+18 W DAK
+16 W DAK
+14 W DAK
+12 W DAK
+10 W DAK
+8 W DAK
+6 W DAK
+4 W DAK
+2 W DAK

123 SW COR
74

101 STUMP
37

113 POST W/
96 ELECT. BOX

101 2-21-80



VERTICAL POST CROSS SECTION DET. 4/84

EXCAVATION EMBANKMENT

EXCAVATION EMBANKMENT

Sub-Totals Cu. Yds. Cu. Yds. Sub-Totals

Sub-Totals Cu. Yds. Cu. Yds. Sub-Totals

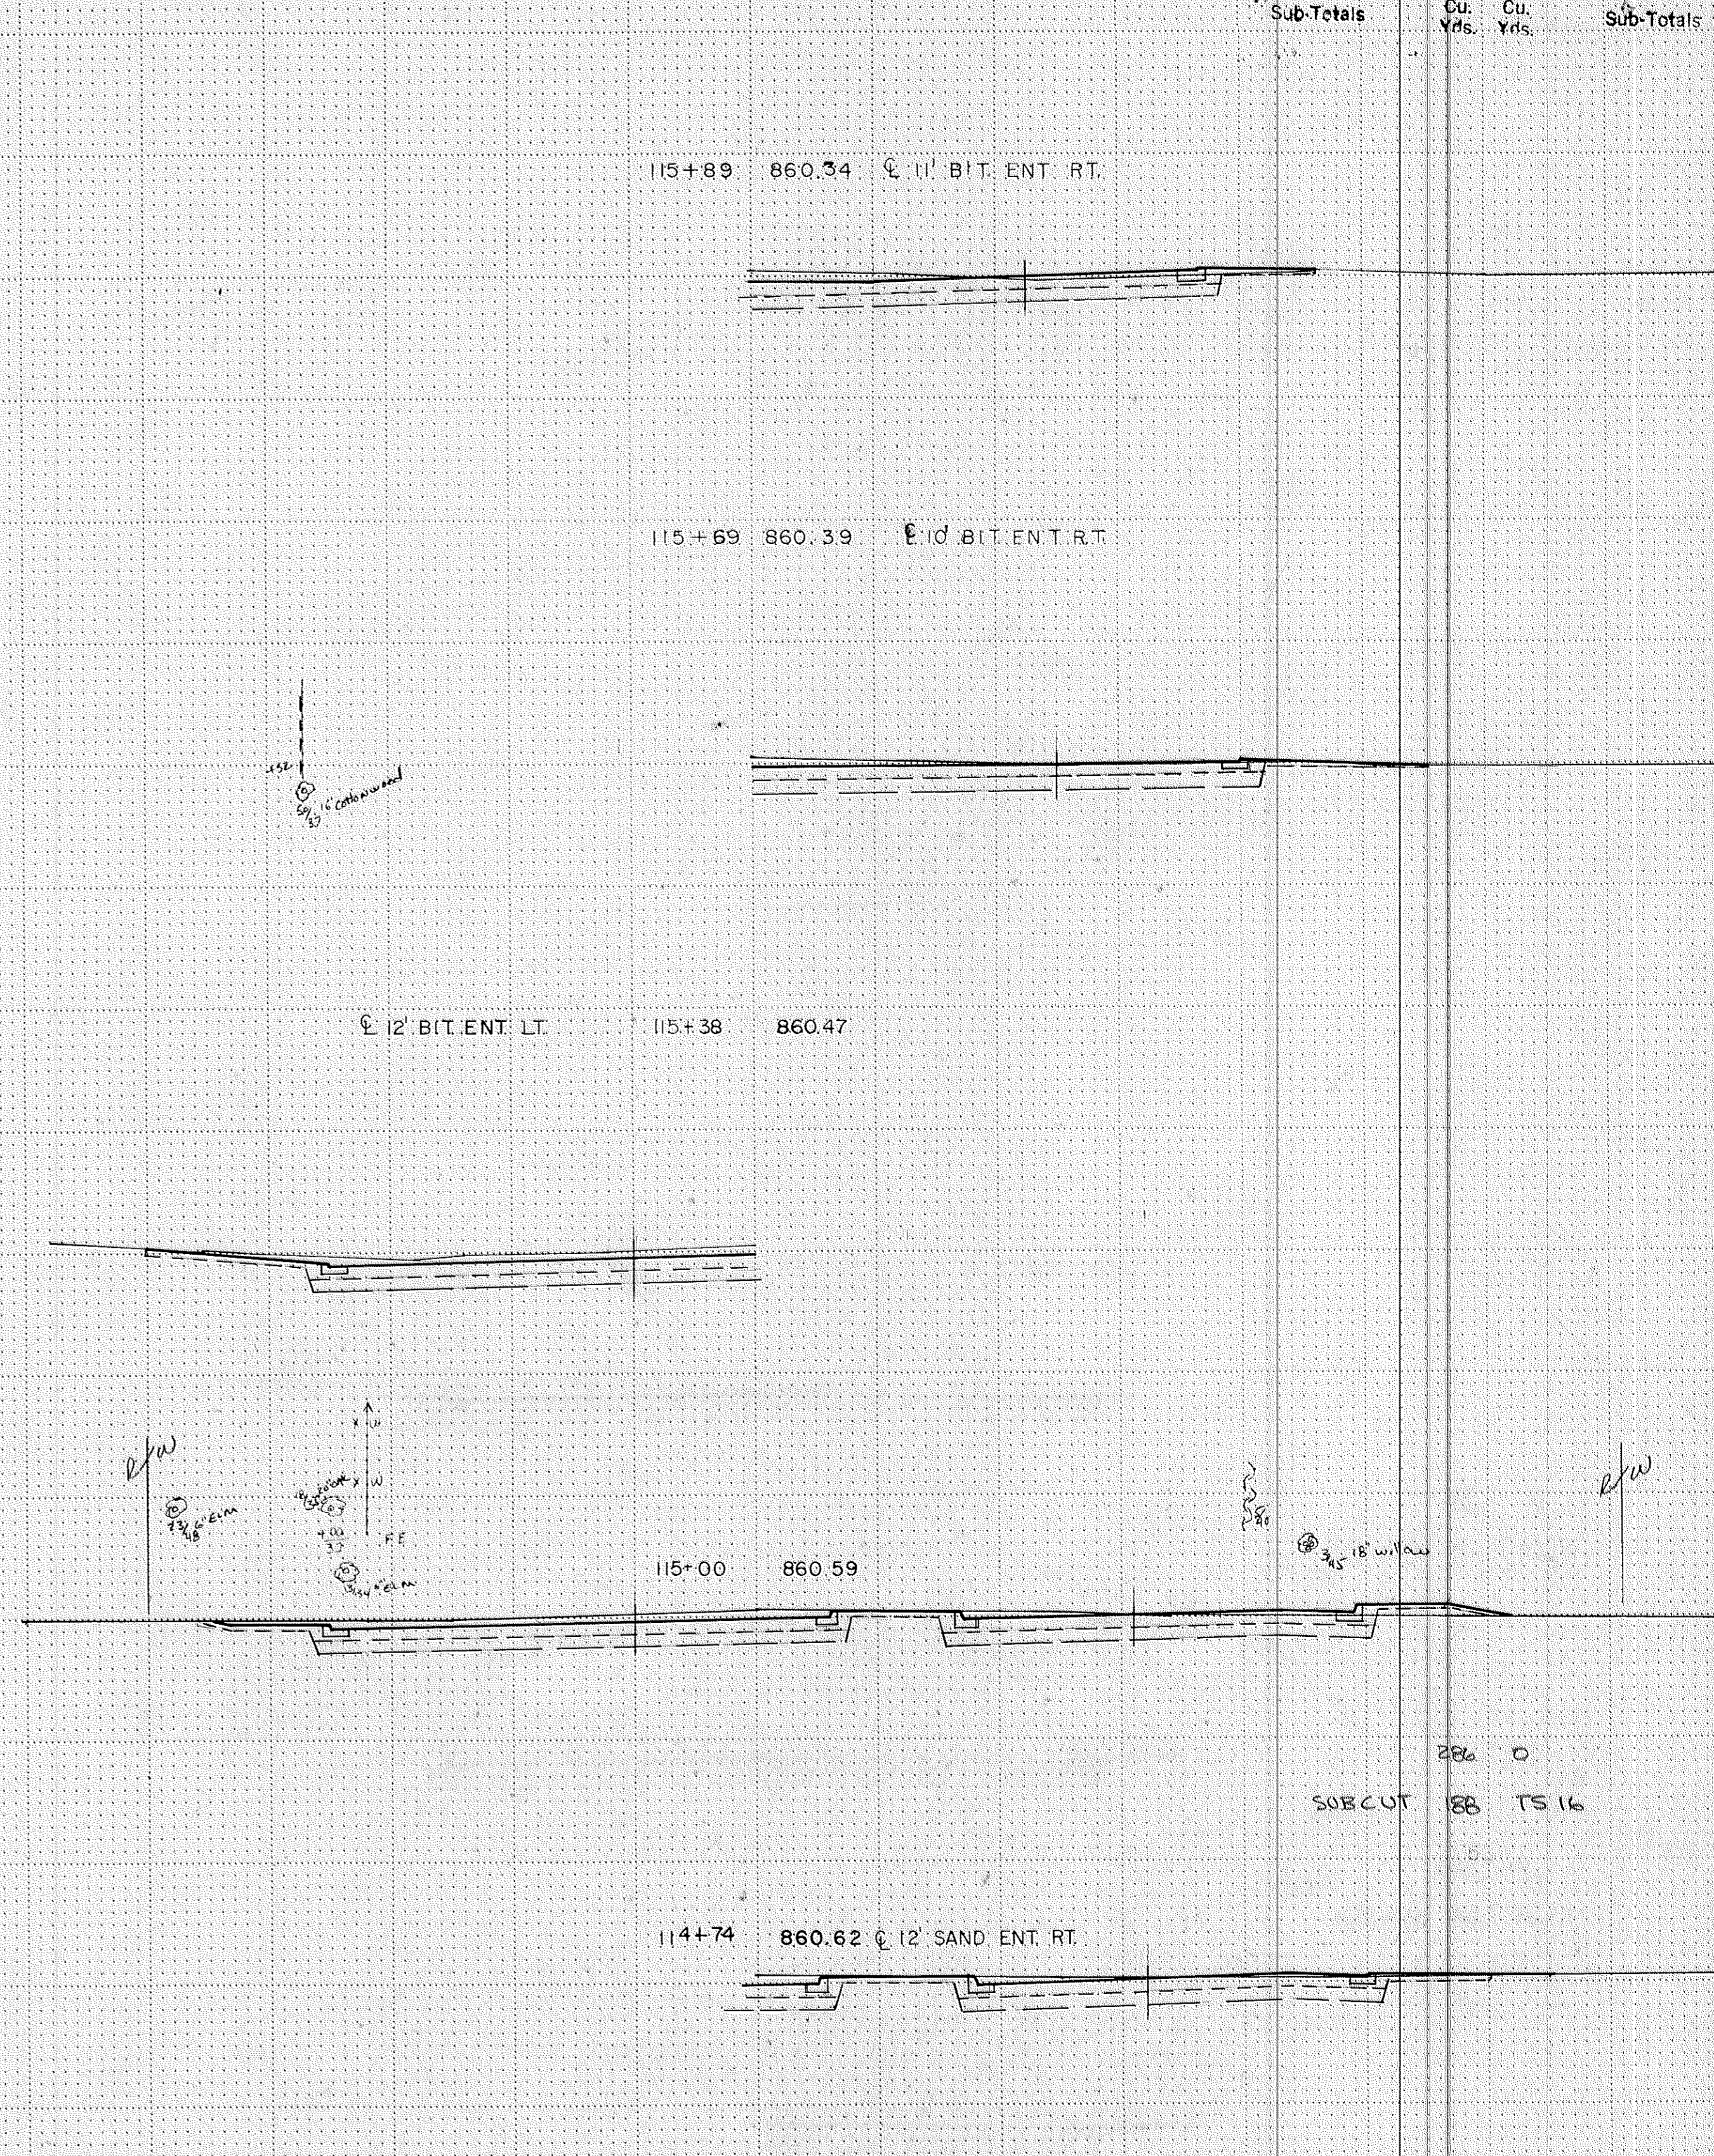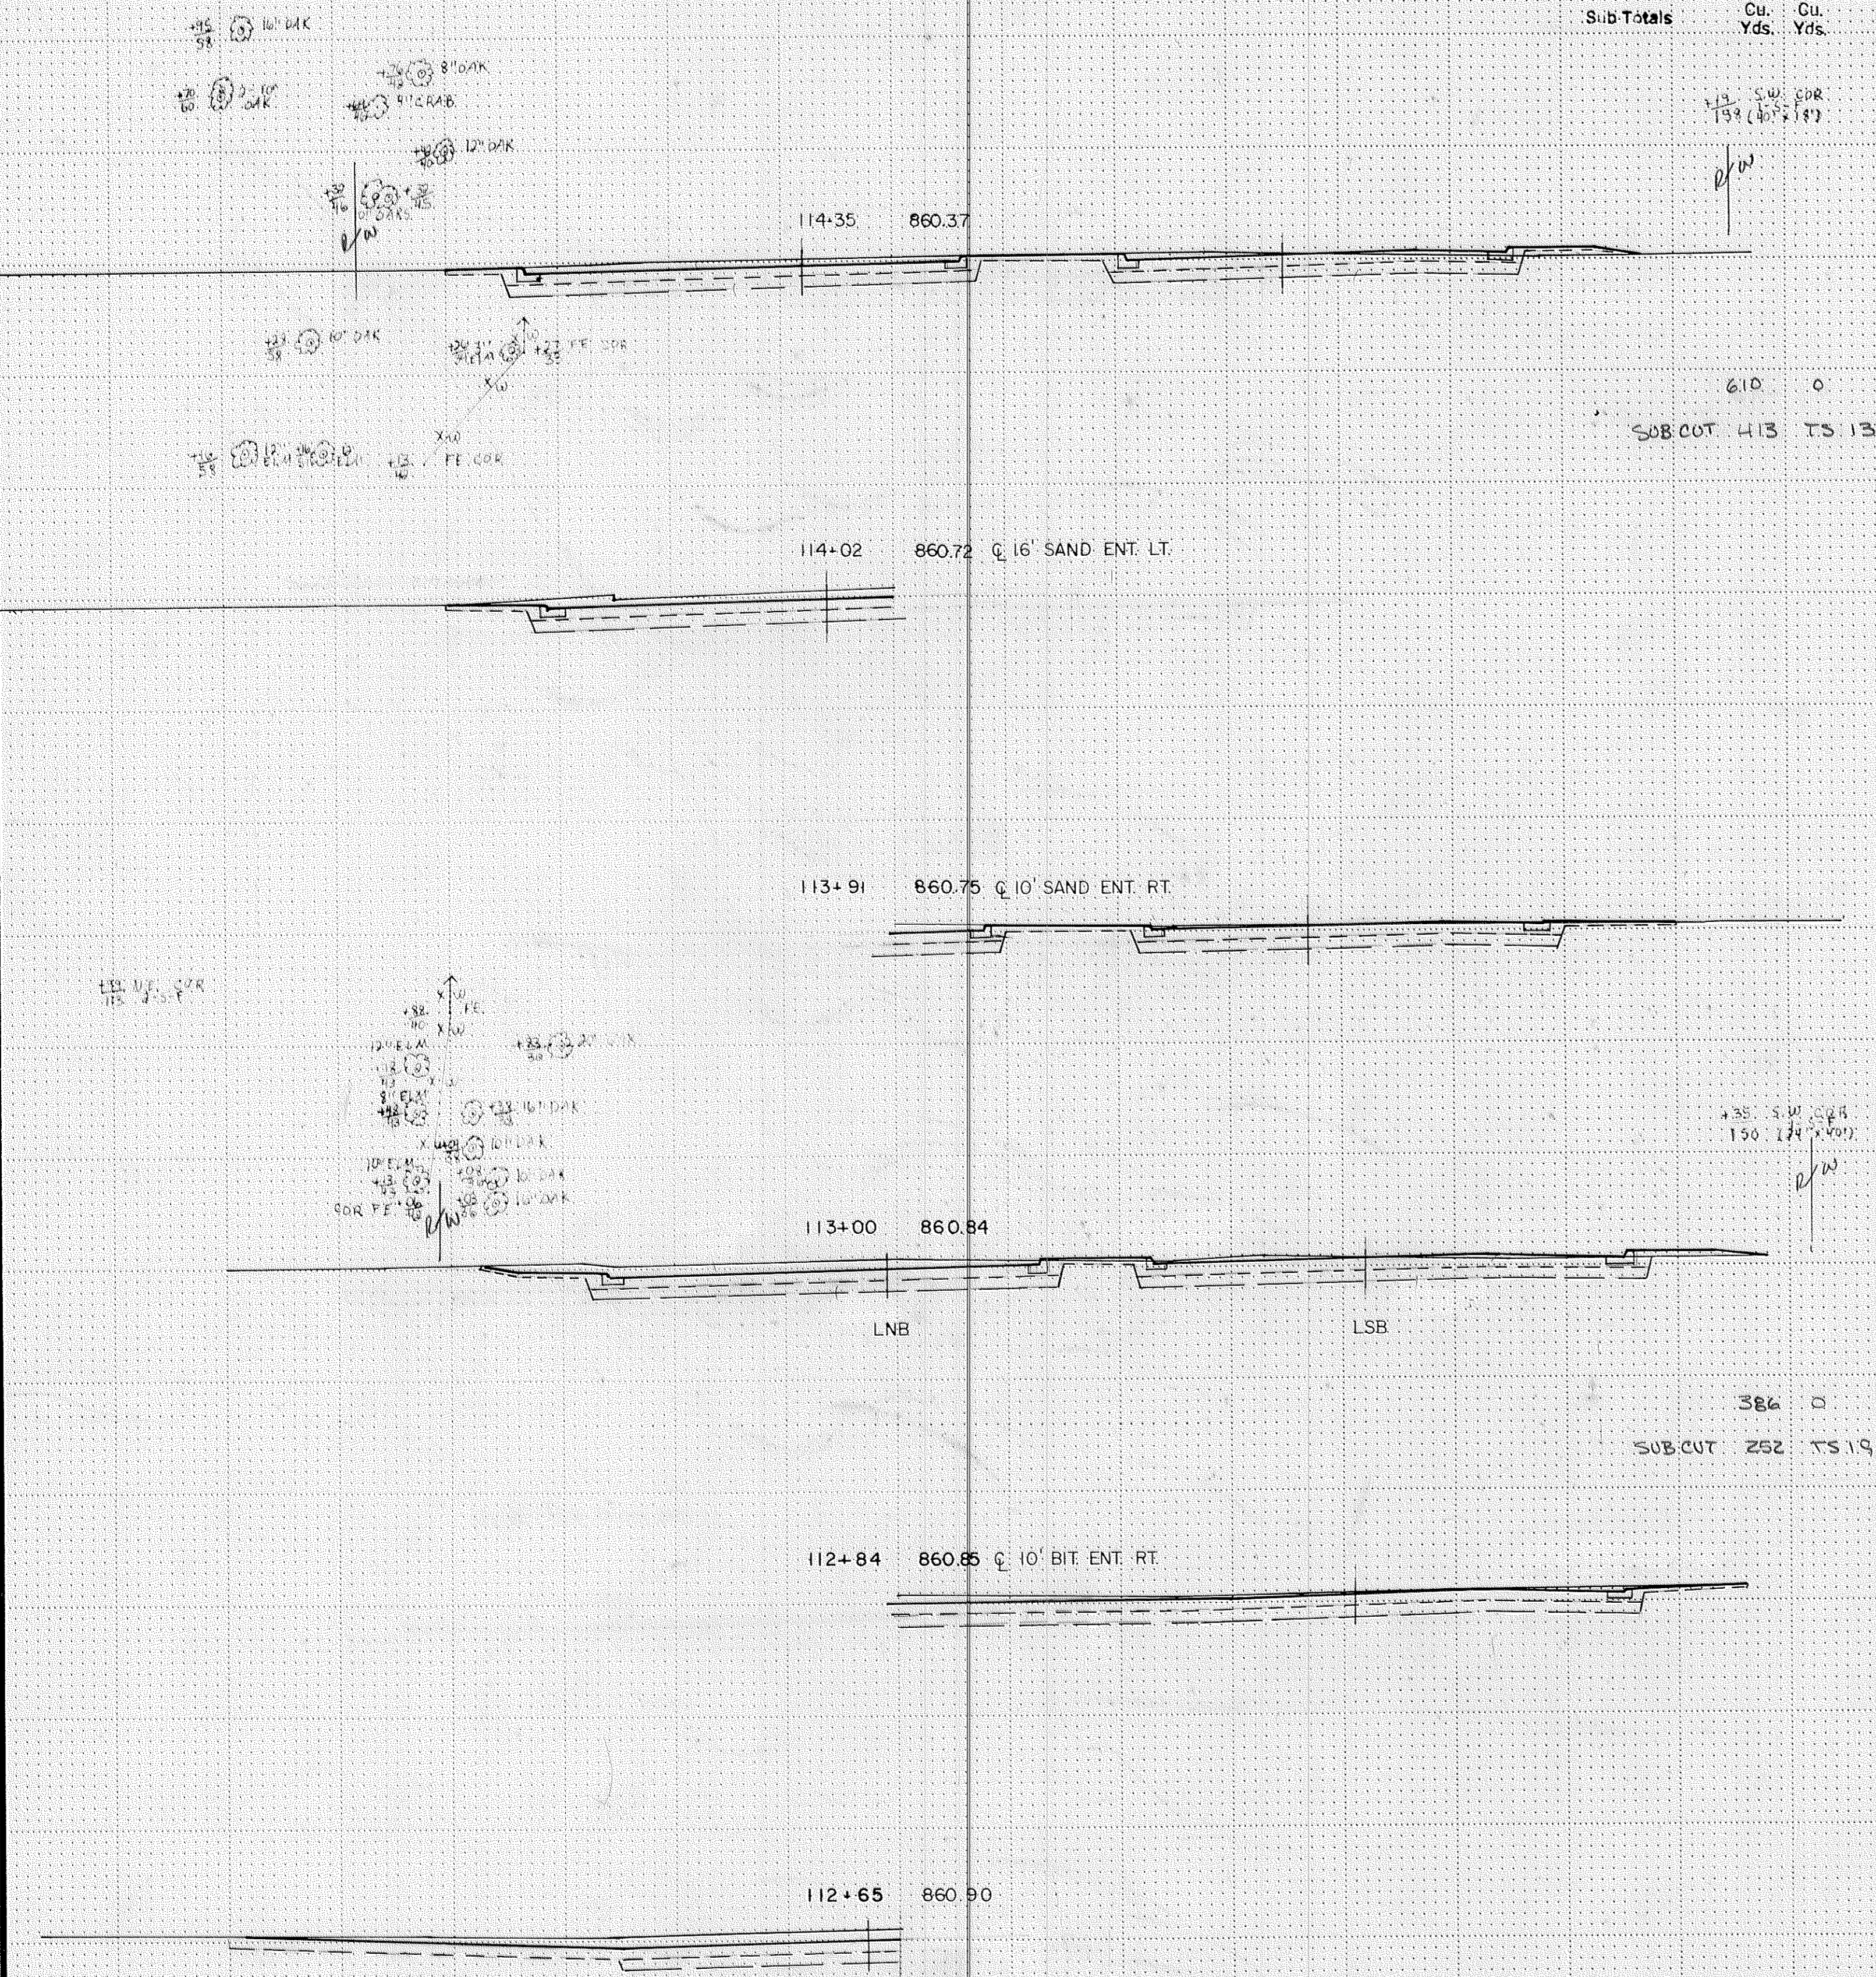


STA. 112+65 TO STA. 115+89

EXCAVATION EMBANKMENT

EXCAVATION EMBANKMENT

Sub-Totals Cu. Yds. Cu. Yds. Sub-Totals

Sub-Totals Cu. Yds. Cu. Yds. Sub-Totals

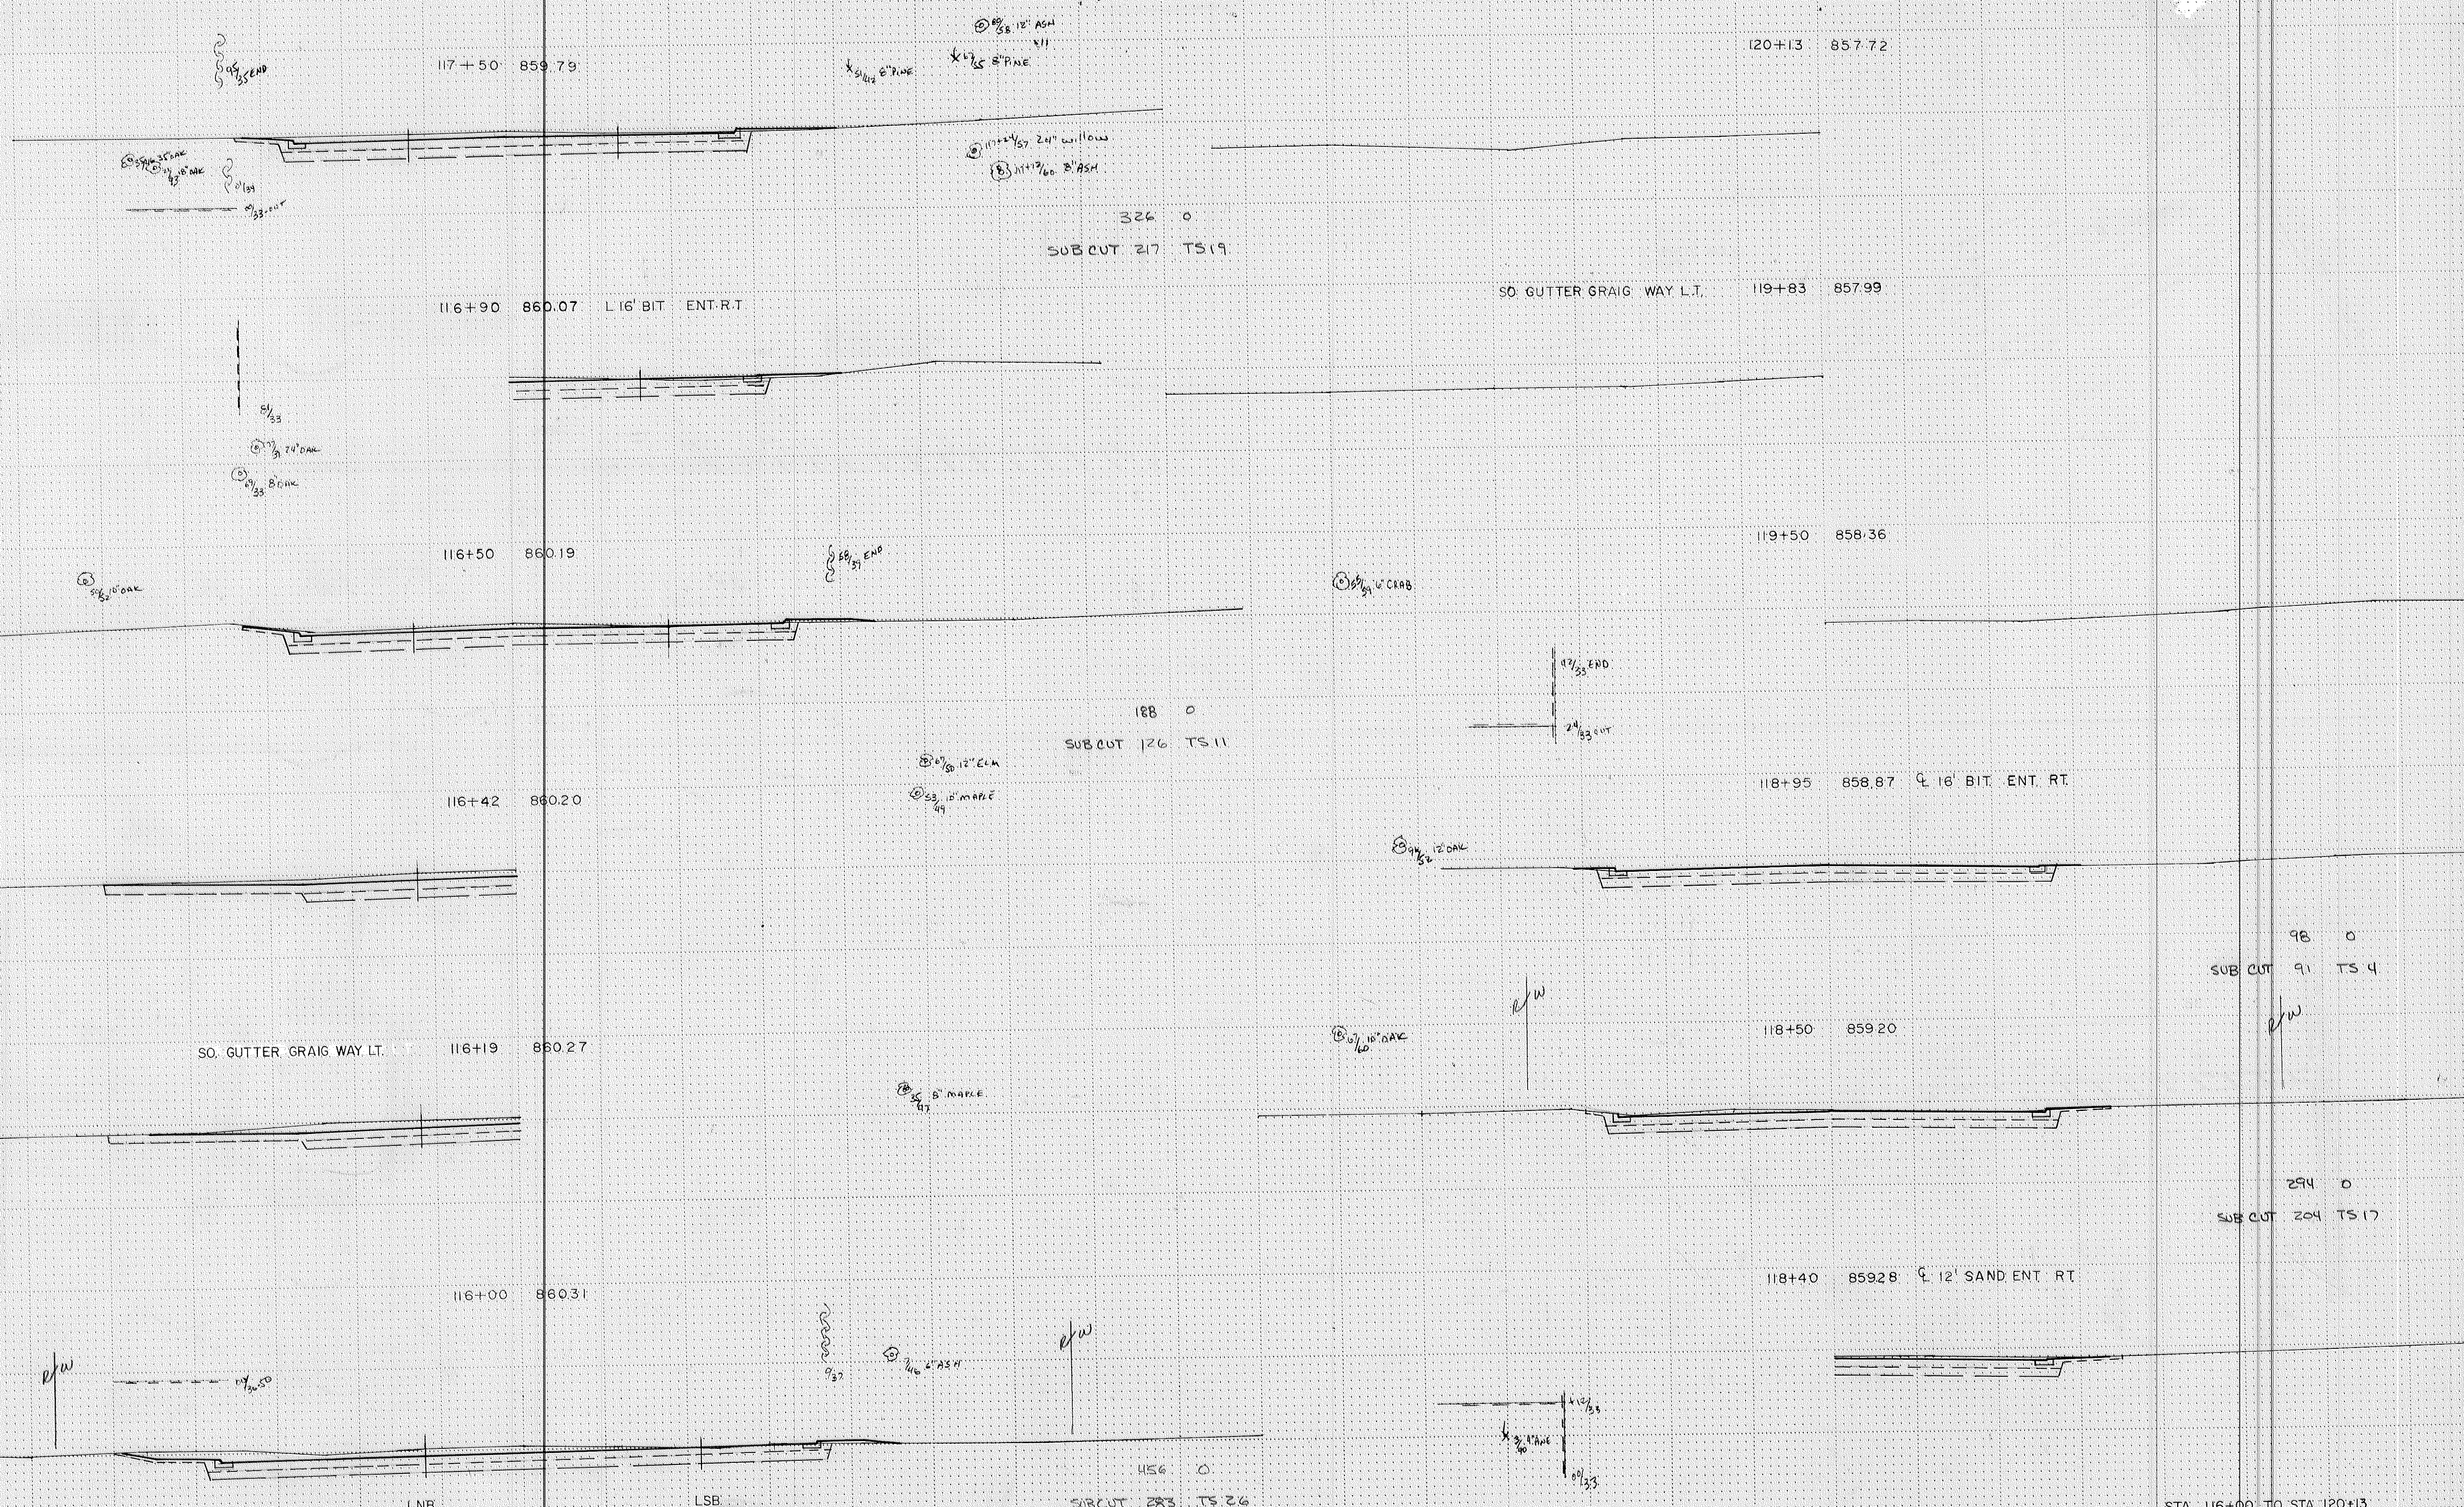

326 0
SUB CUT 217 TS 19




188 0
SUB CUT 126 TS 11

456 0
SUB CUT 283 TS 26


98 0
SUB CUT 91 TS 4

294 0
SUB CUT 204 TS 17

STA. 116+00 TO STA. 120+13

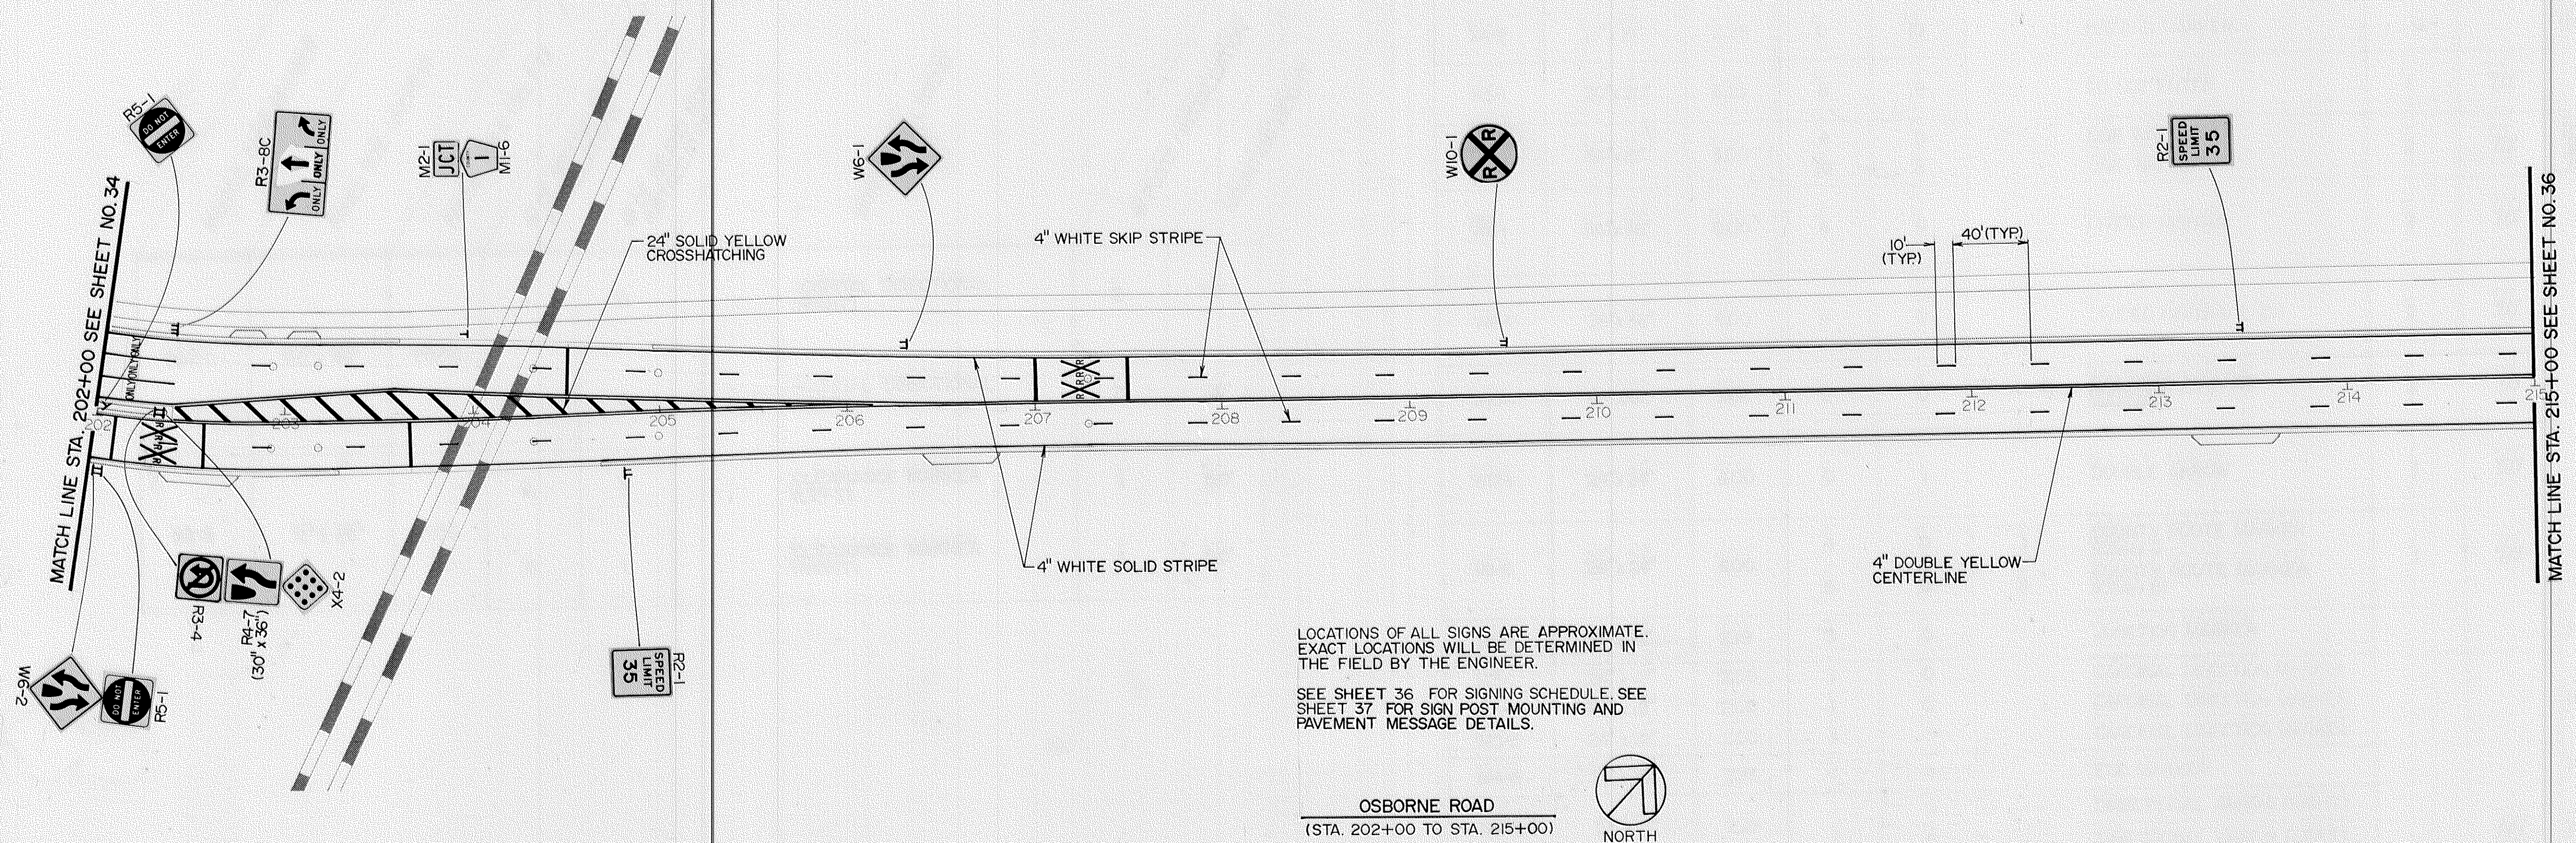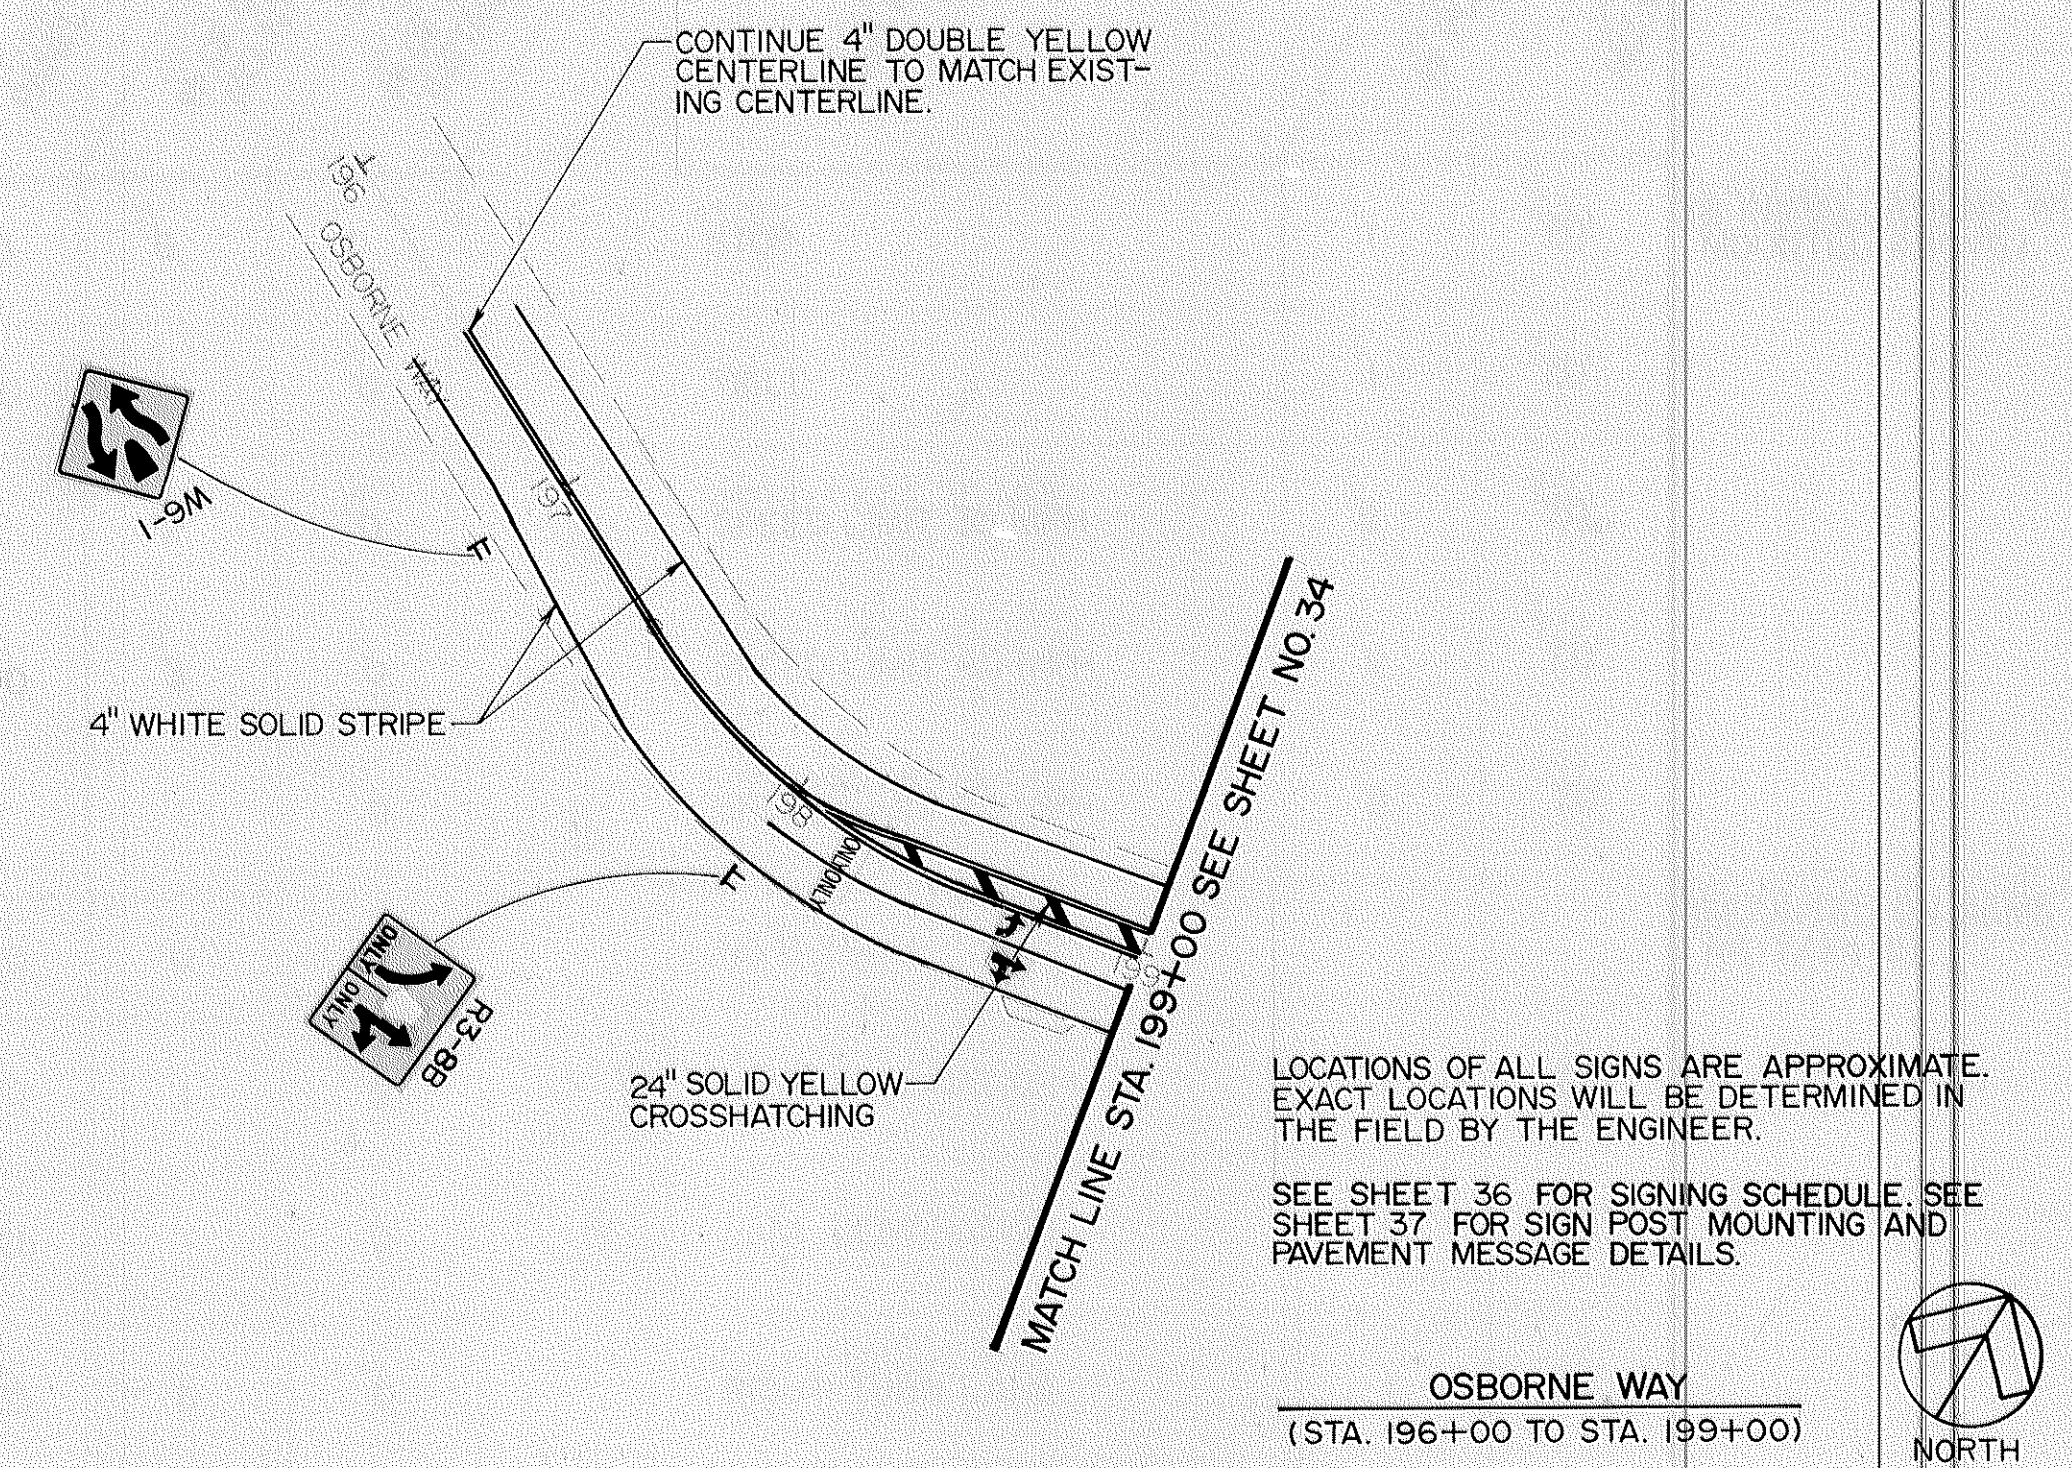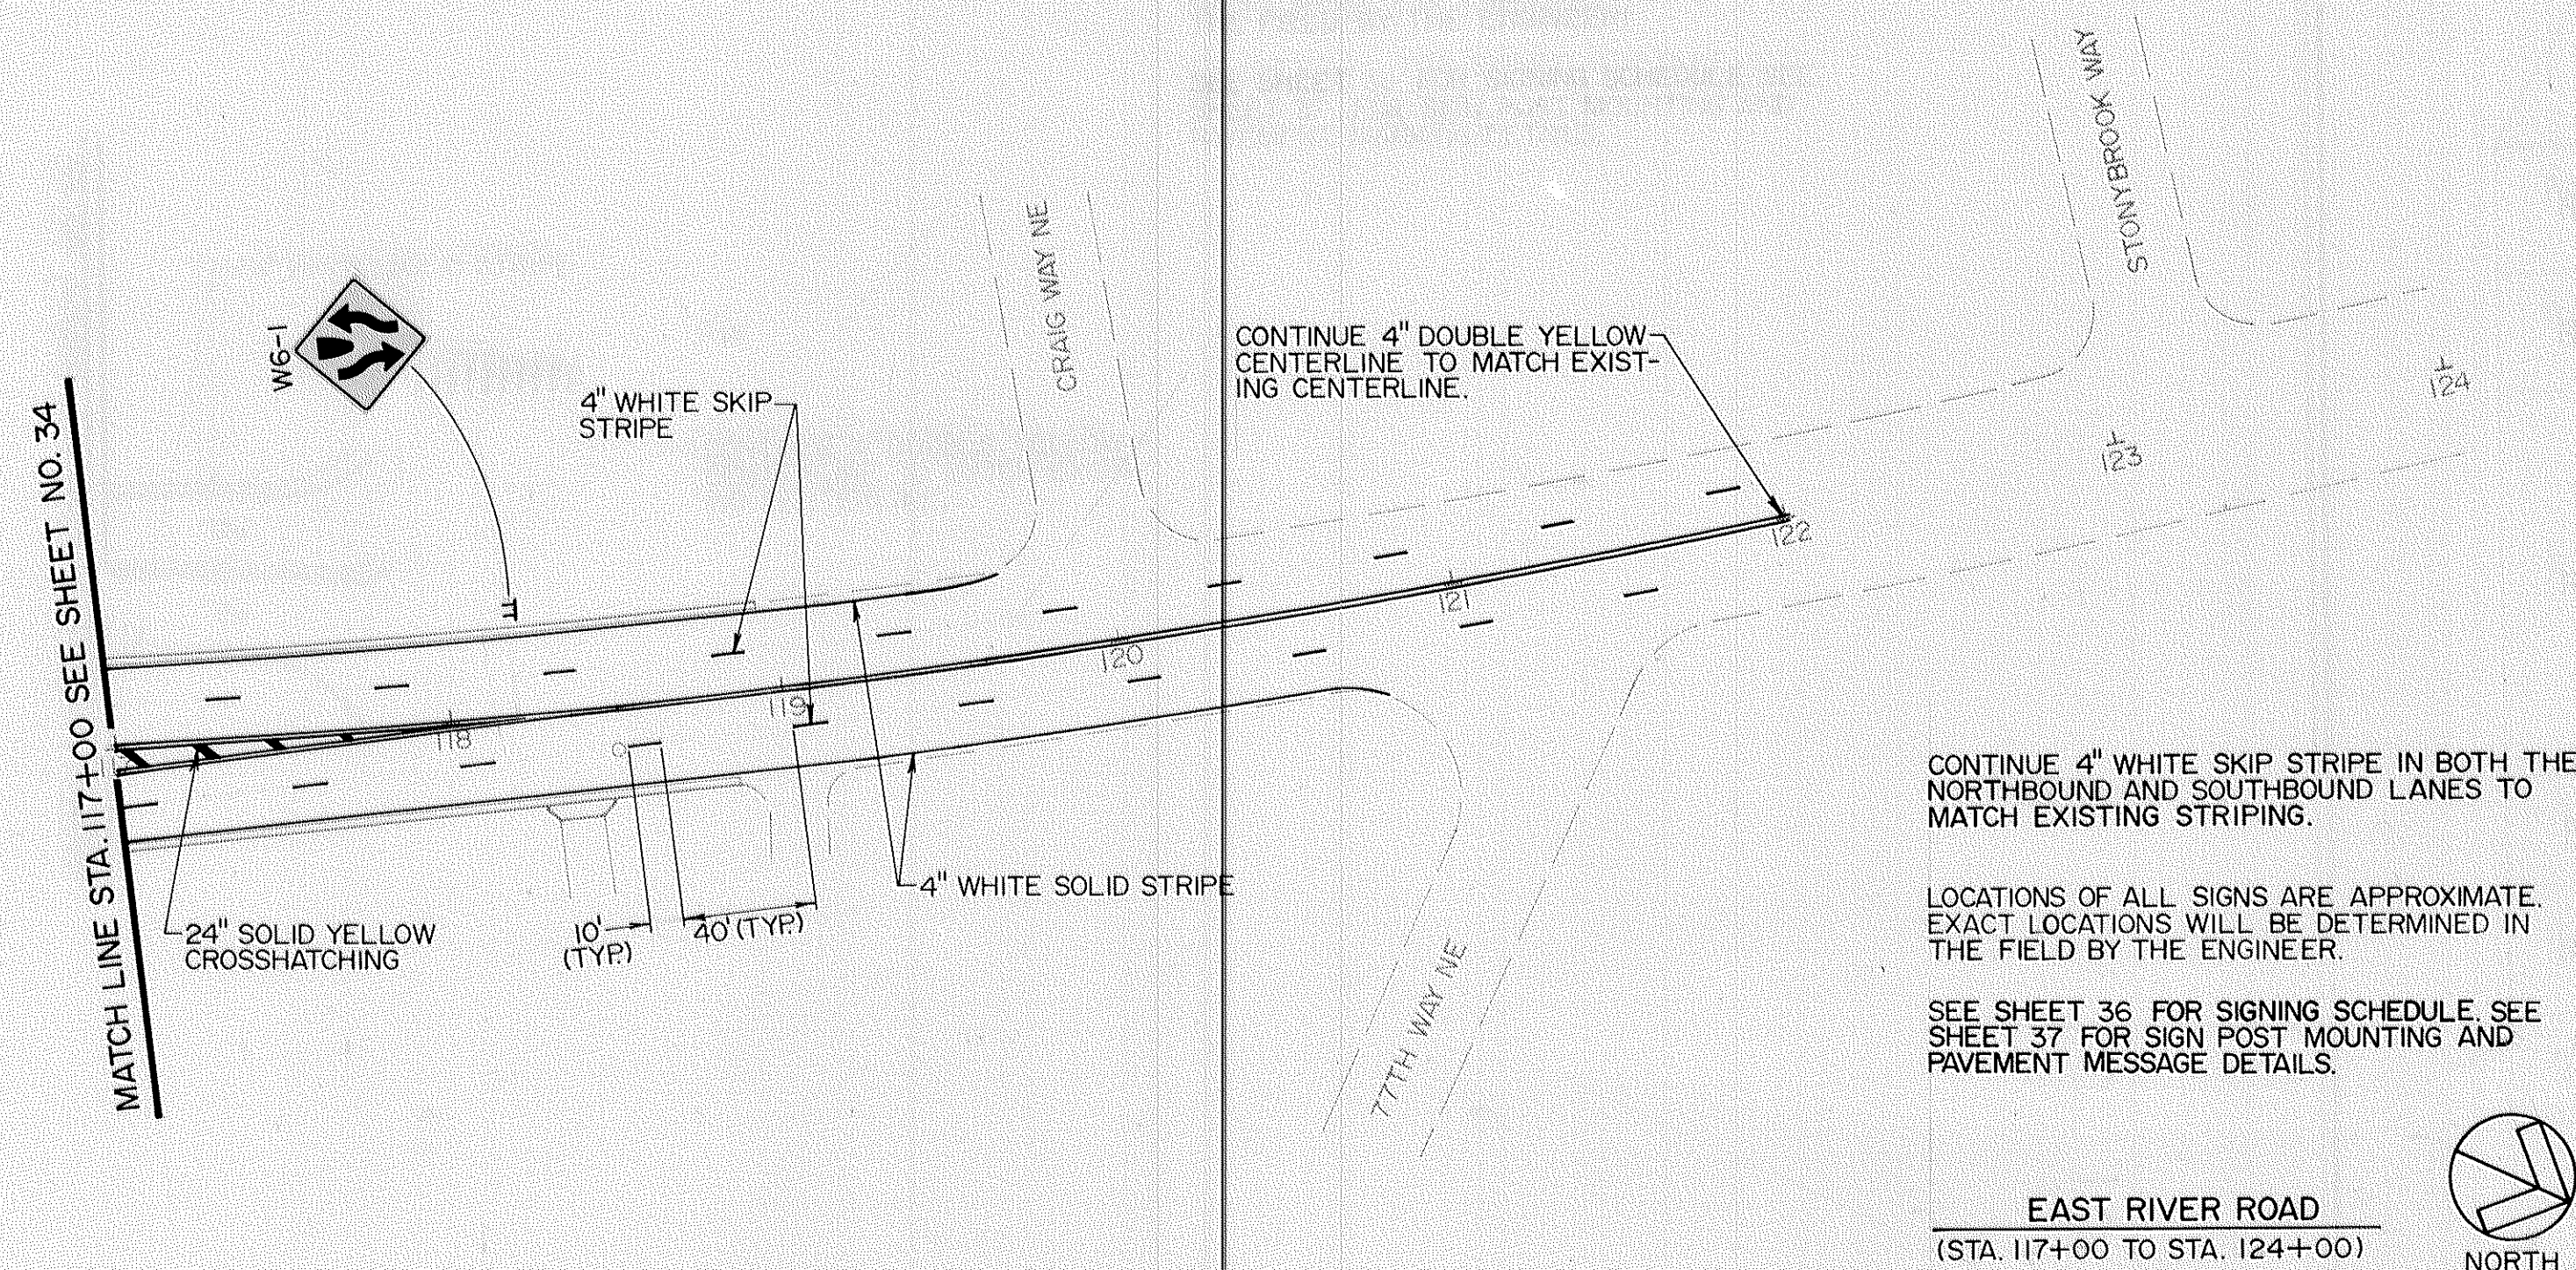


OSBORNE ROAD
(STA. 215+00 TO STA. 221+00)

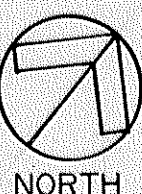

LOCATIONS OF ALL SIGNS ARE APPROXIMATE. EXACT LOCATIONS WILL BE DETERMINED IN THE FIELD BY THE ENGINEER.

SEE SHEET 36 FOR SIGNING SCHEDULE. SEE SHEET 37 FOR SIGN POST MOUNTING AND PAVEMENT MARKING DETAILS.

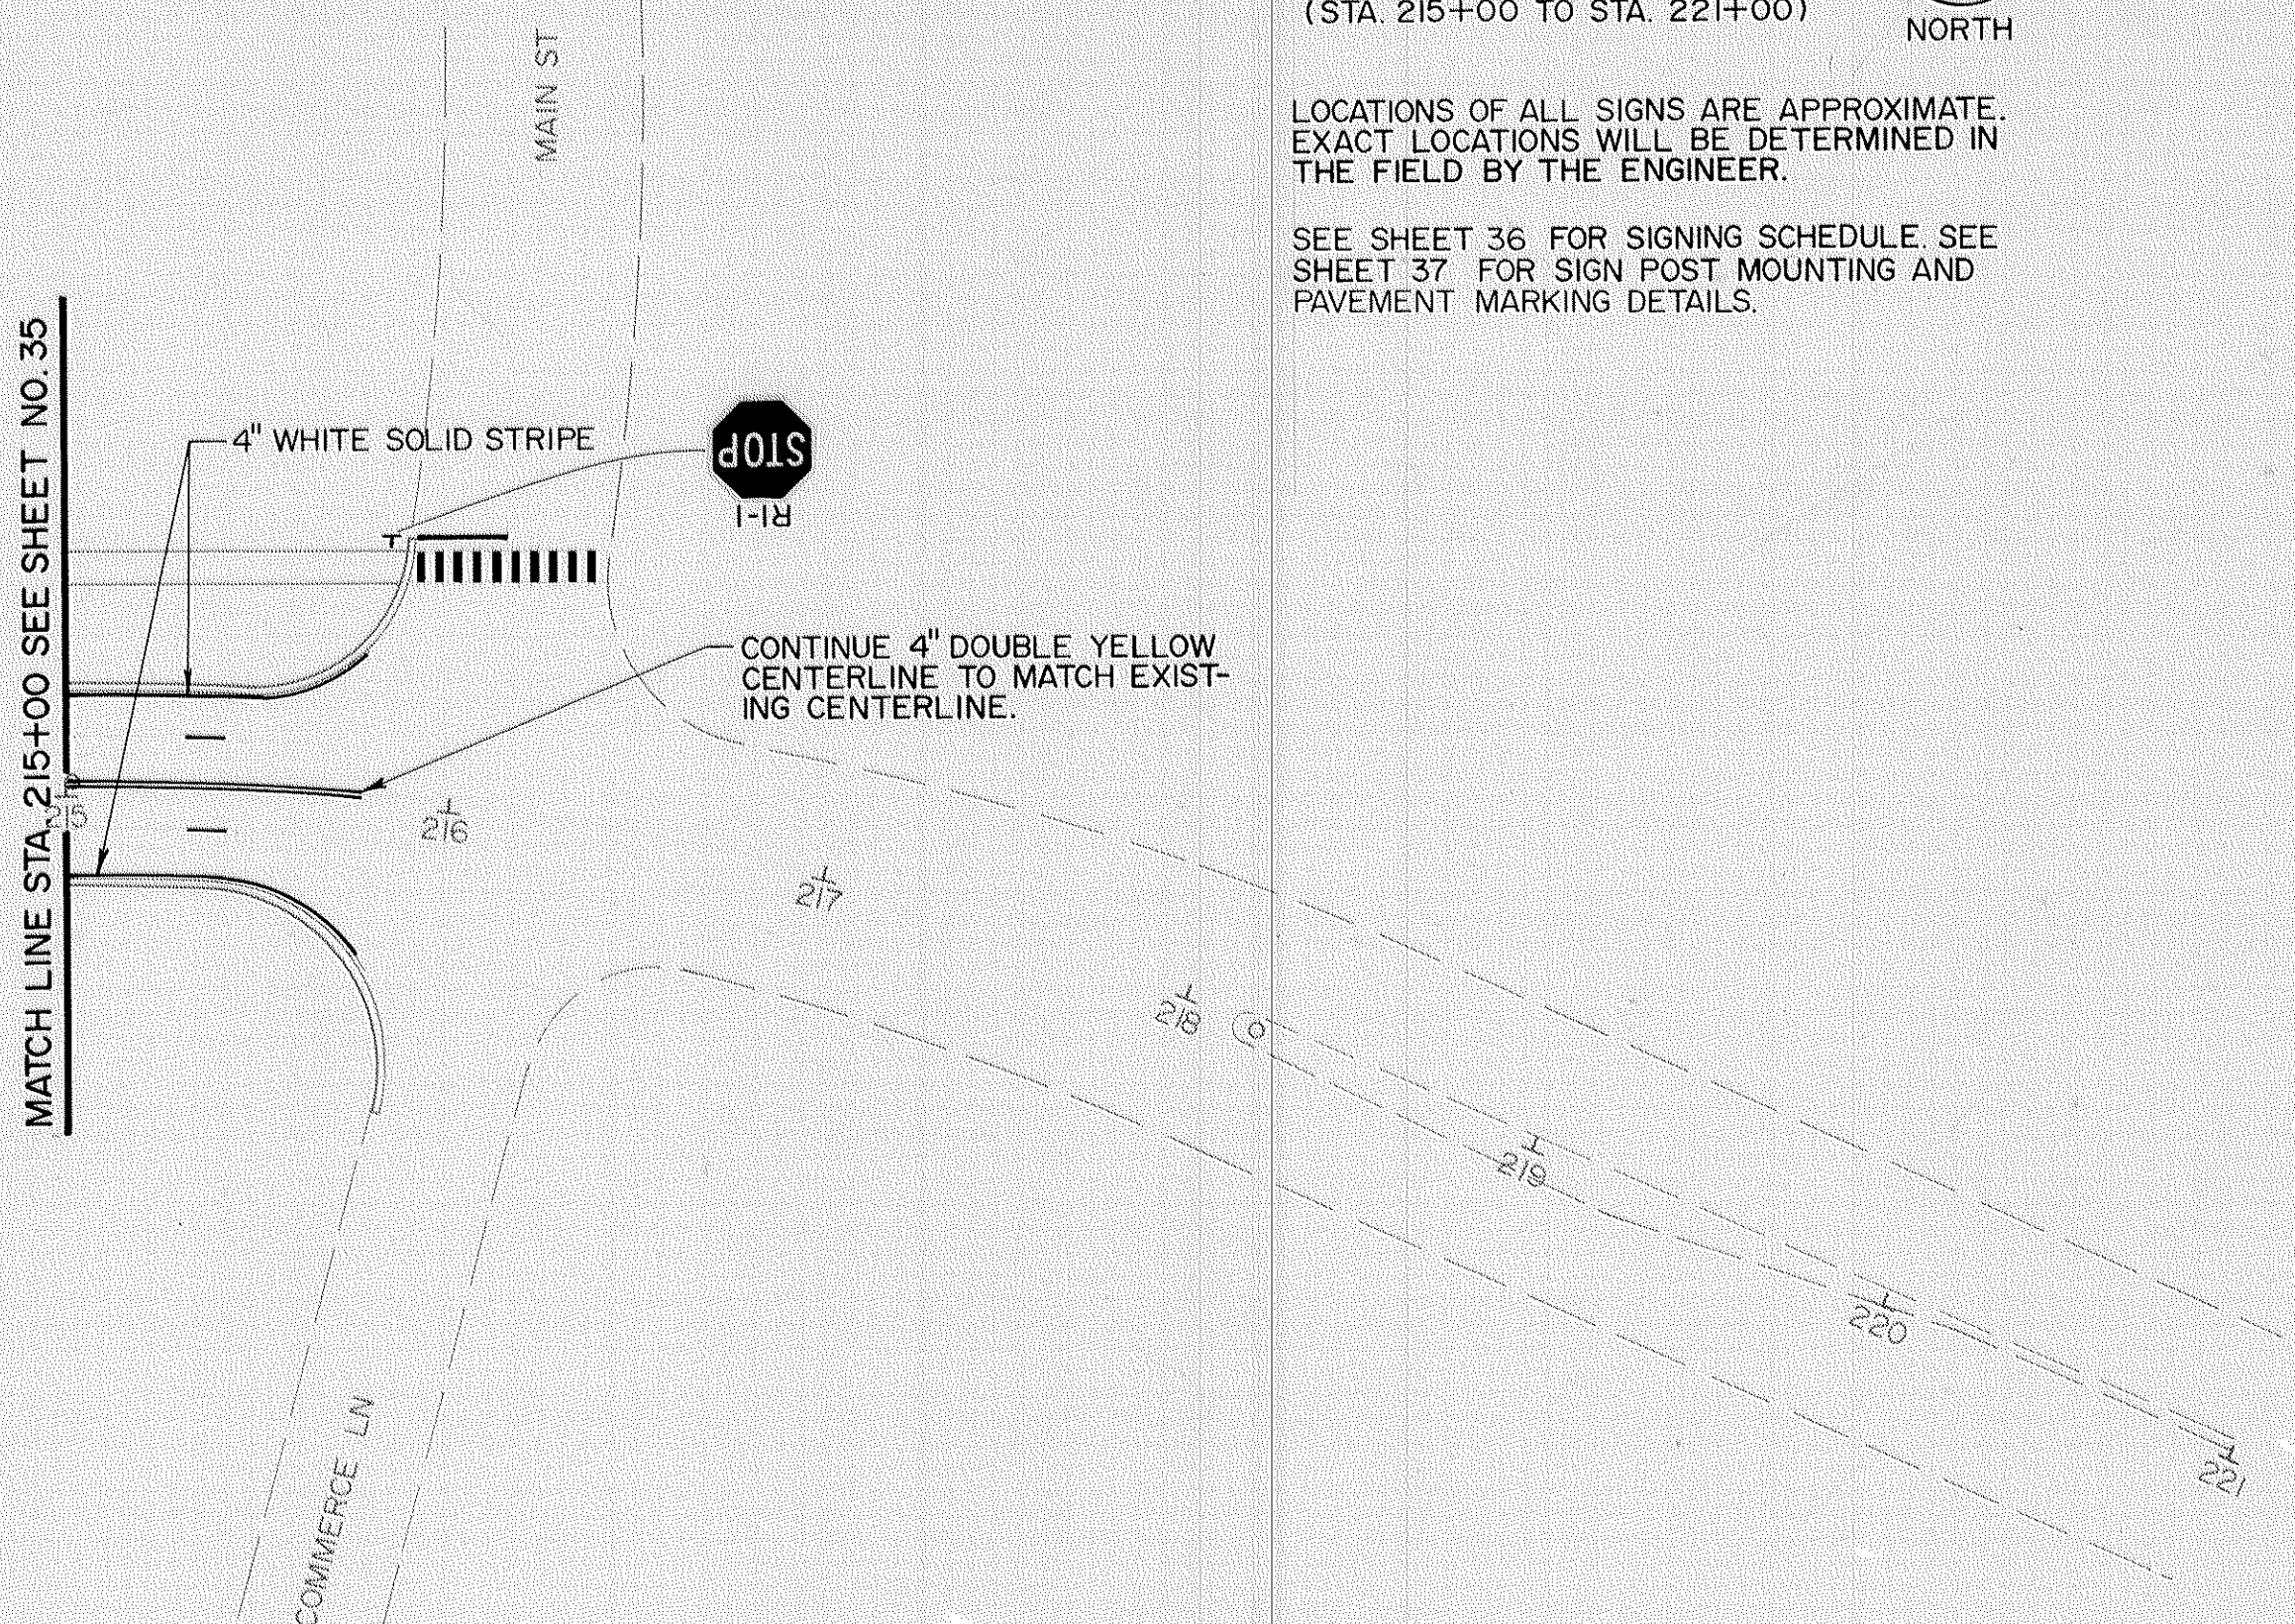

M.U.T.C.D. CODE NUMBER	PANEL SIZE (INCHES)	PANEL AREA (SQ. FT.)	# OF GROUND POST MOUNT INSTALLATIONS	# OF ISLAND MOUNT INSTALLATIONS	SIGN PANEL LEGEND	# POSTS / INSTALLATION	MOUNTING HEIGHT
D9-2B	60" x 48"	20.00	1	0	HOSPITAL HOSPITAL	2	7.0'
					HOSPITAL HOSPITAL	2	7.0'
X4-4	12" x 36"	3.00	0	3		1	5.0'
						1	5.0'

M.U.T.C.D. CODE NUMBER	PANEL SIZE (INCHES)	PANEL AREA (SQ. FT.)	# OF GROUND POST MOUNT INSTALLATIONS	# OF ISLAND MOUNT INSTALLATIONS	SIGN PANEL LEGEND	# POSTS / INSTALLATION	MOUNTING HEIGHT
R1-1	30" x 30"	6.25	6	0	STOP	1	7.0'
R1-2	36" x 36" x 36"	3.90	1	0	YIELD	1	7.0'
R2-1	36" x 48"	12.00	3	0	SPEED LIMIT 35	2	7.0'
					SPEED LIMIT 40	2	7.0'
					SPEED LIMIT 45	2	7.0'
R3-4	24" x 24"	4.00	0	4	NO U-TURN		
R3-8B	36" x 30"	7.50	1	0	LANE DESIGNATION	2	7.0'
R3-8C	54" x 30"	11.25	1	0	LANE DESIGNATION	3	7.0'
R3-X1	30" x 30"	6.25	5	0	RIGHT TURN LANE	1	7.0'
R3-X2	30" x 30"	6.25	0	3	LEFT TURN LANE	1	7.0'
R4-7	30" x 36" 24" x 30"	7.50 5.00	0 0	4 6	KEEP RIGHT	2 1	7.0' 7.0'
X4-2	18" x 18"	2.25	0	10	HAZARD MARKER		
R5-1	30" x 30"	6.25	8	8	DO NOT ENTER	1	7.0'
R6-1	36" x 12"	3.00	4	0	ONE WAY (LEFT)	2	7.0'
					ONE WAY (RIGHT)	19	8
W6-1	36" x 36"	9.00	4	0	DIVIDED HIGHWAY	2	7.0'
W6-2	36" x 36"	9.00	4	0	DIVIDED HIGHWAY ENDS	2	7.0'
W10-1	36" DIA.	7.06	2	0	RAILROAD ADVANCE WARNING	2	7.0'
W12-1	24" x 24"	4.00	0	1	DOUBLE ARROW	1	5.0'
MI-6	24" x 24"	4.00	4	0	COUNTY ROUTE MARKER (CSAH 1)	1	7.0'
					COUNTY ROUTE MARKER (CSAH 8)	6	0
M2-1	21" x 15"	2.19	3	0	JUNCTION MARKER		
M3-1	24" x 12"	2.00	1	0	NORTH		
M3-2	24" x 12"	2.00	1	0	EAST		
M3-3	24" x 12"	2.00	1	0	SOUTH		
M4-6	21" x 15"	2.19	1	0	END		
M6-1	21" x 15"	2.19	1	0	DIRECTIONAL ARROW (RIGHT)		
			1	0	DIRECTIONAL ARROW (LEFT)		
M6-4	21" x 15"	2.19	1	0	DIRECTIONAL ARROW (DBL. HD.)		

(5 INSTALLATIONS WITH R6-1(R) MOUNTED ABOVE)

(MOUNTED ON SAME POST(S) AS R4-7/X4-2)

(MOUNTED BELOW R4-7)

(5 INSTALLATIONS OF R6-1(R) ARE MOUNTED ABOVE R1-1, 1 INSTALLATION OF BACK-TO-BACK R6-1(R).)

(MOUNTED ABOVE MI-6)


(MOUNTED ABOVE MI-6)

(MOUNTED ABOVE MI-6)

(MOUNTED BELOW MI-6)

DETAIL "1"

ISLAND MOUNT BREAK-AWAY SIGN POST INSTALLATION

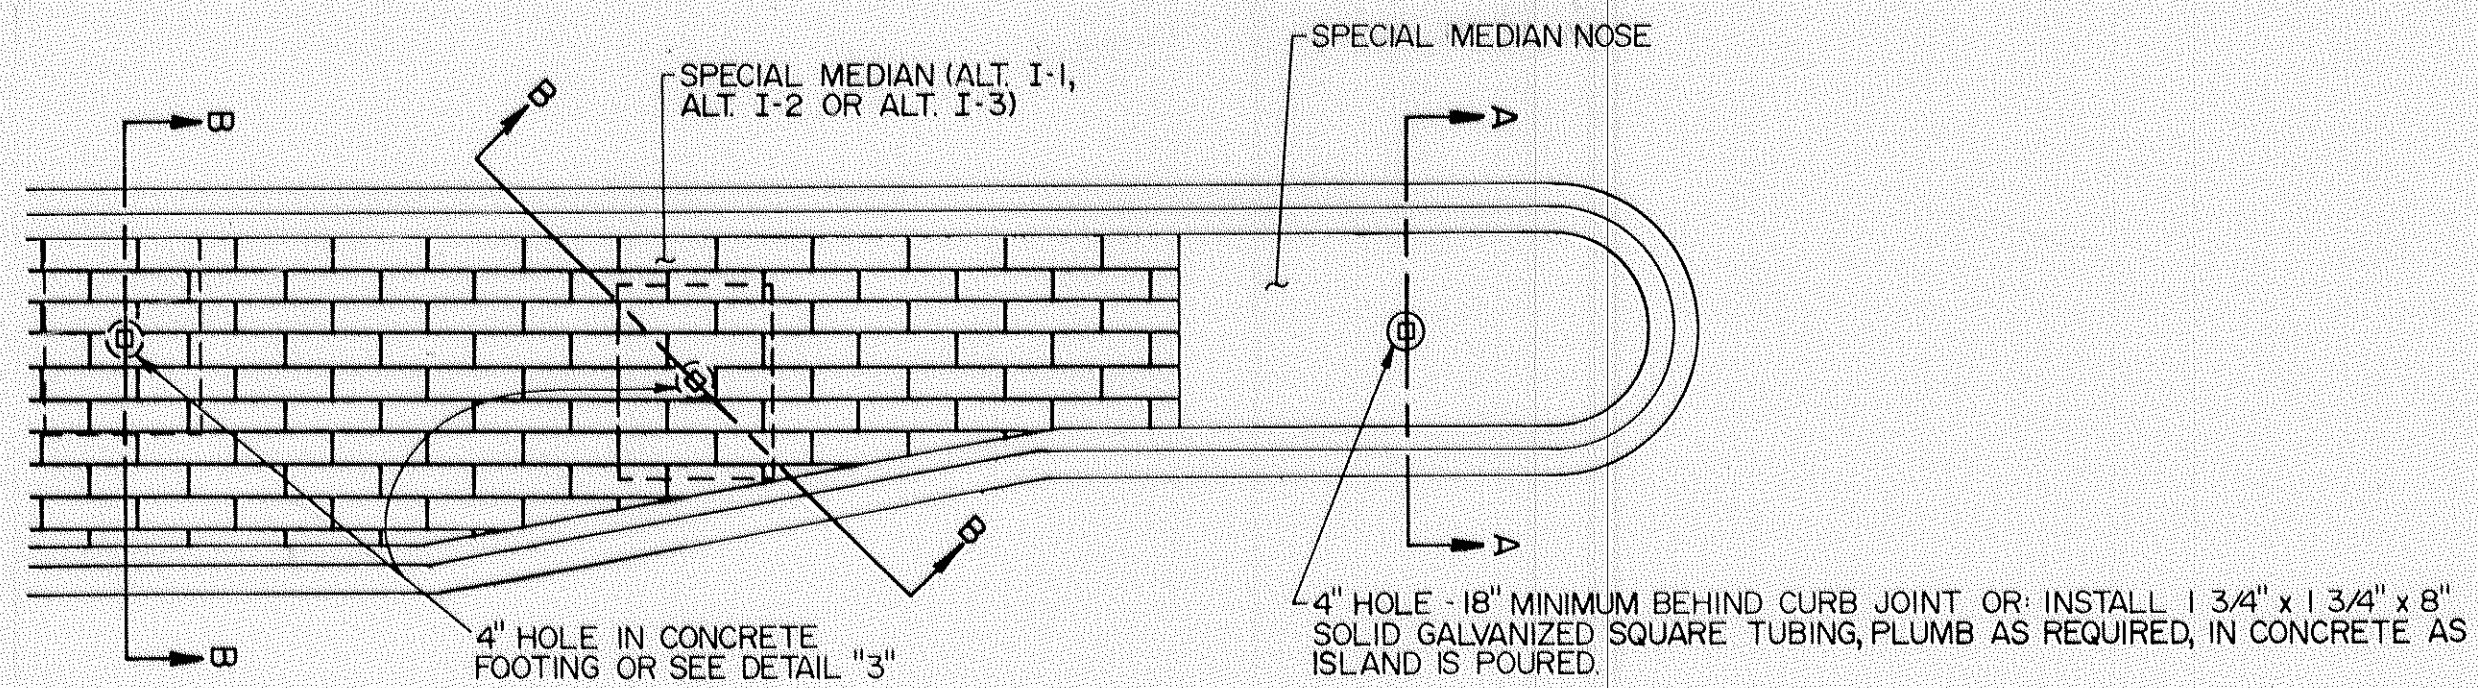

NOTES: DASHED LINES REPRESENT THE APPROX. LIMITS OF CONCRETE FOOTINGS TO BE POURED FOR EACH ISLAND MOUNT SIGN POST INSTALLATION WITHIN SPECIAL MEDIAN AREAS (ALT. I-1, ALT. I-2 OR ALT. I-3) (36" LENGTH x 48" WIDTH x 5" HEIGHT) IF THE ISLAND IS LESS THAN 48" WIDE, THE WIDTH OF THE CONCRETE FOOTING WILL EQUAL THE WIDTH OF THE ISLAND, IF MORE THAN ONE POST IS REQUIRED FOR AN INSTALLATION, SEE DETAIL "4."


SECTION B-B: THE SOLID GALVANIZED SQUARE TUBING FOR THE DO NOT ENTER SIGNS SHALL BE SET AT THE PROPER ANGLE. REFER TO THE MINNESOTA MANUAL ON UNIFORM TRAFFIC CONTROL DEVICES.

FOR PAYMENT OF CONCRETE FOOTINGS, REFER TO THE STATEMENT OF ESTIMATED QUANTITIES, ITEM 2564.513 CONCRETE FOOTINGS.

NOTE: CONCRETE FOOTINGS ARE REQUIRED IN ALL MEDIAN AREAS EXCEPT WHERE SPECIAL MEDIAN NOSES ARE CONSTRUCTED.


DETAIL "2"

ENLARGED SECTION A-A

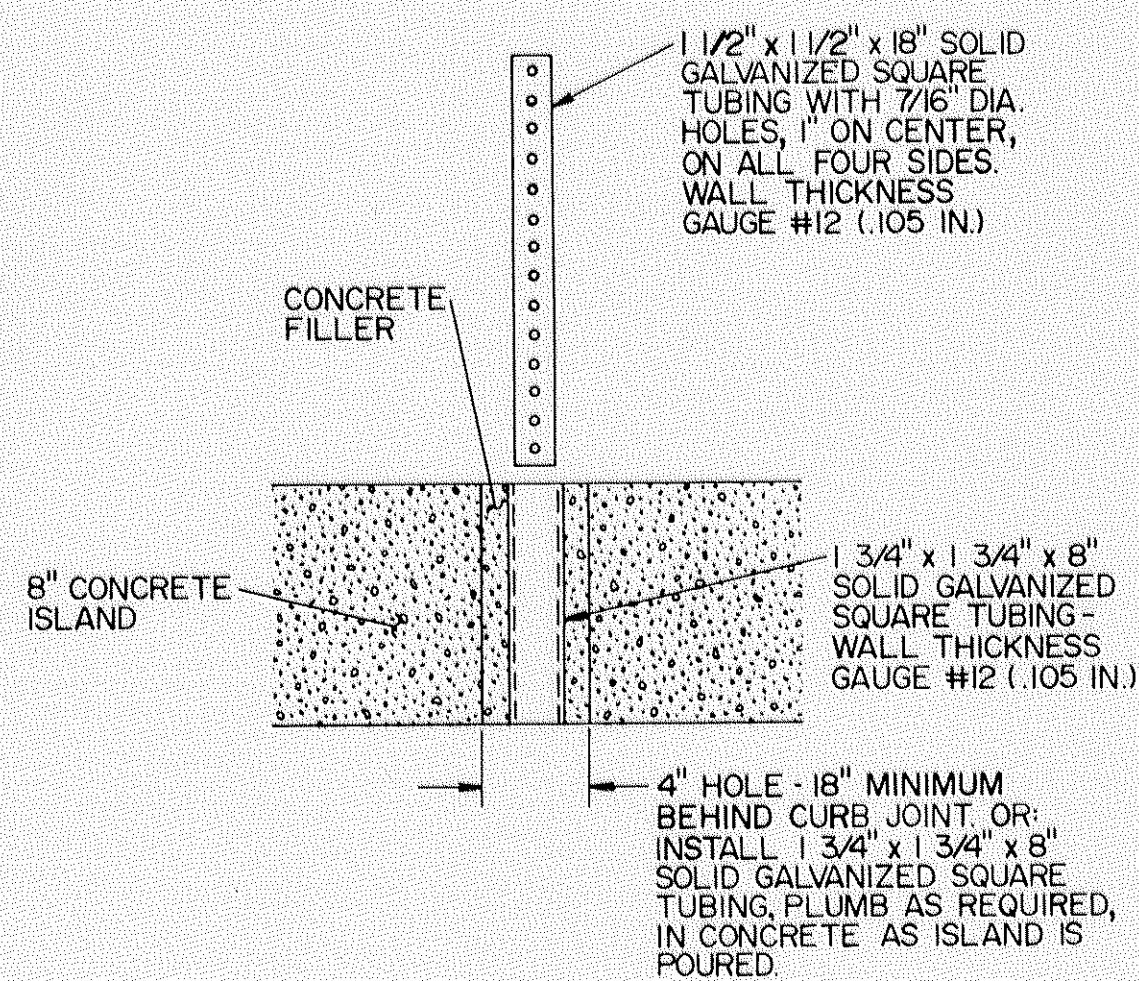


DETAIL "3"

ENLARGED SECTION B-B

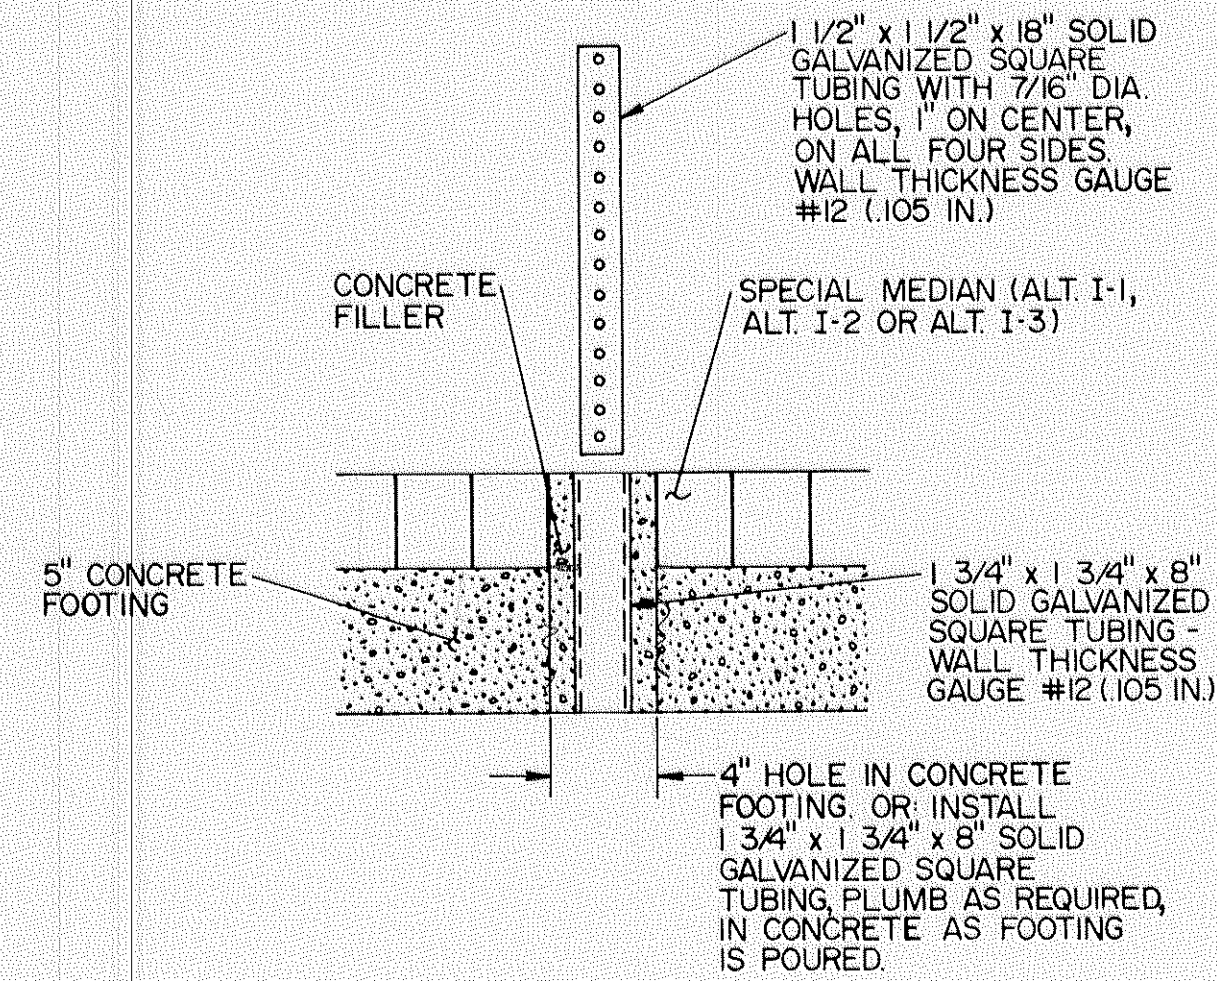


DETAIL "5"

GROUND POST MOUNT SIGN INSTALLATION TYPICAL ISLAND MOUNT BREAK-AWAY SIGN POST INSTALLATION TYPICAL

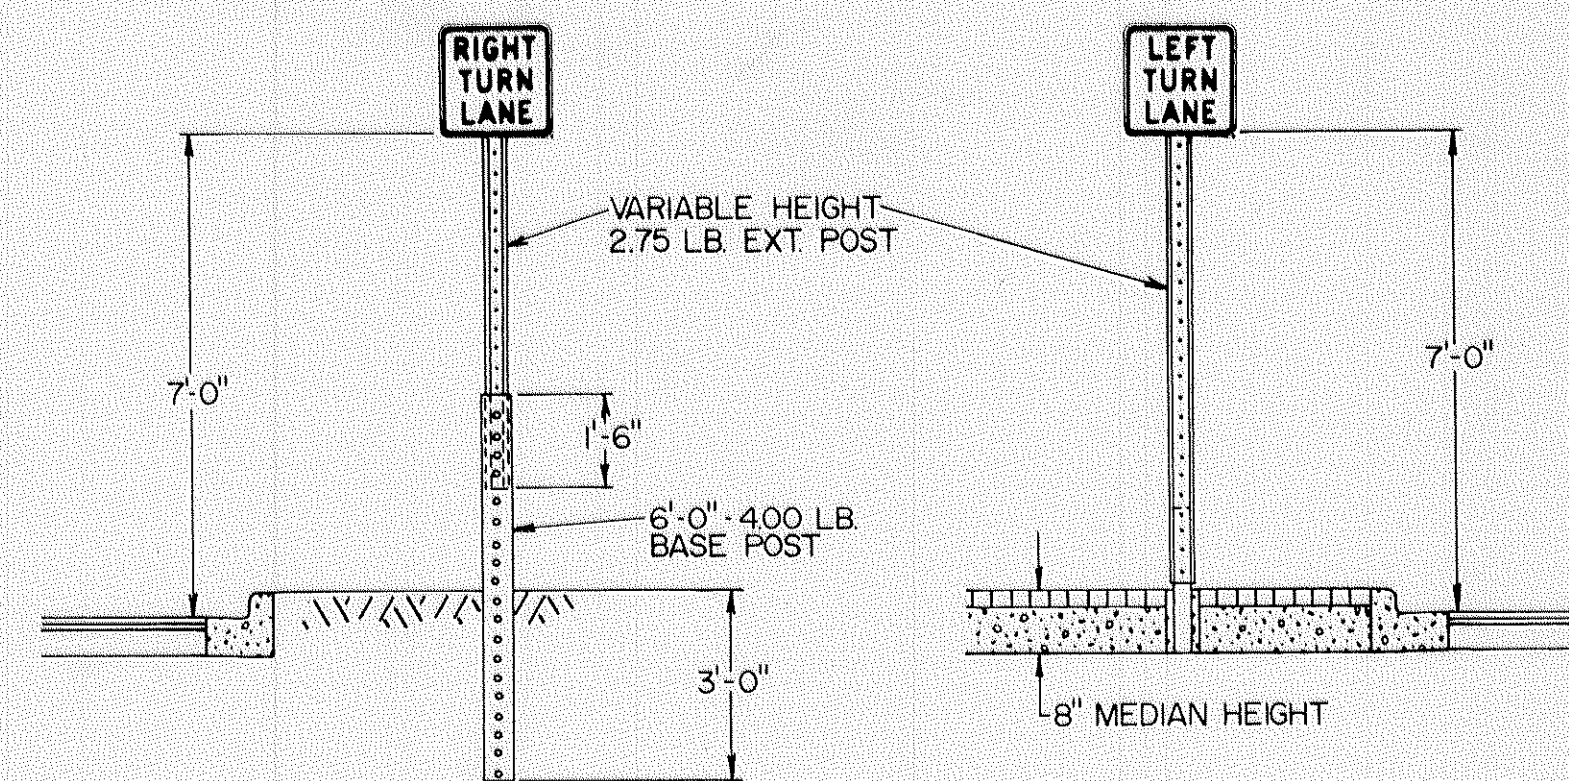


DETAIL "6"

PAVEMENT MESSAGES - LANE DESIGNATION DETAILS

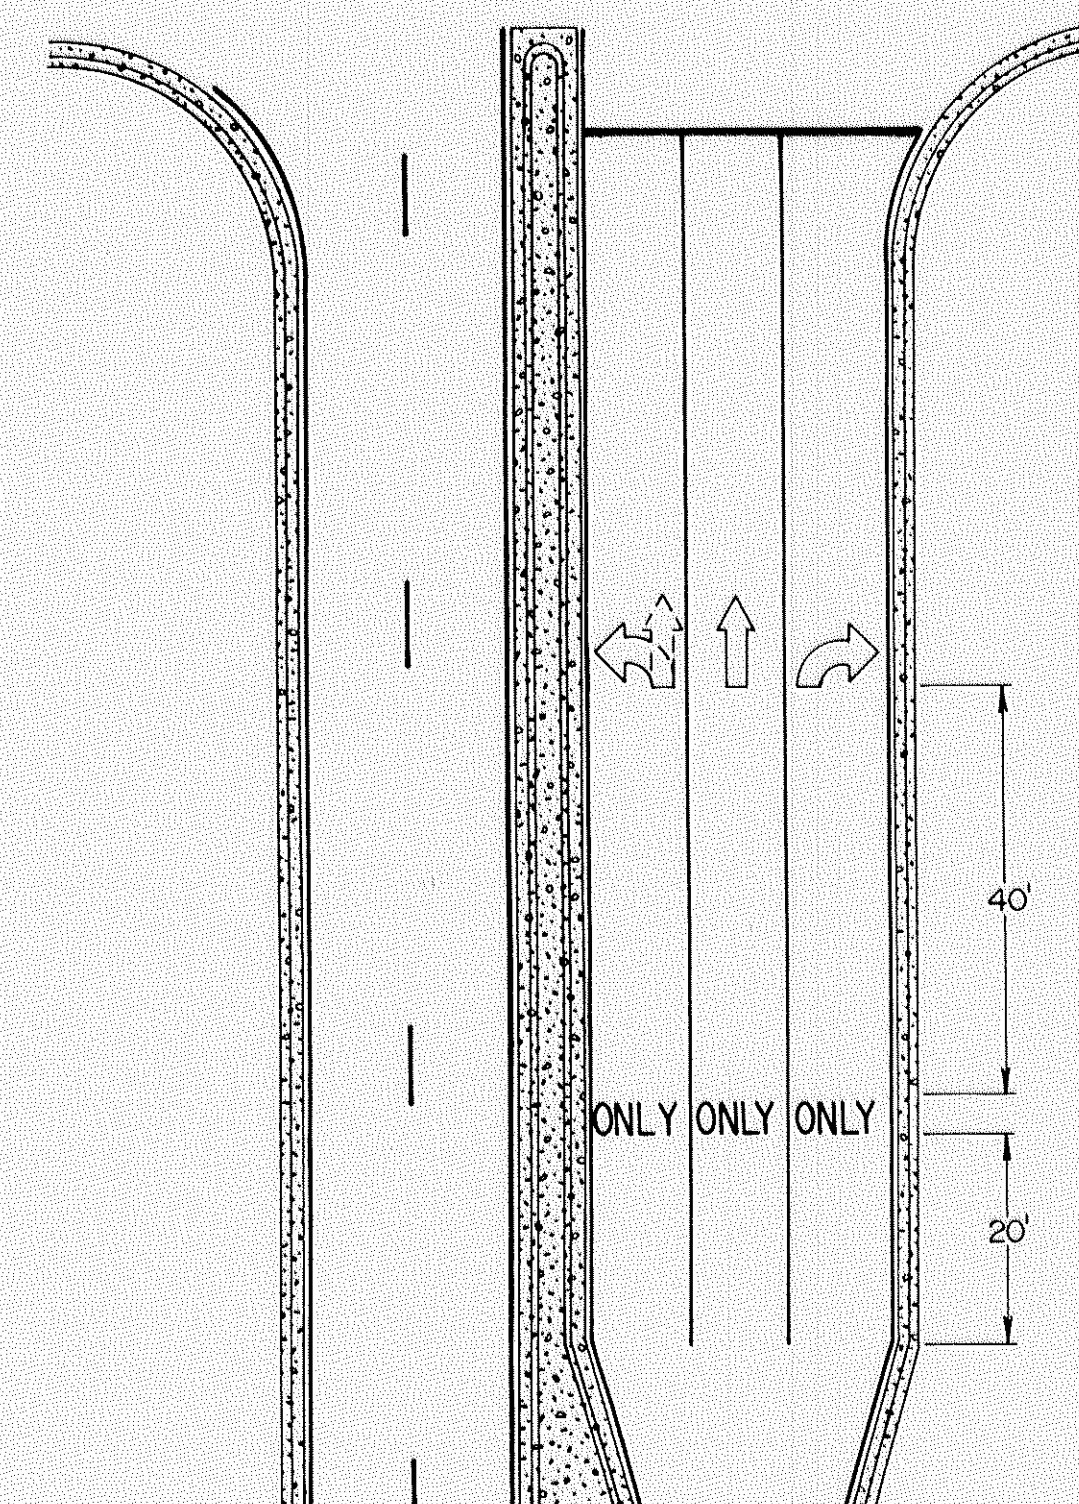

DETAIL "4"

ISLAND MOUNT BREAK AWAY SIGN POST INSTALLATIONS REQUIRING MORE THAN ONE POST (WITHIN AREAS OF BRICK MASONRY PAVING)

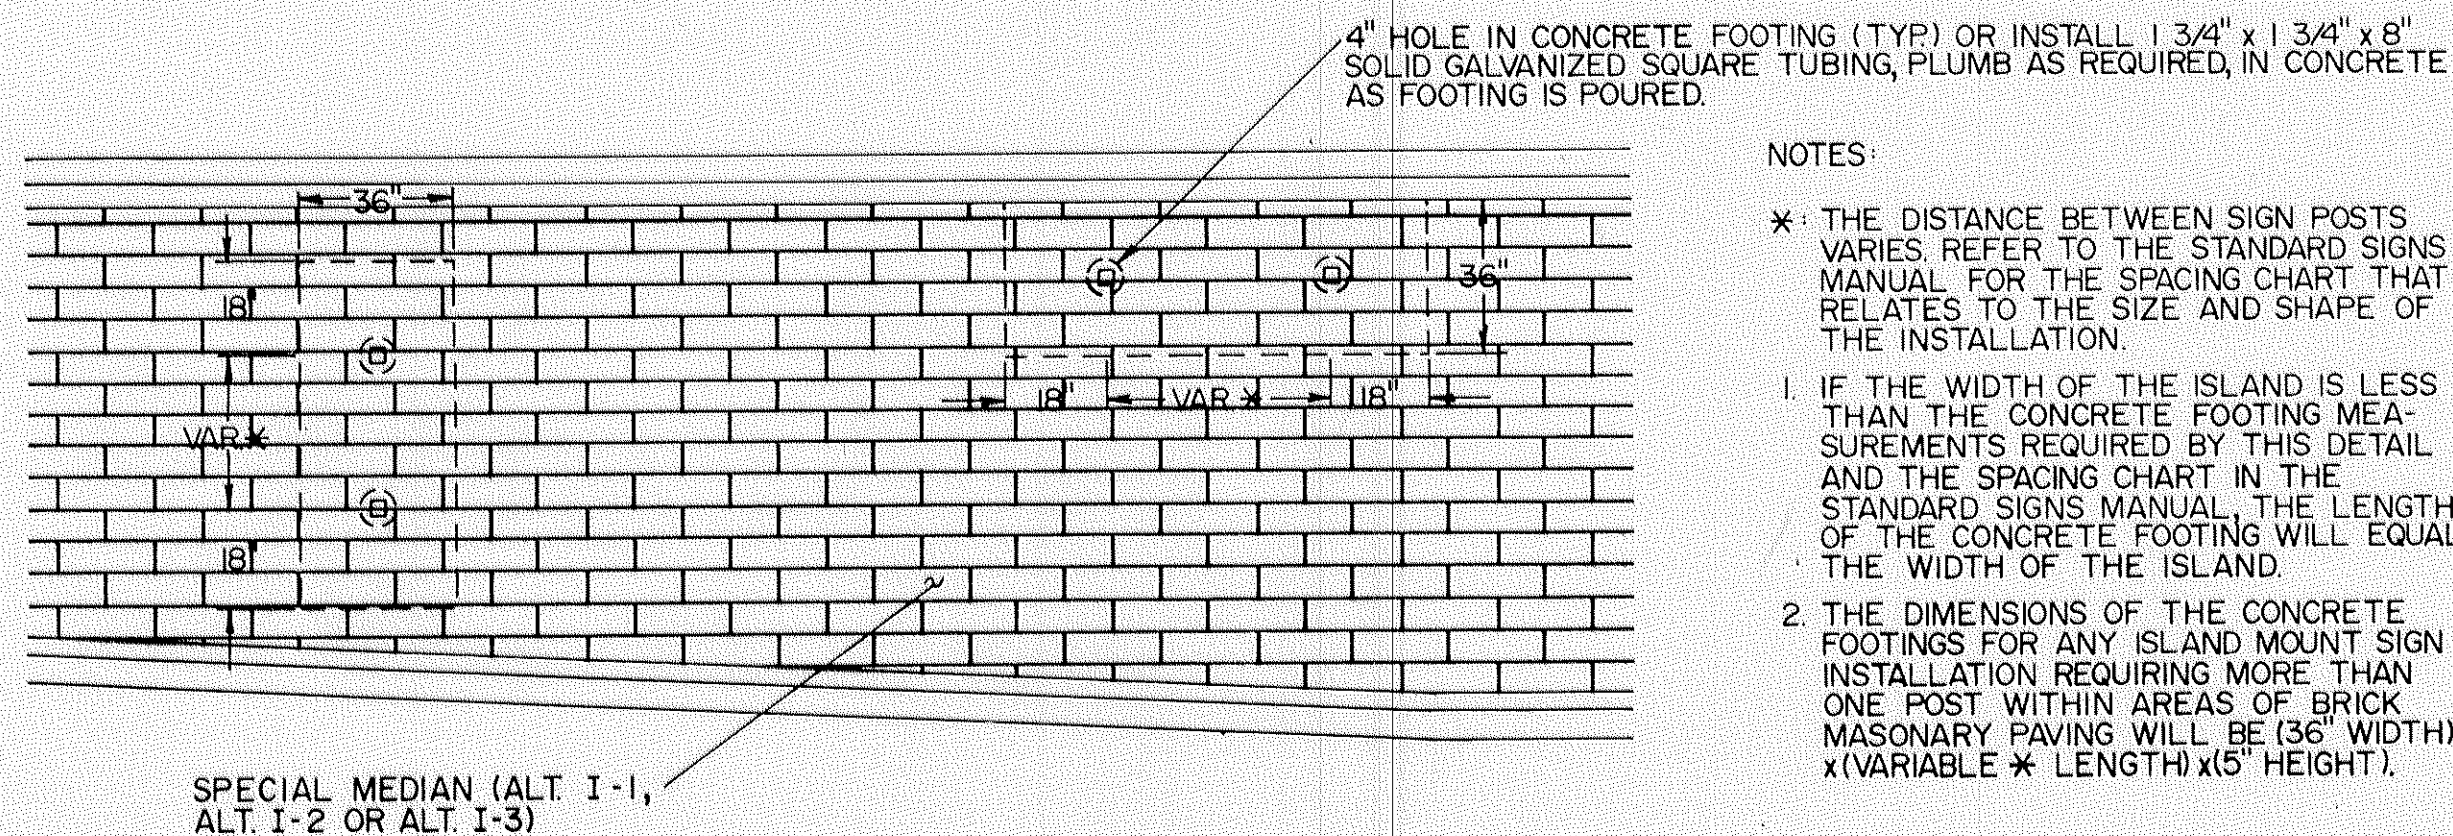

NOTES:

* THE DISTANCE BETWEEN SIGN POSTS VARIES. REFER TO THE STANDARD SIGNS MANUAL FOR THE SPACING CHART THAT RELATES TO THE SIZE AND SHAPE OF THE INSTALLATION.

1. IF THE WIDTH OF THE ISLAND IS LESS THAN THE CONCRETE FOOTING MEASUREMENTS REQUIRED BY THIS DETAIL AND THE SPACING CHART IN THE STANDARD SIGNS MANUAL, THE LENGTH OF THE CONCRETE FOOTING WILL EQUAL THE WIDTH OF THE ISLAND.

2. THE DIMENSIONS OF THE CONCRETE FOOTINGS FOR ANY ISLAND MOUNT SIGN INSTALLATION REQUIRING MORE THAN ONE POST WITHIN AREAS OF BRICK MASONRY PAVING WILL BE (36" WIDTH) x (VARIABLE * LENGTH) x (5" HEIGHT).

3. DASHED LINES REPRESENT THE APPROX. LIMITS OF CONCRETE FOOTINGS TO BE POURED FOR ISLAND MOUNT BREAK-AWAY SIGN POST INSTALLATIONS REQUIRING MORE THAN ONE POST WITHIN SPECIAL MEDIAN AREAS (ALT. I-1, ALT. I-2 OR ALT. I-3)

ARROWS: 6'-11" HIGH WORDS: 8'-0" HIGH

NOTE: SEE SHEETS 34-36 FOR INDIVIDUAL PAVEMENT MESSAGE TYPES AND LOCATIONS. REFER TO THE MINNESOTA MANUAL ON UNIFORM TRAFFIC CONTROL DEVICES FOR LAYOUT SPECIFICATIONS.

HARTMAN
CIRCLE

55


60

65

LOCKE LAKE RD

69TH WAY

MATCH LINE STA. 69+60 SEE BELOW LEFT

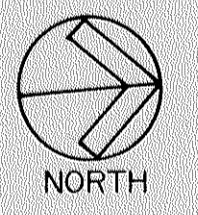

EAST RIVER ROAD - PHASE I TRAFFIC CONTROL
(STA. 54+00 TO STA. 69+60)

NOTES:



- 1. LOCATIONS OF ALL SIGNS ARE APPROXIMATE. EXACT LOCATIONS WILL BE DETERMINED IN THE FIELD BY THE ENGINEER.
- 2. SEE SHEET 53 FOR SIGNING SCHEDULE.
- 3. ALL BARRICADES AND BARRELS WILL BE PROPERLY WEIGHTED WITH SANDBAGS.
- 4. ALL TRAFFIC CONTROL DEVICES SHALL CONFORM TO THE MINNESOTA MANUAL ON UNIFORM TRAFFIC CONTROL DEVICES, INCLUDING APPENDIX B DATED SEPTEMBER, 1985.

MATCH LINE STA. 69+60 SEE ABOVE RIGHT


70TH WAY



71ST WAY

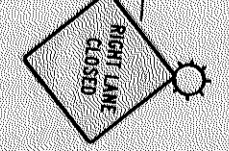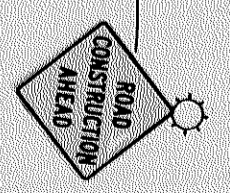

HICKORY DR

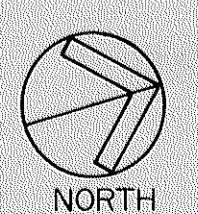

EAST RIVER ROAD - PHASE I TRAFFIC CONTROL
(STA. 69+60 TO STA. 85+00)


MATCH LINE STA. 85+00 SEE SHEET NO.



EAST RIVER ROAD - PHASE I TRAFFIC CONTROL
(STA. 85+00 TO STA. 100+00)

NOTES:

1. LOCATIONS OF ALL SIGNS ARE APPROXIMATE. EXACT LOCATIONS WILL BE DETERMINED IN THE FIELD BY THE ENGINEER.
2. SEE SHEET 53 FOR SIGNING SCHEDULE.
3. ALL BARRICADES AND BARRELS WILL BE PROPERLY WEIGHTED WITH SANDBAGS.
4. ALL TRAFFIC CONTROL DEVICES SHALL CONFORM TO THE MINNESOTA MANUAL ON UNIFORM TRAFFIC CONTROL DEVICES, INCLUDING APPENDIX B DATED SEPTEMBER, 1985.
5. APPROXIMATELY 445 LINEAR FEET OF 4" WHITE LANE TAPE IS REQUIRED FOR THIS PORTION OF PHASE I TRAFFIC CONTROL.
6. DENOTES TO BE USED DURING PHASE I TRAFFIC CONTROL.


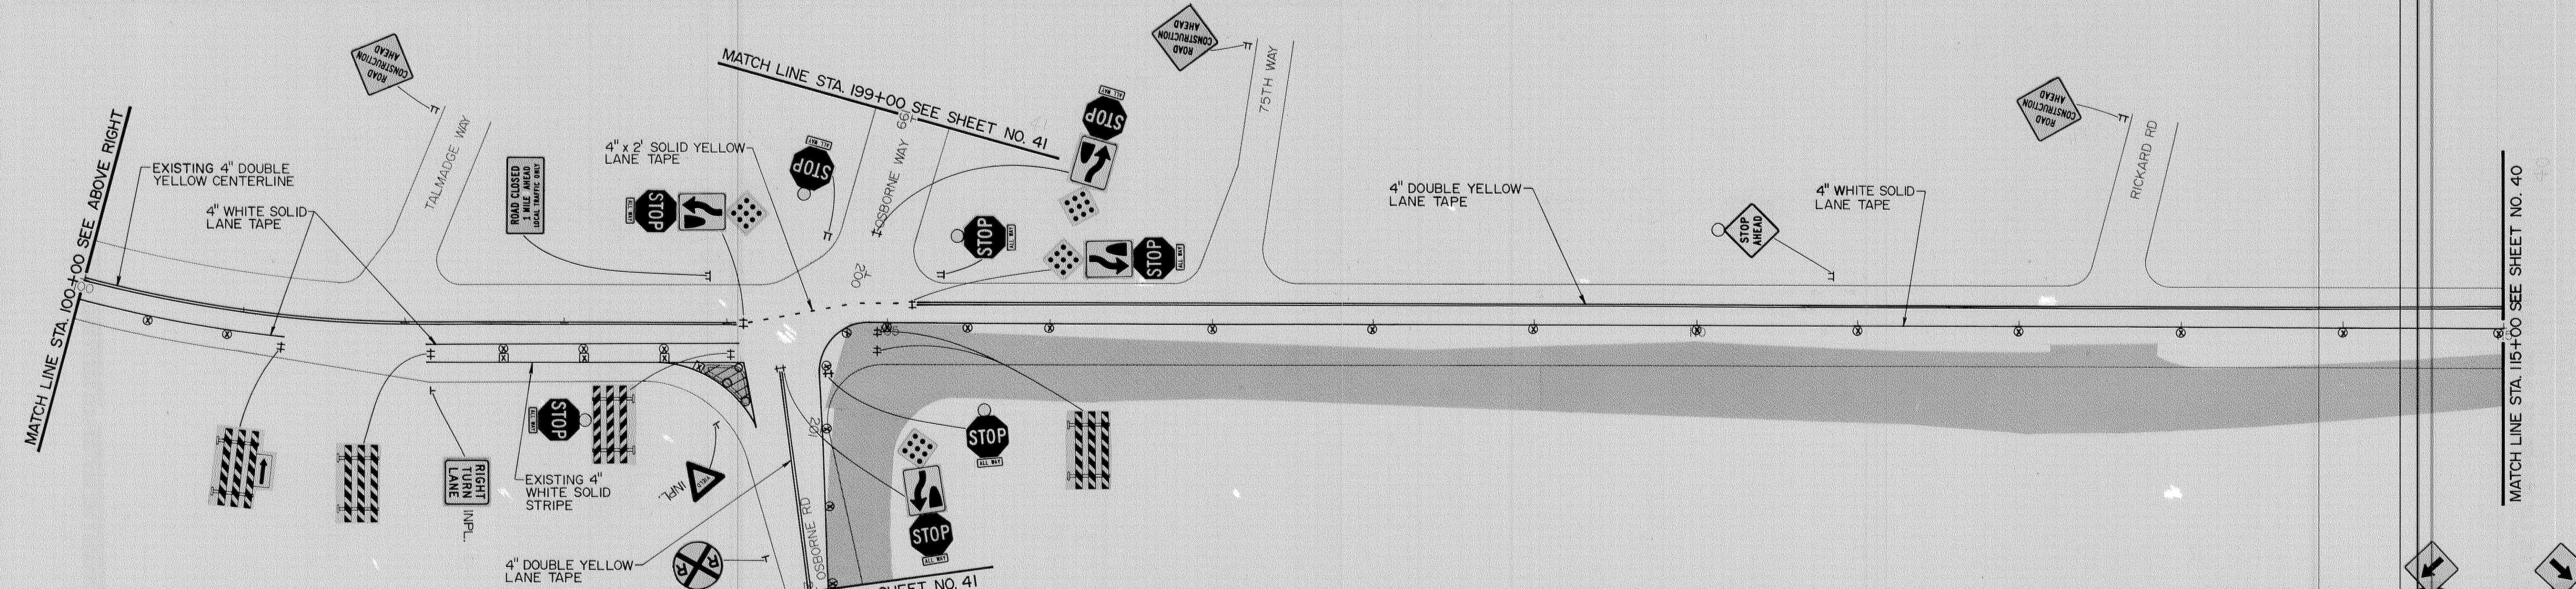


EAST RIVER ROAD - PHASE I TRAFFIC CONTROL
(STA. 100+00 TO STA. 115+00)

OSBORNE ROAD - PHASE I TRAFFIC CONTROL
(STA. 199+00 TO STA. 202+00)

NOTES:



1. DENOTES AREA OF CONCRETE ISLAND REMOVAL TO BE COMPLETED DURING PHASE I.
2. DENOTES AREAS OF CONSTRUCTION TO BE COMPLETED DURING PHASE I.
3. LOCATIONS OF ALL SIGNS ARE APPROXIMATE. EXACT LOCATIONS WILL BE DETERMINED IN THE FIELD BY THE ENGINEER.
4. SEE SHEET 53 FOR SIGNING SCHEDULE.
5. ALL BARRICADES AND BARRELS WILL BE PROPERLY WEIGHTED WITH SANDBAGS.
6. ALL TRAFFIC CONTROL DEVICES SHALL CONFORM TO THE MINNESOTA MANUAL ON UNIFORM TRAFFIC CONTROL DEVICES, INCLUDING APPENDIX B DATED SEPTEMBER, 1985.
7. APPROXIMATELY 1515 LINEAR FEET OF 4" WHITE LANE TAPE AND APPROXIMATELY 2120 LINEAR FEET OF 4" YELLOW LANE TAPE IS REQUIRED FOR THIS PORTION OF PHASE I TRAFFIC CONTROL.
8. DENOTES ; DENOTES ; AND DENOTES DURING PHASE I TRAFFIC CONTROL.

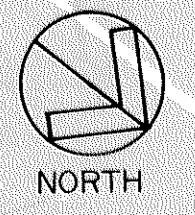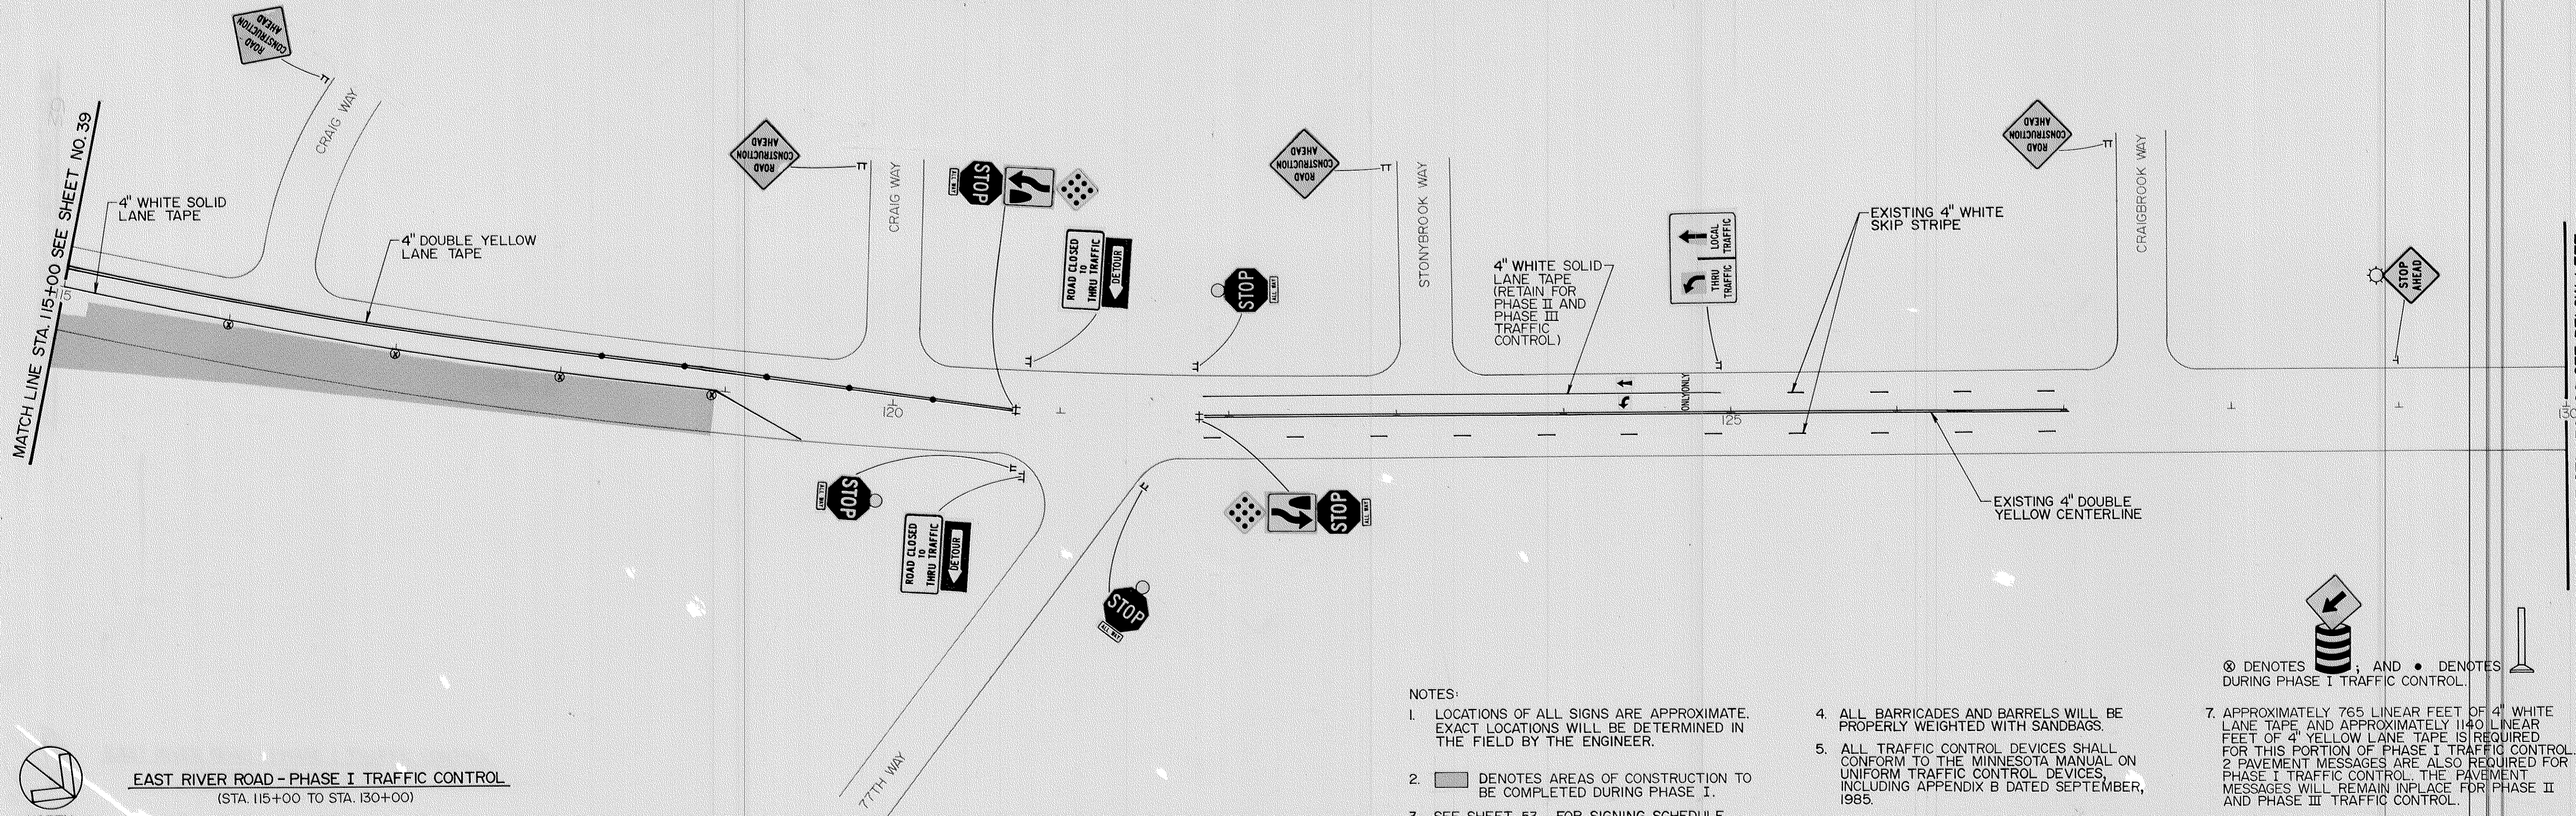

EAST RIVER ROAD - PHASE I TRAFFIC CONTROL
(STA. 115+00 TO STA. 130+00)

- NOTES:**
- LOCATIONS OF ALL SIGNS ARE APPROXIMATE. EXACT LOCATIONS WILL BE DETERMINED IN THE FIELD BY THE ENGINEER.
 - DENOTES AREAS OF CONSTRUCTION TO BE COMPLETED DURING PHASE I.
 - SEE SHEET 53 FOR SIGNING SCHEDULE.
 - ALL BARRICADES AND BARRELS WILL BE PROPERLY WEIGHTED WITH SANDBAGS.
 - ALL TRAFFIC CONTROL DEVICES SHALL CONFORM TO THE MINNESOTA MANUAL ON UNIFORM TRAFFIC CONTROL DEVICES, INCLUDING APPENDIX B DATED SEPTEMBER, 1985.
 - APPROXIMATELY 765 LINEAR FEET OF 4" WHITE LANE TAPE AND APPROXIMATELY 1140 LINEAR FEET OF 4" YELLOW LANE TAPE IS REQUIRED FOR THIS PORTION OF PHASE I TRAFFIC CONTROL. 2 PAVEMENT MESSAGES ARE ALSO REQUIRED FOR PHASE I TRAFFIC CONTROL. THE PAVEMENT MESSAGES WILL REMAIN IN PLACE FOR PHASE II AND PHASE III TRAFFIC CONTROL.



⊗ DENOTES BARRICADE; AND • DENOTES DURING PHASE I TRAFFIC CONTROL.

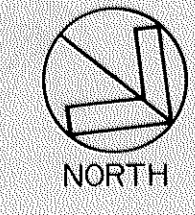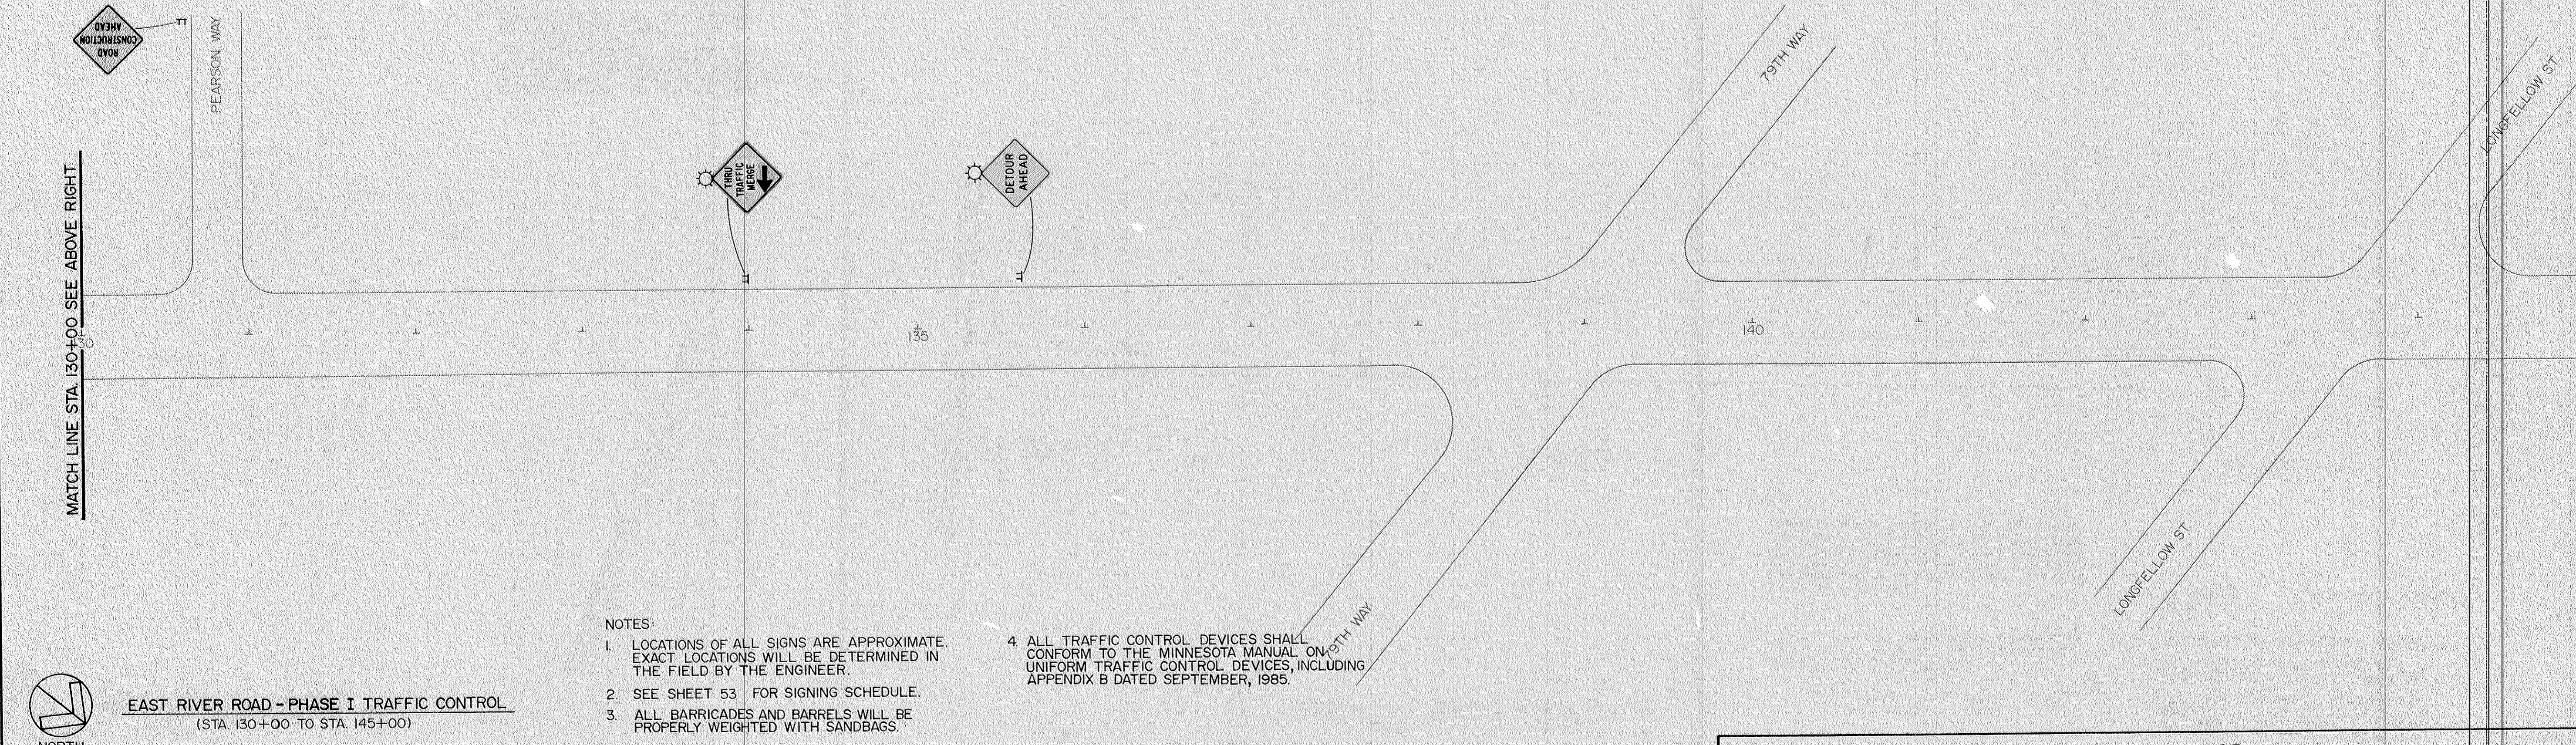

EAST RIVER ROAD - PHASE I TRAFFIC CONTROL
(STA. 130+00 TO STA. 145+00)

- NOTES:**
- LOCATIONS OF ALL SIGNS ARE APPROXIMATE. EXACT LOCATIONS WILL BE DETERMINED IN THE FIELD BY THE ENGINEER.
 - SEE SHEET 53 FOR SIGNING SCHEDULE.
 - ALL BARRICADES AND BARRELS WILL BE PROPERLY WEIGHTED WITH SANDBAGS.
 - ALL TRAFFIC CONTROL DEVICES SHALL CONFORM TO THE MINNESOTA MANUAL ON UNIFORM TRAFFIC CONTROL DEVICES, INCLUDING APPENDIX B DATED SEPTEMBER, 1985.



MATCH LINE STA. 145+00 SEE SHEET NO. 40

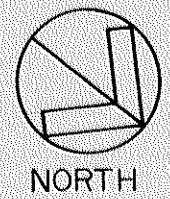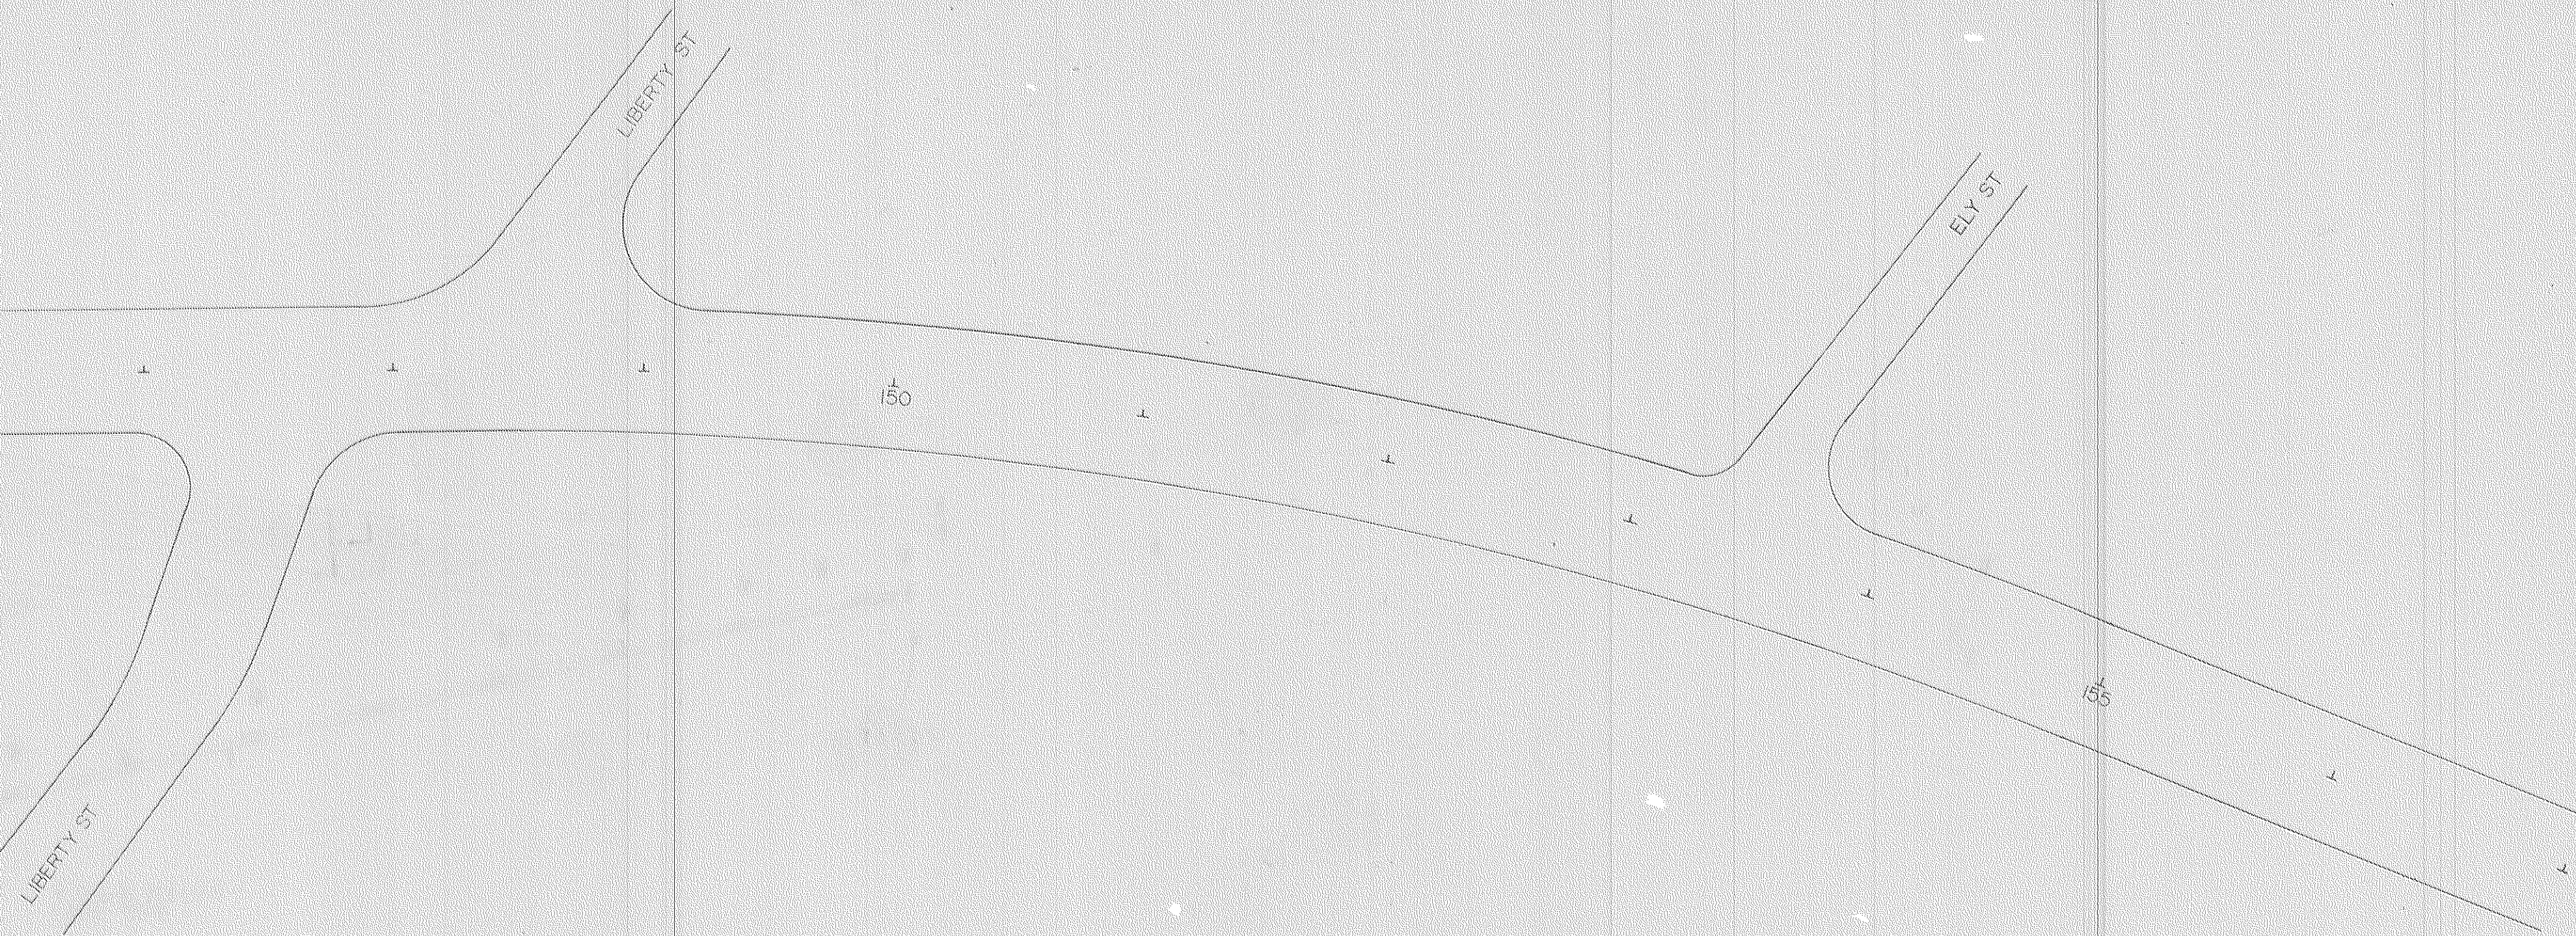



EAST RIVER ROAD - PHASE I TRAFFIC CONTROL
(STA. 145+00 TO STA. 157+00)

NOTES:

1. LOCATIONS OF ALL SIGNS ARE APPROXIMATE. EXACT LOCATIONS WILL BE DETERMINED IN THE FIELD BY THE ENGINEER.
2. SEE SHEET 53 FOR SIGNING SCHEDULE.
3. ALL BARRICADES WILL BE PROPERLY WEIGHTED WITH SANDBAGS.
4. ALL TRAFFIC CONTROL DEVICES SHALL CONFORM TO THE MINNESOTA MANUAL ON UNIFORM TRAFFIC CONTROL DEVICES, INCLUDING APPENDIX B DATED SEPTEMBER, 1985.

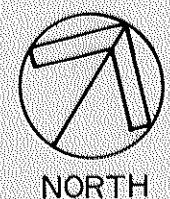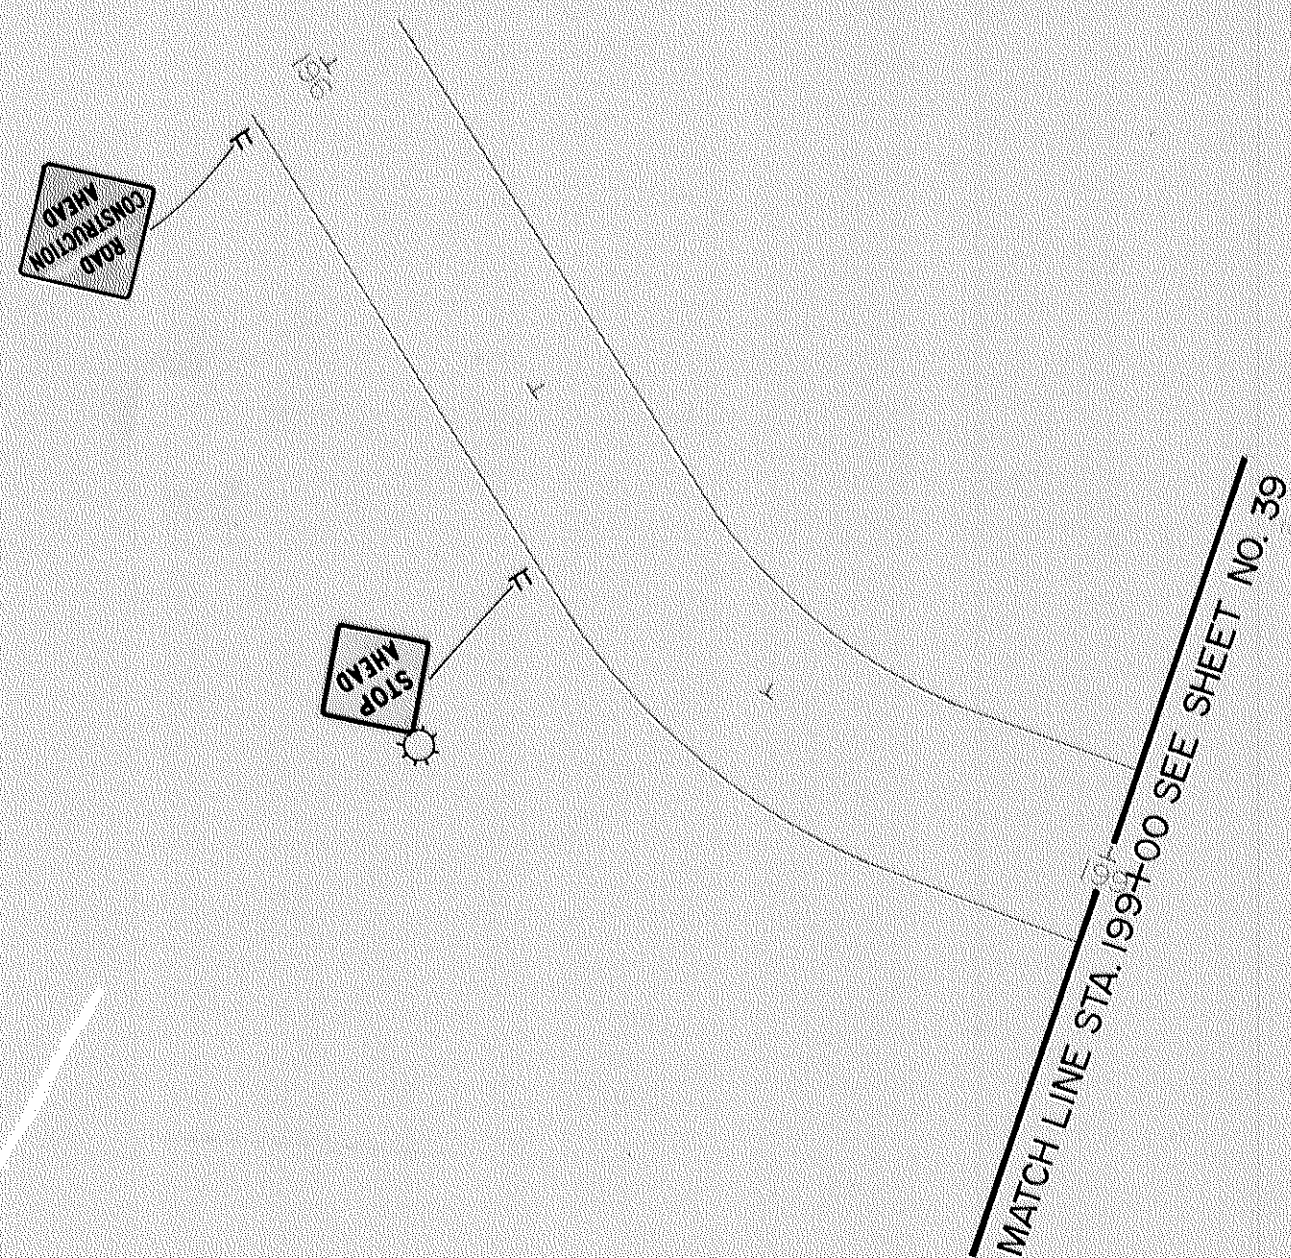

OSBORNE WAY - PHASE I TRAFFIC CONTROL
(STA. 196+00 TO STA. 199+00)

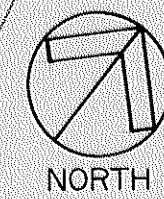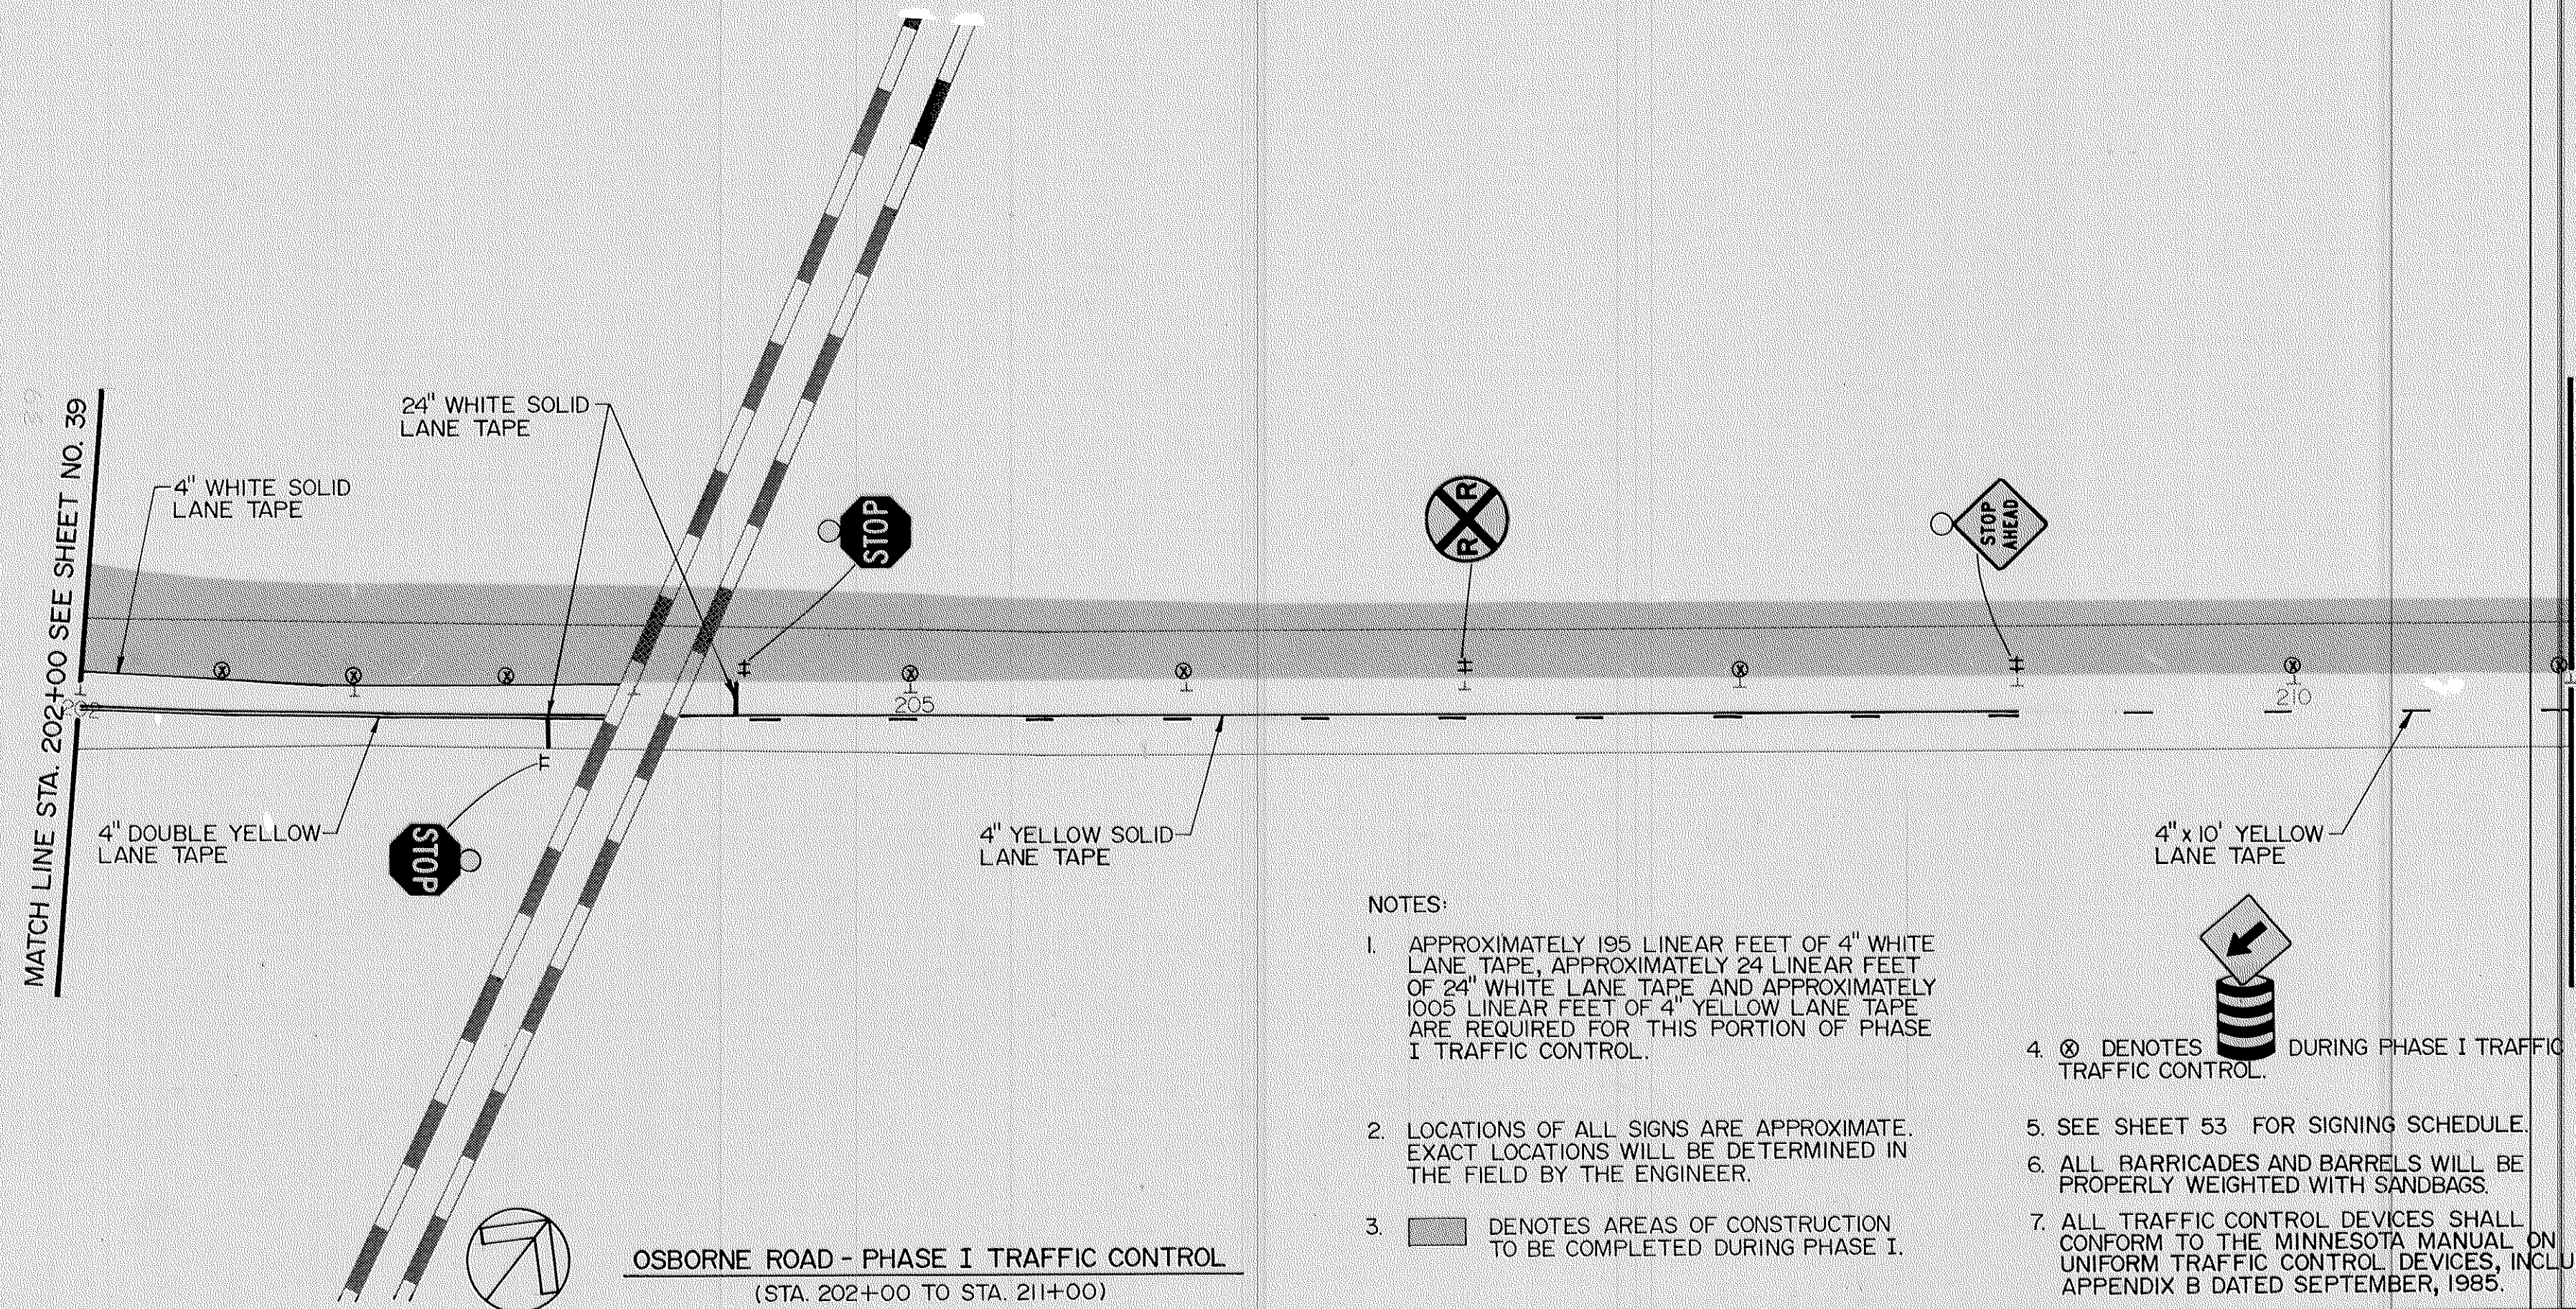

OSBORNE ROAD - PHASE I TRAFFIC CONTROL
(STA. 202+00 TO STA. 211+00)

NOTES:


1. APPROXIMATELY 195 LINEAR FEET OF 4" WHITE LANE TAPE, APPROXIMATELY 24 LINEAR FEET OF 24" WHITE LANE TAPE AND APPROXIMATELY 1005 LINEAR FEET OF 4" YELLOW LANE TAPE ARE REQUIRED FOR THIS PORTION OF PHASE I TRAFFIC CONTROL.
2. LOCATIONS OF ALL SIGNS ARE APPROXIMATE. EXACT LOCATIONS WILL BE DETERMINED IN THE FIELD BY THE ENGINEER.
3. DENOTES AREAS OF CONSTRUCTION TO BE COMPLETED DURING PHASE I.
4. DENOTES DURING PHASE I TRAFFIC CONTROL.
5. SEE SHEET 53 FOR SIGNING SCHEDULE.
6. ALL BARRICADES AND BARRELS WILL BE PROPERLY WEIGHTED WITH SANDBAGS.
7. ALL TRAFFIC CONTROL DEVICES SHALL CONFORM TO THE MINNESOTA MANUAL ON UNIFORM TRAFFIC CONTROL DEVICES, INCLUDING APPENDIX B DATED SEPTEMBER, 1985.

MATCH LINE STA. 211+00 SEE SHEET NO. 42


MATCH LINE STA. 211+00 SEE SHEET NO. 41

4" x 10' YELLOW LANE TAPE







4" SOLID YELLOW LANE TAPE

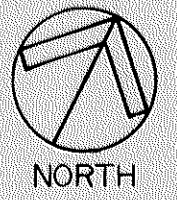


OSBORNE ROAD - PHASE I TRAFFIC CONTROL
(STA. 211+00 TO STA. 221+00)

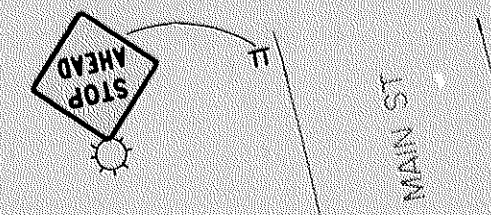

MAIN ST

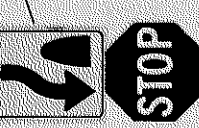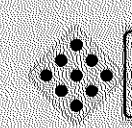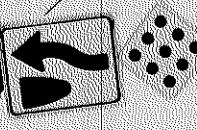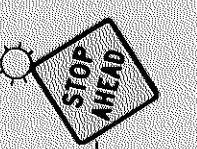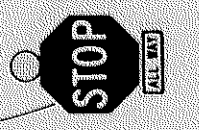
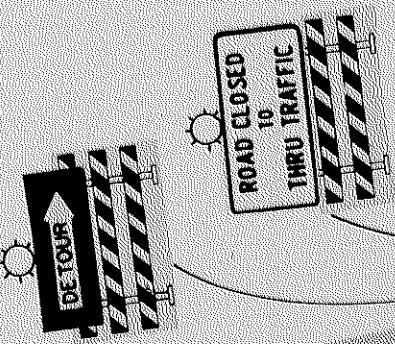


COMMERCE LN

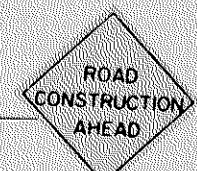



NOTES:

- 1. LOCATIONS OF ALL SIGNS ARE APPROXIMATE. EXACT LOCATIONS WILL BE DETERMINED IN THE FIELD BY THE ENGINEER.
- 2. DENOTES AREAS OF CONSTRUCTION TO BE COMPLETED DURING PHASE I.
- 3. SEE SHEET 53 FOR SIGNING SCHEDULE.
- 4. ALL BARRICADES AND BARRELS WILL BE PROPERLY WEIGHTED WITH SANDBAGS.
- 5. ALL TRAFFIC CONTROL DEVICES SHALL CONFORM TO THE MINNESOTA MANUAL ON UNIFORM TRAFFIC CONTROL DEVICES, INCLUDING APPENDIX B DATED SEPTEMBER, 1985.
- 6. APPROXIMATELY 550 LINEAR FEET OF 4" YELLOW LANE TAPE ARE REQUIRED FOR THIS PORTION OF PHASE I TRAFFIC CONTROL.
- 7. DENOTES TRAFFIC CONTROL DURING PHASE I.

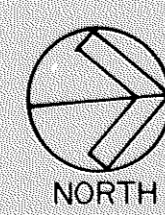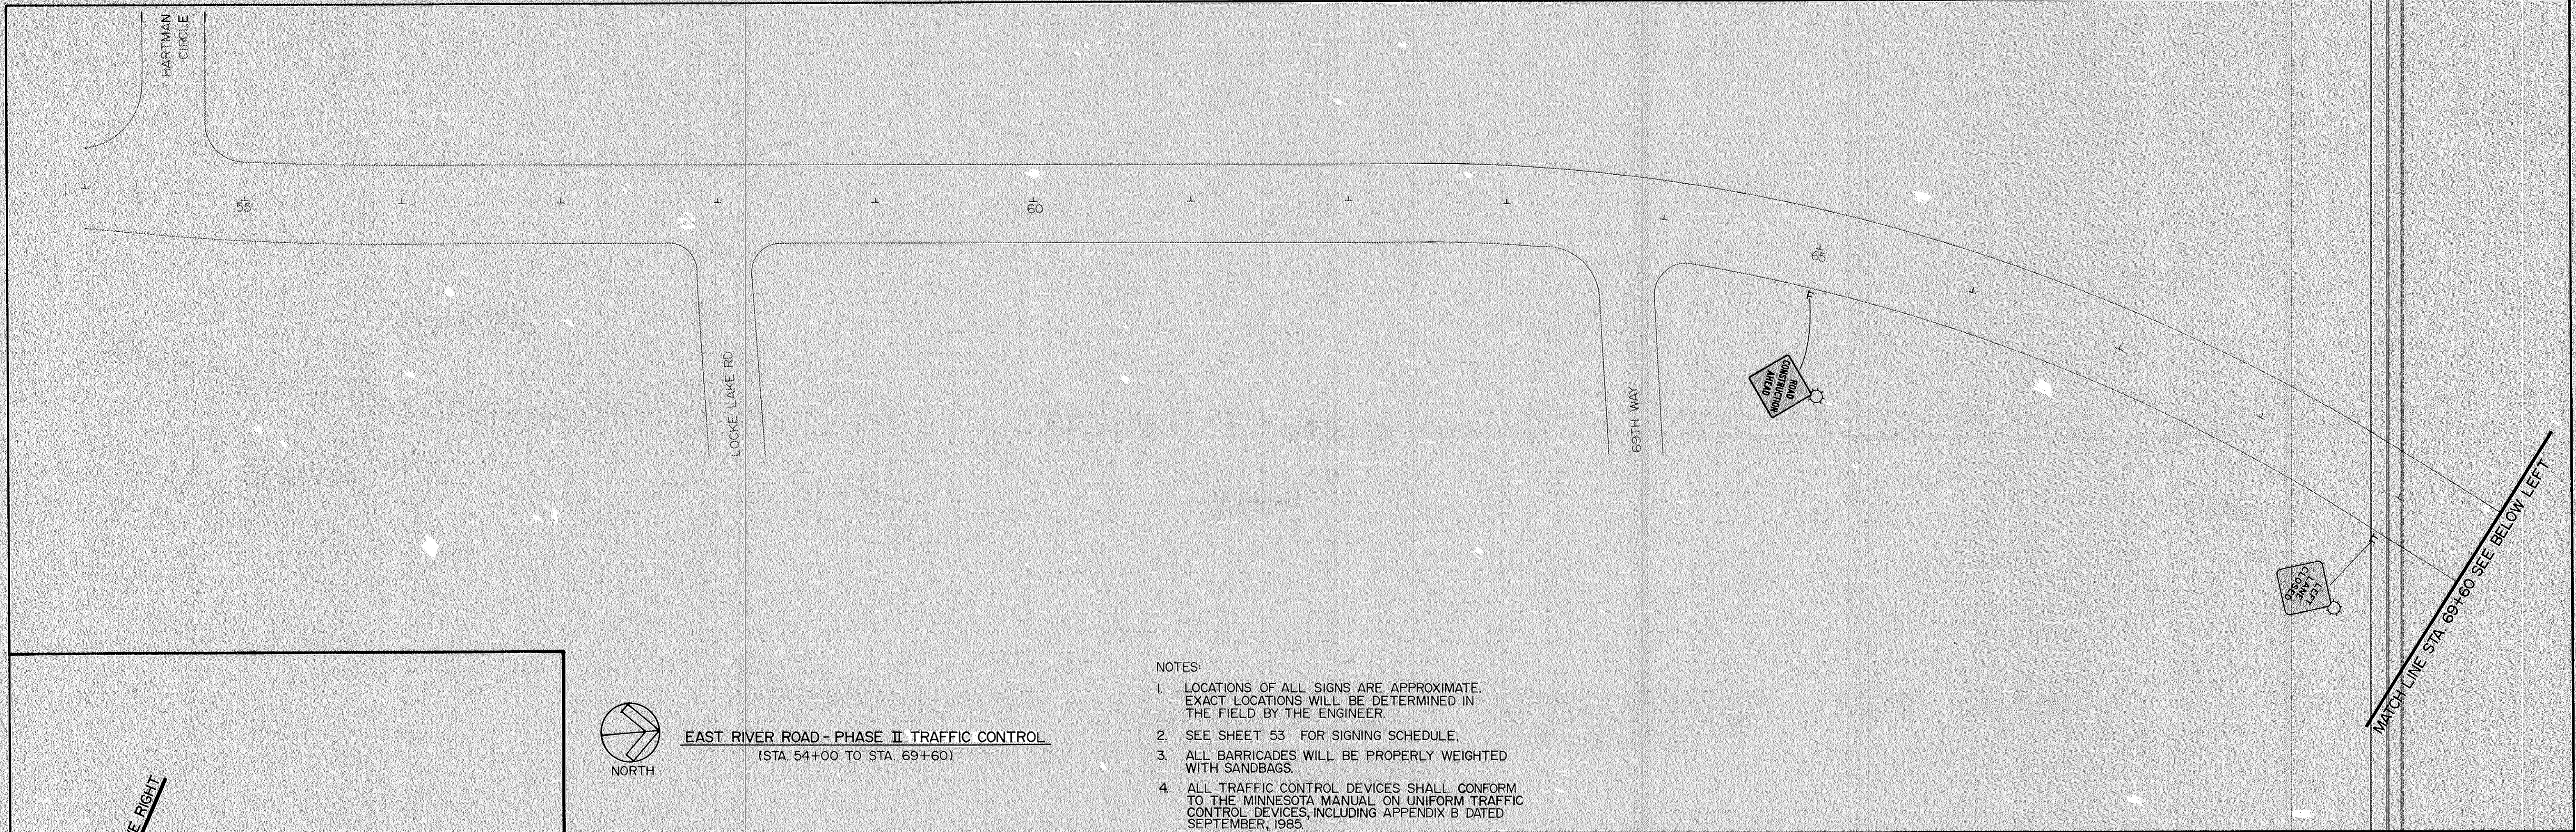


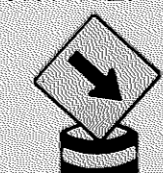
EAST RIVER ROAD - PHASE II TRAFFIC CONTROL
(STA. 54+00 TO STA. 69+60)

- NOTES:
1. LOCATIONS OF ALL SIGNS ARE APPROXIMATE. EXACT LOCATIONS WILL BE DETERMINED IN THE FIELD BY THE ENGINEER.
 2. SEE SHEET 53 FOR SIGNING SCHEDULE.
 3. ALL BARRICADES WILL BE PROPERLY WEIGHTED WITH SANDBAGS.
 4. ALL TRAFFIC CONTROL DEVICES SHALL CONFORM TO THE MINNESOTA MANUAL ON UNIFORM TRAFFIC CONTROL DEVICES, INCLUDING APPENDIX B DATED SEPTEMBER, 1985.

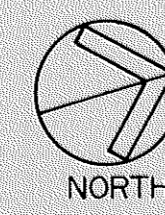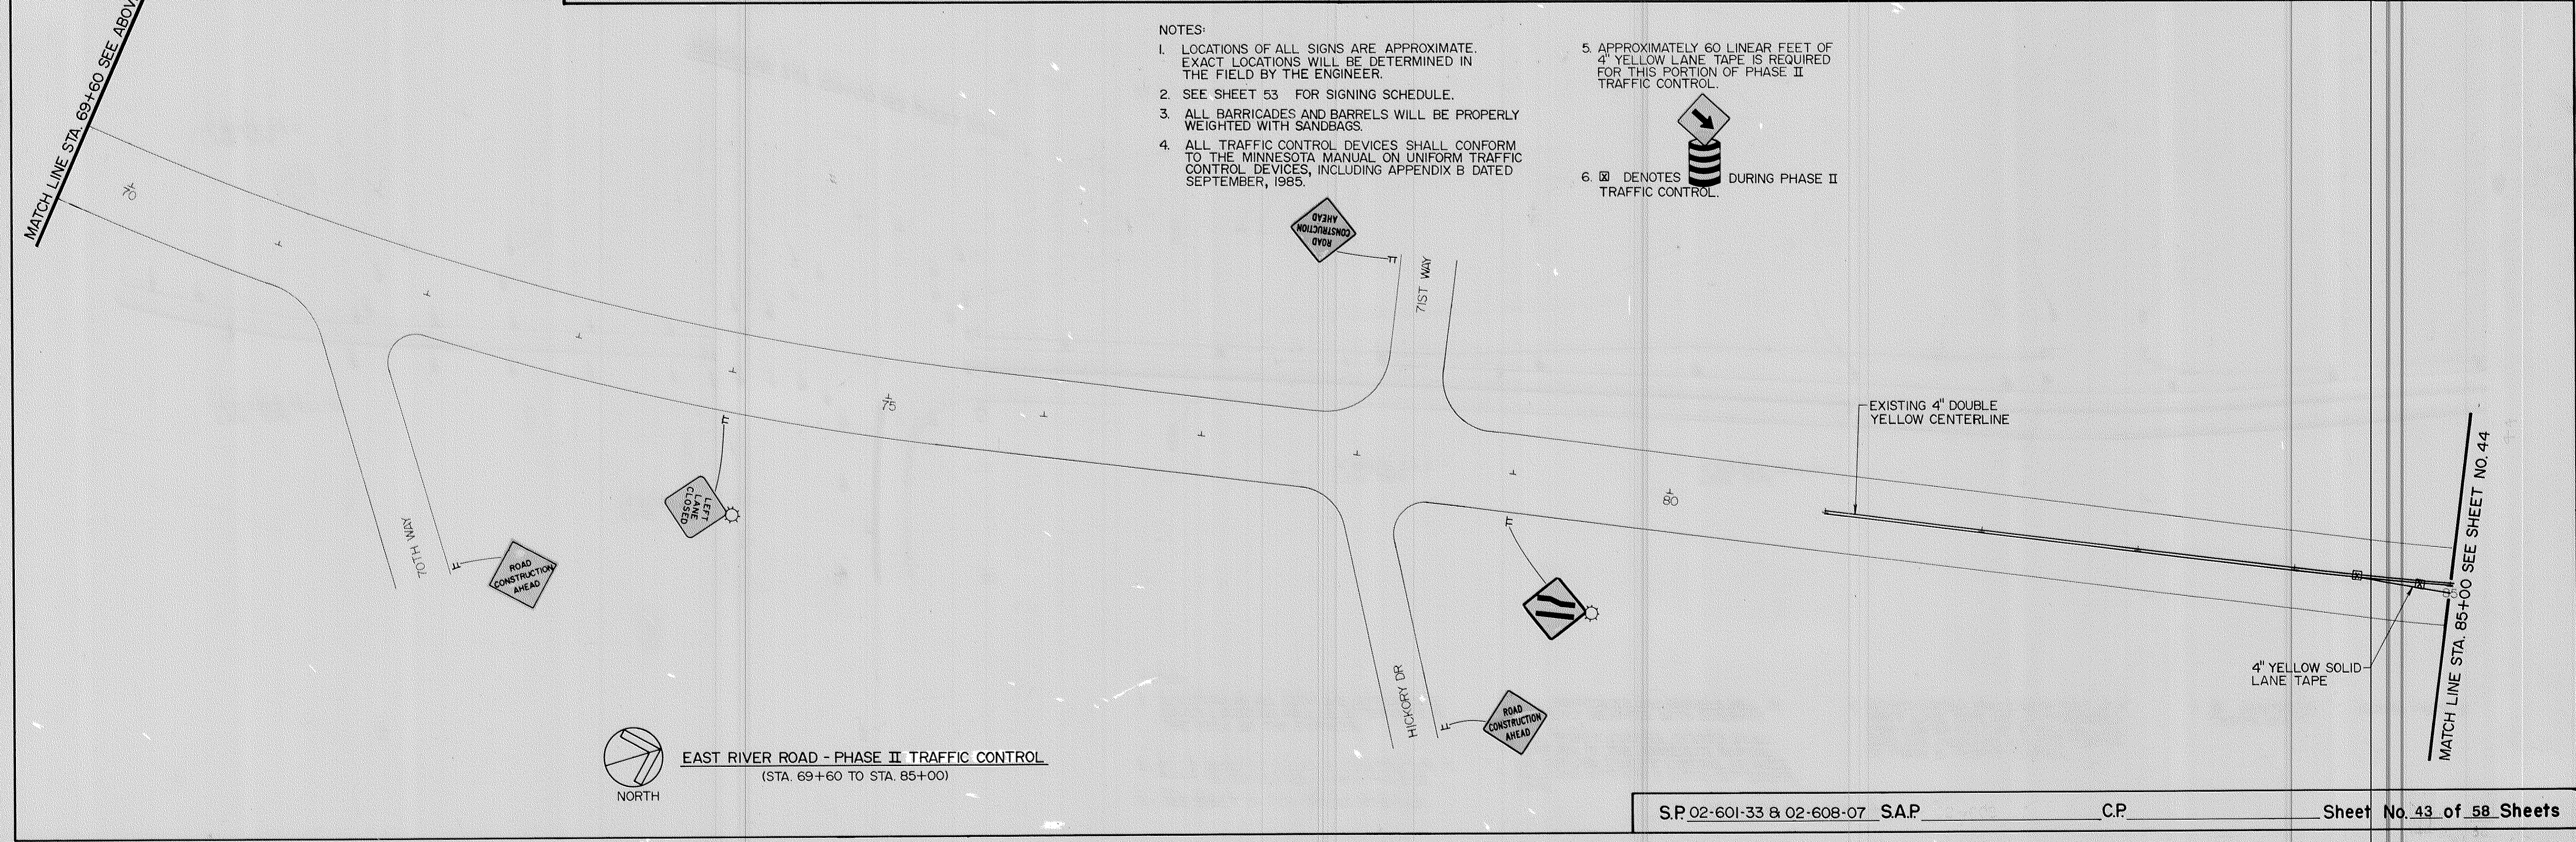


EAST RIVER ROAD - PHASE II TRAFFIC CONTROL
(STA. 69+60 TO STA. 85+00)

- NOTES:
1. LOCATIONS OF ALL SIGNS ARE APPROXIMATE. EXACT LOCATIONS WILL BE DETERMINED IN THE FIELD BY THE ENGINEER.
 2. SEE SHEET 53 FOR SIGNING SCHEDULE.
 3. ALL BARRICADES AND BARRELS WILL BE PROPERLY WEIGHTED WITH SANDBAGS.
 4. ALL TRAFFIC CONTROL DEVICES SHALL CONFORM TO THE MINNESOTA MANUAL ON UNIFORM TRAFFIC CONTROL DEVICES, INCLUDING APPENDIX B DATED SEPTEMBER, 1985.
 5. APPROXIMATELY 60 LINEAR FEET OF 4" YELLOW LANE TAPE IS REQUIRED FOR THIS PORTION OF PHASE II TRAFFIC CONTROL.
 6.  DENOTES DURING PHASE II TRAFFIC CONTROL.



EXISTING 4" DOUBLE YELLOW CENTERLINE


4" YELLOW SOLID LANE TAPE

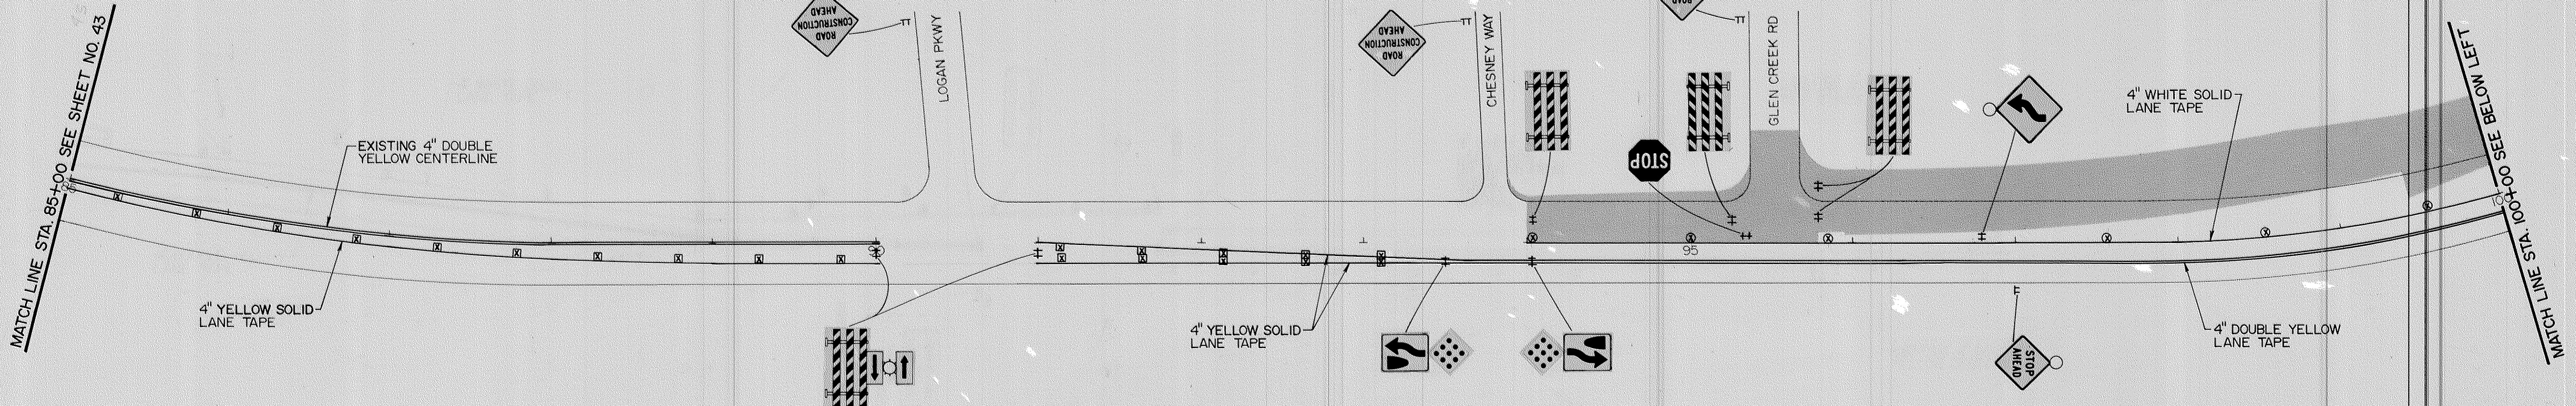

EAST RIVER ROAD - PHASE II TRAFFIC CONTROL
(STA. 85+00 TO STA. 100+00)

NOTES:

1. LOCATIONS OF ALL SIGNS ARE APPROXIMATE. EXACT LOCATIONS WILL BE DETERMINED IN THE FIELD BY THE ENGINEER.
2. DENOTES AREAS OF CONSTRUCTION TO BE COMPLETED DURING PHASE II.
3. SEE SHEET 53 FOR SIGNING SCHEDULE.
4. ALL BARRICADES AND BARRELS WILL BE PROPERLY WEIGHTED WITH SANDBAGS.
5. ALL TRAFFIC CONTROL DEVICES SHALL CONFORM TO THE MINNESOTA MANUAL ON UNIFORM TRAFFIC CONTROL DEVICES, INCLUDING APPENDIX B DATED SEPTEMBER, 1985.
6. APPROXIMATELY 600 LINEAR FEET OF 4" WHITE LANE TAPE AND APPROXIMATELY 2300 LINEAR FEET OF 4" YELLOW LANE TAPE ARE REQUIRED FOR THIS PORTION OF PHASE II TRAFFIC CONTROL.
7. DENOTES ; AND DENOTES DURING PHASE II TRAFFIC CONTROL.

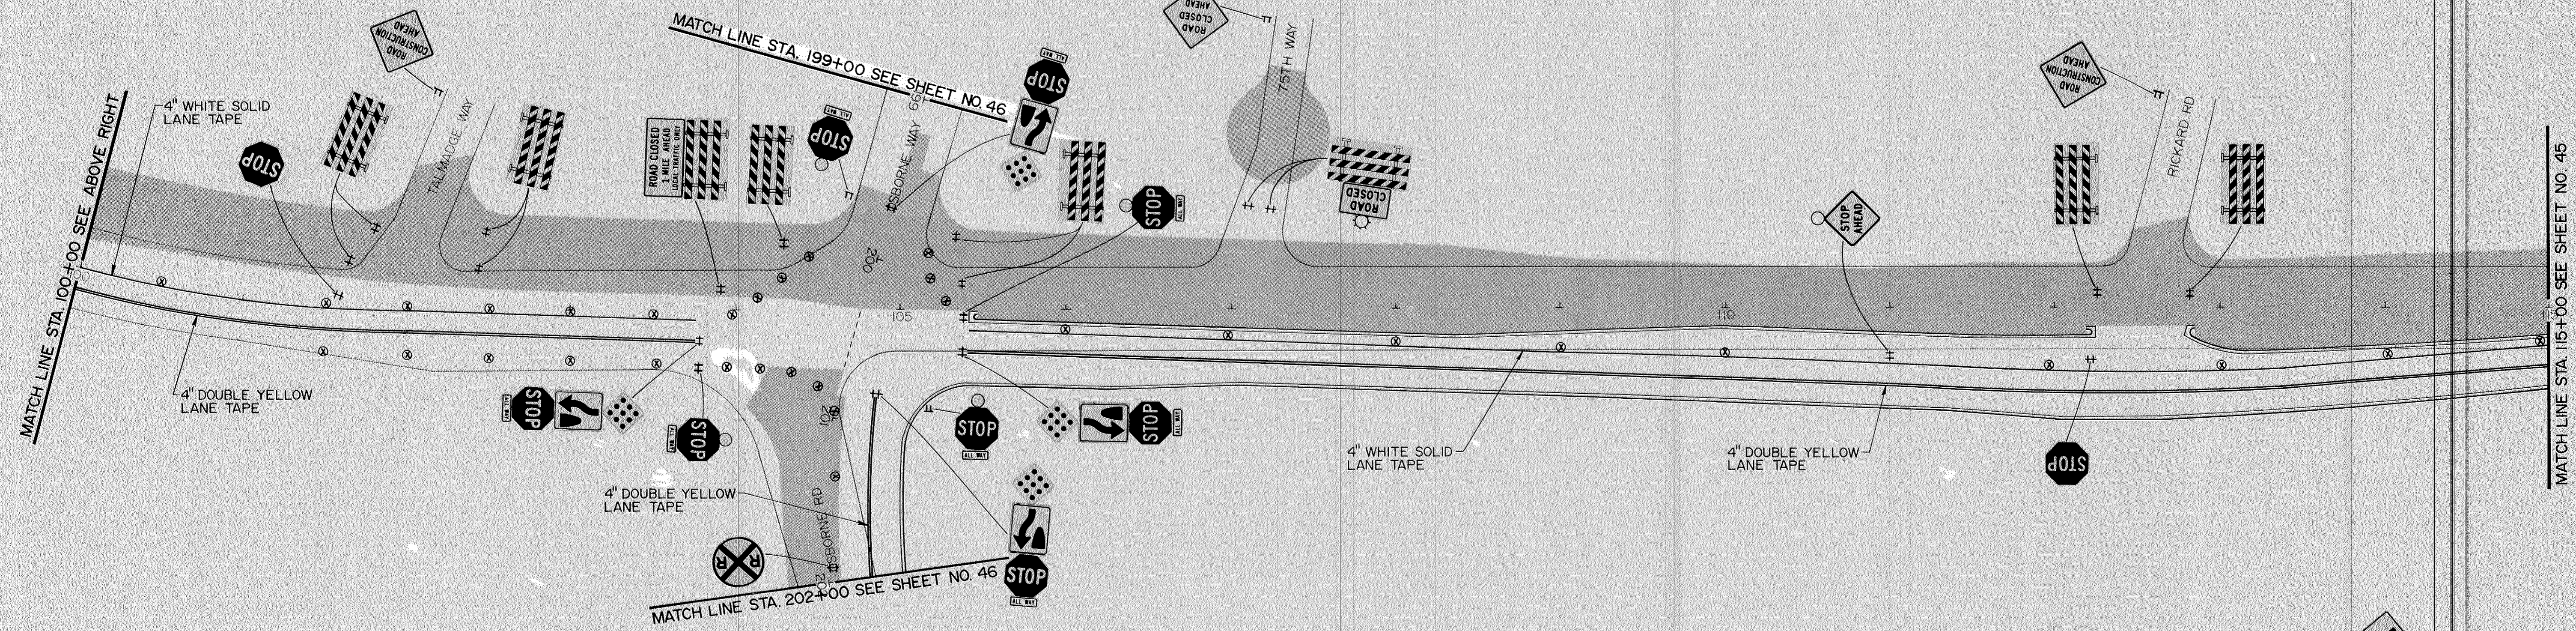


EAST RIVER ROAD - PHASE II TRAFFIC CONTROL
(STA. 100+00 TO STA. 115+00)

OSBORNE ROAD - PHASE II TRAFFIC CONTROL
(STA. 199+00 TO STA. 202+00)

NOTES:

1. LOCATIONS OF ALL SIGNS ARE APPROXIMATE. EXACT LOCATIONS WILL BE DETERMINED IN THE FIELD BY THE ENGINEER.
2. DENOTES AREAS OF CONSTRUCTION TO BE COMPLETED DURING PHASE II.
3. SEE SHEET 53 FOR SIGNING SCHEDULE.
4. ALL BARRICADES AND BARRELS WILL BE PROPERLY WEIGHTED WITH SANDBAGS.
5. ALL TRAFFIC CONTROL DEVICES SHALL CONFORM TO THE MINNESOTA MANUAL ON UNIFORM TRAFFIC CONTROL DEVICES, INCLUDING APPENDIX B DATED SEPTEMBER, 1985.
6. APPROXIMATELY 1340 LINEAR FEET OF 4" WHITE LANE TAPE AND APPROXIMATELY 2910 LINEAR FEET OF 4" YELLOW LANE TAPE ARE REQUIRED FOR THIS PORTION OF PHASE II TRAFFIC CONTROL.
7. DENOTES DURING PHASE II TRAFFIC CONTROL.

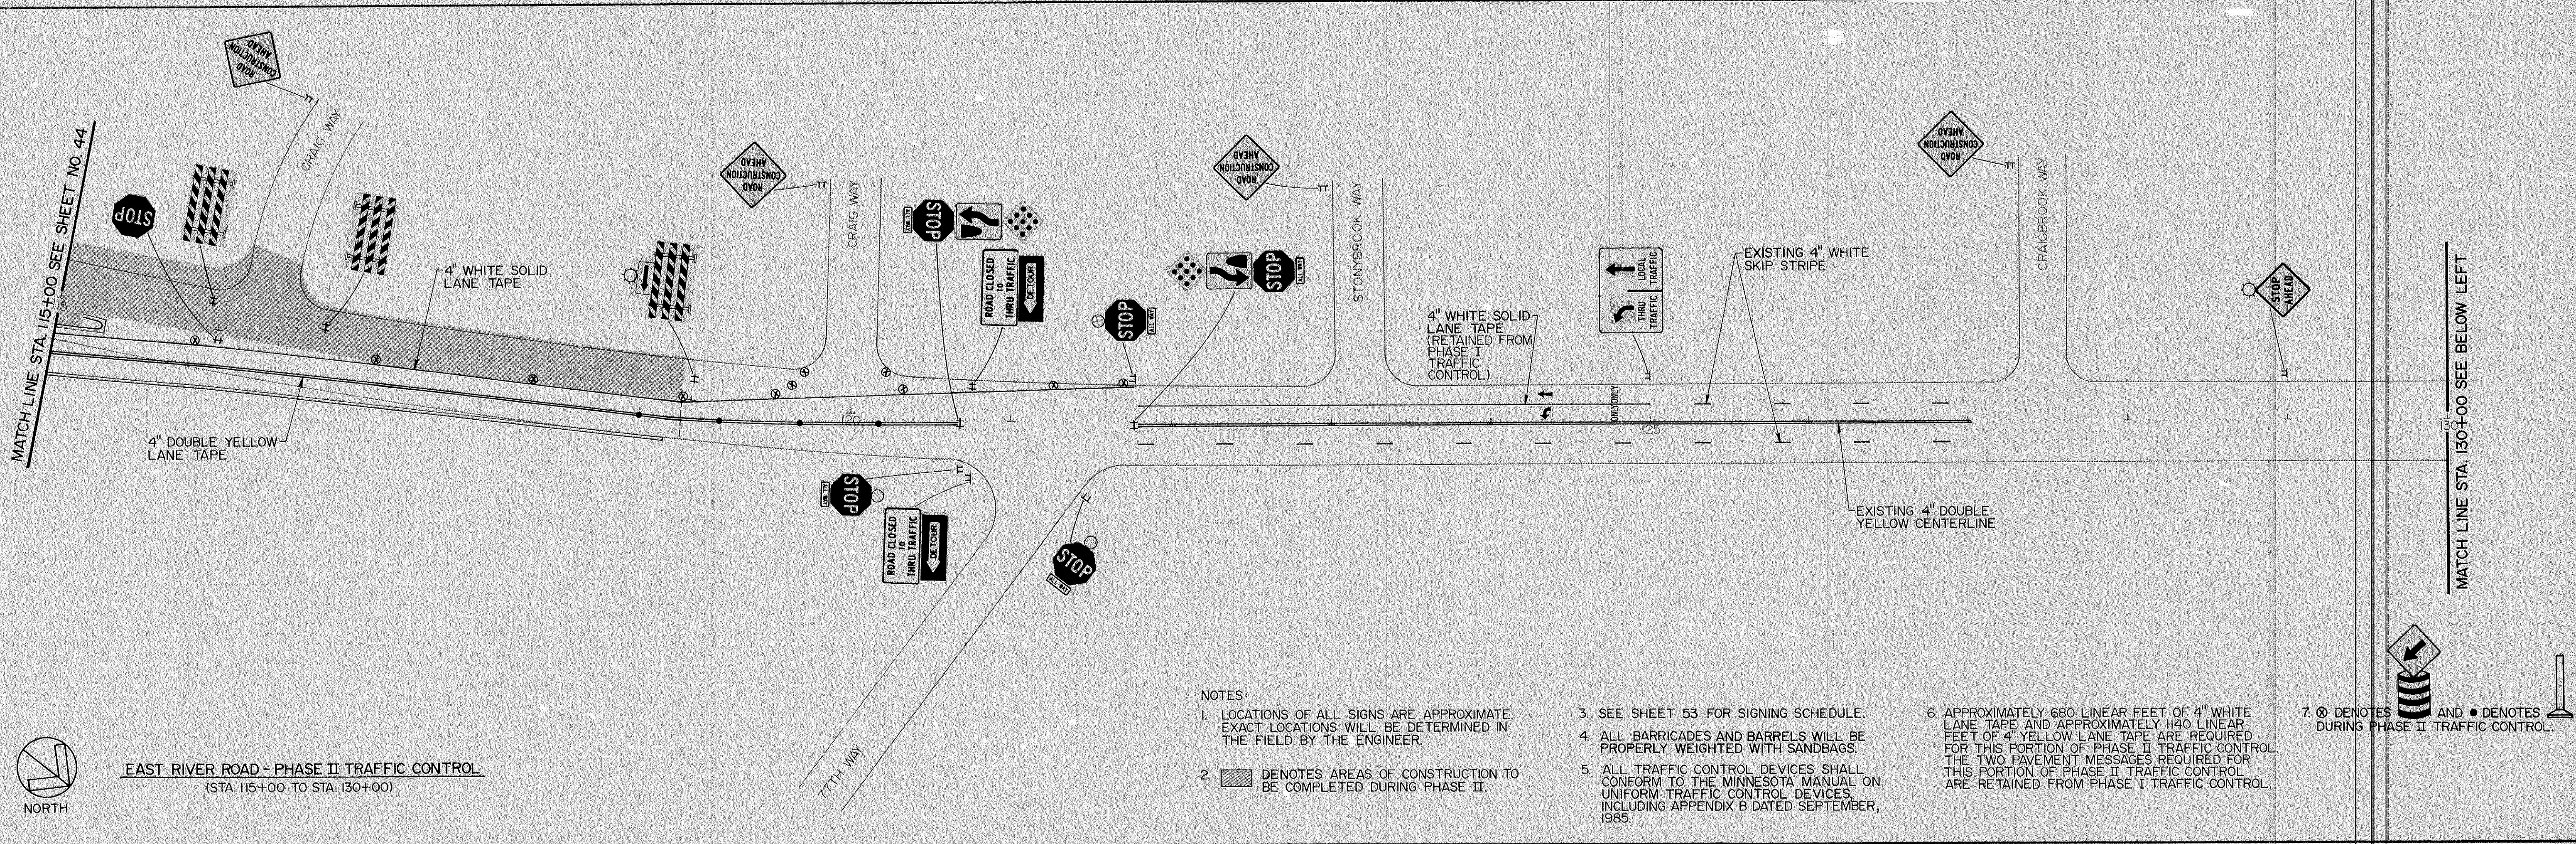


EAST RIVER ROAD - PHASE II TRAFFIC CONTROL
(STA. 115+00 TO STA. 130+00)

- NOTES:
1. LOCATIONS OF ALL SIGNS ARE APPROXIMATE. EXACT LOCATIONS WILL BE DETERMINED IN THE FIELD BY THE ENGINEER.
 2. [Shaded Area] DENOTES AREAS OF CONSTRUCTION TO BE COMPLETED DURING PHASE II.

3. SEE SHEET 53 FOR SIGNING SCHEDULE.
4. ALL BARRICADES AND BARRELS WILL BE PROPERLY WEIGHTED WITH SANDBAGS.
5. ALL TRAFFIC CONTROL DEVICES SHALL CONFORM TO THE MINNESOTA MANUAL ON UNIFORM TRAFFIC CONTROL DEVICES, INCLUDING APPENDIX B DATED SEPTEMBER, 1985.

6. APPROXIMATELY 680 LINEAR FEET OF 4" WHITE LANE TAPE AND APPROXIMATELY 1140 LINEAR FEET OF 4" YELLOW LANE TAPE ARE REQUIRED FOR THIS PORTION OF PHASE II TRAFFIC CONTROL. THE TWO PAVEMENT MESSAGES REQUIRED FOR THIS PORTION OF PHASE II TRAFFIC CONTROL ARE RETAINED FROM PHASE I TRAFFIC CONTROL.



7. [Symbol] DENOTES [Symbol] AND [Symbol] DENOTES [Symbol] DURING PHASE II TRAFFIC CONTROL.

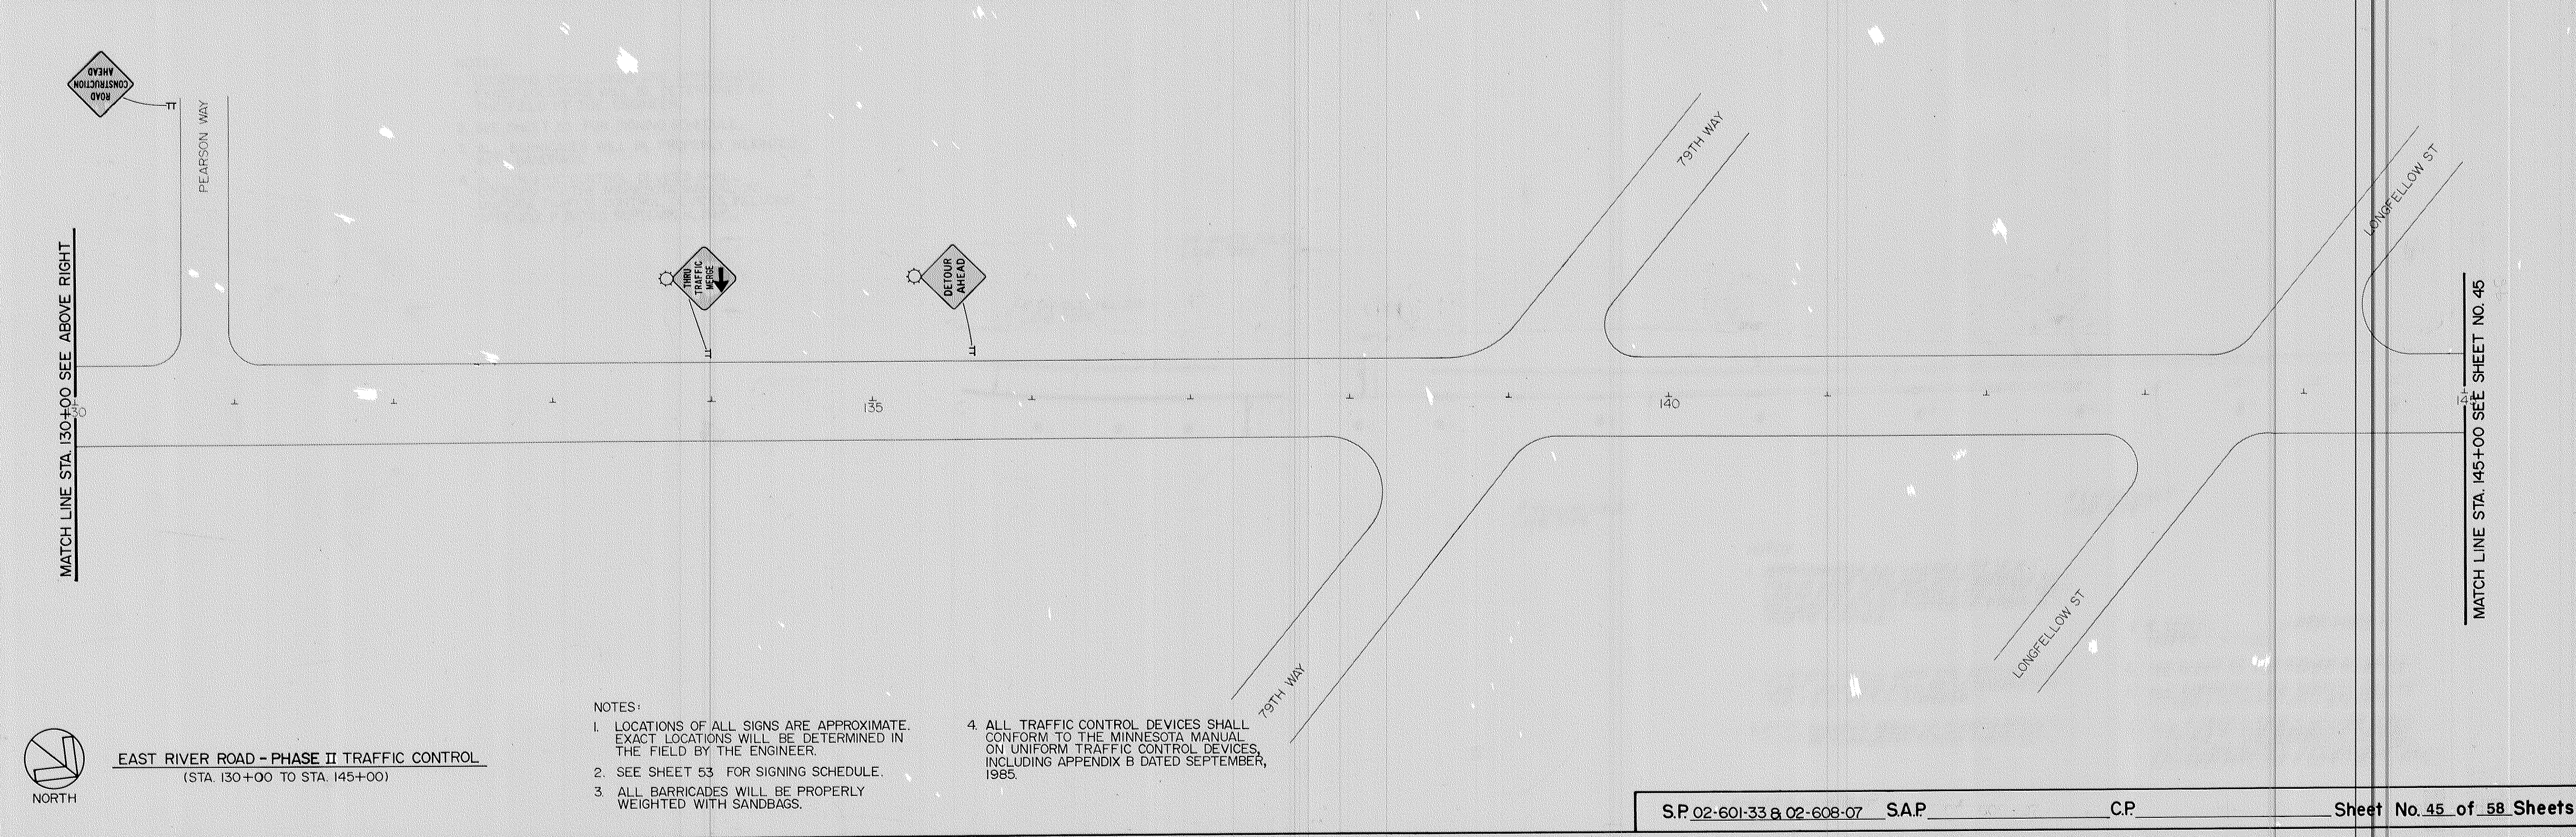

EAST RIVER ROAD - PHASE II TRAFFIC CONTROL
(STA. 130+00 TO STA. 145+00)



- NOTES:
1. LOCATIONS OF ALL SIGNS ARE APPROXIMATE. EXACT LOCATIONS WILL BE DETERMINED IN THE FIELD BY THE ENGINEER.
 2. SEE SHEET 53 FOR SIGNING SCHEDULE.
 3. ALL BARRICADES WILL BE PROPERLY WEIGHTED WITH SANDBAGS.
 4. ALL TRAFFIC CONTROL DEVICES SHALL CONFORM TO THE MINNESOTA MANUAL ON UNIFORM TRAFFIC CONTROL DEVICES, INCLUDING APPENDIX B DATED SEPTEMBER, 1985.

MATCH LINE STA. 145+00 SEE SHEET NO. 45

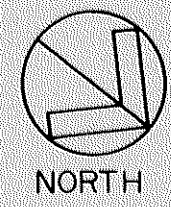
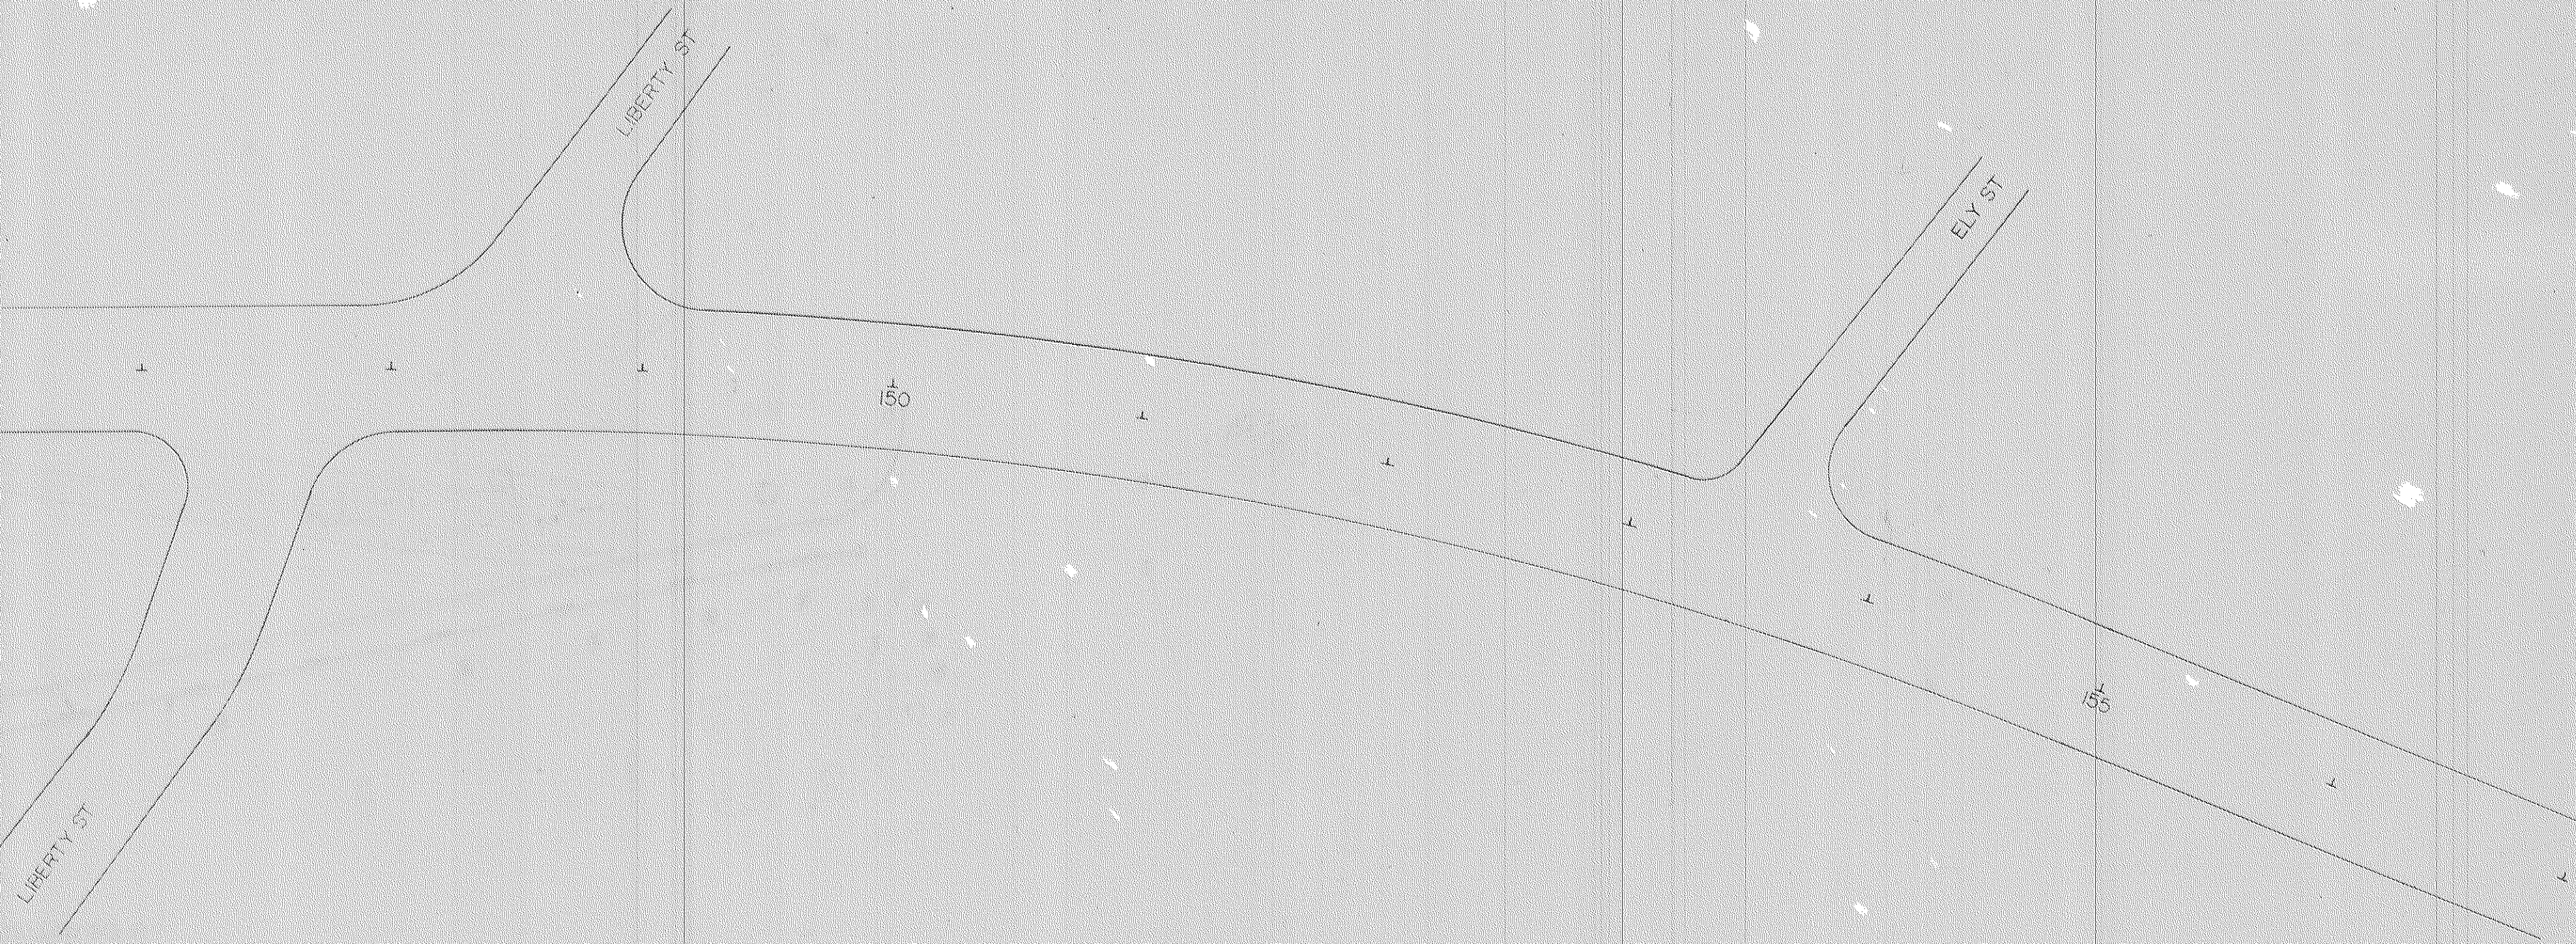


EAST RIVER ROAD - PHASE II TRAFFIC CONTROL
(STA. 145+00 TO STA. 157+00)

- NOTES:
1. LOCATIONS OF ALL SIGNS ARE APPROXIMATE. EXACT LOCATIONS WILL BE DETERMINED IN THE FIELD BY THE ENGINEER.
 2. SEE SHEET 53 FOR SIGNING SCHEDULE.
 3. ALL BARRICADES WILL BE PROPERLY WEIGHTED WITH SANDBAGS.
 4. ALL TRAFFIC CONTROL DEVICES SHALL CONFORM TO THE MINNESOTA MANUAL ON UNIFORM TRAFFIC CONTROL DEVICES, INCLUDING APPENDIX B DATED SEPTEMBER, 1985.

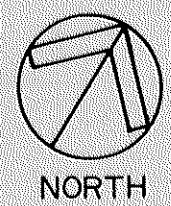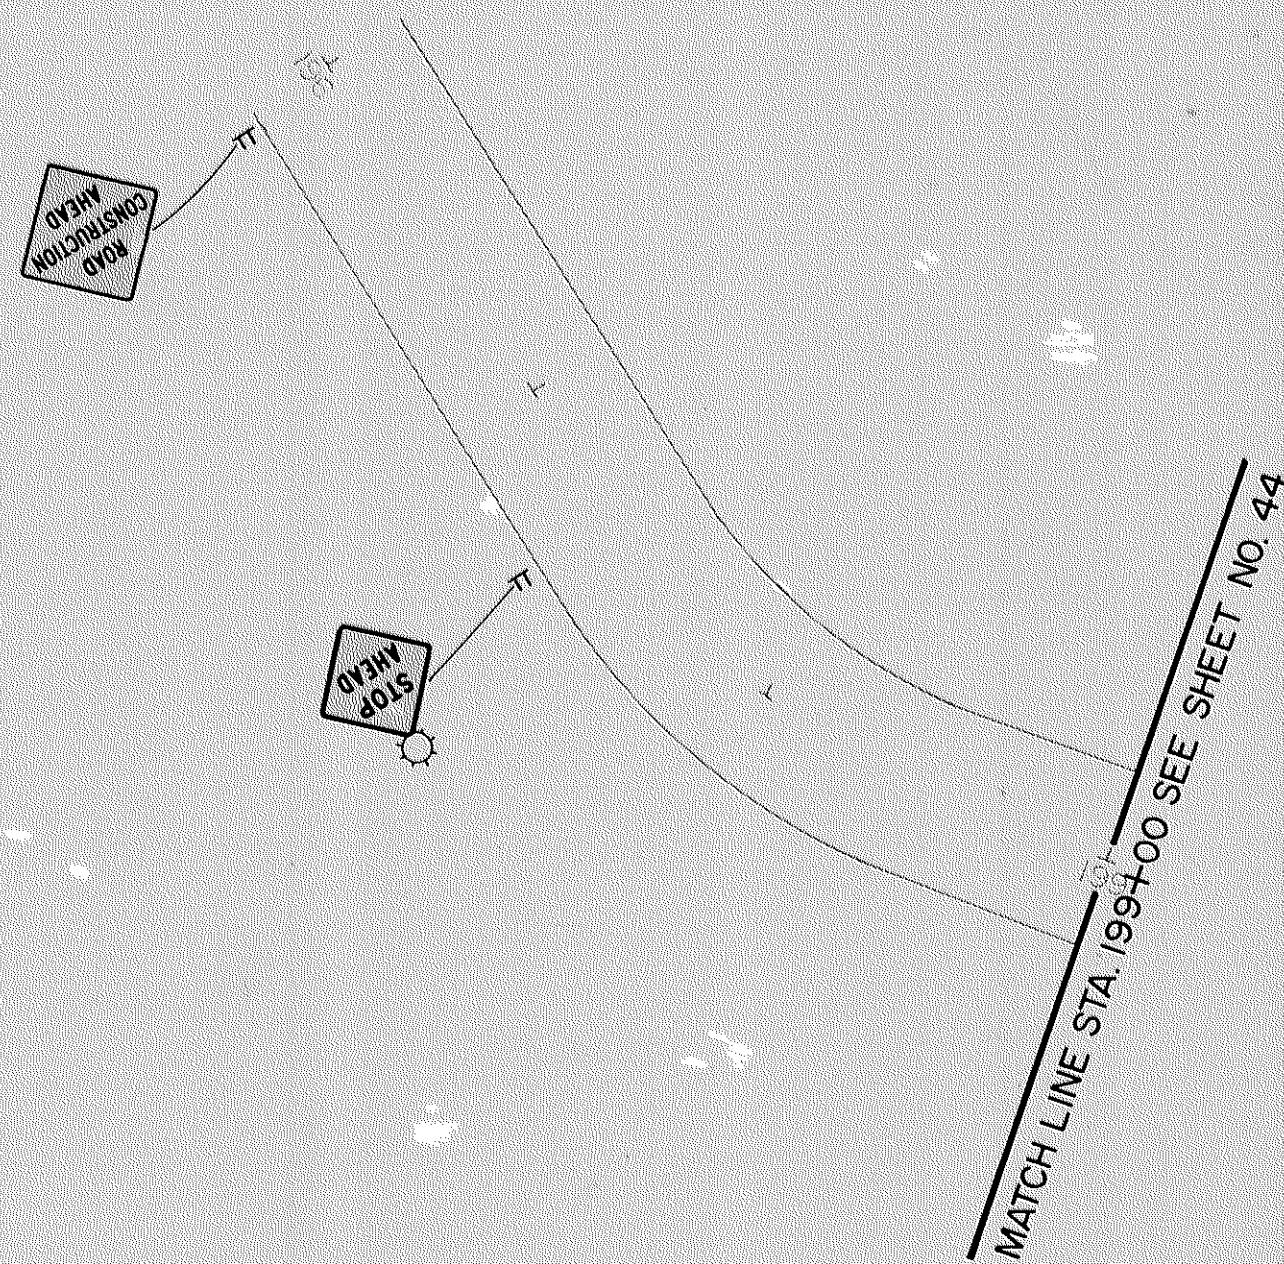

OSBORNE WAY - PHASE II TRAFFIC CONTROL
(STA. 196+00 TO STA. 199+00)

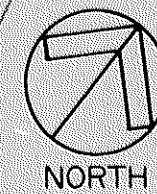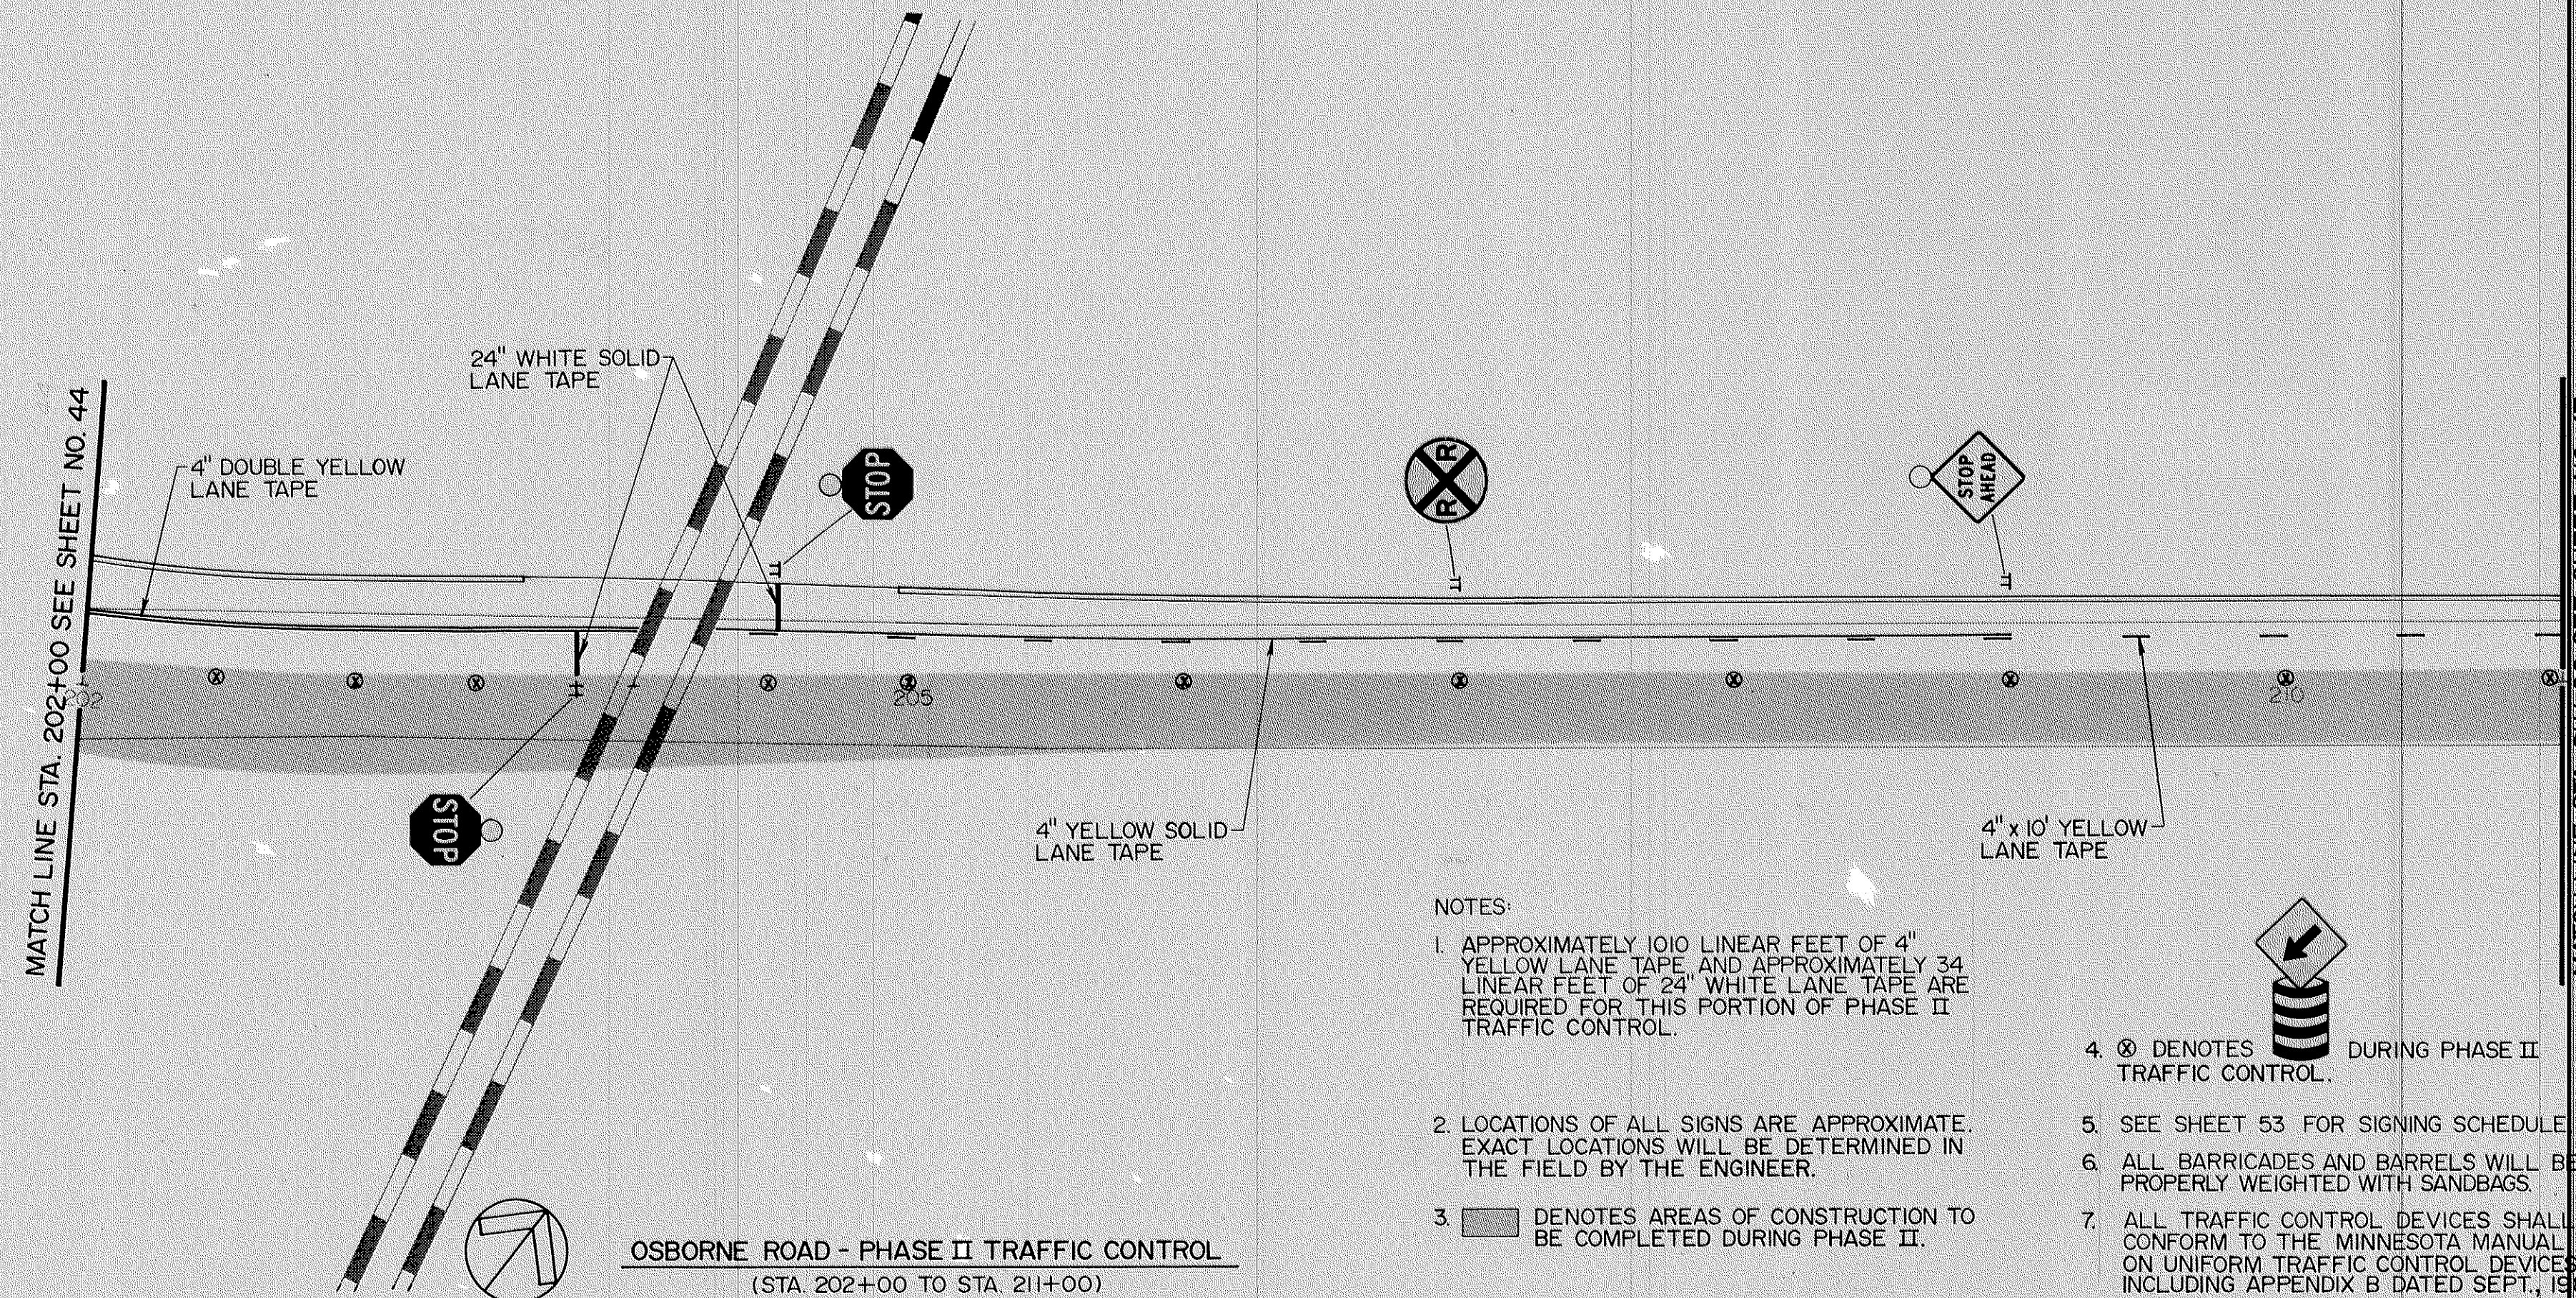

OSBORNE ROAD - PHASE II TRAFFIC CONTROL
(STA. 202+00 TO STA. 211+00)


- NOTES:
1. APPROXIMATELY 1010 LINEAR FEET OF 4" YELLOW LANE TAPE, AND APPROXIMATELY 34 LINEAR FEET OF 24" WHITE LANE TAPE ARE REQUIRED FOR THIS PORTION OF PHASE II TRAFFIC CONTROL.
 2. LOCATIONS OF ALL SIGNS ARE APPROXIMATE. EXACT LOCATIONS WILL BE DETERMINED IN THE FIELD BY THE ENGINEER.
 3. [Shaded Area Symbol] DENOTES AREAS OF CONSTRUCTION TO BE COMPLETED DURING PHASE II.
 4. [Symbol] DENOTES [Symbol] DURING PHASE II TRAFFIC CONTROL.
 5. SEE SHEET 53 FOR SIGNING SCHEDULE.
 6. ALL BARRICADES AND BARRELS WILL BE PROPERLY WEIGHTED WITH SANDBAGS.
 7. ALL TRAFFIC CONTROL DEVICES SHALL CONFORM TO THE MINNESOTA MANUAL ON UNIFORM TRAFFIC CONTROL DEVICES, INCLUDING APPENDIX B DATED SEPT., 1985.

MATCH LINE STA. 211+00 SEE SHEET NO. 47


MATCH LINE STA 211+00 SEE SHEET NO. 46

4' x 10' YELLOW LANE TAPE

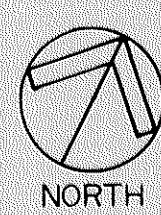

4' YELLOW SOLID LANE TAPE

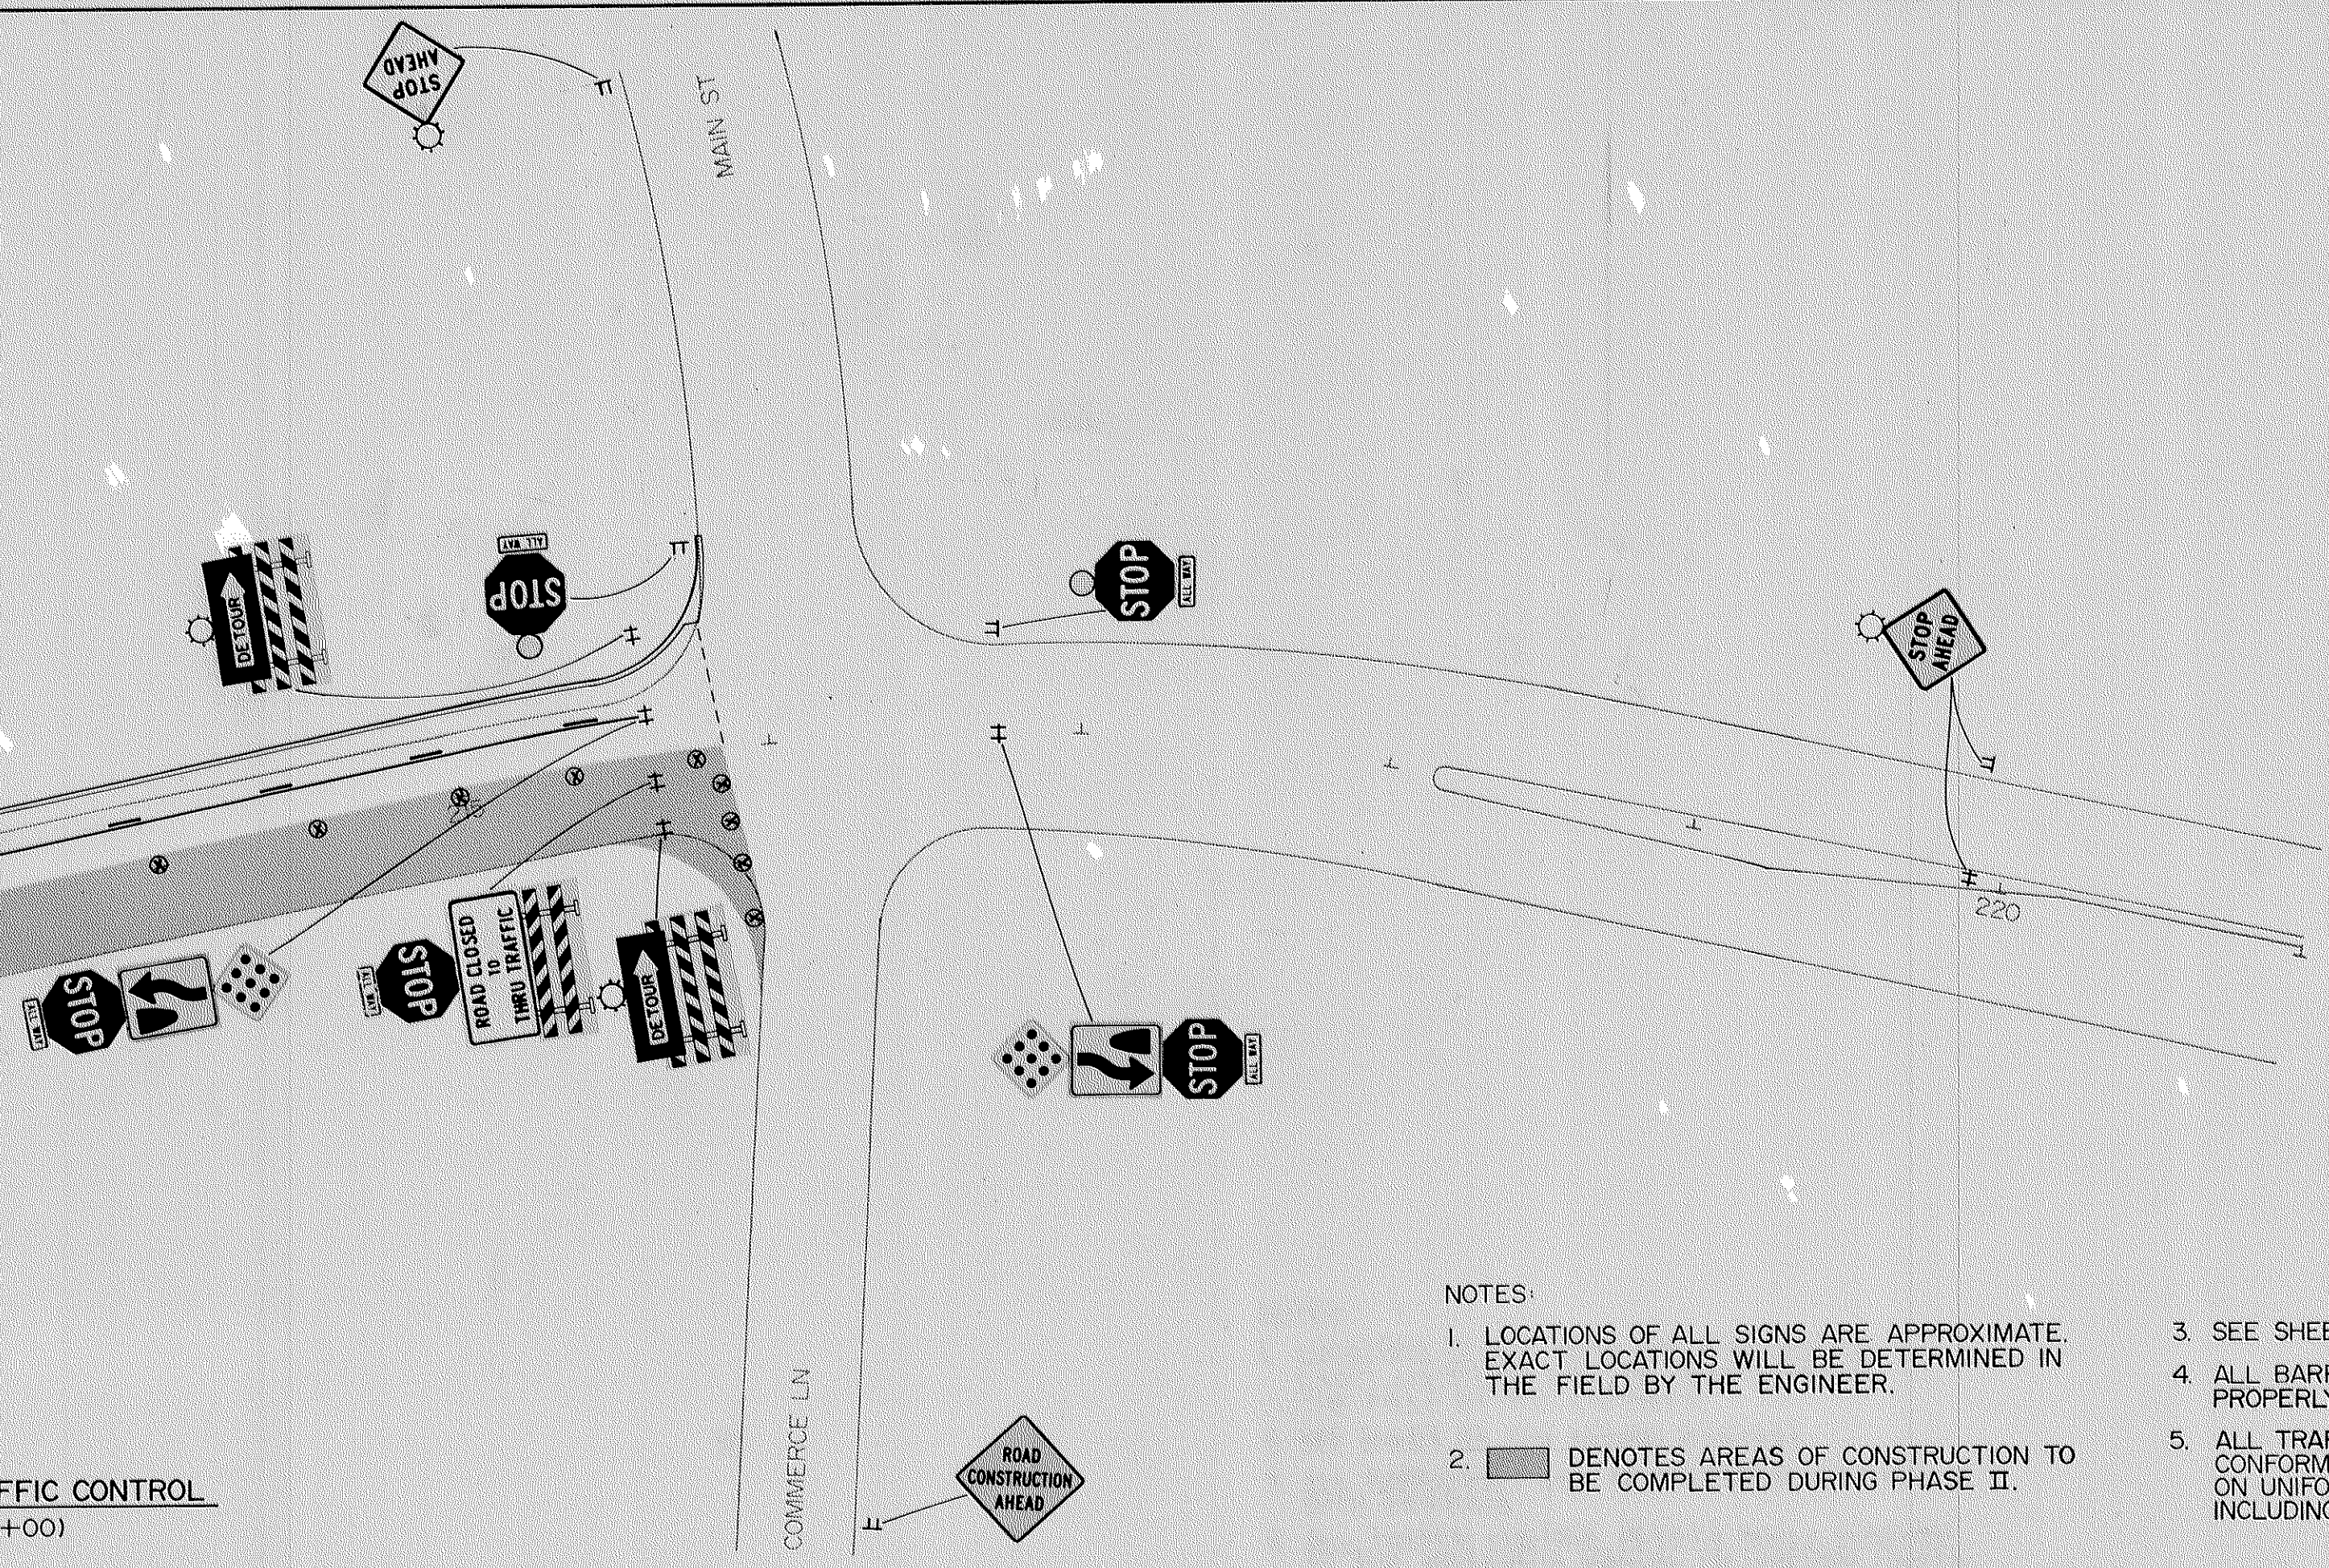


OSBORNE ROAD - PHASE II TRAFFIC CONTROL
(STA. 211+00 TO STA. 221+00)





NOTES:

- 1. LOCATIONS OF ALL SIGNS ARE APPROXIMATE. EXACT LOCATIONS WILL BE DETERMINED IN THE FIELD BY THE ENGINEER.
- 2.  DENOTES AREAS OF CONSTRUCTION TO BE COMPLETED DURING PHASE II.
- 3. SEE SHEET 53 FOR SIGNING SCHEDULE.
- 4. ALL BARRICADES AND BARRELS WILL BE PROPERLY WEIGHTED WITH SANDBAGS.
- 5. ALL TRAFFIC CONTROL DEVICES SHALL CONFORM TO THE MINNESOTA MANUAL ON UNIFORM TRAFFIC CONTROL DEVICES, INCLUDING APPENDIX B DATED SEPT, 1985.
- 6. APPROXIMATELY 555 LINEAR FEET OF 4" YELLOW LANE TAPE ARE REQUIRED FOR THIS PORTION OF PHASE II TRAFFIC CONTROL.
- 7.  DENOTES DURING PHASE II TRAFFIC CONTROL.

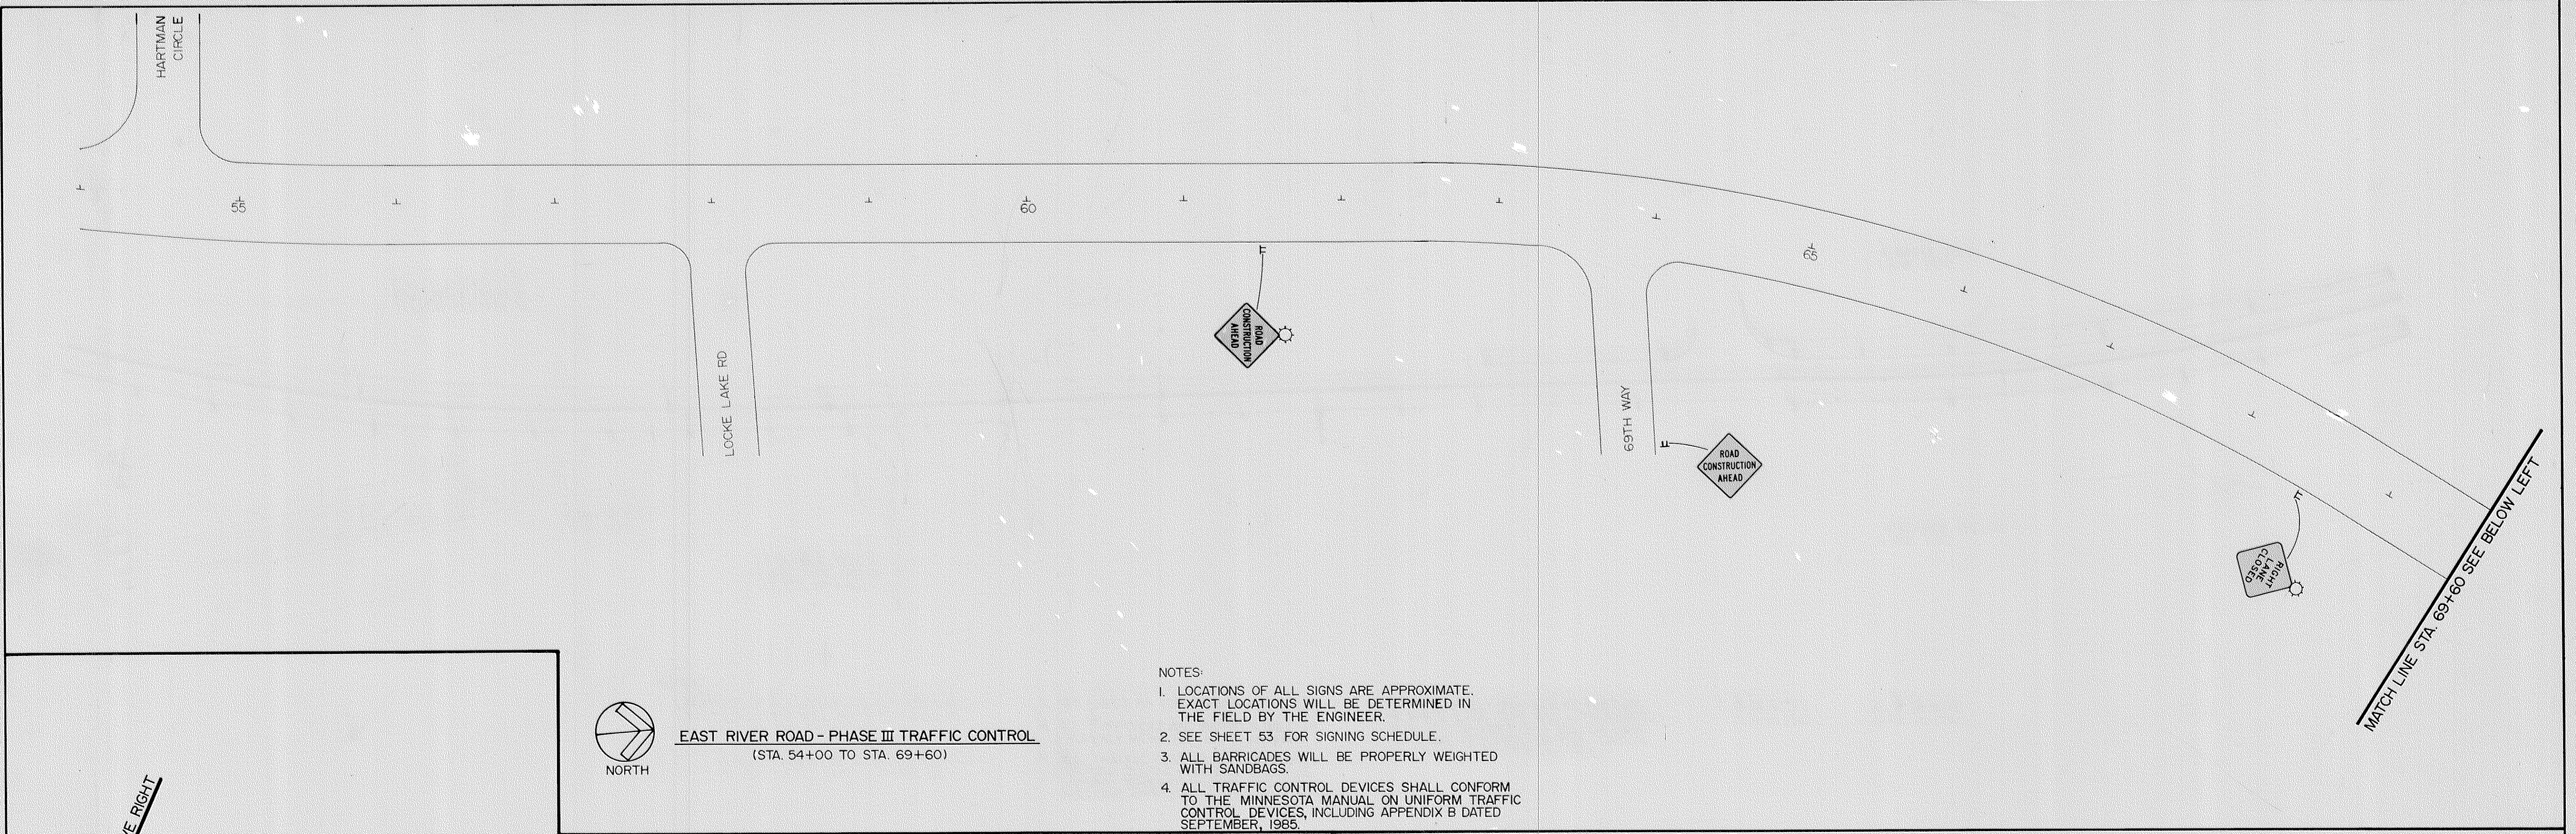


EAST RIVER ROAD - PHASE III TRAFFIC CONTROL
(STA. 54+00 TO STA. 69+60)


- NOTES:
1. LOCATIONS OF ALL SIGNS ARE APPROXIMATE. EXACT LOCATIONS WILL BE DETERMINED IN THE FIELD BY THE ENGINEER.
 2. SEE SHEET 53 FOR SIGNING SCHEDULE.
 3. ALL BARRICADES WILL BE PROPERLY WEIGHTED WITH SANDBAGS.
 4. ALL TRAFFIC CONTROL DEVICES SHALL CONFORM TO THE MINNESOTA MANUAL ON UNIFORM TRAFFIC CONTROL DEVICES, INCLUDING APPENDIX B DATED SEPTEMBER, 1985.

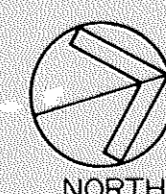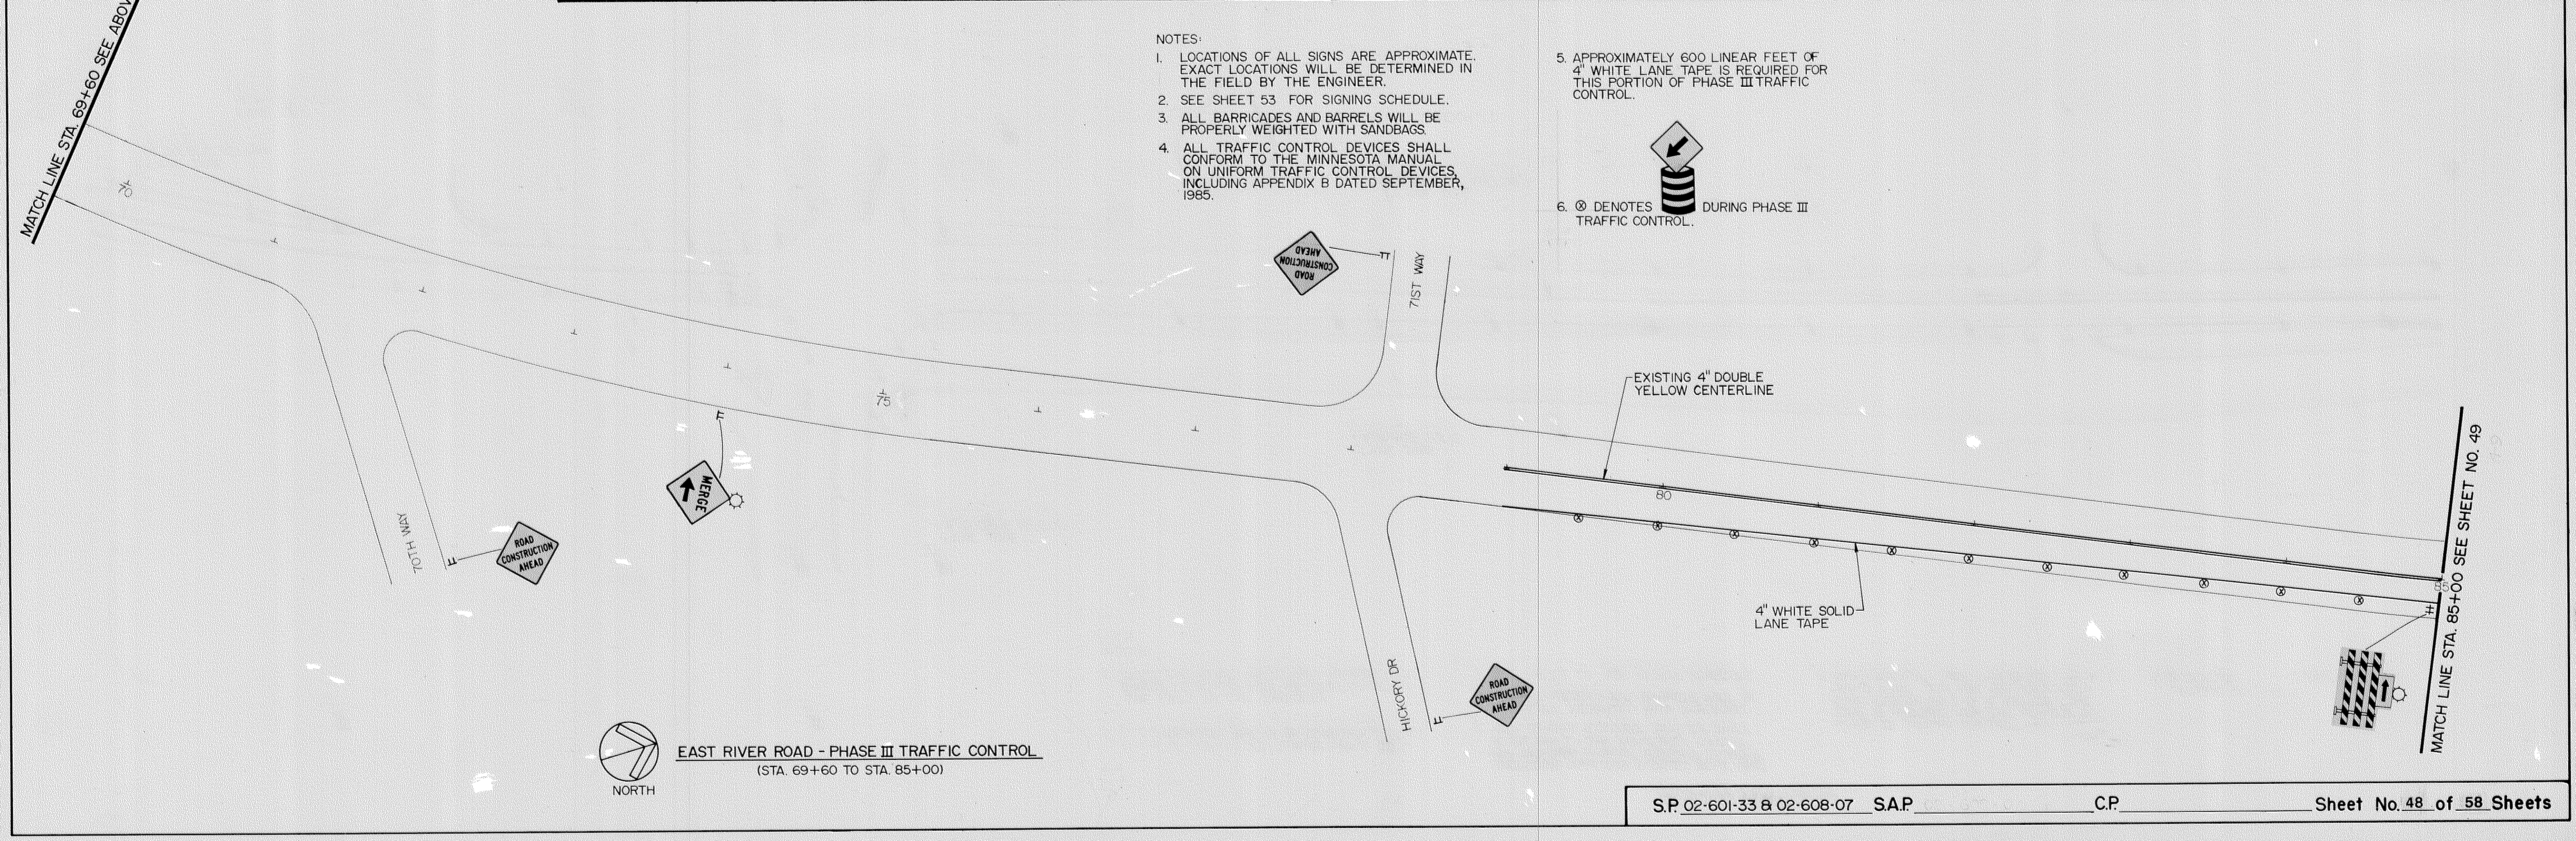

EAST RIVER ROAD - PHASE III TRAFFIC CONTROL
(STA. 69+60 TO STA. 85+00)


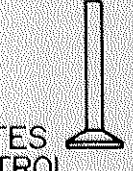
- NOTES:
1. LOCATIONS OF ALL SIGNS ARE APPROXIMATE. EXACT LOCATIONS WILL BE DETERMINED IN THE FIELD BY THE ENGINEER.
 2. SEE SHEET 53 FOR SIGNING SCHEDULE.
 3. ALL BARRICADES AND BARRELS WILL BE PROPERLY WEIGHTED WITH SANDBAGS.
 4. ALL TRAFFIC CONTROL DEVICES SHALL CONFORM TO THE MINNESOTA MANUAL ON UNIFORM TRAFFIC CONTROL DEVICES, INCLUDING APPENDIX B DATED SEPTEMBER, 1985.


5. APPROXIMATELY 600 LINEAR FEET OF 4" WHITE LANE TAPE IS REQUIRED FOR THIS PORTION OF PHASE III TRAFFIC CONTROL.
6.  DENOTES DURING PHASE III TRAFFIC CONTROL.

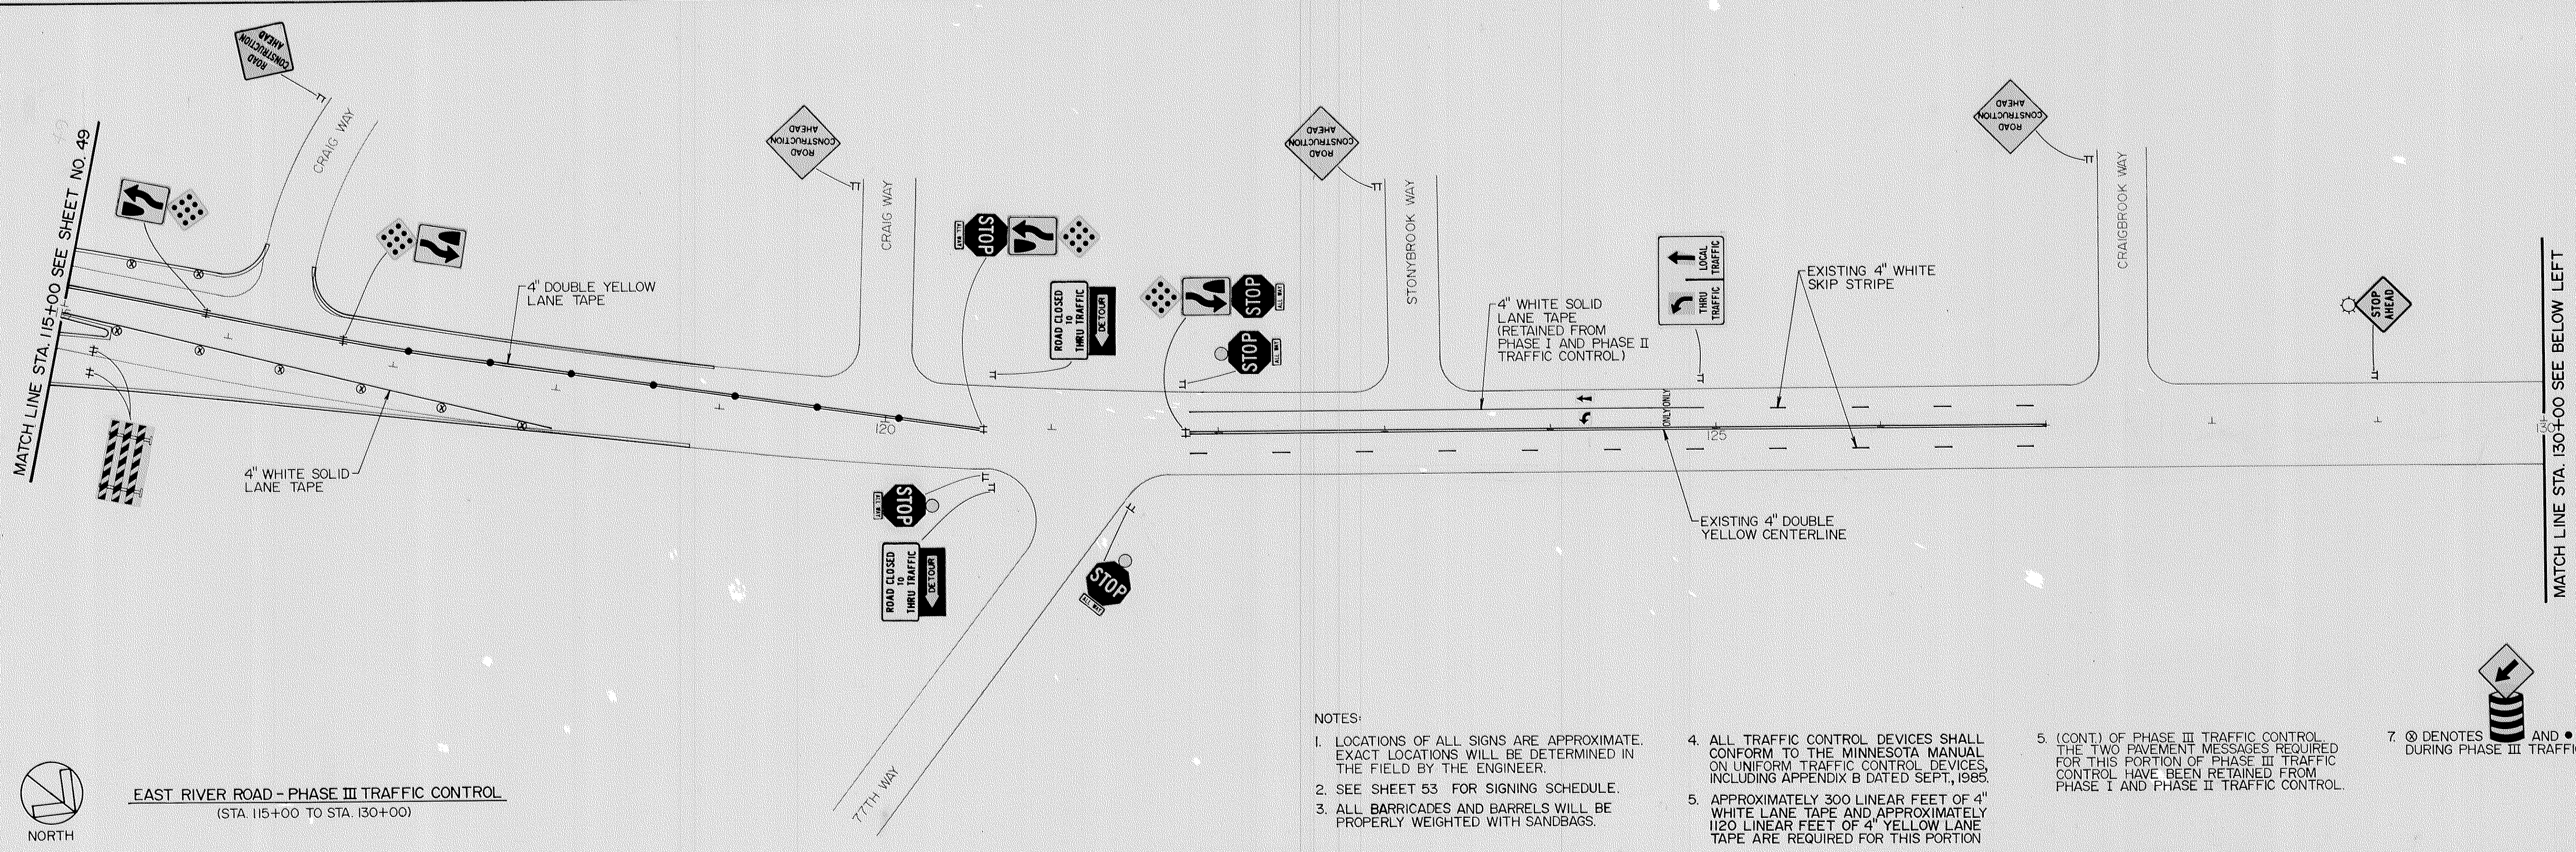

EAST RIVER ROAD - PHASE III TRAFFIC CONTROL
(STA. 115+00 TO STA. 130+00)

NOTES:

1. LOCATIONS OF ALL SIGNS ARE APPROXIMATE. EXACT LOCATIONS WILL BE DETERMINED IN THE FIELD BY THE ENGINEER.
2. SEE SHEET 53 FOR SIGNING SCHEDULE.
3. ALL BARRICADES AND BARRELS WILL BE PROPERLY WEIGHTED WITH SANDBAGS.
4. ALL TRAFFIC CONTROL DEVICES SHALL CONFORM TO THE MINNESOTA MANUAL ON UNIFORM TRAFFIC CONTROL DEVICES, INCLUDING APPENDIX B DATED SEPT, 1985.
5. APPROXIMATELY 300 LINEAR FEET OF 4" WHITE LANE TAPE AND APPROXIMATELY 120 LINEAR FEET OF 4" YELLOW LANE TAPE ARE REQUIRED FOR THIS PORTION
6. (CONT.) OF PHASE III TRAFFIC CONTROL. THE TWO PAVEMENT MESSAGES REQUIRED FOR THIS PORTION OF PHASE III TRAFFIC CONTROL HAVE BEEN RETAINED FROM PHASE I AND PHASE II TRAFFIC CONTROL.
7.  DENOTES AND  DENOTES DURING PHASE III TRAFFIC CONTROL.


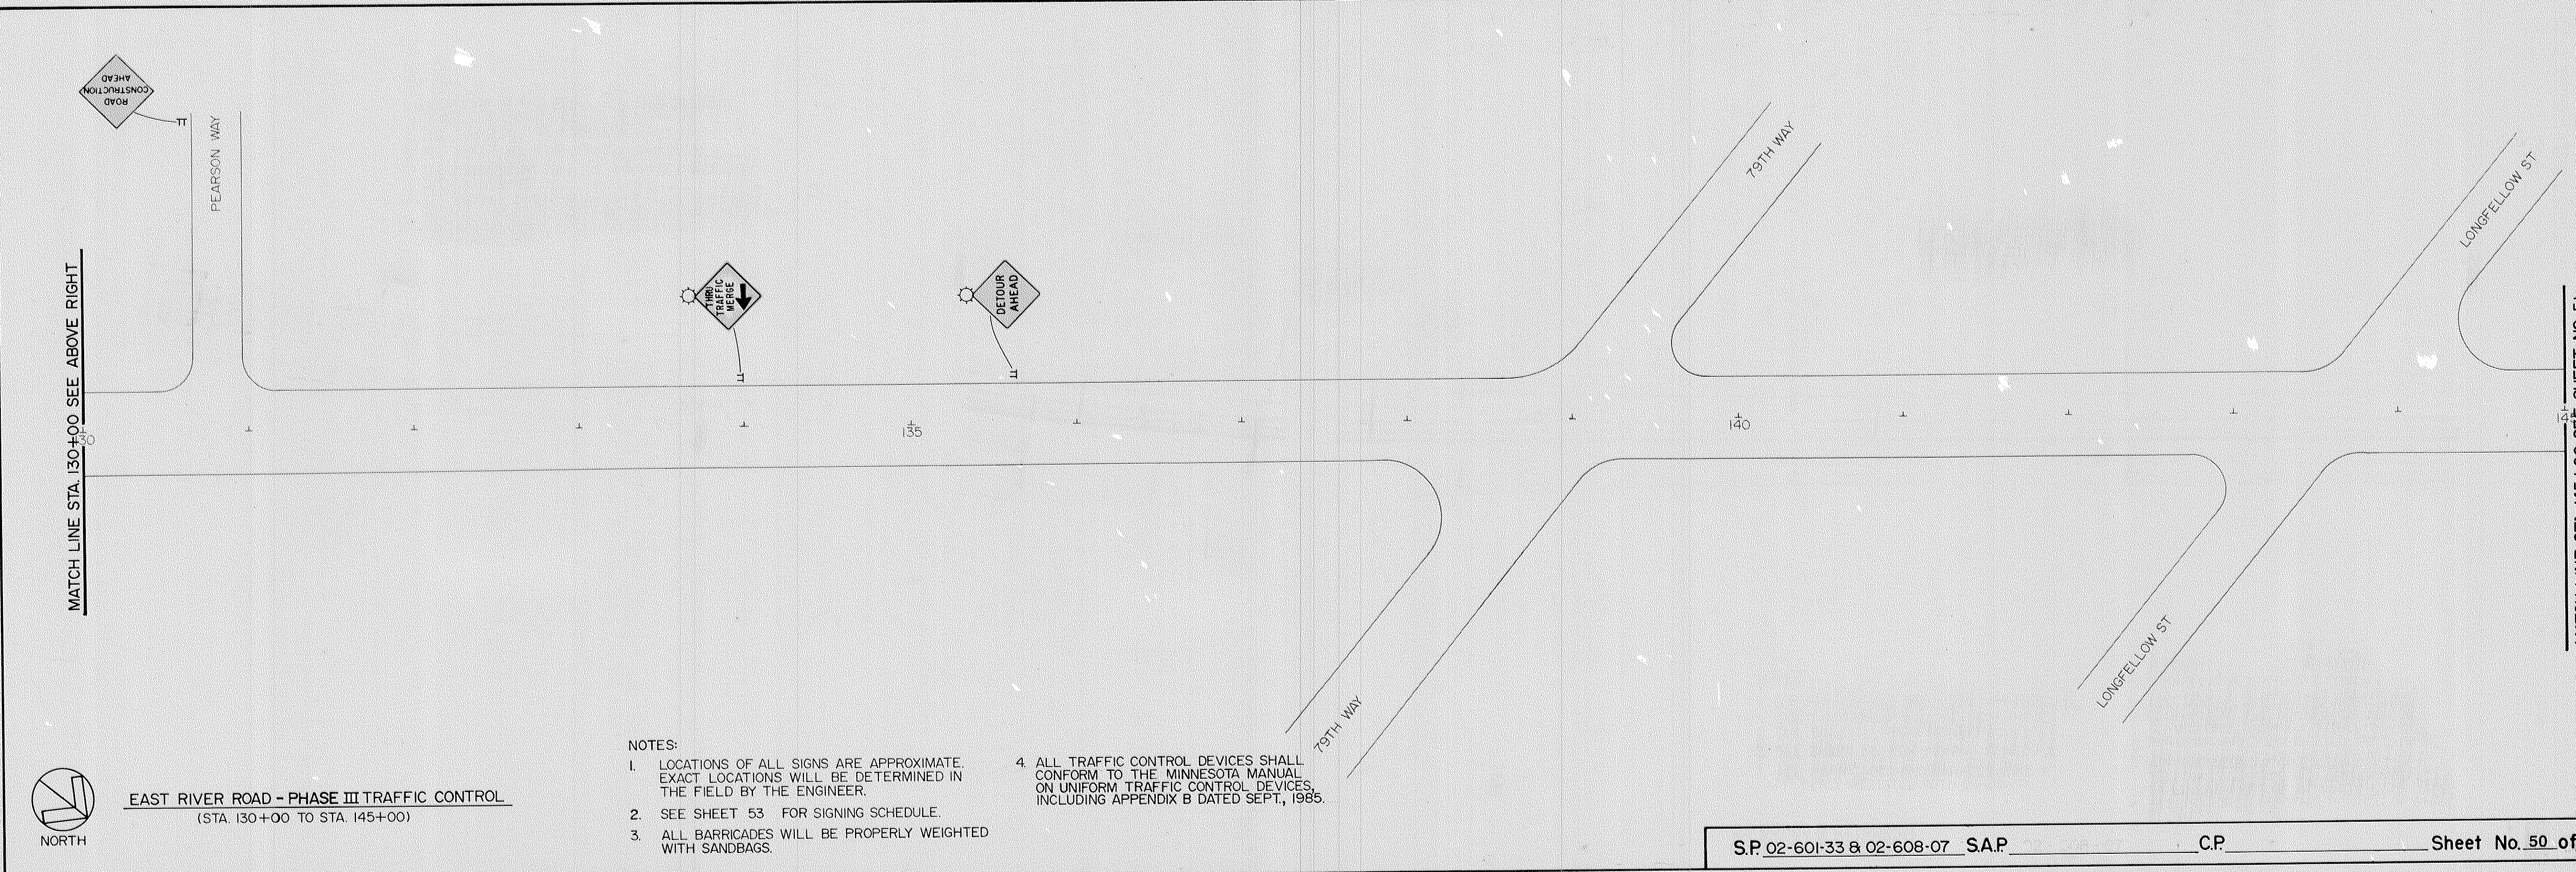


EAST RIVER ROAD - PHASE III TRAFFIC CONTROL
(STA. 130+00 TO STA. 145+00)

NOTES:

1. LOCATIONS OF ALL SIGNS ARE APPROXIMATE. EXACT LOCATIONS WILL BE DETERMINED IN THE FIELD BY THE ENGINEER.
2. SEE SHEET 53 FOR SIGNING SCHEDULE.
3. ALL BARRICADES WILL BE PROPERLY WEIGHTED WITH SANDBAGS.
4. ALL TRAFFIC CONTROL DEVICES SHALL CONFORM TO THE MINNESOTA MANUAL ON UNIFORM TRAFFIC CONTROL DEVICES, INCLUDING APPENDIX B DATED SEPT, 1985.



MATCH LINE STA. 145+00 SEE SHEET NO. 50

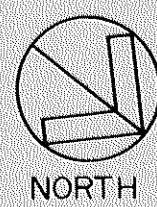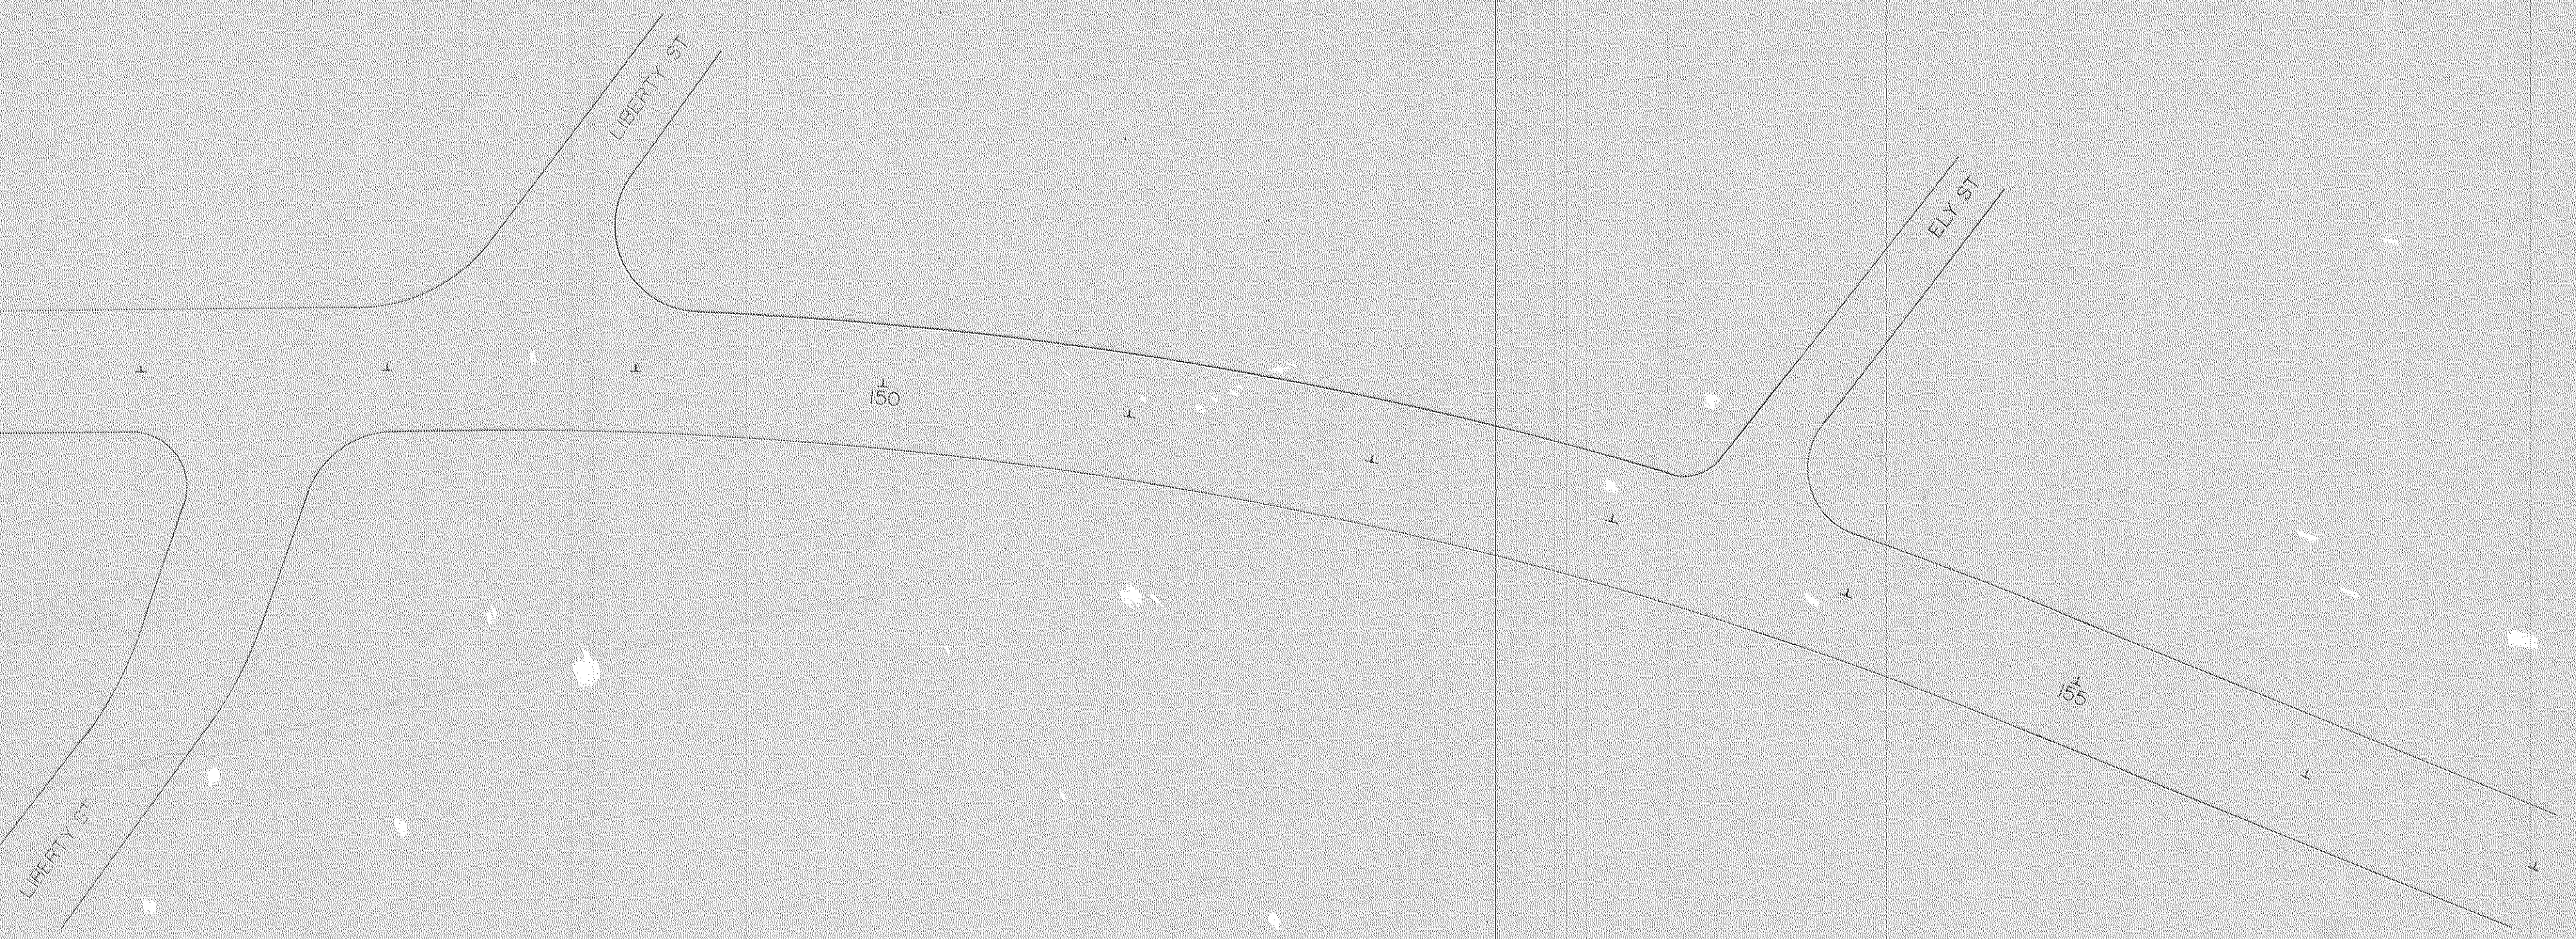



EAST RIVER ROAD - PHASE III TRAFFIC CONTROL
(STA. 145+00 TO STA. 157+00)

NOTES:

1. LOCATIONS OF ALL SIGNS ARE APPROXIMATE. EXACT LOCATIONS WILL BE DETERMINED IN THE FIELD BY THE ENGINEER.
2. SEE SHEET 53 FOR SIGNING SCHEDULE.
3. ALL BARRICADES WILL BE PROPERLY WEIGHTED WITH SANDBAGS.
4. ALL TRAFFIC CONTROL DEVICES SHALL CONFORM TO THE MINNESOTA MANUAL ON UNIFORM TRAFFIC CONTROL DEVICES, INCLUDING APPENDIX B DATED SEPTEMBER, 1985.

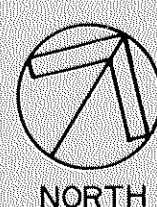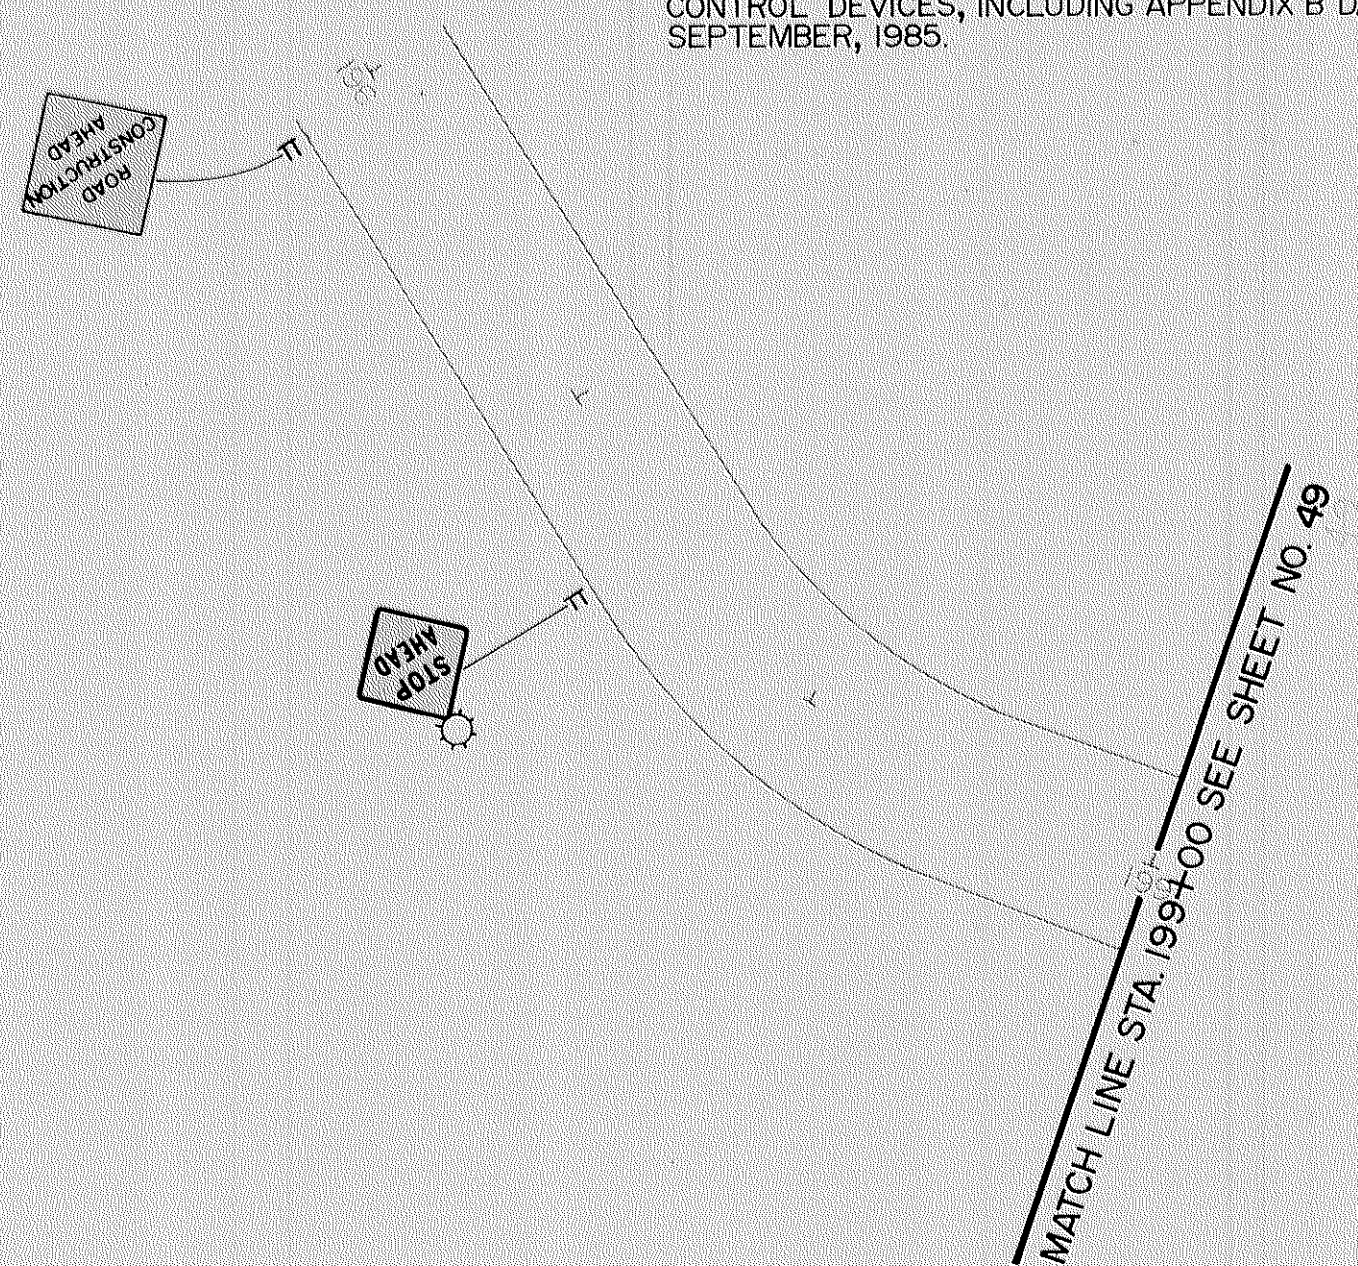


OSBORNE WAY - PHASE III TRAFFIC CONTROL
(STA. 196+00 TO STA. 199+00)

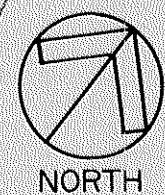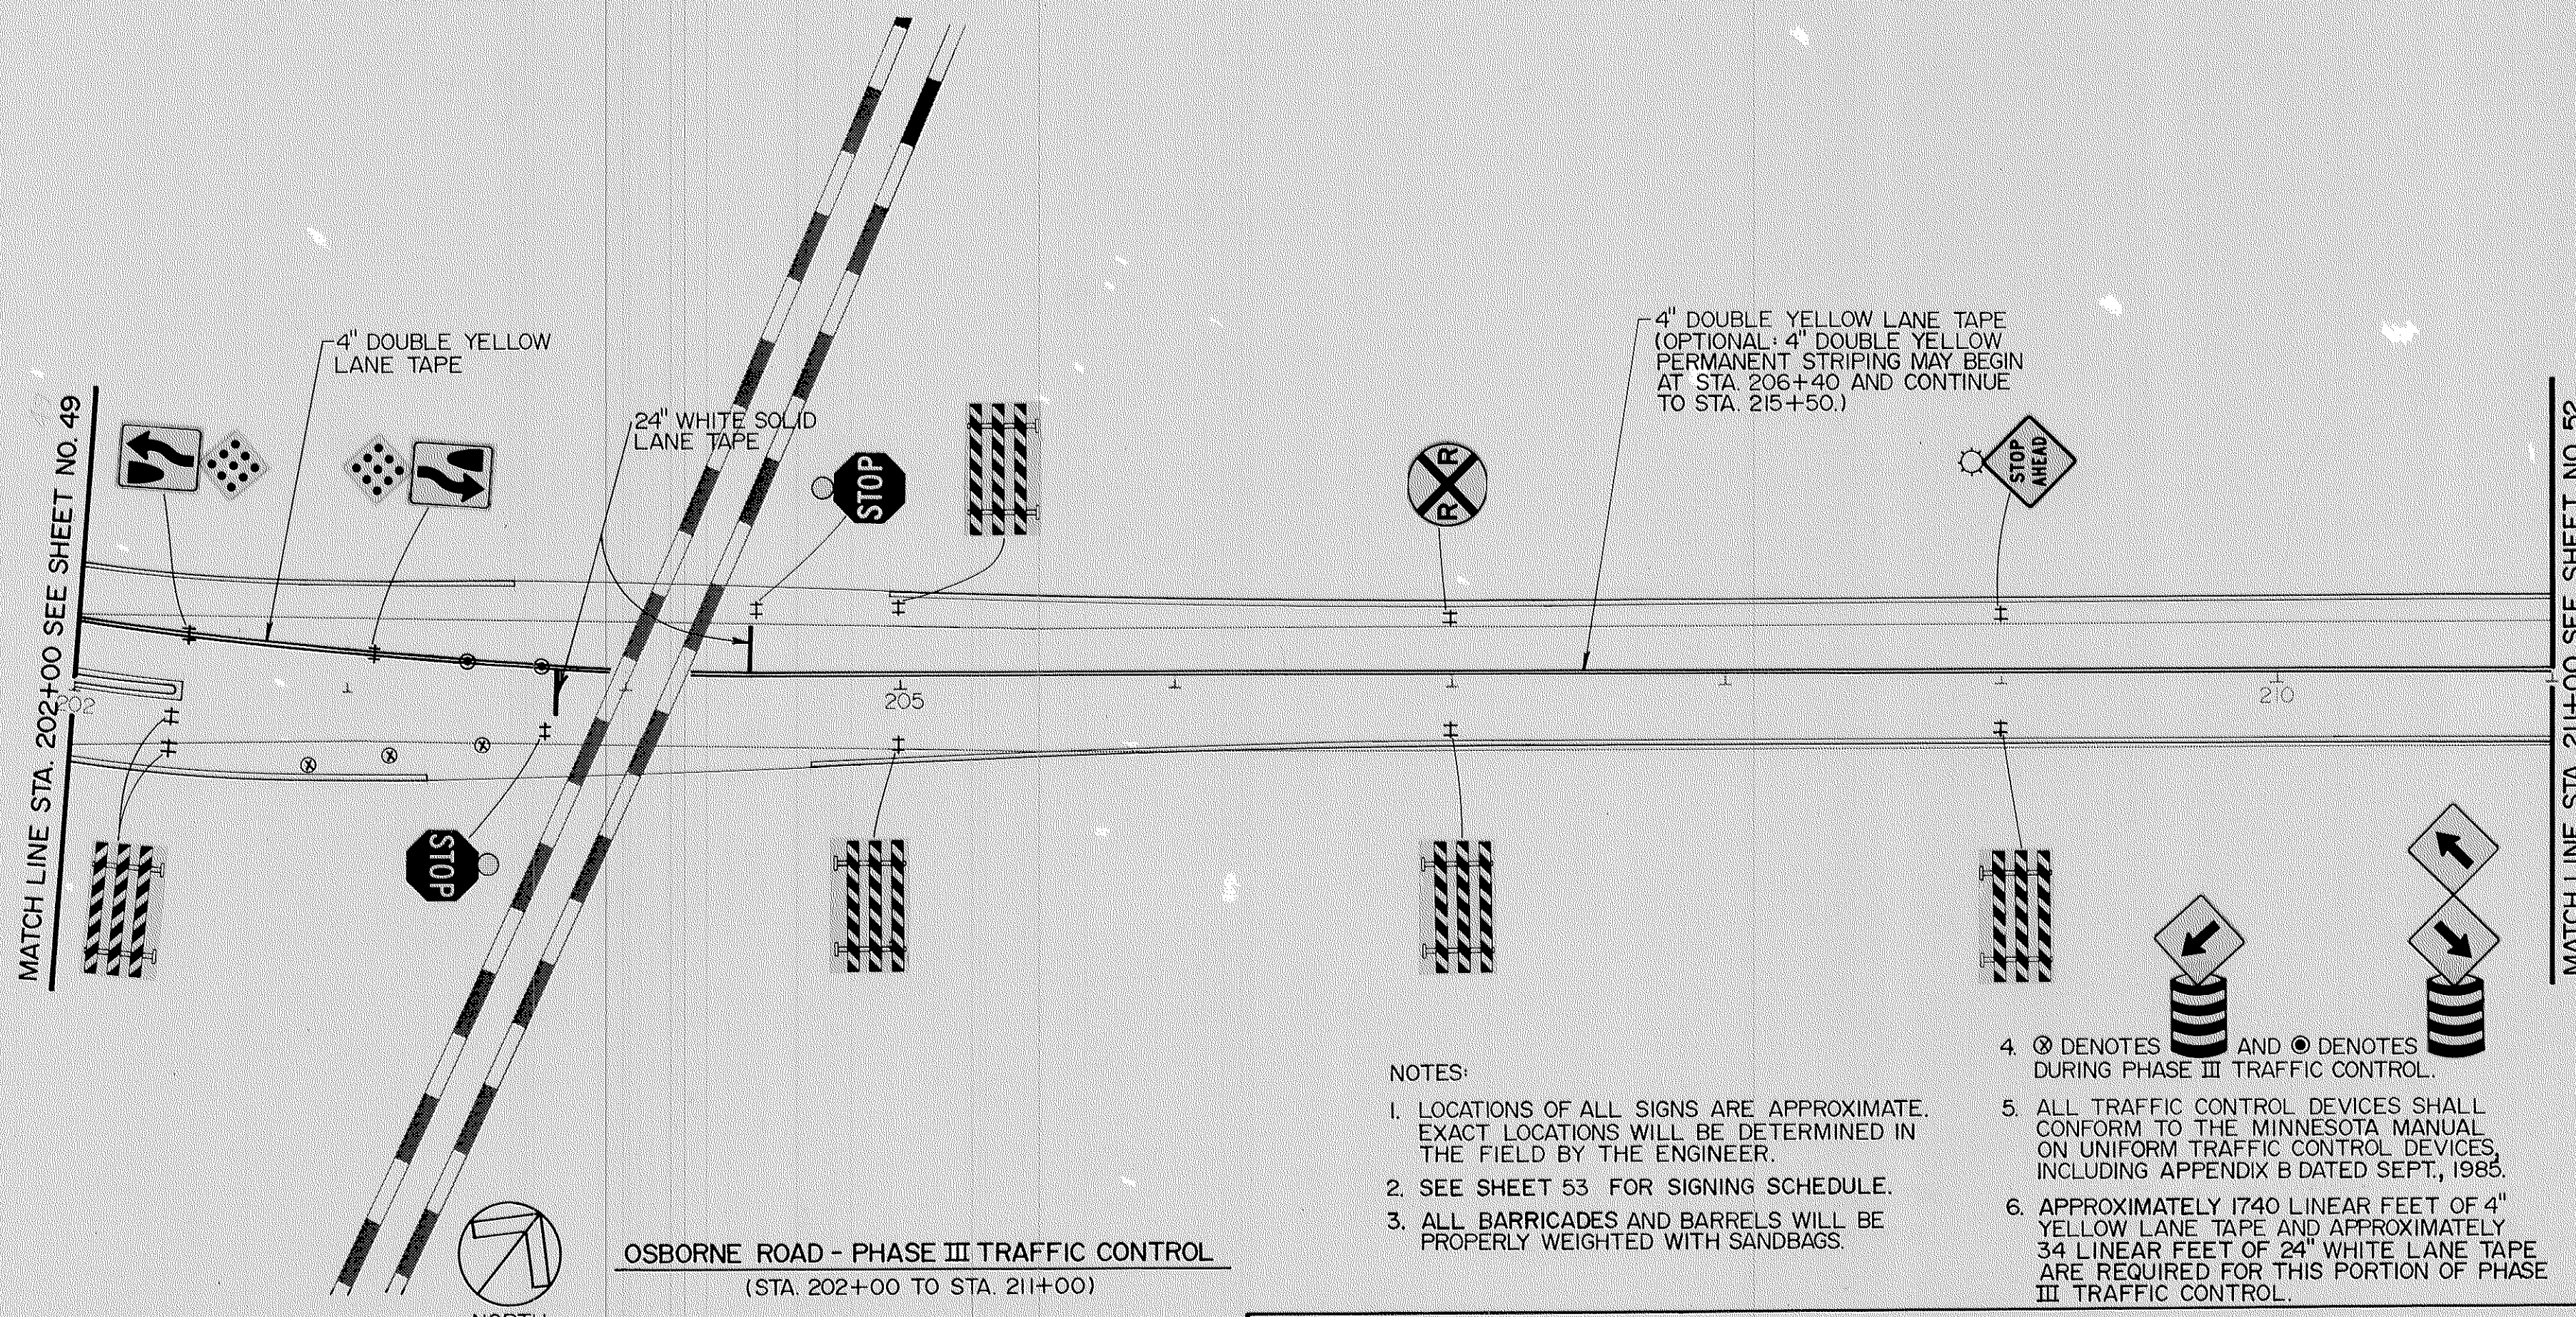


OSBORNE ROAD - PHASE III TRAFFIC CONTROL
(STA. 202+00 TO STA. 211+00)

NOTES:

1. LOCATIONS OF ALL SIGNS ARE APPROXIMATE. EXACT LOCATIONS WILL BE DETERMINED IN THE FIELD BY THE ENGINEER.
2. SEE SHEET 53 FOR SIGNING SCHEDULE.
3. ALL BARRICADES AND BARRELS WILL BE PROPERLY WEIGHTED WITH SANDBAGS.
4. ⊗ DENOTES AND ⊙ DENOTES DURING PHASE III TRAFFIC CONTROL.
5. ALL TRAFFIC CONTROL DEVICES SHALL CONFORM TO THE MINNESOTA MANUAL ON UNIFORM TRAFFIC CONTROL DEVICES, INCLUDING APPENDIX B DATED SEPT, 1985.
6. APPROXIMATELY 1740 LINEAR FEET OF 4" YELLOW LANE TAPE AND APPROXIMATELY 34 LINEAR FEET OF 24" WHITE LANE TAPE ARE REQUIRED FOR THIS PORTION OF PHASE III TRAFFIC CONTROL.

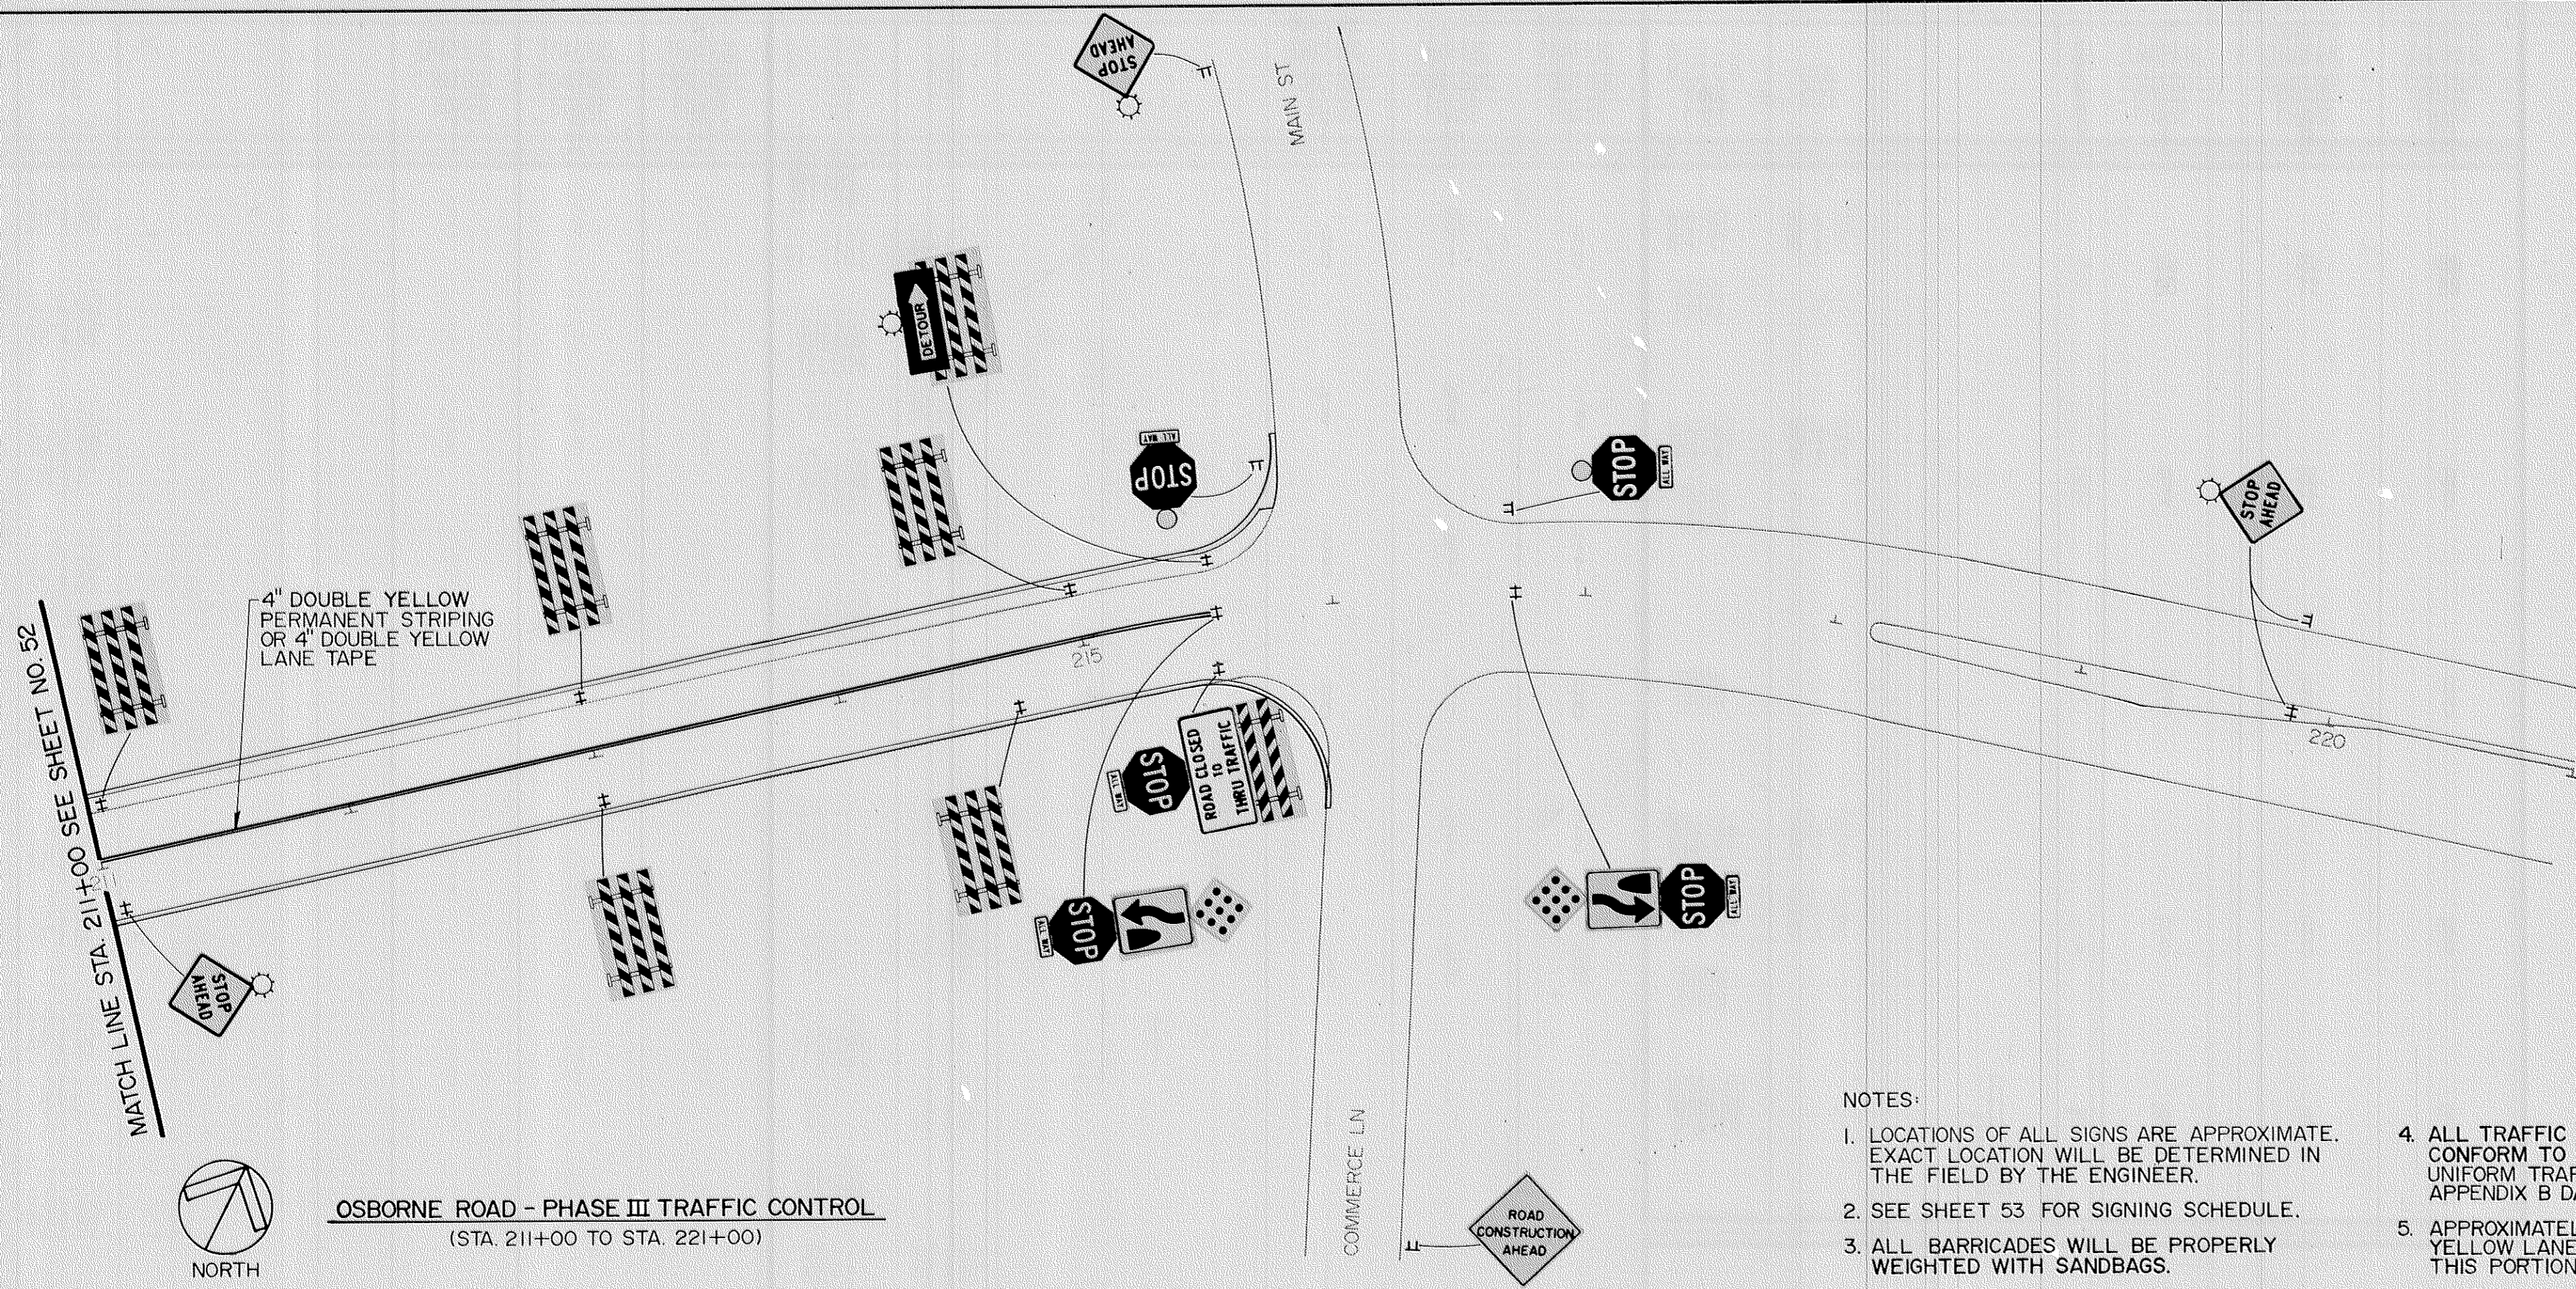

OSBORNE ROAD - PHASE III TRAFFIC CONTROL
 (STA. 211+00 TO STA. 221+00)

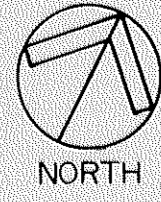


NOTES:

1. LOCATIONS OF ALL SIGNS ARE APPROXIMATE. EXACT LOCATION WILL BE DETERMINED IN THE FIELD BY THE ENGINEER.
2. SEE SHEET 53 FOR SIGNING SCHEDULE.
3. ALL BARRICADES WILL BE PROPERLY WEIGHTED WITH SANDBAGS.
4. ALL TRAFFIC CONTROL DEVICES SHALL CONFORM TO THE MINNESOTA MANUAL ON UNIFORM TRAFFIC CONTROL DEVICES, INCLUDING APPENDIX B DATED SEPTEMBER, 1985.
5. APPROXIMATELY 900 LINEAR FEET OF 4" YELLOW LANE TAPE ARE REQUIRED FOR THIS PORTION OF PHASE III TRAFFIC CONTROL.

M.U.T.C.D. CODE	SIZE	TRAFFIC CONTROL PHASE I	TRAFFIC CONTROL PHASE II	TRAFFIC CONTROL PHASE III	M.U.T.C.D. CODE	SIZE	TRAFFIC CONTROL PHASE I	TRAFFIC CONTROL PHASE II	TRAFFIC CONTROL PHASE III	M.U.T.C.D. CODE	SIZE	TRAFFIC CONTROL PHASE I	TRAFFIC CONTROL PHASE II	TRAFFIC CONTROL PHASE III	SYMBOL	TRAFFIC CONTROL PHASE I	TRAFFIC CONTROL PHASE II	TRAFFIC CONTROL PHASE III
RI-1	30" x 30"	0	4	0	STEADY YELLOW					WI-4 (R)	36" x 36"	0	1	0	↙	50	72	89
STEADY RED															⊗			
RI-1	36" x 36"	2	2	2	STEADY YELLOW													
RI-1	30" x 30"	8	9	9	W3-1	36" x 36"	4	4	2									
RI-4	18" x 6"				YELLOW FLASHER													
STEADY RED																		
RI-1	36" x 36"	10	9	9	W3-1	36" x 36"	5	5	7									
RI-4	18" x 6"				YELLOW FLASHER													
R3-8A	60" x 48"	1	1	1	W4-2(L)	48" x 48"	0	1	0									
R4-7	24" x 30"	8	10	15	W10-1	36" DIA.	2	2	2									
X4-2	18" x 18"																	
YELLOW FLASHER					W20-1	48" x 48"	15	15	16									
RI1-2	48" x 30"	0	2	0	YELLOW FLASHER													
TYPE III	8 FT.				W20-1	48" x 48"	1	1	1									
RI1-3	60" x 30"	1	0	0	YELLOW FLASHER													
RI1-3	60" x 30"	0	1	1	W20-2	48" x 48"	1	1	1									
TYPE III	8 FT.																	
YELLOW FLASHER					W20-3	48" x 48"	0	1	1									
RI1-4	60" x 30"	2	2	2	YELLOW FLASHER													
M4-10(L)	48" x 18"				W20-5	48" x 48"	2	0	1									
YELLOW FLASHER																		
RI1-4	60" x 30"	1	1	1	YELLOW FLASHER													
TYPE III	8 FT.				W20-5	48" x 48"	0	2	0									
YELLOW FLASHER																		
M4-10(R)	48" x 18"	1	2	1	YELLOW FLASHER													
TYPE III	8 FT.				W20-X3	48" x 48"	1	0	1									
YELLOW FLASHER																		
WI-6(L)	48" x 24"	1	1	3	STEADY YELLOW													
WI-6(R)	48" x 24"																	
YELLOW FLASHER																		
WI-6(R)	48" x 24"	0	1	0	YELLOW FLASHER													
TYPE III	8 FT.																	
TYPE III (L)	8 FT.	1	9	6	TYPE III	8 FT.	0	0	1									
TYPE III (R)	8 FT.	3	6	14	YELLOW FLASHER													

NOTES:



1. THE TRAFFIC CONTROL DEVICES AND QUANTITIES SHOWN ON THIS SHEET WILL BE INSTALLED BY THE CONTRACTOR ACCORDING TO THE PHASE I, PHASE II AND PHASE III TRAFFIC CONTROL PLANS SHOWN ON SHEETS 38-52
2. ALL TRAFFIC CONTROL DEVICES SHALL CONFORM TO THE MINNESOTA MANUAL ON UNIFORM TRAFFIC CONTROL DEVICES, INCLUDING APPENDIX B DATED SEPTEMBER, 1985.

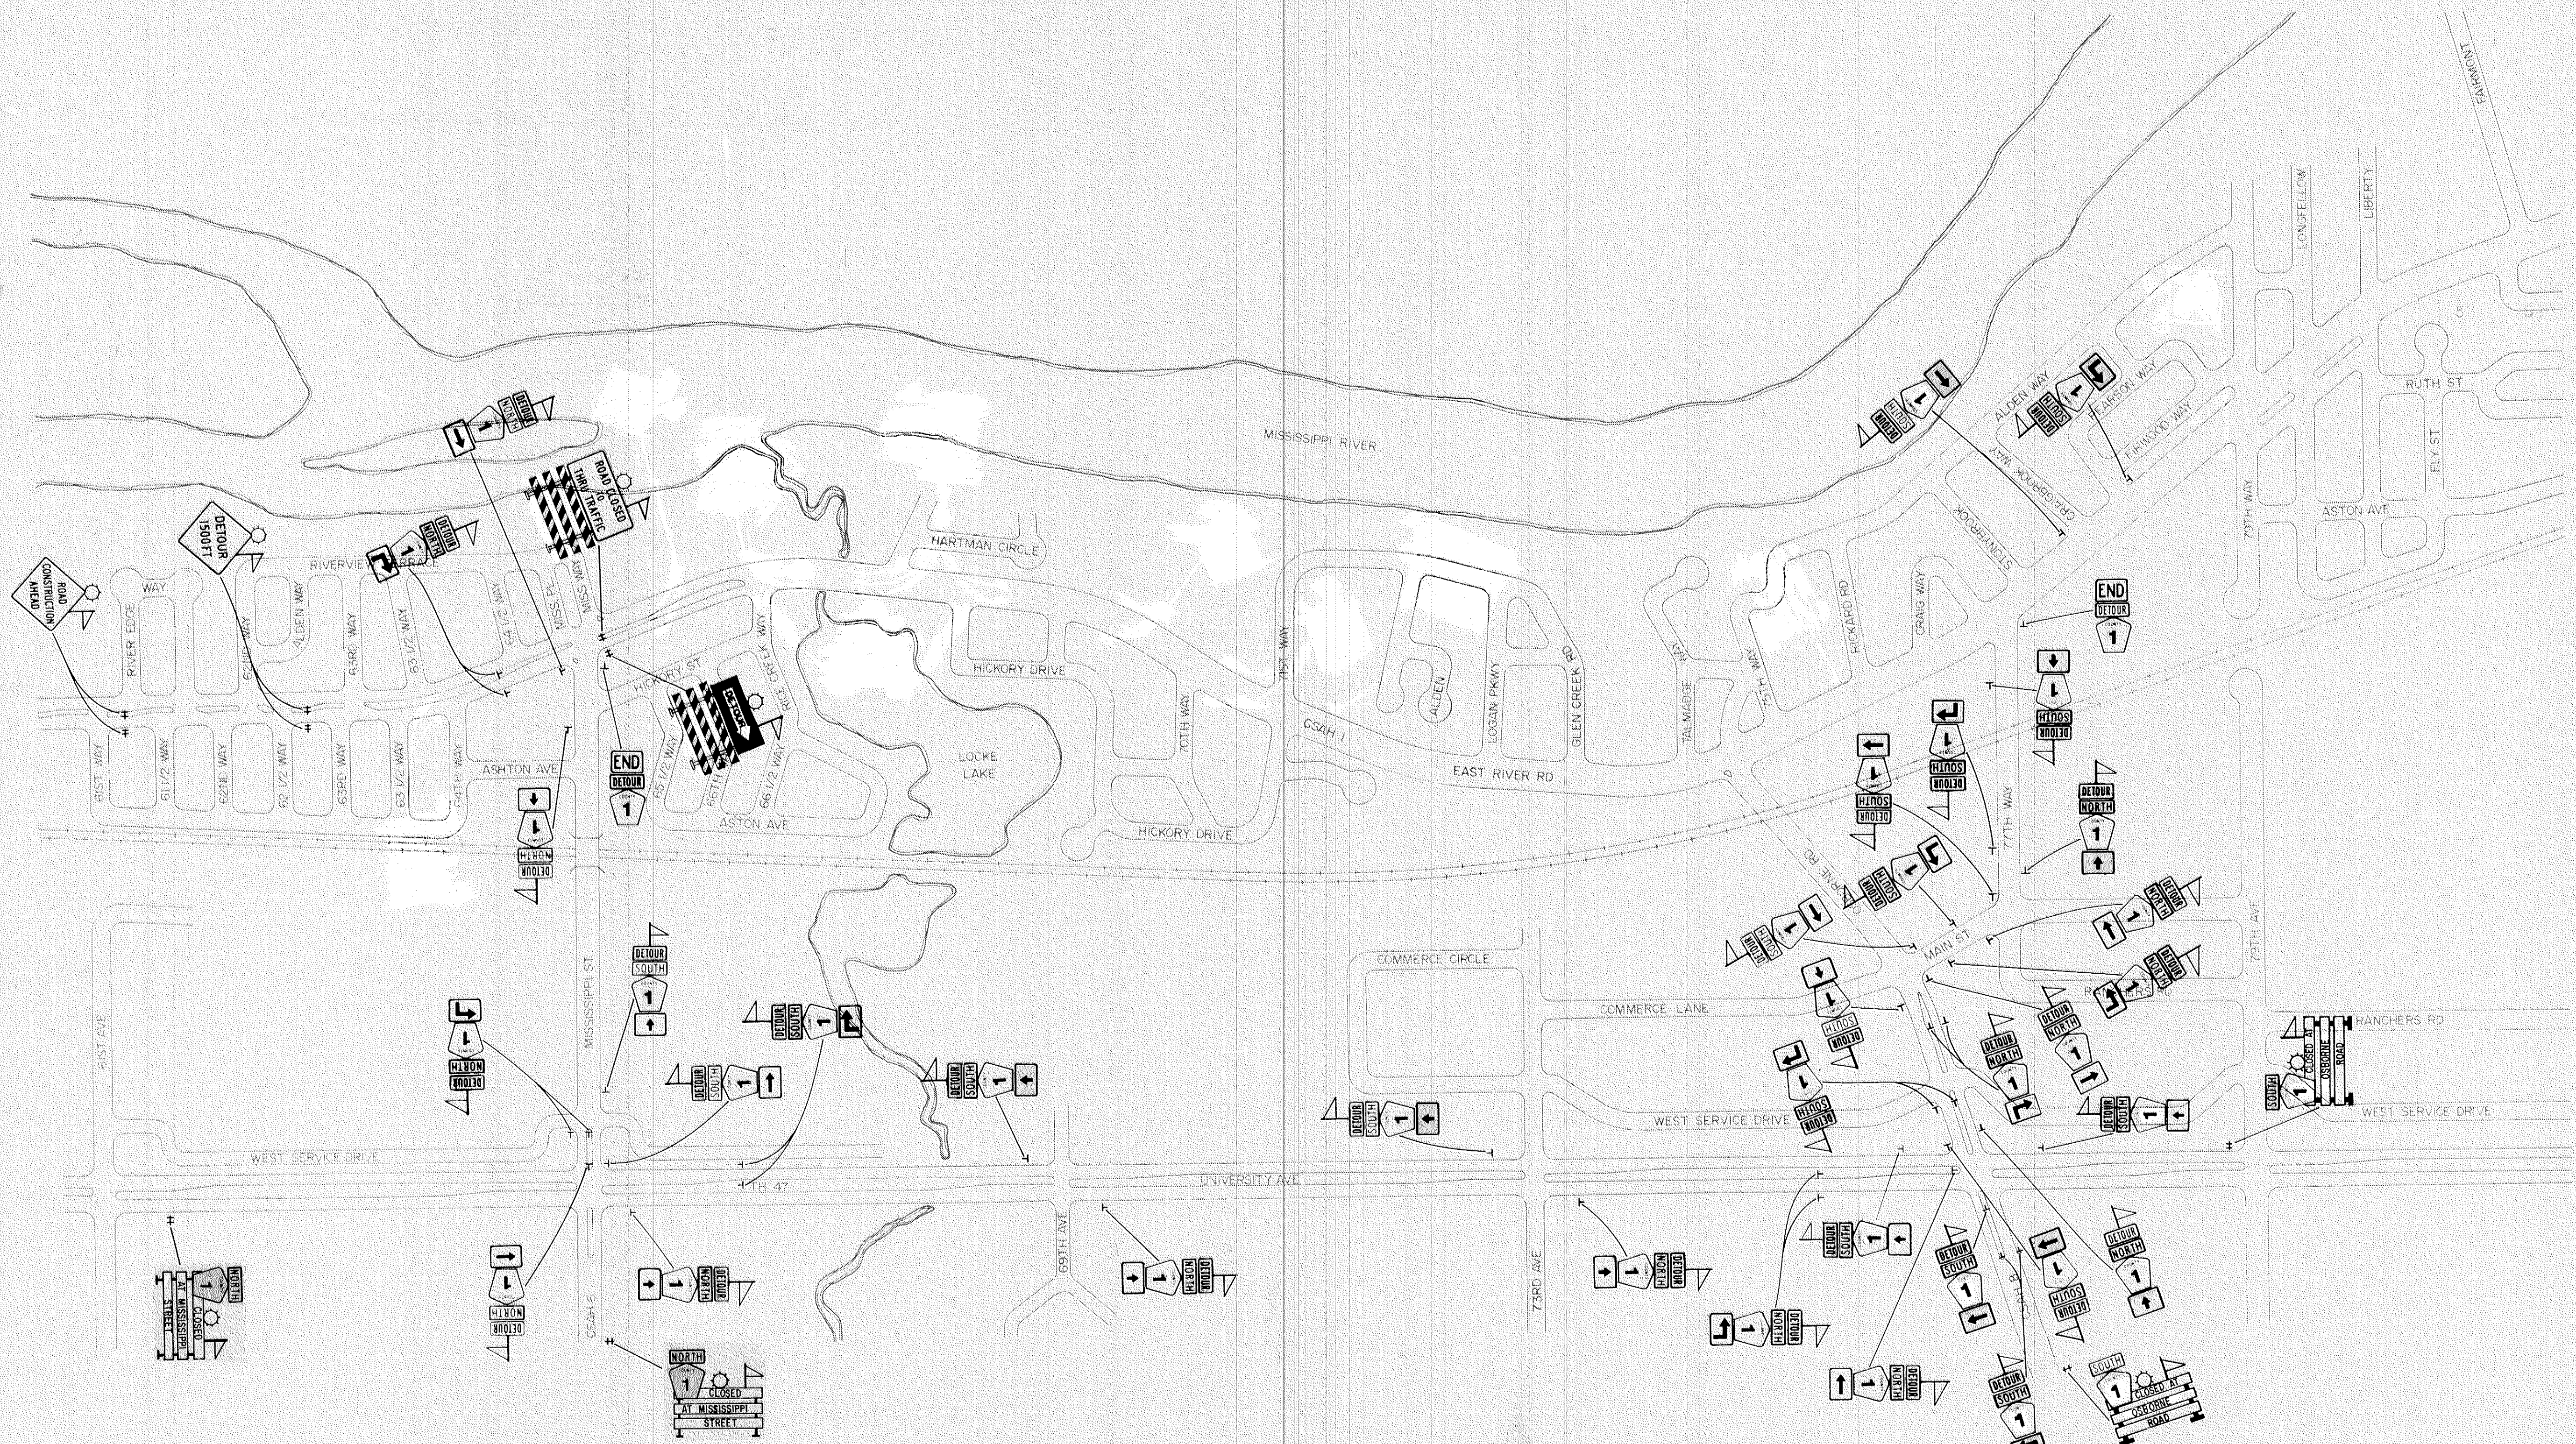

NOTES:

1. LOCATIONS OF ALL SIGNS ARE APPROXIMATE. EXACT LOCATIONS WILL BE DETERMINED IN THE FIELD BY THE ENGINEER.
2. SEE SHEET 55 FOR SIGNING SCHEDULE.
3. ALL BARRICADES WILL BE PROPERLY WEIGHTED WITH SANDBAGS.
4. ALL TRAFFIC CONTROL DEVICES SHALL CONFORM TO THE MINNESOTA MANUAL ON UNIFORM TRAFFIC CONTROL DEVICES INCLUDING APPENDIX B DATED SEPTEMBER, 1985.
5. IF PROJECT S.P. 02-601-29 (RICE CREEK BRIDGE CONSTRUCTION) IS COMPLETED BEFORE S.P. 02-601-33 AND S.P. 02-608-07, THE DETOUR LAYOUT SHOWN ON THIS SHEET WILL BE INSTALLED BY THE CONTRACTOR.

**OSBORNE ROAD / EAST RIVER ROAD
PHASE IV - DETOUR LAYOUT**

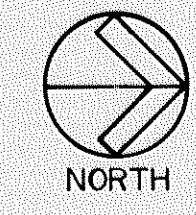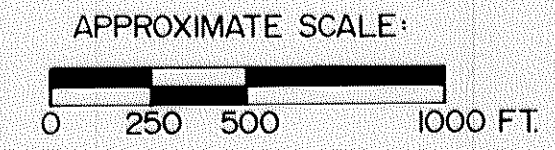

NOTES:



- 1) SEE SPECIAL PROVISIONS FOR CONTRACTORS RESPONSIBILITY FOR LOCATION OF UTILITIES.
- 2) ALL PEDESTRIAN INDICATIONS SHALL BE 12"x12".
- 3) DIRECTIONAL SIGNS TO BE INSTALLED ON MAST ARMS (2) AND (4) DIRECTIONAL AND REGULATORY SIGNS TO BE INSTALLED ON MAST ARMS (1) AND (3) SEE SPECIAL PROVISIONS.
- 4) LOOP DETECTORS/CONDUCTORS SHALL BE CROSS LINKED POLYETHYLENE (XLP). SEE SPECIAL PROVISIONS.
- 5) A 3/4" HALF COUPLING, 3/4" PIPE NIPPLE AND CONDUIT OUTLET BODY FOR EMERGENCY VEHICLE PRE-EMPTION EQUIPMENT SHALL BE FURNISHED AND INSTALLED APPROXIMATELY 20' FROM THE END OF THE MAST ARMS AT POLES (1) AND (3) AND FOUR FEET FROM THE END OF MAST ARM POLE (4).
- 6) SEE SPECIAL PROVISIONS FOR A100 POLE FOUNDATION DETAIL.
- 7) REMOVE AND SALVAGE INPLACE SIGNAL SYSTEM. SEE SPECIAL PROVISIONS.

1 TYPE A100-A-45-D40-9 (SEE NOTE 6)
 A100 POLE FOUNDATION
 2-ONE WAY SIGNALS-OVERHEAD
 TYPE 20C-POLE MOUNTED 270°
 ONE WAY EVP DETECTOR AND LIGHT
 LUMINAIRE-250 WATT H.P.S.(APPROX.340°)
 2-PEDESTRIAN PUSH BUTTONS AND SIGNS

EXTEND INTO H.H.1
 3"R.S.C.
 4-12/c#12
 1-3/c#12
 1-3/c#20
 4-1/c#10

2 TYPE P100-A-35
 P100 POLE FOUNDATION
 ONE WAY SIGNAL OVERHEAD
 TYPE 10C-POLE MOUNTED 270°
 2-PEDESTRIAN PUSH BUTTONS AND SIGNS

EXTEND INTO H.H.6
 3"R.S.C.
 3-12/c#12
 1-3/c#12

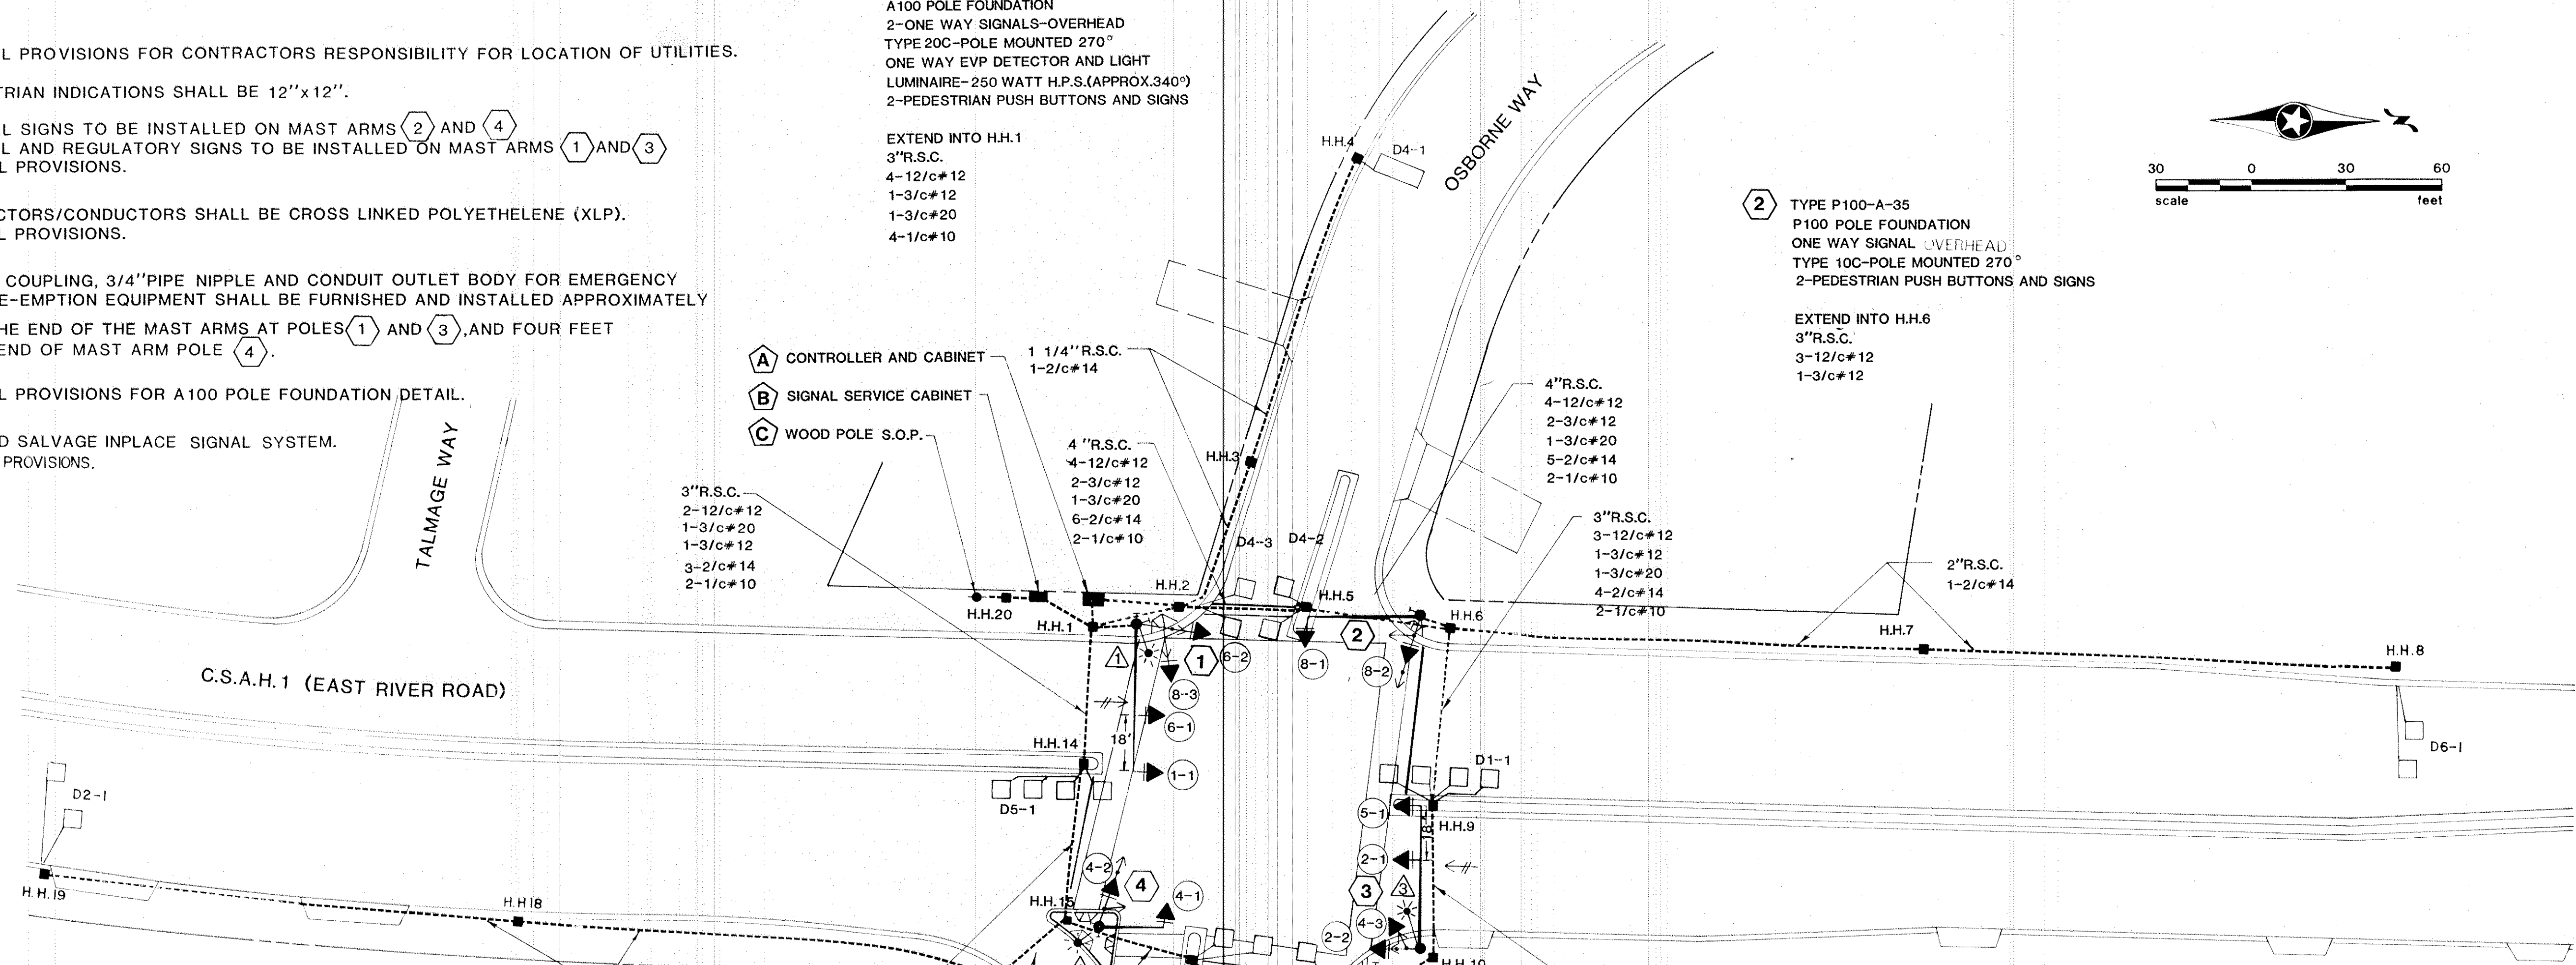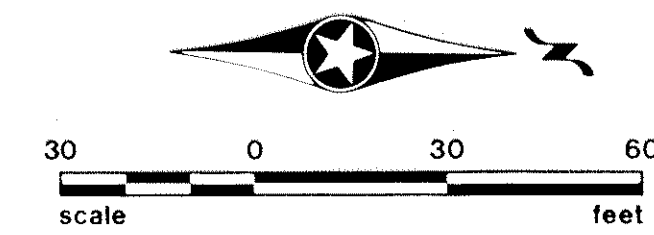

SIGNAL INDICATIONS

FACE	PHASE	FLASH	R	Y	G	RLTA	YLTA	GLTA
1-1	1	R				12	12	12
2-1	2	R	12	12	12			
2-2	2	R	12	12	12			
4-1	4	R	12	12	12			
4-2	4	R	12	12	12			
5-1	5	R				12	12	12
6-1	6	R	12	12	12			
6-2	6	R	12	12	12			
8-1	8	R	12	12	12			
8-2	8	R	12	12	12			
8-3	8	R	12	12	12			

NOTE: ALL DIMENSIONS SHOWN ARE IN INCHES.
 PHASES 4 AND 8 SHALL RUN CONCURRENT.

LOOP DETECTORS

NUMBER	SIZE	FUNCTION	DISTANCE
D1-1	MULTIPLE	1	—
D2-1	2-6'x6'	1	330'
D4-1	6'x15'	3,8	150'
D4-2	2-6'x6'	1	—
D4-3	2-6'x6'	7	—
D5-1	MULTIPLE	1	—
D6-1	2-6'x6'	1	330'
D8-1	6'x15'	1,8	200'
D8-2	6'x6'	3,8	200'
D8-3	4-6'x6'	1	—
D8-4	2-6'x6'	7	—

FUNCTIONS:

- 1) CALL AND EXTEND
- 2) CALL ONLY
- 3) EXTEND ONLY
- 4) CALL ONLY DENSITY
- 5) DELAYED CALL ONLY
- 6) DELAYED CALL ONLY-DENSITY
- 7) DELAYED CALL-IMMEDIATE EXTEND
- 8) CARRY OVER (STRETCH)
- 9) ADVISORY DETECTOR
- 10) SAMPLING DETECTOR
- 11) SPECIAL FUNCTION

4 TYPE P80-A-20-D40-9
 P80 POLE FOUNDATION
 ONE WAY SIGNAL - OVERHEAD
 TYPE 10C-POLE MOUNTED 270°
 LUMINAIRE-250 WATT H.P.S.(APPROX 130°)
 2-PEDESTRIAN PUSH BUTTONS AND SIGNS

EXTEND INTO H.H.15
 3"R.S.C.
 2-12/c#12
 1-3/c#20
 1-3/c#12
 2-1/c#10

A CONTROLLER AND CABINET
 CABINET FOUNDATION
 EXTEND INTO H.H.1
 4"R.S.C.
 4-12/c#12
 2-3/c#12
 2-3/c#20
 3-2/c#14
 3-1/c#6
 EXTEND INTO H.H.2
 4"R.S.C.
 4-12/c#12
 2-3/c#12
 1-3/c#20
 8-2/c#14
 BETWEEN H.H.1 AND H.H.2
 1 1/4" R.S.C.
 2-1/c#10


B SIGNAL SERVICE CABINET
 CABINET FOUNDATION
 EXTEND INTO H.H.20
 2"R.S.C.
 3-1/c#6
 EXTEND INTO H.H.1
 METERED SIGNAL POWER
 1 1/4"R.S.C.
 3-1/c#6
 UNMETERED STREET LIGHTING POWER
 1"R.S.C.
 4-1/c#10

C WOOD POLE S.O.P.
 (RELOCATED BY N.S.P.)
 1 1/4"R.S.C. RISER AND WEATHERHEAD
 3-1/c#6
 EXTEND INTO H.H.20
 1 1/4"R.S.C.
 3-1/c#6


3 TYPE A100-A-45-D40-9
 A100 POLE FOUNDATION (SEE NOTE 6)
 2-ONE WAY SIGNALS-OVERHEAD
 TYPE 20C-POLE MOUNTED 270°
 ONE WAY EVP DETECTOR AND LIGHT
 LUMINAIRE-250 WATT H.P.S.(APPROX.330°)

EXTEND INTO H.H.10
 3"R.S.C.
 3-12/c#12
 1-3/c#20
 2-1/c#10
 PEDESTRIAN PUSH BUTTON STATION
 2 PEDESTRIAN PUSH BUTTONS AND SIGNS
 EXTEND INTO H.H.11
 1 1/4"R.S.C.
 1-3/c#12

CONTROLLER PHASING

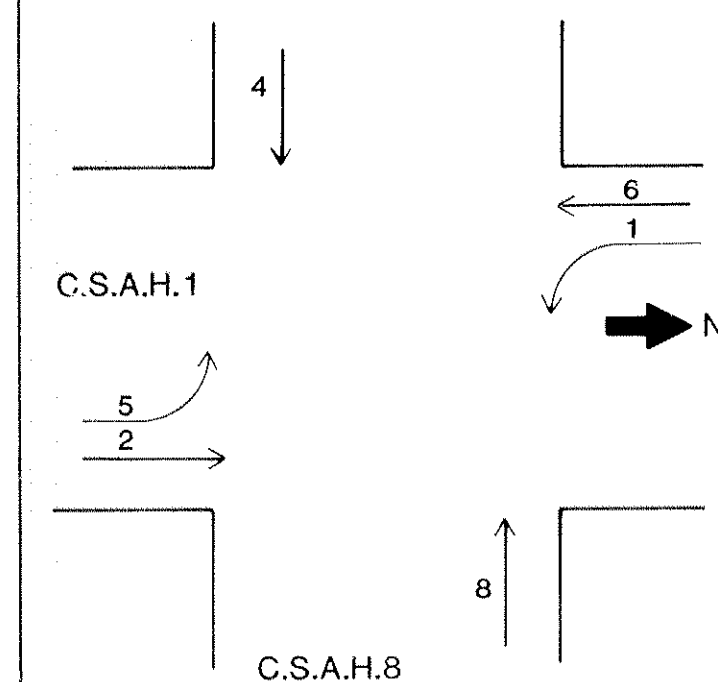

PEDESTRIAN PHASING

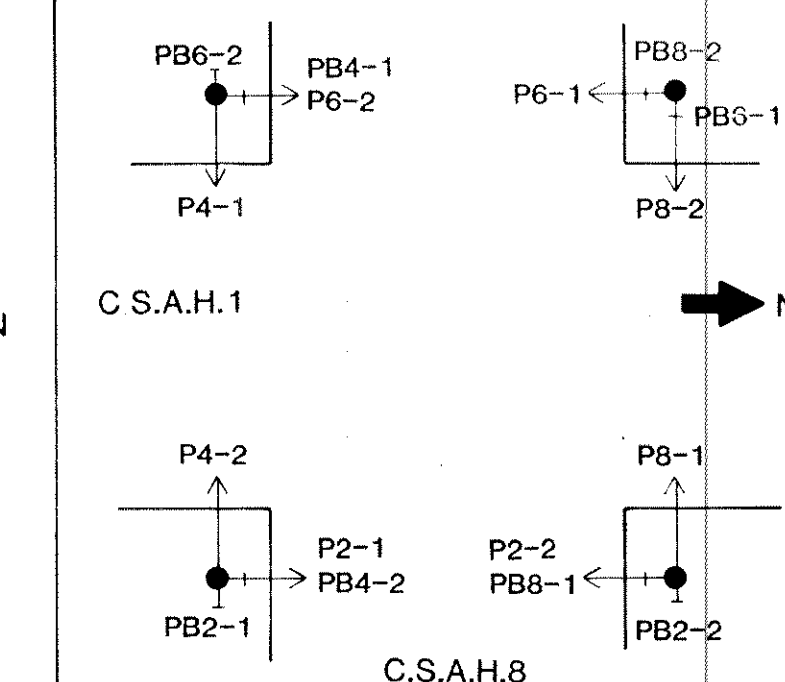

"ELECTRICAL ENGINEER CERTIFICATION"
 I hereby certify that this plan was prepared by me or under my direct supervision and that I am a duly Registered Professional Engineer under the laws of the State of Minnesota.
 Date: _____ Reg.No. 4713



SHORT - ELLIOTT - HENDRICKSON, INC.
 Saint Paul, Minnesota • Chippewa Falls, Wisconsin

SIGNAL SYSTEM INTERSECTION LAYOUT

EAST RIVER ROAD (C.S.A.H. 1) AT OSBORNE ROAD (C.S.A.H. 8)


S.P. 02-608-07,
 S P 02-601-33 & S P 127-332-02

FILE NO: 86138
 DATE: 6/26/86
 58


SURVEY	CHECKED BY:	NO.	DATE	REVISIONS
DESIGN M.K.	G.V.W.		7/8	PER ANOKA COUNTY
DRAWN G.N.				

I HEREBY CERTIFY THAT THIS PLAN WAS PREPARED BY ME OR UNDER MY DIRECT SUPERVISION AND THAT I AM A DULY REGISTERED PROFESSIONAL ENGINEER UNDER THE LAWS OF THE STATE OF MINNESOTA.
 REG. NO. 9089


CONTROLLER CABINET

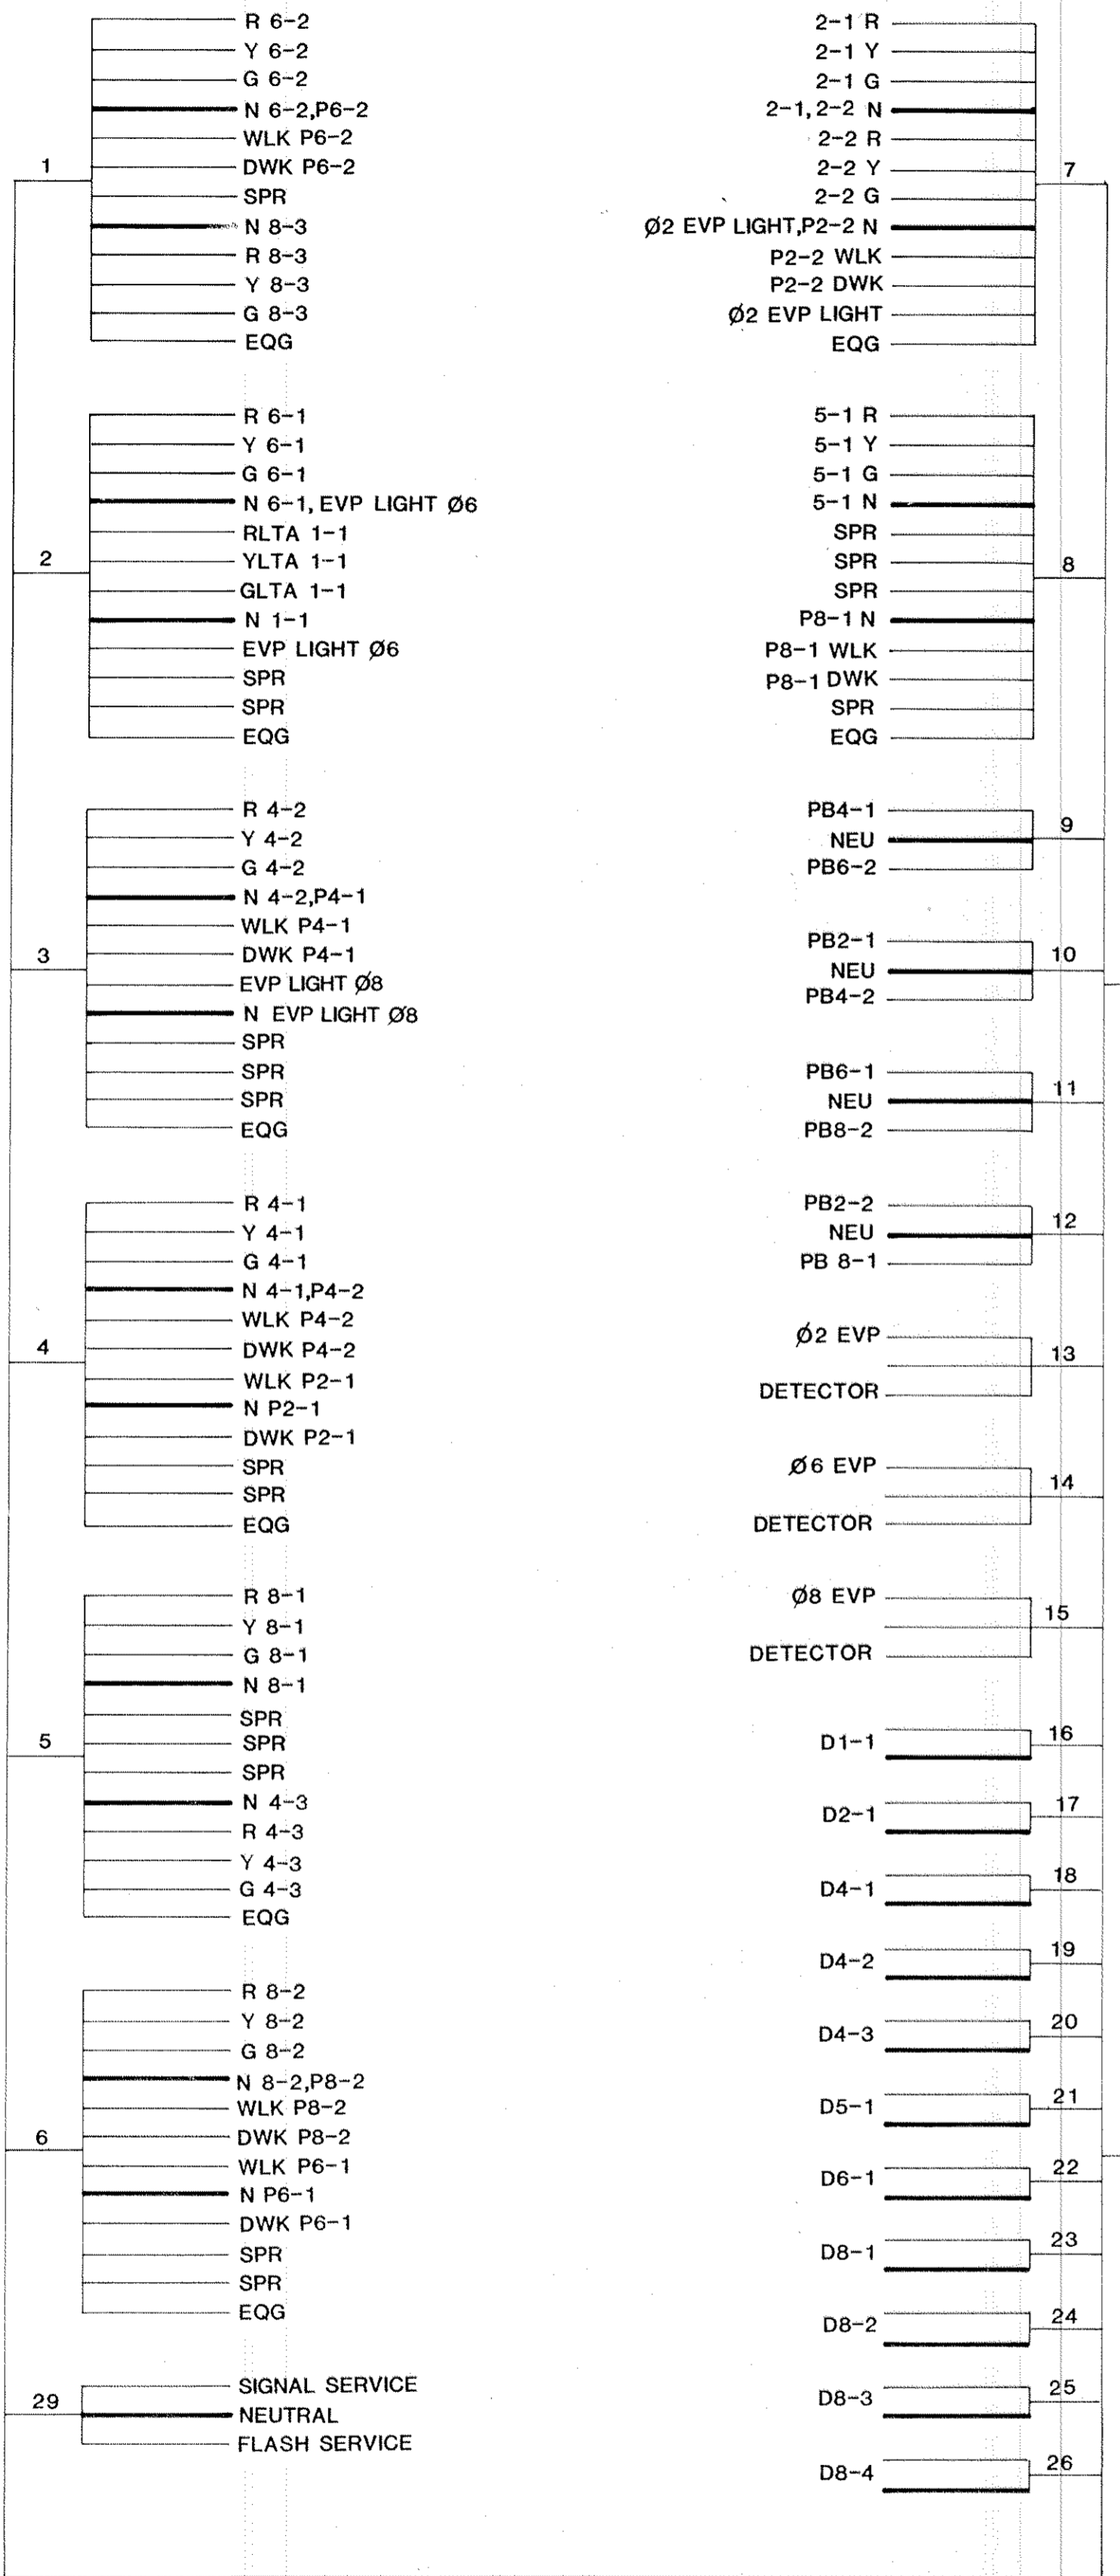

SIGNAL SERVICE CABINET

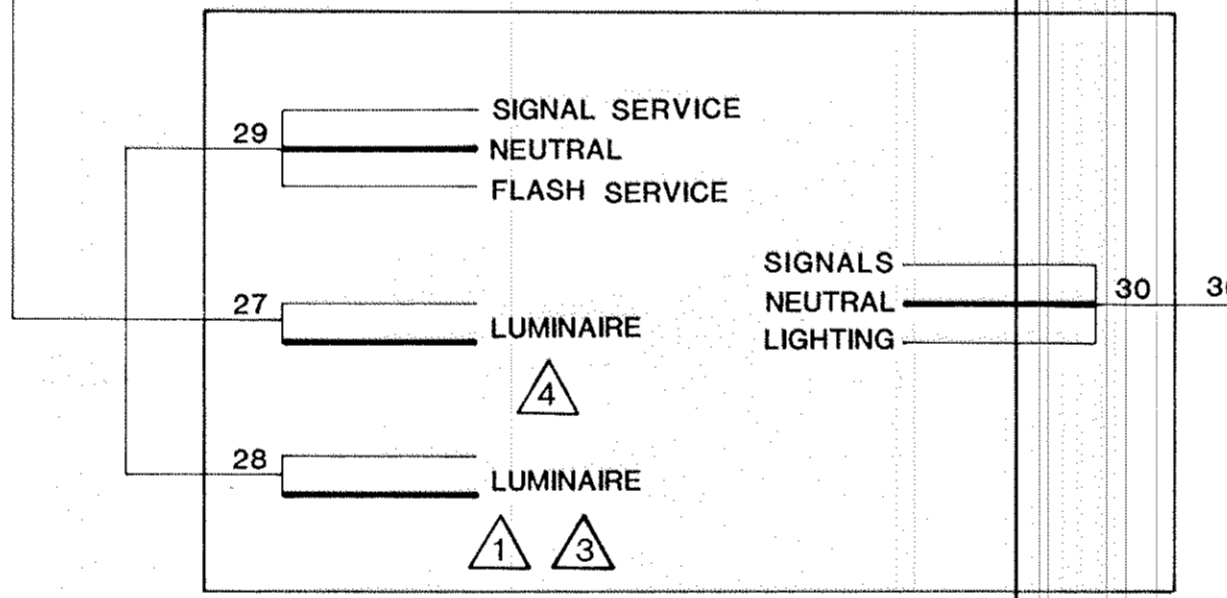


"ELECTRICAL ENGINEER CERTIFICATION"
 I hereby certify that this plan was prepared by me or under my direct supervision and that I am a duly Registered Professional Engineer under the laws of the State of Minnesota.
 Date: _____ Reg.No. 473


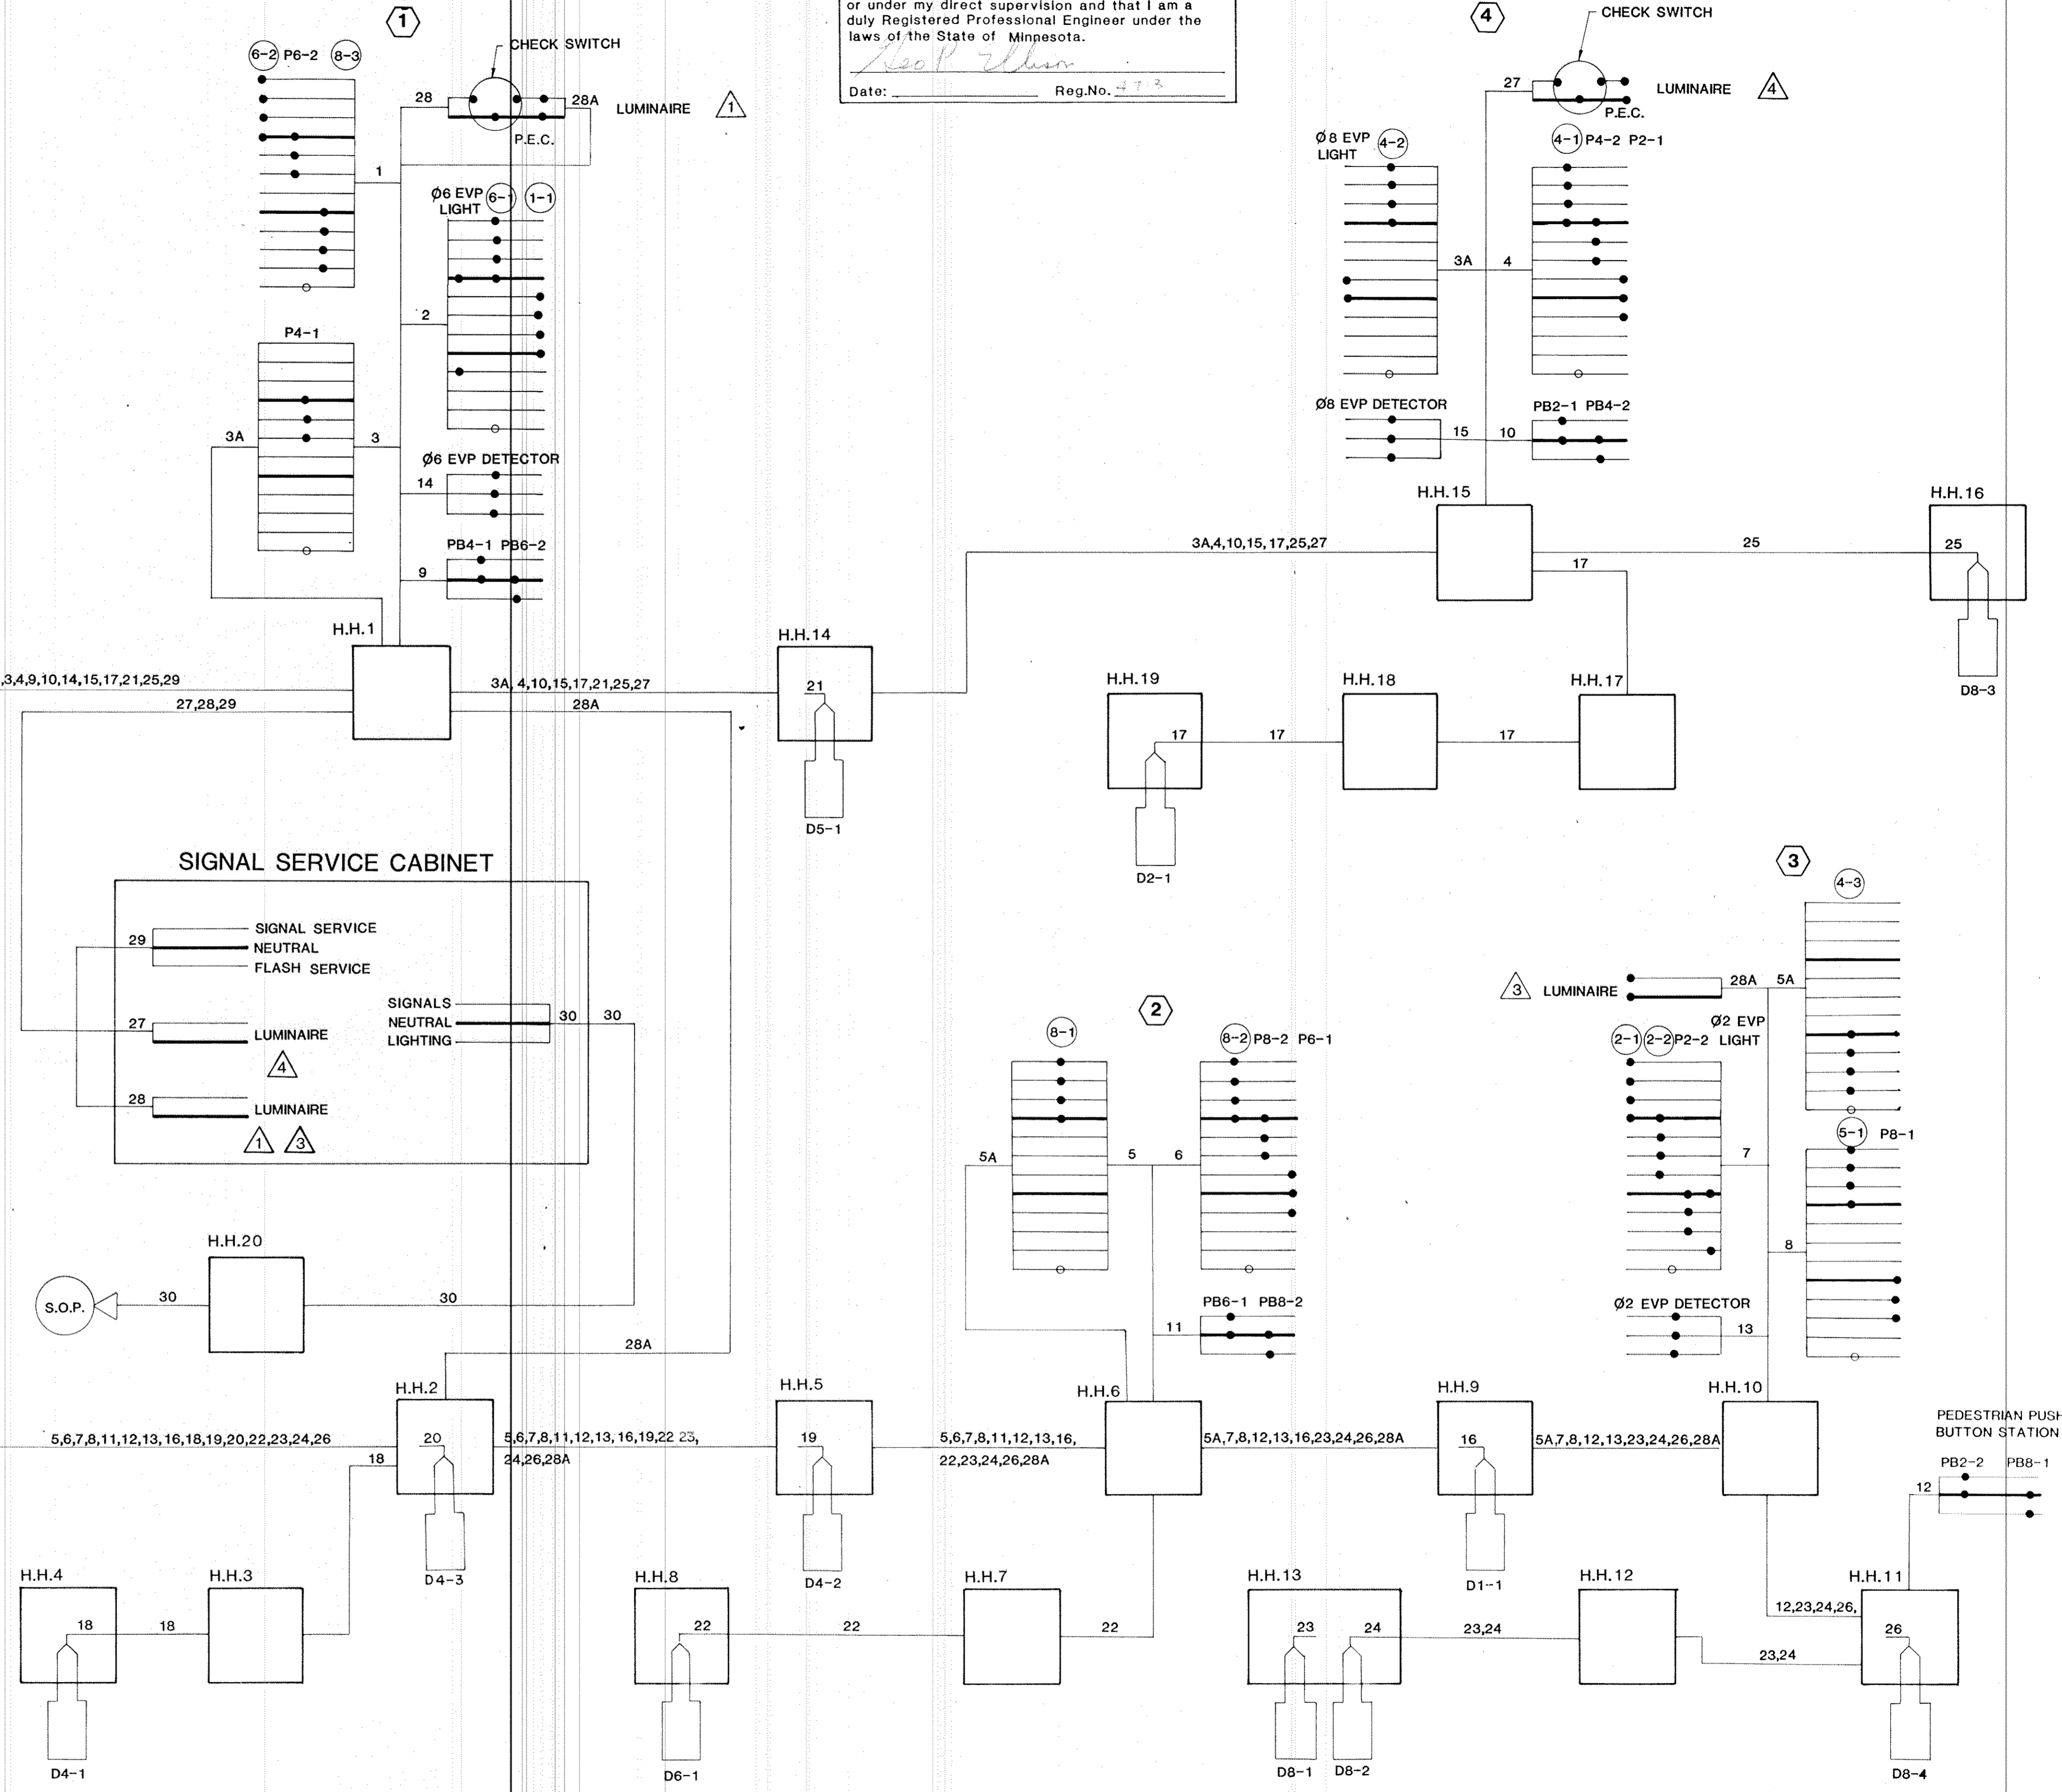


LOOP DETECTOR DETAIL "A"



PLAN VIEW
(NOT TO SCALE)

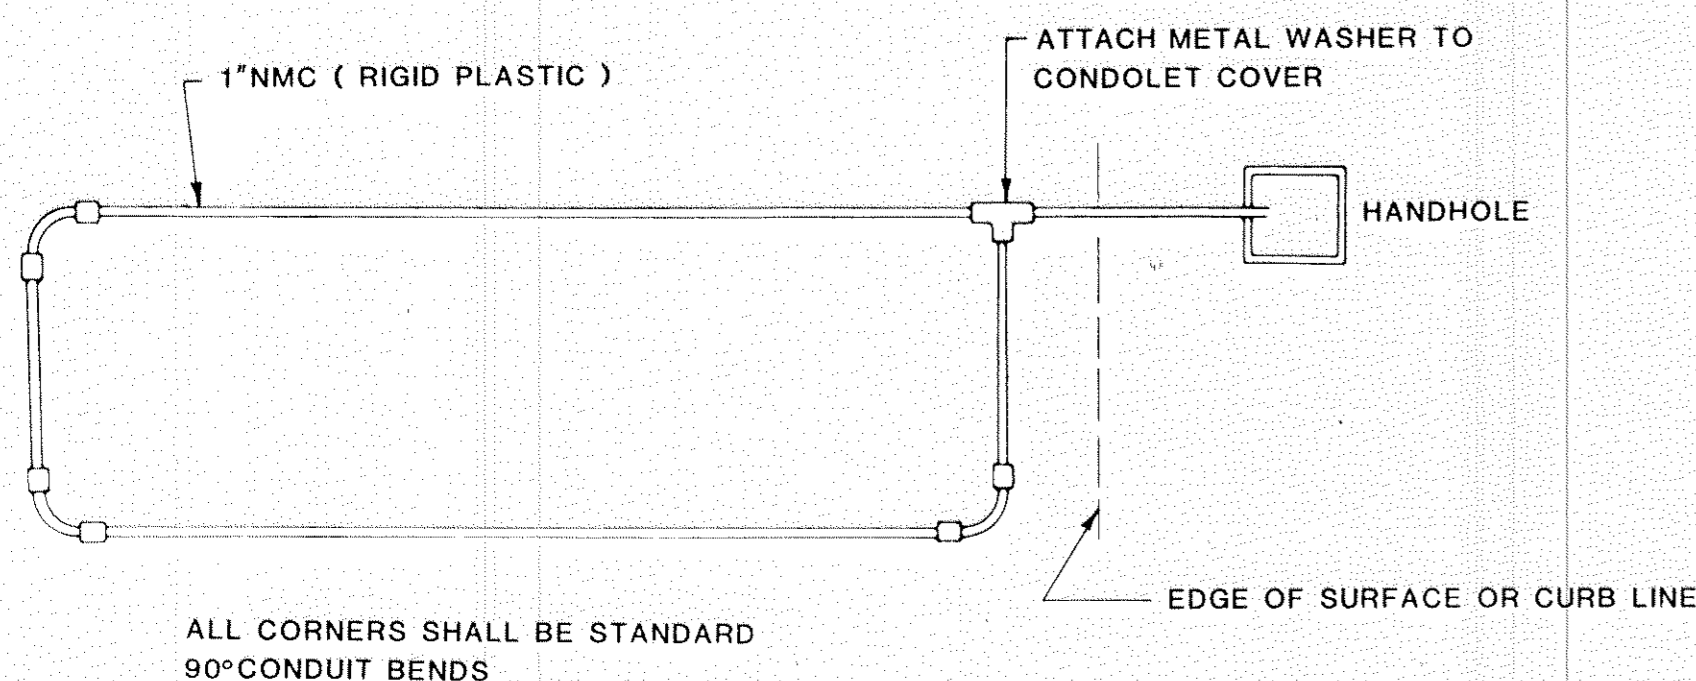

DRAINAGE DETAILS

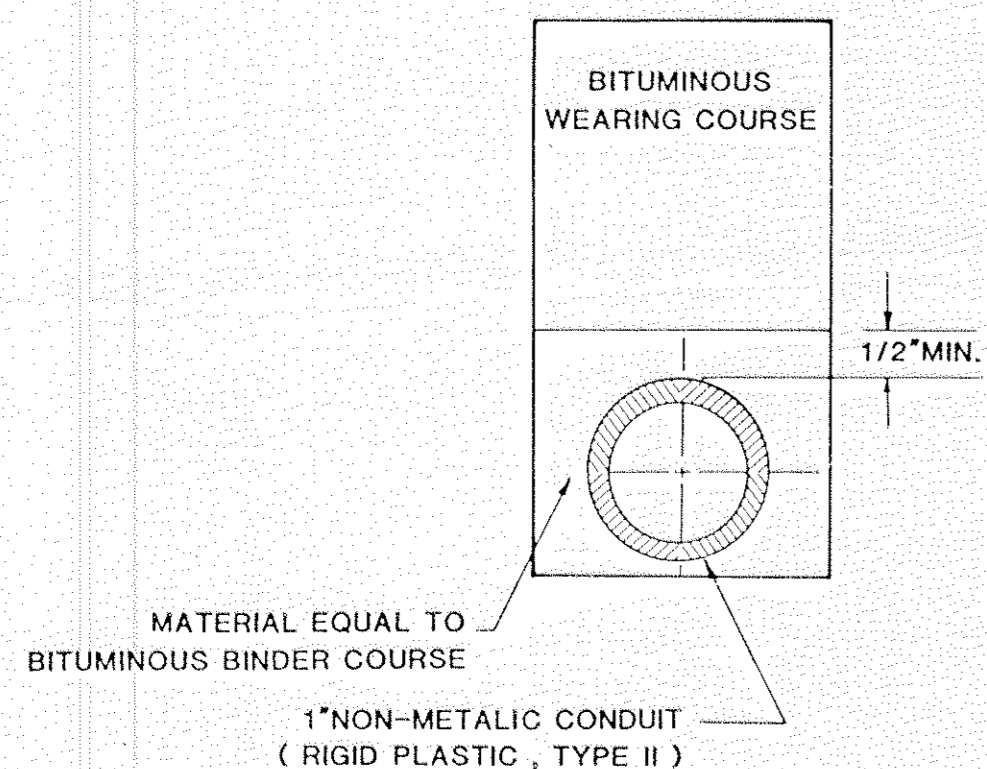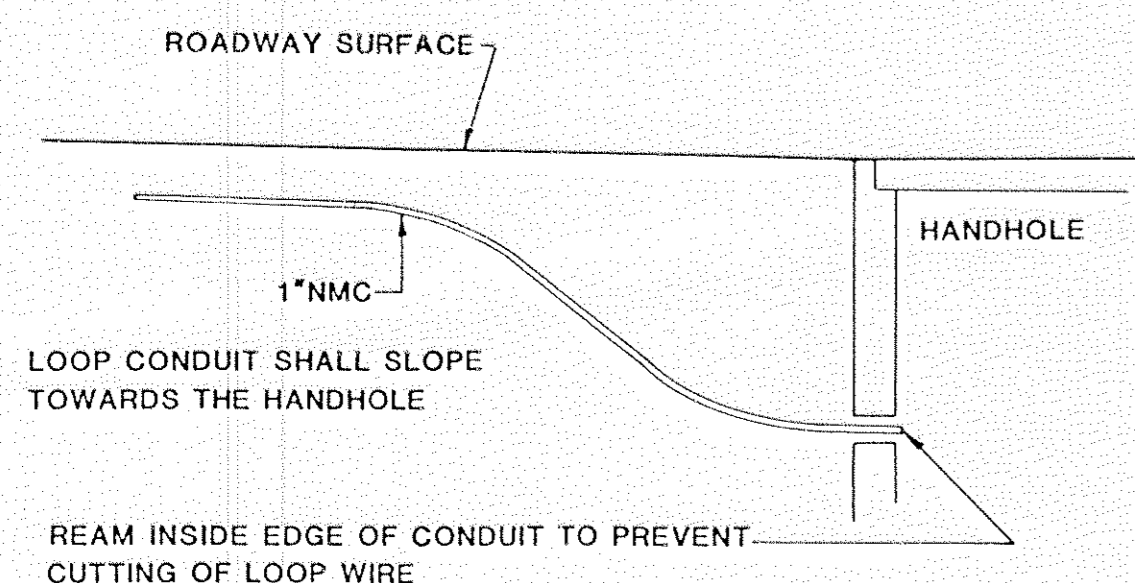


PEDESTRIAN PUSH BUTTON MOUNTING DETAIL

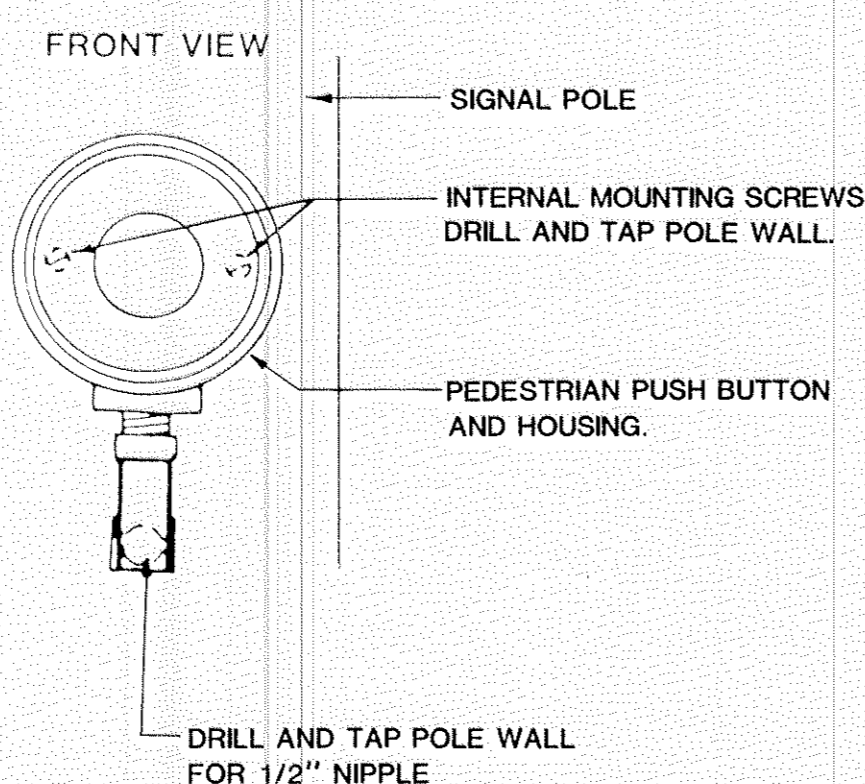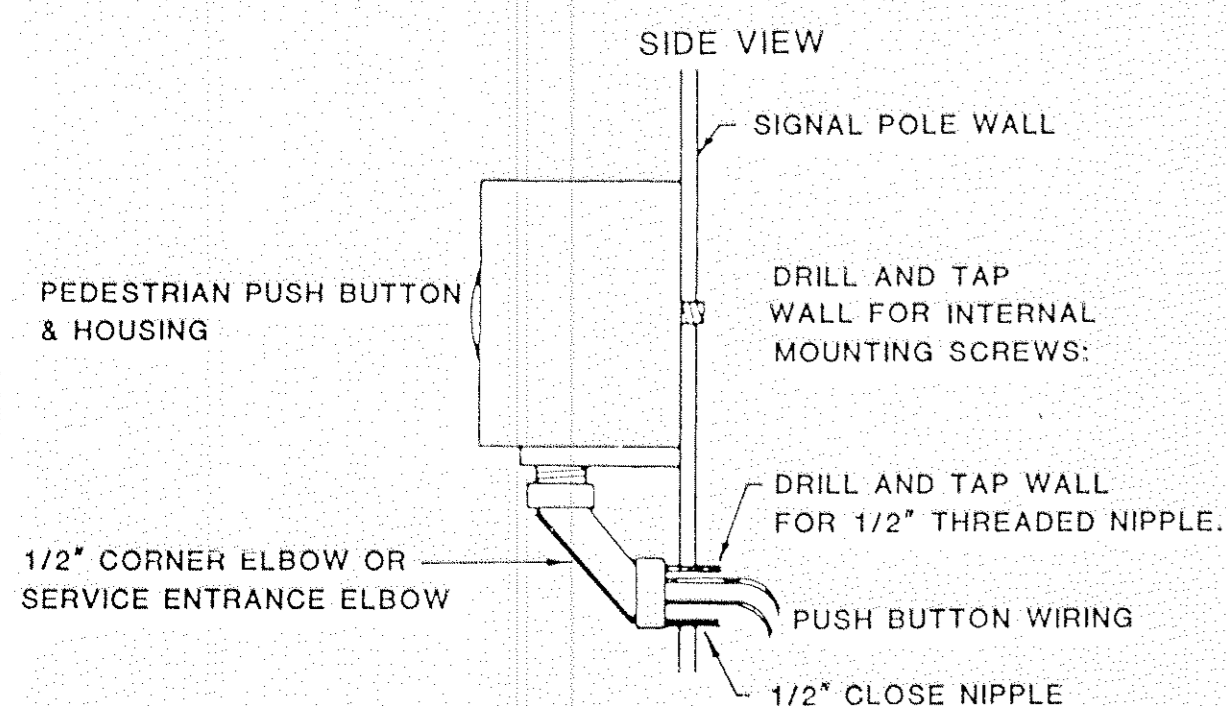

LOOP DETECTOR DETAIL "B"

PLAN VIEW
(NOT TO SCALE)
(TYPICAL)

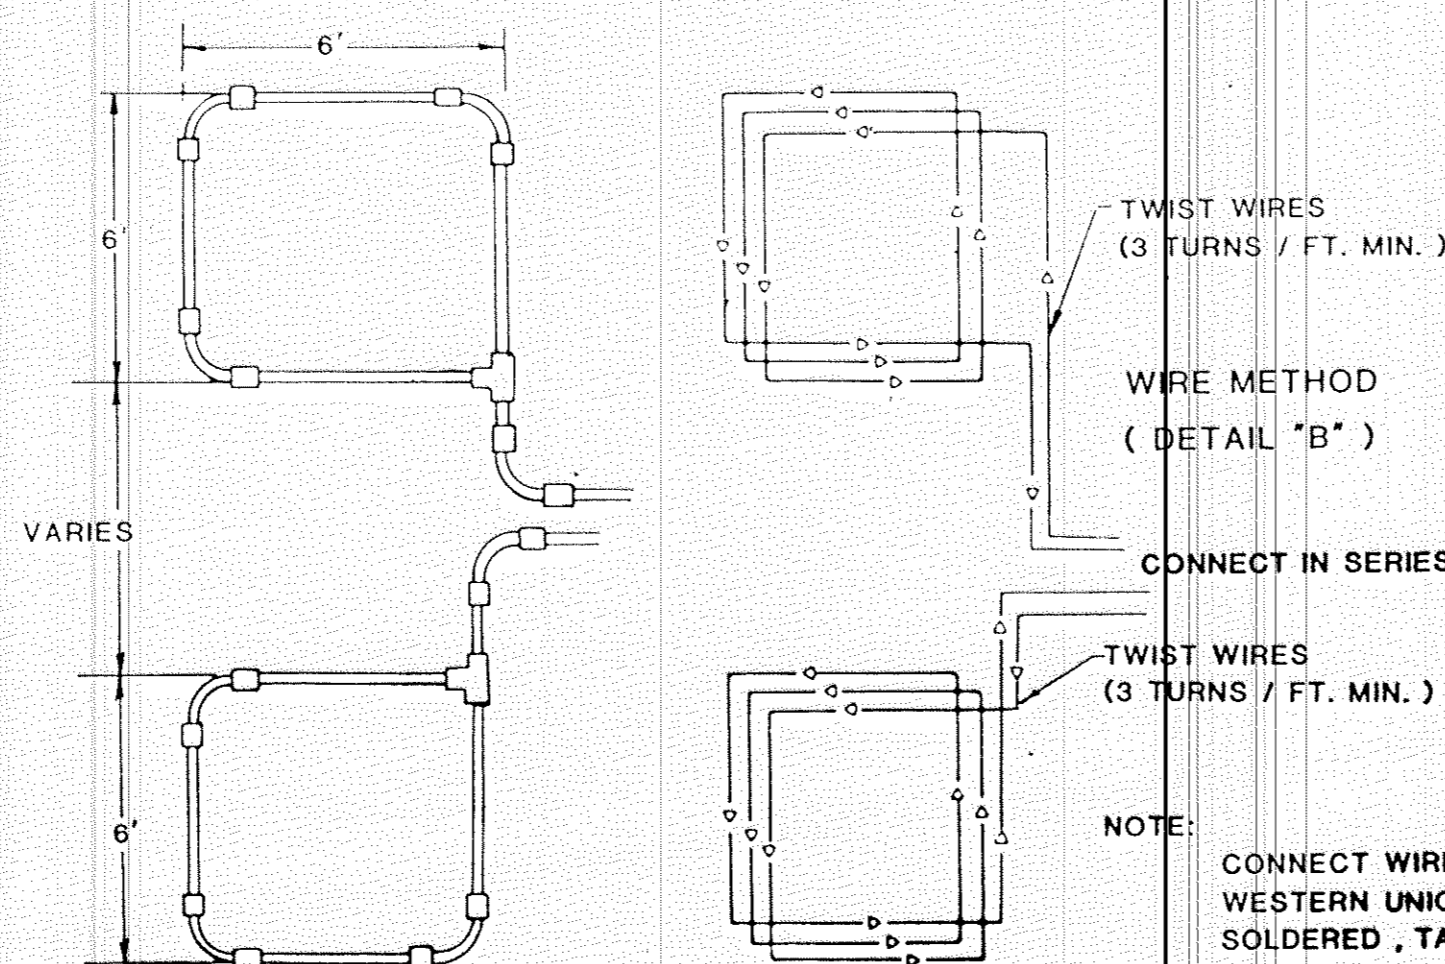

NOTE:
LOOP DETECTOR WIRES SHALL BE CROSS LINKED POLYETHYLENE (XLP). SEE SPECIAL PROVISIONS.

CONDUIT INSTALLATION DETAIL FOR LOOP DETECTOR

LOOP DETECTOR CONDUITS ARE TO BE INSTALLED IN 3" CUT TRENCHES AS SHOWN ON PLANS. INSTALL EACH COMPLETE DETECTOR ASSEMBLY WITH THE DETECTOR WIRE PULLED THROUGH THE COMPLETE ASSEMBLY TO HANDHOLE. WHERE APPROPRIATE, PLACE DETECTOR CONDUIT IN BITUMINOUS BINDER COURSE PRIOR TO PLACEMENT OF THE WEARING COURSE. THE DEPTH OF THE TRENCH AND THE RESULTANT PLACEMENT OF THE DETECTOR CONDUIT SHALL BE SUCH THAT THE ENTIRE DETECTOR ASSEMBLY DRAINS INTO THE HANDHOLE. BACKFILL AND COMPACT THE TRENCHES WITH MATERIAL EQUIVALENT TO THE MATERIAL REMOVED.

ABBREVIATIONS

EQUIPMENT AND INDICATIONS

- R - RED
- Y - YELLOW
- G - GREEN
- WLK - WALK
- NEU, N - NEUTRAL
- DWK - DON'T WALK
- LUM - LUMINAIRE
- DNL - DOWNLIGHT
- H.H. - HANDHOLE
- EQG - EQUIPMENT GROUND
- R.S.C. - RIGID STEEL CONDUIT
- GLTA - GREEN LEFT TURN ARROW
- YRTA - YELLOW RIGHT TURN ARROW
- D2-1(eg) - DETECTOR - PHASE "2"
- GR.R - GROUND ROD
- SER. - SERVICE
- PAI - PEDESTRIAN INDICATIONS
- 2-1(eg) - SIGNAL HEADS - PHASE "2"
- SPR. - SPARE CONDUCTORS
- N.M.C. - NON METALLIC CONDUIT
- E.V.P. - EMERGENCY VEHICLE PRE-EMPTION
- J.B. - JUNCTION BOX
- W.P. - WOOD POLE
- P.E.C. - PHOTOELECTRIC CELL
- S.O.P. - SOURCE OF POWER.

CONDUCTOR COLOR CODE

- R - RED
- O - ORANGE
- BL - BLUE
- WH - WHITE
- G - GREEN
- BLK - BLACK
- R/BLK - RED WITH BLACK TRACER
- O/BLK - ORANGE WITH BLACK TRACER
- BL/BLK - BLUE WITH BLACK TRACER
- WH/BLK - WHITE WITH BLACK TRACER
- BLK/WH - BLACK WITH WHITE TRACER
- G/BLK - GREEN WITH BLACK TRACER

LEGEND

- CONTROLLER AND SERVICE EQPT. NO.5
- SIGNAL BASE NO.
- SIGNAL FACE NO.
- LUMINAIRE NO.
- CONTROLLER AND CABINET
- CONTROLLER AND CABINET-IN PLACE
- HANDHOLE
- HANDHOLE-IN PLACE
- RIGID STEEL CONDUIT (R.S.C.)
- RIGID STEEL CONDUIT (R.S.C.)-IN PLACE
- SIGNAL FACE WITH BACKGROUND SHIELD
- SIGNAL FACE W/O BACKGROUND SHIELD
- SIGNAL FACE-IN PLACE
- PEDESTRIAN INDICATIONS
- PEDESTRIAN INDICATIONS-IN PLACE
- PEDESTRIAN PUSH BUTTON ON PEDESTAL OR POLE
- PEDESTRIAN PUSH BUTTON STATION
- TRAFFIC SIGNAL PEDESTAL
- TRAFFIC SIGNAL PEDESTAL-IN PLACE
- TRAFFIC SIGNAL POLE AND MAST ARM
- TRAFFIC SIGNAL POLE AND MAST ARM-IN PLACE
- STREET LIGHT POLE AND LUMINAIRE
- STREET LIGHT POLE AND LUMINAIRE-IN PLACE
- MAST ARM AND LUMINAIRE
- MAST ARM AND LUMINAIRE-IN PLACE
- WOOD POLE
- WOOD POLE-IN PLACE
- SOURCE OF POWER
- RAILROAD SIGNAL-IN PLACE
- RIGHT OF WAY LINE
- CENTER LINE
- EDGE OF ROADWAY
- SHOULDER LINE
- CURB LINE
- STOP BAR
- EVP DETECTOR

CONDUCTOR COLOR CODING

R	BLK	2-1/C#6
O	WH	2-1/C#10
BL	R	
WH	W	3/C#12
R/BLK	BLK	
O/BLK	BLK	
BL/BLK	BLK	2/C#14
WH/BLK	CLEAR	
BLK	R OR O	
BLK/WH	WH OR YEL	3/C#20
G/BLK	BLK OR BL	
G		

NOTE:
ALL TERMINAL BLOCK CONNECTIONS SHALL BE ARRANGED AS SPECIFIED ABOVE

NOTE:
SEE SPECIAL PROVISIONS FOR A100 POLE FOUNDATION DETAIL.

STANDARD PLATES

PLATE NO.	DESCRIPTION
* 8110 C	TRAFFIC SIGNAL BRACKETING - POLE MOUNTED
8111 B	TRAFFIC SIGNAL BRACKETING - PEDESTAL MOUNTED
8112 C	PEDESTAL FOUNDATION
8113 C	MAGNETIC VEHICLE DETECTOR INSTALLATION
* 8115 C	PEDESTRIAN PUSH BUTTON INSTALLATION
* 8116 C	STEEL GUARD POST
* 8117 F	PRECAST CONCRETE HANDHOLE
* 8118 C	SERVICE EQUIPMENT AND POLE
* 8119 C	GROUND MOUNTED CABINET FOUNDATION
* 8120 H	P-80 AND P-90 POLE FOUNDATION
* 8121 B	TRANSFORMER BASE WITH POLE BASE PLATE
8122 C	PEDESTAL AND PEDESTAL BASE
* 8123 B	POLE AND MAST ARM
* 8124 D	SIGNAL HEAD MOUNTS
8125 A	SWING-AWAY HINGE
* 8126 C	P-100 POLE FOUNDATION
* 8130 D	SAW CUT LOOP DETECTORS

* THESE STANDARD PLATES APPLY TO THIS PLAN

SURVEY:	CHECKED BY:	NO	DATE	REVISIONS
DESIGN: M.K.	G.V.W.		7/8	PER ANOKA COUNTY
DRAWN: G.N.				

I HEREBY CERTIFY THAT THIS PLAN WAS PREPARED BY ME OR UNDER MY DIRECT SUPERVISION AND THAT I AM A DULY REGISTERED PROFESSIONAL ENGINEER UNDER THE LAWS OF THE STATE OF MINNESOTA.

DATE: _____ REG. NO. 9089



SHORT - ELLIOTT - HENDRICKSON, INC.
Saint Paul, Minnesota • Chippewa Falls, Wisconsin

SIGNAL SYSTEM
DETAILS
EAST RIVER ROAD (C.S.A.H. 1) AT
OSBORNE ROAD (C.S.A.H. 8)

S.P. 02-608-07,
S.P. 02-601-33 & S.P. 127-332-02

FILE NO.: 86138
DATE: 6/26/86
58