

ANOKA COUNTY HIGHWAY DEPARTMENT AND MINNESOTA DEPARTMENT OF TRANSPORTATION

CONSTRUCTION PLAN FOR GRADING, STORM SEWER, BITUMINOUS AND CONCRETE PAVING, CONCRETE CURB & GUTTER, TRAFFIC SIGNALS, BOX CULVERT, BR. 02550

PLAN SYMBOLS

STATE LINE.....	-----
COUNTY LINE.....	-----
TOWNSHIP OR RANGE LINE.....	-----
SECTION LINE.....	-----
QUARTER LINE.....	-----
SIXTEENTH LINE.....	-----
RIGHT-OF-WAY LINE.....	-----
PRESENT RIGHT-OF-WAY LINE.....	-----
CONTROL OF ACCESS LINE.....	-----
PROPERTY LINE (Except Land Lines).....	-----
VACATED PLATTED PROPERTY.....	-----
CORPORATE OR CITY LIMITS.....	-----
TRUNK HIGHWAY CENTER LINE.....	-----
RETAINING WALL.....	-----
RAILROAD.....	-----
RAILROAD RIGHT-OF-WAY LINE.....	-----
RIVER OR CREEK.....	-----
DRY RUN.....	-----
DRAINAGE DITCH.....	-----
DRAIN TILE.....	-----
CULVERT.....	-----
DROP INLET.....	-----
GUARD RAIL.....	-----
BARBED WIRE FENCE.....	-----
WOVEN WIRE FENCE.....	-----
CHAIN LINK FENCE.....	-----
RAILROAD SNOW FENCE.....	-----
STONE WALL OR FENCE.....	-----
HEDGE.....	-----
RAILROAD CROSSING SIGN.....	-----
RAILROAD CROSSING BELL.....	-----
ELECTRIC WARNING SIGN.....	-----
CROSSING GATE.....	-----
MEANDER CORNER.....	-----
SPRINGS.....	-----
MARSH.....	-----

TIMBER ORCHARD.....	-----
BRUSH.....	-----
NURSERY.....	-----
CATCH BASIN.....	-----
FIRE HYDRANT.....	-----
CATTLE GUARD.....	-----
OVERPASS (Highway Over).....	-----
UNDERPASS (Highway Under).....	-----
BRIDGE.....	-----
BUILDING (One Story Frame).....	-----
F-FRAME C-CONCRETE.....	-----
S-STONE T-TILE.....	-----
B-BRICK ST-STUCCO.....	-----
IRON PIPE OR ROD.....	-----
MONUMENT (STONE, CONCRETE, OR METAL).....	-----
WOODEN HUB.....	-----
GRAVEL PIT.....	-----
SAND PIT.....	-----
BORROW PIT.....	-----
ROCK QUARRY.....	-----

UTILITY SYMBOLS

POWER POLE LINE.....	-----
TELEPHONE OR TELEGRAPH POLE LINE.....	-----
JOINT TELEPHONE AND POWER ON POWER POLES.....	-----
ON TELEPHONE POLES.....	-----
ANCHOR.....	-----
STEEL TOWER.....	-----
STREET LIGHT.....	-----
PEDESTAL (TELEPHONE CABLE TERMINAL).....	-----
GAS MAIN.....	-----
WATER MAIN.....	-----
CONDUIT.....	-----
TELEPHONE CABLE IN CONDUIT.....	-----
ELECTRIC CABLE IN CONDUIT.....	-----
TELEPHONE MANHOLE.....	-----
ELECTRIC MANHOLE.....	-----
BURIED COMMUNICATION CABLE.....	-----
BURIED TELEPHONE CABLE.....	-----
BURIED ELECTRIC CABLE.....	-----
AERIAL TELEPHONE CABLE.....	-----
SEWER (SANITARY).....	-----
SEWER (STORM).....	-----
SEWER MANHOLE.....	-----
HANDHOLE.....	-----
CATCH BASIN.....	-----


S.A.P. 02-617-11
LOCATED ON C.S.A.H. 17 (LEXINGTON AVE.)
FROM C.S.A.H. 23 TO PHEASANT RIDGE DR.
GROSS LENGTH..... 1028.508 METERS..... 1.01 KILOMETERS
BRIDGES-LENGTH..... 87.862 METERS..... 0.09 KILOMETERS
EXCEPTIONS-LENGTH..... 0 METERS..... 0 KILOMETERS
NET LENGTH..... 940.646 METERS..... 0.92 KILOMETERS

S.A.P. 106-020-12
LOCATED ON C.S.A.H. 17 (LEXINGTON AVE.)
FROM EDGEWOOD RD. TO PHEASANT RIDGE DR.
GROSS LENGTH..... 1028.508 METERS..... 1.01 KILOMETERS
BRIDGES-LENGTH..... 87.862 METERS..... 0.09 KILOMETERS
EXCEPTIONS-LENGTH..... 0 METERS..... 0 KILOMETERS
NET LENGTH..... 940.646 METERS..... 0.92 KILOMETERS

S.P. 0280-47
LOCATED ON C.S.A.H. 17 (LEXINGTON AVE.) AT I-35W
GROSS LENGTH..... NA METERS..... NA KILOMETERS
BRIDGES-LENGTH..... NA METERS..... NA KILOMETERS
EXCEPTIONS-LENGTH..... NA METERS..... NA KILOMETERS
NET LENGTH..... NA METERS..... NA KILOMETERS

END S.A.P. 02-617-11:
S.A.P. 106-020-12:
STA. 10+660.000 (N.B. CSAH 17)

BEGIN S.A.P. 02-617-11:
S.A.P. 106-020-12:
STA. 9+631.492 (NB CSAH 17)

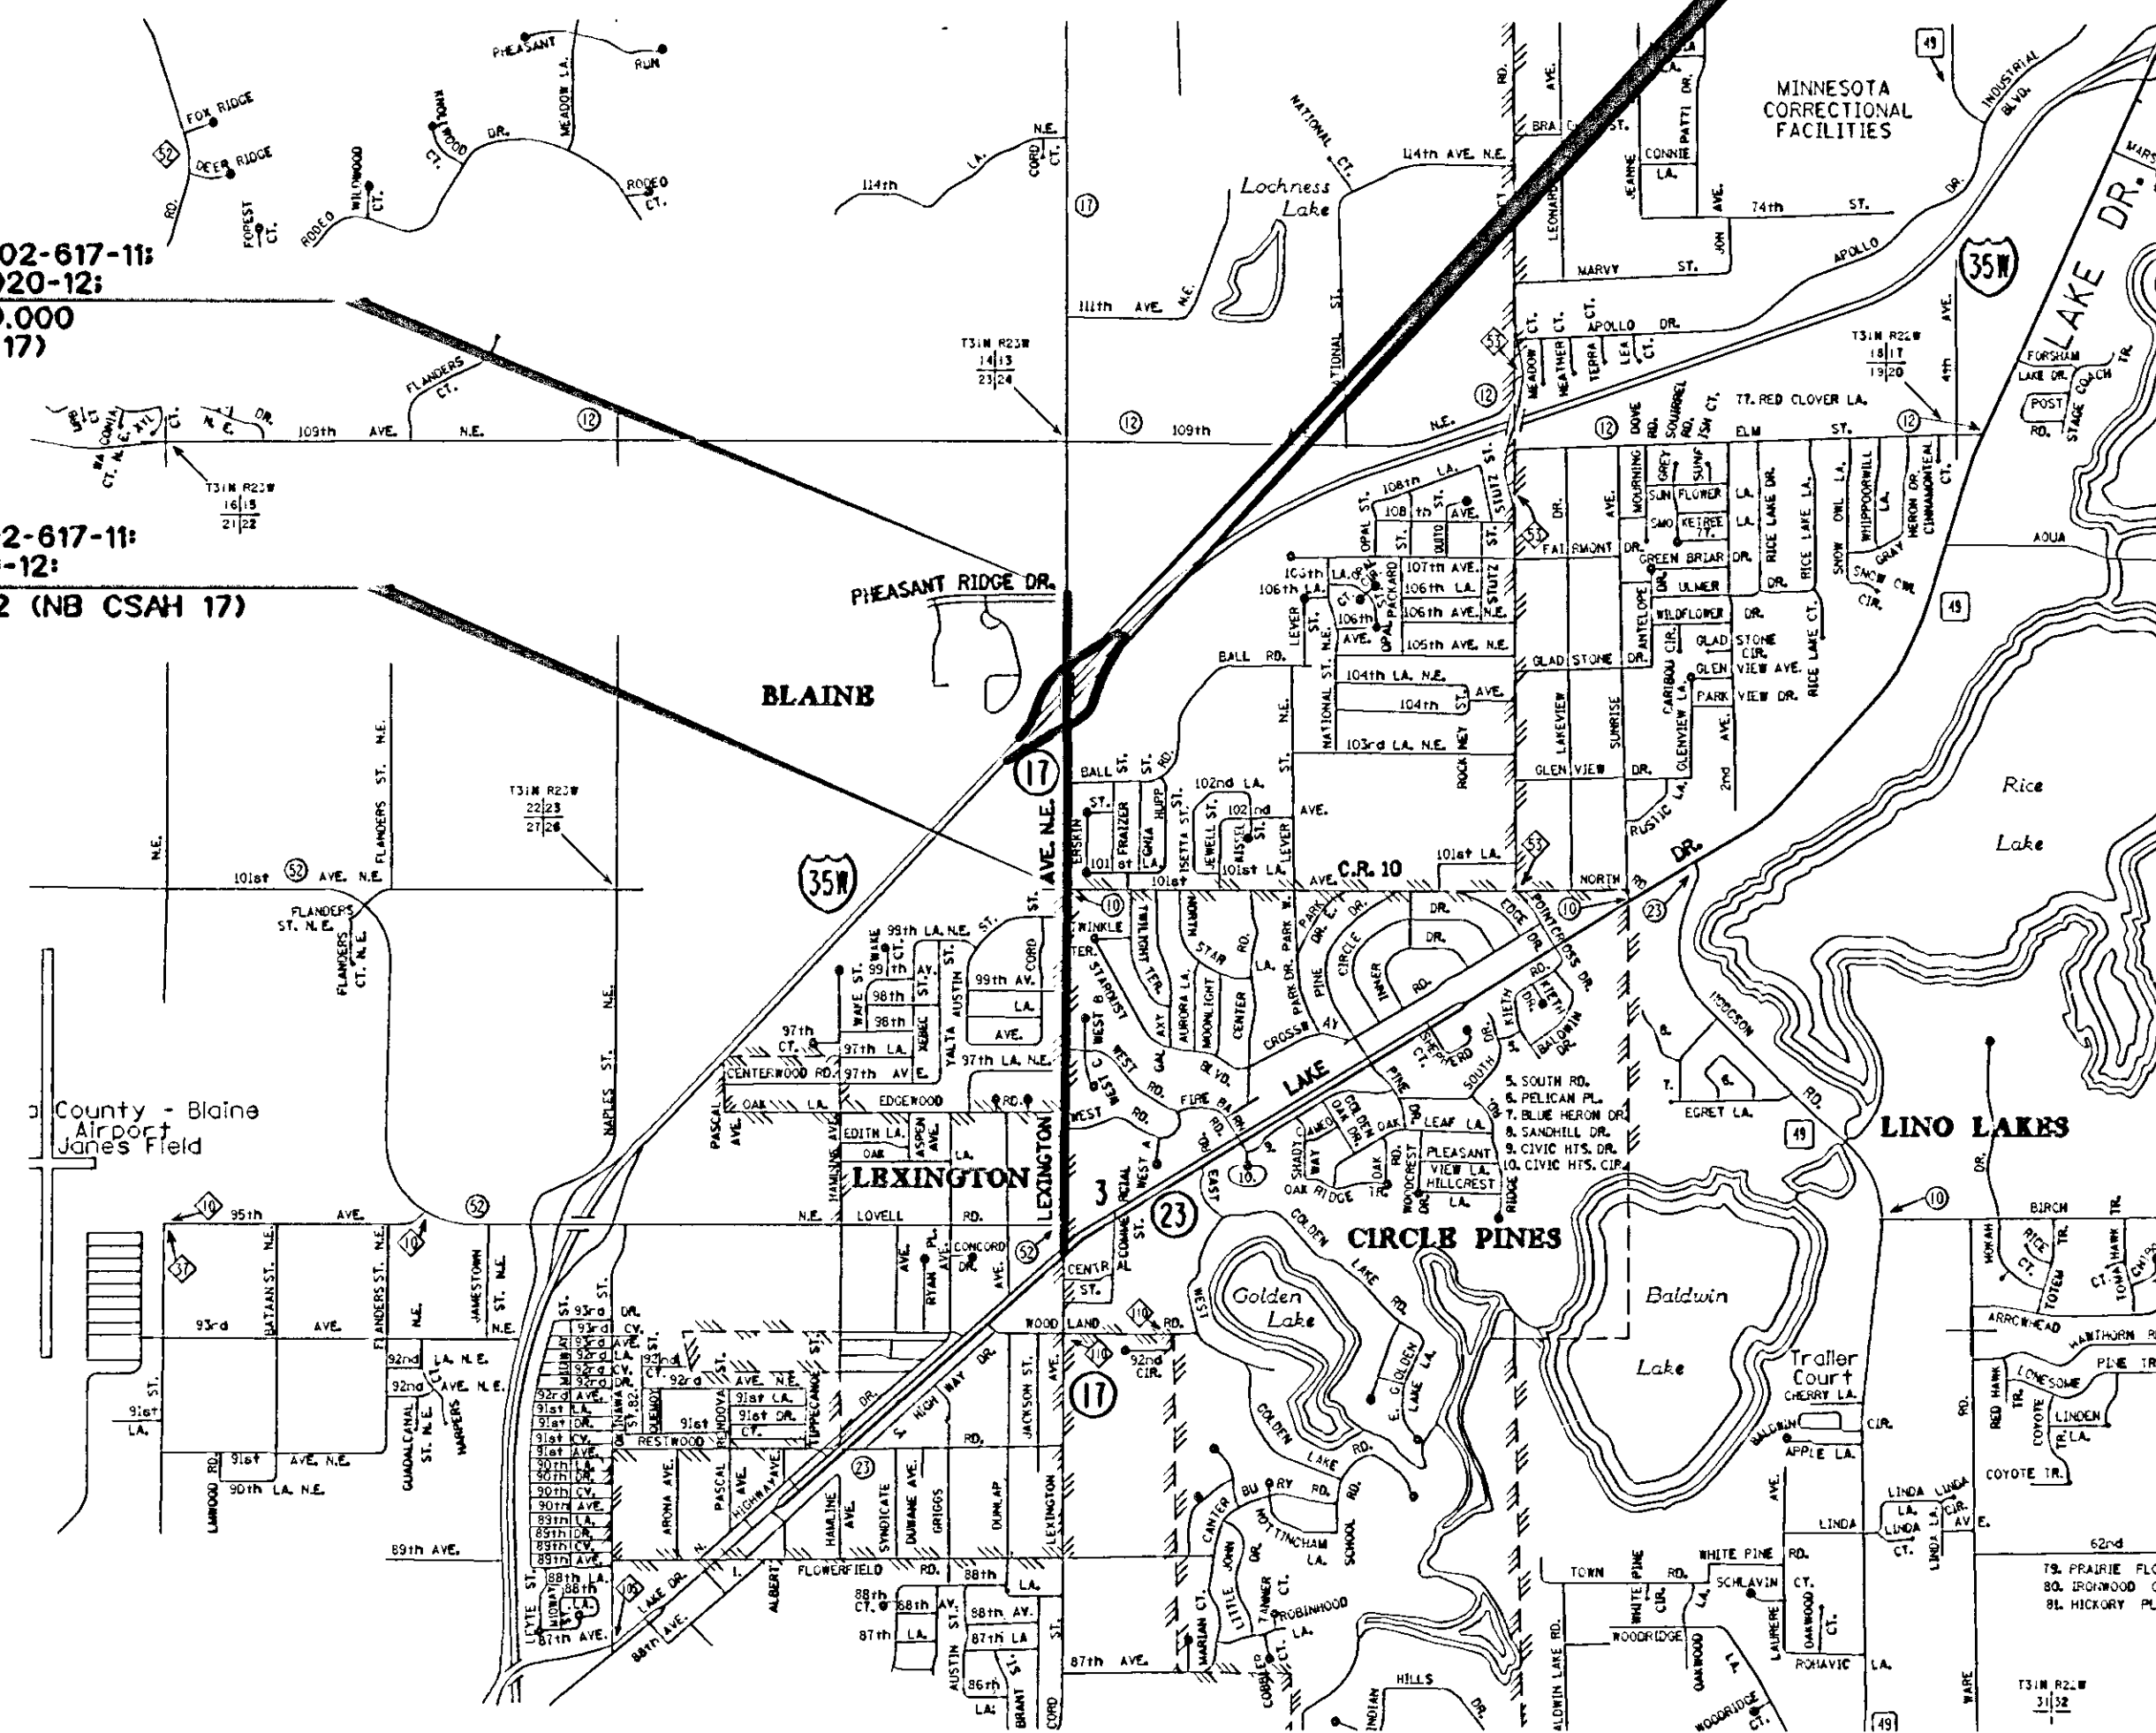


BRIDGE NO. 02550
STA. 10+283.723 (N.B. CSAH 17)
STA. 10+371.585 (N.B. CSAH 17)

SEE GENERAL LAYOUT FOR TRAFFIC SIGNAL LOCATIONS AND PROJECT NUMBERS

SCALES

PLAN.....	10
PROFILE.....	10
INDEX MAP.....	1000
GENERAL LAYOUT.....	75
X-SECTION.....	2

ALL DIMENSIONS ARE IN METERS UNLESS NOTED OTHERWISE

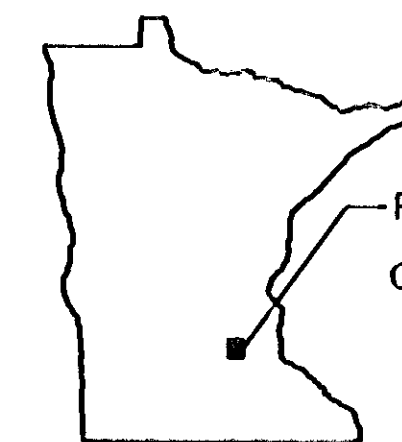


PROJECT LOCATION
COUNTY ANOKA
METRO DIVISION

PLAN REVISIONS		
DATE	SHEET NO.	APPROVED BY
3-26-97	1,3-6,22,28,37,39-41,45,	DAD
	46,65,66,68,69,71,87,111,	
	113,115,116,147,148,152,159	
4-1-97	119,123,129,134	DAD
4-4-97	52,57,62,70,73,77,	DAD
	80,83,88	
4-17-97	3-7	DAD
4-24-97	105,106,108-112,115,117,	DAD
	118,134,145	

DESIGN DESIGNATION.....	S.A.P. 02-617-11	S.P. 0280-47
FUNCTIONAL CLASSIFICATION.....	C.S.A.H. 17	RAMPS
NO. OF TRAFFIC LANES.....	4	1
NO. OF PARKING LANES.....	0	0
STRUCTURAL DESIGN.....	10 TON	10 TON
R-VALUE.....	55	55
DESIGN SPEED.....	70 Km/h	70 Km/h
STOPPING SIGHT DISTANCE BASED ON: HEIGHT OF EYE.....	1070mm	1070mm
HEIGHT OF OBJECT.....	150mm	150mm
ADT (CURRENT YEAR) (1997).....	10200	6300
ADT (FUTURE YEAR) (2017).....	18300	11400
ΣN18.....	2.18E X 06	3.06E X 06

① SW RAMP-STA. 40+022 TO STA. 40+128 AND
NE RAMP-STA. 30+022 TO STA. 30+128
AS BUILT ALIGNMENTS MEET 60km/h

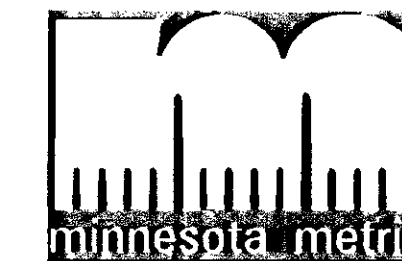

ANOKA COUNTY C.S.A.H. 17 RECONSTRUCTION
S.A.P. 02-617-11, 106-010-15, 106-020-12, 106-120-03, S.P. 0280-47 (TH 35W-394)

GOVERNING SPECIFICATIONS

THE 1995 EDITION OF THE MINNESOTA DEPARTMENT OF TRANSPORTATION "STANDARD SPECIFICATIONS FOR CONSTRUCTION" (METRIC) AND ALL SUPPLEMENTS THERETO, SHALL GOVERN.

ALL TRAFFIC CONTROL DEVICES SHALL CONFORM TO THE MINNESOTA MANUAL ON UNIFORM TRAFFIC CONTROL DEVICES, INCLUDING THE FIELD MANUAL FOR TEMPORARY TRAFFIC CONTROL ZONE LAYOUTS, DATED APRIL, 1995.

INDEX

SHEET NO.	SHEET DESCRIPTION
1	TITLE SHEET
2	GENERAL LAYOUT
3-6	STATEMENT OF ESTIMATED QUANTITIES
7	CONSTRUCTION/SOILS NOTES, STD. PLATES
8	EARTHWORK TABULATION
9	EARTHWORK SUMMARY AND TABULATION
10-17	TABULATIONS
18-19	TYPICAL SECTIONS
20-26	DETAILS
27	DETOUR SIGN TABULATION AND GENERAL NOTES
28-36	DETOUR PLAN
37	TRAFFIC CONTROL SIGN TABULATION AND GENERAL NOTES
38	PPCB GUIDELINES
39-49	TRAFFIC CONTROL
50-53	ALIGNMENT PLAN
54-57	ALIGNMENT TABULATION
58-64	EXISTING TOPOGRAPHY AND REMOVALS
65-77	CONSTRUCTION PLAN AND PROFILE
78-80	INTERSECTION DETAILS
81-84	DRAINAGE TABULATION
85-88	MISCELLANEOUS STORM SEWER PROFILES
89	MISCELLANEOUS PROFILES
90-95	BOX CULVERT PLAN, PROFILE AND DETAILS
96-100	PAVEMENT JOINT DETAILS
101	PAVEMENT JOINT LAYOUT
102-104	GUARDRAIL DETAILS
105-107	STANDARD SIGN DETAILS
108-109	STRUCTURAL DETAILS
110	SIGN DETAILS
111	SIGNING AND STRIPING GENERAL NOTES AND TABULATION
112	TYPE "D" SIGN DETAILS
113-118	SIGNING AND STRIPING PLAN
119-134	TRAFFIC SIGNAL PLANS AND DETAILS
135-144	TRAFFIC MANAGEMENT SYSTEM PLANS AND DETAILS
145-146	LIGHTING PLAN
147-153	TURF ESTABLISHMENT/EROSION CONTROL PLAN
154-158	EROSION CONTROL DETAILS
159-160	MISCELLANEOUS GRADING PLAN
161	CROSS SECTION MATCHLINES
162-235	CROSS SECTIONS
236	DELETED
B1-B47	BRIDGE NO. 02550

THIS PLAN CONTAINS 282 SHEETS.



I HEREBY CERTIFY THAT THIS PLAN WAS PREPARED BY ME OR UNDER MY DIRECT SUPERVISION AND THAT I AM A DULY REGISTERED PROFESSIONAL ENGINEER UNDER THE LAWS OF THE STATE OF MINNESOTA.

ENGR. *Donald A. Demas*

Reg. No. 23397 Date 3-21-97

SRI CONSULTING GROUP, INC.

Approved.....	ANOKA COUNTY HIGHWAY ENGINEER	19
Approved.....	CITY OF BLAINE	19
Recommended for Approval.....	FOR METRO DIVISION	19
Recommended for Approval.....	STATE TRAFFIC ENGINEER	19
Recommended for Approval.....	STATE PRE-LETTING ENGINEER	19
Office of Land Management Approved.....	DIRECTOR, LAND MANAGEMENT	19
Approved.....	STATE DESIGN ENGINEER	19
Recommended for Approval.....	METRO ASSISTANT DIVISION ENGINEER - STATE AID	19
Approved for State Aid Division.....	STATE AID ENGINEER	19

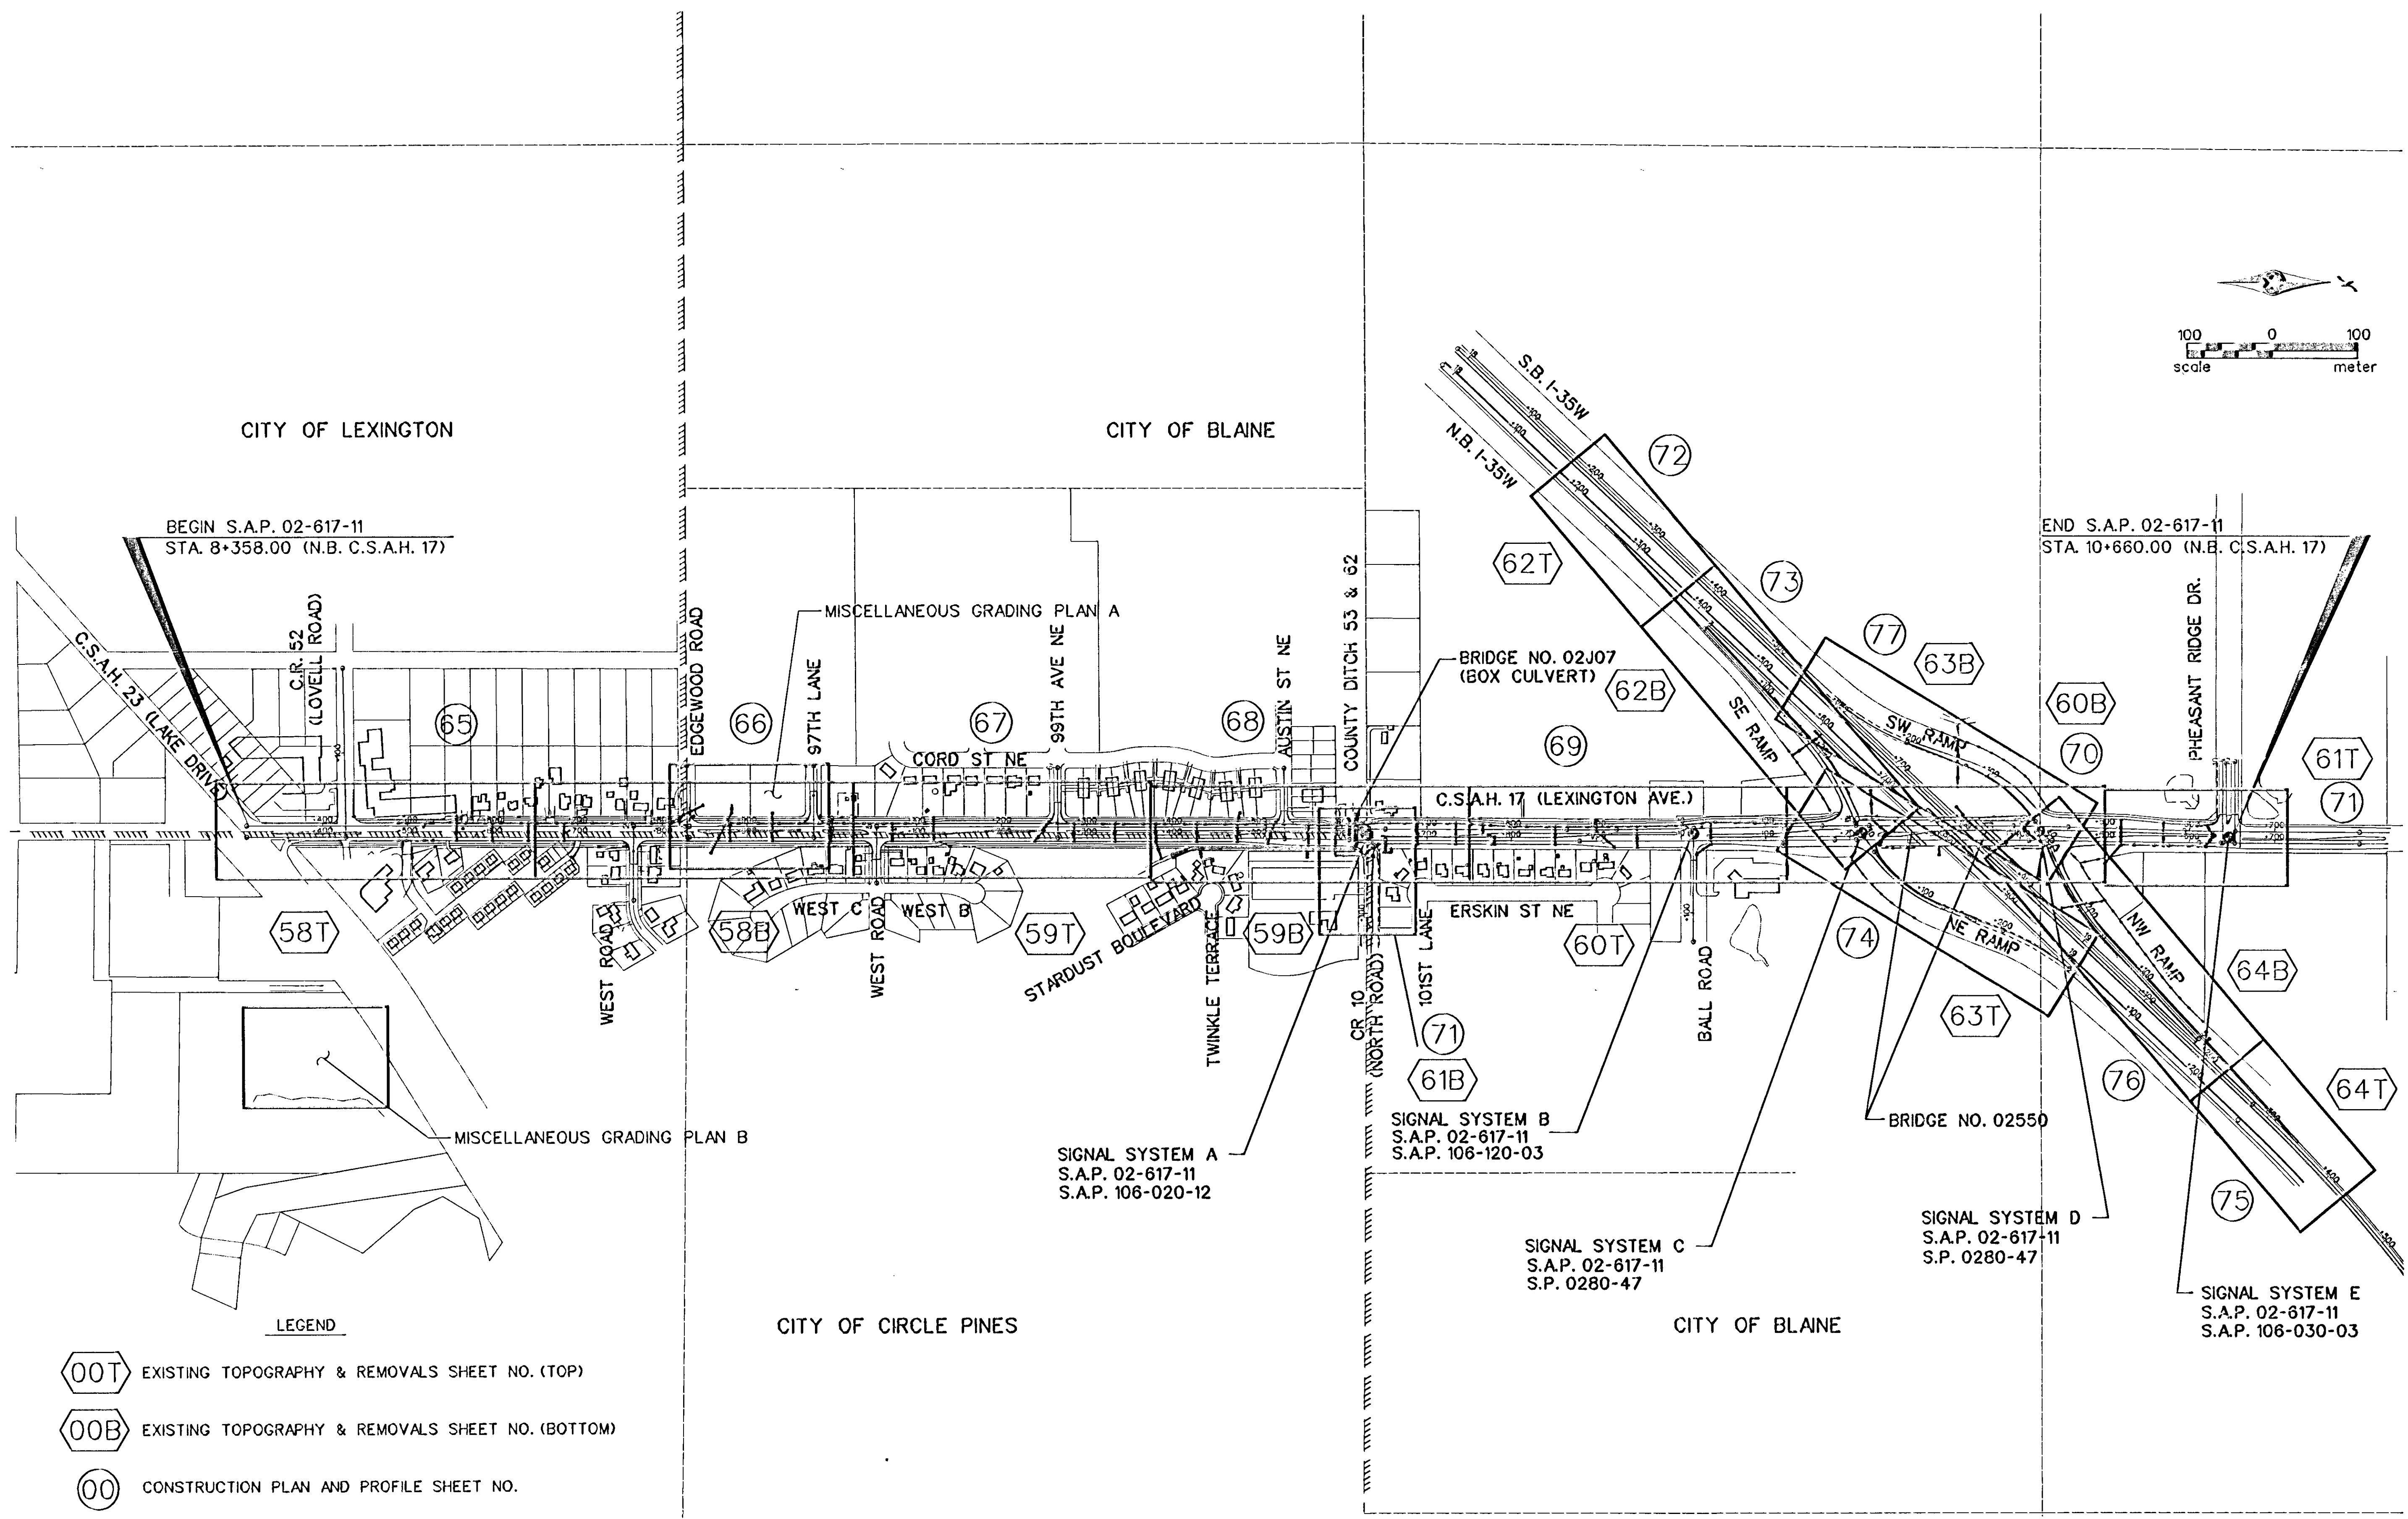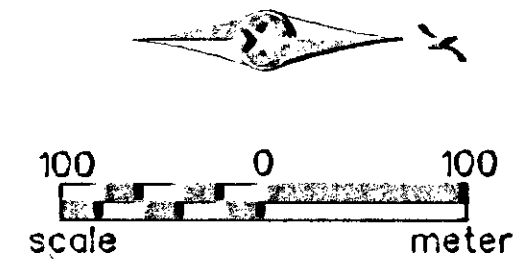

CITY OF LEXINGTON

CITY OF BLAINE


BEGIN S.A.P. 02-617-11
STA. 8+358.00 (N.B. C.S.A.H. 17)

END S.A.P. 02-617-11
STA. 10+660.00 (N.B. C.S.A.H. 17)

- LEGEND**
- ⬡(00T) EXISTING TOPOGRAPHY & REMOVALS SHEET NO. (TOP)
 - ⬡(00B) EXISTING TOPOGRAPHY & REMOVALS SHEET NO. (BOTTOM)
 - ⊙(00) CONSTRUCTION PLAN AND PROFILE SHEET NO.

1	4-17-97	MCI	DAD	SAP 106-120-03 SIG. SYS. B
NO	DATE	BY	CKD	APPR
				REVISION

NAME: GEN 410.PLN DATE: Mar. 17, 1997

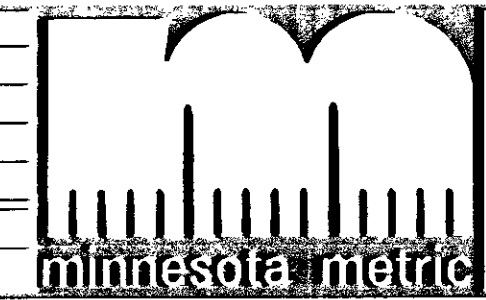


I hereby certify that this plan, specification or report was prepared by me or under my direct supervision and that I am a duly Registered Professional Engineer under the laws of the State of Minnesota.

Ronald A Demers
Date: 3-21-97 Reg. No. 23397

STATE AID PROJECT NO.
S.A.P. 02-617-11
S.A.P. 106-020-12

CO. PROJECT NO.

DRAWN BY V. GRAF DATE 12-98
DESIGNED BY B. URBANEK DATE 12-98
CHECKED BY D. DEMERS DATE 2-97
COMM. NO. 0962410

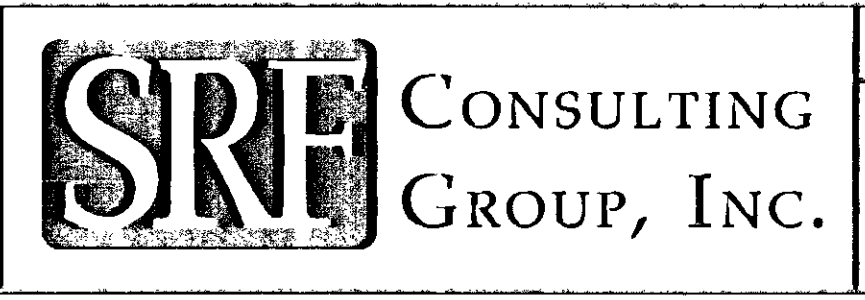



ANOKA COUNTY
GENERAL LAYOUT
C.S.A.H. 17 RECONSTRUCTION

SHEET 2 OF 236

STATEMENT OF ESTIMATED QUANTITIES

TAB	NOTES	ITEM NO.	ITEM DESCRIPTION	UNIT	TOTAL QUANTITY	ANOKA COUNTY		LEXINGTON	CIRCLE PINES	BLAINE	MN/DOT
						SAP 02-617-11	DRAINAGE	NON-PART	NON-PART	SAP 106-020-12	SP 0280-47
		2021.501	MOBILIZATION	LUMP SUM	1.00		0.38	0.12			
		2031.501	FIELD OFFICE TYPE D	EACH	1.00		0.88	0.12			
		0013.601	SURVEY EQUIPMENT	LUMP SUM	1.00		0.88	0.12			
		0013.601	CELLULAR MOBILE TELEPHONE	LUMP SUM	1.00		0.88	0.12			
		0015.601	COMPUTER EQUIPMENT	LUMP SUM	1.00		0.88	0.12			
A		2101.501	CLEARING	ha	1.64		1.64				
A		2101.502	CLEARING	TREE	257		257				
A		2101.506	GRUBBING	ha	1.64		1.64				
A		2101.507	GRUBBING	TREE	257		257				
		2102.502	PAVEMENT MARKING REMOVAL	m	8800.0		8800.0				
E		2104.501	REMOVE TIMBER RETAINING WALL	m	19.5		19.5				
E		2104.501	REMOVE CONCRETE RETAINING WALL	m	9.0		9.0				
B		2104.501	REMOVE PIPE SEWER	m	513.0		513.0				
C		2104.501	REMOVE CONCRETE C & G	m	955.0		955.0				
K		2104.501	REMOVE GUARDRAIL	m	73.0		73.0				
C	15	2104.503	REMOVE BITUMINOUS PAVEMENT	m2	36771.0		36771.0				
C		2104.503	REMOVE CONCRETE PAVEMENT	m2	7810.0		7810.0				
B		2104.509	REMOVE DRAINAGE STRUCTURE	EACH	21		21				
B		2104.509	REMOVE PIPE APRON	EACH	23		23				
N		2104.509	REMOVE LIGHT STANDARD BASE	EACH	12		12				
N		2104.509	REMOVE PULL BOX	EACH	4		4				
J		2104.501	REMOVE FENCE	m	140.3		140.3				
B		2104.501	REMOVE TIMBER BOX CULVERT	m	16.0			16.0			
C		2104.511	SAWING CONCRETE PAVEMENT	m	542.0		542.0				
C		2104.513	SAWING BITUMINOUS PAVEMENT	m	176.0		176.0				
J		2104.521	SALVAGE FENCE (CHAIN LINK)	m	947.5		947.5				
J		2104.521	SALVAGE FENCE (WOOD)	m	28.6		28.6				
J		2104.521	SALVAGE FENCE (WIRE)	m	167.9		167.9				
K	9	2104.521	SALVAGE GUARDRAIL	m	369.0		369.0				
E		2104.521	SALVAGE TIMBER PLANTER BOX	m	31.0		31.0				
E		2104.521	SALVAGE CONCRETE BLOCK BBQ	m	6.0		6.0				
L		2104.521	SALVAGE 457 mm STEEL CASING	m	15.0					15.0	
M		2104.521	SALVAGE 762 mm STEEL CASING	m	18.0					18.0	
L		2104.521	SALVAGE 152 mm DUCT IRON PIPE (SANITARY)	m	26.5					26.5	
M		2104.521	SALVAGE 400 mm DUCT IRON PIPE (WATERMAIN)	m	97.0					97.0	
N		2104.523	SALVAGE LIGHTING UNIT	EACH	12		12				
K		2104.523	SALVAGE WOOD BOLLARD	EACH	11		11				
		2104.523	SALVAGE SIGN PANEL (TYPE C & D)	EACH	149		149				
		2104.523	SALVAGE SIGN PANEL (TYPE A)	EACH	2		2				
M		2104.523	SALVAGE CURB STOP AND BOX	EACH	8			8			
M		2104.523	SALVAGE GATE VALVE AND BOX	EACH	1					1	
M		2104.523	SALVAGE HYDRANT	EACH	5			1	1	3	
S		2105.501	COMMON EXCAVATION	m3	43296.0		43296.0				
S	1	2105.507	SUBGRADE EXCAVATION	m3	20175.0		20175.0				
S	25	0105.603	SPECIAL EXCAVATION	m3	32296.0			32296.0			
S		2105.522	SELECT GRANULAR BORROW (LV)	m3	81450.0		81450.0				
		2105.522	SELECT GRANULAR BORROW, MODIFIED (LV)	m3	4560.0		4560.0				
		2105.523	COMMON BORROW (L V)	m3	44100.0		44100.0				
	19	2130.501	WATER	m3	1000.0			1000.0			
H		2211.503	AGGREGATE BASE (CV) CLASS 5A	m3	15580.0		15580.0				
F	23	2211.501	AGGREGATE BASE (CV) CLASS 5A	metric ton	76.0		76.0				
		2301.501	CONCRETE PAVEMENT	m2	1890.0		1890.0				
		2301.511	STRUCTURAL CONCRETE	m3	380.0		380.0				
		2301.529	REINFORCEMENT BARS (EPOXY COATED)	kg	255.0		255.0				
		2301.538	DOWEL BAR	EACH	1380		1380				
		2301.545	CONCRETE CORING	EACH	6		6				
		2301.553	BRIDGE APPROACH PANEL	m2	806.0		806.0				
		0301.604	PERMANENT HEADER	m	14.6		14.6				
		0301.610	DRILL & GROUT REINFORCEMENT BAR	EACH	28		28				
H		2340.508	TYPE 41 WEARING COURSE MIXTURE	metric ton	5225.0		5225.0				
H		2340.508	TYPE 47 WEARING COURSE MIXTURE	metric ton	530.0		530.0				
F	12	SPEC	TYPE 41 WEARING COURSE MIXTURE	m2	910.0		910.0				
F	8	SPEC	TYPE 41 WEARING COURSE MIXTURE	m2	5890.0		5890.0				
H	24	2340.510	TYPE 41 BINDER COURSE MIXTURE	metric ton	5630.0		5630.0				
H	24	2340.510	TYPE 47 BINDER COURSE MIXTURE	metric ton	610.0		610.0				
H	24	2340.514	TYPE 31 BASE COURSE MIXTURE	metric ton	11325.0		11325.0				
H	24	2340.516	TYPE 31 SHOULDER MIXTURE	metric ton	330.0		330.0				
		2357.502	BITUMINOUS MATERIAL FOR TACK COAT	LITER	103715.0		103715.0				
E		0411.603	CONCRETE BLOCK RETAINING WALL	m2	47.0		47.0				
E		0411.604	INSTALL TIMBER PLANTER BOX	m	31.0		31.0				
E		0411.604	INSTALL CONCRETE BLOCK BBQ	m	6.0		6.0				
		2412.511	3600 mm x 2400 mm PRECAST CONC BOX CULV	m	249.49			249.49			
		2412.512	3600 mm x 2400 mm PRECAST CONC BOX CULV END SECT	EACH	2			2			



SEE NOTES ON SHEET 6

1	7-26-97	DAD	AC+D COMMENTS		I hereby certify that this plan, specification or report was prepared by me or under my direct supervision and that I am a duly Registered Professional Engineer under the laws of the State of Minnesota. <i>Donald A. James</i> Date: 3-21-97 Reg. No. 23297	STATE AID PROJECT NO.	DRAWN BY DATE		ANOKA COUNTY STATEMENT OF ESTIMATED QUANTITIES C.S.A.H. 17 RECONSTRUCTION	SHEET 3 OF 236
2	4-17-97	DAD	0340.601 TO SPEC, BLAINE SAP No.			S.A.P. 02-617-11	V. GRAF 12-96			
3	4-24-97	DAD	Revise item Desc. (Remove Light STD base)			S.A.P. 106-020-12	B. MOORE 12-96			
NO	DATE	BY	CHKD	APPR	REVISION	CO. PROJECT NO.	CHECKED BY	COMM. NO.		
							D. DEWERS 3-97	0052410		
NAME: SEQ1 410.PLN DATE: Mar. 17, 1997										

STATEMENT OF ESTIMATED QUANTITIES

TAB	NOTES	ITEM NO.	ITEM DESCRIPTION	UNIT	TOTAL QUANTITY	ANOKA COUNTY		DRAINAGE	LEXINGTON	CIRCLE PINES	BLAINE	MN/DOT
						SAP 02-517-11	SAP 02-517-11	SAP 02-517-11	NON-PART	NON-PART	SAP 106-020-12	SP 0280-47
D		0412.602	RELOCATE MAIL BOX	EACH	81		81					
	6	0451.602	AGGREGATE FOUNDATION	metric ton	3100.0			3100.0				
R		2501.511	450 mm RC PIPE CULVERT CLASS II	m	4.6		4.6					
R		2501.511	675 mm RC PIPE CULVERT CLASS V	m	44.0		44.0					
R		2501.515	300 mm RC PIPE APRON	EACH	1			1				
R		2501.515	375 mm RC PIPE APRON	EACH	1			1				
R		2501.515	450 mm RC PIPE APRON	EACH	1		1					
R		2501.515	525 mm RC PIPE APRON	EACH	1			1				
R		2501.515	600 mm RC PIPE APRON	EACH	5			5				
R		2501.515	675 mm RC PIPE APRON	EACH	2		2					
R		2501.515	900 mm RC PIPE APRON	EACH	3			3				
R		2501.515	375 mm CS PIPE APRON	EACH	2			2				
R		2501.515	450 mm CS PIPE APRON	EACH	1			1				
R		2501.567	375 mm RC SAFETY APRON AND GRATE DESIGN M3022B	EACH	1			1				
R		2501.567	450 mm RC SAFETY APRON AND GRATE DESIGN M3022B	EACH	1			1				
R		2501.567	750 mm RC SAFETY APRON AND GRATE DESIGN M3022B	EACH	1			1				
R		2501.567	900 mm RC SAFETY APRON AND GRATE DESIGN M3022B	EACH	1			1				
R		0501.602	TRASH GUARD FOR 300 mm PIPE APRON	EACH	1			1				
R		0501.602	TRASH GUARD (SPECIAL) (300 mm TO 600 mm)	EACH	4			4				
R		0501.602	TRASH GUARD (SPECIAL) (750 mm TO 900 mm)	EACH	2			2				
R		2503.541	300 mm RC PIPE SEWER DESIGN 3006 CLASS II	m	1020.8			1020.8				
R		2503.541	300 mm RC PIPE SEWER DESIGN 3006 CLASS III	m	74.1			74.1				
R		2503.541	375 mm RC PIPE SEWER DESIGN 3006 CLASS II	m	271.6			271.6				
R		2503.541	375 mm RC PIPE SEWER DESIGN 3006 CLASS III	m	10.2			10.2				
R		2503.541	450 mm RC PIPE SEWER DESIGN 3006 CLASS II	m	171.3			171.3				
R		2503.541	450 mm RC PIPE SEWER DESIGN 3006 CLASS III	m	40.2			40.2				
R		2503.541	525 mm RC PIPE SEWER DESIGN 3006 CLASS II	m	376.2			376.2				
R		2503.541	525 mm RC PIPE SEWER DESIGN 3006 CLASS IV	m	50.0			50.0				
R		2503.541	525 mm RC PIPE SEWER DESIGN 3006 CLASS V	m	38.5			38.5				
R		2503.541	600 mm RC PIPE SEWER DESIGN 3006 CLASS II	m	205.8			205.8				
R		2503.541	600 mm RC PIPE SEWER DESIGN 3006 CLASS III	m	104.2			104.2				
R		2503.541	600 mm RC PIPE SEWER DESIGN 3006 CLASS IV	m	195.8			195.8				
R		2503.541	750 mm RC PIPE SEWER DESIGN 3006 CLASS II	m	100.7			100.7				
R		2503.541	750 mm RC PIPE SEWER DESIGN 3006 CLASS III	m	4.0			4.0				
R		2503.541	825 mm RC PIPE SEWER DESIGN 3006 CLASS III	m	143.4			143.4				
R		2503.541	900 mm RC PIPE SEWER DESIGN 3006 CLASS II	m	55.8			55.8				
R		2503.541	900 mm RC PIPE SEWER DESIGN 3006 CLASS IV	m	49.0			49.0				
R		2503.511	375 mm CS PIPE SEWER DESIGN 3040 16 GA	m	75.0			75.0				
R		2503.511	450 mm CS PIPE SEWER DESIGN 3040 16 GA	m	36.2			36.2				
		0503.602	FURNISH & INSTALL BAFFELED WEIR	EACH	1			1				
L,M		0503.605	50 mm INSULATION	m2	1668.0				1368.0		300.0	
M		0504.602	ADJUST VALVE BOX	EACH	21				3		7	11
M		0504.602	ADJUST HYDRANT	EACH	2						1	1
M		0504.602	RELOCATE CURB STOP AND BOX	EACH	8				8			
M		0504.602	INSTALL GATE VALVE AND BOX	EACH	1							1
M		0504.602	INSTALL HYDRANT	EACH	5				1		1	3
	22	0504.602	REVISE IRRIGATION SYSTEM	EACH	1		1					
L	16	0504.603	INSTALL 457 mm STEEL CASING	m	15.0						15.0	
M	17	0504.603	INSTALL 762 mm STEEL CASING	m	18.0						18.0	
L	16	0504.603	INSTALL 152 mm DUCT, IRON PIPE	m	26.5						26.5	
M	17	0504.603	INSTALL 400 mm DUCT, IRON PIPE	m	97.0						97.0	
M		0504.603	150 mm WATERMAIN DUCT, IRON CL 52	m	47.0				11.0	5.0	31.0	
M		0504.603	400 mm WATERMAIN DUCT, IRON CL 52	m	8.5						8.5	
L		0504.603	457 mm STEEL CASING PIPE	m	5.0						5.0	
M		0504.603	762 mm STEEL CASING PIPE	m	24.0						24.0	
M		0504.620	WATERMAIN FITTINGS	kg	252.0				68.0		184.0	
R		2506.501	CONST DRAINAGE STRUCT DESIGN F	m	77.76			77.76				
R		2506.501	CONST DRAINAGE STRUCT DESIGN G	m	41.87			41.87				
R		2506.501	CONST DRAINAGE STRUCT DESIGN 1200 mm 4020	m	8.50			8.50				
R		2506.501	CONST DRAINAGE STRUCT DESIGN 1350 mm 4020	m	13.78			13.78				
R		2506.501	CONST DRAINAGE STRUCT DESIGN 1500 mm 4020	m	19.49			19.49				
R		2506.501	CONST DRAINAGE STRUCT DESIGN 1800 mm 4020	m	1.60			1.60				
R		2506.501	CONST DRAINAGE STRUCT DESIGN 1950 mm 4020	m	1.78			1.78				
R		2506.502	CONST DRAINAGE STRUCT DESIGN SPECIAL 1	EACH	1			1				
L		2506.503	RECONSTRUCT DRAINAGE STRUCTURE	m	3.50				1.6		1.9	
Q		2506.516	CASTING ASSEMBLY	EACH	120			120				
L		2506.522	ADJUST FRAME AND RING CASTING	EACH	5				4		1	
R	10	2511.505	HAND PLACED RIPRAP	m3	70.5		5.3	65.2				
G	4	2521.501	100 mm CONCRETE WALK	m2	4895.0		4895.0					
G	4 14	2521.501	150 mm CONCRETE WALK	m2	44.0		44.0					
G	4	2521.511	50 mm BITUMINOUS WALK	m2	8930.0				960.0	3660.0	4310.0	
G		2531.501	CONCRETE CURB AND GUTTER DESIGN B618	m	4360.0		2205.0		205.0	645.0	1305.0	
G		2531.501	CONCRETE CURB AND GUTTER, SURMOUNTABLE	m	160.0		80.0		2.5	30.0	47.5	

SEE NOTES ON SHEET 6

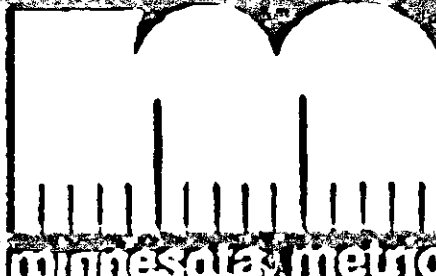1	3-26-97		DDO ASHD COMMENTS		I hereby certify that this plan, specification or report was prepared by me or under my direct supervision and that I am a duly Registered Professional Engineer under the laws of the State of Minnesota. <i>Donald A. Domeo</i> Date 3-21-97 Proj No. 23377	STATE AND PROJECT NO.	DRAWN BY DATE		ANOKA COUNTY STATEMENT OF ESTIMATED QUANTITIES C.S.A.H. 17 RECONSTRUCTION	SHEET 4 OF 236
1	4-17-97	DDO	DDO BLAINE SAP No.			S.A.P. 02-517-11 S.A.P. 106-020-12	V. GRAF 12-96 B. MOORE 12-96 D. DEVERS 3-97			
NO	DATE	BY	CHK	APPR	REVISION					
NAME: SE02 4X0 PLN DATE: Mar. 17, 1997										

STATEMENT OF ESTIMATED QUANTITIES

TAB	NOTES	ITEM NO.	ITEM DESCRIPTION	UNIT	TOTAL QUANTITY	ANOKA COUNTY					MN/DOT
						SAP 02-617-11	DRAINAGE	LEXINGTON	CIRCLE PINES	BLAINE	
						SAP 02-617-11	SAP 02-617-11	NON-PART	NON-PART	SAP 106-020-12	SP 0280-47
G		2531.501	CONCRETE CURB AND GUTTER DESIGN 3612	m	3090.0	3090.0					
G		2531.501	CONCRETE CURB AND GUTTER DESIGN D424	m	655.0	655.0					
G		2531.501	CONCRETE CURB AND GUTTER DESIGN B413	m	120.0	60.0					
	13	2533.504	CONCRETE MEDIAN BARRIER DESIGN 8323	m	1300.0	1300.0				60.0	
N		2545.515	LIGHT BASE DESIGN E	EACH	8	8					
N		2545.521	78 mm RIGID STEEL CONDUIT	m	103.6	103.6					
N		2545.521	78 mm RIGID STEEL CONDUIT (AUGERED)	m	80.0	80.0					
N		2545.533	ARMORED CABLE 3 CONDUCTOR NO. 4	m	1110.0	1110.0					
N		2545.553	PULLBOX	EACH	3	3					
N		0545.602	INSTALL LIGHTING UNIT	EACH	8	8					
K		2554.501	TRAFFIC BARRIER DESIGN SPECIAL	m	15.2	15.2					
K		2554.501	TRAFFIC BARRIER DESIGN B 8307	m	170.0	170.0					
		2554.509	GUIDE POST, TYPE B	EACH	12	3		9			
K	9	2554.511	INSTALL TRAFFIC BARRIER	m	290.0	290.0					
K		2554.521	ANCHORAGE ASSEMBLY	EACH	2	2					
K		2554.523	END TREATMENT (ELT) 8329	EACH	4	4					
K		0554.602	INSTALL WOOD BOLLARD	EACH	9	9					
	13	0554.604	IMPACT ATTENUATOR	ASSEMBLY	7	7					
J		2557.501	WIRE FENCE DESIGN 60-9322	m	49.7	49.7					
J		0557.603	INSTALL FENCE (CHAIN LINK)	m	947.5	947.5					
J		0557.603	INSTALL FENCE (WOOD)	m	28.6	28.6					
J		0557.603	INSTALL FENCE (WIRE)	m	167.3	167.3					
		0563.601	DETOUR SIGNING	LUMP SUM	1.0	1.0					
	13	0563.602	PORTABLE CHANGEABLE MESSAGE SIGN	UNIT DAY	40	40					
	13	0563.603	RAISED PAVEMENT MARKER TEMPORARY	EACH	200	200					
	18	0564.604	RELOCATE IMPACT ATTENUATOR	ASSEMBLY	2	2					
	20	0533.603	RELOCATE CONCRETE MEDIAN BARRIER	m	380	380					
T	7	2564.531	SIGN PANELS TYPE C	m2	84.0	84.0					
		2564.531	SIGN PANELS TYPE D	m2	12.5	12.5					
		2564.537	INSTALL SIGN TYPE C	EACH	56	56					
		2564.537	INSTALL SIGN TYPE D	EACH	1	1					
U		2564.537	INSTALL SIGN TYPE A	EACH	2	2					
	28	0564.602	F&I SIGN COLLAR	EACH	12	12					
		2564.522	STRUCTURAL STEEL (POSTS FOR TYPE A SIGNS)	kg	1760	1760					
		2564.552	TRAFFIC CONTROL (STAGE 1A)	LUMP SUM	1.00	1.00					
		2564.552	TRAFFIC CONTROL (STAGE 1B)	LUMP SUM	1.00	1.00					
		2564.552	TRAFFIC CONTROL (STAGE 2A)	LUMP SUM	1.00	1.00					
		2564.552	TRAFFIC CONTROL (STAGE 2B)	LUMP SUM	1.00	1.00					
		0564.602	PAVEMENT MESSAGE (ONLY) PAINT	EACH	19	19					
		0564.602	PAVEMENT MESSAGE (LEFT ARROW) PAINT	EACH	36	36					
		0564.602	PAVEMENT MESSAGE (RIGHT ARROW) PAINT	EACH	23	23					
		0564.602	PAVEMENT MESSAGE (LEFT/THRU ARROW) PAINT	EACH	4	4					
	11	0564.602	RELOCATE SIGN TYPE SPECIAL	EACH	4	4					
	5.21	0564.603	100 mm SOLID LINE WHITE PAINT	m	9900.0	9900.0					
	5.29	0564.603	100 mm BROKEN LINE WHITE PAINT	m	9100.0	9100.0					
	5	0564.603	300 mm SOLID LINE WHITE PAINT	m	230.0	230.0					
		0564.603	600 mm SOLID LINE WHITE PAINT	m	198.0	198.0					
	5	0564.603	100 mm SOLID LINE YELLOW PAINT	m	8250.0	8250.0					
	5.29	0564.603	100 mm BROKEN LINE YELLOW PAINT	m	1500.0	1500.0					
	21	0564.603	200 mm DOUBLE SOLID LINE YELLOW PAINT	m	6600.0	6600.0					
		0564.603	200 mm SOLID LINE WHITE PAINT	m	360.0	360.0					
		0564.604	ZEBRA CROSSWALK WHITE PAINT	m2	325.0	325.0					
	30	2565.511	FULL T ACT T CONTROL SIGNAL SYSTEM A	SIGNAL SYSTEM	1.0	0.5000				0.5000	
	31	2565.511	FULL T ACT T CONTROL SIGNAL SYSTEM B	SIGNAL SYSTEM	1.0	0.2500				0.7500	
		2565.511	FULL T ACT T CONTROL SIGNAL SYSTEM C	SIGNAL SYSTEM	1.0	0.500					0.500
		2565.511	FULL T ACT T CONTROL SIGNAL SYSTEM D	SIGNAL SYSTEM	1.0	0.500					0.500
		0565.604	REVISE SIGNAL SYSTEM E	SYSTEM	1.0	1.000					
	32	0565.601	EMERGENCY VEHICLE PREEMPTION SYSTEM A	LUMP SUM	1.0					1.000	
	33	0565.601	EMERGENCY VEHICLE PREEMPTION SYSTEM B	LUMP SUM	1.0					1.000	
	34	0565.601	EMERGENCY VEHICLE PREEMPTION SYSTEM C	LUMP SUM	1.0					1.000	
	34	0565.601	EMERGENCY VEHICLE PREEMPTION SYSTEM D	LUMP SUM	1.0					1.000	
		0565.601	EMERGENCY VEHICLE PREEMPTION SYSTEM E	LUMP SUM	1.0					1.000	
		0565.601	TRAFFIC CONTROL INTERCONNECTION	LUMP SUM	1	1					
	26	0104.601	SALVAGE MISCELLANEOUS STRUCTURES	LUMP SUM	1	1					
	26	0104.601	REMOVE MISCELLANEOUS STRUCTURES	LUMP SUM	1	1					
	26	0104.607	HAUL SALVAGED MATERIAL	LUMP SUM	1	1					
	26	2550.509	SYSTEMS INTEGRATION	LUMP SUM	1	1					
	26	2550.511	CABINET FOUNDATION	EACH	1	1					
	26	2550.511	SERVICE FOUNDATION	EACH	1	1					
	26	2550.512	HANDHOLE, TYPE PVC CONCRETE COVER	EACH	7	7					
	26	2550.514	FIBEROPTIC SPLICE VAULT	EACH	1	1					
	26	2550.515	OUTDOOR FIBER SPLICE ENCLOSURE	EACH	1	1					
	26.27	2550.523	50 mm NON-METALLIC CONDUIT	m	205.0	205.0					
	26	2550.523	75 mm NON-METALLIC CONDUIT	m	170.0	170.0					
	26	2550.523	100 mm NON-METALLIC CONDUIT	m	10.0	10.0					
	26	2550.524	75 mm PUSHED CONDUIT	m	45.0	45.0					

SEE NOTES ON SHEET 6

1	3-26-97	DAD	ADD COMMENTS
2	4-17-97	DAD	ADD TYPE D SIGNS, TRAFFIC CONTROL BY SPACES
3	4-24-97	DAD	REVISE F&I FUNDING SOURCE, C.I.P. SIGN QTY, STEEL POST QTY
NO	DATE	BY	CHKD
NAME	SECS	PLN	DATE



I hereby certify that this plan, specification or report was prepared by me or under my direct supervision and that I am a duly Registered Professional Engineer under the laws of the State of Minnesota.
Donald A. James
 Date 3-21-97 Reg No 23397

STATE AID PROJECT NO. S.A.P. 02-617-11 S.A.P. 106-020-12
 CO. PROJECT NO.

DRAWN BY DATE V. GRAF 12-96
 DESIGNED BY B. MOORE 12-96
 CHECKED BY D. DEMERS 3-97
 COMM. NO. 0262419



ANOKA COUNTY
 STATEMENT OF ESTIMATED QUANTITIES
 C.S.A.H. 17 RECONSTRUCTION

SHEET 5 OF 236

STATEMENT OF ESTIMATED QUANTITIES

TAB	NOTES	ITEM NO.	ITEM DESCRIPTION	UNIT	TOTAL QUANTITY	ANOKA COUNTY				
						SAP 02-617-11	DRAINAGE	LEXINGTON	CIRCLE PINES	BLAINE
26		2550.532	POWER CABLE 1 CONDUCTOR NO. 6	m	400.0	400.0				
26		2550.532	POWER CABLE 1 CONDUCTOR NO. 3	m	150.0	150.0				
26		2550.532	LEAD-IN CABLE 2 CONDUCTOR NO. 14	m	1580.0	1580.0				
26		2550.532	SIGNAL CONTROL CABLE 5 CONDUCTOR NO. 12	m	240.0	240.0				
26		2550.532	CONTROL CABLE 15 CONDUCTOR NO. 18	m	50.0	50.0				
26		2550.533	VIDEO CABLE RG1 1	m	50.0	50.0				
26		2550.535	ARMORED FIBEROPTIC PIGTAIL	EACH	1	1				
26		2550.541	1.7 m X 1.7m LOOP DETECTOR DESIGN SAWCUT	EACH	2	2				
26		2550.542	LOOP DETECTOR SPLICE	EACH	6	6				
26		2550.571	INSTALL CABINET	EACH	1	1				
26		0550.601	DOCUMENTATION AND TRAINING	LUMP SUM	1	1				
3		2573.501	BALE CHECK	EACH	300	300				
3		2573.502	SILT FENCE HEAVY DUTY	m	4550.0	4550.0				
3		2573.505	FLOATATION SILT CURTAIN, TYPE STILL WATER	m	150.0		150.0			
		2575.501	SEEDING	ha	5.5	5.5				
		2575.502	SEED MIXTURE 90A	kg	250.0	250.0				
		2575.502	SEED MIXTURE 25A	kg	25.0	25.0				
		2575.505	SODDING TYPE SALT RESISTANT	m2	16900.0	16900.0				
		2575.505	SODDING TYPE LAWN	m2	11350.0	11350.0				
		2575.511	MULCH MATERIAL TYPE I	metric ton	20.8	20.8				
		2575.519	DISK ANCHORING	ha	5.5	5.5				
3		2575.523	EROSION CONTROL BLANKET (STRAW 2S)	m2	9300.0	9300.0				
		2575.532	COMMERCIAL FERT ANALYSIS 10-10-10	kg	3120.0	3120.0				
13		2581.501	REMOVABLE PREFORMED PLASTIC MARKING	m	3865.0	3865.0				
		2401.513	TYPE F (SPECIAL) RAILING CONCRETE (3Y46)	m	30.0	30.0				
2		0563.605	POLICE OFFICER	HOURL	1440.0	1440.0				



NOTES:

- 1 INCLUDES 7500 m2 FOR SUBGRADE CORRECTION TO BE USED AT THE DIRECTION OF THE ENGINEER IN THE FIELD.
 - 2 FOR USE AT I-35W AND 95TH AVENUE RAMP INTERSECTIONS DURING PEAK HOURS.
 - 3 INCLUDES MAINTENANCE.
 - 4 QUANTITY INCLUDES AGGREGATE BASE.
 - 5 QUANTITY INCLUDES STRIPING PROJECT SOUTH OF BALL ROAD TWICE.
 - 6 QUANTITY CONSISTS OF 1900 metric tons FOR THE BOX CULVERT AND 1200 metric tons FOR PIPE FOUNDATION CORRECTIONS TO BE USED AT THE DIRECTION OF THE ENGINEER IN THE FIELD.
 - 7 QUANTITY INCLUDES DELINEATORS X4-2 AND X4-5.
 - 8 QUANTITY CONSISTS OF 5890 m2 FOR TEMPORARY PAVEMENT CONSTRUCTION AND INCLUDES 150 mm AGGREGATE BASE CLASS 5A.
 - 9 QUANTITY INCLUDES PREFORMED RADIUS SECTIONS.
 - 10 THE REQUIRED GRANULAR FILTER MATERIAL AND/OR FILTER FABRIC SHALL BE CONSIDERED INCIDENTAL.
 - 11 QUANTITY CONSISTS OF CIRCLE PINES PROFESSIONAL CENTER, CENTENNIAL REAL ESTATE, LOVELL BUILDING - LEXINGTON CITY HALL, AND OASIS MARKET.
 - 12 QUANTITY CONSISTS OF BITUMINOUS SURFACED DRIVES AND INCLUDES 100 mm AGGREGATE BASE CLASS 5A.
 - 13 FOR TRAFFIC CONTROL PURPOSES DURING CONSTRUCTION.
 - 14 QUANTITY FOR CONCRETE APPROACH NOSES ON MEDIANS.
 - 15 QUANTITY INCLUDES 2531 m2 FOR BITUMINOUS SURFACED DRIVES.
 - 16 FOR SANITARY SEWER FORCEMAIN RELOCATION.
 - 17 FOR 400 mm DIP WATERMAIN RELOCATION.
 - 18 QUANTITY CONSISTS OF 2 IMPACT ATTENUATORS WHICH MAY BE REQUIRED TO BE RELOCATED TO DIFFERENT LOCATIONS ALONG CSAH 17 AS DIRECTED BY THE ENGINEER IN THE FIELD.
 - 19 FOR DUST CONTROL.
 - 20 QUANTITY CONSISTS OF 380 m SHOWN BETWEEN CR 10 AND BALL ROAD WHICH MAY BE REQUIRED TO BE RELOCATED TO DIFFERENT LOCATIONS ALONG CSAH 17 AS DIRECTED BY THE ENGINEER IN THE FIELD.
 - 21 QUANTITY INCLUDES 3200 m FOR TRAFFIC CONTROL DURING STAGE I TEMPORARY WIDENING AND 3200 m FOR TRAFFIC CONTROL DURING STAGE II CONSTRUCTION.
 - 22 ASSUMES IRRIGATION SYSTEM AT OASIS MARKET.
 - 23 QUANTITY CONSISTS OF AGGREGATE SURFACED DRIVES.
 - 24 QUANTITY BASED UPON PLAN THICKNESS PLUS 6 mm.
 - 25 QUANTITY CONSISTS OF PONDS A AND B.
 - 26 SEE TRAFFIC MANAGEMENT SYSTEM PLANS AND DETAIL SHEETS.
 - 27 20 m OF 50 mm NMC IS HD NMC UNDER ROADWAY SURFACE.
 - 28 FOR USE ON SIGN POSTS IN CONCRETE MEDIANS WITHIN MN/DOT RIGHT-OF-WAY.
 - 29 LENGTH INCLUDES GAP.
 - 30 0.50 (SAP 106-020-12) IS FUNDED AS FOLLOWS: 0.1875 SAP 106-020-12, 0.3125 CITY OF BLAINE (NON-PART).
 - 31 0.75 (SAP 106-020-12) IS FUNDED AS FOLLOWS: 0.25 SAP 106-020-12, 0.25 SAP 106-120-03, 0.25 CITY OF BLAINE (NON-PART).
 - 32 1.0 (SAP 106-020-12) IS FUNDED AS FOLLOWS: 0.50 SAP 106-020-12, 0.50 CITY OF BLAINE (NON-PART).
 - 33 1.0 (SAP 106-020-12) IS FUNDED AS FOLLOWS: 0.75 SAP 106-020-12, 0.25 CITY OF BLAINE (NON-PART).
 - 34 1.0 (SAP 106-020-12) IS FUNDED AS FOLLOWS: 0.50 SAP 106-020-12, 0.50 SAP 106-010-15.
- (P) PLAN QUANTITY.

INDEX OF TABULATIONS

TAB.	TABULATION	SHEET NO.
A	CLEARING & GRUBBING	10 - 12
B	DRAINAGE REMOVALS	12
C	PAVEMENT REMOVALS	13
D	MAILBOXES	13 -
E	RETAINING WALL & PLANTER BOX	13
F	DRIVEWAY CONSTRUCTION	13
G	WALK and C & G CONSTRUCTION	14
H	BITUMINOUS PAVEMENT CONSTRUCTION	14
J	FENCE CONSTRUCTION	14
K	TRAFFIC BARRIER (GUARDRAIL)	15
L	SANITARY SEWER CONSTRUCTION	15
M	WATERMAIN CONSTRUCTION	16
N	RAMP LIGHTING	17
P	ALIGNMENT	54 - 57
Q	CASTING ASSEMBLIES	84
R	DRAINAGE TABULATION	81 - 84
S	EARTHWORK	8 - 9
T	PERMANENT SIGN INSTALLATIONS	112
U	TYPE "A" SIGNS	110
V	DETOUR TRAFFIC SIGN TABULATION	27
W	TRAFFIC SIGN TABULATION	37

NOTE: "I" AND "O" NOT USED

1	3-26-97		DAD	ACHD	COMMENTS		I hereby certify that this plan, specification or report was prepared by me or under my direct supervision and that I am a duly Registered Professional Engineer under the laws of the State of Minnesota. <i>Emmel A. Demers</i> Date 3-21-97 Reg No 23397	STATE AND PROJECT NO. S.A.P. 02-617-11 S.A.P. 106-020-12	DRAWN BY DATE V. GRAF 12-96 DESIGNED BY B. MOORE 12-96 CHECKED BY D. DEMERS 3-97 COMM. NO. 0252410		ANOKA COUNTY STATEMENT OF ESTIMATED QUANTITIES C.S.A.H. 17 RECONSTRUCTION	SHEET 6 OF 236
2	4-17-97	DAD	DAD	ADD EXP ITEMS								
3	4-24-97	DAD	DAD	ADD NOTES 22, 33, 34 FOR EXP ITEMS								
NO	DATE	BY	CHK	APPR	REVISION							
NAME: SEQ 4 410.PLN DATE: Mar 17, 1997												

THE FOLLOWING STANDARD PLATES APPROVED BY THE DEPARTMENT OF TRANSPORTATION FEDERAL HIGHWAY ADMINISTRATION SHALL APPLY ON THIS PROJECT

STANDARD PLATES	
PLATE NO.	DESCRIPTION
M 1103 J	TYPICAL DOWEL BAR ASSEMBLY
M 1141 D	PAVEMENT KEYWAY FOR KEYED CONSTRUCTION
M 1150 P	CONSTRUCTION OF HEADER JOINTS
M 3000 L	REINFORCED CONCRETE PIPE
M 3006 G	GASKET JOINT FOR R.C. PIPE
M 3007 B	SHEAR REINFORCEMENT FOR PRECAST DRAINAGE STRUCTURES
M 3023 B	PRECAST CONCRETE END SECTION
M 3040 F	CORRUGATED METAL PIPE CULVERT
M 3100 G	CONCRETE APRON FOR REINFORCED CONCRETE PIPE
M 3123 J	METAL APRON FOR CS PIPE
M 3124 B	METAL APRON CONNECTION
M 3128 F	SAFETY APRON
M 3133 B	RIPRAP AT RCP OUTLETS
M 3145 E	CONCRETE PIPE TIES
M 3148 A	SAFETY SLOPE METAL END SECTION
M 3221 C	CORRUGATED STEEL PIPE COUPLING BAND
M 4005 L	MANHOLE OR CATCH BASIN
M 4006 L	MANHOLE OR CATCH BASIN
M 4010 H	CONC. SHORT CONE & ADJUSTING RING
M 4011 E	PRECAST CONCRETE BASE
M 4018 A	MH OR CB REDUCER CONE SECTION
M 4020 G	MANHOLE OR CATCH BASIN COVER
M 4101 D	RING CASTING FOR MANHOLE OR CATCH BASIN
M 4110 F	COVER CASTING FOR MANHOLE
M 4126 F	CATCH BASIN FRAME CASTING
M 4132 F	CATCH BASIN FRAME CASTING TYPE D CURB
M 4143 E	STOOL GRATE & CONCRETE FRAME
M 4149 C	GRATE CASTING FOR CATCH BASIN
M 4154 B	CATCH BASIN GRATE CASTING
M 4161 F	CURB BOX CASTING FOR CATCH BASIN
M 7035 J	CONCRETE WALK & CURB RETURNS AT ENTRANCES
M 7036 D	PEDESTRIAN CURB RAMP
M 7100 G	CONCRETE CURB & GUTTER
M 7102 I	CONCRETE CURB & GUTTER
M 7108 F	EXIT NOSE
M 7111 J	INSTALLATION OF CATCH BASIN CASTINGS
M 7112 C	INSTALLATION AND REINFORCEMENT OF CB AND MH CASTINGS
M 7113 A	CONCRETE APPROACH NOSE DETAIL
M 8000 I	STANDARD BARRICADES
M 8110 D	TRAFFIC SIGNAL BRACKETING
M 8111 C	TRAFFIC SIGNAL BRACKETING
M 8112 C	PEDESTAL FOUNDATION
M 8114 A	P.V.C. HANDHOLE / PULLBOX
M 8115 D	PEDESTRIAN PUSH BUTTON INSTALLATION
M 8117 F	PRECAST CONCRETE HANDHOLE (OR PULLBOX)
M 8119 C	GROUND MOUNTED CABINET FOUNDATION
M 8120 K	POLE FOUNDATION
M 8121 D	TRANSFORMER BASE AND POLE BASE PLATE
M 8122 C	PEDESTAL AND PEDESTAL BASE
M 8123 D	POLE AND MAST ARM
M 8124 E	MAST ARM SIGNAL HEAD MOUNTS
M 8126 F	POLE FOUNDATION
M 8127 B	LIGHT BASE - DESIGN E
M 8130 D	SAW CUT LOOP DETECTORS
M 8150 B	INSTALLATION OF CULVERT MARKERS
M 8307 P	STEEL PLATE BEAM GUARDRAIL
M 8318 C	GUARDRAIL ANCHORAGE PLATE FOR BRIDGES AND BCTS
M 8323 H	TEMPORARY PORTABLE PRECAST CONCRETE BARRIER
M 8329 F	ECCENTRIC LOADER BREAKAWAY CABLE TERMINAL (ELT)
M 9101 B	SHAPING AND SODDING OF SLOPES AT BOX CULVERT ENDS
M 9102 D	TURF ESTABLISHMENT AREAS (AT PIPE CULVERT ENDS)
M 9322 J	CHAIN LINK FENCE

CONSTRUCTION /SOILS NOTES

- SUITABLE GRADING MATERIAL ON THIS PROJECT SHALL CONSIST OF ALL SOILS ENCOUNTERED WITH THE EXCEPTION OF SLOPE DRESSING, DEBRIS, ORGANIC MATERIAL, MUCK AND OTHER UNSUITABLE MATERIAL.
- ITEMS REFERRED TO AS INCIDENTAL ON THIS PROJECT SHALL BE CONSIDERED INCIDENTAL WITH NO DIRECT COMPENSATION MADE THEREFORE.
- SELECT GRANULAR MATERIAL SHALL MEET THE REQUIREMENTS OF SPEC. 3149.2B2.
- BITUMINOUS AND CONCRETE SURFACING REMOVED BY CONSTRUCTION SHALL BECOME THE PROPERTY OF THE CONTRACTOR AND SHALL EITHER BE RECYCLED OR DISPOSED OF OFF THE PROJECT, IN ACCORDANCE WITH THE THE PROVISIONS OF SPEC. 2104 AND 2105.
- UNSUITABLE MATERIALS SHALL BE PLACED IN EMBANKMENTS OUTSIDE OF A 1V:1-1/2H SLOPE EXTENDING DOWN AND OUTWARD FROM THE GRADING PI OR THE BOULEVARD PI.
- COMPACTION OF THE GRADING ITEMS OF THIS PROJECT SHALL BE BY THE "SPECIFIED DENSITY METHOD", EXCEPT WHEN WITHIN 1 m OF THE WATER TABLE, THEN BY THE "QUALITY COMPACTION METHOD".
- COMPACTION OF THE AGGREGATE BASE ITEMS OF THIS PROJECT SHALL BE BY THE "SPECIFIED DENSITY METHOD" EXCEPT WHEN THE CONTRACTOR ELECTS TO USE RECYCLED MATERIALS FOR THE AGGREGATE BASE ITEMS, THEN THE "QUALITY COMPACTION METHOD" SHALL BE UTILIZED.
- COMPACTION OF THE BITUMINOUS ITEMS OF THIS PROJECT SHALL BE BY THE "MODIFIED SPECIFIED DENSITY METHOD", IN ACCORDANCE WITH THE PROVISIONS OF SPEC. 2340.
- STABILIZING AGGREGATE SHALL BE INCORPORATED INTO THE SUBGRADE TO ACHIEVE SATISFACTORY SURFACE STABILITY AT LOCATIONS DEEMED NECESSARY BY THE ENGINEER, IN ACCORDANCE WITH THE PROVISIONS OF SPEC. 2105.3G. GRANULAR MATERIAL WHICH IS FURNISHED BY THE CONTRACTOR SHALL BE STABILIZED, IF NECESSARY, AT THE CONTRACTOR'S EXPENSE. WHERE STABILIZING AGGREGATE IS DEEMED NECESSARY, IT SHALL BE APPLIED AT A RATE OF APPROXIMATELY 110 KILOGRAMS PER SQUARE METER.
- WHERE WIDENING ADJACENT TO EXISTING PAVEMENT, CUT VERTICALLY TO THE BOTTOM OF THE CLASS 5 AGGREGATE BASE AND THEN AT A 1V:1/2H SLOPE TO THE BOTTOM OF THE RECOMMENDED SUBGRADE EXCAVATION (AS SHOWN ON THE TYPICAL SECTIONS AND THE CROSS SECTIONS). BACKFILL PROMPTLY TO AVOID UNDERMINING THE EXISTING PAVEMENT.
- PROVIDE 1V:20H LONGITUDINAL TAPERS BETWEEN CHANGES IN SUBGRADE AND SUBCUT DEPTHS.
- USE TACK COAT BETWEEN ALL BITUMINOUS MIXTURES AND WHERE CONCRETE CURBING ABUTS BITUMINOUS MIXTURES.
- STRIP AND REUSE AS SLOPE DRESSING ALL EXISTING TOPSOIL, WHERE PRESENT. IN AREAS TO BE DISTURBED BY CONSTRUCTION, TOPSOIL STRIPING IS CONSIDERED TO BE COMMON EXCAVATION.
- PLACE A MINIMUM OF 100 MILLIMETERS OF SLOPE DRESSING ON ALL AREAS SCHEDULED FOR PERMANENT TURF ESTABLISHMENT. ALL EXCESS TOPSOIL SHALL BE USED AS SLOPE DRESSING BY PROVIDING A THICKNESS GREATER THAN 100 mm.
- SEEDING REQUIREMENTS ON THIS PROJECT SHALL BE AS FOLLOWS.
 - SEED MIXTURE 90A SHALL BE APPLIED AT A RATE OF 50 KILOGRAMS PER HECTARE.
 - MULCH MATERIAL TYPE I SHALL BE APPLIED AT A RATE OF 4.5 METRIC TONS PER HECTARE.
 - COMMERCIAL FERTILIZER ANALYSIS 10-10-10 (OR EQUIVALENT) SHALL BE APPLIED AT A RATE OF 560 KILOGRAMS PER HECTARE.
- DITCH BOTTOMS, TOE OF FILL, CUT RUNOUTS AND THE TOP EDGE OF THE BACKSLOPES SHALL BE ROUNDED REGARDLESS OF THE SECTION USED ON THE CROSS SECTION SHEETS.
- ALL TRAFFIC CONTROL DEVICES SHALL CONFORM TO THE MINNESOTA MANUAL ON UNIFORM TRAFFIC CONTROL DEVICES, INCLUDING THE FIELD MANUAL FOR TEMPORARY TRAFFIC CONTROL ZONE LAYOUTS, DATED APRIL 1995.
- COMMON BORROW MATERIAL SHALL HAVE A MINIMUM R-VALUE OF 55. BORROW MATERIAL PLACED WITHIN THE UPPER 1.2 m OF THE EMBANKMENT BELOW THE GRADING GRADE SHALL BE SELECT GRANULAR MATERIAL.
- THE EXISTING 35W MAINLINE PAVEMENT IS ASSUMED TO BE 203 mm CONTINUALLY REINFORCED CONCRETE PAVEMENT WITH VARIABLE DEPTHS OF BITUMINOUS OVERLAY. THE EXISTING RAMP PAVEMENT IS ASSUMED TO BE 203 mm UNIFORM REINFORCED CONCRETE PAVEMENT WITH INTEGRANT CURB. THE CONTRACTOR SHALL INVESTIGATE AND MAKE OWN DETERMINATION OF ACTUAL PAVEMENT DEPTHS. (INFORMATION FROM RECORD DRAWING FOR SP 0280-06).

THE EXISTING CSAH 17 BITUMINOUS PAVEMENT IS ASSUMED TO BE 114 mm THICK SOUTH OF I-35W AND 191 mm NORTH OF I-35W. THE CONTRACTOR SHALL INVESTIGATE AND MAKE OWN DETERMINATION OF ACTUAL PAVEMENT DEPTHS. (INFORMATION TAKEN FROM RECORD DRAWINGS FOR SAP 02-617-04 AND SAP 02-617-06).
- GRADING GRADE ON THIS PROJECT SHALL BE DEFINED AS THE BOTTOM OF THE AGGREGATE BASE OR SELECT GRANULAR MATERIAL AS SHOWN IN THE PAVEMENT DETAILS.

1	4-17-97	DAD	DAD	DAD	ADD "M" TO PL. 8110 D AND 8150 D
2	4-24-97	DAD	DAD	DAD	ADD "M" TO PL. 8111 C, 8122 C, 8124 E, 8130 D, 820 A, 8114 A
NO	DATE	BY	CHKD	APPR	REVISION
NAME: CSH 410.PLN DATE: Mar. 17, 1997					



I hereby certify that this plan, specification or report was prepared by me or under my direct supervision and that I am a duly Registered Professional Engineer under the laws of the State of Minnesota.
Ernest A. Jensen
 Date: 3-21-97 Reg. No. 23397

STATE AND PROJECT NO.
 S.A.P. 02-617-11
 S.A.P. 106-020-12
 S.A.P. 106-030-03
 CO. PROJECT NO.

DRAWN BY DATE
 V. GRAF 12-96
 DESIGNED BY
 D. DEMERS 12-96
 CHECKED BY
 D. DEMERS 1-97
 COMM. NO.
 0252410



ANOKA COUNTY
 CONSTRUCTION/SOILS NOTES, STANDARD PLATES
 C.S.A.H. 17 RECONSTRUCTION

SHEET
 7
 OF
 236

EARTHWORK TABULATION							
STATION	EXCAVATION			EMBANKMENT			
	COMMON	TOPSOIL	SUBGRADE	SUBGRADE	SELECT	SLOPE	
	STRIPPING			BACKFILL	SUITABLE	GRANULAR	DRESSING
	(m3)	(m3)	(m3)	(m3)	(m3)	(m3)	(m3)
CSAH 17 (LEXINGTON AVE) SOUTH OF I-35W							
8+436.5							
8+460.0	337	33	161	161	0	0	14
8+480.0	291	29	137	137	0	0	11
8+500.0	308	24	137	137	0	0	11
8+520.0	294	29	137	137	7	11	12
8+540.0	264	39	137	137	14	39	22
8+547.5	106	18	51	51	3	23	9
8+560.0	194	35	86	86	5	44	16
8+567.3	110	14	50	50	8	27	9
8+580.0	212	15	87	87	10	46	11
8+600.0	359	35	137	137	16	72	21
8+610.5	170	18	72	72	8	33	11
8+620.0	143	15	65	65	7	24	12
8+640.0	303	45	137	137	16	65	28
8+660.0	307	47	137	137	15	63	21
8+664.0	62	7	27	27	3	9	4
8+677.0	107	10	48	48	6	25	7
8+680.0	137	18	82	82	8	43	9
8+700.0	355	27	137	137	10	83	16
8+720.0	442	27	137	137	7	54	19
8+740.0	429	54	137	137	14	31	24
8+756.3	280	32	121	121	9	16	14
8+760.0	49	6	26	26	1	2	2
8+766.1	91	13	73	73	0	1	4
8+780.0	170	27	153	153	4	11	11
8+783.5	36	6	24	24	2	6	3
8+790.0	67	11	44	44	4	10	5
8+796.5	71	15	44	44	3	9	6
8+800.0	39	10	24	24	1	16	2
8+820.0	202	68	131	131	240	227	22
8+829.4	98	27	77	77	152	144	16
8+840.0	87	32	85	85	144	167	20
8+860.0	151	68	111	111	126	236	34
8+880.0	216	56	111	111	32	186	48
8+900.0	275	53	128	128	21	98	44
8+920.0	411	49	138	138	14	36	18
8+940.0	483	47	137	137	7	0	17
8+960.0	524	48	137	137	0	0	15
8+978.4	727	32	193	193	0	0	9
9+000.0	779	37	214	214	0	0	12
9+020.0	461	48	114	114	0	0	16
9+023.0	74	5	17	17	0	0	2
9+040.0	385	32	105	105	3	4	11
9+052.6	294	24	127	127	4	7	6
9+060.0	187	15	79	79	3	5	4
9+080.0	423	54	139	139	10	29	16
9+082.3	44	5	14	14	1	5	2
9+100.0	312	35	105	105	11	39	13
9+120.0	273	52	117	117	12	53	16
9+140.0	243	50	114	114	12	55	15
9+160.0	285	50	119	119	9	31	15
9+180.0	344	54	131	131	4	11	17
9+200.0	427	58	138	138	3	8	21
9+220.0	463	58	138	138	4	8	20
9+240.0	446	55	138	138	4	7	18
9+260.0	533	53	153	153	1	3	15
9+265.9	217	11	66	66	0	0	4
9+280.0	451	25	144	144	0	0	10
9+300.0	446	50	121	121	0	0	17
9+320.0	481	53	116	116	0	0	21
9+340.0	508	56	116	116	1	2	24

EARTHWORK TABULATION							
STATION	EXCAVATION			EMBANKMENT			
	COMMON	TOPSOIL	SUBGRADE	SUBGRADE	SELECT	SLOPE	
	STRIPPING			BACKFILL	SUITABLE	GRANULAR	DRESSING
	(m3)	(m3)	(m3)	(m3)	(m3)	(m3)	(m3)
9+360.0	517	62	115	115	4	5	29
9+380.0	509	62	115	115	9	26	29
9+400.0	354	73	108	108	270	75	39
9+420.0	204	75	86	86	428	295	47
9+440.0	163	68	68	68	346	548	40
9+460.0	141	73	64	64	389	598	40
9+480.0	152	73	66	66	348	603	40
9+500.0	168	74	76	76	264	604	40
9+520.0	164	69	94	94	237	497	34
9+532.8	141	34	102	102	143	233	16
9+540.0	63	20	63	63	86	115	8
9+560.0	80	71	108	108	274	418	28
9+580.0	116	70	83	83	220	512	30
9+600.0	223	52	104	104	131	389	24
9+607.0	88	14	36	36	47	110	7
9+616.5	83	16	41	41	38	145	10
9+620.0	29	6	17	17	20	48	4
9+631.5	246	12	105	105	67	83	7
9+640.0	231	9	92	92	0	0	2
9+660.0	422	49	170	170	0	2	14
9+680.0	389	53	159	159	9	27	18
9+700.0	401	53	159	159	17	63	18
9+720.0	444	54	159	159	17	68	20
9+740.0	436	55	160	160	15	47	19
9+760.0	476	52	149	149	13	19	17
9+780.0	573	49	131	131	6	2	17
9+800.0	653	48	125	125	0	0	19
9+813.8	499	23	83	83	0	0	13
9+820.0	226	10	36	36	0	0	6
9+840.0	628	49	115	115	0	2	21
9+860.0	551	48	117	117	0	4	21
9+880.0	504	46	125	125	0	4	18
9+900.0	430	47	140	140	9	16	17
9+920.0	352	58	150	150	20	59	25
9+940.0	307	61	144	144	22	90	26
9+960.0	286	57	131	131	24	98	20
9+980.0	263	56	124	124	19	94	18
10+000.0	245	54	137	137	11	71	17
10+014.9	273	33	156	156	4	22	10
10+020.0	107	9	68	68	0	0	3
10+040.0	176	53	155	155	30	231	23
10+060.0	0	78	24	24	233	677	35
10+080.0	0	87	0	0	743	987	44
10+100.0	0	102	0	0	1452	1075	59
10+120.0	0	118	0	0	2168	1068	71
10+140.0	0	124	0	0	2823	1051	77
10+160.0	0	135	0	0	3496	1055	87
10+180.0	0	132	0	0	3823	1138	94
10+200.0	0	118	0	0	2712	1158	79
10+220.0	4	114	0	0	1592	1158	93
10+240.0	4	105	0	0	1908	1044	105
10+260.0	0	77	0	0	1563	797	100
10+280.0	0	49	0	0	474	437	124
10+283.7	0	7	0	0	14	31	25
SUBTOTAL	29309	5215	10822	10822	27555	20073	2719
CSAH 17 (LEXINGTON AVE) NORTH OF I-35W							
10+360.0							
10+380.0	0	83	0	0	1335	694	108
10+400.0	0	88	0	0	1894	964	100
10+420.0	0	87	0	0	2028	1176	107
10+440.0	0	83	0	0	2669	1304	104

EARTHWORK TABULATION							
STATION	EXCAVATION			EMBANKMENT			
	COMMON	TOPSOIL	SUBGRADE	SUBGRADE	SELECT	SLOPE	
	STRIPPING			BACKFILL	SUITABLE	GRANULAR	DRESSING
	(m3)	(m3)	(m3)	(m3)	(m3)	(m3)	(m3)
10+460.0	0	92	0	0	3146	1254	95
10+480.0	0	108	0	0	3406	1200	105
10+500.0	0	111	0	0	3171	1142	100
10+520.0	0	100	0	0	2591	1120	90
10+540.0	0	89	0	0	2009	1097	79
10+560.0	0	75	0	0	1356	1062	66
10+580.0	0	58	0	0	629	1023	52
10+600.0	0	47	1	1	160	801	42
10+620.0	8	42	79	79	54	416	38
10+639.2	166	20	192	192	18	112	23
10+653.4	234	0	174	174	0	0	5
10+660.0	102	0	73	73	0	0	3
SUBTOTAL	510	1083	519	519	24166	13365	1118
COUNTY ROAD 10 (NORTH ROAD)							
8+035.0							0
8+040.0	84	4	19	19	0	0	3
8+060.0	265	15	69	69	0	0	11
8+075.0	130	6	47	47	0	0	6
8+080.0	35	2	16	16	0	0	1
8+100.0	103	6	63	63	0	0	5
8+105.0	19	1	16	16	0	0	1
SUBTOTAL	636	34	230	230	0	0	27
SE RAMP							
18+253.9							0
18+260.0	13	2	6	6	0	0	2
18+280.0	43	5	23	23	0	0	6
18+300.0	43	9	30	30	4	4	8
18+320.0	40	14	37	37	8	14	10
18+340.0	36	16	40	40	7	20	8
18+360.0	36	17	41	41	6	18	6
18+380.0	40	18	45	45	4	15	5
18+400.0	48	20	50	50	6	21	6
18+422.0	43	24	46	46	11	36	7
=							
3+000.0							
3+020.0	27	23	28	28	13	48	9
3+040.0	25	24	24	24	16	76	12
3+060.0	29	26	15	15	20	126	17
3+080.0	19	29	4	4	44	209	24
3+100.0	22	32	0	0	131	292	31
3+120.0	30	40	0	0	318	344	38
3+140.0	42	49	0	0	583	365	45
3+160.0	36	58	0	0	918	386	53
3+180.0	24	73	0	0	1283	424	63
3+200.0	20	85	0	0	1505	454	68
3+220.0	15	92	0	0	1508	466	71
3+240.0	17	96	0	0	1380	446	78
3+260.0	8	94	0	0	1439	484	90
3+280.0	0	58	0	0	852	506	98
SUBTOTAL	647	904	389	389	10056	4753	755
NE RAMP							
30+020.0							
30+040.0	0	78	0	0	1201	819	82
30+060.0	0	100	0	0	17		

EARTHWORK TABULATION							
STATION	EXCAVATION			EMBANKMENT			
	COMMON	TOPSOIL	SUBGRADE	SUBGRADE		SELECT	SLOPE
	(m3)	STRIPPING (m3)	(m3)	BACKFILL (m3)	SUITABLE (m3)	GRANULAR (m3)	DRESSING (m3)
30+100.0	121	86	22	22	576	206	95
30+120.0	57	75	40	40	244	118	82
30+140.0	112	64	45	45	140	90	70
30+160.0	147	55	45	45	64	88	61
30+170.0	80	22	22	22	20	45	23
SUBTOTAL	408	579	178	178	5445	2447	618
NW RAMP							
19+178.0					0		
19+200.0	192	42	48	48	10	42	27
19+220.0	193	40	51	51	9	32	24
19+240.0	188	39	44	44	8	32	25
19+250.0	156	36	40	40	8	28	24
19+280.0	112	30	37	37	6	22	21
19+300.0	60	20	34	34	6	17	14
19+320.0	32	12	29	29	8	8	10
19+340.0	33	11	24	24	9	0	10
19+346.1	10	3	7	7	3	0	3
5+000.0							
5+020.0	164	37	32	32	10	48	28
5+040.0	170	36	28	28	11	59	34
5+060.0	180	38	19	19	14	86	37
5+080.0	185	40	7	7	19	164	40
5+100.0	197	47	0	0	59	285	46
5+120.0	198	56	0	0	191	354	52
5+140.0	191	63	0	0	391	354	59
5+160.0	179	70	0	0	628	345	64
5+180.0	151	77	0	0	788	350	70
5+200.0	159	81	0	0	900	367	79
5+220.0	160	85	0	0	874	375	88
5+240.0	136	88	0	0	825	369	88
5+260.0	108	90	0	0	1029	373	92
5+280.0	41	60	0	0	728	426	94
SUBTOTAL	3195	1101	400	400	6505	4135	1029
SW RAMP							
40+040.0			0	0			
40+060.0	10	91	0	0	1678	796	101
40+080.0	6	92	0	0	1667	838	107
40+100.0	19	95	0	0	1507	753	106
40+120.0	59	102	0	0	1224	599	101
40+140.0	93	109	5	5	1104	457	100
40+160.0	102	95	30	30	772	236	90
40+180.0	109	75	49	49	335	94	73
40+200.0	135	63	46	46	159	89	61
40+205.0	39	14	11	11	15	22	14
SUBTOTAL	572	736	141	141	8461	3884	753
MISCELLANEOUS GRADING PLANS							
A	12733	559					559
B	19563						320
1.35W MEDIAN		148					148
SUBTOTAL	32296	707	0	0		0	1027
TOTAL	67573	10359	12679	12679	82488	48657	8046

① EARTHWORK SUMMARY

			SUITABLE GRADING	31118
			PAVEMENT REMOVAL	④ 4159
			TOPSOIL	10359
EXCAVATION m3 (EV)	② COMMON	45636		
	⑤ SUBGRADE	20179		
	⑥ SPECIAL	32296	SUITABLE GRADING	
EMBANKMENT m3 (CV)				
		SUITABLE GRADING	83233	
		SUBGRADE BACKFILL	12679	
	⑤ SELECT GRANULAR	56157	81450 (LV)	
	SELECT GRANULAR (MOD 10%)	3150	4560 (LV)	
	TOPSOIL	8046	8046 (LV)	
BORROW m3 (CV)				
		SELECT GRANULAR (MOD 10%)	3150	4560 (LV)
	⑤ SELECT GRANULAR	56157	81450 (LV)	
	③ COMMON	30388	44100 (LV)	

NOTES:

SEE CONSTRUCTION/SOIL NOTES FOR MATERIAL DEFINITIONS AND ADDITIONAL INFORMATION.


- ① 120% SHRINKAGE FACTOR USED FROM EXCAVATED VOLUME (EV) TO COMPACTED VOLUME (CV), EXCEPT FOR TOPSOIL. 145% SHRINKAGE FACTOR USED FROM LOOSE VOLUME (LV) TO COMPACTED VOLUME (CV), EXCEPT FOR TOPSOIL. SHRINKAGE FACTORS ARE ASSUMED VALUES, USED ONLY FOR THE PURPOSE OF ESTIMATED QUANTITIES. IT SHALL BE UNDERSTOOD THAT NO WARRANTY IS MADE OR IMPLIED AS TO THE ACCURACY, SUFFICIENCY, OR RELIABILITY OF THE SHRINKAGE FACTOR.
- ② INCLUDES TOPSOIL STRIPPING (ASSUMED TO BE 100 mm THICK). PAY QUANTITY INCREASED BY 1819 m3 FOR REMOVAL OF TEMPORARY WIDENING CONSTRUCTED UNDER STAGE I TRAFFIC CONTROL PLANS.
- ③ COMMON BORROW QUANTITY INCLUDES 170 m3 FOR PLASTIC SOILS CAP AT BOX CULVERT.
- ④ TO BE PAID UNDER SEPERATE ITEMS.
- ⑤ QUANTITY INCLUDES 7500 m3 (CV) FOR SUBGRADE CORRECTION.
- ⑥ SPECIAL EXCAVATION CONSISTS OF PONDS A AND B. ASSUMED TO BE SUITABLE GRADING MATERIAL.

A CLEARING & GRUBBING								REMARK
STATION	TO STATION	OFFSET LEFT	OFFSET RIGHT	CLEARING		GRUBBING		
				TREE	HECTARE	TREE	HECTARE	
NB CSAH 17								
8+389.1			7.2	1		1		
8+391.2			8.4	1		1		
8+438.8		24.0		1		1		
8+461.5		17.1		1		1		
8+467.1		17.2		1		1		
8+481.0		17.6		1		1		
8+487.2		17.9		1		1		
8+495.8		19.4		1		1		
8+504.5		15.4		1		1		
8+506.4		17.6		1		1		
8+508.0		15.8		1		1		
8+511.6		17.1		1		1		
8+516.0		20.2		1		1		
8+528.4		17.9		1		1		
8+533.9		16.1		1		1		
8+536.9			12.7	1		1		
8+538.3		24.3		1		1		
8+545.8		23.2		1		1		
8+550.1		23.5		1		1		
8+551.3		17.0		1		1		
8+554.1		17.7		1		1		
8+562.0		22.8		1		1		
8+575.9		17.8		2		2		
8+576.0		14.7 - 31.5						HEDGES
8+583.4	8+601.4	14.1 - 16.6						HEDGES
8+584.5		17.7		1		1		
8+597.7			2.5	1		1		
8+602.2			2.6	2		2		
8+606.2		18.3		1		1		
8+613.3			2.6	1		1		
8+618.5		16.0		1		1		
8+622.5			3.2	2		2		
8+621.6		20.0		1		1		
8+624.4		17.4		1		1		
8+629.3		17.6		1		1		
8+623.2			3.5	1		1		
8+629.0		24.0		2		2		
8+635.4			4.3	2		2		
8+635.8		13.2 - 24.9						HEDGES
8+636.0		15.0		1		1		
8+637.9		20.8		1		1		
8+643.2		24.0		1		1		
8+644.4		15.9		1		1		
8+651.2		15.9		1		1		
8+653.3			3.6	1		1		
8+655.0		18.3		1		1		
8+655.8			3.8	3		3		
8+658.1		16.5		1		1		
8+659.5		15.7		1		1		
8+661.1			3.1	1		1		
8+665.8			6.0	1		1		
8+677.3		18.9		1		1		
8+677.7		23.7		1		1		
8+690.8		20.2		1		1		
8+695.4		16.8		4		4		
8+705.4		21.6		1		1		

A CLEARING & GRUBBING								REMARK
STATION	TO STATION	OFFSET LEFT	OFFSET RIGHT	CLEARING		GRUBBING		
				TREE	HECTARE	TREE	HECTARE	
8+705.8		16.4		1		1		
8+707.5		20.9		1		1		
8+708.1		14.5		1		1		
8+710.3		14.7		1		1		
8+711.1		17.6		1		1		
8+712.2	8+727.3	14.8		12		12		
8+714.6		17.9		1		1		
8+715.7		24.9		1		1		
8+718.3		22.5		1		1		
8+719.6		18.0		1		1		
8+724.6		19.5		1		1		
8+741.4		20.7		1		1		
8+728.4	8+754.5	14.8						HEDGES
8+753.8		16.4 - 25.4						HEDGES
8+759.4	8+778.2	15.8						HEDGES
8+759.7		16.7 - 25.4						HEDGES
8+762.9		21.4		1		1		
8+732.0			9.7	1		1		
8+737.2			9.7	1		1		
8+747.1			10.4	1		1		
8+753.3			9.3	1		1		
8+786.5	8+788.6	16.0 - 21.3						LANDSCAPING
8+788.4		23.5		1		1		
8+795.9		22.5		1		1		
8+796.3		17.1		1		1		
8+809.7			12.5	1		1		
8+811.6		25.0		1		1		
8+816.0	8+819.4	16.9 - 19.8						LANDSCAPING
8+819.6		16.5		1		1		
8+819.8		22.4		1		1		
8+820.4		25.7		1		1		
8+820.8			7.2	1		1		
8+834.8			5.5	1		1		
8+844.8			9.9	1		1		
8+862.6			5.7	1		1		
8+891.1			6.1	1		1		
8+898.3			6.3	1		1		
8+900.7			11.7	1		1		
8+907.1			8.0	1		1		
8+910.3			13.5	1		1		
8+842.9	8+842.9	13.9 - 76.0			0.42		0.42	
8+822.9	8+832.9		11.5 - 21.5		0.02		0.02	
8+918.0	8+985.3	14.4 - 76.0			0.3		0.3	
8+933.9			11.4	1		1		
8+936.9			5.7	1		1		
8+938.7			7.0	1		1		
8+941.9			8.2	1		1		
8+944.0			6.5	1		1		
8+949.2			5.9	1		1		
8+952.6			9.5	1		1		
8+951.6			5.3	1		1		
8+963.3			7.8	1		1		
8+964.3			6.0	1		1		
8+970.8			8.0	1		1		
8+973.0			8.1	1		1		
8+981.8			7.3	1		1		
8+982.2			8.5	1		1		

A CLEARING & GRUBBING

NO	DATE	BY	CHKD	APPN	REVISION

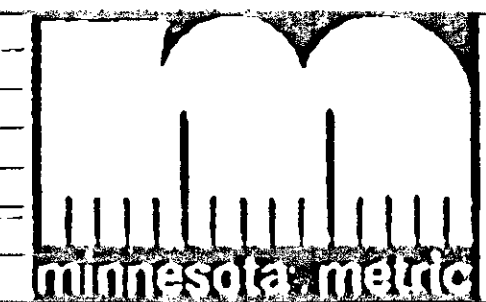

I hereby certify that this plan, specification or report was prepared by me or under my direct supervision and that I am a duly Registered Professional Engineer under the laws of the State of Minnesota.
Arnold A. Jensen
 Date 3-21-97 Reg No 23397

STATE AID PROJECT NO. S.A.P. 02-617-11 S.A.P. 106-020-12 S.A.P. 106-030-03
 CO. PROJECT NO.
 DRAWN BY V. CRAF DATE 12-96
 DESIGNED BY D. DEMERS 12-96
 CHECKED BY D. DEMERS 2-97
 COMM. NO. 0262410





ANOKA COUNTY
 TABULATIONS
 C.S.A.H. 17 RECONSTRUCTION

SHEET 10 OF 236

A CLEARING & GRUBBING								
STATION	TO STATION	OFFSET LEFT	OFFSET RIGHT	CLEARING		GRUBBING		REMARK
				TREE	HECTARE	TREE	HECTARE	
9+674.5			8.0	1		1		
9+677.5			8.6	1		1		
9+680.0		18.6		1		1		
9+680.6		29.7		1		1		
9+683.5			8.4	1		1		
9+686.5		18.6		1		1		
9+689.8			8.5	1		1		
9+691.0		29.0		1		1		
9+691.4		19.5		1		1		
9+698.9		20.3		1		1		
9+703.5			8.8	1		1		
9+706.3		20.0		1		1		
9+754.5			5.4	1		1		
9+758.7			6.4	1		1		
9+738.4	9+760.4	18.3 - 25.1			0.02		0.02	
9+772.4	9+785.7	19.6 - 25.3			0.02		0.02	
9+790.3			8.3	1		1		
9+796.4			8.7	1		1		
9+802.6			8.5	1		1		
9+808.7			8.5	1		1		
9+818.1			8.3	1		1		
9+821.1			8.0	1		1		
9+824.0			8.4	1		1		
9+826.8			7.9	1		1		
9+833.0			8.0	1		1		
9+833.0		20.4		1		1		
9+836.1			8.2	1		1		
9+839.1			8.0	1		1		
9+842.0			8.2	1		1		
9+845.0			8.1	1		1		
9+851.3			7.9	1		1		
9+854.4			8.3	1		1		
9+857.5			8.1	1		1		
9+860.5			8.3	1		1		
9+863.3		20.6		1		1		
9+863.6			7.8	1		1		
9+866.1			8.2	1		1		
9+869.7			8.1	1		1		
9+872.5			7.6	1		1		
9+878.8		20.1		1		1		
9+886.7			6.2	1		1		
9+889.6			6.2	2		2		
9+894.3		19.7		1		1		
9+897.1			8.3	1		1		
9+900.1			8.3	1		1		
9+903.2			7.9	1		1		
9+906.2			8.2	1		1		
9+909.2			7.9	1		1		
9+912.2			15.1	1		1		
9+912.2			8.3	1		1		
9+915.5			8.0	1		1		
9+918.7			8.7	1		1		
9+922.4			8.0	1		1		
9+925.6			8.8	1		1		
9+931.8			9.2	1		1		
9+935.3			8.5	1		1		
9+938.2			9.4	1		1		

A CLEARING & GRUBBING								
STATION	TO STATION	OFFSET LEFT	OFFSET RIGHT	CLEARING		GRUBBING		REMARK
				TREE	HECTARE	TREE	HECTARE	
8+987.4			8.3	1		1		
8+989.9			8.9	1		1		
8+990.4			4.8	1		1		
8+990.5			8.7	1		1		
8+990.7	8+996.3	19.2 - 23.4			0.02		0.02	
8+991.2			8.4	1		1		
8+992.6			8.6	1		1		
8+992.8			4.9	1		1		
8+996.4			8.5	1		1		
8+999.5			8.7	1		1		
9+001.1			8.7	1		1		
9+004.5			8.9	1		1		
9+008.6			9.2	1		1		
9+013.1			10.2	1		1		
9+016.7			7.7	1		1		
9+018.8			6.7	2		2		
9+036.0	9+157.0	18.8 - 24.5			0.06		0.06	
9+036.2			4.7	1		1		
9+042.2			4.3	1		1		
9+042.9			10.4	1		1		
9+043.3			8.5	1		1		
9+066.1			4.9	2		2		
9+073.5			5.6	1		1		
9+077.5			5.8	1		1		
9+226.0	9+257.0	16.0 - 24.5			0.02		0.02	
9+087.7			11.6	1		1		
9+275.2	9+323.1	14.0 - 26.3			0.04		0.04	
9+344.0	9+358.2	20.5 - 23.0			0.02		0.02	
9+089.6	9+404.5	2.0 - 24.0			0.38		0.38	
9+367.5		20.5		1		1		
9+409.3		22.8		1		1		
9+431.7			21.3	1		1		
9+432.2			13.9	2		2		
9+549.9	9+585.6	15.9 - 28.0			0.04		0.04	
9+554.7	9+577.9	19.9 - 21.7			0.02		0.02	
9+594.5			21.0	1		1		
9+600.0			21.0	1		1		
9+604.2			21.0	1		1		
9+608.6			21.0	1		1		
9+618.0			21.0	1		1		
9+619.5			23.0	1		1		
9+622.1			22.0	1		1		
9+643.0	9+656.0	6.0 - 19.0						SHRUBS
9+622.0		23.2		1		1		
9+636.4		18.2						LANDSCAPING
9+650.9		21.2		1		1		
9+653.0		25.7		1		1		
9+655.5		20.4		1		1		
9+656.4			8.2	1		1		
9+659.0		25.6		1		1		
9+662.2		21.9		1		1		
9+665.3			8.5	1		1		
9+666.4		16.9		1		1		
9+666.6		20.5		1		1		
9+666.7		25.1		1		1		
9+668.3			7.8	1		1		
9+671.3			8.5	1		1		

A CLEARING & GRUBBING

NO		DATE		BY		CHKD		APPR		REVISION	
NAME: TAB2 410.PLN DATE: Mar. 17, 1997											
			I hereby certify that this plan, specification or report was prepared by me or under my direct supervision and that I am a duly Registered Professional Engineer under the laws of the State of Minnesota. <i>Janet A. Demers</i> Date: 3-21-97 Reg. No. 23397								
			STATE AID PROJECT NO. S.A.P. 02-617-11 S.A.P. 106-020-12 S.A.P. 106-030-03 CO. PROJECT NO.			DRAWN BY V. GRAF DESIGNED BY D. DEMERS CHECKED BY D. DEMERS COMM. NO. 026240					
										SHEET 11 OF 236	

A CLEARING & GRUBBING										
STATION	TO STATION	OFFSET LEFT	OFFSET RIGHT	CLEARING		GRUBBING		REMARK		
				TREE	HECTARE	TREE	HECTARE			
9+941.6			9.0	1		1				
9+945.1			9.6	1		1				
10+034.6			14.7	1		1				
10+058.2			12.4	1		1				
10+060.7			14.3	1		1				
10+066.2			8.6	1		1				
10+080.0			11.4	1		1				
10+080.6			15.4	1		1				
10+081.5		29.8		1		1				
10+087.2			19.5	1		1				
10+027.9	10+046.2		10.0 - 15.0					LANDSCAPING		
10+080.6	10+085.0		17.8 - 21.2					LANDSCAPING		
10+233.2		20.9		1		1				
10+267.7			18.3	1		1				
10+282.7			23.7	1		1				
10+287.4			21.3	1		1				
10+289.1			19.1	1		1				
10+298.5			13.6	1		1				
10+377.4		24.2		1		1				
10+383.1		24.5		1		1				
10+387.4		31.2		1		1				
10+425.2	10+517.6	28.4 - 71.1			0.26		0.26			
10+293.2		31.4		1		1				
10+590.4		34.0		1		1				
10+593.7		34.0		1		1				
10+597.3		34.2		1		1				
10+601.3		34.2		1		1				
10+604.9		34.0		1		1				
10+609.0		33.5		1		1				
WEST ROAD (SOUTH)						3		3		
TOTAL						257	1.64	257	1.64	



NOTES: TREES WITHIN THE CONSTRUCTION LIMITS WILL BE DESIGNATED FOR REMOVAL BY THE ENGINEER.
ALL TREES TO BE TRANSPLANTED WILL BE TRANSPLANTED BY OTHERS.
REMOVAL OF MISCELLANEOUS SHRUBS AND LANDSCAPING SHALL BE CONSIDERED INCIDENTAL.

B DRAINAGE REMOVALS									
ALIGNMENT	STATION	TO STATION	OFFSET		REMOVE			REMARK	
			LEFT (meter)	RIGHT (meter)	STRUCTURE (EACH)	APRON (EACH)	PIPE (meter)		
NB CSAH 17	8+436.0		24.0		1			CB	
NB CSAH 17	8+511.0			3.0	1			MH	
NB CSAH 17	8+511.0			1.0 - 3.0			11.0	12" RCP	
NB CSAH 17	8+519.0		12.0		1			CB	
NB CSAH 17	8+521.0		12.0		1			CB	
NB CSAH 17	8+522.0			1.0	1			CB	
NB CSAH 17	8+519.0	8+521.0	12.0				2.0	15" RCP	
NB CSAH 17	8+527.0			5.0		1		12" RCP	
NB CSAH 17	8+522.0	8+527.0		1.0 - 4.0			5.0	12" RCP	
NB CSAH 17	8+541.0			6.0		1		12"	
NB CSAH 17	8+541.0	8+548.0		6.0			7.0	12"	
NB CSAH 17	8+548.0			6.0		1		12"	
NB CSAH 17	8+521.0	8+547.0	12.0 - 14.0				26.0		
NB CSAH 17	8+547.0		14.0		1				
NB CSAH 17	8+547.0	8+547.5	14.0 - 20.0				6.0		
NB CSAH 17	8+547.5		20.0		1				
NB CSAH 17	8+547.0	8+558.0	20.0 - 25.5				13.0		
NB CSAH 17	8+911.0	8+921.0	15.0				10.0	6"	
NB CSAH 17	8+966.0		16.0			1		15" CMP	
NB CSAH 17	8+966.0	8+994.0	16.0				23.0	15"	
NB CSAH 17	8+994.0		16.0			1		15" CMP	
NB CSAH 17	9+519.0	8+546.0	17.0				27.0	15"	
NB CSAH 17	9+593.0		16.0			1		15" CMP	
NB CSAH 17	9+593.0	9+608.0	16.0				15.0	15" CMP	
NB CSAH 17	9+608.0		16.0			1		15" CMP	
NB CSAH 17	9+612.0	9+619.0	17.0	4.0 - 7.0			16.0	TIMBER BOX (DOUBLE 5' x 5')	
NB CSAH 17	9+617.0			9.0		1		21" RCP	
NB CSAH 17	9+617.0			7.0		1		30" RCP	
NB CSAH 17	9+617.0	9+647.0	4.0 - 9.0				28.0	21" RCP	
NB CSAH 17	9+617.0	9+649.0	1.5 - 7.0				31.0	30" RCP	
NB CSAH 17	9+647.0			4.0	1			MH	
NB CSAH 17	9+647.0			4.0 - 12.0			6.0	21" RCP	
NB CSAH 17	9+647.0			12.0		1		21" RCP	
NB CSAH 17	9+649.0			1.5	1			M	
NB CSAH 17	9+649.0			1.5			9.0	30" RCP	
NB CSAH 17	9+649.0			12.0		1		30" RCP	
NB CSAH 17	9+807.0	9+820.0	17.0				13.0	6" CMP	
NB CSAH 17	10+003.0	10+027.0		6.0			24.0	30" RCP	
NB CSAH 17	10+085.0	10+102.0		6.0			17.0	18"	
NB CSAH 17	10+267.0			0.5	1			CB	
NB CSAH 17	10+267.0		8.0		1			CB	
NB CSAH 17	10+380.0			0.5	1			CB	
NB CSAH 17	10+380.0		8.0	0.1	1			CB	
SB 35W	18+804.0		13.0			1		24" RCP	
SB 35W	18+815.0		14.0			1		24"	
SB 35W	18+815.0	18+873.0	14.0 - 15.0				58.0	24"	
SB 35W	18+873.0		15.0			1		24"	
NB 35W	18+608.0			10.0		1		24" RCP	
NB 35W	18+800.0			10.0		1		24" RCP	
NB 35W	18+802.0	18+835.0	12.0	10.0			33.0	18" CMP	
NB 35W	18+835.0		12.0			1		18" CMP	
SE RAMP	3+121.0		3.0		1			CB	
SE RAMP	3+111.0		3.0	2.0			6.0	12"	
SE RAMP	3+136.0		2.0		1			CB	
SE RAMP	3+136.0		2.0	4.0			6.0	12"	
SE RAMP	3+187.0		11.0			1		18"	
SE RAMP	3+184.0	3+187.0	11.0	11.0			22.0	18"	
SE RAMP	3+194.0			4.0	1			CB	
SE RAMP	3+194.0			4.0 - 15.0			11.0	12"	
NW RAMP	4+991.0			1.0		1		18"	
NW RAMP	5+110.0		3.0		1			CB	
NW RAMP	5+110.0		3.0	3.0			6.0	12" CMP	
NW RAMP	5+125.0		2.0		1			CB	
NW RAMP	5+125.0		2.0	4.0			6.0	18" CMP	
NW RAMP	5+183.0			4.0	1			CB	
NW RAMP	5+183.0			4.0 - 15.0			11.0	12"	
NW RAMP	5+204.0		13.0			1		24" RCP	
NW RAMP	5+192.0	5+204.0	13.0	15.0			29.0	24" RCP	
SW RAMP	40+133.0		17.0			1		30" RCP	
SW RAMP	40+133.0	40+146.0	17.0	18.0			35.0	30" RCP	
SW RAMP	40+146.0			18.0		1		30" RCP	
SW RAMP	40+175.0			3.6	1			CB	
SW RAMP	40+175.0			3.6 - 15.0			12.0	12"	
SW RAMP	40+175.0			15.0		1		12"	
NE RAMP	30+183.0			4.0	1			CB	
TOTAL						21	23	529.0	

NOTE:

REMOVAL OF TIMBER BOX CULVERT TO BE PAID UNDER SEPERATE ITEM . REMOVAL OF WING WALLS IS CONSIDERED INCIDENTAL

A CLEARING & GRUBBING
B DRAINAGE REMOVALS

NO		DATE	BY	CHKD	APPR	REVISION		I hereby certify that this plan, specification or report was prepared by me or under my direct supervision and that I am a duly Registered Professional Engineer under the laws of the State of Minnesota. <i>Donald A. James</i> Date 3-21-97 Reg No 23397	STATE AND PROJECT NO. S.A.P. 02-617-11 S.A.P. 106-020-12 S.A.P. 106-030-03 CO. PROJECT NO.	DRAWN BY V. GRAF DESIGNED BY D. DEMERS CHECKED BY D. DEMERS DATE 12-96 DATE 12-96 DATE 2-97 COMM. NO. 0262410		ANOKA COUNTY TABULATIONS C.S.A.H. 17 RECONSTRUCTION	SHEET 12 OF 236
NAME: TABS 410.PLN DATE: Mar. 17, 1997													

C PAVEMENT REMOVALS						
NOTES	LOCATION	REMOVE CURB & GUTTER	REMOVE BITUMINOUS PAVEMENT	REMOVE CONCRETE PAVEMENT	SAWING BITUMINOUS PAVEMENT	SAWING CONCRETE PAVEMENT
		(meter)	3 (m2)	2 (m2)	(meter)	(meter)
	CSAH 17 (SOUTH OF BR)	271	21910		55	
	CSAH 17 (NORTH OF BR)	424	6380		31	
	EDGEWOOD RD	24	240		8	
	WEST RD (SOUTH)	58	340		10	
	WEST RD (NORTH)	40	350		10	
	97th LANE	70	440		9	
	99th LANE	38	530		9	
	AUSTIN ST	30	280		9	
	CR 10		1070		10	
	BALL RD		340		7	
	PHEASANT RIDGE DR		350		18	
	SE RAMP		370	2800		270
	NE RAMP			1110		5
	NW RAMP		320	2650		250
	SW RAMP			1240		6
1	NB I-35W		540			
1	SB I-35W		680			
	TOTAL	955	34240	7810	176	542

NOTES: 1 QUANTITY FOR USE IN RECONSTRUCTING I-35W MEDIAN SHOULDERS AS PART OF TRAFFIC STAGING PLANS.
 2 QUANTITY INCLUDES CONCRETE CURB & GUTTER.
 3 QUANTITY FOR CSAH 17 (SOUTH OF BRIDGE) INCLUDES 5890 m2 FOR TEMPORARY PAVEMENT PLACED AS PART OF STAGING PLANS.

D MAILBOXES						
ALIGNMENT	STATION	OFFSET		ADDRESS	RELOCATE (EACH)	REMARK
		LT	RT			
NB CSAH 17	8+562.0		1.5	9507	1	MAILBOX
SB CSAH 17	8+576.0	0.5		9480	1	MAILBOX
SB CSAH 17	8+613.0		1.0	9500	1	MAILBOX
SB CSAH 17	8+643.0		1.1	9508	1	MAILBOX
SB CSAH 17	8+674.0		0.5	9516	1	MAILBOX
SB CSAH 17	8+703.0		2.0	9532	1	MAILBOX
SB CSAH 17	8+753.0		0.5	9546	1	MAILBOX
SB CSAH 17	8+772.0		0.5	9560	1	MAILBOX
	PROJECT TOTALS:				8	

NOTES: INSTALL MAIL BOXES TO LOCATIONS DESIRED BY THE OWNER.

F DRIVEWAY CONSTRUCTION										
NOTES	ALIGNMENT	STATION	ADDRESS	LT	RT	EXISTING SURFACING	REMOVAL	DRIVEWAY WIDTH	AGGREGATE DRIVES	BITUMINOUS PAVEMENT
							(m2)	(meter)	(t)	(m2)
	NB CSAH 17	8+427.7			X	BITUMINOUS	92	10.0		86
	NB CSAH 17	8+500.0			X	BITUMINOUS	272	9.0		198
	NB CSAH 17	8+547.5	9507		X	BITUMINOUS	74	3.6		52
	NB CSAH 17	8+567.3	4175	X		BITUMINOUS	130	6.8		52
	NB CSAH 17	8+580.0	9480	X		BITUMINOUS	274	5.0		96
	NB CSAH 17	8+610.5	9500	X		AGGREGATE		4.8	18	16
	NB CSAH 17	8+664.0	9508	X		AGGREGATE		4.0	3	13
	NB CSAH 17	8+671.0	9516	X		AGGREGATE		5.0	2	16
	NB CSAH 17	8+700.0	9532	X		AGGREGATE		3.3	8	11
	NB CSAH 17	8+700.0			X	BITUMINOUS	220	6.3		155
	NB CSAH 17	8+756.8	9546	X		AGGREGATE		2.5	8	9
1	NB CSAH 17	8+783.5	9560	X		BITUMINOUS	104	6.3		40
	WEST ROAD	2+026.0	2		X	BITUMINOUS	16	3.0		5
	WEST ROAD	2+025.0	1	X		BITUMINOUS	155	5.8		54
2	NB CSAH 17	8+013.0	9564	X		BITUMINOUS	87			
2	NB CSAH 17	8+915.1			X	AGGREGATE				
	NB CSAH 17	9+023.0	GAS SUBSTATION	X		AGGREGATE		3.6	6	12
3	NB CSAH 17	9+082.3	95		X	AGGREGATE		2.7	31	10
	NB CSAH 17	9+500.0	LIFT STATION	X		BITUMINOUS	145	6.8		22
	NB CSAH 17	9+631.5	10102	X		BITUMINOUS	154	5.8		19
2	NB CSAH 17	9+313.8			X	AGGREGATE				
2	NB CSAH 17	10+094.3	10333 - 10345		X	BITUMINOUS	754			
	CR 10	8+074	GALILEE CHURCH		X	BITUMINOUS	54	7.2		54
	TOTAL						2531		76	910

NOTES: AGGREGATE DRIVE SURFACING SHALL BE 175 mm THICK.
 BITUMINOUS DRIVEWAY PAVEMENT SHALL BE A MINIMUM OF 100 mm THICK. QUANTITY INCLUDES 100 mm AGGREGATE BASE CLASS 5A.
 BITUMINOUS DRIVE APRONS SHALL EXTEND 3 m FROM FACE OF CURB AND SHALL BE CONSTRUCTED TO THE DIMENSIONS SHOWN ON STD PL M7035.
 1 BEGIN DRIVEWAY PROFILE AT FACE OF CURB.
 2 CLOSE DRIVEWAY.
 3 REALIGN DRIVE TO WEST ROAD.

E RETAINING WALL & PLANTER BOX CONSTRUCTION									
ALIGNMENT	STATION TO STATION	OFFSET		ADDRESS	REMOVE (meter)	SALVAGE (meter)	INSTALL (meter)	FURNISH & INSTALL	REMARK
		LT	RT					CONCRETE BLOCK WALL (m2)	
SB CSAH 17	8+755.0	1.5 - 16.5		9546	15.0		7.0		TIMBER WALL
SB CSAH 17	8+780.0	5.0 - 12.0		9560		7.0	7.0		TIMBER PLANTER BOX & ROCKS
NB CSAH 17	8+785.5	8+797.2						13.0	WALL A
SB CSAH 17	8+786.3	8+788.4	2.8 - 8.5	9550		14.1	14.1		TIMBER PLANTER BOX
NB CSAH 17	8+793.1	8+795.6		1	4.5				TIMBER WALL
NB CSAH 17	8+939.3	8+979.2						22.0	WALL B
NB CSAH 17	9+062.0				6.0	6.0			CONCRETE BLOCK BBQ
NB CSAH 17	9+409.1	9+411.7			9.0				CONCRETE WALL
SB CSAH 17	9+605.5	9+611.5	7.7					12.0	WALL C
SB CSAH 17	9+635.4	9+638.5	3.3 - 6.0	10102		9.9	9.9		TIMBER PLANTER BOX
	PROJECT TOTALS:				28.5	37.0	37.0	47.0	

NOTES: INSTALL SALVAGED TIMBER PLANTER BOXES TO LOCATIONS DESIRED BY THE OWNER.

- C PAVEMENT REMOVALS
- D MAILBOXES
- E RETAINING WALL & PLANTER BOX CONSTRUCTION
- F DRIVEWAY CONSTRUCTION

G WALK and CURB & GUTTER CONSTRUCTION									
NOTES	LOCATION	100 mm CONCRETE WALK (m2)	150 mm CONCRETE WALK (m2)	50 mm BITUMINOUS WALK (m2)	B612 C & G 1 (meter)	B618 C & G (meter)	B418 C & G 2 (meter)	D424 C & G (meter)	SURMOUNTABLE C & G (meter)
	CSAH 17 (SOUTH OF BR)	3870	25	3200	2590	3670	55		
	CSAH 17 (NORTH OF BR)	965	7	730	500	480	65		
	EDGEWOOD RD								10
	WEST RD (SOUTH)								35
	WEST RD (NORTH)								25
	97th LANE								55
	99th LANE								25
	AUSTIN ST								10
	CR 10					160			
	BALL RD								
	PHEASANT RIDGE DR								
	SE RAMP	30	6			25			
	NE RAMP							305	
	NW RAMP	30	6			25			
	SW RAMP							350	
	NB I-35W								
	SB I-35W								
	TOTAL	4895	44	8930	3090	4360	120	655	160

NOTES: 1 CSAH 17 MEDIAN.
2 CSAH 17 ADJACENT TO GUARDRAIL AT BRIDGE APPROACHES.

H BITUMINOUS PAVEMENT CONSTRUCTION								
NOTES	LOCATION	TYPE 41 WEAR (t)	TYPE 41 BINDER (t)	TYPE 47 WEAR (t)	TYPE 47 BINDER (t)	TYPE 31 BASE (t)	TYPE 31 SHLD (t)	AGGREGATE BASE CLASS 5 (m3)
	CSAH 17 (SOUTH OF BR)	3950	4540			7990		9915
	CSAH 17 (NORTH OF BR)	830	950			1670		1750
	EDGEWOOD RD	5	5			10		10
	WEST RD (SOUTH)	15	15			30		30
	WEST RD (NORTH)	13	10			25		25
	97th LANE	25	25			45		45
	99th LANE	10	10			25		25
	AUSTIN ST	5	5			10		10
	CR 10	60	65			120		130
	BALL RD	5	5			10		10
	PHEASANT RIDGE DR							
	SE RAMP			290	330	760	160	1710
	NE RAMP							90
	NW RAMP			240	280	630	170	1675
	SW RAMP							155
1	NB I-35W	150						
1	SB I-35W	160						
	TOTAL	5225	5630	530	610	11325	330	15580

NOTES: 1 QUANTITY FOR USE IN RECONSTRUCTING I-35W MEDIAN SHOULDERS AS PART OF TRAFFIC STAGING PLANS.

J FENCE CONSTRUCTION										
ALIGNMENT	STATION TO	STATION	OFFSET LEFT (meter)	OFFSET RIGHT (meter)	LEAVE IN PLACE	REMOVE (meter)	SALVAGE (meter)	INSTALL (meter)	F & I CHAIN LINK (meter)	REMARK
SB CSAH 17		8+575.0	5.5 - 14.5			6.0	3.0	3.0		CHAIN LINK
SB CSAH 17		8+605.6	1.8 - 13.0			8.2	3.0	3.0		CHAIN LINK
SB CSAH 17	8+617.3	TO 8+634.3	1.6 - 2.0				16.5	16.5		CHAIN LINK
SB CSAH 17	8+816.0	TO 8+819.6	3.3 - 7.6				6.0	6.0		SPLIT RAIL
NB CSAH 17		8+711.5		9.5 - 13.0		2.5	1.0	1.0		CHAIN LINK
NB CSAH 17	8+711.5	TO 8+729.4		9.5			18.0	18.0		CHAIN LINK
NB CSAH 17		8+729.4		9.5 - 12.0		2.5				CHAIN LINK
NB CSAH 17	8+735.5	TO 8+797.2		9.5					11.7	WALL A
NB CSAH 17	8+885.5	TO 8+892.3		7.0 - 16.2			32.2	32.2		CHAIN LINK (GAS BUILDING)
NB CSAH 17	8+962.4	TO 9+016.0		10.6 - 12.5	X					CHAIN LINK
SB CSAH 17	9+007.5	TO 9+030.6	9.3 - 11.5			4.6	23.1	23.1		CHAIN LINK (GAS SUBSTATION)
NB CSAH 17	9+022.4	TO 9+043.1		10.7	X					WOOD FENCE
NB CSAH 17		9+039.1		7.4 - 11.0		3.6				CHAIN LINK
NB CSAH 17	9+089.1	TO 9+111.7		7.4			22.5	22.6		WOOD FENCE
NB CSAH 17		9+111.7		7.4 - 10.6		3.2				WOOD FENCE
SB CSAH 17	9+107.7	TO 9+117.0	11.5		X					CHAIN LINK
SB CSAH 17	9+117.0	TO 9+123.0	11.5		X					CHAIN LINK
SB CSAH 17	9+123.0	TO 9+204.5	11.5		X					CHAIN LINK
NB CSAH 17	9+111.7	TO 9+137.0		10.6 - 11.6	X					CHAIN LINK
NB CSAH 17	9+137.0	TO 9+140.0		11.6 - 13.8	X					CHAIN LINK
NB CSAH 17	9+144.3	TO 9+171.2		11.3	X					WOOD FENCE
SB CSAH 17		9+592.8	12.6 - 17.6				5.0	5.0		CHAIN LINK
NB CSAH 17	9+398.6	TO 9+403.3		19.5 - 17.6					5.5	BOX CULVERT
NB CSAH 17	9+400.2	TO 9+404.8		23.4 - 21.5					5.5	BOX CULVERT
NB CSAH 17	9+403.3	TO 9+404.8		17.6 - 21.4					5.0	BOX CULVERT
NB CSAH 17	9+406.5	TO 9+436.2		22.0 - 30.5	X					SPLIT RAIL
SB CSAH 17	9+505.5	TO 9+511.5	7.1						6.0	WALL C
SB CSAH 17		9+614.4	14.1 - 12.1						5.5	BOX CULVERT
SB CSAH 17	9+614.4	TO 9+618.5	14.1						5.0	BOX CULVERT
SB CSAH 17		9+618.5	14.1 - 19.1						5.5	BOX CULVERT
NB CSAH 17	9+645.2	TO 9+676.0		20.5	X					WOOD FENCE (PICKET)
SB CSAH 17		9+693.4	7.2 - 17.0			6.4	3.4	3.4		WIRE FENCE
SB CSAH 17	9+693.4	TO 9+780.0	6.9 - 7.2				86.6	86.6		WIRE FENCE
NB CSAH 17	9+705.8	TO 9+730.2		19.0	X					WOOD FENCE
NB CSAH 17	9+754.5	TO 9+778.6		18.4	X					WOOD FENCE
SB CSAH 17		9+856.6	7.7 - 13.4			5.7				WIRE FENCE
SB CSAH 17	9+856.6	TO 9+934.5	6.4 - 7.7				77.9	77.9		WIRE FENCE
SB CSAH 17		9+964.0	11.7 - 31.5		X					WIRE FENCE
NB CSAH 17	10+200.6	TO 10+212.2		9.0 - 20.4		6.0	10.0	10.0		CHAIN LINK
NB CSAH 17	10+237.0	TO 10+284.0		2.0 - 8.6		8.5	42.0	42.0		CHAIN LINK
NB CSAH 17	10+373.6	TO 10+428.8		2.4 - 8.4		18.1	38.0	38.0		CHAIN LINK
NB CSAH 17	10+460.0	TO 10+502.5		15.0 - 25.0			50.6	50.6		CHAIN LINK
SB CSAH 17	10+177.9	TO 10+196.6	1.4 - 14.7			23.0				CHAIN LINK
SB CSAH 17	10+218.3	TO 10+274.0		0.0 - 7.4		30.2	26.0	26.0		CHAIN LINK
SB CSAH 17	10+363.0	TO 10+410.3	0.5 - 0.0	0.0 - 7.5			49.9	49.9		CHAIN LINK
SB CSAH 17	10+436.8	TO 10+445.5	6.8 - 13.0			12.4				CHAIN LINK
SE RAMP	3+160.0	TO 3+259.0		16.0 - 28.5			102.0	102.0		CHAIN LINK
NE RAMP	30+011.3	TO 30+120.0		26.5			122.0	122.0		CHAIN LINK
NW RAMP	5+009.5	TO 5+255.0		17.0 - 25.3			239.0	239.0		CHAIN LINK
SW RAMP	40+015.3	TO 40+182.5		20.6 - 25.5			167.2	167.2		CHAIN LINK
PROJECT TOTALS:						140.9	1144.0	1144.0	49.7	

NOTES: F & I CHAIN LINK FENCE INCLUDES THE REQUIRED ELECTRICAL GROUNDS, BRACE ASSEMBLIES, AND METAL POST EXTENSIONS.

- ⓐ WALK AND CURB & GUTTER CONSTRUCTION
- ⓑ BITUMINOUS PAVEMENT CONSTRUCTION
- ⓒ FENCE CONSTRUCTION



(K) TRAFFIC BARRIER (GUARDRAIL)																
ALIGNMENT	STATION	TO	STATION	LOCATION (meter)	SALVAGE WOOD BOLLARD (EACH)	INSTALL WOOD BOLLARD (EACH)	REMOVE END TREATMENT (EACH)	SALVAGE END TREATMENT (EACH)	PLATE BEAM GUARDRAIL					ANCHORAGE ASSEMBLY (EACH)	END TREATMENT (ELT) 3329 (EACH)	REMARK
									REMOVE (meter)	SALVAGE (meter)	INSTALL (meter)	DESIGN B8307 (meter)	DESIGN SPECIAL (meter)			
NB CSAH 17			8+433.0	11.5 RT. - 16.5 RT.	2	2										
NB CSAH 17	8+689.5	TO	8+703.8	6.0 RT. - 16.5 RT.	9	7										
NB CSAH 17	9+607.2	TO	9+628.9	10.7 LT. - 12.5 LT.			2									
NB CSAH 17	9+595.3	TO	9+625.7	0.0 RT. - 5.0 RT.			1									
NB CSAH 17	10+245.6	TO	10+283.6	4.0 RT. - 1.3 RT.			1					39				
NB CSAH 17	10+373.5	TO	10+411.0	1.7 RT. - 5.3 RT.			1					38				
SB CSAH 17	10+236.6	TO	10+269.5	4.0 RT. - 7.6 RT.			1					33				
SB CSAH 17	10+363.0	TO	10+400.7	7.7 RT. - 5.2 RT.			1					38				
C.R. 10	8+018.0	TO	8+035.2	6.0 RT.			1									
NB 35W	18+734.3	TO	18+795.7	6.7 RT. - 9.3 RT.				1				62				
NB 35W	18+780.0	TO	18+827.5	10.0 LT. - 15.1 LT.								100			1	
SB 35W	18+817.7	TO	18+876.4	6.5 LT. - 9.0 LT.				1				59				
NB CSAH 17	10+240.6	TO	10+252.0	6.828 RT											1	
NB CSAH 17	10+252.0	TO	10+267.4	6.828 RT							15.4					
NB CSAH 17	10+267.4	TO	10+275.0	6.828 RT									7.6			
SB CSAH 17	10+357.0	TO	10+364.6	6.828 LT									7.6			
SB CSAH 17	10+364.6	TO	10+381.6	6.828 LT							17					
SB CSAH 17	10+381.6	TO	10+393.0	6.828 LT											1	
NB 35W			18+760.2	LT							11.4				2	
NB 35W	18+760.2	TO	18+835.0	LT							134.6	25				
NB 35W			18+835.0	LT							11.4					
NW RAMP	5+136.0	TO	5+147.4	3.6 LT											1	
NW RAMP	5+147.4	TO	5+260.0	3.6 LT							112.5					
NW RAMP			5+260.0	3.6 LT									1			
SE RAMP	3+116.0	TO	3+127.4	3.6 LT											1	
SE RAMP	3+127.4	TO	3+260.0	3.6 LT							132.6					
SE RAMP			3+260.0	3.6 LT										1		
PROJECT TOTALS:					11	9	8	2	73	369	290.0	170.0	15.2	2	4	

NOTES: SALVAGING AND REMOVAL OF END TREATMENTS AND ANCHORAGES SHALL BE CONSIDERED INCIDENTAL.
 1 100 m INCLUDES 7.6m OF 1.5m RADIUS AND 15.2m OF 12m RADIUS PREFORMED SECTIONS.
 2 PREFORMED RADII FROM MEDIAN LOOP ENCLOSURE.

(L) SANITARY SEWER CONSTRUCTION																	
ALIGNMENT	STATION	TO	STATION	OFFSET	OWNER	SALVAGE		INSTALL		FURNISH & INSTALL		PROPOSED RIM ELEV.	ADJUST CASTING (EACH)	RECONSTRUCT MANHOLE (meter)	NOTES		
						457 mm CASING (meter)	152 mm DIP (meter)	457 mm CASING (meter)	152 mm DIP (meter)	457 mm CASING (meter)	50 mm INSULATION BOARD (m2)						
SB CSAH 17			8+346.076		3.1	LEXINGTON										LEAVE AS IS	
SB CSAH 17			8+427.229		3.1	LEXINGTON										LEAVE AS IS	
SB CSAH 17			8+495.932		3.0	LEXINGTON						276.856	1				
SB CSAH 17			8+565.236		3.1	LEXINGTON						276.862	1				
SB CSAH 17			8+631.328		3.0	LEXINGTON						277.311	1				
SB CSAH 17			8+697.165		3.0	LEXINGTON						277.772	1				
SB CSAH 17			8+793.176		3.0	LEXINGTON						277.757		1.60			
SB CSAH 17	9+504.5	TO	9+630.0	4.2 - 6.0		BLAINE	15.0	26.5	15.0	26.5	5.0					1	
SB CSAH 17	9+612.3	TO	9+621.3	4.2 - 8.0		BLAINE						108.0				2	
SB CSAH 17			10+024.336		1.3	BLAINE						275.601		1.90			
BALL RD			9+050.276		9.3	BLAINE										LEAVE AS IS	
NB CSAH 17			10+646.393		11.4	BLAINE										LEAVE AS IS	
EDGEWOOD RD			3+031.709		0.0	BLAINE										LEAVE AS IS	
97th LANE			4+035.355		0.1	BLAINE						276.587	1				
PROJECT TOTALS:							15.0	26.5	15.0	26.5	5.0	108.0		5	3.50		



NOTES: 1 QUANTITY INCLUDES FOUR 152 mm BY 45 DEGREE BENDS.
 2 QUANTITY CONSISTS OF 3 LAYERS OF 50 mm INSULATION BOARD.

(K) TRAFFIC BARRIER (GUARDRAIL)
 (L) SANITARY SEWER CONSTRUCTION

NO		DATE	BY	CHKD	APPR	REVISION		I hereby certify that this plan, specification or report was prepared by me or under my direct supervision and that I am a duly Registered Professional Engineer under the laws of the State of Minnesota. <i>Donald A. Demers</i> Date 3-21-97 Reg No. 23357	STATE AND PROJECT NO. S.A.P. 02-617-11 S.A.P. 106-020-12 S.A.P. 106-030-03 CO. PROJECT NO.	DRAWN BY DATE V. GRAF 12-96 DESIGNED BY D. DEMERS 12-96 CHECKED BY D. DEMERS 2-97 COMM. NO. 0962410		ANOKA COUNTY TABULATIONS C.S.A.H. 17 RECONSTRUCTION		SHEET 15 OF 236
NAME: TABS 410.PLN DATE: Mar 17, 1997														



WATERMAIN CONSTRUCTION																						
ALIGNMENT	STATION TO STATION	OFFSET		OWNER	F & I DIP WM (CL 52)		F & I 762 mm CASING (meter)	F & I 50 mm INSULATION BOARD (m2)	SALVAGE				INSTALL				RELOCATE CURB STOP & BOX (EACH)	ADJUST HYDRANT (EACH)	ADJUST VALVE BOX (EACH)	WATERMAIN FITTINGS (kilogram)	NOTES	
		LT	RT		150 mm (meter)	400 mm (meter)			400 mm DIP (meter)	762 mm CASING (meter)	HYDRANT (EACH)	GATE VALVE (EACH)	400 mm DIP (meter)	762 mm CASING (meter)	HYDRANT (EACH)	GATE VALVE (EACH)						
SB CSAH 17	8+415.0		7.1	LEXINGTON																HYDRANT LEAVE AS IS		
SB CSAH 17	8+416.7		0.1	LEXINGTON																VALVE BOX LEAVE AS IS		
SB CSAH 17	8+424.7		3.5	LEXINGTON																VALVE BOX LEAVE AS IS		
SB CSAH 17	8+438.0		0.1	LEXINGTON																		
NB CSAH 17	8+491.1			36.0	CIRCLE PINES														1	HYDRANT LEAVE AS IS		
SB CSAH 17	8+540.0 TO 8+750.0		0.1	LEXINGTON				1056														
SB CSAH 17	8+589.0		4.0	LEXINGTON															1			
SB CSAH 17	8+623.0		3.9	LEXINGTON															1			
SB CSAH 17	8+641.5		4.0	LEXINGTON															1			
NB CSAH 17	8+683.0			13.5	CIRCLE PINES														1			
SB CSAH 17	8+684.8		3.4	LEXINGTON															1			
NB CSAH 17	8+692.7			14.4	CIRCLE PINES														1			
NB CSAH 17	8+694.0			15.5	CIRCLE PINES														1			
SB CSAH 17	8+714.8		2.6	LEXINGTON															1			
SB CSAH 17	8+748.0		5.2	LEXINGTON															1			
NB CSAH 17	8+753.5			9.5	CIRCLE PINES	5.0													1			
NB CSAH 17	8+758.5			9.5	CIRCLE PINES														1			
NB CSAH 17	8+757.8			7.2	CIRCLE PINES														1			
NB CSAH 17	8+761.2			9.5	CIRCLE PINES														1			
NB CSAH 17	8+766.7			9.8	CIRCLE PINES														1			
SB CSAH 17	8+775.0		6.0	LEXINGTON															1			
NB CSAH 17	8+776.0			7.2	CIRCLE PINES														1			
NB CSAH 17	8+776.9			6.2	CIRCLE PINES														1			
SB CSAH 17	8+797.0		4.8	LEXINGTON															1			
SB CSAH 17	8+819.5		0.4	LEXINGTON															1			
SB CSAH 17	8+820.5		2.0	LEXINGTON															1			
SB CSAH 17	8+820.5		12.5	LEXINGTON	11.0														1	68 LEAD 0.5m BELOW STORM		
SB CSAH 17	8+827.3		0.7	LEXINGTON															1			
SB CSAH 17	8+833.0		10.8	BLAINE															1			
EDGEWOOD RD	3+036.7			10.0	BLAINE														1	VALVE BOX LEAVE AS IS		
SB CSAH 17	8+834.5		11.8	BLAINE															1			
SB CSAH 17	8+836.0		12.0	BLAINE															1			
SB CSAH 17	8+838.0		12.0	BLAINE	2.0														1			
SB CSAH 17	8+900.0 TO 8+940.0			0.1	BLAINE			192.0														
SB CSAH 17	8+960.0 TO 8+980.0			0.1	BLAINE			96.0														
SB CSAH 17	8+867.0 TO 8+882.0			0.7	BLAINE	12.0		12.0												92 LOWER WATERMAIN		
EDGEWOOD	3+051.0 TO 3+059.0			3.0	BLAINE	8.0		12.0												92 LOWER WATERMAIN		
SB CSAH 17	8+980.5		11.0	BLAINE															1			
SB CSAH 17	8+983.5		12.0	BLAINE															1			
SB CSAH 17	8+984.3		12.0	BLAINE															1			
SB CSAH 17	8+986.3		12.0	BLAINE	2.0														1			
97th LANE	4+030.0			10.0	BLAINE															VALVE BOX LEAVE AS IS		
NB CSAH 17	9+539.5			13.3	BLAINE														1			
BALL RD	9+041.6			9.3	BLAINE															HYDRANT LEAVE AS IS		
SB CSAH 17	9+592.5		32.0	BLAINE																VALVE BOX LEAVE AS IS		
NB CSAH 17	9+592.0		25.0	14.0	BLAINE				39.0	18.0												
NB CSAH 17	9+592.0		25.0	19.5	BLAINE		5.5	24.0					39.0	18.0								
NB CSAH 17	9+592.0 TO 9+646.0			5.2 - 14.0	BLAINE		3.0						58.0									
NB CSAH 17	9+636.0 TO 9+638.0			11.0 - 13.0	BLAINE	3.0																
NB CSAH 17	9+638.7			8.5	BLAINE																	
NB CSAH 17	9+640.8			10.5	BLAINE																	
NB CSAH 17	9+666.1			5.0	BLAINE														1			
NB CSAH 17	9+690.0 TO 9+720.0			4.5	BLAINE			192.0														
BALL RD	9+041.6			11.5	BLAINE															VALVE BOX LEAVE AS IS		
BALL RD	9+046.2			12.2	BLAINE															VALVE BOX LEAVE AS IS		
NB CSAH 17	10+002.4			1.8	BLAINE														1			
SB CSAH 17	10+002.8		1.2	BLAINE															1			
SB CSAH 17	10+029.2		4.2	BLAINE															1			
SB CSAH 17	10+030.7			1.6	BLAINE														1			
SB CSAH 17	10+629.5		15.5	BLAINE	4.0														1			
SB CSAH 17	10+633.5		15.5	BLAINE															1			
SB CSAH 17	10+635.0		15.4	BLAINE															1			
NB CSAH 17	10+640.9			9.1	BLAINE														1			
PROJECT TOTALS:					47.0	8.5	24.0	1560.0	97.0	18.0	5	1	97.0	18.0	5	1	8	2	21	252		


(M) WATERMAIN CONSTRUCTION

		I hereby certify that this plan, specification or report was prepared by me or under my direct supervision and that I am a duly Registered Professional Engineer under the laws of the State of Minnesota. <i>Donald A Demers</i> Date: 3-21-97 Reg No: 23397		STATE AID PROJECT NO. S.A.P. 02-617-11 S.A.P. 108-020-12 S.A.P. 108-030-03 CO. PROJECT NO.		DRAWN BY: V. GRAY DATE: 12-96 DESIGNED BY: D. DEMERS DATE: 12-96 CHECKED BY: D. DEMERS DATE: 2-97 COMM. NO. 0252410				ANOKA COUNTY TABULATIONS C.S.A.H. 17 RECONSTRUCTION		SHEET 16 OF 236	
--	--	---	--	---	--	--	--	---	--	---	--	--------------------------	--


RAMP LIGHTING														REMARK	
ALIGNMENT	STATION TO STATION		OFFSET		LIGHTING UNIT NUMBER	REMOVE PULLBOX (EACH)	REMOVE LIGHT BASE (EACH)	SALVAGE LIGHTING UNIT (EACH)	F & I LIGHT BASE DESIGN E (EACH)	F & I PULLBOX (EACH)	INSTALL LIGHTING UNIT (EACH)	F & I 78 mm RSC (meter)	F & I 78 mm RSC AUGERED (meter)		F & I 3/C #4 (meter)
	LEFT (meter)	RIGHT (meter)	LEFT (meter)	RIGHT (meter)											
NB 35W	18+342			14.027	1				1		1			80	
NB 35W	18+422			19.356	2				1		1			65	
NB 35W	18+438.5			12.0	1 EXIST.		1	1			1			15	
NB 35W	18+487			23.693	3				1		1				
NB 35W	18+487		9.4	23.7								14.3			
NB 35W	18+487			9.350	4				1		1			100	
NB 35W	18+518			17.0	2 EXIST.		1	1							
NB 35W	18+531			25.3	3 EXIST.		1	1							
NB 35W	18+584			9.5	4 EXIST.		1	1							
NB 35W	18+584			9.350					1					205	SPLICE TO EXISTING CABLE
NB 35W	18+835 TO 18+890		42.0	16.0									80		LEAVE AS IS
NB 35W	19+012			13.6	5 EXIST.										LEAVE AS IS
NB 35W	19+085			11.0	6 EXIST.										LEAVE AS IS
NB 35W	19+158			9.5	7 EXIST.										LEAVE AS IS
NB CSAH 17	10+193.3		10.0		15 EXIST.		1	1							
NB CSAH 17	10+228 TO 10+255		35.0	11.0								53			
NB CSAH 17	10+239			4.5		1									
NB CSAH 17	10+240.5			3.3	16 EXIST.		1	1							
NB CSAH 17	10+253.0			4.5		1									
NB CSAH 17	10+263			14.0					1					395	
NB CSAH 17	10+395			4.0		1									
NB CSAH 17	10+405.5			4.0		1									
NB CSAH 17	10+406.5		10.5		17 EXIST.		1	1							
NB CSAH 17	10+467			10.5	18 EXIST.		1	1							
NW RAMP	5+261 TO 5+265		8.5	7.5								16			
SB 35W	18+451.5			9.0	14 EXIST.										LEAVE AS IS
SB 35W	18+524.5			10.5	13 EXIST.										LEAVE AS IS
SB 35W	18+597.5			13.0	12 EXIST.										LEAVE AS IS
SB 35W	19+027			8.0	11 EXIST.		1	1							
SB 35W	19+028			25.5	10 EXIST.		1	1							
SB 35W	19+029			9.350					1					90	SPLICE TO EXISTING CABLE
SB 35W	19+095			16.3	9 EXIST.		1	1							
SB 35W	19+113			9.350	11				1		1			15	
SB 35W	19+113		9.4	23.7								14.3			
SB 35W	19+113			23.693	10				1		1			65	
SB 35W	19+165			11.6	8 EXIST.		1	1			1			80	
SB 35W	19+178			19.360	9				1		1				
SB 35W	19+258			14.027	8				1		1				
PROJECT TOTALS						4	12	12	8	3	8	103.6	80	1110	

(N) RAMP LIGHTING


NO	DATE	BY	CHK	APPR	REVISION		I hereby certify that this plan, specification or report was prepared by me or under my direct supervision and that I am a duly Registered Professional Engineer under the laws of the State of Minnesota. <i>Donald A Demers</i> Date 3-21-97 Reg No. 23397	STATE AID PROJECT NO. S.A.P. 02-617-11 S.A.P. 106-020-12 S.A.P. 106-030-03 CO. PROJECT NO.	DRAWN BY V. GRAF DATE 12-98 DESIGNED BY D. DEMERS 12-98 CHECKED BY D. DEMERS 2-97 COMM. NO. 0562410		ANOKA COUNTY		SHEET 17 OF 236
NAME: TABB 410.PLN DATE: Mar. 17, 1997					TABULATIONS						C.S.A.H. 17 RECONSTRUCTION		

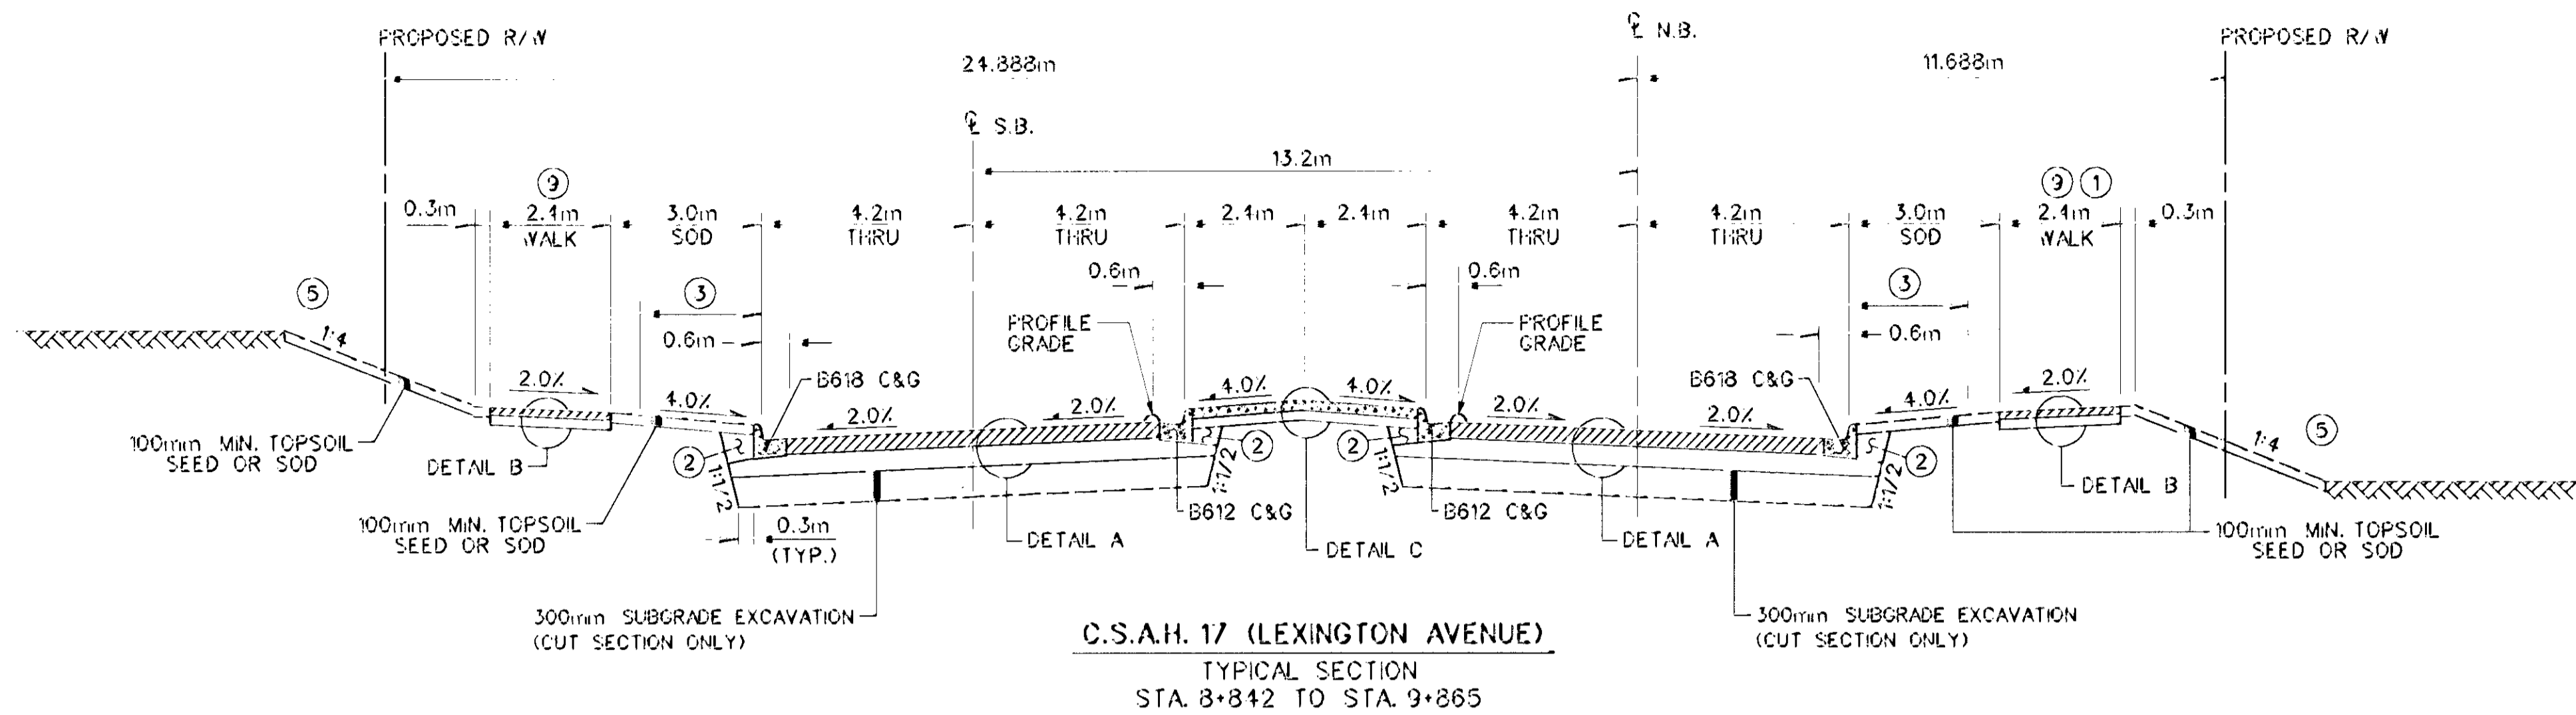


C.S.A.H. 17 (LEXINGTON AVENUE)
TYPICAL SECTION
STA. 8+842 TO STA. 9+865

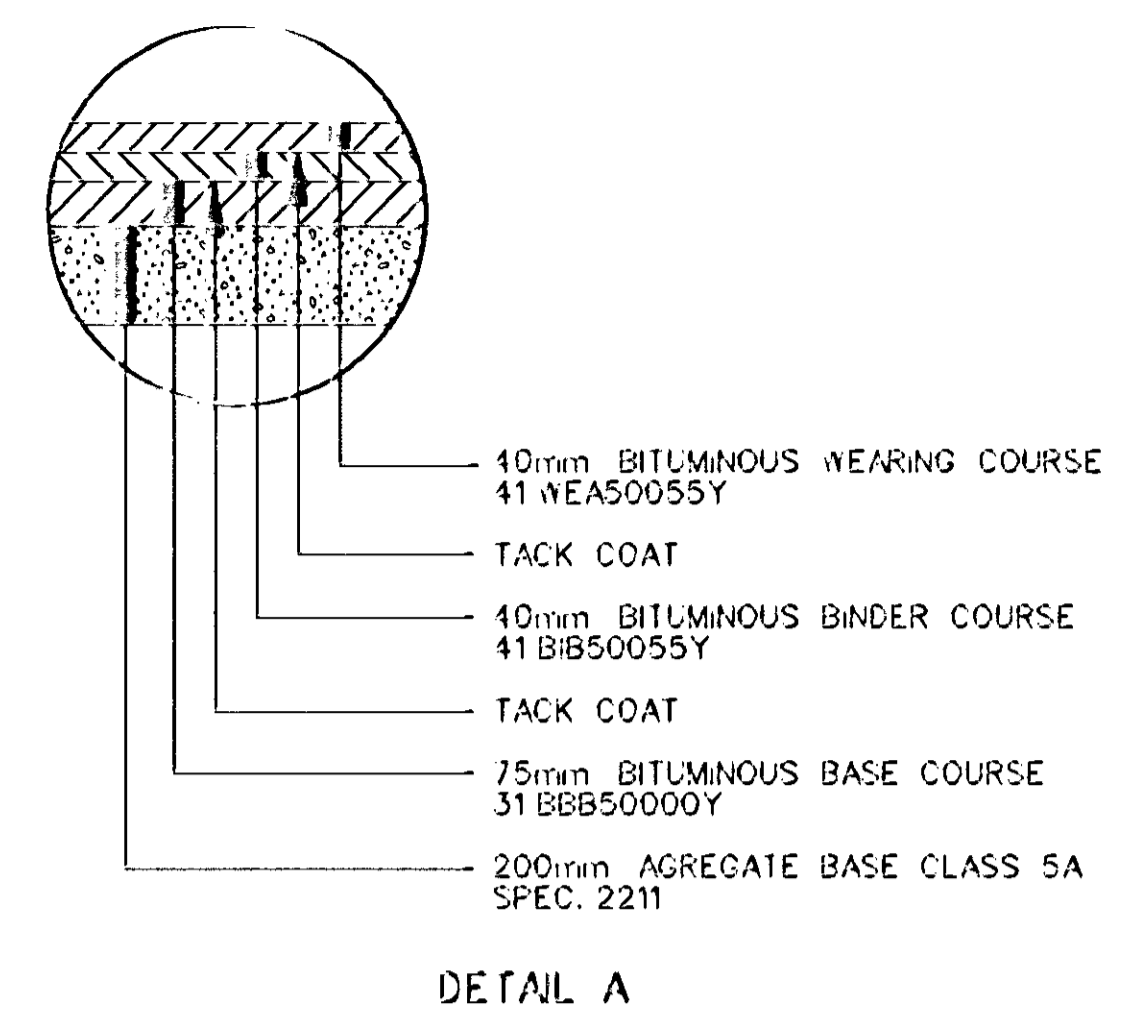


DETAIL A

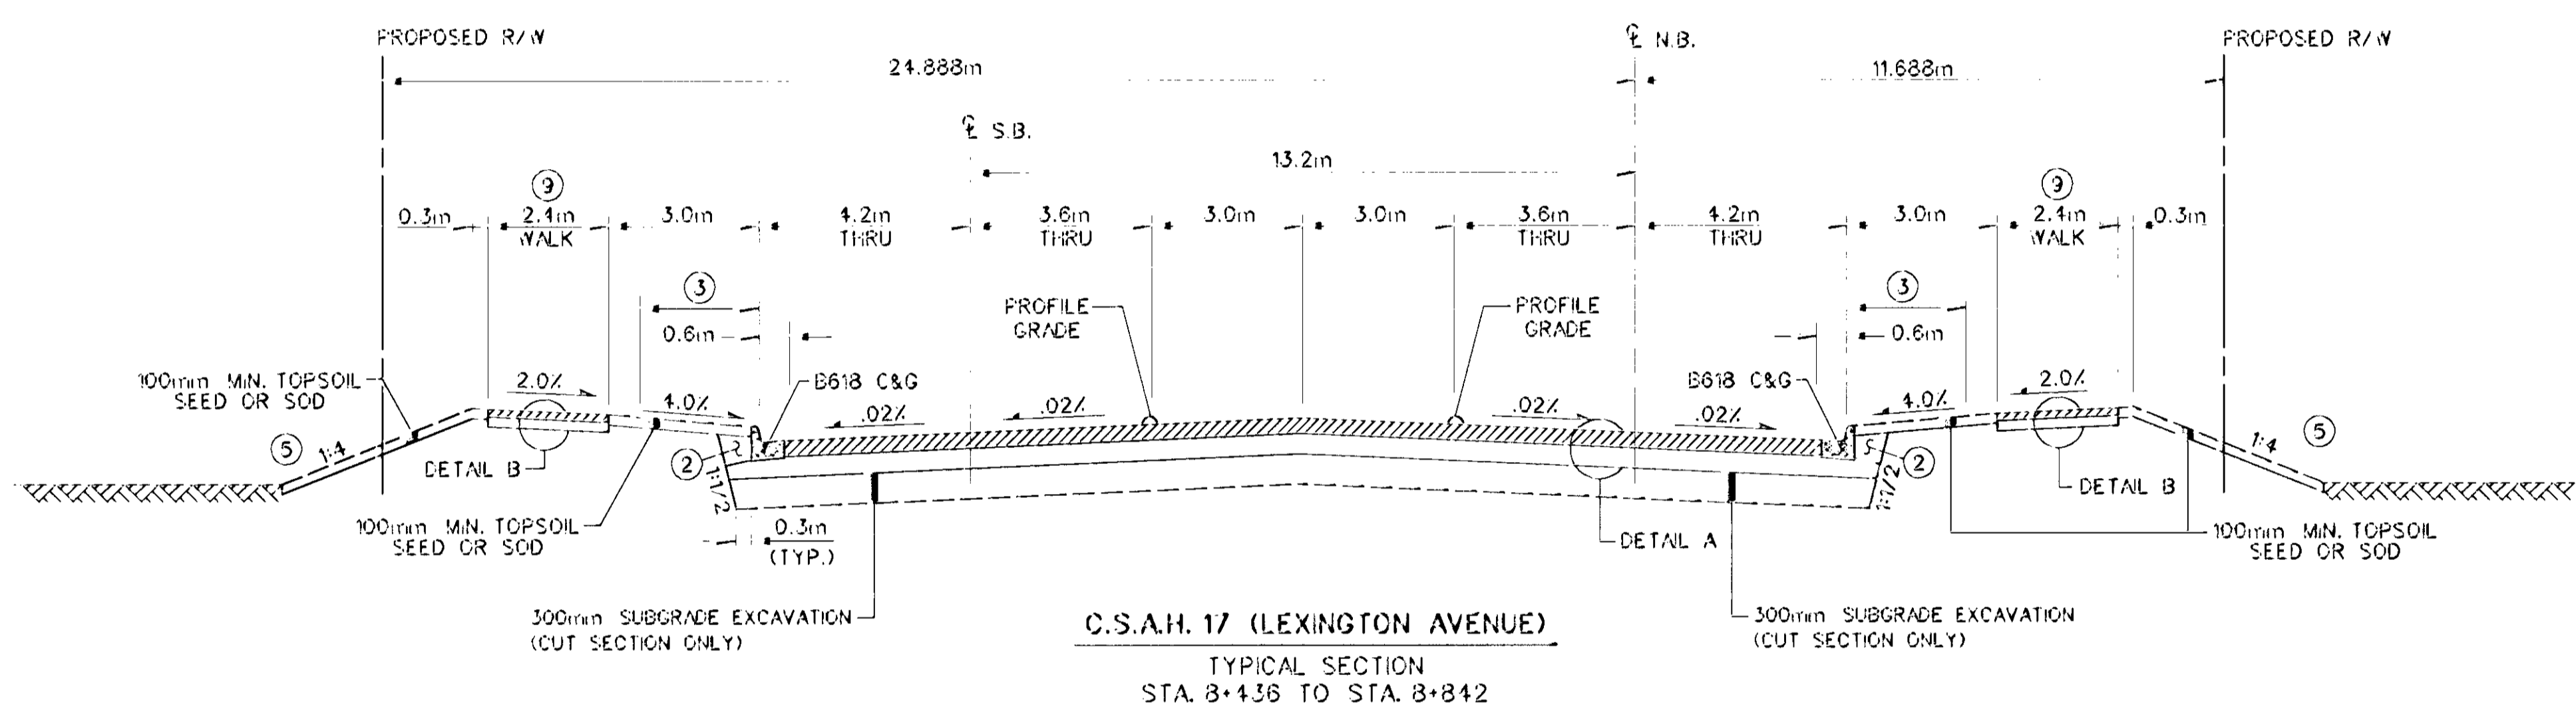


C.S.A.H. 17 (LEXINGTON AVENUE)
TYPICAL SECTION
STA. 8+436 TO STA. 8+842

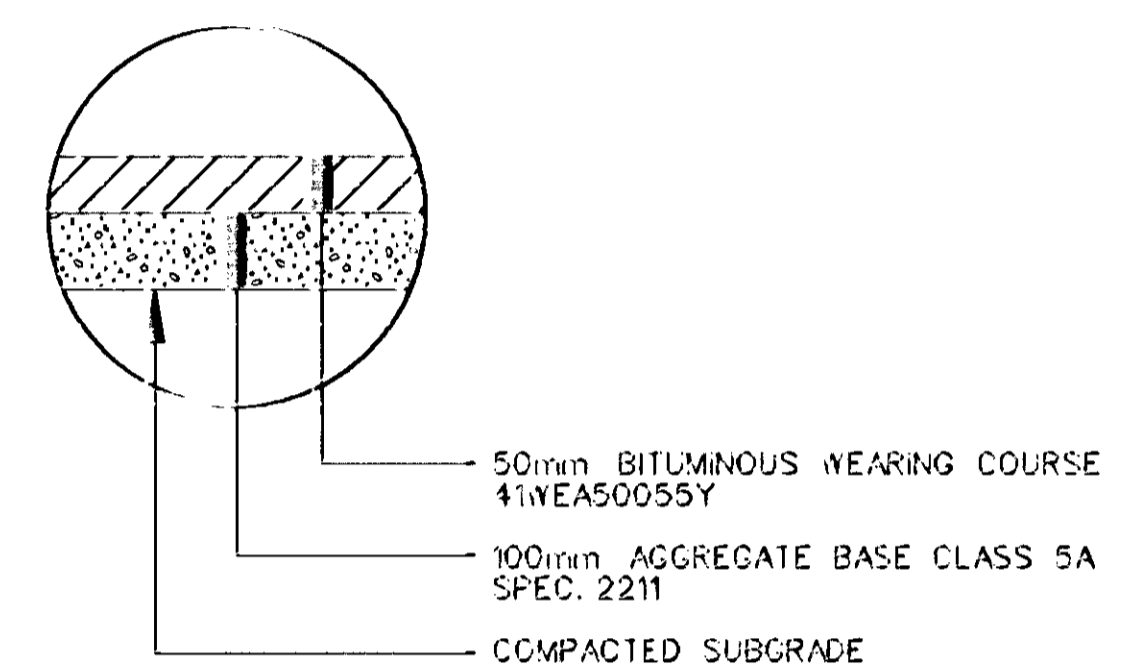

DETAIL B

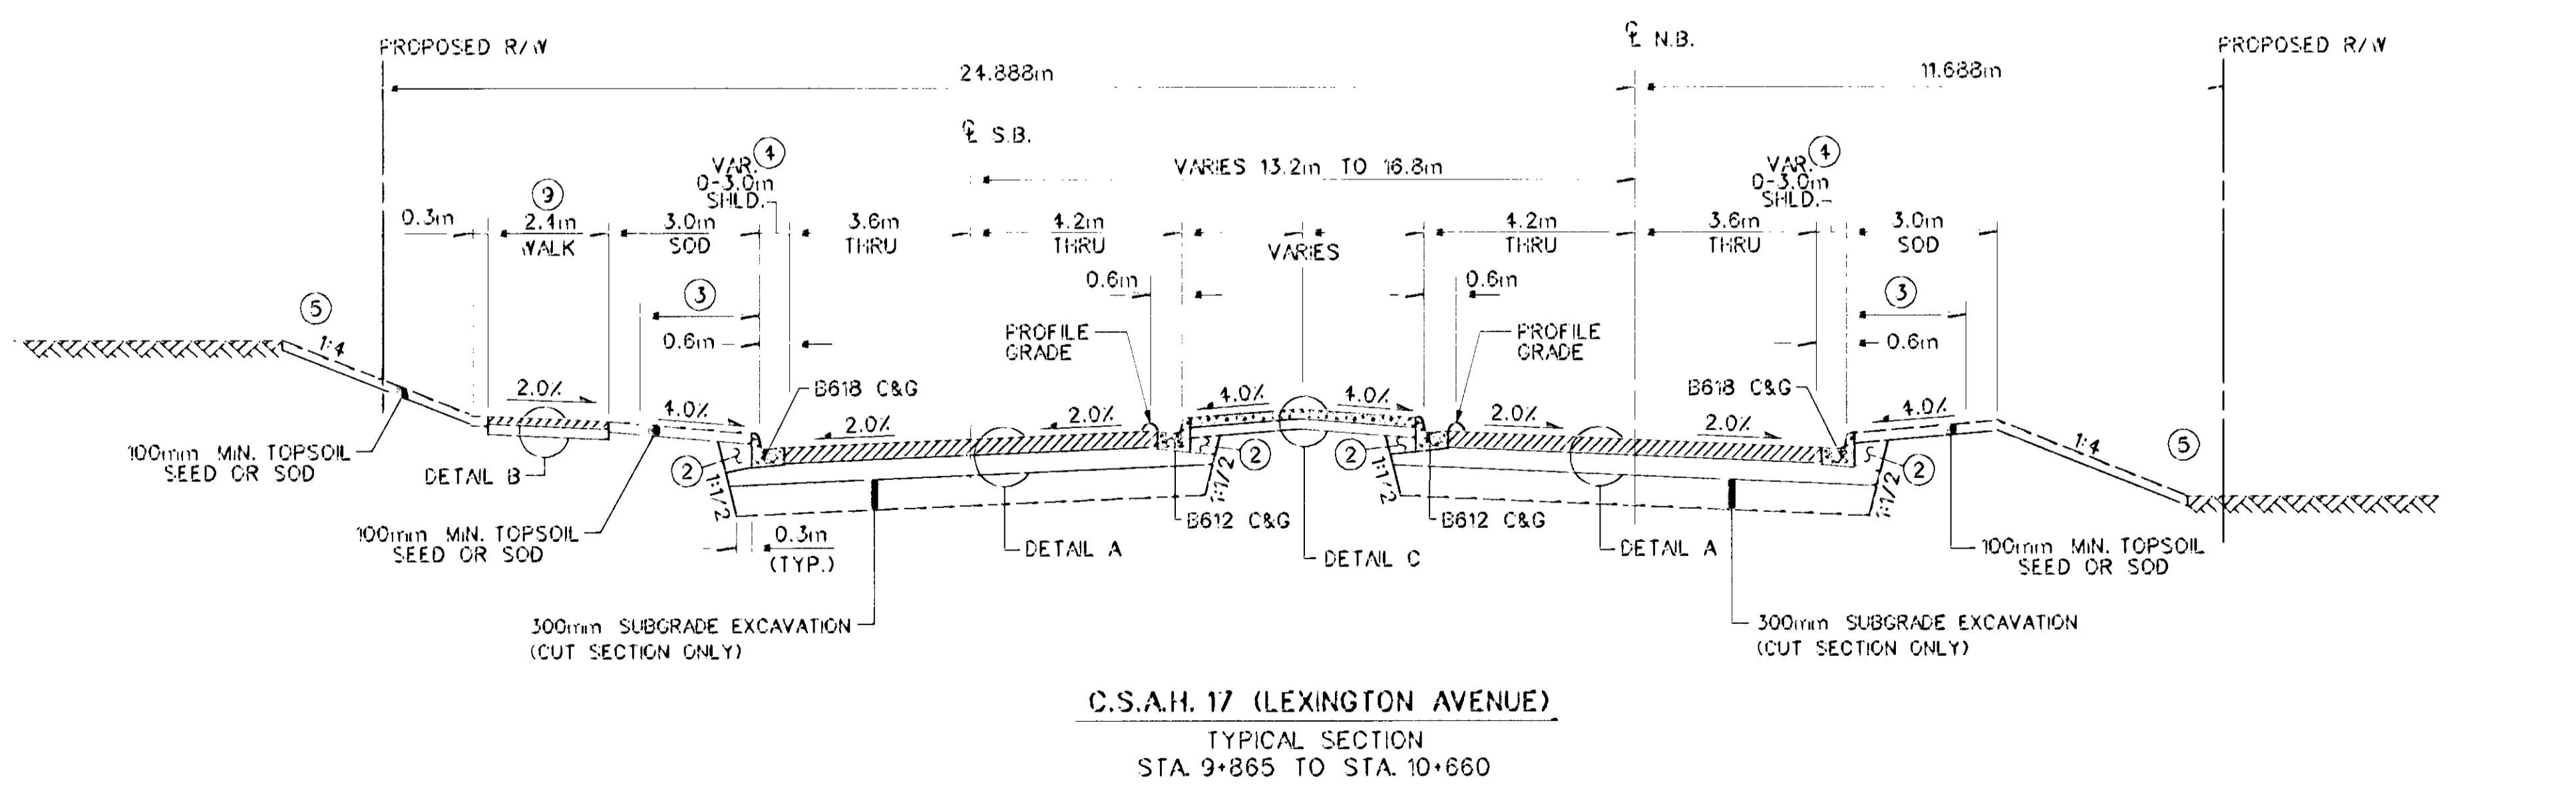

C.S.A.H. 17 (LEXINGTON AVENUE)
TYPICAL SECTION
STA. 9+865 TO STA. 10+660

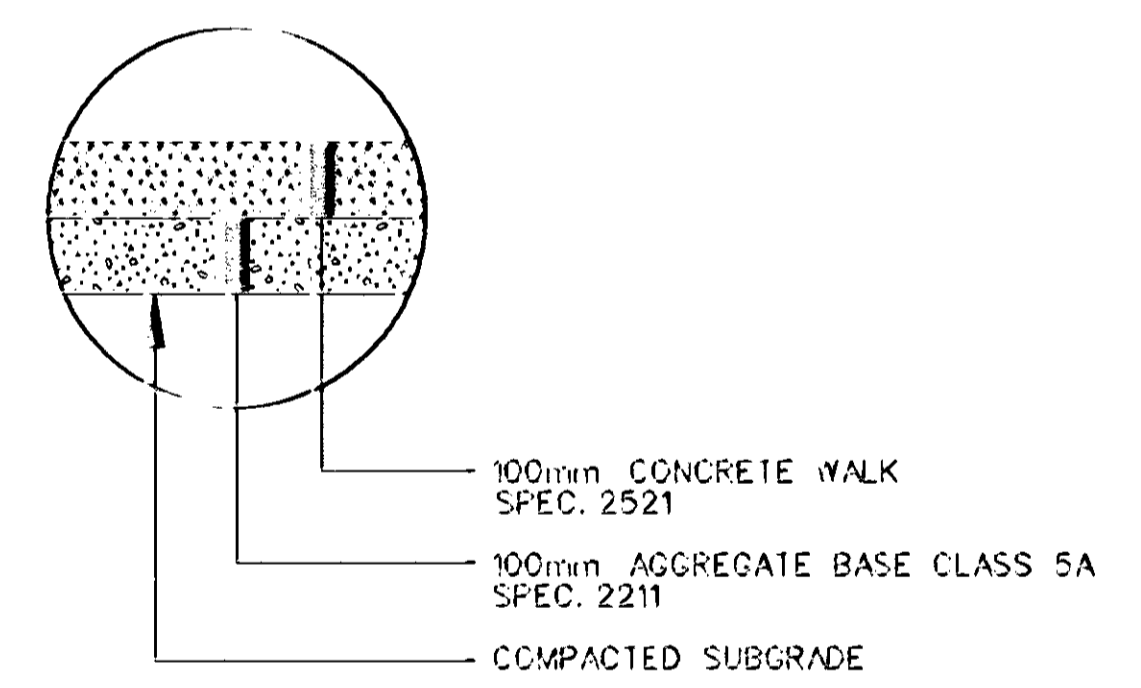

DETAIL C

- NOTES:
- ① STATION 8+358 TO STATION 9+624.
 - ② BACKFILL WITH SUITABLE GRADING MATERIAL.
 - ③ 0.5m OBSTACLE FREE CLEAR ZONE FROM FACE OF CURB
 - ④ 3.0m SHLD. FROM STA. 10+230 TO STA. 10+430 (NB CSAH 17)
 - ⑤ SEE CROSS SECTIONS FOR LOCATIONS OF VARIABLE SLOPES.
 - ⑥ SEE CONSTRUCTION PLANS FOR WALK LOCATION.

NO	DATE	BY	CHKD	APPR	REVISION

NAME: TS1 410.PLN DATE: Mar. 20, 1997

I hereby certify that this plan, specification or report was prepared by me or under my direct supervision and that I am a duly Registered Professional Engineer under the laws of the State of Minnesota.

Donald A. Demers
Date: 3-21-97 Reg. No. 23397


STATE AID PROJECT NO.
S.A.P. 02-617-11
S.A.P. 108-020-12
S.A.P. 106-030-03
CO. PROJECT NO.

DRAWN BY DATE
L. VANDRASEK 11-96
DESIGNED BY
B. URBANEK 11-96
CHECKED BY
D. DEMERS 12-96
COMM. NO.
0962410

SRI CONSULTING GROUP, INC.


ANOKA COUNTY
TYPICAL SECTIONS
C.S.A.H. 17 RECONSTRUCTION

SHEET
18
OF
236

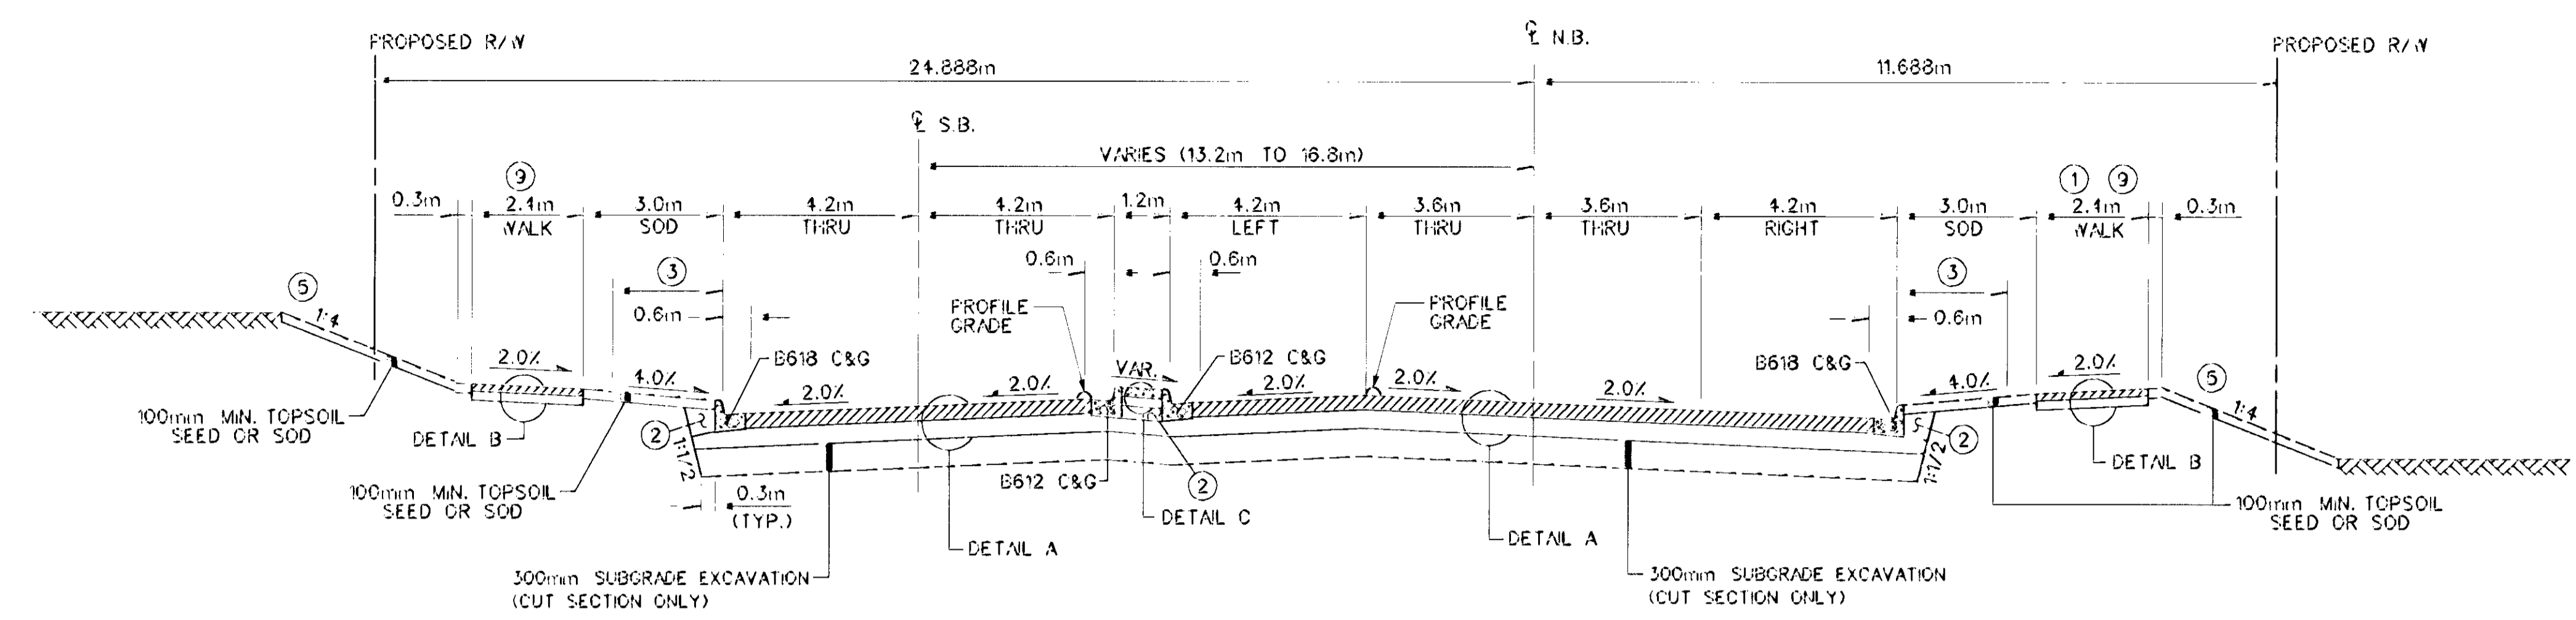


C.S.A.H. 17 (LEXINGTON AVENUE)
TYPICAL SECTION WITH TURN LANES


NOTE: FOR DOUBLE LEFT TURN LANE, THE TURN LANE ADJACENT TO THE THRU LANE SHALL SLOPE TO THE RIGHT.

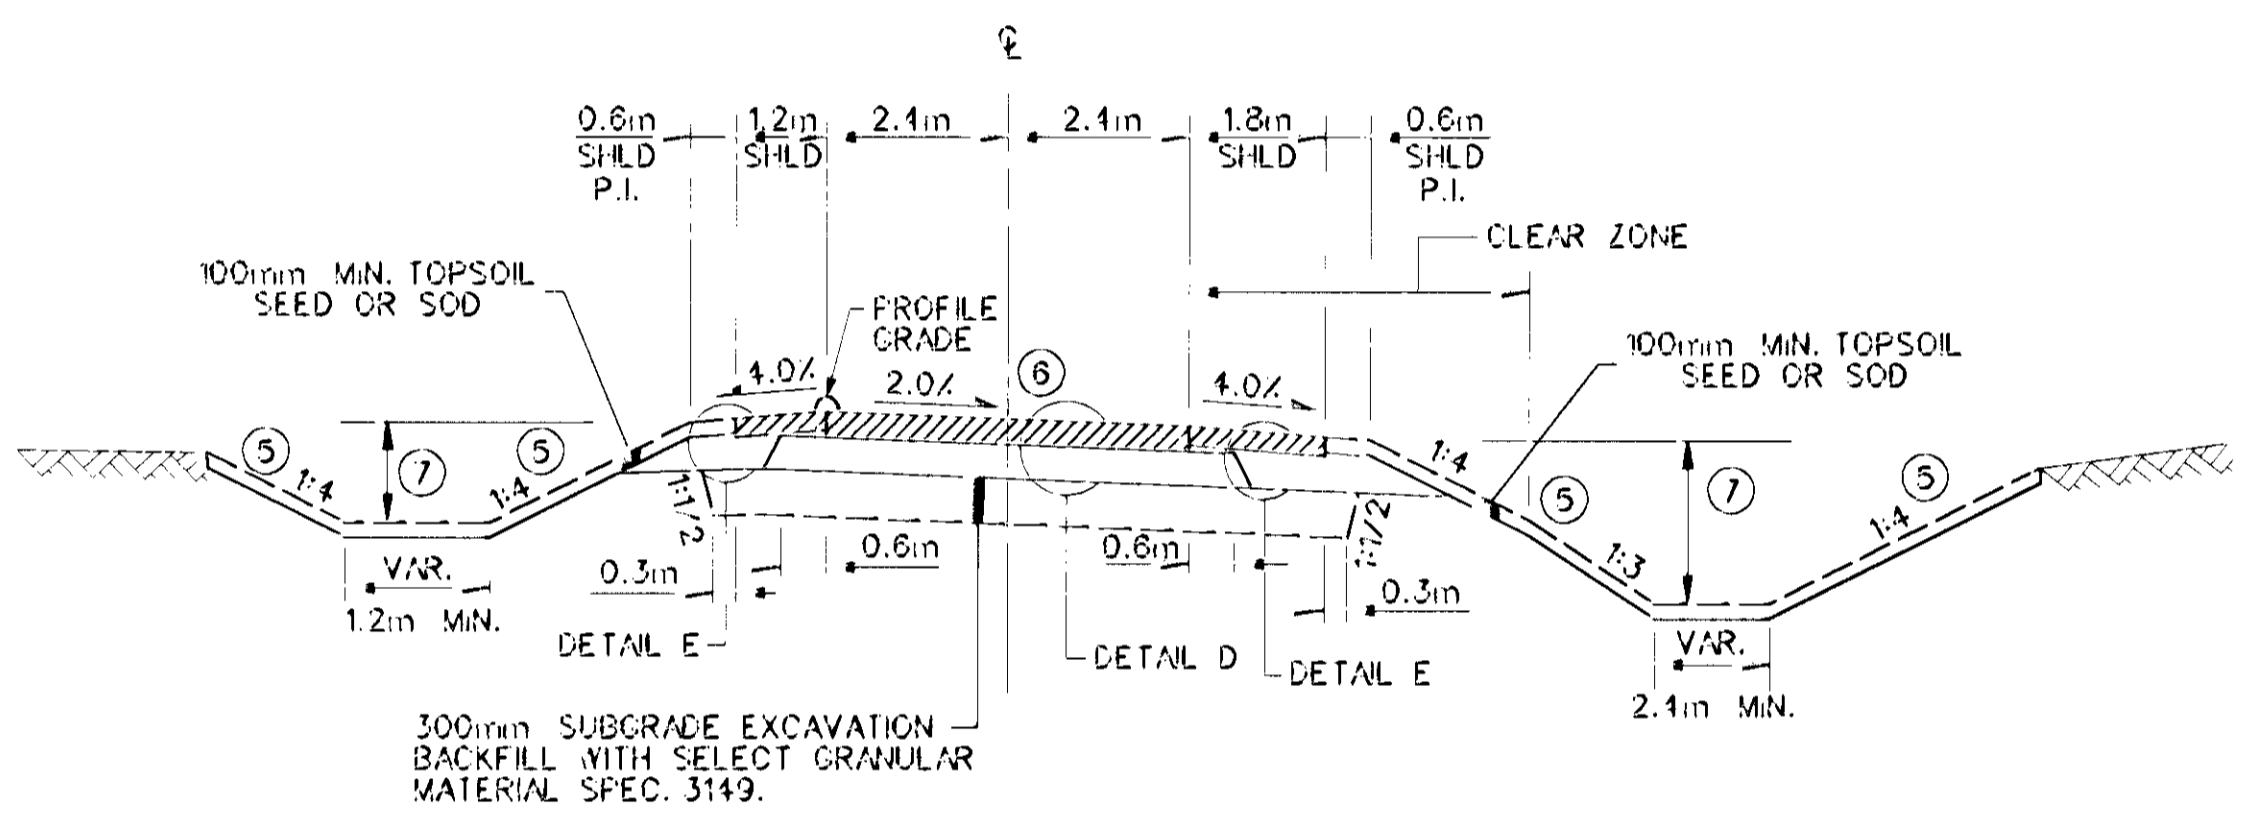


S.E. RAMP AND N.W. RAMP
TYPICAL SECTION

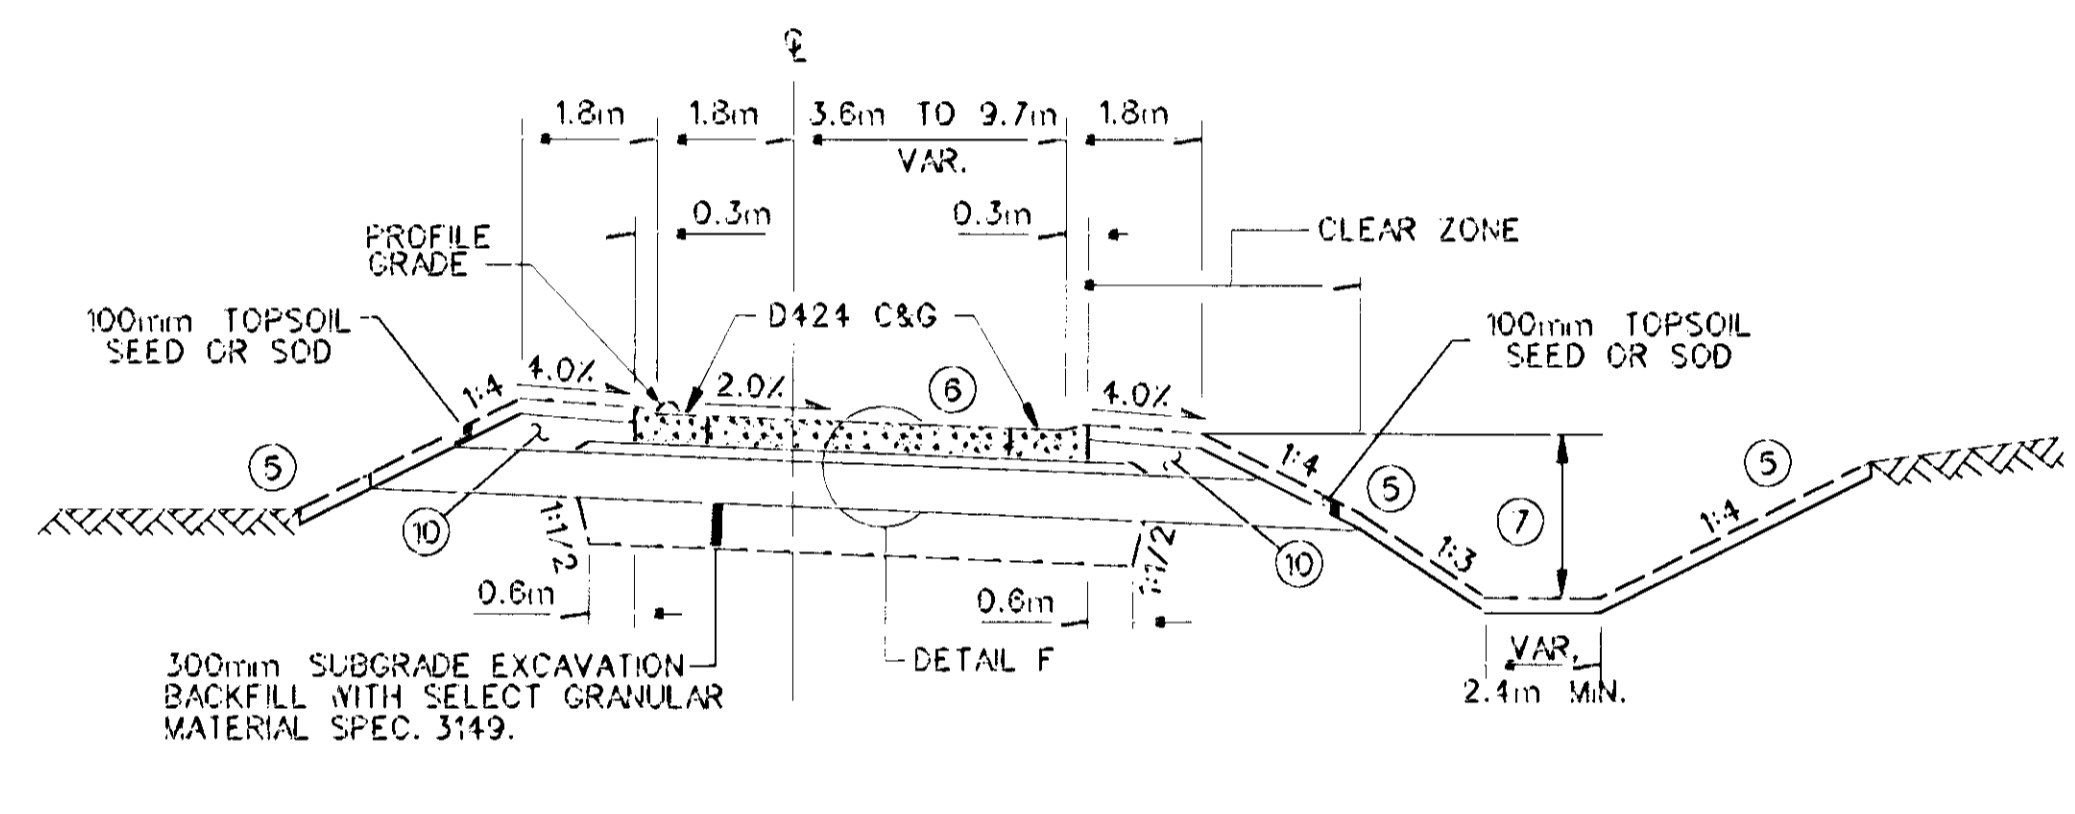


S.W. RAMP AND N.E. RAMP
TYPICAL SECTION

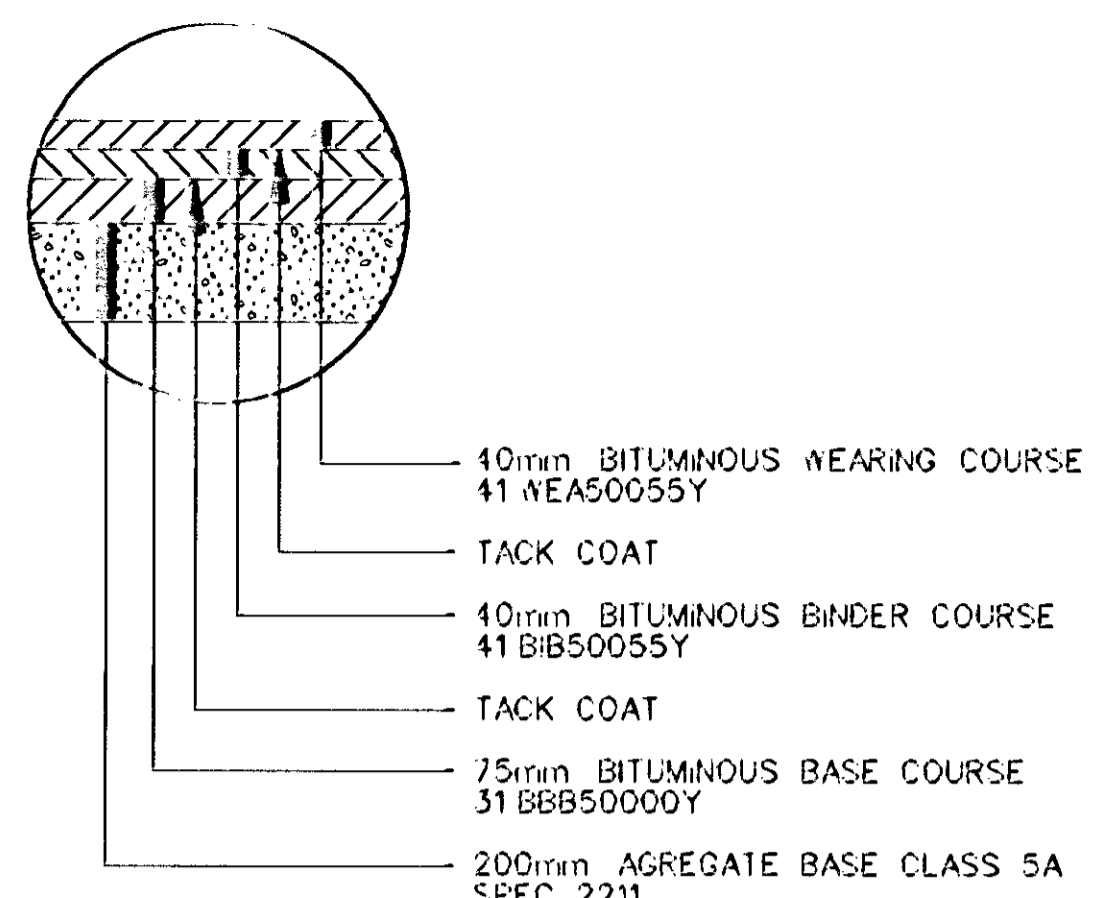


DETAIL A

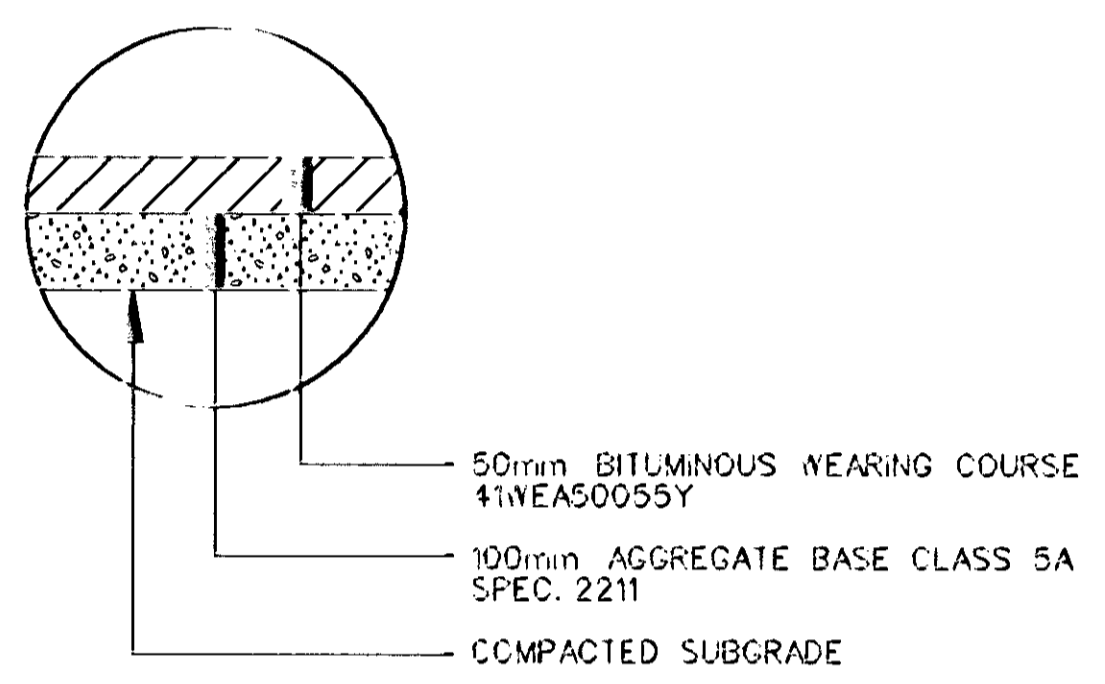


DETAIL B

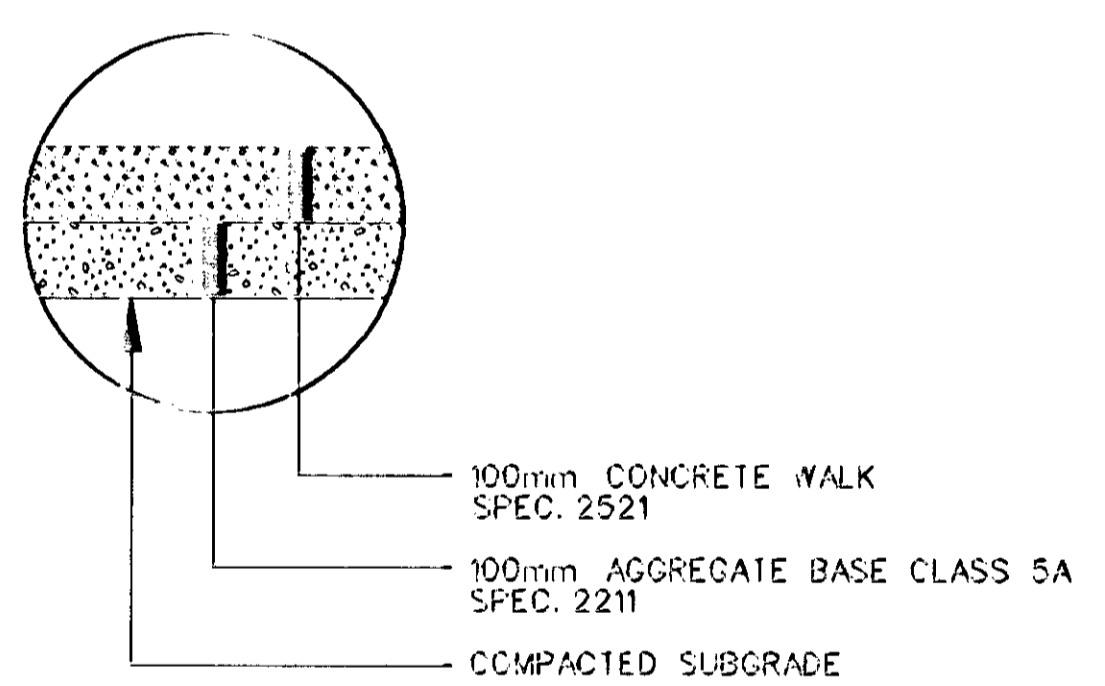


DETAIL C

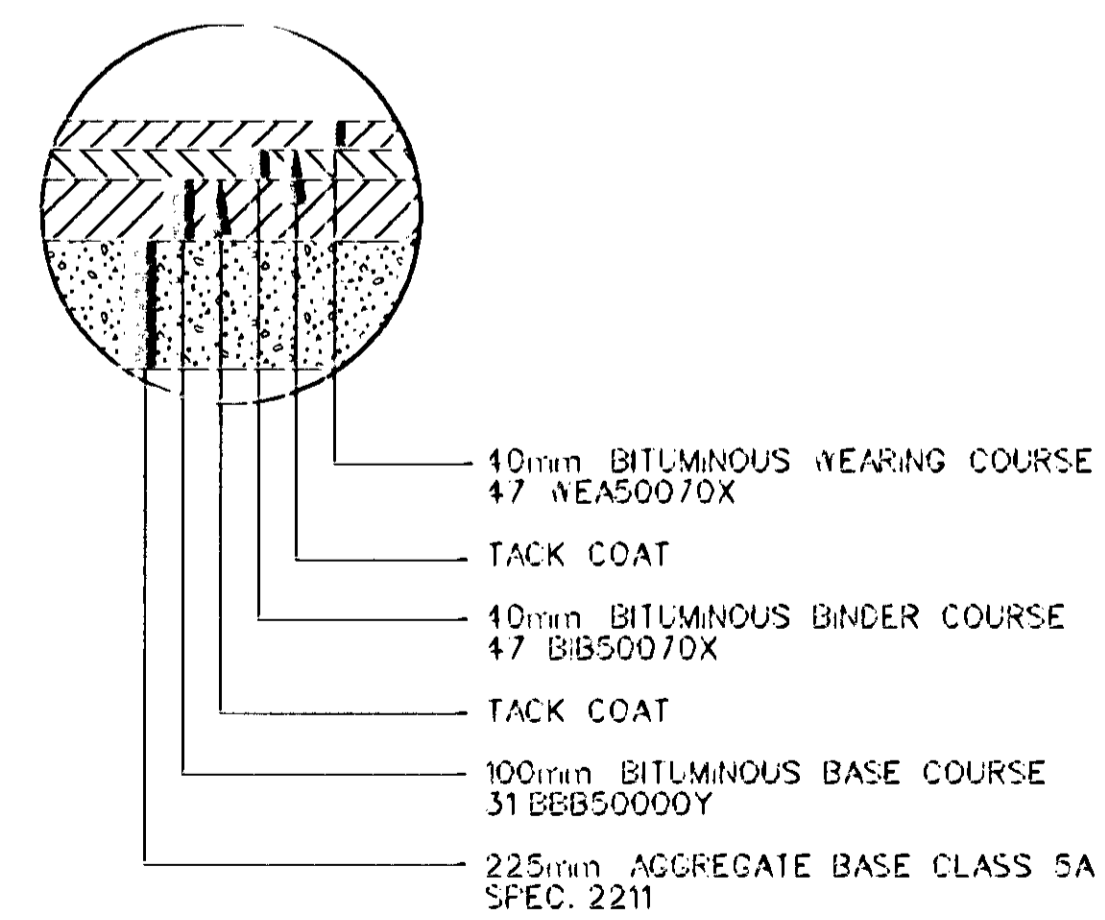

DETAIL D

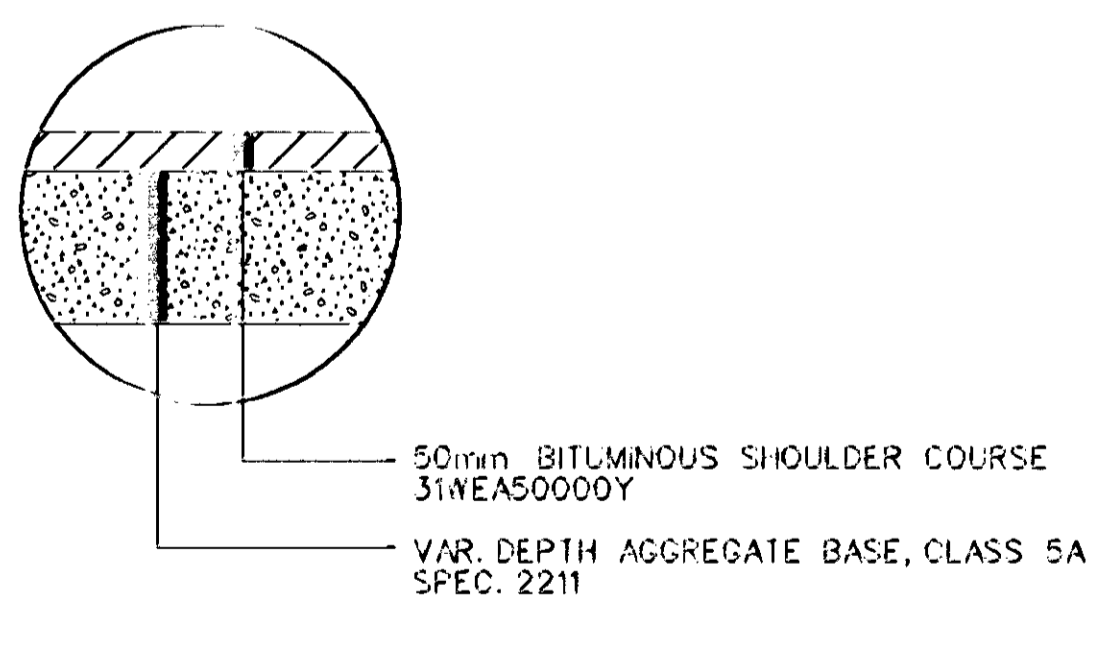

DETAIL E

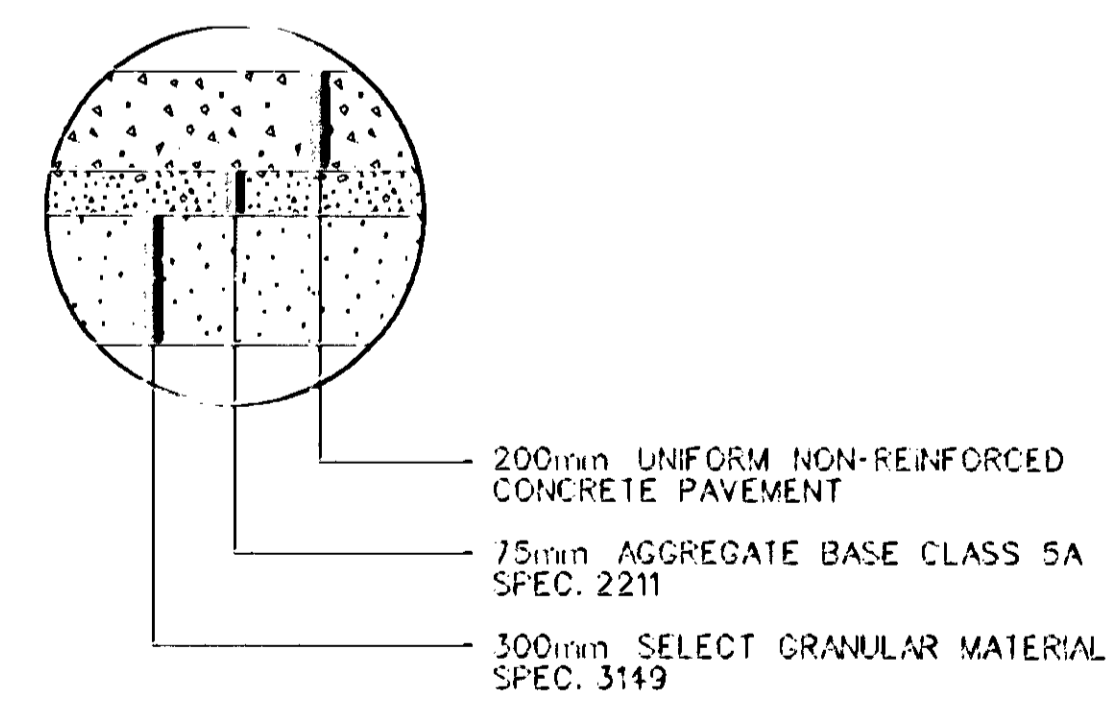

DETAIL F

- NOTES:
- ① STATION 8+358 TO STATION 9+624.
 - ② BACKFILL WITH SUITABLE GRADING MATERIAL.
 - ③ 0.5m OBSTACLE FREE CLEAR ZONE FROM FACE OF CURB
 - ④ 3.0m SHLD. FROM STA. 10+230 TO STA. 10+430 (N.B. C.S.A.H. 17)
 - ⑤ SEE CROSS SECTIONS FOR LOCATIONS OF VARIABLE SLOPES.
 - ⑥ SEE CONSTRUCTION PLANS FOR SUPER ELEVATION TRANSITIONS.
 - ⑦ SEE PROFILES FOR SPECIAL DITCH GRADES.
 - ⑧ SEE CONSTRUCTION PLANS FOR WALK LOCATION.
 - ⑩ BACKFILL WITH AGGREGATE BASE CLASS 5A SPEC. 2211.

NO.	DATE	BY	CKD	APPR	REVISION

N:\ME\TS2 410.PLN DATE: Mar. 20, 1997

I hereby certify that this plan, specification or report was prepared by me or under my direct supervision and that I am a duly Registered Professional Engineer under the laws of the State of Minnesota.

Donald A. James
Date: 3-21-97 Reg. No. 23397



STATE AID PROJECT NO. S.A.P. 02-617-11 S.A.P. 106-020-12 S.A.P. 106-030-03
CO. PROJECT NO.

DRAWN BY DATE L. VANDRASEK 11-96
DESIGNED BY B. URBANEK 11-96
CHECKED BY D. DEMERS 12-96
COMM. NO. 0962410

SRE CONSULTING GROUP, INC.


ANOKA COUNTY
TYPICAL SECTIONS
C.S.A.H. 17 RECONSTRUCTION

SHEET 19 OF 236

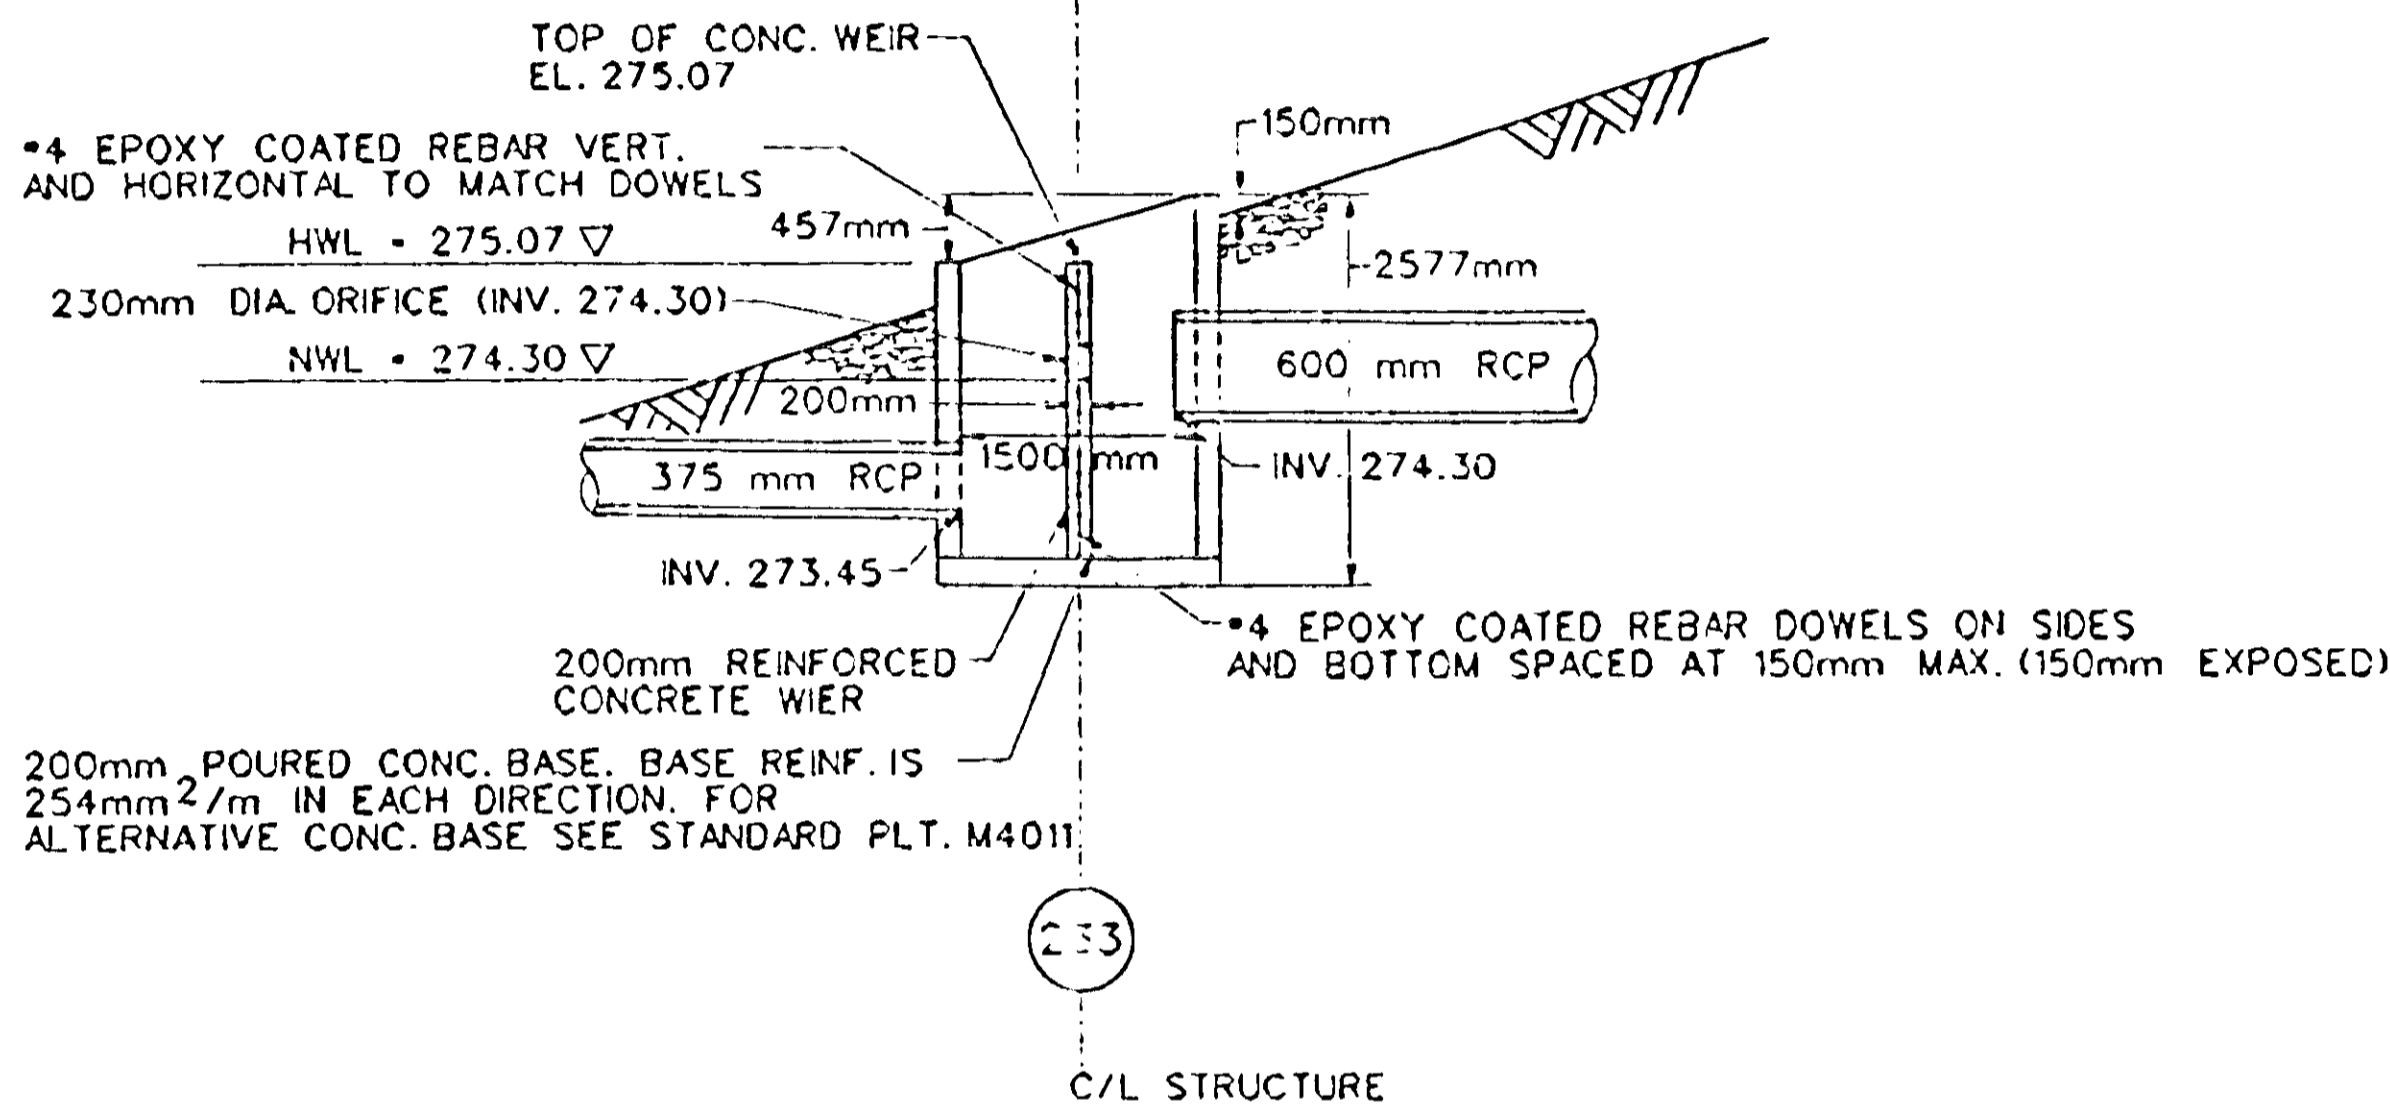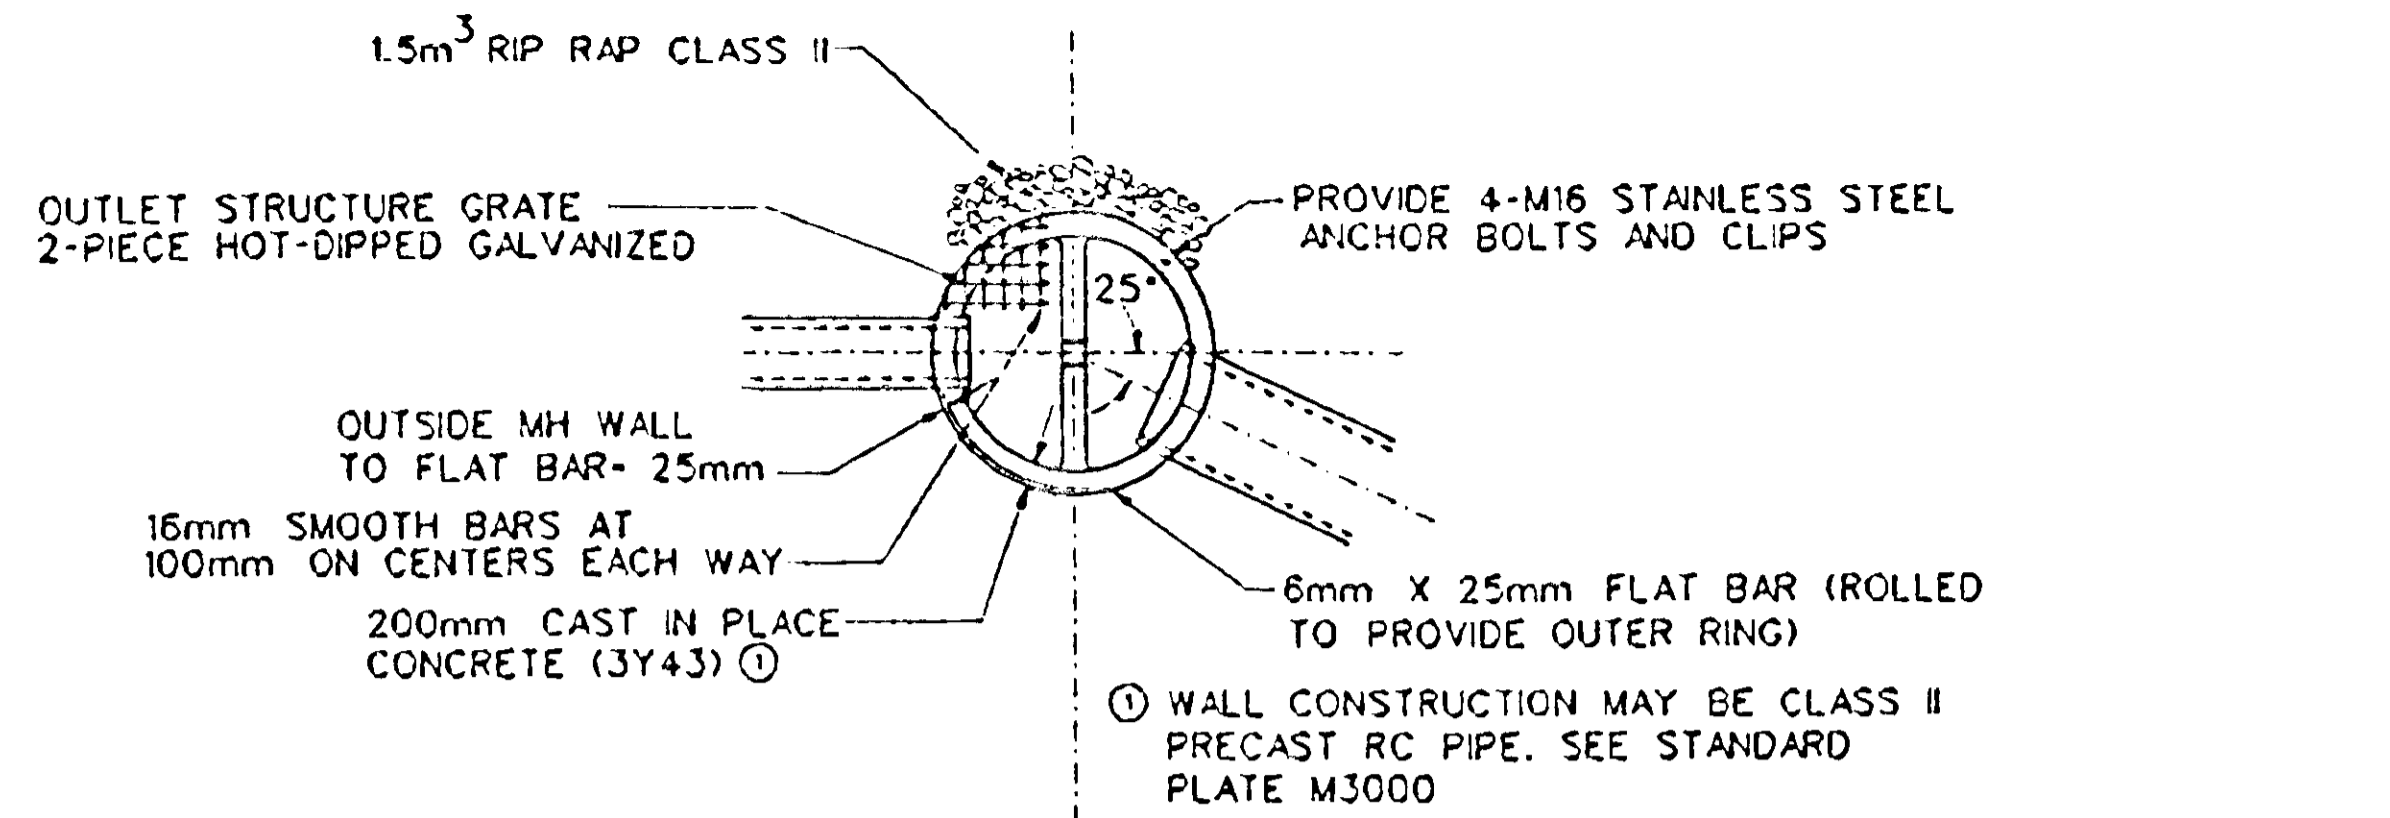


POND A OUTLET STRUCTURE
(DRAINAGE STRUCTURE DESIGN SPECIAL 1)

ALIGNMENT	STATION	OFFSET		EXPOSED HEIGHT (METER)
		LEFT (METER)	RIGHT (METER)	
WALL A				
NB CSAH 17	8+785.3		10.2	0.3
	8+785.9		10.2	0.4
	8+790.0		10.2	0.4
	8+796.5		10.2	0.8
	8+797.2		10.2	0.3
WALL B				
NB CSAH 17	8+959.3		10.2	0.3
	8+960.0		10.2	0.7
	8+978.4		10.2	0.8
	8+979.2		10.2	0.3
WALL C				
SB CSAH 17	9+605.5		7.7	0.3
	9+606.0		7.7	0.5
	9+610.0		7.7	1.5
	9+611.5		7.7	0.3

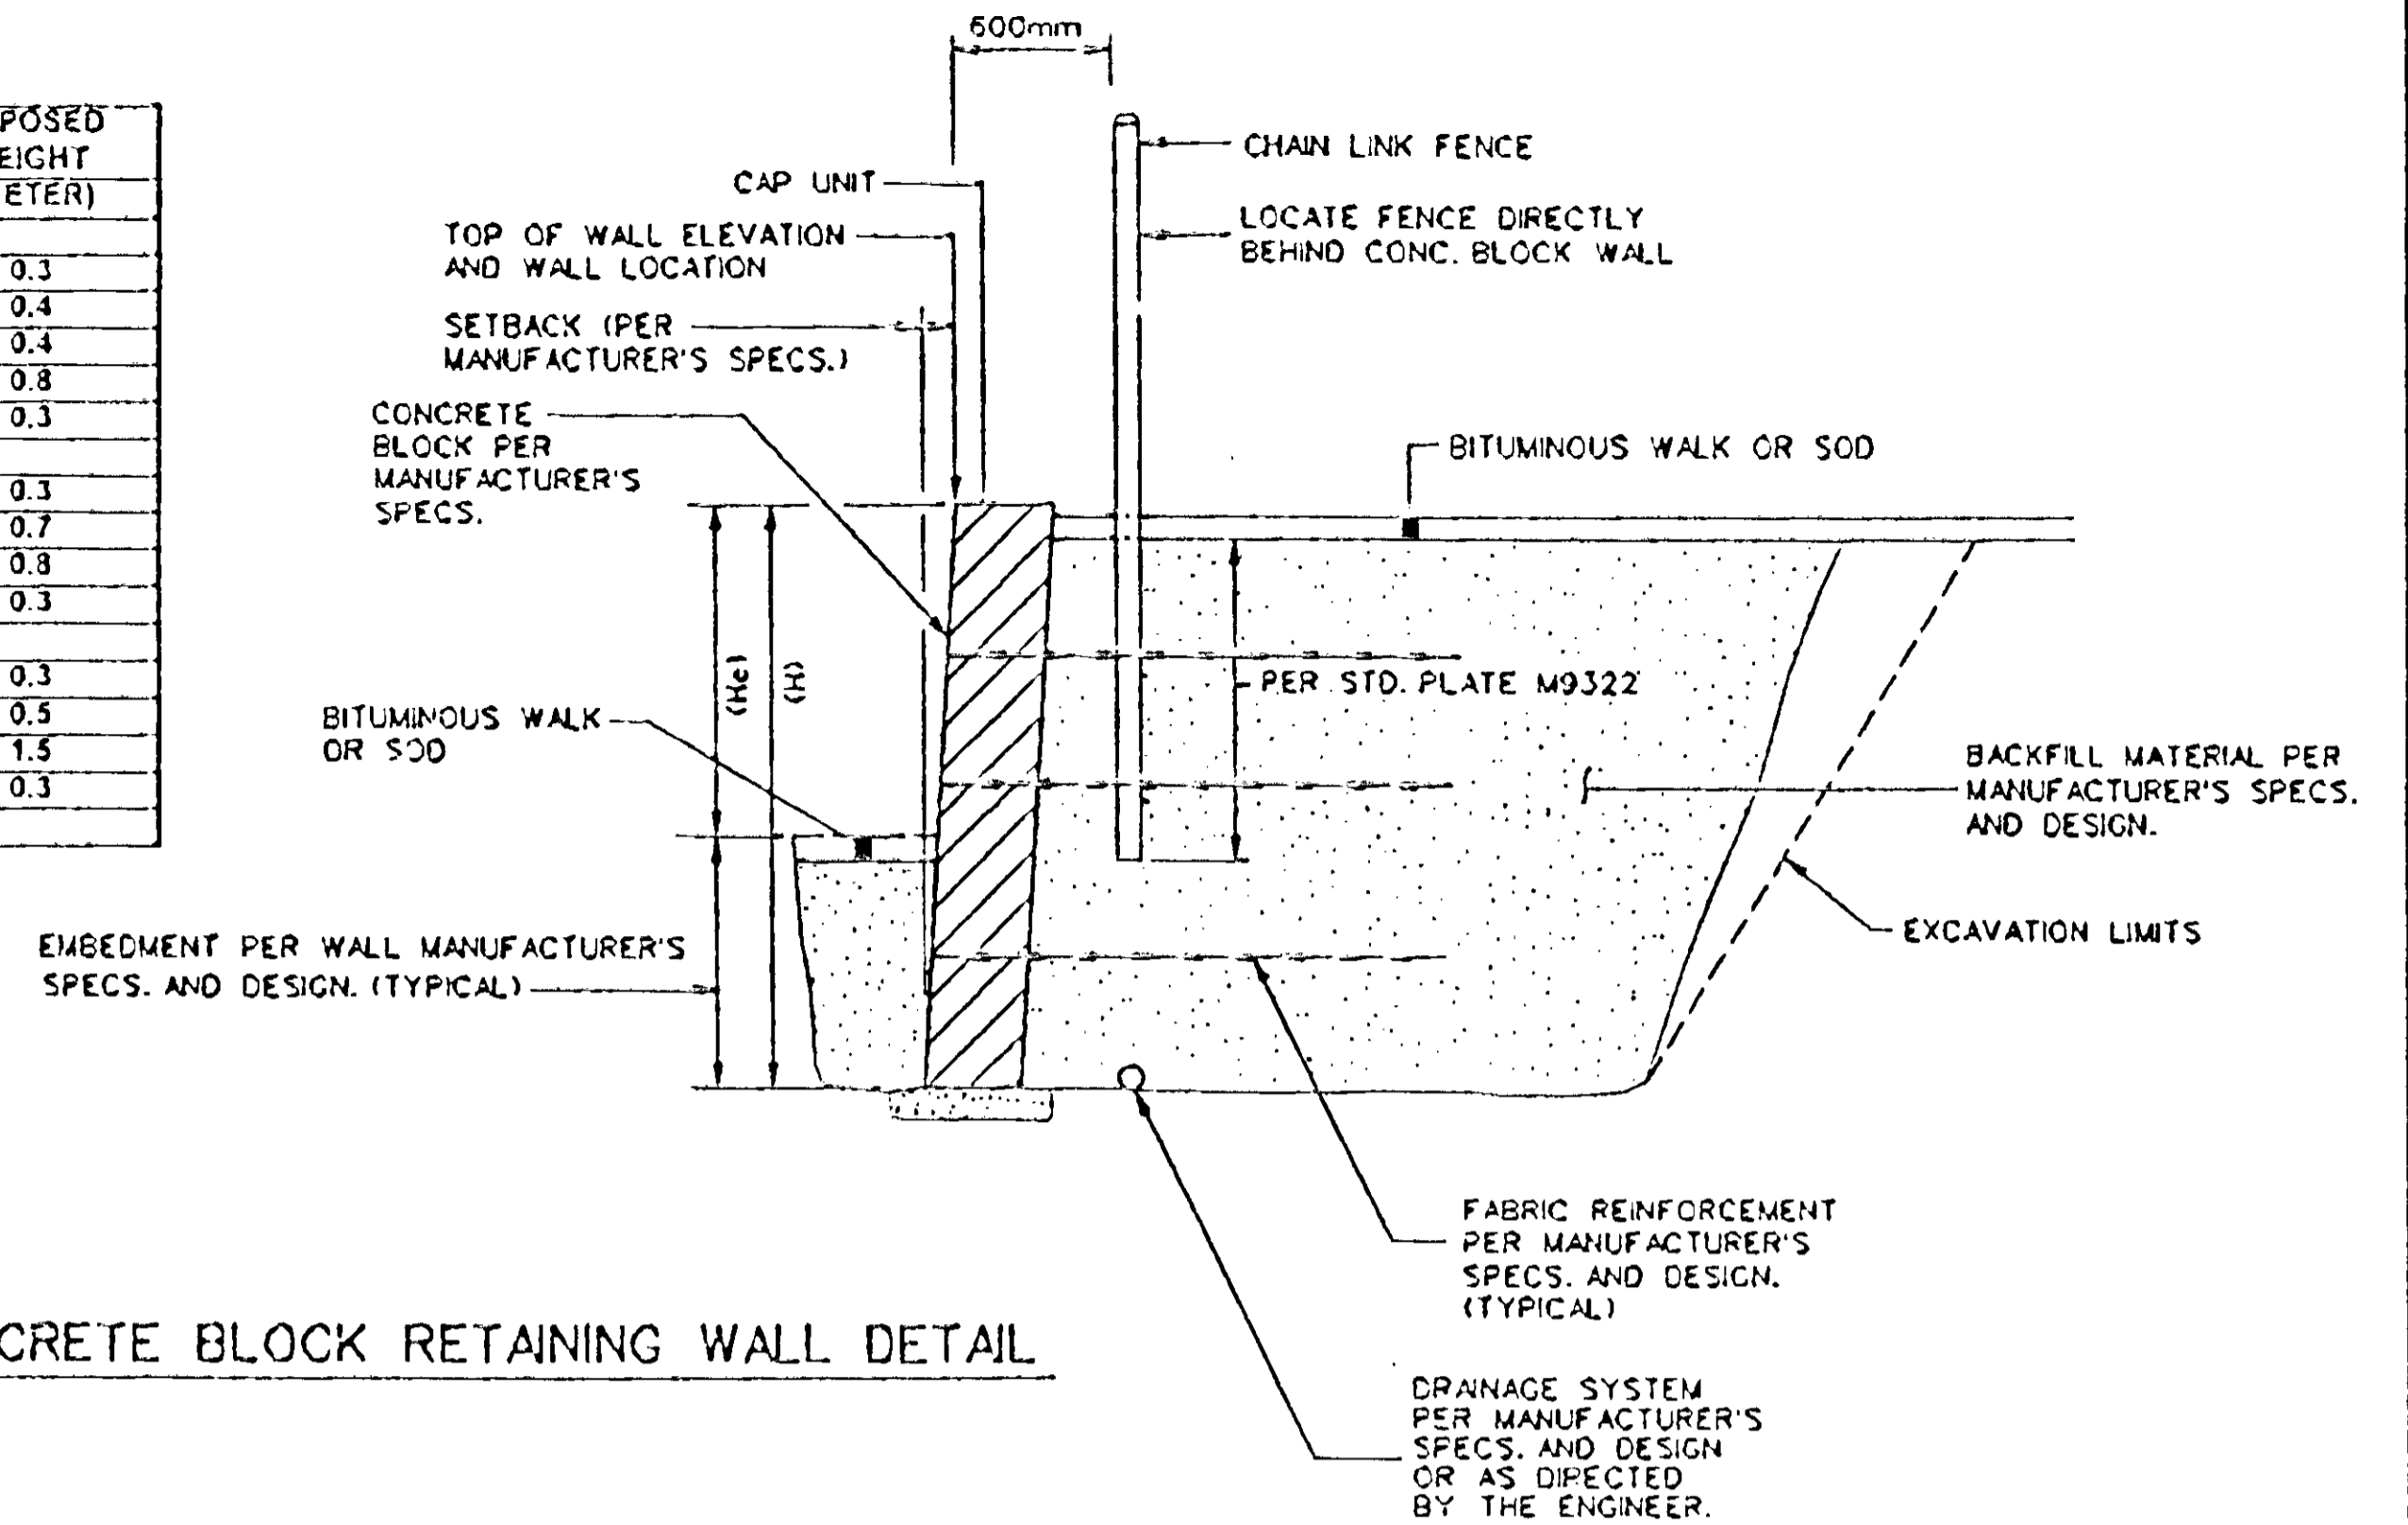

CONCRETE BLOCK RETAINING WALL DETAIL

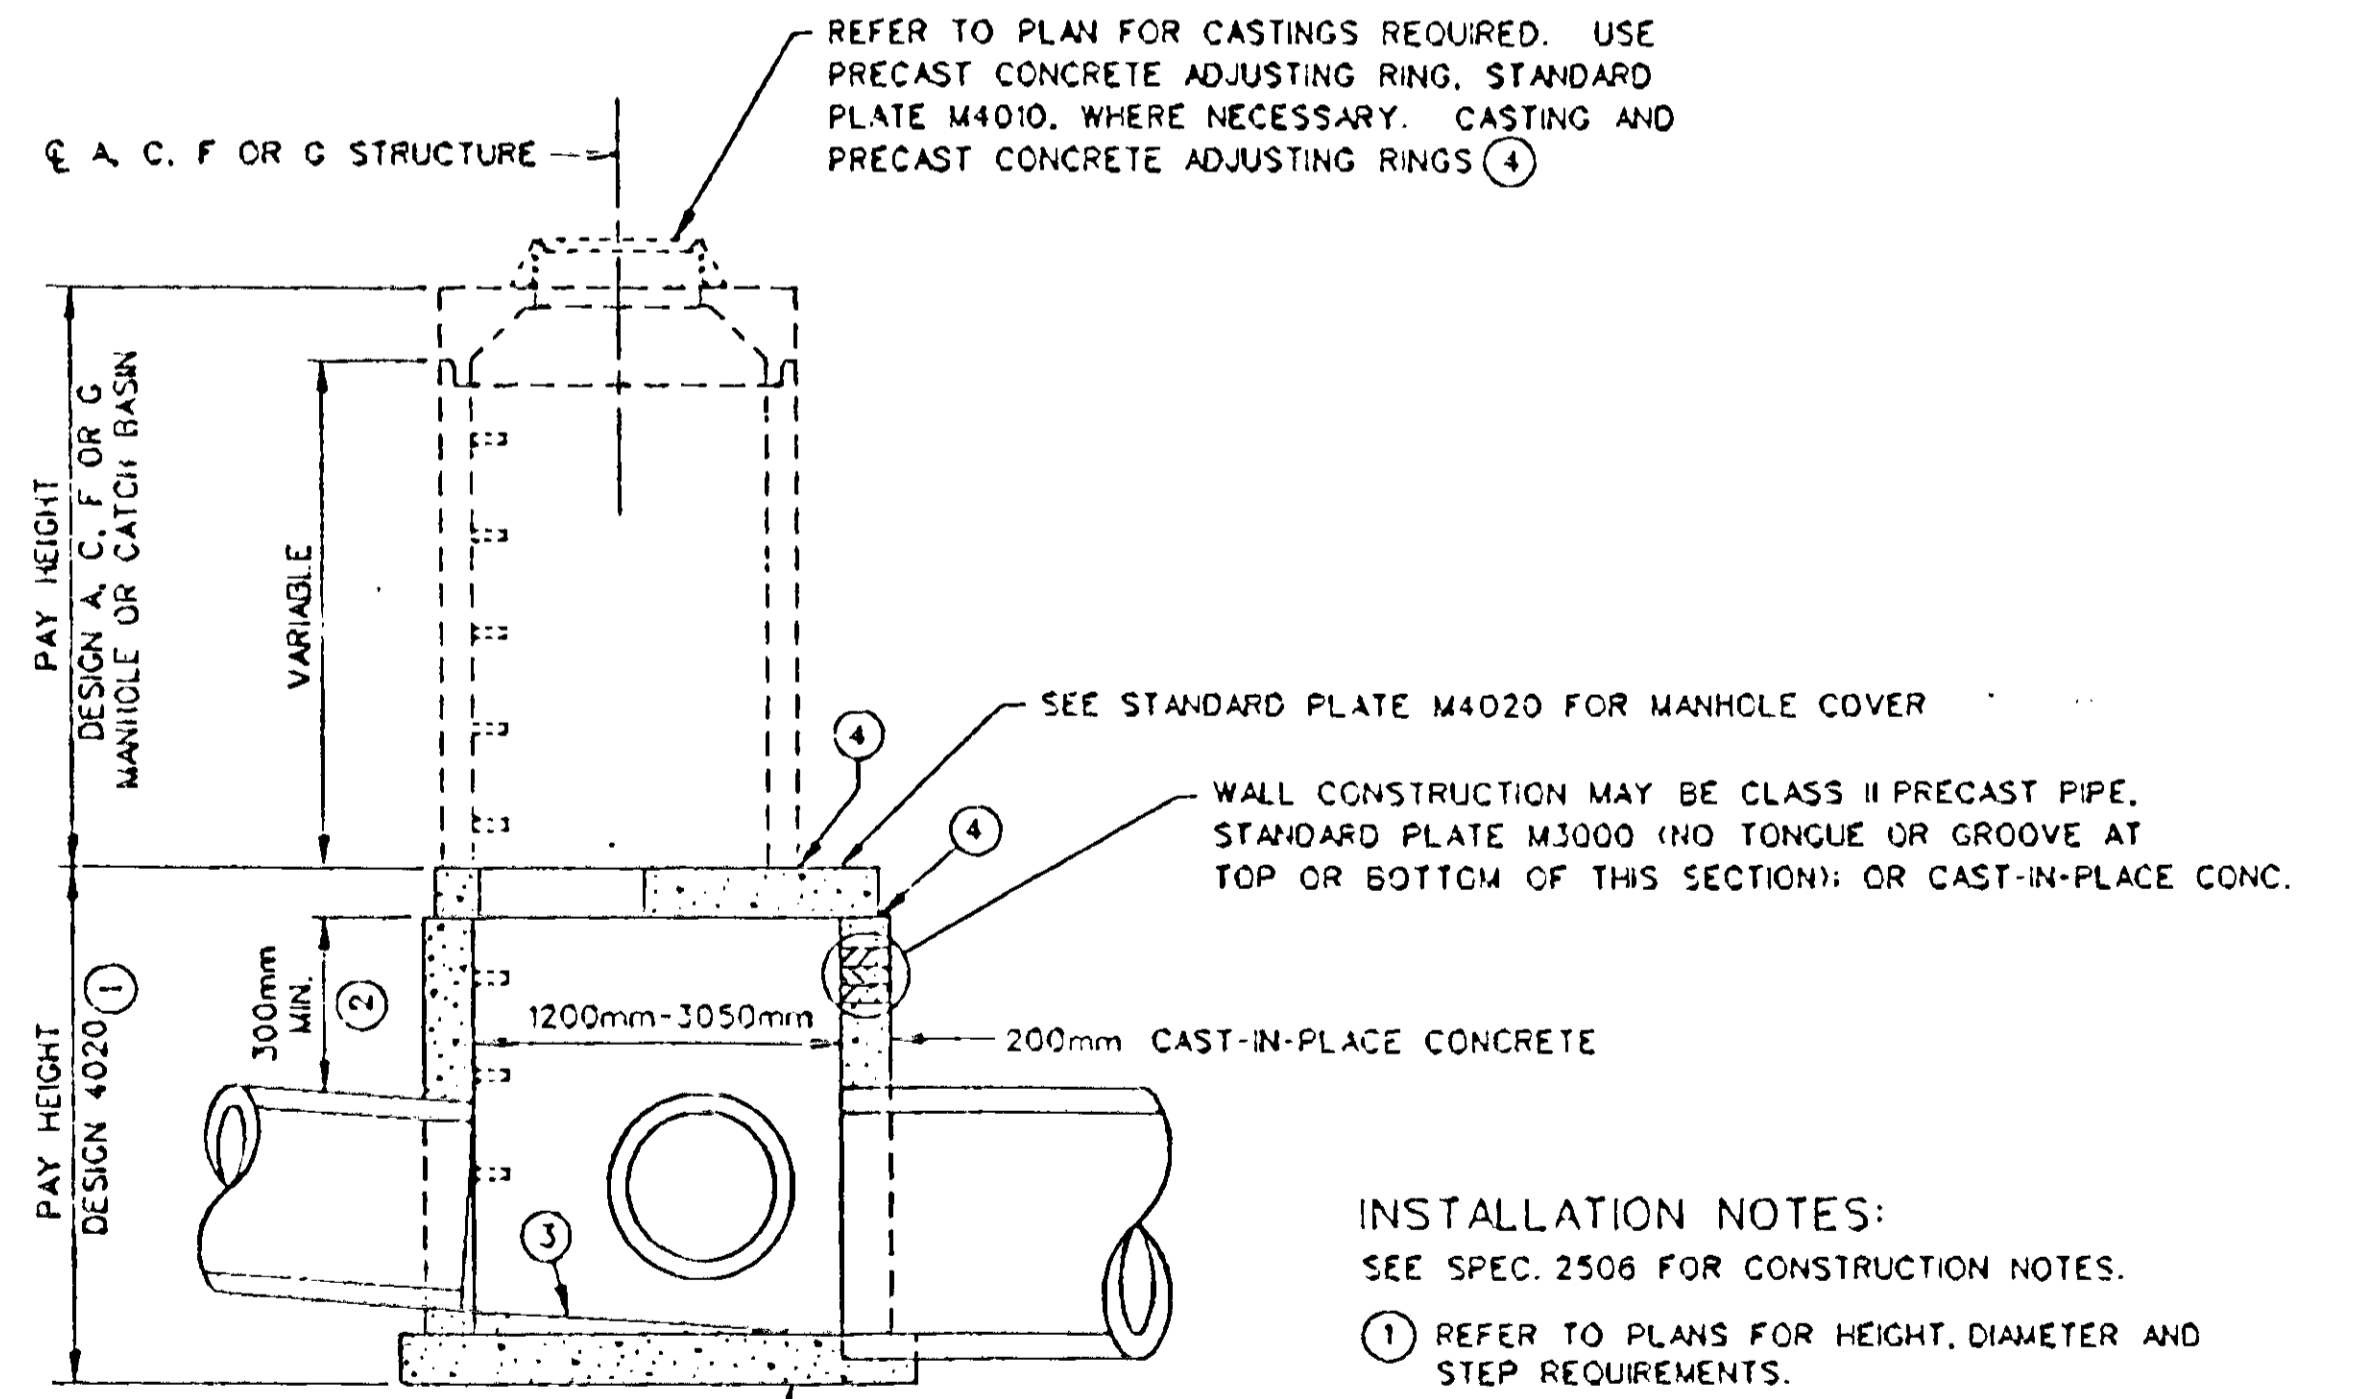

200mm POURED CONCRETE BASE. FOR ALTERNATE PRECAST CONCRETE BASE SEE STANDARD PLATE M4011 (MODIFY DIA. AND 50mm RAISED AREA TO FIT REQUIRED DIA.).

- INSTALLATION NOTES:**
SEE SPEC. 2506 FOR CONSTRUCTION NOTES.
- REFER TO PLANS FOR HEIGHT, DIAMETER AND STEP REQUIREMENTS.
 - 300mm MINIMUM FOR PRECAST.
 - PROVIDE MORTAR FILLETS TO FIT BOTTOM PORTIONS OF PIPE TO DIRECT FLOW TO OUTLET.
 - PROVIDE A FULL MORTAR BED.

DRAINAGE STRUCTURE TYPE 4020
INSTALLATION DETAILS

NO.	DATE	BY	CHKD	APPR	REVISION

NAME: DET 1 410 PLN DATE: Mar 17, 1997



I hereby certify that this plan, specification or report was prepared by me or under my direct supervision and that I am a duly Registered Professional Engineer under the laws of the State of Minnesota.

Donald A. Demers

Date 3-21-97 Reg. No. 23397

STATE AND PROJECT NO.
S.A.P. 02-617-11
S.A.P. 108-020-12
S.A.P. 108-030-03

CO. PROJECT NO.

DRAWN BY DATE
V. GRAF 12-96

DESIGNED BY
M. HANSEN 12-96

CHECKED BY
D. DEMERS 1-97

COMM. NO.
0262410




ANOKA COUNTY


DETAILS

C.S.A.H. 17 RECONSTRUCTION

SHEET 20 OF 236

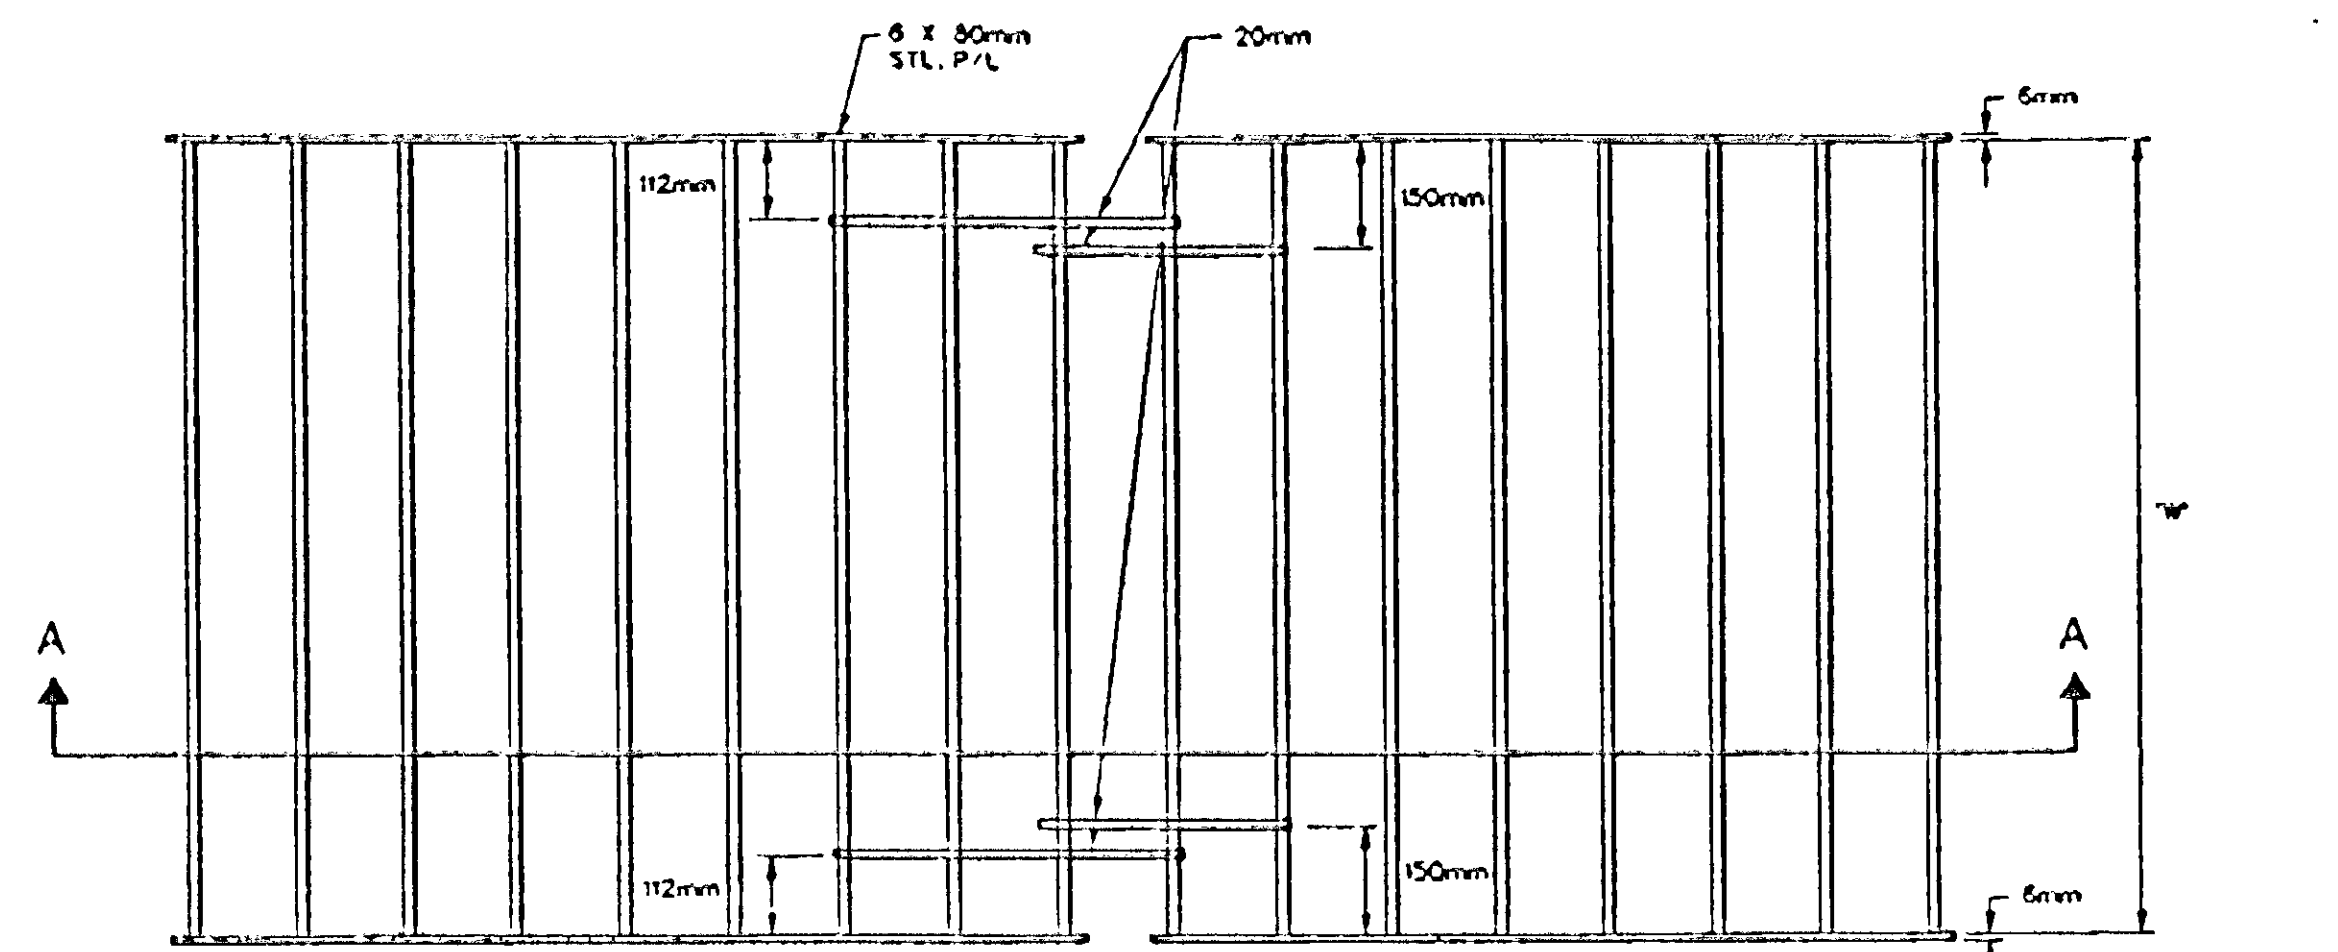


TOP VIEW

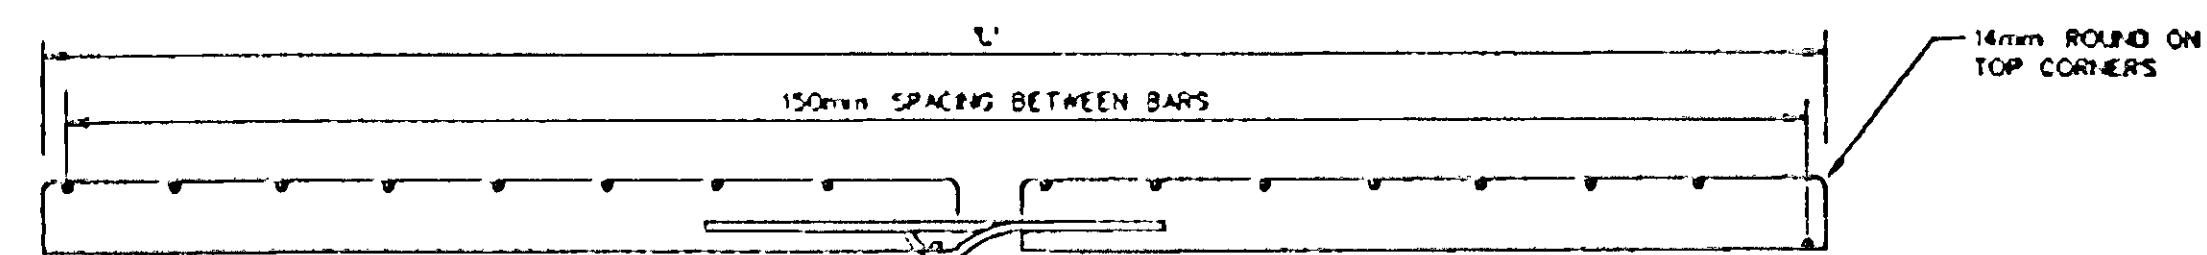


SECTION A-A

APRON SIZE	SLOPE	L' LENGTH OF GRATE	W' WIDTH OF GRATE	CROSS BAR DIA.	NO. PCS. GRATE
900mm	1:4	2075mm	1000mm	32mm	2

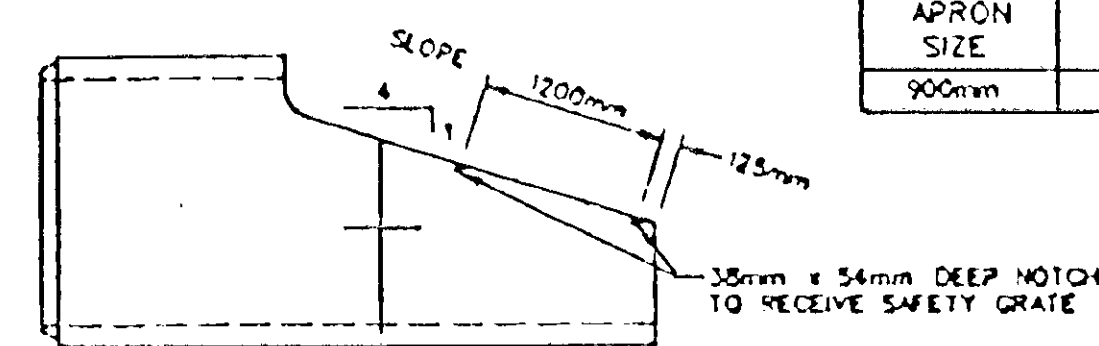

SAFETY GRATES FOR PRECAST CONCRETE END SECTION

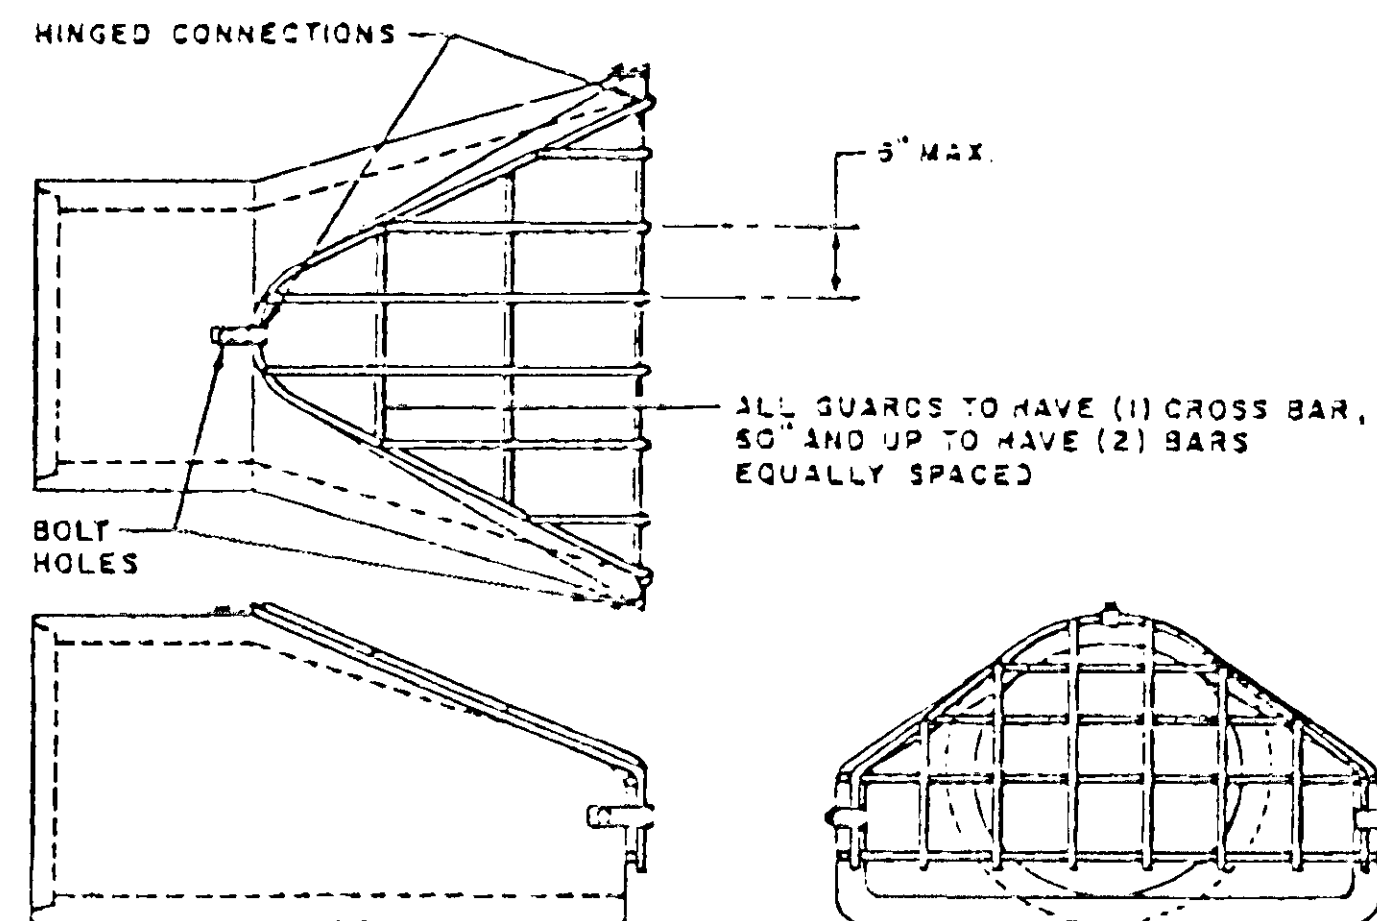


Hot dip galvanized per Mn/DOT 3392 or ASTM-A153.


TRASH GUARD FOR FLARED ENDS

BAR SIZES			
HEAVY DESIGN			
PIPE SIZE	HOLE DIA. SIZE	BOLT	BAR SIZE
300mm-450mm	18mm	M16	20mm
525mm-1200mm	24mm	M22	25mm


BOLT LG. - PIPE WALL THK = 64mm

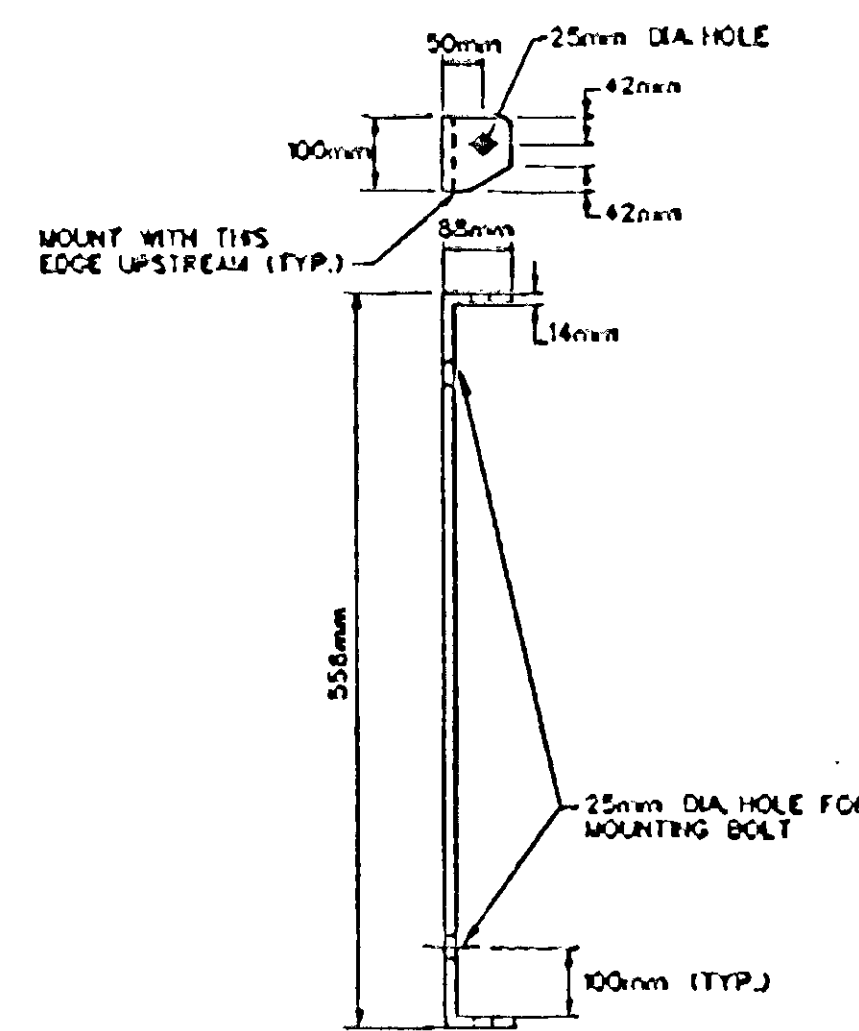


NOTE: TRASH GUARD AND MOUNTING BRACKETS TO BE GALVANIZED AFTER FABRICATION PER MN/DOT SPEC. 3392.

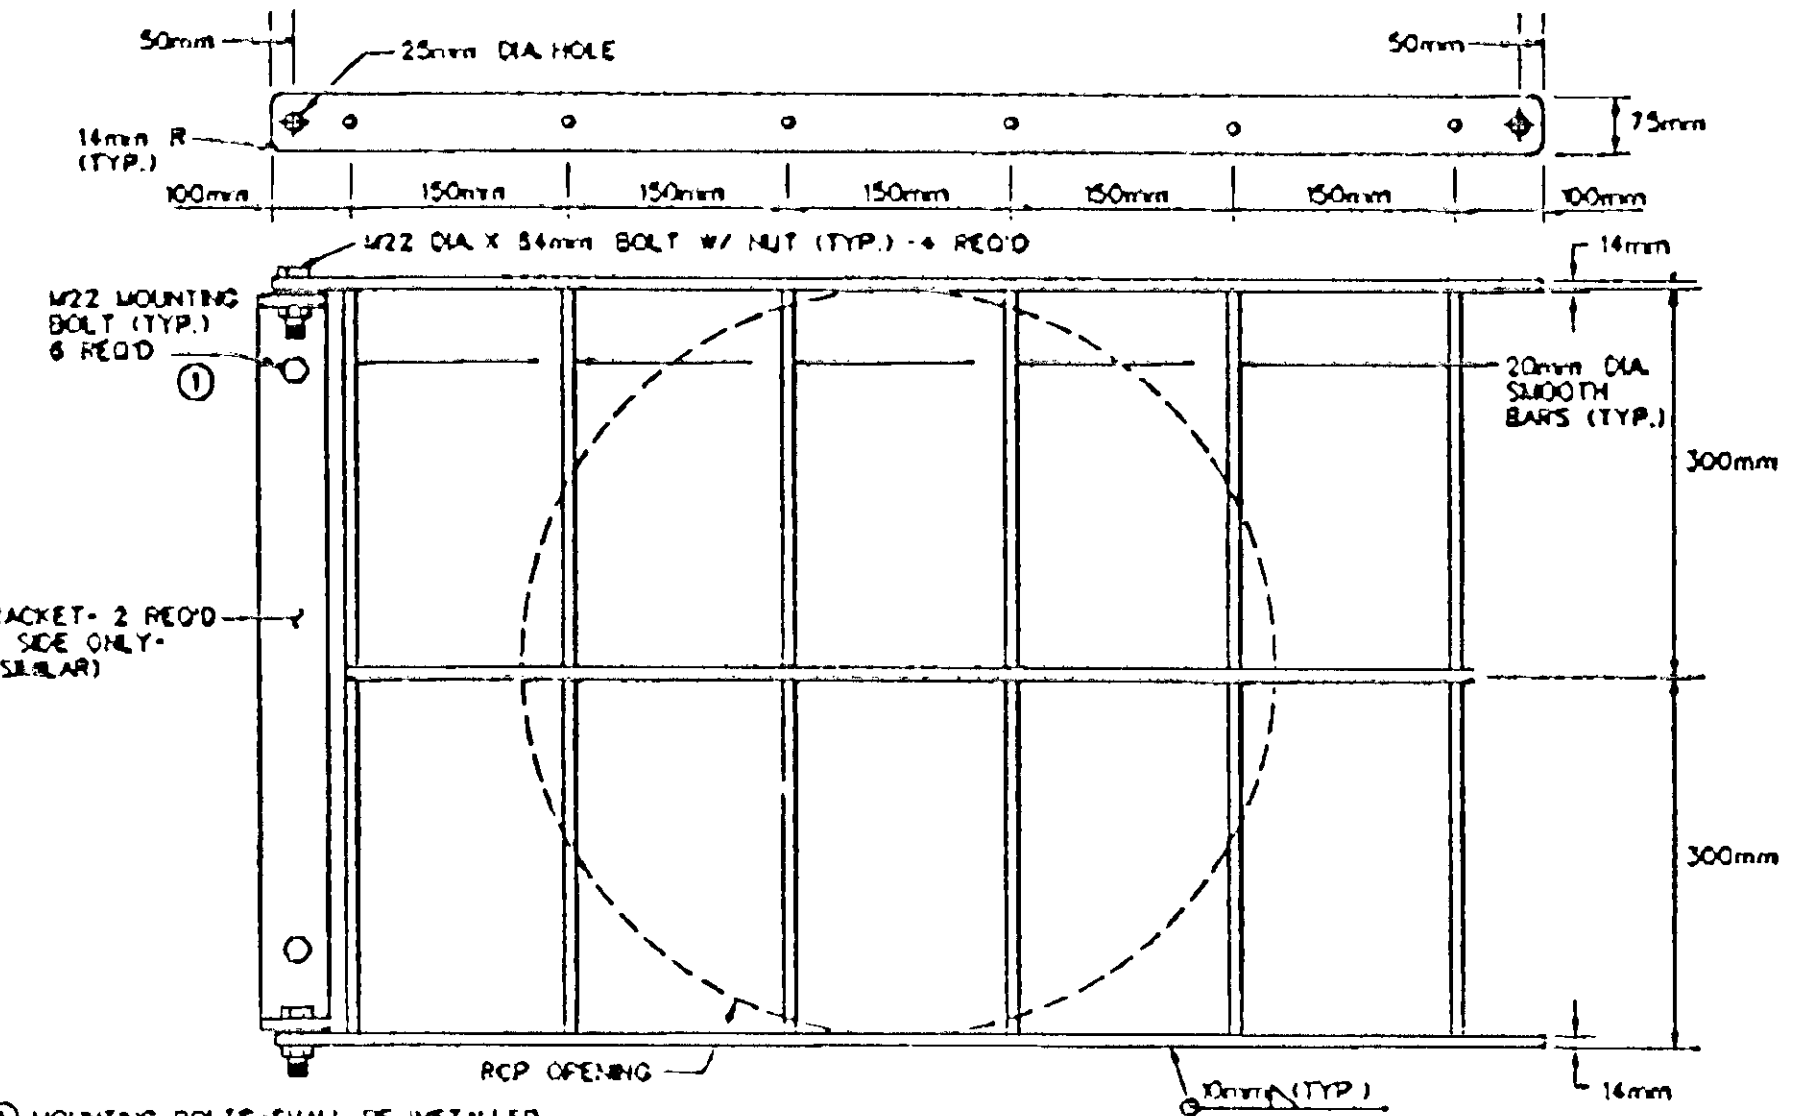

TRASH GUARD DESIGN SPECIAL (1300mm THROUGH 600mm RCP AT BOX CULVERT)

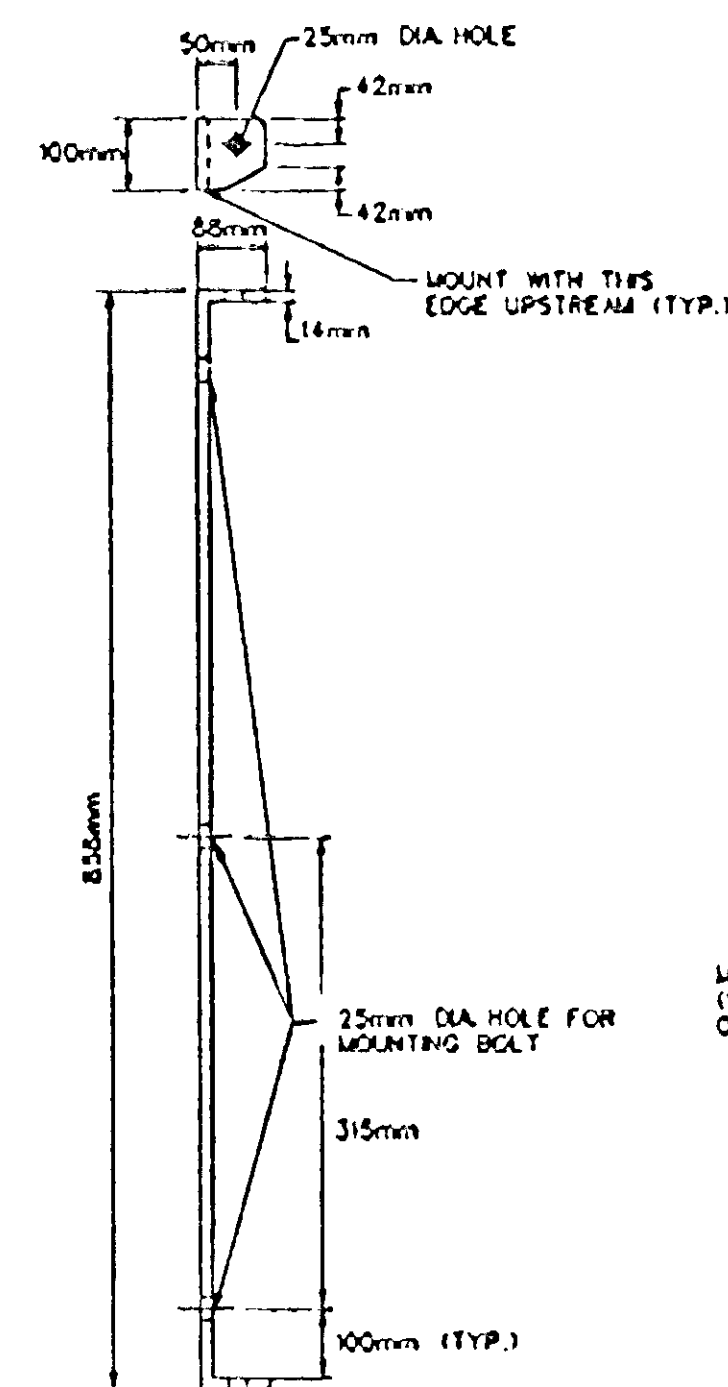


NOTE: TRASH GUARD AND MOUNTING BRACKETS TO BE GALVANIZED AFTER FABRICATION PER MN/DOT SPEC. 3392.

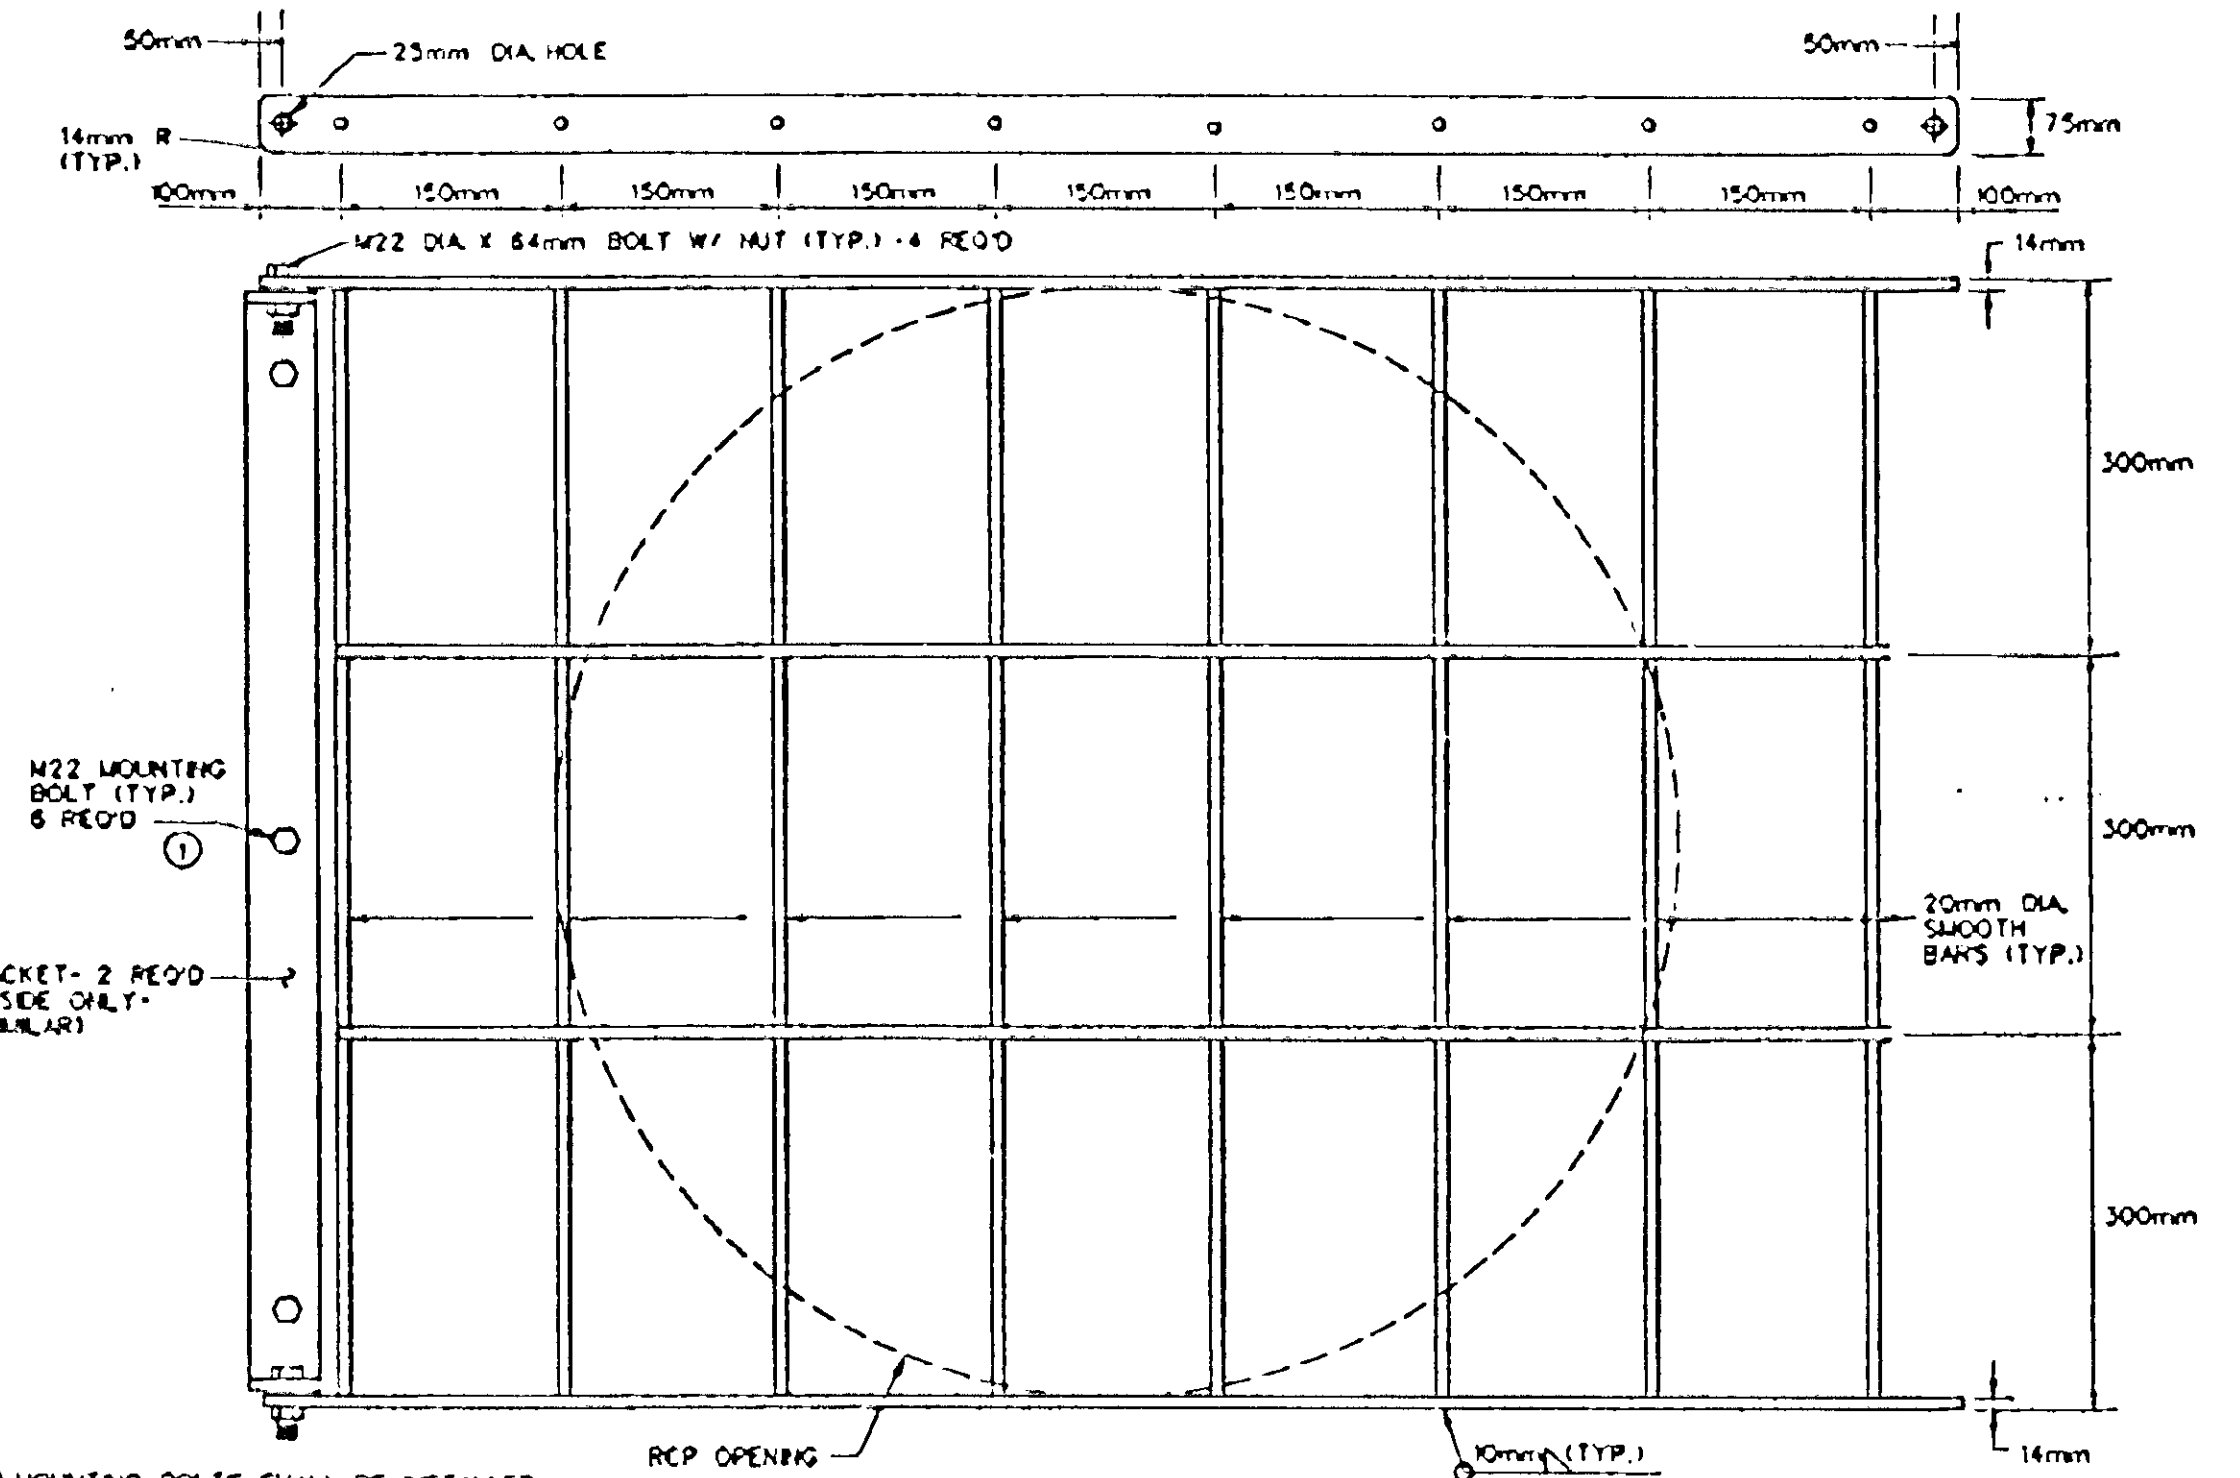

TRASH GUARD DESIGN SPECIAL (1750mm THROUGH 900mm RCP AT BOX CULVERT)

NO.	DATE	BY	CHKD	APPRI	REVISION

NAME: DET2 410 PLN DATE: Mar. 17, 1997

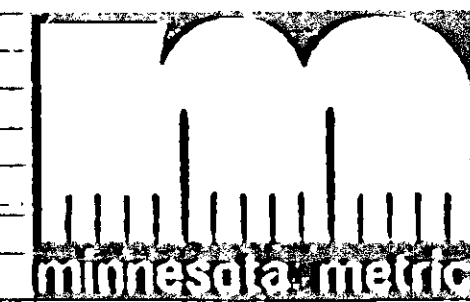

I hereby certify that this plan, specification or report was prepared by me or under my direct supervision and that I am a duly Registered Professional Engineer under the laws of the State of Minnesota.
Donald A. Demers
 Date 3-21-97 Reg No 23397


STATE AID PROJECT NO. S.A.P. 02-617-11 S.A.P. 106-020-12 S.A.P. 106-030-03
 CO. PROJECT NO.

DRAWN BY DATE V. GRAF 12-96
 DESIGNED BY L. ROBJENT 12-96
 CHECKED BY D. DEMERS 1-97
 COMM. NO. 0262410



ANOKA COUNTY
 DETAILS
 C.S.A.H. 17 RECONSTRUCTION


SHEET 21 OF 236

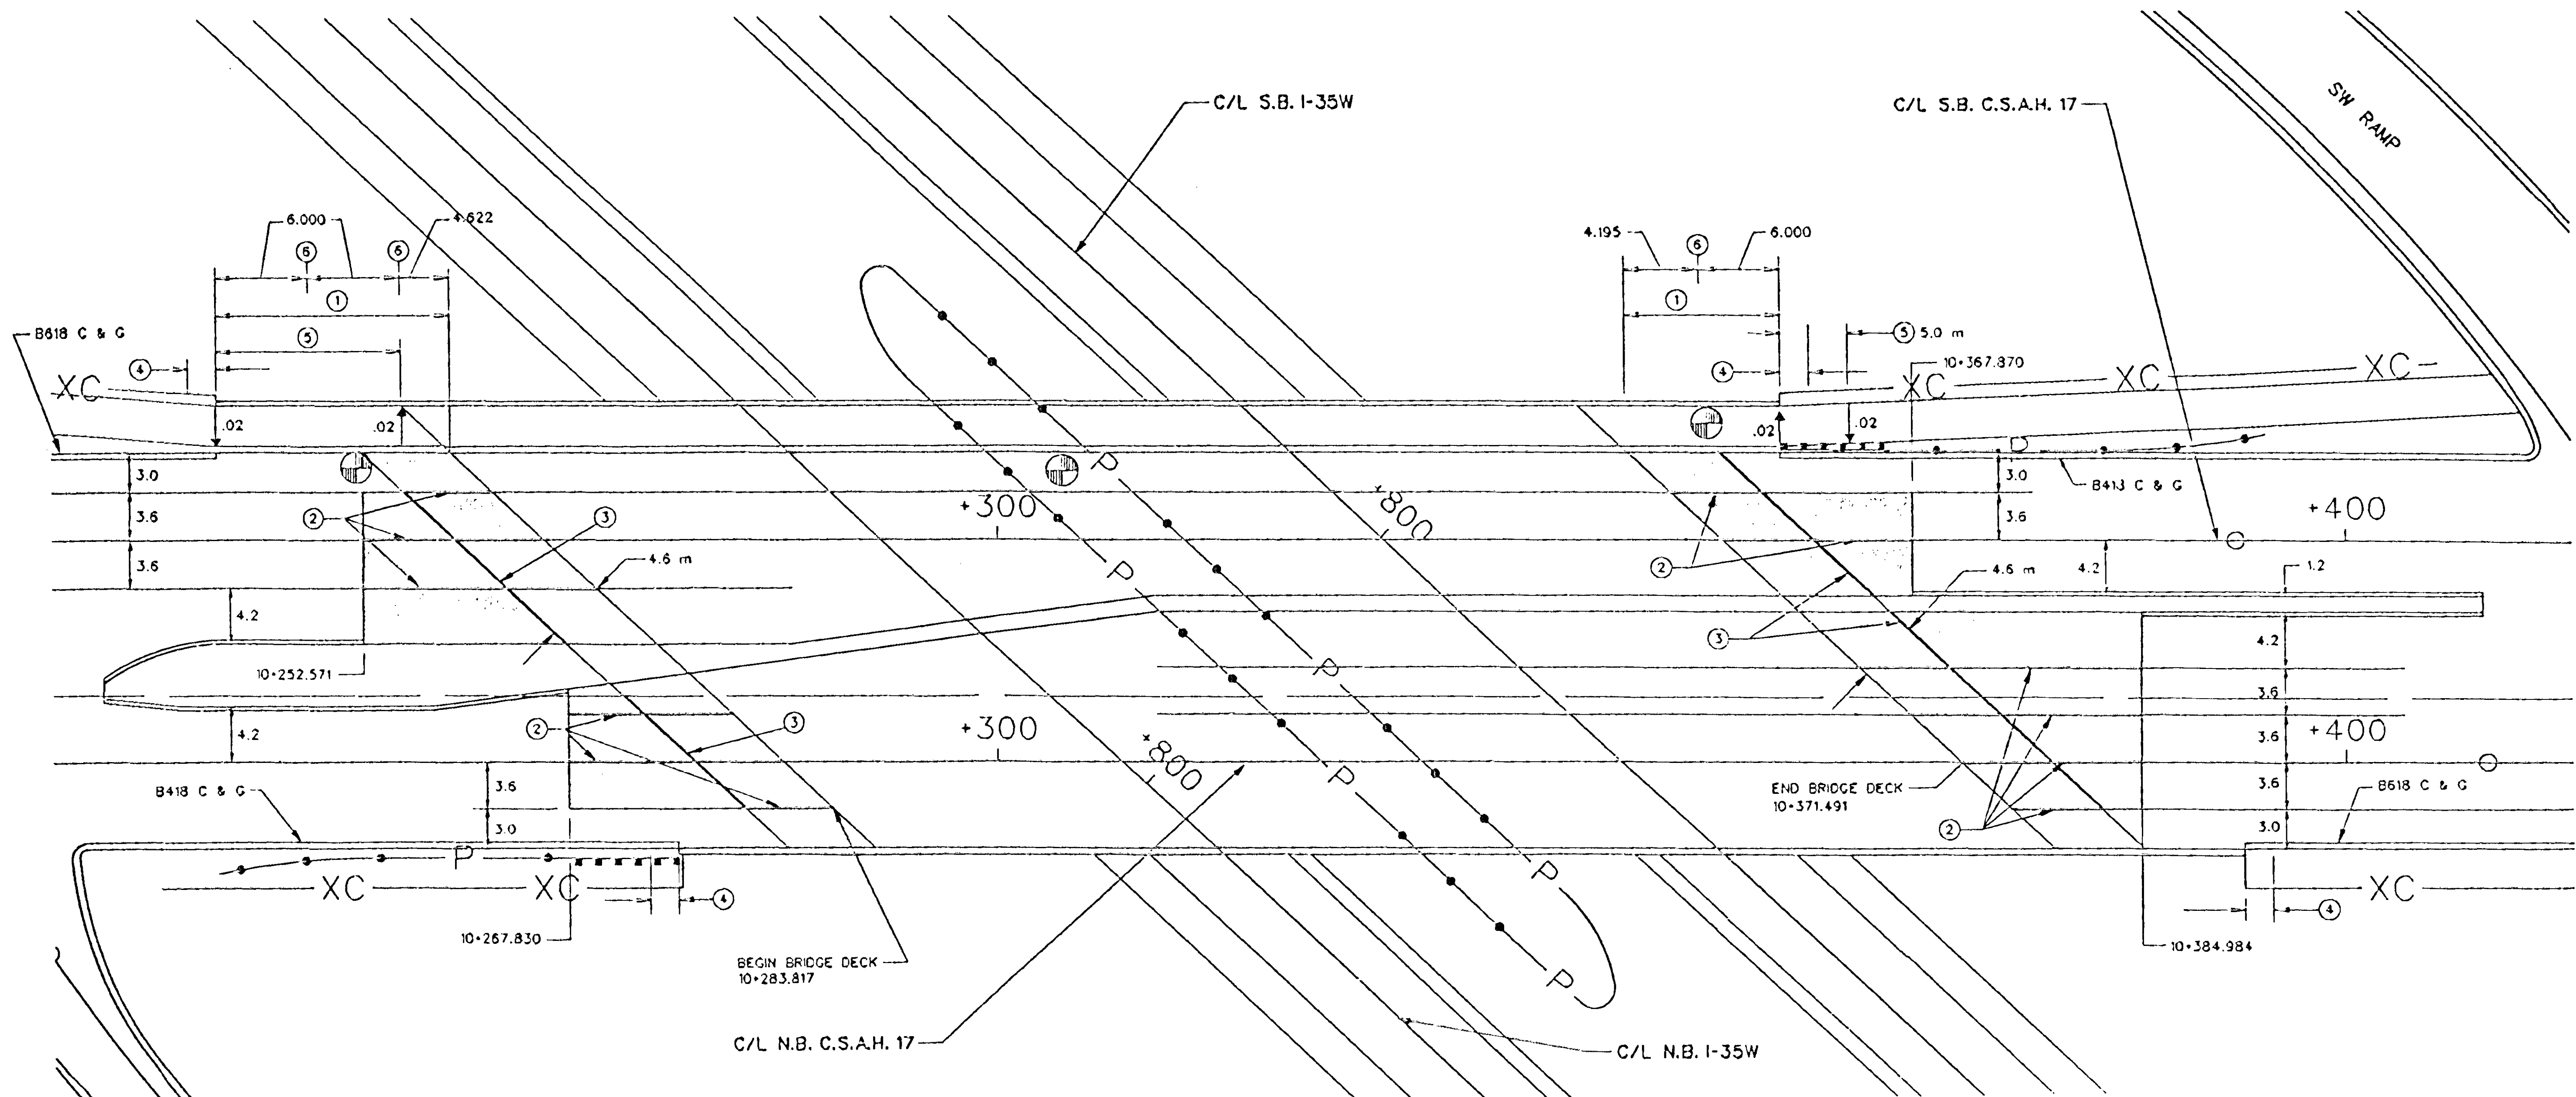

NOTES:
 SEE STD. SHEET 5-297.224M FOR MORE INFORMATION
 APPROACH PANELS TO RECEIVE LOW SLUMP CONCRETE
 OVERLAY, UNDER BRIDGE PORTION OF CONTRACT

DENOTES CONCRETE APPROACH PANEL.

- ① F-RAIL DESIGN SPECIAL
- ② L1T OR L2KT LONGITUDINAL JOINT
- ③ C2B-D CONTRACTION JOINT
- ④ 2.1 m CURB TRANSITION
- ⑤ TRANSITION WALK FROM TOP BACK CURB TO BRIDGE DECK ELEV. AND CROSS-SLOPE
- ⑥ RAIL DEFLECTION JOINT

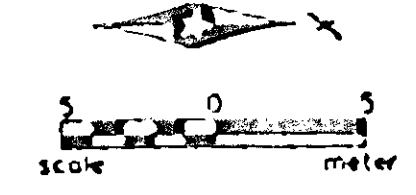

BRIDGE APPROACH PANELS		
LOCATION	AREA (m ²)	E8S JOINT (m)
SOUTH PANEL	382	
NORTH PANEL	424	
PROJECT TOTALS:	806	0

REBAR REQUIREMENTS FOR BRIDGE APPROACH PANELS SHALL BE:
 BRIDGE TO CONTRACTION JOINT 19.75 kg/m² PLUS 3 EXTRA 15M FOR EXPANSION JOINT. (IF NEEDED)
 CONTRACTION JOINT TO END OF APPROACH PANEL 5.1 kg/m²
 KEYWAY 4.8 kg/m
 2.1 m CURB TRANSITION 9.1 kg/each
 SILL (IF REQUIRED) 20.2 kg/m

NO	DATE	BY	CHKD	APPR	REVISION

NAME: APD #10.PLN DATE: Mar 17, 1997



I hereby certify that this plan, specification or report was prepared by me or under my direct supervision and that I am a duly Registered Professional Engineer under the laws of the State of Minnesota.
Donald A. Demers
 Date 3-21-97 Reg No 23397





STATE AID PROJECT NO.
 S.A.P. 02-617-11
 S.A.P. 106-020-12
 S.A.P. 106-030-03
 CO. PROJECT NO.

DRAWN BY DATE
 M. ISAKKA 3-97
 DESIGNED BY
 D. DEMERS 3-97
 CHECKED BY
 D. DEMERS 3-97
 COMM. NO.
 0262410







ANOKA COUNTY
 APPROACH PANEL DETAIL
 C.S.A.H. 17 RECONSTRUCTION

SHEET
 23
 OF
 236

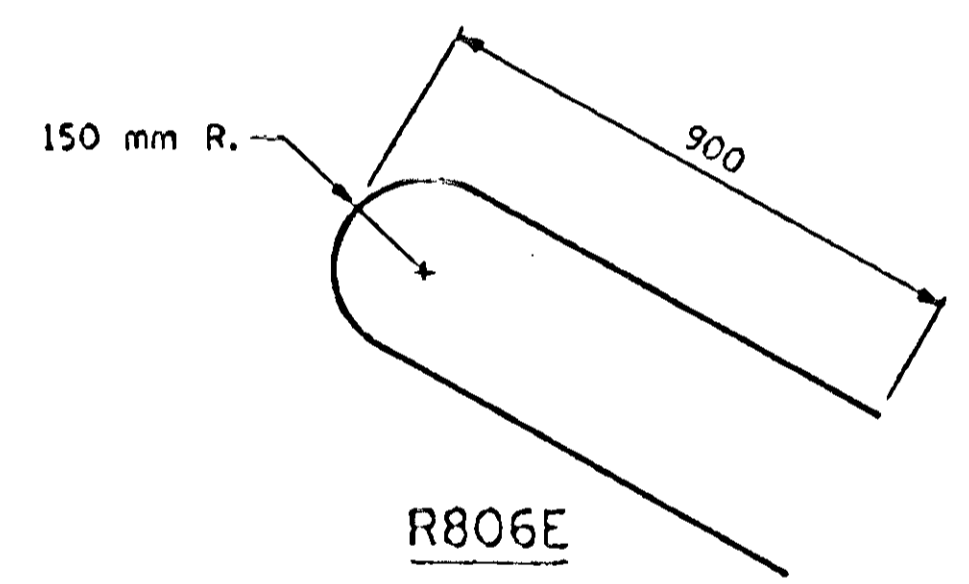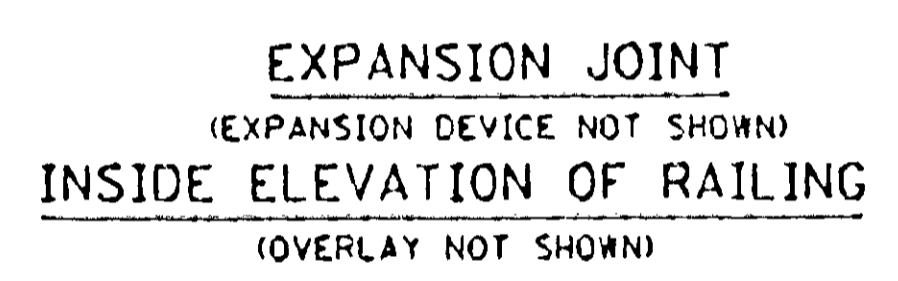
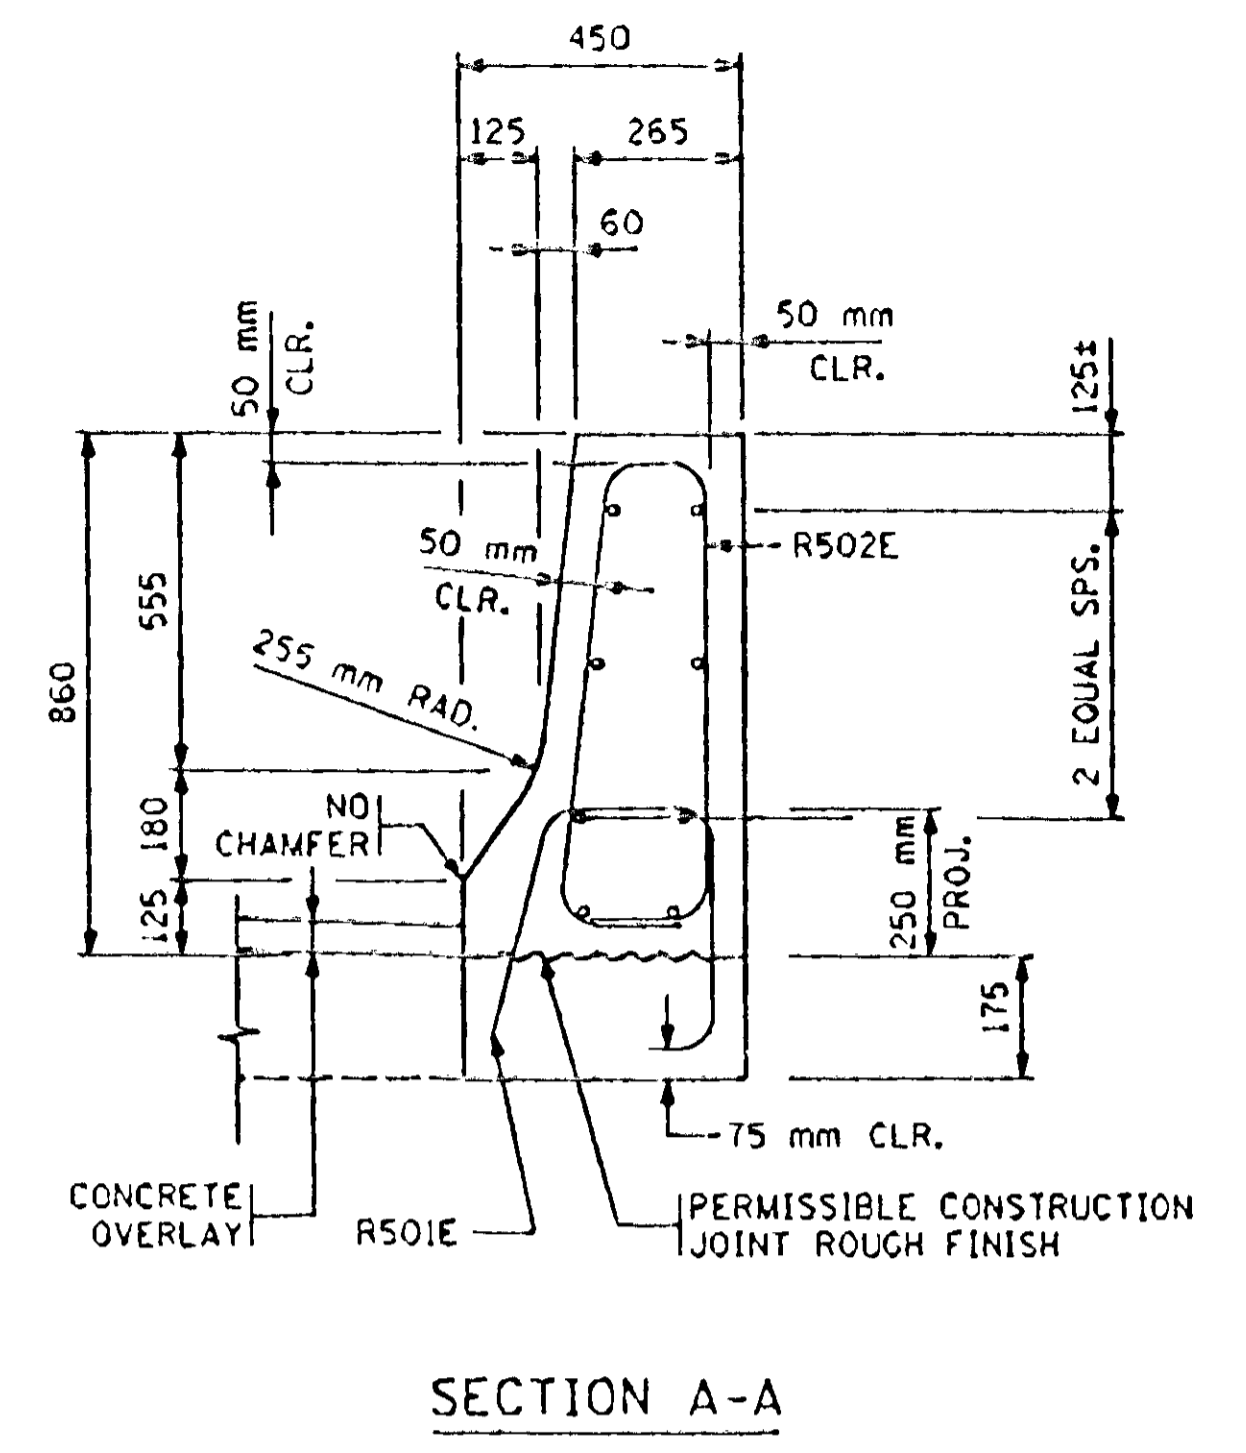
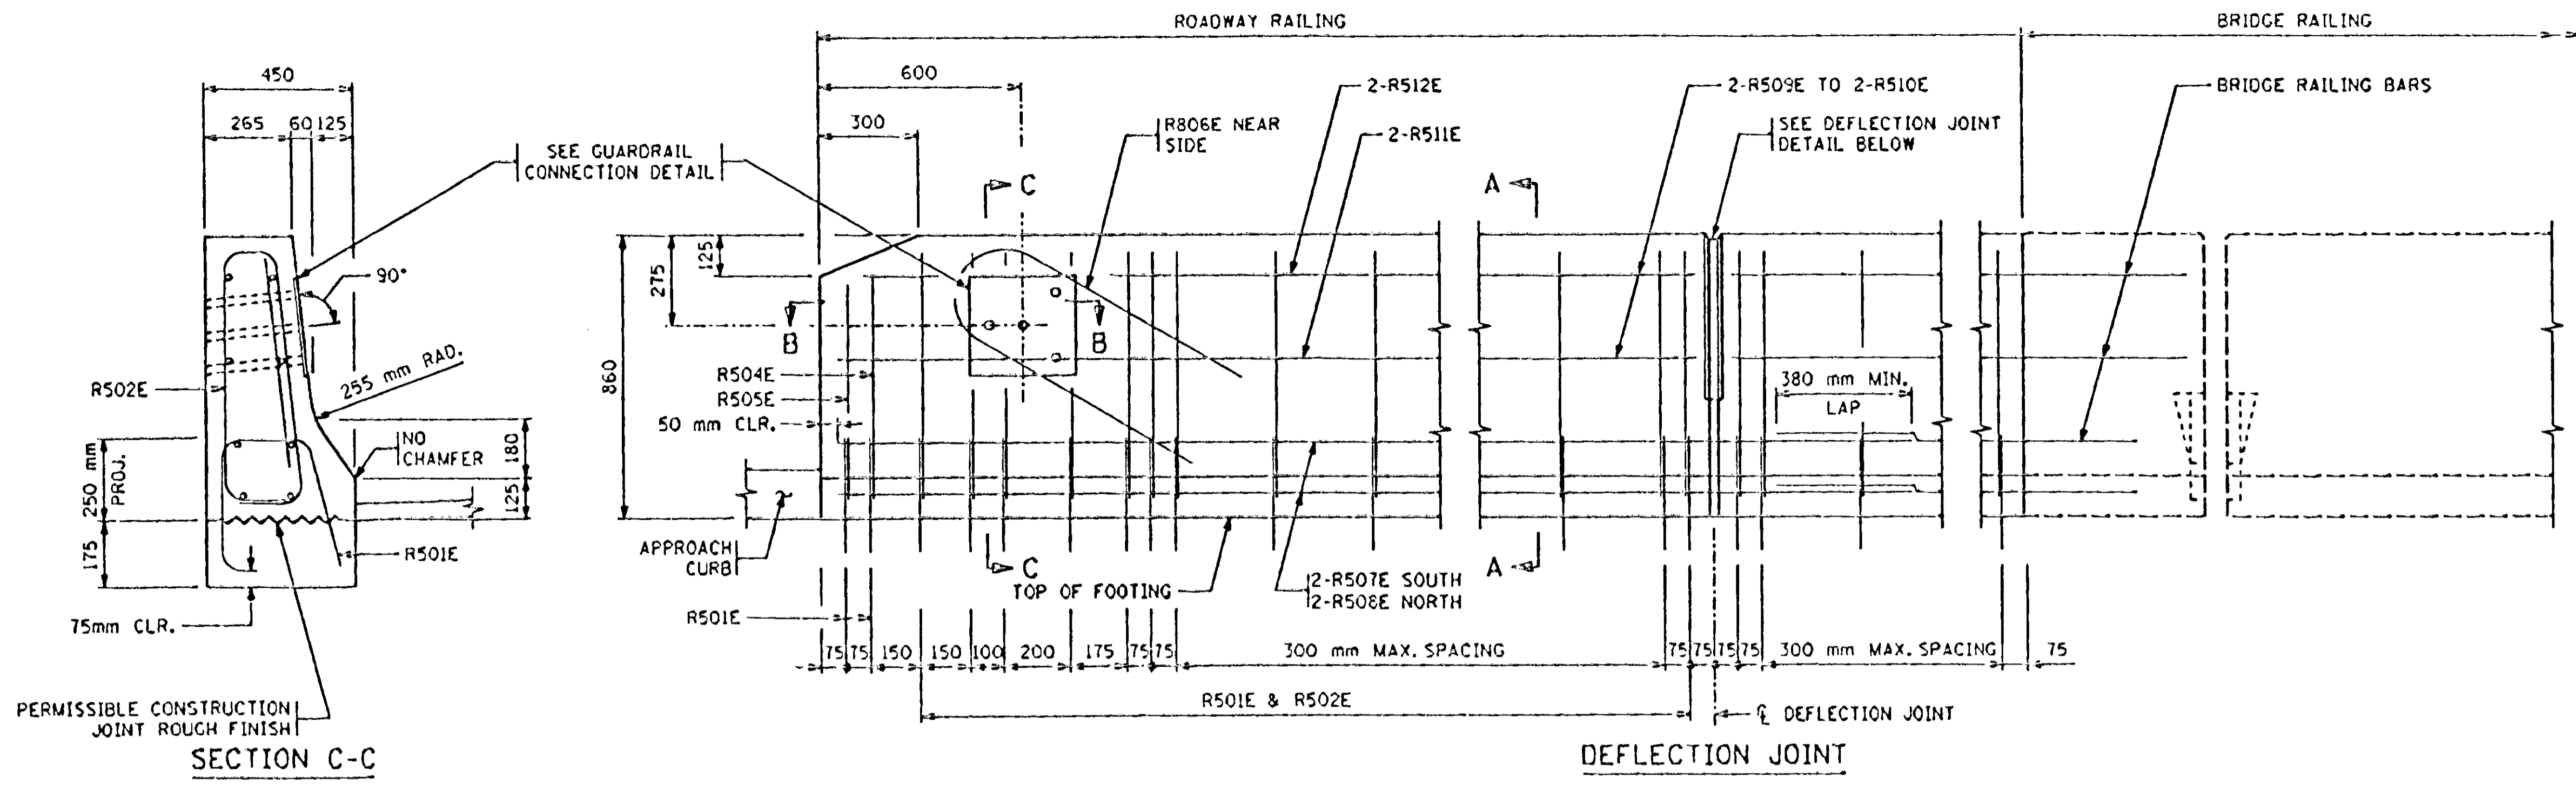


BILL OF REINFORCEMENT FOR RAILING					
BAR	NO.	LENGTH	SHAPE	LOCATION	
R501E	107	1150		RAIL DOWEL	
R502E	103	2080		RAIL VERTICAL	
R503E	-	1530		RAIL VERTICAL	
R504E	2	1940		RAIL VERTICAL	
R505E	2	1890		RAIL VERTICAL	
R806E	2	1970		RAIL VERTICAL	
R507E	8	8475		RAIL LONGITUDINAL	
R508E	8	5500		RAIL LONGITUDINAL	
R509E	4	5875		RAIL LONGITUDINAL	
R510E	8	4550		RAIL LONGITUDINAL	
R511E	4	5885		RAIL LONGITUDINAL	
R512E	4	5305		RAIL LONGITUDINAL	

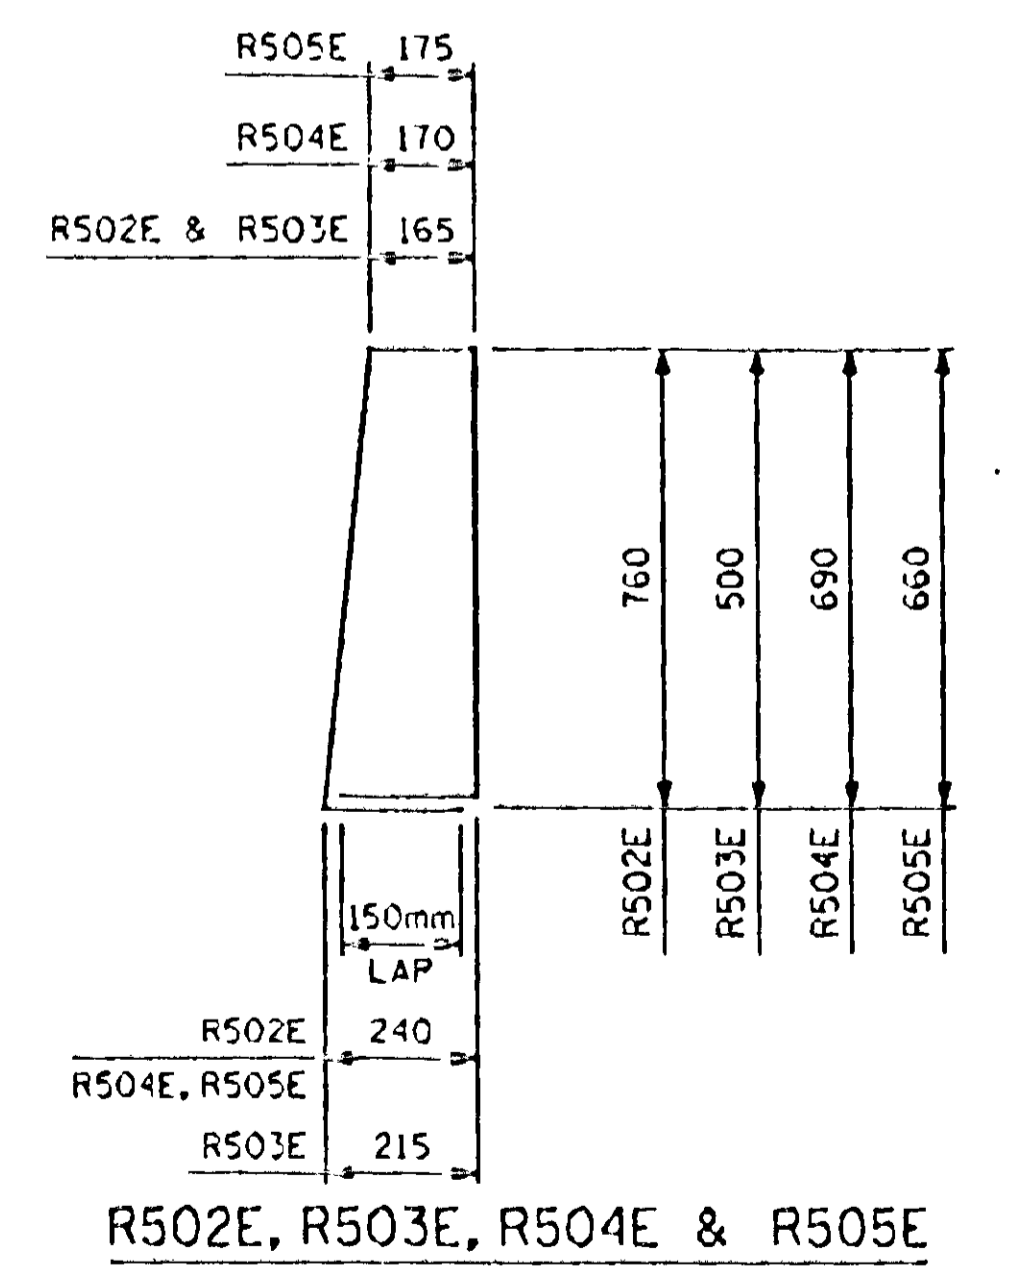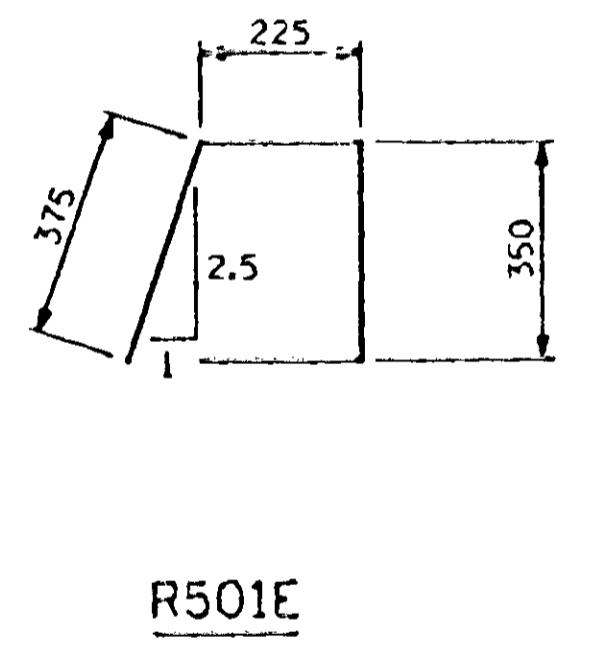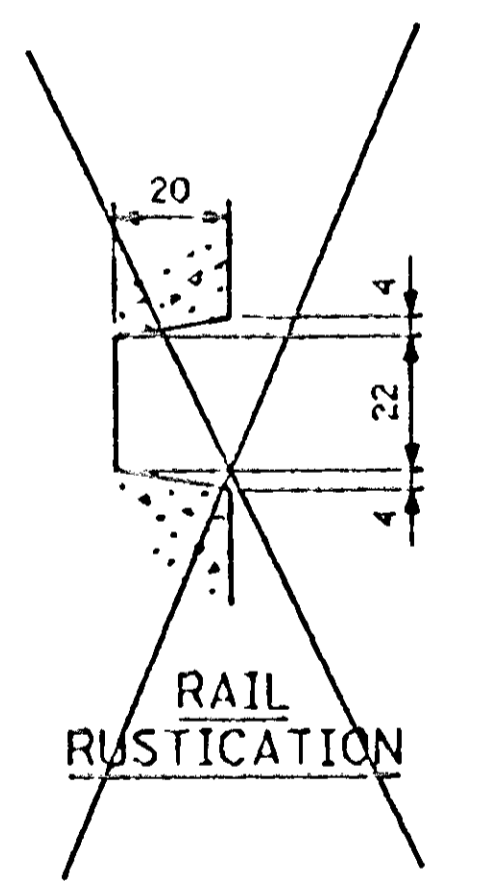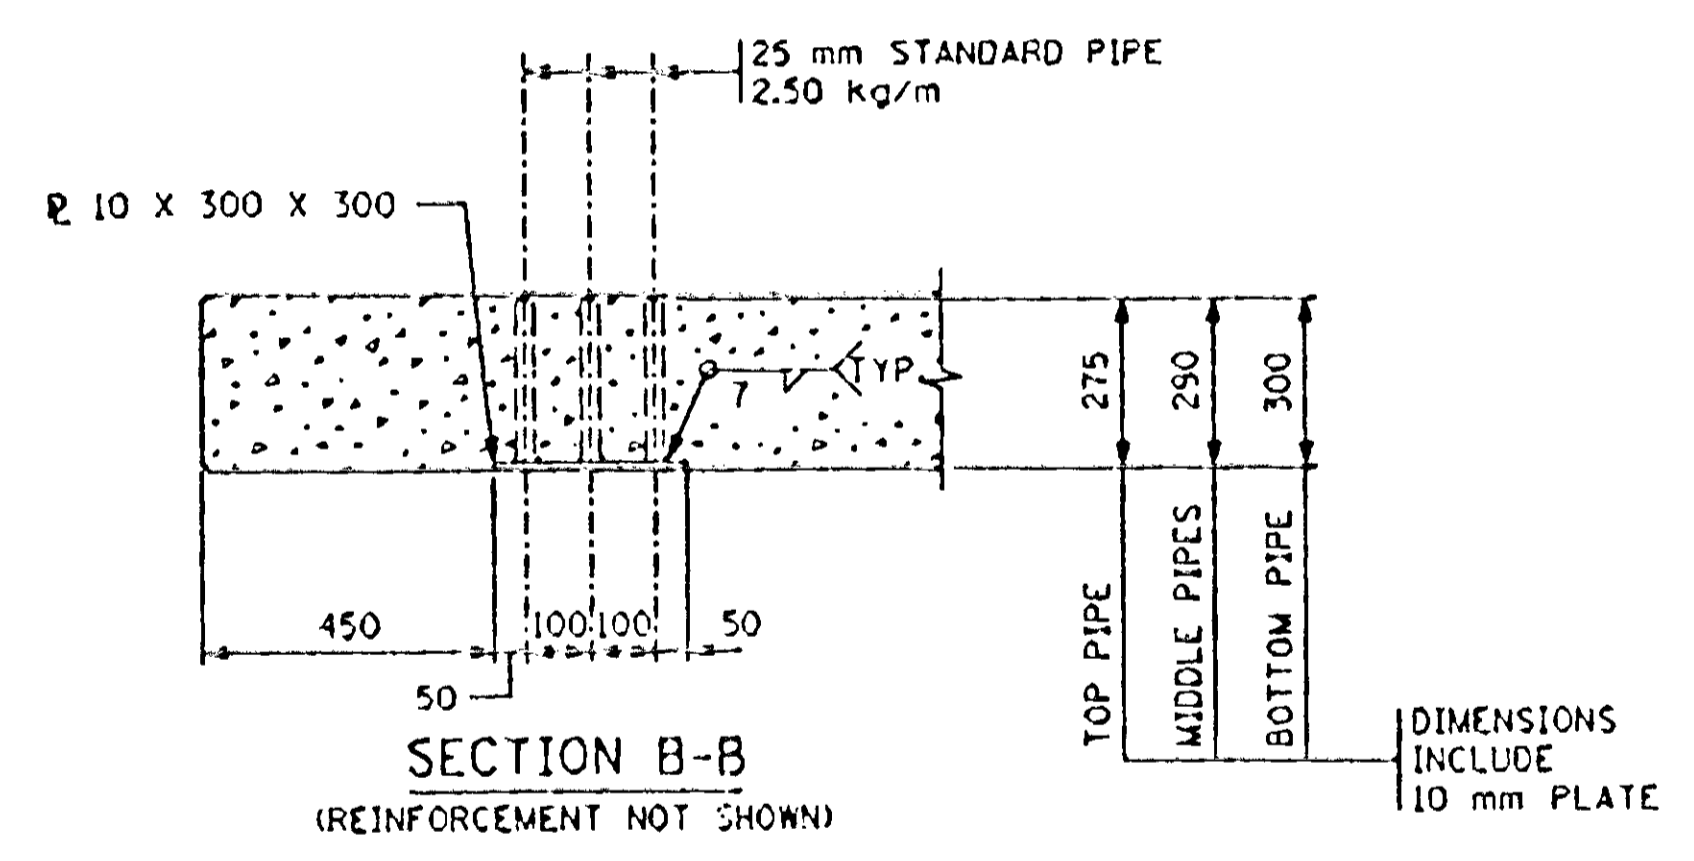

GENERAL NOTES

- CONCRETE RAILING = 0.369m³/m INCLUDING FOOTING.
- GUARDRAIL CONNECTION TO BE STRUCTURAL STEEL, SPEC. 3306.
- FINISH ALL EDGES OF RAIL WITH 13 mm VEE, EXCEPT WHERE OTHERWISE NOTED.
- SEE APPROACH PANEL DETAIL SHEET FOR JOINT SPACING.
- GUARDRAIL CONNECTION TO BE INCLUDED IN PRICE BID FOR OTHER ITEMS.
- MAXIMUM SPACING OF CONCRETE DEFLECTION JOINTS SHALL BE 6 METERS.
- RAIL TO BE CONCRETE MIX NO. 3Y46.
- RAIL REINFORCEMENT (895kg) INCIDENTAL TO RAILING.

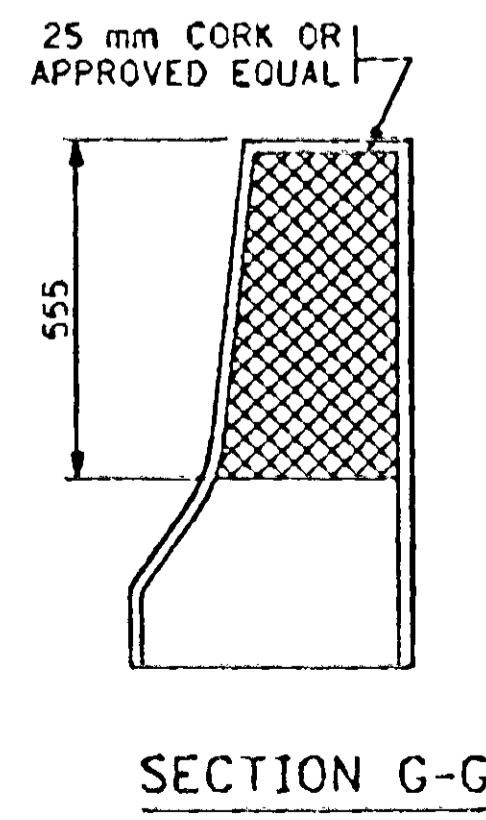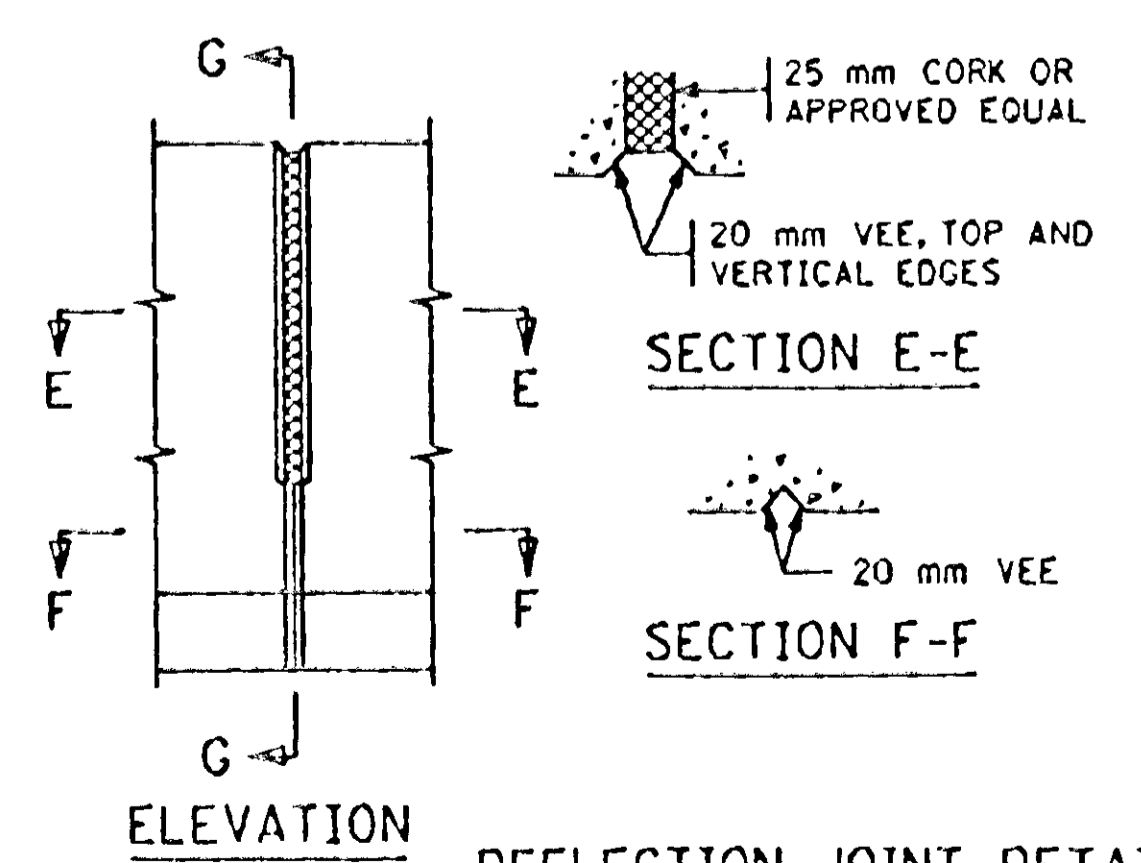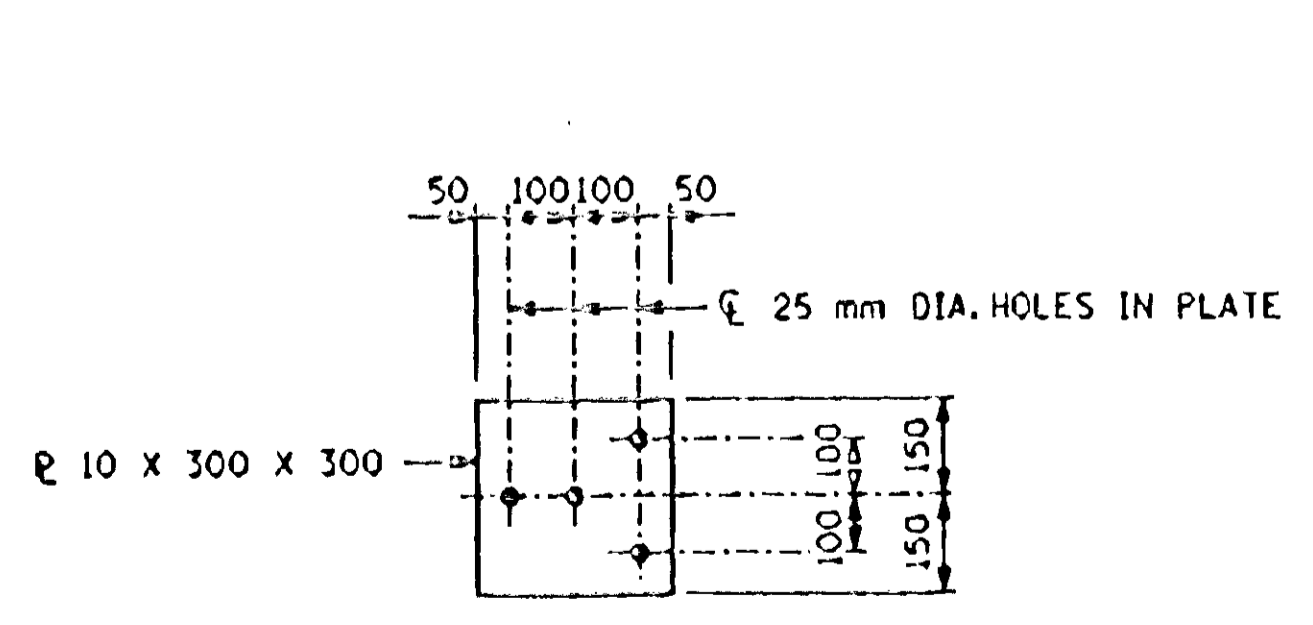

GUARDRAIL CONNECTION DETAIL
GALVANIZE AFTER FABRICATION PER SPEC. 3334
ESTIMATED WEIGHT = 9.9 kg

DEFLECTION JOINT DETAILS









S.A.P. 02-617-11, et al.
CERTIFIED BY: *Robert A. Simpson*
PROFESSIONAL ENGINEER
REG. NO. 19632 3/21 1997

TITLE: **CONCRETE RAILING (TYPE F) SPECIAL**
WITH INTEGRAL END POST
(WITH CONCRETE OVERLAY)



DES: RAS	DR: JCH	MODIFIED	FIG. 5-397.117M
CHK: LAE	CHK: RAS		
SHEET NO. 24 OF 236 SHEETS			BRIDGE NO.

APPROVED: X X. 1995
STATE BRIDGE ENGINEER

H:/STRUC/003/2413/FIG 7117M.DGN

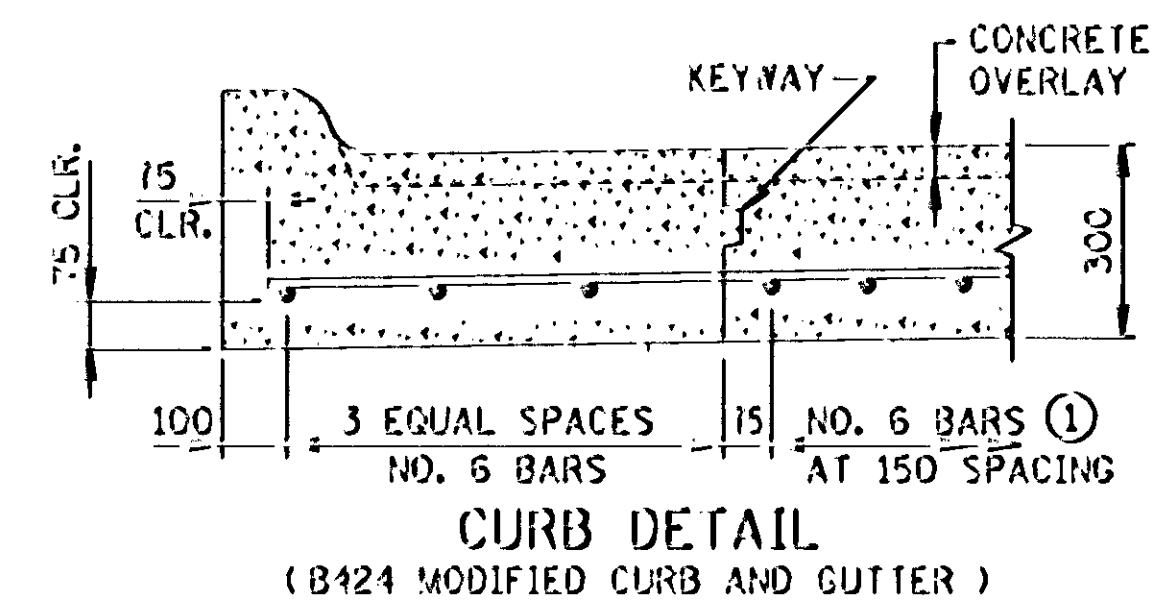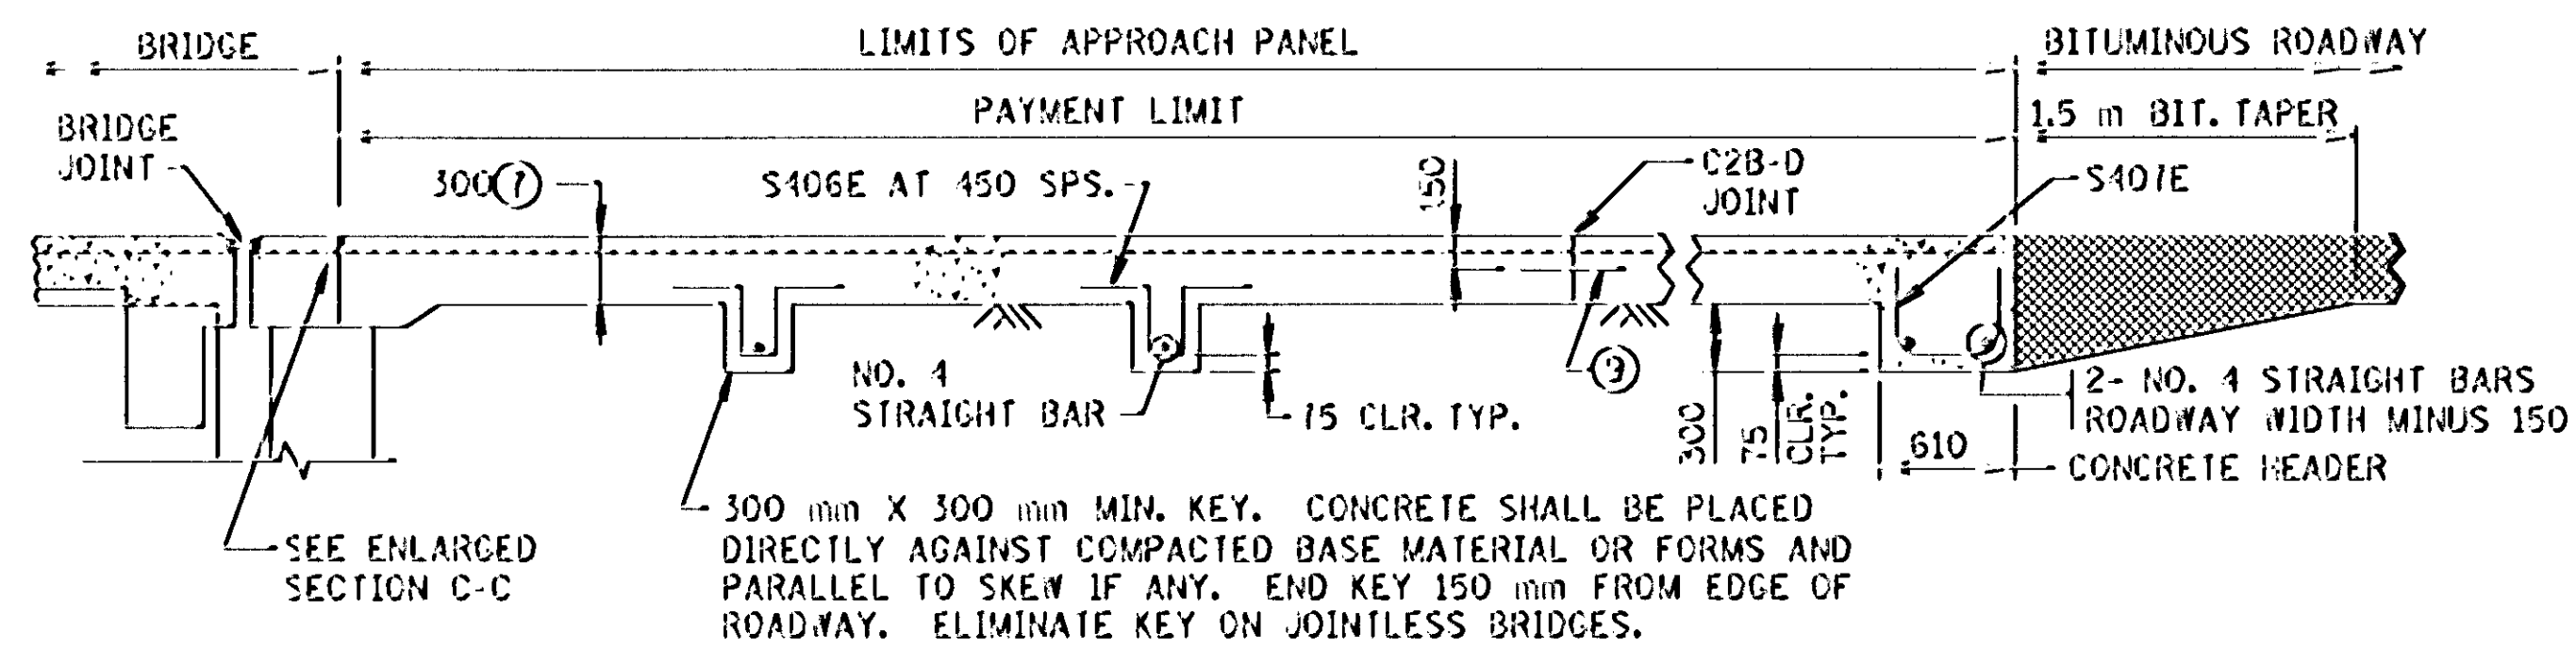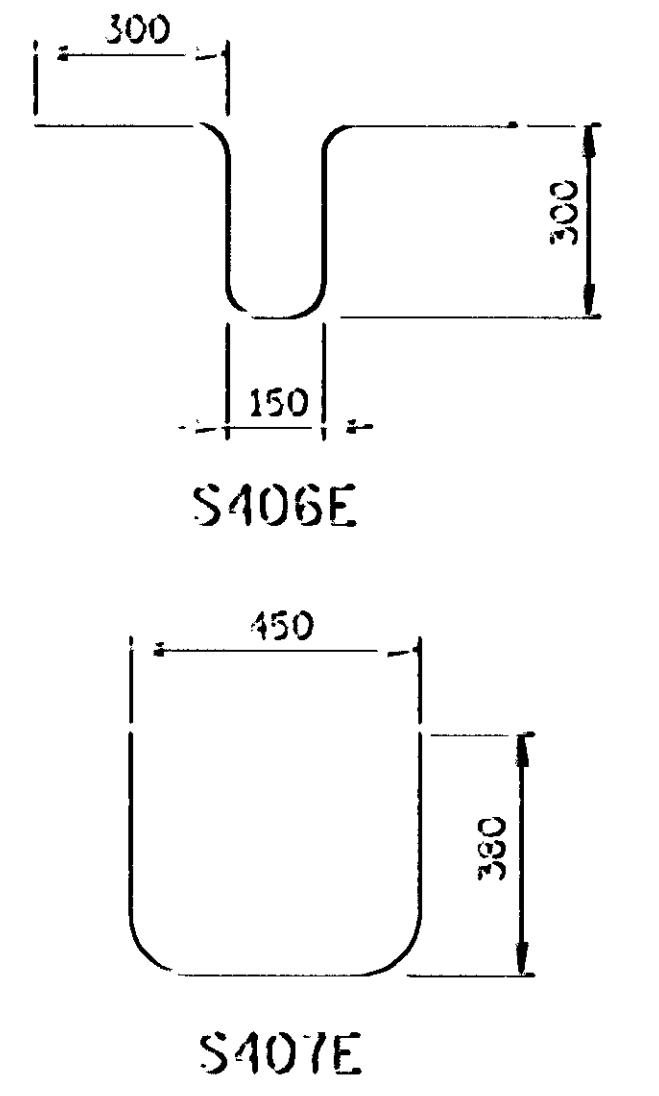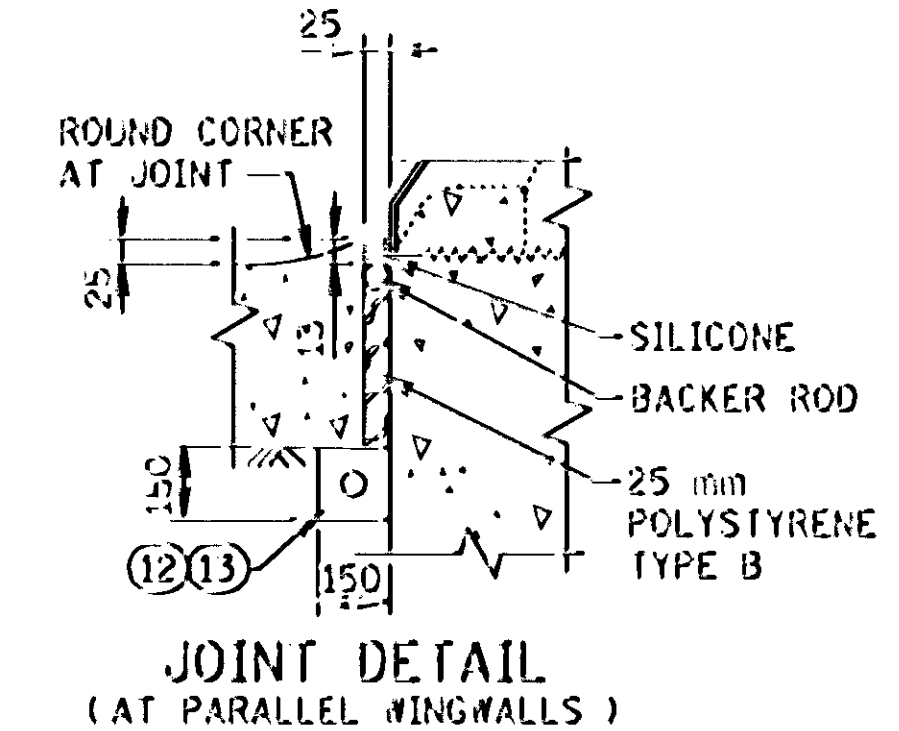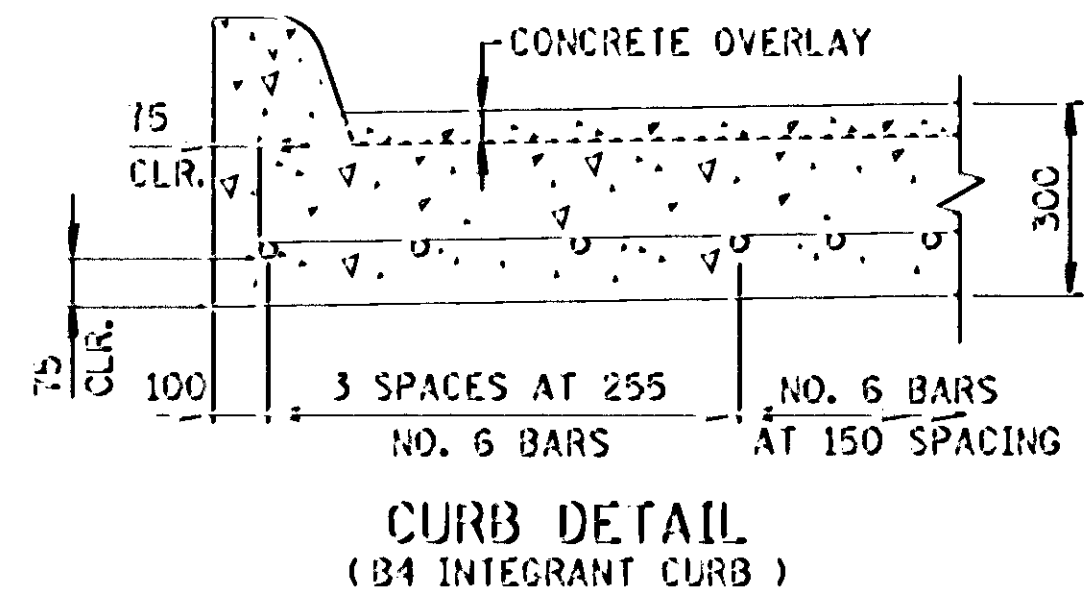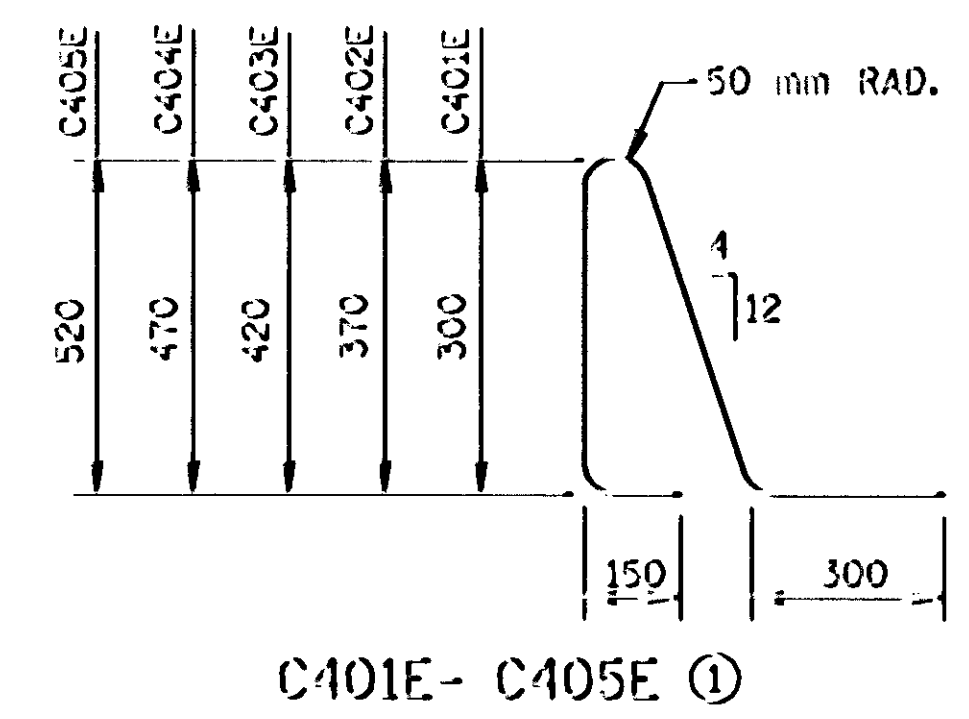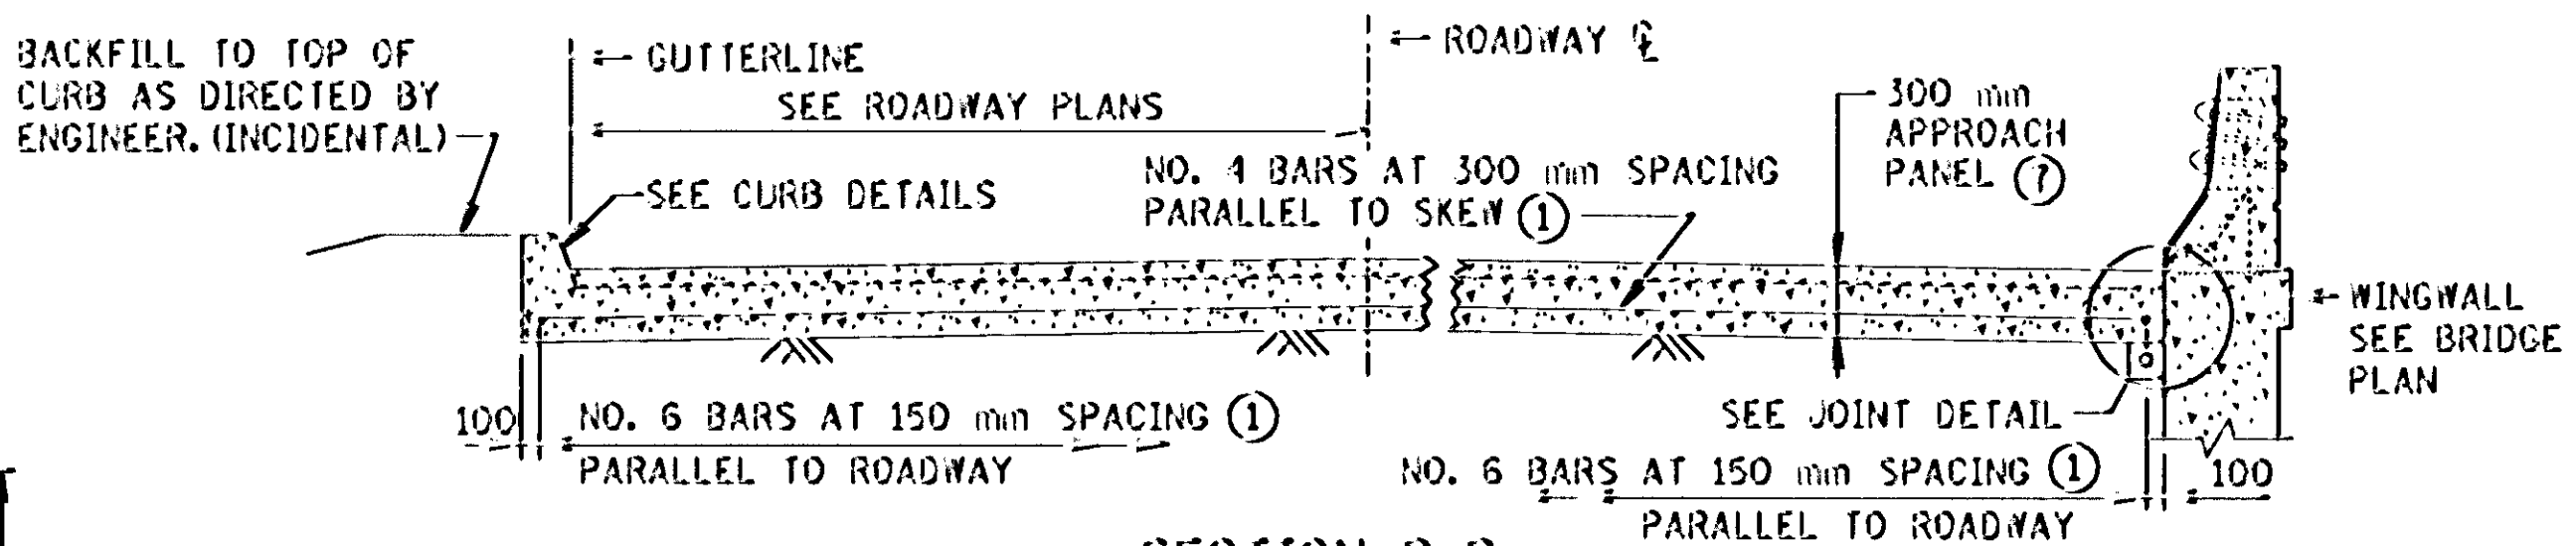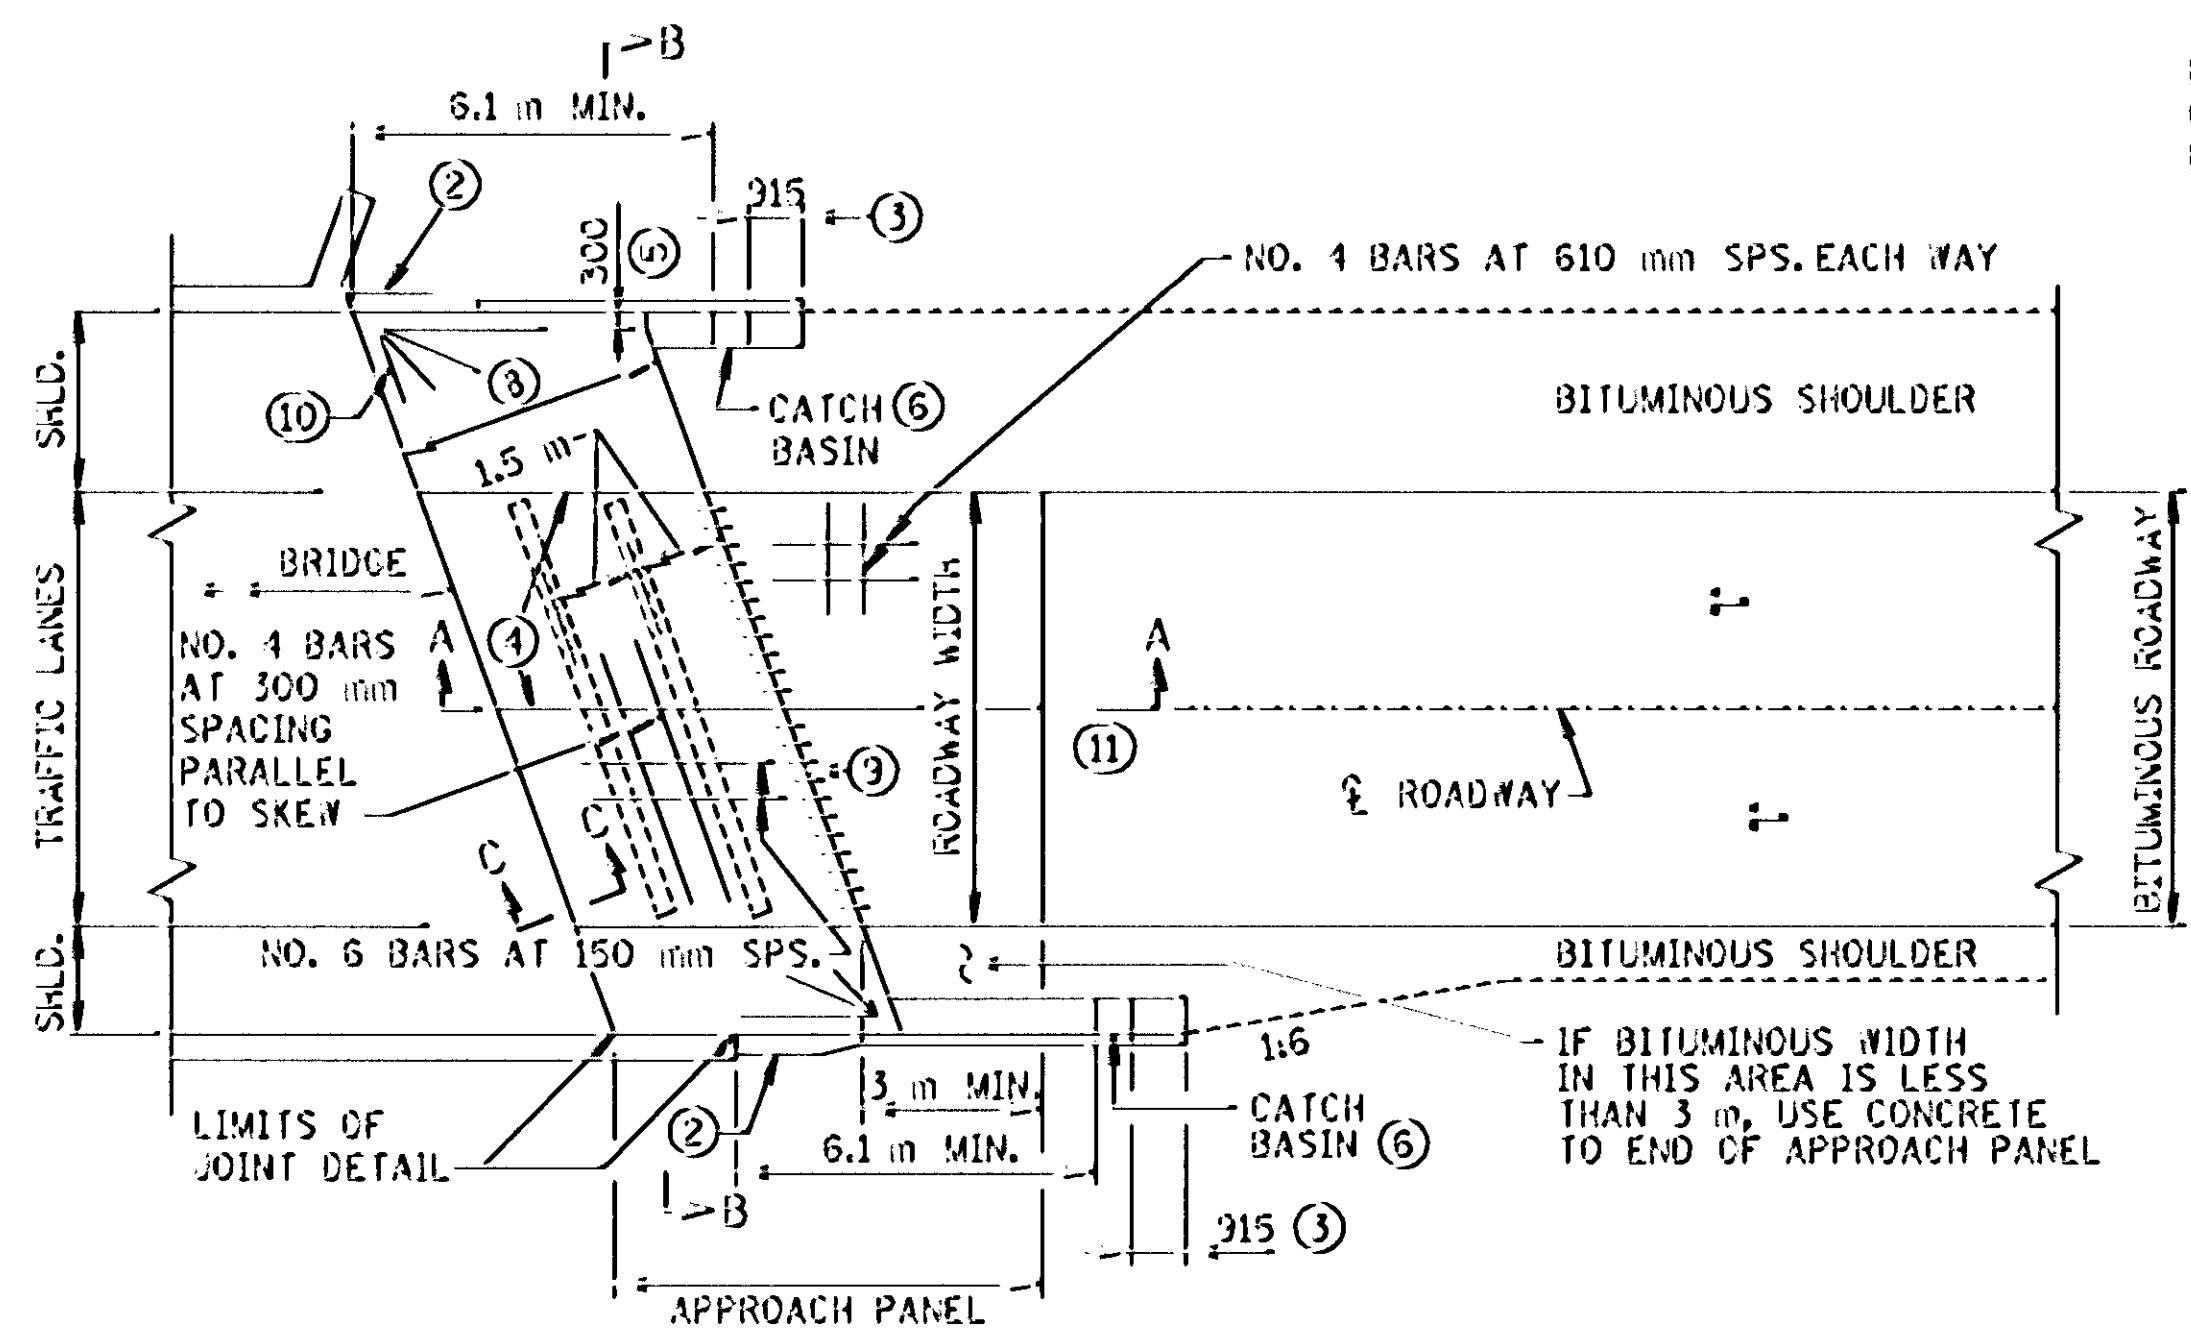


- NOTES:**
- ALL REINFORCEMENT IN APPROACH PANEL, SILL AND CURB SHALL BE GRADE 60 AND EPOXY COATED AS PER SPEC. 3301.
 - TRANSITION FACE OF 100 mm CURB INTO PROFILE OF BRIDGE RAILING. SEE CURB TRANSITION DETAILS.
 - TRANSITION APPROACH PANEL CURB HEIGHT 100 mm TO 0 mm WHERE THERE IS NO ROADWAY CURB.
 - L2KT OR L1T LONGITUDINAL JOINTS AS REQUIRED. SEE STANDARD PAVEMENT JOINT SHEET FOR DETAILS.
 - EDGE OF PANEL PERPENDICULAR TO GUTTER FOR SKEWS OVER 45°.
 - LOCATION MAY BE ON OR OFF THE APPROACH PANEL AS DETERMINED BY THE DESIGNER. SEE ROAD DESIGN MANUAL CHAPTER 7 FOR CATCH BASIN INFORMATION.
 - APPROACH SLAB THICKNESS SHOWN INCLUDES ANY CONCRETE OVERLAY THAT MAY BE REQUIRED. SEE BRIDGE PLANS FOR REQUIREMENTS. CONCRETE OVERLAYS TO BE INCLUDED IN BRIDGE QUANTITIES AND DONE AT THE SAME TIME BY BRIDGE CONTRACTOR.
 - 6.1 m TO 40° SKEWS, 4.6 m OVER 40° SKEWS.
 - CONTRACTION JOINT C2B-D WITH 38 mm DIA. X 460 mm LG. EPOXY COATED DONEL BARS AT 305 mm SPACING PARALLEL TO 1/2 OF ROADWAY. CAGES NOT REQUIRED.
 - FAN 4 - NO. 4 BARS 2.4 m LONG AS SHOWN FOR SKEWS OVER 45°.
 - SEE STANDARD PLAN SHEET FOR BRIDGE APPROACH TRANSITION INFORMATION.
 - 50 mm NOMINAL DIA. THERMOPLASTIC PIPE, AS PER ASTM D1785M, SCHEDULE 40. SLOPE PIPE TO DITCH ON LOW SIDE. FURNISHING AND INSTALLING DRAIN SYSTEM SHALL BE INCIDENTAL, WITH NO DIRECT PAYMENT. WRAP PERFORATED PIPE WITH GEOTEXTILE AS PER SPEC. 3733. 3 mm PER 300 mm MINIMUM SLOPE.
 - BACKFILL WITH FINE AGGREGATE, SPEC. 3149, MODIFIED TO 0-3% PASSING A 75 μm SIEVE.

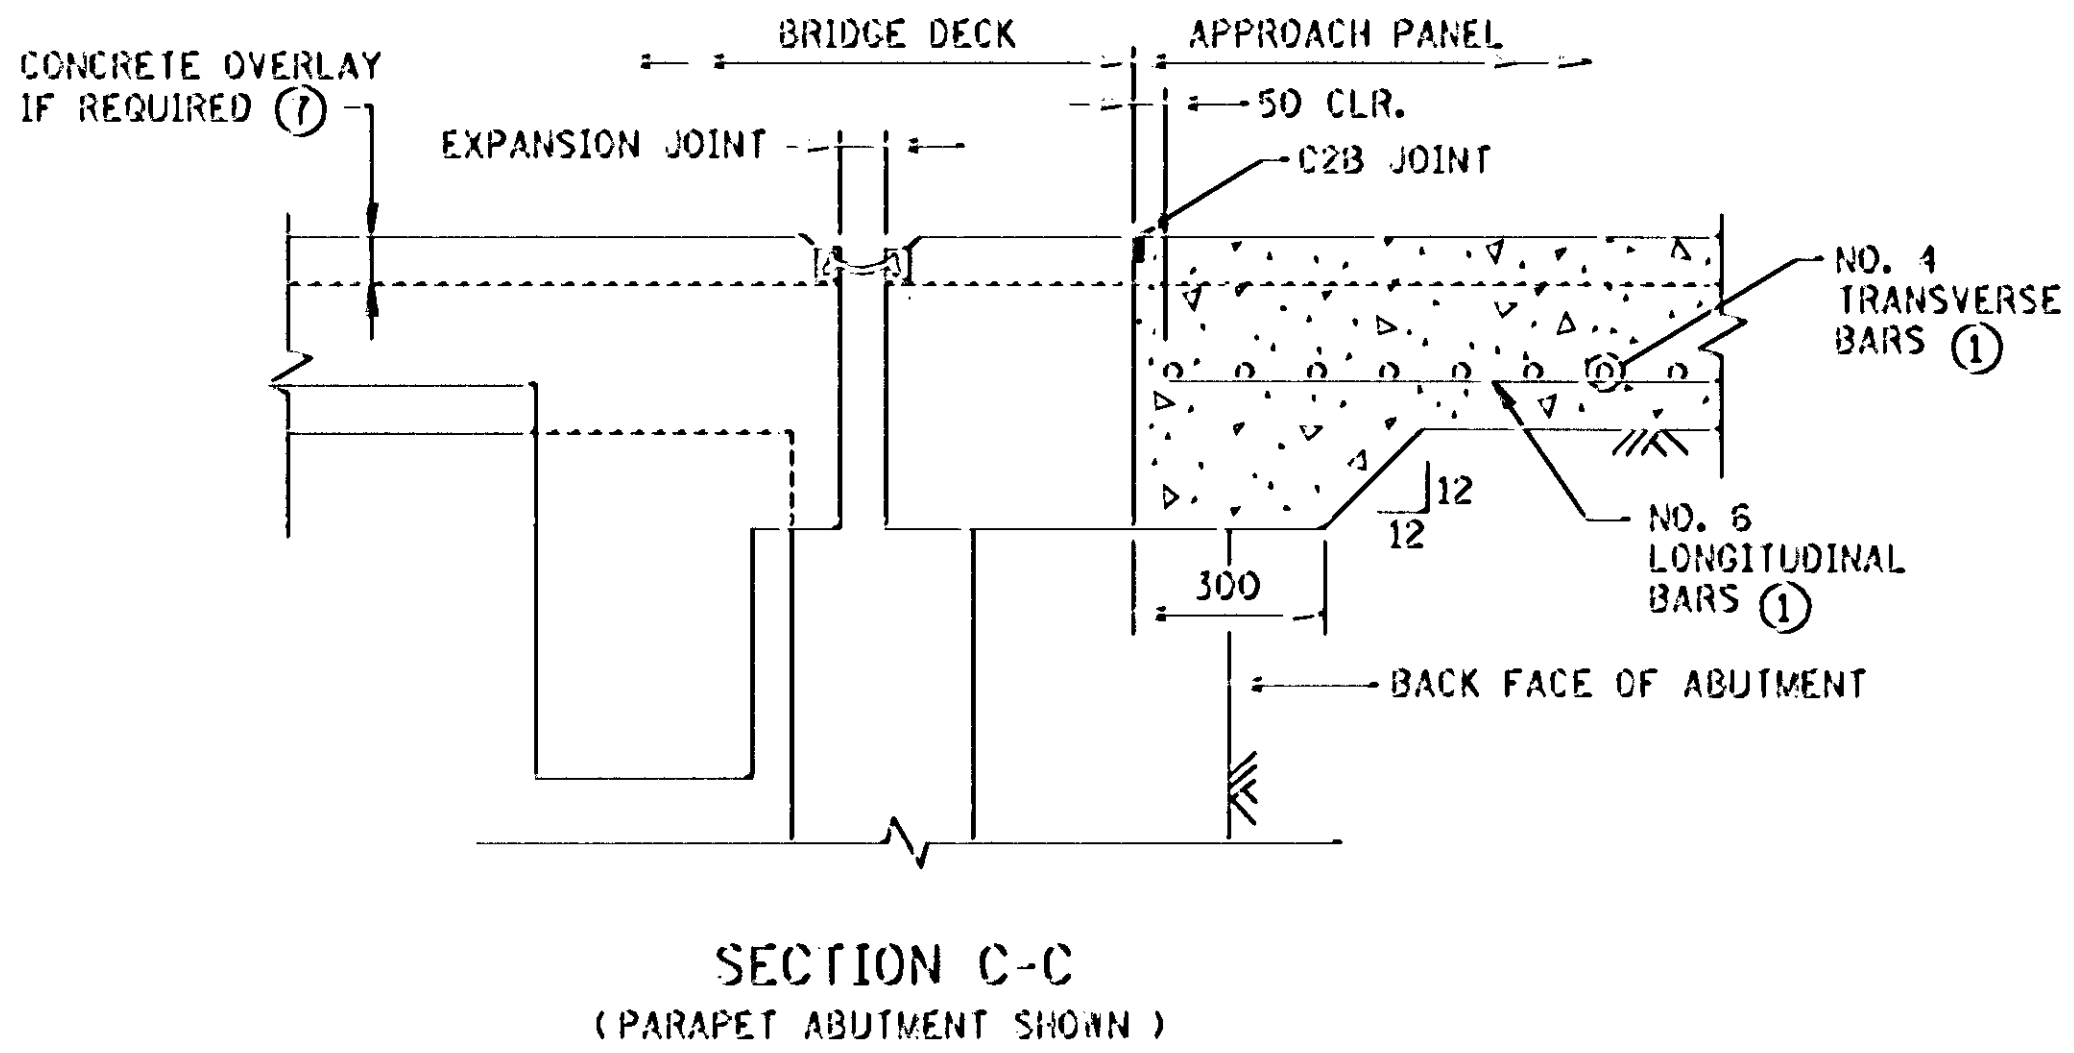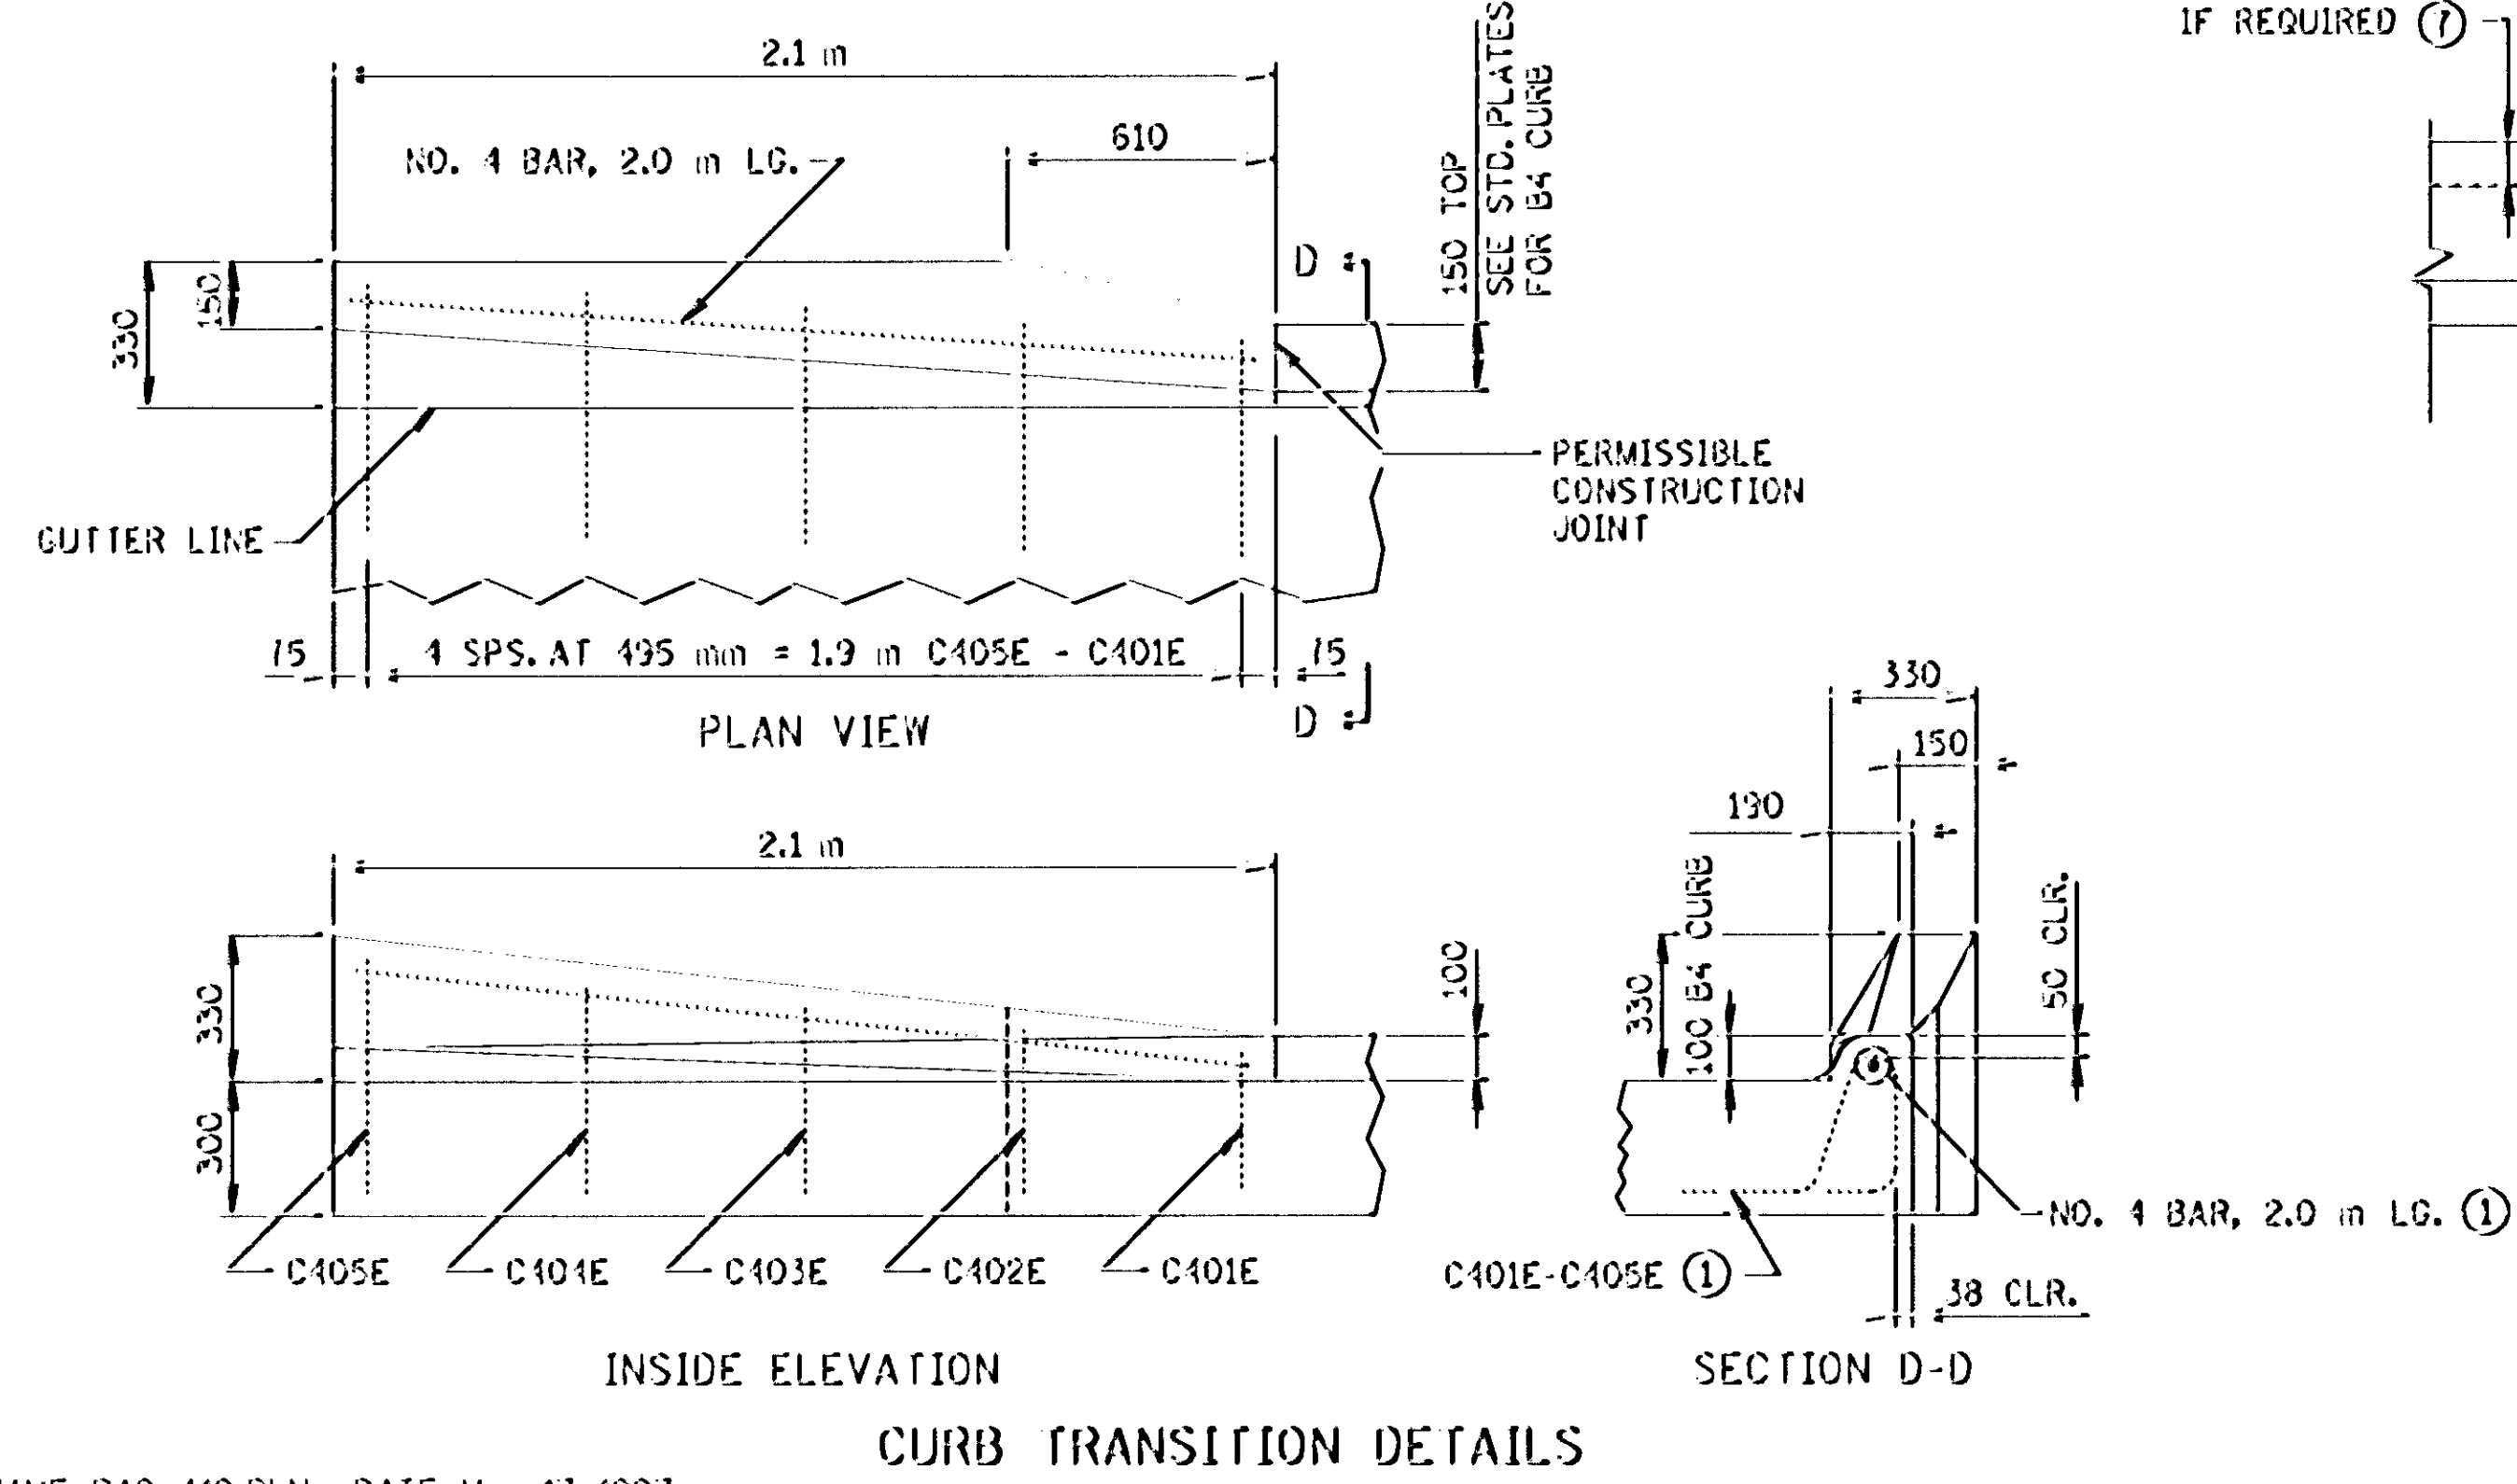


NOTE: ALL DIMENSIONS ARE IN MILLIMETERS, EXCEPT AS NOTED.

STANDARD SHEET NO. 5-297.224M	TITLE BRIDGE APPROACH PANEL WITH OR WITHOUT CONCRETE OVERLAY BITUMINOUS ROADWAY
STANDARD APPROVED: FEBRUARY 24, 1934	
S.A.P. 02-617-11, et al.	SHEET NO. 25 OF 236 SHEETS


SERVER: CAG-51/USR/STANDARDS FILE NAME: SW224854.SPN

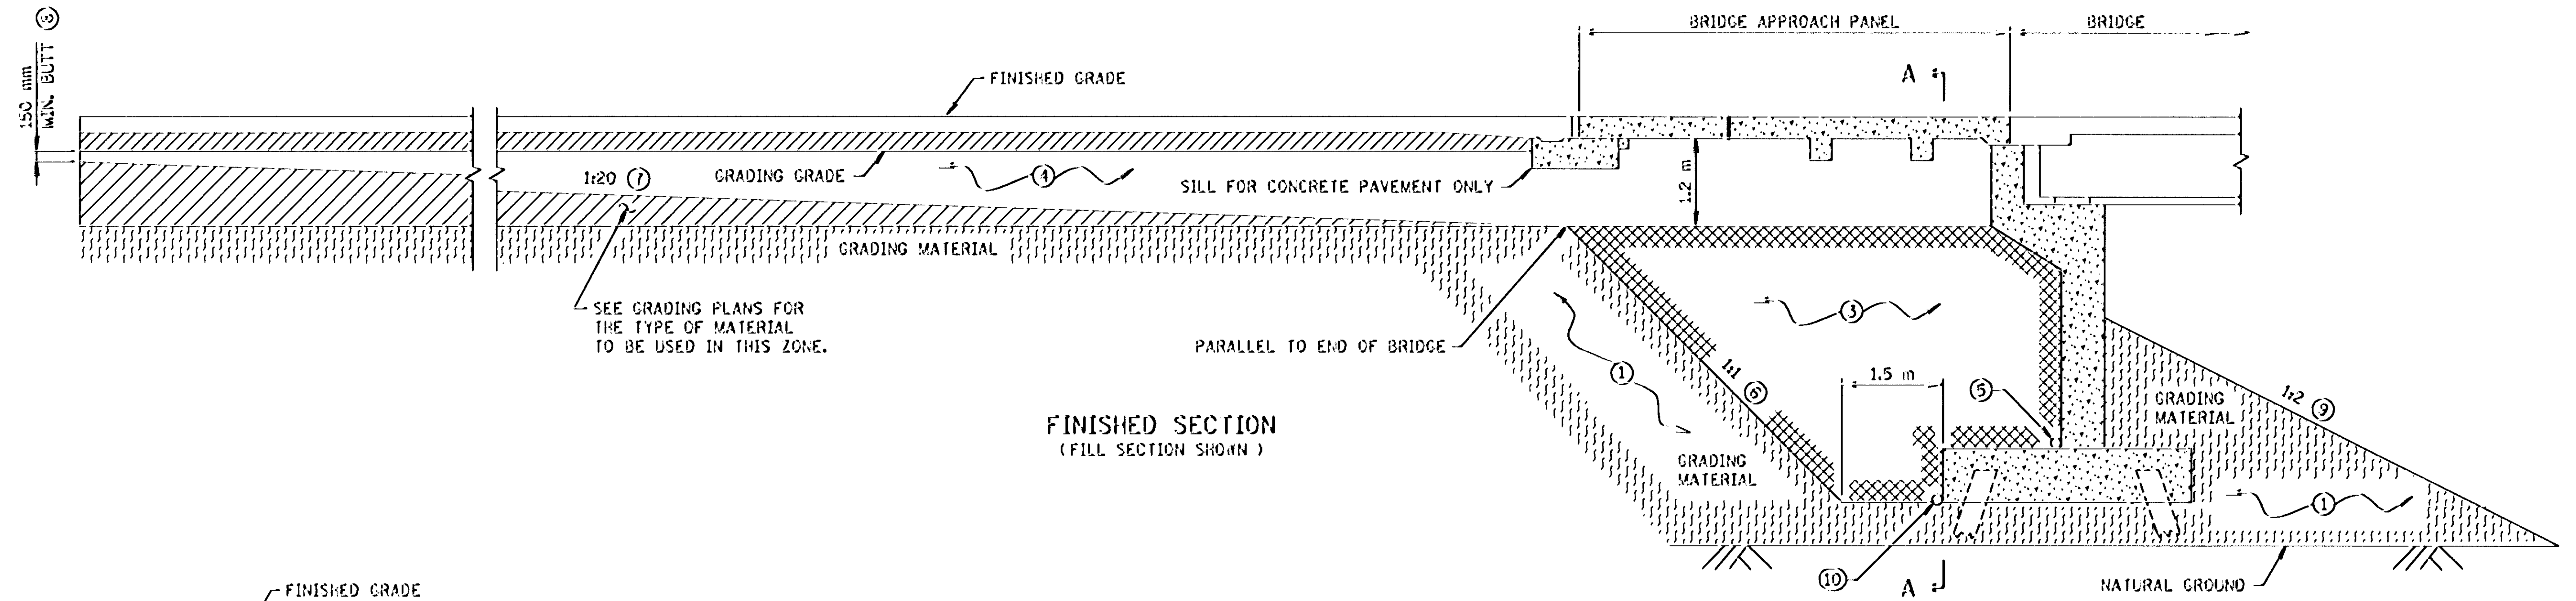


FINISHED SECTION
(FILL SECTION SHOWN)

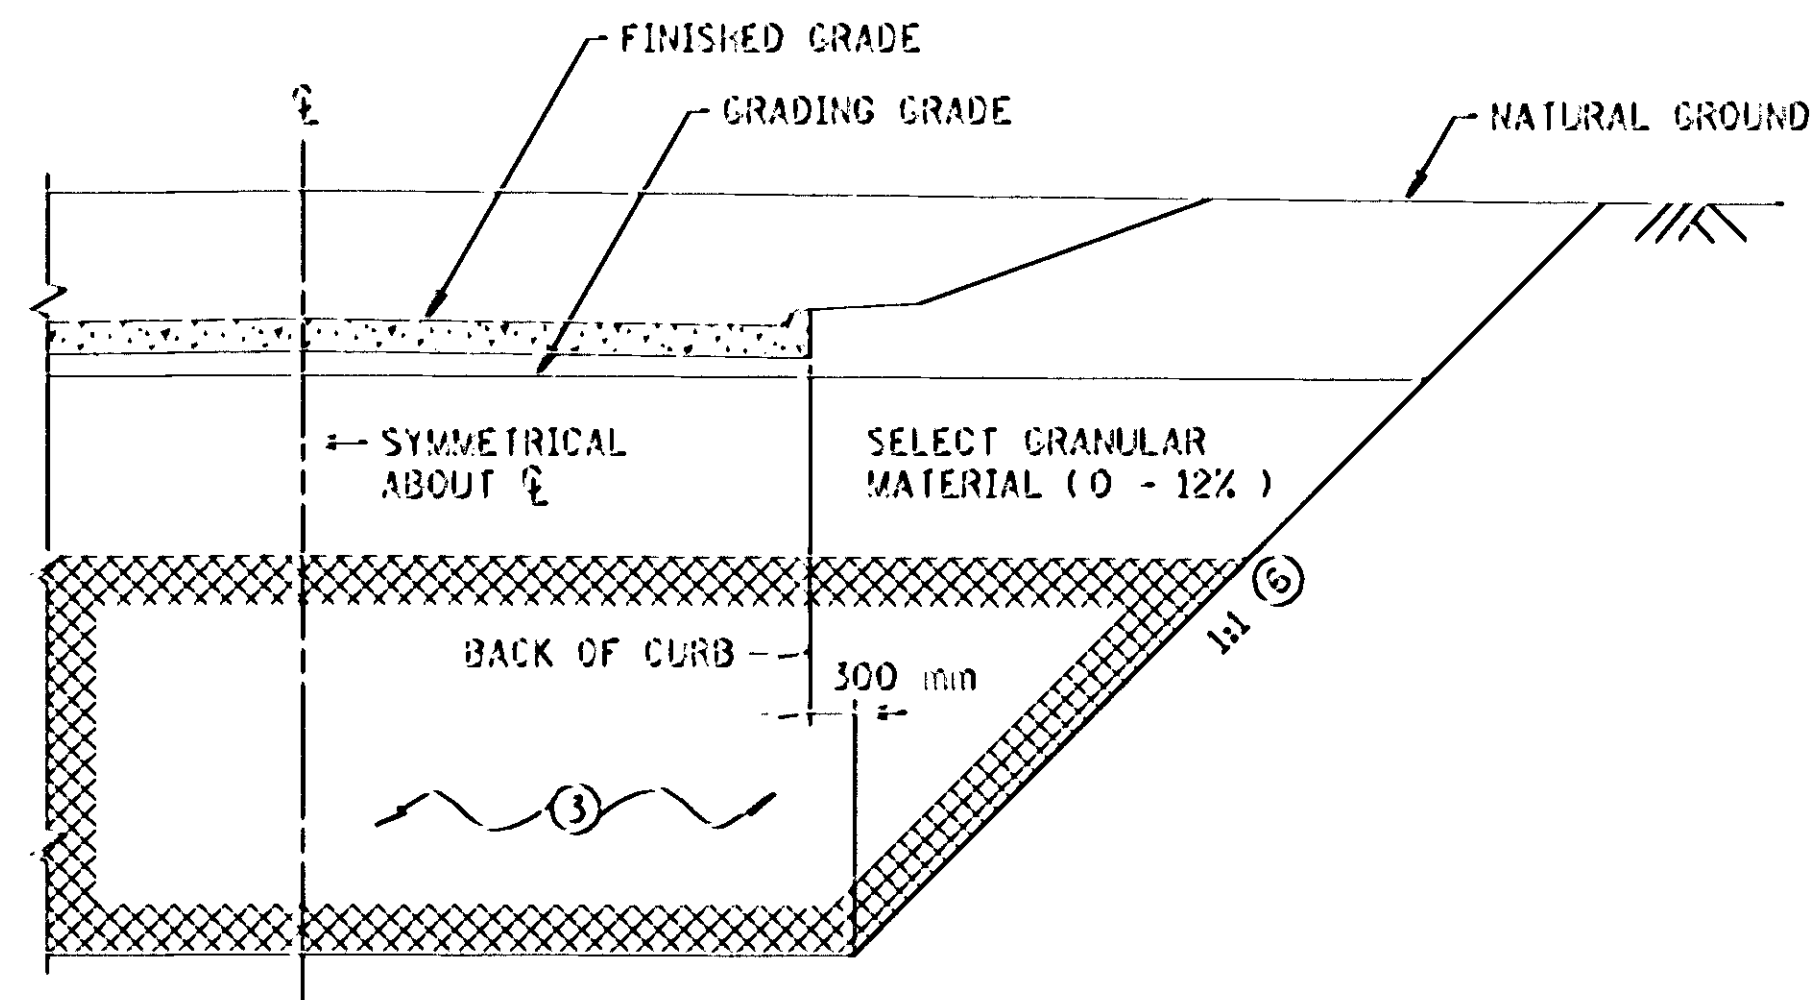

HALF SECTION A-A
(CUT SECTION)

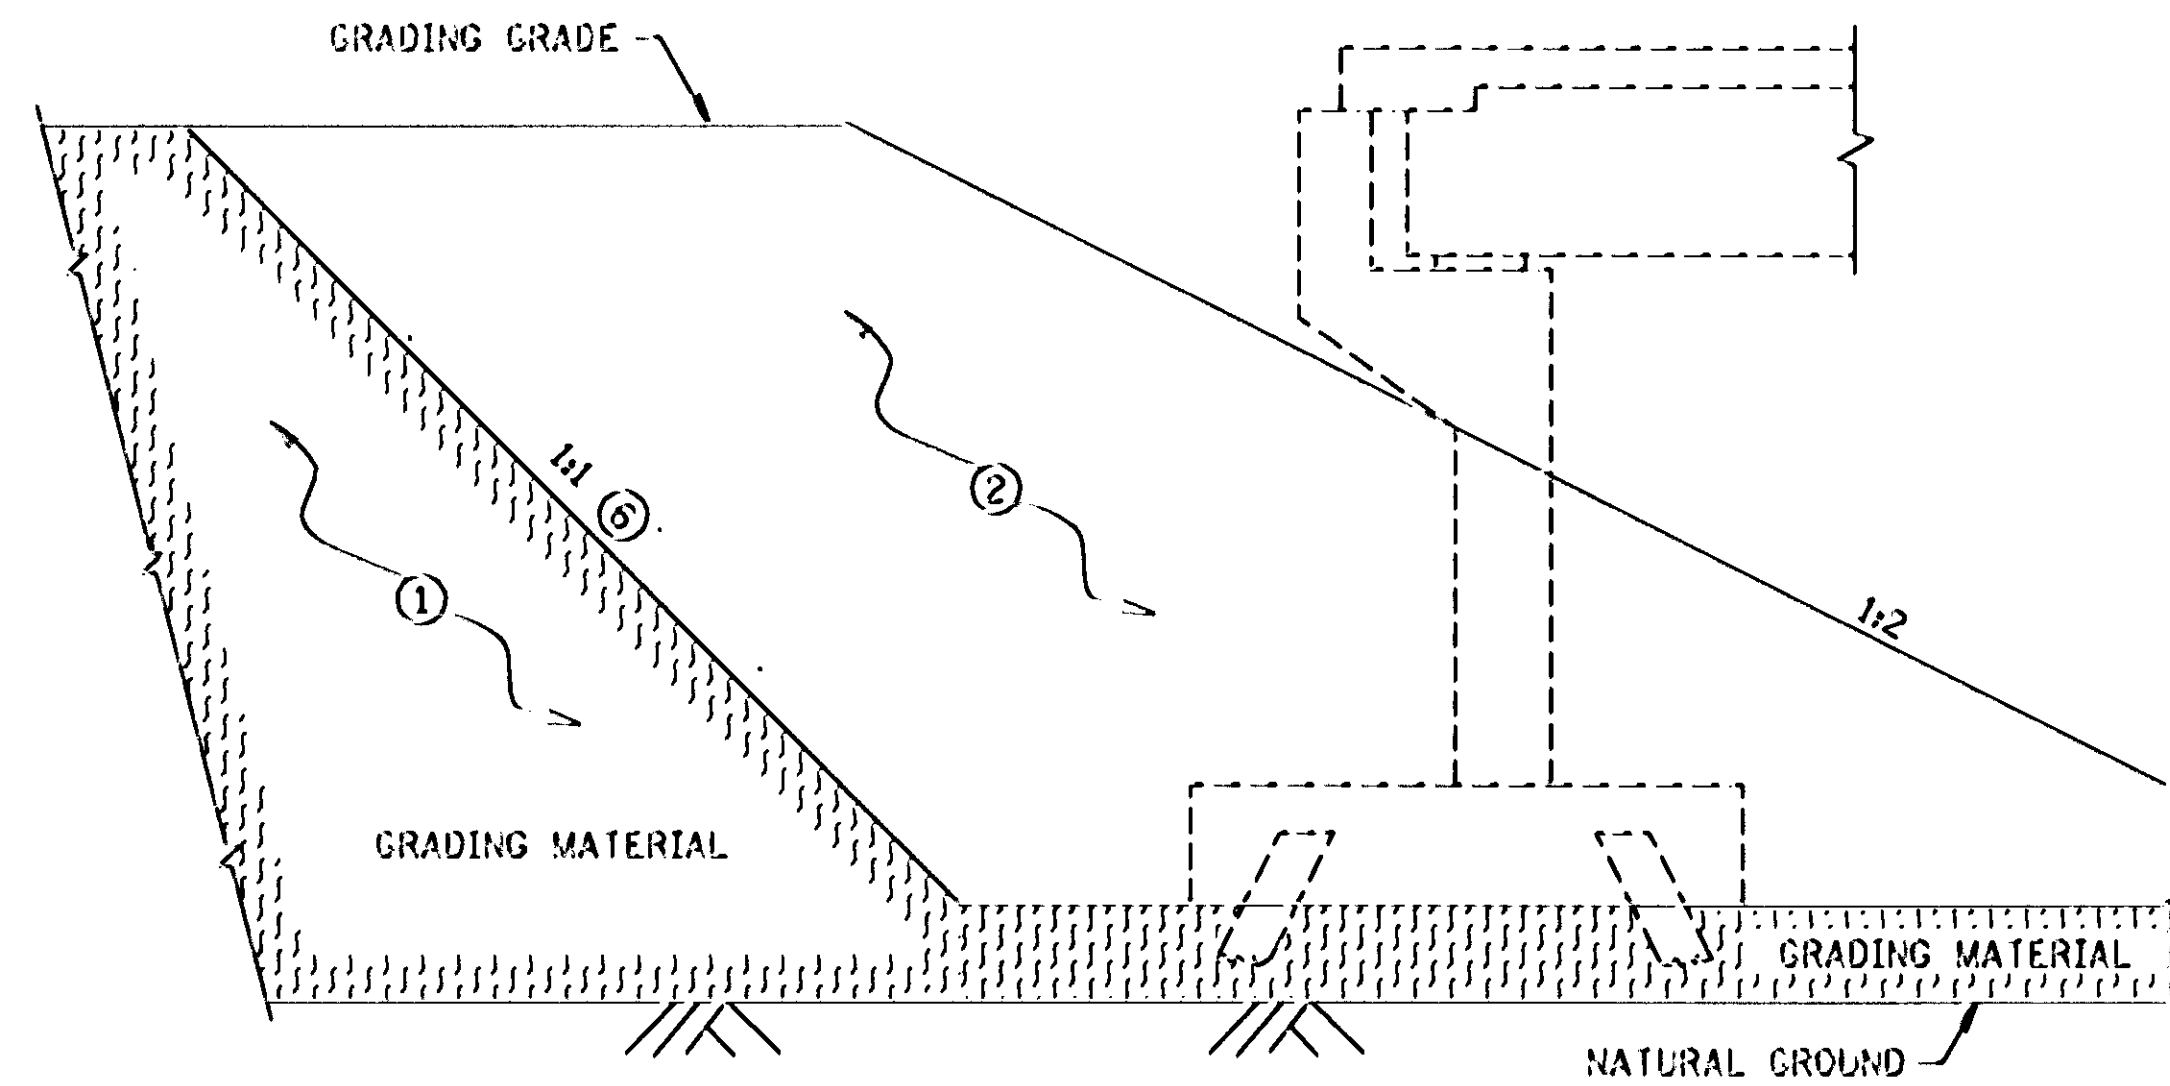

GRADING SECTION AT ABUTMENT

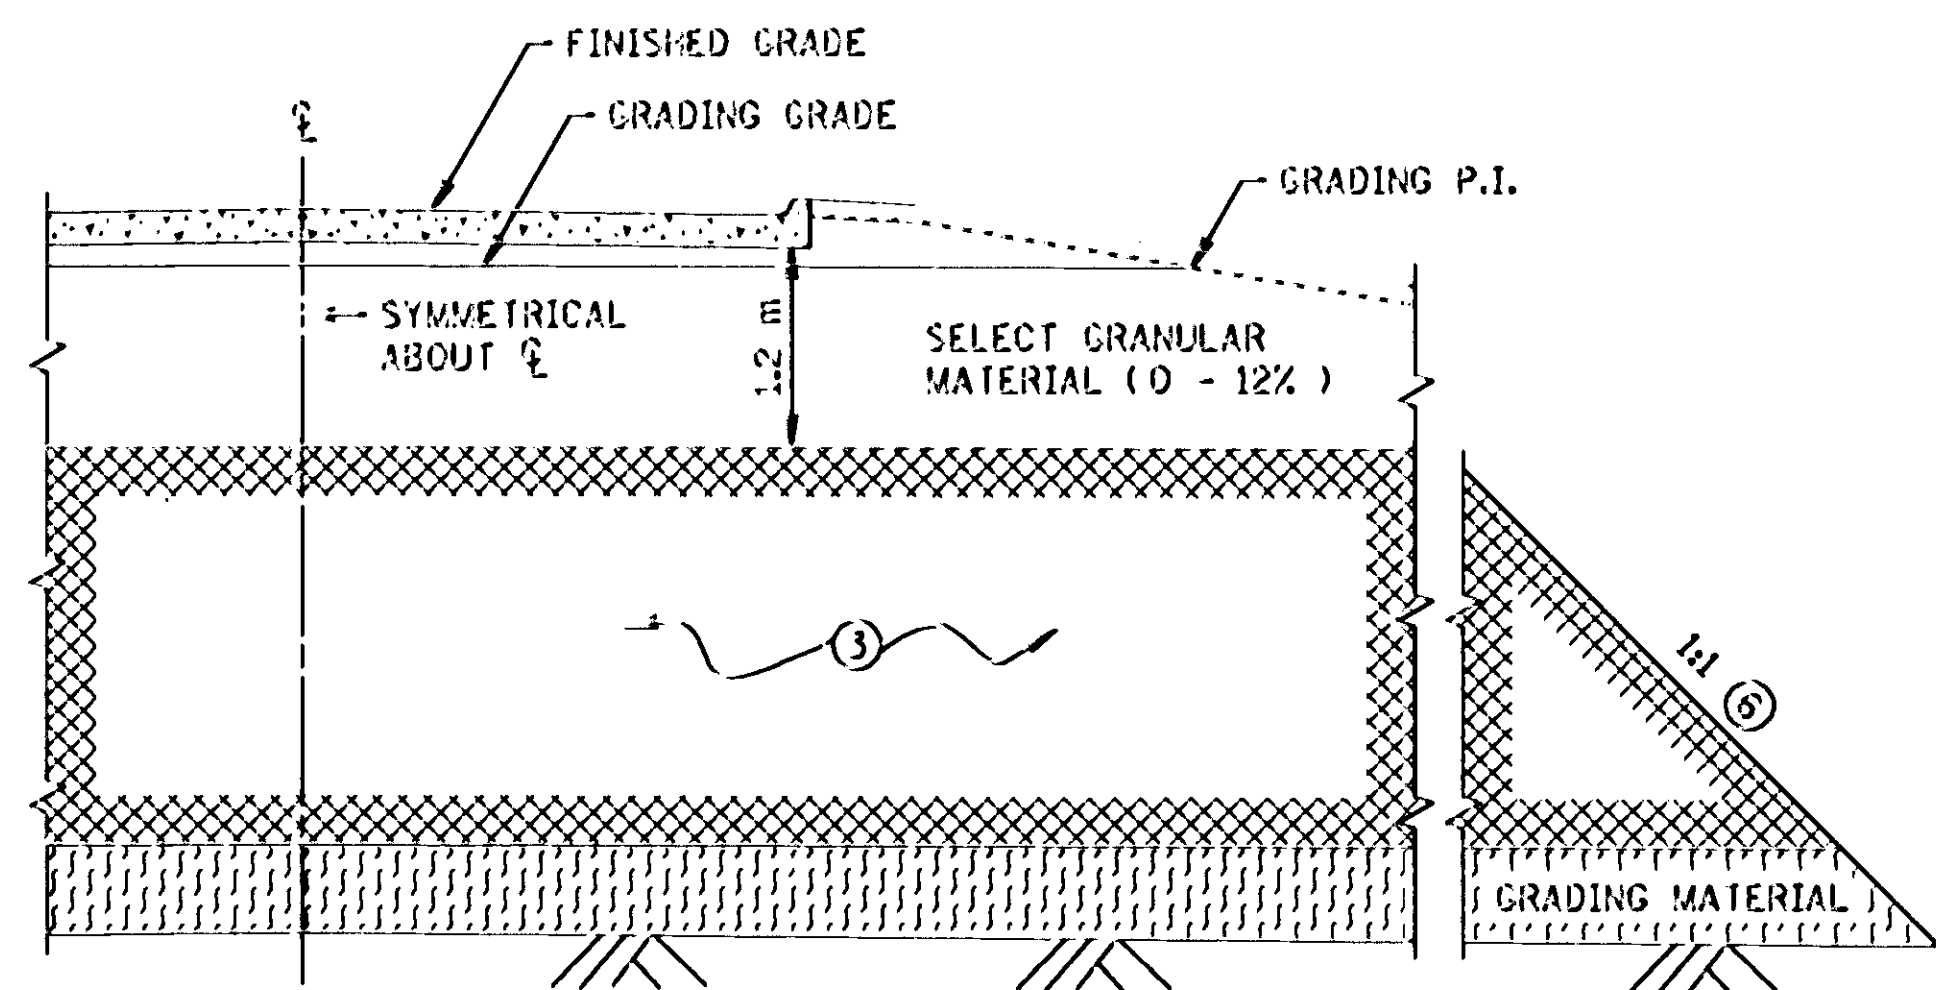

HALF SECTION A-A
(FILL SECTION)

- NOTES:
- ① GRADING MATERIAL PLACED BY THE CONTRACTOR.
 - ② GRADING MATERIAL CONSTRUCTED BY THE CONTRACTOR PRIOR TO THE BRIDGE CONSTRUCTION. TO BE REMOVED LATER BY THE CONTRACTOR.
 - ③ SELECT GRANULAR MATERIAL MODIFIED SHALL COMPLY WITH SPEC. 3149.2B, MODIFIED TO 10% OR LESS PASSING THE NUMBER 15 μ m SIEVE. MATERIAL SHALL BE PLACED BY THE CONTRACTOR AFTER COMPLETION OF THE ABUTMENT.
 - ④ BACKFILL PLACED BY THE CONTRACTOR. MATERIAL SHALL COMPLY WITH SPEC. 3149.2B (SELECT GRANULAR BORROW).
 - ⑤ DRAIN IF REQUIRED. SEE BRIDGE STANDARD DETAIL B910.
 - ⑥ ACTUAL SLOPE TO BE DETERMINED DURING CONSTRUCTION BY THE CONTRACTOR, DEPENDING ON INSITU SOIL PROPERTIES AND/OR SAFETY FACTORS. (USE 1:1 FOR DESIGN)
 - ⑦ START 1:20 TAPER AT END OF APPROACH PANELS ON SKEWED BRIDGES.
 - ⑧ GRADING TO BE SQUARED OFF ON SKEWED APPROACHES.
 - ⑨ SEE BRIDGE PLANS FOR SLOPE PAVING.
 - ⑩ SUBSURFACE PIPE DRAIN WHEN REQUIRED AS DIRECTED BY THE DISTRICT SOILS ENGINEER. 100 mm NOM. DIA. PLASTIC PIPE PER SPEC. 3245 PLACED BY THE CONTRACTOR. PERFORATED PIPE TO BE WRAPPED WITH GEOTEXTILE MEETING THE REQUIREMENTS OF SPEC. 3733 TYPE 1. FOUNDATION SHALL BE SHAPED TO FIT LOWER ONE THIRD CIRCUMFERENCE OF PIPE.

STANDARD SHEET NO.
5-297.225M
STANDARD APPROVED:
AUGUST 4, 1992

TITLE:
BRIDGE APPROACH TREATMENT
FOR BOTH HIGH AND LOW ABUTMENTS ON PILING

V DETOUR TRAFFIC SIGN TABULATION				
SIGN LEGEND	SIGN DESIGNATION	SIGN SIZE	SIGN COLOR	QUANTITY
	M1-1	24"x24"	WHITE ON RED, BLUE	2
	M1-6	24"x24"	WHITE AND YELLOW ON BLUE	24
	M3-1	24"x12"	BLACK ON WHITE	9
	M3-3	24"x12"	BLACK ON WHITE	12
	M4-5A	24"x12"	WHITE ON BLUE	2
	M4-8	24"x12"	BLACK ON ORANGE	22
	M4-8A	24"x18"	BLACK ON ORANGE	2
	M5-1R	21"x15"	BLACK ON WHITE	2
	M5-1L	21"x15"	BLACK ON WHITE	1
	M5-1AR	21"x15"	WHITE ON BLUE	1
	M6-1	21"x15"	BLACK ON WHITE	7
	M6-3	21"x15"	BLACK ON WHITE	11
	M6-3A	21"x15"	WHITE ON BLUE	1
	R1-1	36"x36"	WHITE ON RED	2
	R1-4	18"x6"	WHITE ON RED	3
	Y3-1A	36"x36"	BLACK, RED, WHITE ON ORANGE	1
	SPECIAL-2	174"x108"	BLACK ON ORANGE	2
	SPECIAL-3	102"x36"	BLACK ON ORANGE	1
	SPECIAL-4	174"x90"	BLACK ON ORANGE	1

V DETOUR TRAFFIC SIGN TABULATION				
SIGN LEGEND	SIGN DESIGNATION	SIGN SIZE	SIGN COLOR	QUANTITY
	SPECIAL-5	174"x114"	BLACK ON ORANGE	2
	SPECIAL-6	24"x18"	BLACK ON ORANGE	23
	SPECIAL-7	216"x23"	BLACK ON ORANGE	4
	SPECIAL-8	78"x16"	BLACK ON ORANGE	1
	SPECIAL-9	90"x24"	BLACK ON ORANGE	2
	SPECIAL-10	120"x42"	BLACK ON ORANGE	2
	G20-X2 (A)	132"x108"	BLACK ON ORANGE	2
	G20-X2 (B)	132"x108"	BLACK ON ORANGE	2
	G20-X1 (A)	84"x60"	BLACK ON ORANGE	4
	G20-X1 (B)	84"x60"	BLACK ON ORANGE	2

GENERAL TRAFFIC CONTROL NOTES:

ALL TRAFFIC CONTROL DEVICES SHALL CONFORM TO REQUIREMENTS OF THE MINNESOTA MANUAL ON UNIFORM TRAFFIC CONTROL DEVICES INCLUDING THE FIELD MANUAL FOR TEMPORARY TRAFFIC CONTROL ZONE LAYOUTS DATED APRIL 1995.

THE CONTRACTOR SHALL FURNISH, INSTALL, MAINTAIN AND REMOVE, AS APPROPRIATE, ALL SIGNS SHOWN ON THESE PLANS TO THE SATISFACTION OF THE ENGINEER.

THE CONTRACTOR SHALL REMOVE, SALVAGE, OR COVER AS APPROPRIATE, ALL EXISTING SIGNING WHICH CONFLICTS WITH THIS TRAFFIC CONTROL PLAN TO THE SATISFACTION OF THE ENGINEER. THE CONTRACTOR SHALL RESTORE ALL APPROPRIATE ORIGINAL SIGNING WHEN AND AS DIRECTED BY THE ENGINEER.


THE LOCATIONS AND QUANTITIES OF TRAFFIC CONTROL DEVICES SHOWN ON THESE PLANS ARE APPROXIMATE AND ARE SUBJECT TO REVISION BY THE ENGINEER.

THESE DETOUR LAYOUTS DO NOT SHOW ALL INPLACE SIGNING. CONTRACTOR SHALL RELOCATE ALL APPROPRIATE INPLACE SIGNING TO MAINTAIN PROPER SIGN VISIBILITY DURING CONSTRUCTION AS DEEMED NECESSARY BY THE ENGINEER.

"SPECIAL-1" NOT USED

- ① CONTRACTOR SHALL PLACE SIX G20-X1 SIGNS (BLACK ON ORANGE) ONE WEEK IN ADVANCE OF PLACEMENT OF DETOUR. INSTALL G20-X1(a) AT RAMP AND G20-X1(b) ON C.S.A.H. 17 AT BALL ROAD AND 109TH AVE.
- ② THIS SIGN OWNED BY MINNESOTA LOGOS 201 W. TRAVELERS TRAIL SUITE 230 BURNSVILLE MN. 55337 PHONE 895-8499 CONTRACTOR SHALL CONTACT OWNER OF SIGN TO COVER SIGN AS PART OF TRAFFIC CONTROL DETOUR PLAN.
- ③ SIGN PANEL OVERLAY TO BE MOUNTED ON EXISTING TYPE A SIGN. EXISTING SIGN PANEL HAS OVERLAY IN PLACE.
- ④ "Lexington Ave." LETTERS SHALL BE 13.3"-10" SERIES E-MOD. ALL OTHER LETTERS SHALL BE 10" SERIES E.
- ⑤ LETTERS SHALL BE 4", SERIES E.
- ⑥ LETTERS SHALL BE 8"-6" SERIES E-MOD.
- ⑦ LETTERS SHALL BE 10.67"-8", SERIES E-MOD.
- ⑧ LETTERS SHALL BE 12", SERIES E.
- ⑨ LETTERS SHALL BE 16", SERIES E-MOD.
- ⑩ LETTERS SHALL BE 10" SERIES E.


1	3-26-97	MCI	DAD	ALL WAY STOP AT W. 95TH RAMPS
NO	DATE	BY	CHKD	APPR
NAME: DPN 410-PLN	DATE: Mar. 13, 1997			REVISION

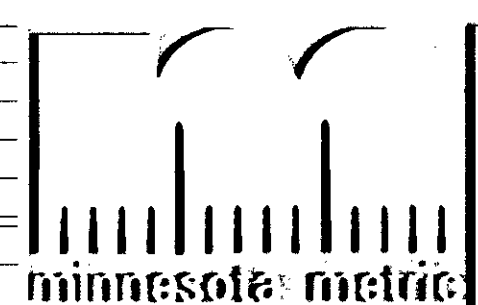

I hereby certify that this plan, specification or report was prepared by me or under my direct supervision and that I am a duly Registered Professional Engineer under the laws of the State of Minnesota.
Dennis A. Demers
 Date 3-21-97 Reg. No. 23397


STATE AID PROJECT NO. S.A.P. 02-617-11 S.A.P. 106-020-12 S.A.P. 106-030-03
 CO. PROJECT NO.

DRAWN BY DATE M. ISAKKA 12-96
 DESIGNED BY D. DEMERS 12-96
 CHECKED BY D. DEMERS 1-97
 COMM. NO. 0962410

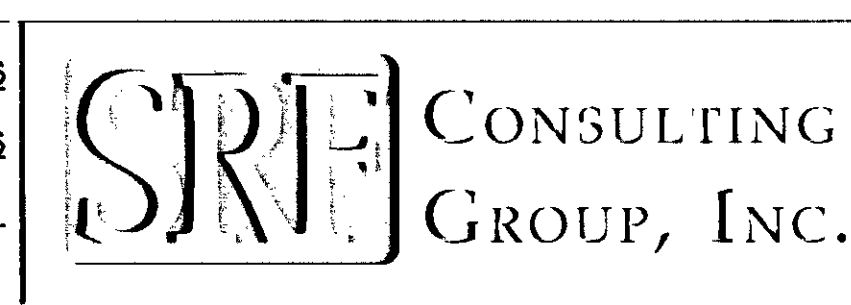

ANOKA COUNTY
 DETOUR SIGN TABULATION AND GENERAL NOTES
 C.S.A.H. 17 RECONSTRUCTION


SHEET 27 OF 236

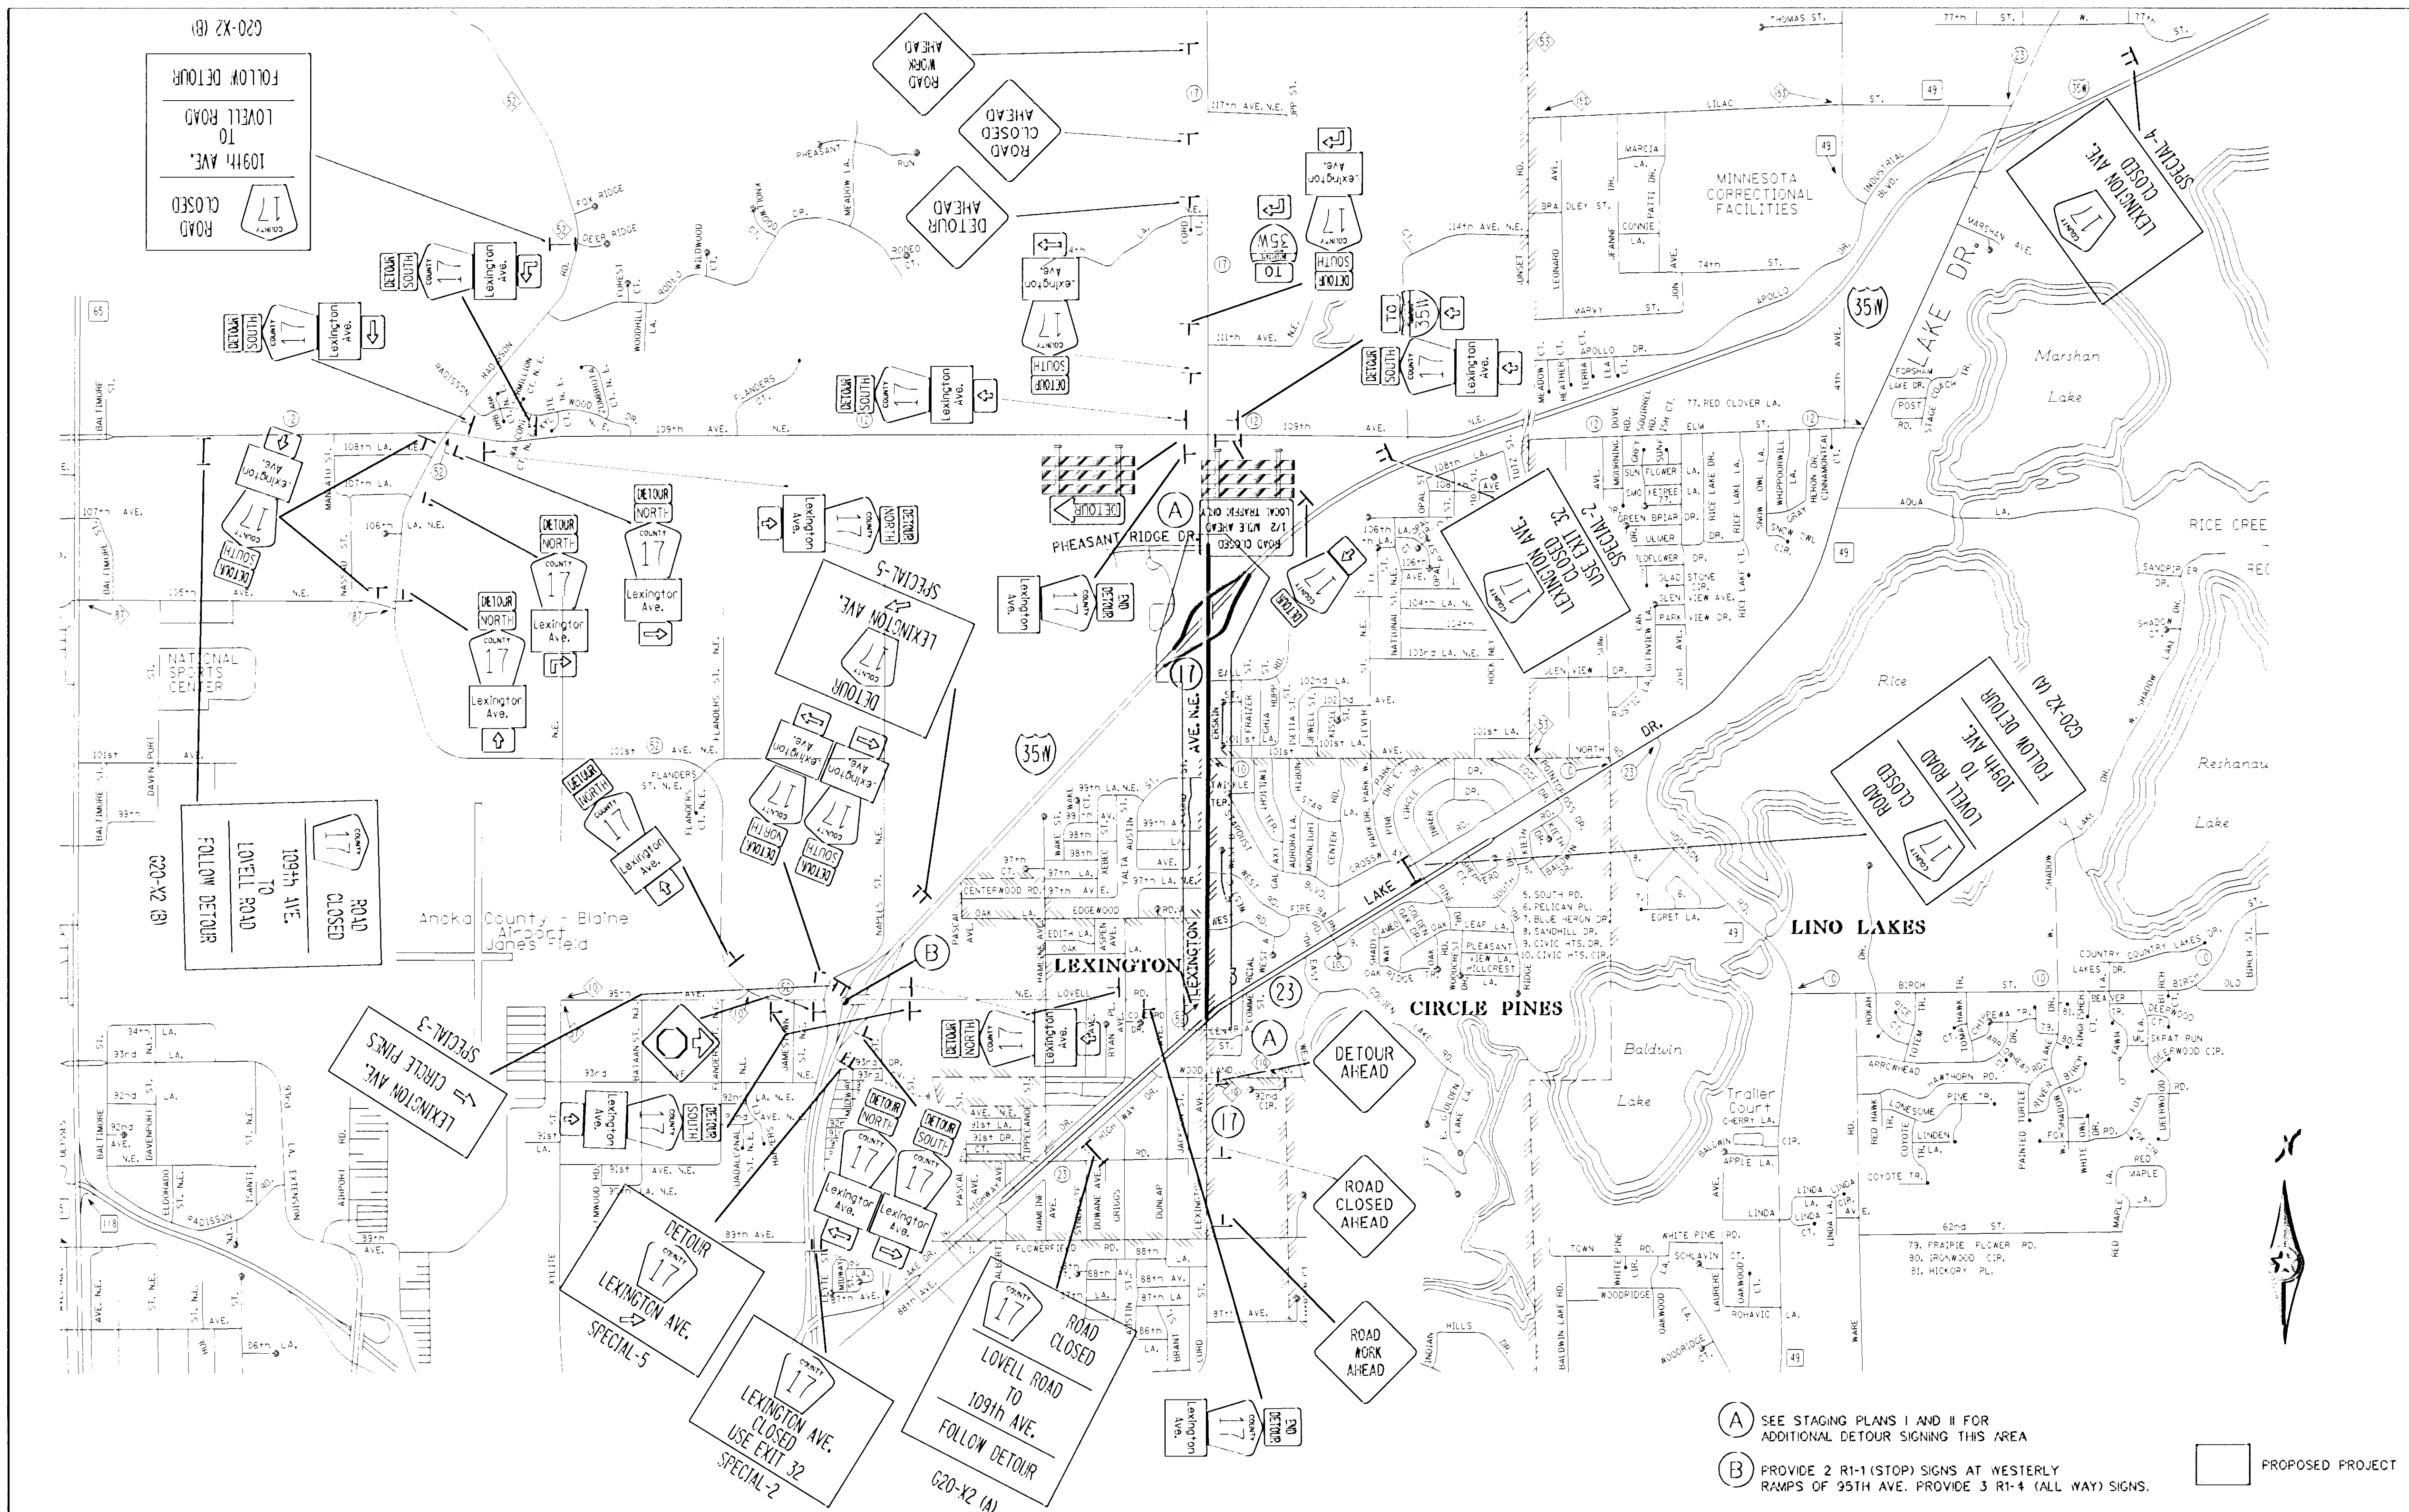

- (A) SEE STAGING PLANS I AND II FOR ADDITIONAL DETOUR SIGNING THIS AREA
- (B) PROVIDE 2 R-1 (STOP) SIGNS AT WESTERLY RAMPS OF 95TH AVE. PROVIDE 3 R-4 (ALL WAY) SIGNS.

PROPOSED PROJECT

1	3-26-97	MCI	DAD	ADD ALL WAY STOP AT 95TH RAMPS
NO	DATE	BY	CKD	APPR
				REVISION
N:\ME: DP1 410.PLN DATE: Mar. '8, 1997				

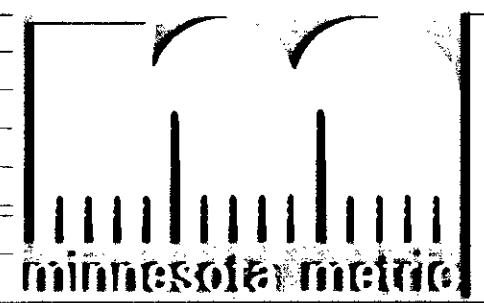

I hereby certify that this plan, specification or report was prepared by me or under my direct supervision and that I am a duly Registered Professional Engineer under the laws of the State of Minnesota.

Donald A. Demers
Date **3-21-97** Reg. No. **23397**

STATE AID PROJECT NO. S.A.P. 02-617-11 S.A.P. 108-020-12 S.A.P. 108-030-03

CO. PROJECT NO.

DRAWN BY M. ISAACKA DATE 12-96

DESIGNED BY D. DEMERS 11-96



CHECKED BY D. DEMERS 1-97

COMM. NO. 0962410



ANOKA COUNTY
DETOUR PLAN
C.S.A.H. 17 RECONSTRUCTION

SHEET
28
OF
236

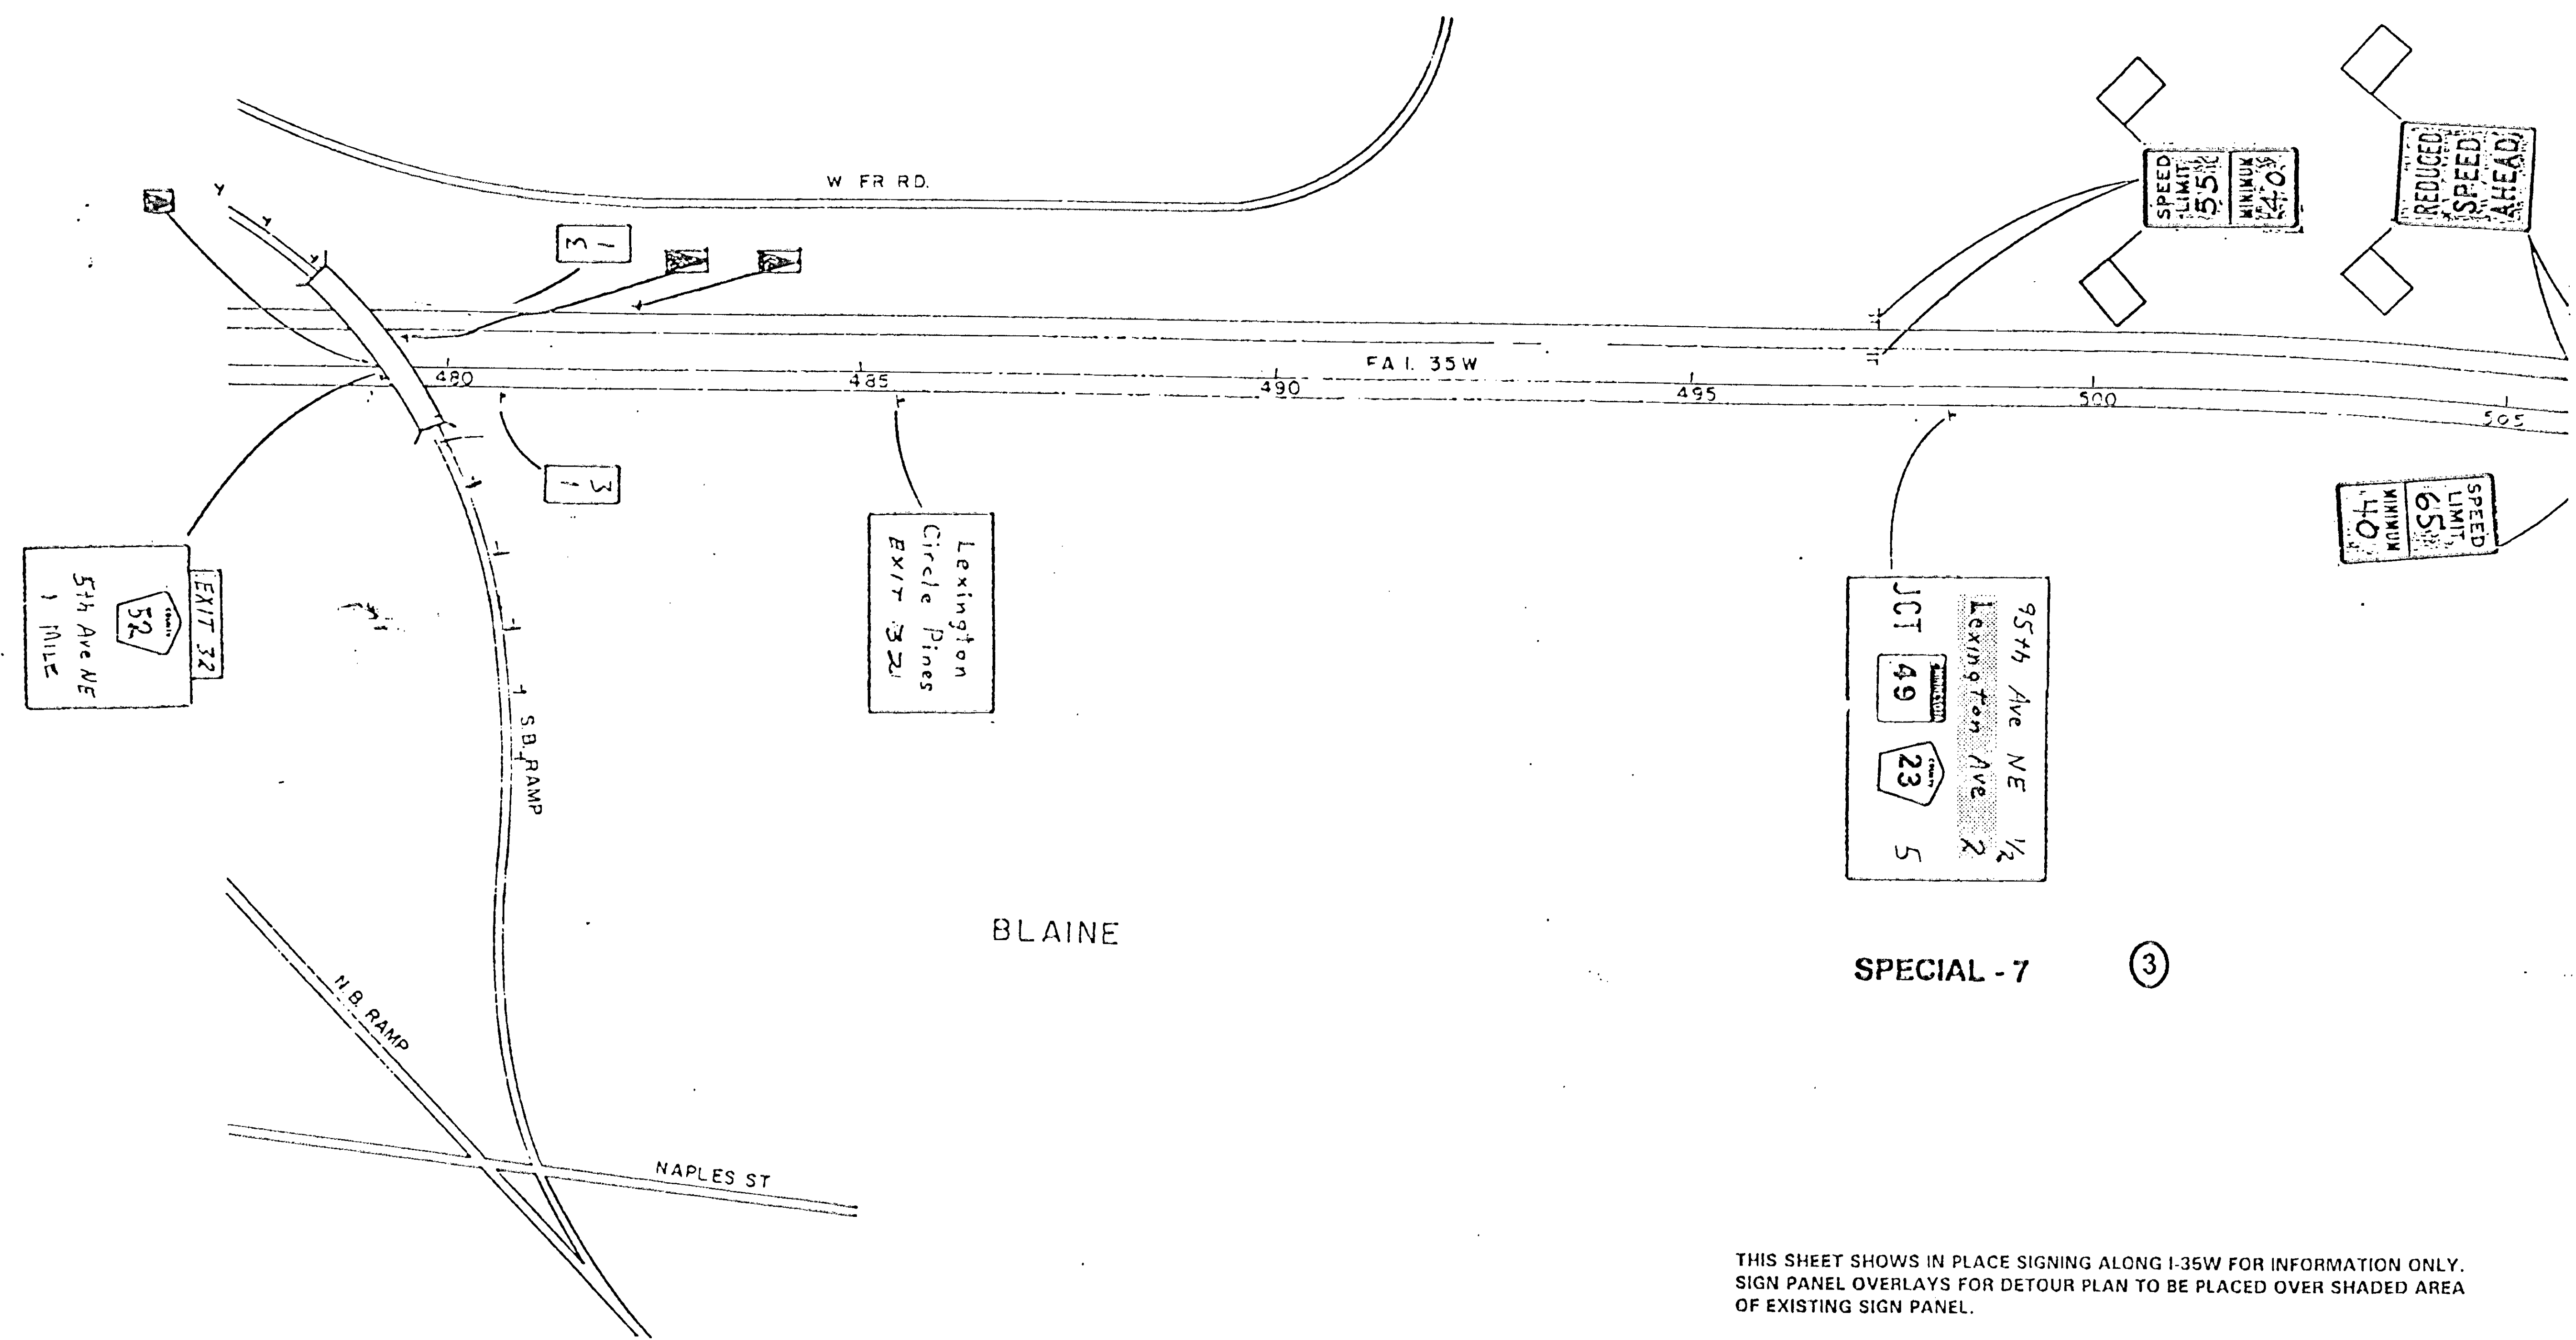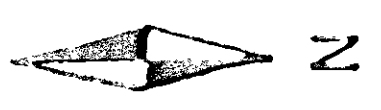


SPECIAL - 7 (3)

THIS SHEET SHOWS IN PLACE SIGNING ALONG I-35W FOR INFORMATION ONLY. SIGN PANEL OVERLAYS FOR DETOUR PLAN TO BE PLACED OVER SHADED AREA OF EXISTING SIGN PANEL.

NO.	DATE	BY	CHKD	APPR	REVISION

NAME: DP2 410 PLN DATE: Mar. 17, 1997

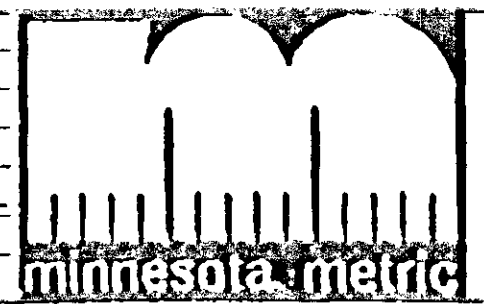

I hereby certify that this plan, specification or report was prepared by me or under my direct supervision and that I am a duly Registered Professional Engineer under the laws of the State of Minnesota.

Daniel A Demers
Date: 3-21-97 Req. No: 23377



STATE AID PROJECT NO.
S.A.P. 02-617-11
S.A.P. 106-020-12
S.A.P. 106-030-03
CO. PROJECT NO.

DRAWN BY: V. GRAF DATE: 12-96
DESIGNED BY: D. DEMERS DATE: 12-96
CHECKED BY: D. DEMERS DATE: 2-97
COMM. NO.: 0962410





ANOKA COUNTY
DETOUR PLAN
C.S.A.H. 17 RECONSTRUCTION

SHEET
29
OF
236

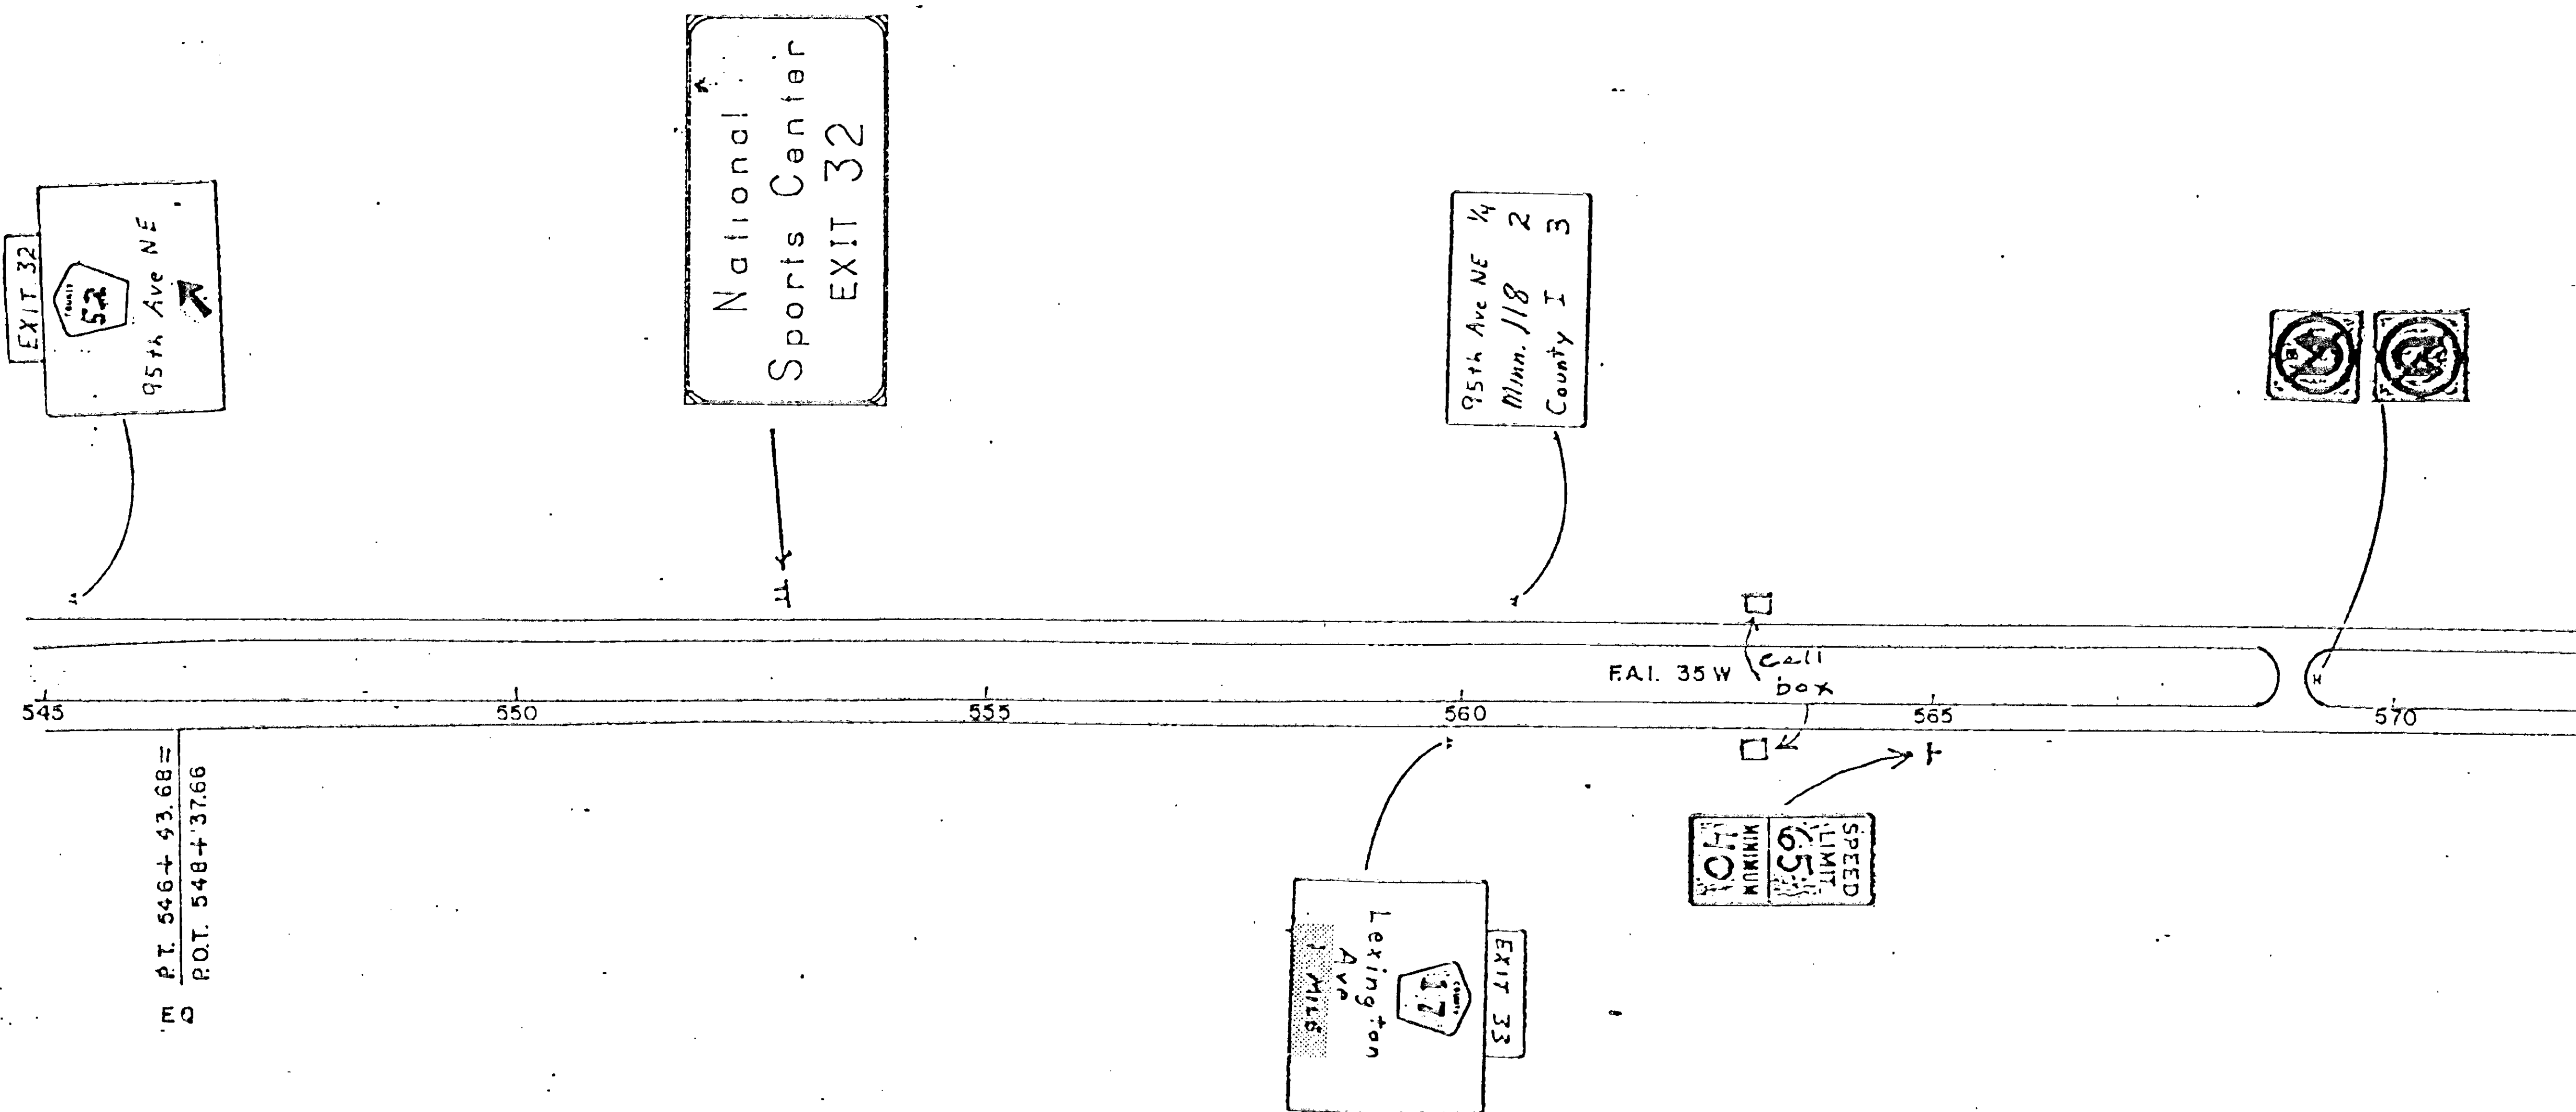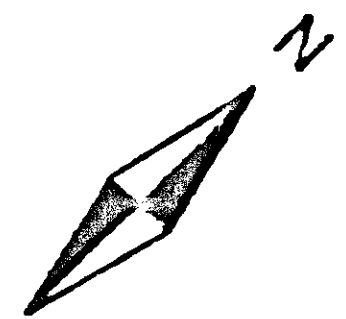

P.T. 546+53.68 =
 P.O.T. 548+37.66
 F.D.

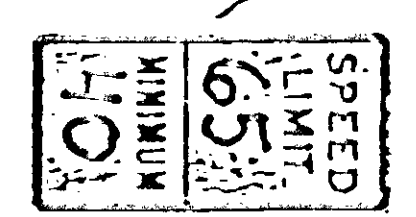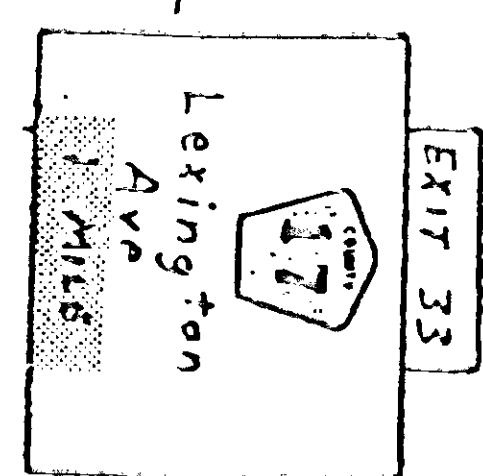


SPECIAL - 9 (3)

THIS SHEET SHOWS IN PLACE SIGNING ALONG I-35W FOR INFORMATION ONLY. SIGN PANEL OVERLAYS FOR DETOUR PLAN TO BE PLACED OVER SHADED AREA OF EXISTING SIGN PANEL.

NO	DATE	BY	CHKD	APPR	REVISION


NAME: DP3 410.PLN DATE: Mar. 17, 1997

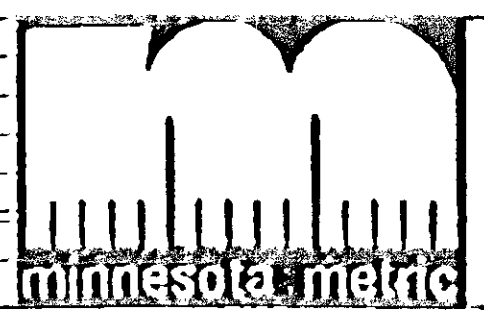

I hereby certify that this plan, specification or report was prepared by me or under my direct supervision and that I am a duly Registered Professional Engineer under the laws of the State of Minnesota.
Donald A. James
 Date 3-21-97 Reg. No. 23397


STATE AID PROJECT NO.
 S.A.P. 02-617-11
 S.A.P. 106-020-12
 S.A.P. 106-030-02
 CO. PROJECT NO.

DRAWN BY V. GRAF DATE 12-96
 DESIGNED BY D. DEMERS 12-96
 CHECKED BY D. DEMERS 2-97
 COMM. NO. 0962410

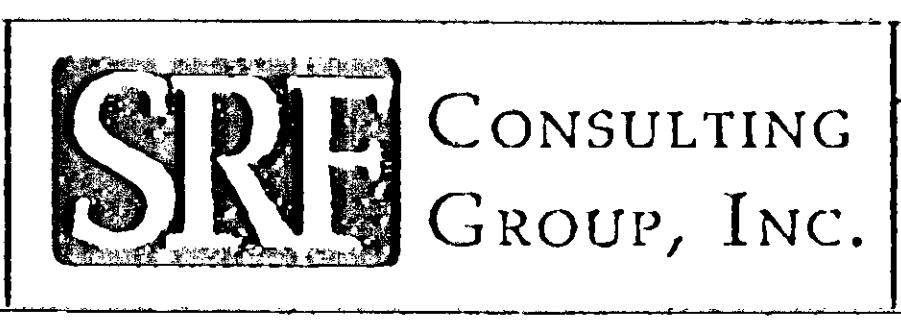

ANOKA COUNTY
 DETOUR PLAN
 C.S.A.H. 17 RECONSTRUCTION

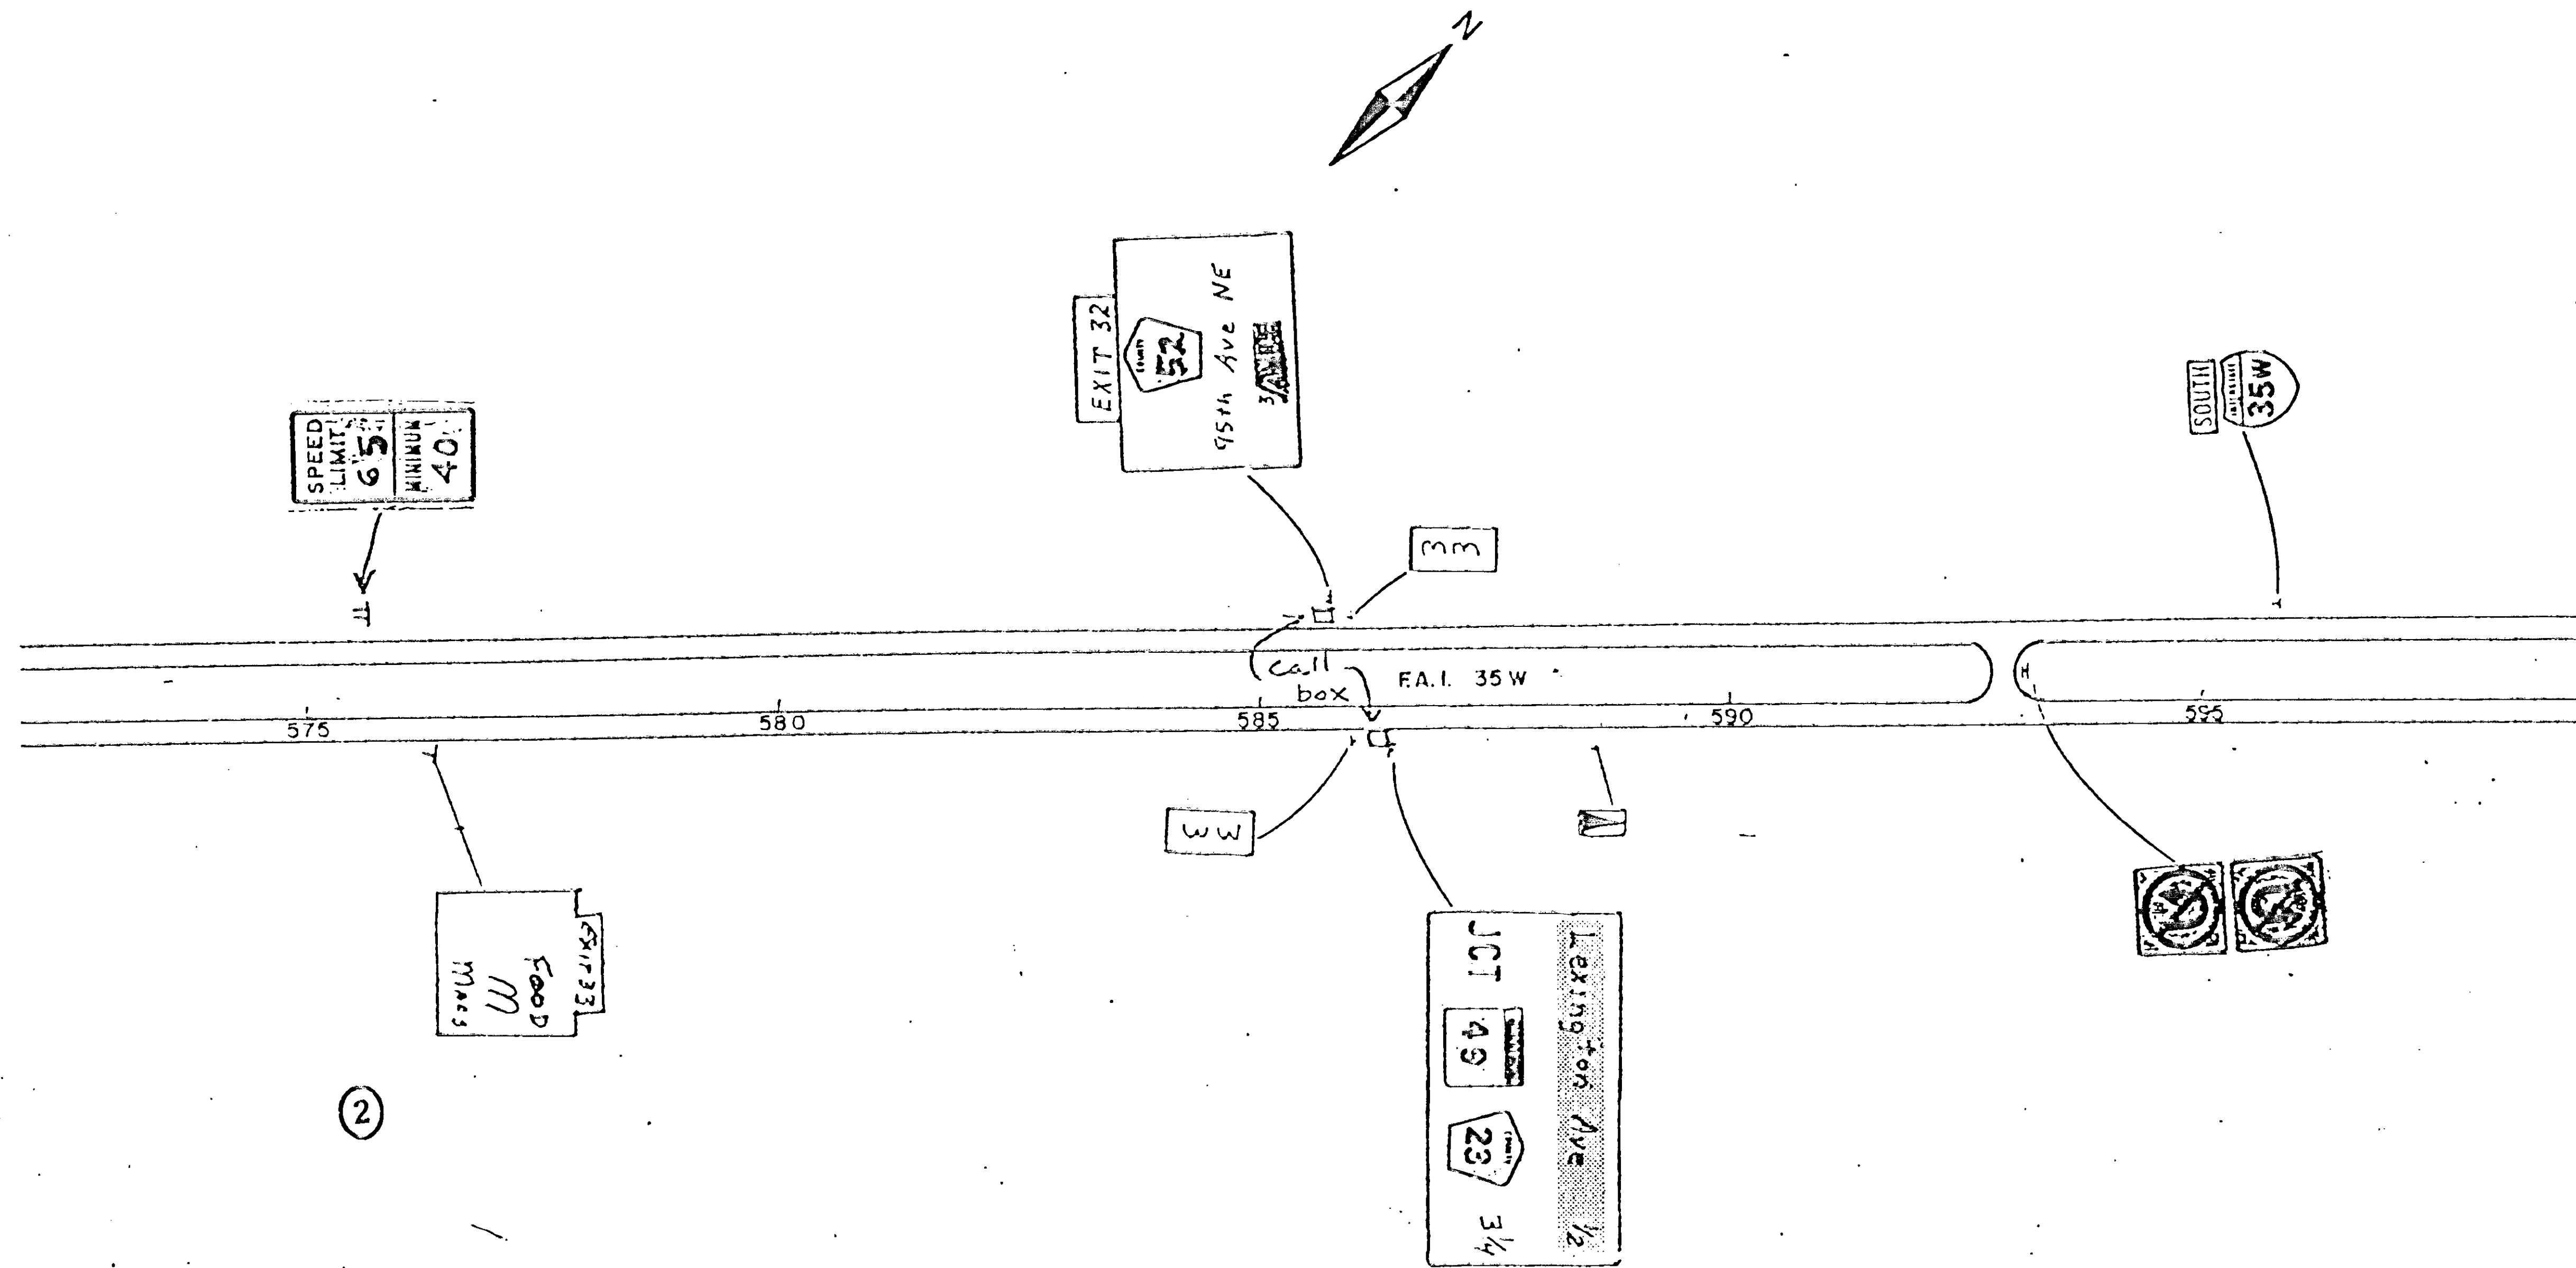

SHEET 30 OF 236




②

SPECIAL - 7 ③

THIS SHEET SHOWS IN PLACE SIGNING ALONG I-35W FOR INFORMATION ONLY. SIGN PANEL OVERLAYS FOR DETOUR PLAN TO BE PLACED OVER SHADED AREA OF EXISTING SIGN PANEL.

<table border="1"> <tr> <th>NO</th> <th>DATE</th> <th>BY</th> <th>CRD</th> <th>APPR</th> <th>REVISION</th> </tr> <tr> <td> </td> <td> </td> <td> </td> <td> </td> <td> </td> <td> </td> </tr> </table>				NO	DATE	BY	CRD	APPR	REVISION								I hereby certify that this plan, specification or report was prepared by me or under my direct supervision and that I am a duly Registered Professional Engineer under the laws of the State of Minnesota. <i>Donald A. Jensen</i> Date <u>3-21-97</u> Reg. No. <u>23397</u>	STATE AID PROJECT NO. S.A.P. 02-617-11 S.A.P. 106-020-12 S.A.P. 106-030-03 CO. PROJECT NO.	DRAWN BY V. GRAF DATE 12-96 DESIGNED BY D. DEMERS DATE 12-96 CHECKED BY D. DEMERS DATE 2-97 COMM. NO. 0262410	 CONSULTING GROUP, INC.	ANOKA COUNTY DETOUR PLAN C.S.A.H. 17 RECONSTRUCTION		SHEET 31 OF 236
NO	DATE	BY	CRD	APPR	REVISION																		
NAME: DP4 410 PLN DATE: Mar. 17, 1997																							

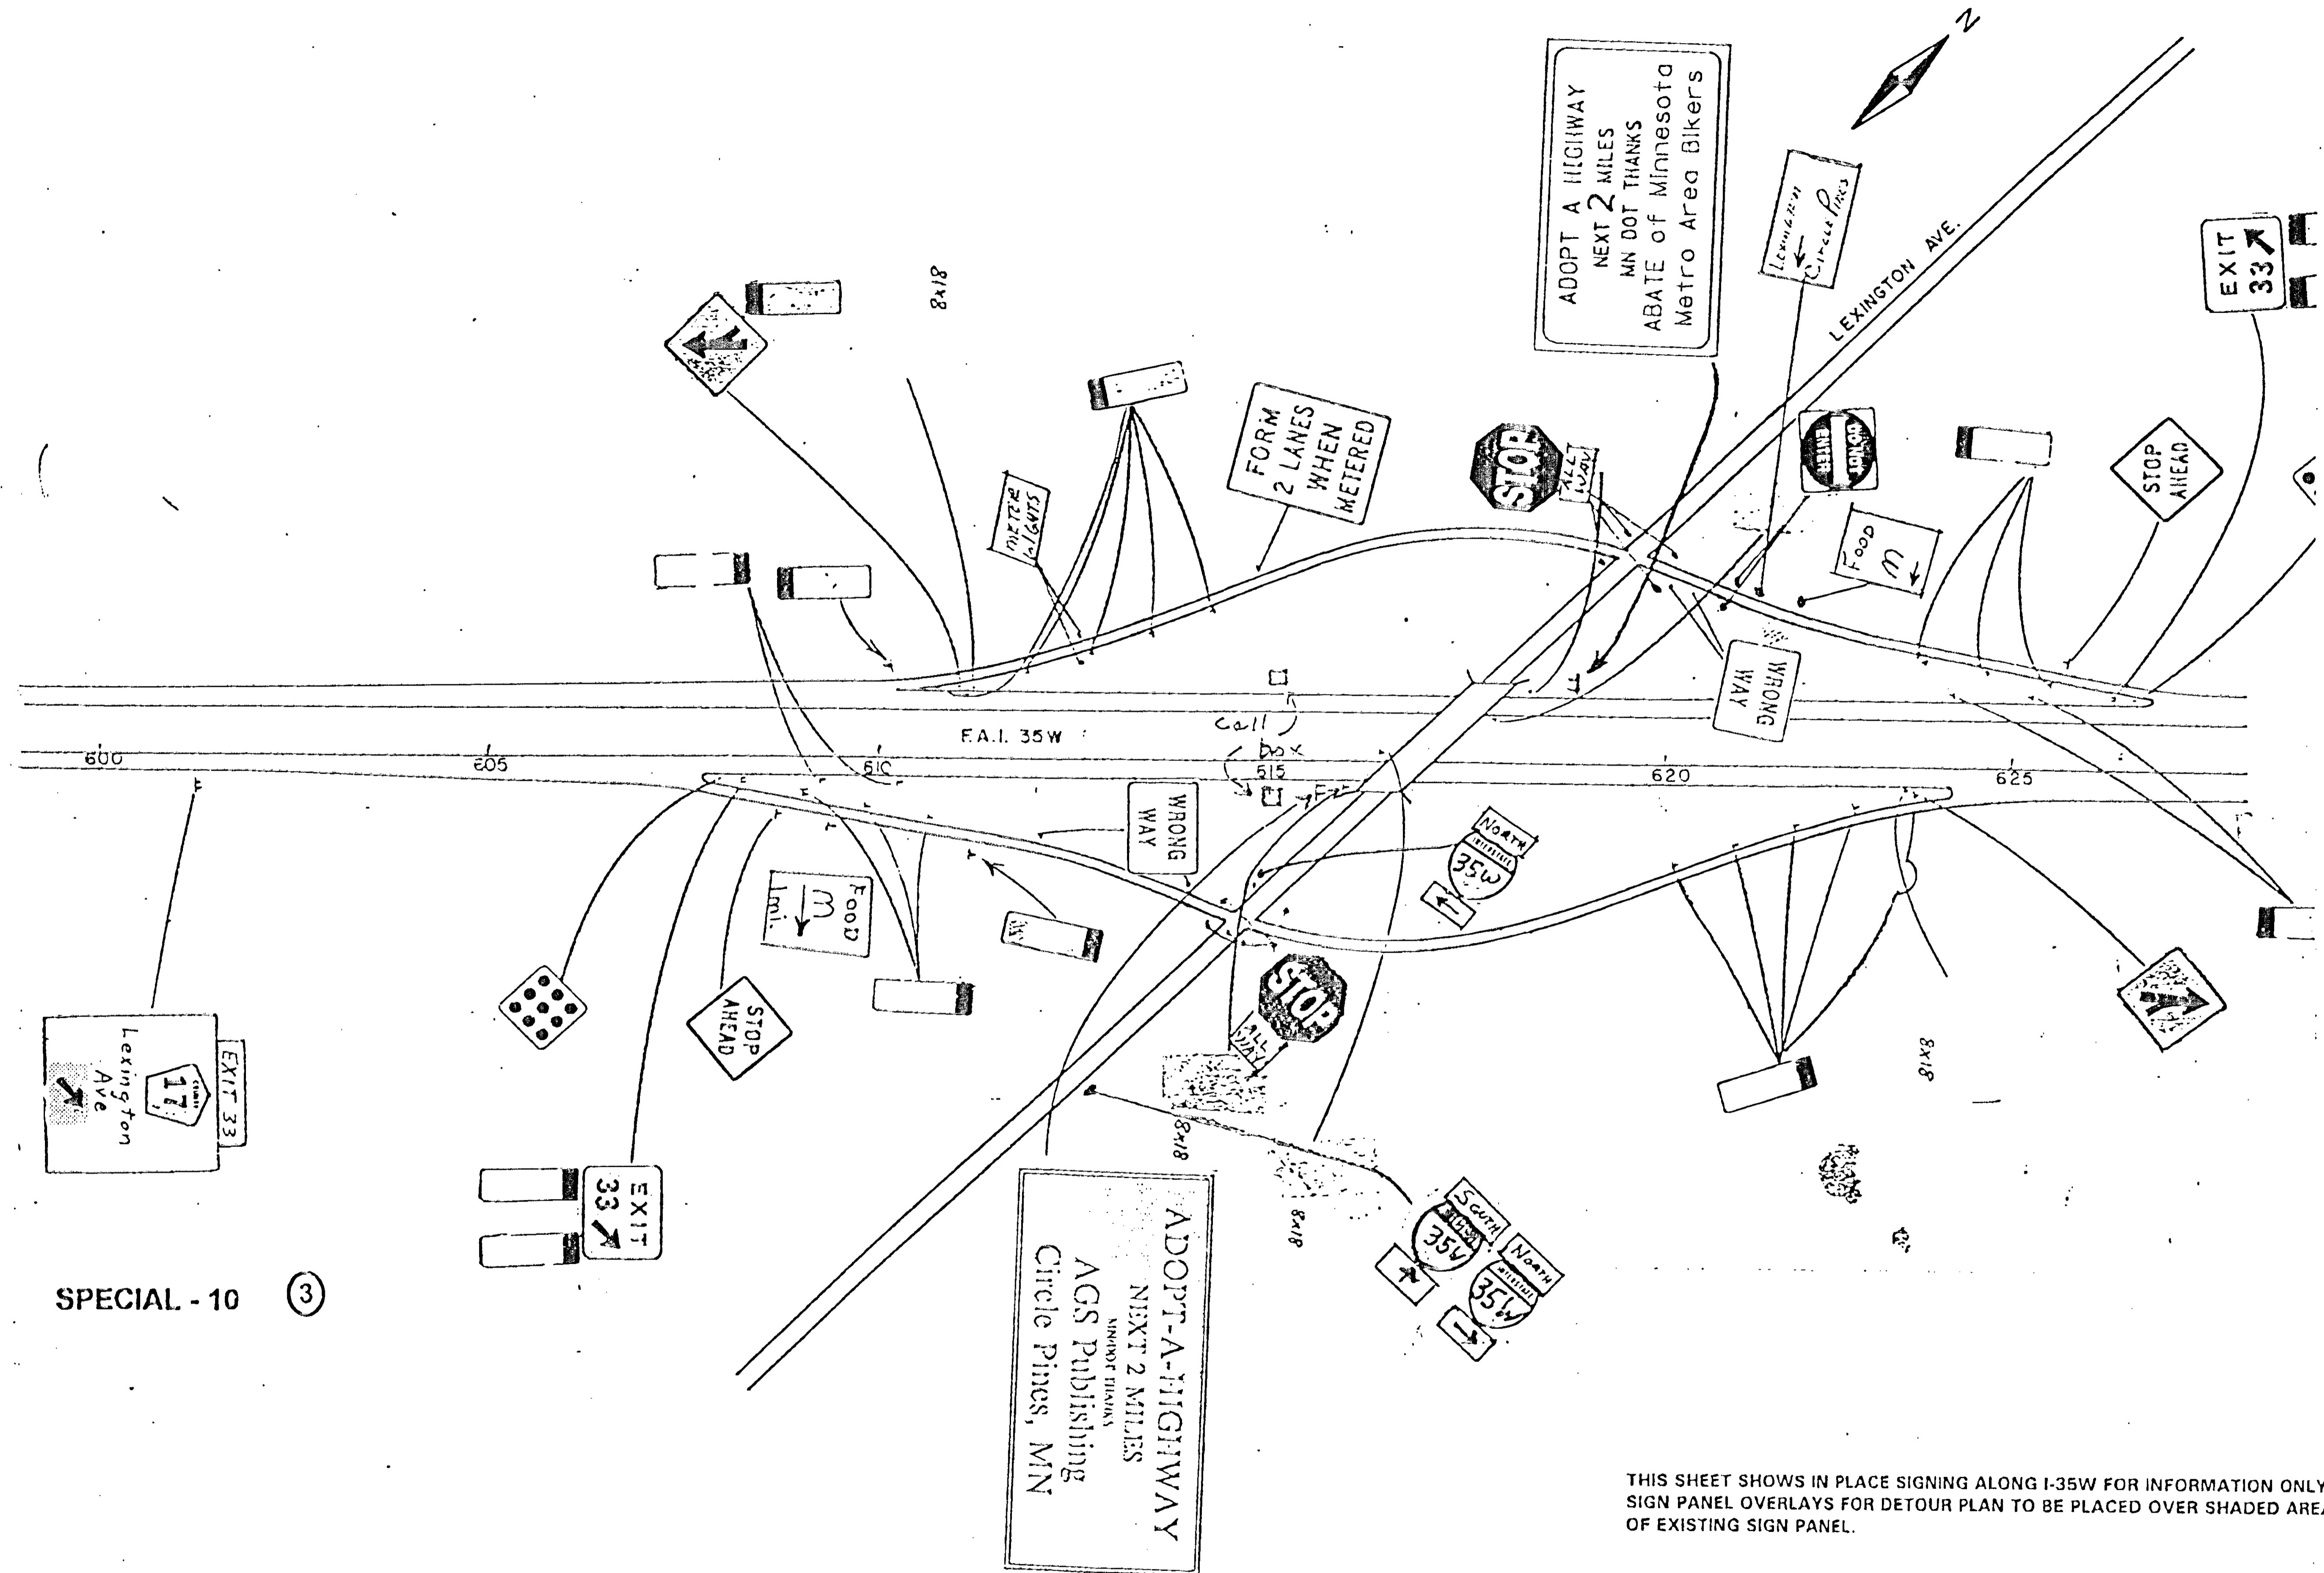


SPECIAL - 10 (3)

THIS SHEET SHOWS IN PLACE SIGNING ALONG I-35W FOR INFORMATION ONLY. SIGN PANEL OVERLAYS FOR DETOUR PLAN TO BE PLACED OVER SHADED AREA OF EXISTING SIGN PANEL.

NO	DATE	BY	CHKD	APPRD	REVISION


NAME: DP5 410.PLM DATE: Mar. 17, 1997

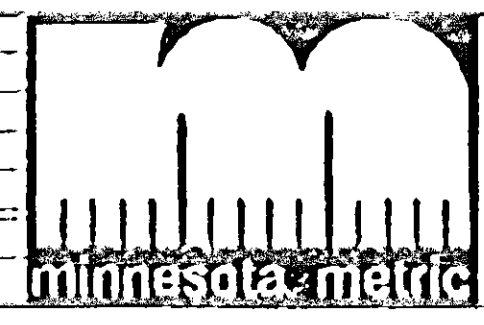

I hereby certify that this plan, specification or report was prepared by me or under my direct supervision and that I am a duly Registered Professional Engineer under the laws of the State of Minnesota.
Donald A. Demers
 Date 3-21-97 Reg. No. 23397

STATE AID PROJECT NO. S.A.P. 02-617-11 S.A.P. 106-020-12 S.A.P. 106-030-03 CO. PROJECT NO.


DRAWN BY V. GRAF DATE 12-96 DESIGNED BY D. DEMERS DATE 12-96 CHECKED BY D. DEMERS DATE 2-97 COMM. NO. 0262410

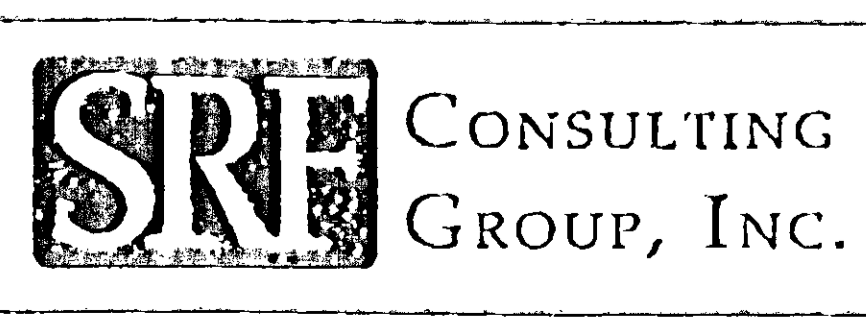



ANOKA COUNTY
 DETOUR PLAN
 C.S.A.H. 17 RECONSTRUCTION

SHEET 32 OF 236

SPECIAL - 10 (3)

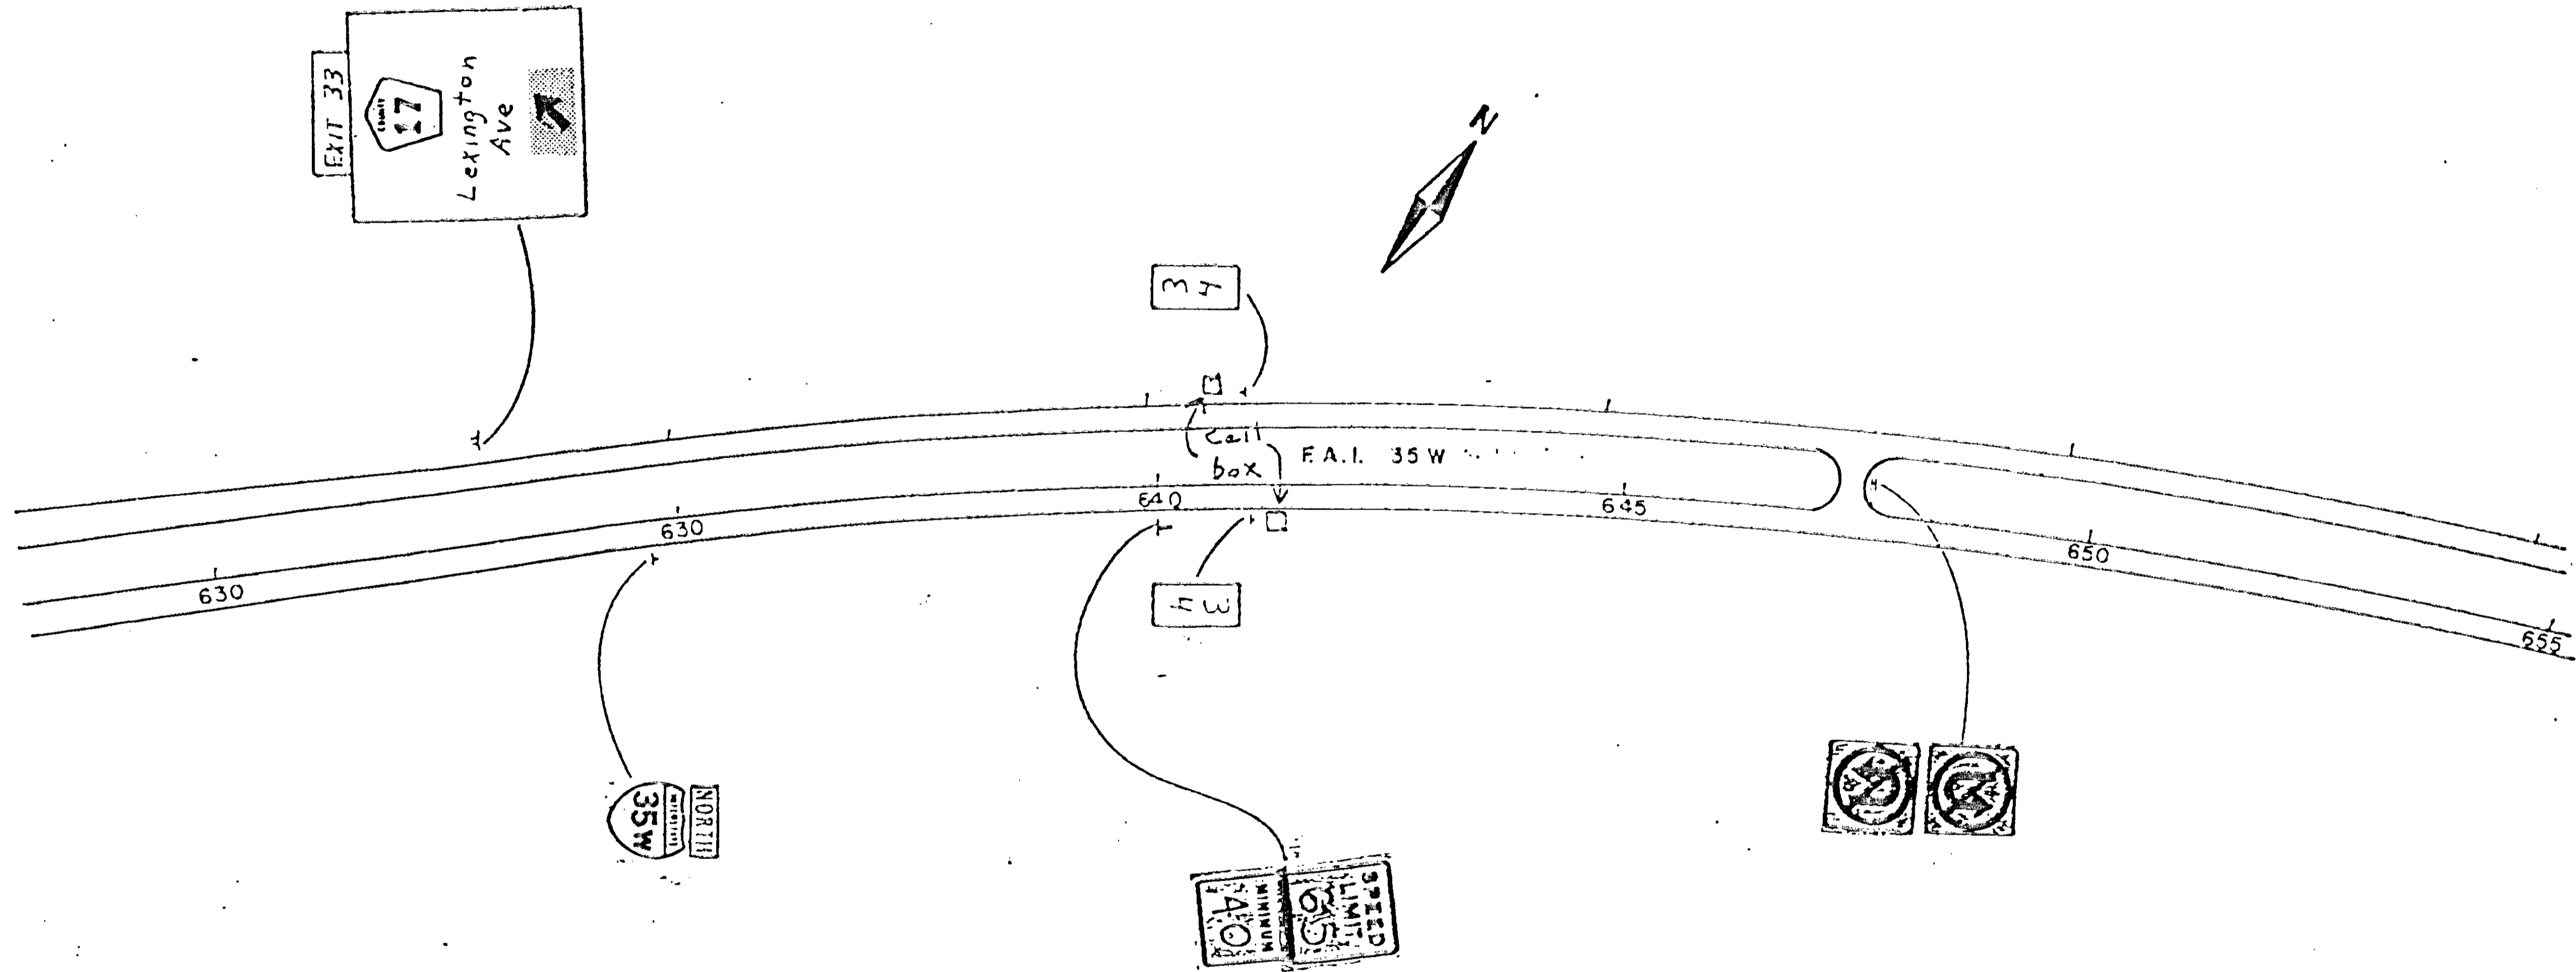


THIS SHEET SHOWS IN PLACE SIGNING ALONG I-35W FOR INFORMATION ONLY. SIGN PANEL OVERLAYS FOR DETOUR PLAN TO BE PLACED OVER SHADED AREA OF EXISTING SIGN PANEL.
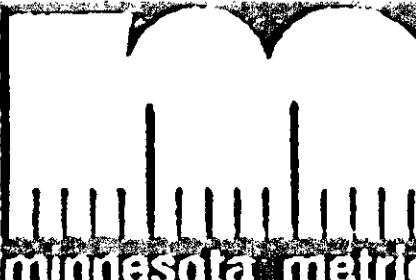
<table border="1"> <tr> <th>NO</th> <th>DATE</th> <th>BY</th> <th>CHKD</th> <th>APPR</th> <th>REVISION</th> </tr> <tr> <td> </td> <td> </td> <td> </td> <td> </td> <td> </td> <td> </td> </tr> </table>				NO	DATE	BY	CHKD	APPR	REVISION								I hereby certify that this plan, specification or report was prepared by me or under my direct supervision and that I am a duly Registered Professional Engineer under the laws of the State of Minnesota. <i>Dorenda A. Demers</i> Date <u>3-21-97</u> Reg. No. <u>23397</u>	<table border="1"> <tr> <td>STATE AID PROJECT NO.</td> <td>DRAWN BY</td> <td>DATE</td> </tr> <tr> <td>S.A.P. 02-617-11</td> <td>V. GRAF</td> <td>12-96</td> </tr> <tr> <td>S.A.P. 106-020-12</td> <td>DESIGNED BY</td> <td></td> </tr> <tr> <td>S.A.P. 106-030-03</td> <td>D. DEMERS</td> <td>12-96</td> </tr> <tr> <td>CO. PROJECT NO.</td> <td>CHECKED BY</td> <td></td> </tr> <tr> <td></td> <td>D. DEMERS</td> <td>2-97</td> </tr> <tr> <td></td> <td>COMM. NO.</td> <td></td> </tr> <tr> <td></td> <td>0952410</td> <td></td> </tr> </table>	STATE AID PROJECT NO.	DRAWN BY	DATE	S.A.P. 02-617-11	V. GRAF	12-96	S.A.P. 106-020-12	DESIGNED BY		S.A.P. 106-030-03	D. DEMERS	12-96	CO. PROJECT NO.	CHECKED BY			D. DEMERS	2-97		COMM. NO.			0952410			ANOKA COUNTY DETOUR PLAN C.S.A.H. 17 RECONSTRUCTION		SHEET 33 OF 236
NO	DATE	BY	CHKD	APPR	REVISION																																									
STATE AID PROJECT NO.	DRAWN BY	DATE																																												
S.A.P. 02-617-11	V. GRAF	12-96																																												
S.A.P. 106-020-12	DESIGNED BY																																													
S.A.P. 106-030-03	D. DEMERS	12-96																																												
CO. PROJECT NO.	CHECKED BY																																													
	D. DEMERS	2-97																																												
	COMM. NO.																																													
	0952410																																													
NAME: <u>CP6 410.PLN</u> DATE: <u>Mar. 17, 1997</u>																																														


SPECIAL - 8 (3)

SPECIAL - 9 (3)

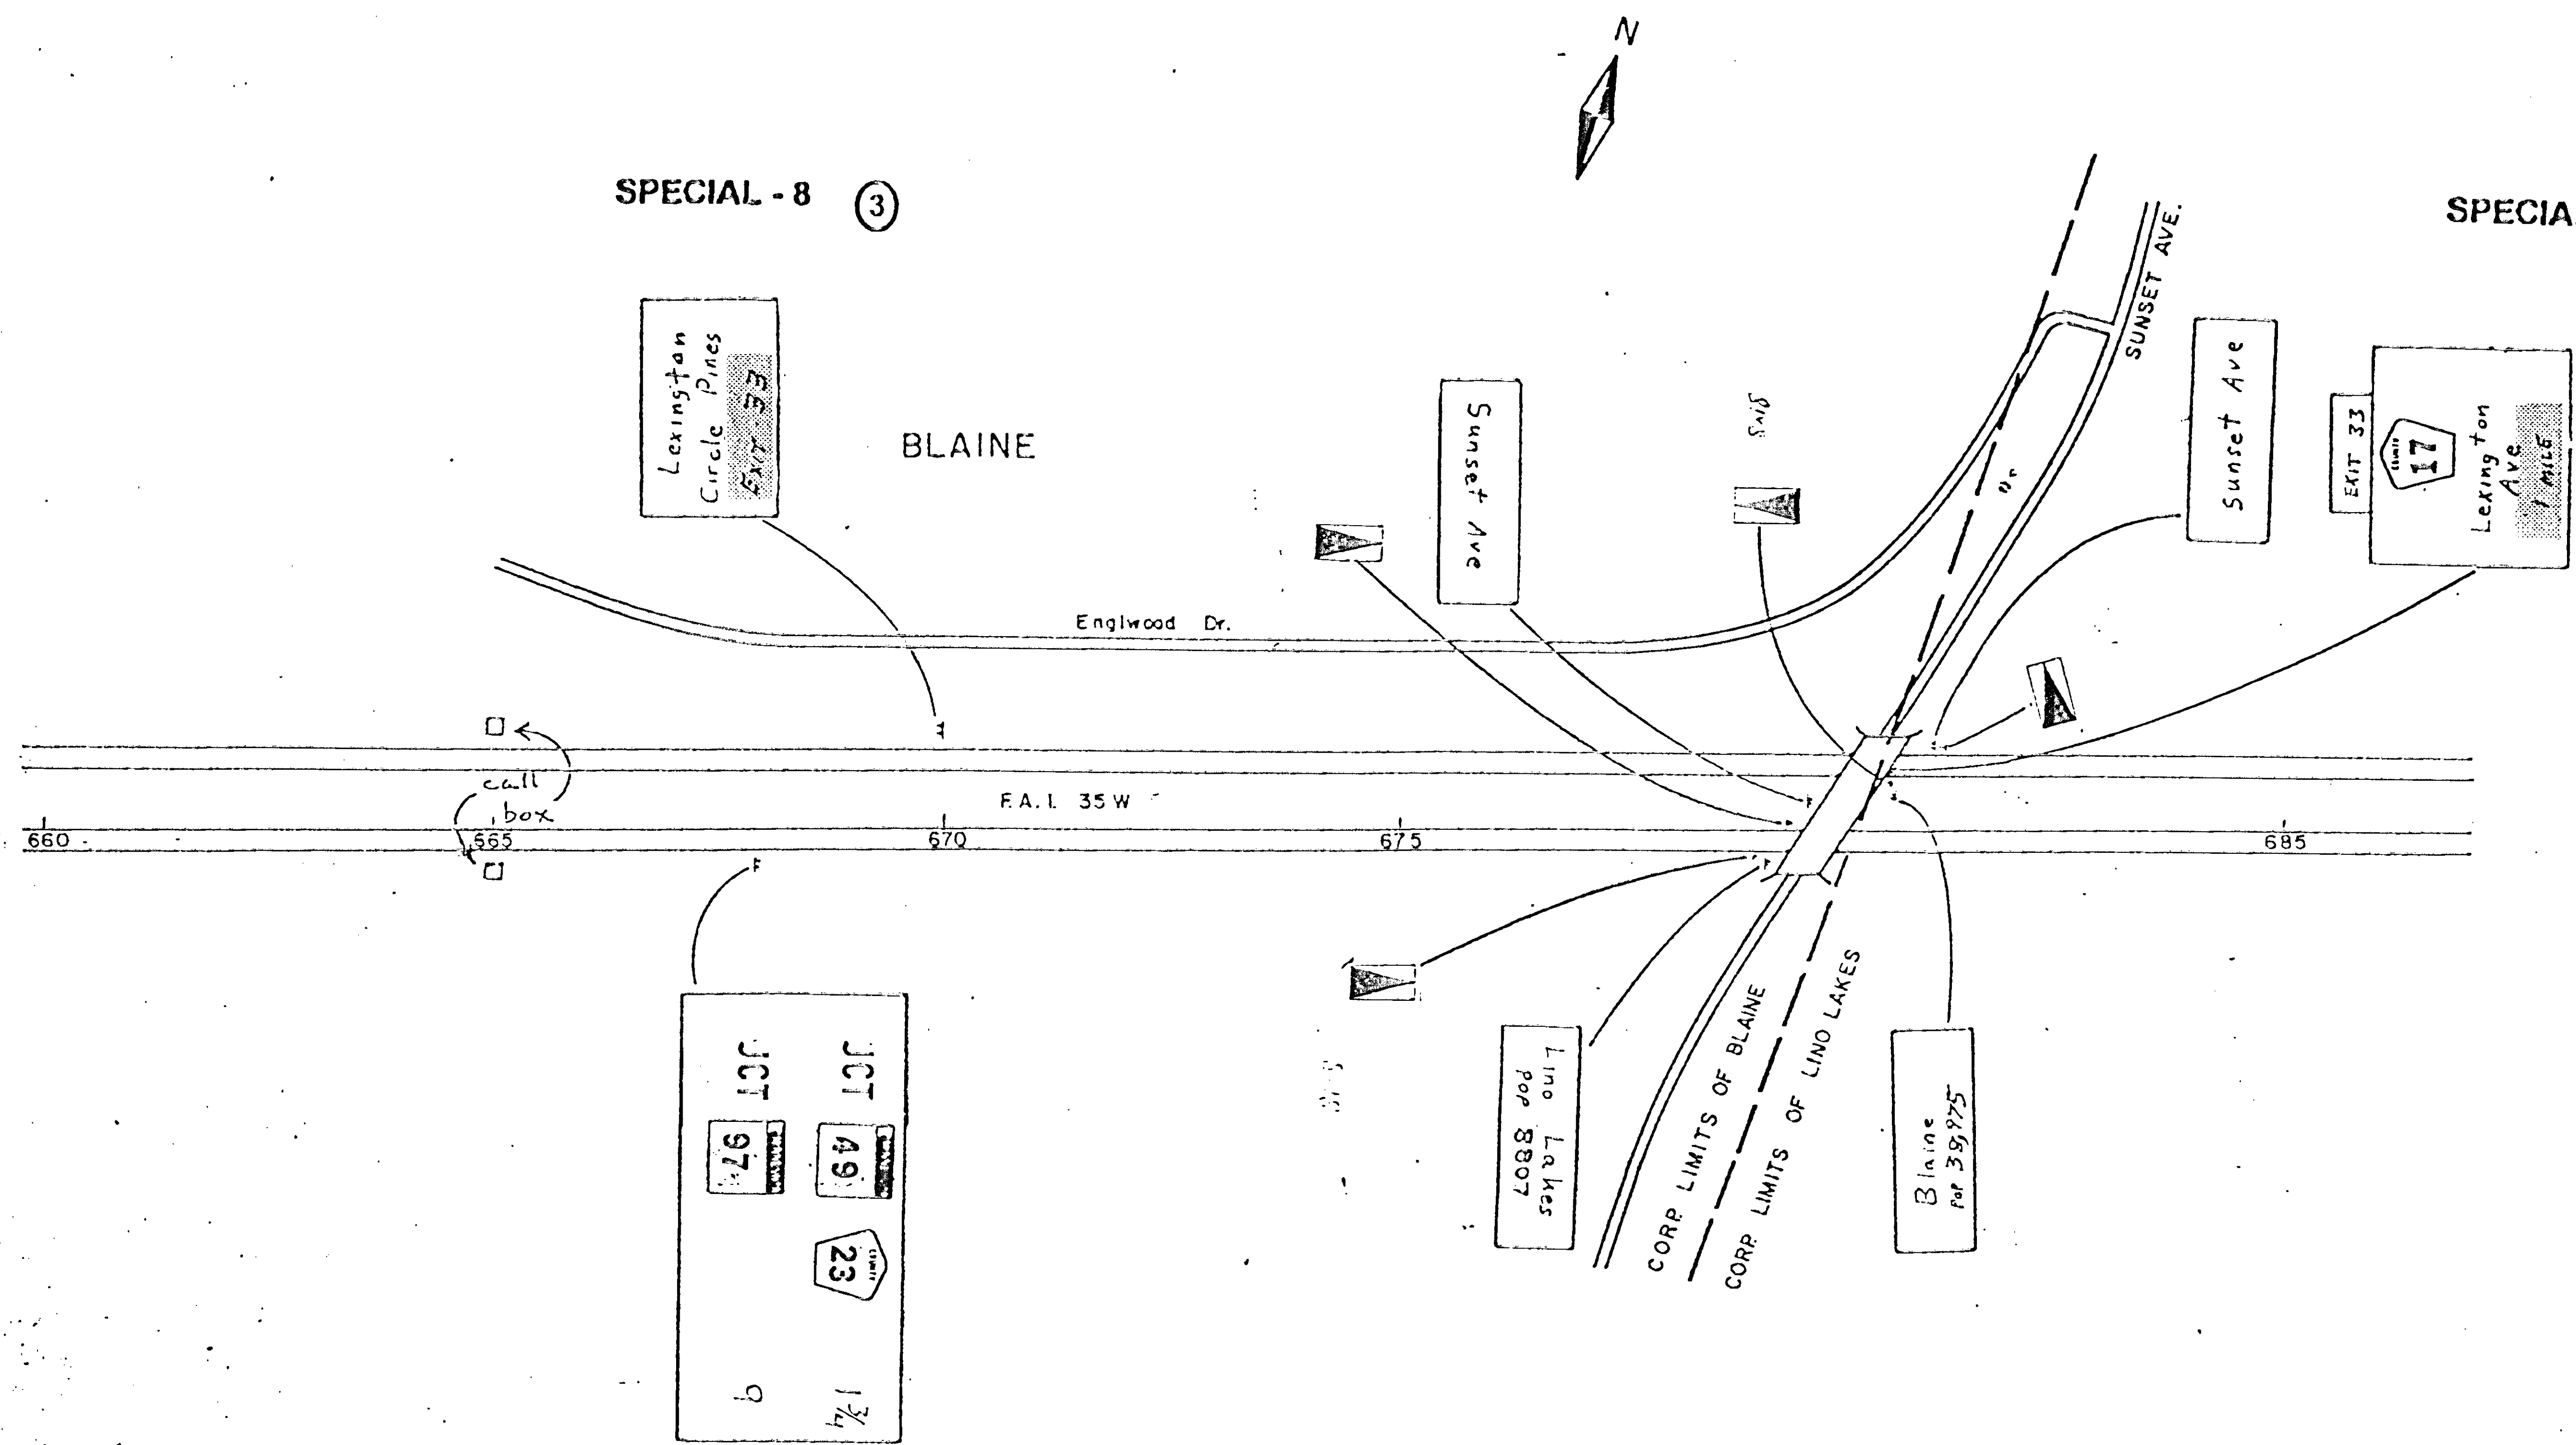

THIS SHEET SHOWS IN PLACE SIGNING ALONG I-35W FOR INFORMATION ONLY. SIGN PANEL OVERLAYS FOR DETOUR PLAN TO BE PLACED OVER SHADED AREA OF EXISTING SIGN PANEL.

NO	DATE	BY	CHKD	APPRI	REVISION
NAME: DP7 410.PLN DATE: Mar 17, 1997					

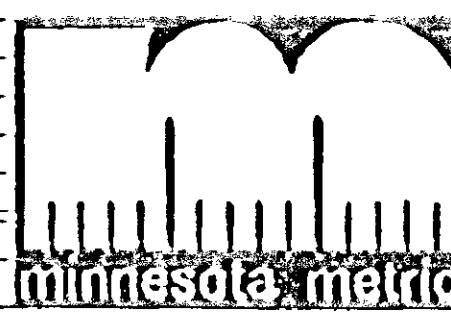

I hereby certify that this plan, specification or report was prepared by me or under my direct supervision and that I am a duly Registered Professional Engineer under the laws of the State of Minnesota.
Donald A. Demers
 Date 3-21-97 Reg No. 23397

STATE AID PROJECT NO.
 S.A.P. 02-617-11
 S.A.P. 106-020-12
 S.A.P. 106-030-03
 CO. PROJECT NO.


DRAWN BY V. GRAF DATE 12-96
 DESIGNED BY D. DEMERS 12-96
 CHECKED BY D. DEMERS 2-97
 COMM. NO. 0952410





ANOKA COUNTY
 DETOUR PLAN
 C.S.A.H. 17 RECONSTRUCTION

SHEET 34 OF 236

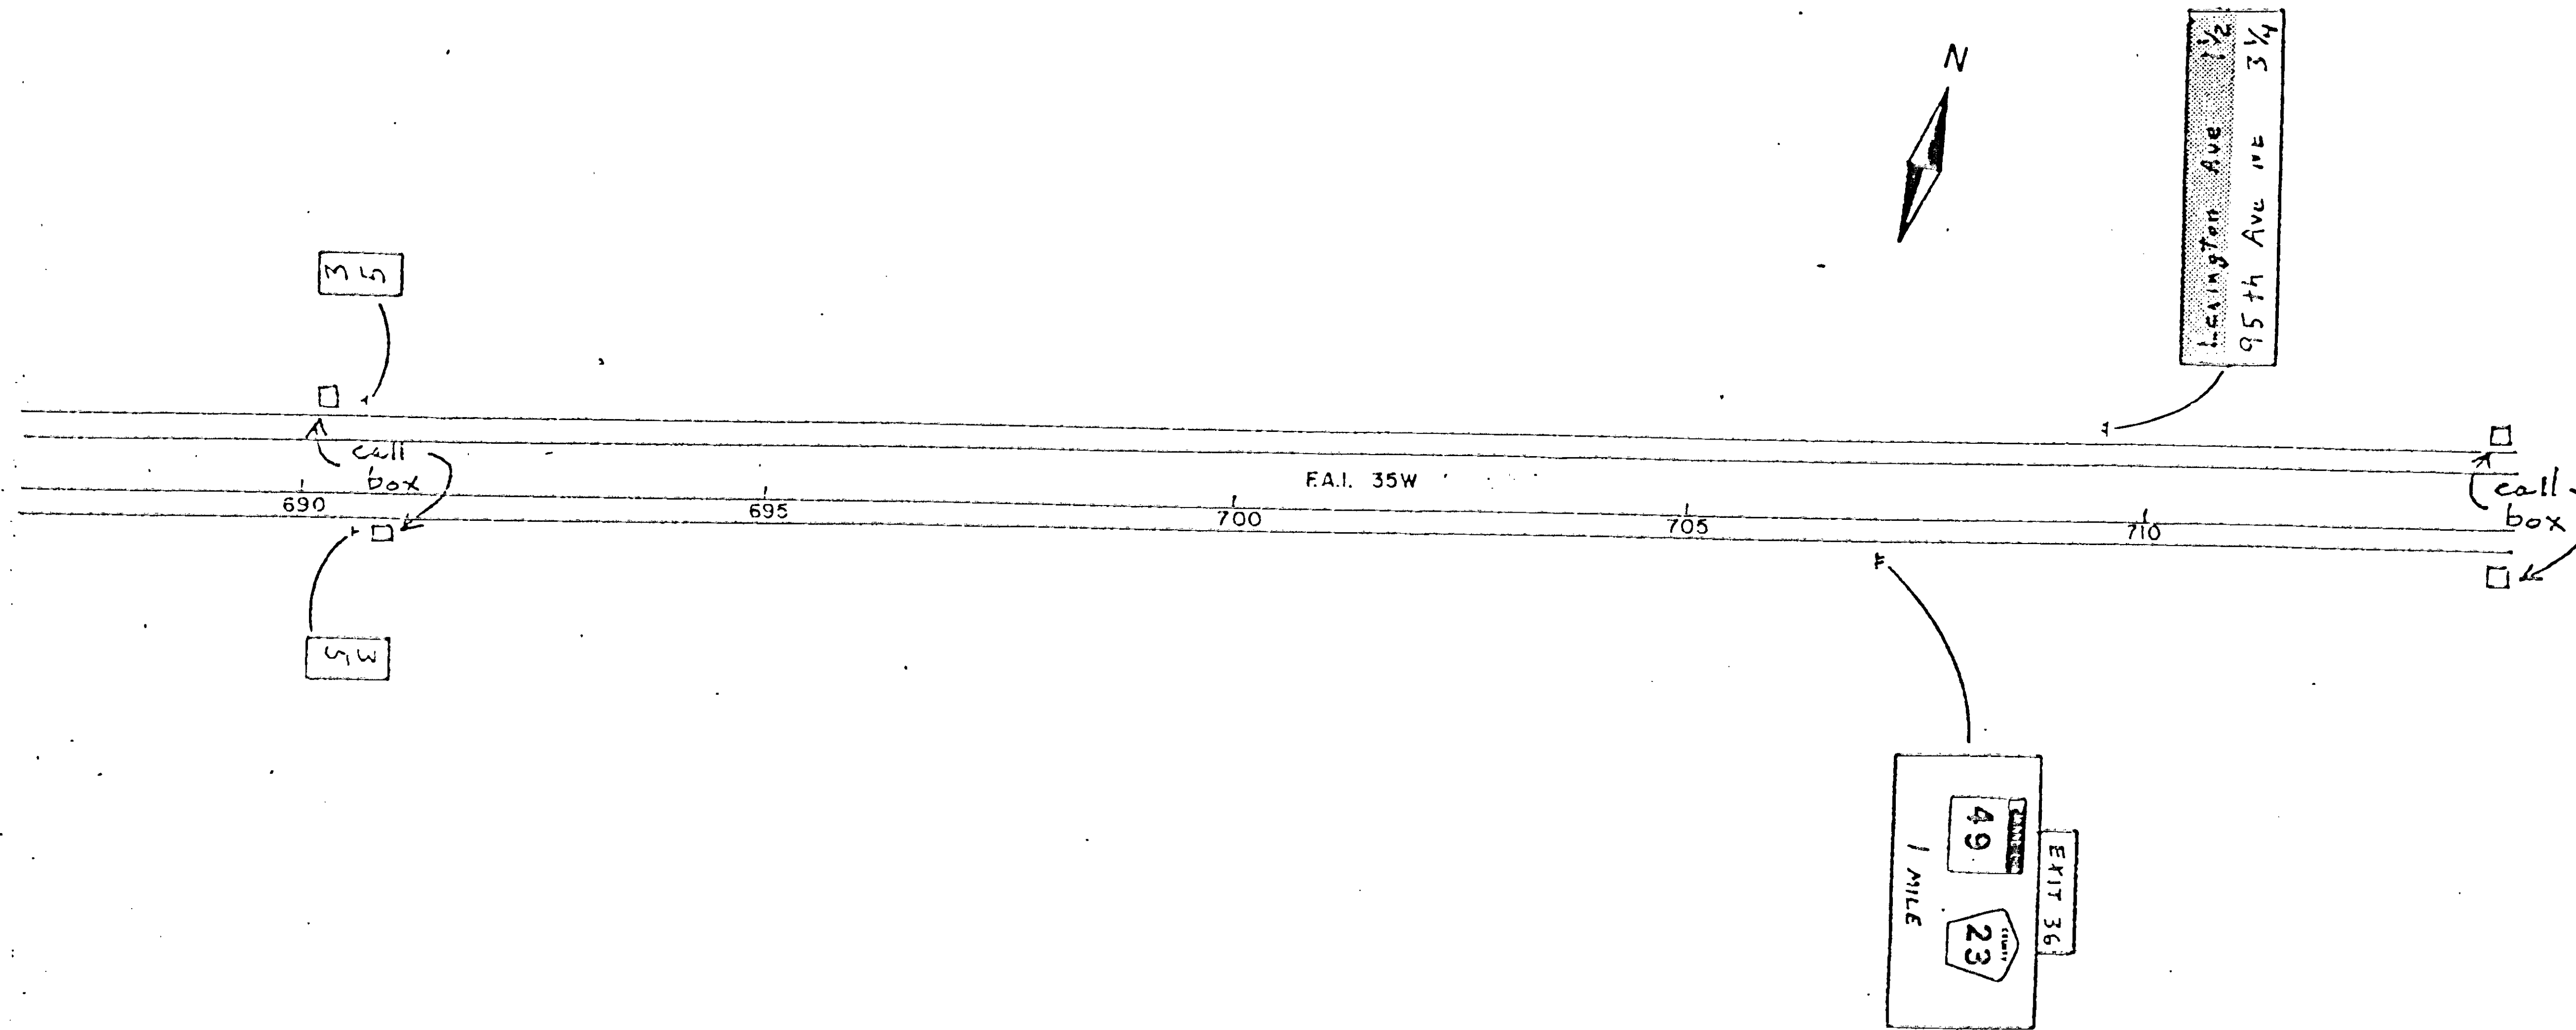SPECIAL - 7 (3)




THIS SHEET SHOWS IN PLACE SIGNING ALONG I-35W FOR INFORMATION ONLY. SIGN PANEL OVERLAYS FOR DETOUR PLAN TO BE PLACED OVER SHADED AREA OF EXISTING SIGN PANEL.

<table border="1"> <tr> <th>NO.</th> <th>DATE</th> <th>BY</th> <th>CHKD</th> <th>APPR</th> <th>REVISION</th> </tr> <tr> <td> </td> <td> </td> <td> </td> <td> </td> <td> </td> <td> </td> </tr> </table>				NO.	DATE	BY	CHKD	APPR	REVISION									I hereby certify that this plan, specification or report was prepared by me or under my direct supervision and that I am a duly Registered Professional Engineer under the laws of the State of Minnesota. <i>Donald A. Demas</i> Date <u>3-21-97</u> Reg. No. <u>23397</u>		STATE AND PROJECT NO. S.A.P. 02-617-11 S.A.P. 106-020-12 S.A.P. 106-030-03 CO. PROJECT NO.		DRAWN BY V. GRAFT DATE 12-96 DESIGNED BY D. DEMERS DATE 12-96 CHECKED BY D. DEMERS DATE 2-97 COMM. NO. 0262410				ANOKA COUNTY DETOUR PLAN C.S.A.H. 17 RECONSTRUCTION		SHEET 35 OF 236
NO.	DATE	BY	CHKD	APPR	REVISION																							
NAME: DPB 410 PLN DATE: Mar. 17, 1997																												

SPECIAL - 7




(3)

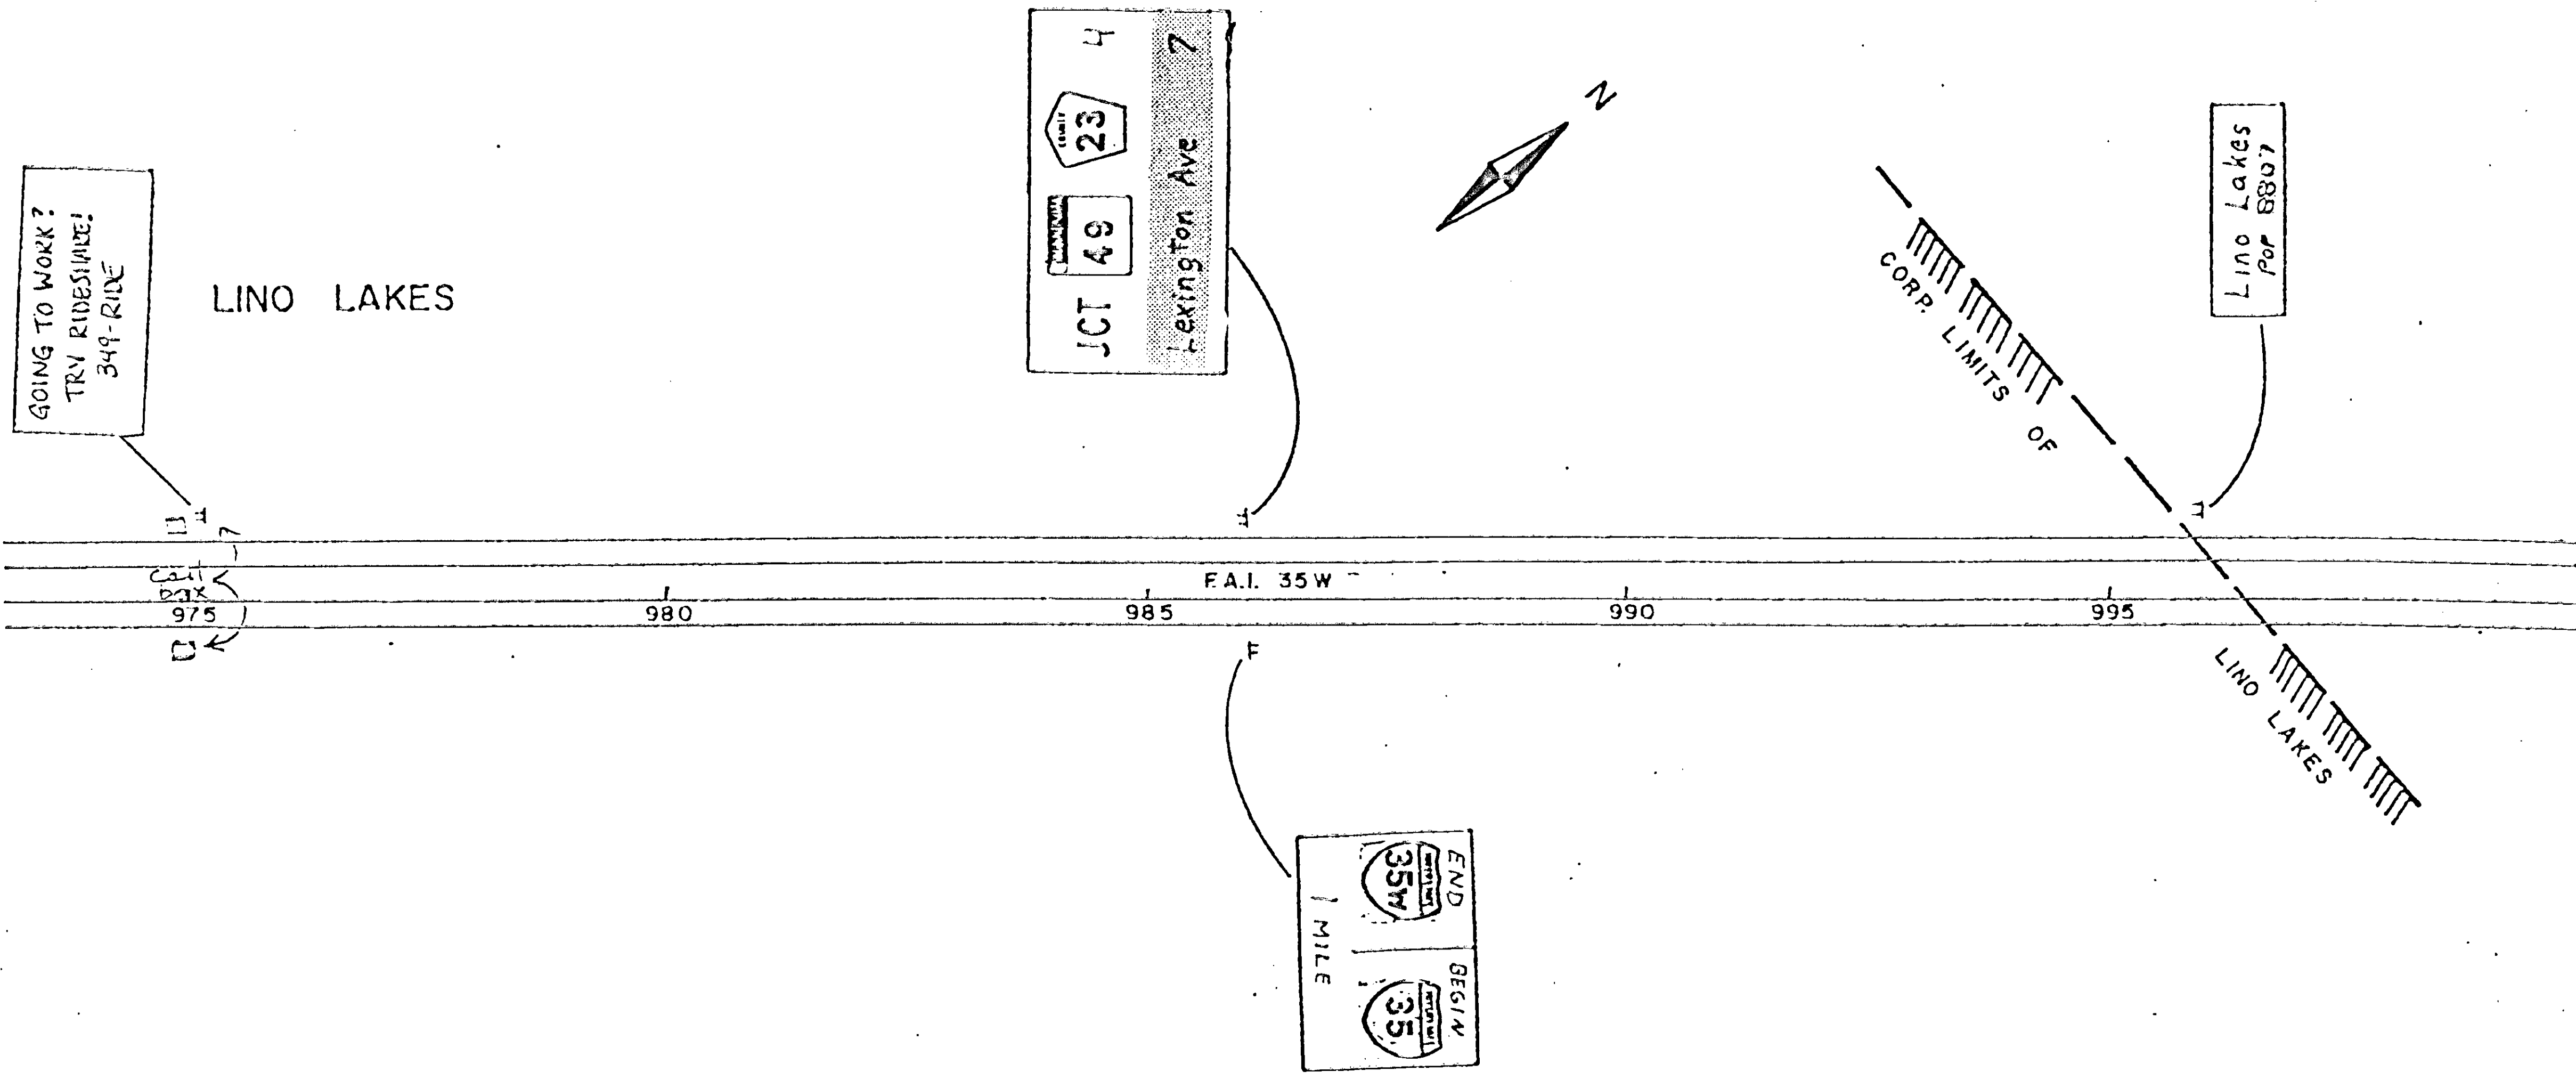

THIS SHEET SHOWS IN PLACE SIGNING ALONG I-35W FOR INFORMATION ONLY. SIGN PANEL OVERLAYS FOR DETOUR PLAN TO BE PLACED OVER SHADED AREA OF EXISTING SIGN PANEL.

<table border="1"> <tr> <th>NO.</th> <th>DATE</th> <th>BY</th> <th>CHKD</th> <th>APPR</th> <th>REVISION</th> </tr> <tr> <td> </td> <td> </td> <td> </td> <td> </td> <td> </td> <td> </td> </tr> </table>					NO.	DATE	BY	CHKD	APPR	REVISION								I hereby certify that this plan, specification or report was prepared by me or under my direct supervision and that I am a duly Registered Professional Engineer under the laws of the State of Minnesota. <i>Donald A Demers</i> Date <u>3-21-97</u> Reg No <u>23397</u>	STATE AND PROJECT NO. S.A.P. 02-617-11 S.A.P. 106-020-12 S.A.P. 106-030-03 CO. PROJECT NO.	DRAWN BY DATE V. GRAF 12-96 DESIGNED BY D. DEMERS 12-96 CHECKED BY D. DEMERS 2-97 COMM. NO. 0962410		ANOKA COUNTY DETOUR PLAN C.S.A.H. 17 RECONSTRUCTION	SHEET 36 OF 236
NO.	DATE	BY	CHKD	APPR	REVISION																		
NAME: DP9 410 PLN DATE: Mar. 17, 1997																							

TRAFFIC SIGN TABULATION					
SIGN LEGEND	SIGN DESIGNATION	SIGN SIZE	SIGN COLOR	QUANTITY	
				STAGE I	STAGE II
	G20-2A	18"x24"	BLACK ON ORANGE	4	4
	R1-1	30"x30"	WHITE ON RED	8	8
	R1-2	36"x36"x36"	RED ON WHITE	1	1
	R1-4	18"x6"	WHITE ON RED	4	4
	R3-1	24"x24"	BLACK AND RED ON WHITE	2	2
	R4-7	24"x30"	BLACK ON WHITE	3	0
	R11-2	18"x30"	BLACK ON WHITE	2	2
	R3-11	60"x30"	BLACK ON WHITE	2	2
	W1-1R	30"x30"	BLACK ON WHITE	1	1
	W1-3R	30"x30"	BLACK ON ORANGE	1	1
	W1-6	18"x24"	BLACK ON ORANGE	4	1
	W1-7	18"x24"	BLACK ON ORANGE	1	4
	W3-1a	36"x36"	BLACK, RED, WHITE ON ORANGE	3	3
	W4-2R	36"x36"	BLACK ON ORANGE	0	1
	W6-3	30"x30"	BLACK ON ORANGE	4	3
	W13-1	24"x24"	BLACK ON ORANGE	1	1
	W14-X7	24"x24"	BLACK ON ORANGE	1	1
	W20-1	18"x18"	BLACK ON ORANGE	19	19
	W20-2	18"x18"	BLACK ON ORANGE	2	2
	W20-3	18"x18"	BLACK ON ORANGE	4	4
	W20-100 P	24"x18"	BLACK ON ORANGE	1	1
	W20-X7(R)	18"x18"	BLACK ON ORANGE	4	4

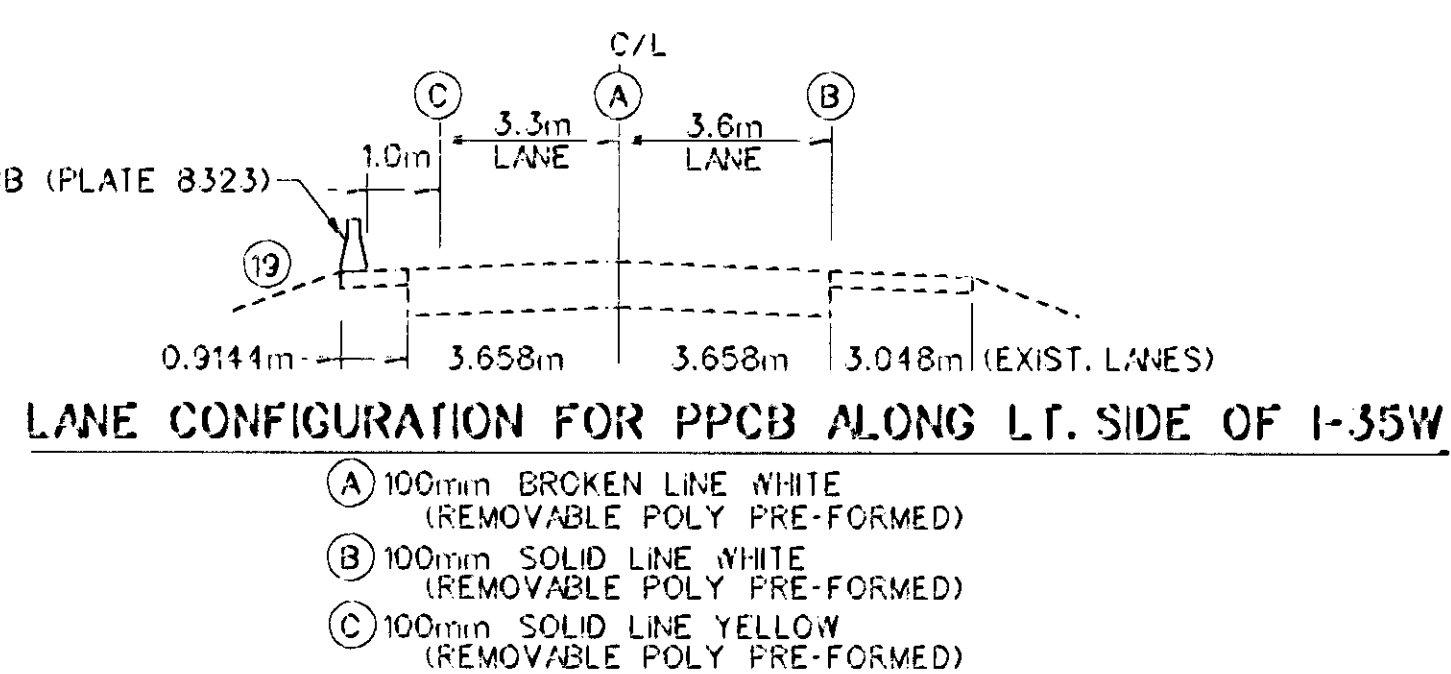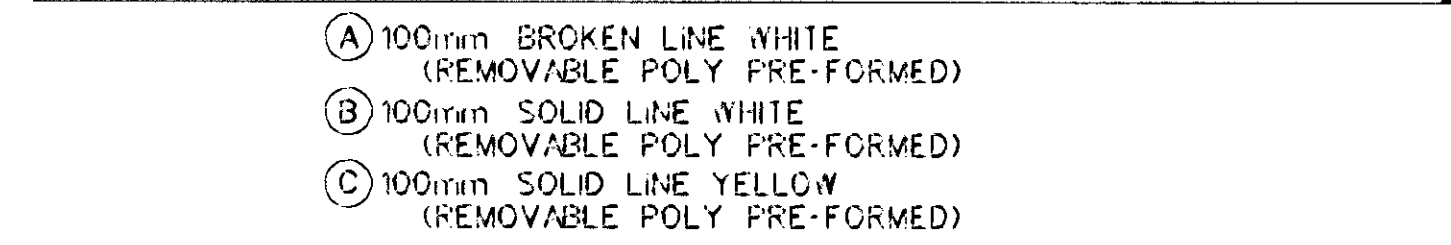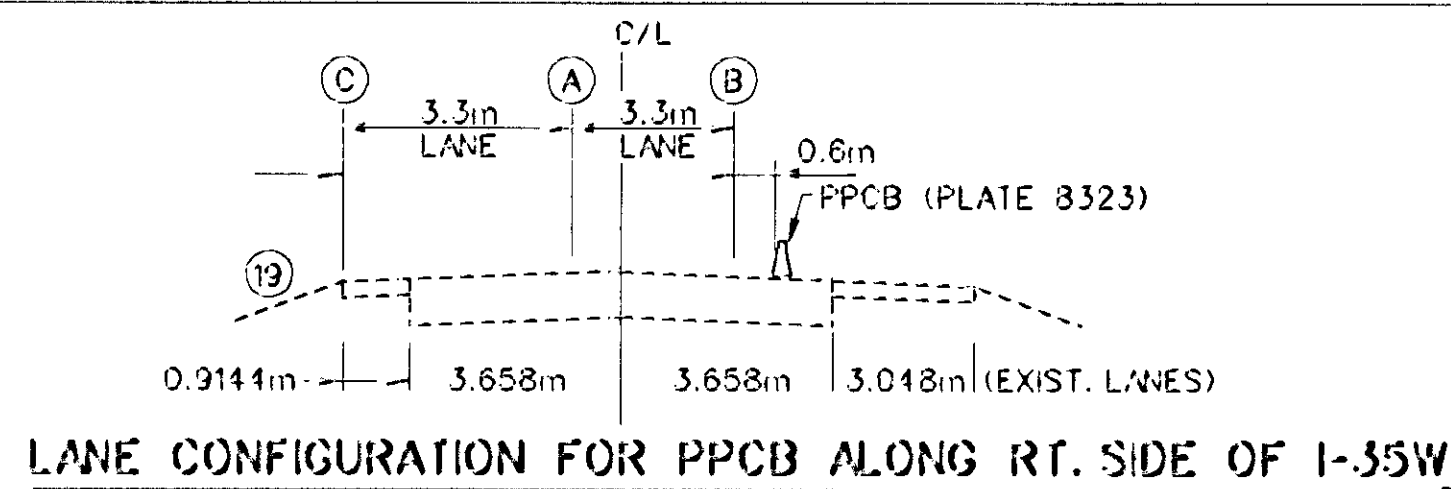

SEE TRAFFIC SIGN TABULATION AND GENERAL NOTES FOR GENERAL TRAFFIC CONTROL NOTES.

LEGEND

- REFLECTORIZED DRUMS (USED FOR CHANNELIZATION)
- REFLECTORIZED DRUM WITH STANDARD SIGN
- TYPE "A" LOW INTENSITY WARNING FLASHER
- STANDARD SIGN (POST OR STAND MOUNTED)
- TYPE 3 BARRICADE - REFLECTORIZED BOTH SIDES (2.4m WIDE UNLESS NOTED OTHERWISE)
- TRAFFIC LOCATION AND DIRECTION
- 100mm DOUBLE SOLID LINE YELLOW (PAINT)
- 100mm BROKEN LINE WHITE (REMOVABLE POLY PREFORM)
- 100mm SOLID LINE WHITE (REMOVABLE POLY PREFORM)
- 100mm SOLID LINE YELLOW (REMOVABLE POLY PREFORM)
- 100mm SOLID LINE WHITE PAINT
- TEMPORARY RAISED PAVEMENT MARKERS (TRFM)
- STAGE I TEMPORARY PAVEMENT WIDENING
- CONSTRUCTION AREA
- BOX CULVERT CONSTRUCTION (STAGE I)
- CONSTRUCTION UNDER TRAFFIC

TRAFFIC SIGN TABULATION					
	W20-X7(L)	18"x18"	BLACK ON ORANGE	4	4
	W20-X17	18"x18"	BLACK ON ORANGE	4	4
	W21-X1	18"x18"	BLACK ON ORANGE	4	4
	W4-10L	18"x18"	BLACK ON ORANGE	2	1
	W4-10R	18"x18"	BLACK ON ORANGE	1	1
	X4-4	18"x18"	YELLOW ON BLACK	4	4
	SPECIAL	24"x30"	BLACK ON WHITE	0	1

GENERAL TRAFFIC CONTROL NOTES:

- ALL TRAFFIC CONTROL DEVICES, TEMPORARY LANE CLOSURE ARRANGEMENTS AND PROCEDURES, ETC. SHALL CONFORM TO REQUIREMENTS OF THE MINNESOTA MANUAL ON UNIFORM TRAFFIC CONTROL DEVICES INCLUDING THE FIELD MANUAL FOR TEMPORARY TRAFFIC CONTROL ZONE LAYOUTS DATED APRIL 1995.
- PAVEMENT MARKINGS SHALL BE PAINT OR REMOVABLE POLYMER PERFORMED AND SHALL BE SUPPLEMENTED WITH ONE-WAY TEMPORARY RAISED PAVEMENT MARKERS (TRFMS), AS APPROPRIATE, ON 3 METER CENTERS WHERE IDENTIFIED ON THE PLANS. THE CONTRACTOR SHALL FURNISH, INSTALL, MAINTAIN, AND REMOVE ALL TRFMS AND PAVEMENT MARKINGS TO THE SATISFACTION OF THE ENGINEER. TRFM COLORS SHALL CONFORM TO THE REQUIREMENTS OF THE MINNESOTA MANUAL ON UNIFORM TRAFFIC CONTROL DEVICES (MMUTCD) AND SHALL BE PLACED AS DETAILED IN FIGURE 8.7 OF THE MN/DOT TRAFFIC MANUAL. REMOVABLE PREFORMED PAVEMENT MARKINGS AND TRFMS SHALL BE PAID FOR SEPARATELY FROM THE LUMP SUM FOR TRAFFIC CONTROL UNDER THE APPROPRIATE CONTRACT ITEMS INDICATED ON THE PROPOSAL.
- TRFM LOCATIONS:
NB I-35W (STAGE I & II)
STA. 18+000 TO 18+100
STA. 18+560 TO 18+670
SB I-35W (STAGE I & II)
STA. 18+950 TO 19+050
STA. 19+500 TO 19+650
CSAH 17 (STAGE II)
STA. 8+390 TO 8+440
- ALL TRAFFIC THRU LANES SHALL BE A MINIMUM OF 3.6 METERS IN WIDTH UNLESS NOTED OTHERWISE.
- REFLECTORIZED DRUMS USED FOR CHANNELIZATION SHALL TYPICALLY HAVE 3 METER SPACING IN INTERSECTION AREAS, AND 15 METER SPACING IN OTHER AREAS. DRUMS SPACED AT 15m INTERVALS SHALL BE SUPPLEMENTED WITH DOWN ARROWS. DRUM LOCATIONS AND SPACINGS SHOWN ON THIS PLAN ARE APPROXIMATE AND ARE SUBJECT TO REVISION BY THE ENGINEER.
- THE LOCATIONS AND QUANTITIES OF TRAFFIC CONTROL DEVICES SHOWN ON THESE PLANS ARE APPROXIMATE AND ARE SUBJECT TO REVISION BY THE ENGINEER.
- ANY TEMPORARY PORTABLE TRAFFIC BARRIER USED ON THIS PROJECT SHALL HAVE BARRIER DELINEATORS SPACED AT 15.24 METERS. THE DELINEATORS SHALL HAVE A MINIMUM OF 0.0155 SQUARE METERS (24 SQ. INCHES).
- THE CONTRACTOR SHALL MAINTAIN A 0.6 METER MINIMUM CLEAR DISTANCE BETWEEN THE EDGE OF THE TRAVEL LANE AND THE NEAREST EDGE OF ANY ADJACENT TRAFFIC CONTROL DEVICES (DRUMS, BARRICADES, BARRIERS, ETC.).
- CONTRACTOR SHALL MAINTAIN ACCESS TO ALL DRIVEWAYS AT ALL TIMES TO THE SATISFACTION OF THE ENGINEER.
- THE CONTRACTOR SHALL PROVIDE CHANNELIZING DEVICES (AND SIGNING IF NECESSARY) AT ALL PRIVATE ENTRANCE LOCATIONS WHERE NEEDED TO SAFELY GUIDE TRAFFIC TO AND FROM THE TRAVEL CORRIDOR, TO THE SATISFACTION OF THE ENGINEER.
- THE CONTRACTOR SHALL REMOVE, SALVAGE, OR COVER AS APPROPRIATE, ALL EXISTING SIGNING WHICH CONFLICTS WITH THIS TRAFFIC CONTROL PLAN TO THE SATISFACTION OF THE ENGINEER. THE CONTRACTOR SHALL RESTORE ALL APPROPRIATE ORIGINAL SIGNING WHEN AND AS DIRECTED BY THE ENGINEER.
- THE CONTRACTOR SHALL REMOVE ALL EXISTING PAVEMENT MARKINGS WHICH CONFLICT WITH THESE TRAFFIC CONTROL PLANS TO THE SATISFACTION OF THE ENGINEER. THE CONTRACTOR SHALL RESTORE ALL APPROPRIATE ORIGINAL PAVEMENT MARKINGS WHEN AND AS DIRECTED BY THE ENGINEER.
- PAVEMENT MARKING REMOVALS:
CSAH 17 (STAGE I)
STA. 8+390 TO 10+030
NB I-35W STA. 18+000 TO 18+840
SB I-35W STA. 18+760 TO 19+650
- THESE TRAFFIC CONTROL LAYOUTS DO NOT SHOW ALL INPLACE SIGNING. CONTRACTOR SHALL RELOCATE ALL APPROPRIATE INPLACE SIGNING TO MAINTAIN PROPER SIGN VISIBILITY DURING CONSTRUCTION AS DEEMED NECESSARY BY THE ENGINEER.
- THE CONTRACTOR SHALL PROVIDE QUALIFIED FLAGGERS WITH TWO-WAY RADIOS AT ALL TIMES WHEN CONTRACTOR OPERATIONS REQUIRE ONE-LANE-TWO-WAY OPERATION OR WHEN, IN THE OPINION OF THE ENGINEER, ONE-LANE TWO-WAY OPERATIONS IS APPROPRIATE DUE TO SAFETY CONCERNS FROM OPEN EXCAVATIONS, ADJACENT EQUIPMENT, ETC..
- THE CONTRACTOR SHALL NOT PLACE PAINTED TEMPORARY PAVEMENT MARKINGS ON PERMANENT FINAL SURFACING (OR ON OTHER SURFACING WHICH WILL NOT ULTIMATELY BE REPLACED OR COVERED BY PLANNED CONSTRUCTION), UNLESS THE TEMPORARY MARKINGS ARE IN THE SAME LOCATION AS THE PERMANENT MARKINGS.
- PAVEMENT MARKINGS SHALL BE PAINT EXCEPT MARKINGS SHALL BE REMOVABLE POLY PREFORMED AT THE FOLLOWING LOCATIONS:
CSAH 17 SOUTH OF STA. 8+440
NB I-35W STA. 18+000 TO 18+840
SB I-35W STA. 18+760 TO 19+650
- 1:3 MAXIMUM TEMPORARY CONSTRUCTION EDGE SLOPES SHALL BE MAINTAINED AT ALL TIMES EXCEPT WHEN EXCAVATION WORK TEMPORARILY MANDATES STEEPER EDGE SLOPES. WHEN STEEPER EDGE SLOPES ARE NECESSARY (AS APPROVED BY THE ENGINEER), CONTRACTOR SHALL PROVIDE PPCB AND ATTENUATORS. PPCB IS SHOWN ATTENUATORS AS NEEDED ALONG CSAH 17.
- THE CONTRACTOR SHALL FURNISH, INSTALL, MAINTAIN AND REMOVE, AS APPROPRIATE, ALL SIGNS, PAVEMENT MARKINGS AND DEVICES SHOWN ON THESE PLANS TO THE SATISFACTION OF THE ENGINEER.
- STORM SEWER LATERALS, MISCELLANEOUS SANITARY SEWER, AND WATERMAIN CROSSINGS SHALL BE CONSTRUCTED UNDER TRAFFIC AS REQUIRED. PROVIDE TEMPORARY PAVEMENT AS REQUIRED.
- TEMPORARY PAVEMENT SHALL CONSIST OF 90 mm BITUMINOUS WEAR COURSE AND 150 mm OF AGGREGATE BASE CLASS 5A.
- THE I-35W MEDIAN (LEFT) SHOULDERS SHALL BE RECONSTRUCTED TO PROVIDE A MINIMUM DEPTH OF 100 mm BITUMINOUS WEARING COURSE PRIOR TO LANE SHIFTS.

1	3-26-97	MCI		DAD	ACHD COMMENTS
NO	DATE	BY	CHKD	APPR	REVISION
NAME: TCN 410.PLN DATE: Mar. 17, 1997					

I hereby certify that this plan, specification or report was prepared by me or under my direct supervision and that I am a duly Registered Professional Engineer under the laws of the State of Minnesota.

Donald A. Jones
Date: 3-21-97 Reg. No. 23397

STATE AID PROJECT NO. S.A.P. 02-617-11 S.A.P. 106-020-12 S.A.P. 106-030-03
CO. PROJECT NO.


DRAWN BY M. HSAKKA DATE 12-96
DESIGNED BY D. DEMERS 12-96
CHECKED BY D. DEMERS 1-97
COMM. NO. 0962410

STRF CONSULTING GROUP, INC.

ANOKA COUNTY
TRAFFIC CONTROL SIGN TABULATION AND GENERAL NOTES
C.S.A.H. 17 RECONSTRUCTION

SHEET 37 OF 236

PORTABLE CONCRETE BARRIER PLACEMENT

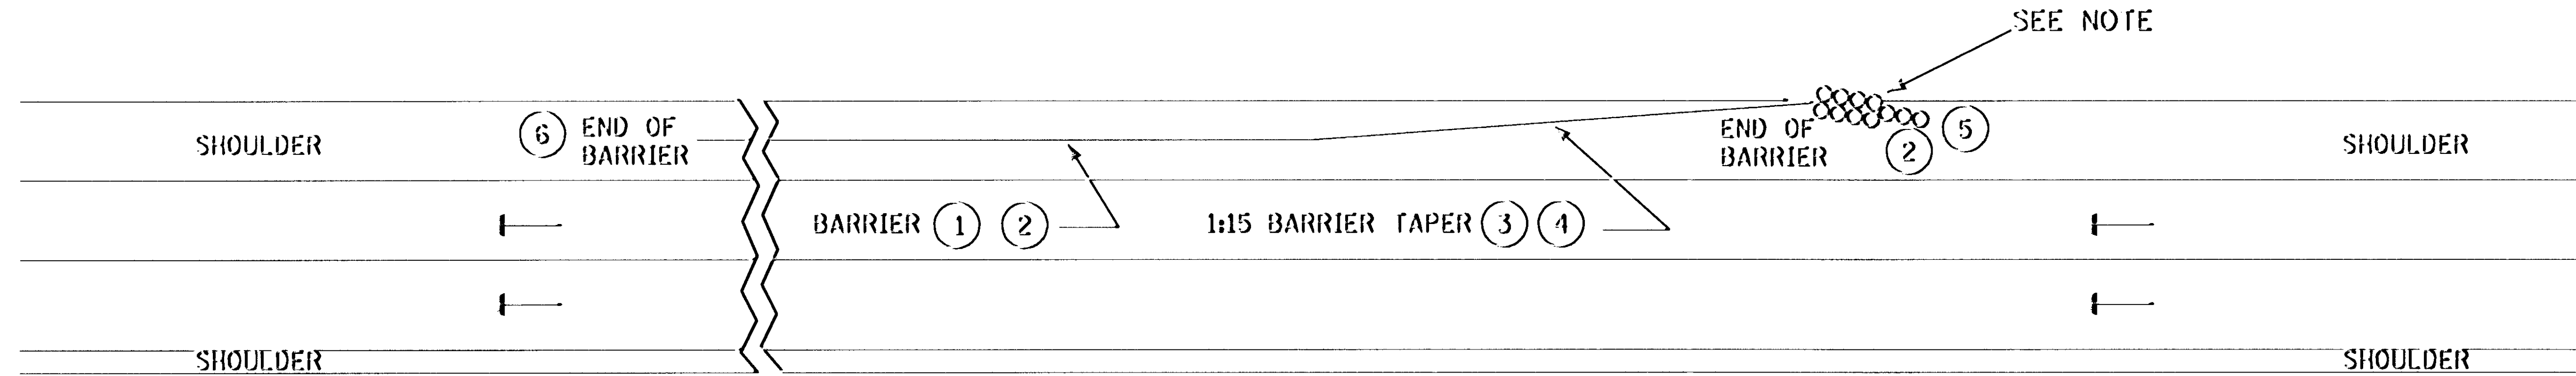

① IT IS DESIRABLE TO MAINTAIN FULL SHOULDER WIDTH WHENEVER POSSIBLE. IF NOT POSSIBLE, MINIMUM DESIRABLE LATERAL OFFSETS ARE BASED ON THE FOLLOWING POSTED SPEEDS:

- 65 MPH - 3.0 m
- 60 MPH - 2.4 m
- 50 MPH - 2.0 m
- 40 MPH - 1.5 m

FOR RESTRICTED CONDITIONS, LESSER OFFSETS MAY BE USED. THE OFFSETS SHOULD BE A MINIMUM OF 600 mm UNLESS THE CONDITIONS ARE EXTREME. LATERAL OFFSETS ARE MEASURED TO THE BOTTOM OF THE BARRIER. BARRIER OFFSET FROM EDGE OF THRU LANE SHOULD NOT EXCEED 4.5 m.

② DESIRABLE TREATMENTS FOR EXPOSED BARRIER ENDS ARE; A CONNECTION TO EXISTING BARRIER; IMPACT ATTENUATOR; TAPER AWAY TO THE EDGE OF THE CLEAR ZONE; AND EXTENDING THROUGH A PLATE BEAM GUARDRAIL BY REMOVING A PANEL.

FOR POSTED SPEEDS 30 MPH OR LESS, THE TAPERING AWAY FROM THE TRAFFIC IS DESIRABLE AND USE OF IMPACT ATTENUATOR ARE OPTIONAL

③ A 1:10 TAPER MAY BE USED WHEN POSTED SPEED LIMIT IS 35 MPH OR LESS.

④ IF THE BARRIER IS TO BE EXTENDED BEYOND THE SHOULDER, ADDITIONAL FILL WILL BE NEEDED IN ORDER TO PROVIDE A FLAT (1:10) APPROACH AREA TO THE BARRIER. FILL WILL BE INCIDENTAL TO BARRIER AND/OR IMPACT ATTENUATOR. (SEE SHOULDER FILL DETAIL BELOW)


⑤ THE IMPACT ATTENUATOR SHOULD BE OFFSET A MINIMUM OF 600 mm FROM THE EDGE OF THE THRU LANE (SEE SAND BARREL OFFSET DETAIL). THE IMPACT ATTENUATOR SHOULD BE ORIENTED TO ACCOMMODATE THE PROBABLE IMPACT ANGLE OF AN ENCROACHING VEHICLE. FOR MOST ROADSIDE CONDITIONS, AN ANGLE APPROXIMATELY 10 DEGREES, AS MEASURED BETWEEN THE HIGHWAY AND THE IMPACT ATTENUATOR LONGITUDINAL CENTERLINE, IS CONSIDERED APPROPRIATE (SEE SHOULDER FILL DETAIL). FOR SAND BARREL ARRANGEMENT SEE DETAIL BELOW.

⑥ FOR TWO-LANE TWO-WAY TRAFFIC BOTH ENDS OF THE BARRIER SHOULD BE TREATED IN THE SAME MANNER AS DESCRIBED IN ②

NOTE:

AT THE DIRECTION OF THE ENGINEER, OTHER APPROVED IMPACT ATTENUATORS CAN BE SUBSTITUTED IN LIEU OF THE SAND BARRELS ESPECIALLY WHERE REDIRECTION IS DESIRED OR AT WIDTH RESTRICTED AREAS.


SAND FILLED BARREL ARRANGEMENT

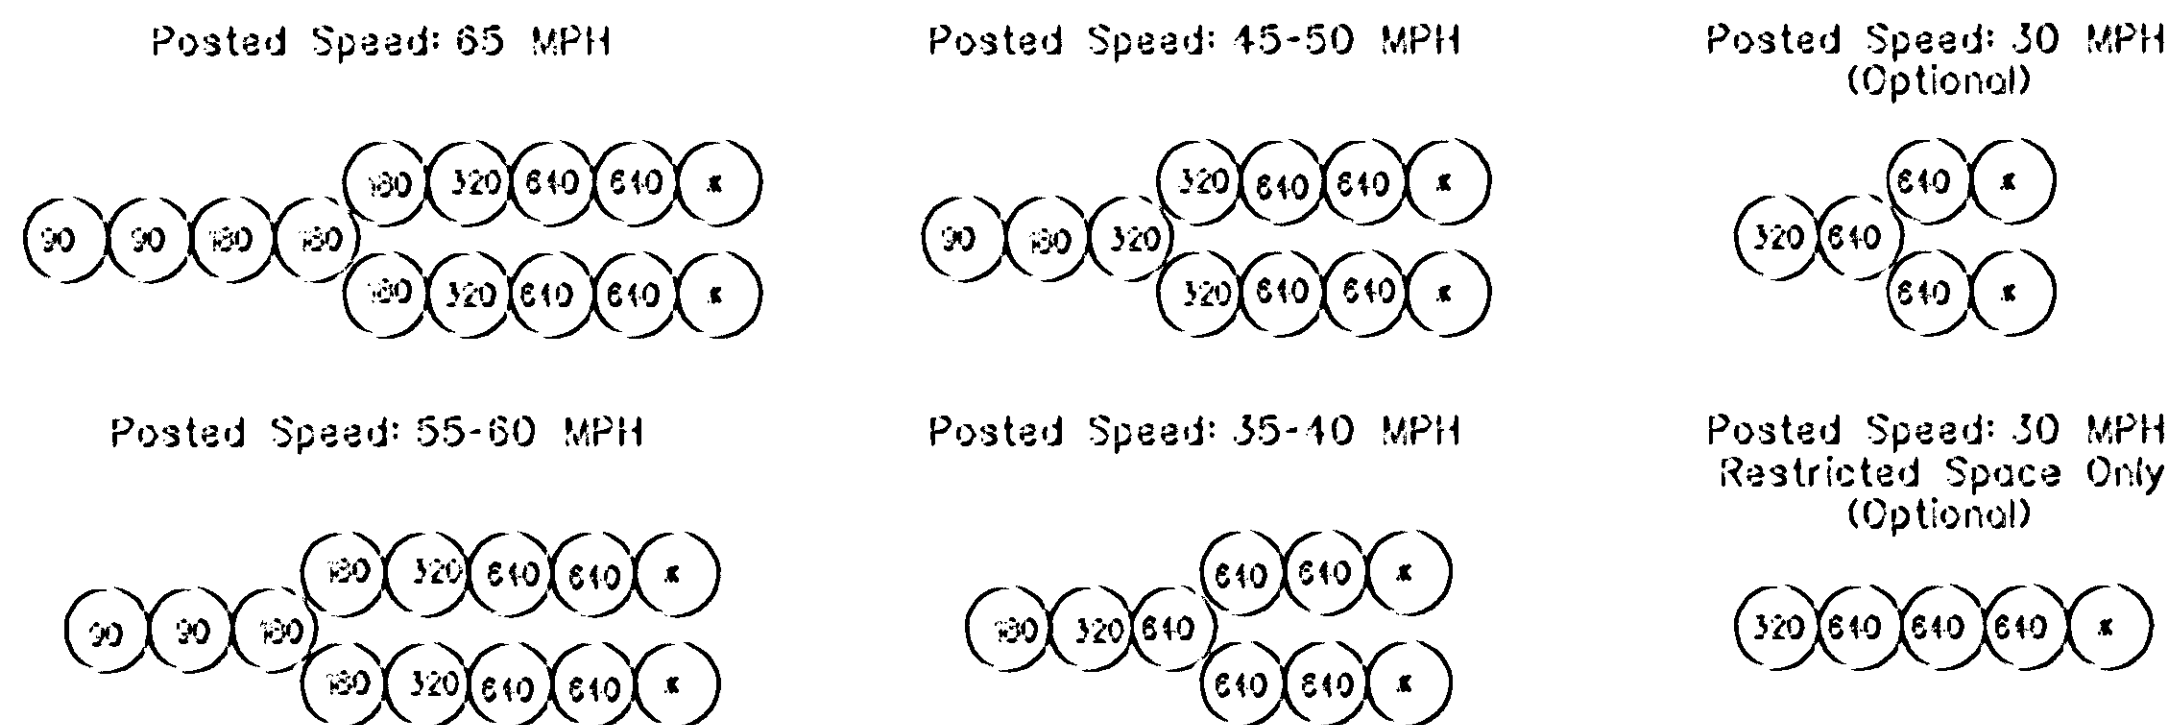

⊛ Use a 960 Kilogram drum for Energite System and a 640 Kilogram drum for a Fitch System


Note: Numbers indicate standard module weights in kilograms.

SAND FILLED BARREL OFFSET

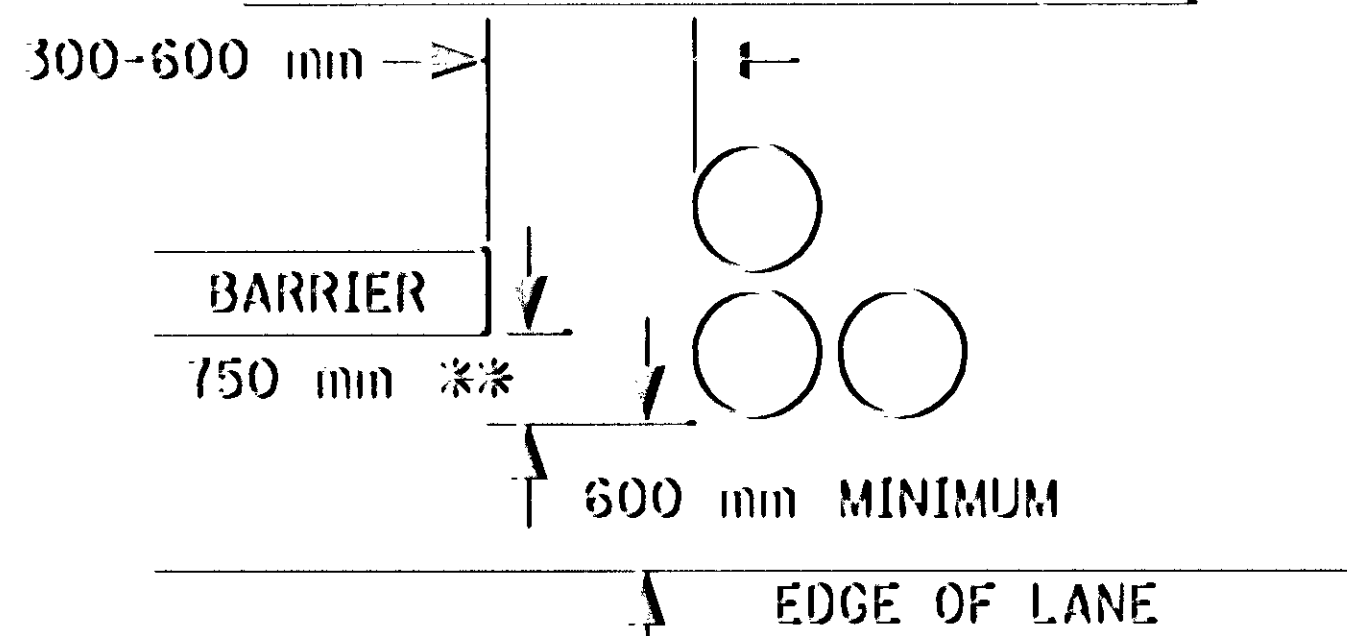

** DISTANCE MAY BE REDUCED TO MINIMUM OF 380 mm. THIS IS ACCEPTABLE ONLY WHERE A GREATER OFFSET WOULD CAUSE UNACCEPTABLE INTERFERENCE WITH TRAFFIC.

SHOULDER FILL

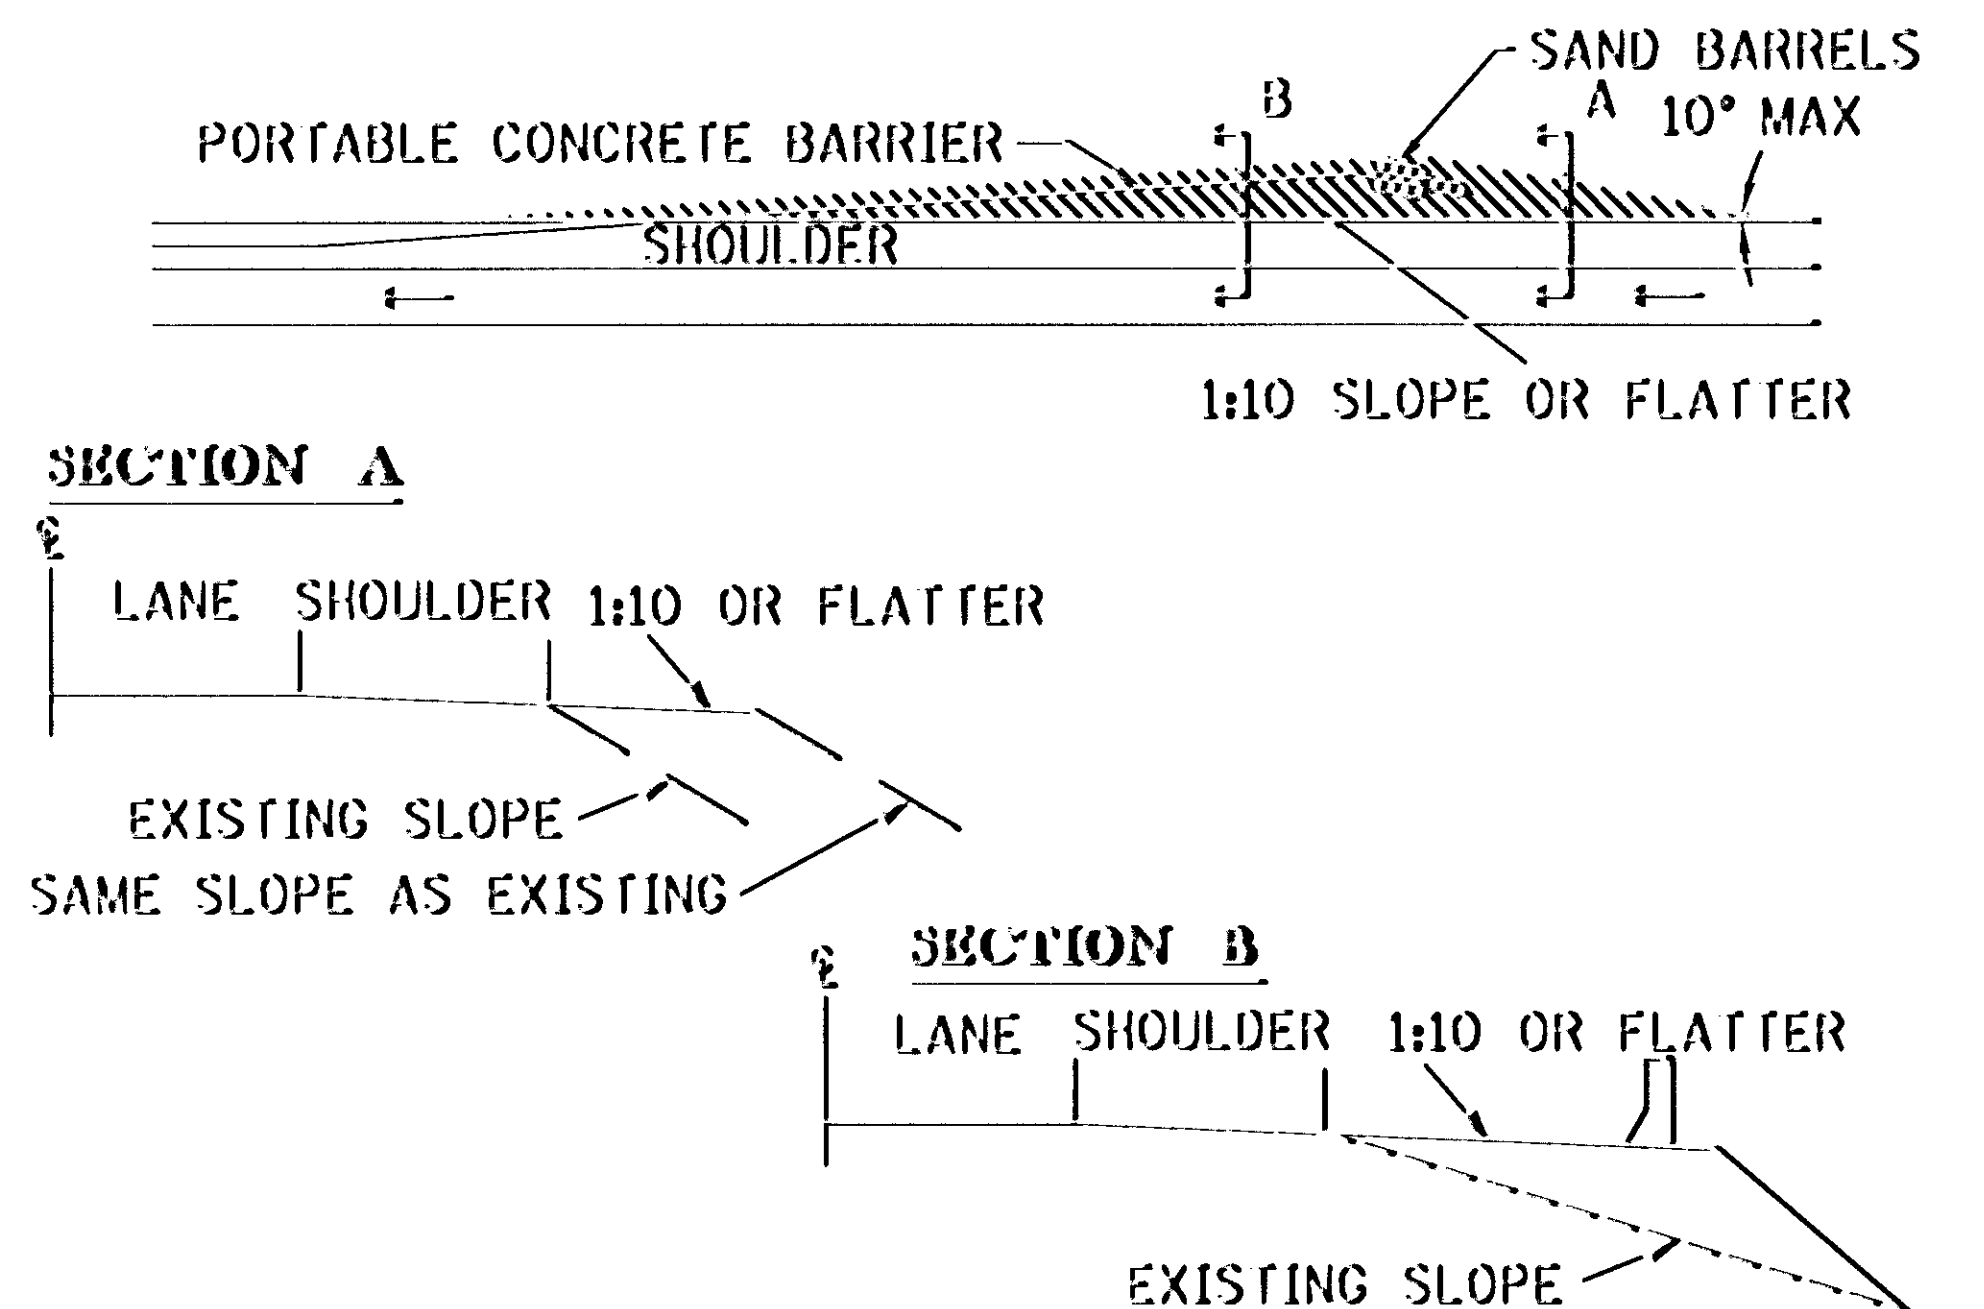

TRAFFIC CONTROL SHEET NO. 1

TITLE: GUIDELINES FOR PORTABLE CONCRETE BARRIER PLACEMENT AND END TREATMENTS IN WORK ZONES


CERTIFIED BY

Donald A. Demas
PROFESSIONAL ENGINEER


REG NO 23397 3-21 19 97

STATE PROJ NO S.A.P. 02-617-11, et al

SHEET NO 38 OF 236 SHEETS

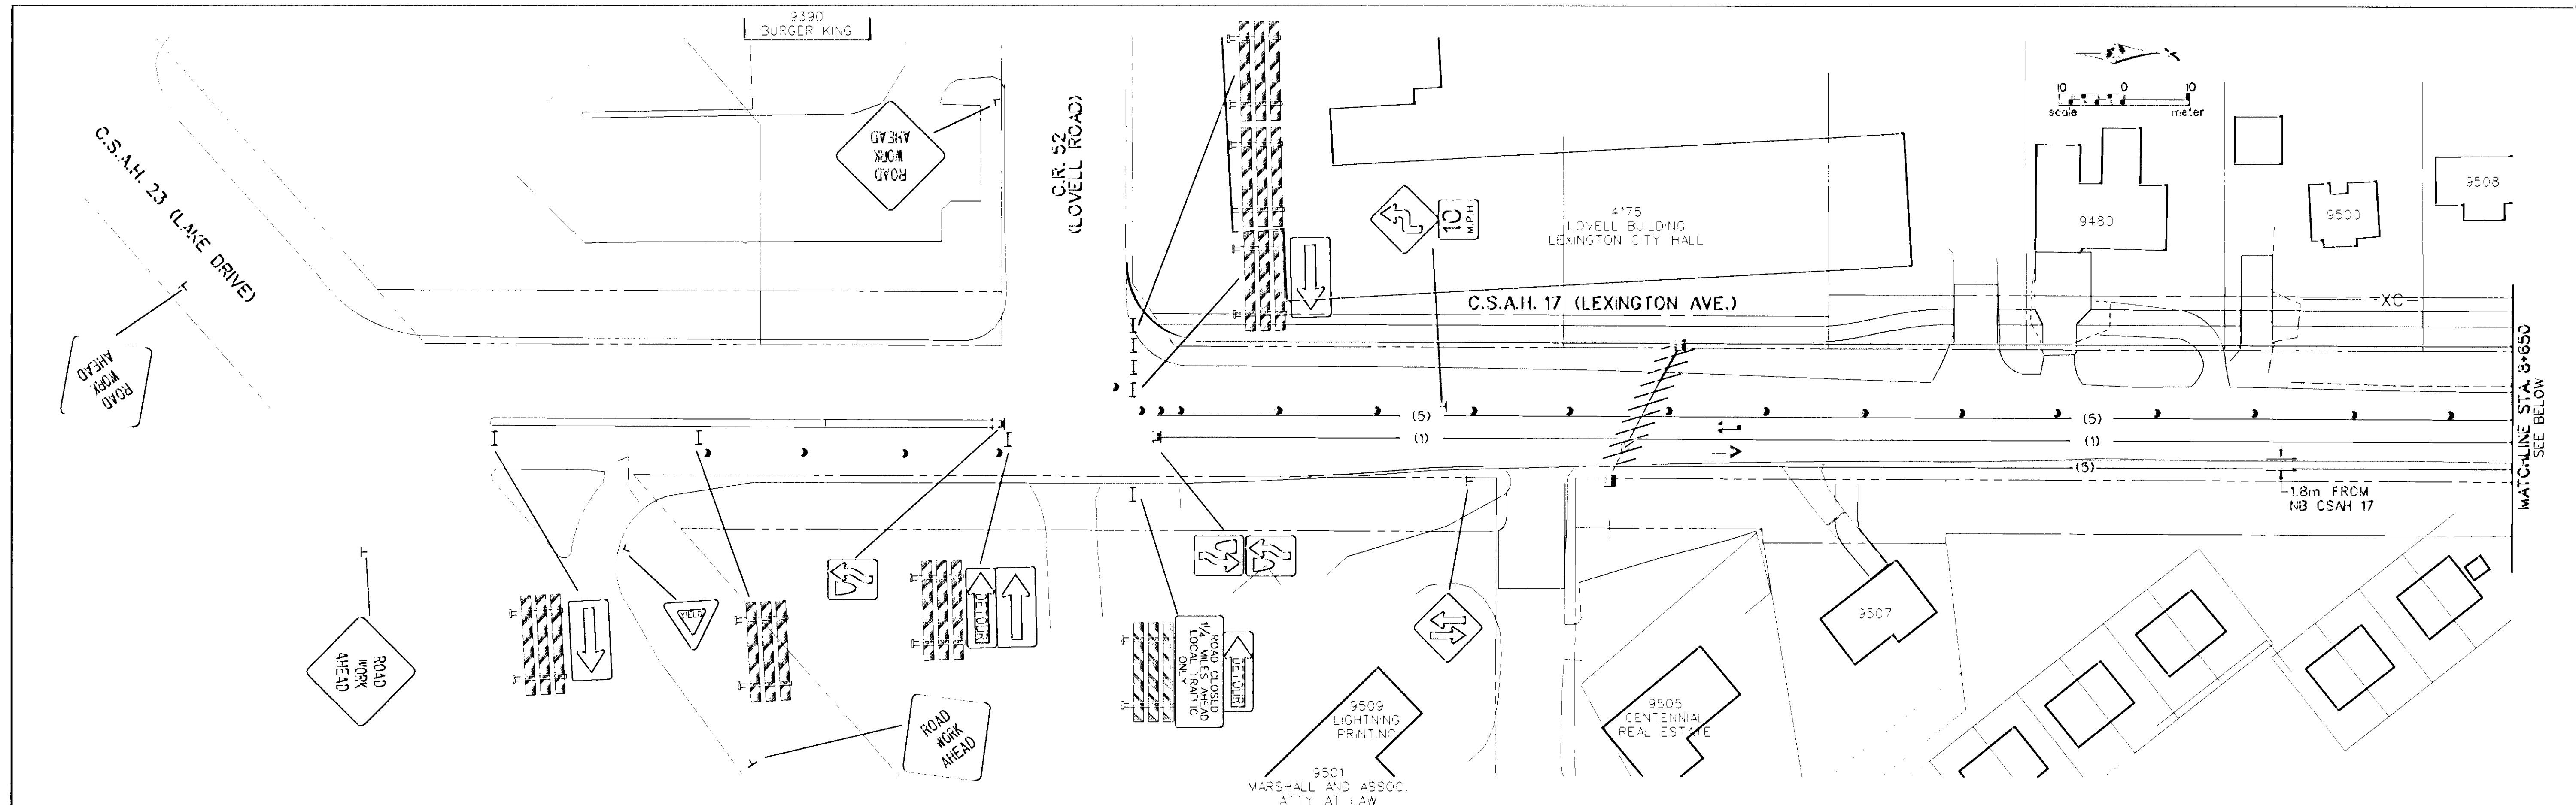

NOTES:
SEE TRAFFIC CONTROL SIGN TABULATION AND
GENERAL NOTES SHEET FOR GENERAL TRAFFIC
CONTROL NOTES AND LEGEND.

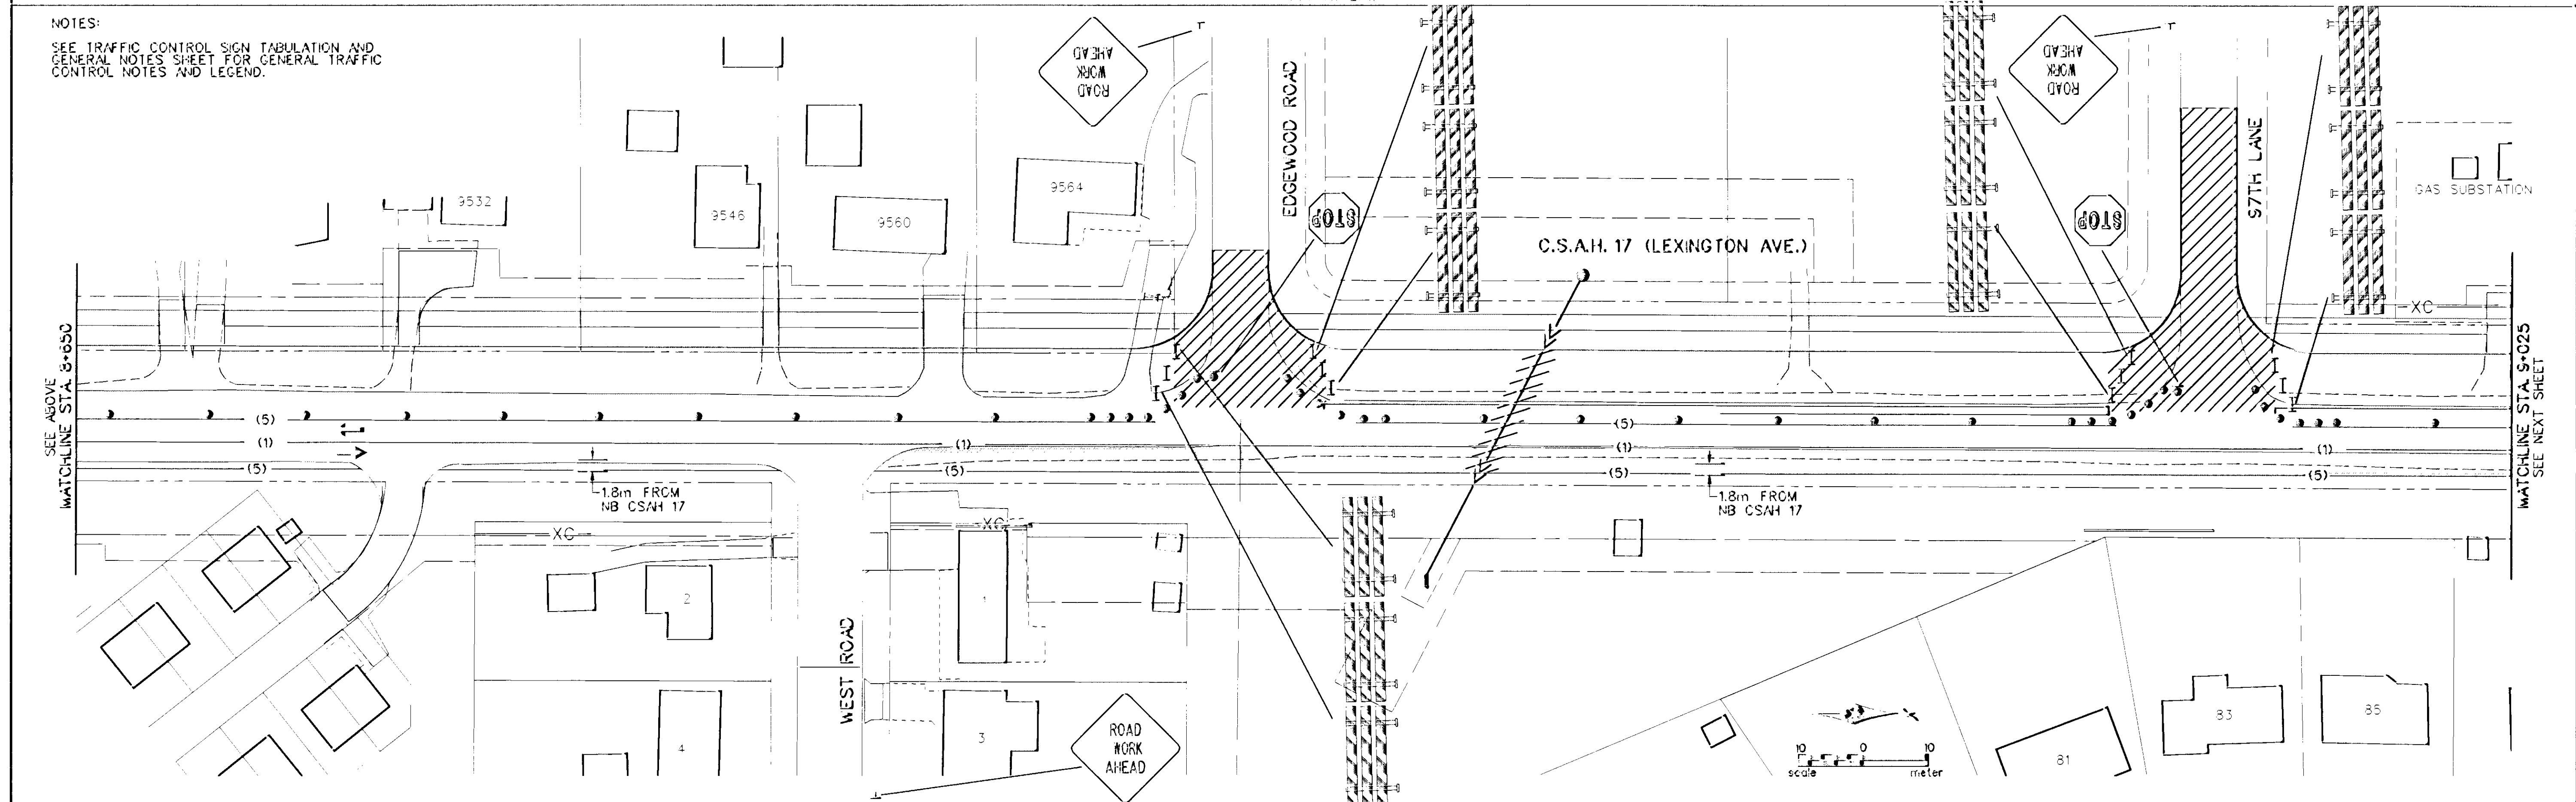

1	3-26-97	MCI	DAD	ADD WHITE STRIPE
NO	DATE	BY	CKD	APPR
NAME: TC1A 410.PLN	DATE: Mar. 19, 1997			

I hereby certify that this plan, specification or report was prepared by me or under my direct supervision and that I am a duly Registered Professional Engineer under the laws of the State of Minnesota.

Donald A. Demers

 Date 3-21-97 Reg. No. 23397

STATE AID PROJECT NO.

 S.A.P. 02-617-11

 S.A.P. 106-020-12

 S.A.P. 106-030-03

 CO. PROJECT NO.

DRAWN BY DATE

 M. HSAKKA 12-96

 DESIGNED BY

 D. DEMERS 12-96

 CHECKED BY

 D. DEMERS 1-97

 COMM. NO.

 0962410

ANOKA COUNTY

 TRAFFIC CONTROL-STAGE 1

 C.S.A.H. 17 RECONSTRUCTION


 STA. 8+358 TO STA. 9+025

SHEET


 39

 OF

 236

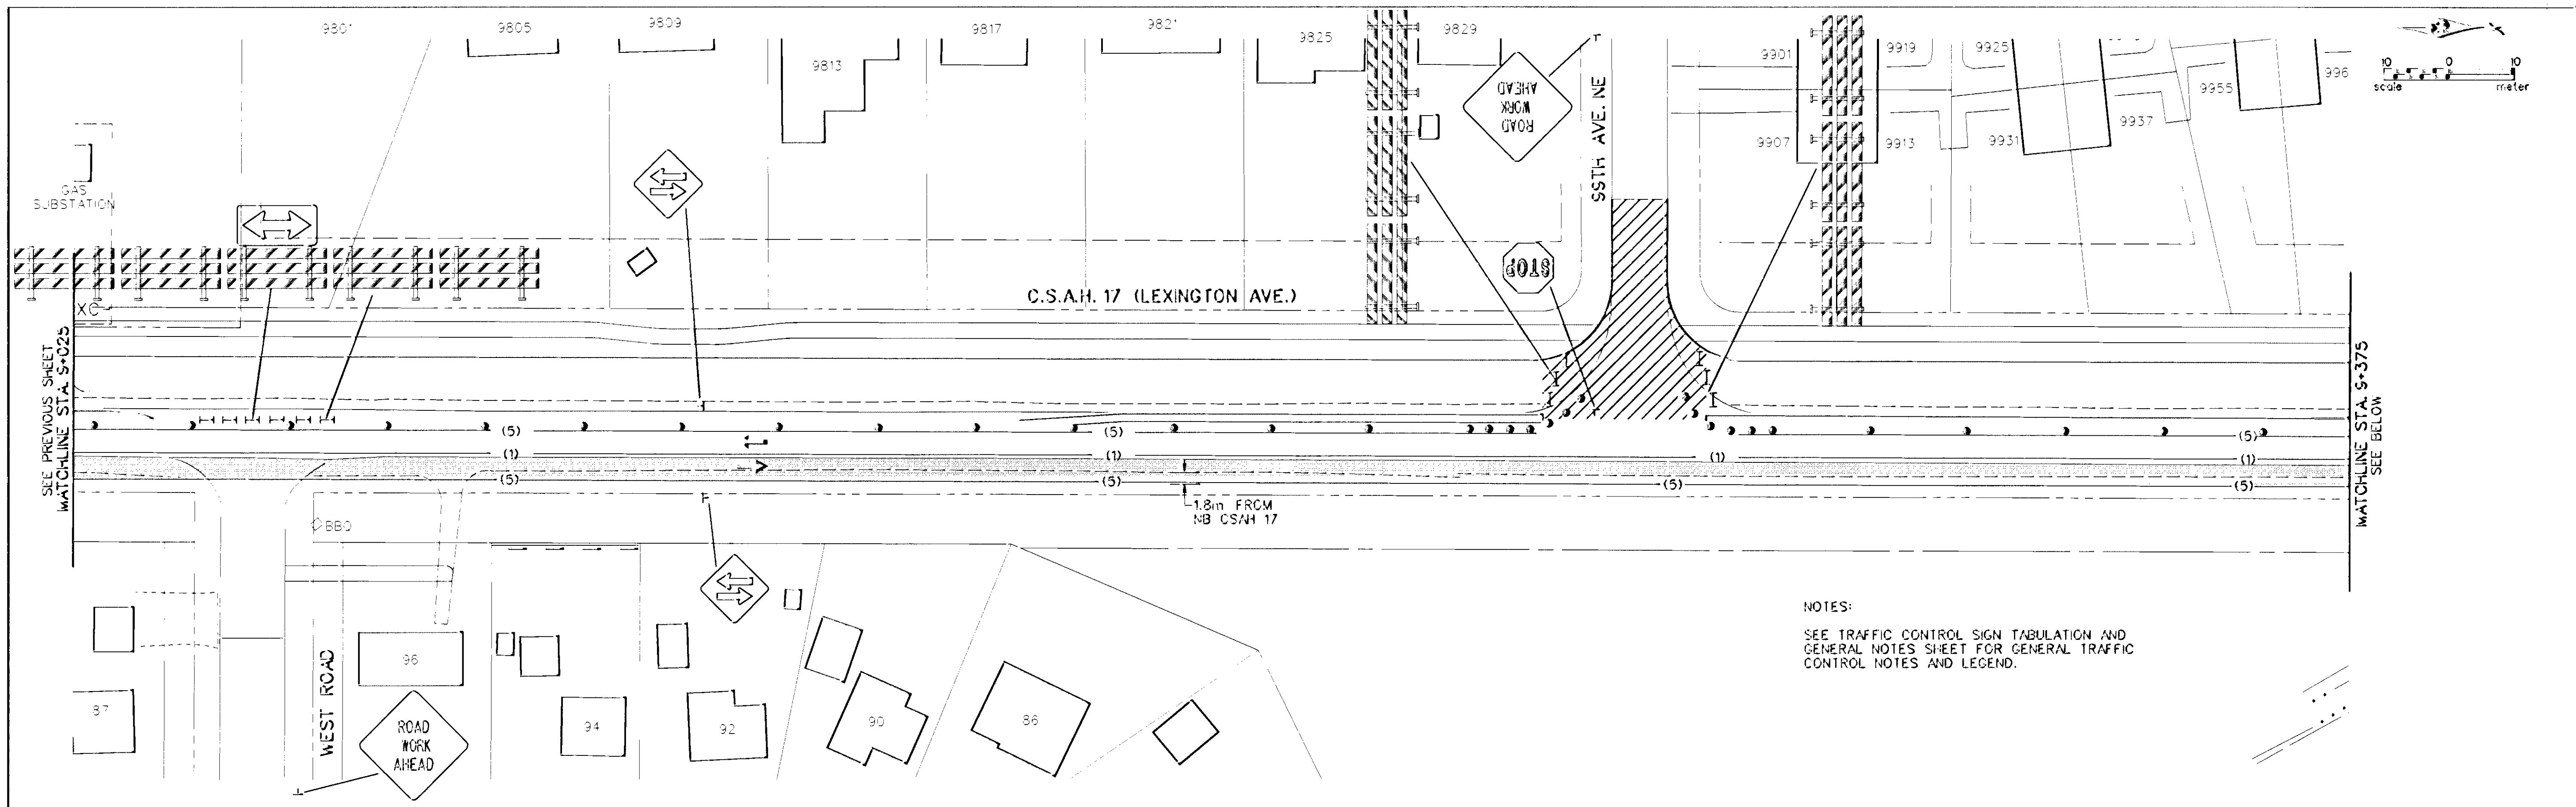


NOTES:
 SEE TRAFFIC CONTROL SIGN TABULATION AND GENERAL NOTES SHEET FOR GENERAL TRAFFIC CONTROL NOTES AND LEGEND.

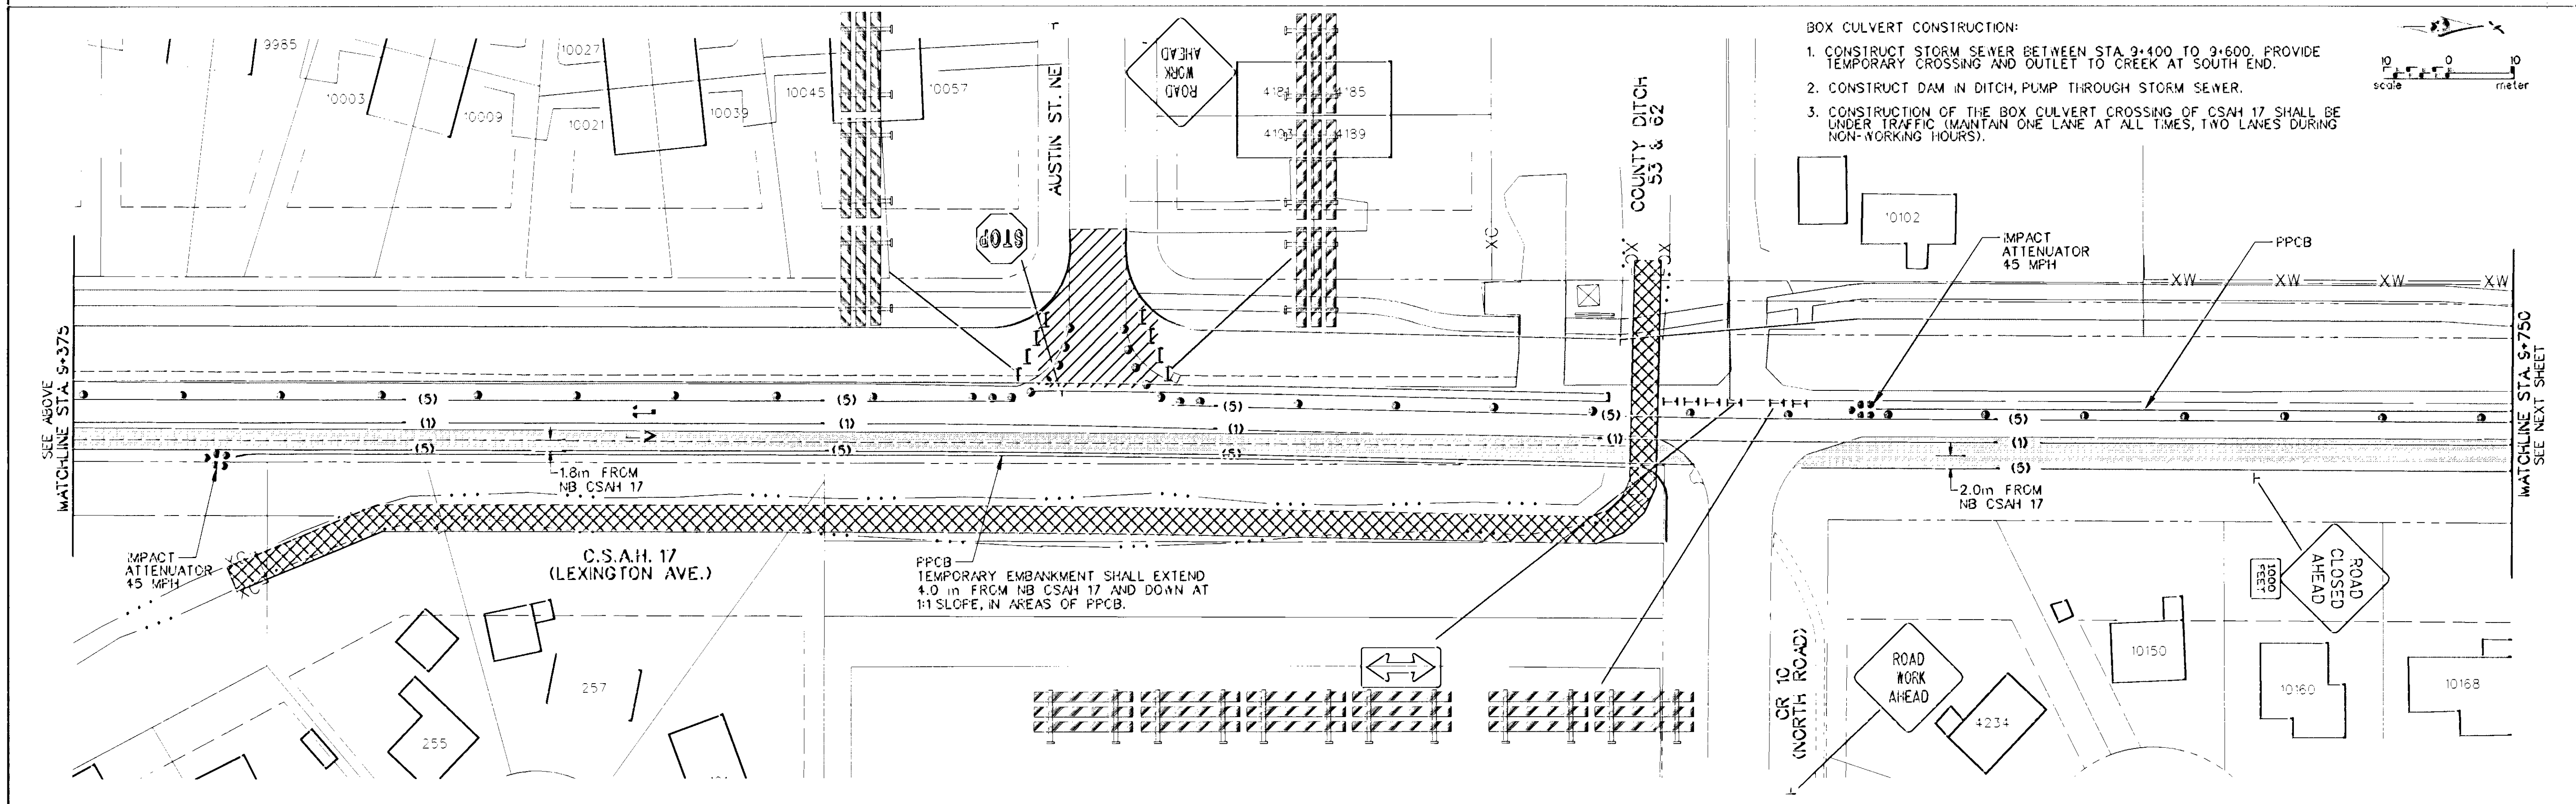

BOX CULVERT CONSTRUCTION:
 1. CONSTRUCT STORM SEWER BETWEEN STA 9+400 TO 9+600. PROVIDE TEMPORARY CROSSING AND OUTLET TO CREEK AT SOUTH END.
 2. CONSTRUCT DAM IN DITCH, PUMP THROUGH STORM SEWER.
 3. CONSTRUCTION OF THE BOX CULVERT CROSSING OF CSAH 17 SHALL BE UNDER TRAFFIC (MAINTAIN ONE LANE AT ALL TIMES, TWO LANES DURING NON-WORKING HOURS).


1	3-26-97	MCI	DAD	ADD WHITE STRIPE	
NO	DATE	BY	CHKD	APPR	REVISION
NAME: TC 1B 410.PLN DATE: Mar. 20, 1997					

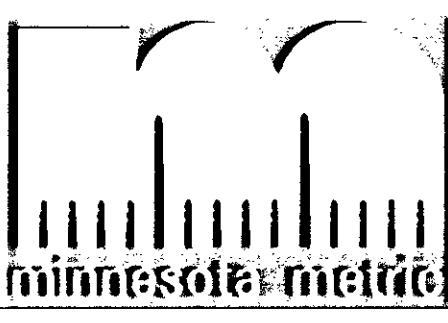

I hereby certify that this plan, specification or report was prepared by me or under my direct supervision and that I am a duly Registered Professional Engineer under the laws of the State of Minnesota.
Donald A. Demers
 Date 3-21-97 Reg. No. 23397

STATE AID PROJECT NO.
 S.A.P. 02-617-11
 S.A.P. 108-020-12
 S.A.P. 106-030-03
 CO. PROJECT NO.

DRAWN BY M. IISAKKA DATE 12-96
 DESIGNED BY D. DEMERS 12-96
 CHECKED BY D. DEMERS 1-97
 COMM. NO. 0982410




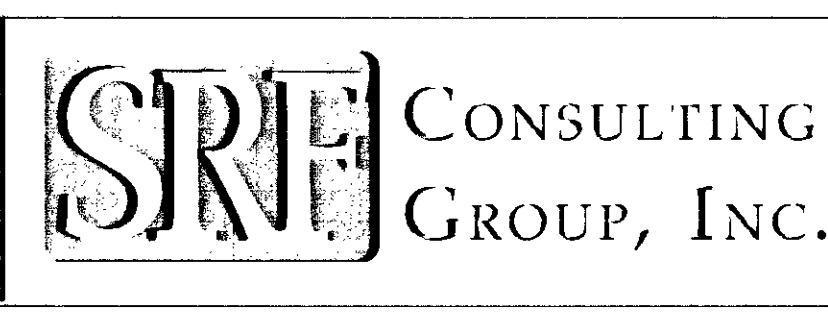


ANOKA COUNTY
 TRAFFIC CONTROL-STAGE 1
 C.S.A.H. 17 RECONSTRUCTION
 STA. 9+025 TO STA. 9+750

SHEET 40 OF 236


NOTES:

SEE TRAFFIC CONTROL SIGN TABULATION AND GENERAL NOTES SHEET FOR GENERAL TRAFFIC CONTROL NOTES AND LEGEND.

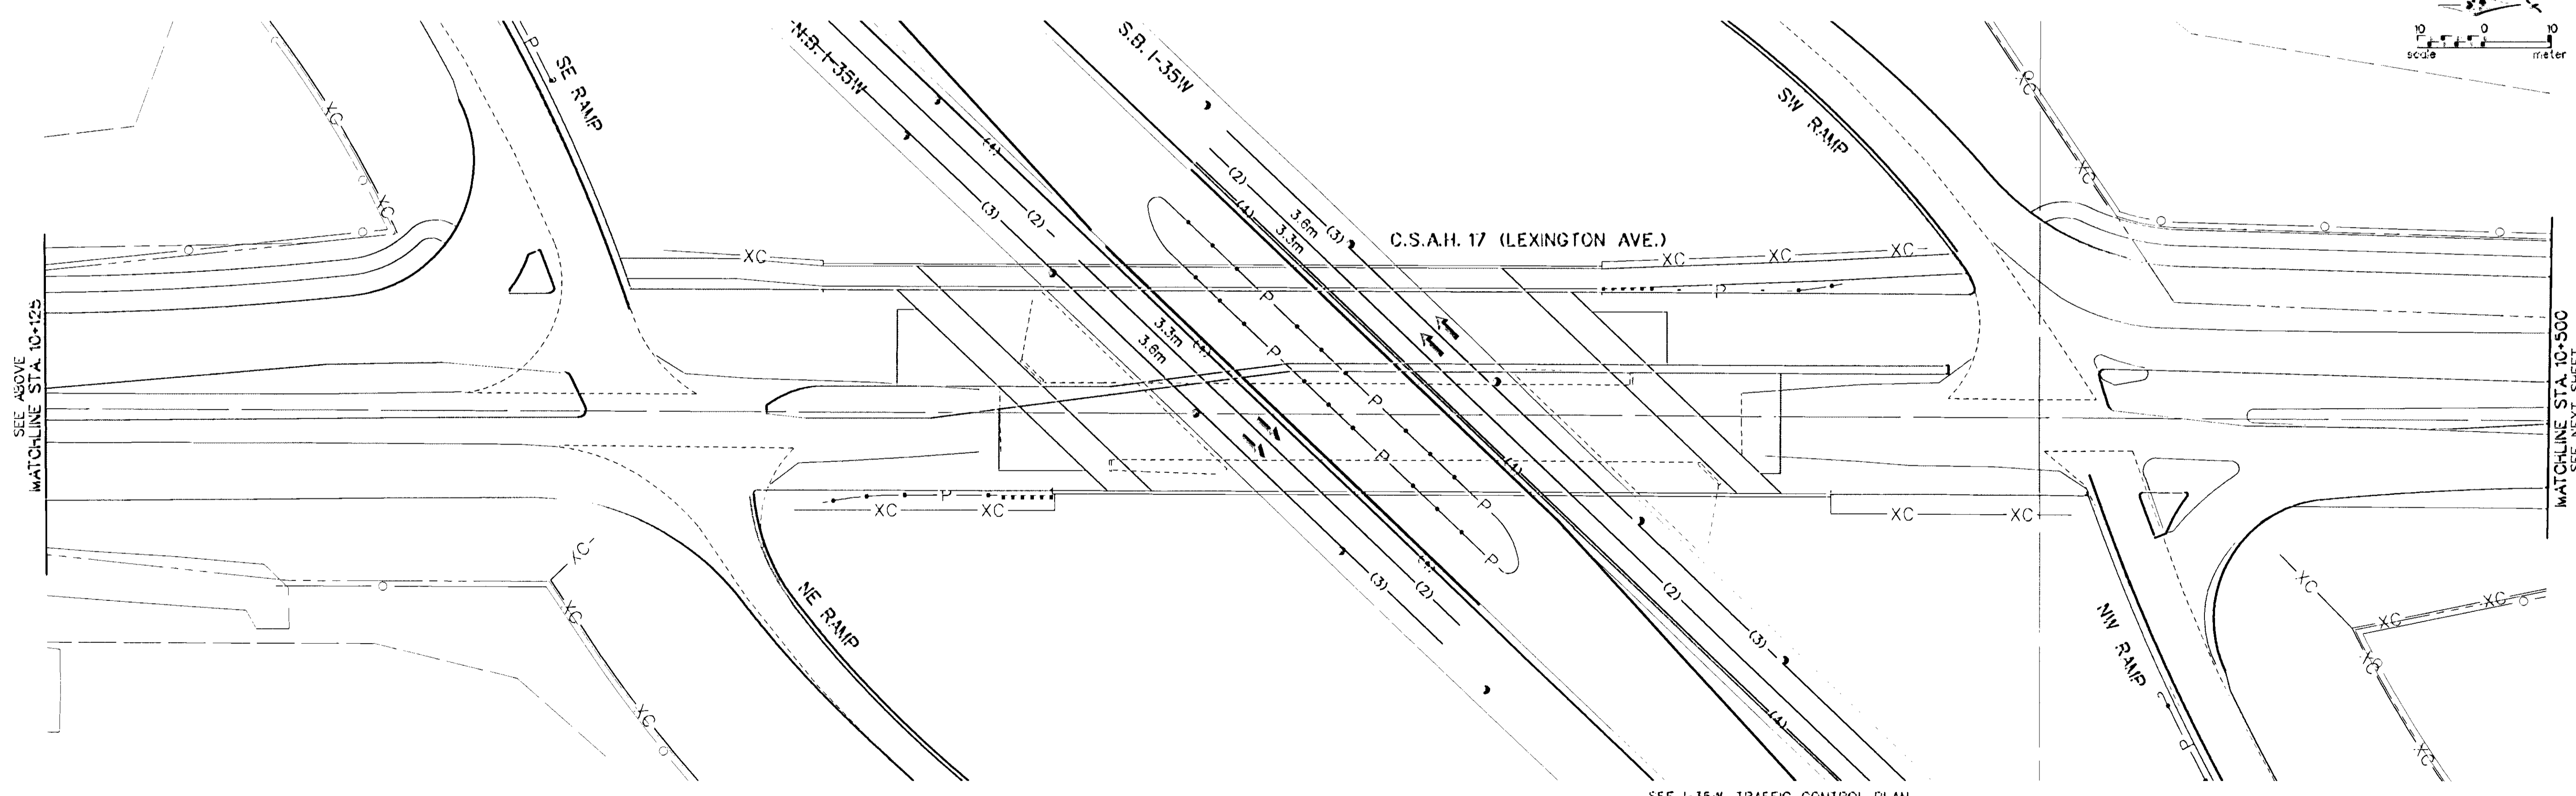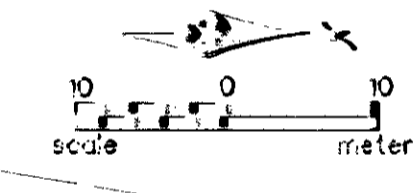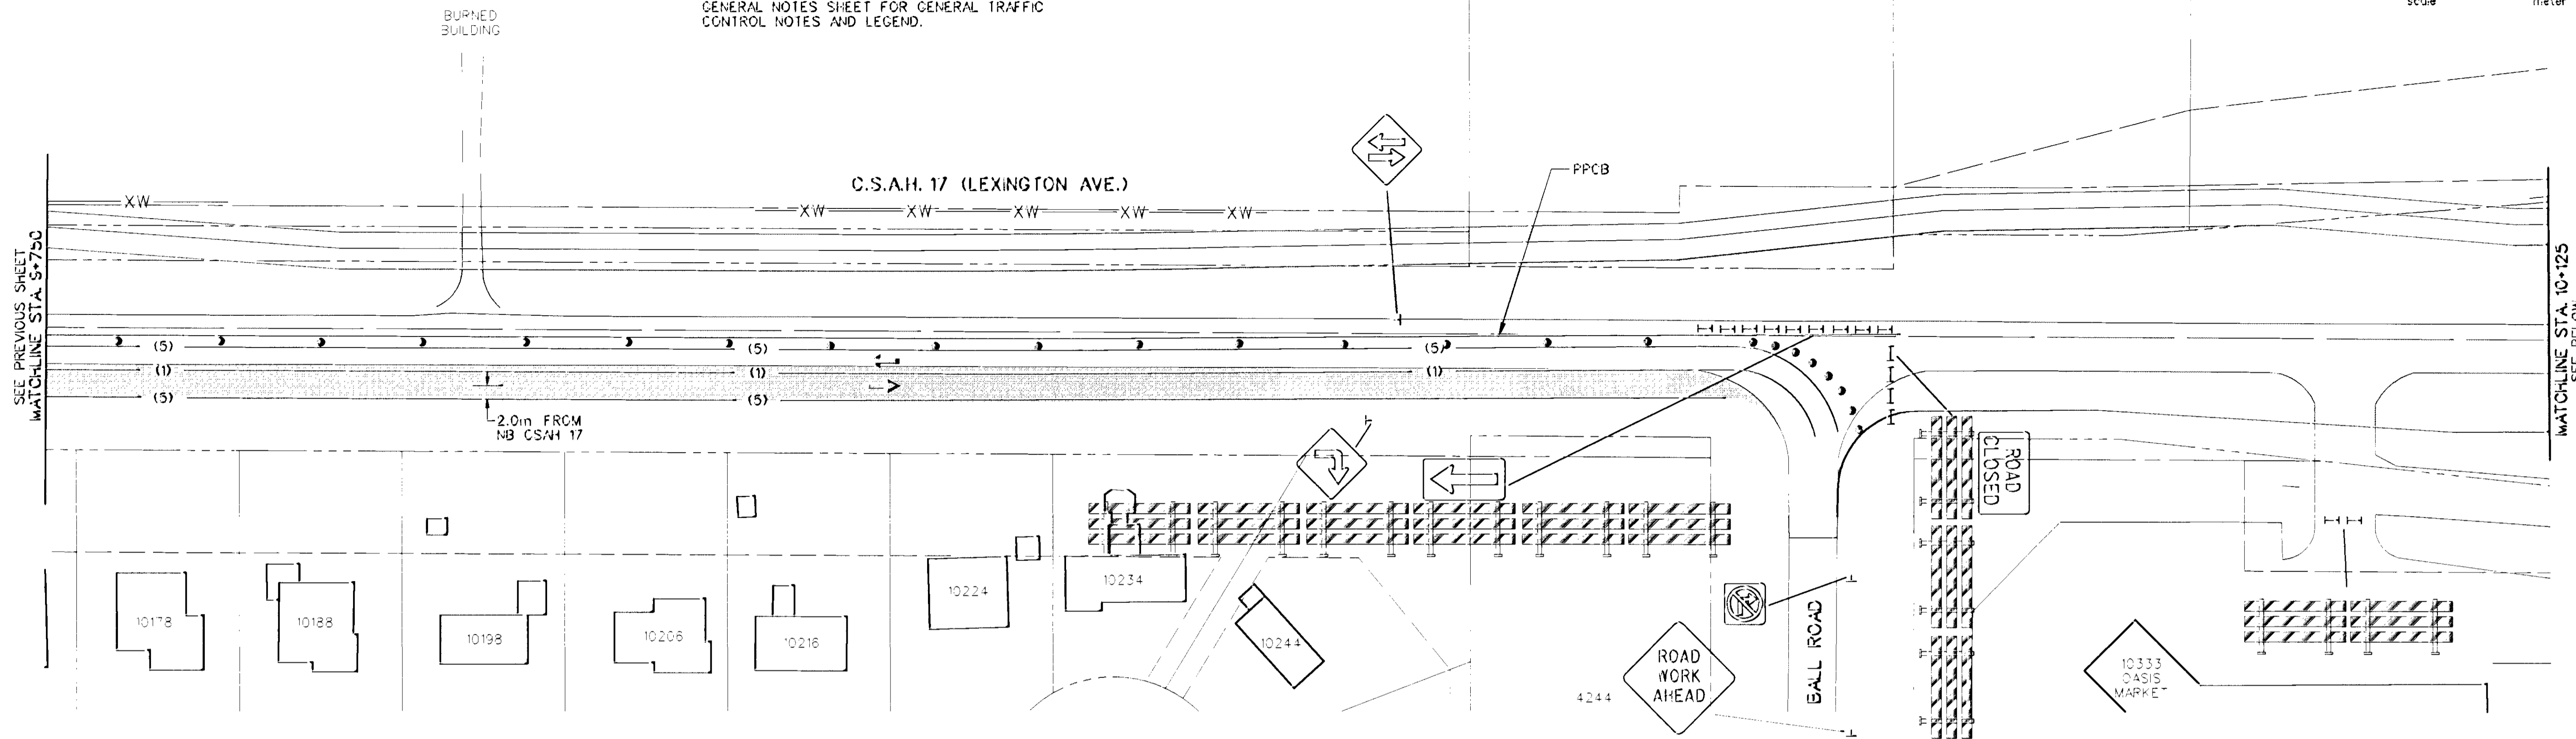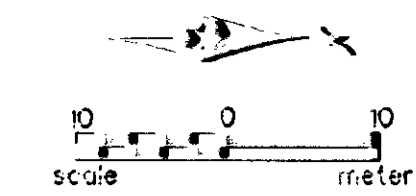

SEE I-35W TRAFFIC CONTROL PLAN


1	3-26-97	MCI	DAD	ADD PAINT STRIPE	
NO	DATE	BY	CKD	APPR	REVISION
NAME: TCIC 410.PLN DATE: Mar. 20, 1997					

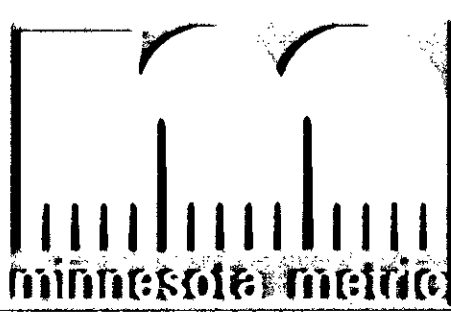

I hereby certify that this plan, specification or report was prepared by me or under my direct supervision and that I am a duly Registered Professional Engineer under the laws of the State of Minnesota.
Donald A. Demers
 Date: 3-21-97 Reg. No. 23397


STATE AID PROJECT NO.
 S.A.P. 02-617-11
 S.A.P. 106-020-12
 S.A.P. 106-030-03
 CO. PROJECT NO.

DRAWN BY M. IISAKKA DATE 12-96
 DESIGNED BY D. DEMERS 12-96
 CHECKED BY D. DEMERS 1-97
 COMM. NO. 0962410

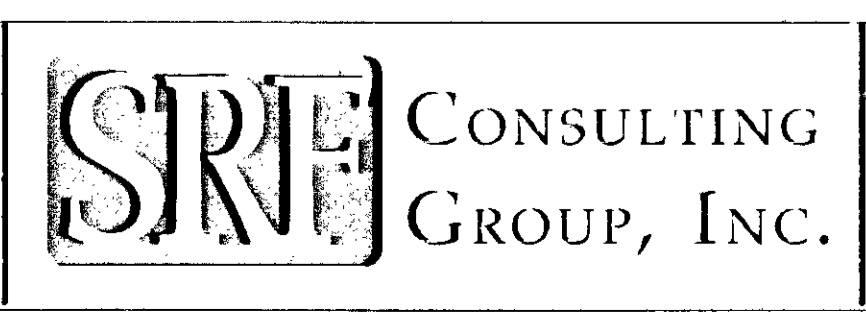

ANOKA COUNTY
 TRAFFIC CONTROL-STAGE 1
 C.S.A.H. 17 RECONSTRUCTION
 STA. 9+750 TO STA. 10+500

SHEET 41 OF 236

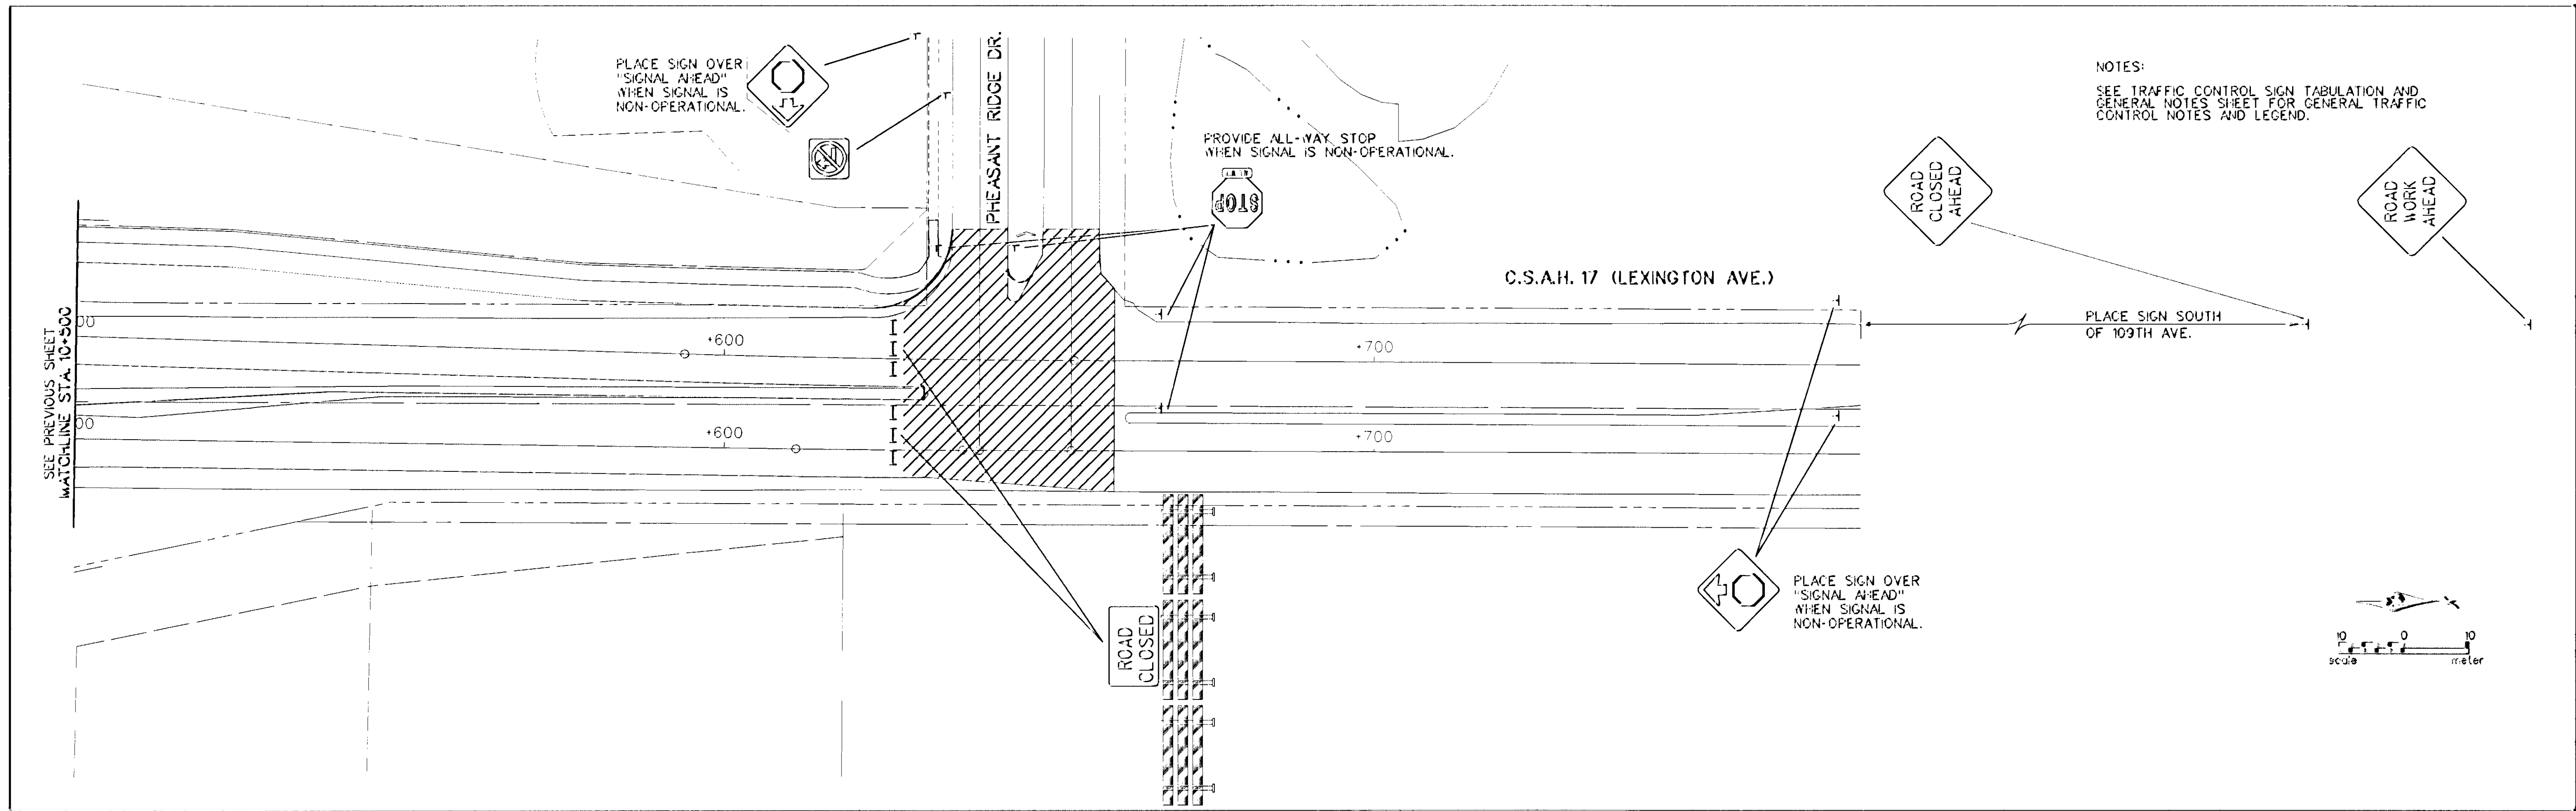

NO.	DATE	BY	CHKD	APPR	REVISION

NAME: TCID 410.PLN DATE: Mar. 17, 1997



I hereby certify that this plan, specification or report was prepared by me or under my direct supervision and that I am a duly Registered Professional Engineer under the laws of the State of Minnesota.

Gonell A Demers
Date: 3-21-97 Reg. No. 23397


STATE AID PROJECT NO.
S.A.P. 02-617-11
S.A.P. 106-020-12
S.A.P. 106-030-03
CO. PROJECT NO.

DRAWN BY DATE
M. IISAKKA 12-96
DESIGNED BY
D. DEMERS 12-96
CHECKED BY
D. DEMERS 1-97
COMM. NO.
0962410





ANOKA COUNTY
TRAFFIC CONTROL-STAGE 1
C.S.A.H. 17 RECONSTRUCTION
STA. 10+500 TO STA. 10+660


SHEET
42
OF
236

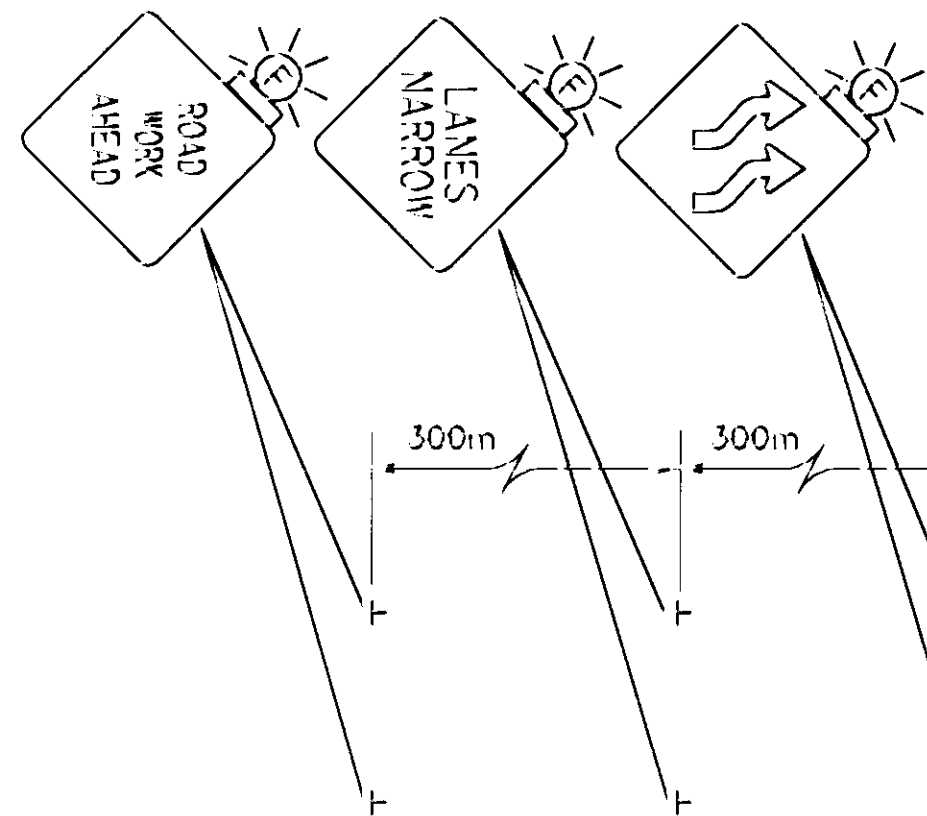

NOTES:
SEE TRAFFIC CONTROL SIGN TABULATION AND GENERAL NOTES SHEET FOR GENERAL TRAFFIC CONTROL NOTES AND LEGEND.

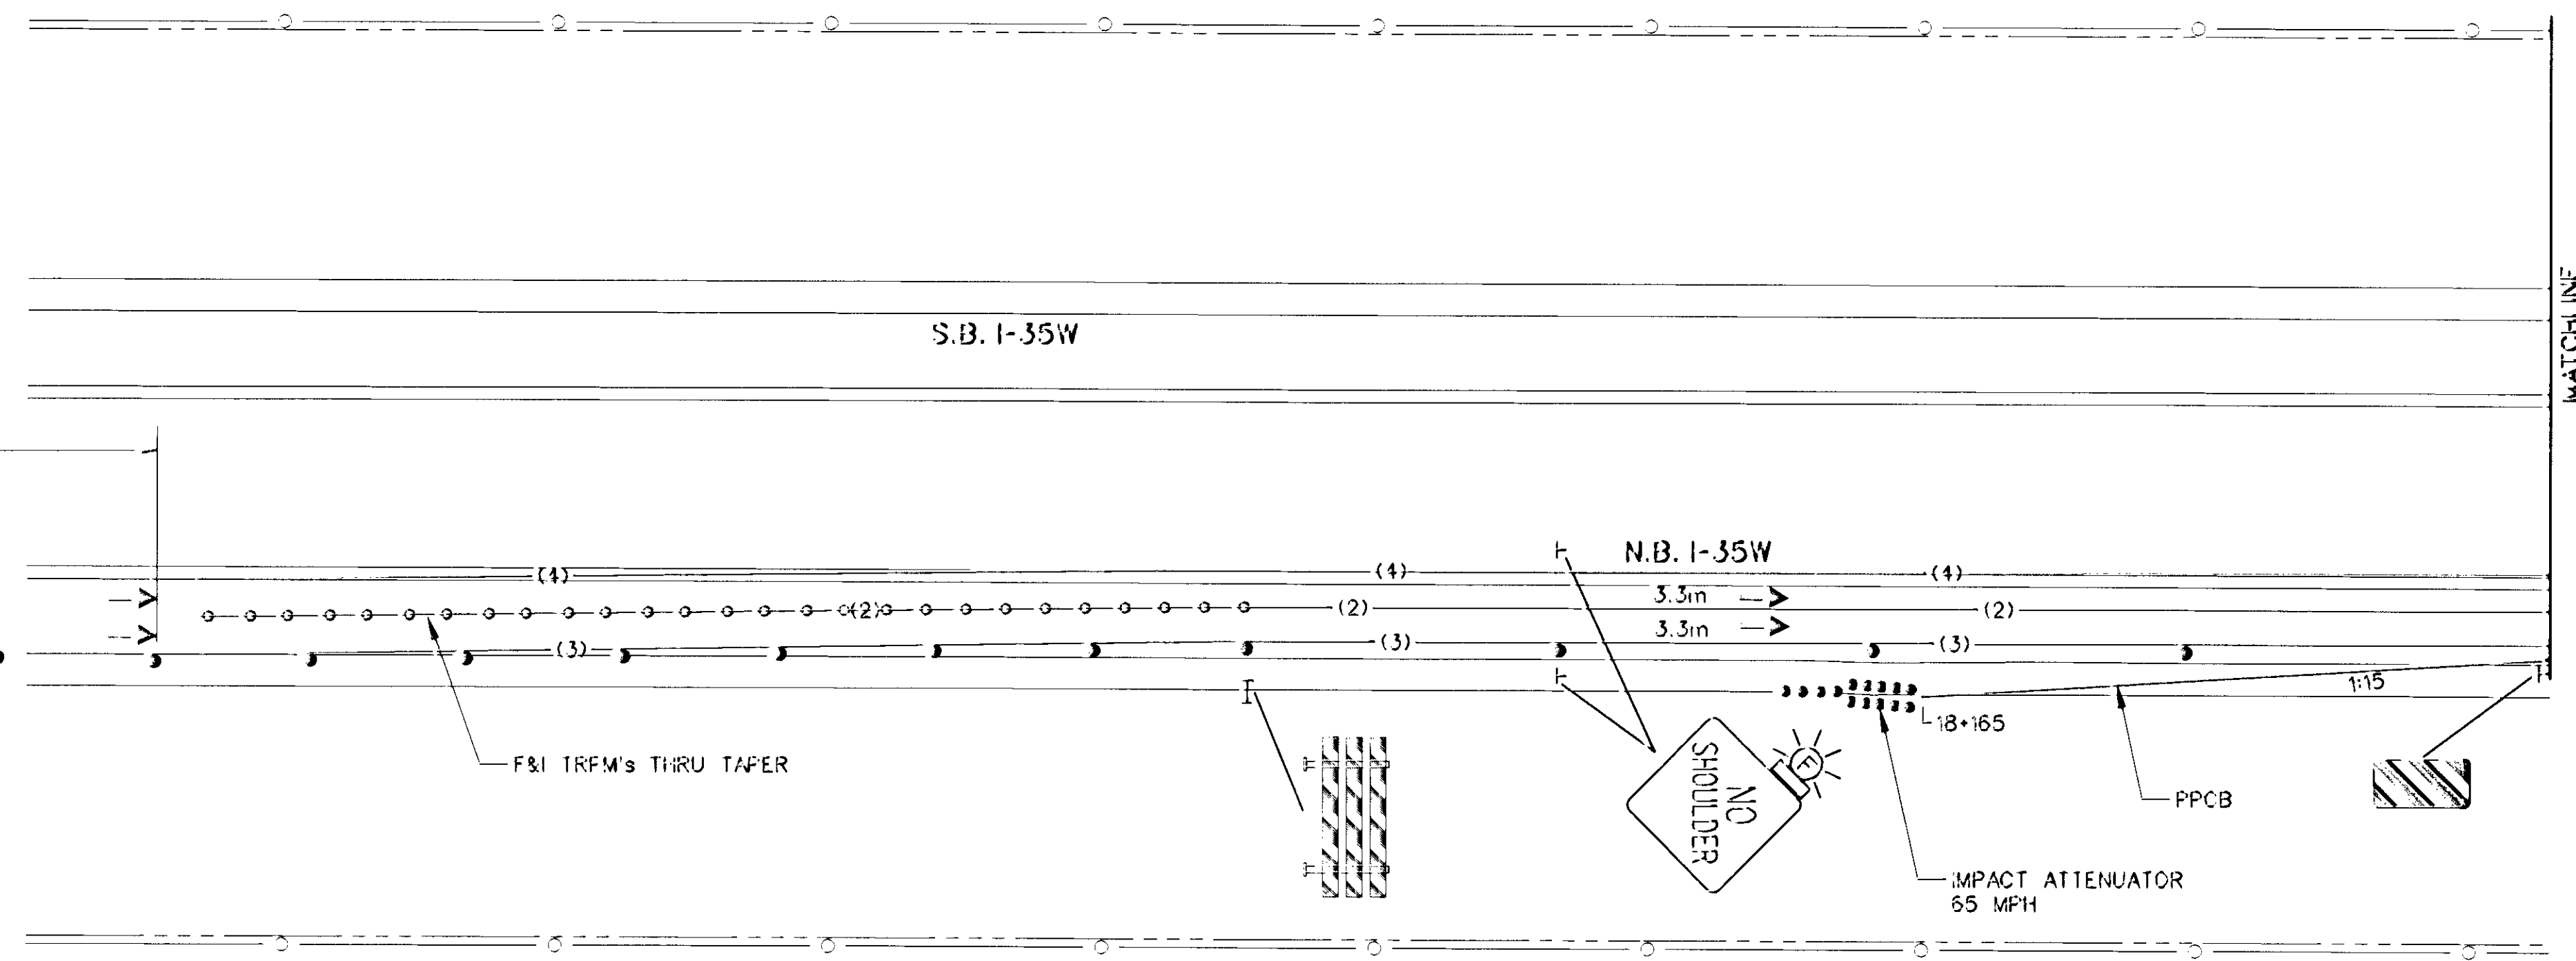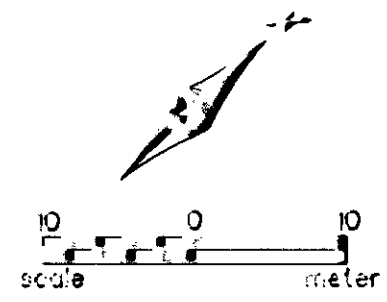


MATCHLINE
SEE BELOW LEFT

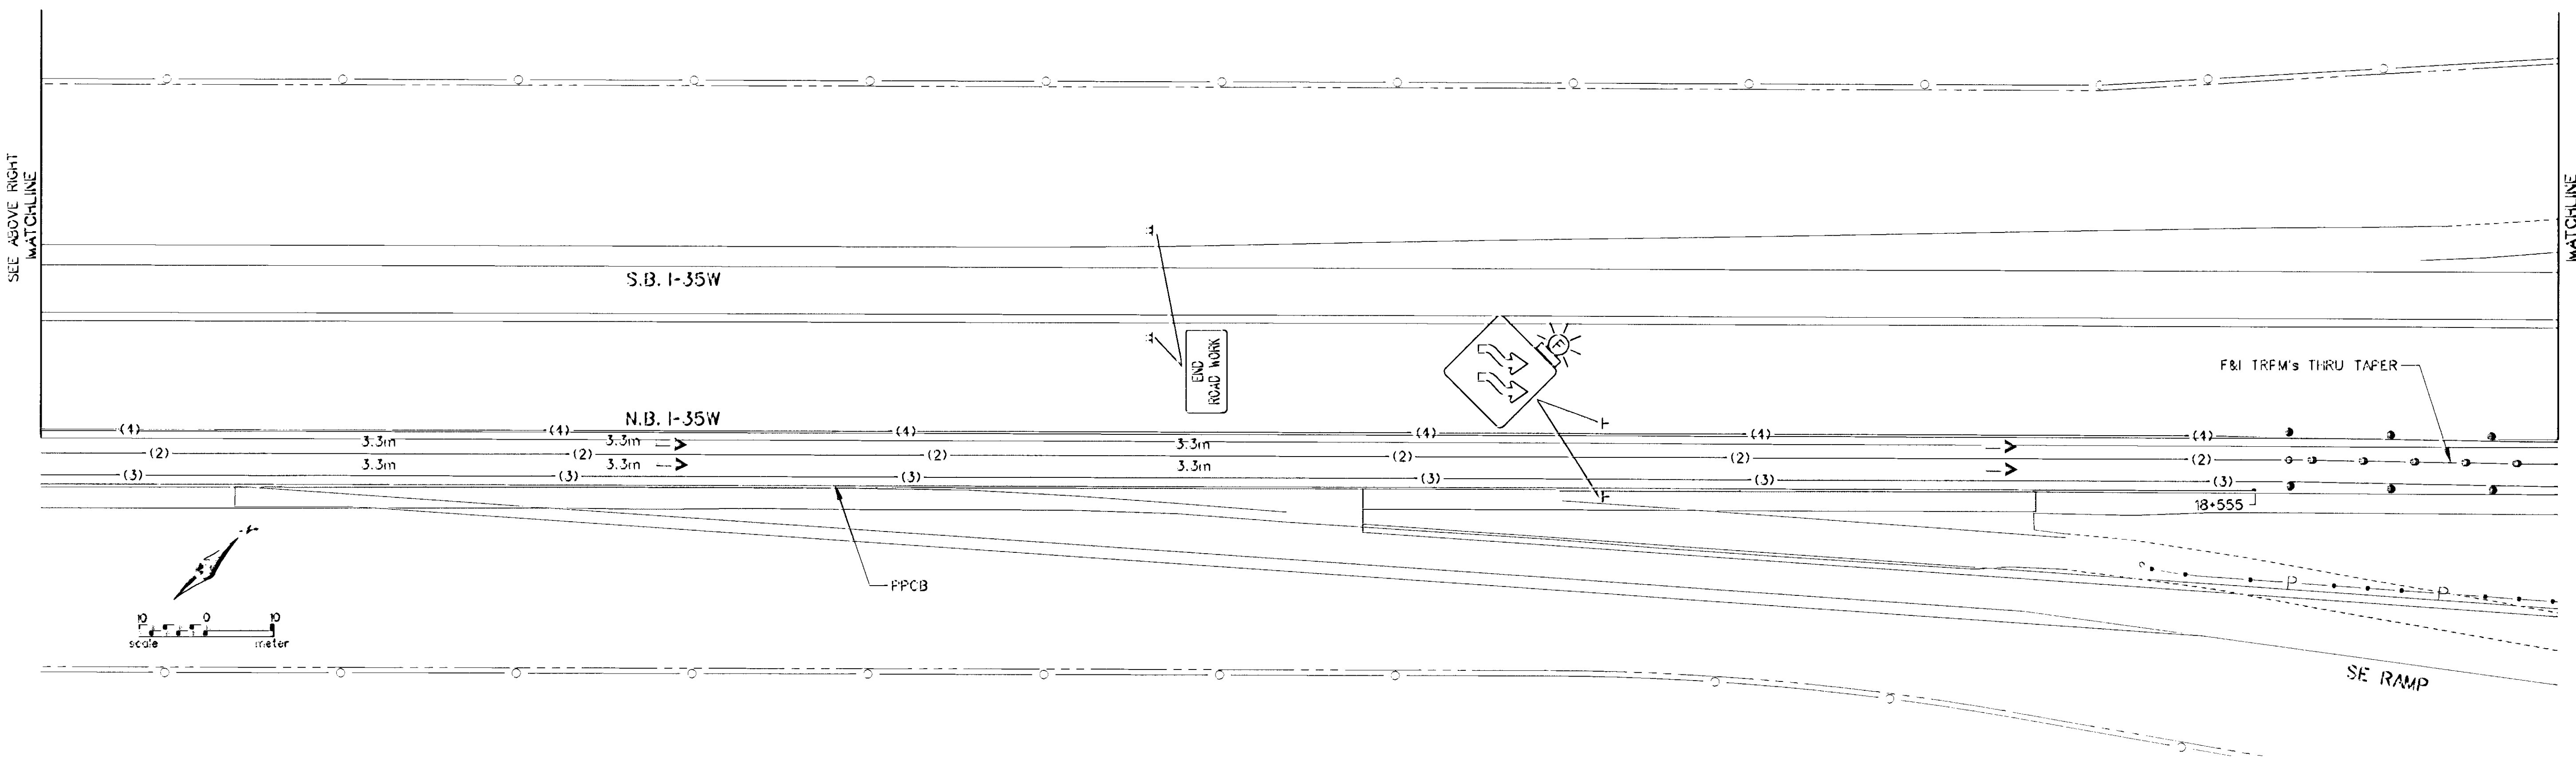

SEE ABOVE RIGHT
MATCHLINE

MATCHLINE
SEE NEXT SHEET

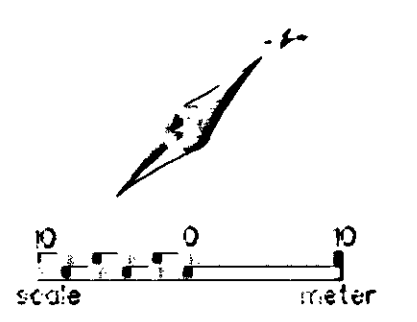

NO	DATE	BY	CHKD	APPR	REVISION

NAME: TCIE 410.PLN DATE: Mar. 17, 1997



I hereby certify that this plan, specification or report was prepared by me or under my direct supervision and that I am a duly Registered Professional Engineer under the laws of the State of Minnesota.
Donald A. Demers
Date: 3-21-97 Reg. No. 23397



STATE AID PROJECT NO.
S.A.P. 02-617-11
S.A.P. 106-020-12
S.A.P. 106-030-03
CO. PROJECT NO.

DRAWN BY DATE
M. IISAKKA 12-96
DESIGNED BY
D. DEMERS 12-96
CHECKED BY
D. DEMERS 1-97
COMM. NO.
0962410



ANOKA COUNTY
TRAFFIC CONTROL - STAGE 1 AND 2
C.S.A.H. 17 RECONSTRUCTION
INTERSTATE 35W

SHEET
43
OF
236

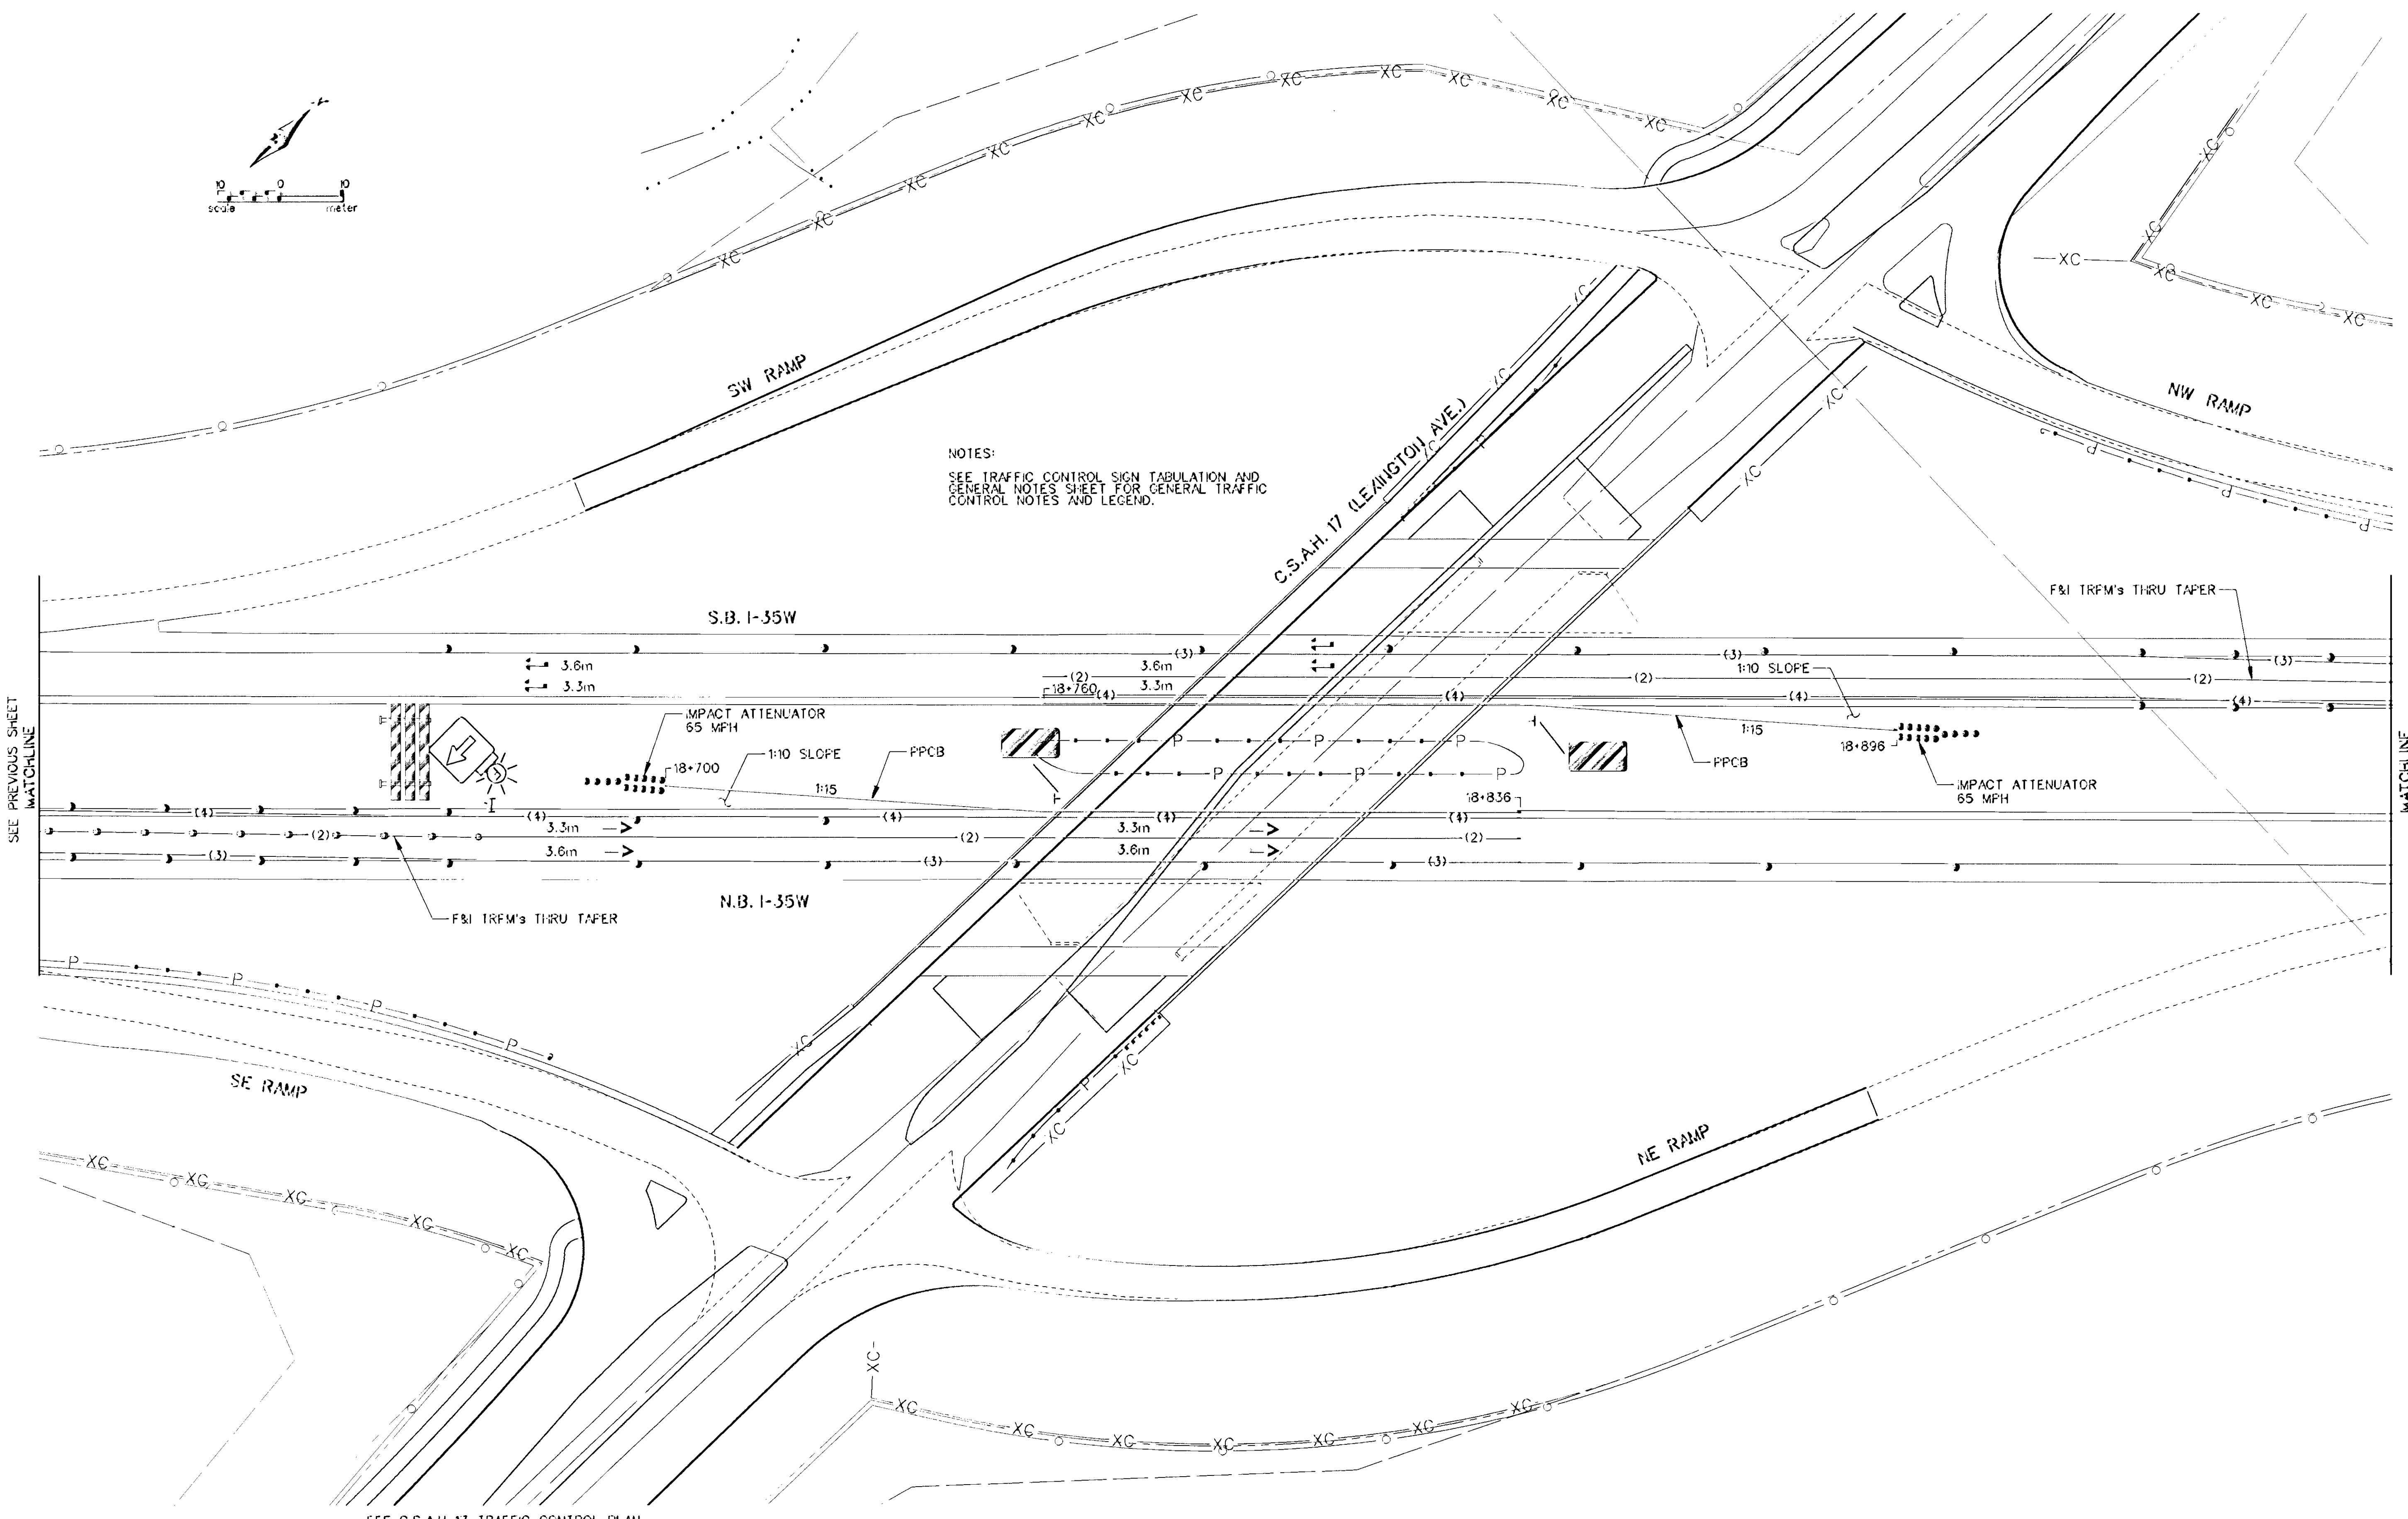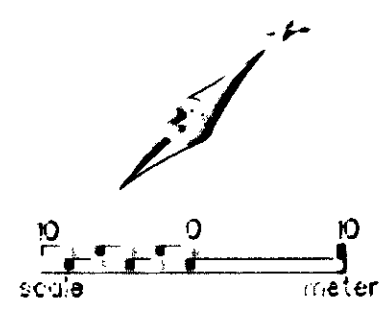

NOTES:
SEE TRAFFIC CONTROL SIGN TABULATION AND GENERAL NOTES SHEET FOR GENERAL TRAFFIC CONTROL NOTES AND LEGEND.


SEE PREVIOUS SHEET MATCHLINE

MATCHLINE SEE NEXT SHEET

SEE C.S.A.H. 17 TRAFFIC CONTROL PLAN

NO.	DATE	BY	CHKD	APPR	REVISION

NAME: TCIF 410.PLN DATE: Mar. 17, 1997

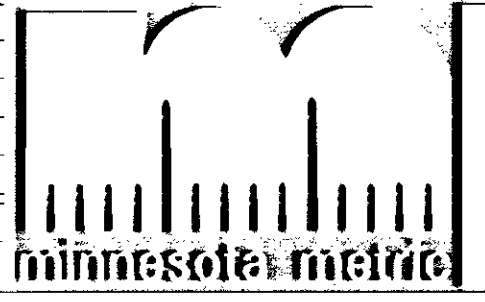

I hereby certify that this plan, specification or report was prepared by me or under my direct supervision and that I am a duly Registered Professional Engineer under the laws of the State of Minnesota.
Donald A. James
Date: 3-21-97 Reg. No. 23397


STATE AID PROJECT NO.
S.A.P. 02-617-11
S.A.P. 106-020-12
S.A.P. 106-030-03
CO. PROJECT NO.

DRAWN BY DATE
M. IISAKKA 12-96
DESIGNED BY
D. DEMERS 12-96
CHECKED BY
D. DEMERS 1-97
COMM. NO.
0962410




ANOKA COUNTY
TRAFFIC CONTROL- STAGE 1 AND 2
C.S.A.H. 17 RECONSTRUCTION
INTERSTATE 35W

SHEET
44
OF
236

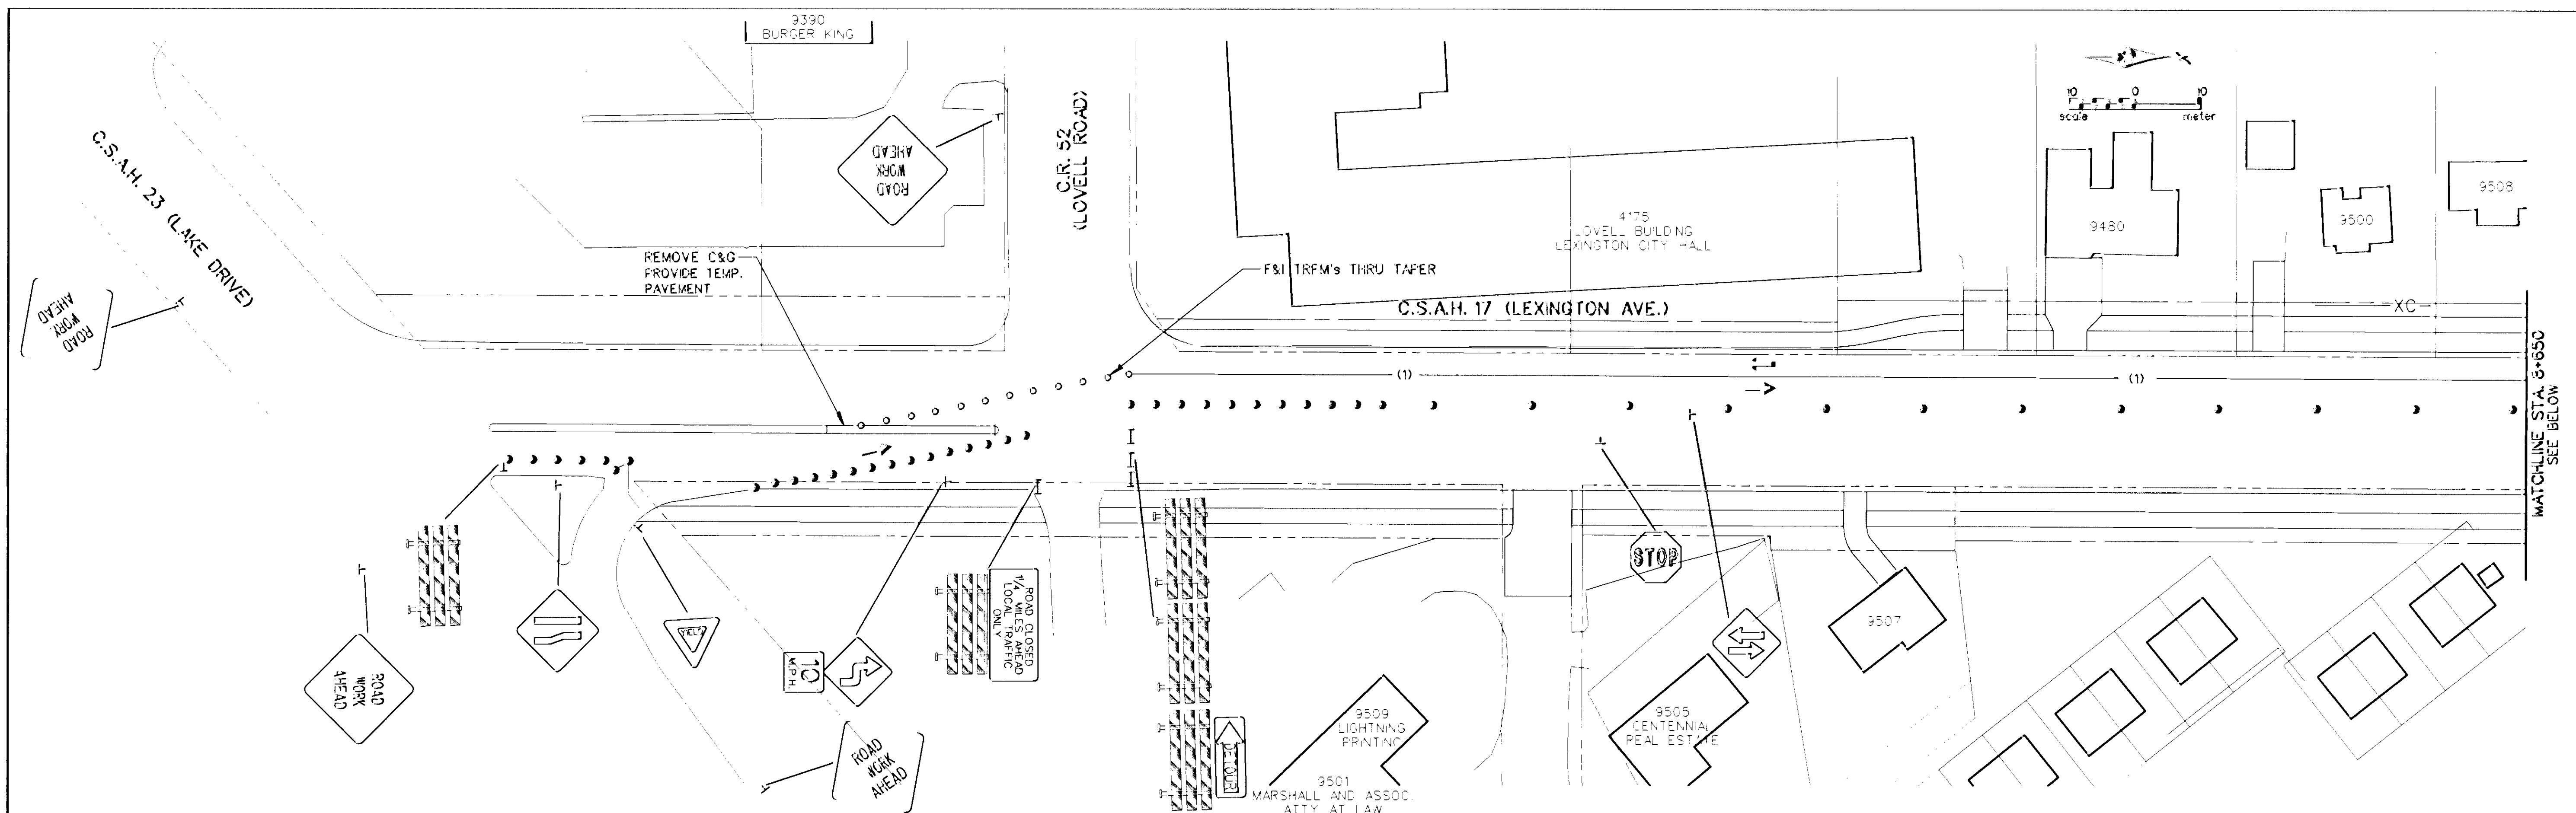

NOTES:
 SEE TRAFFIC CONTROL SIGN TABULATION AND
 GENERAL NOTES SHEET FOR GENERAL TRAFFIC
 CONTROL NOTES AND LEGEND.

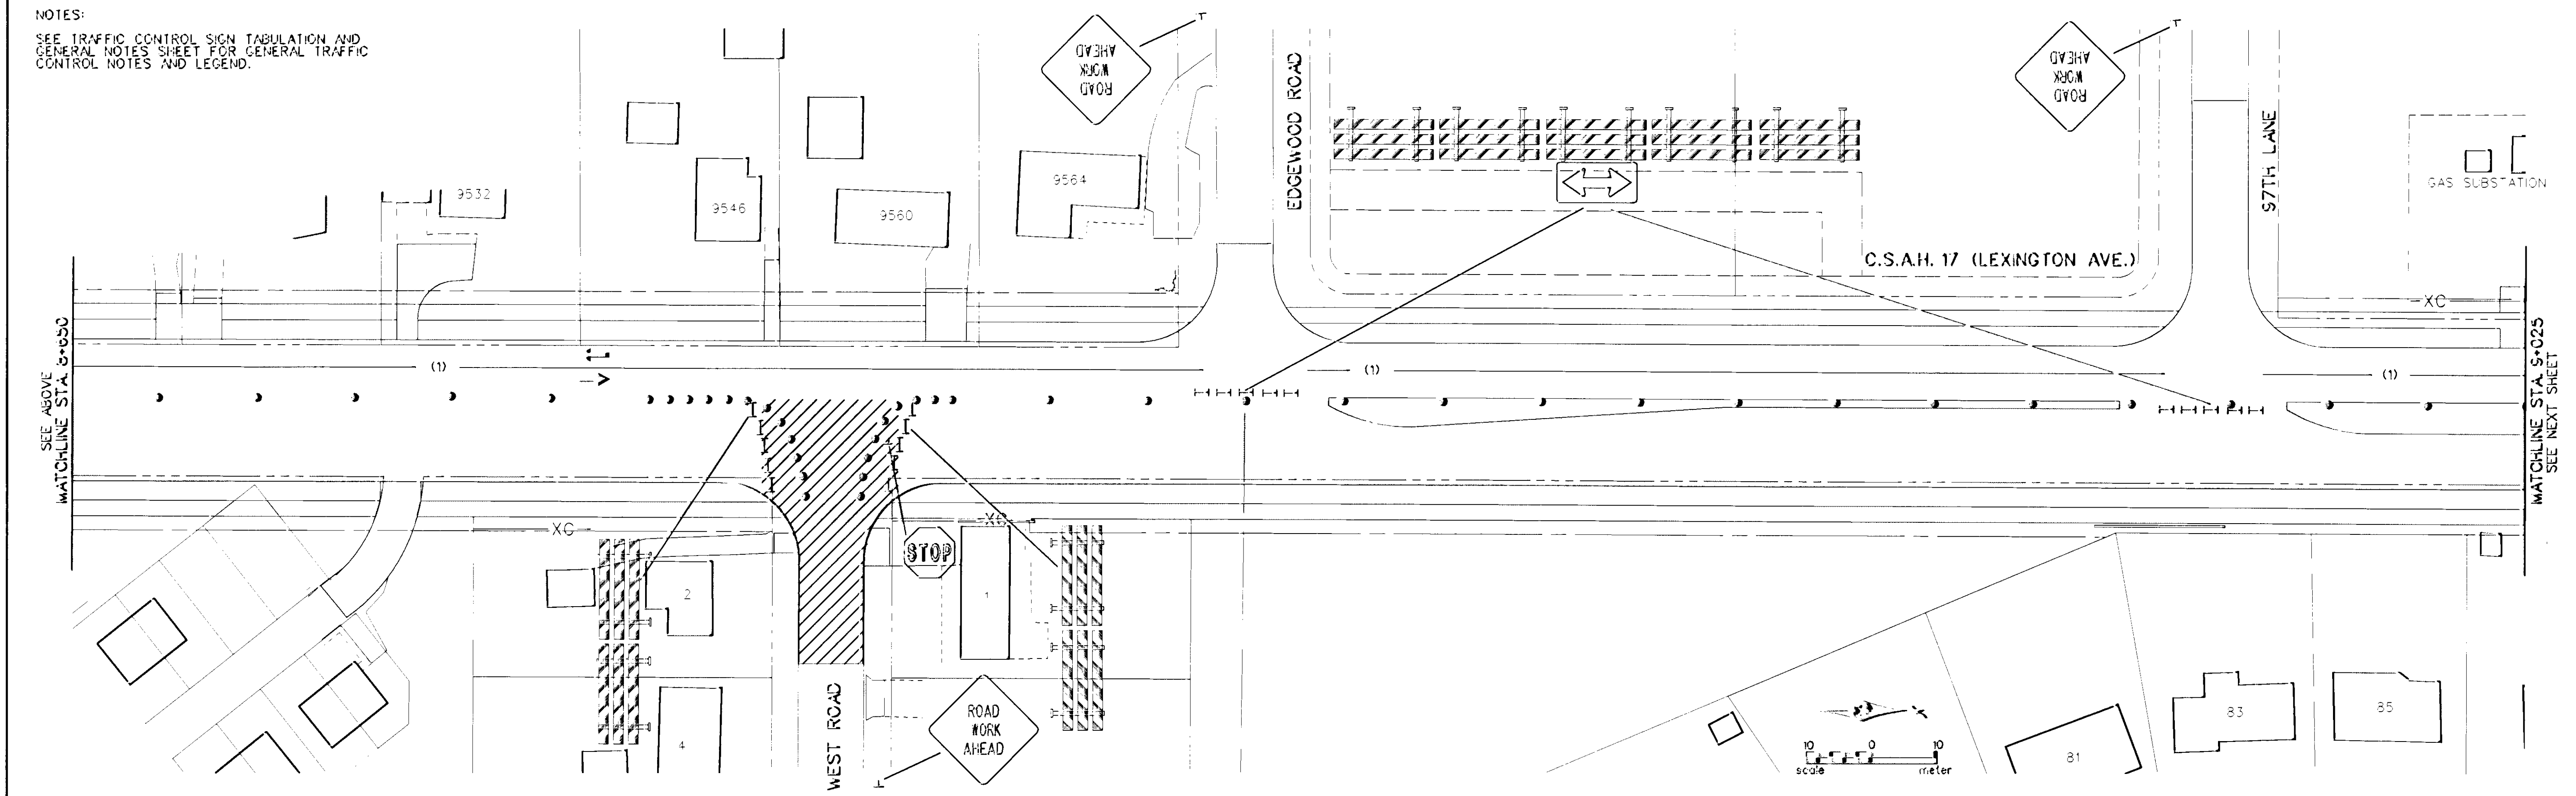

1	3-26-97	MCI	DAD	REVISE TAPER AREA
NO	DATE	BY	CHKD	APPR
REVISION				
NAME: TC2A 410.PLN DATE: Mar. 17, 1997				

minnesota metric

I hereby certify that this plan, specification or report was prepared by me or under my direct supervision and that I am a duly Registered Professional Engineer under the laws of the State of Minnesota.

Donald A. Demers
 Date: 3-21-97 Reg. No. 23397

STATE AID PROJECT NO. S.A.P. 02-617-11 S.A.P. 106-020-12 S.A.P. 106-030-03 CO. PROJECT NO.




DRANN BY DATE M. ISAKKA 12-96
 DESIGNED BY D. DEMERS 12-96
 CHECKED BY D. DEMERS 1-97
 COMM. NO. 0962410

SRI CONSULTING GROUP, INC.

ANOKA COUNTY
 TRAFFIC CONTROL-STAGE 2
 C.S.A.H. 17 RECONSTRUCTION
 STA 8+358 TO STA. 9+025

SHEET 46 OF 236


NOTES:
 SEE TRAFFIC CONTROL SIGN TABULATION AND
 GENERAL NOTES SHEET FOR GENERAL TRAFFIC
 CONTROL NOTES AND LEGEND.

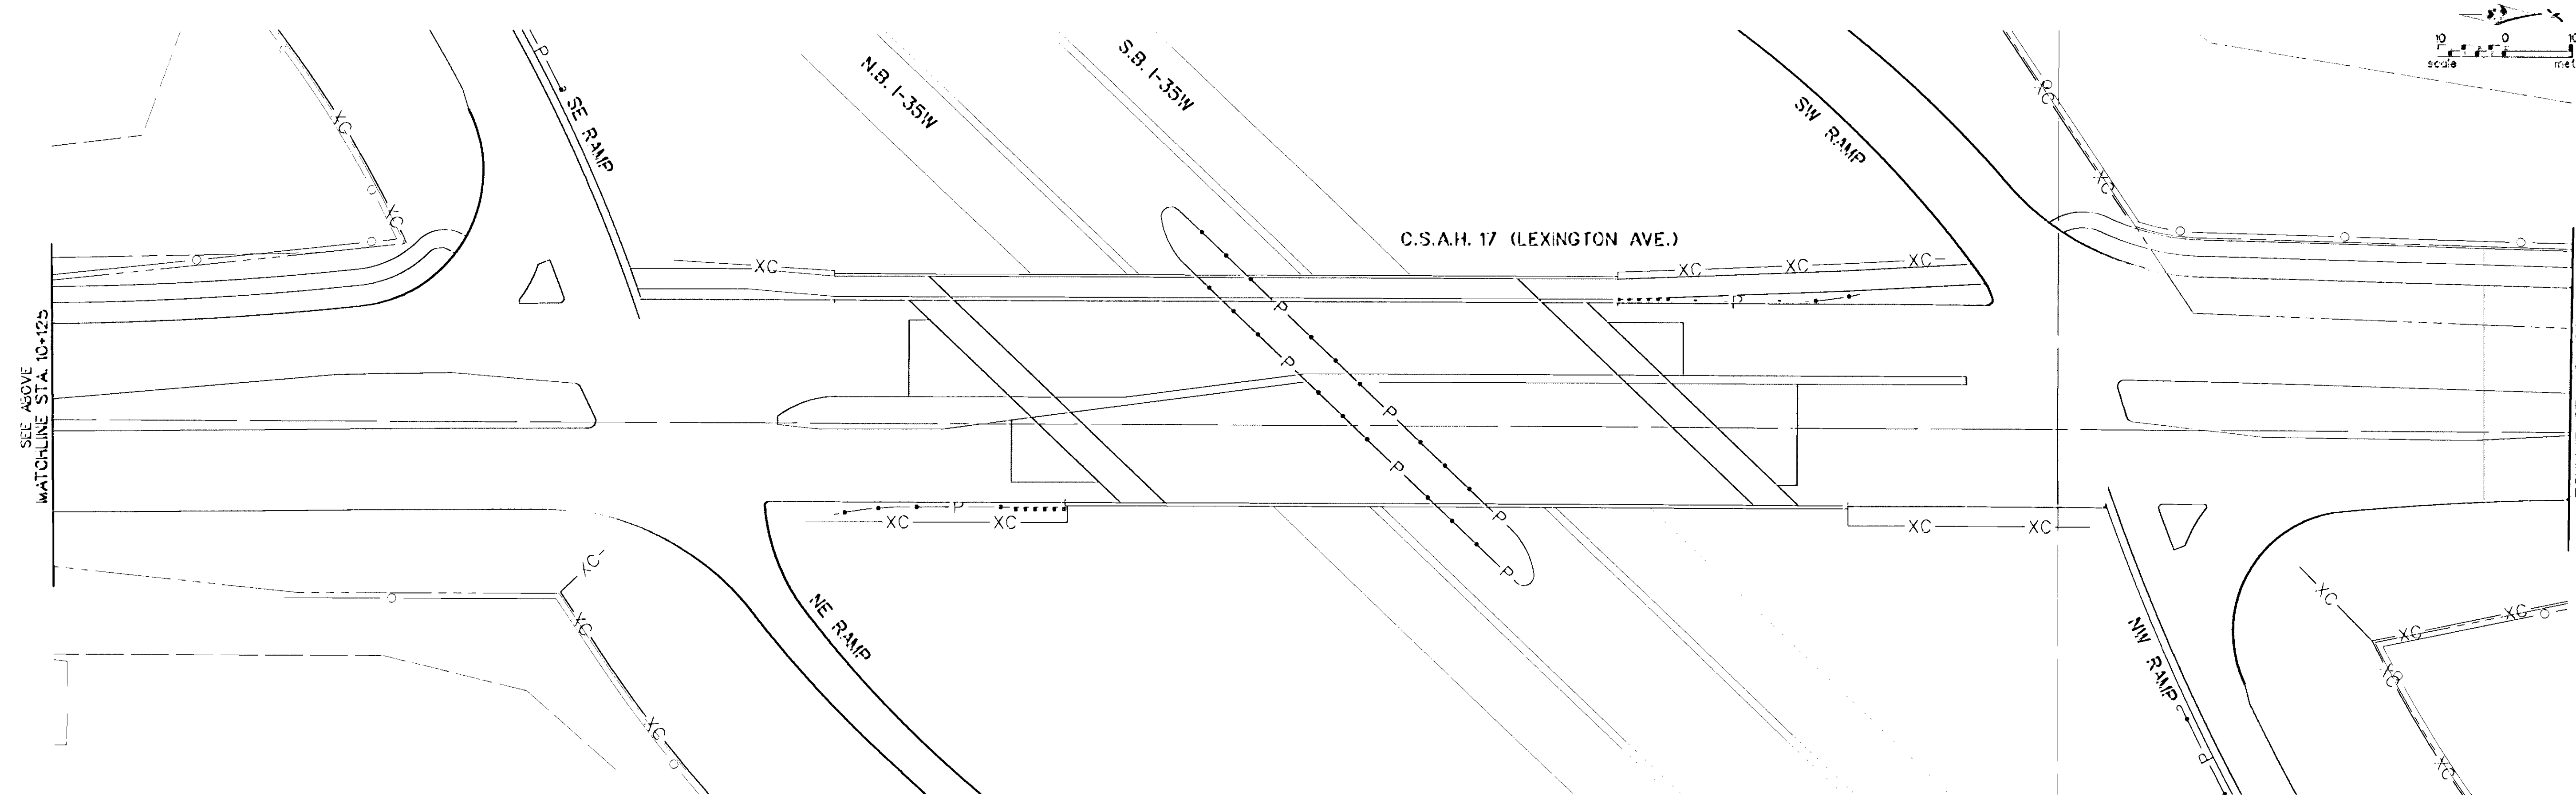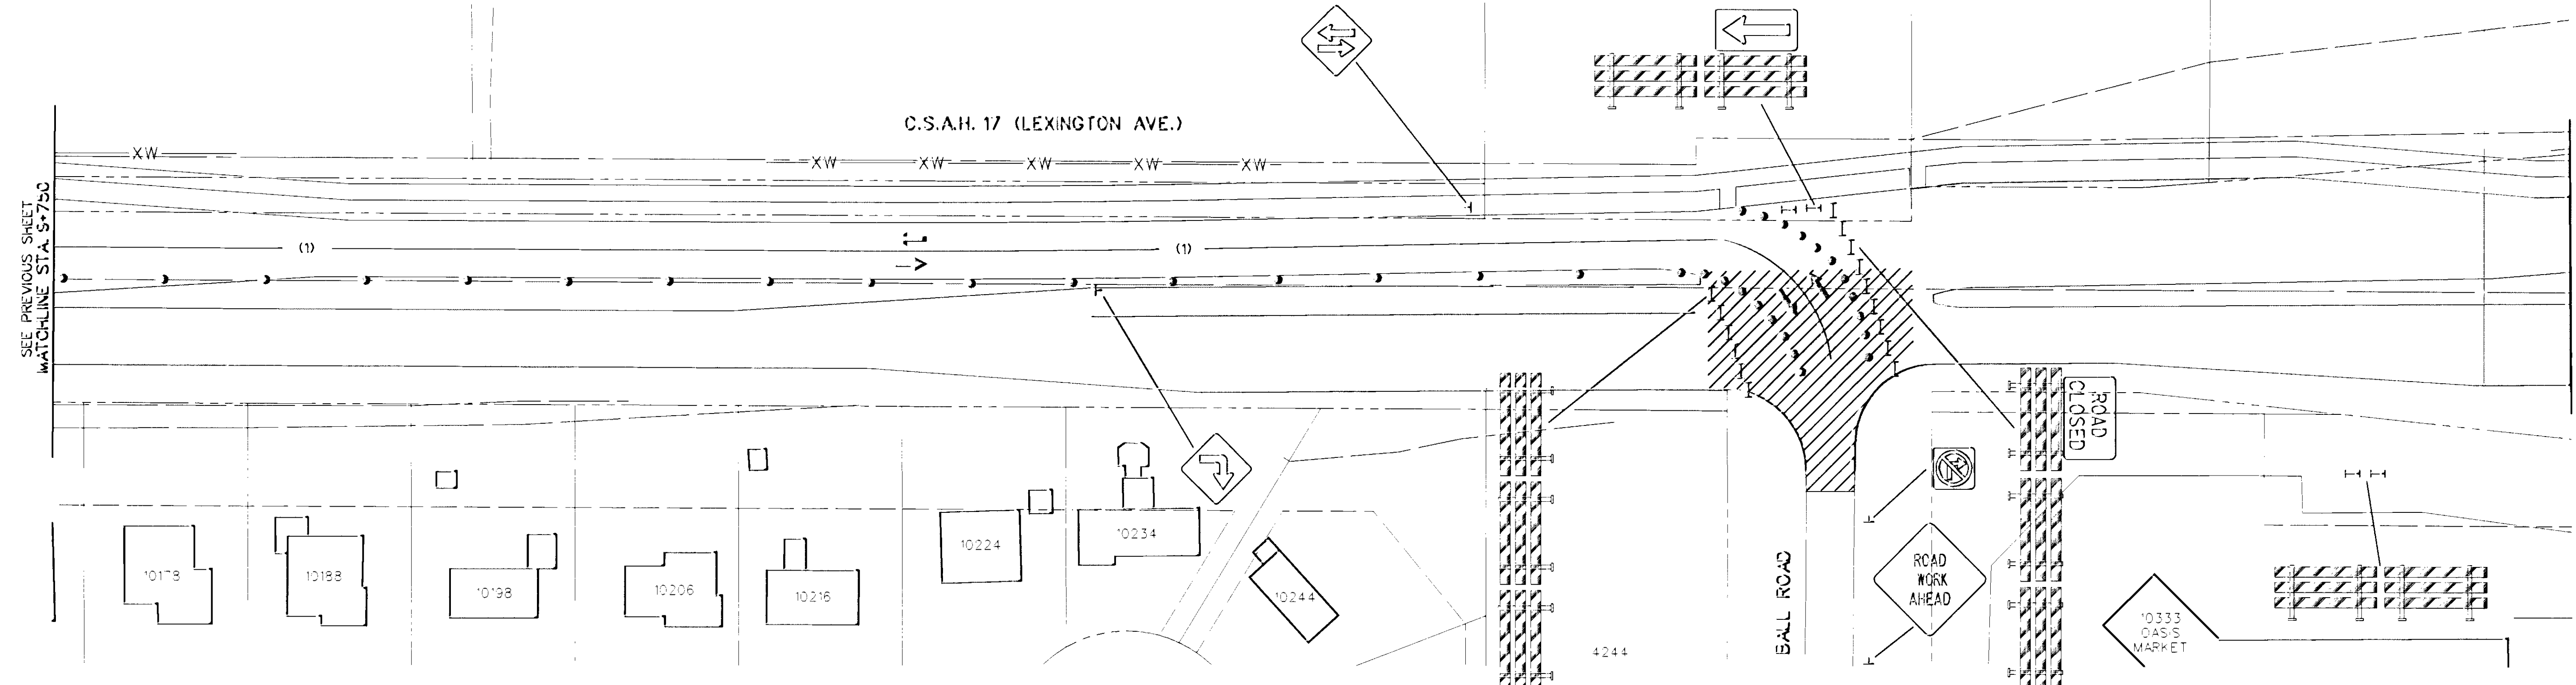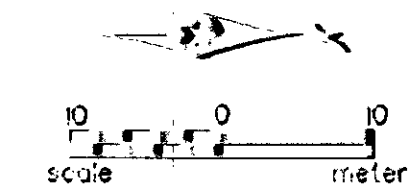

SEE I-35W TRAFFIC CONTROL PLAN

NO.	DATE	BY	CHKD	APPR	REVISION


NO: TC2C 410.PLN DATE: Mar. 17, 1997

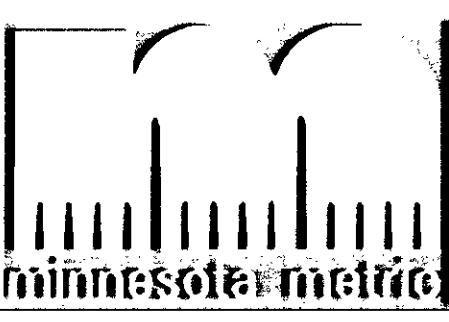

I hereby certify that this plan, specification or report was prepared by me or under my direct supervision and that I am a duly Registered Professional Engineer under the laws of the State of Minnesota.
Donald A. Demers
 Date: 3-21-97 Reg. No. 23397

STATE AID PROJECT NO.
 S.A.P. 02-617-11
 S.A.P. 106-020-12
 S.A.P. 106-030-03
 CO. PROJECT NO.


DRAWN BY M. IISAKKA DATE 12-98
 DESIGNED BY D. DEMERS 12-96
 CHECKED BY D. DEMERS 1-97
 COMM. NO. 0362410

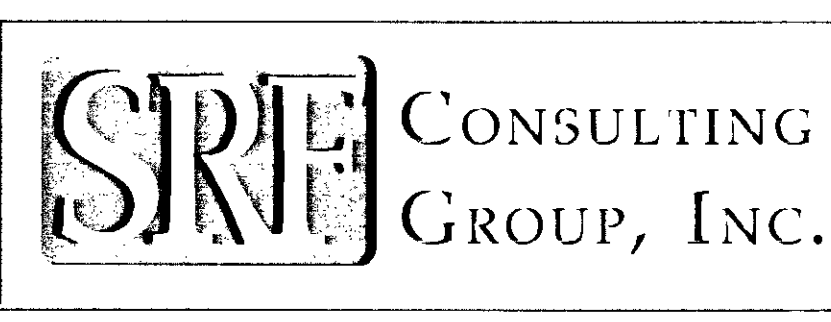

ANOKA COUNTY
 TRAFFIC CONTROL-STAGE 2
 C.S.A.H. 17 RECONSTRUCTION
 STA. 9+750 TO STA. 10+500

SHEET 18 OF 236

NOTES:
SEE TRAFFIC CONTROL SIGN TABULATION AND GENERAL NOTES SHEET FOR GENERAL TRAFFIC CONTROL NOTES AND LEGEND.

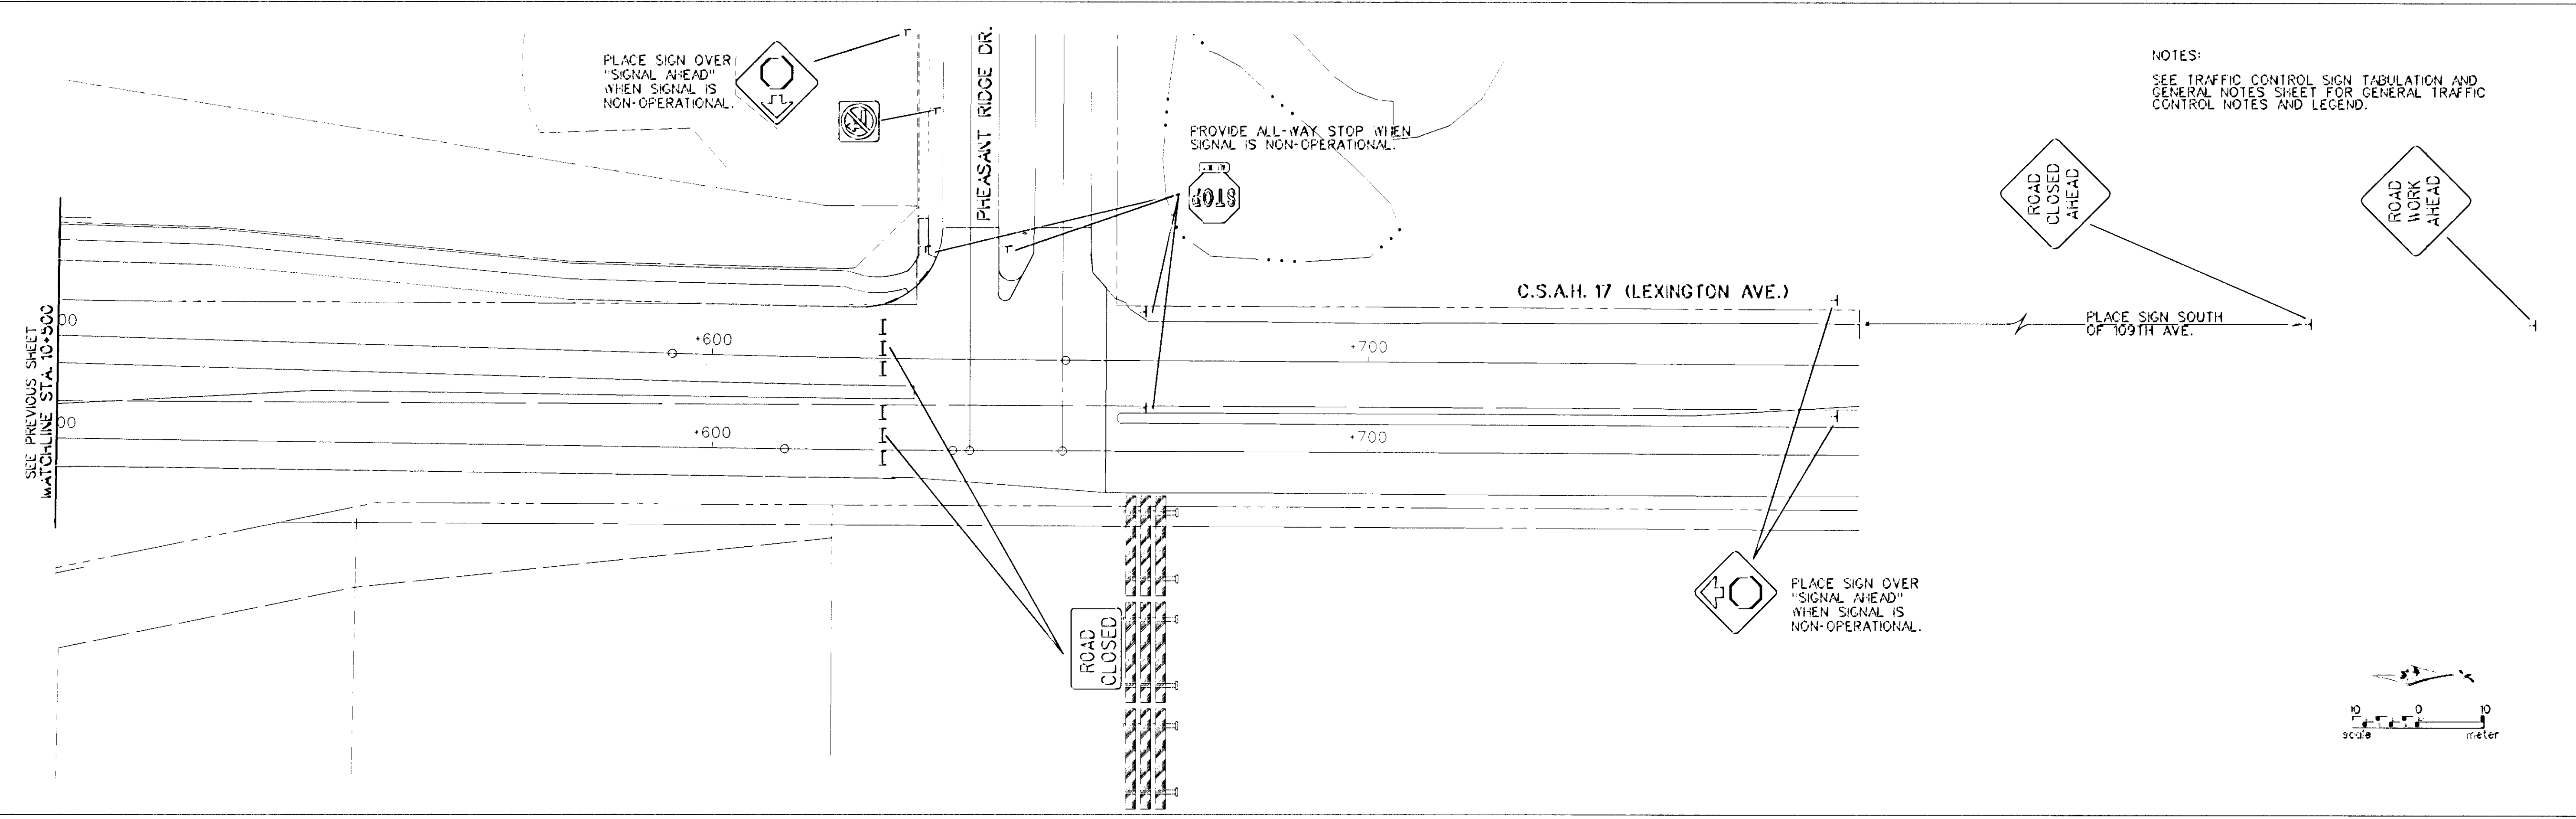

NO	DATE	BY	CHKD	APPR	REVISION

NAME: TC2D 410.PLN DATE: Mar. 17, 1997

minnesota metric

I hereby certify that this plan, specification or report was prepared by me or under my direct supervision and that I am a duly Registered Professional Engineer under the laws of the State of Minnesota.

Donald A Demers
Date 3-21-97 Reg. No. 23397

STATE AID PROJECT NO.
S.A.P. 02-617-11
S.A.P. 106-020-12
S.A.P. 106-030-03

CO. PROJECT NO.




DRAWN BY M. IISAKKA DATE 12-96
DESIGNED BY D. DEMERS 12-96
CHECKED BY D. DEMERS 1-97
COMM. NO. 0962410

SRT CONSULTING GROUP, INC.


ANOKA COUNTY
TRAFFIC CONTROL-STAGE 2
C.S.A.H. 17 RECONSTRUCTION
STA. 10+500 TO STA. 10+660

SHEET 49 OF 236

HORIZONTAL CONTROL BASED ON ANOKA COUNTY COORDINATE SYSTEM.

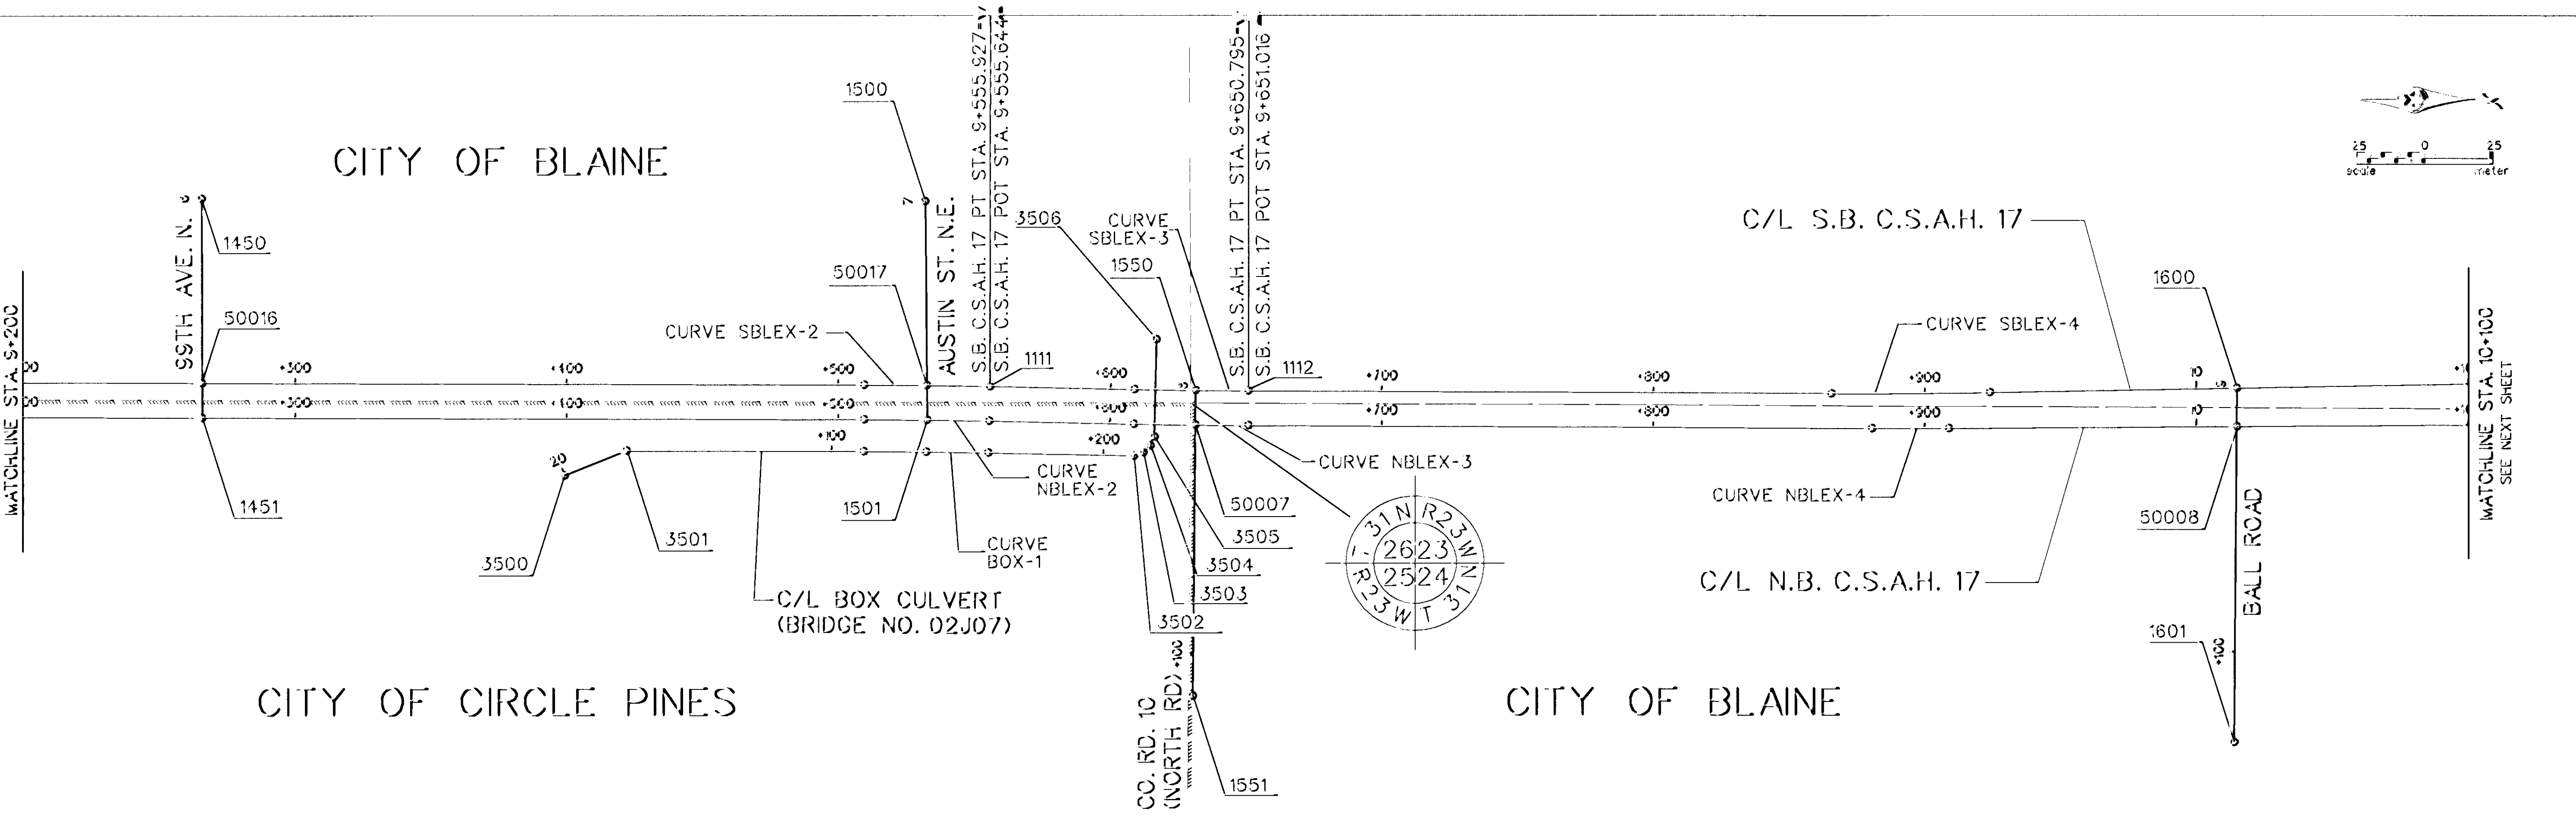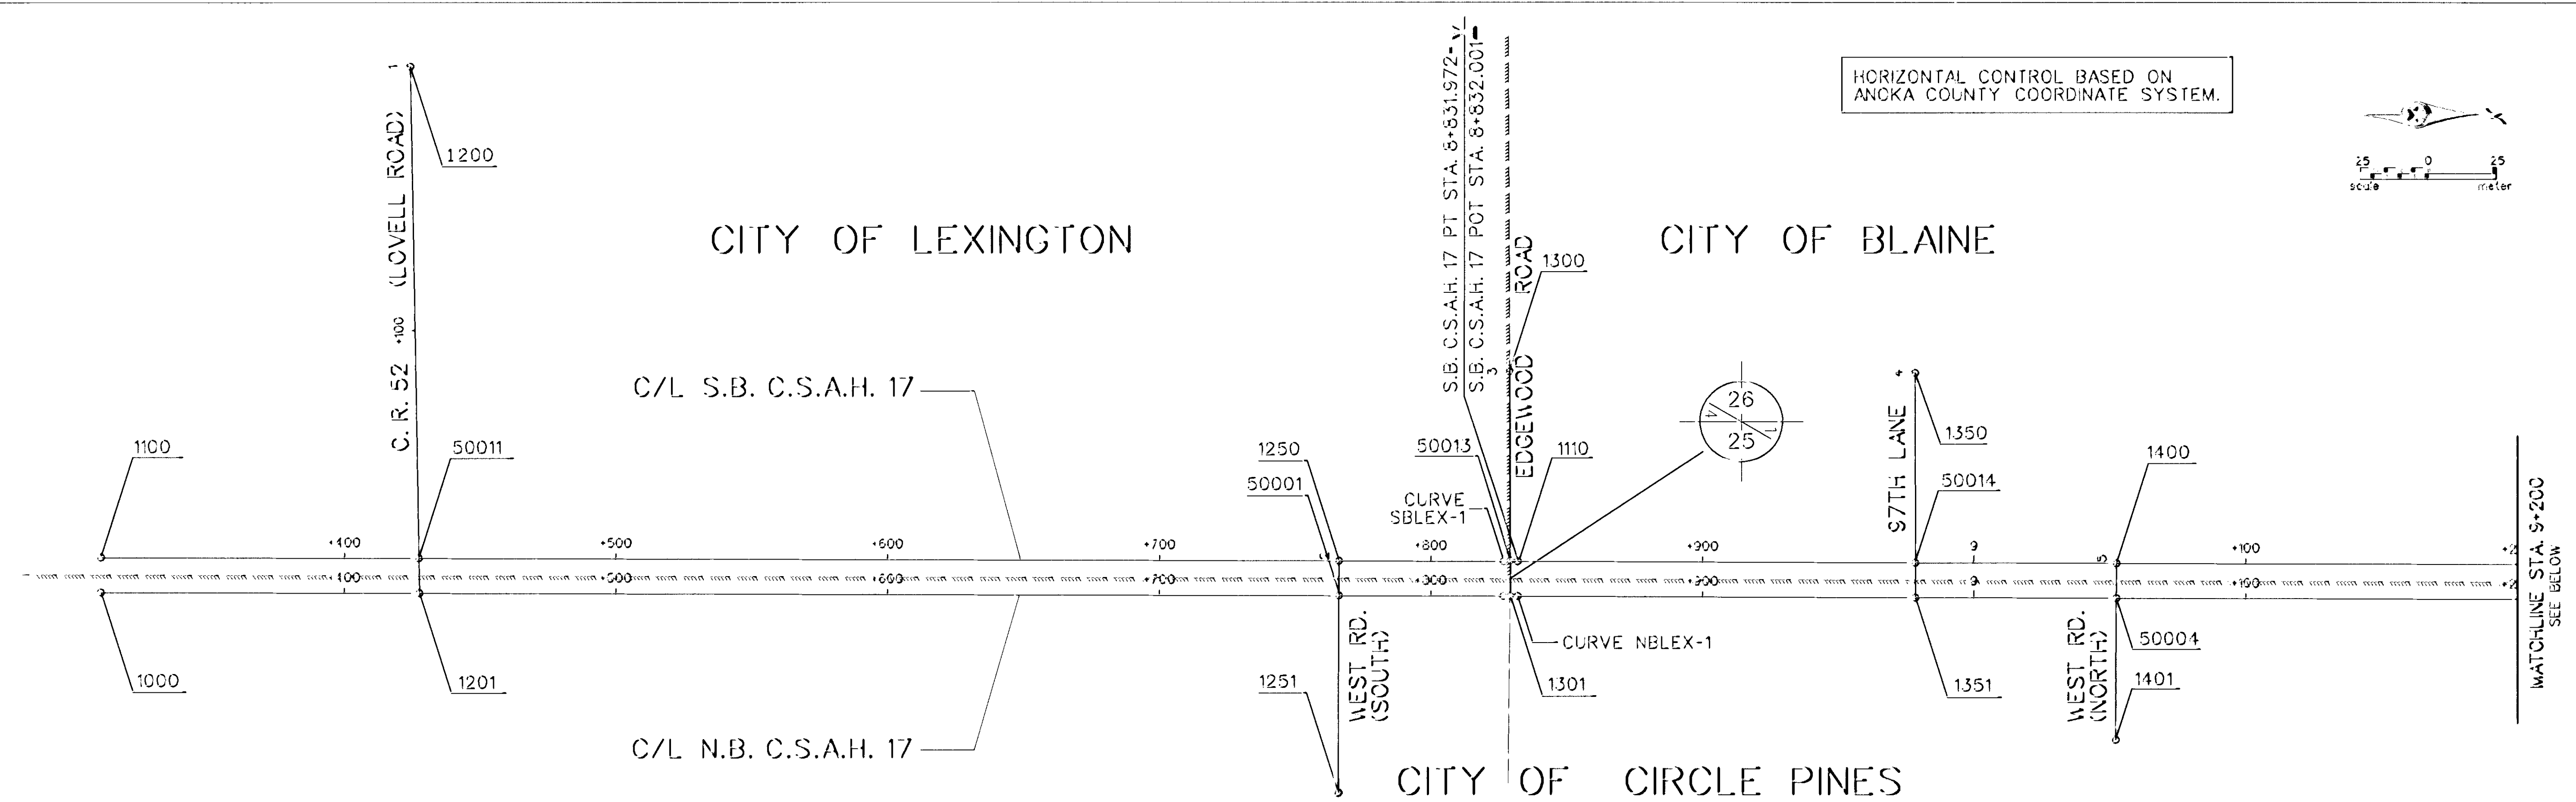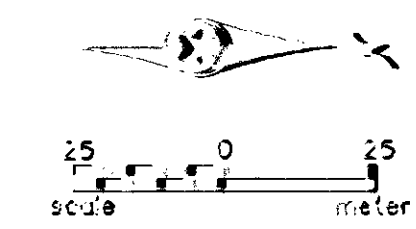


<table border="1"> <thead> <tr> <th>NO.</th> <th>DATE</th> <th>BY</th> <th>CHKD</th> <th>APPR</th> <th>REVISION</th> </tr> </thead> <tbody> <tr> <td> </td> <td> </td> <td> </td> <td> </td> <td> </td> <td> </td> </tr> </tbody> </table>					NO.	DATE	BY	CHKD	APPR	REVISION								I hereby certify that this plan, specification or report was prepared by me or under my direct supervision and that I am a duly Registered Professional Engineer under the laws of the State of Minnesota. <i>Donald A. Demers</i> Date <u>3-21-97</u> Reg. No. <u>23397</u>	STATE AID PROJECT NO. S.A.P. 02-617-11 S.A.P. 108-020-12 S.A.P. 108-030-03 CO. PROJECT NO.	DRAWN BY L. VANDRASEK DESIGNED BY B. LUKBANEK CHECKED BY D. DEMERS COMM. NO. 0262410		ANOKA COUNTY ALIGNMENT PLAN C.S.A.H. 17 RECONSTRUCTION C.S.A.H. 17 STA. 8+300 TO STA. 10+100	SHEET 50 OF 236
NO.	DATE	BY	CHKD	APPR	REVISION																		
NAME: AP1 410.PLN DATE: Mar. 17, 1997																							

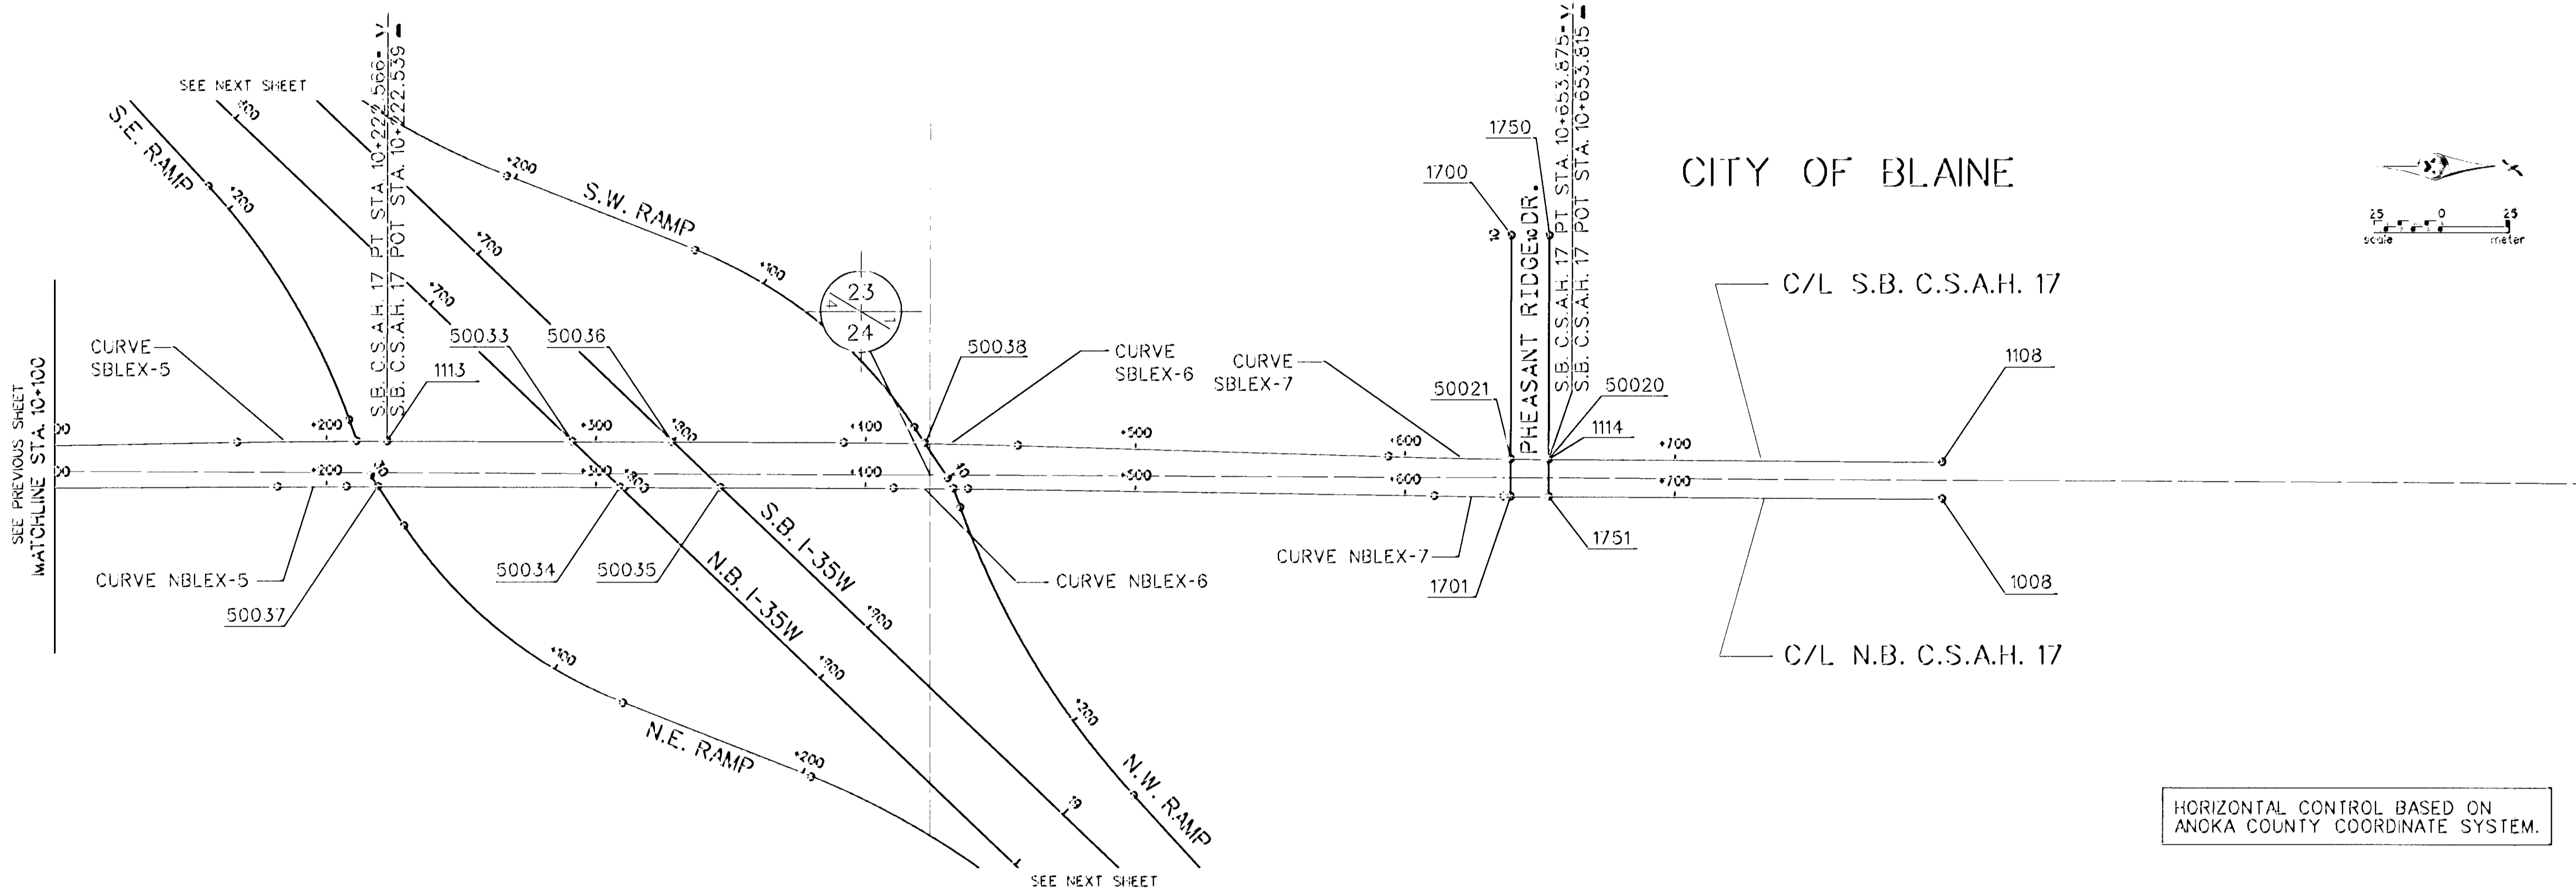

NO.	DATE	BY	CHKD	APPR	REVISION

NO. DATE BY CKD APPR REVISION

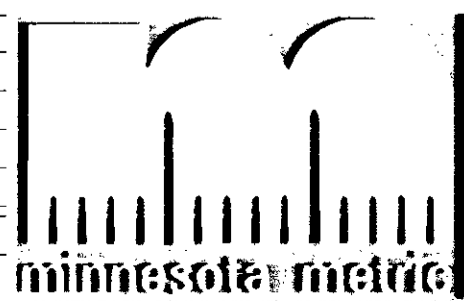

I hereby certify that this plan, specification or report was prepared by me or under my direct supervision and that I am a duly Registered Professional Engineer under the laws of the State of Minnesota.

Donald A. Jones
Date 3-21-97 Reg. No. 23397



STATE AID PROJECT NO.
S.A.P. 02-617-11
S.A.P. 106-020-12
S.A.P. 106-030-03
CO. PROJECT NO.

DRAWN BY DATE
L. VONDRASEK 11-96
DESIGNED BY
B. URBANEK 11-96
CHECKED BY
D. DEMERS 1-97
CCMM. NO.
0362410




ANOKA COUNTY
ALIGNMENT PLAN
C.S.A.H. 17 RECONSTRUCTION
C.S.A.H. 17 STA. 10+100 TO STA. 10+800

SHEET
51
OF
236

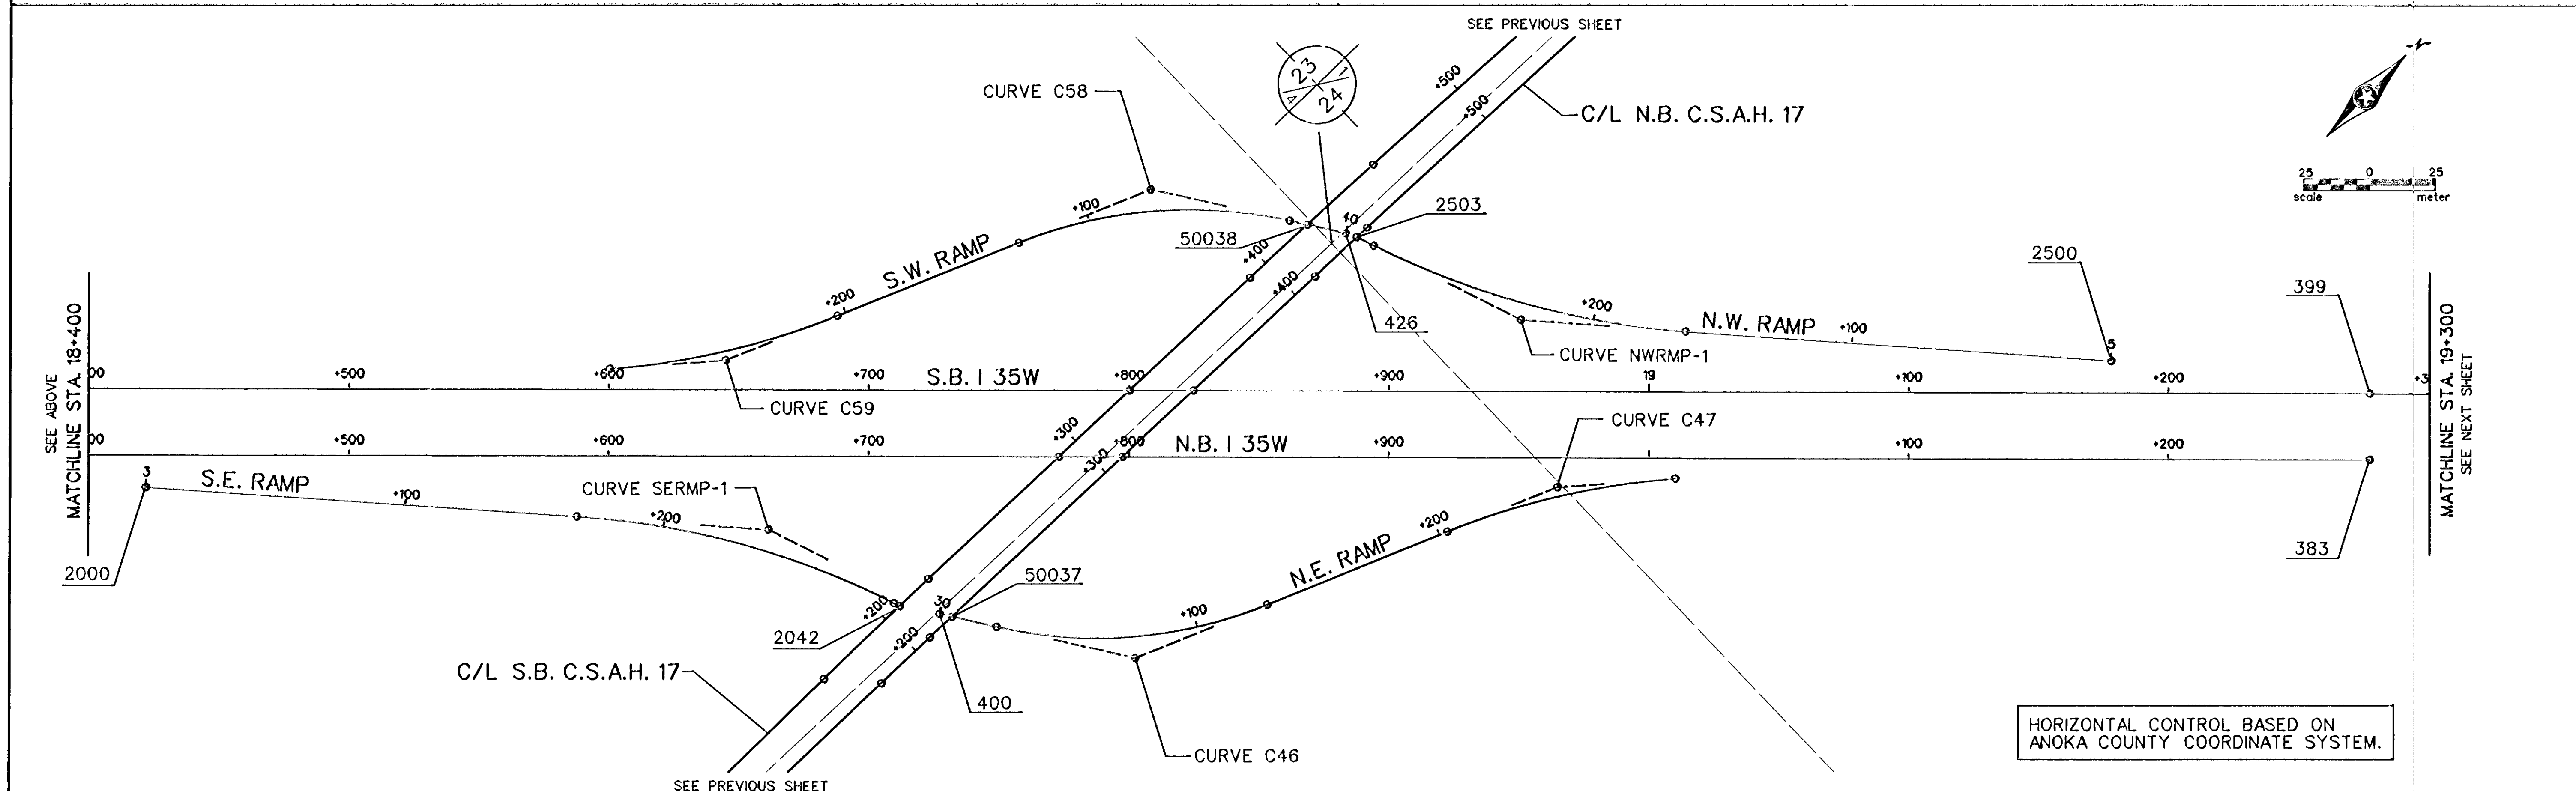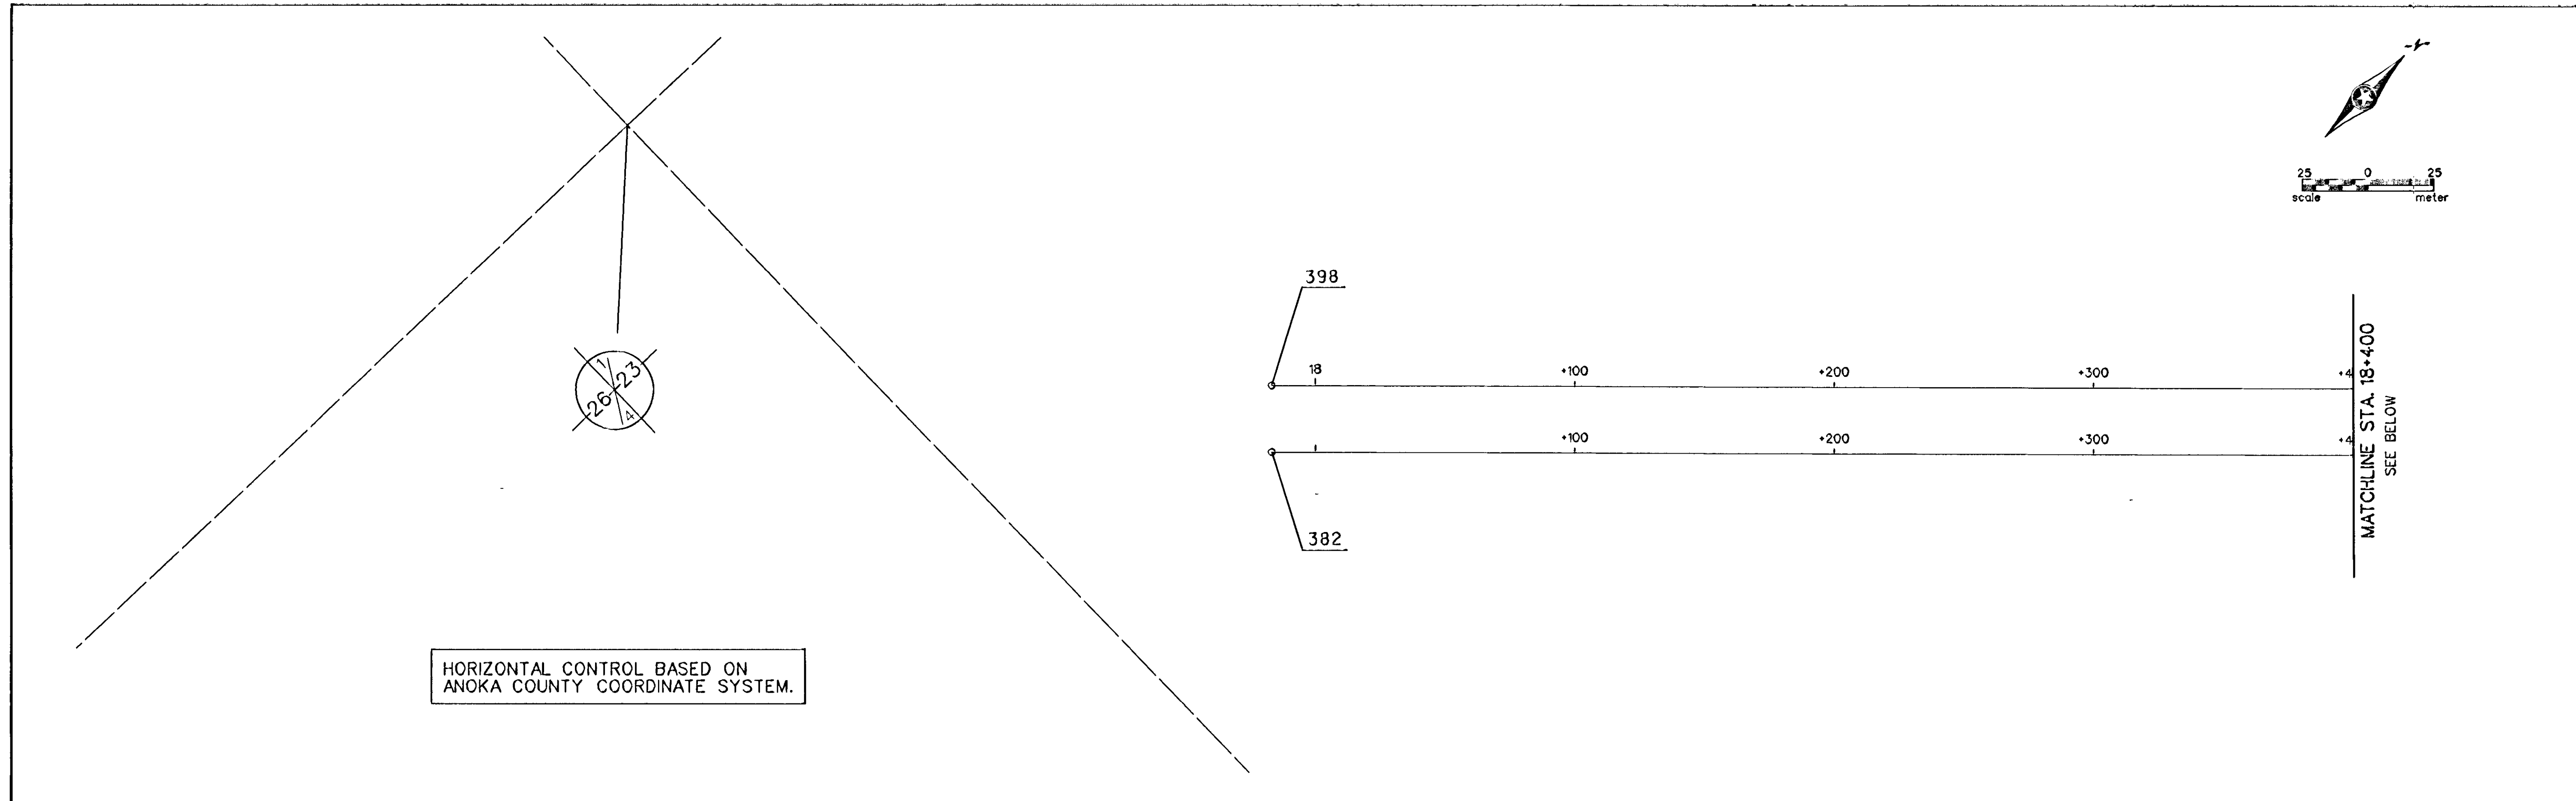

1	4-4-97	MCI	MDH	DAD	REVISE SE RAMP ALIGNMENT
NO	DATE	BY	CHKD	APPR	REVISION
NAME: AP3 410.PLN DATE: Mar. 17, 1997					

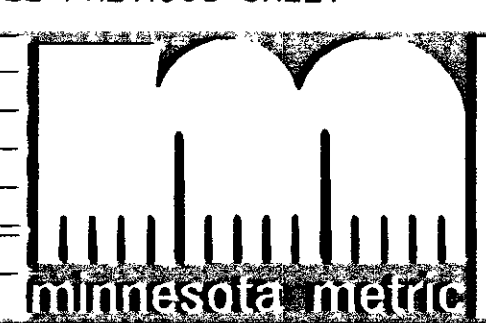

I hereby certify that this plan, specification or report was prepared by me or under my direct supervision and that I am a duly Registered Professional Engineer under the laws of the State of Minnesota.

Donald A. Demco
 Date: 3-21-97 Reg. No. 23397

STATE AID PROJECT NO.
 S.A.P. 02-617-11
 S.A.P. 108-020-12
 S.A.P. 106-030-03
 CO. PROJECT NO.


DRAWN BY DATE
 L. VanDRASEK 11-96
 DESIGNED BY
 B. URBANEK 11-96
 CHECKED BY
 D. DEMERS 1-97
 COMM. NO.
 0962410



ANOKA COUNTY
 ALIGNMENT PLAN
 C.S.A.H. 17 RECONSTRUCTION
 I-35W STA. 18+000 TO STA. 19+300

SHEET
 52
 OF
 236


SEE PREVIOUS SHEET
MATCHLINE STA. 19+300

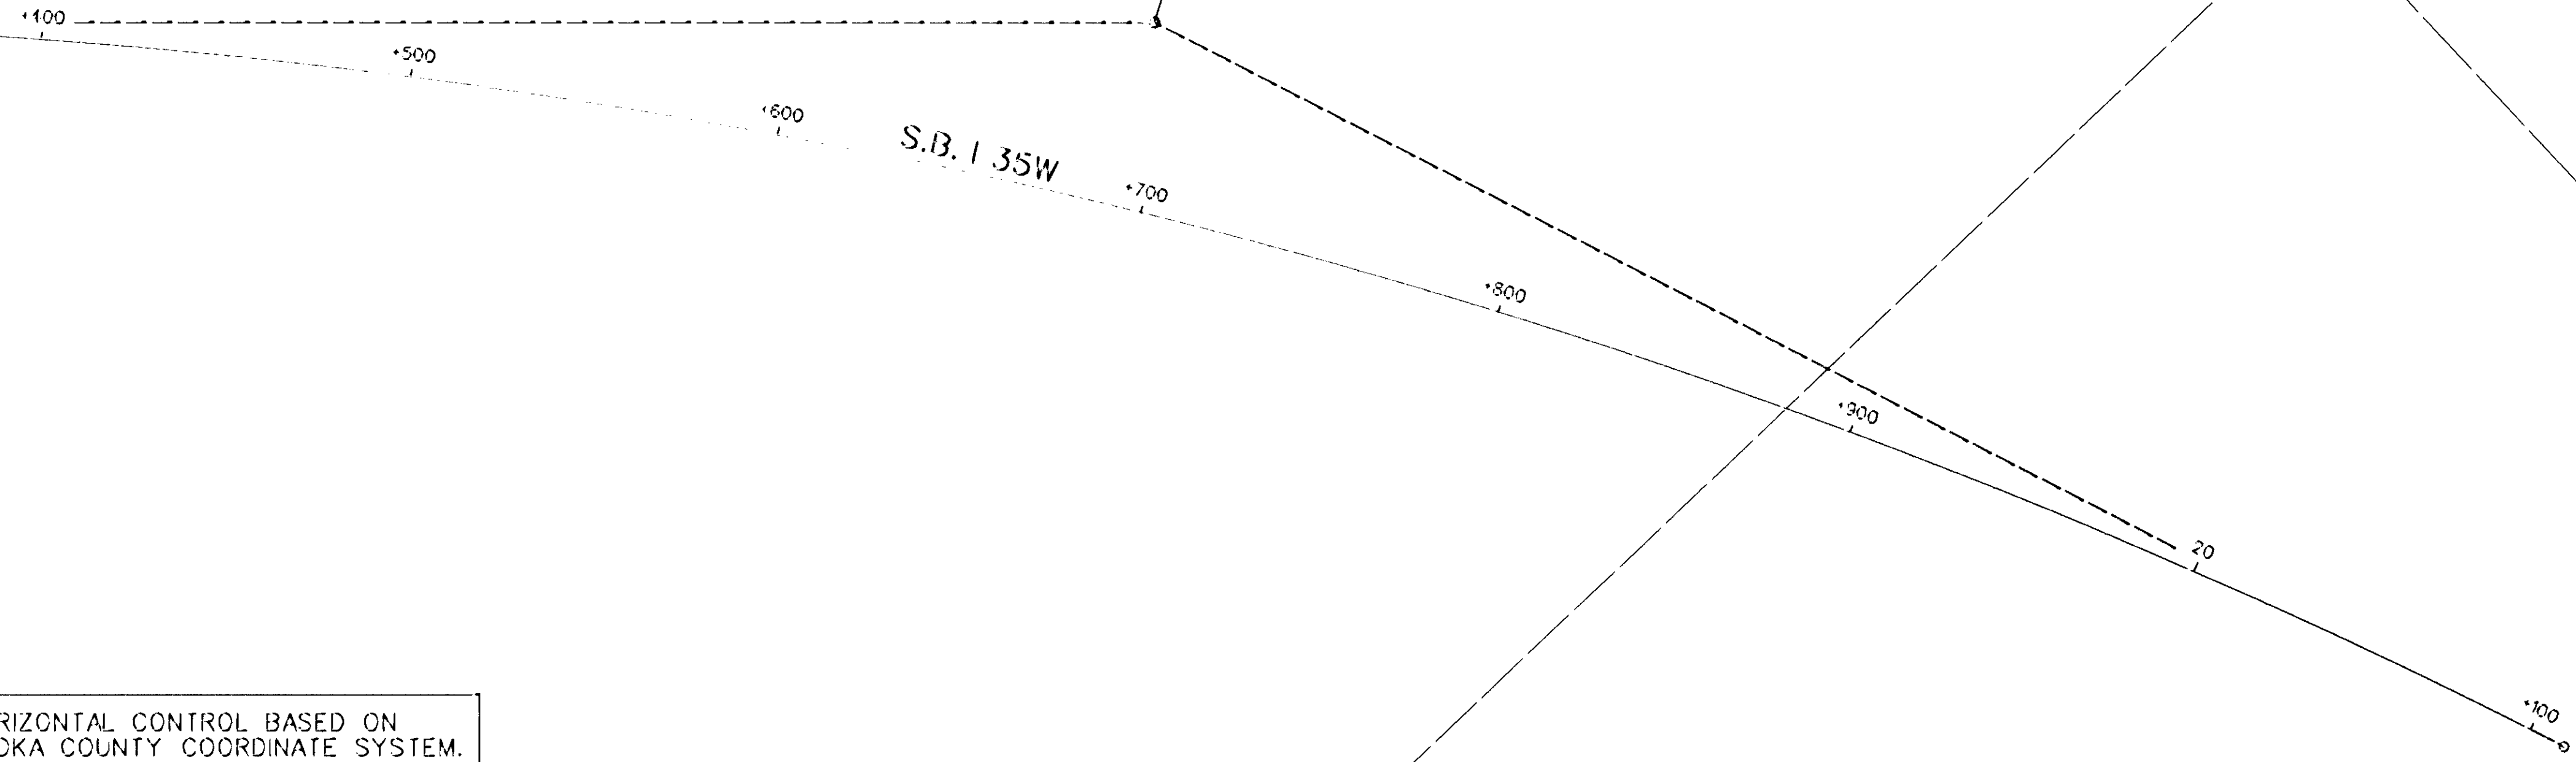

HORIZONTAL CONTROL BASED ON ANOKA COUNTY COORDINATE SYSTEM.

SEE PREVIOUS SHEET

NO.	DATE	BY	CHKD	APPR	REVISION

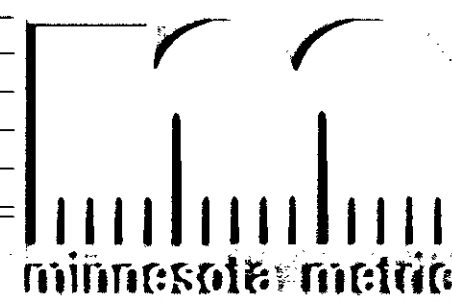

I hereby certify that this plan, specification or report was prepared by me or under my direct supervision and that I am a duly Registered Professional Engineer under the laws of the State of Minnesota.
Donald A Demers
Date 3-21-97 Reg. No. 23397

STATE AID PROJECT NO.
S.A.P. 02-617-11
S.A.P. 106-020-12
S.A.P. 106-030-03
CO. PROJECT NO.

DRAWN BY DATE
L. VanDRASEK 11-96
DESIGNED BY
B. URBANEK 11-96
CHECKED BY
D. DEMERS 1-97
CCWM. NO.
0962410



ANOKA COUNTY
ALIGNMENT PLAN
C.S.A.H. 17 RECONSTRUCTION
I-35W STA. 19+300 TO STA. 20+010


SHEET
53
OF
236

(P)

CURVE NO.	POINT	STATION	CURVE DATA				COORDINATES		AZIMUTH
			Δ	R	T	L	X	Y	
C/L N.B. C.S.A.H. 17 (LEXINGTON AVE.)									
1000	POB	C/L N.B. C.S.A.H. 17					219,212.3810	24,925.5160	0° 11' 12.7"
	PC	3+826.787					219,214.6645	25,441.7362	
NBLEX-1	PI	3+829.334	0° 00' 10.8" R	100,000.000	2.607	5.214	219,214.6730	25,444.3430	PI
	PT	3+832.001					219,214.6816	25,446.3498	0° 11' 23.4"
	PC	3+509.586					219,216.9267	26,124.5314	
NBLEX-2	PI	3+532.616	1° 03' 20.1" R	2,500.000	23.030	46.058	219,217.0030	26,147.5610	PI
	PT	3+555.644					219,217.5035	26,170.5853	1° 14' 43.5"
	PC	3+608.829					219,218.6595	26,223.7578	
NBLEX-3	PI	3+629.923	0° 58' 00.7" L	2,500.000	21.034	42.187	219,219.1180	26,244.8470	PI
	PT	3+651.016					219,219.2206	26,265.9109	0° 16' 42.8"
	PC	3+880.665					219,220.3370	26,495.5867	
NBLEX-4	PI	3+834.853	0° 39' 01.2" L	2,500.000	14.189	28.377	219,220.4060	26,509.7150	PI
	PT	3+909.042					219,220.3139	26,523.9632	359° 37' 41.5"
	PC	10+181.973					219,218.5429	26,736.8885	
NBLEX-5	PI	10+134.746	0° 35' 07.8" R	2,500.000	12.774	25.547	219,218.4600	26,809.6620	PI
	PT	10+207.520					219,218.5076	26,822.4357	0° 12' 49.4"
	PC	10+410.473					219,219.2646	27,025.3872	
NBLEX-6	PI	10+424.242	0° 37' 52.0" R	2,500.000	13.769	27.537	219,219.3160	27,039.1560	PI
	PT	10+438.010					219,219.5190	27,052.9234	0° 50' 41.4"
	PC	10+611.027					219,222.0700	27,225.9209	
NBLEX-7	PI	10+623.843	0° 35' 14.9" L	2,500.000	12.817	25.633	219,222.2530	27,238.7360	PI
	PT	10+636.660					219,222.3166	27,251.5524	0° 15' 26.5"
1003	POB	C/L N.B. C.S.A.H. 17					219,223.0470	27,414.1670	
C/L S.B. C.S.A.H. 17 (LEXINGTON AVE.)									
1100	POB	C/L S.B. C.S.A.H. 17					219,199.7810	24,925.5530	0° 11' 12.7"
	PC	3+826.815					219,201.4646	25,441.8076	
SBLEX-1	PI	3+829.334	0° 00' 10.6" R	100,013.200	2.578	5.157	219,201.4730	25,444.3860	PI
	PT	3+831.972=					219,201.4815	25,446.3644	0° 11' 23.3"
1110	A PT.	ON C/L S.B. C.S.A.H. 17 POB					219,201.4815	25,446.3644	0° 11' 23.3"
	PC	3+509.604					219,203.7263	26,124.5642	
SBLEX-2	PI	3+532.766	1° 03' 21.8" R	2,513.200	23.162	46.322	219,203.8030	26,147.7260	PI
	PT	3+555.927=					219,204.3066	26,170.8824	1° 14' 45.1"
1111	A PT.	ON C/L S.B. C.S.A.H. 17 POB					219,204.3066	26,170.8824	1° 14' 45.1"
	PC	3+608.808					219,205.4625	26,224.0337	
SBLEX-3	PI	3+629.802	0° 58' 02.6" L	2,486.800	20.994	41.987	219,205.9130	26,245.0230	PI
	PT	3+650.795					219,206.0210	26,266.0170	0° 16' 42.5"
1112	A PT.	ON C/L S.B. C.S.A.H. 17 POB					219,206.0210	26,266.0170	0° 16' 42.5"
	PC	3+865.630					219,207.0641	26,480.6283	
SBLEX-4	PI	3+834.823	1° 20' 17.0" L	2,500.000	29.193	58.384	219,207.2060	26,509.8210	PI
	PT	3+924.014					219,206.6662	26,539.0091	358° 56' 25.5"
	PC	10+167.005					219,202.1727	26,781.9592	
SBLEX-5	PI	10+134.787	1° 16' 24.1" R	2,500.000	27.782	55.561	219,201.6530	26,809.7360	PI
	PT	10+222.566=					219,201.7627	26,837.5174	0° 12' 49.6"
1113	A PT.	ON C/L S.B. C.S.A.H. 17 POB					219,201.7627	26,837.5174	0° 12' 49.6"
	PC	10+391.932					219,202.3347	27,006.3038	
SBLEX-6	PI	10+424.175	1° 28' 40.1" R	2,500.000	32.242	64.481	219,202.5150	27,039.1520	PI
	PT	10+456.414					219,203.4668	27,071.3804	1° 41' 29.7"
	PC	10+593.931					219,207.5262	27,208.8379	
SBLEX-7	PI	10+623.304	1° 22' 25.7" L	2,500.000	29.973	59.943	219,208.4110	27,238.7380	PI
	PT	10+653.875=					219,208.5772	27,268.7707	0° 19' 04.0"
1114	A PT.	ON C/L S.B. C.S.A.H. 17 POB					219,208.5772	27,268.7707	0° 19' 04.0"
1103	POB	C/L S.B. C.S.A.H. 17					219,209.3810	27,414.2280	
C/L C.R. 52 (LOVELL ROAD)									
1200	POB	C/L LOVELL ROAD					219,013.7950	25,039.3000	89° 02' 53.0"
50011	POB	C/L LOVELL ROAD					219,200.1620	25,042.3970	
	A PT.	ON C/L S.B. C.S.A.H. 17 POB							
1201	POB	C/L LOVELL ROAD					219,213.3630	25,042.6160	
	A PT.	ON C/L N.B. C.S.A.H. 17 POB							

NO	DATE	BY	CHK	APPR	REVISION


--	--	--	--	--	--

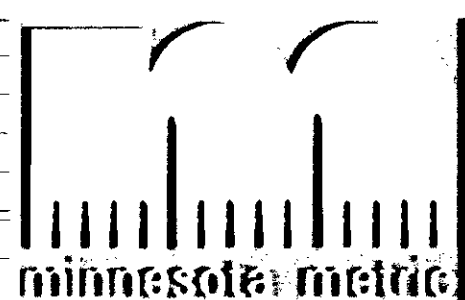

I hereby certify that this plan, specification or report was prepared by me or under my direct supervision and that I am a duly Registered Professional Engineer under the laws of the State of Minnesota.
Donald A. Demers
 Date: 3-21-97 Reg. No. 23397

STATE AID PROJECT NO.
 S.A.P. 02-617-11
 S.A.P. 106-020-12
 S.A.P. 106-030-03
 CO. PROJECT NO.

DRAWN BY DATE
 L. VAN DRASEK 11-96
 DESIGNED BY
 B. URBANEK 10-96
 CHECKED BY
 D. DEMERS 1-97
 COMM. NO.
 0362410

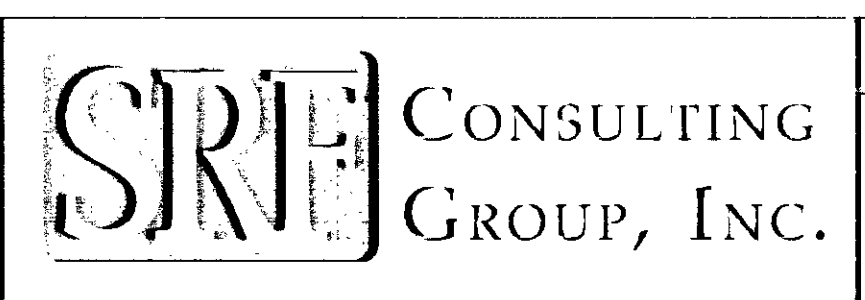


ANOKA COUNTY
 ALIGNMENT TABULATION
 C.S.A.H. 17 RECONSTRUCTION

SHEET
 54
 OF
 236

(P)

CURVE NO.	POINT	STATION	CURVE DATA				COORDINATES		AZIMUTH
			Δ	R	T	L	X	Y	
C/L WEST ROAD (SOUTH)									
1250	POT	C/L WEST ROAD	2+000.000=				279,201.2660	25,381.1330	90° 11' 19.6"
	A PT.	ON C/L S.B. C.S.A.H. 17	3+766.140						
50001	POT	C/L WEST ROAD	2+013.201=				279,214.4670	25,381.0830	
	A PT.	ON C/L N.B. C.S.A.H. 17	3+766.140						
1251	POT	C/L WEST ROAD	2+038.018				279,289.2830	25,380.8430	
C/L EDGEWOOD ROAD									
1300	POT	C/L EDGEWOOD ROAD	3+000.000				279,129.4650	25,443.9600	89° 45' 23.7"
50013	POT	C/L EDGEWOOD ROAD	3+072.008=				279,201.4730	25,444.2660	
	A PT.	ON C/L S.B. C.S.A.H. 17	3+829.274						
1301	POT	C/L EDGEWOOD ROAD	3+035.210=				279,214.6740	25,444.3220	
	A PT.	ON C/L N.B. C.S.A.H. 17	3+829.373						
C/L 97TH LANE									
1350	POT	C/L 97TH LANE	4+000.000				279,129.9300	25,593.2970	89° 56' 27.0"
50014	POT	C/L 97TH LANE	4+072.037=				279,201.3670	25,593.3710	
	A PT.	ON C/L S.B. C.S.A.H. 17	3+978.379						
1351	POT	C/L 97TH LANE	4+035.237=				279,215.1670	25,593.3850	
	A PT.	ON C/L N.B. C.S.A.H. 17	3+978.437						
C/L WEST ROAD (NORTH)									
1400	POT	C/L WEST ROAD	5+000.000=				279,202.2120	25,667.5970	90° 16' 07.3"
	A PT.	ON C/L S.B. C.S.A.H. 17	3+052.605						
50004	POT	C/L WEST ROAD	5+013.201=				279,215.4130	25,667.5350	
	A PT.	ON C/L N.B. C.S.A.H. 17	3+052.587						
1401	POT	C/L WEST ROAD	5+056.955				279,269.1660	25,667.2830	
C/L 99TH AVENUE N.E.									
1450	POT	C/L 99TH AVE. N.E.	6+000.000				279,133.0140	25,880.6570	89° 53' 42.7"
50016	POT	C/L 99TH AVE. N.E.	6+059.305=				279,202.9190	25,880.7850	
	A PT.	ON C/L S.B. C.S.A.H. 17	3+265.734						
1451	POT	C/L 99TH AVE. N.E.	6+033.105=				279,216.1190	25,880.8090	
	A PT.	ON C/L N.B. C.S.A.H. 17	3+265.862						
C/L AUSTIN ST. N.E.									
1500	POT	C/L AUSTIN ST. N.E.	7+000.000				279,134.0940	26,147.0580	89° 31' 50.5"
50017	POT	C/L AUSTIN ST. N.E.	7+059.817=				279,203.9090	26,147.6300	
	A PT.	ON C/L S.B. C.S.A.H. 17	3+532.641						
1501	POT	C/L AUSTIN ST. N.E.	7+033.021=				279,217.1120	26,147.7380	
	A PT.	ON C/L N.B. C.S.A.H. 17	3+532.793						
C/L CO. RD. 10 (NORTH ROAD)									
1550	POT	C/L CO. RD. 10	8+000.000=				279,205.8500	26,246.5450	90° 33' 19.9"
	A PT.	ON C/L S.B. C.S.A.H. 17	3+631.332						
50007	POT	C/L CO. RD. 10	8+013.200=				279,219.0490	26,246.4170	
	A PT.	ON C/L N.B. C.S.A.H. 17	3+631.492						
1551	POT	C/L CO. RD. 10	8+115.723				279,321.5680	26,245.4230	

NO.	DATE	BY	CHKD	APPR	REVISION

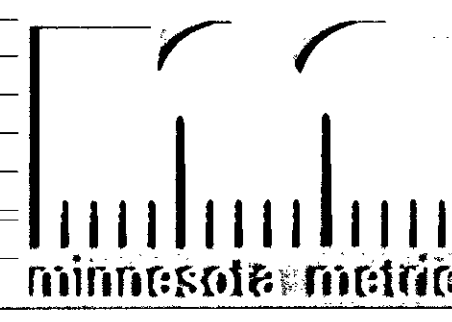


I hereby certify that this plan, specification or report was prepared by me or under my direct supervision and that I am a duly Registered Professional Engineer under the laws of the State of Minnesota.

Donald A. Demers
 Date: 3-21-97 Reg. No. 23397

STATE AND PROJECT NO.
 S.A.P. 02-617-11
 S.A.P. 106-020-12
 S.A.P. 106-030-03
 CO. PROJECT NO.

DRAWN BY DATE
 L. VanDRASEK 11-96
 DESIGNED BY
 B. URBANEK 10-96
 CHECKED BY
 D. DEMERS 1-97
 COMM. NO.
 0962410

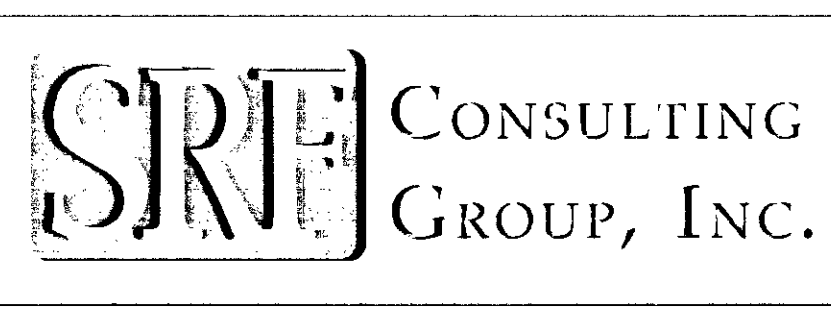

ANOKA COUNTY
 ALIGNMENT TABULATION
 C.S.A.H. 17 RECONSTRUCTION


SHEET
 55
 OF
 236

(P)

CURVE NO.	POINT	STATION	CURVE DATA				COORDINATES		AZIMUTH
			Δ	R	T	L	X	Y	
C/L BALL ROAD									
1600	POT	C/L BALL ROAD	3+000.000=				219,204.9840	26,629.9350	90° 25' 45.5"
	A PT.	ON C/L S.B. C.S.A.H. 17	10+014.366						
50008	POT	C/L BALL ROAD	3+014.643=				219,219.6210	26,629.9250	
	A PT.	ON C/L N.B. C.S.A.H. 17	10+014.306						
1601	POT	C/L BALL ROAD	3+134.266				219,339.2460	26,628.9230	
C/L W.B. PHEASANT RIDGE DRIVE									
1150	POT	C/L W.B. PLEASANT RIDGE DRIVE	10+000.000				219,125.8860	27,268.4360	90° 06' 05.5"
50020	POT	C/L W.B. PLEASANT RIDGE DRIVE	10+082.689=				219,208.5150	27,268.2890	
	A PT.	ON C/L S.B. C.S.A.H. 17	10+653.396						
1151	POT	C/L W.B. PLEASANT RIDGE DRIVE	10+036.506=				219,222.3920	27,268.2650	
	A PT.	ON C/L N.B. C.S.A.H. 17	10+653.373						
C/L E.B. PHEASANT RIDGE DRIVE									
1700	POT	C/L E.B. PLEASANT RIDGE DRIVE	10+000.000				219,125.8610	27,254.3500	90° 07' 41.8"
50021	POT	C/L E.B. PLEASANT RIDGE DRIVE	10+082.635=				219,208.4960	27,254.1650	
	A PT.	ON C/L S.B. C.S.A.H. 17	10+639.271						
1701	POT	C/L E.B. PLEASANT RIDGE DRIVE	10+036.468=				219,222.3290	27,254.1340	
	A PT.	ON C/L N.B. C.S.A.H. 17	10+639.241						
C/L N.B. I 35W (FOR INFORMATION ONLY)									
382	POT	C/L N.B. I 35W	17+983.240				218,656.9380	26,334.6080	43° 38' 14.0"
50033	POT	C/L N.B. I 35W	18+773.110=				219,202.0191	26,306.2556	
	A PT.	ON C/L S.B. C.S.A.H. 17	10+291.277						
50034	POT	C/L N.B. I 35W	18+797.552=				219,218.8860	26,923.9450	
	A PT.	ON C/L N.B. C.S.A.H. 17	10+309.030						
383	POT	C/L N.B. I 35W	19+277.201				219,549.8810	27,271.0780	
C/L S.B. I 35W (FOR INFORMATION ONLY)									
398	POT	C/L S.B. I 35W	17+983.240				218,638.4080	26,352.2760	43° 38' 14.0"
50036	POT	C/L S.B. I 35W	18+800.163=				219,202.1580	26,343.5020	
	A PT.	ON C/L S.B. C.S.A.H. 17	10+328.525						
50035	POT	C/L S.B. I 35W	18+824.605=				219,219.0250	26,361.1920	
	A PT.	ON C/L N.B. C.S.A.H. 17	10+346.277						
399	POT	C/L S.B. I 35W	19+277.201				219,531.3510	27,288.7460	
C/L N.W. RAMP									
2500	POT		5+000.000=				219,453.9255	27,225.5093	227° 27' 04.0"
	A PT.	12.400m LG. OF C/L S.B. I 35W	19+178.000						
	PC		5+164.373				219,332.8317	27,114.3570	
NARMP-1	PI		5+227.849	22° 47' 10.0" RT	315.000	63.475	219,286.0693	27,071.4337	PI
	PT		5+239.646				219,226.3326	27,049.9710	250° 14' 14.0"
2503	POT	C/L N.W. RAMP	5+236.365=				219,219.4449	27,047.4963	
	A PT.	ON C/L N.B. C.S.A.H. 17	10+432.583						

NO.	DATE	BY	CHKD	APPR	REVISION


--	--	--	--	--	--

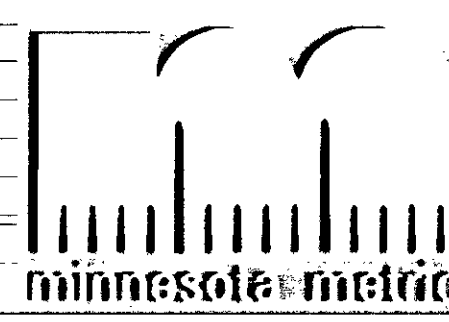

I hereby certify that this plan, specification or report was prepared by me or under my direct supervision and that I am a duly Registered Professional Engineer under the laws of the State of Minnesota.
Donald A. Demers
 Date 3-21-97 Reg. No. 23327

STATE AID PROJECT NO. S.A.P. 02-617-11 S.A.P. 106-020-12 S.A.P. 106-030-03
 CO. PROJECT NO.

DRAWN BY DATE L. VanDRASEK 11-96
 DESIGNED BY B. URBANEK 10-96
 CHECKED BY D. DEMERS 1-97
 COMM. NO. 0962410

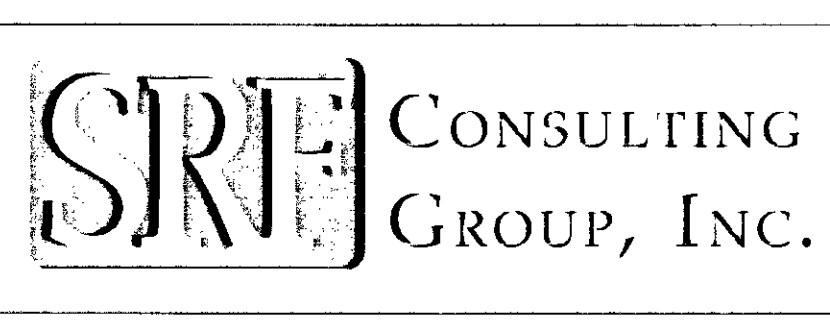

ANOKA COUNTY
 ALIGNMENT TABULATION
 C.S.A.H. 17 RECONSTRUCTION

SHEET 56 OF 236

(P)

CURVE NO.	POINT	STATION	CURVE DATA				COORDINATES		AZIMUTH	
			Δ	R	T	L	X	Y		
C/L N.E. RAMP (AS BUILT)										
400	POT	C/L N.E. RAMP	30+000.000=					279,214.5274	26,831.3659	56° 14' 14.0"
	A PT.	4.014m LT. C/L N.B. C.S.A.H. 17	10+216.435					279,218.5510	26,834.0557	
50037	POT	C/L N.E. RAMP	30+004.840=							
	A PT.	ON C/L N.B. C.S.A.H. 17	10+219.140							
	PC		30+022.311					279,233.0759	26,843.7656	
C46	PI		30+077.005	34° 46' 45.0" LT	174.639	54.694	106.008	279,278.5451	26,874.1619	PI
	PT		30+128.319					279,298.5531	26,925.0644	21° 27' 29.0"
	PC		30+203.272					279,325.9725	26,994.8225	
C47	PI		30+248.722	17° 45' 00.0" RT	291.063	45.449	90.170	279,342.5983	27,037.1214	PI
	PT	C/L N.E. RAMP	30+293.443					279,371.3290	27,072.3380	39° 12' 29.0"
	A PT.	7.922m RT. C/L N.B. I 35W	19+010.147							
C/L S.W. RAMP (AS BUILT)										
426	POT	C/L S.W. RAMP	40+000.000=					279,215.4136	27,045.4104	236° 14' 14.0"
	A PT.	12.576m RT. C/L S.B. C.S.A.H. 17	10+430.678							
50038	POT	C/L S.W. RAMP	40+015.309=					279,202.6365	27,036.9023	
	A PT.	ON C/L S.B. C.S.A.H. 17	10+421.927							
	PC		40+022.311					279,196.8651	27,033.0107	
C58	PI		40+077.005	34° 46' 45.0" LT	174.639	54.694	106.008	279,151.3959	27,002.6144	PI
	PT		40+128.319					279,131.3979	26,951.7119	201° 27' 29.0"
	PC		40+203.272					279,103.9631	26,931.9533	
C59	PI		40+248.722	17° 45' 00.0" RT	291.063	45.449	90.170	279,097.3422	26,839.6549	PI
	PT	C/L S.W. RAMP	40+293.443=					279,058.6120	26,804.4384	219° 12' 29.0"
	A PT.	7.921m LT. C/L S.B. I 35W	18+600.459							
C/L S.E. RAMP										
2000	POT	C/L S.W. RAMP	3+000.000=					278,968.6960	26,643.5919	47° 27' 04.0"
	A PT.	12.400m RT. C/L N.B. I 35W	18+422.000							
	PC		3+166.330					279,091.232	26,756.053	
SERMP-1	PI		3+230.813	22° 47' 10.0" RT	320.000	64.483	127.262	279,139.736	26,799.672	PI
	PT		3+293.592					279,199.421	26,821.476	70° 14' 14.0"
2042	POT	C/L S.E. RAMP	3+296.069=					279,201.752	26,822.313	
	A PT.	6.6m LT OF S.B. C.S.A.H. 17	10+207.362							
C/L BOX CULVERT (BRIDGE NO. 02J07)										
3500	POT	C/L BOX CULVERT	20+000.000=					279,238.0160	26,014.2910	337° 41' 16.3"
	A PT.	21.455m RT. C/L N.B. C.S.A.H. 17	9+399.416							
3501	PI		20+024.707					279,223.6360	26,037.1430	0° 11' 22.5"
	PC		20+111.964					279,228.9247	26,124.4042	
BOX-1	PI		20+134.880	1° 03' 19.6" RT	2,488.000	22.916	45.831	279,229.0005	26,147.3202	PI
	PT		20+157.795					279,229.4985	26,170.2310	1° 14' 42.1"
3502	PI		20+211.345					279,230.6620	26,223.7690	338° 49' 39.1"
3503	PI		20+215.033					279,229.3300	26,227.2030	313° 17' 05.4"
3504	PI		20+218.691					279,226.8020	26,229.8520	293° 45' 43.6"
3505	PI		20+222.349					279,223.4540	26,231.3260	271° 14' 47.7"
3506	PI	C/L BOX CULVERT	20+259.260=					279,186.5520	26,232.1290	
	A PT.	32.270m LT. C/L N.B. C.S.A.H. 17	9+616.601							

1	4-4-97	MCI	MDH	DAD	REVISE SE RAMP ALIGNMENT
NO	DATE	BY	CKD	APPR	REVISION
NAME: AT4 410.PLN DATE: Mar. 17, 1997					



I hereby certify that this plan, specification or report was prepared by me or under my direct supervision and that I am a duly Registered Professional Engineer under the laws of the State of Minnesota.

Donald A. Demco
Date 3-21-97 Reg. No. 23377

STATE AID PROJECT NO.
S.A.P. 02-817-11
S.A.P. 108-020-12
S.A.P. 106-030-03
CO. PROJECT NO.


DRAWN BY DATE
L. VanDRASEK 11-96
DESIGNED BY
B. URBANEK 10-96
CHECKED BY
D. DEMERS 1-97
COMM. NO.
0962410



CONSULTING GROUP, INC.


ANOKA COUNTY
ALIGNMENT TABULATION
C.S.A.H. 17 RECONSTRUCTION

SHEET 57 OF 236

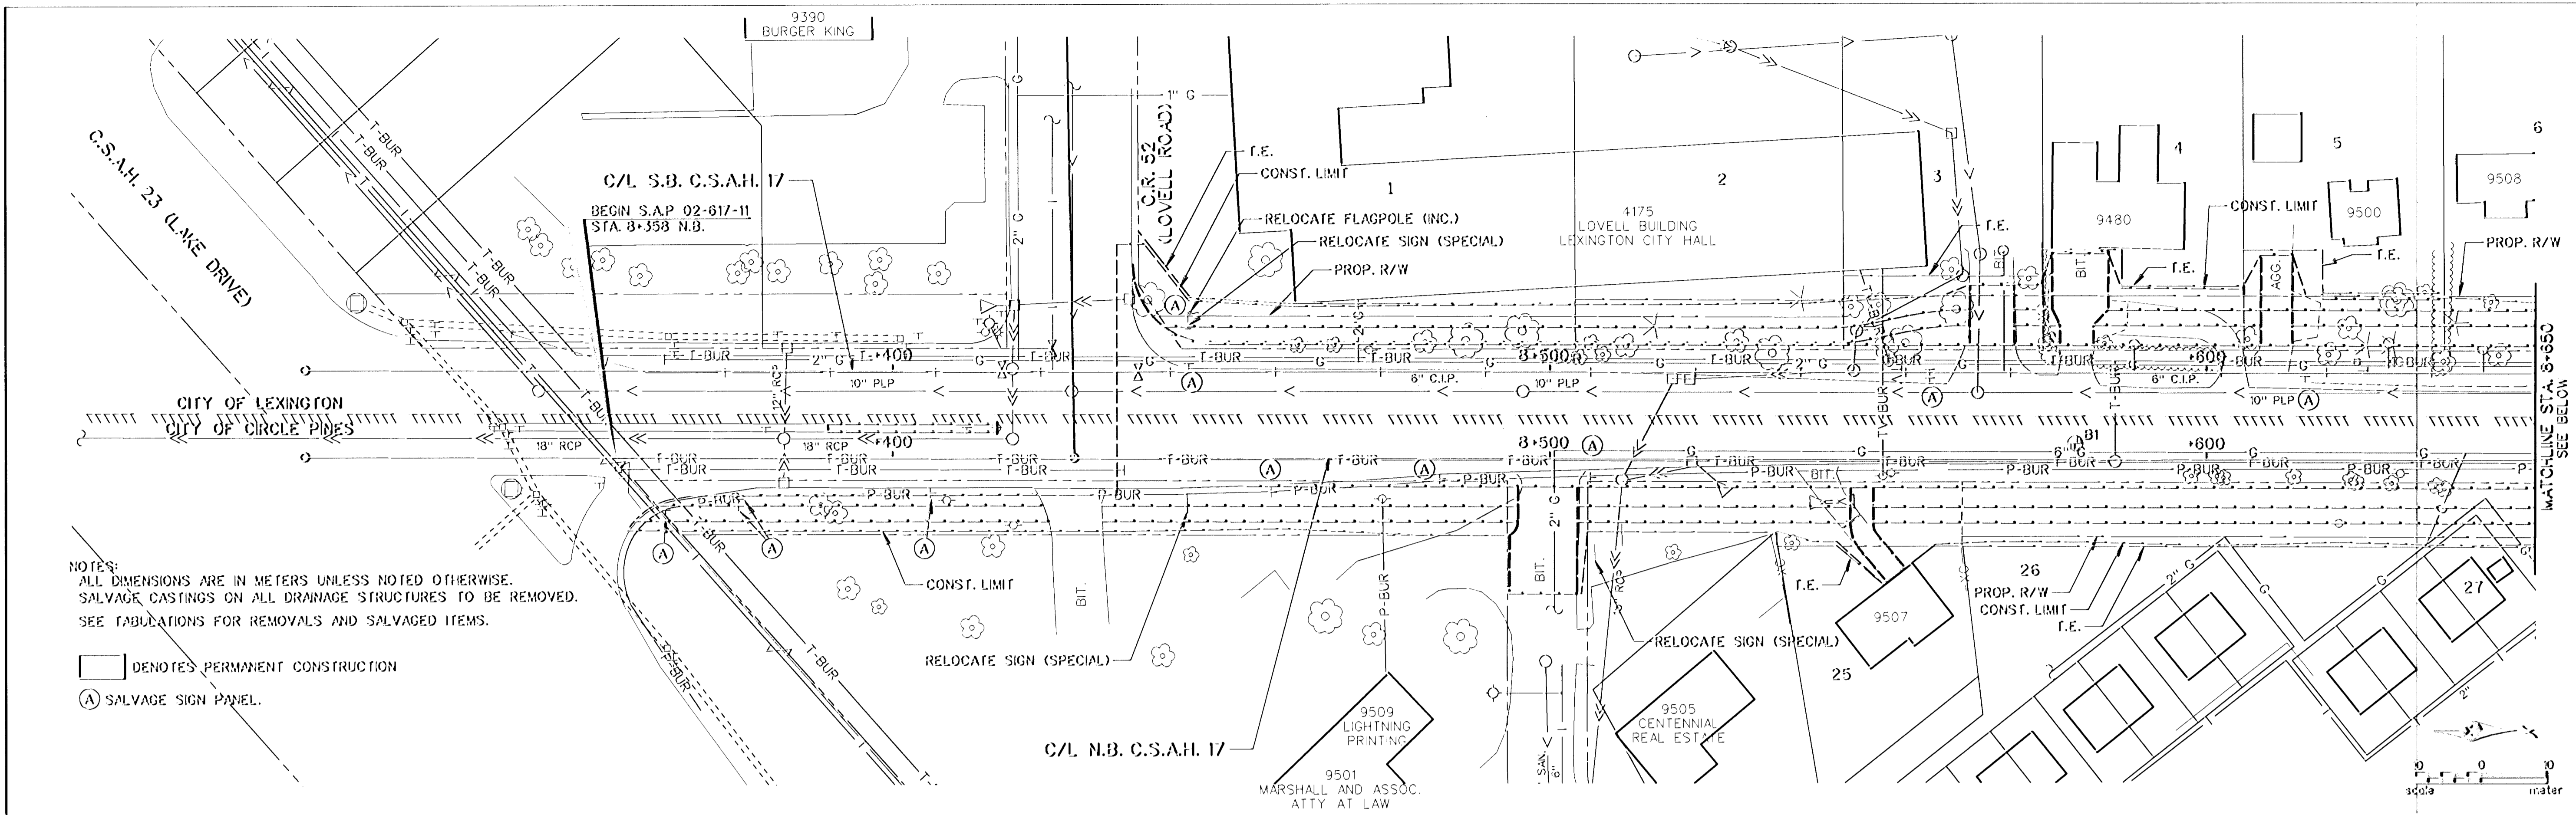


NOTES:
 ALL DIMENSIONS ARE IN METERS UNLESS NOTED OTHERWISE.
 SALVAGE CASTINGS ON ALL DRAINAGE STRUCTURES TO BE REMOVED.
 SEE FABULATIONS FOR REMOVALS AND SALVAGED ITEMS.

- DENOTES PERMANENT CONSTRUCTION
- (A) SALVAGE SIGN PANEL.

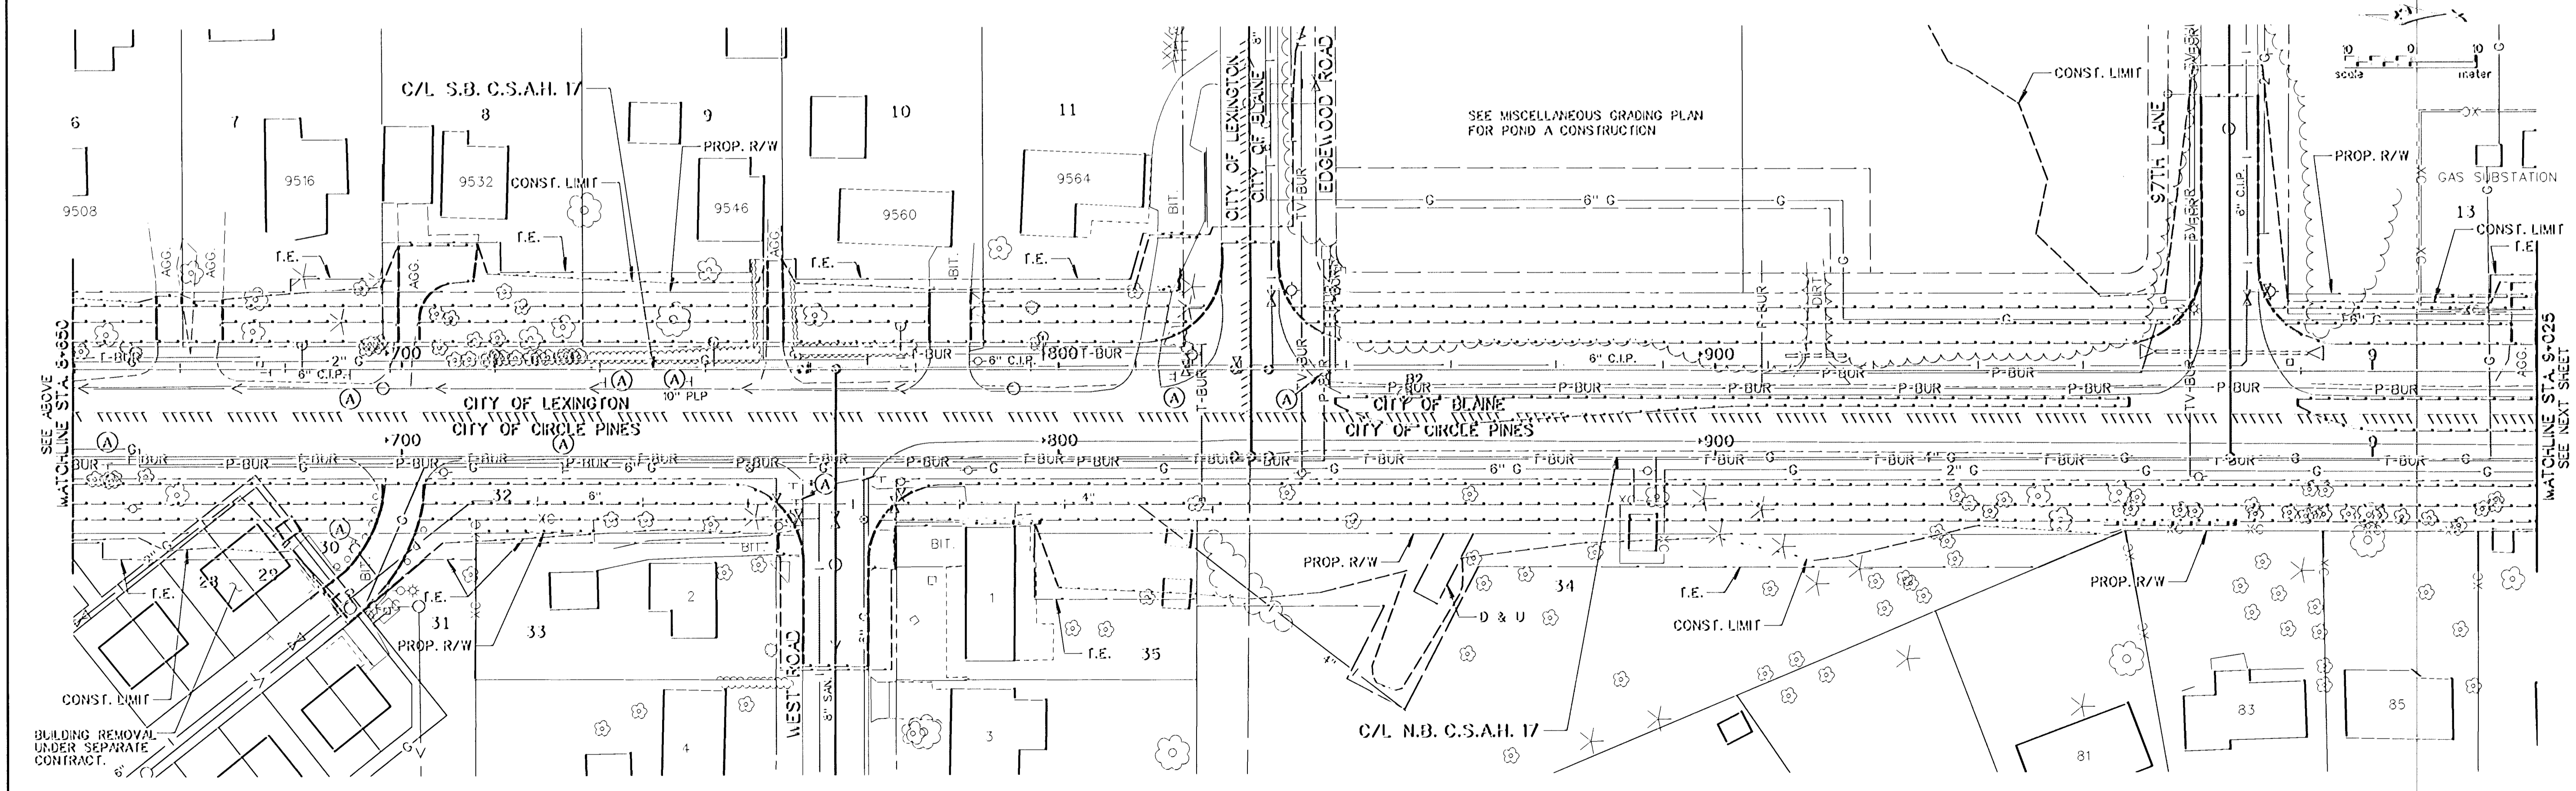

NO	DATE	BY	CKD	APPR	REVISION


NO	DATE	BY	CKD	APPR	REVISION

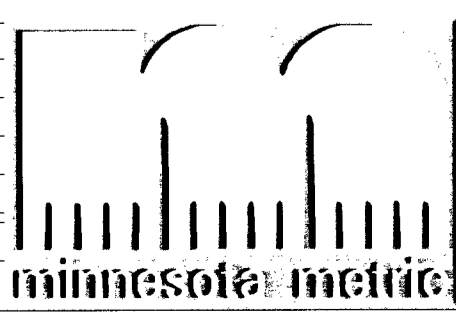

I hereby certify that this plan, specification or report was prepared by me or under my direct supervision and that I am a duly Registered Professional Engineer under the laws of the State of Minnesota.
Donald A. James
 Date 3-21-97 Reg. No. 23397


STATE AID PROJECT NO. S.A.P. 02-617-11 S.A.P. 108-020-12 S.A.P. 108-030-03
 CO. PROJECT NO.

DRAWN BY V. GRAF DATE 10-98
 DESIGNED BY B. URBANEK DATE 10-98
 CHECKED BY D. DEMERS DATE 1-97
 COMM. NO. 0982410

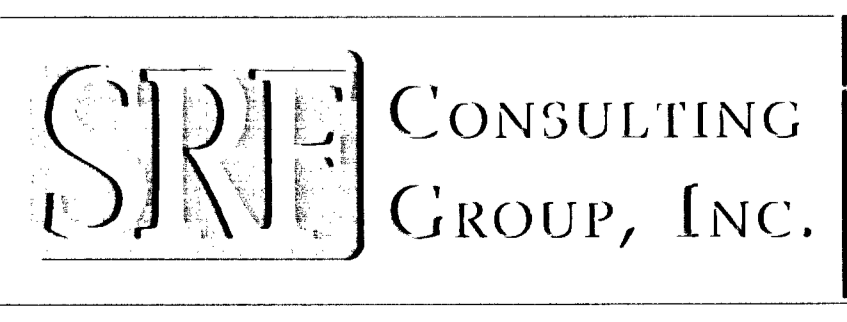


ANOKA COUNTY
 EXISTING TOPOGRAPHY AND REMOVALS
 C.S.A.H. 17 RECONSTRUCTION
 STA. 8+358 TO STA. 9+025

SHEET 58 OF 236

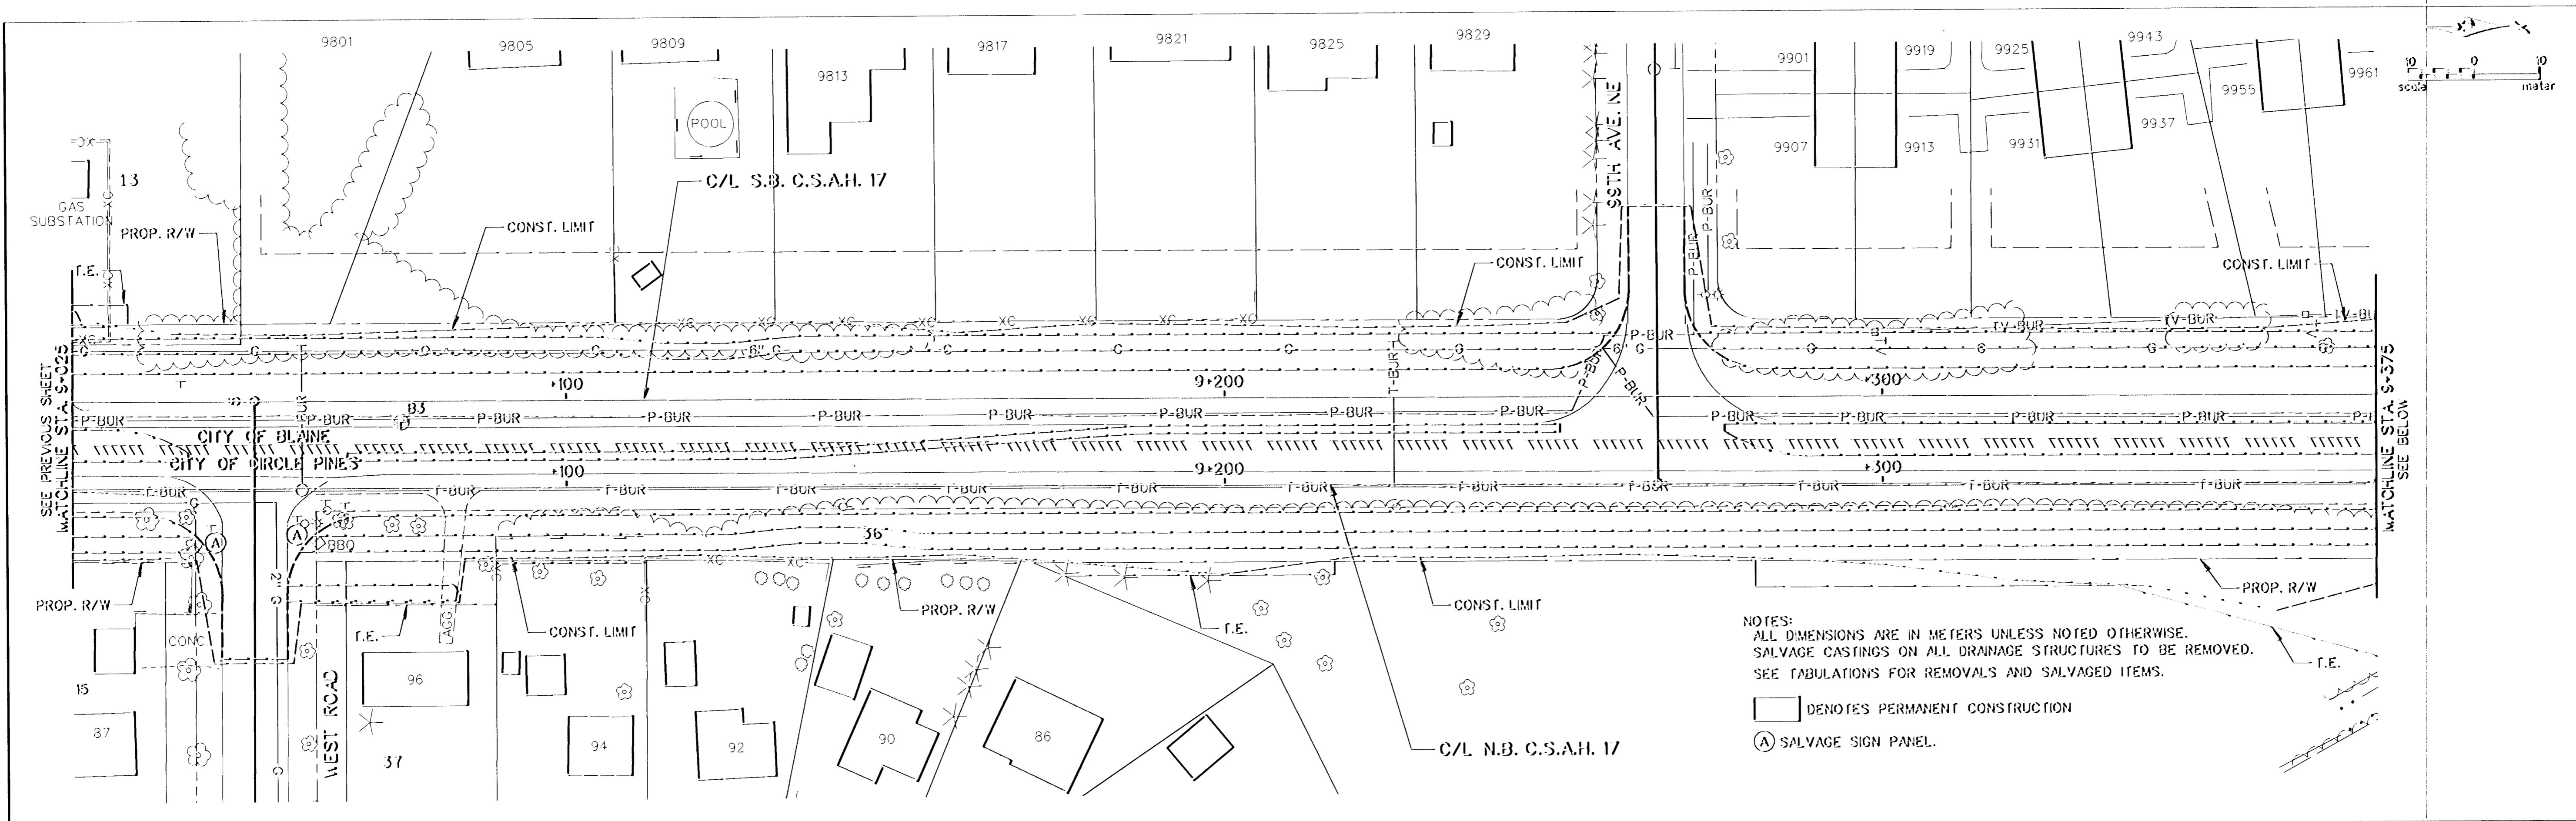

NOTES:
 ALL DIMENSIONS ARE IN METERS UNLESS NOTED OTHERWISE.
 SALVAGE CASTINGS ON ALL DRAINAGE STRUCTURES TO BE REMOVED.
 SEE FABULATIONS FOR REMOVALS AND SALVAGED ITEMS.

□ DENOTES PERMANENT CONSTRUCTION
 (A) SALVAGE SIGN PANEL.

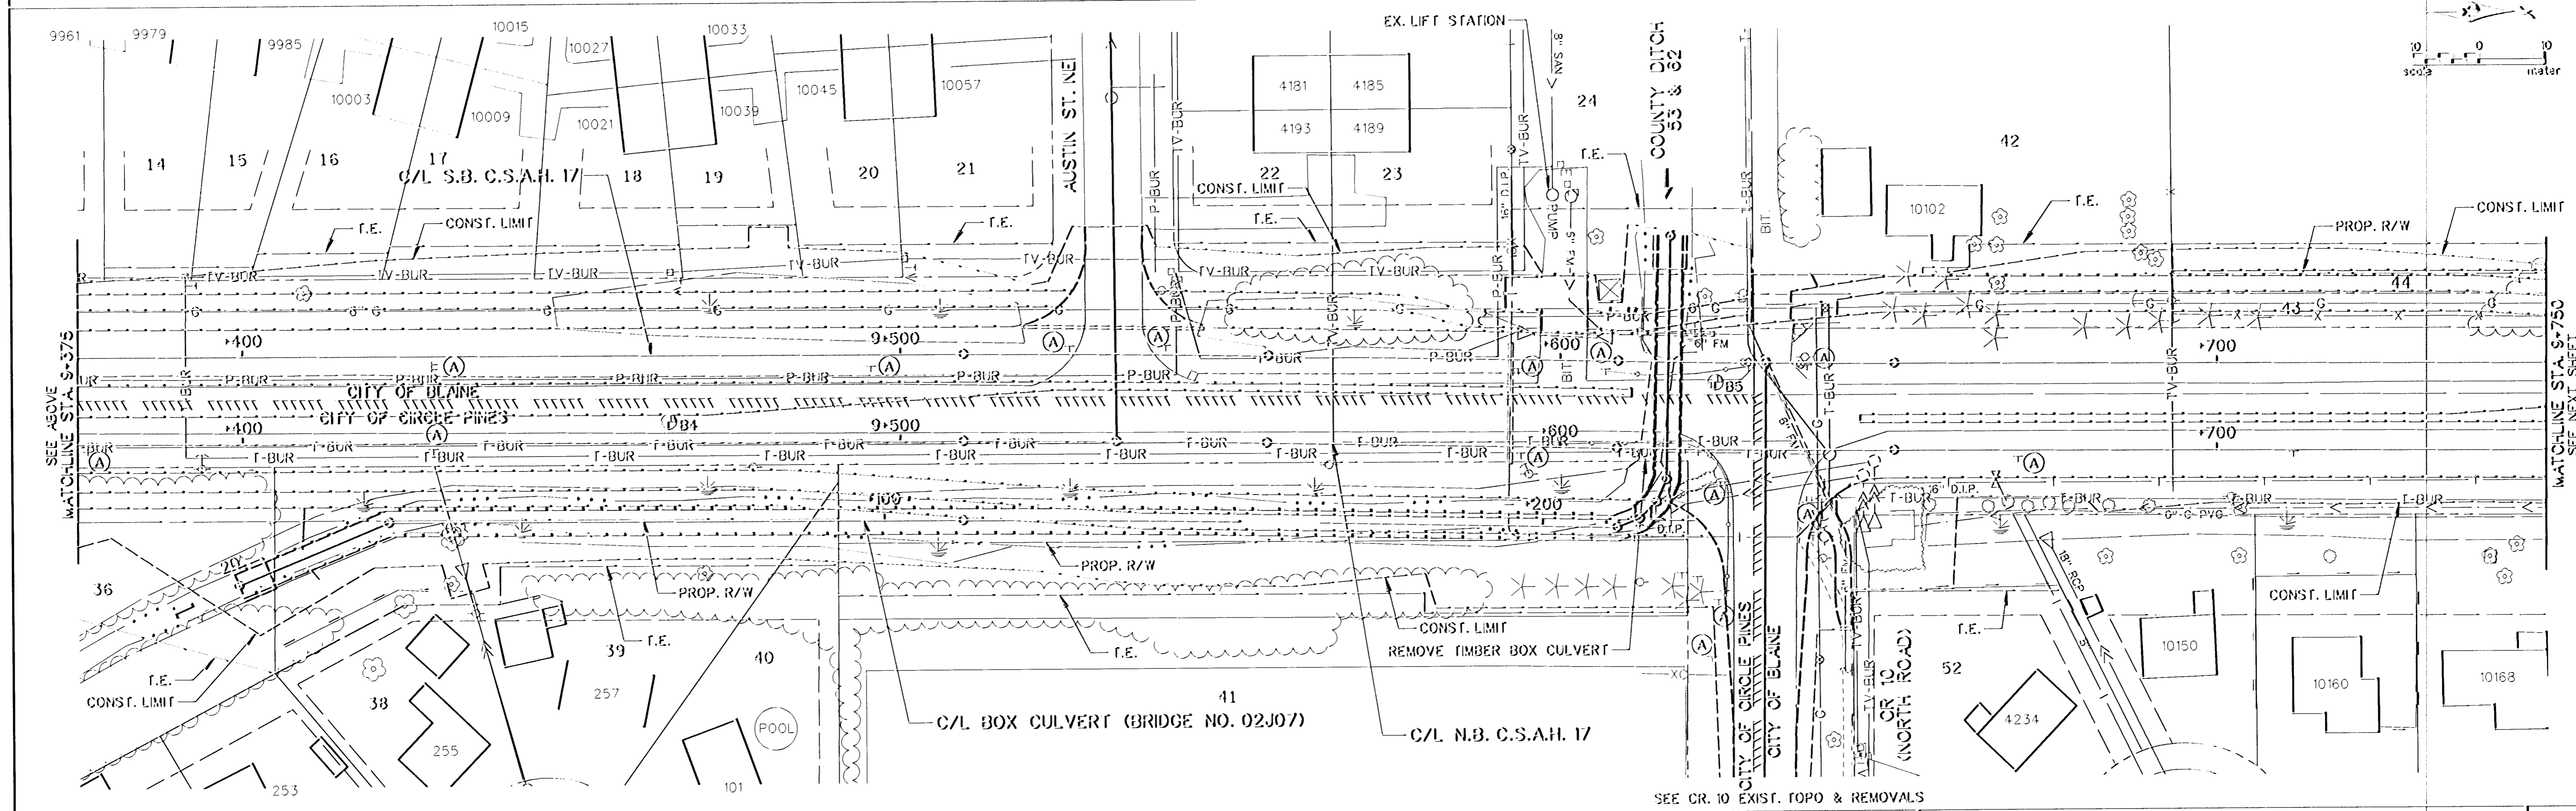

NO	DATE	BY	CHKD	APPR	REVISION


NAME: TP2 410.PLN DATE: Mar. 17, 1997

I hereby certify that this plan, specification or report was prepared by me or under my direct supervision and that I am a duly Registered Professional Engineer under the laws of the State of Minnesota.

Donald A. Demers
 Date 3-21-97 Reg. No. 23397

STATE AID PROJECT NO.
 S.A.P. 02-617-11
 S.A.P. 106-020-12
 S.A.P. 106-030-03
 CO. PROJECT NO.

DRAWN BY DATE
 V. GRAF 10-98
 DESIGNED BY
 B. URBANEK 10-98
 CHECKED BY
 D. DEMERS 1-97
 COMM. NO.
 0982410


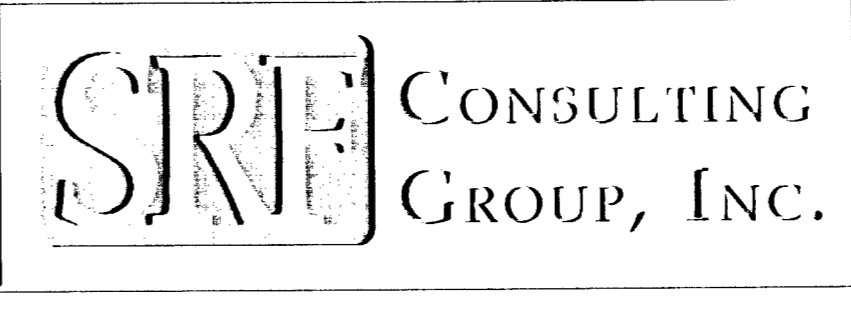


ANOKA COUNTY
 EXISTING TOPOGRAPHY AND REMOVALS
 C.S.A.H. 17 RECONSTRUCTION
 STA. 9+025 TO STA. 9+750

SHEET
 59
 OF
 236

NOTES:
 ALL DIMENSIONS ARE IN METERS UNLESS NOTED OTHERWISE.
 SALVAGE CASTINGS ON ALL DRAINAGE STRUCTURES TO BE REMOVED.
 SEE TABULATIONS FOR REMOVALS AND SALVAGED ITEMS.

□ DENOTES PERMANENT CONSTRUCTION
 (A) SALVAGE SIGN PANEL

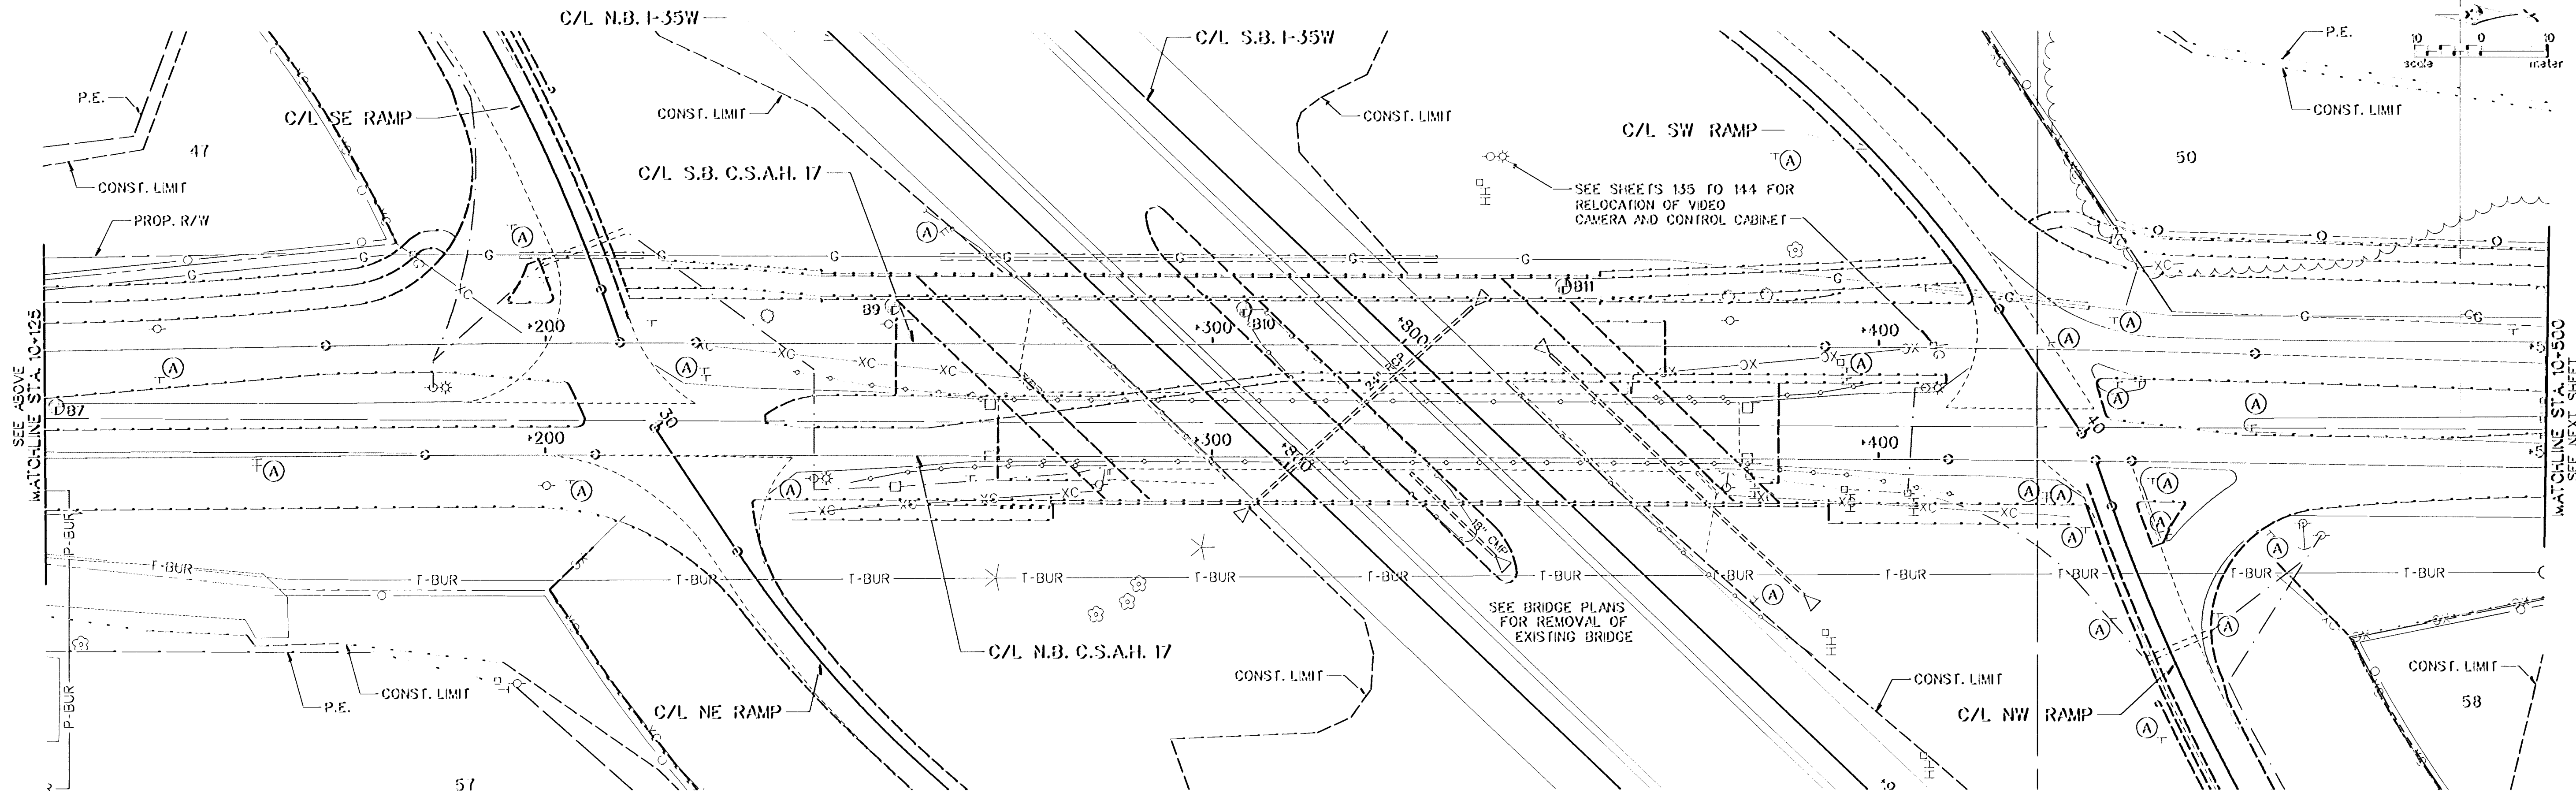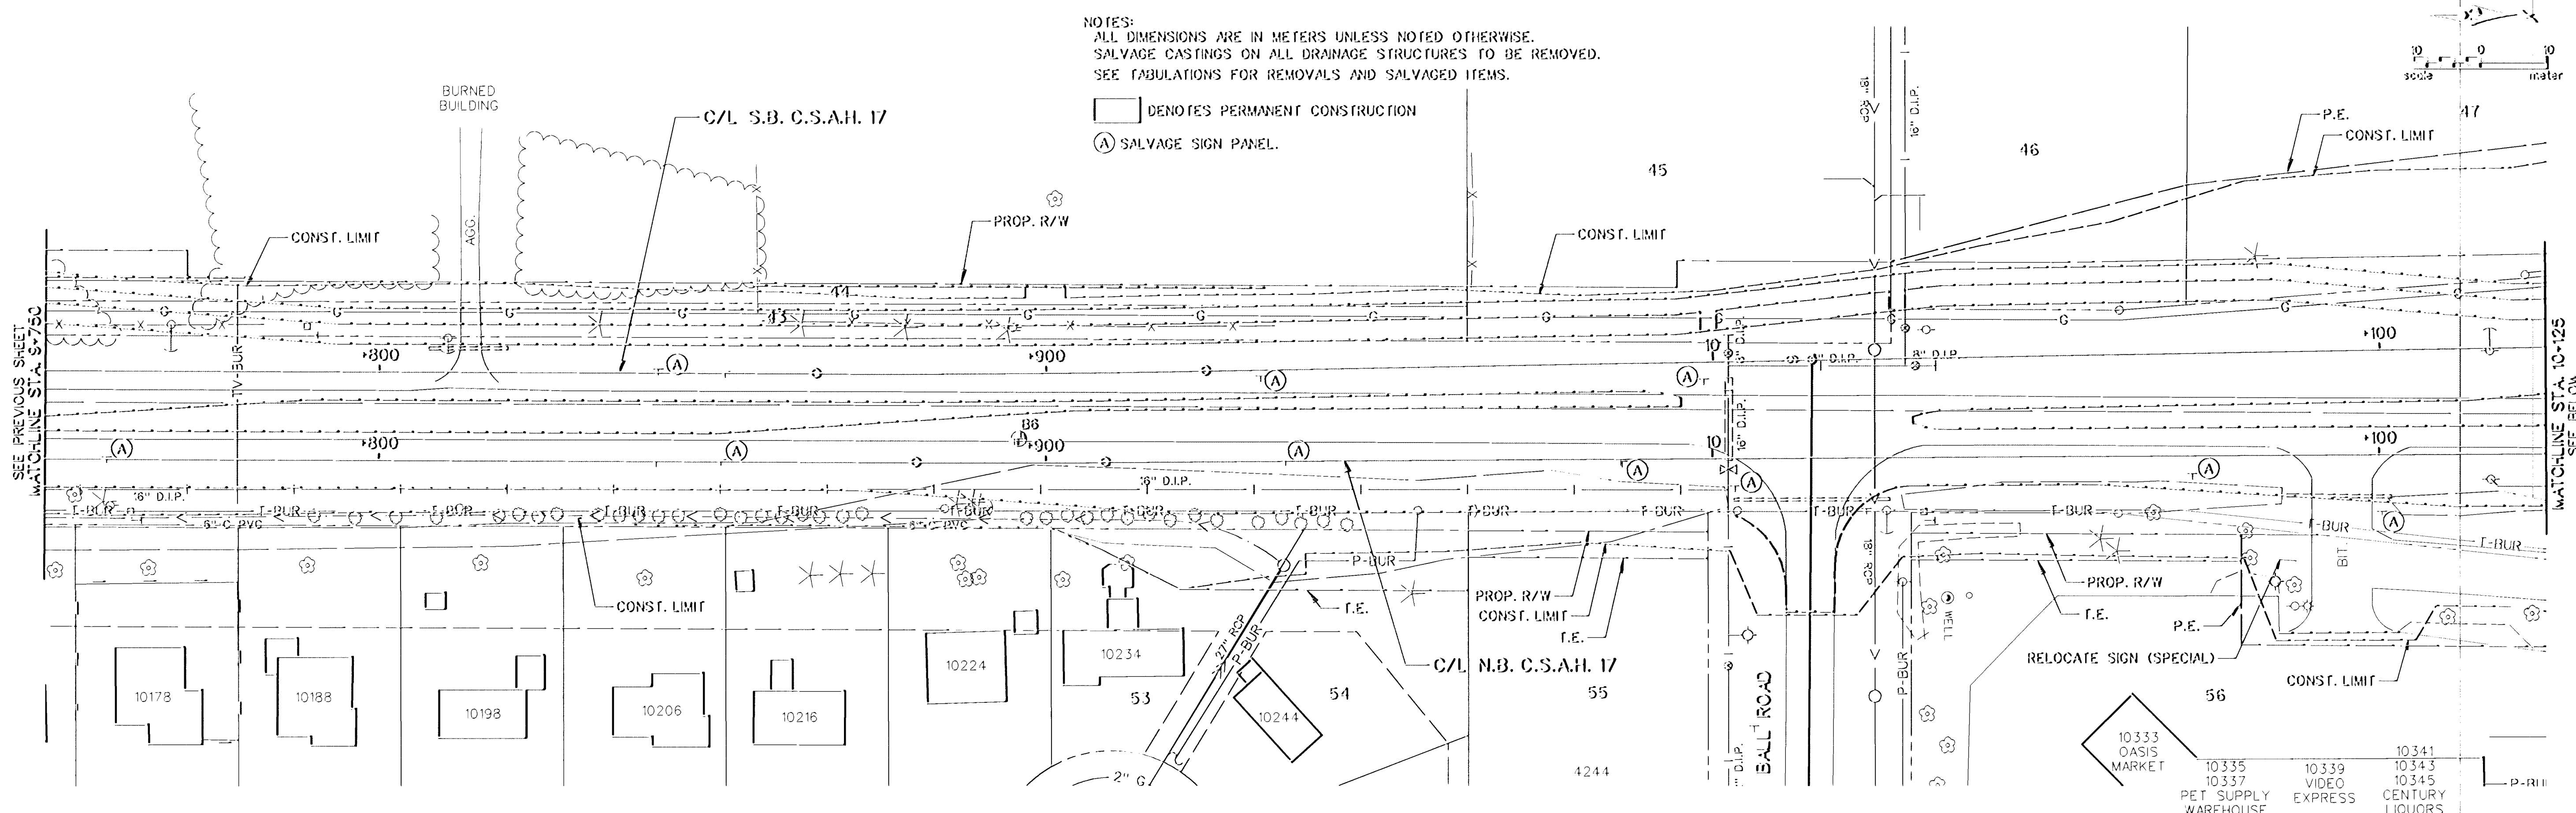

NO	DATE	BY	CHKD	APPR	REVISION

NAME: TP3 410.PLN DATE: Mar. 20, 1997



I hereby certify that this plan, specification or report was prepared by me or under my direct supervision and that I am a duly Registered Professional Engineer under the laws of the State of Minnesota.
Amold A. Demers
 Date 3-21-97 Reg. No. 23397



STATE AID PROJECT NO.
 S.A.P. 02-617-11
 S.A.P. 106-020-12
 S.A.P. 106-030-03
 CO. PROJECT NO.

DRAWN BY V. GRAF DATE 10-98
 DESIGNED BY B. URBANEK DATE 10-98
 CHECKED BY D. DEMERS DATE 1-97
 COMM. NO. 0982410





ANOKA COUNTY
 EXISTING TOPOGRAPHY AND REMOVALS
 C.S.A.H. 17 RECONSTRUCTION
 STA. 9+750 TO STA. 10+500

SHEET 60 OF 236

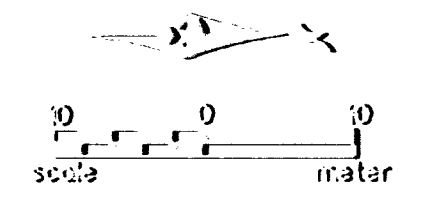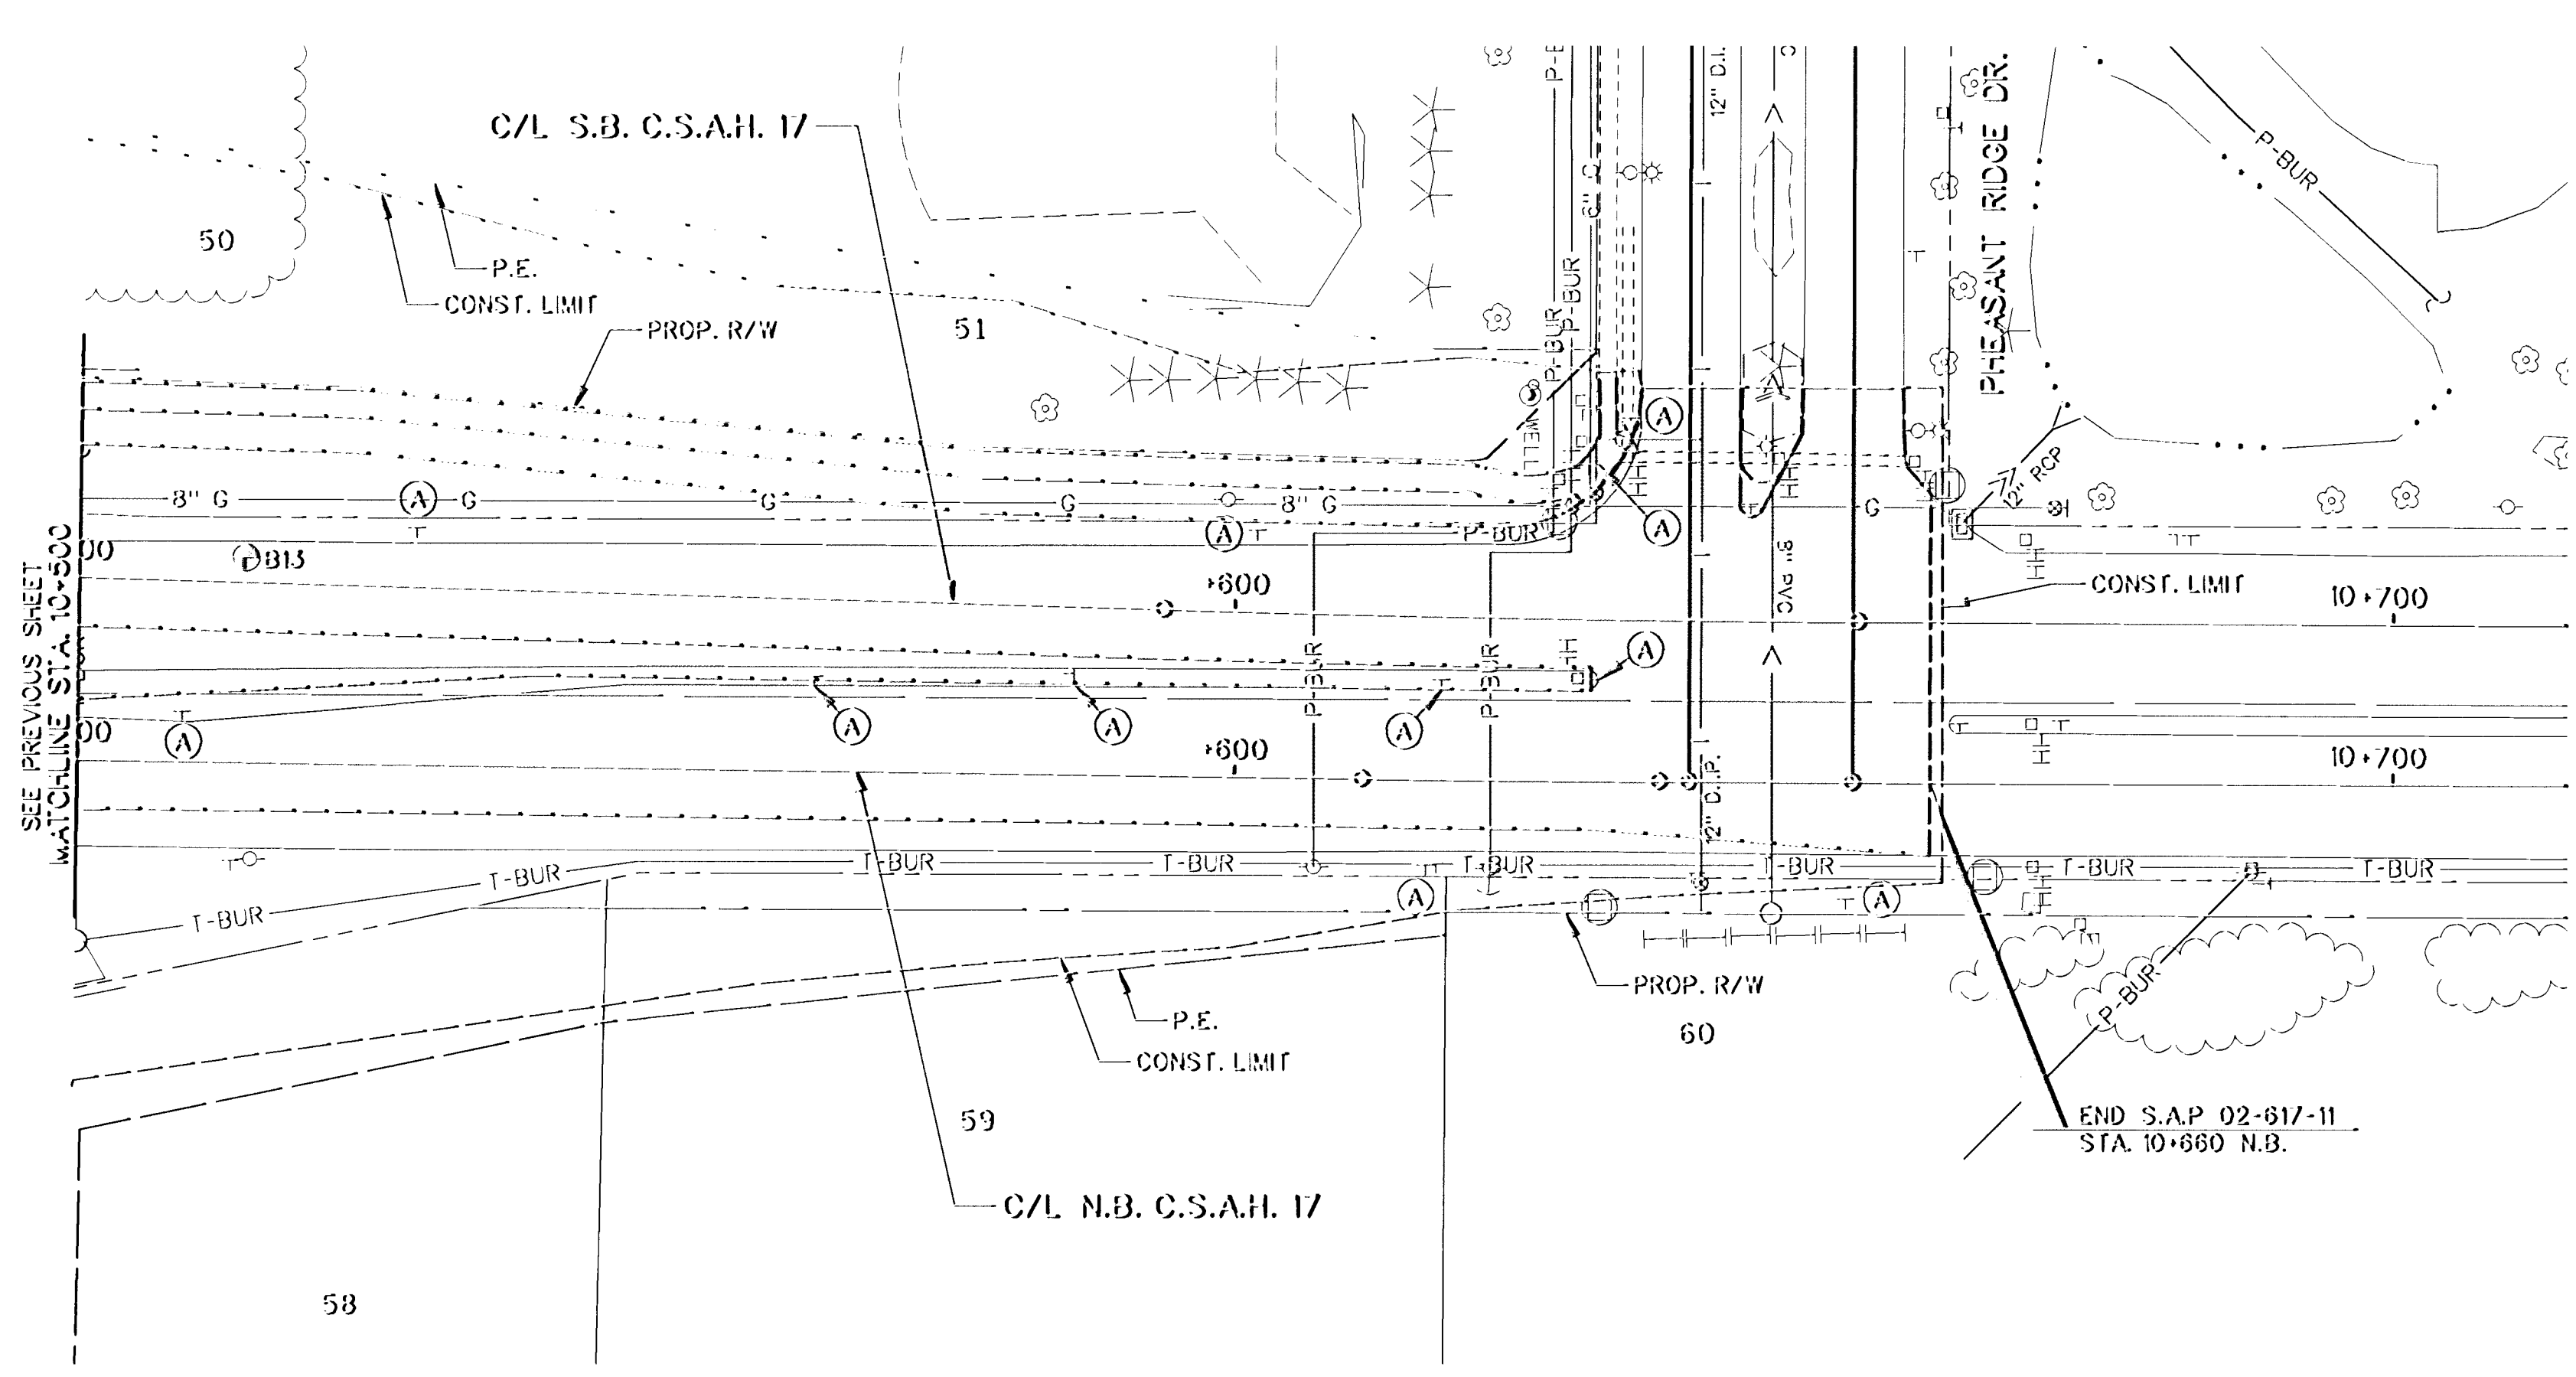


NOTES:
 ALL DIMENSIONS ARE IN METERS UNLESS NOTED OTHERWISE.
 SALVAGE CASTINGS ON ALL DRAINAGE STRUCTURES TO BE REMOVED.
 SEE TABULATIONS FOR REMOVALS AND SALVAGED ITEMS.

- DENOTES PERMANENT CONSTRUCTION
- SALVAGE SIGN PANEL.

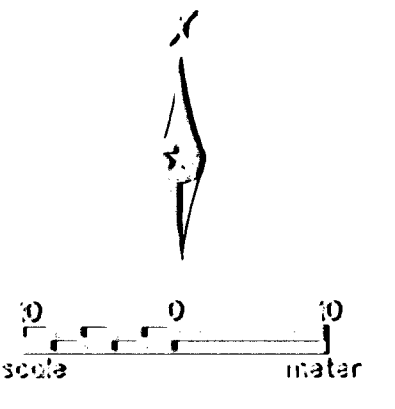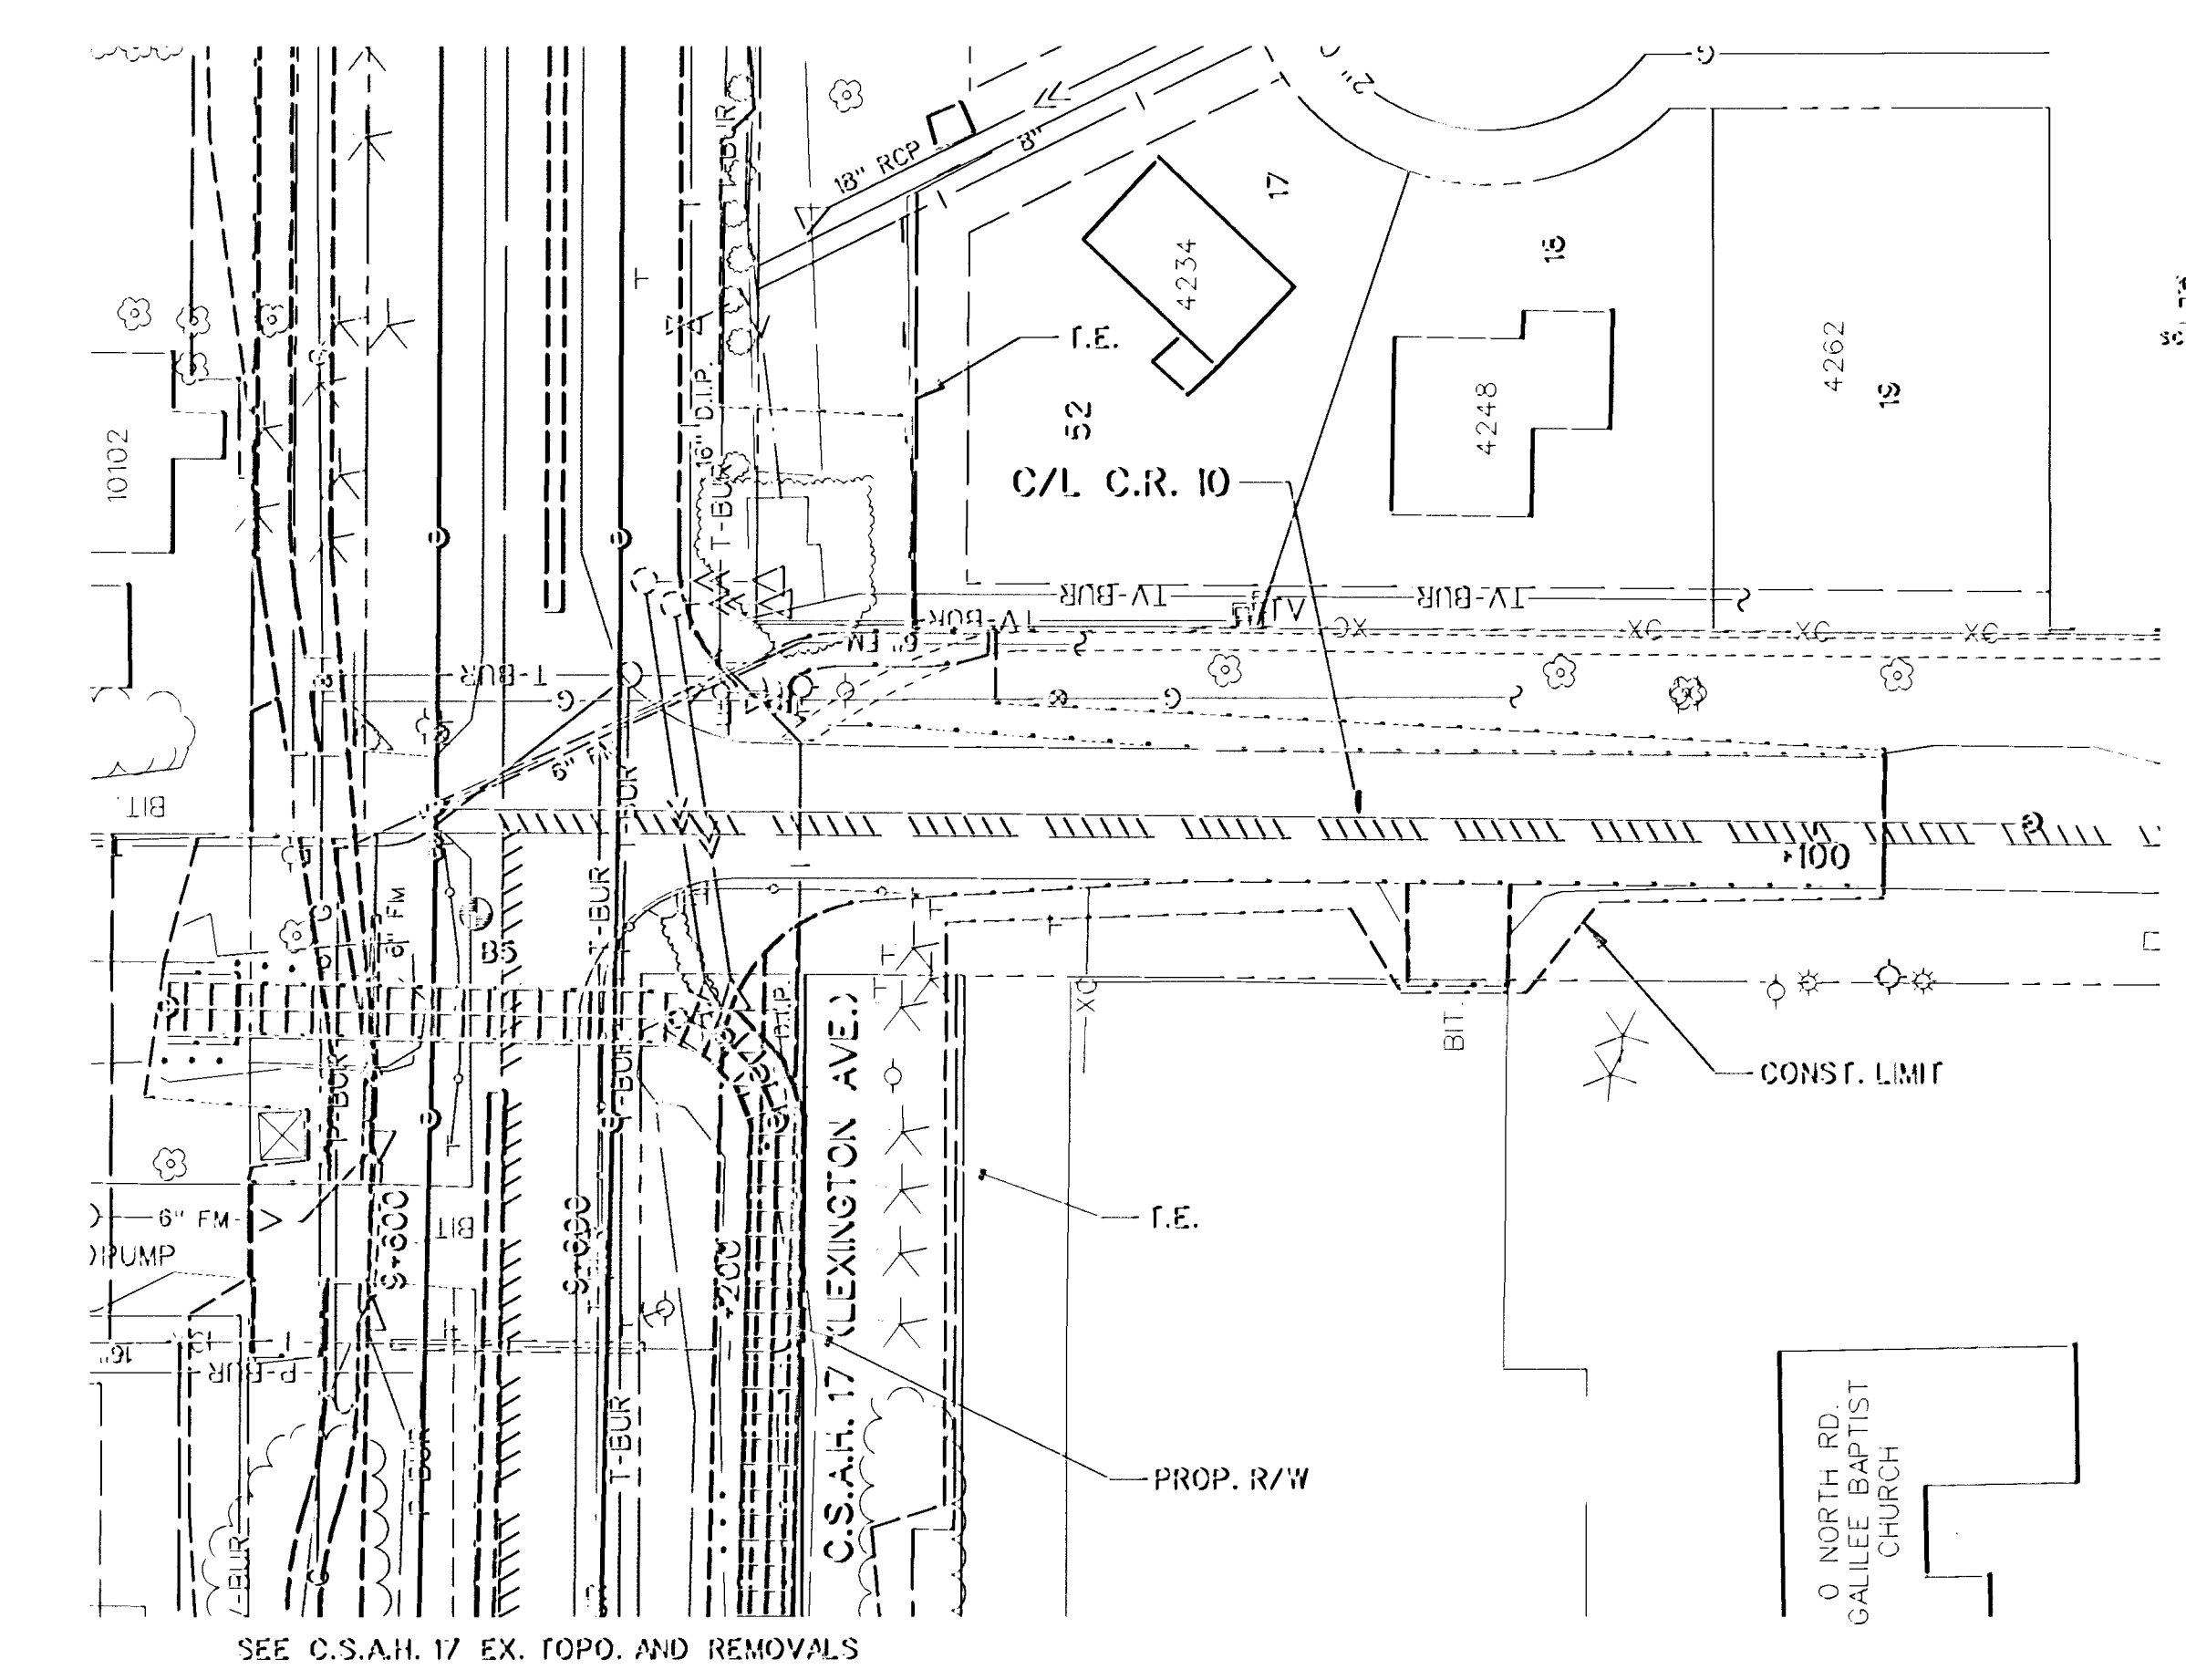

SEE C.S.A.H. 17 EX. TOPO. AND REMOVALS


NO	DATE	BY	CHKD	APPR	REVISION

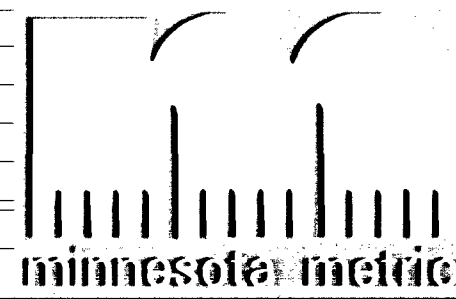

I hereby certify that this plan, specification or report was prepared by me or under my direct supervision and that I am a duly Registered Professional Engineer under the laws of the State of Minnesota.
Danell A Demers
 Date 3-21-97 Reg. No. 23377

STATE AID PROJECT NO.
 S.A.P. 02-617-11
 S.A.P. 106-020-12
 S.A.P. 106-030-03
 CO. PROJECT NO.



DRAWN BY DATE
 V. GRAF 10-96
 DESIGNED BY
 B. URBANEK 10-96
 CHECKED BY
 D. DEMERS 1-97
 COMM. NO.
 0962410


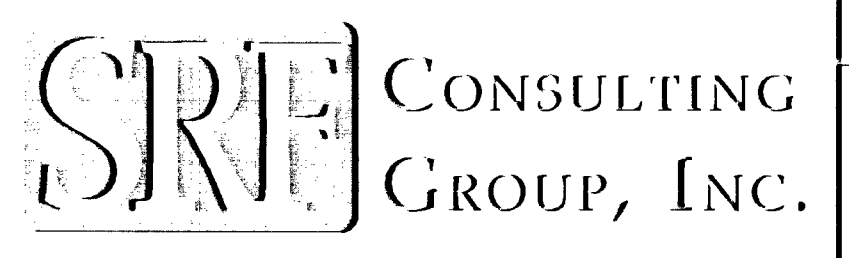


ANOKA COUNTY
 EXISTING TOPOGRAPHY AND REMOVALS
 C.S.A.H. 17 RECONSTRUCTION
 C.S.A.H. 17 STA. 10+500 TO STA. 10+660 & C.R. 10

SHEET
 61
 OF
 236


NOTES:
 ALL DIMENSIONS ARE IN METERS UNLESS NOTED OTHERWISE.
 SALVAGE CASTINGS ON ALL DRAINAGE STRUCTURES TO BE REMOVED.
 SEE TABULATIONS FOR REMOVALS AND SALVAGED ITEMS.

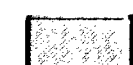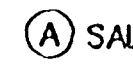-  DENOTES PERMANENT CONSTRUCTION
-  SALVAGE SIGN PANEL.

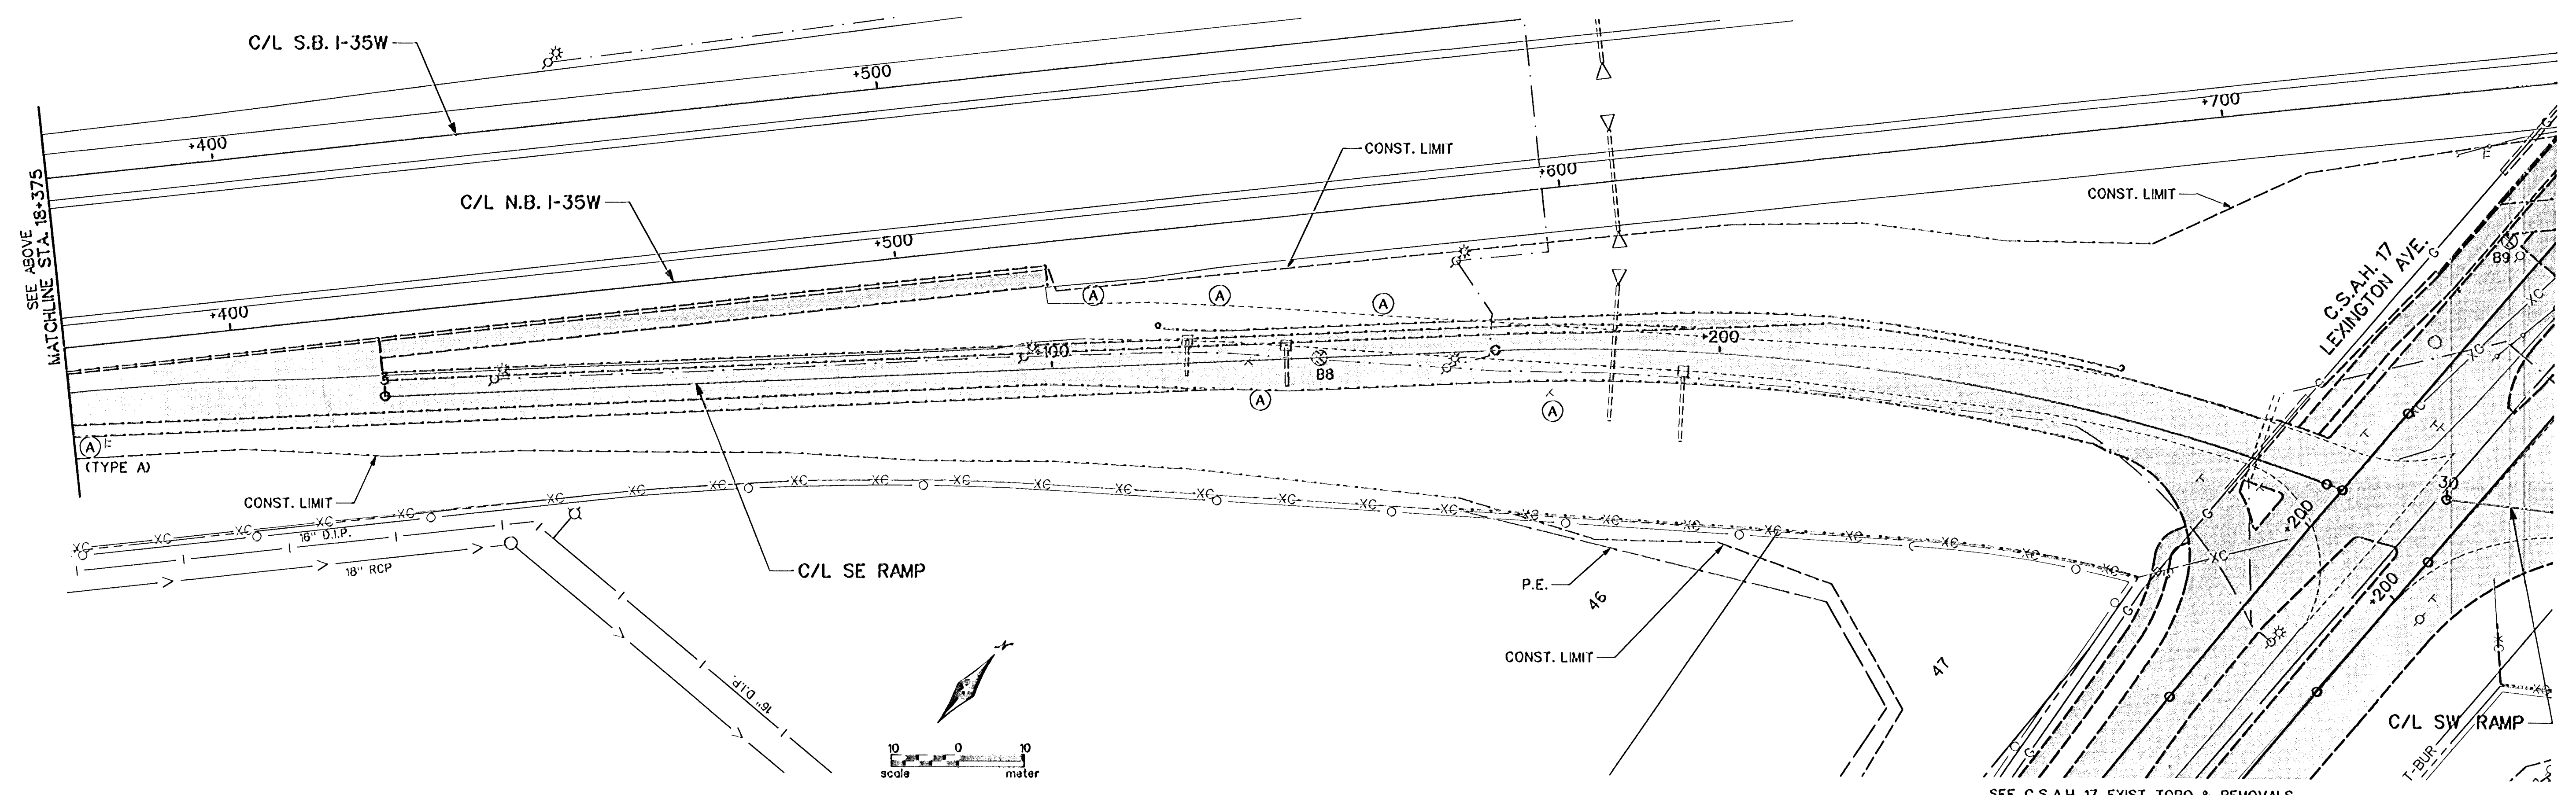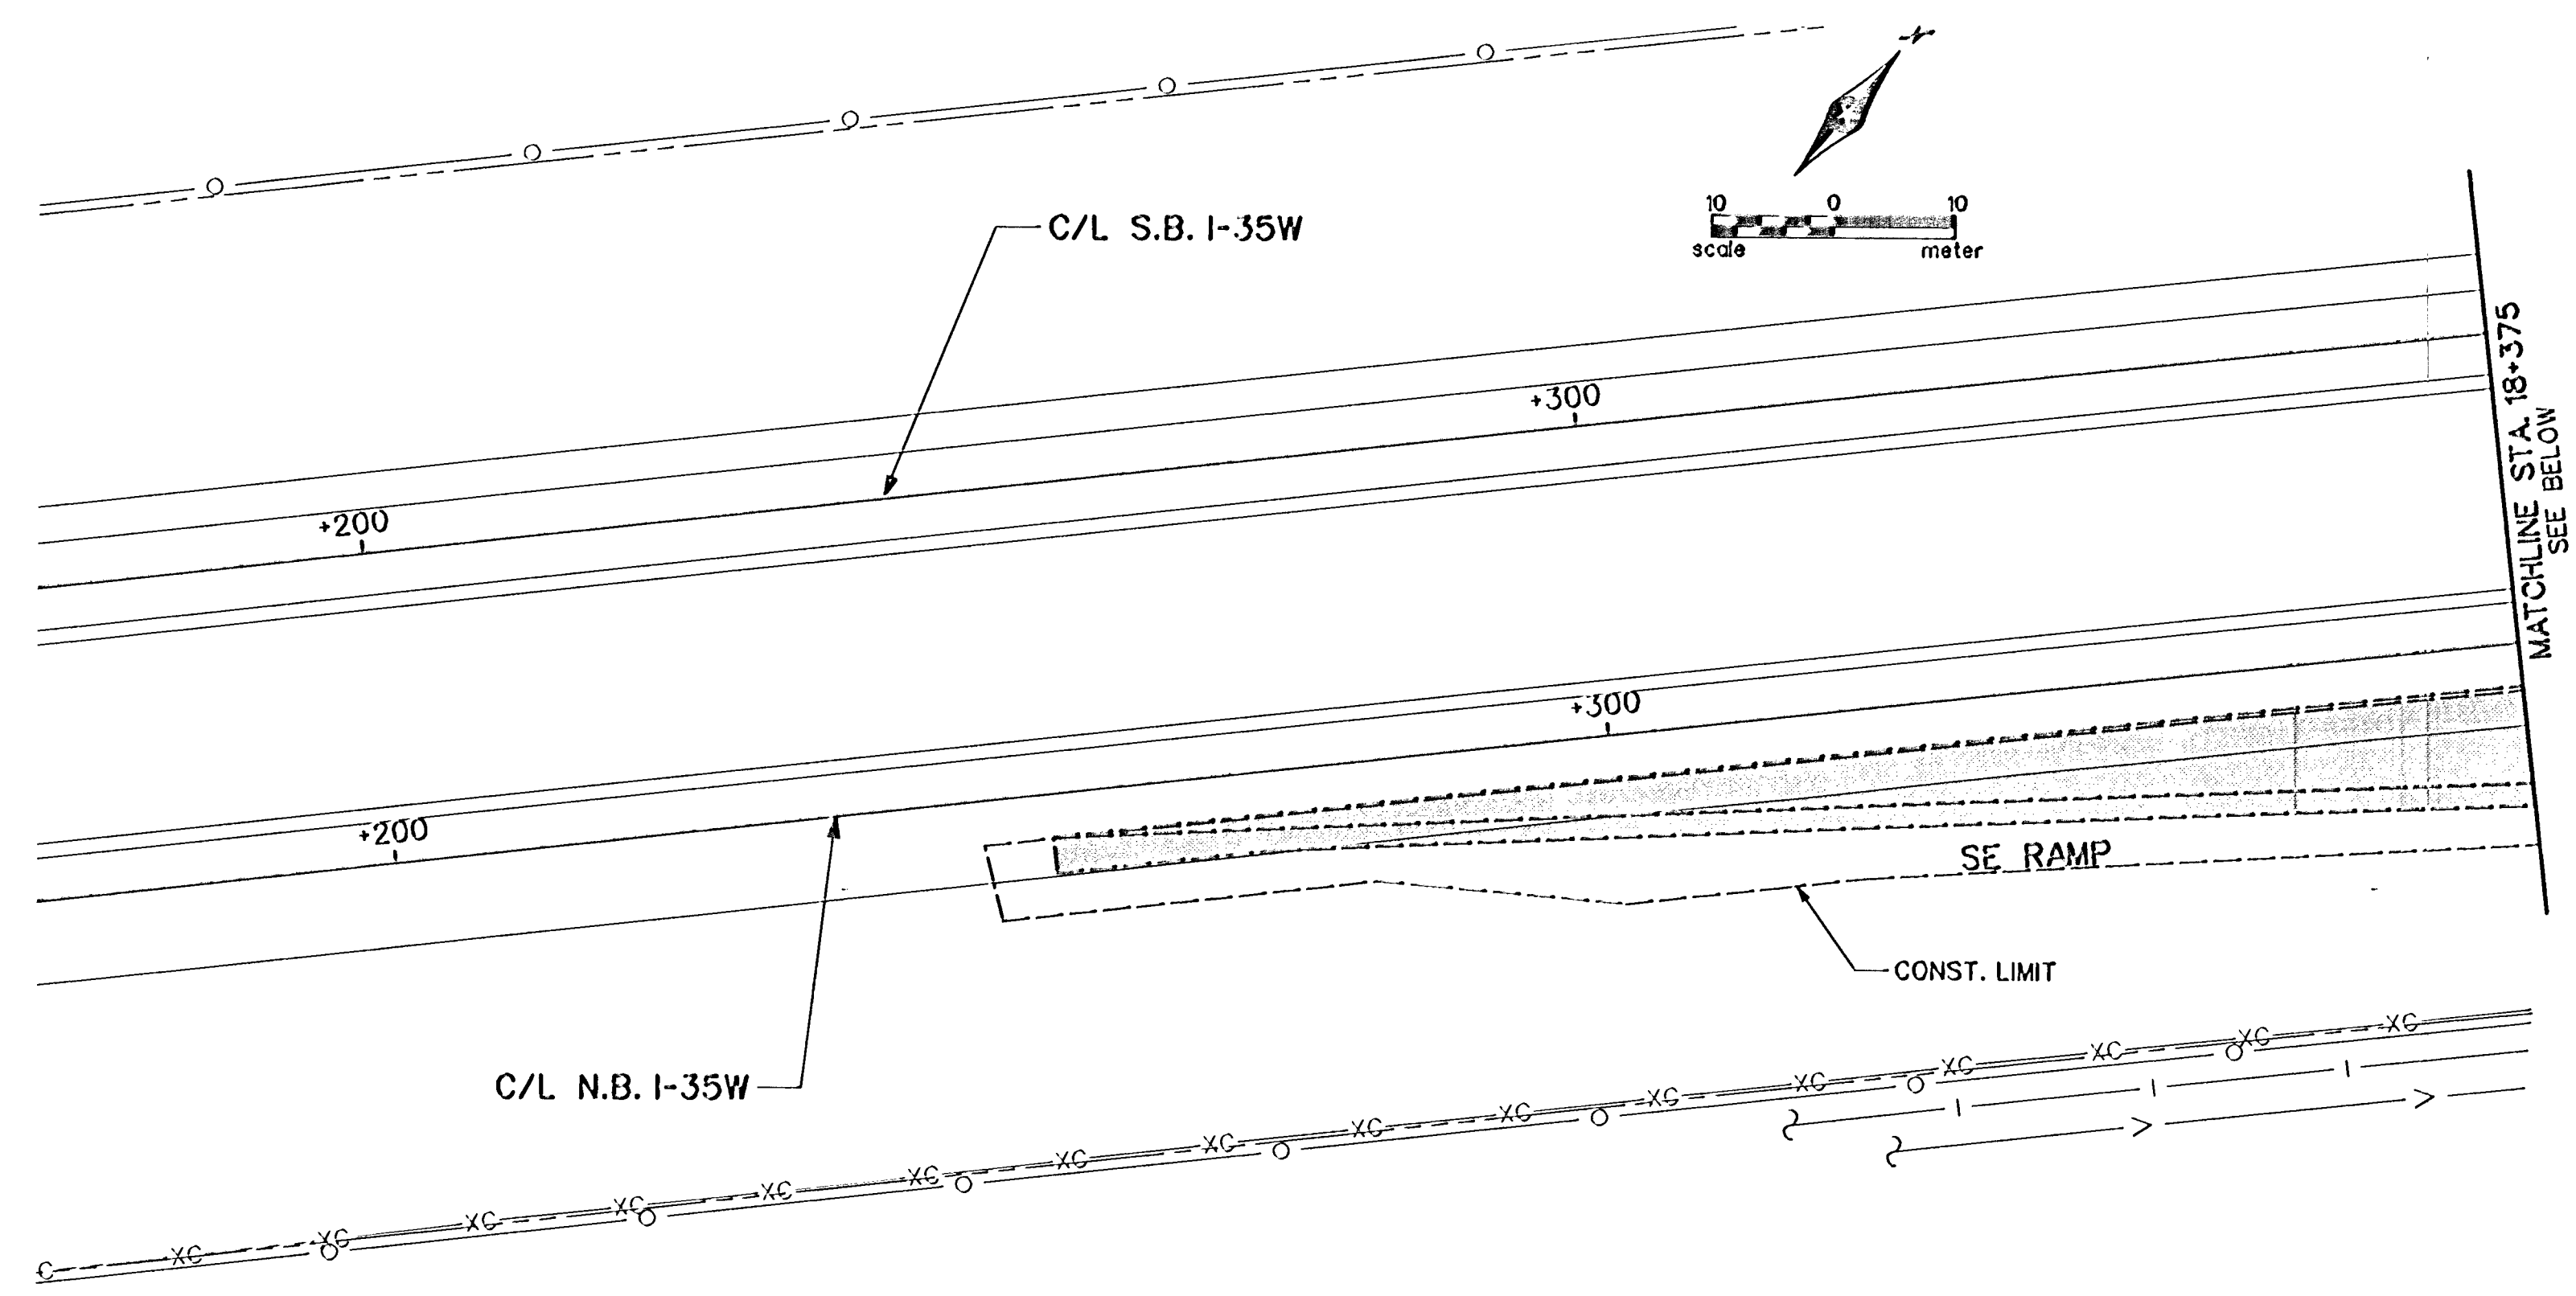

SEE C.S.A.H. 17 EXIST. TOPO. & REMOVALS

1	4-4-97	MCI	MCH	DAD	REVISE SE RAMP
NO	DATE	BY	CHKD	APPR	REVISION
NAME: TP5 410.PLN DATE: Mar. 17, 1997					

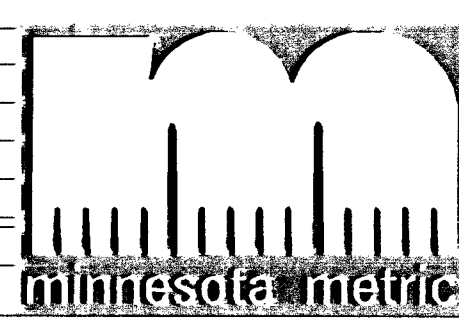

I hereby certify that this plan, specification or report was prepared by me or under my direct supervision and that I am a duly Registered Professional Engineer under the laws of the State of Minnesota.
Donald A. Demers
 Date 3-21-97 Reg. No. 23377



STATE AID PROJECT NO. S.A.P. 02-617-11 S.A.P. 108-020-12 S.A.P. 108-030-03
 CO. PROJECT NO.

DRAWN BY V. GRAF DATE 12-96
 DESIGNED BY B. URBANEK 12-96
 CHECKED BY D. DEMERS 1-97
 COMM. NO. 0962410




ANOKA COUNTY
 EXISTING TOPOGRAPHY AND REMOVALS
 C.S.A.H. 17 RECONSTRUCTION
 SE RAMP

SHEET 62 OF 236

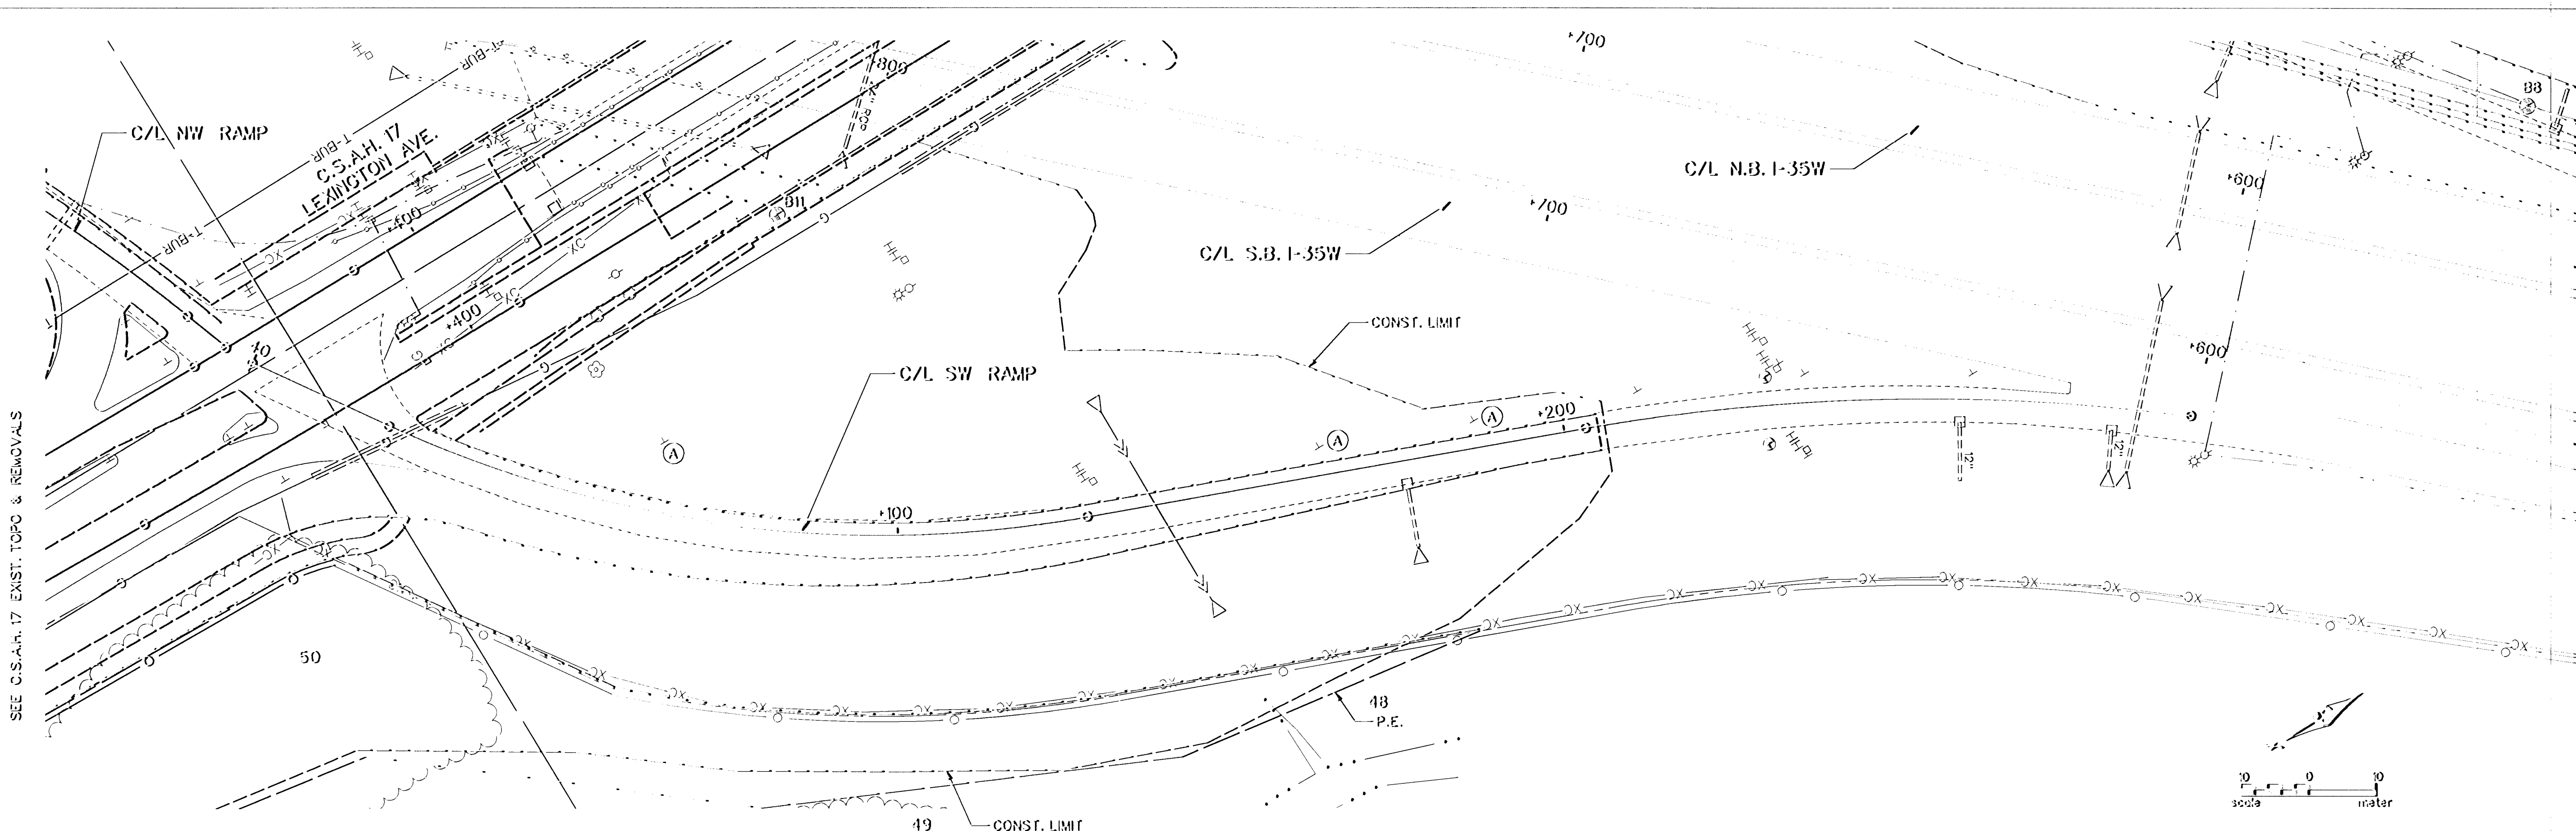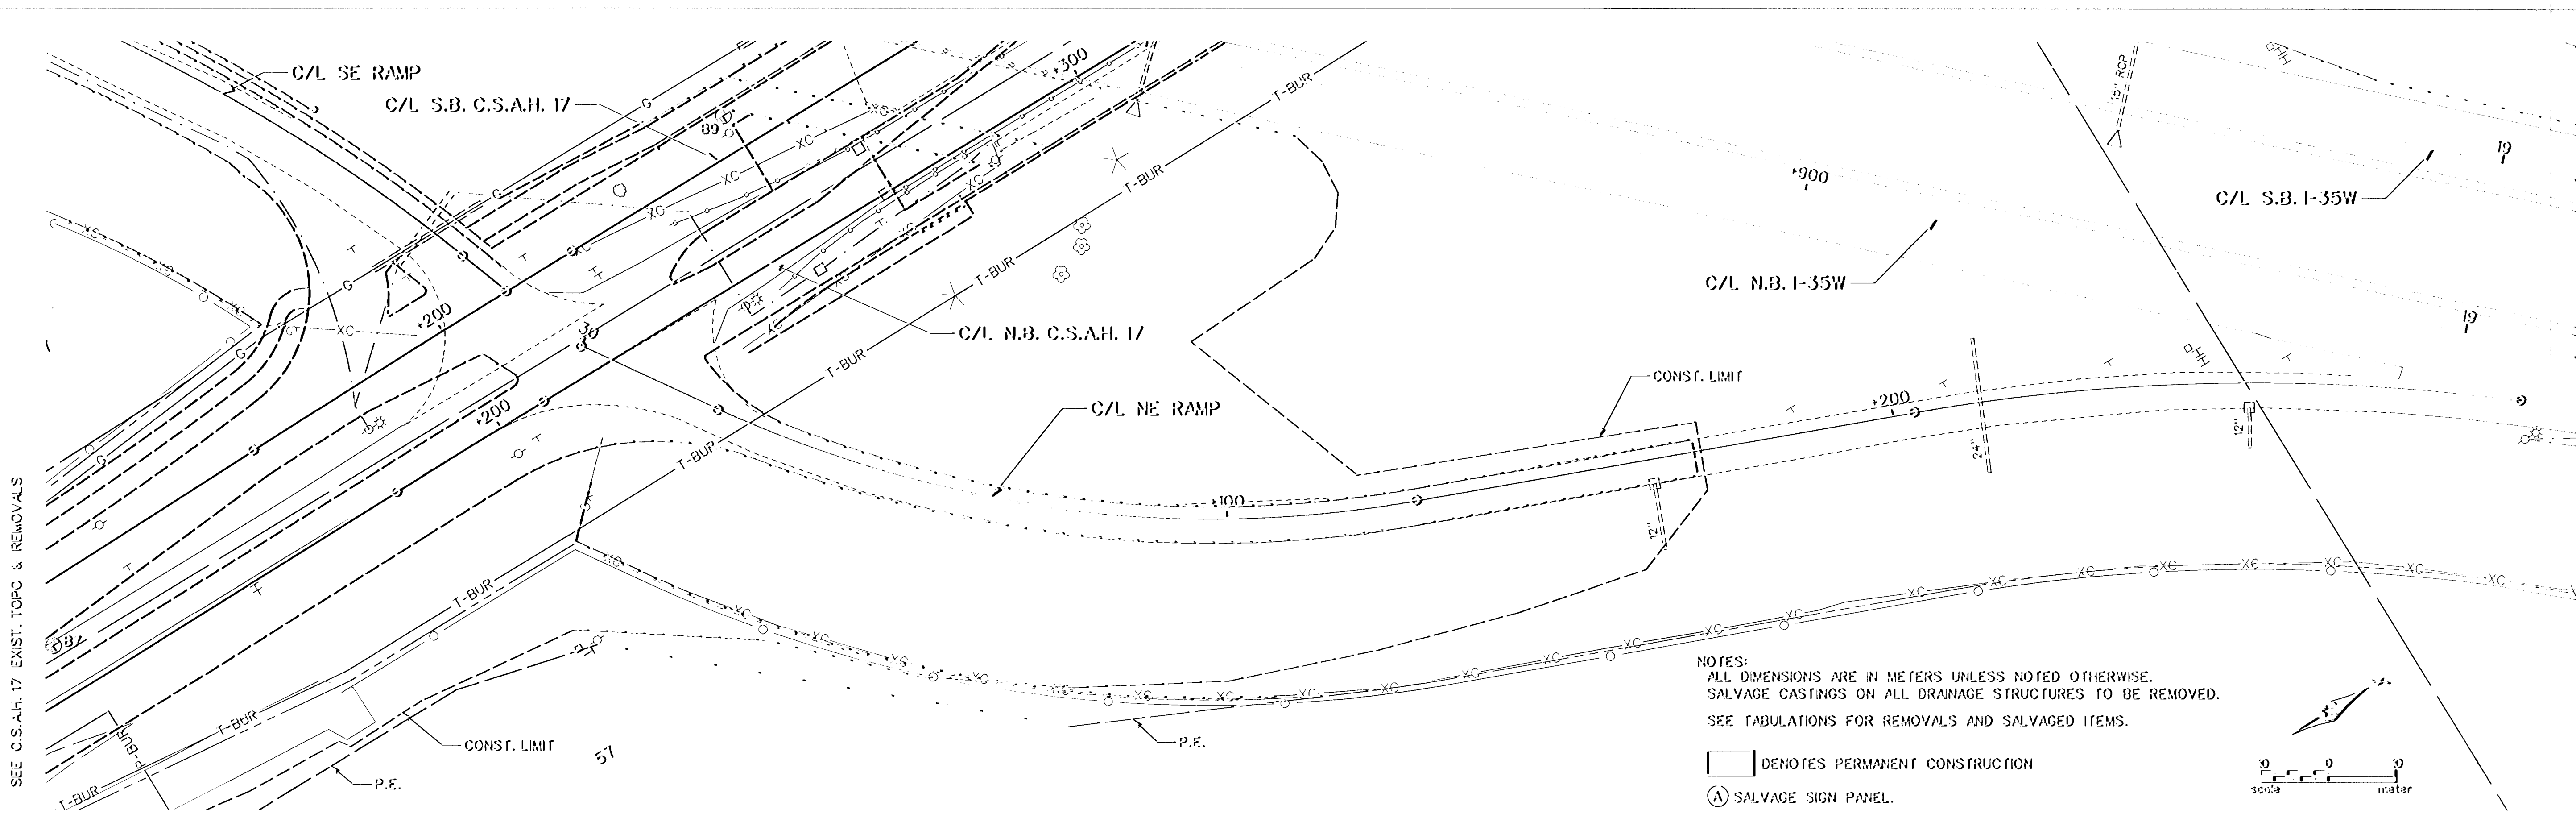

NO	DATE	BY	CHKD	APPR	REVISION

NAME: IP6 410.PLN DATE: Mar. 17, 1997

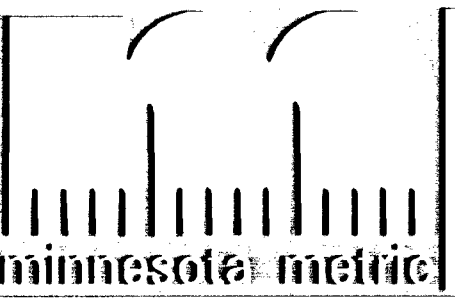


I hereby certify that this plan, specification or report was prepared by me or under my direct supervision and that I am a duly Registered Professional Engineer under the laws of the State of Minnesota.

Donald A Demers
 Date: 3-21-97 Reg. No. 23397

STATE AID PROJECT NO.
 S.A.P. 02-617-11
 S.A.P. 108-020-12
 S.A.P. 108-030-03
 CO. PROJECT NO.

DRAWN BY V. GRAF DATE 12-96
 DESIGNED BY B. URBANEK 12-96
 CHECKED BY D. DEMERS 1-97
 COMM. NO. 0962410

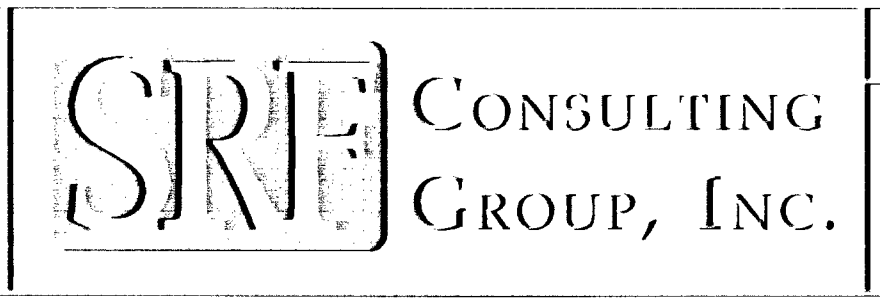



ANOKA COUNTY
 EXISTING TOPOGRAPHY AND REMOVALS
 C.S.A.H. 17 RECONSTRUCTION
 NE RAMP AND SW RAMP

SHEET 63 OF 236

NOTES:
 ALL DIMENSIONS ARE IN METERS UNLESS NOTED OTHERWISE.
 SALVAGE CASTINGS ON ALL DRAINAGE STRUCTURES TO BE REMOVED.
 SEE TABULATIONS FOR REMOVALS AND SALVAGED ITEMS.


□ DENOTES PERMANENT CONSTRUCTION

Ⓐ SALVAGE SIGN PANEL

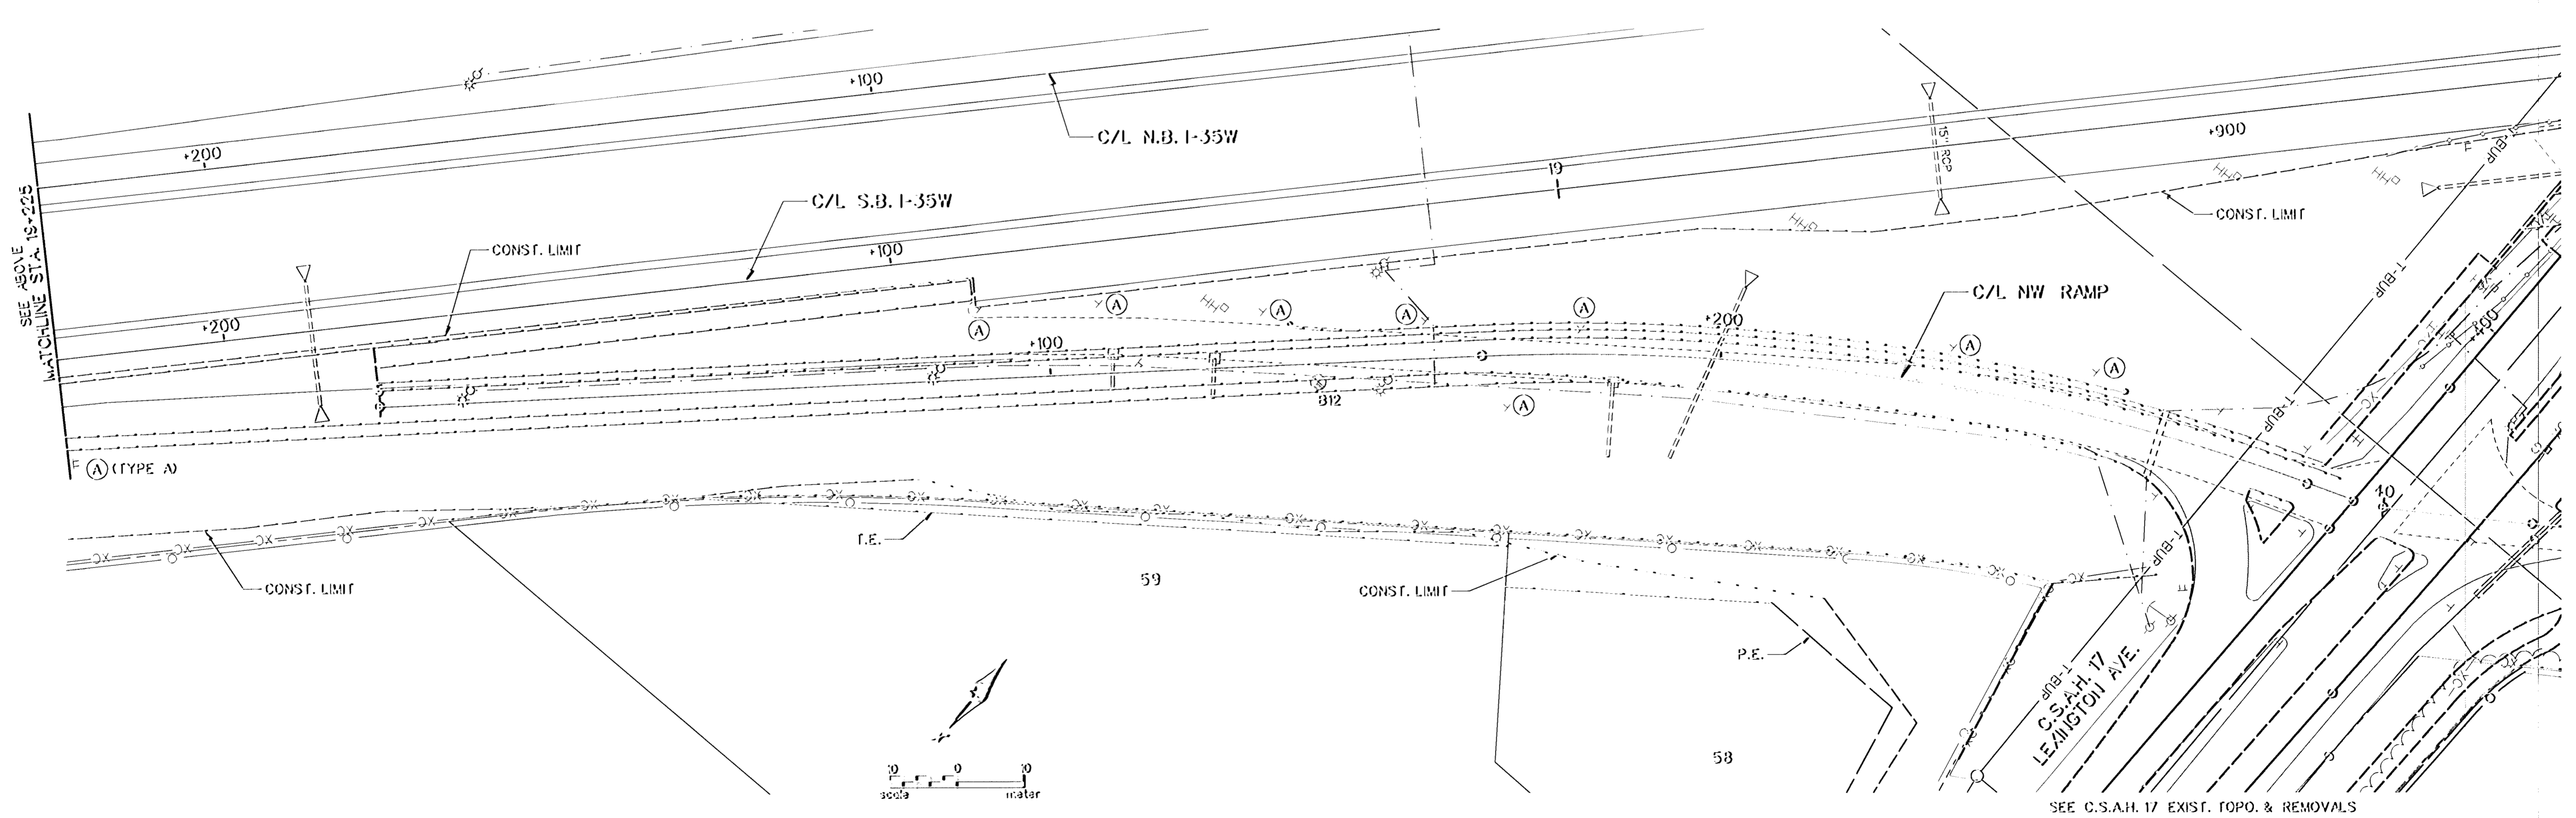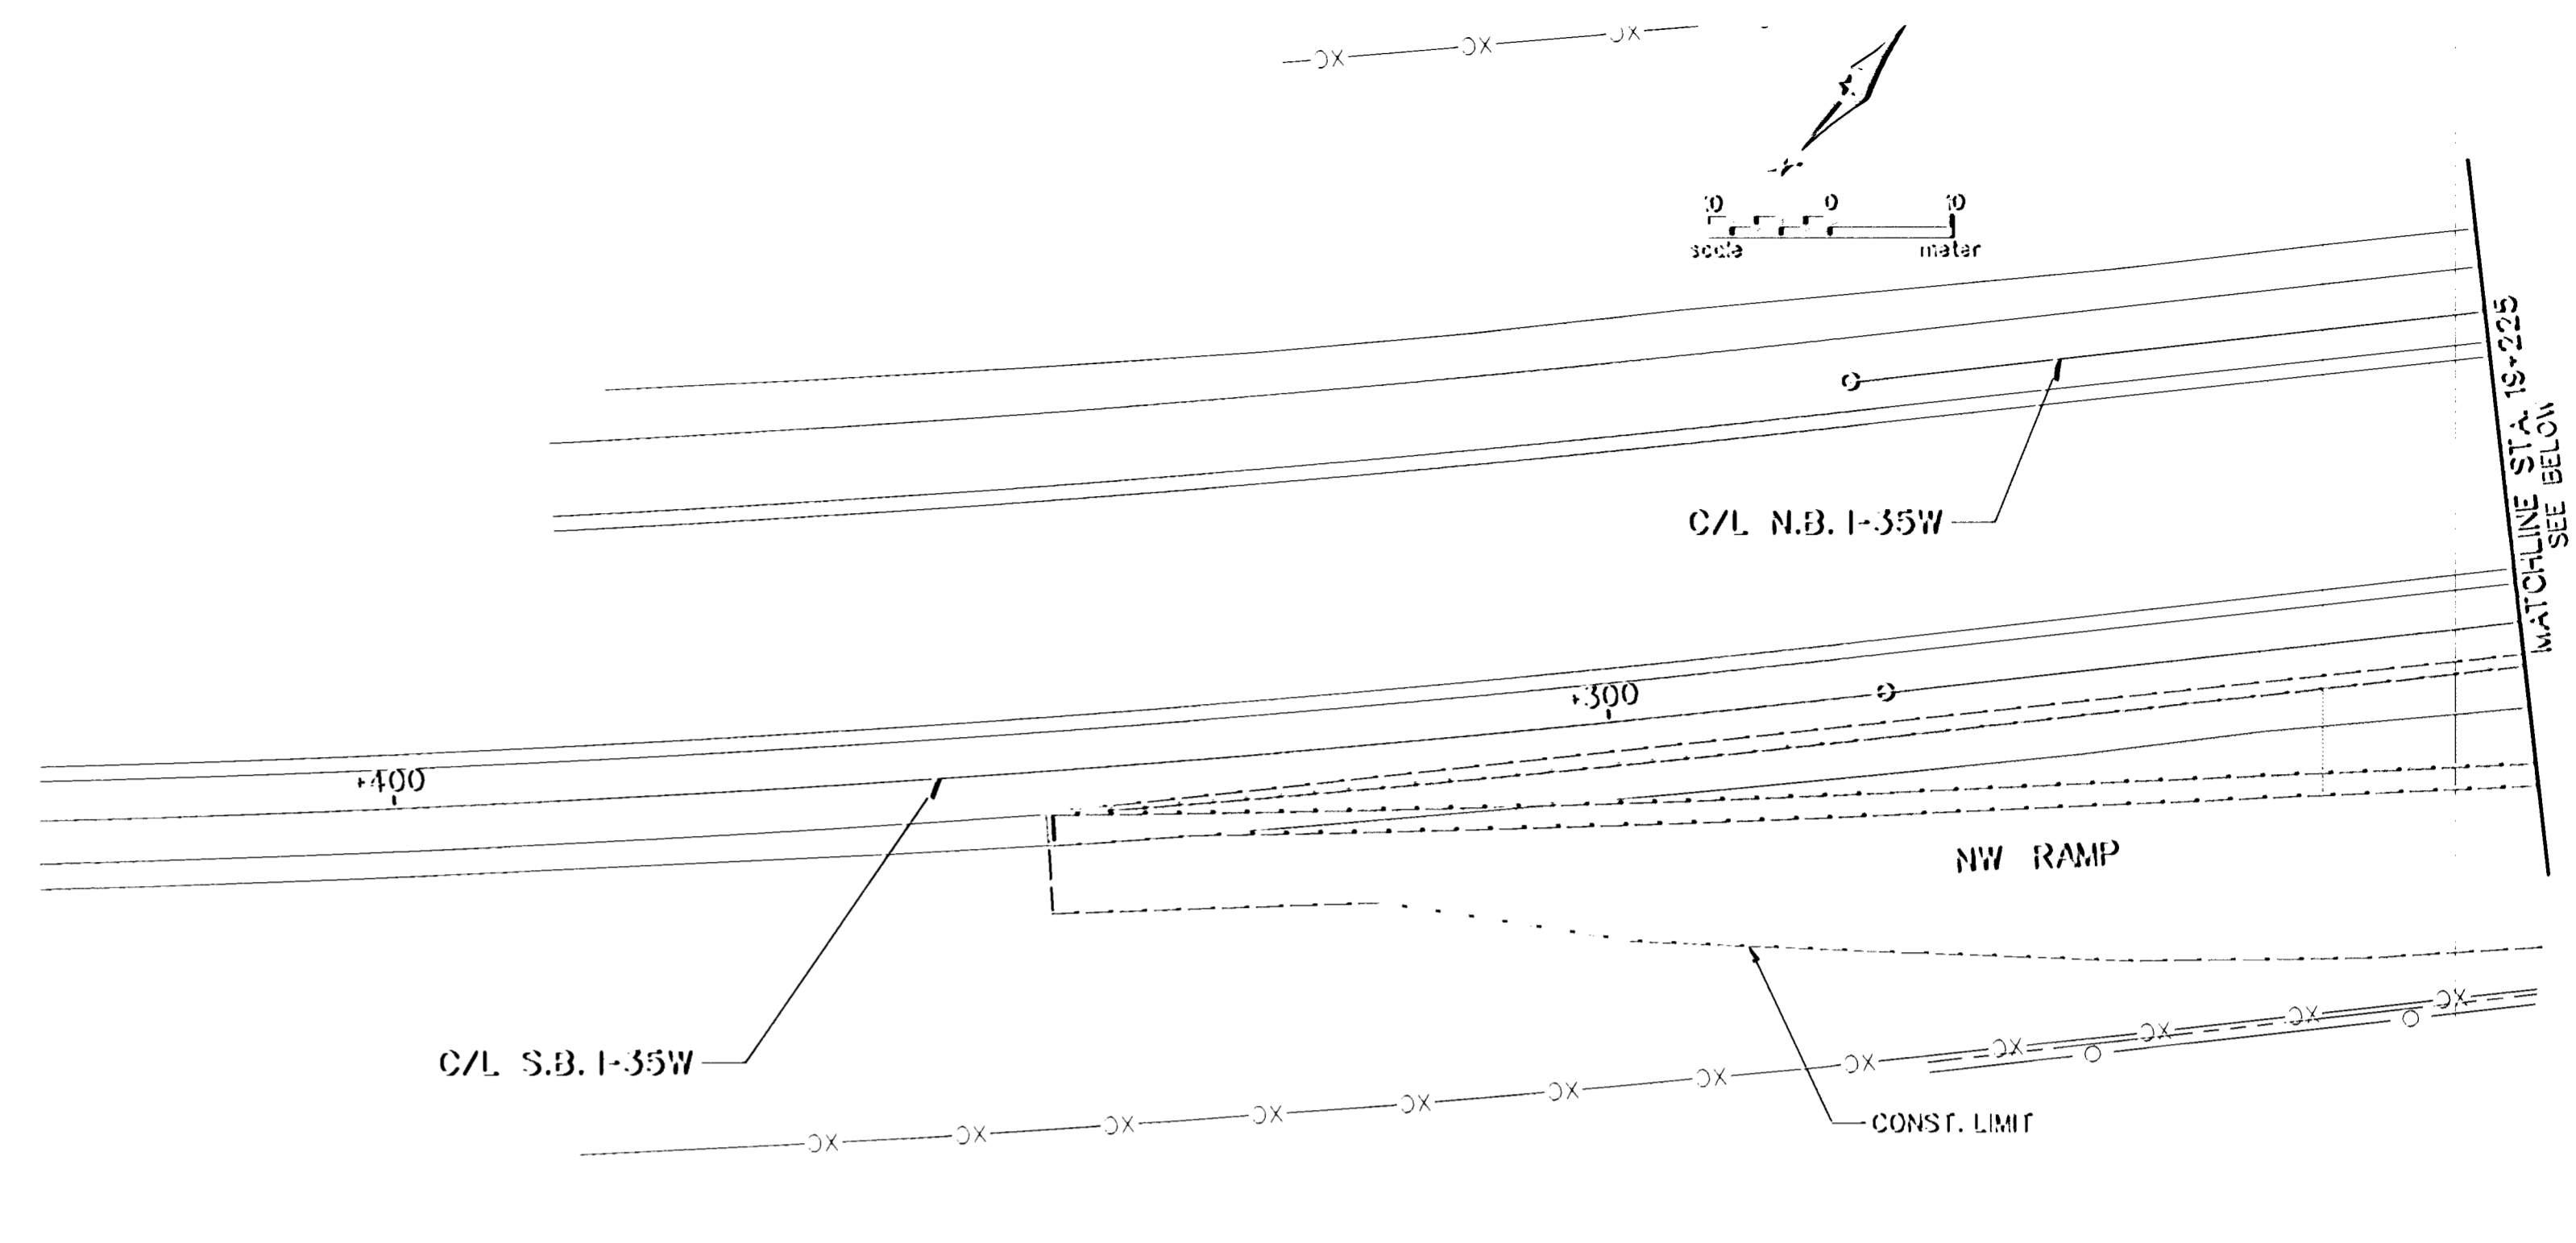

NO.	DATE	BY	CKD	APPR	REVISION

NAME: TP7 410.PLN DATE: Mar. 17, 1997

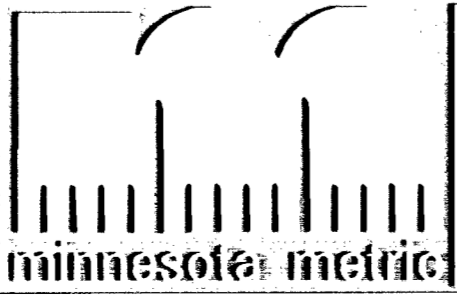

I hereby certify that this plan, specification or report was prepared by me or under my direct supervision and that I am a duly Registered Professional Engineer under the laws of the State of Minnesota.

Donald A Demers
 Date: 3-21-97 Reg. No. 23397

STATE AID PROJECT NO.
 S.A.P. 02-617-11
 S.A.P. 106-020-12
 S.A.P. 106-030-03
 CO. PROJECT NO.


DRAWN BY DATE
 V. GRAF 12-96
 DESIGNED BY
 B. URBANEK 12-96
 CHECKED BY
 D. DEMERS 1-97
 COMM. NO.
 0982410

SRIE CONSULTING GROUP, INC.

ANOKA COUNTY
 EXISTING TOPOGRAPHY AND REMOVALS
 C.S.A.H. 17 RECONSTRUCTION
 NW RAMP

SHEET
 64
 OF
 236



9390
BURGER KING

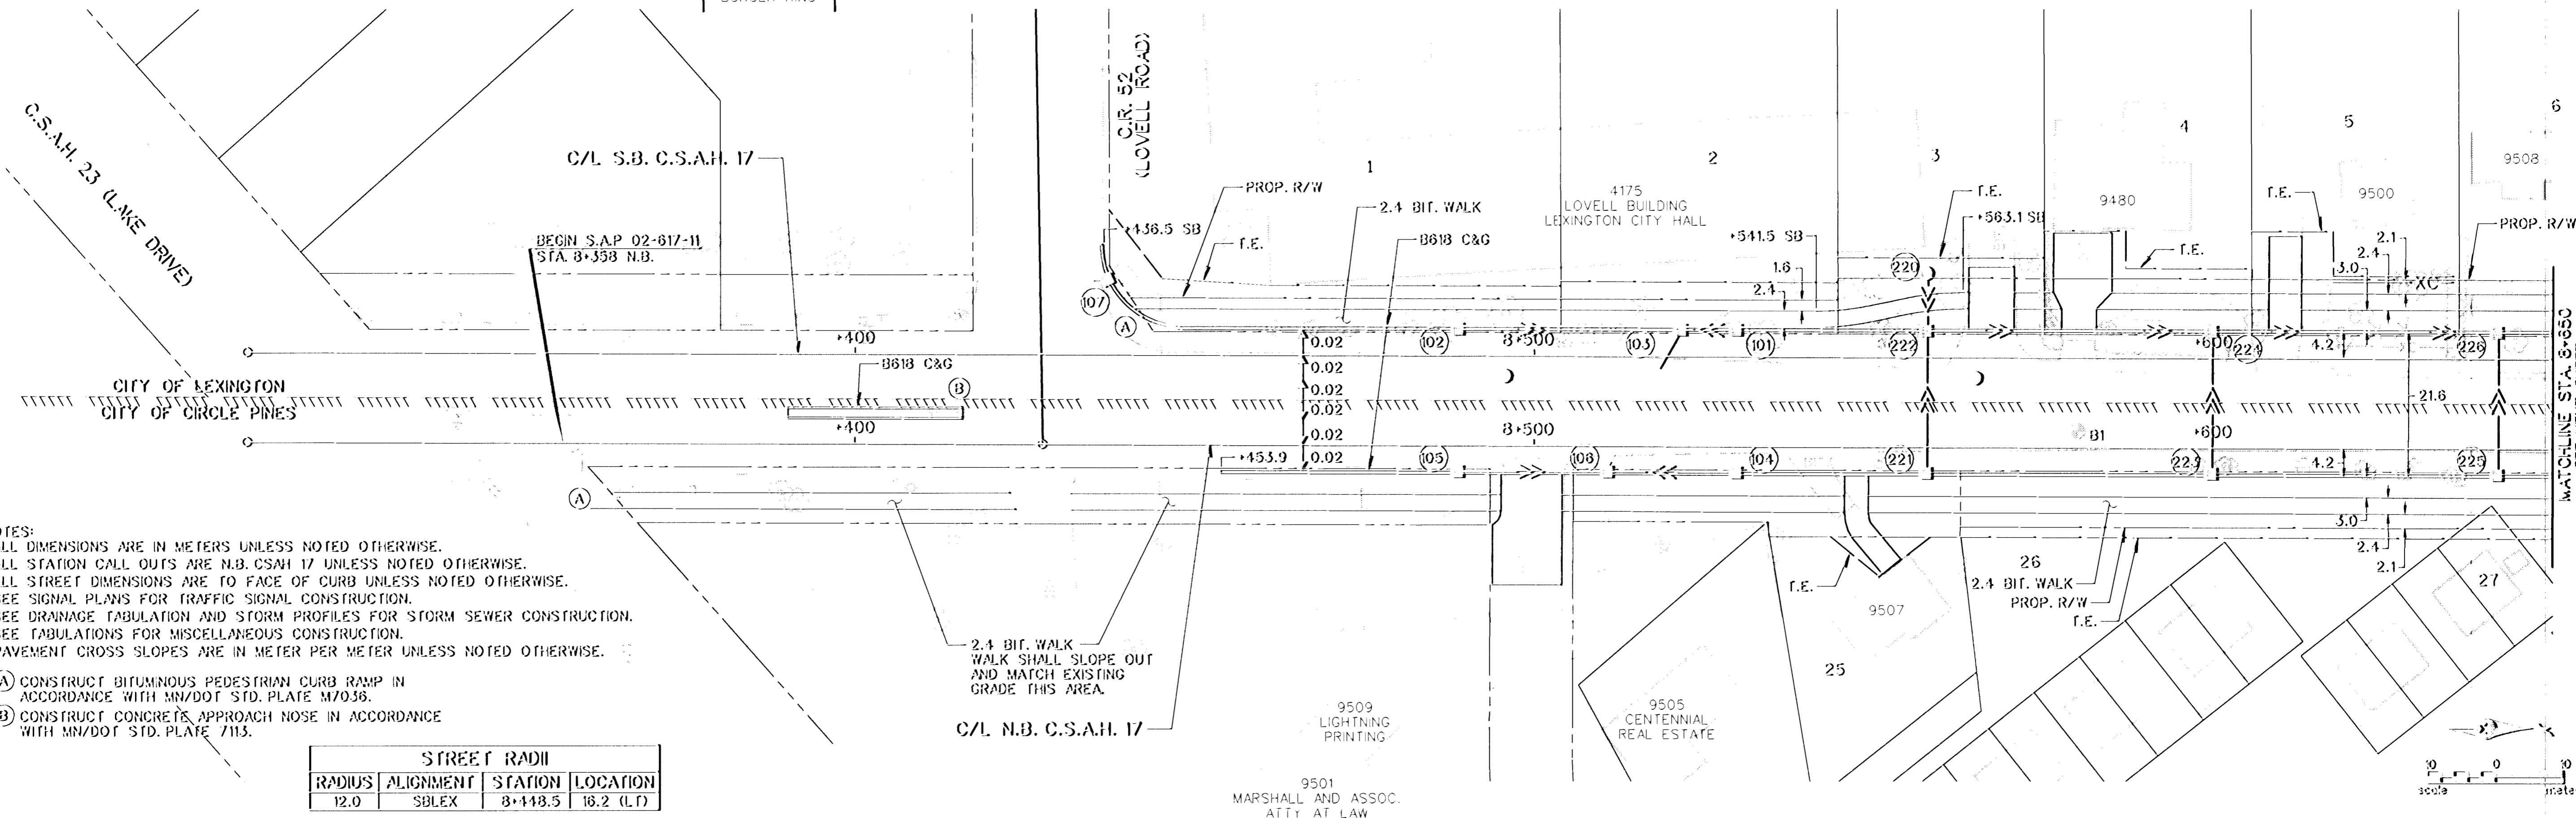

NOTES:
ALL DIMENSIONS ARE IN METERS UNLESS NOTED OTHERWISE.
ALL STATION CALL OUTS ARE N.B. CSAH 17 UNLESS NOTED OTHERWISE.
ALL STREET DIMENSIONS ARE TO FACE OF CURB UNLESS NOTED OTHERWISE.
SEE SIGNAL PLANS FOR TRAFFIC SIGNAL CONSTRUCTION.
SEE DRAINAGE TABULATION AND STORM PROFILES FOR STORM SEWER CONSTRUCTION.
SEE TABULATIONS FOR MISCELLANEOUS CONSTRUCTION.
PAVEMENT CROSS SLOPES ARE IN METER PER METER UNLESS NOTED OTHERWISE.

- (A) CONSTRUCT BITUMINOUS PEDESTRIAN CURB RAMP IN ACCORDANCE WITH MN/DOT STD. PLATE M7036.
- (B) CONSTRUCT CONCRETE APPROACH NOSE IN ACCORDANCE WITH MN/DOT STD. PLATE 7113.

STREET RADII			
RADIUS	ALIGNMENT	STATION	LOCATION
12.0	SBLEX	8+448.5	18.2 (L.F)

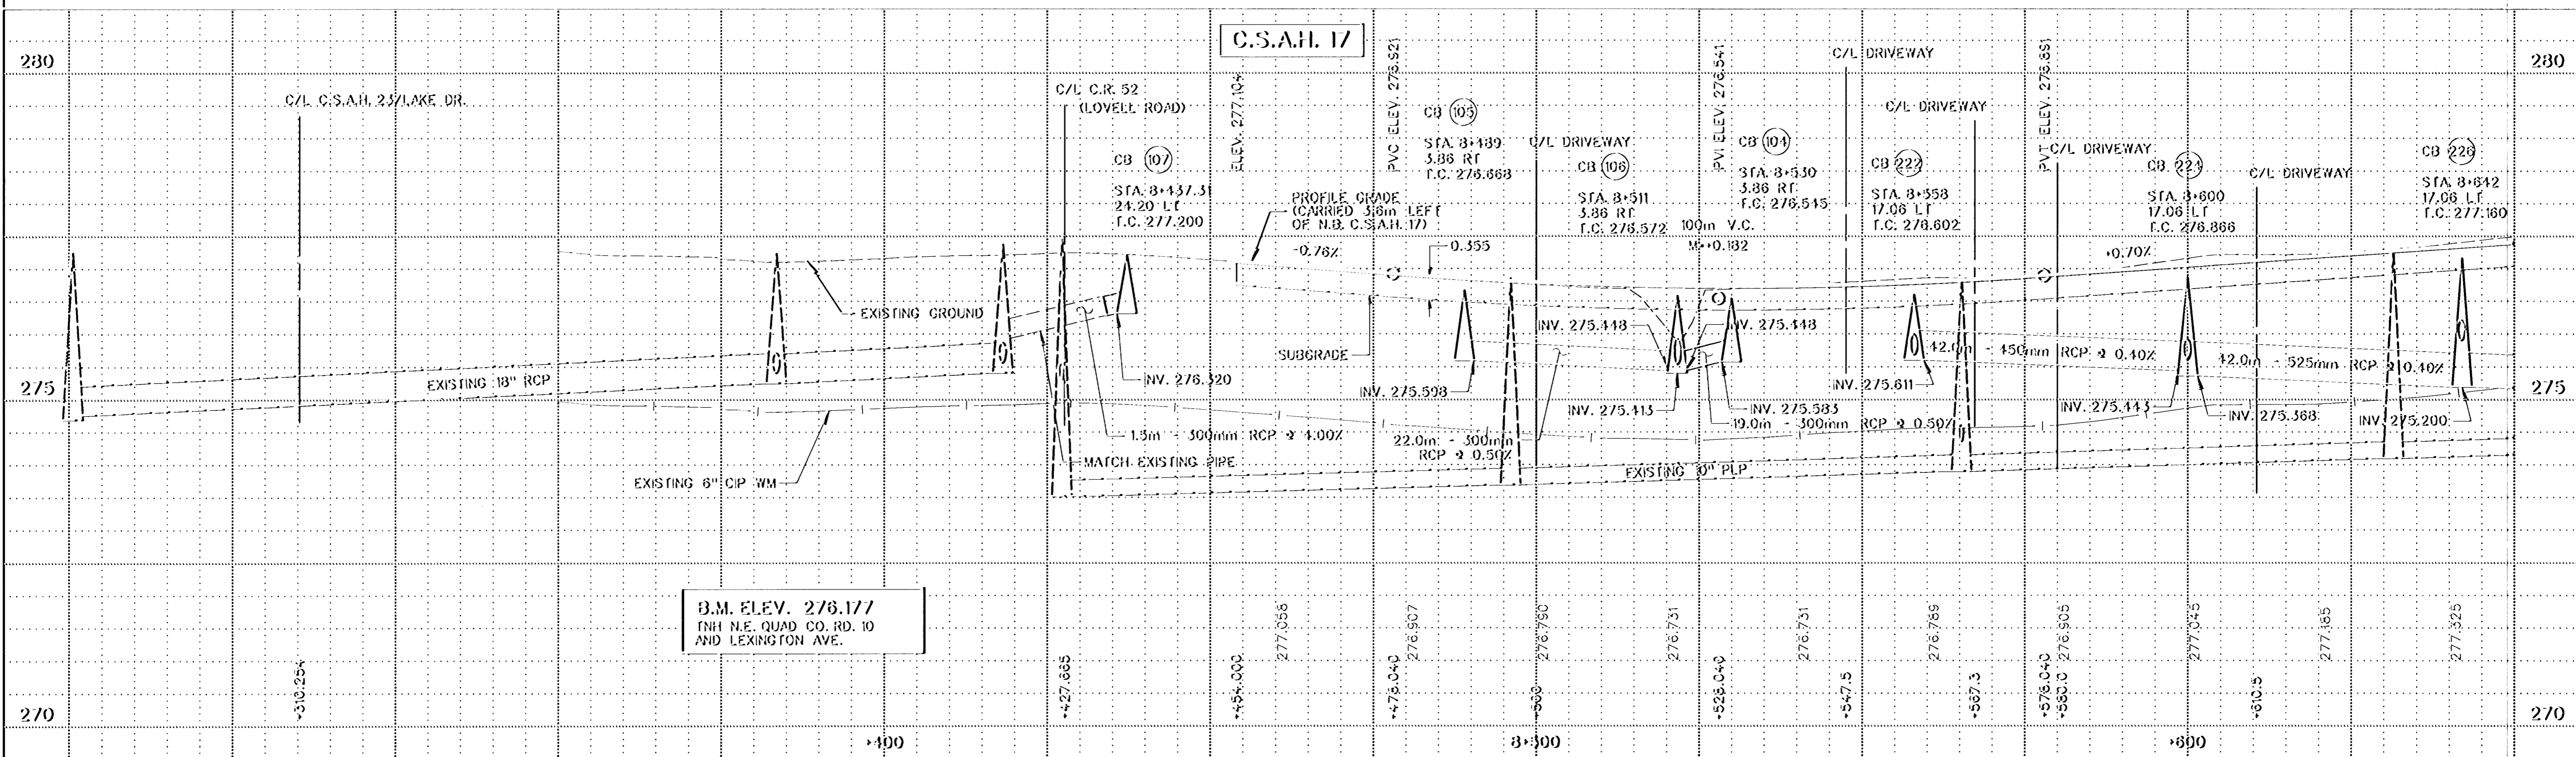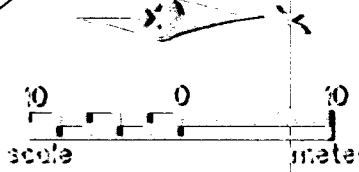

B.M. ELEV. 276.177
TNI N.E. QUAD CO. RD. 10
AND LEXINGTON AVE.

1	3-28-97	MCI	DAD	ADD C&G ON EXIST. MEDIAN
NO	DATE	BY	CKD	APPR
NAME: CP1 410.PLN	DATE: Mar. 18, 1997			

minnesota metric

I hereby certify that this plan, specification or report was prepared by me or under my direct supervision and that I am a duly Registered Professional Engineer under the laws of the State of Minnesota.

Donald A. Demers
Date 3-21-97 Reg. No. 23397

STATE AID PROJECT NO.
S.A.P. 02-617-11
S.A.P. 106-020-12
S.A.P. 106-030-03



CO. PROJECT NO.

DRAWN BY V. GRAF DATE 10-98
DESIGNED BY B. URBANEK 10-98
CHECKED BY D. DEMERS 1-97
COMM. NO. 0982410

SRIE CONSULTING GROUP, INC.

ANOKA COUNTY
CONSTRUCTION PLAN AND PROFILE
C.S.A.H. 17 RECONSTRUCTION
STA. 8+358 TO STA. 8+650

SHEET 65 OF 236

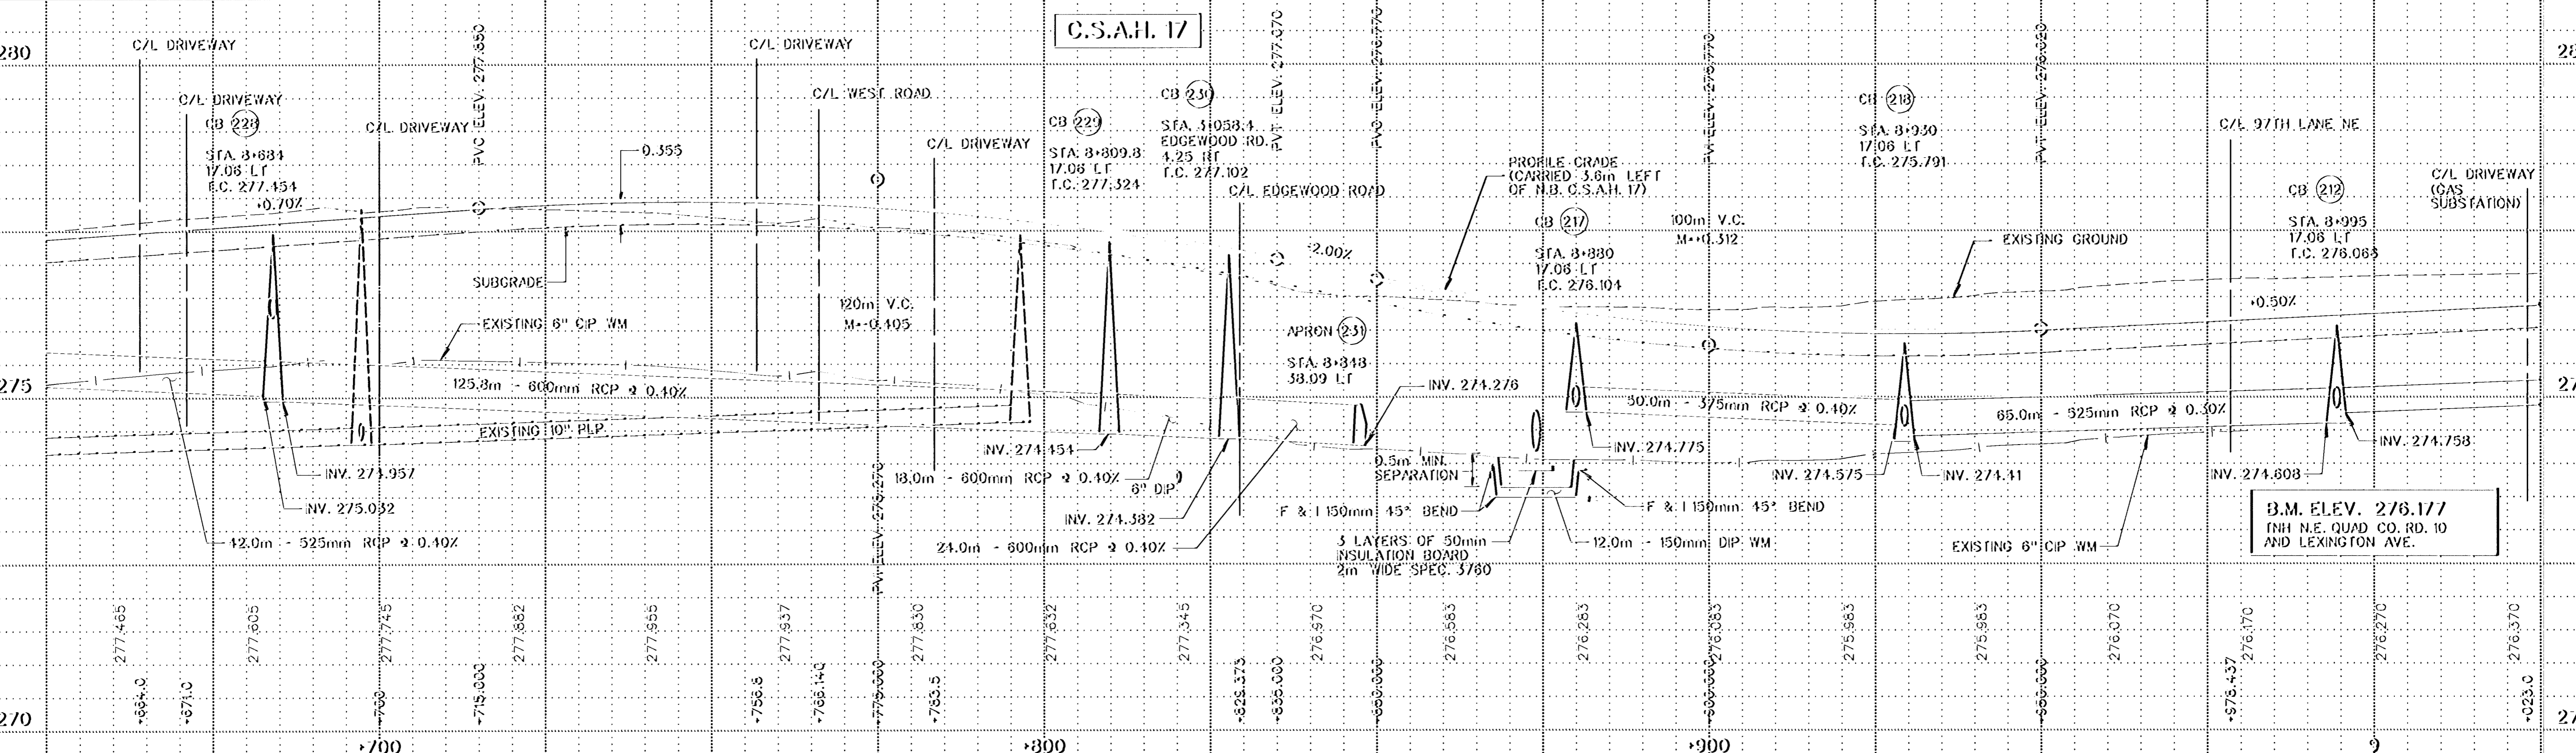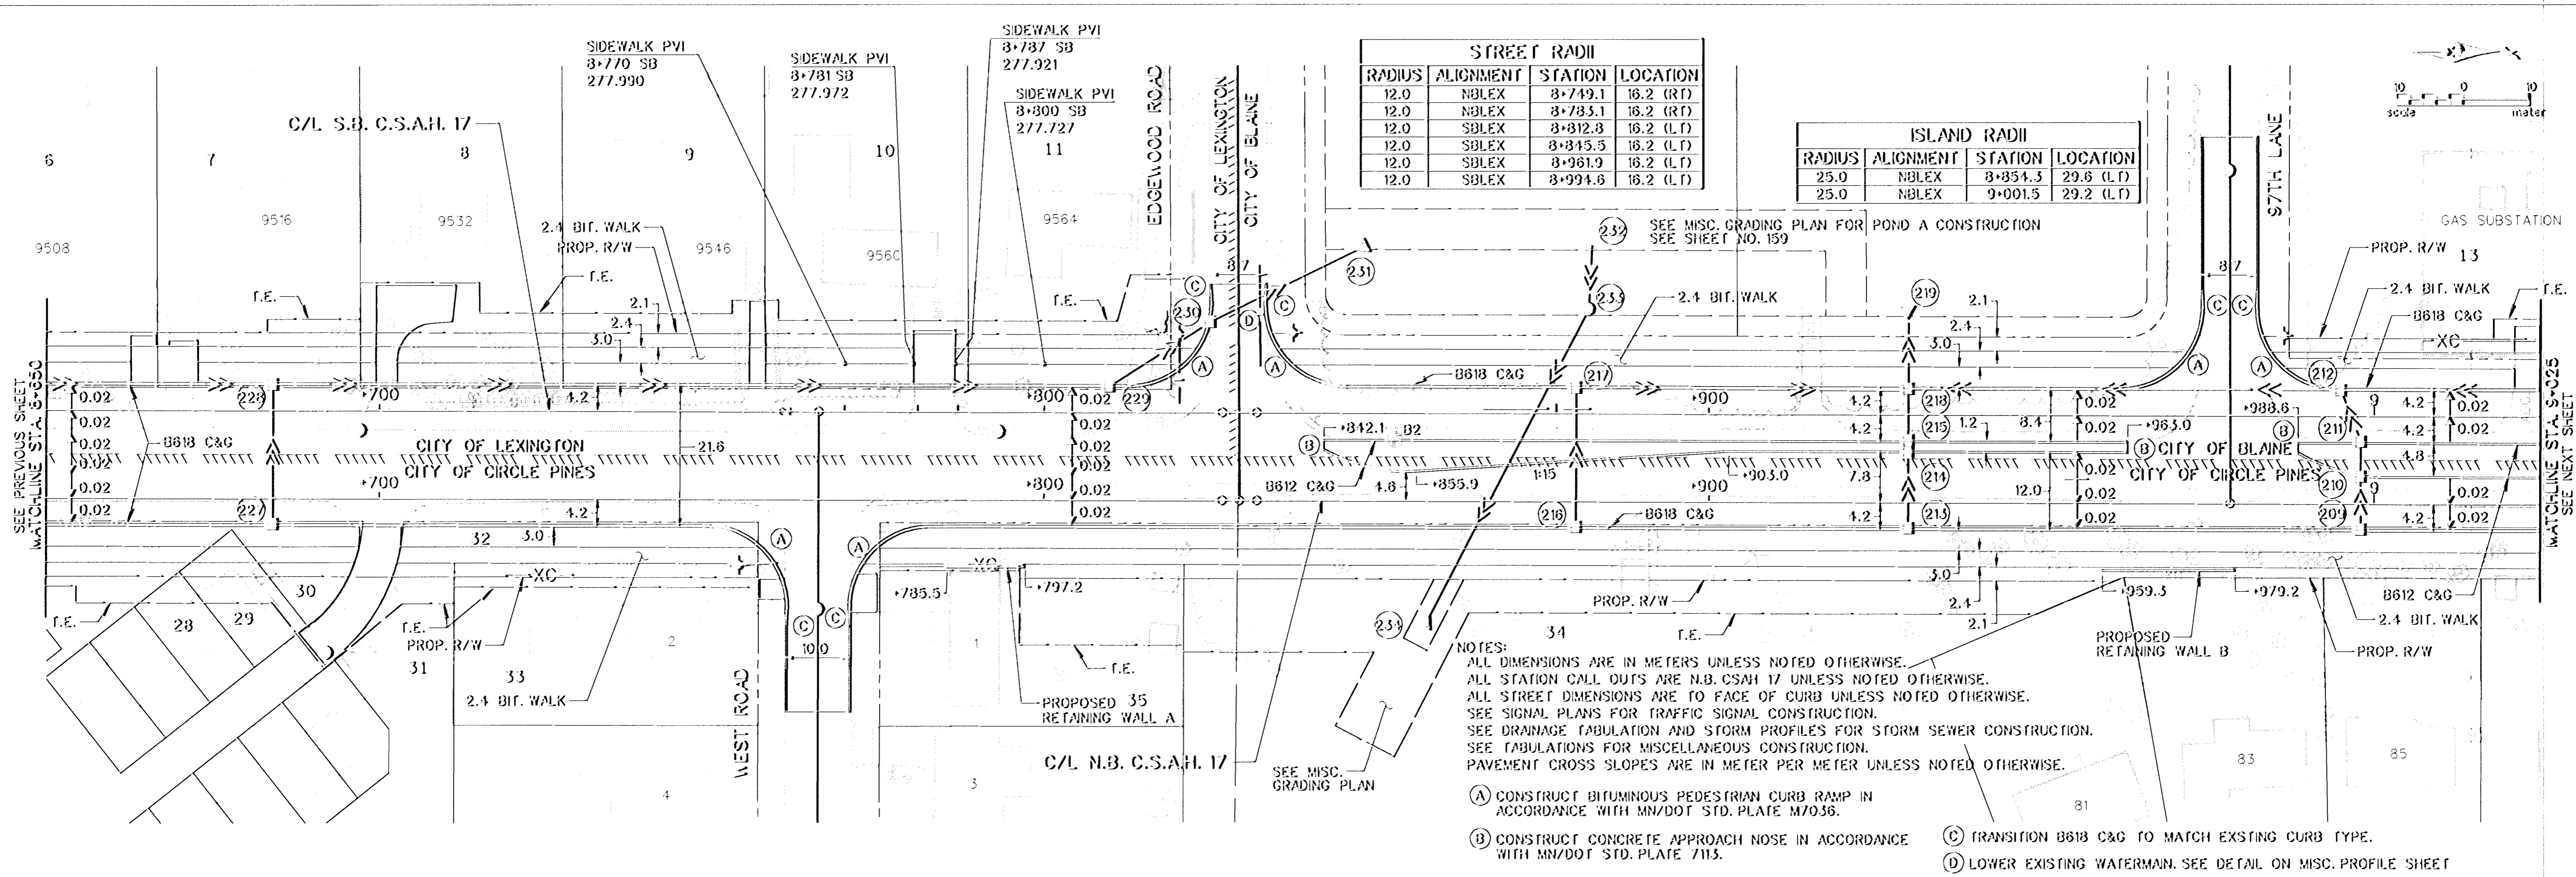

NO	DATE	BY	CHKD	APPR	REVISION

minnesota metric

I hereby certify that this plan, specification or report was prepared by me or under my direct supervision and that I am a duly Registered Professional Engineer under the laws of the State of Minnesota.

Donald A. Demers
 Date 3-21-97 Reg. No. 23397


STATE AID PROJECT NO. S.A.P. 02-617-11 S.A.P. 106-020-12 S.A.P. 106-030-03 CO. PROJECT NO.

DRAWN BY V. GRAF DATE 10-98
 DESIGNED BY B. URBANEK 10-98
 CHECKED BY D. DEMERS 1-97
 COMM. NO. 0982410


SRI CONSULTING GROUP, INC.

ANOKA COUNTY
 CONSTRUCTION PLAN AND PROFILE
 C.S.A.H. 17 RECONSTRUCTION
 STA. 8+650 TO STA. 9+025

SHEET 66 OF 236

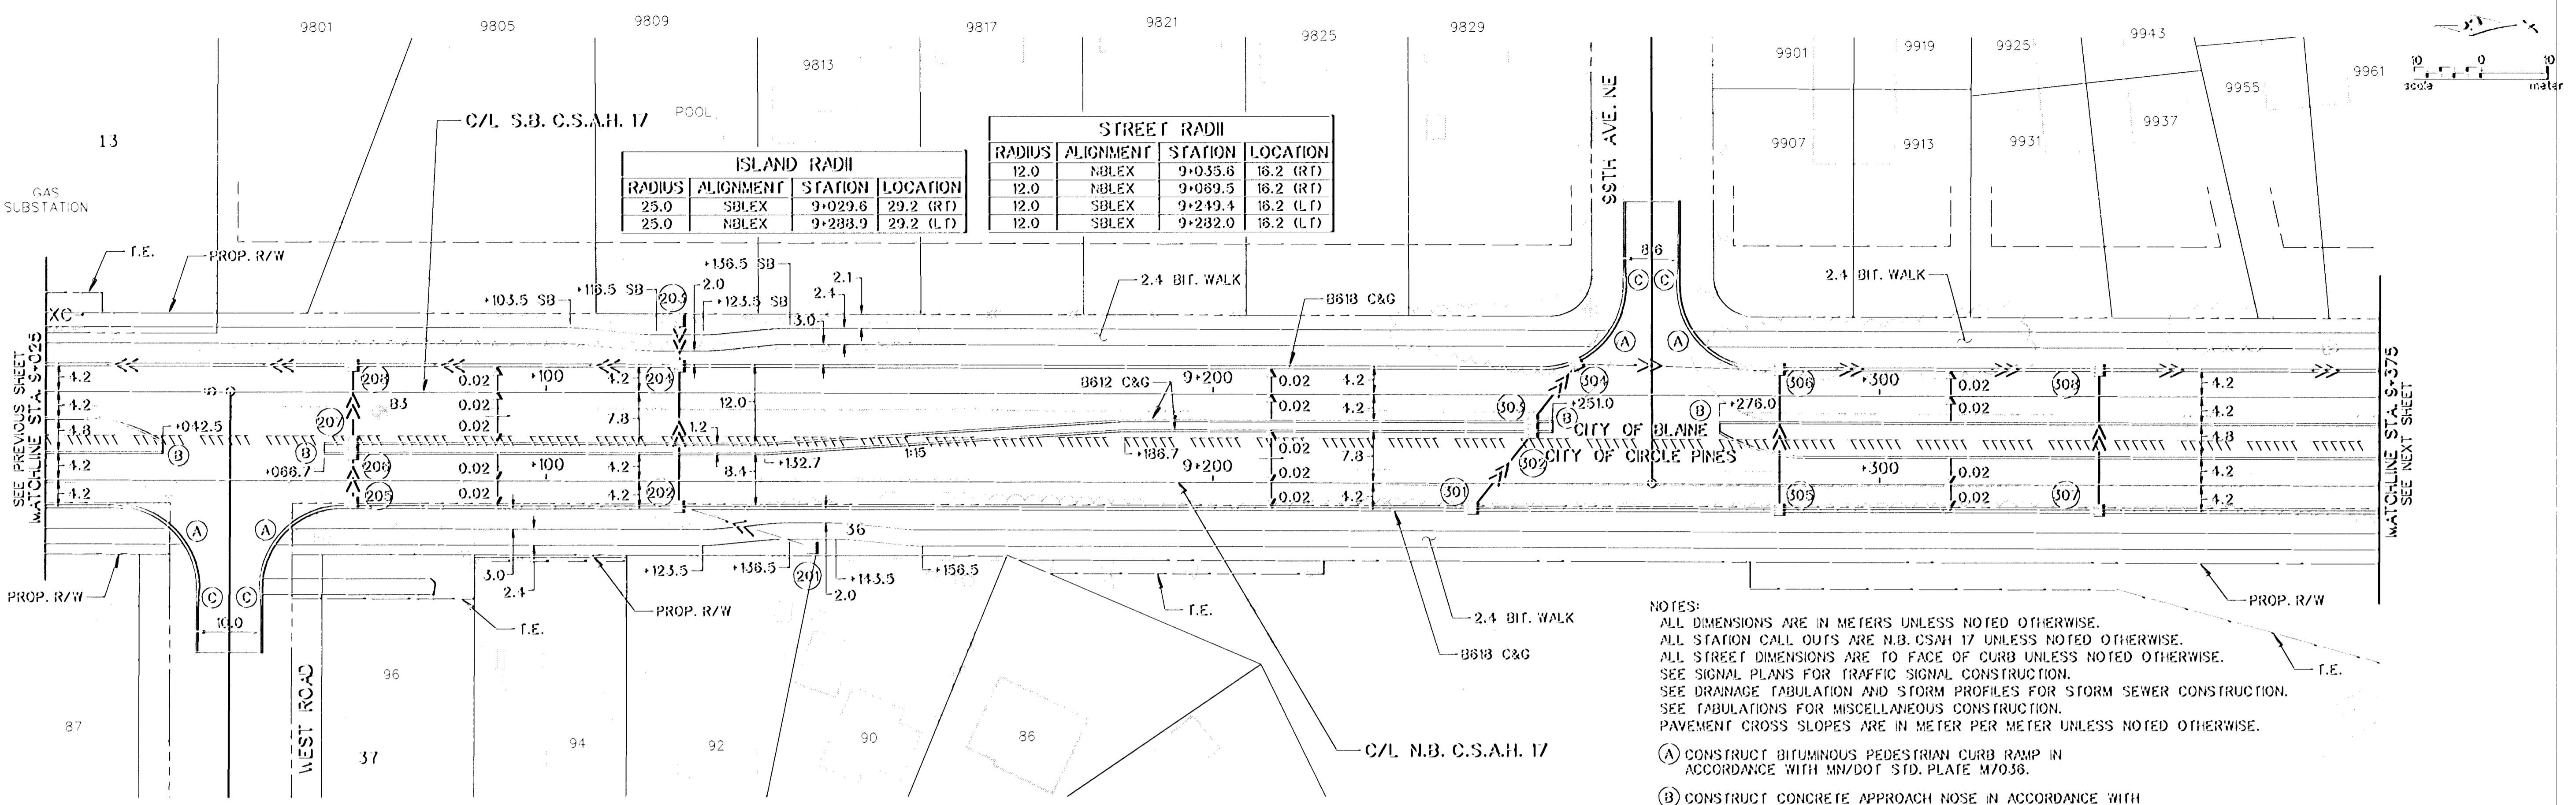


- NOTES:**
- ALL DIMENSIONS ARE IN METERS UNLESS NOTED OTHERWISE.
 - ALL STATION CALL OUTS ARE N.B. CSAH 17 UNLESS NOTED OTHERWISE.
 - ALL STREET DIMENSIONS ARE TO FACE OF CURB UNLESS NOTED OTHERWISE.
 - SEE SIGNAL PLANS FOR TRAFFIC SIGNAL CONSTRUCTION.
 - SEE DRAINAGE TABULATION AND STORM PROFILES FOR STORM SEWER CONSTRUCTION.
 - SEE TABULATIONS FOR MISCELLANEOUS CONSTRUCTION.
 - PAVEMENT CROSS SLOPES ARE IN METER PER METER UNLESS NOTED OTHERWISE.
- (A) CONSTRUCT BITUMINOUS PEDESTRIAN CURB RAMP IN ACCORDANCE WITH MN/DOT STD. PLATE M7036.
 - (B) CONSTRUCT CONCRETE APPROACH NOSE IN ACCORDANCE WITH MN/DOT STD. PLATE 7115.
 - (C) TRANSITION B818 C&G TO MATCH EXISTING CURB TYPE.

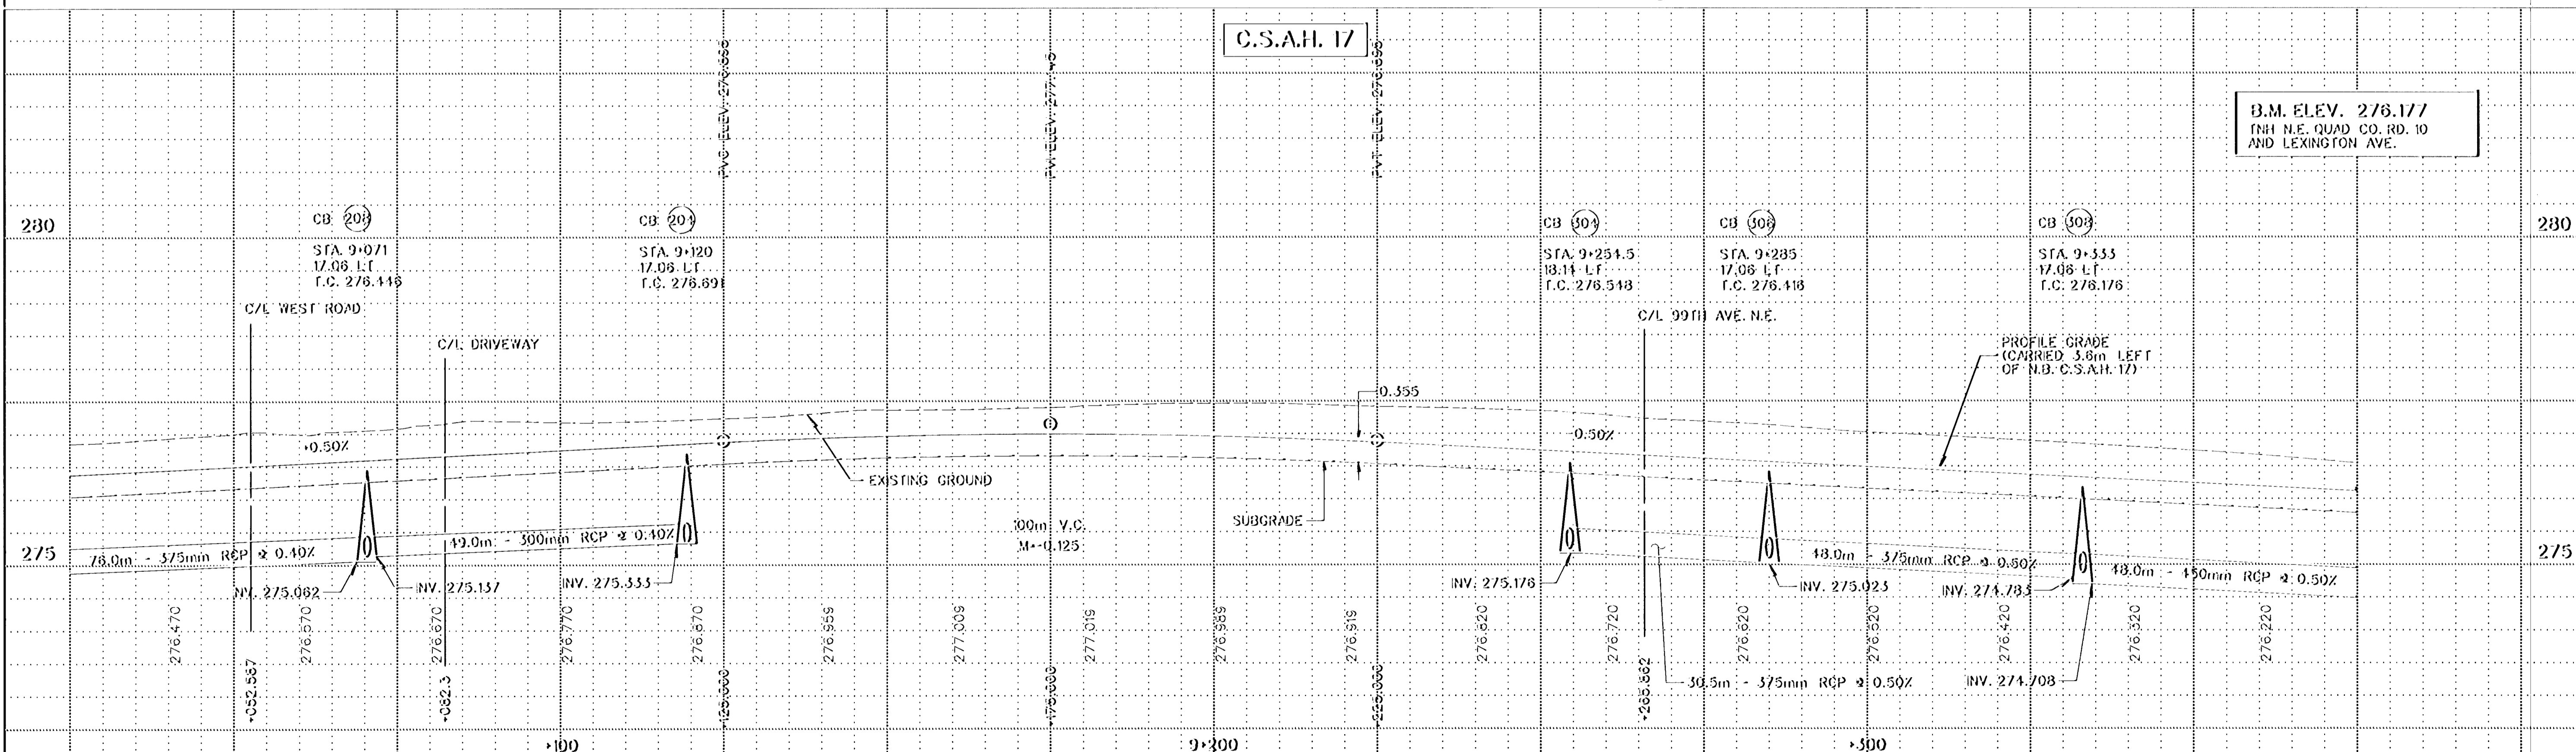

I hereby certify that this plan, specification or report was prepared by me or under my direct supervision and that I am a duly Registered Professional Engineer under the laws of the State of Minnesota. <i>Ornold A. Demers</i> Date <u>3-21-97</u> Reg. No. <u>23377</u>					STATE AID PROJECT NO. S.A.P. 02-617-11 S.A.P. 108-020-12 S.A.P. 108-030-03 CO. PROJECT NO.		DRAWN BY V. GRAF DESIGNED BY B. URBANEK CHECKED BY D. DEMERS COMM. NO. 0982410		ANOKA COUNTY CONSTRUCTION PLAN AND PROFILE C.S.A.H. 17 RECONSTRUCTION STA. 9+025 TO STA. 9+375		SHEET 87 OF 236
NO	DATE	BY	CKD	APPR	REVISION						


NAME: CP3 410.PLN DATE: Mar. 18, 1997

NOTES:
 ALL DIMENSIONS ARE IN METERS UNLESS NOTED OTHERWISE.
 ALL STATION CALL OUTS ARE N.B. CSAH 17 UNLESS NOTED OTHERWISE.
 ALL STREET DIMENSIONS ARE TO FACE OF CURB UNLESS NOTED OTHERWISE.
 SEE SIGNAL PLANS FOR TRAFFIC SIGNAL CONSTRUCTION.
 SEE DRAINAGE TABULATION AND STORM PROFILES FOR STORM SEWER CONSTRUCTION.
 SEE TABULATIONS FOR MISCELLANEOUS CONSTRUCTION.
 PAVEMENT CROSS SLOPES ARE IN METER PER METER UNLESS NOTED OTHERWISE.
 (A) CONSTRUCT BITUMINOUS PEDESTRIAN CURB RAMP IN ACCORDANCE WITH MN/DOT STD. PLATE M7036.
 (B) CONSTRUCT CONCRETE APPROACH NOSE IN ACCORDANCE WITH MN/DOT STD. PLATE 7115.
 (C) TRANSITION B618 C&G TO MATCH EXISTING CURB TYPE.
 (E) STORM SEWER FROM (309) TO (309A) IS TEMPORARY, TO BE USED DURING BOX CULVERT CONSTRUCTION. REMOVE PIPE WHEN BOX CULVERT IS COMPLETE.

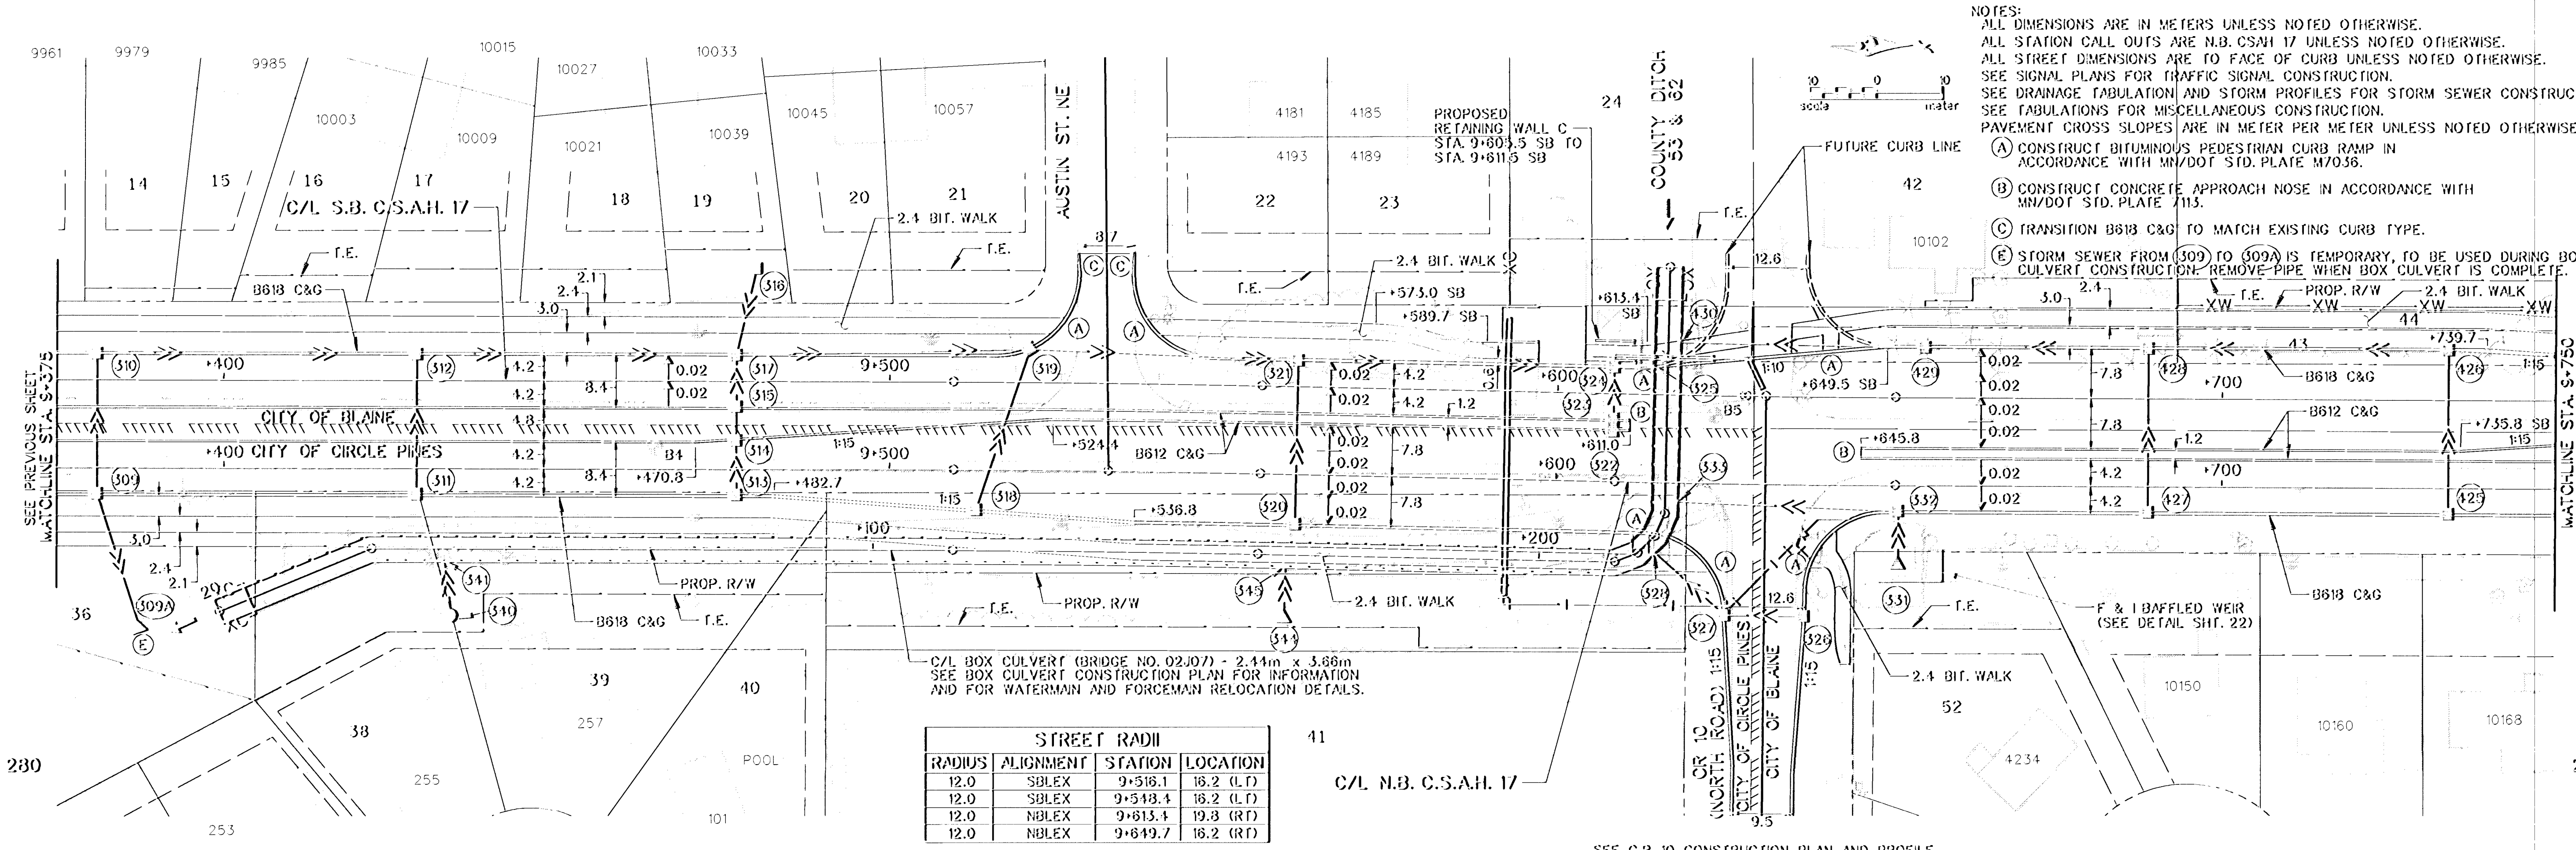

C/L BOX CULVERT (BRIDGE NO. 02J07) - 2.44m x 3.66m
 SEE BOX CULVERT CONSTRUCTION PLAN FOR INFORMATION AND FOR WATERMAN AND FORCEMAN RELOCATION DETAILS.

STREET RADII			
RADIUS	ALIGNMENT	STATION	LOCATION
12.0	SBLEX	9+516.1	18.2 (LT)
12.0	SBLEX	9+548.4	18.2 (LT)
12.0	NBLEX	9+813.4	19.8 (RT)
12.0	NBLEX	9+649.7	18.2 (RT)

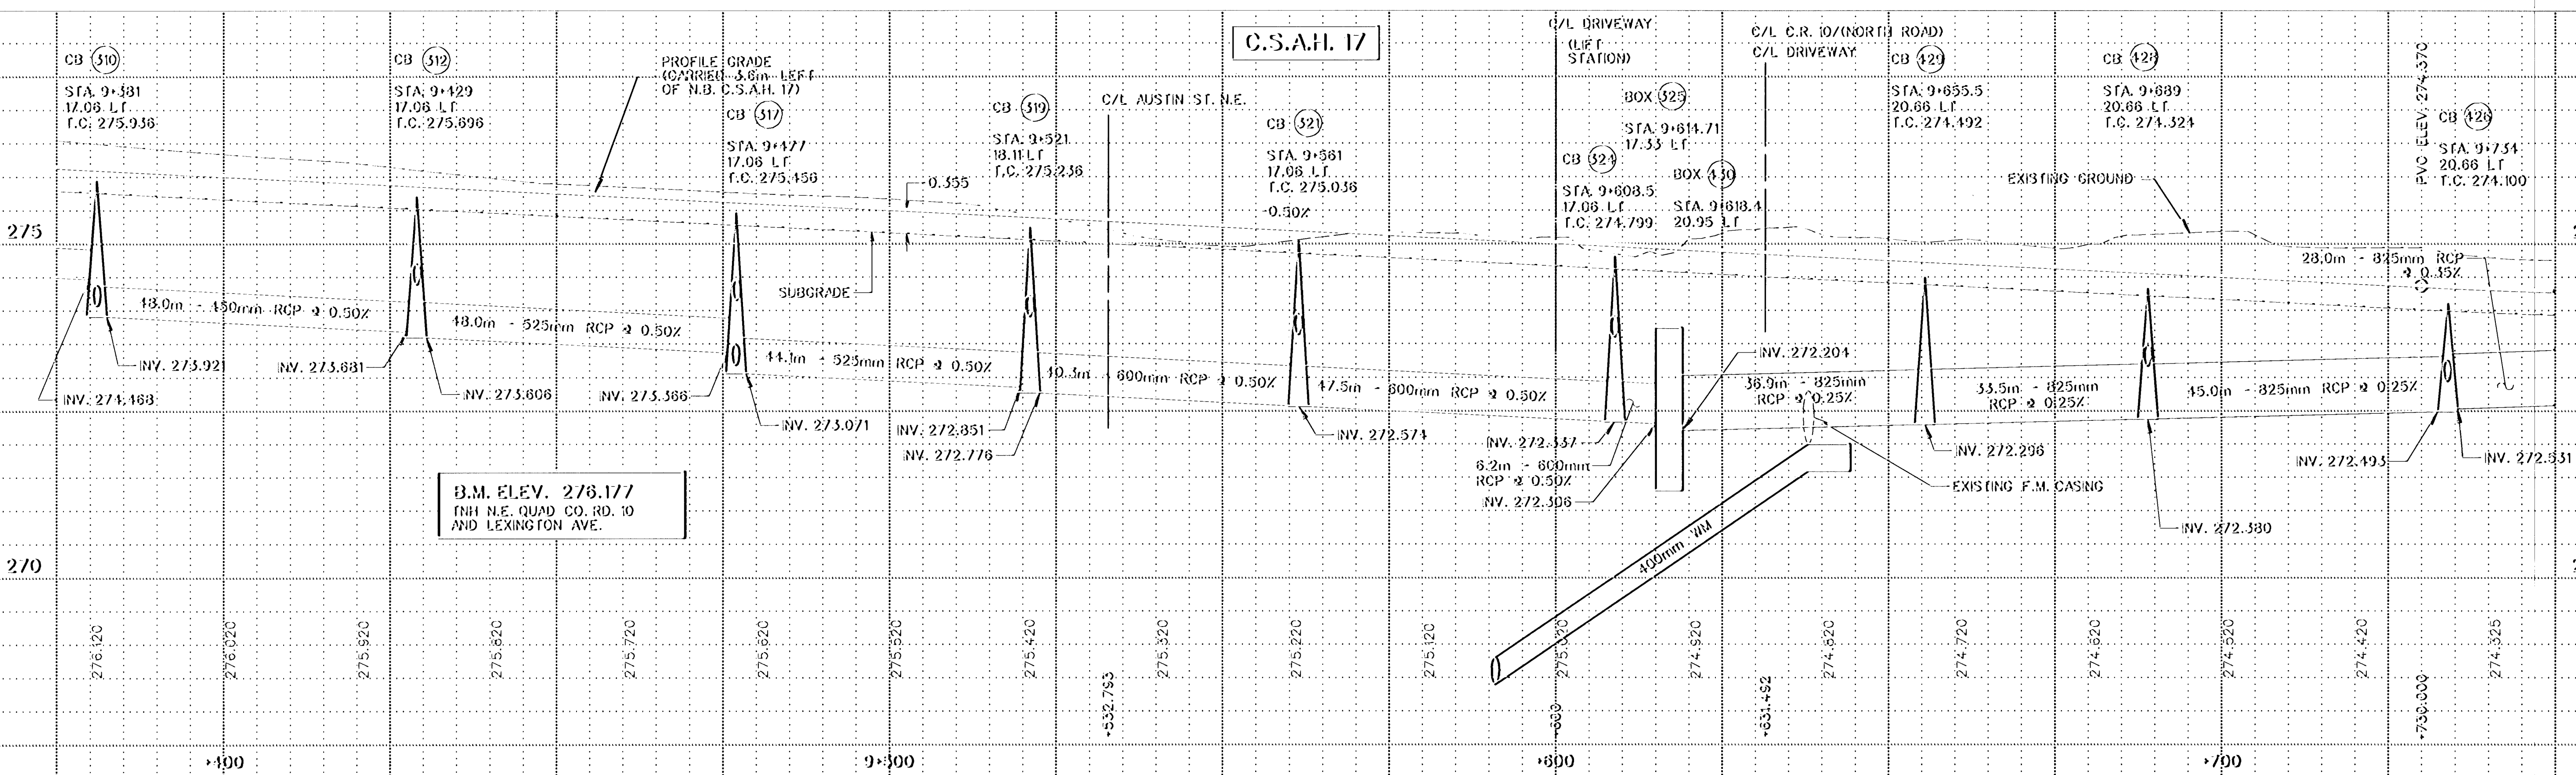

1	3-28-97	MCI	DAD	ACHD COMMENTS
NO	DATE	BY	CKD	APPR
NAME: CP4 410.PLN DATE: Mar. 18, 1997				

minnesota metric

I hereby certify that this plan, specification or report was prepared by me or under my direct supervision and that I am a duly Registered Professional Engineer under the laws of the State of Minnesota.

Donald A. Demers

Date: 3-21-97 Reg. No. 23397

STATE AID PROJECT NO. S.A.P. 02-617-11 S.A.P. 108-020-12 S.A.P. 108-030-03

CO. PROJECT NO.

DRAWN BY V. GRAF DATE 10-98

DESIGNED BY B. URBANEK DATE 10-98

CHECKED BY D. DEMERS DATE 1-97

COMM. NO. 0982410

SRF CONSULTING GROUP, INC.

ANOKA COUNTY

CONSTRUCTION PLAN AND PROFILE

C.S.A.H. 17 RECONSTRUCTION



STA. 9+375 TO STA. 9+750

SHEET 68 OF 236

NOTES:
 ALL DIMENSIONS ARE IN METERS UNLESS NOTED OTHERWISE.
 ALL STATION CALL OUTS ARE N.B. C.S.A.H. 17 UNLESS NOTED OTHERWISE.
 ALL STREET DIMENSIONS ARE TO FACE OF CURB UNLESS NOTED OTHERWISE.
 SEE SIGNAL PLANS FOR TRAFFIC SIGNAL CONSTRUCTION.
 SEE DRAINAGE TABULATION AND STORM PROFILES FOR STORM SEWER CONSTRUCTION.
 SEE TABULATIONS FOR MISCELLANEOUS CONSTRUCTION.
 PAVEMENT CROSS SLOPES ARE IN METER PER METER UNLESS NOTED OTHERWISE.

STREET RADII			
RADIUS	ALIGNMENT	STATION	LOCATION
12.0	NBLEX	9+999.0	19.8 (RT)
12.0	NBLEX	10+030.8	16.2 (RT)

ISLAND RADII			
RADIUS	ALIGNMENT	STATION	LOCATION
25.0	SBLEX	9+987.5	29.2 (RT)
20.0	NBLEX	10+035.2	24.2 (LT)
25.0	SBLEX	10+036.8	32.8 (RT)

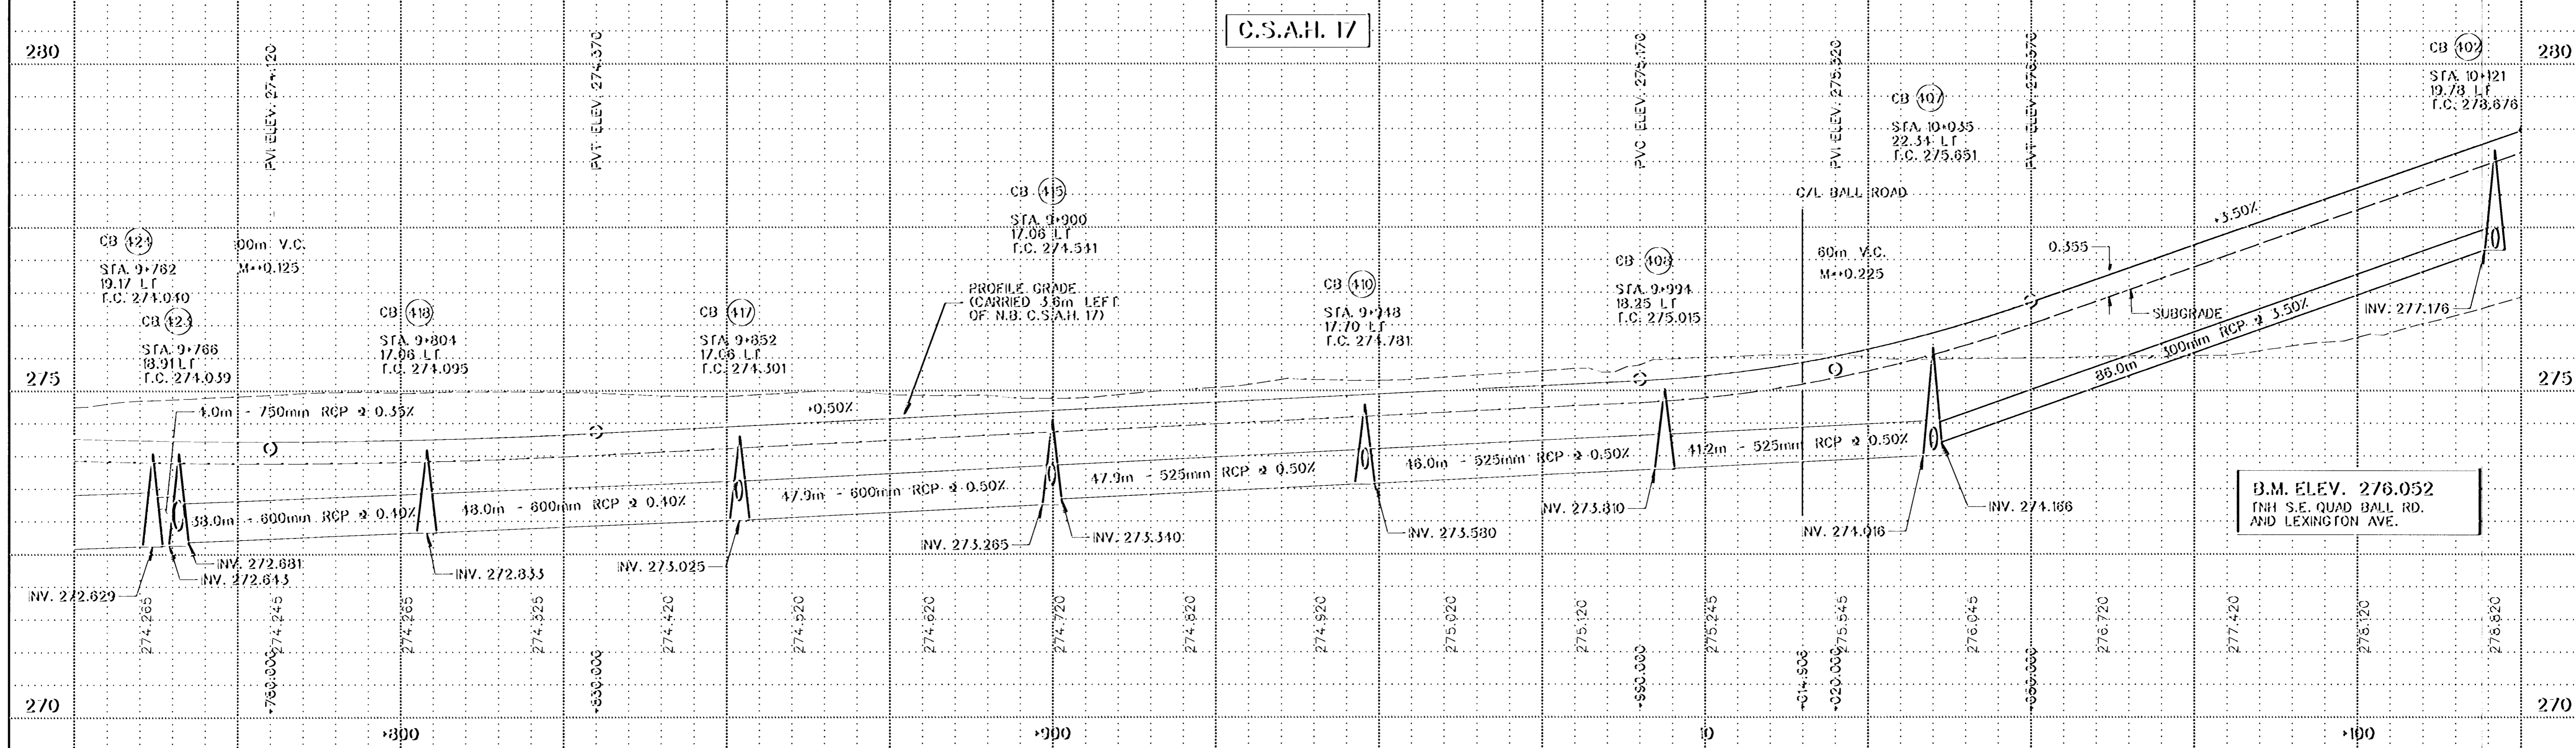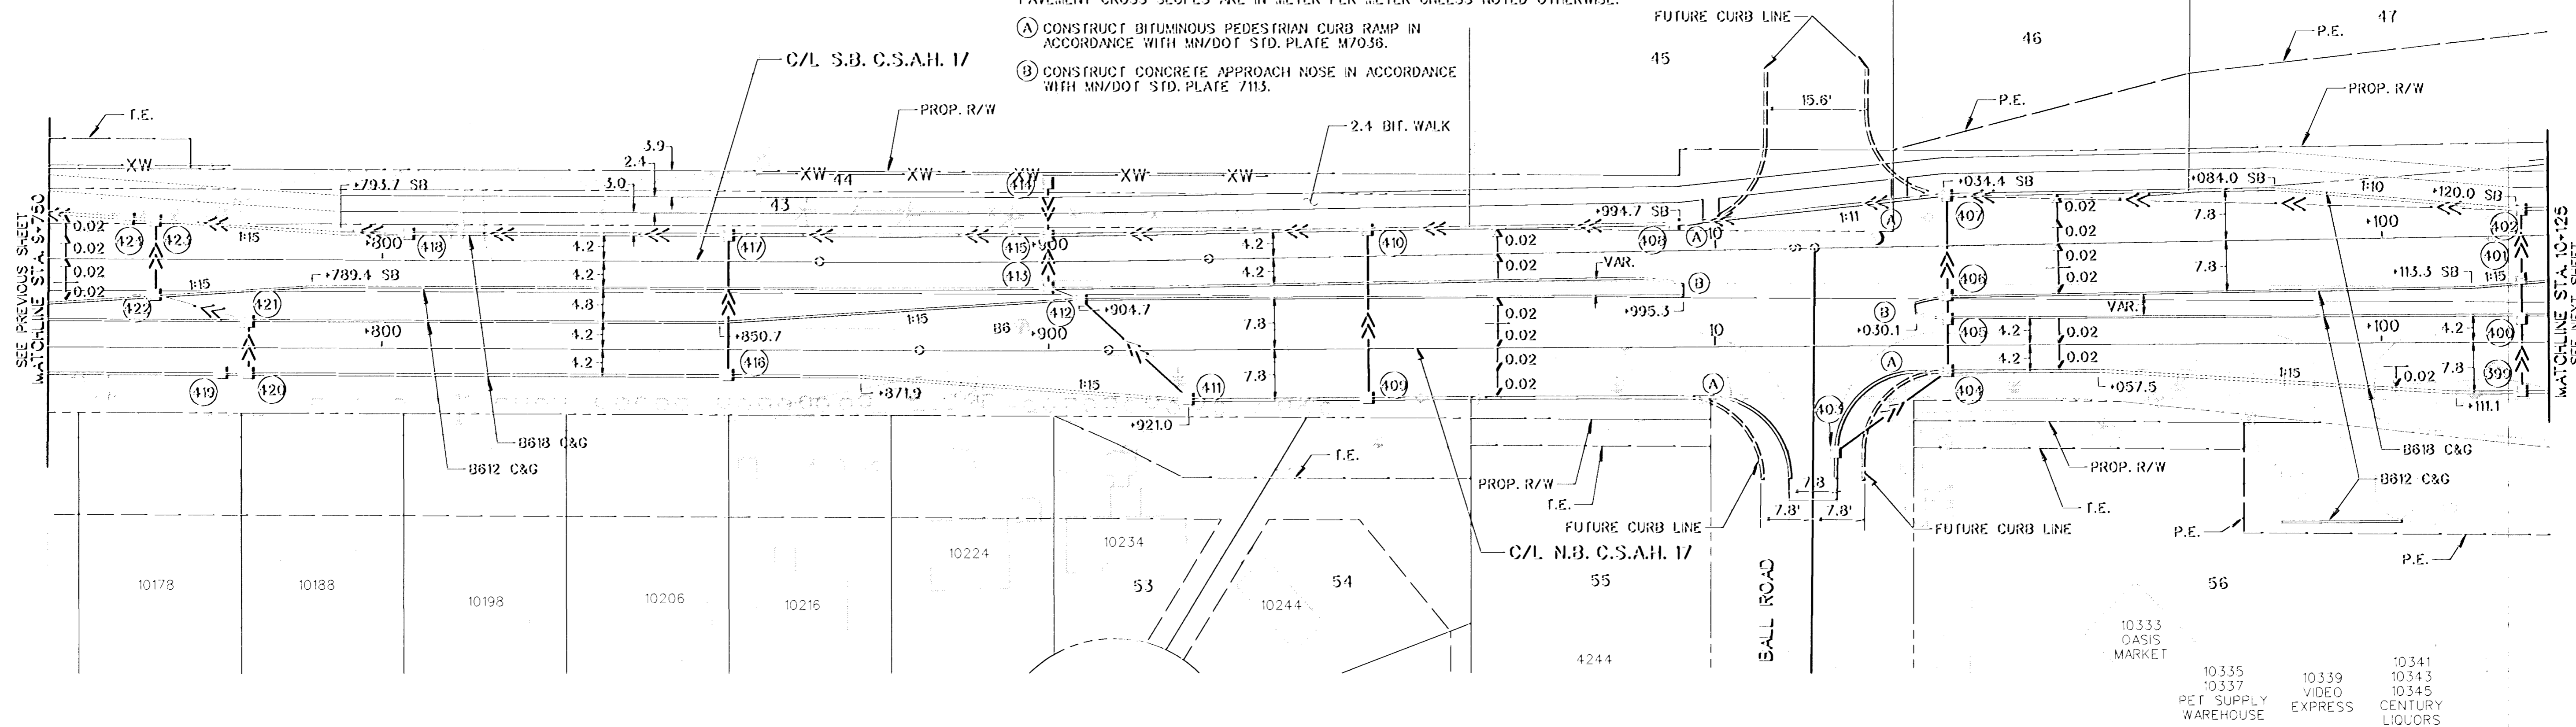

NO.	DATE	BY	CHKD	APPR	REVISION
1	3-28-97	MCI		DAD	ACHD COMMENTS

I hereby certify that this plan, specification or report was prepared by me or under my direct supervision and that I am a duly Registered Professional Engineer under the laws of the State of Minnesota.
Donald A. Jensen
 Date: 3-21-97 Reg. No. 23397

STATE AND PROJECT NO.
 S.A.P. 02-617-11
 S.A.P. 108-020-12
 S.A.P. 108-030-03
 CO. PROJECT NO.

DRAWN BY: V. GRAF
 DESIGNED BY: B. URBANEK
 CHECKED BY: D. DEMERS
 DATE: 10-98
 10-98
 1-97
 COMM. NO. 0982410



ANOKA COUNTY
 CONSTRUCTION PLAN AND PROFILE
 C.S.A.H. 17 RECONSTRUCTION
 STA. 9+750 TO STA. 10+125


SHEET 69 OF 236

SEE SE RAMP CONST. PLAN & PROFILE

C/L S.B. I-35W


SEE SW RAMP CONST. PLAN & PROFILE

ISLAND RADII			
RADIUS	ALIGNMENT	STATION	LOCATION
18.45	SBLEX	10+180.1	17.9 (LT)
0.6	SBLEX	10+200.5	6.6 (LT)
1.0	SBLEX	10+202.7	6.94 (RT)
1.0	NBLEX	10+204.9	5.2 (LT)
15.0	SBLEX	10+242.0	22.8 (RT)
1.0	SBLEX	10+433.8	5.2 (RT)
1.0	NBLEX	10+434.9	7.2 (LT)
0.6	NBLEX	10+439.6	6.6 (RT)
19.45	NBLEX	10+461.4	18.4 (RT)

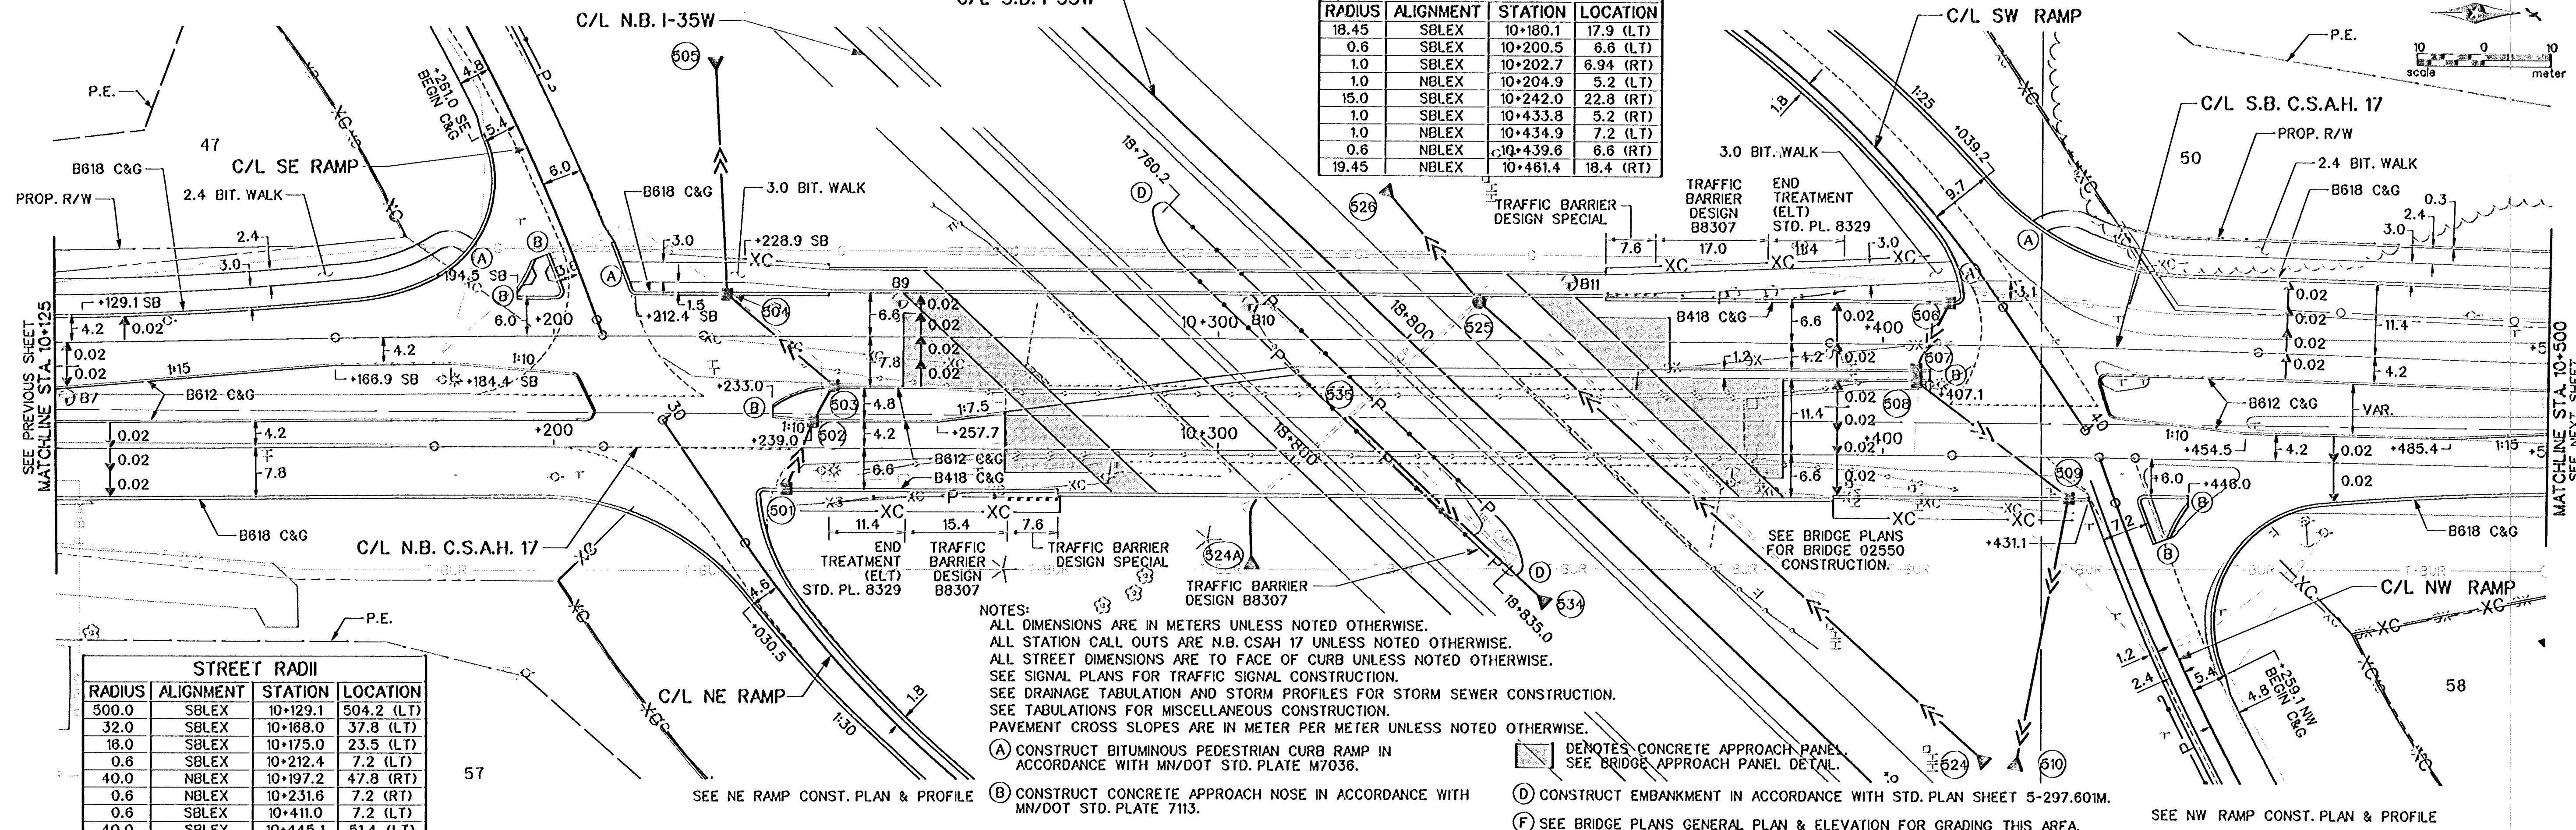


STREET RADII			
RADIUS	ALIGNMENT	STATION	LOCATION
500.0	SBLEX	10+129.1	504.2 (LT)
32.0	SBLEX	10+168.0	37.8 (LT)
18.0	SBLEX	10+175.0	23.5 (LT)
0.6	SBLEX	10+212.4	7.2 (LT)
40.0	NBLEX	10+197.2	47.8 (RT)
0.6	NBLEX	10+231.6	7.2 (RT)
0.6	SBLEX	10+411.0	7.2 (LT)
40.0	SBLEX	10+445.1	51.4 (LT)
18.0	NBLEX	10+468.3	24.6 (RT)
400.0	NBLEX	10+510.6	404.2 (RT)

NOTES:
 ALL DIMENSIONS ARE IN METERS UNLESS NOTED OTHERWISE.
 ALL STATION CALL OUTS ARE N.B. CSAH 17 UNLESS NOTED OTHERWISE.
 ALL STREET DIMENSIONS ARE TO FACE OF CURB UNLESS NOTED OTHERWISE.
 SEE SIGNAL PLANS FOR TRAFFIC SIGNAL CONSTRUCTION.
 SEE DRAINAGE TABULATION AND STORM PROFILES FOR STORM SEWER CONSTRUCTION.
 SEE TABULATIONS FOR MISCELLANEOUS CONSTRUCTION.
 PAVEMENT CROSS SLOPES ARE IN METER PER METER UNLESS NOTED OTHERWISE.
 (A) CONSTRUCT BITUMINOUS PEDESTRIAN CURB RAMP IN ACCORDANCE WITH MN/DOT STD. PLATE M7036.
 (B) CONSTRUCT CONCRETE APPROACH NOSE IN ACCORDANCE WITH MN/DOT STD. PLATE 7113.
 (C) DENOTES CONCRETE APPROACH PANEL. SEE BRIDGE APPROACH PANEL DETAIL.
 (D) CONSTRUCT EMBANKMENT IN ACCORDANCE WITH STD. PLAN SHEET 5-297.601M.
 (E) SEE BRIDGE PLANS GENERAL PLAN & ELEVATION FOR GRADING THIS AREA.

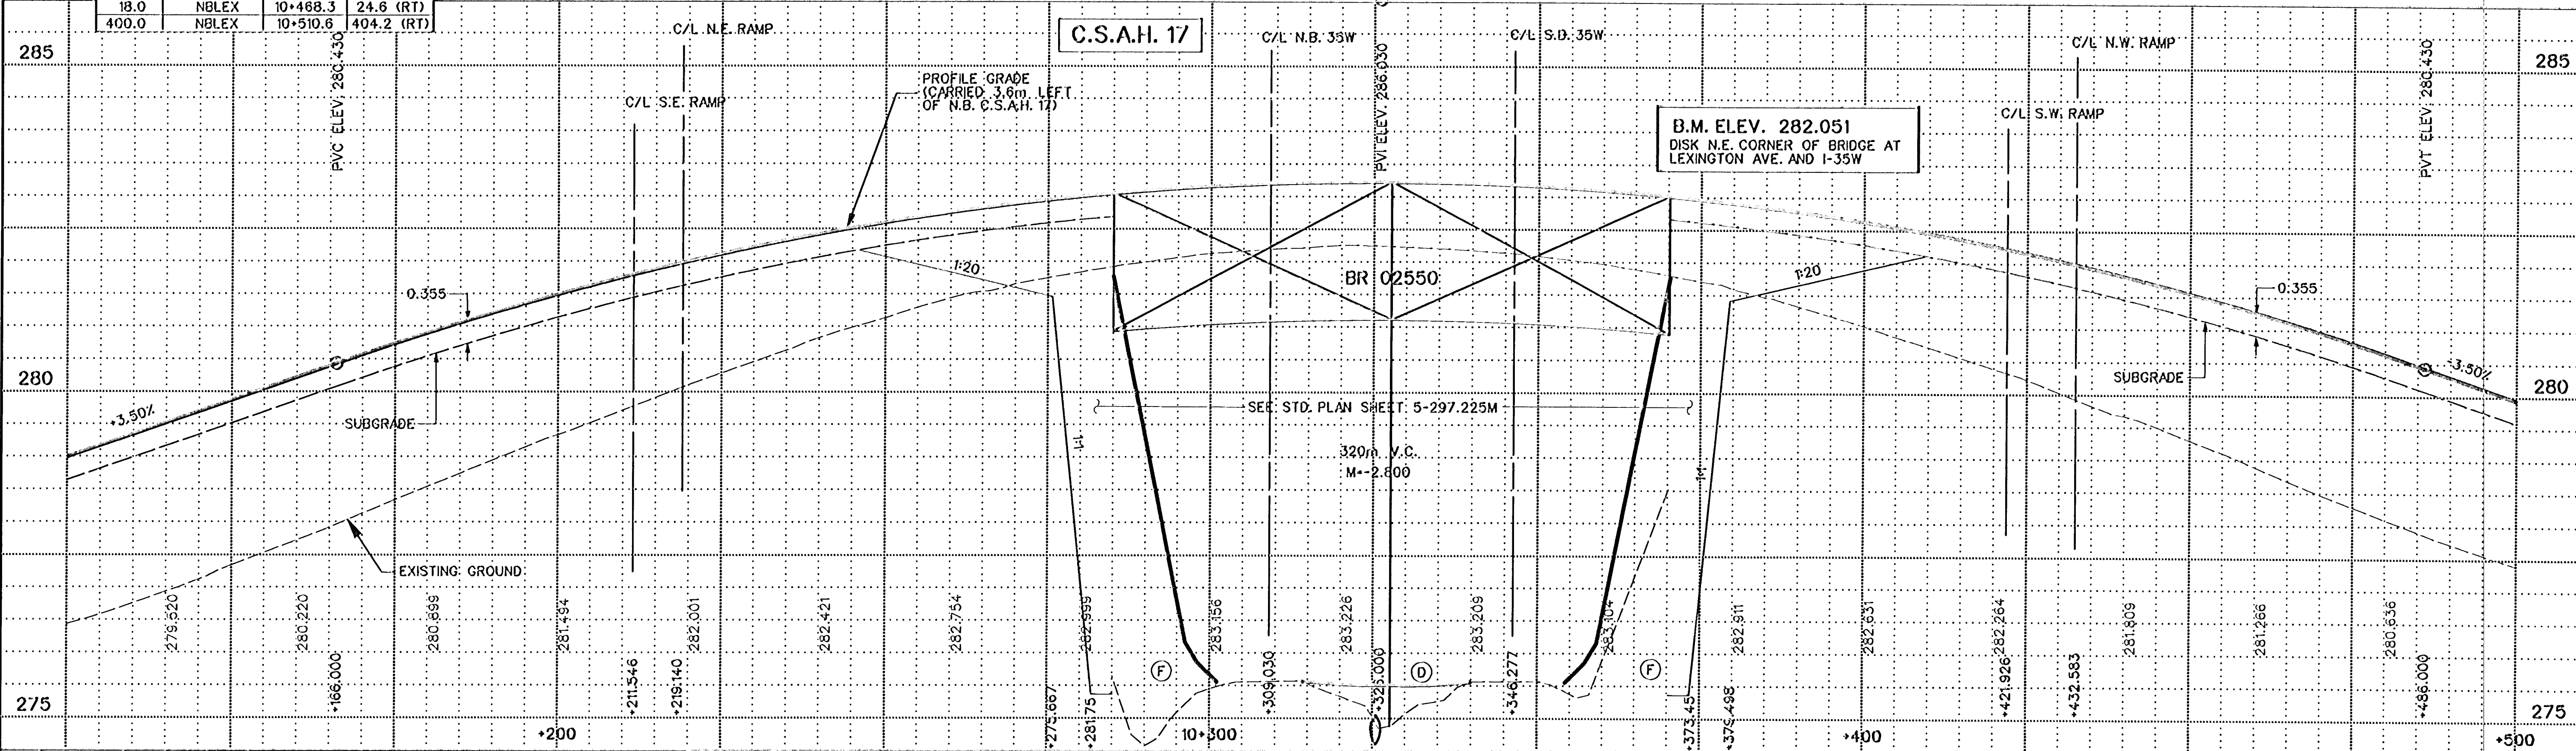

1	4-1-97	MCI	MDH	DAD	REVISE SE RAMP AND SW RAMP RADII
NO	DATE	BY	CHKD	APPR	REVISION

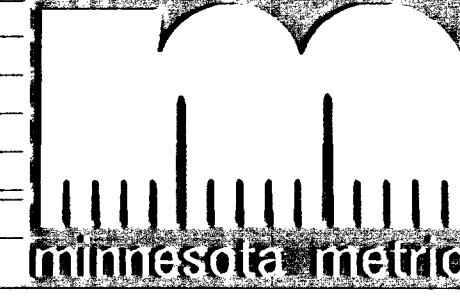

I hereby certify that this plan, specification or report was prepared by me or under my direct supervision and that I am a duly Registered Professional Engineer under the laws of the State of Minnesota.
Donald A. James
 Date: 3-21-97 Reg. No. 23377


STATE AND PROJECT NO.
 S.A.P. 02-617-11
 S.A.P. 106-020-12
 S.A.P. 106-030-03
 CO. PROJECT NO.

DRAWN BY DATE
 V. GRAF 10-98
 DESIGNED BY
 B. URBANEK 10-98
 CHECKED BY
 D. DEMERS 1-97
 COMM. NO.
 0982410






ANOKA COUNTY
 CONSTRUCTION PLAN AND PROFILE
 C.S.A.H. 17 RECONSTRUCTION
 STA. 10+125 TO STA. 10+500

SHEET
 70
 OF
 236

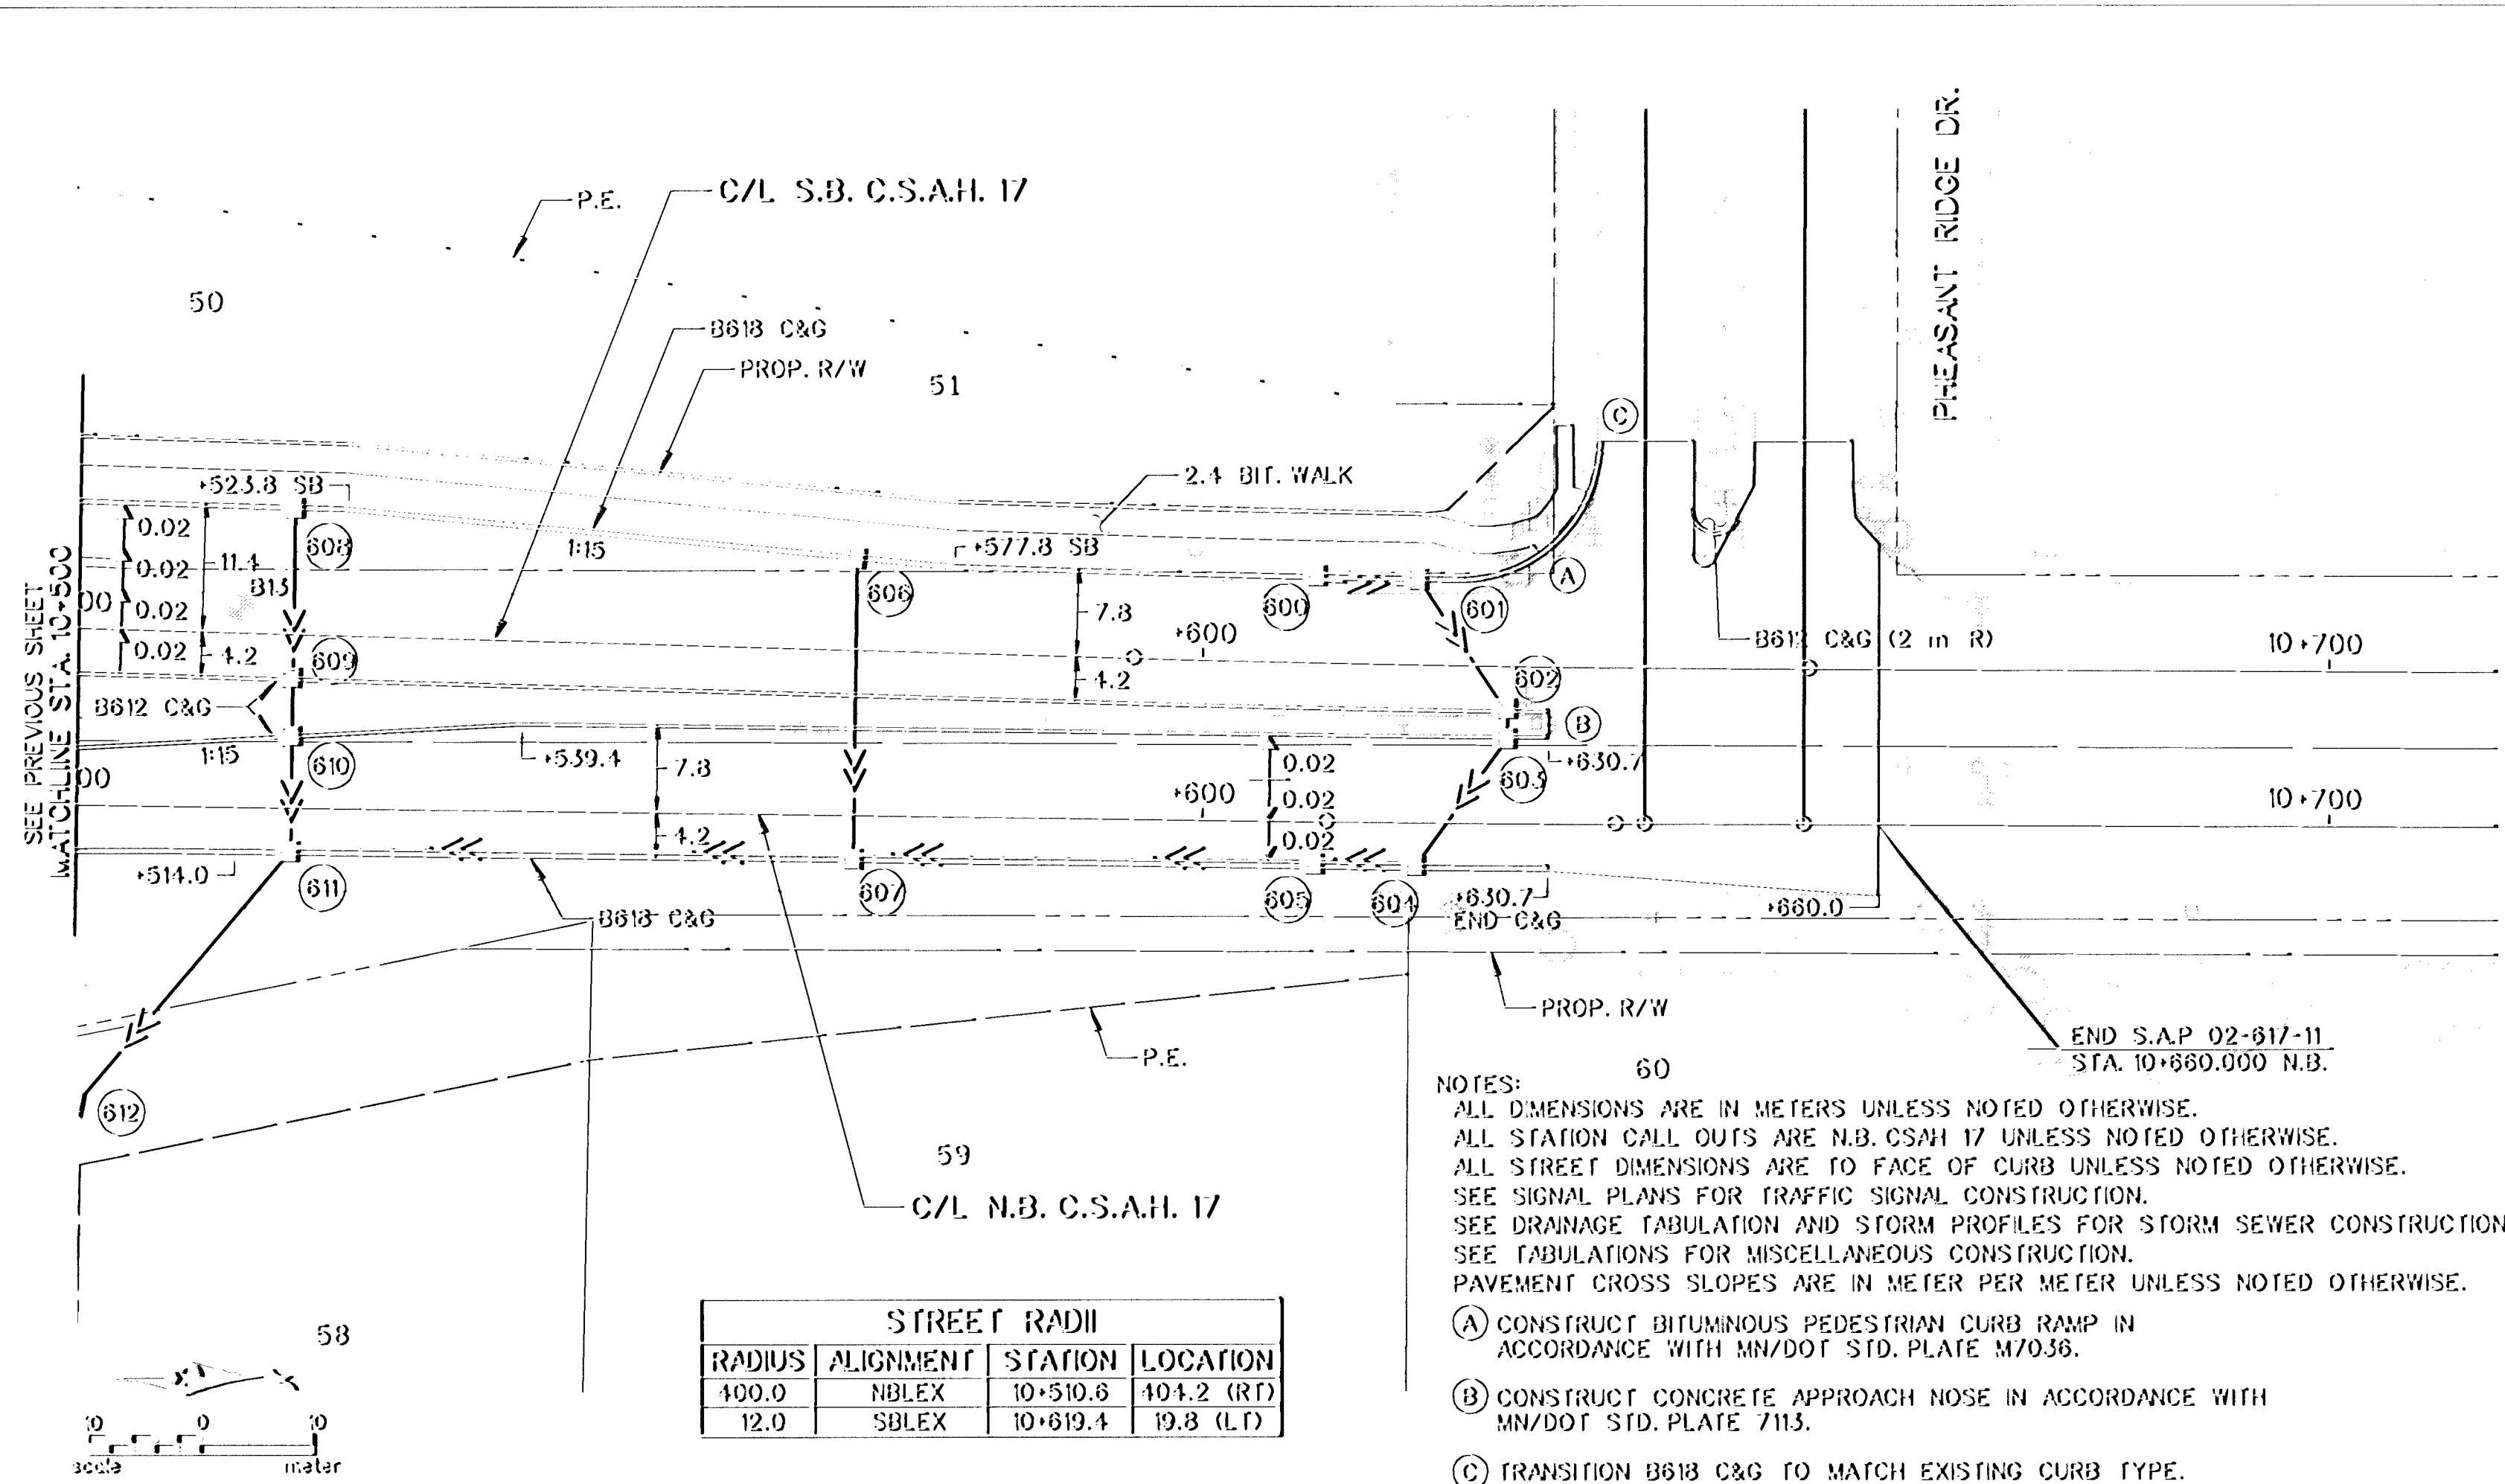

STREET RADII			
RADIUS	ALIGNMENT	STATION	LOCATION
100.0	NBLEX	10+510.6	101.2 (RT)
12.0	SBLEX	10+619.4	19.8 (LT)

- NOTES:
- ALL DIMENSIONS ARE IN METERS UNLESS NOTED OTHERWISE.
 - ALL STATION CALL OUTS ARE N.B. CSAH 17 UNLESS NOTED OTHERWISE.
 - ALL STREET DIMENSIONS ARE TO FACE OF CURB UNLESS NOTED OTHERWISE.
 - SEE SIGNAL PLANS FOR TRAFFIC SIGNAL CONSTRUCTION.
 - SEE DRAINAGE TABULATION AND STORM PROFILES FOR STORM SEWER CONSTRUCTION.
 - SEE TABULATIONS FOR MISCELLANEOUS CONSTRUCTION.
 - PAVEMENT CROSS SLOPES ARE IN METER PER METER UNLESS NOTED OTHERWISE.
- (A) CONSTRUCT BITUMINOUS PEDESTRIAN CURB RAMP IN ACCORDANCE WITH MN/DOT STD. PLATE M7036.
 - (B) CONSTRUCT CONCRETE APPROACH NOSE IN ACCORDANCE WITH MN/DOT STD. PLATE 7115.
 - (C) TRANSITION 8818 C&G TO MATCH EXISTING CURB TYPE.

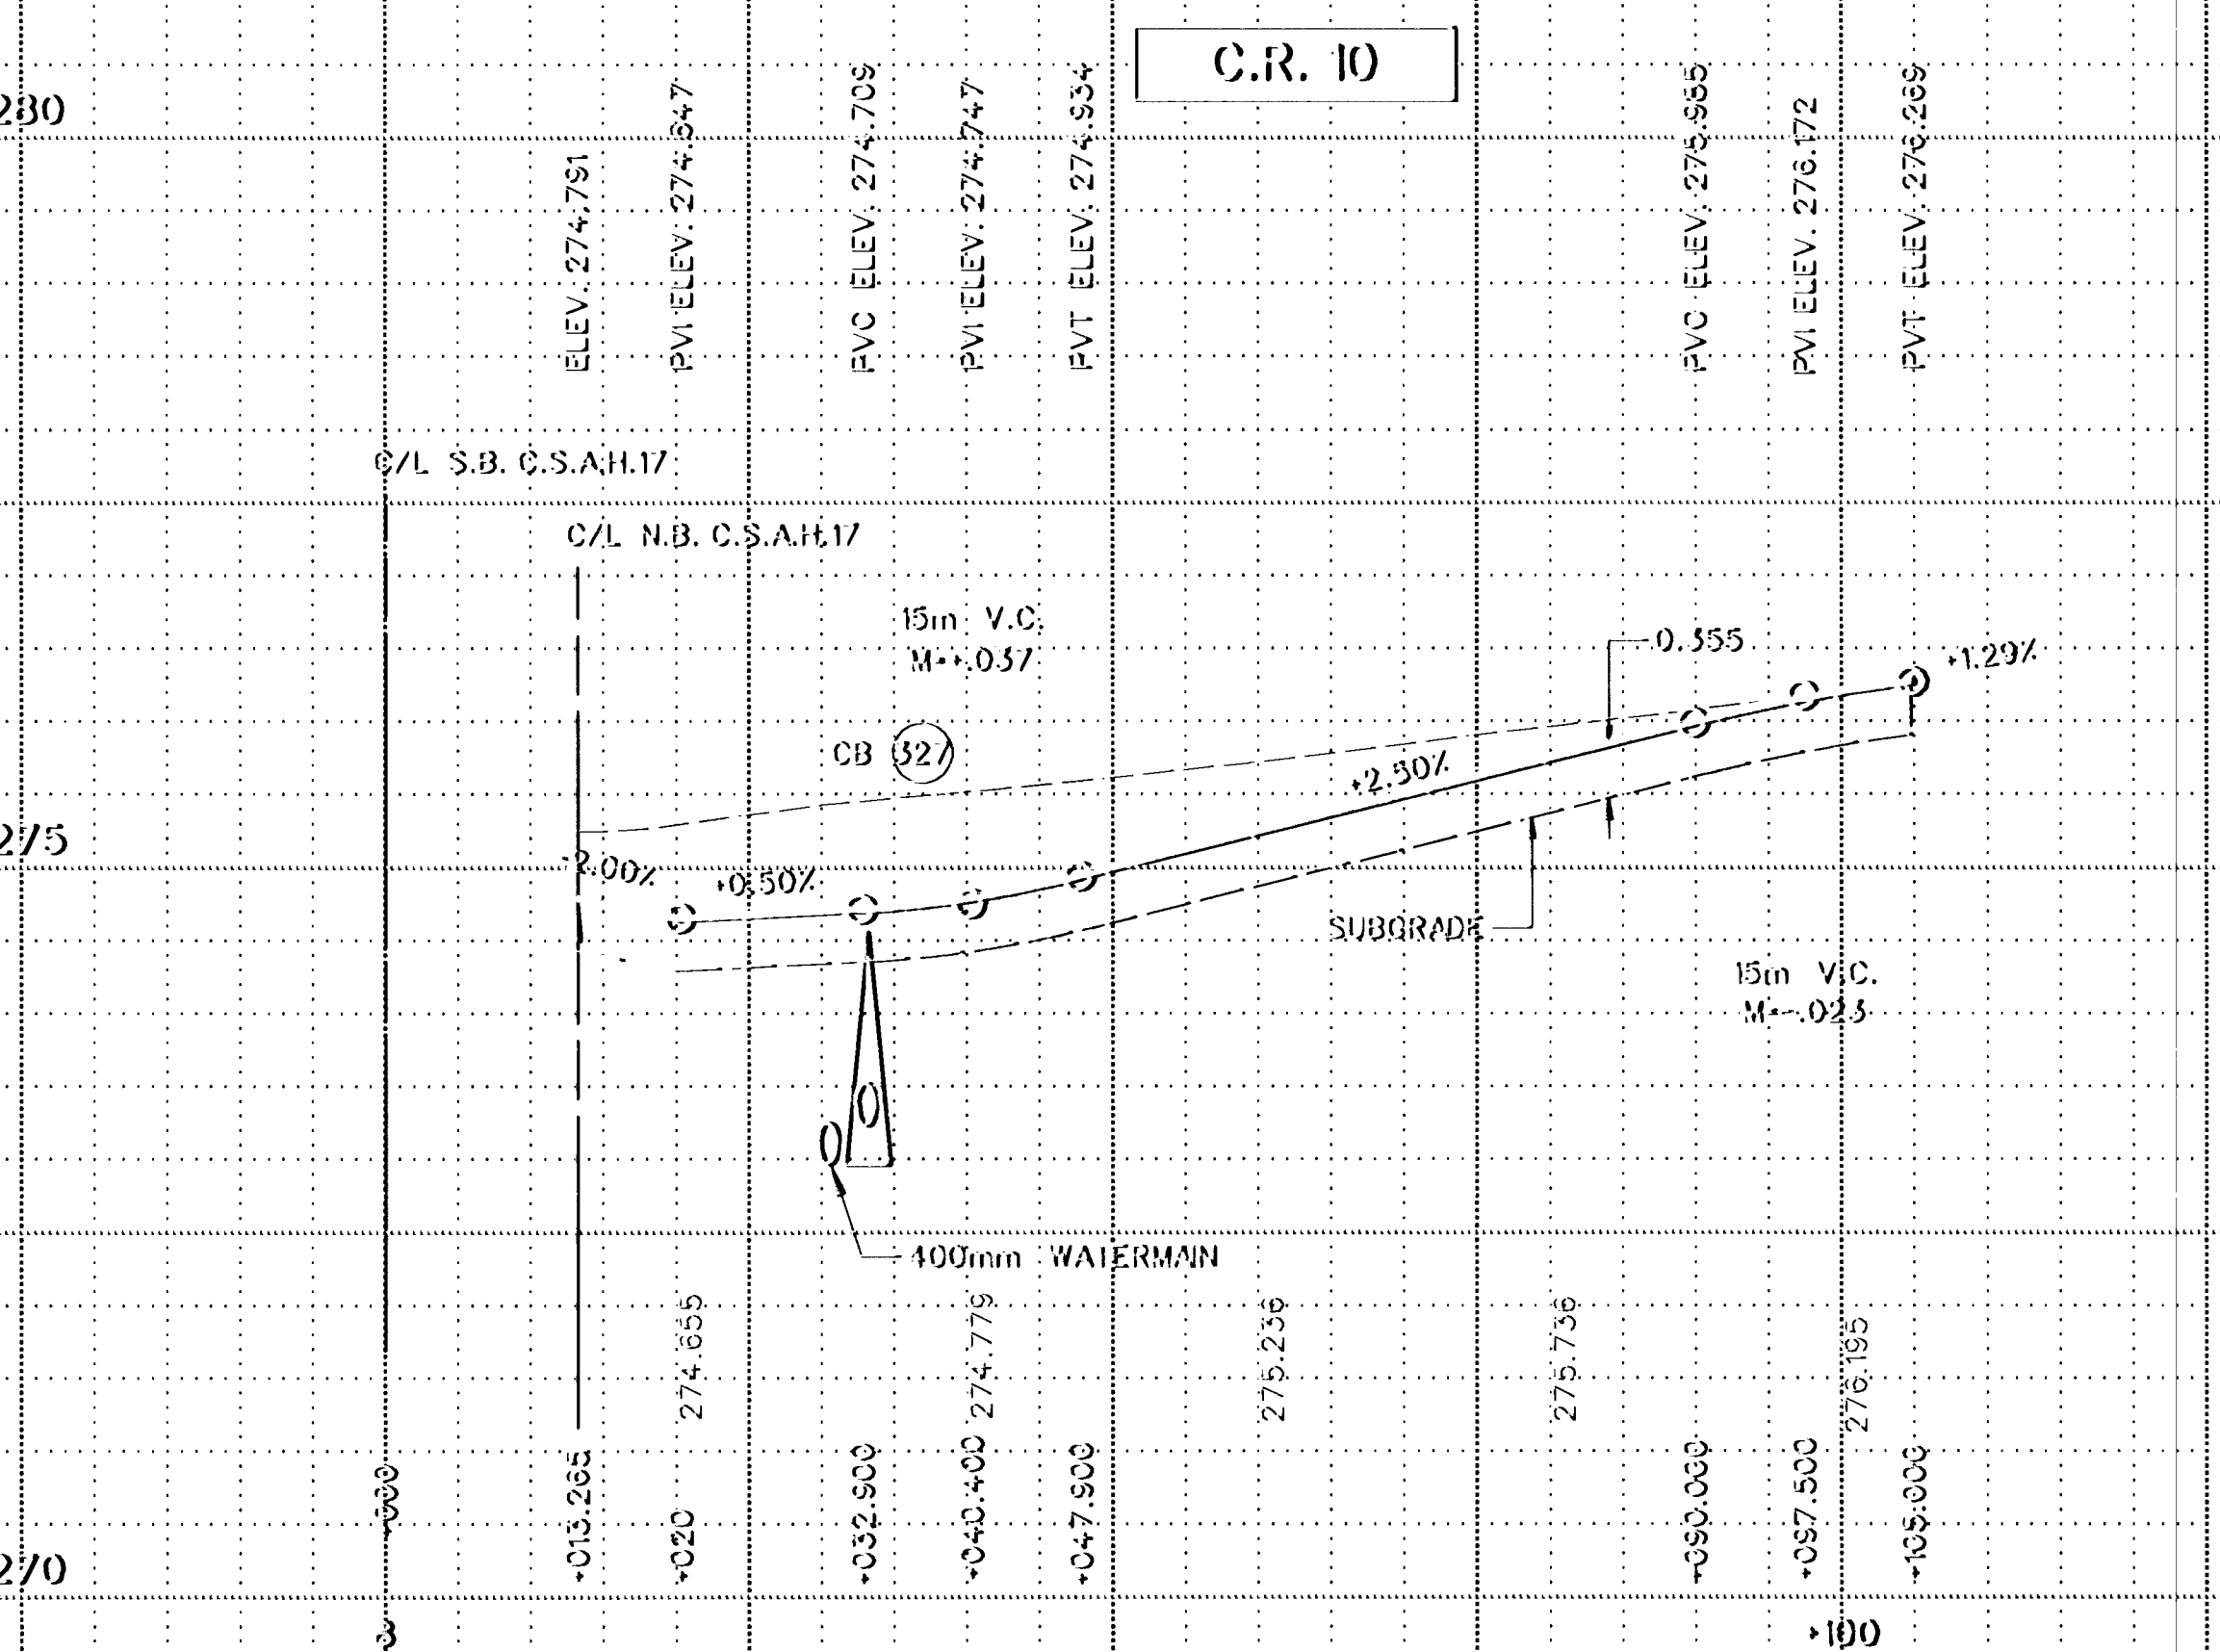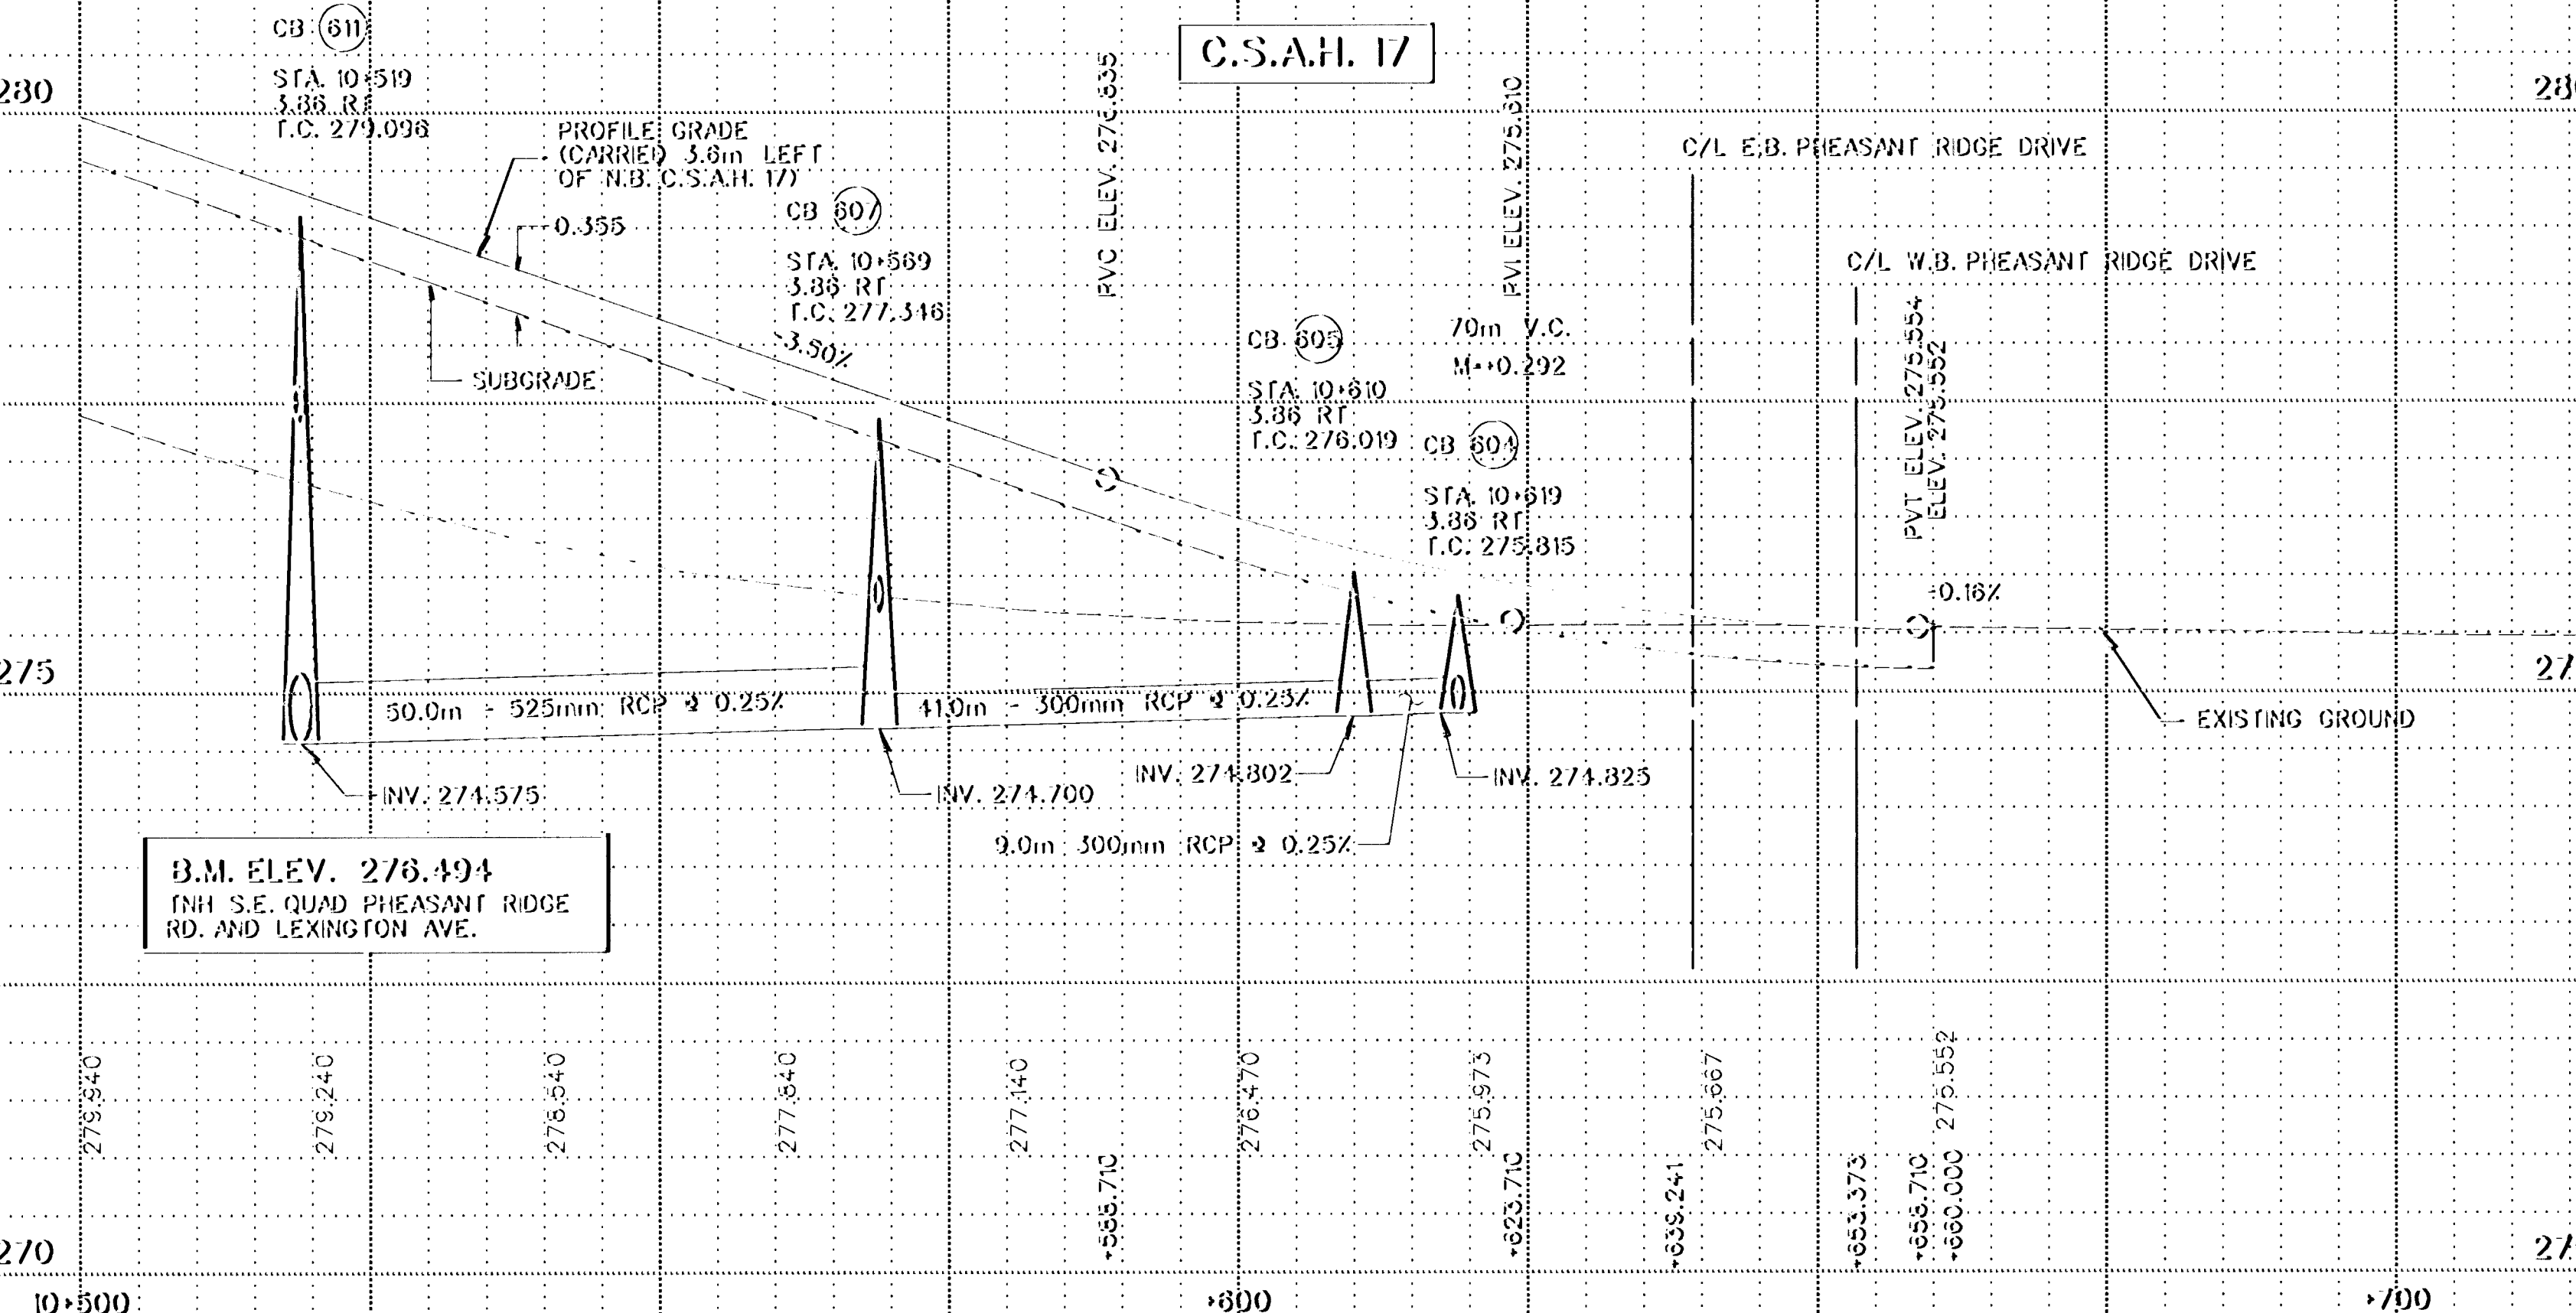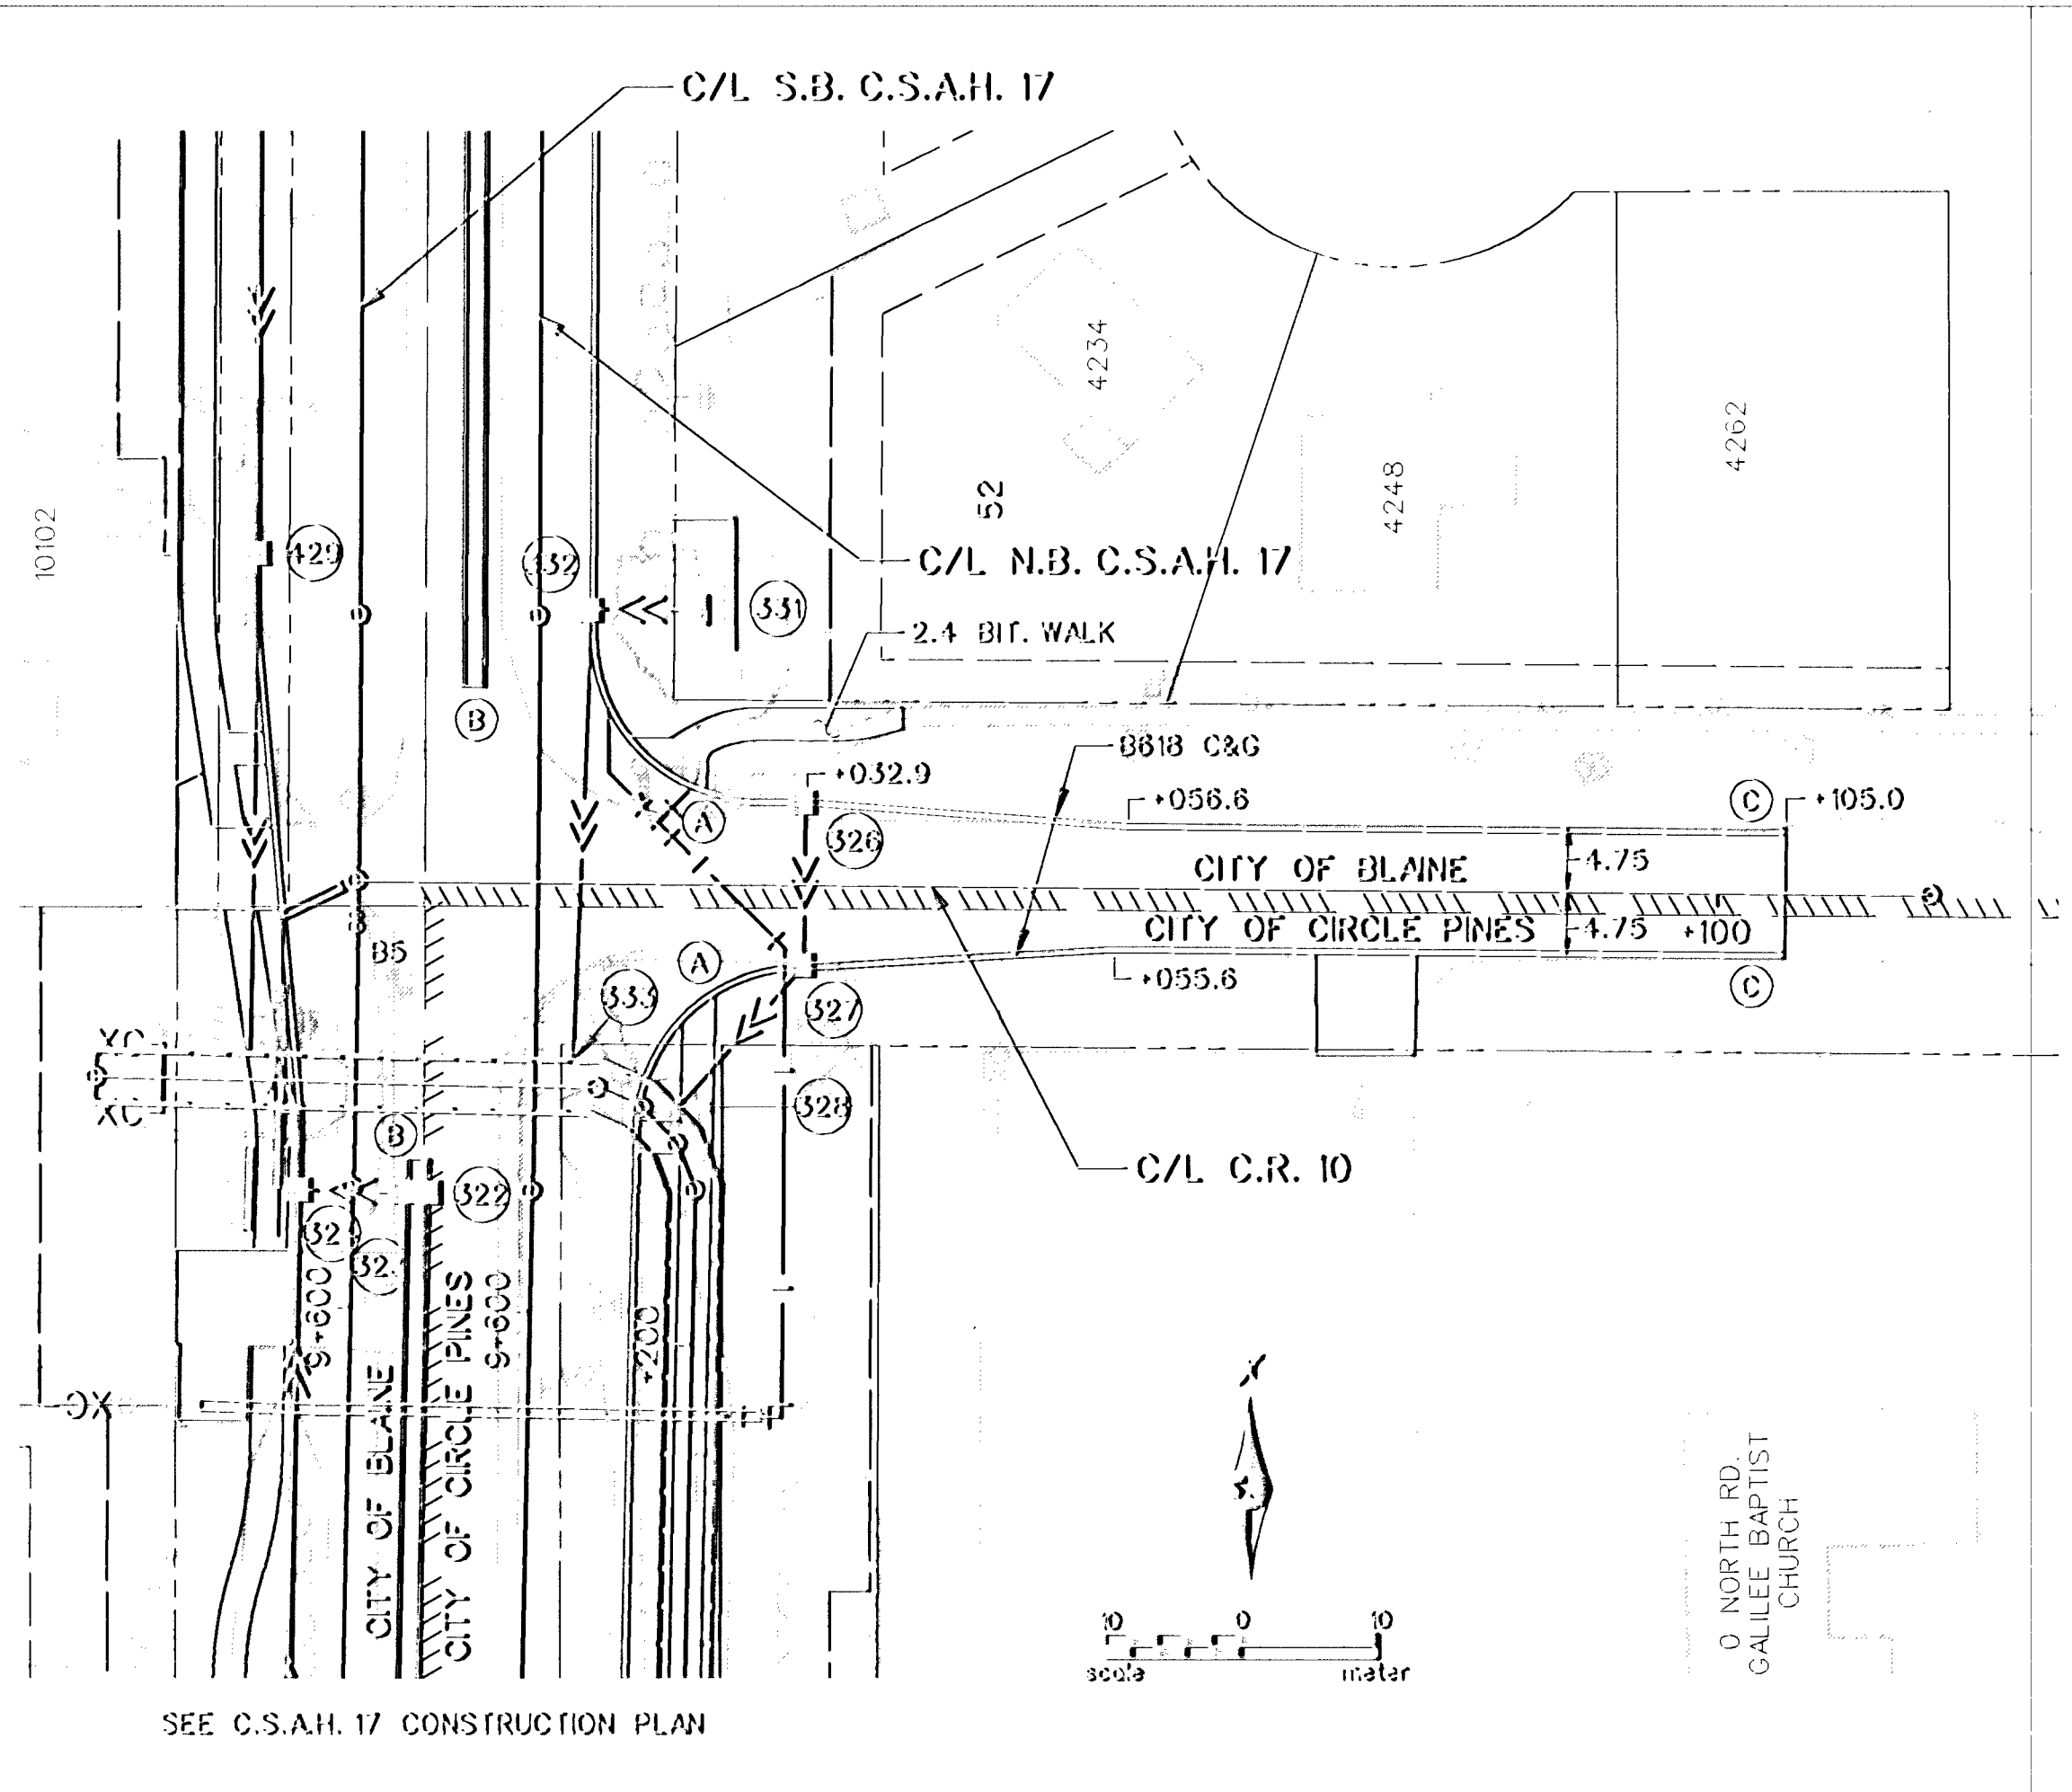

NO	DATE	BY	CHKD	APPR	REVISION
1	3-26-97	MCI		DAD	PHEASANT RIDGE DRIVE MEDIAN NOSE




I hereby certify that this plan, specification or report was prepared by me or under my direct supervision and that I am a duly Registered Professional Engineer under the laws of the State of Minnesota.

Donald A. Demers
Date 3-21-97 Reg. No. 23397

STATE AID PROJECT NO.
S.A.P. 02-617-11
S.A.P. 106-020-12
S.A.P. 106-030-03
CO. PROJECT NO.


DRAWN BY V. GRAF DATE 10-96
DESIGNED BY B. URBANEK 10-96
CHECKED BY D. DEMERS 1-97
COMM. NO. 0962410

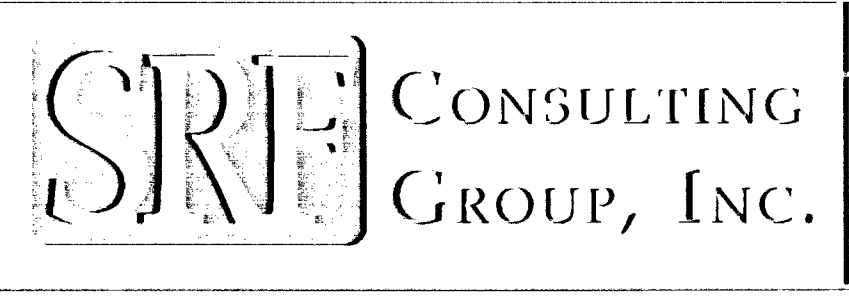

ANOKA COUNTY
CONSTRUCTION PLAN AND PROFILE
C.S.A.H. 17 RECONSTRUCTION
C.S.A.H. 17 STA. 10+500 TO STA. 10+680+000 & C.R. 10

SHEET 71 OF 236

NOTES:
 ALL DIMENSIONS ARE IN METERS UNLESS NOTED OTHERWISE.
 SEE LIGHTING PLAN FOR RAMP LIGHTING CONSTRUCTION.
 SEE TABULATIONS FOR MISCELLANEOUS CONSTRUCTION.
 PAVEMENT CROSS SLOPES ARE IN METER PER METER UNLESS NOTED OTHERWISE.

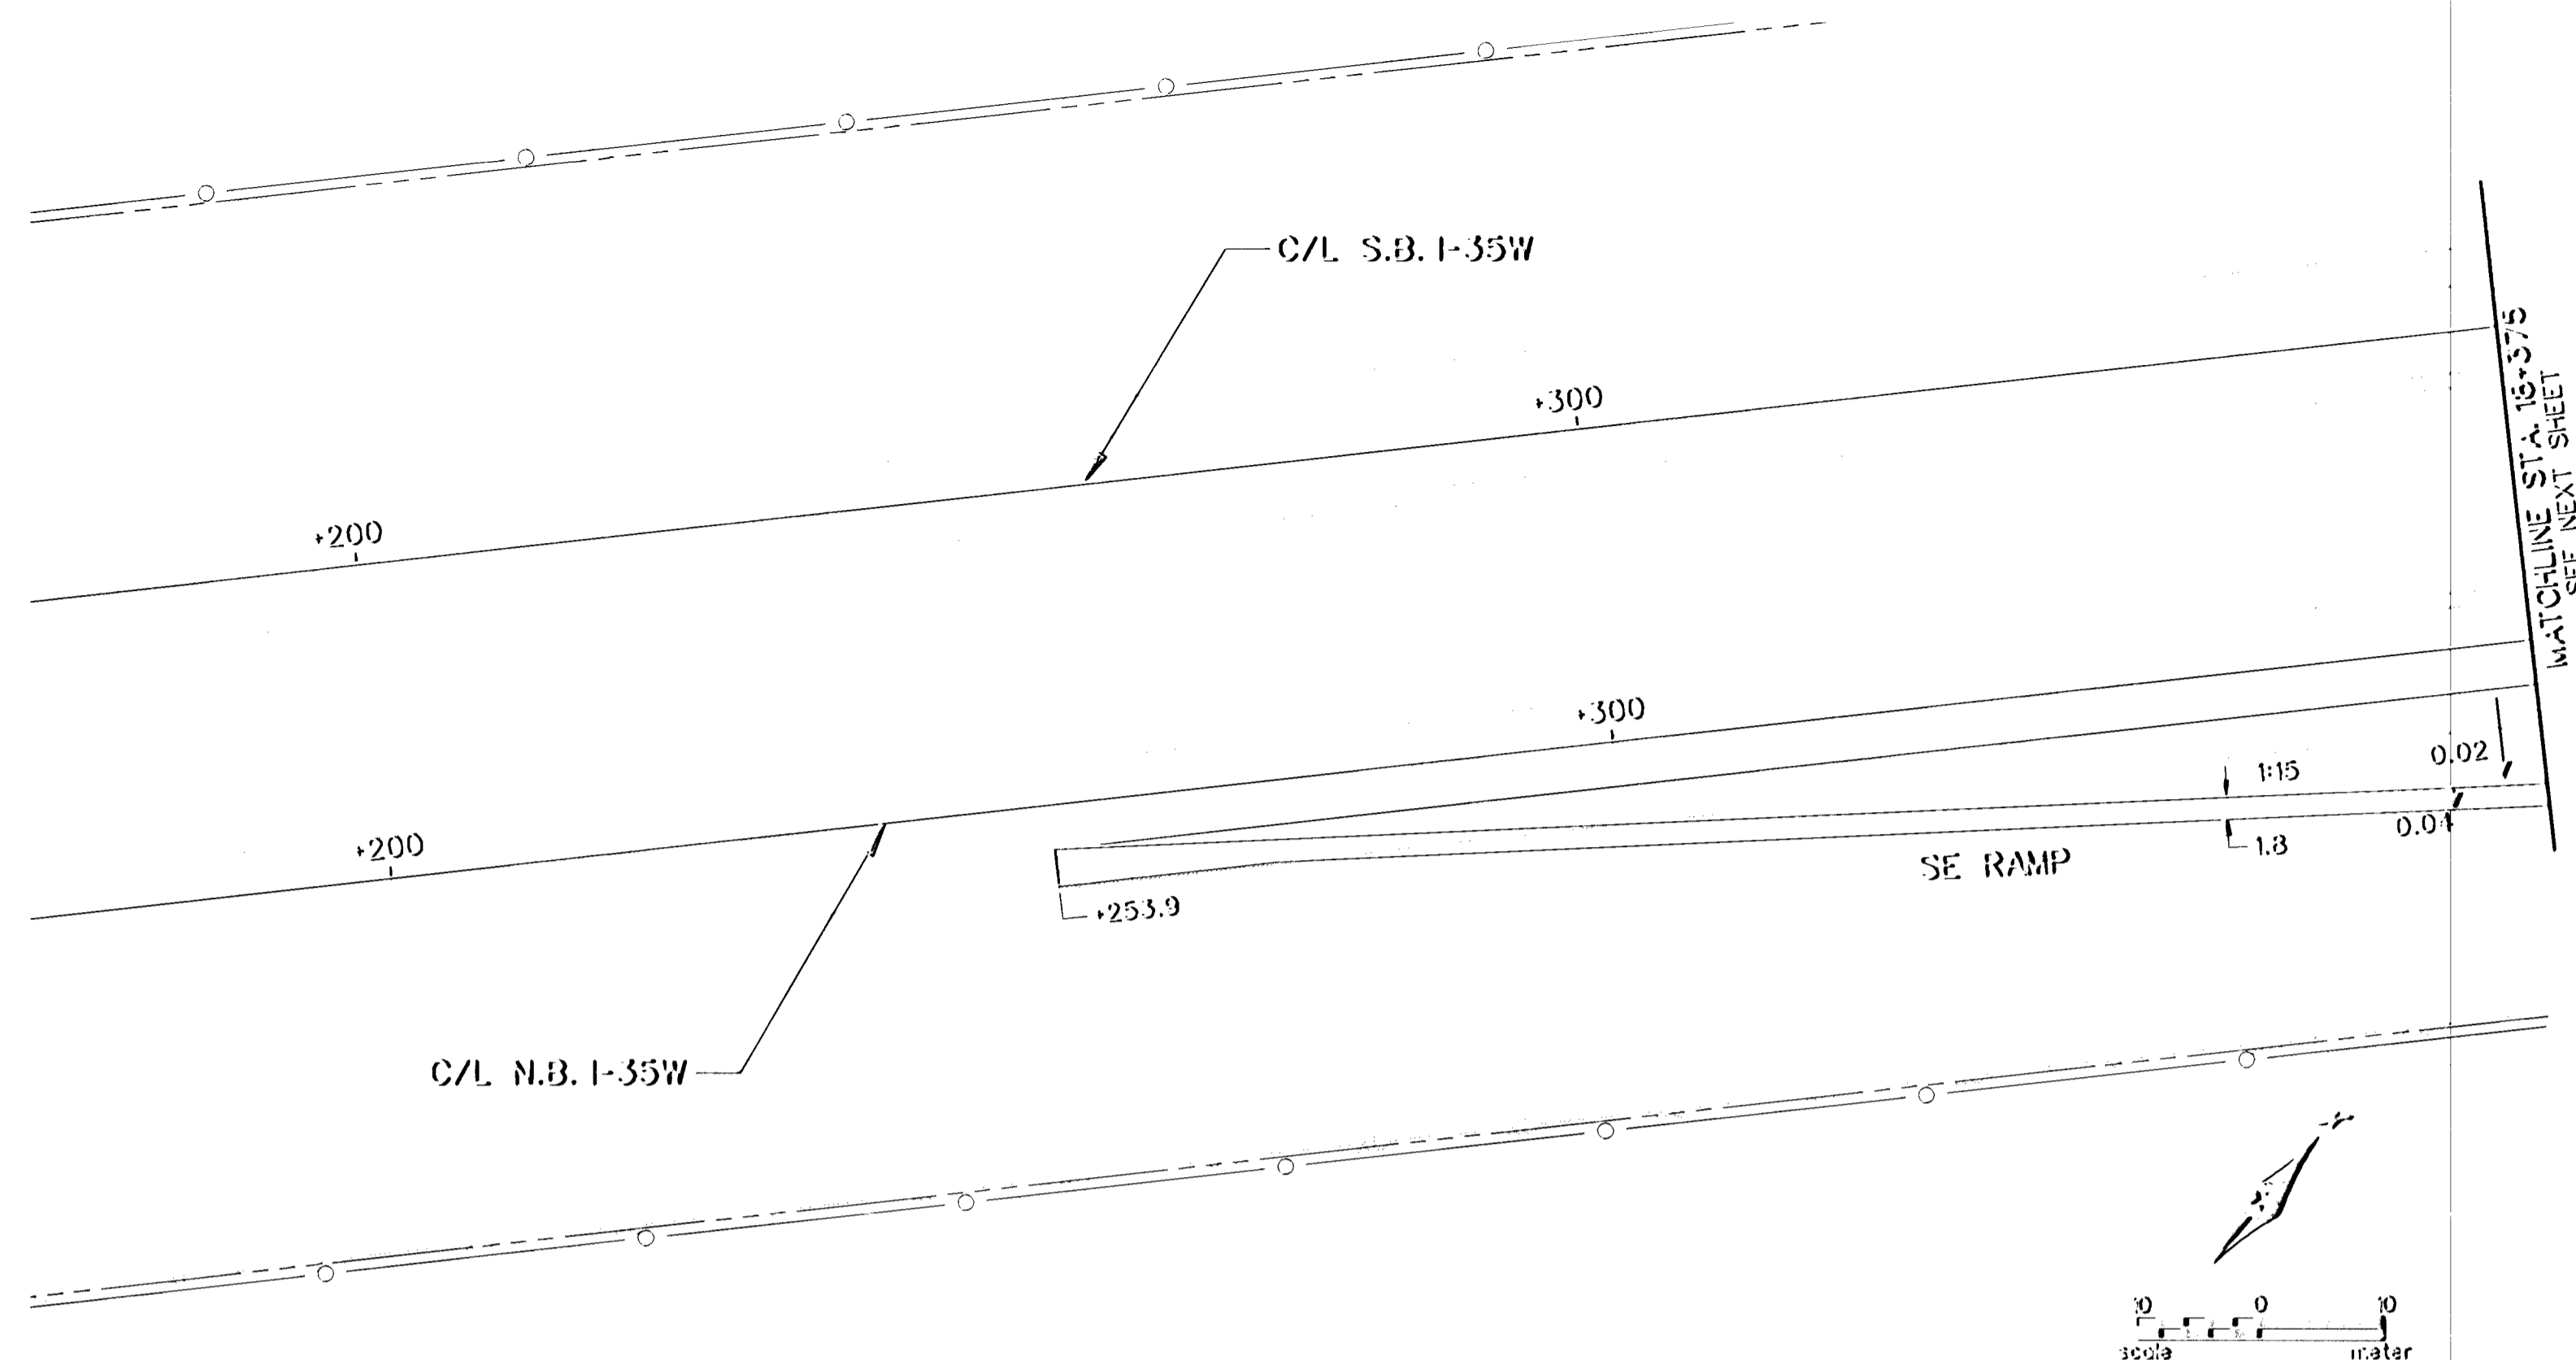


B.M. ELEV. 282.031
 DISK N.E. CORNER OF BRIDGE AT
 LEXINGTON AVE. AND I-35W

WATCHLINE STA. 10+375
SEE NEXT SHEET

NO.	DATE	BY	CHKD	APPR	REVISION

NAME: CP8 410.PLN DATE: Mar. 18, 1997

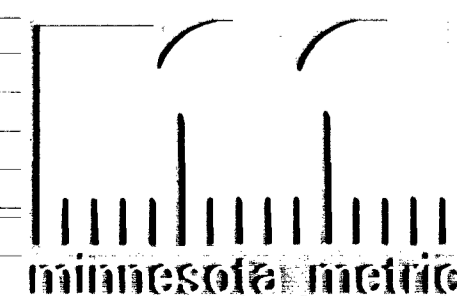


I hereby certify that this plan, specification or report was prepared by me or under my direct supervision and that I am a duly Registered Professional Engineer under the laws of the State of Minnesota.

Date _____ Reg. No. _____

STATE AID PROJECT NO.
 S.A.P. 02-617-11
 S.A.P. 108-020-12
 S.A.P. 108-030-03


CO. PROJECT NO. _____

DRAWN BY: V. GRAF DATE: 12-98
 DESIGNED BY: B. URBANEK DATE: 12-98
 CHECKED BY: D. DEMERS DATE: 1-97
 COMM. NO. 0962410

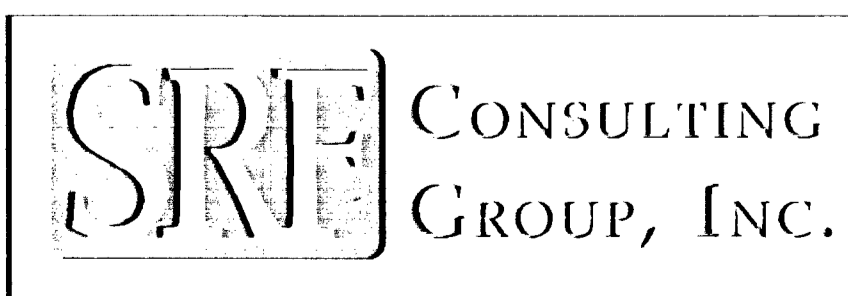

ANOKA COUNTY
 CONSTRUCTION PLAN AND PROFILE
 C.S.A.H. 17 RECONSTRUCTION
 S.E. RAMP


SHEET
 72
 OF
 236

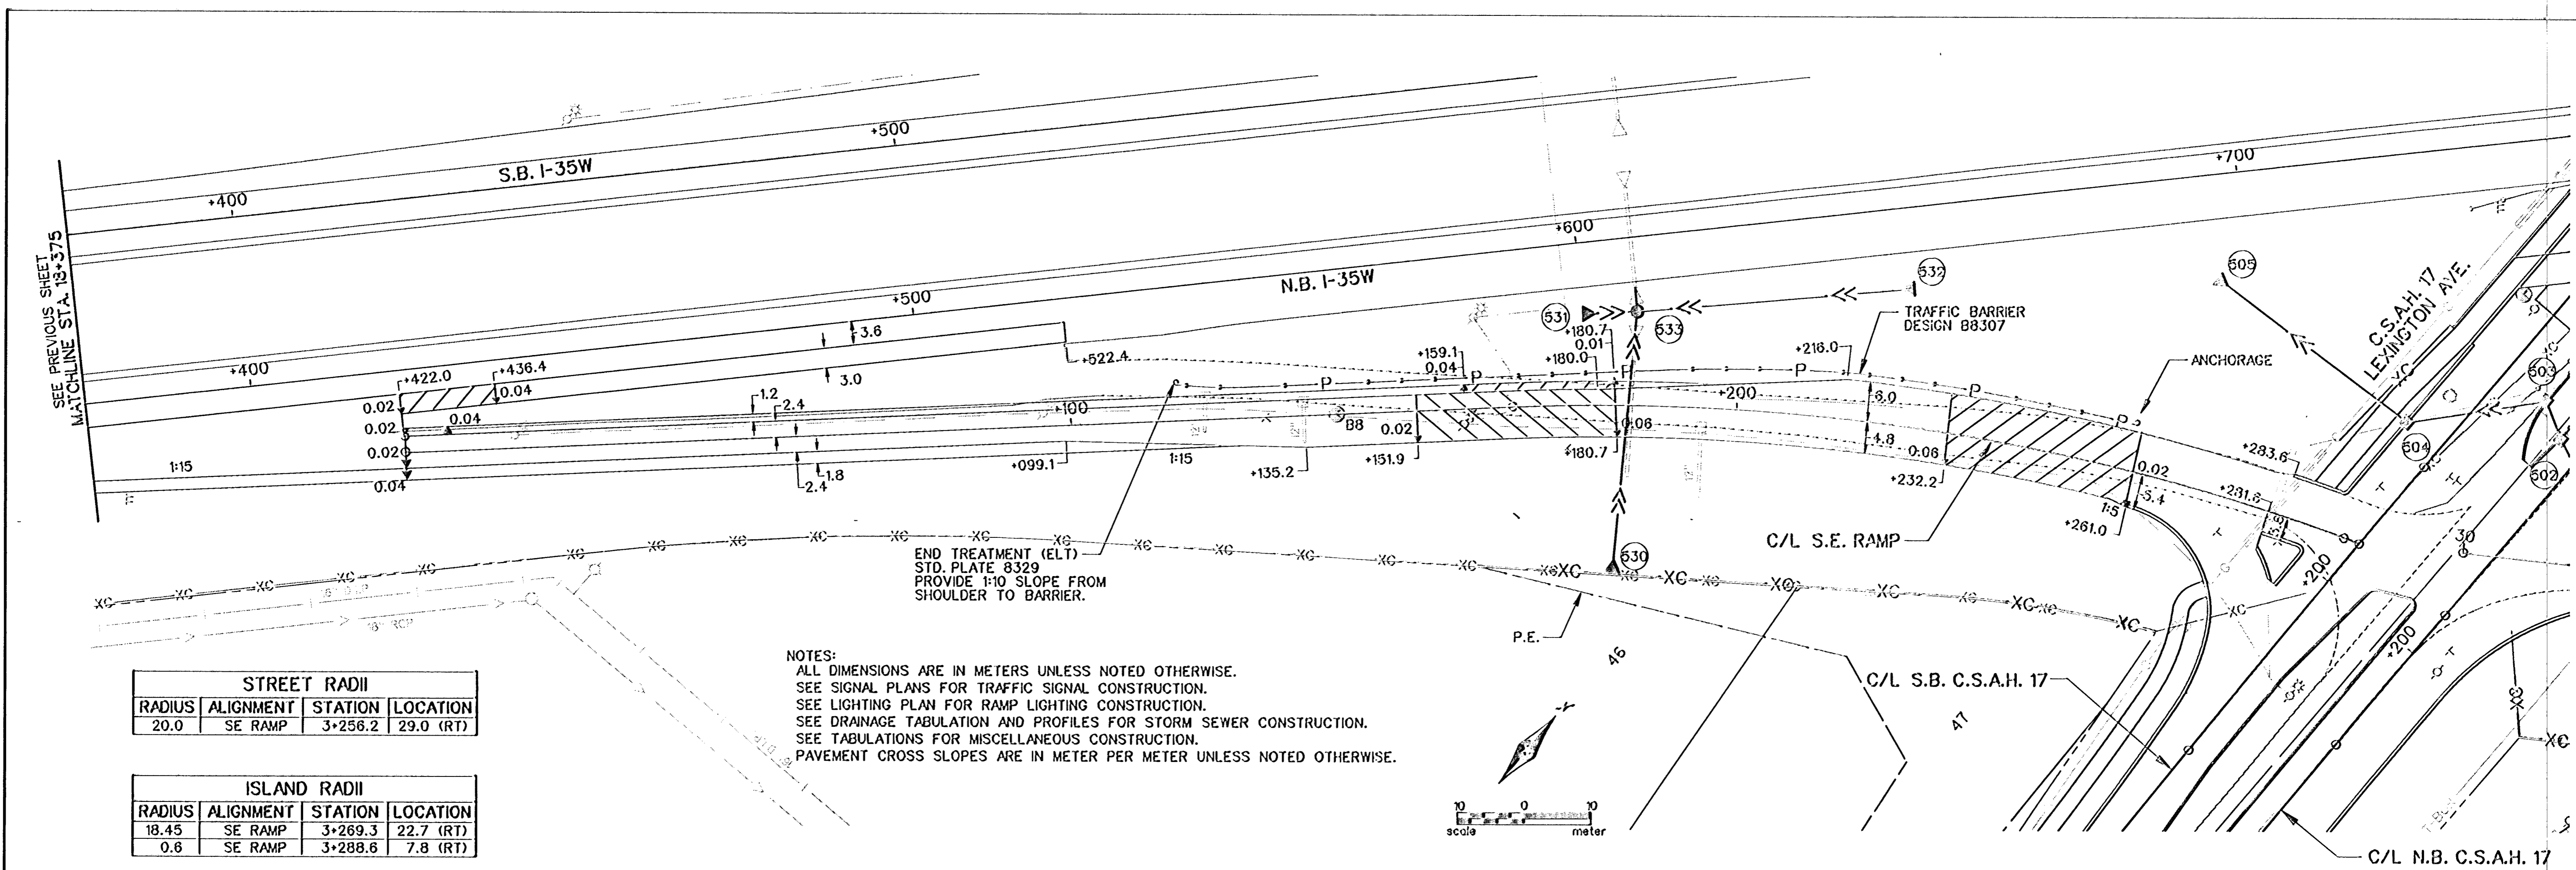

STREET RADII			
RADIUS	ALIGNMENT	STATION	LOCATION
20.0	SE RAMP	3+256.2	29.0 (RT)

ISLAND RADII			
RADIUS	ALIGNMENT	STATION	LOCATION
18.45	SE RAMP	3+269.3	22.7 (RT)
0.8	SE RAMP	3+288.6	7.8 (RT)

NOTES:
 ALL DIMENSIONS ARE IN METERS UNLESS NOTED OTHERWISE.
 SEE SIGNAL PLANS FOR TRAFFIC SIGNAL CONSTRUCTION.
 SEE LIGHTING PLAN FOR RAMP LIGHTING CONSTRUCTION.
 SEE DRAINAGE TABULATION AND PROFILES FOR STORM SEWER CONSTRUCTION.
 SEE TABULATIONS FOR MISCELLANEOUS CONSTRUCTION.
 PAVEMENT CROSS SLOPES ARE IN METER PER METER UNLESS NOTED OTHERWISE.

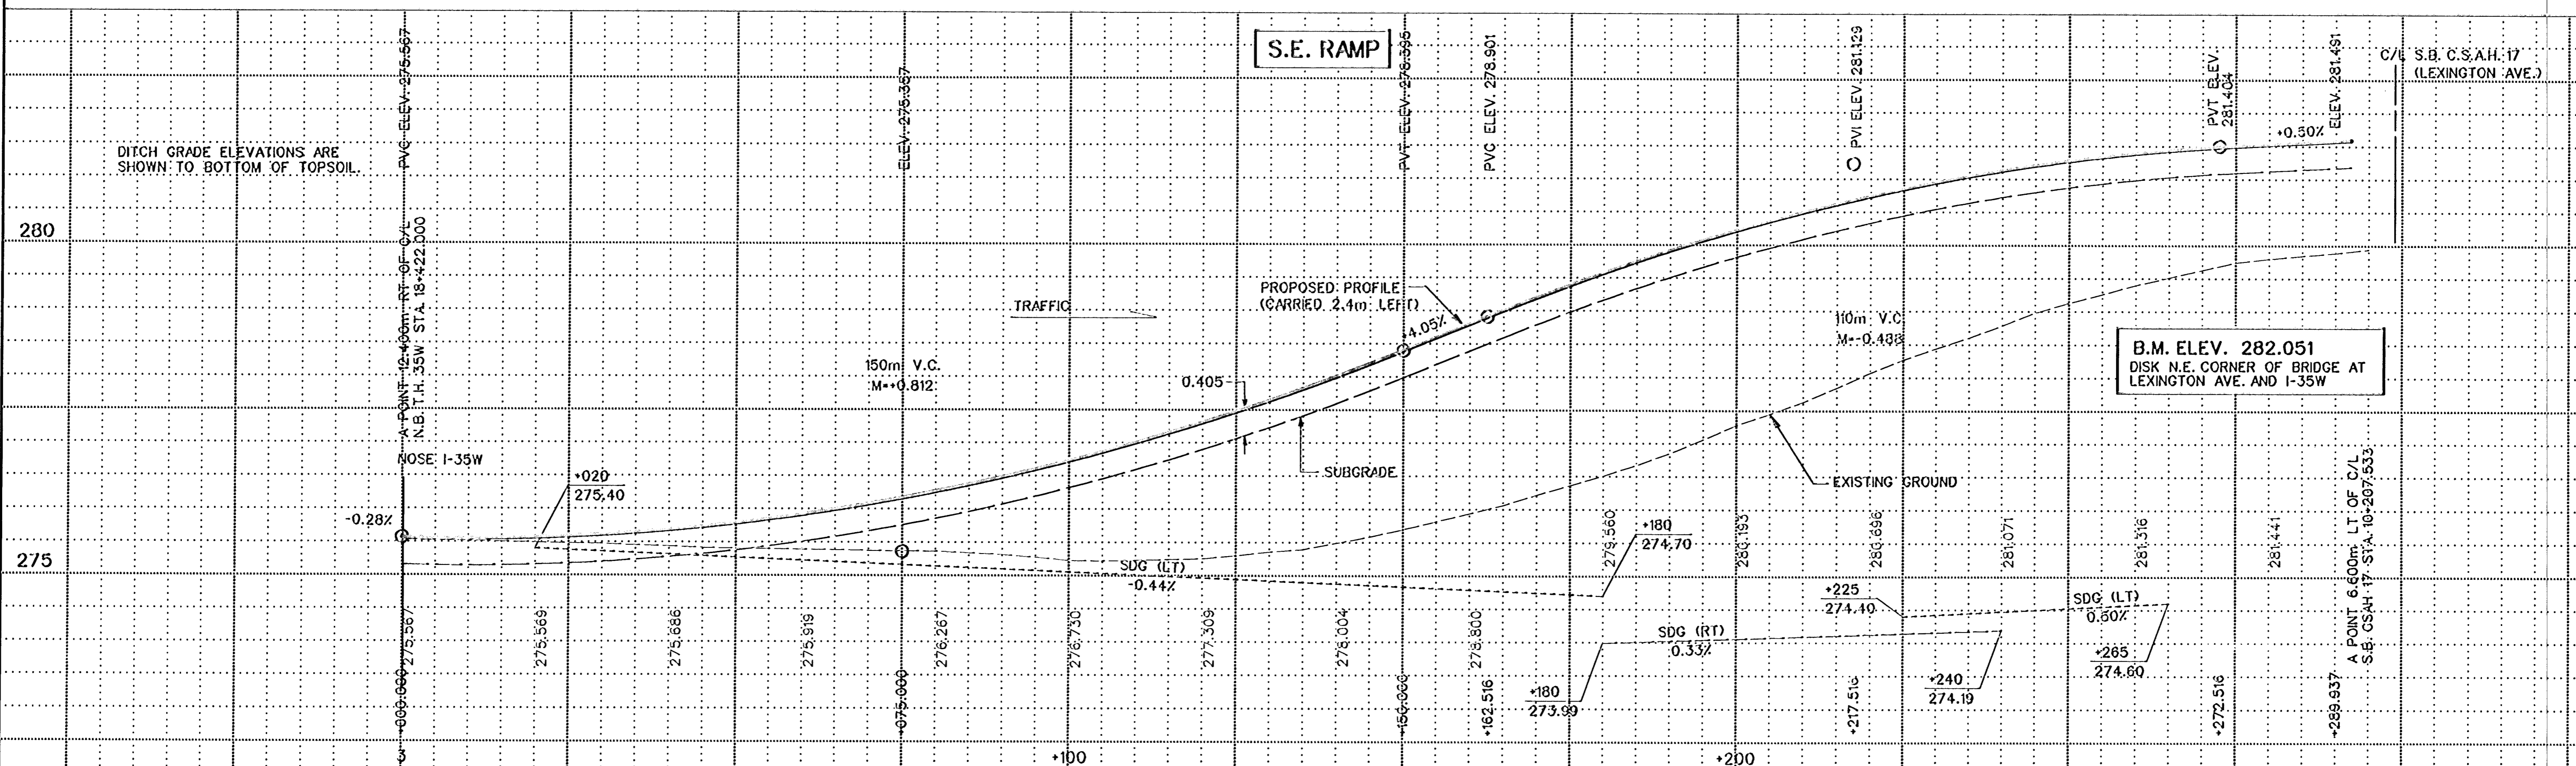

1	4-4-97	MCI	MDH	DAD	REVISE SE RAMP
NO	DATE	BY	CKD	APPR	REVISION



I hereby certify that this plan, specification or report was prepared by me or under my direct supervision and that I am a duly Registered Professional Engineer under the laws of the State of Minnesota.
Ernest A. Demers
 Date 3-21-97 Reg. No. 23377



STATE AID PROJECT NO.
 S.A.P. 02-617-11
 S.A.P. 106-020-12
 S.A.P. 106-030-03
 CO. PROJECT NO.

DRAWN BY
 V. GRAF
 DESIGNED BY
 B. URBANEK
 CHECKED BY
 D. DEMERS
 DATE
 12-98
 12-98
 1-97
 COMM. NO.
 0982410



ANOKA COUNTY
 CONSTRUCTION PLAN AND PROFILE
 C.S.A.H. 17 RECONSTRUCTION
 S.E. RAMP

SHEET 73 OF 236

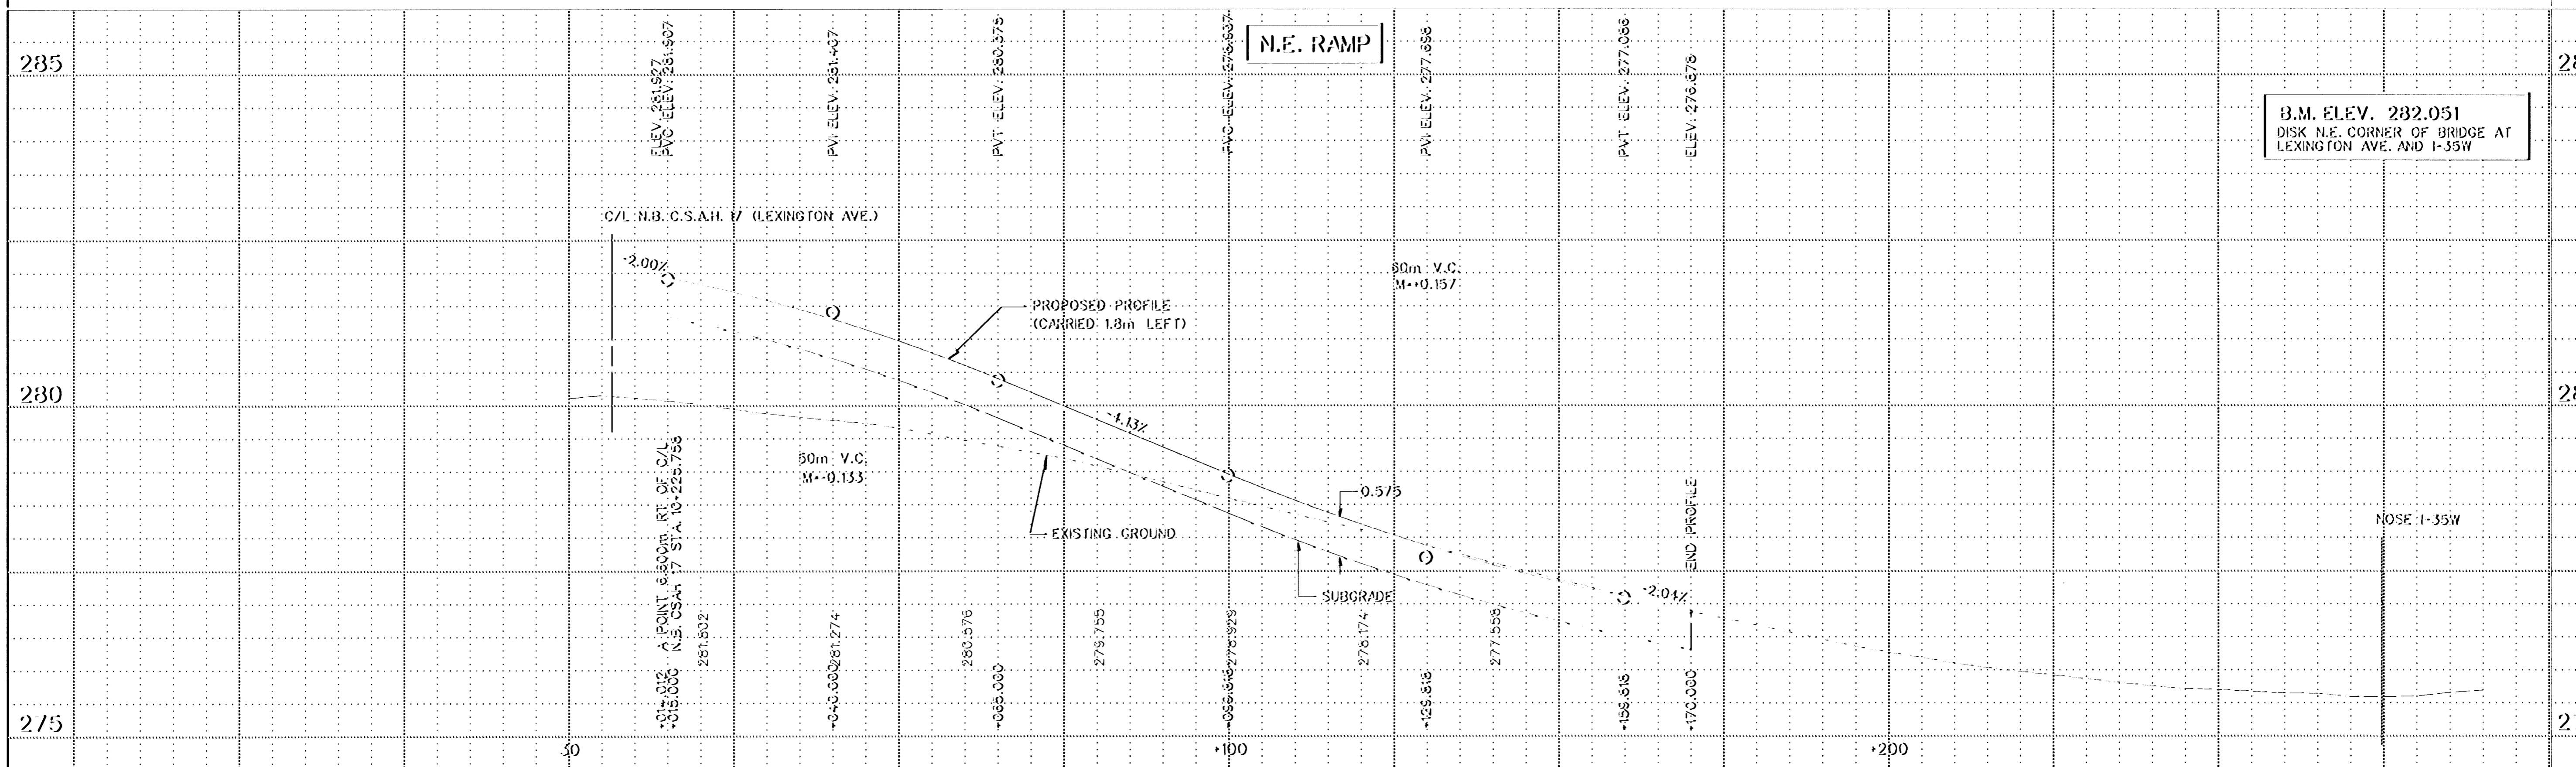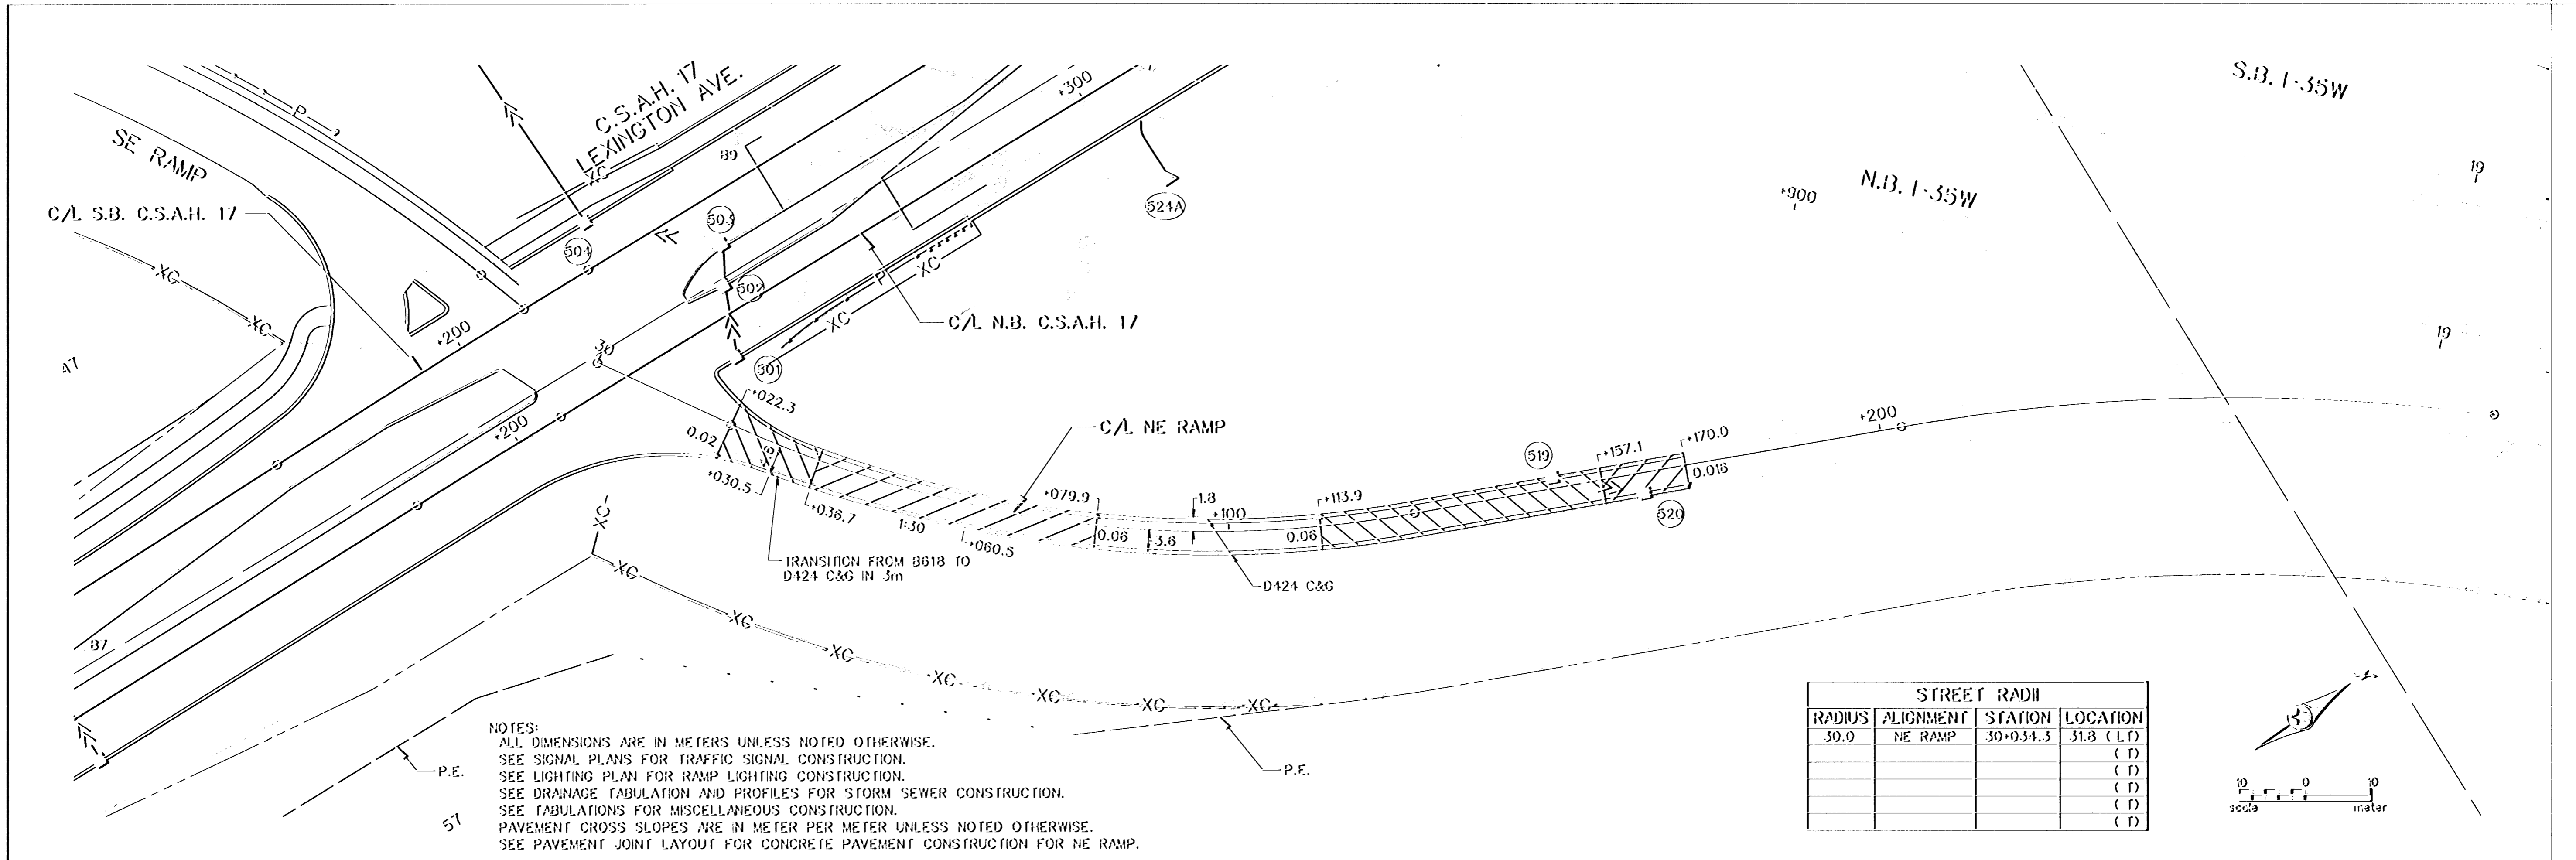

NO	DATE	BY	CHKD	APPR	REVISION

NO	DATE	BY	CHKD	APPR	REVISION




I hereby certify that this plan, specification or report was prepared by me or under my direct supervision and that I am a duly Registered Professional Engineer under the laws of the State of Minnesota.

Donald A. Demers
 Date: 3-21-97 Reg. No. 23397

STATE AID PROJECT NO.
 S.A.P. 02-617-11
 S.A.P. 108-020-12
 S.A.P. 106-030-03
 CO. PROJECT NO.


DRAWN BY V. GRAF DATE 12-96
 DESIGNED BY B. URBANEK DATE 12-96
 CHECKED BY D. DEMERS DATE 1-97
 COMM. NO. 0982410

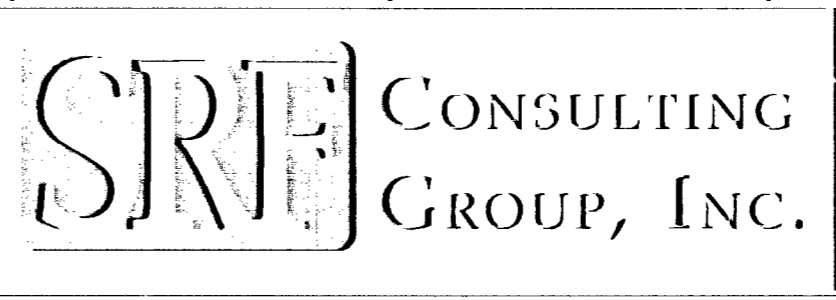

ANOKA COUNTY
 CONSTRUCTION PLAN AND PROFILE
 C.S.A.H. 17 RECONSTRUCTION
 N.E. RAMP

SHEET 74 OF 236


NOTES:
 ALL DIMENSIONS ARE IN METERS UNLESS NOTED OTHERWISE.
 SEE LIGHTING PLAN FOR RAMP LIGHTING CONSTRUCTION.
 SEE TABULATIONS FOR MISCELLANEOUS CONSTRUCTION.
 PAVEMENT CROSS SLOPES ARE IN METER PER METER UNLESS NOTED OTHERWISE.

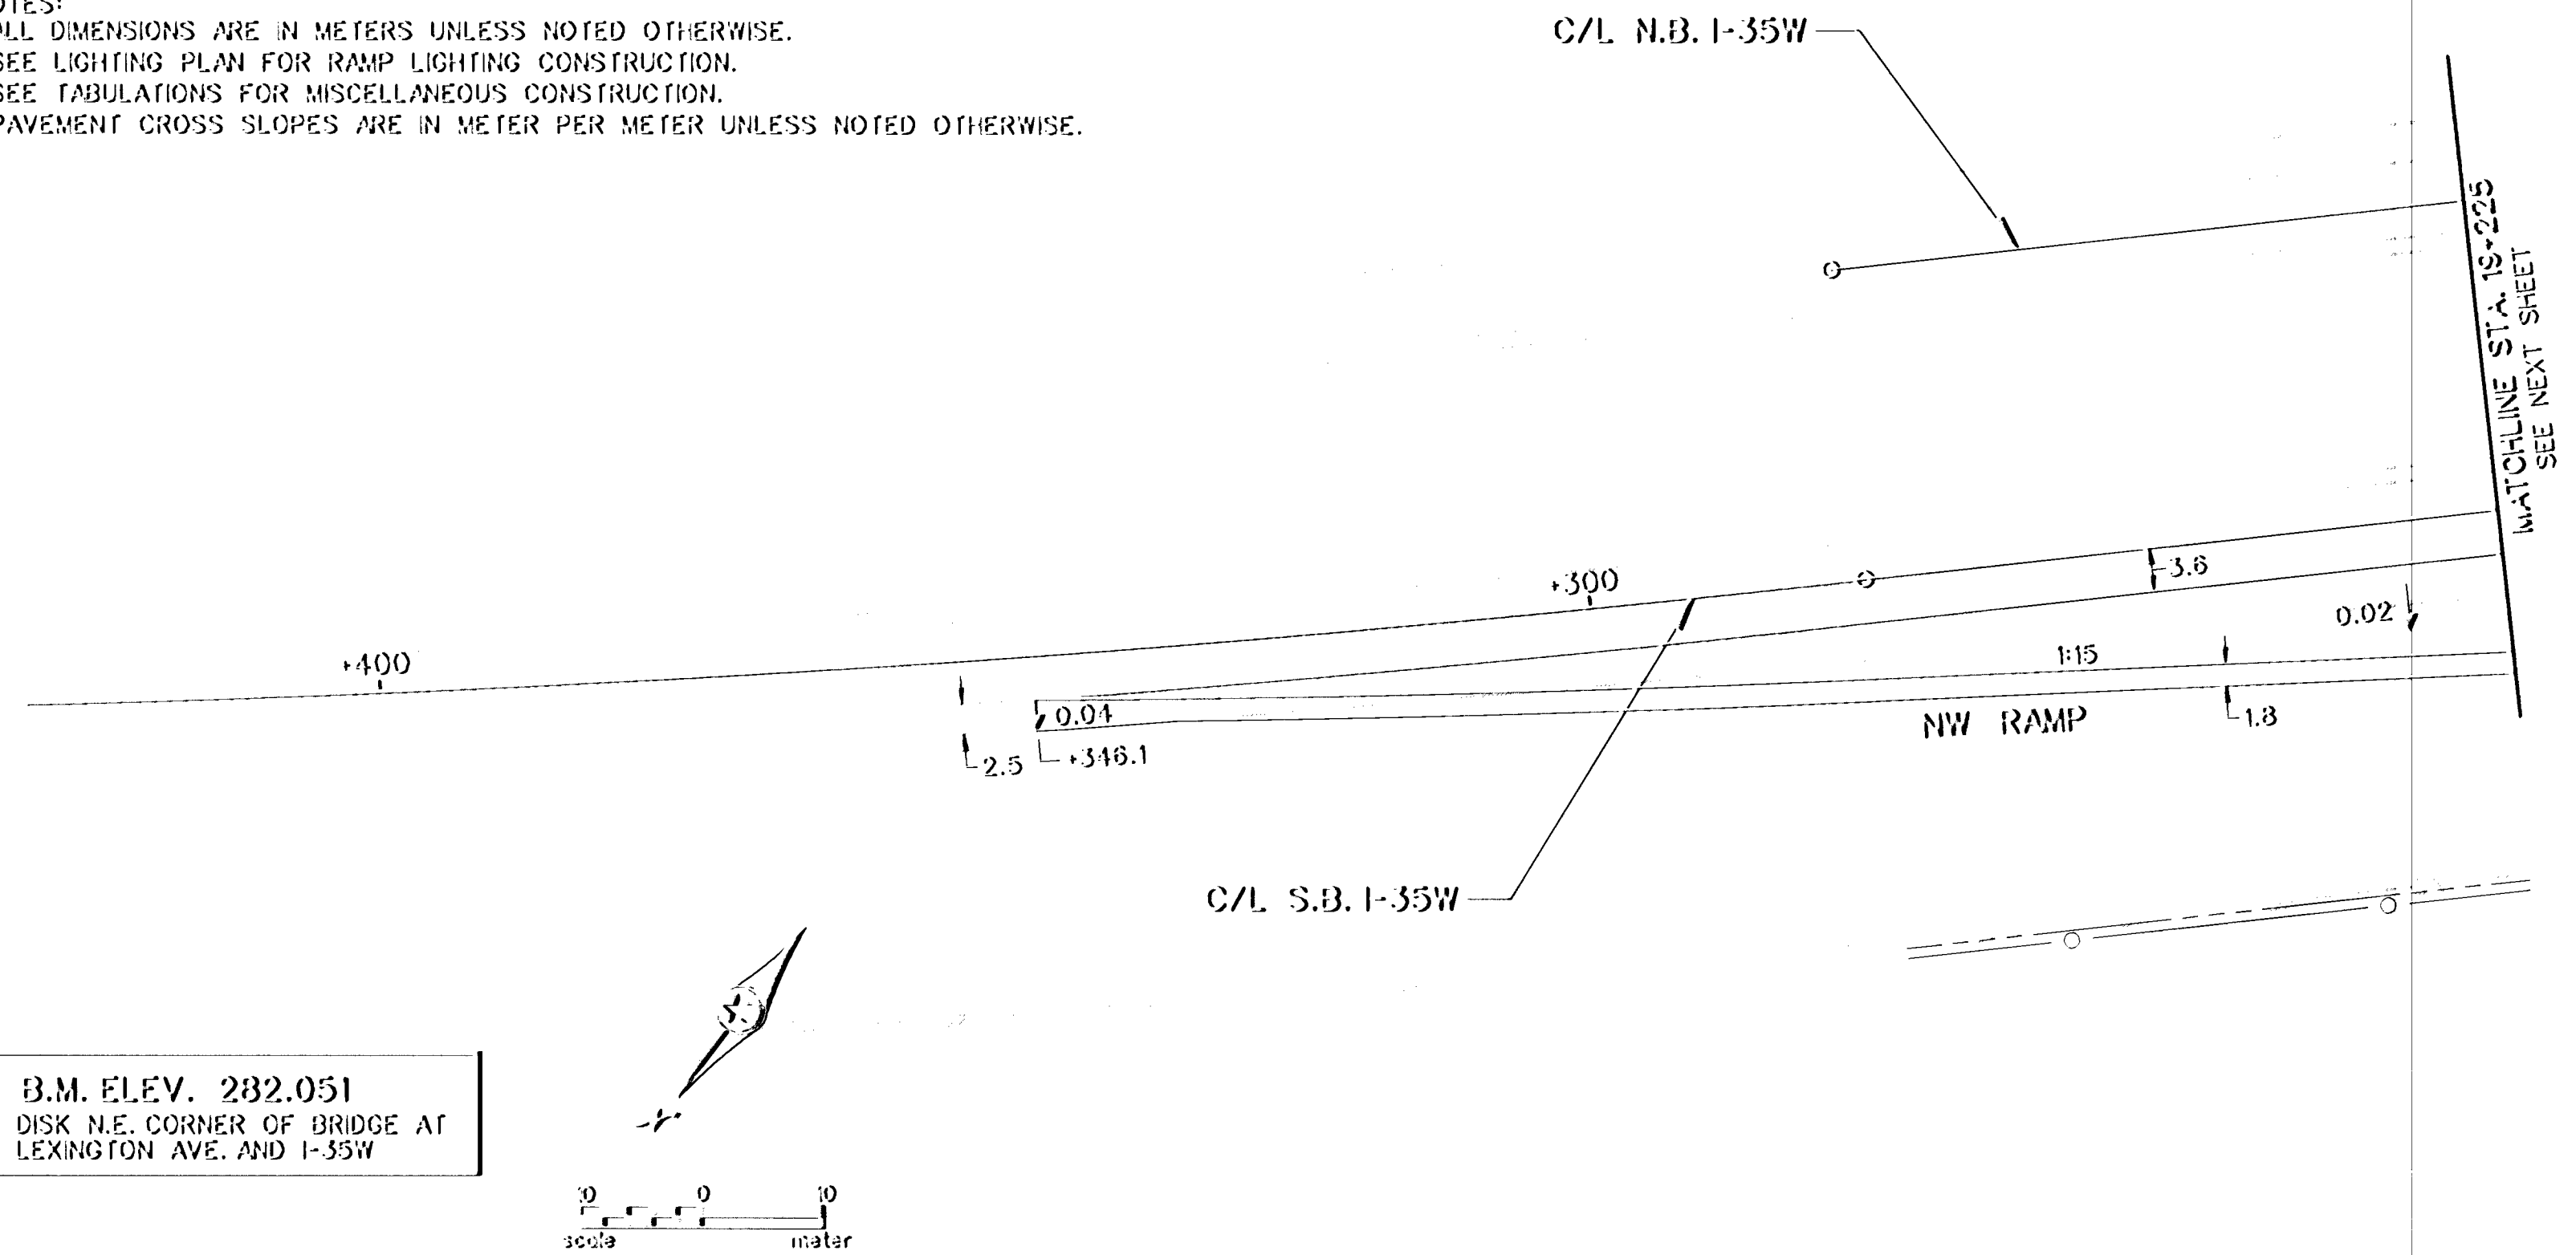

B.M. ELEV. 282.051
 DISK N.E. CORNER OF BRIDGE AT
 LEXINGTON AVE. AND I-35W

NO.	DATE	BY	CHKD	APPR	REVISION

NAME: CP11 410.PLN DATE: Mar. 18, 1997

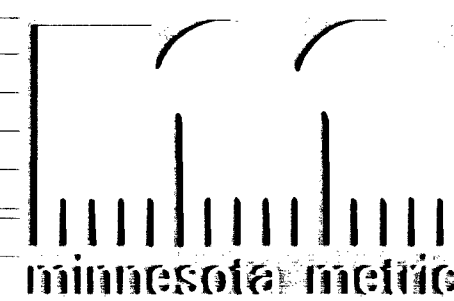

I hereby certify that this plan, specification or report was prepared by me or under my direct supervision and that I am a duly Registered Professional Engineer under the laws of the State of Minnesota.

Donald A. Demers
 Date 3-21-97 Reg. No. 23397

STATE AID PROJECT NO.
 S.A.P. 02-617-11
 S.A.P. 106-020-12
 S.A.P. 106-030-03


CO. PROJECT NO.

DRAWN BY V. GRAF DATE 12-96
 DESIGNED BY B. URBANEK 12-96
 CHECKED BY D. DEMERS 1-97
 COMM. NO. 0982410



ANOKA COUNTY
 CONSTRUCTION PLAN AND PROFILE
 C.S.A.H. 17 RECONSTRUCTION
 N.W. RAMP


SHEET
 75
 OF
 256

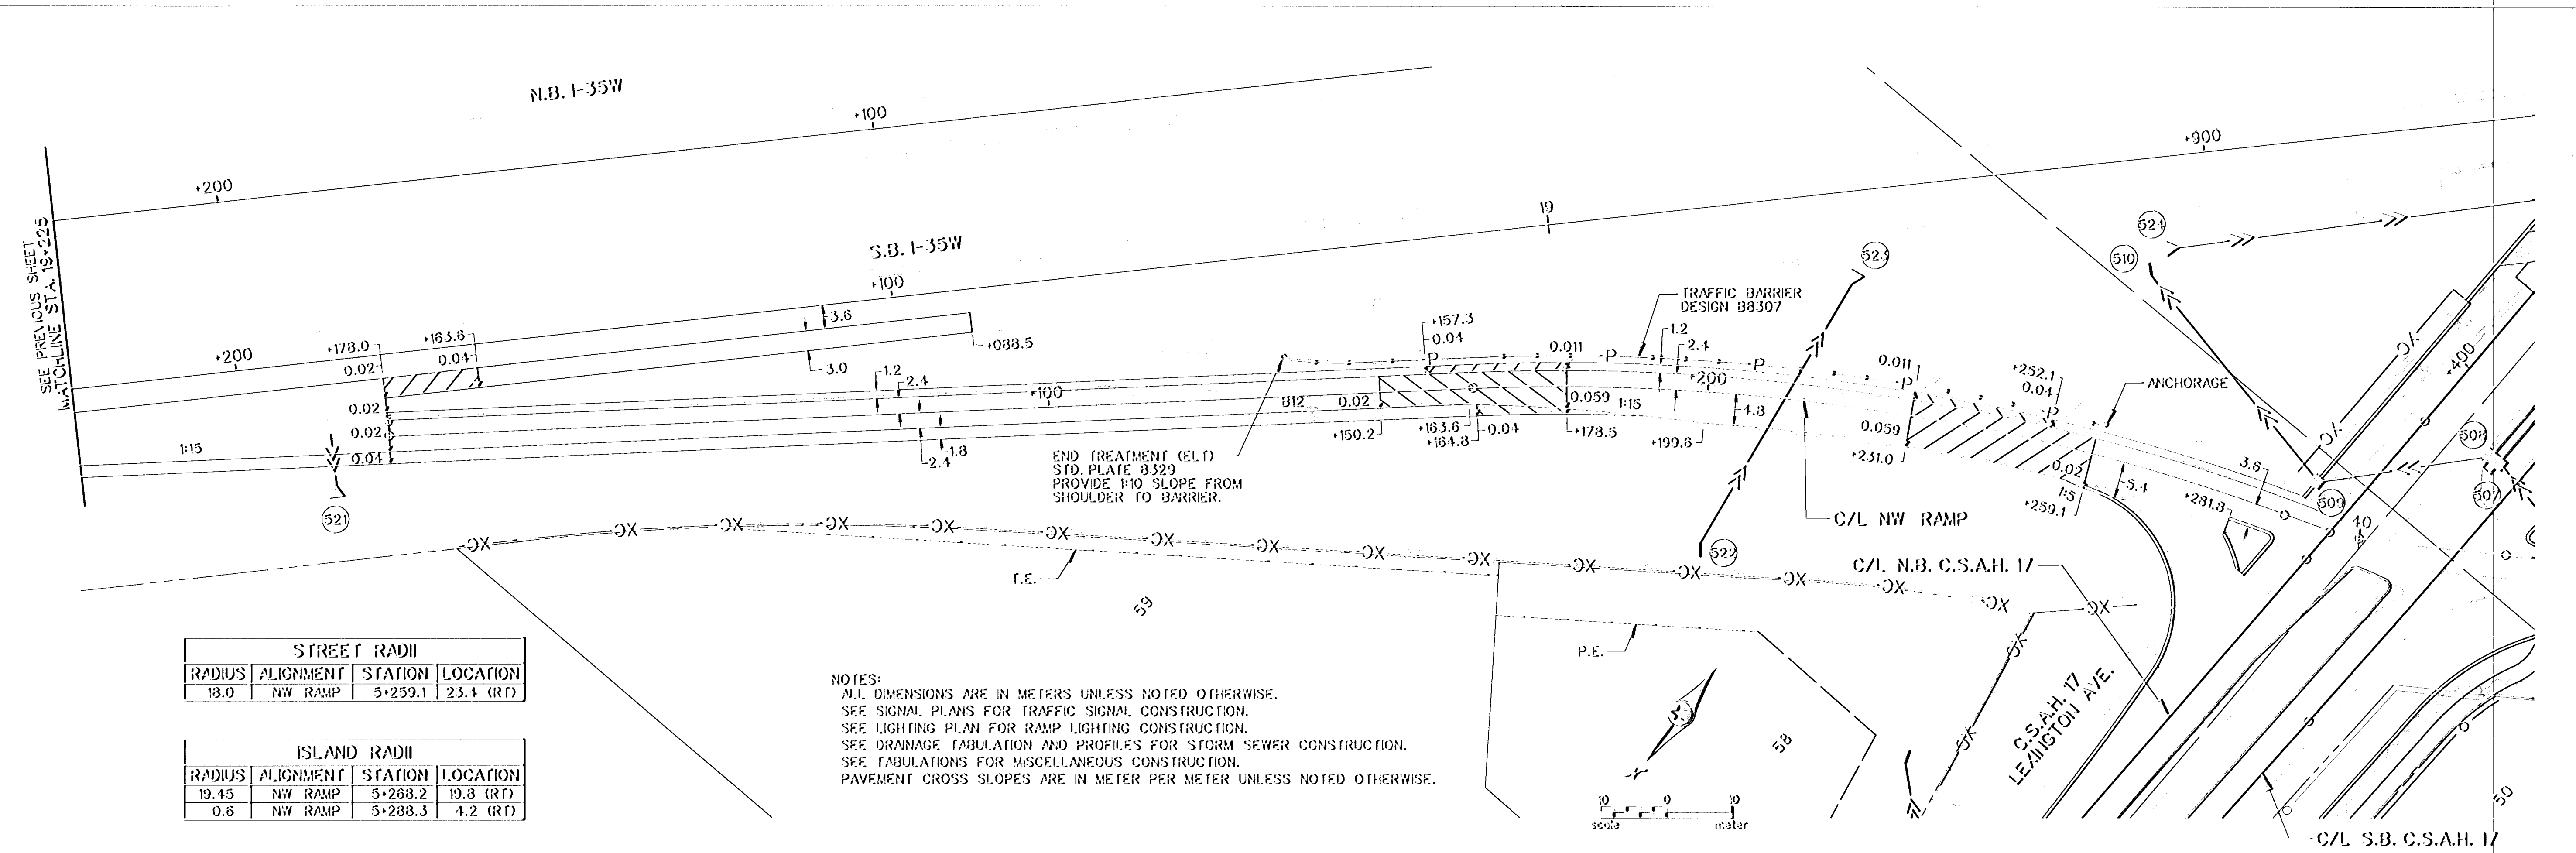

STREET RADII			
RADIUS	ALIGNMENT	STATION	LOCATION
13.0	NW RAMP	5+259.1	23.4 (RT)


ISLAND RADII			
RADIUS	ALIGNMENT	STATION	LOCATION
19.45	NW RAMP	5+288.2	19.8 (RT)
0.6	NW RAMP	5+288.3	4.2 (RT)

NOTES:
 ALL DIMENSIONS ARE IN METERS UNLESS NOTED OTHERWISE.
 SEE SIGNAL PLANS FOR TRAFFIC SIGNAL CONSTRUCTION.
 SEE LIGHTING PLAN FOR RAMP LIGHTING CONSTRUCTION.
 SEE DRAINAGE TABULATION AND PROFILES FOR STORM SEWER CONSTRUCTION.
 SEE TABULATIONS FOR MISCELLANEOUS CONSTRUCTION.
 PAVEMENT CROSS SLOPES ARE IN METER PER METER UNLESS NOTED OTHERWISE.

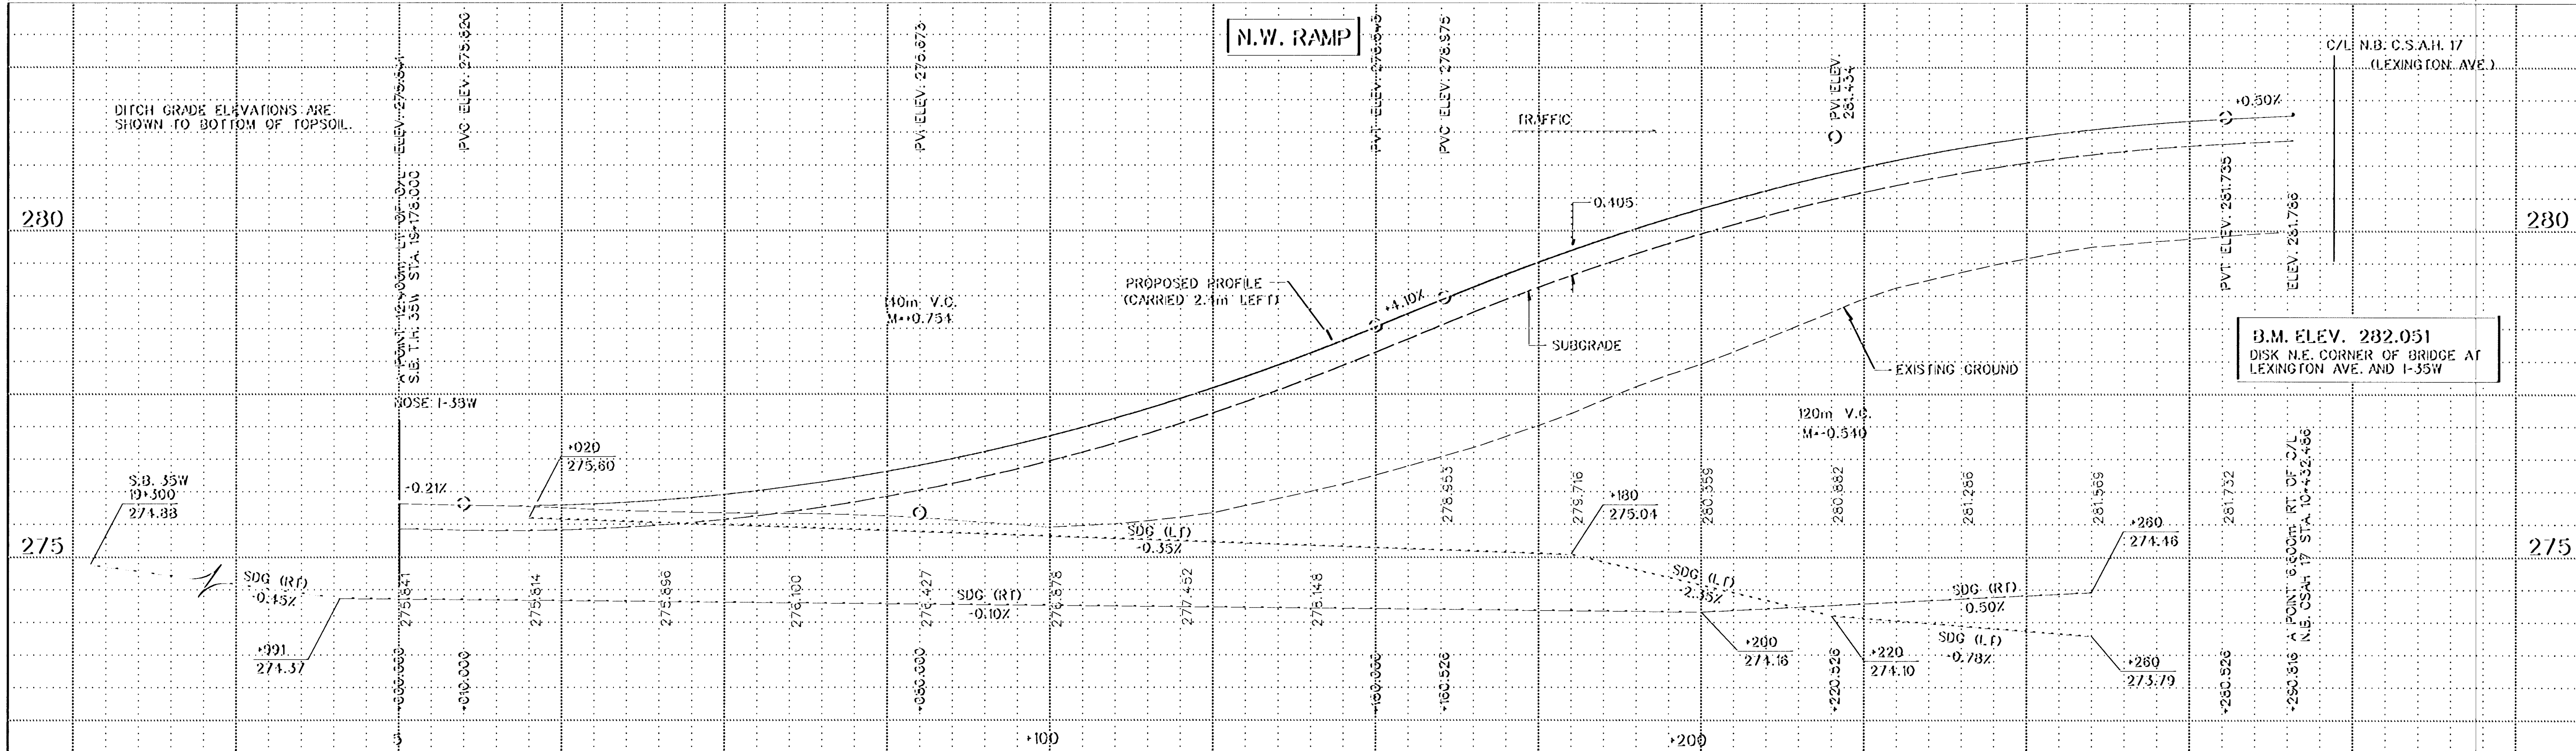

NO	DATE	BY	CKD	APPR	REVISION

NAME: CP12 410.PLN DATE: Mar. 18, 1997

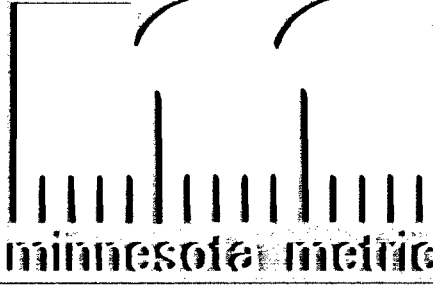

I hereby certify that this plan, specification or report was prepared by me or under my direct supervision and that I am a duly Registered Professional Engineer under the laws of the State of Minnesota.
Donald A. Demers
 Date 3-21-97 Reg. No. 23377



STATE AID PROJECT NO.
 S.A.P. 02-617-11
 S.A.P. 106-020-12
 S.A.P. 106-030-03
 CO. PROJECT NO.

DRAWN BY V. GRAF DATE 12-98
 DESIGNED BY B. URBANEK 12-98
 CHECKED BY D. DEMERS 1-97
 COMM. NO. 0982410



ANOKA COUNTY
 CONSTRUCTION PLAN AND PROFILE
 C.S.A.H. 17 RECONSTRUCTION
 N.W. RAMP

SHEET 76 OF 236

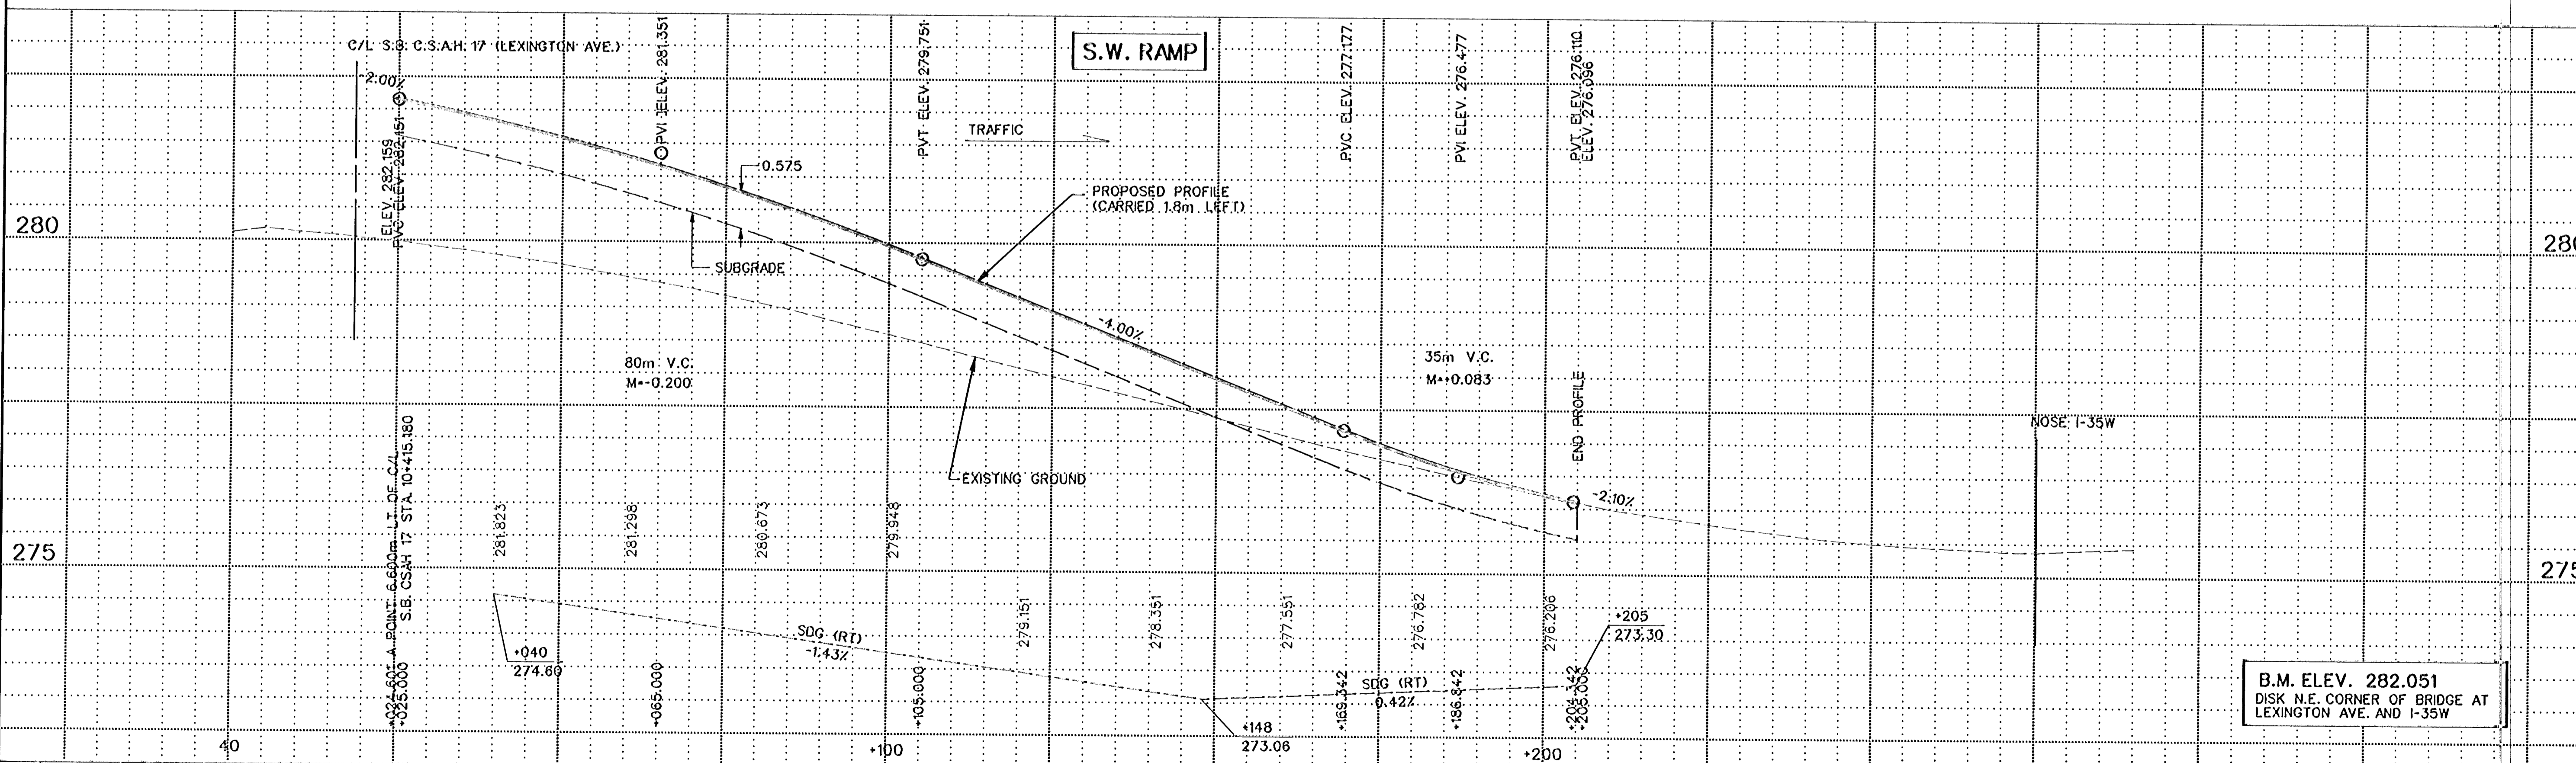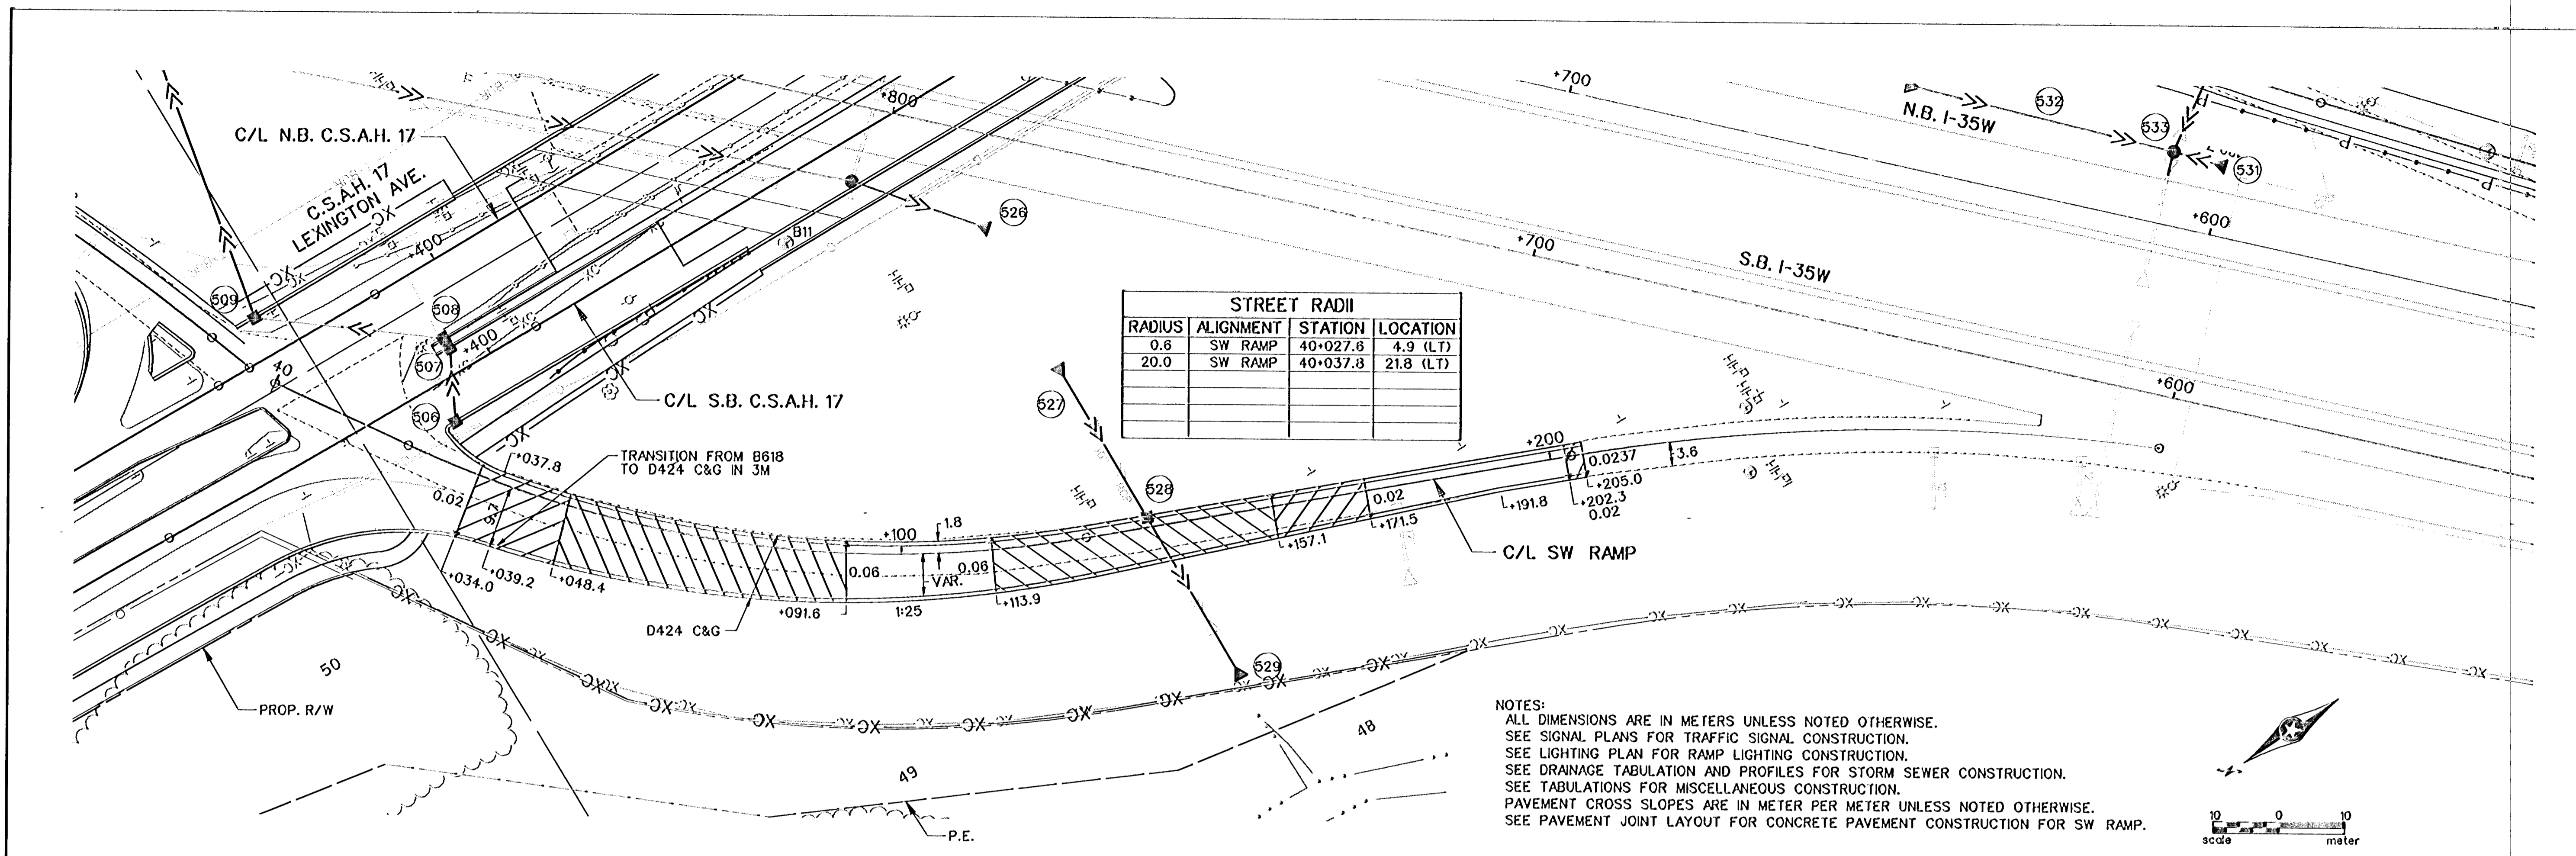

NO	DATE	BY	CHKD	APPR	REVISION
1	4-4-97	MCI	MCI	DAD	REVISE SW RAMP RADII

Minnesota Metric

I hereby certify that this plan, specification or report was prepared by me or under my direct supervision and that I am a duly Registered Professional Engineer under the laws of the State of Minnesota.

Donald A. Jones
 Date: 3-21-97 Reg. No. 23377







STATE AID PROJECT NO.
 S.A.P. 02-617-11
 S.A.P. 106-020-12
 S.A.P. 106-030-03
 CO. PROJECT NO.

DRAWN BY V. GRAF DATE 12-96
 DESIGNED BY B. URBANEK 12-96
 CHECKED BY D. DEMERS 1-97
 COMM. NO. 0962410

SRE CONSULTING GROUP, INC.

ANOKA COUNTY
 CONSTRUCTION PLAN AND PROFILE
 C.S.A.H. 17 RECONSTRUCTION
 S.W. RAMP

SHEET 77 OF 236

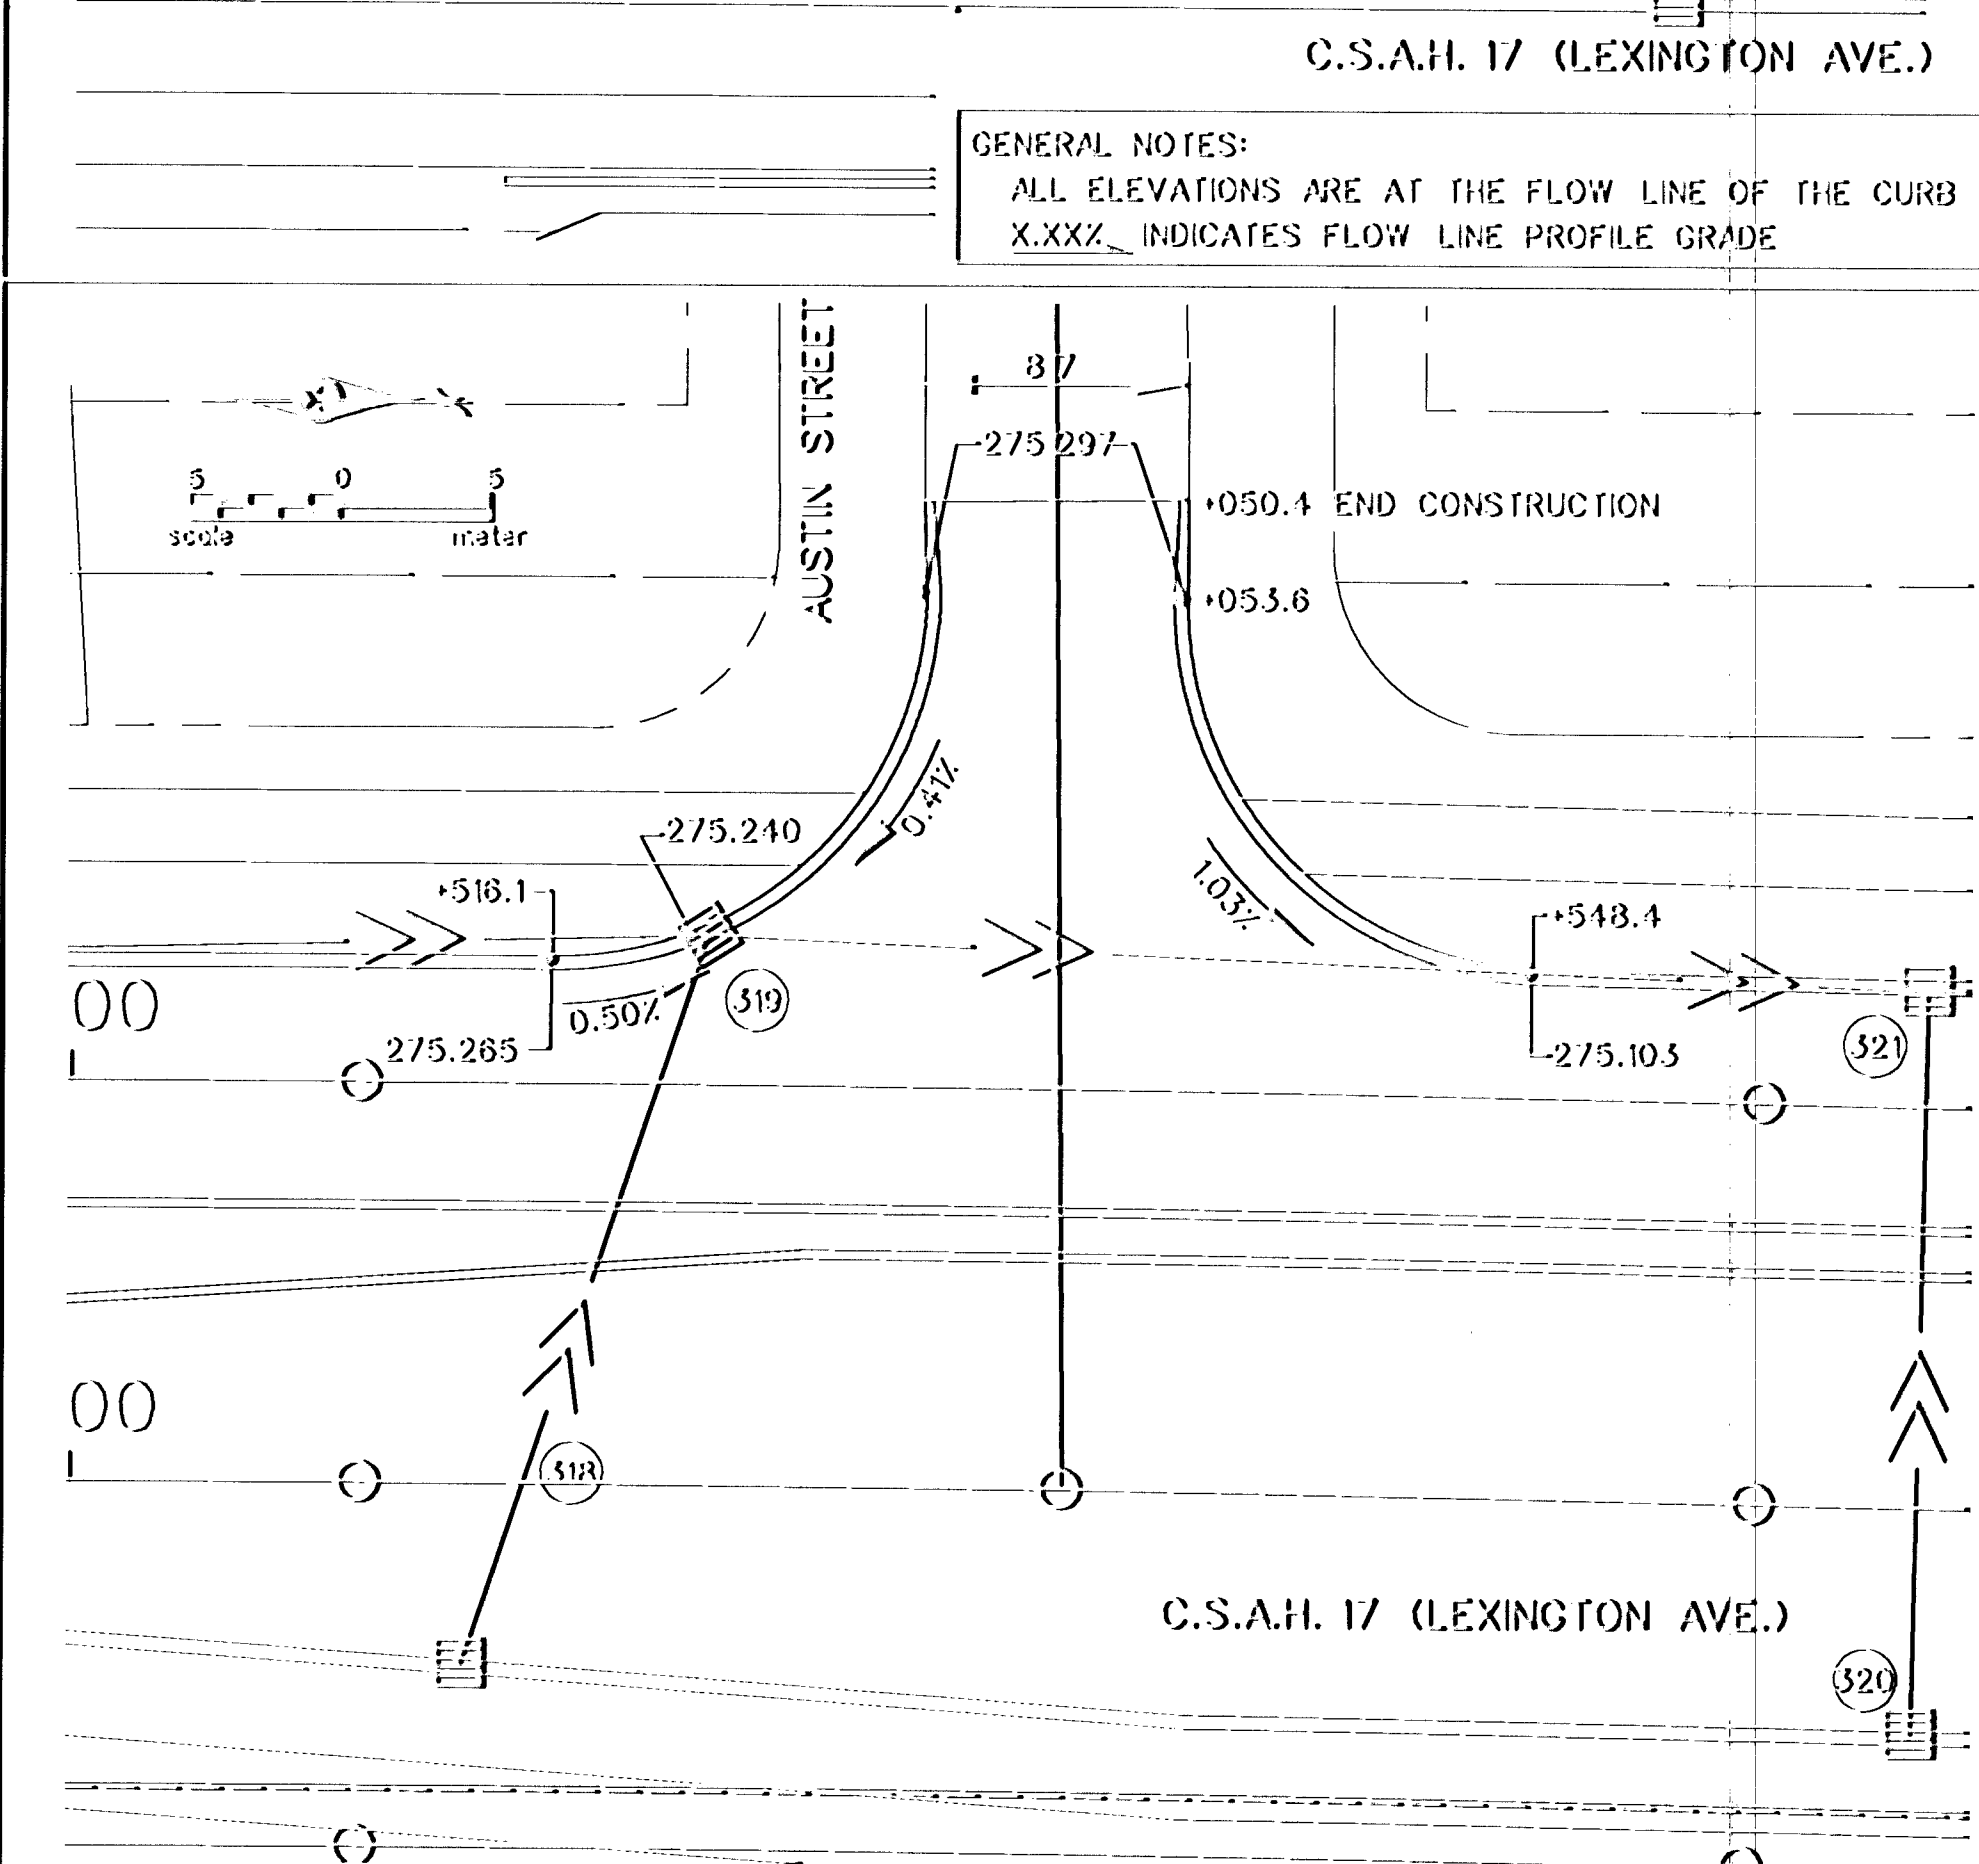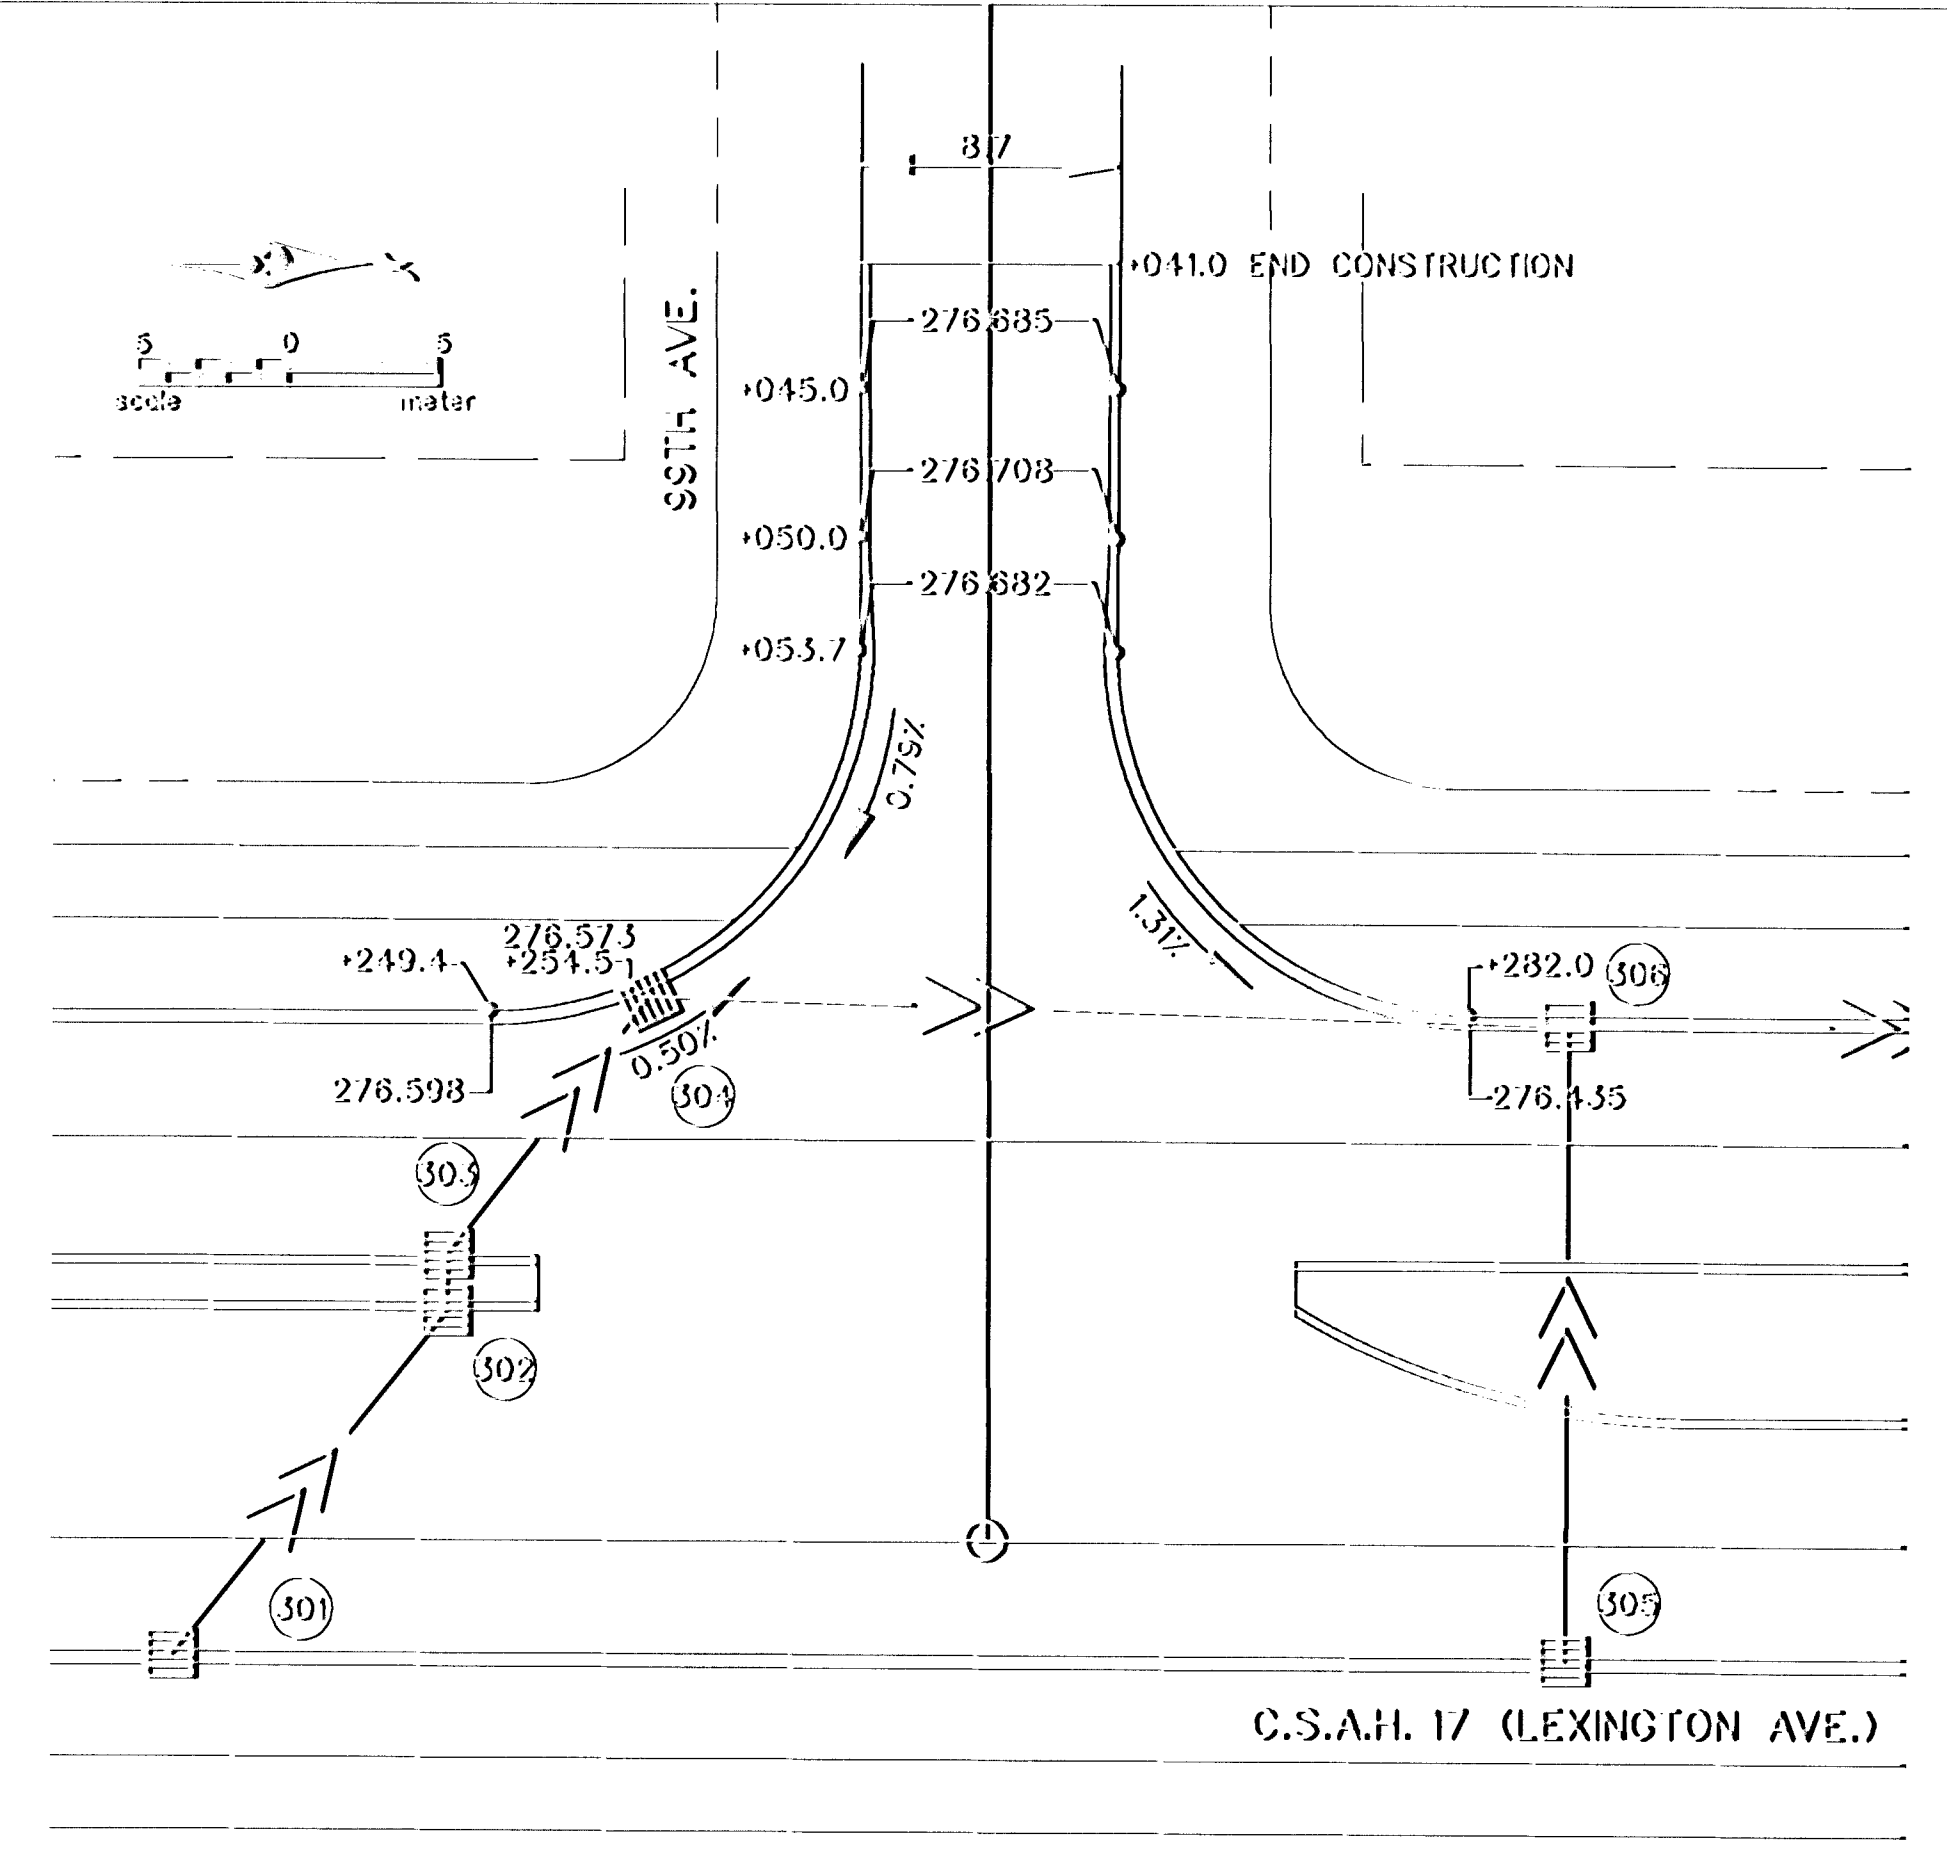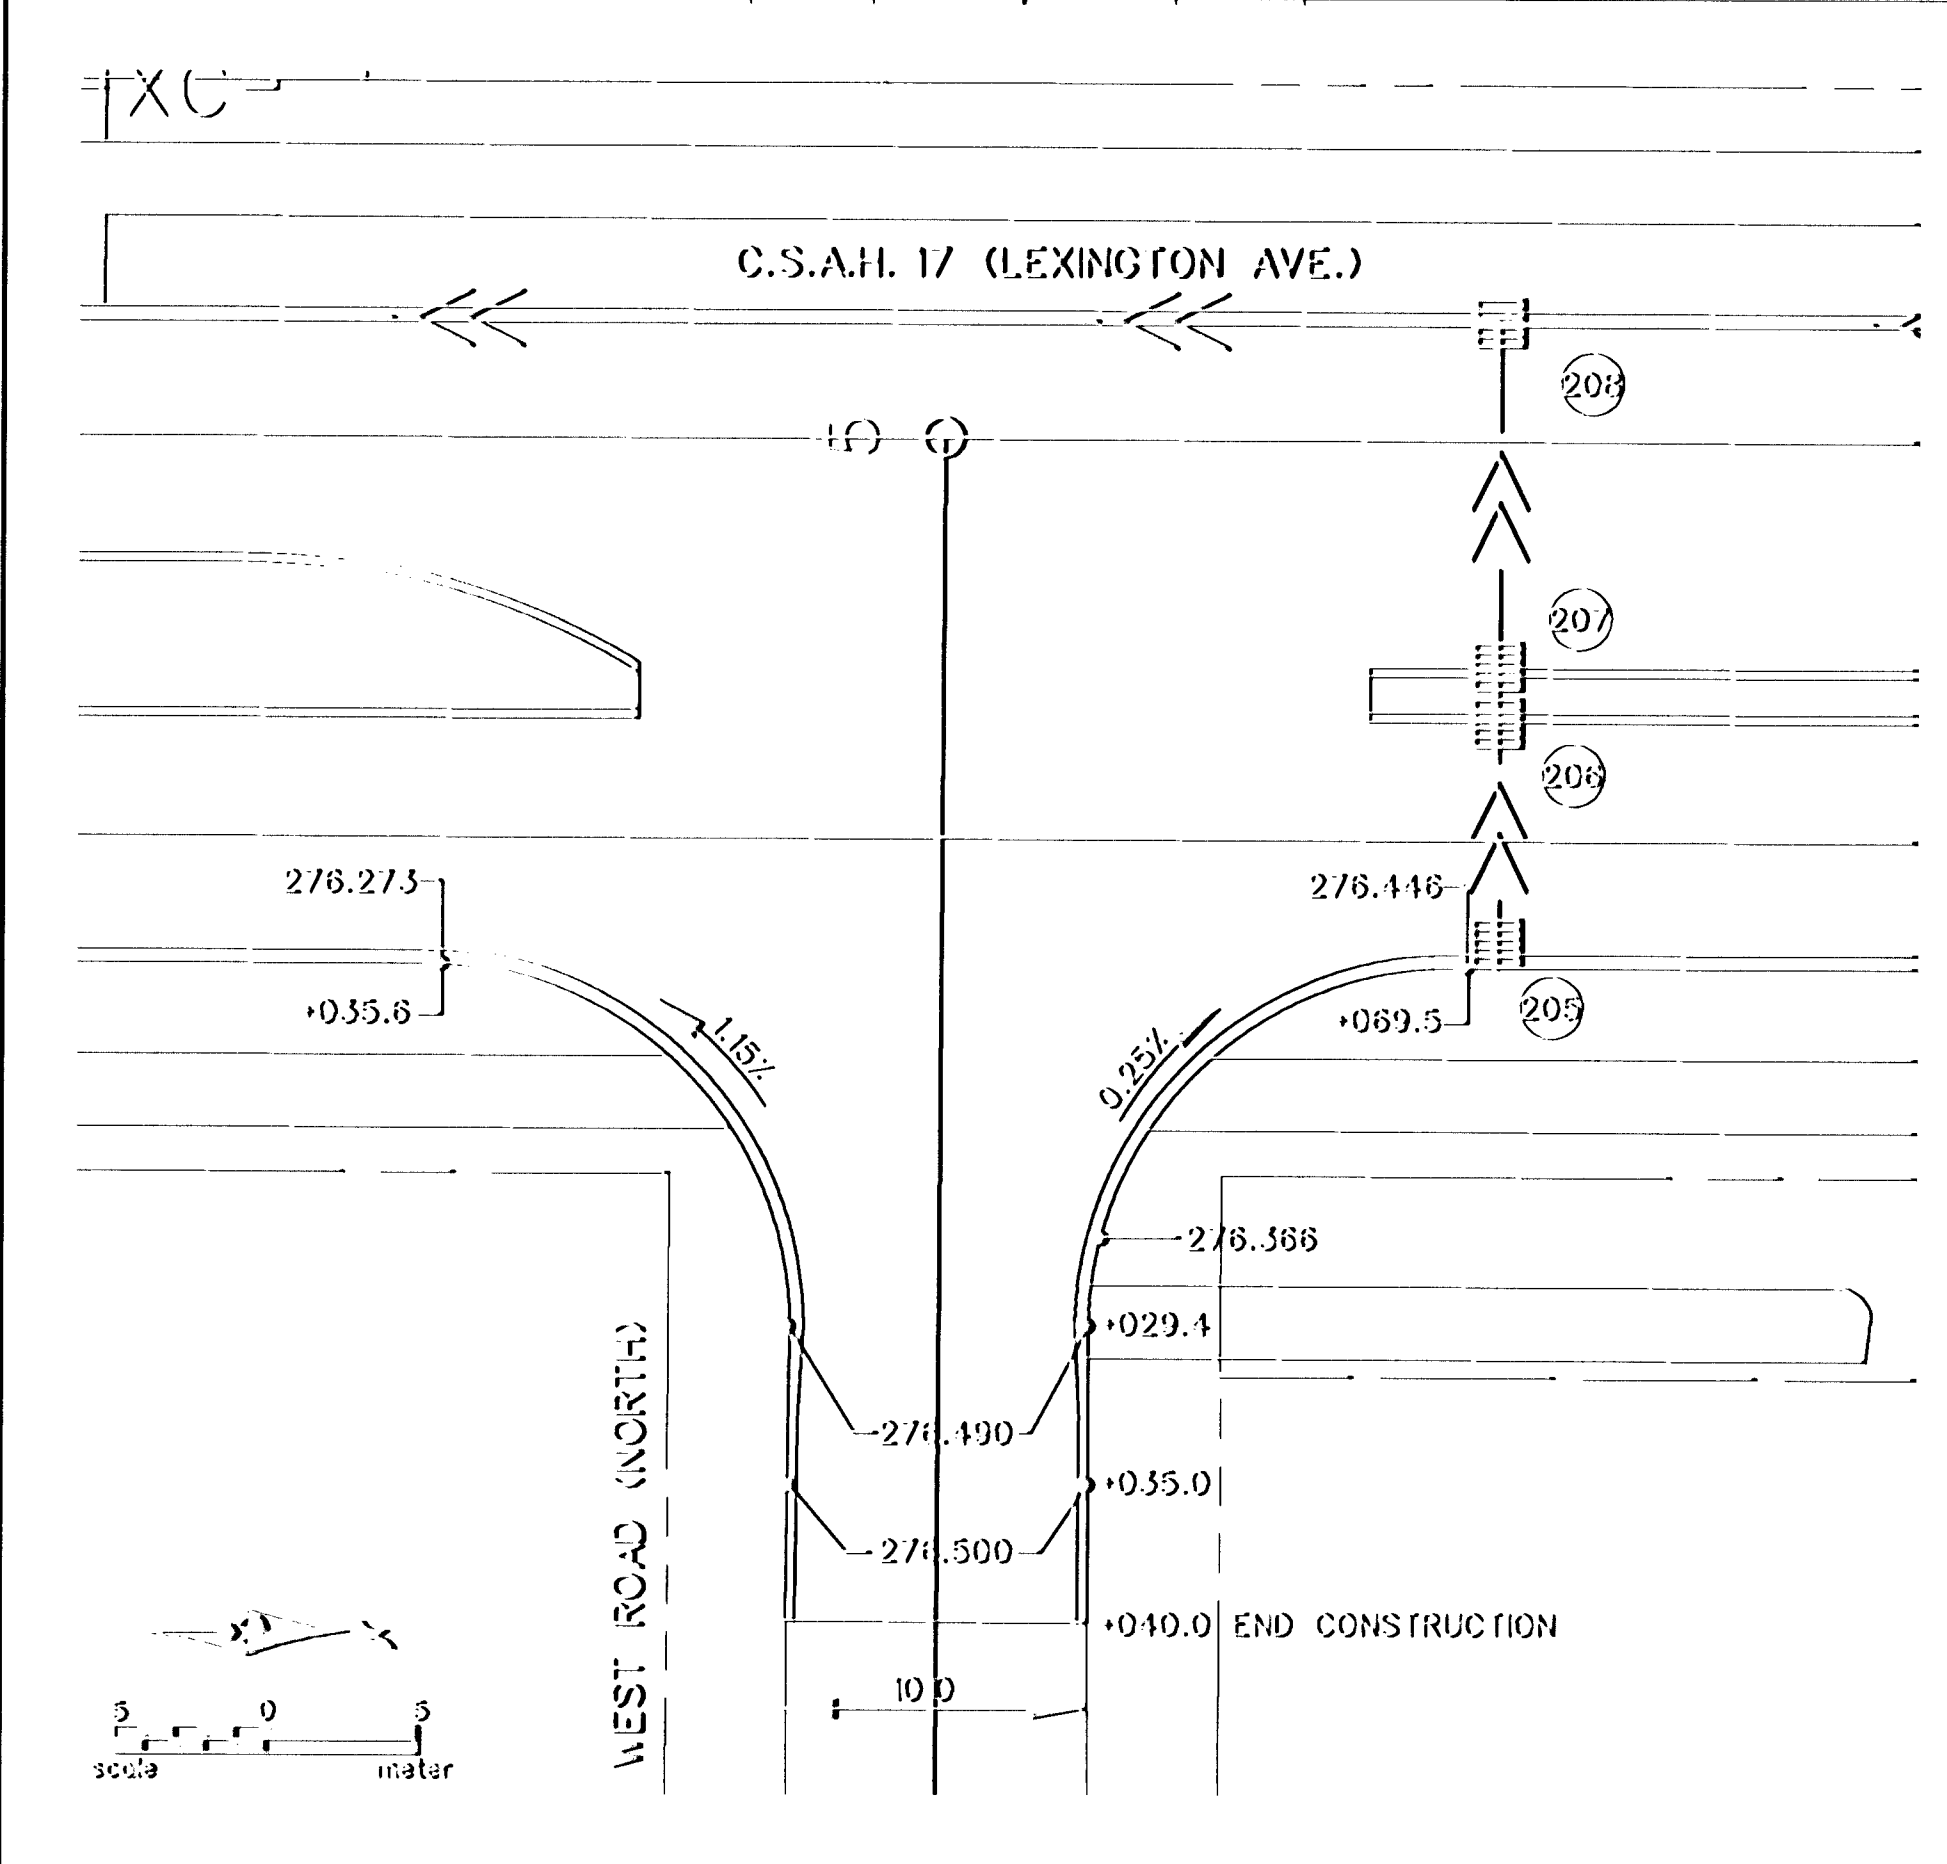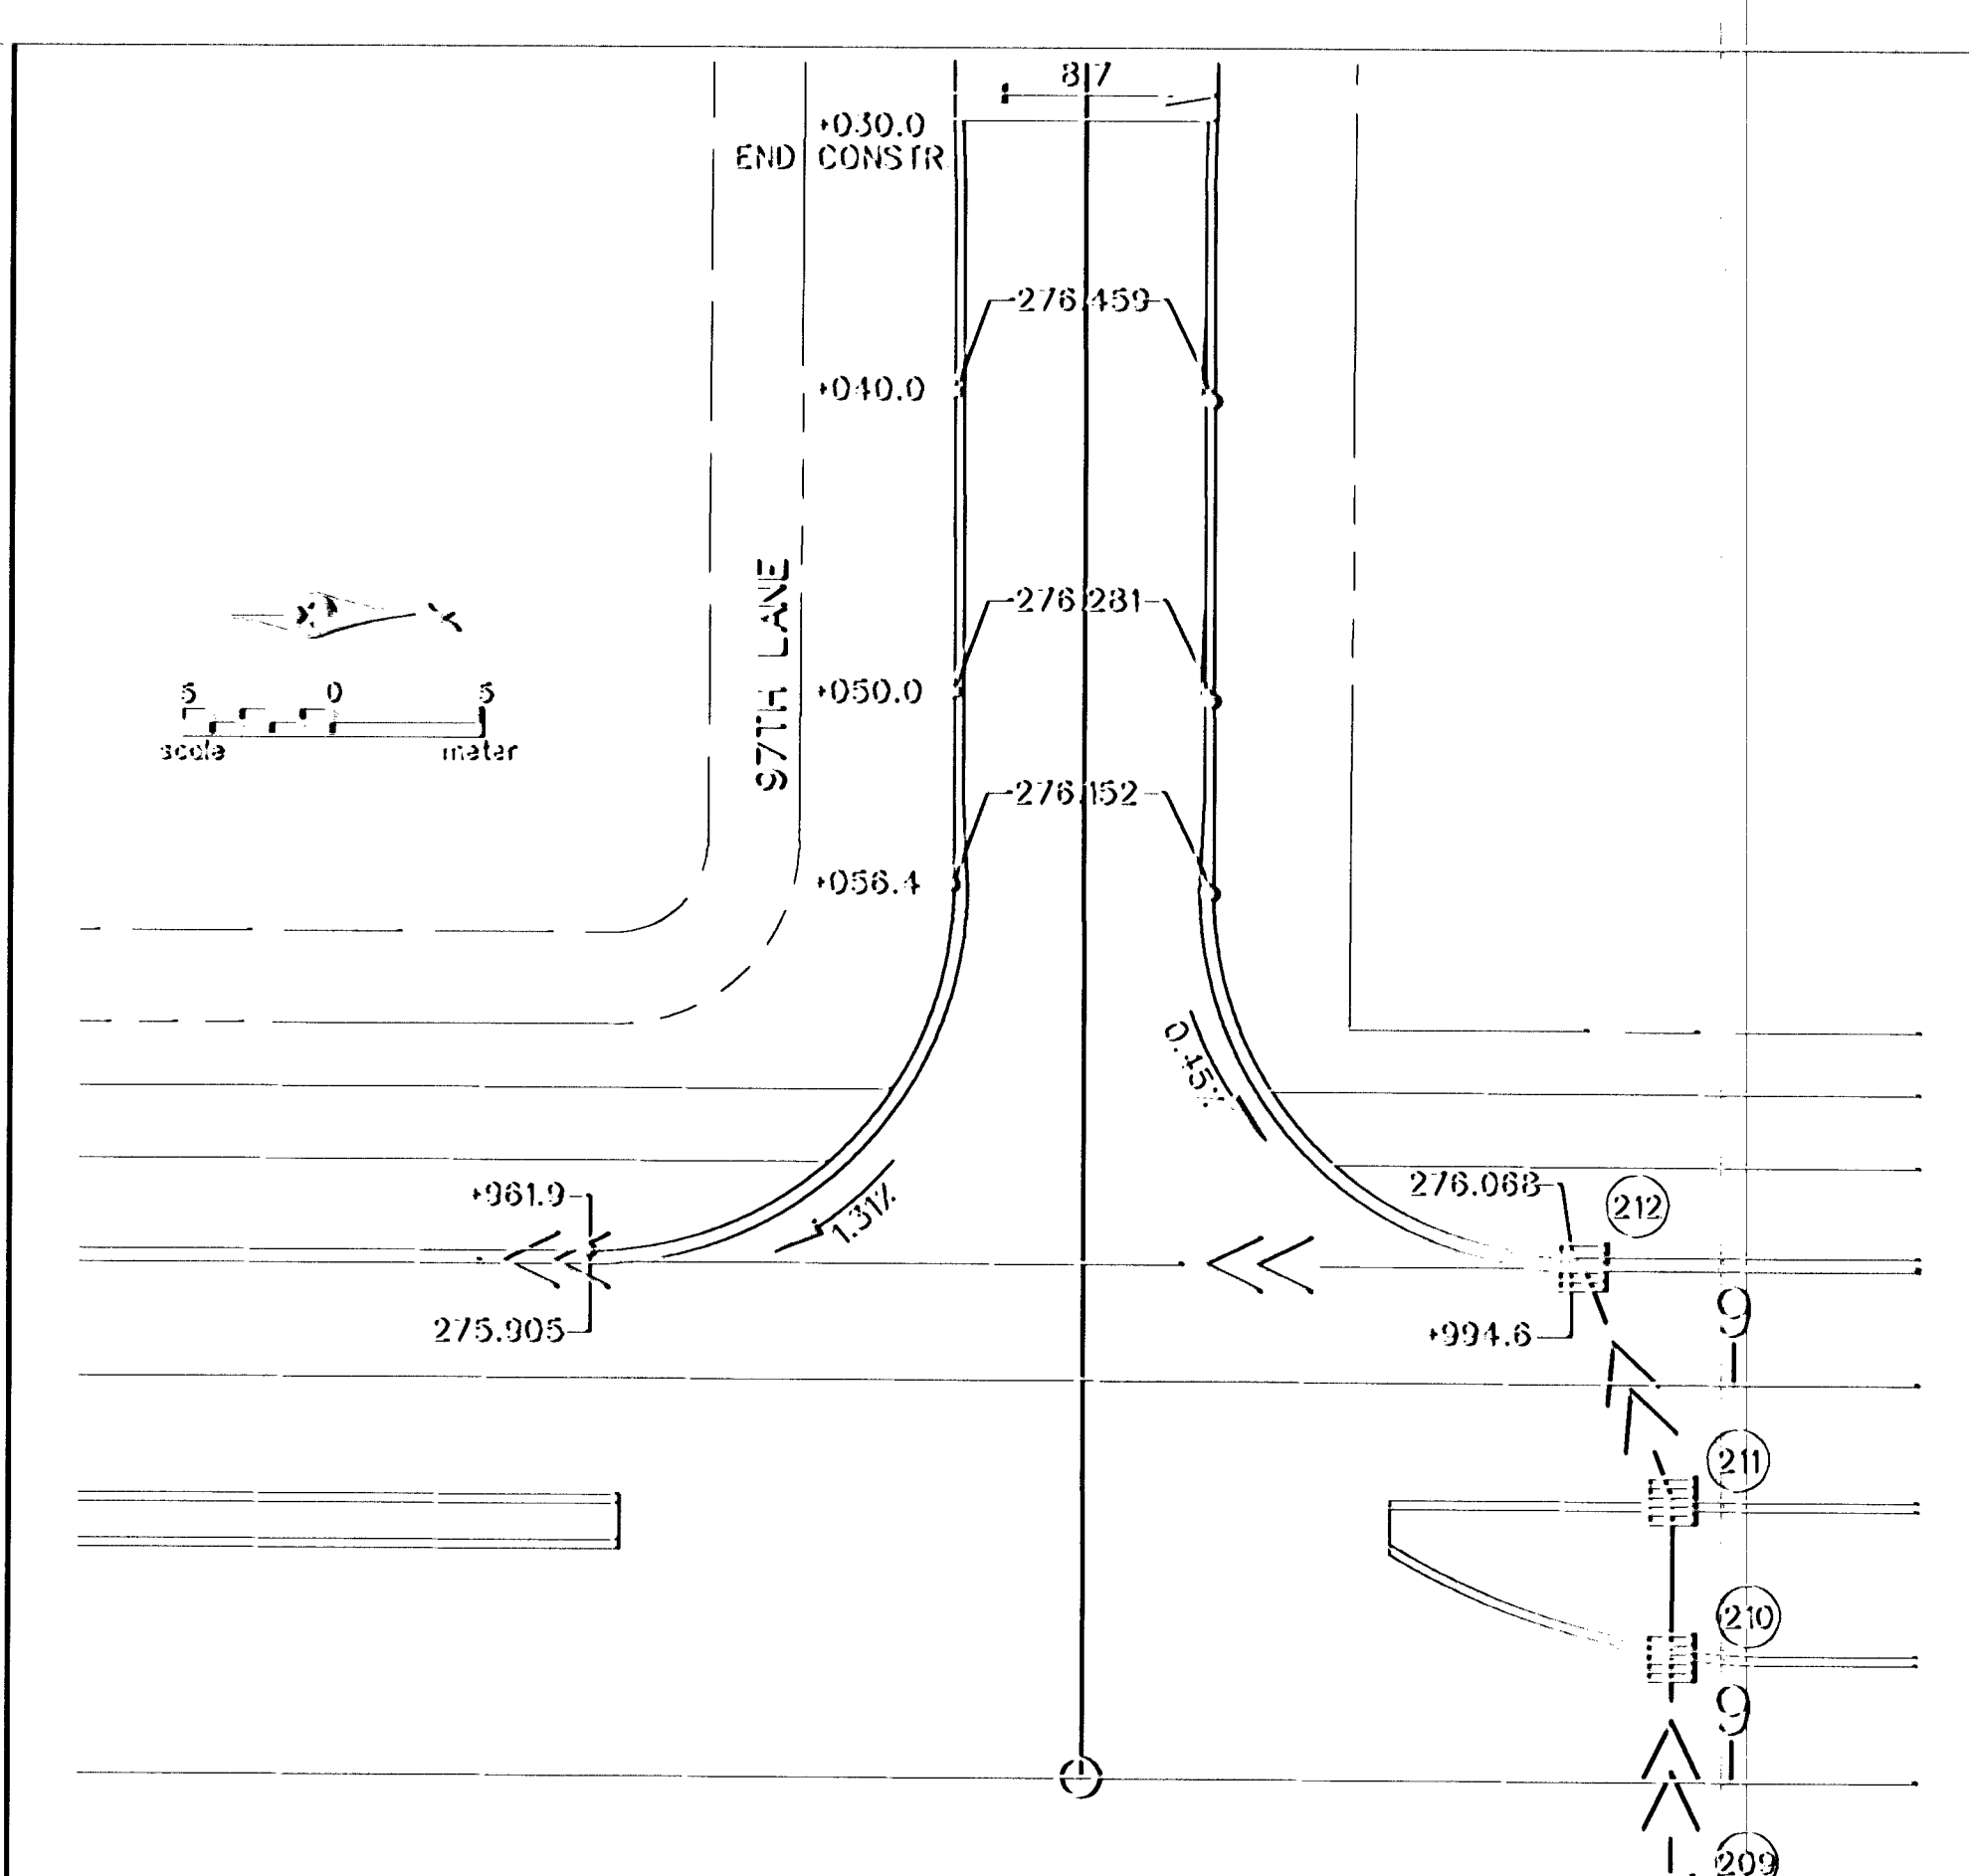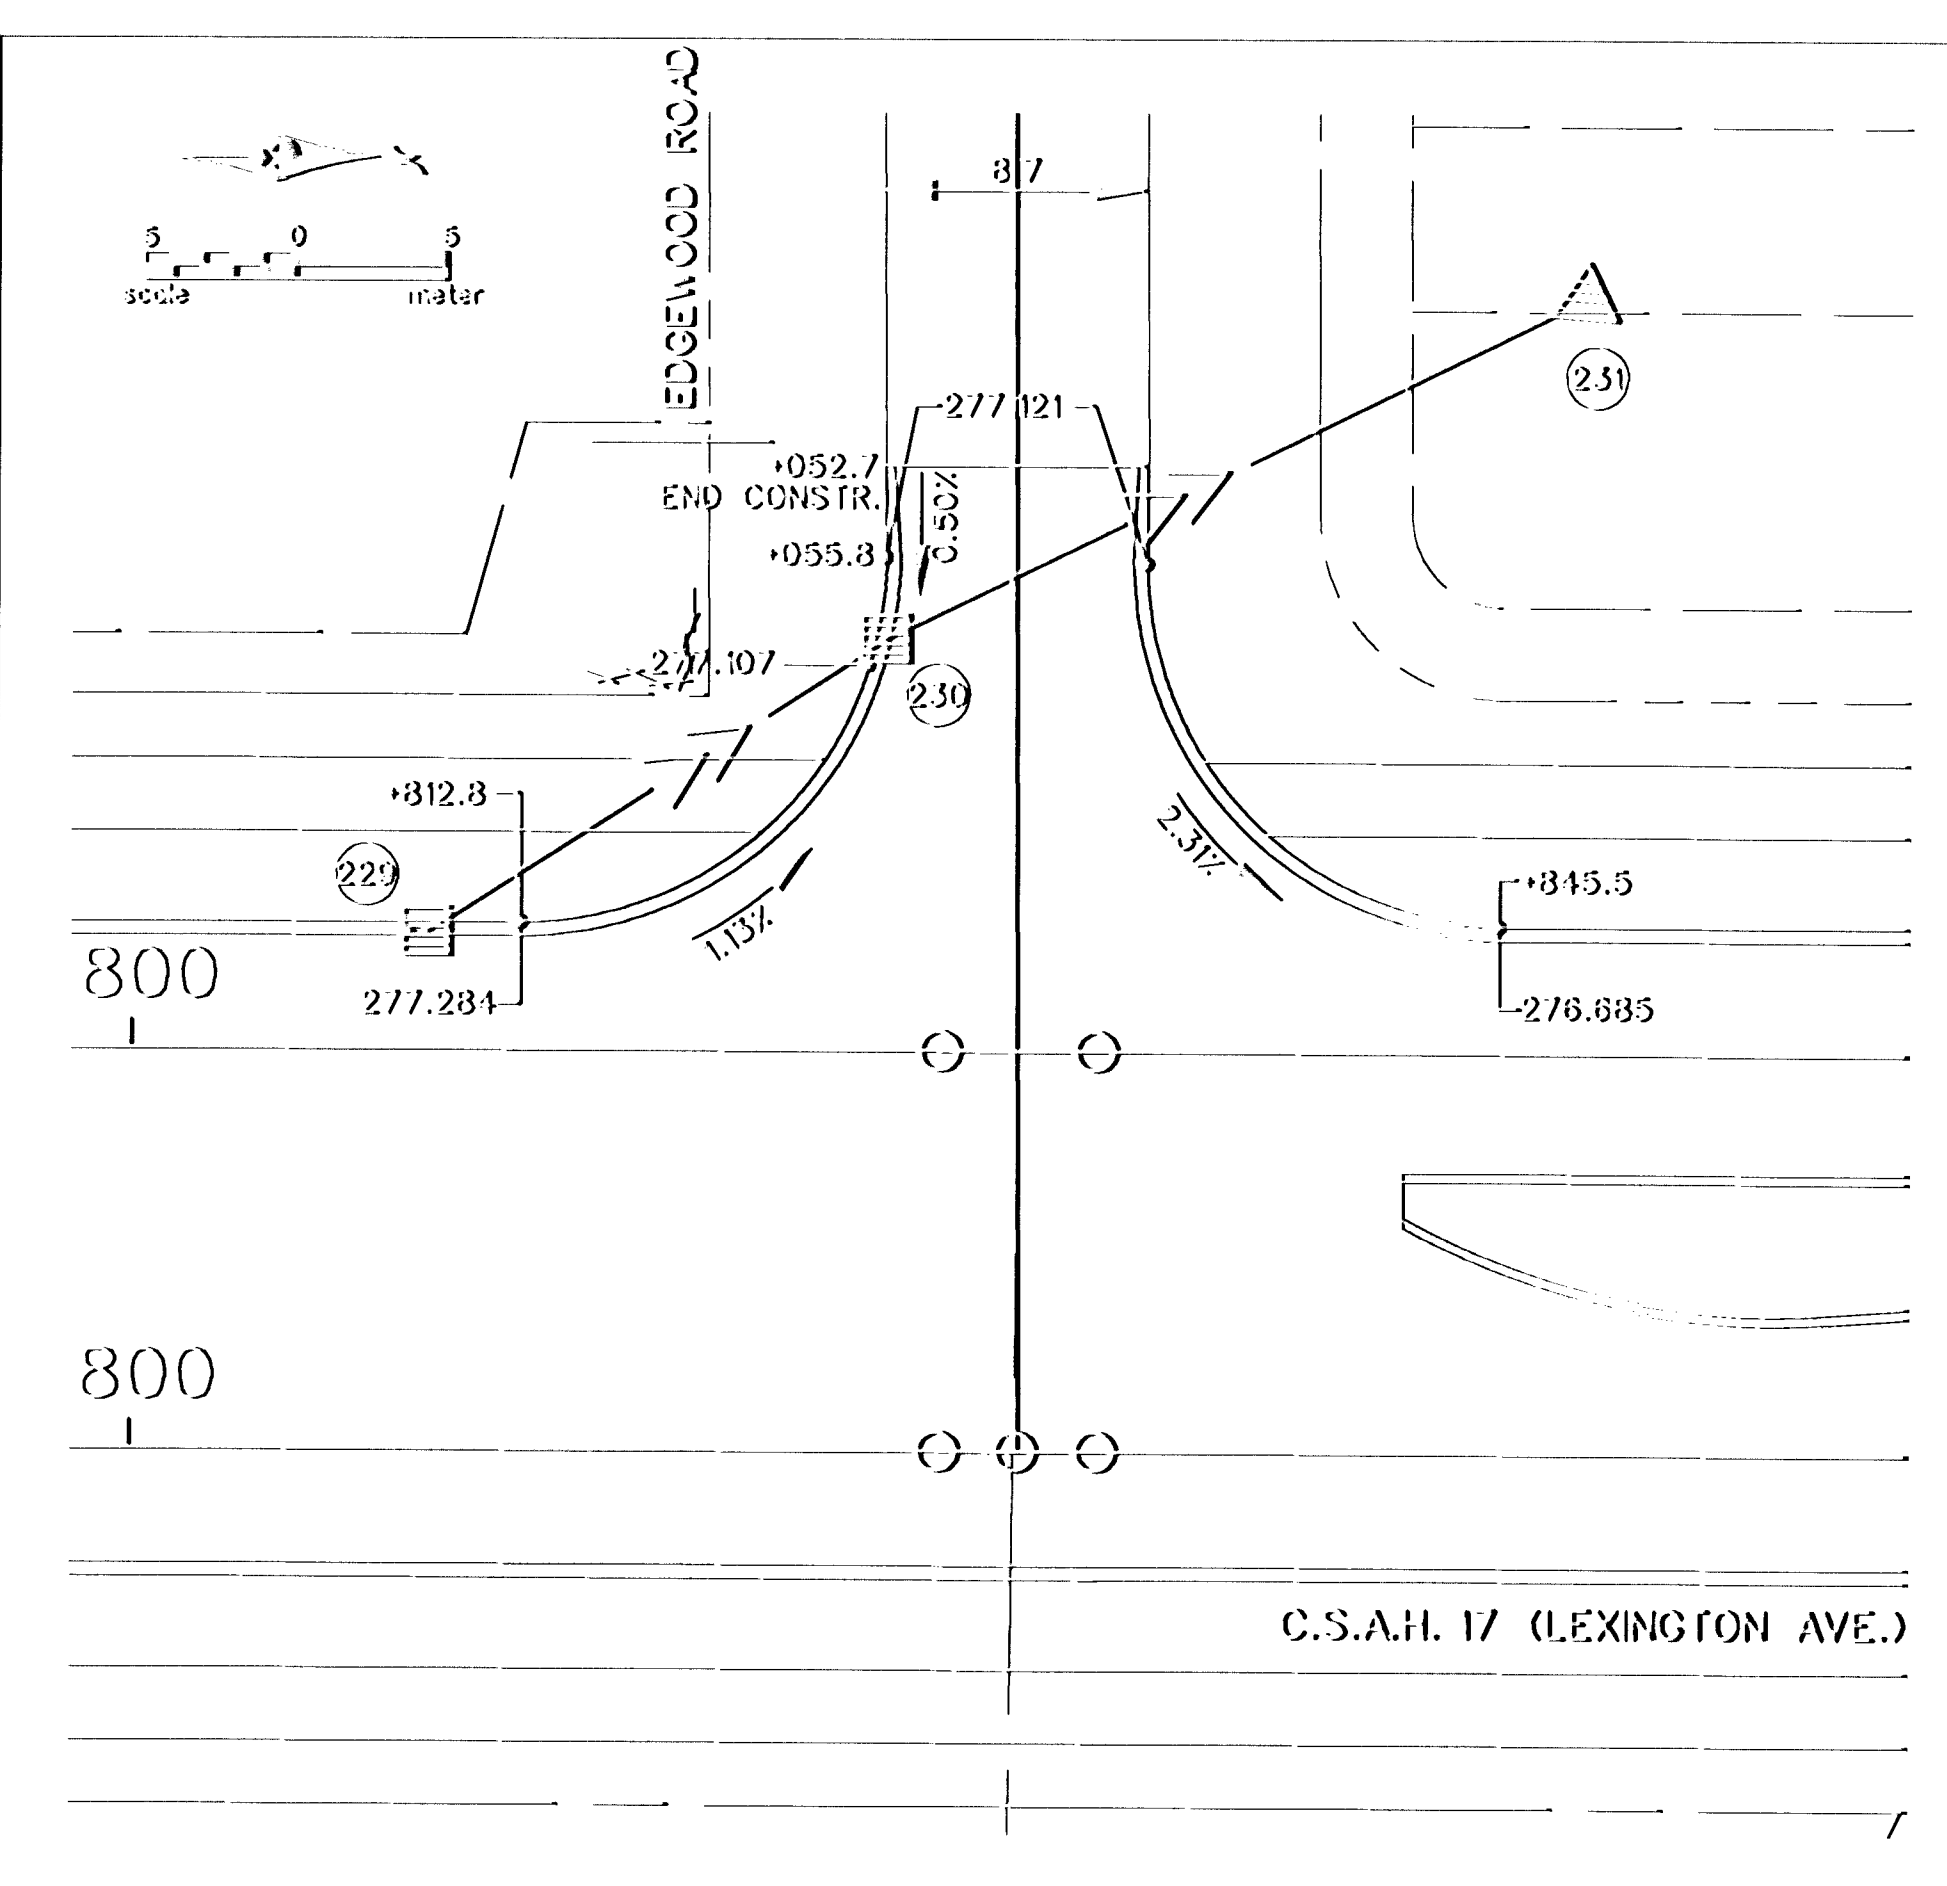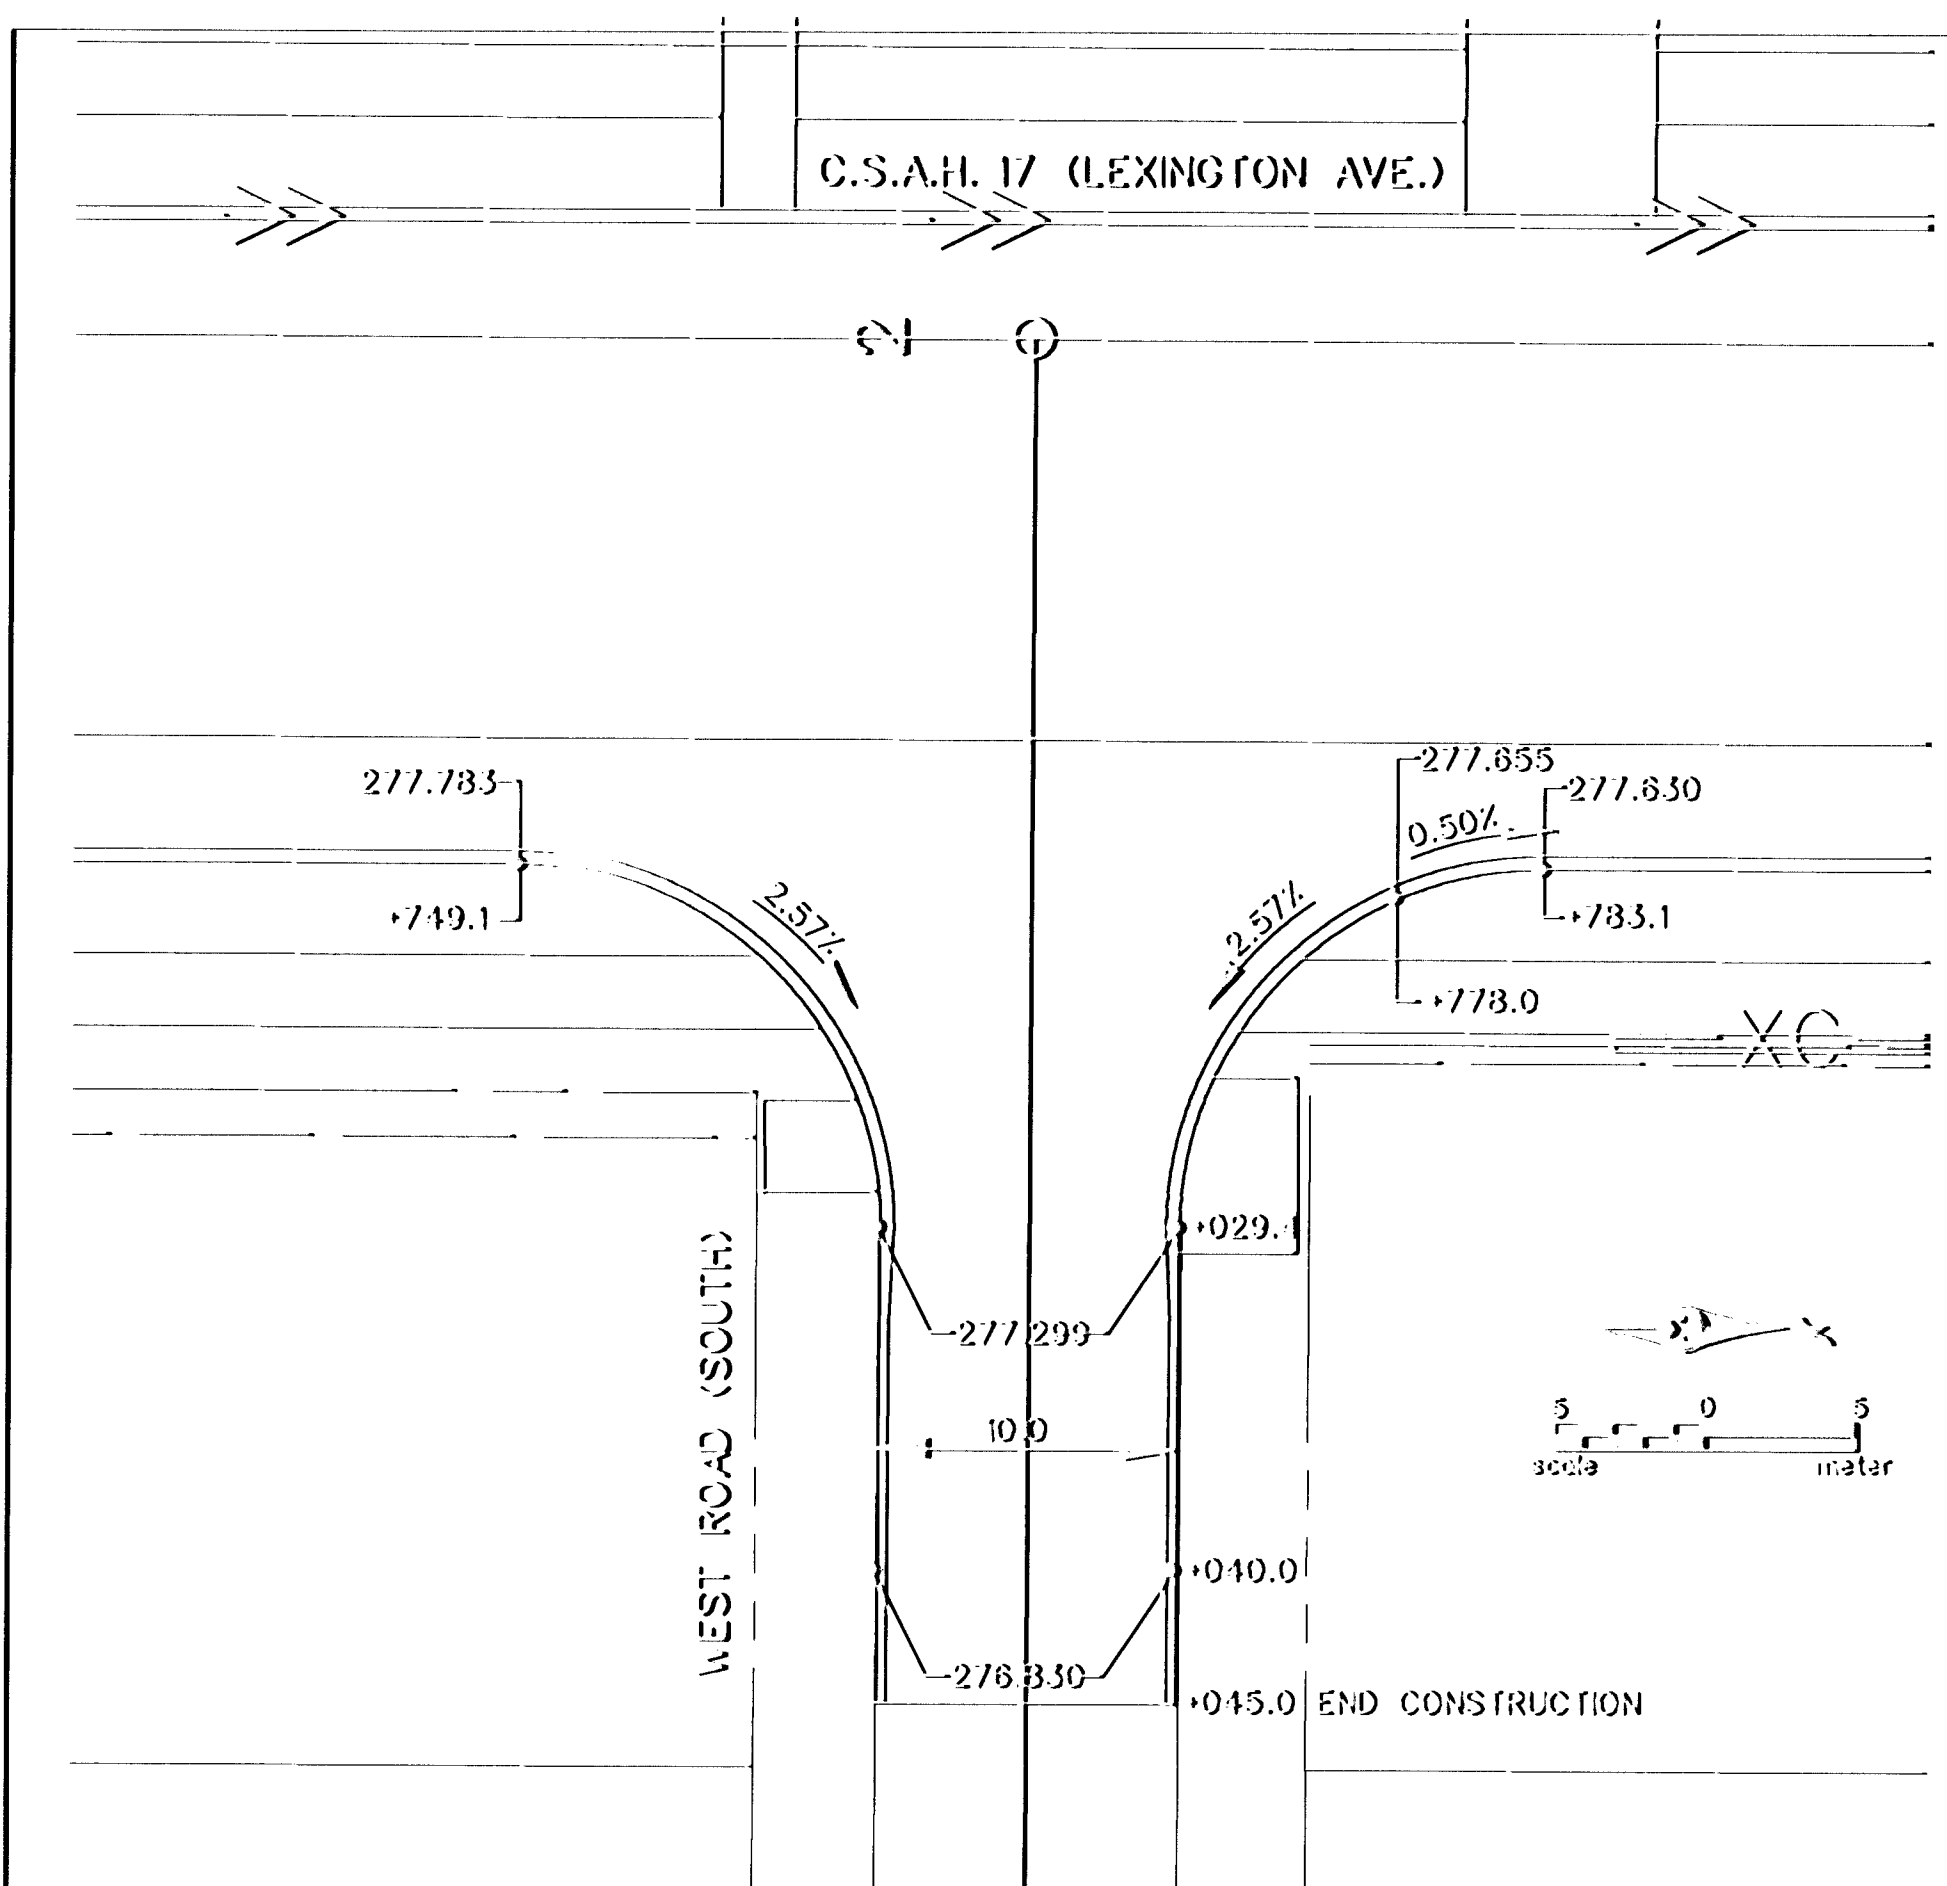

GENERAL NOTES:
ALL ELEVATIONS ARE AT THE FLOW LINE OF THE CURB
X.XXX INDICATES FLOW LINE PROFILE GRADE

NO	DATE	BY	CHKD	APPR	REVISION

NAME: IN1 410.PLN DATE: Mar. 17, 1997

I hereby certify that this plan, specification or report was prepared by me or under my direct supervision and that I am a duly Registered Professional Engineer under the laws of the State of Minnesota.

Donald A. Demers

Date: 3-21-97 Reg. No. 23397



STATE AID PROJECT NO.
S.A.P. 02-617-11
S.A.P. 108-020-12
S.A.P. 108-030-03
CO. PROJECT NO.

DRAWN BY DATE
M. IISAKKA 12-98
DESIGNED BY
M. HANSEN 12-98
CHECKED BY
D. DEMERS 1-97
COMM. NO.
0982410

SRI CONSULTING GROUP, INC.


ANOKA COUNTY
INTERSECTION DETAILS
C.S.A.H. 17 RECONSTRUCTION

SHEET 78 OF 236

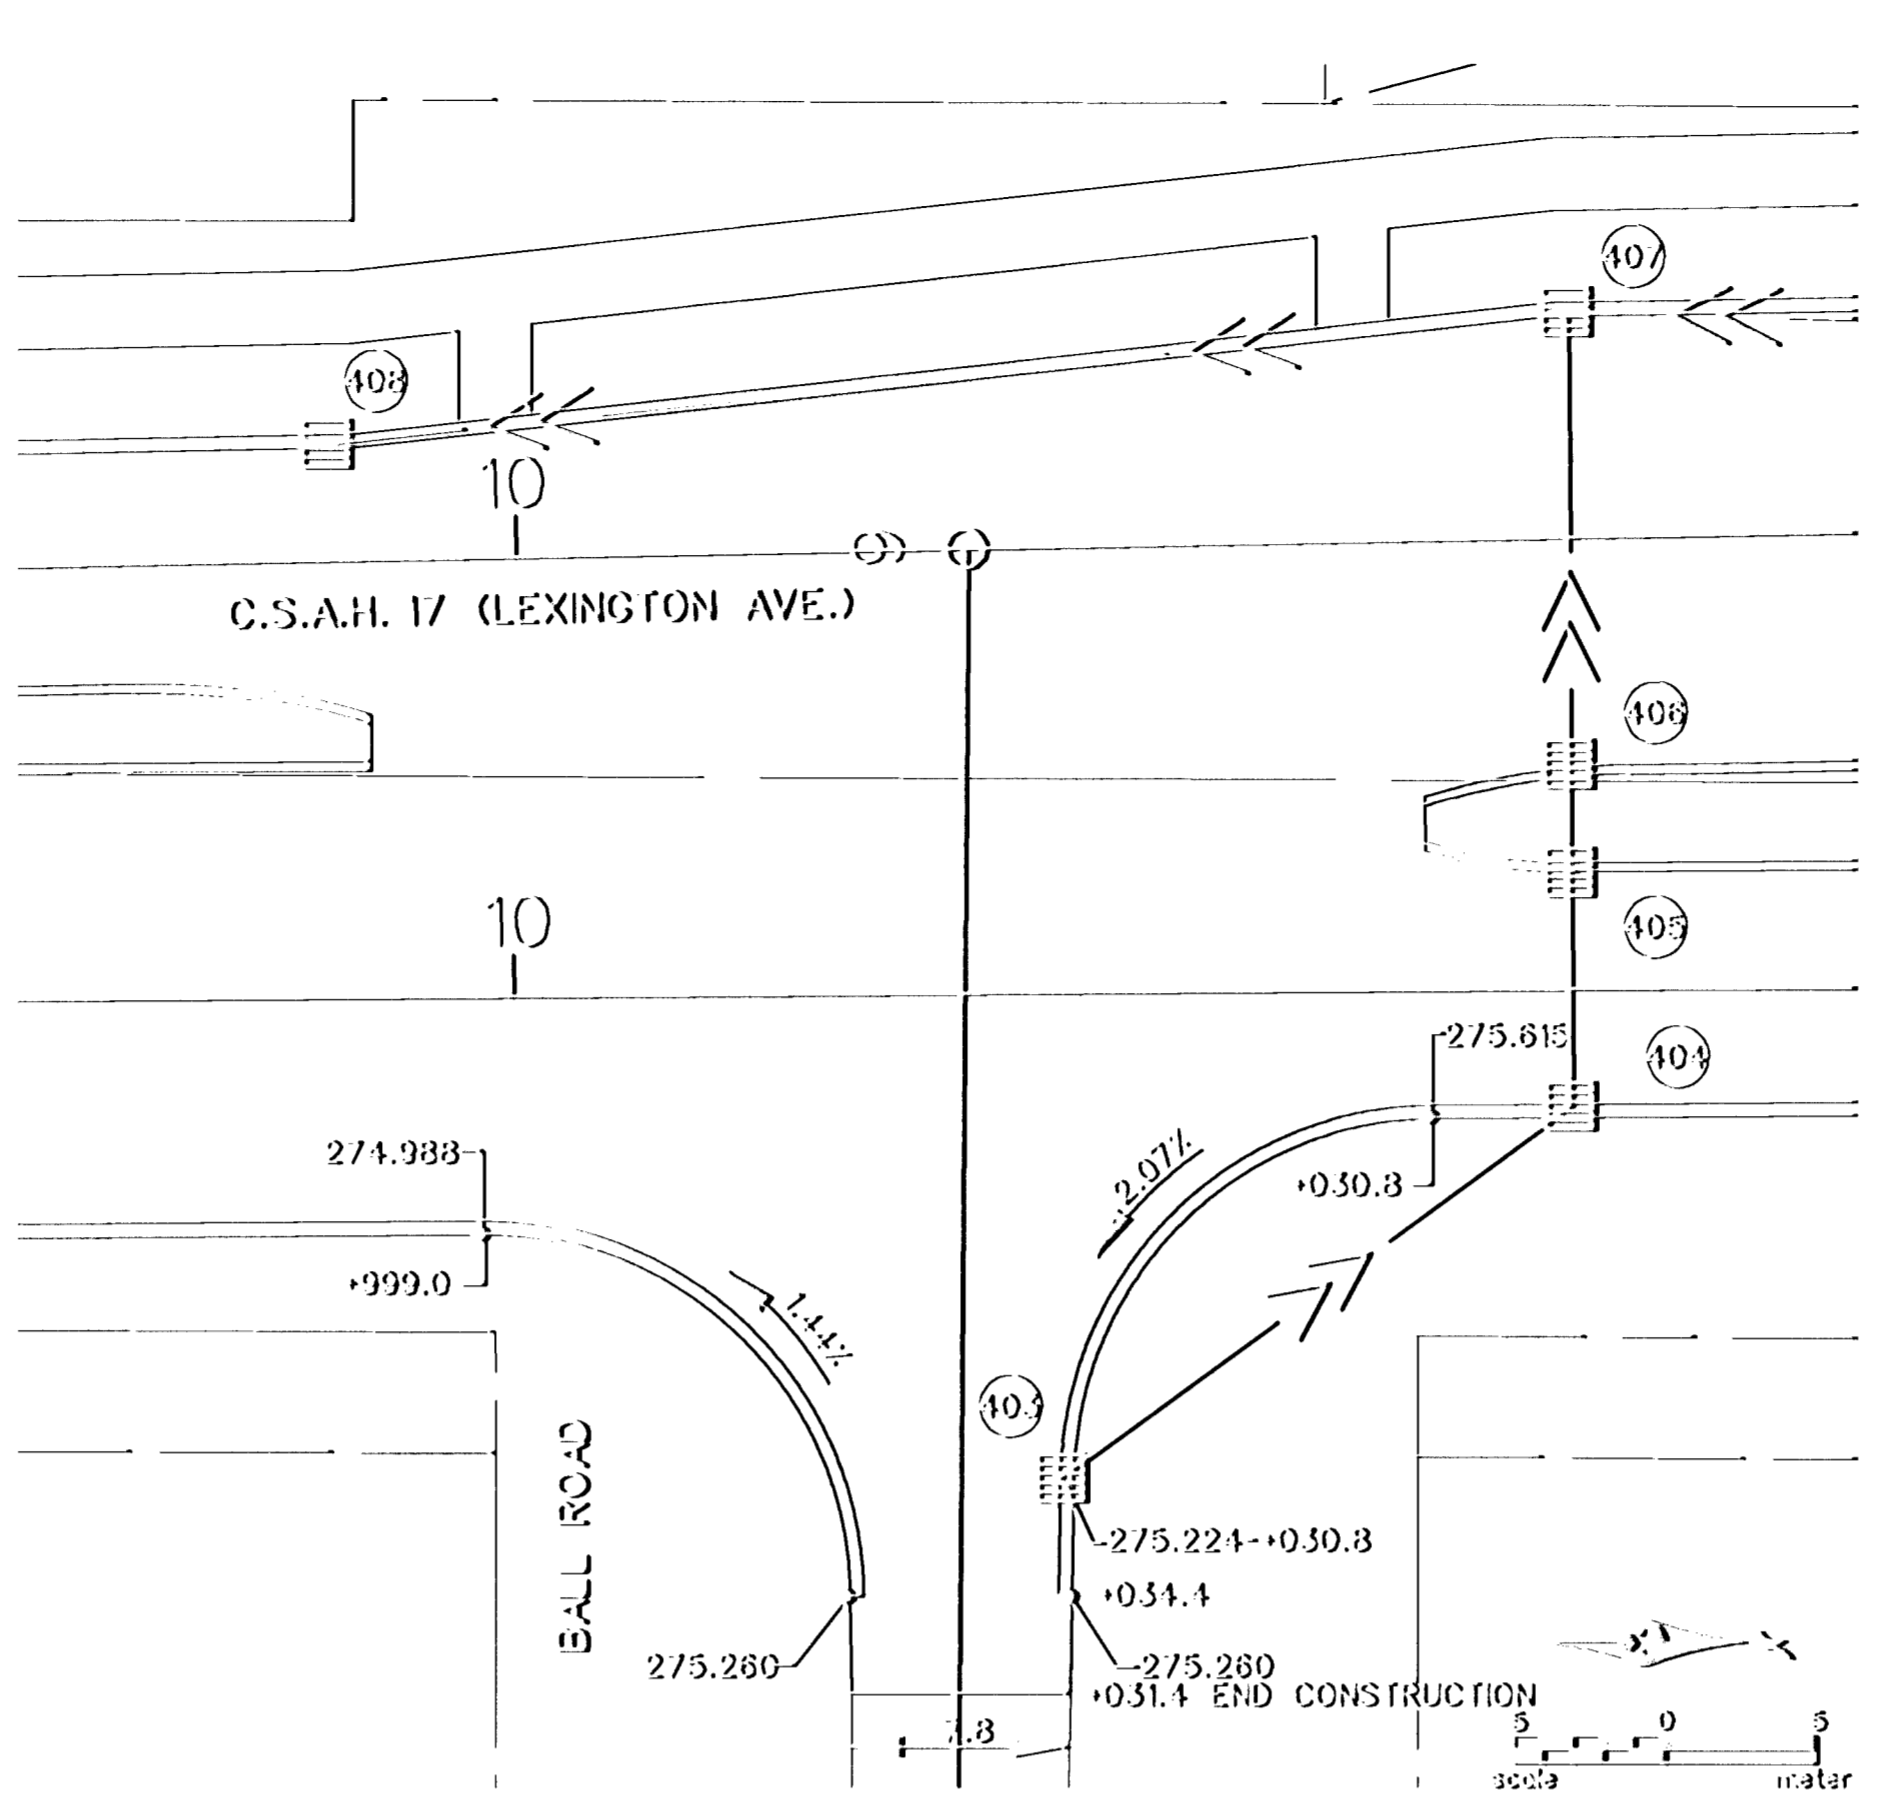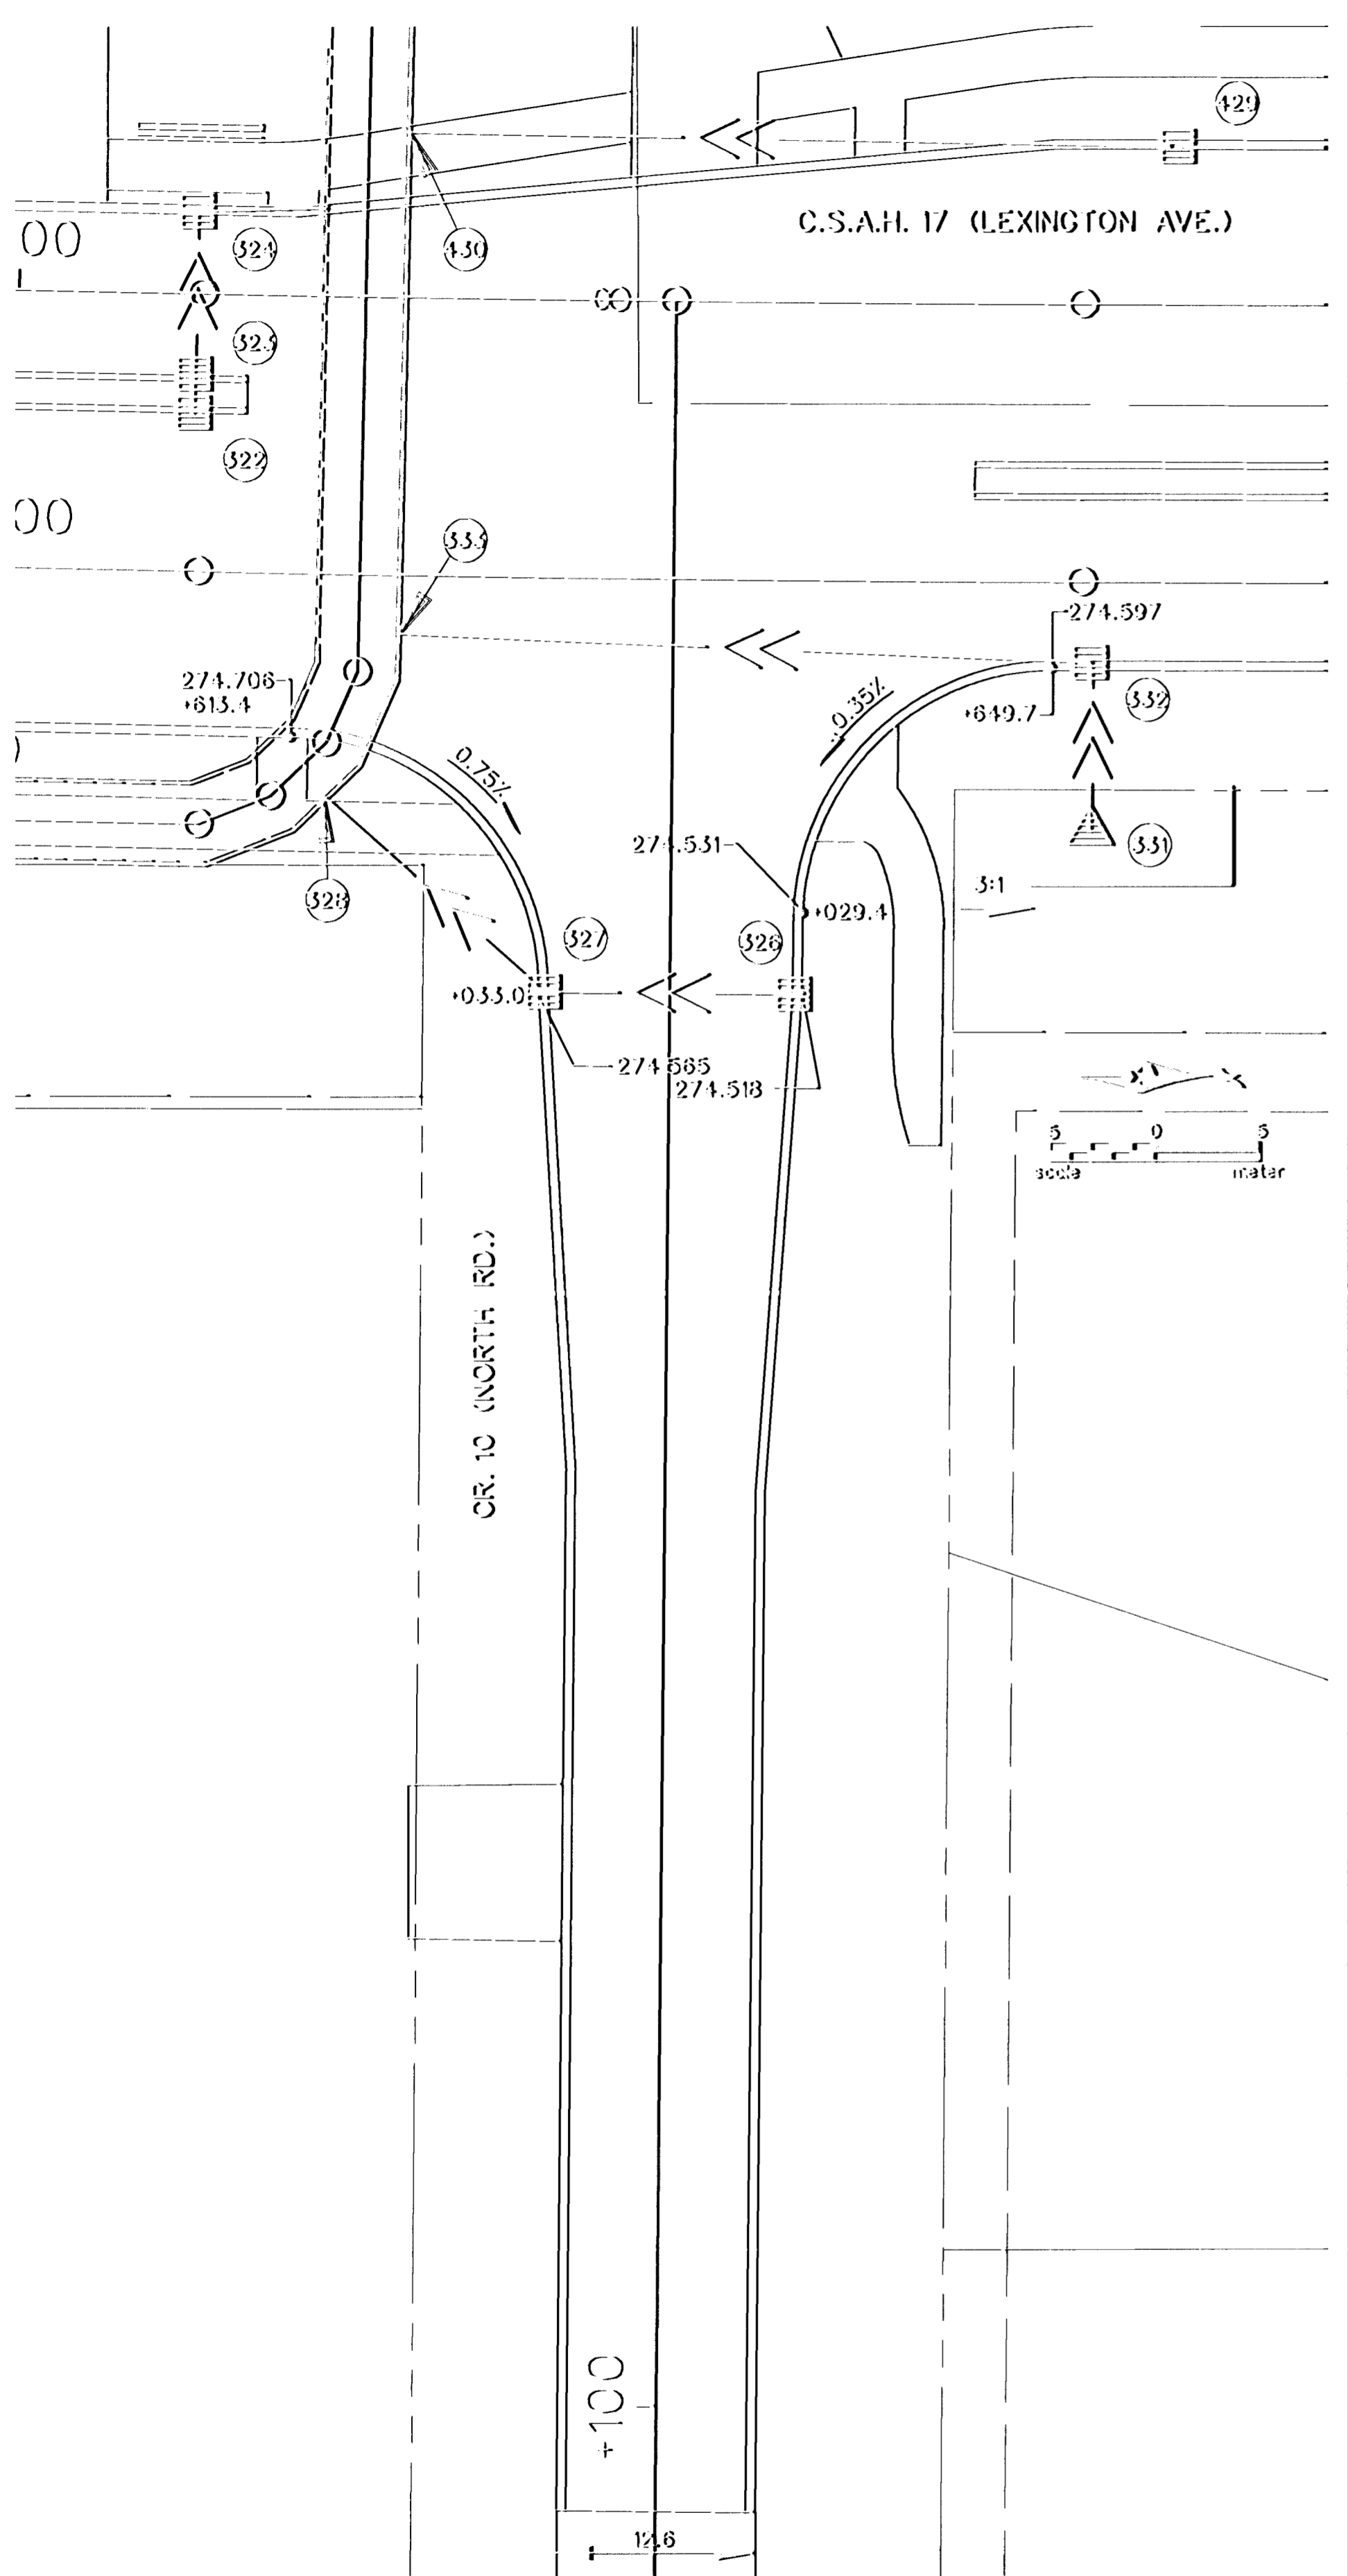

GENERAL NOTES:
 ALL ELEVATIONS ARE AT THE FLOW LINE OF THE CURB
 X.XX% INDICATES FLOW LINE PROFILE GRADE.

NO	DATE	BY	CHKD	APPR	REVISION
NAME: IN2	410.PLN	DATE: Mar. 17, 1997			

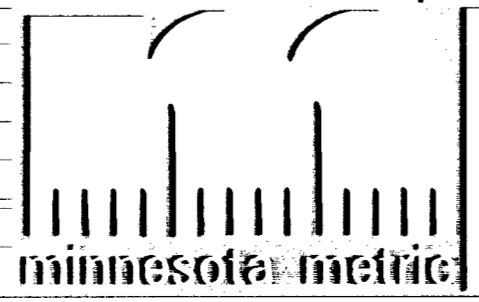

I hereby certify that this plan, specification or report was prepared by me or under my direct supervision and that I am a duly Registered Professional Engineer under the laws of the State of Minnesota.
Ronald A. Demers
 Date 3-21-97 Reg. No. 23397



STATE AID PROJECT NO.
 S.A.P. 02-617-11
 S.A.P. 106-020-12
 S.A.P. 106-030-03
 CO. PROJECT NO.

DRAWN BY M. IISAKKA DATE 12-96
 DESIGNED BY M. HANSEN DATE 12-96
 CHECKED BY D. DEMERS DATE 1-97
 COMM. NO. 0962410





ANOKA COUNTY
 INTERSECTION DETAILS
 C.S.A.H. 17 RECONSTRUCTION


SHEET 79 OF 236

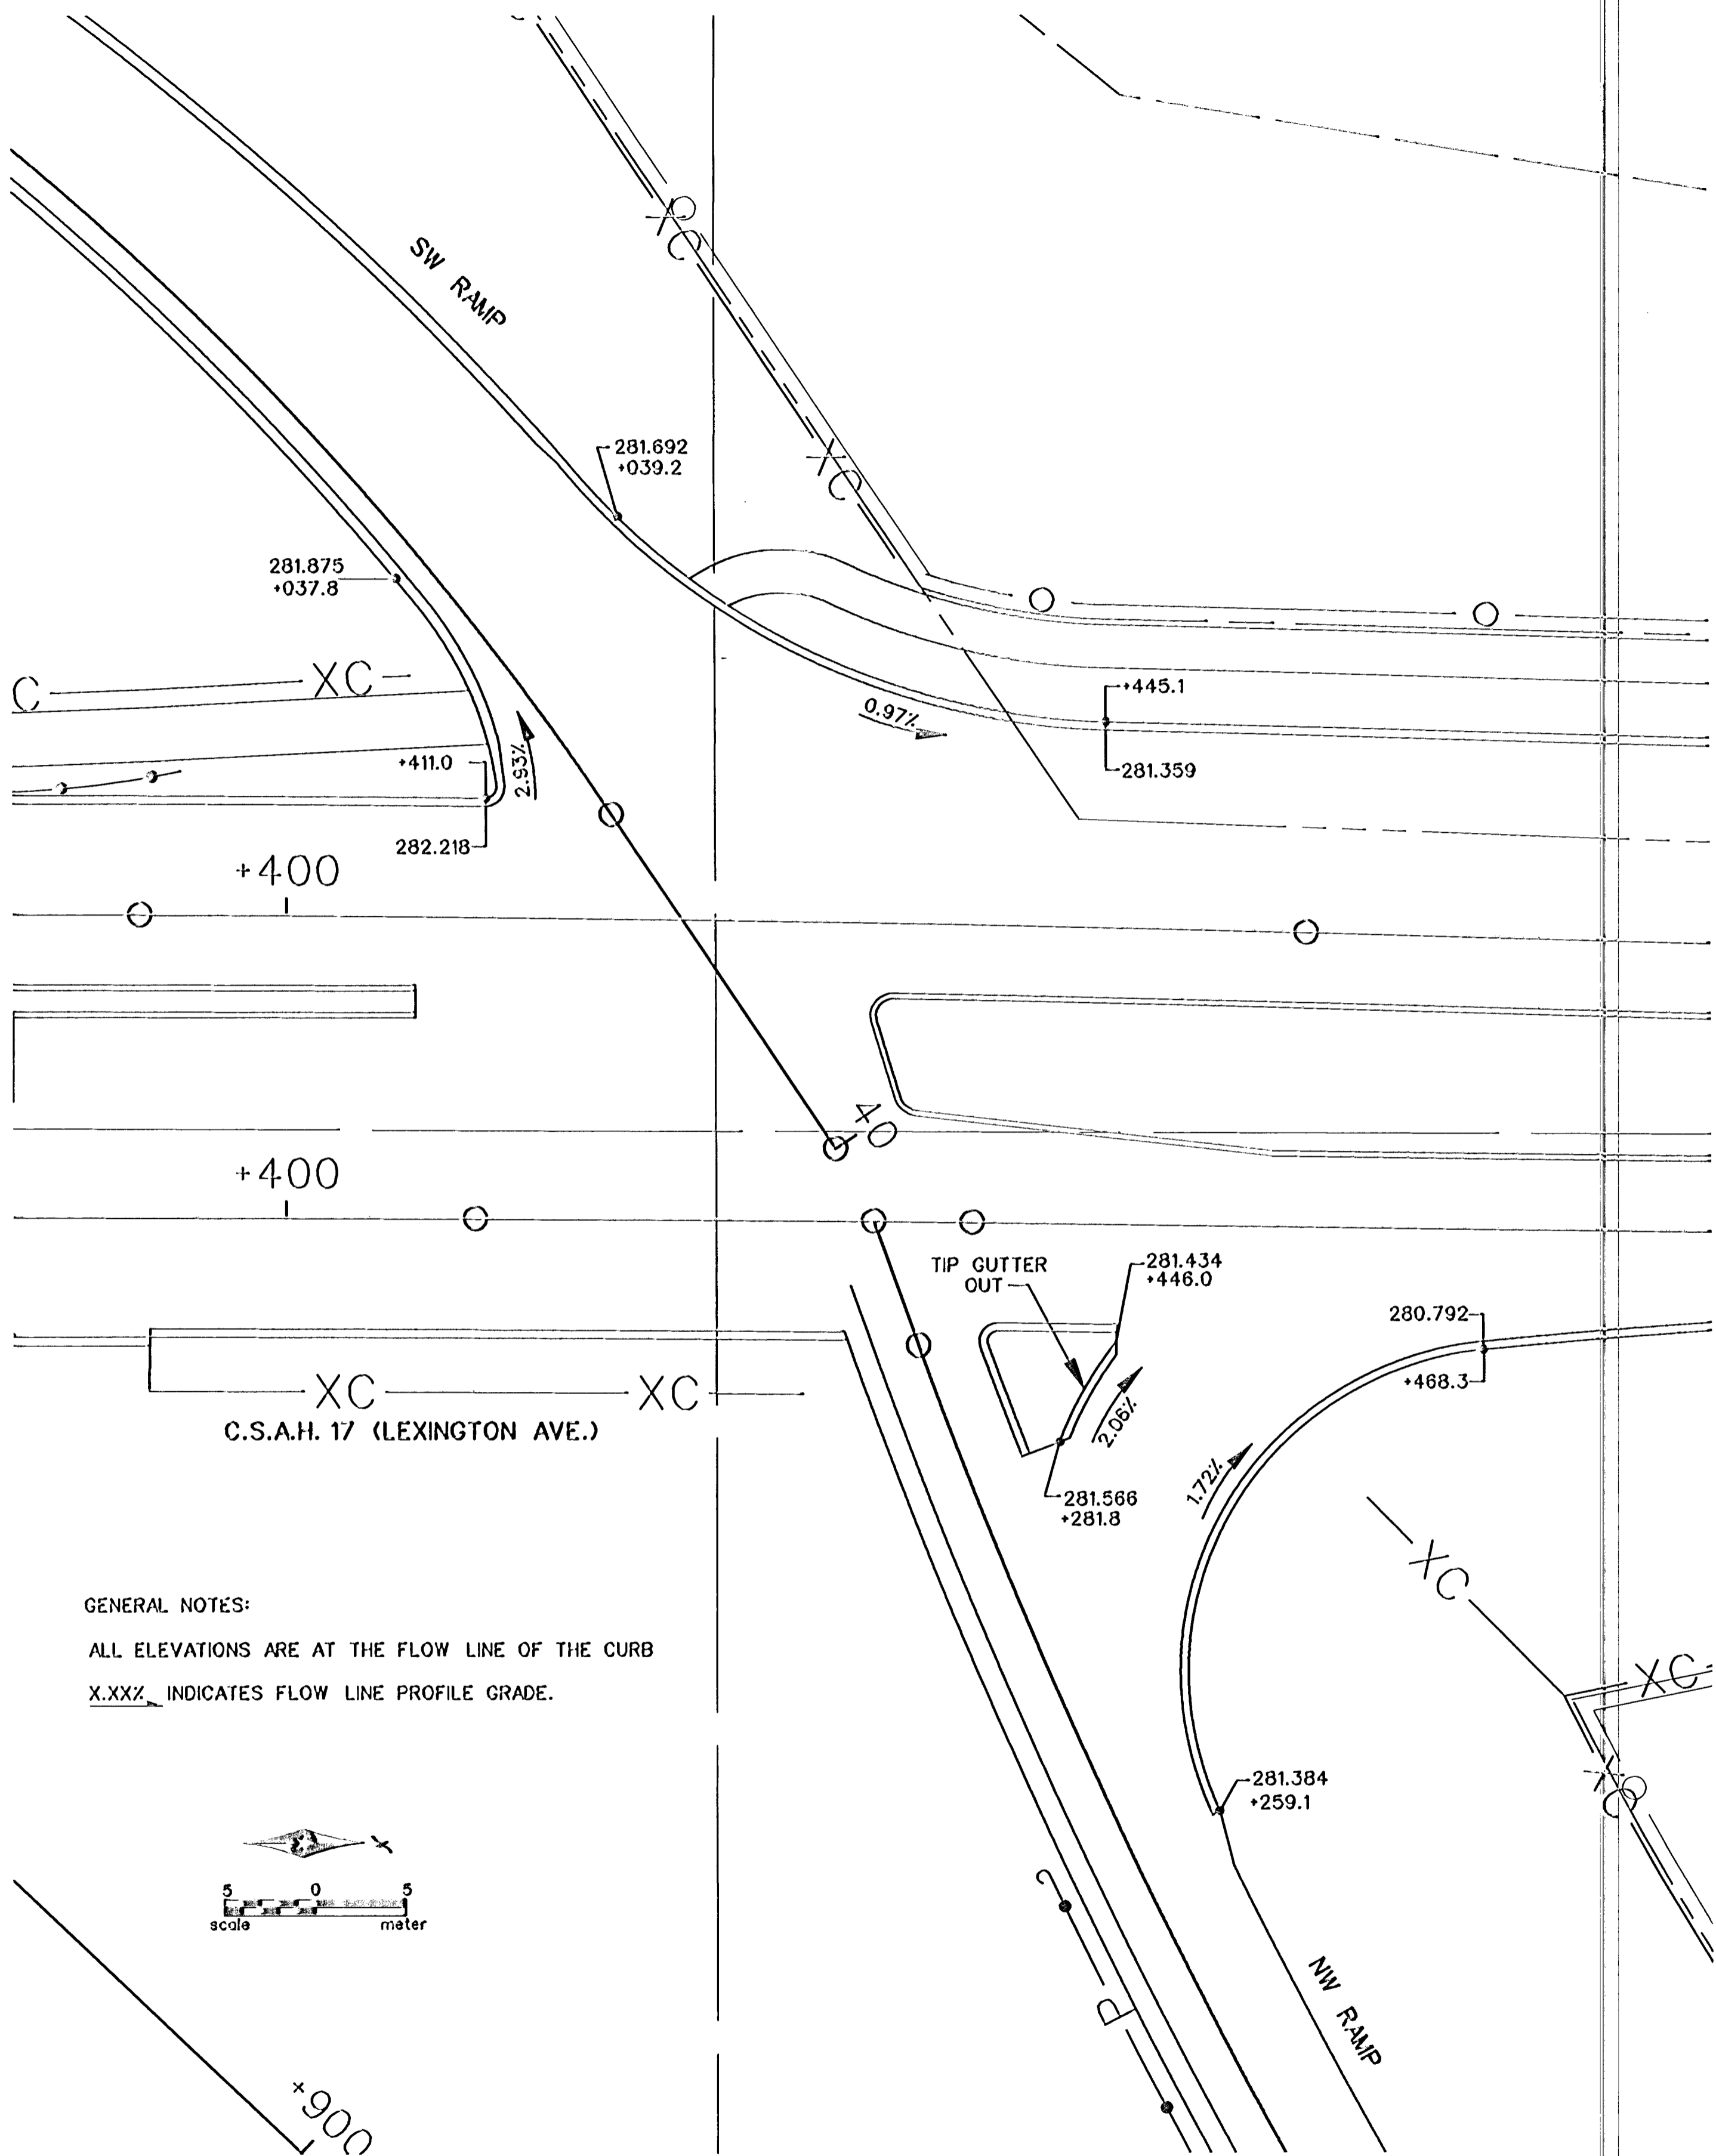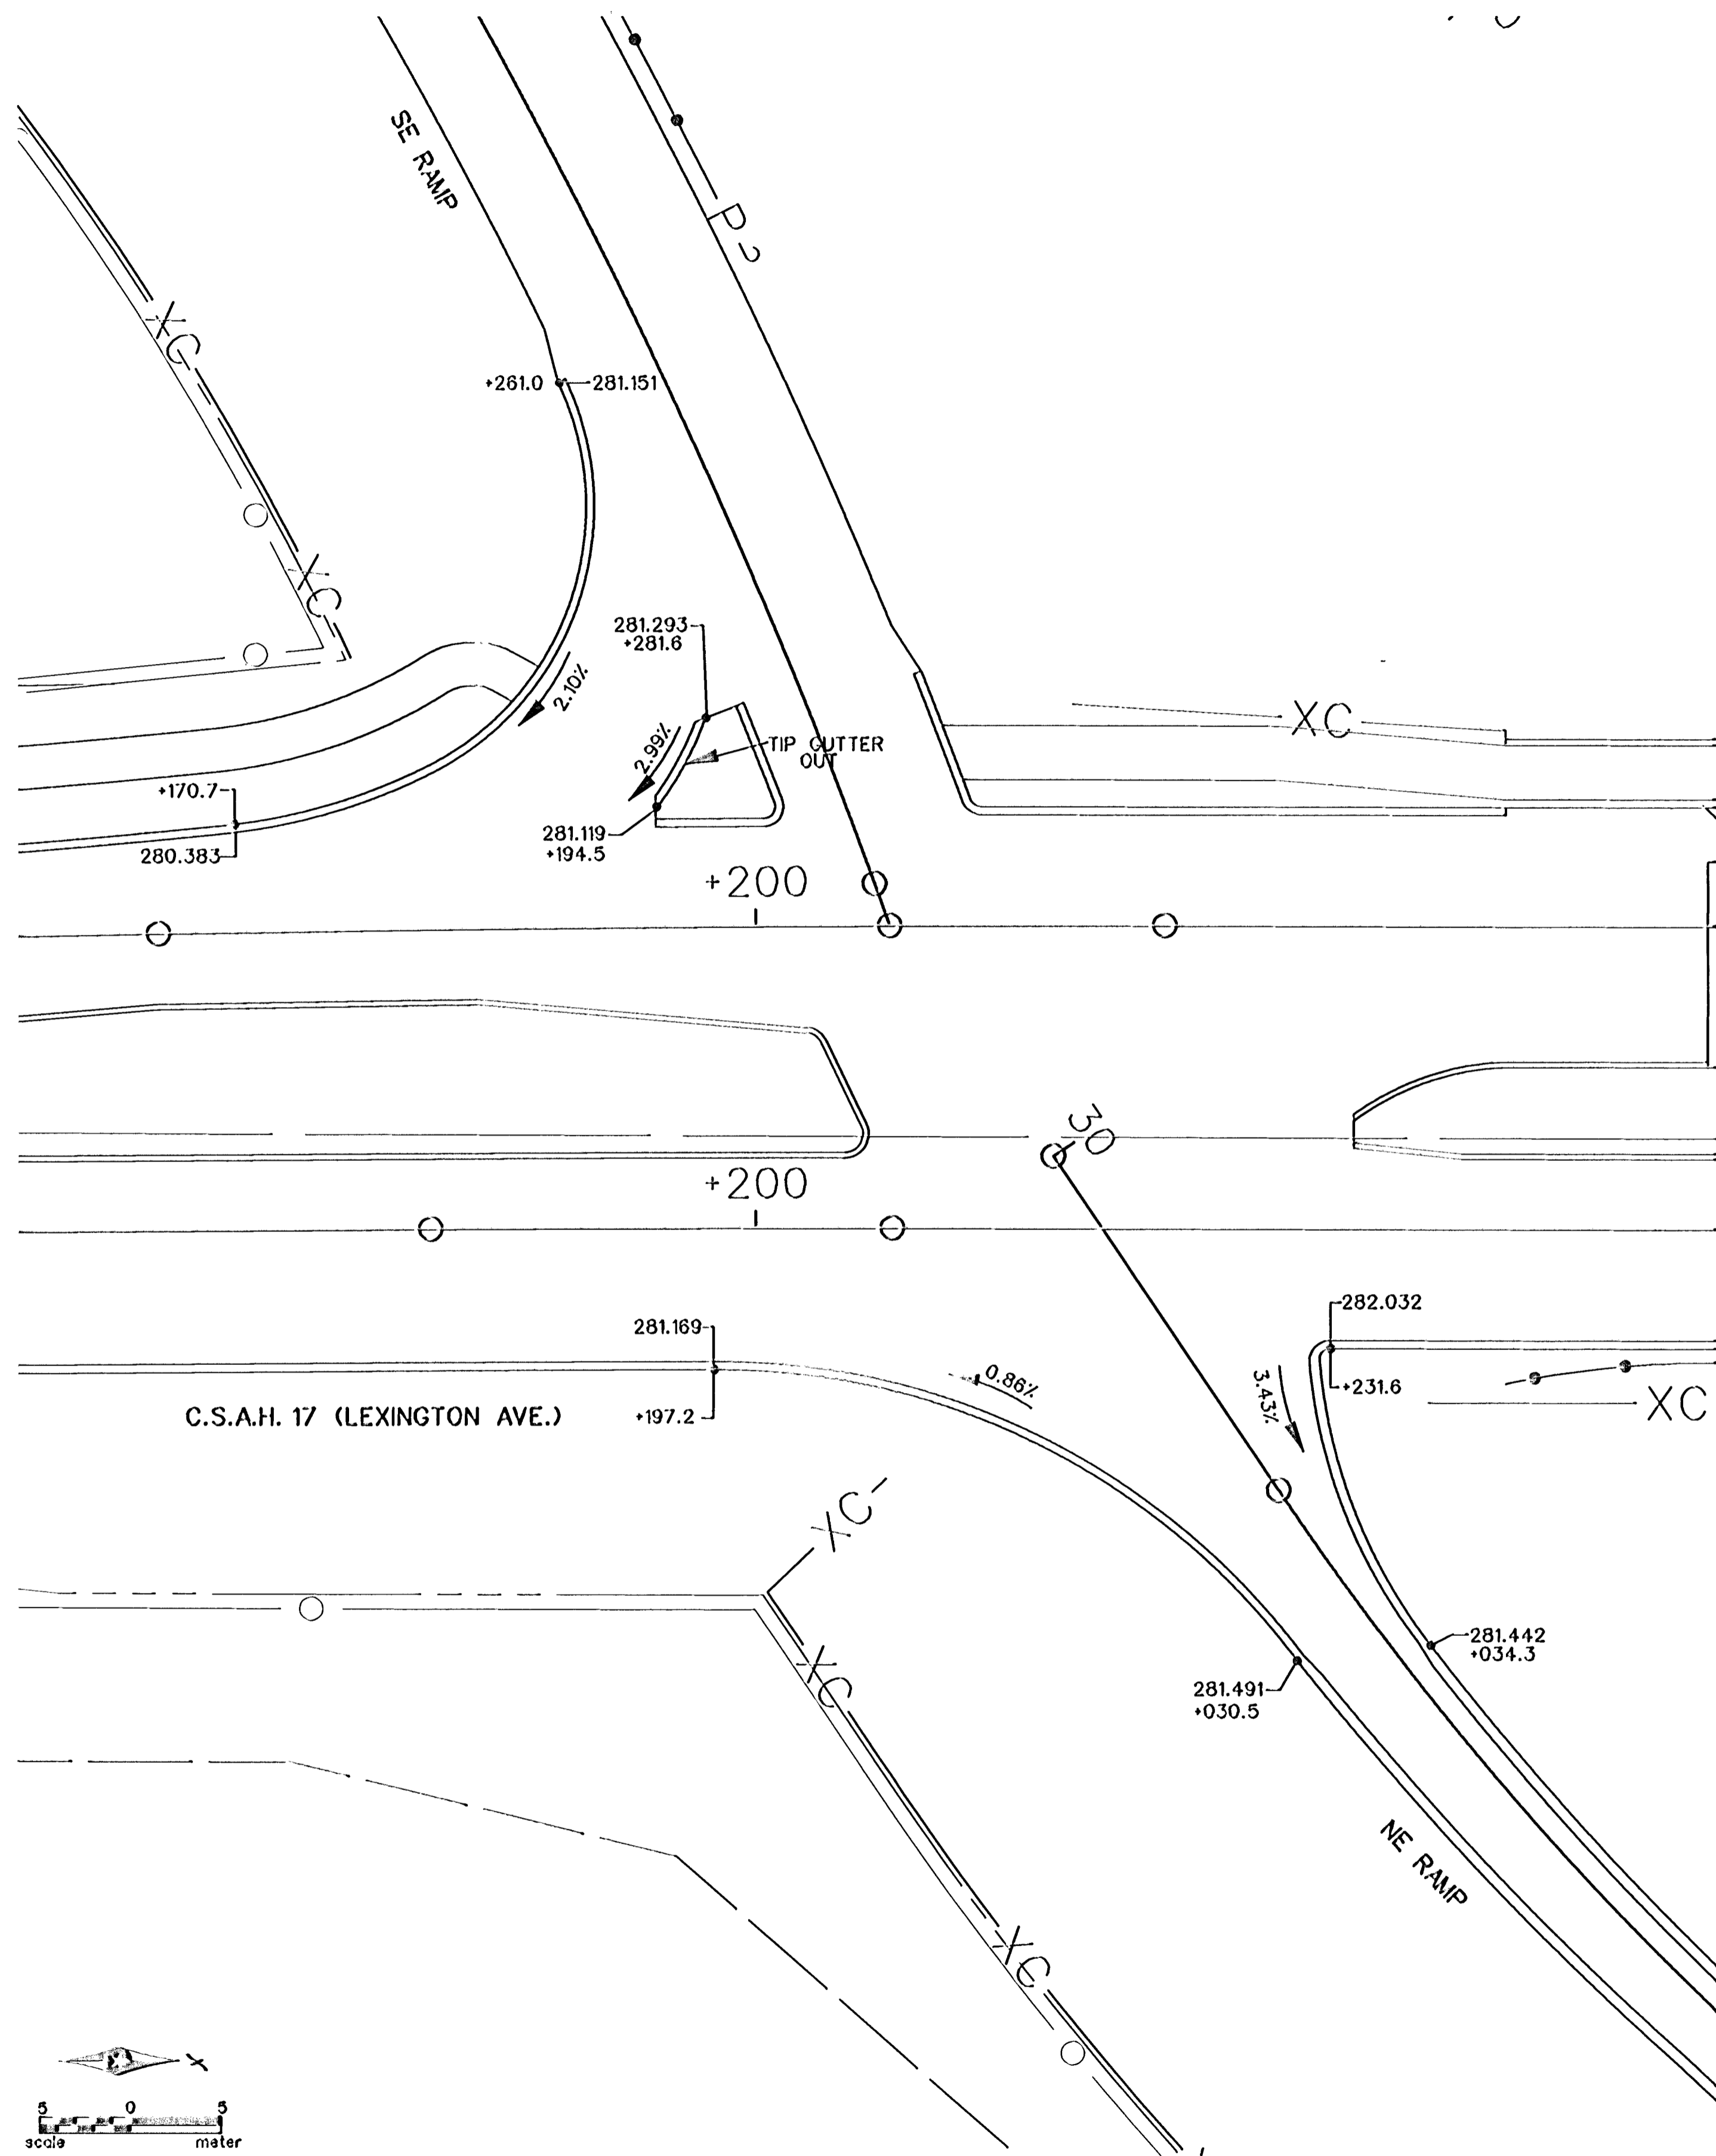

GENERAL NOTES:
 ALL ELEVATIONS ARE AT THE FLOW LINE OF THE CURB
 X.XXZ INDICATES FLOW LINE PROFILE GRADE.

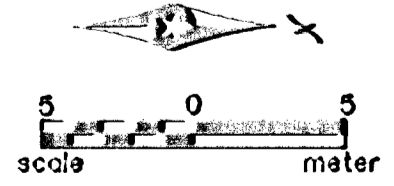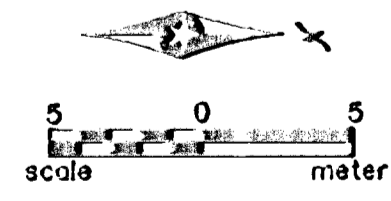

1	4-4-97	MCI	MCI	DAD	REVISE SE AND SW RAMP RADII
NO	DATE	BY	CKD	APPR	REVISION
NAME: IN3 410.PLN DATE: Mar. 17, 1997					

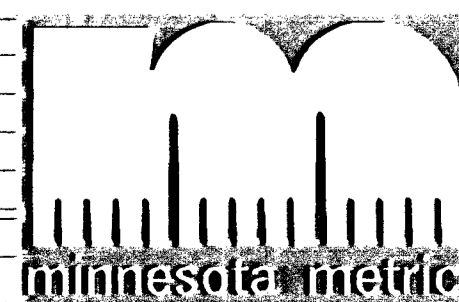

I hereby certify that this plan, specification or report was prepared by me or under my direct supervision and that I am a duly Registered Professional Engineer under the laws of the State of Minnesota.
Donald A. Demers
 Date 3-21-97 Reg. No. 23377

STATE AID PROJECT NO.
 S.A.P. 02-617-11
 S.A.P. 106-020-12
 S.A.P. 106-030-03
 CO. PROJECT NO.

DRAWN BY M. ISAKKA DATE 12-96
 DESIGNED BY M. HANSEN 12-96
 CHECKED BY D. DEMERS 1-97
 COMM. NO. 0962410



ANOKA COUNTY
 INTERSECTION DETAILS
 C.S.A.H. 17 RECONSTRUCTION

SHEET 80 OF 236

R

DRAINAGE TABULATION

Table with columns: FLOWS FROM: STR. OR APRON INLET, ALIGNMENT, STATION, OFF SET, L/R, TOP OF CASTING ELEV, INV ELEV FROM, PIPE SLOPE, FLOWS TO: STR. OR APRON, NEW STRUCTURE CONSTRUCTION (DESIGN, PAY HT., F & I CASTING ASMBLY, RE-QUIRED), DRAINAGE PIPE (RCP DESIGN 3006) with various pipe sizes (300mm to 900mm), CSP (375mm to 450mm), RIP RAP CLASS III (15), GUIDE POSTS TYPE B, NOTES.

SEE NOTES ON SHEET 84

Revision table with columns: NO, DATE, BY, CKD, APPR, REVISION. Includes entry: 1 14-4-97 MCE (MCM/DAI) REVERSE CB 507 AND 508 LOCATION.



I hereby certify that this plan, specification or report was prepared by me or under my direct supervision and that I am a duly Registered Professional Engineer under the laws of the State of Minnesota. Date 3-21-97 Reg No 21364

STATE AID PROJECT NO. S.A.P. 02-617-11 S.A.P. 106-020-12 S.A.P. 106-030-03 CO. PROJECT NO.

DRAWN BY V. GRAF DATE 12-96 DESIGNED BY M. HANSEN 12-96 CHECKED BY O. DEMERS 3-97 COMM. NO. 0952410





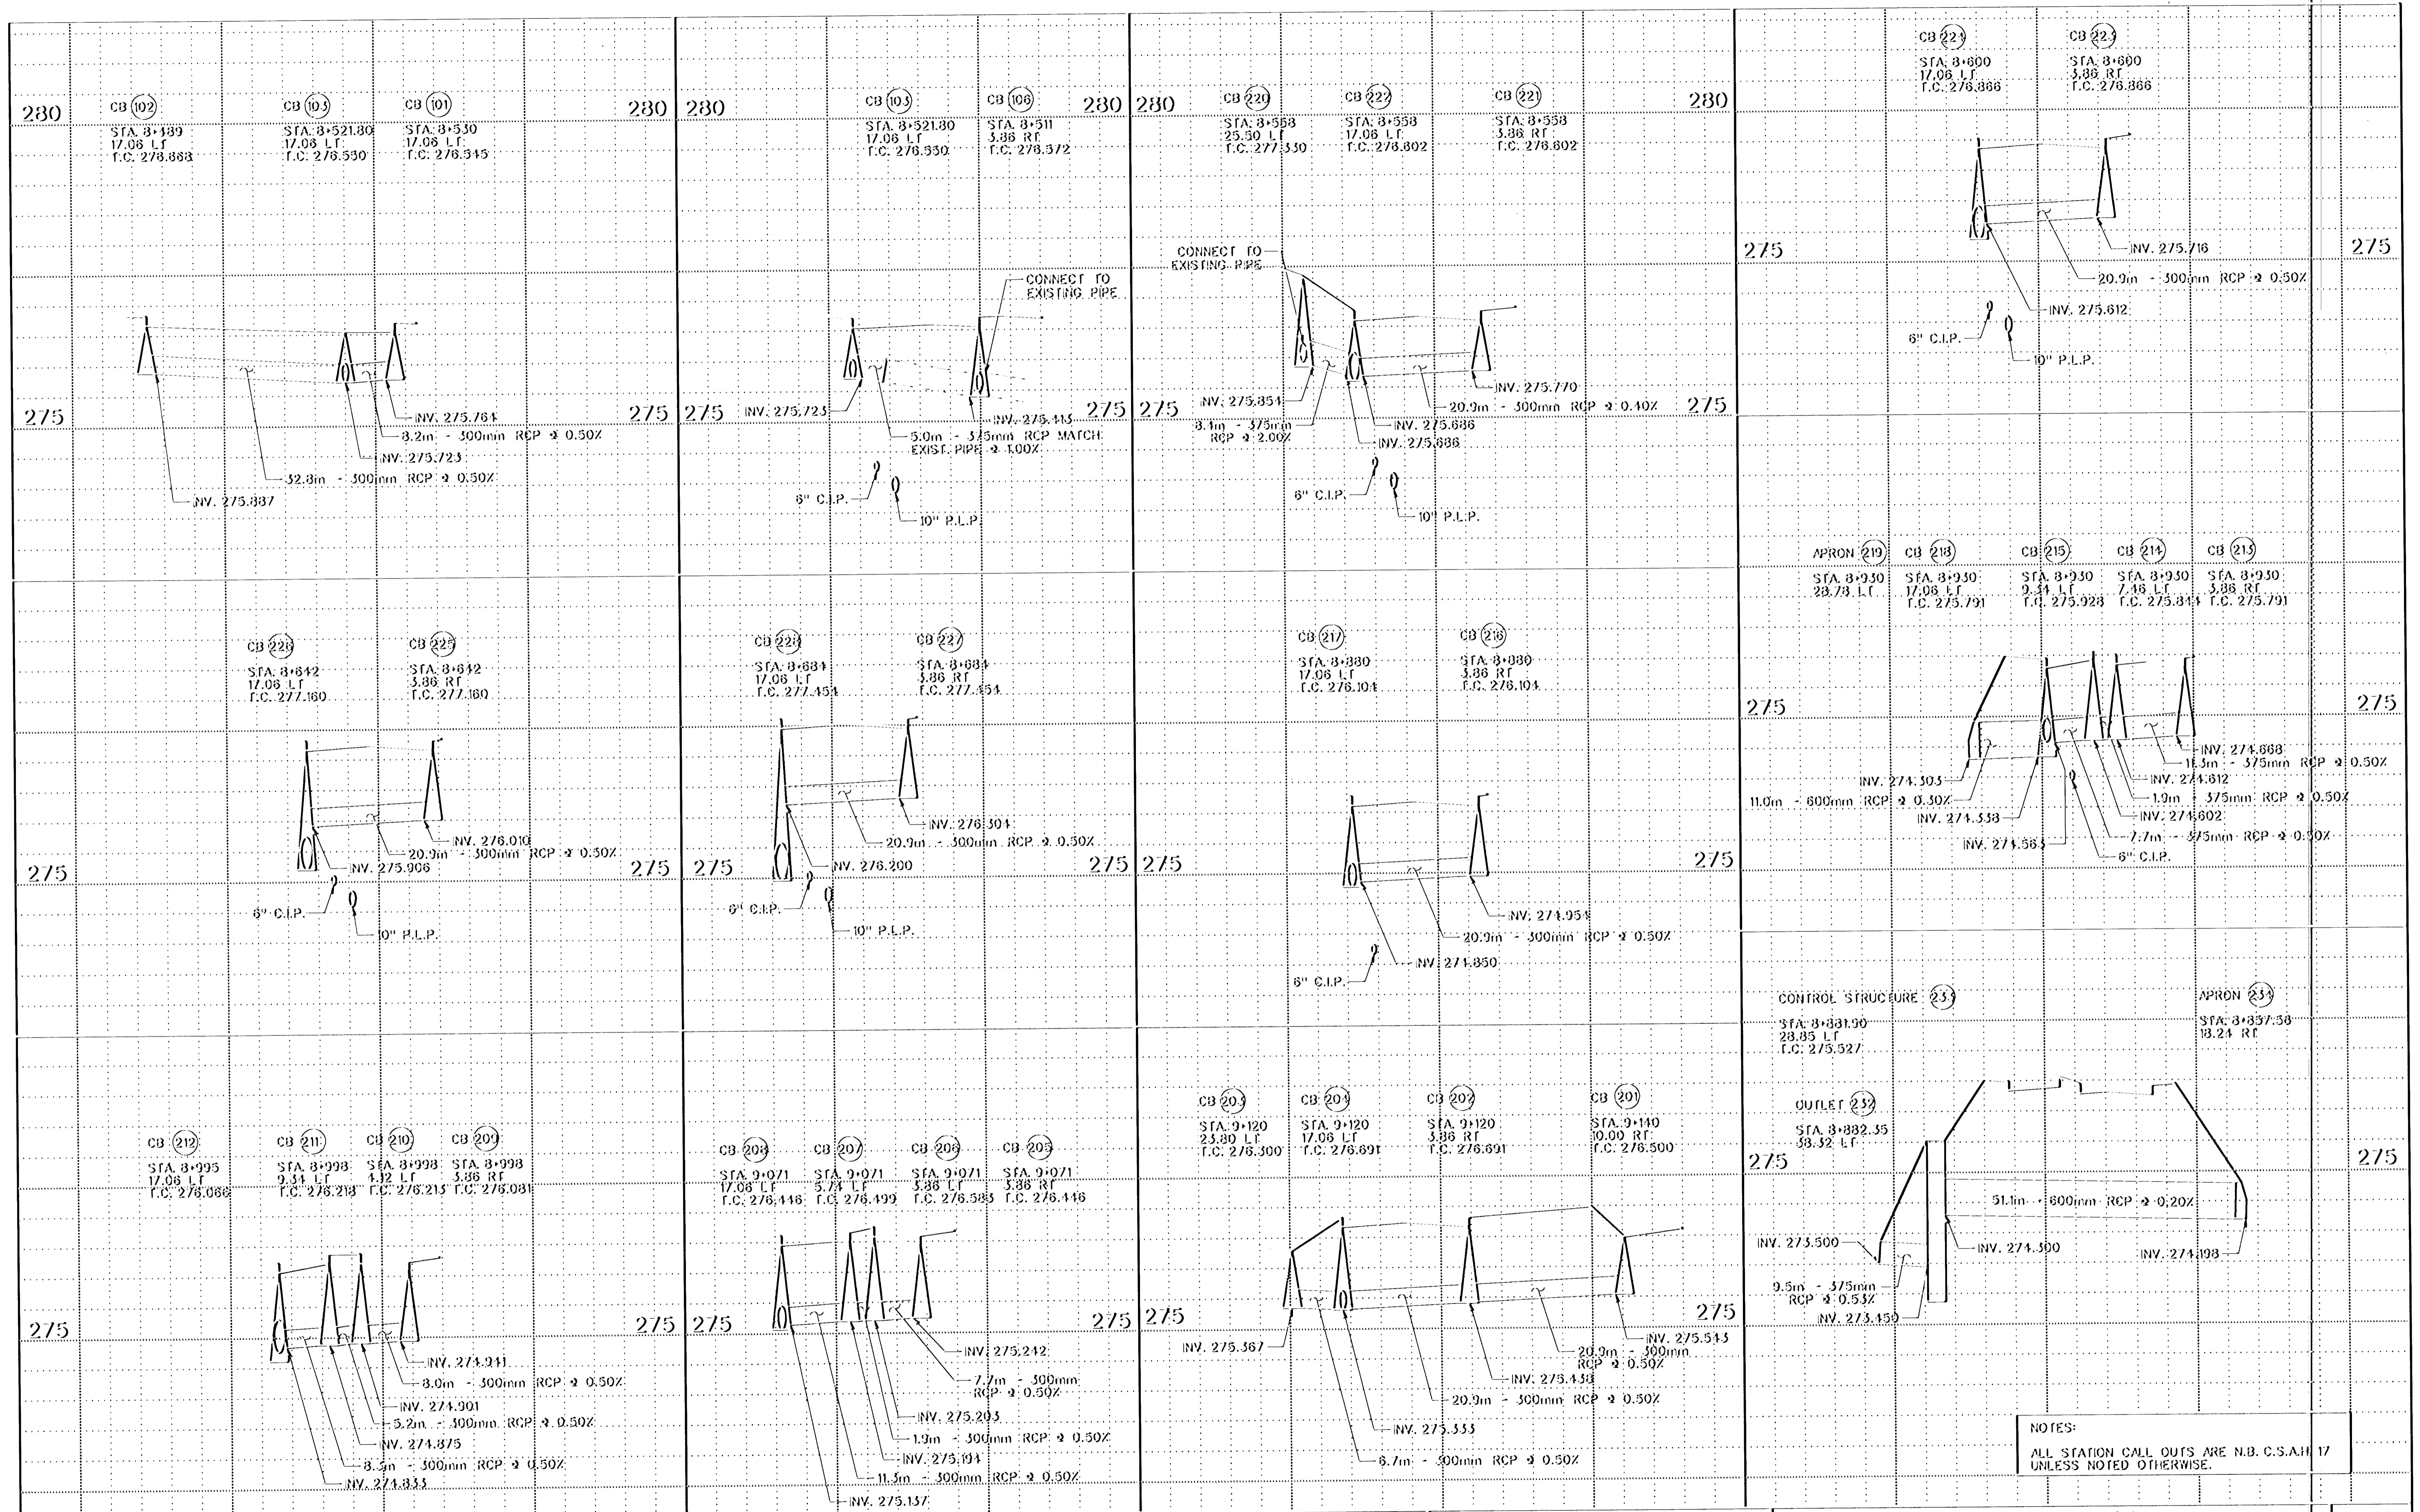
ANOKA COUNTY DRAINAGE TABULATION C.S.A.H. 17 RECONSTRUCTION SHEET 83 OF 236

R DRAINAGE TABULATION																																							
FLOWS FROM: STR. OR APRON INLET	ALIGNMENT	STATION (1)	OFF SET (1)	L/R	TOP OF CAST-ING ELEV (1)	INV ELEV FROM	PIPE SLOPE	FLOWS TO: STR. OR APRON	NEW STRUCTURE CONSTRUCTION				DRAINAGE PIPE																							RIP RAP CLASS III (15)	GUIDE POSTS TYPE E	NOTES	
									DESIGN	PAY HT.	F & I CASTING ASMBLY TYPE	RE- QUIRED (12)	RCP (DESIGN 3006)																										
													300mm CL II	300mm CL III	375mm CL II	375mm CL III	450mm CL II	450mm CL III	525mm CL II	525mm CL IV	525mm CL V	600mm CL II	600mm CL III	600mm CL IV	675mm CL V	750mm CL II	750mm CL III	825mm CL III	900mm CL II	900mm CL IV	375mm 16 GA.	450mm 16 GA.							
508	NB CSAH 17	10+519.00	28.46	L	279.950	277.650	0.01	609	G	1.24	B-1		14.9																										
609	NB CSAH 17	10+519.00	11.53	L	279.230	277.501	0.01	610	F	1.66	B-1		5.4																								4		
610	NB CSAH 17	10+519.00	6.10	L	279.175	277.447	0.01	611	F	1.66	B-1		10.0																								4		
611	NB CSAH 17	10+519.00	3.86	R	279.096	274.575	0.0025	612	F	4.46	B-1	Y																								5,14			
612	NB CSAH 17	10+500.00	27.00	R		274.500			APRON																										4.4				
TOTAL PIPE SEWER									164.76				1020.8	74.1	271.6	10.2	171.3	40.2	376.2	50.0	38.5	205.8	104.2	195.8		100.7	4.0	143.4	55.8	49.0	75.0	36.2							
521	SB I-35W	19+186.80	20.10	L		274.470	0.006		DITCH	APRON																										2.8	1.0	2,13	
522	NW RAMP	5+200.00	24.00	R		274.250	0.001	523	APRON																												1.0	13	
523	NW RAMP	5+220.00	19.50	L		274.200			DITCH	APRON																											5.3	1.0	13
TOTAL PIPE CULVERT													1.0		1.0		4.6	1.0				1.0	3.0		2.0	44.0	2.0			1.0	2.0	2.0	1.0	48.5	12.0				

- NOTES
- STATIONS, OFFSETS, AND TOP OF CASTING ELEVATIONS ARE GIVEN TO CENTER OF CASTING. CENTER OF CATCH BASIN CASTING IS 0.34 m FROM FACE OF CURB. SUMP DEPTH IS 25 mm ON OUTSIDE CURB AND 50 mm ON MEDIAN CURB. PIPE APRON LOCATIONS ARE GIVEN AT TOE OF APRON.
 - MATCH EXISTING PIPE. VERIFY EXISTING PIPE ELEVATION IN THE FIELD. CONNECTION TO EXISTING PIPE CONSIDERED INCIDENTAL.
 - CONSTRUCT OVER EXISTING PIPE. VERIFY EXISTING PIPE ELEVATION IN THE FIELD. CONNECTION TO EXISTING PIPE CONSIDERED INCIDENTAL.
 - USE TYPE C CONE.
 - USE TYPE B CONE.
 - SUBMERGED OUTLET, NO APRON.
 - OUTLET CONTROL STRUCTURE, DESIGN SPECIAL 1 (SEE DETAIL).
 - STATION AND OFFSET GIVEN TO INSIDE WALL OF BOX CULVERT.
 - TEMPORARY STORM PIPE TO BE IN PLACE DURING BOX CULVERT CONSTRUCTION. REMOVE PIPE AND APRON AND REPAIR CB 309 WHEN BOX CULVERT CONSTRUCTION IS COMPLETE.
 - PIPE LENGTH INCLUDES TWO (2) 25 DEGREE ELBOWS. FURNISHING AND INSTALLING PIPE ELBOWS CONSIDERED INCIDENTAL.
 - BLANK.
 - FURNISHING AND INSTALLING STEPS CONSIDERED INCIDENTAL.
 - TIE ALL JOINTS. FURNISHING AND INSTALLING PIPE TIES CONSIDERED INCIDENTAL.
 - TIE LAST THREE JOINTS AT APRON END. FURNISHING AND INSTALLING PIPE TIES CONSIDERED INCIDENTAL.
 - GRANULAR FILTER BLANKET OR GEOTEXTILE MATERIAL REQUIRED CONSIDERED INCIDENTAL.
 - FURNISH AND INSTALL TRASH GUARD.
 - FURNISH AND INSTALL TRASH GUARD DESIGN SPECIAL (SEE DETAIL).
 - FURNISH AND INSTALL PRECAST CONCRETE END SECTION (1:4 SLOPE, MALE END) AND SAFETY GRATE.
 - FURNISH AND INSTALL PRECAST CONCRETE END SECTION (1:6 SLOPE, MALE END).
 - PIPE LENGTH INCLUDES EIGHT (8) 7.5 DEGREE LONG RADIUS BENDS. FURNISHING AND INSTALLING PIPE BENDS WILL BE PAID FOR AS 600mm RCP.
 - PLUG HOLE FROM OLD PIPE. CONNECTION TO EXISTING PIPE AT NEW LOCATION CONSIDERED INCIDENTAL.

Q CASTING ASSEMBLIES SUMMARY						
ASSEMBLY	RING OR FRAME CASTING	COVER OR GRATE CASTING	CURB BOX	STANDARD PLATE NO.	QUANTITY	REMARKS
B-1	801			M4126	109	CATCH BASIN
		810		M4149		
			821B	M4161		
D-4	805			M4129	3	CATCH BASIN
		816		M4154		
M-11	Round Conc.			M4143	5	CATCH BASIN
		731		M4143		
A-7D	700-7			M4101	3	MANHOLE
		715		M4110		
PROJECT TOTALS:					120	

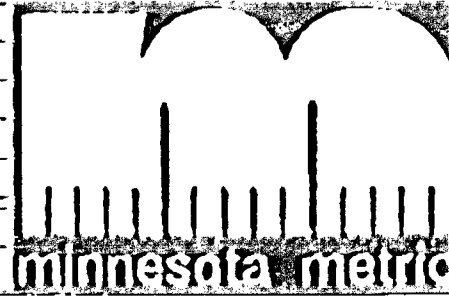				I hereby certify that this plan, specification or report was prepared by me or under my direct supervision and that I am a duly Registered Professional Engineer under the laws of the State of Minnesota. <i>M. Hansen</i> Date: 3-21-97 Reg. No. 213647		STATE AID PROJECT NO. S.A.P. 02-617-11 S.A.P. 106-020-12 S.A.P. 106-030-03 CO. PROJECT NO.		DRAWN BY V. GRAF DATE 12-96 DESIGNED BY M. HANSEN DATE 12-96 CHECKED BY D. DEMERS DATE 1-97 COMM. NO. 0262410				ANOKA COUNTY DRAINAGE TABULATION C.S.A.H. 17 RECONSTRUCTION		SHEET 84 OF 236
--	--	--	--	---	--	--	--	--	--	---	--	---	--	--------------------------



NOTES:
ALL STATION CALL OUTS ARE N.B. C.S.A.H. 17
UNLESS NOTED OTHERWISE.

NO	DATE	BY	CKD	APPR	REVISION

NAME: SPI 110.PLN DATE: Mar. 17, 1997

minnesota metric

I hereby certify that this plan, specification or report was prepared by me or under my direct supervision and that I am a duly Registered Professional Engineer under the laws of the State of Minnesota.

M. Hansen
Date 3-21-97 Reg. No. 21364

STATE AID PROJECT NO. S.A.P. 02-817-11 S.A.P. 108-020-12 S.A.P. 108-030-03


CO. PROJECT NO.

DRAWN BY DATE L. VONDRASEK 11-98
DESIGNED BY M. HANSEN 11-98
CHECKED BY D. DEMERS 5-97
COMM. NO. 0962410




ANOKA COUNTY
MISCELLANEOUS STORM SEWER PROFILES
C.S.A.H. 17 RECONSTRUCTION

SHEET
85
OF
236

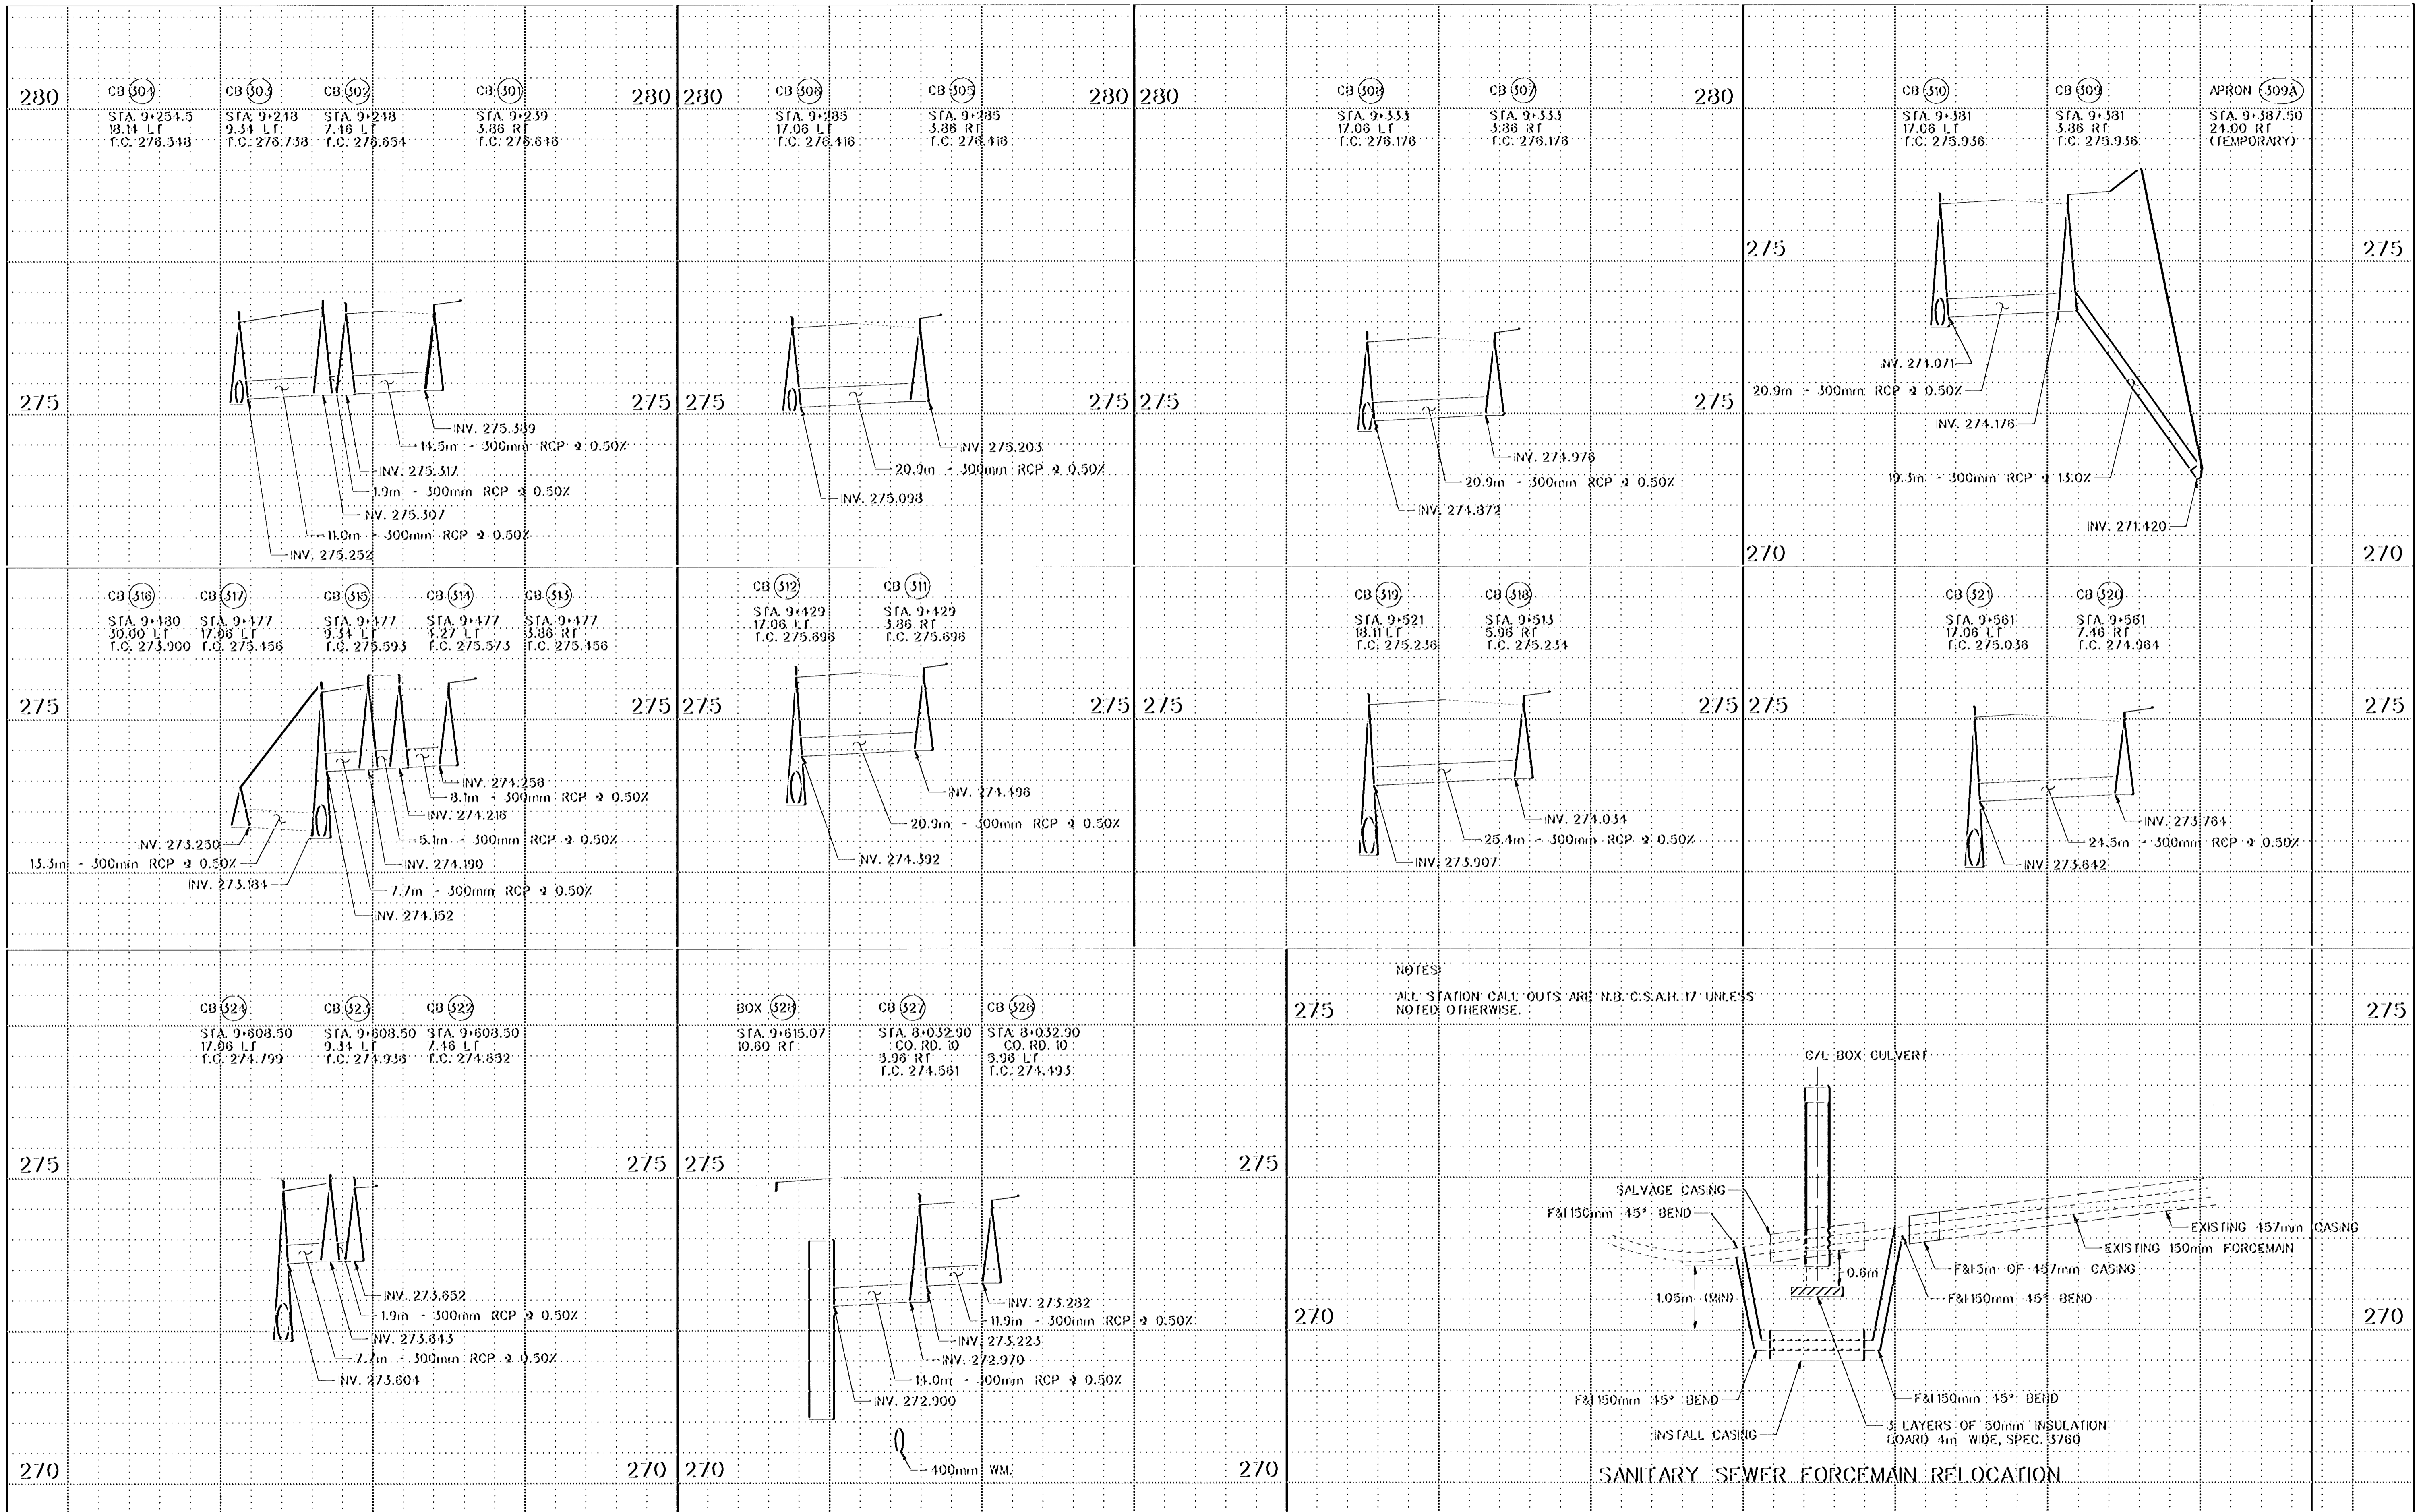

NOTES:
ALL STATION CALL OUTS ARE N.B. C.S.A.H. 17 UNLESS NOTED OTHERWISE.

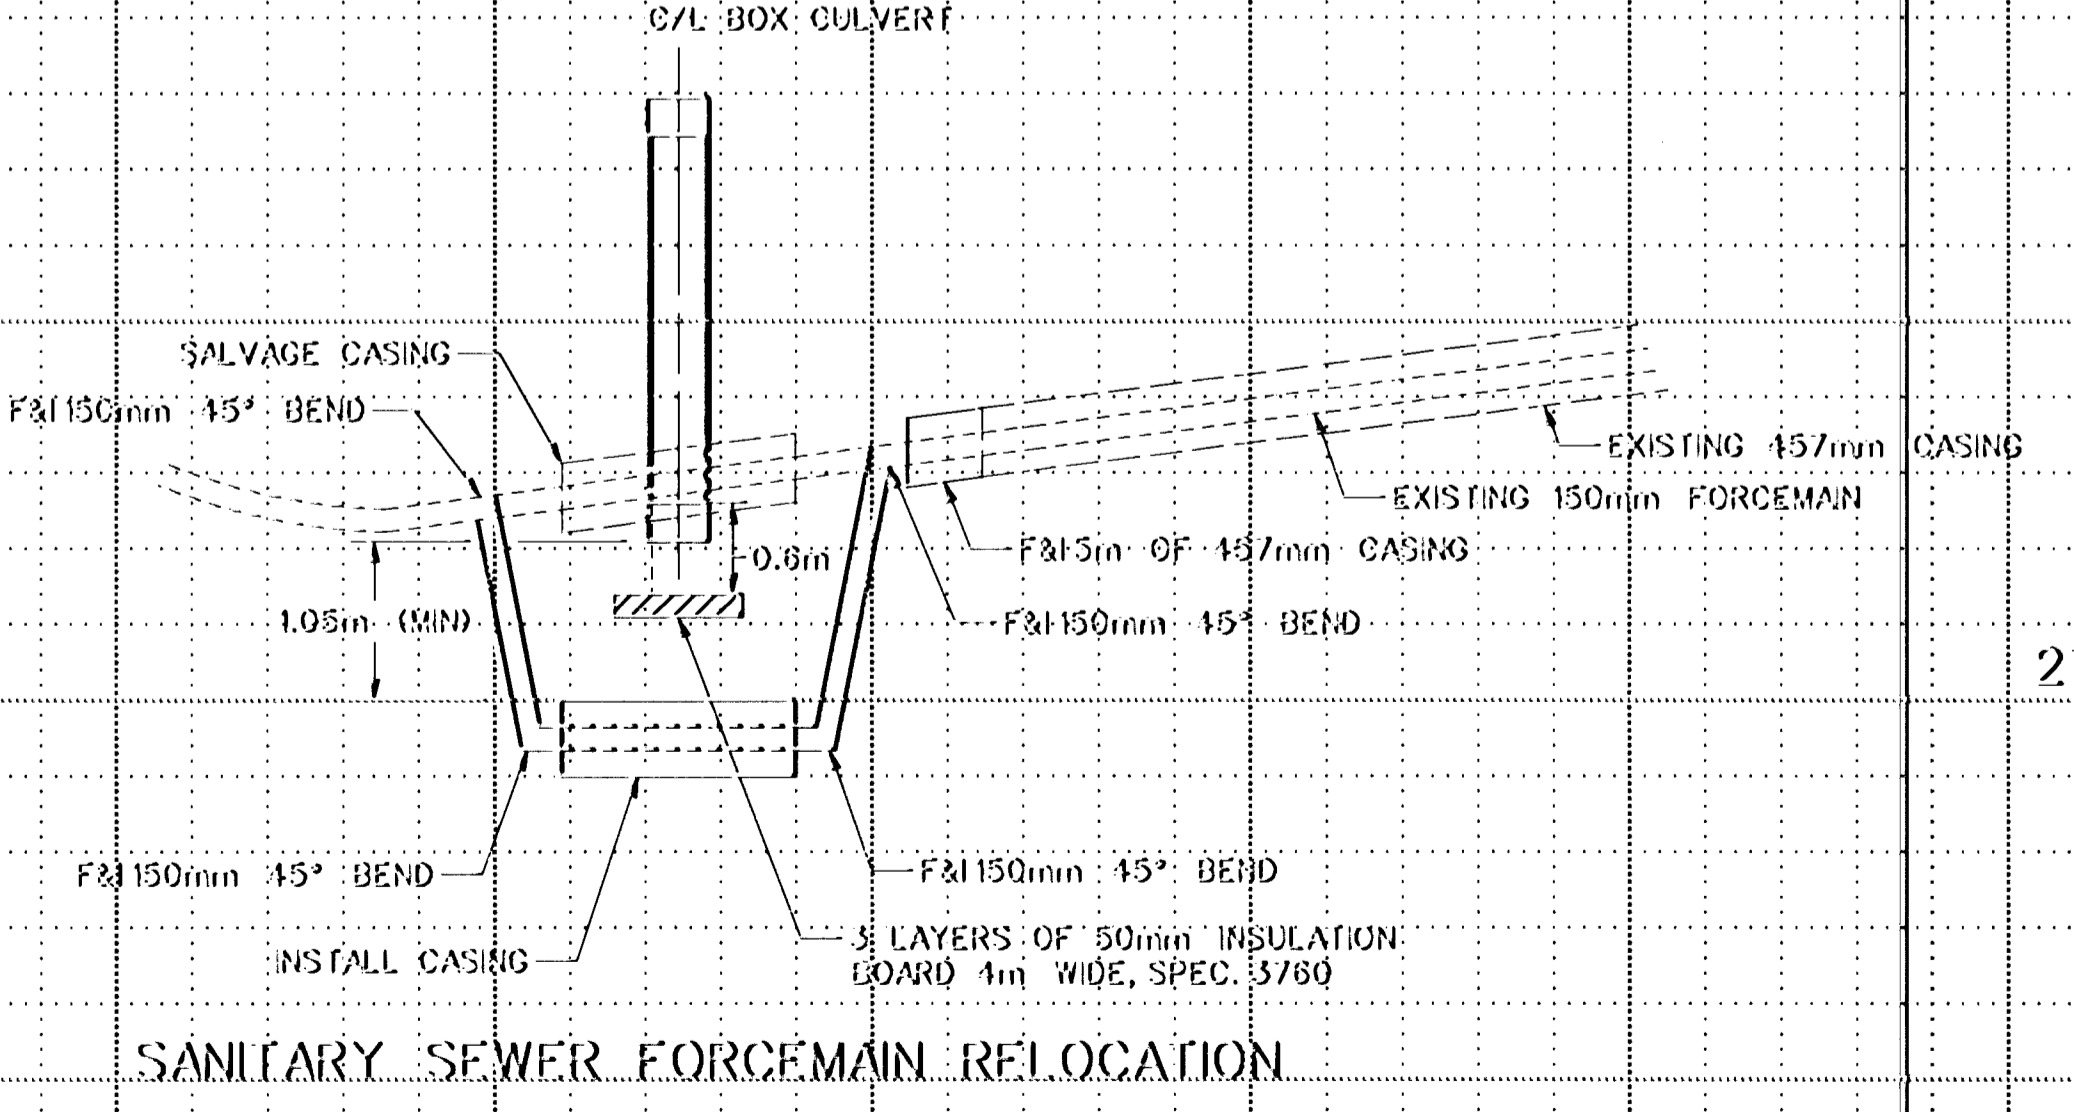


NO	DATE	BY	CHKD	APPR	REVISION
NAME: SP2 110.PLN DATE: Mar. 17, 1997					

I hereby certify that this plan, specification or report was prepared by me or under my direct supervision and that I am a duly Registered Professional Engineer under the laws of the State of Minnesota.


Wendell D. Heuser
Date: 3-21-97 Reg. No. 21364

STATE AID PROJECT NO. S.A.P. 02-617-11 S.A.P. 106-020-12 S.A.P. 106-030-03
CO. PROJECT NO.

DRAWN BY DATE L. VanDRASEK 11-96
DESIGNED BY M. HANSEN 11-96
CHECKED BY D. DEMERS 5-97
COMM. NO. 0982410

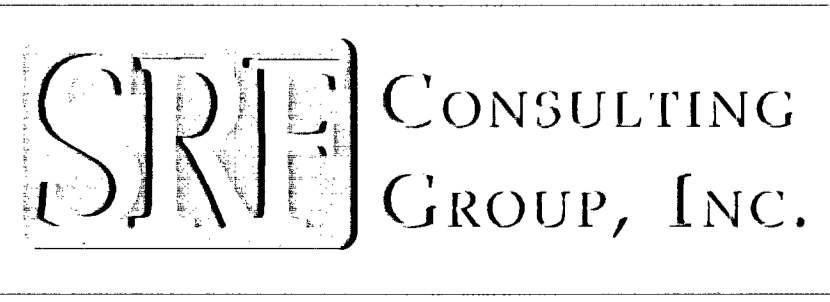

ANOKA COUNTY
MISCELLANEOUS STORM SEWER PROFILES
C.S.A.H. 17 RECONSTRUCTION

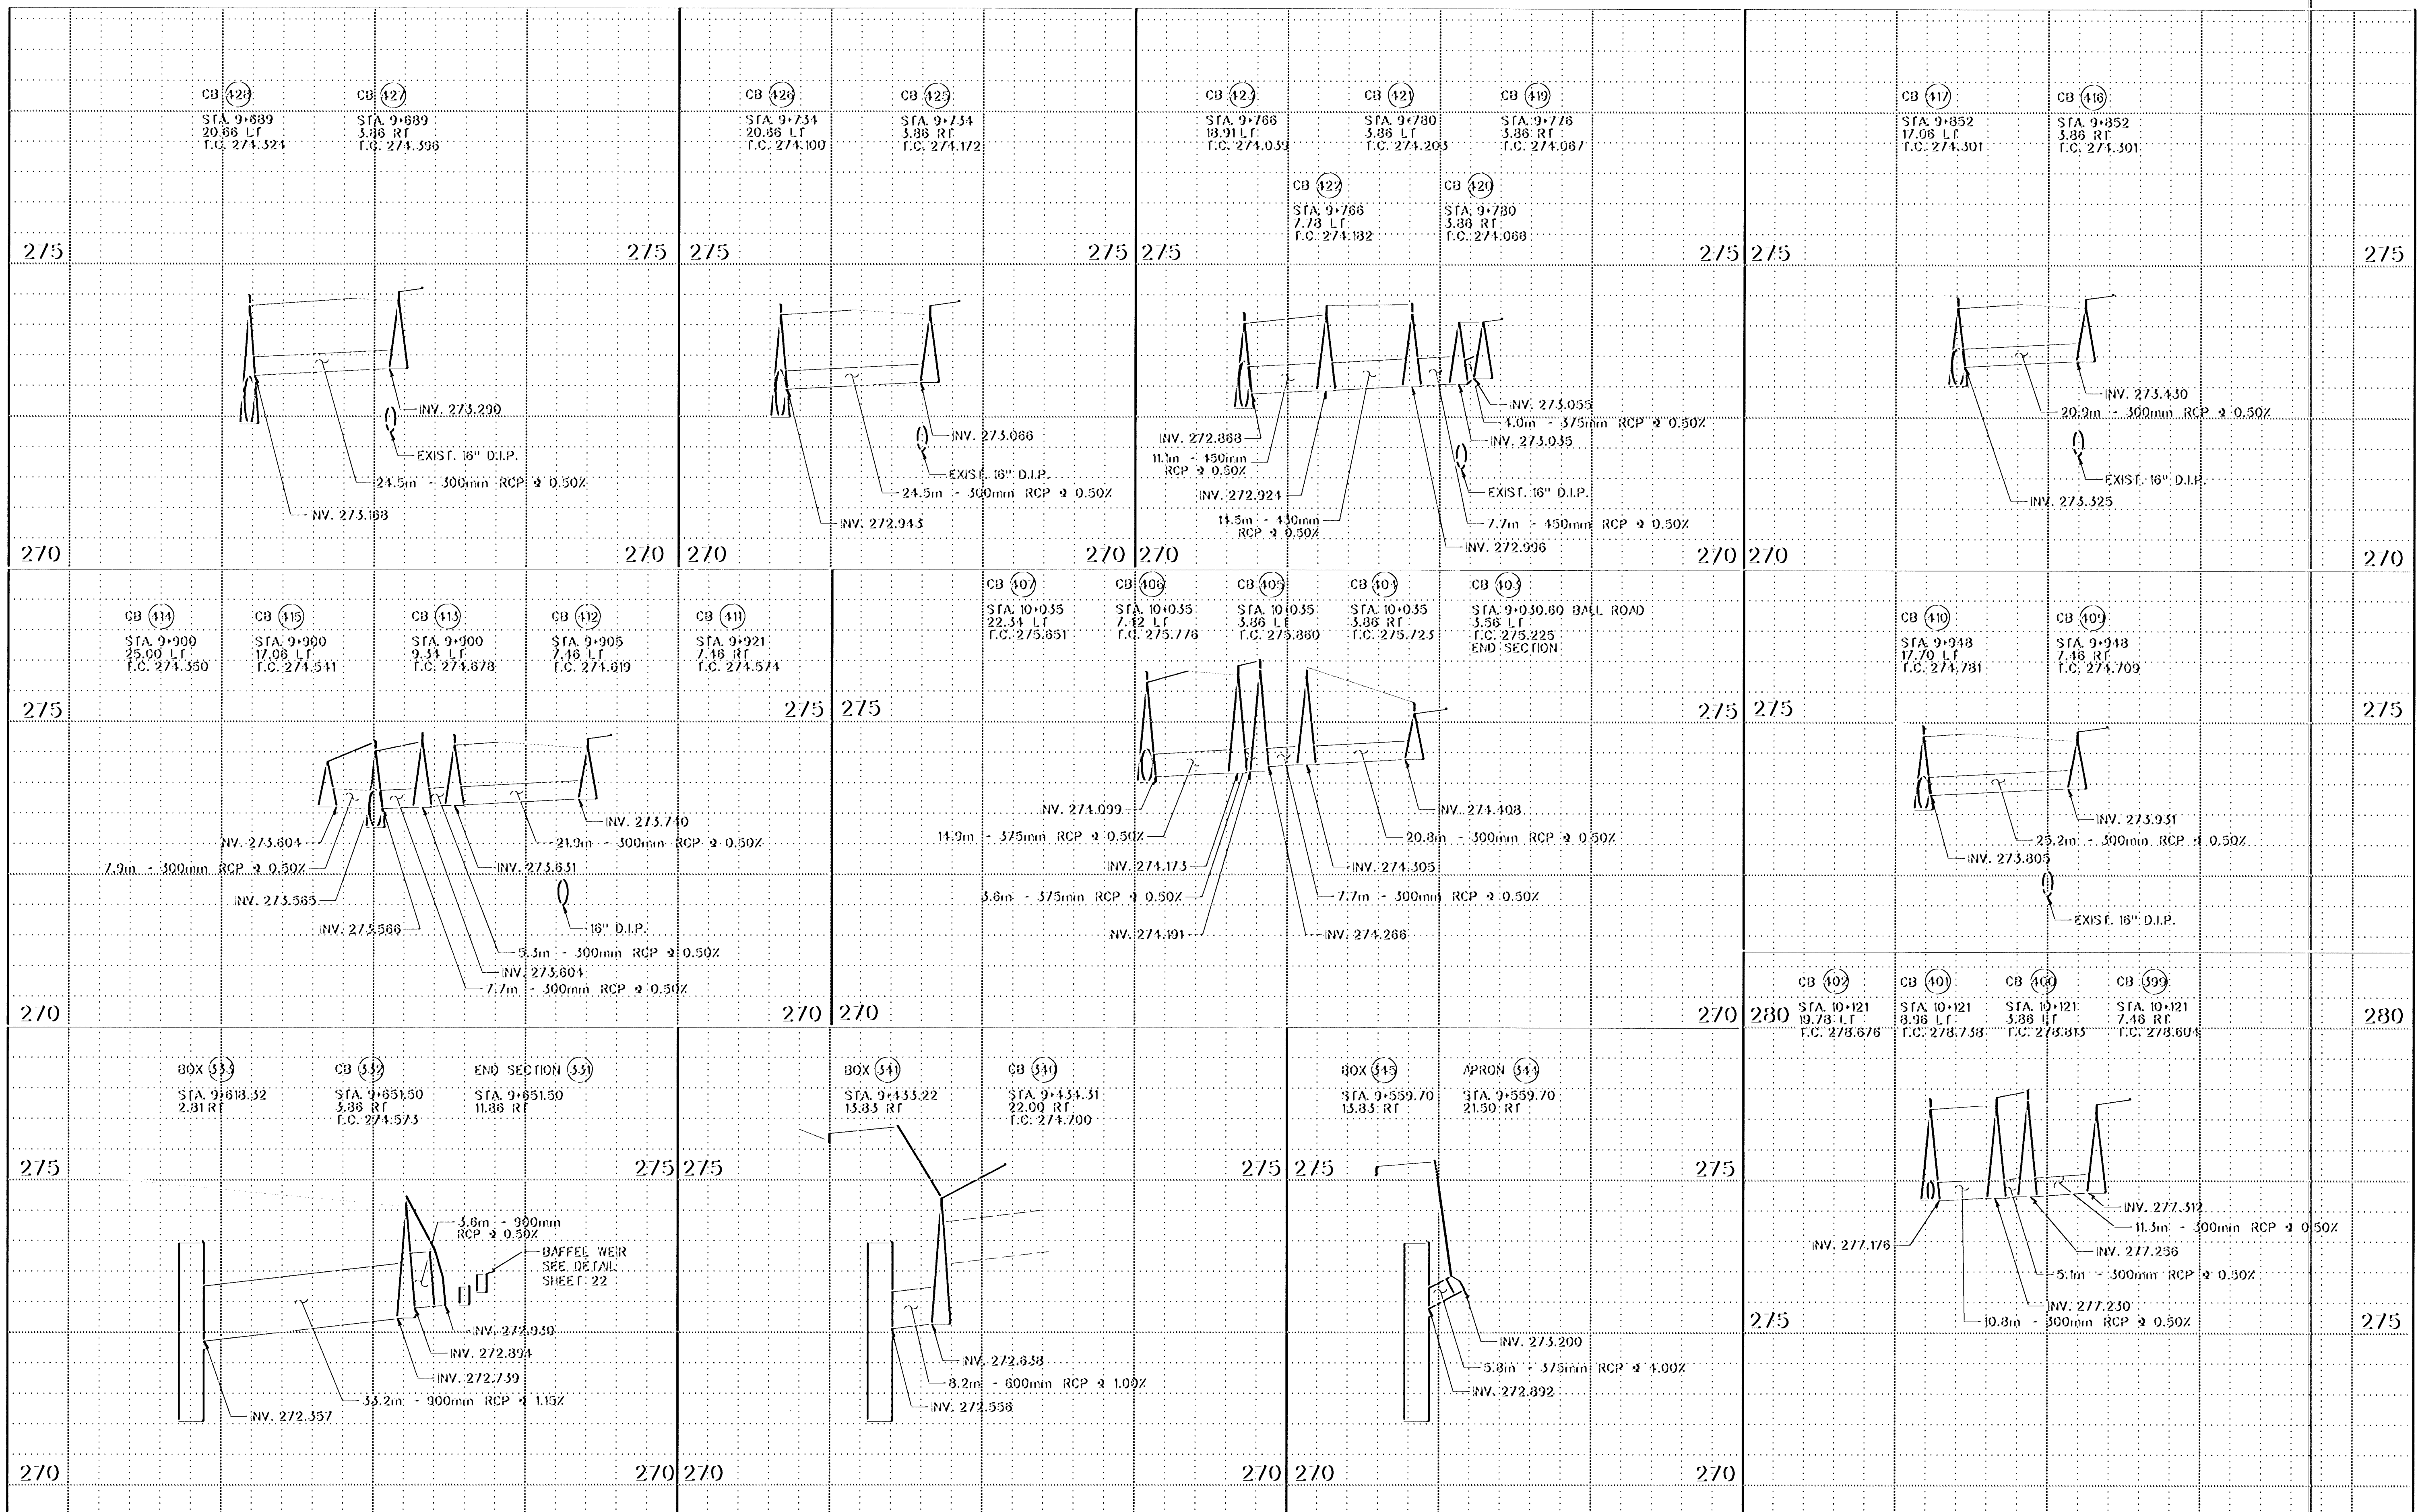

NO	DATE	BY	CHKD	APPR	REVISION
1	3-28-97	MCI		DAD	ACHD COMMENTS

I hereby certify that this plan, specification or report was prepared by me or under my direct supervision and that I am a duly Registered Professional Engineer under the laws of the State of Minnesota.

Michael D. Hansen
 Date **3-21-97** Reg. No. **21364**

STATE AID PROJECT NO.
 S.A.P. 02-617-11
 S.A.P. 108-020-12
 S.A.P. 108-030-03


CO. PROJECT NO.

DRAWN BY DATE
 L. VONDRASEK 11-96

DESIGNED BY
 M. HANSEN 11-96


CHECKED BY
 D. DEMERS 5-97

COMM. NO.
 0982410

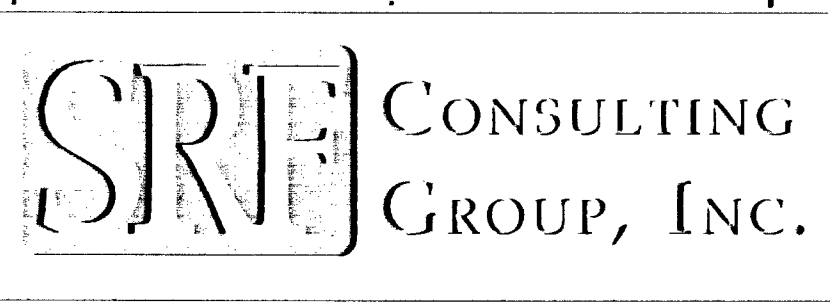

ANOKA COUNTY
 MISCELLANEOUS STORM SEWER PROFILES
 C.S.A.H. 17 RECONSTRUCTION

SHEET
 87
 OF
 236

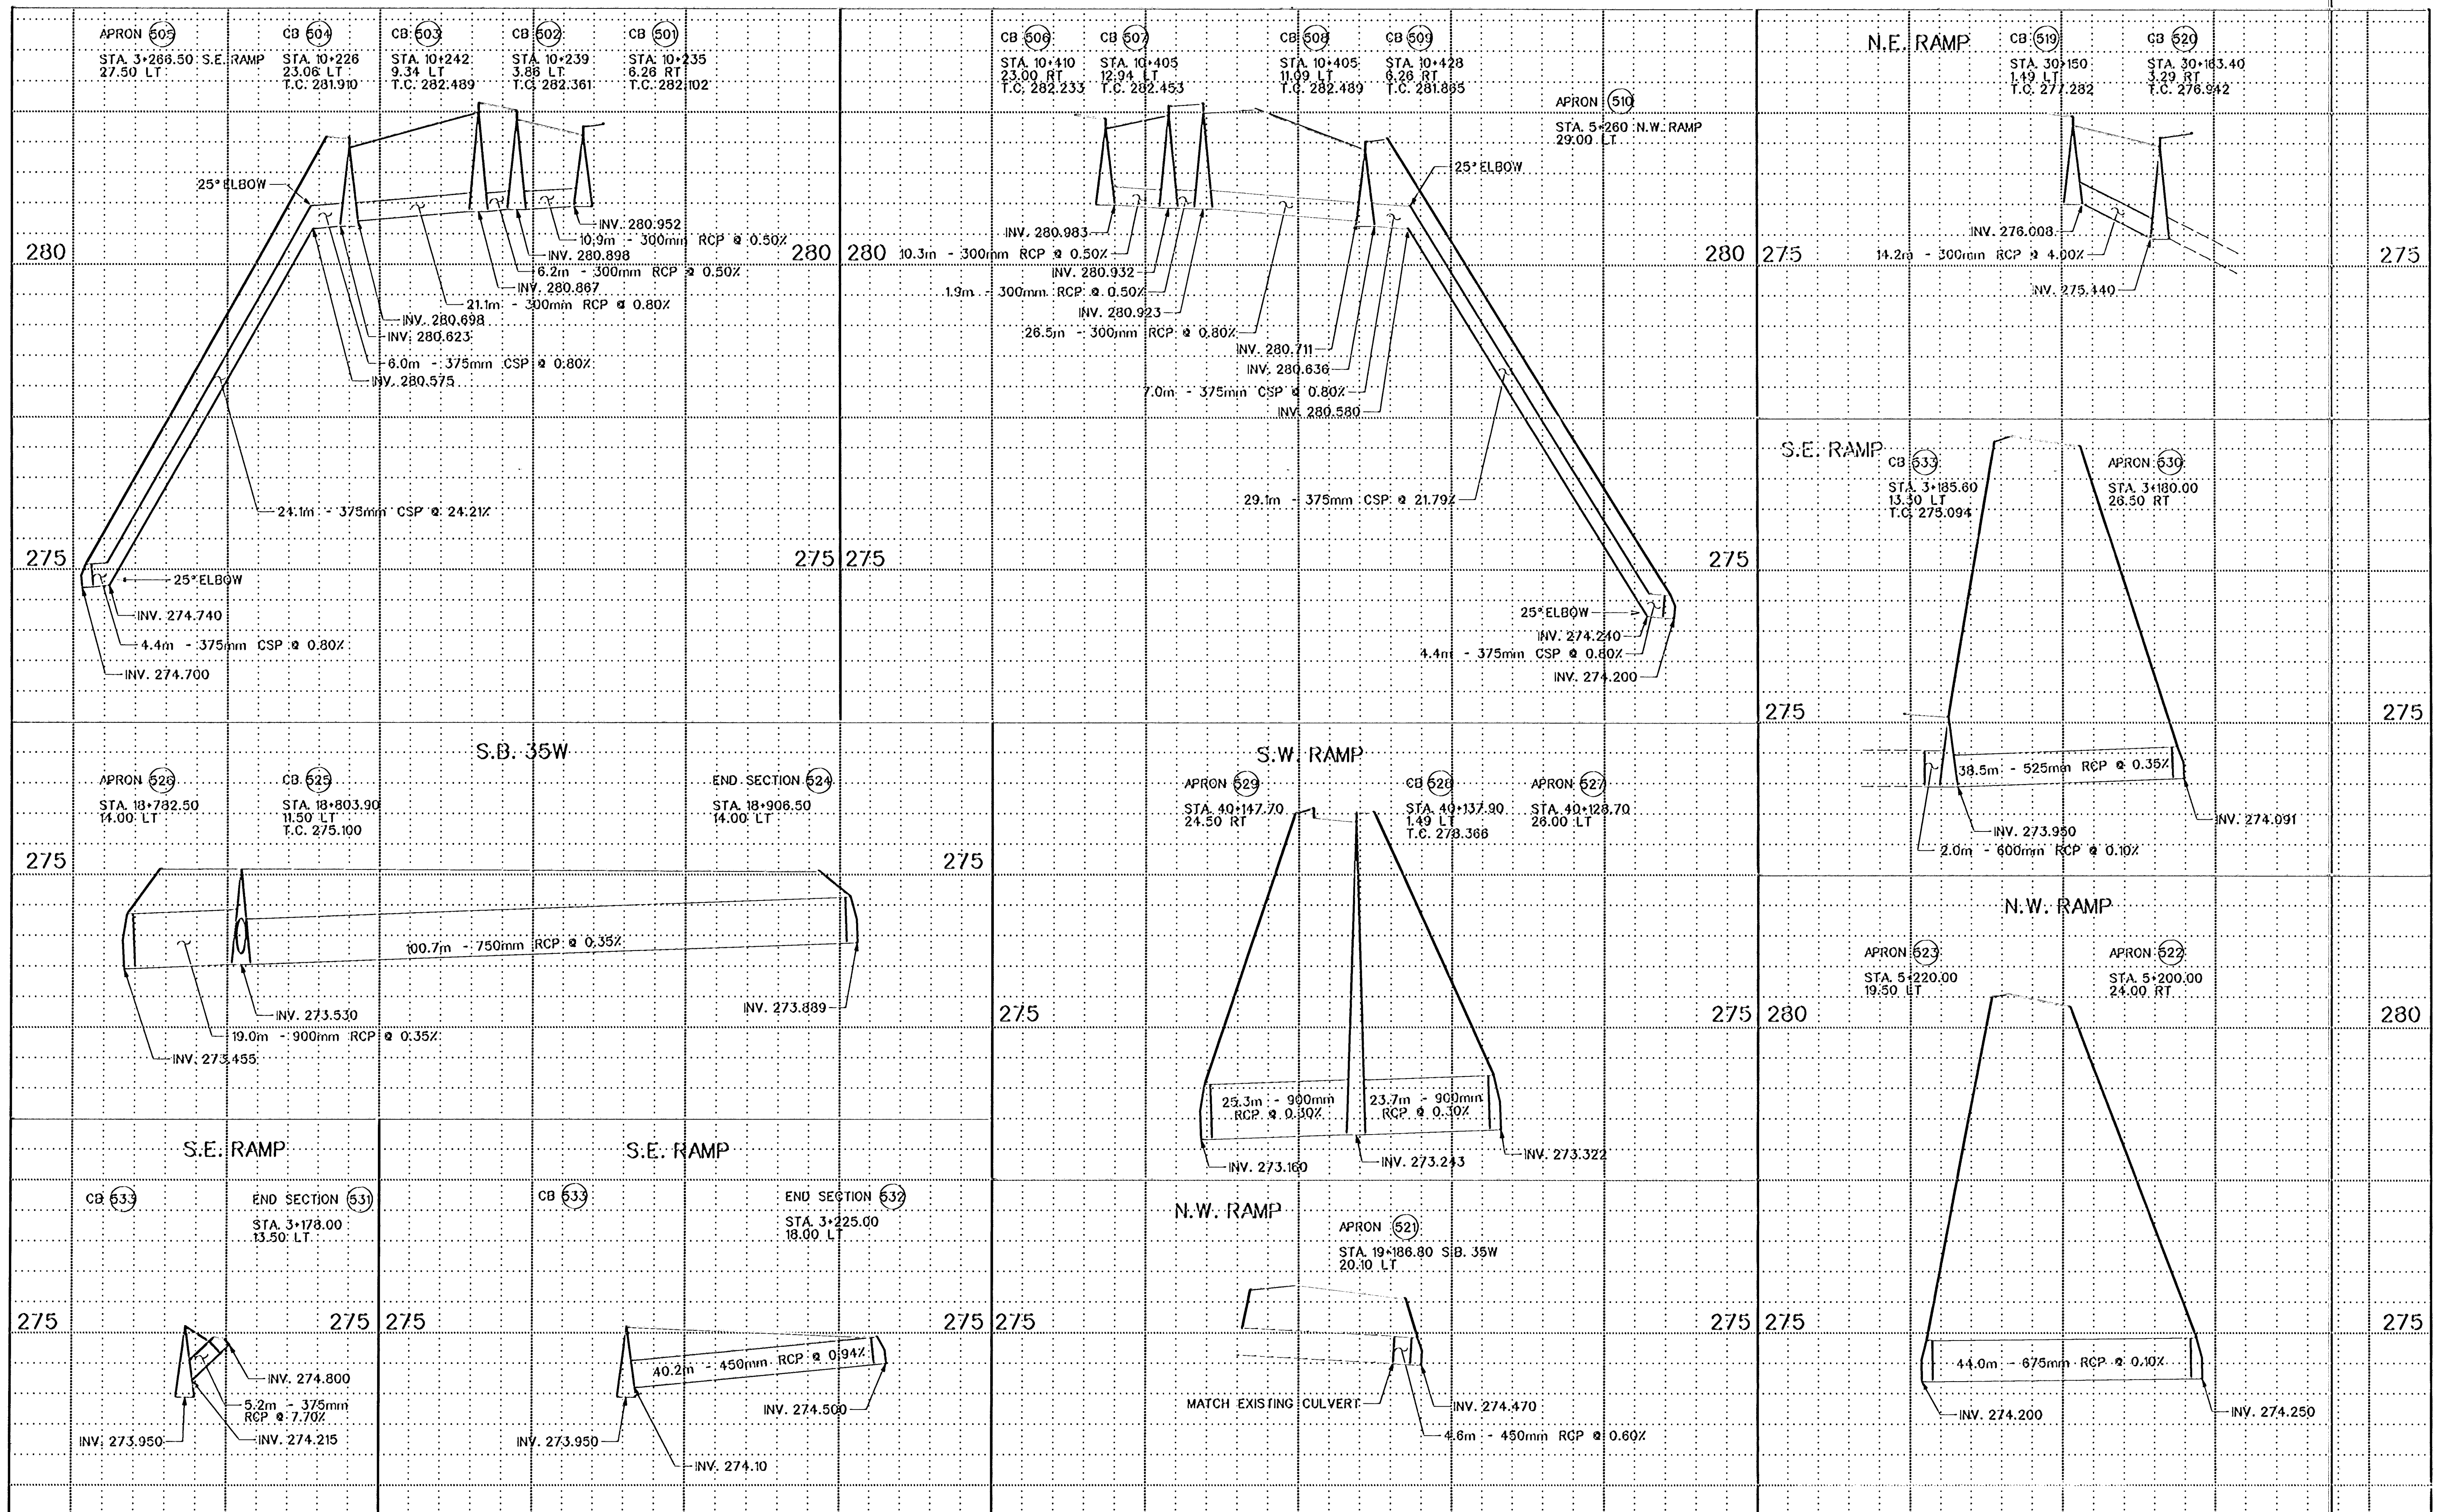

1	4-4-97	MCI	MDH	DAD	REVISE CB 507 AND 508 LOCATION
NO	DATE	BY	CKD	APPR	REVISION
NAME: SP5 410.PLN DATE: Mar. 17, 1997					



I hereby certify that this plan, specification or report was prepared by me or under my direct supervision and that I am a duly Registered Professional Engineer under the laws of the State of Minnesota.

M. J. D. Hansen
Date: 3-21-97 Reg. No. 21364


STATE AID PROJECT NO.
S.A.P. 02-617-11
S.A.P. 108-020-12
S.A.P. 108-030-03
CO. PROJECT NO.

DRAWN BY DATE
L. VanDRASEK 11-96
DESIGNED BY
M. HANSEN 11-96
CHECKED BY
D. DEMERS 3-97
COMM. NO.
0962410



ANOKA COUNTY
MISCELLANEOUS STORM SEWER PROFILES
C.S.A.H. 17 RECONSTRUCTION

SHEET
83
OF
236

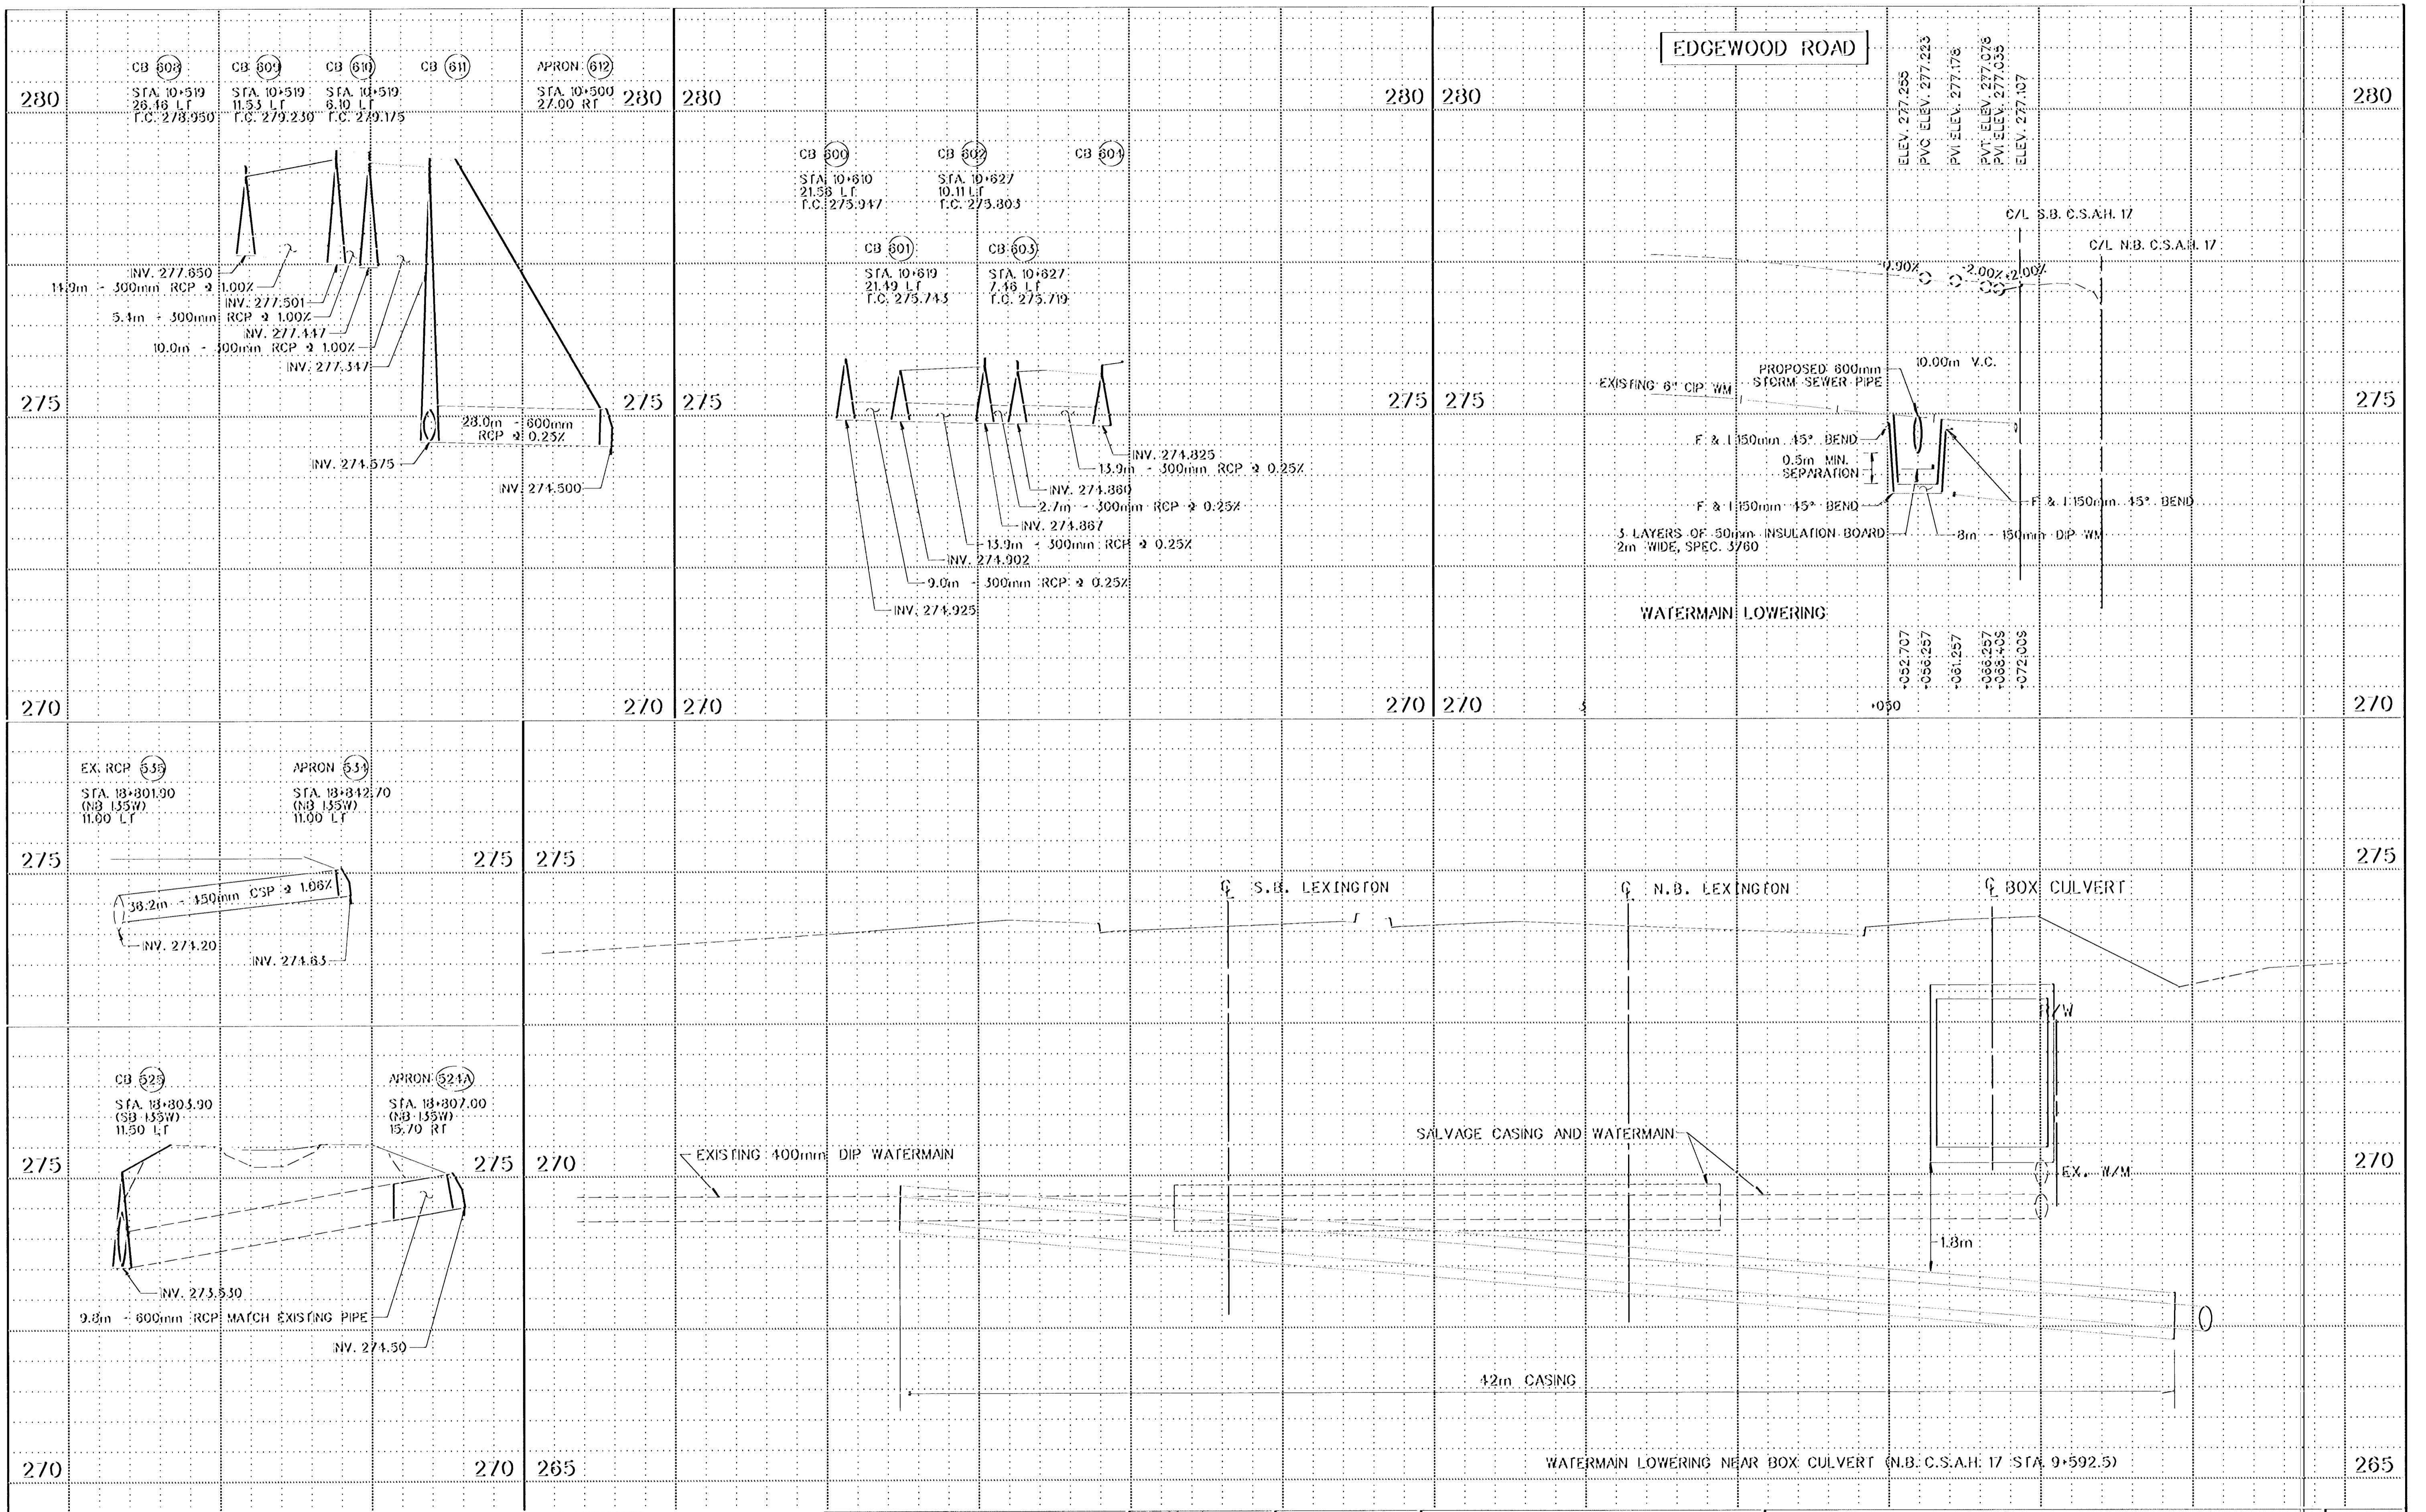

NO.	DATE	BY	CHKD	APPR	REVISION


NAME: SP4 410.PLN DATE: Mar. 17, 1997

I hereby certify that this plan, specification or report was prepared by me or under my direct supervision and that I am a duly Registered Professional Engineer under the laws of the State of Minnesota.

Mark D. Harn
Date: 3-21-97 Reg. No. 21364


STATE AID PROJECT NO.
S.A.P. 02-617-11
S.A.P. 106-020-12
S.A.P. 106-030-03
CO. PROJECT NO.

DRAWN BY DATE
L. VAN DRASEK 11-96
DESIGNED BY
M. HANSEN 11-96
CHECKED BY
D. DEMERS 3-97
COMM. NO.
0962410

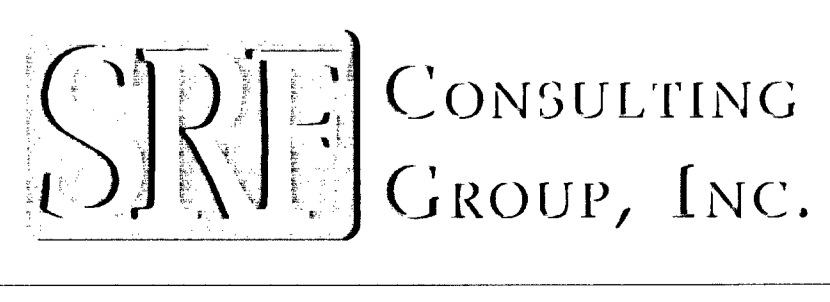


ANOKA COUNTY
MISCELLANEOUS PROFILES
C.S.A.H. 17 RECONSTRUCTION

SHEET
89
OF
236

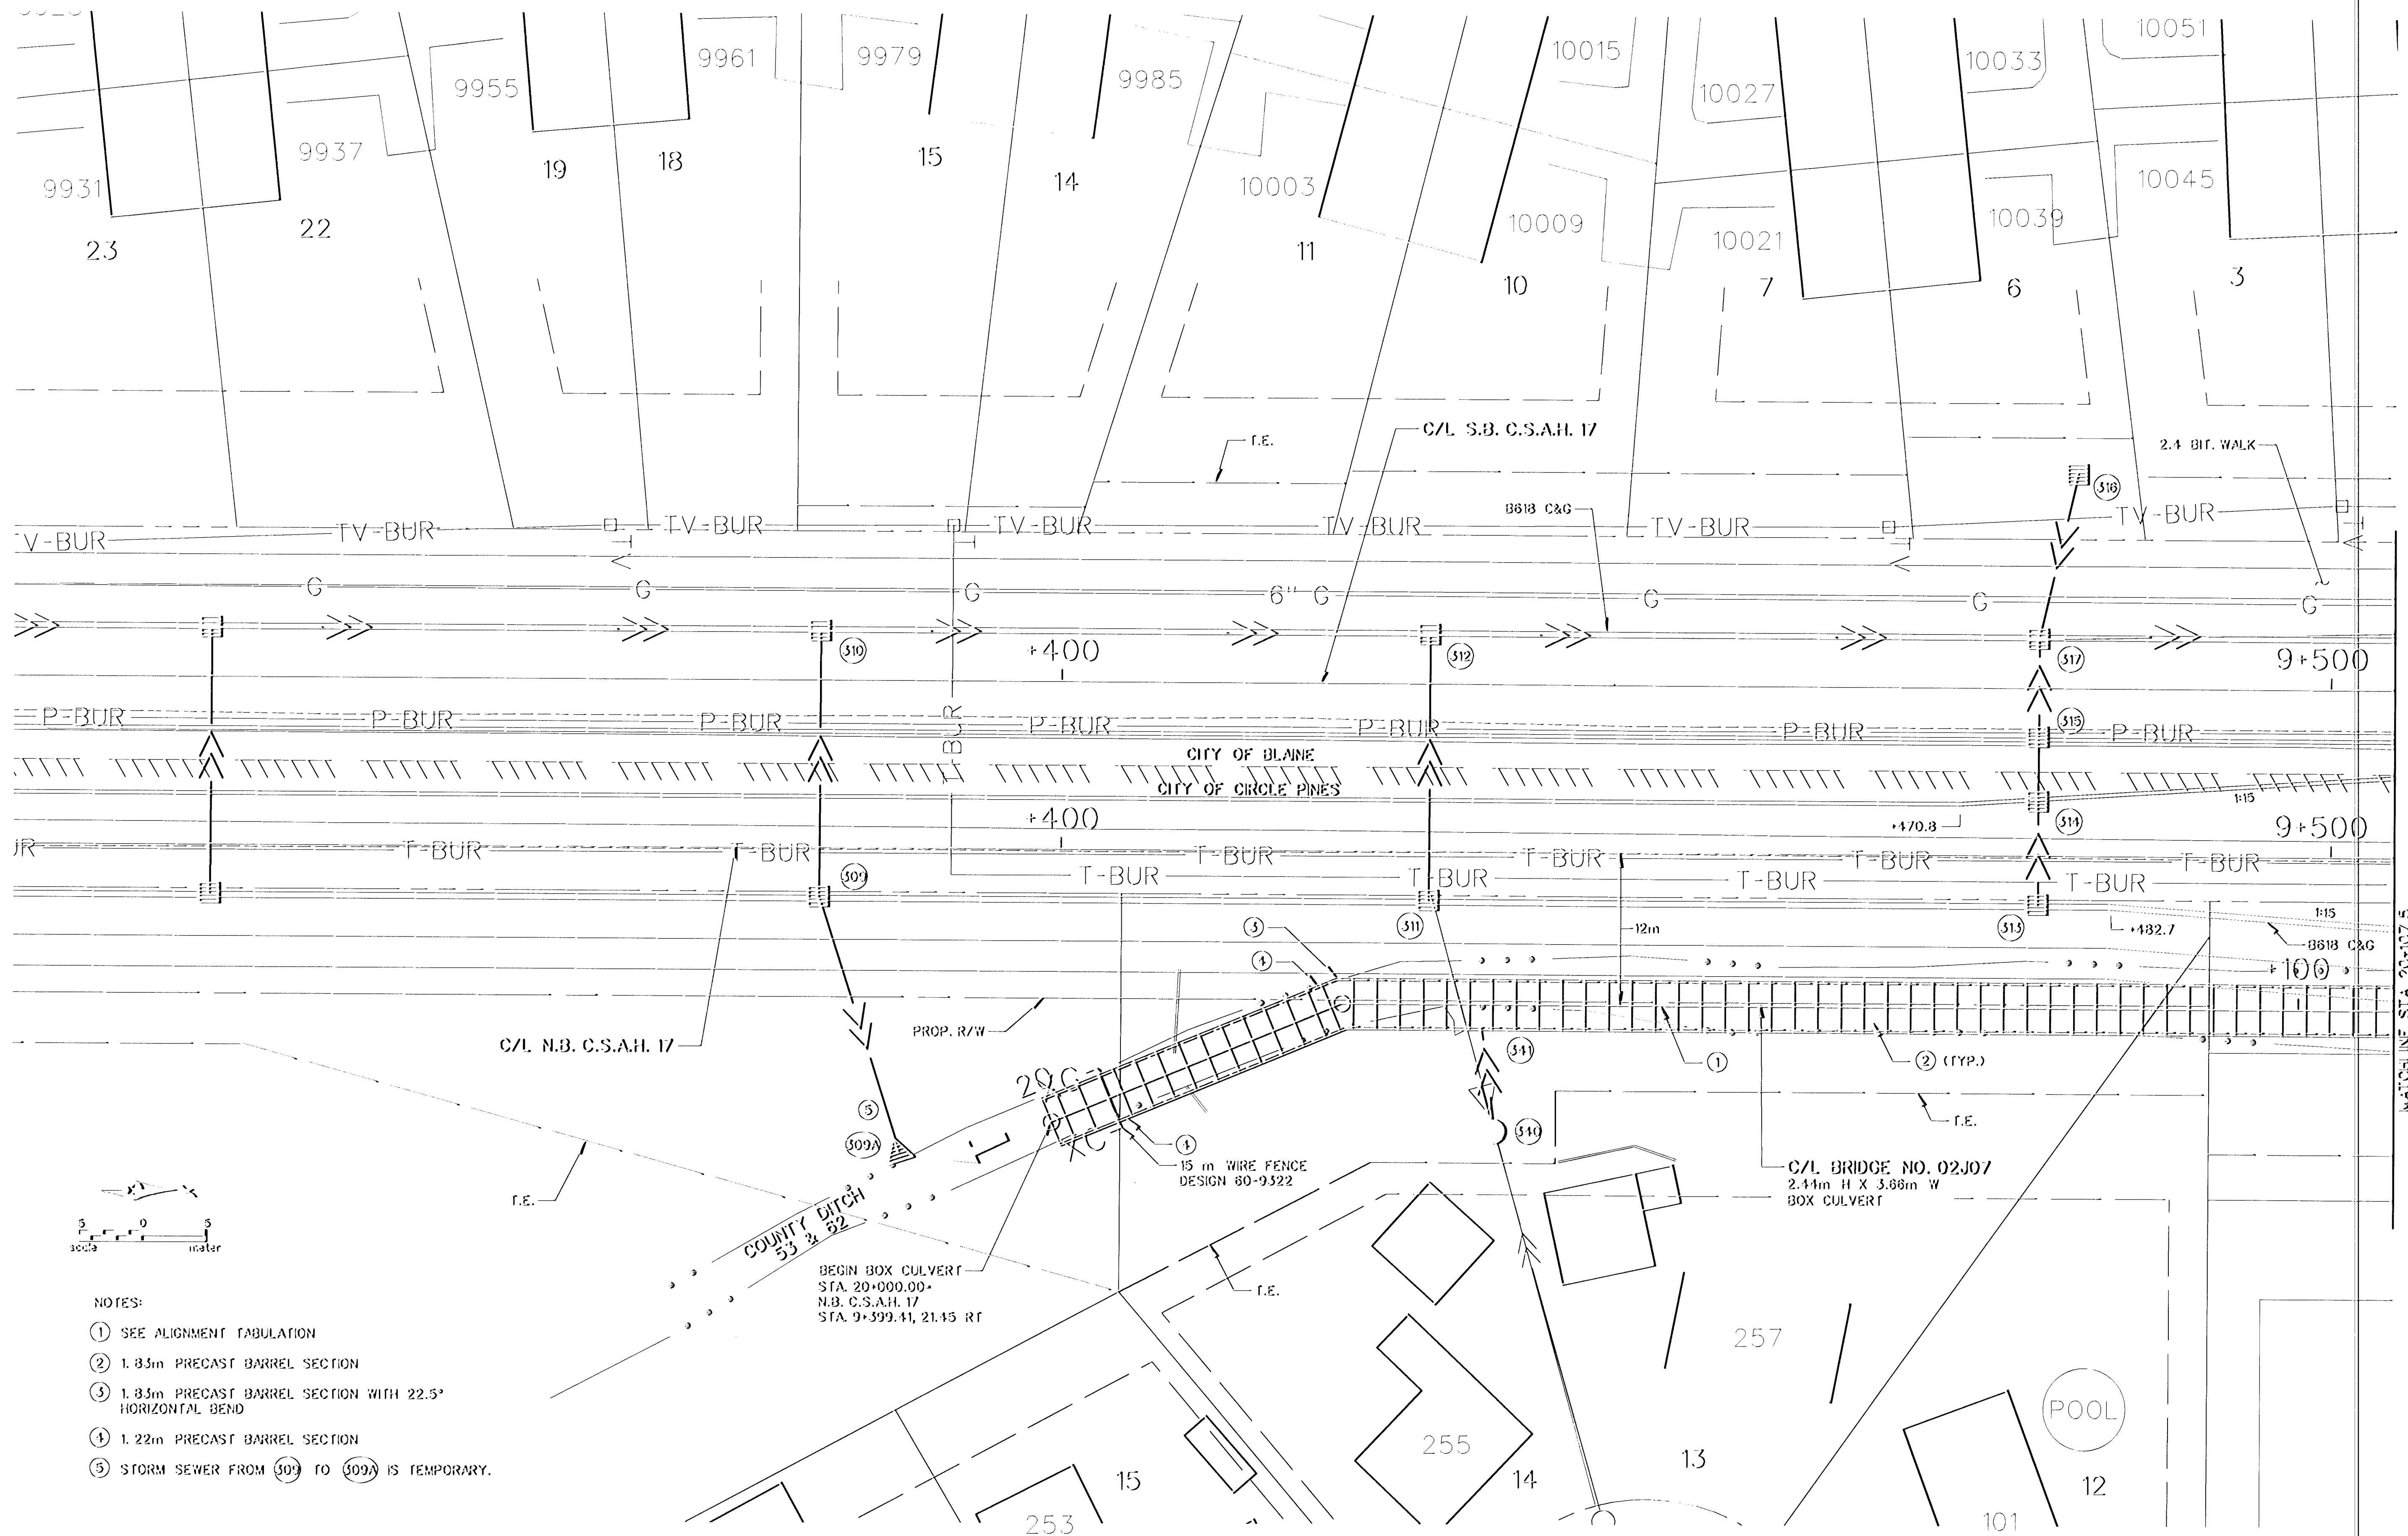

- NOTES:
- ① SEE ALIGNMENT TABULATION
 - ② 1.83m PRECAST BARREL SECTION
 - ③ 1.83m PRECAST BARREL SECTION WITH 22.5° HORIZONTAL BEND
 - ④ 1.22m PRECAST BARREL SECTION
 - ⑤ STORM SEWER FROM (509) TO (509A) IS TEMPORARY.


NO.	DATE	BY	CHKD	APPR	REVISION
NAME: BC1 410.PLN DATE: Mar. 17, 1997					

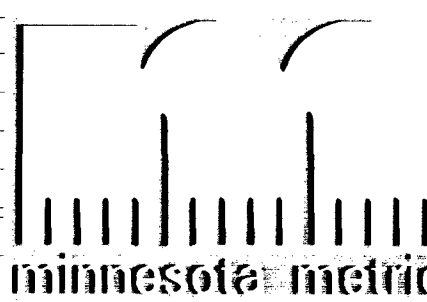
 I hereby certify that this plan, specification or report was prepared by me or under my direct supervision and that I am a duly Registered Professional Engineer under the laws of the State of Minnesota.

Date: 3-21-97 Reg. No. 25066



STATE AID PROJECT NO. S.A.P. 02-617-11 S.A.P. 108-020-12 S.A.P. 108-030-03
 CO. PROJECT NO.

DRAWN BY V. GRAF DATE 12-98
 DESIGNED BY L. ROBJENT 12-98
 CHECKED BY D. DEMERS 3-97
 COMM. NO. 0982410



ANOKA COUNTY
 BOX CULVERT CONSTRUCTION PLAN
 C.S.A.H. 17 RECONSTRUCTION
 STA. 20+000 TO STA. 20+107.5

SHEET 90 OF 236

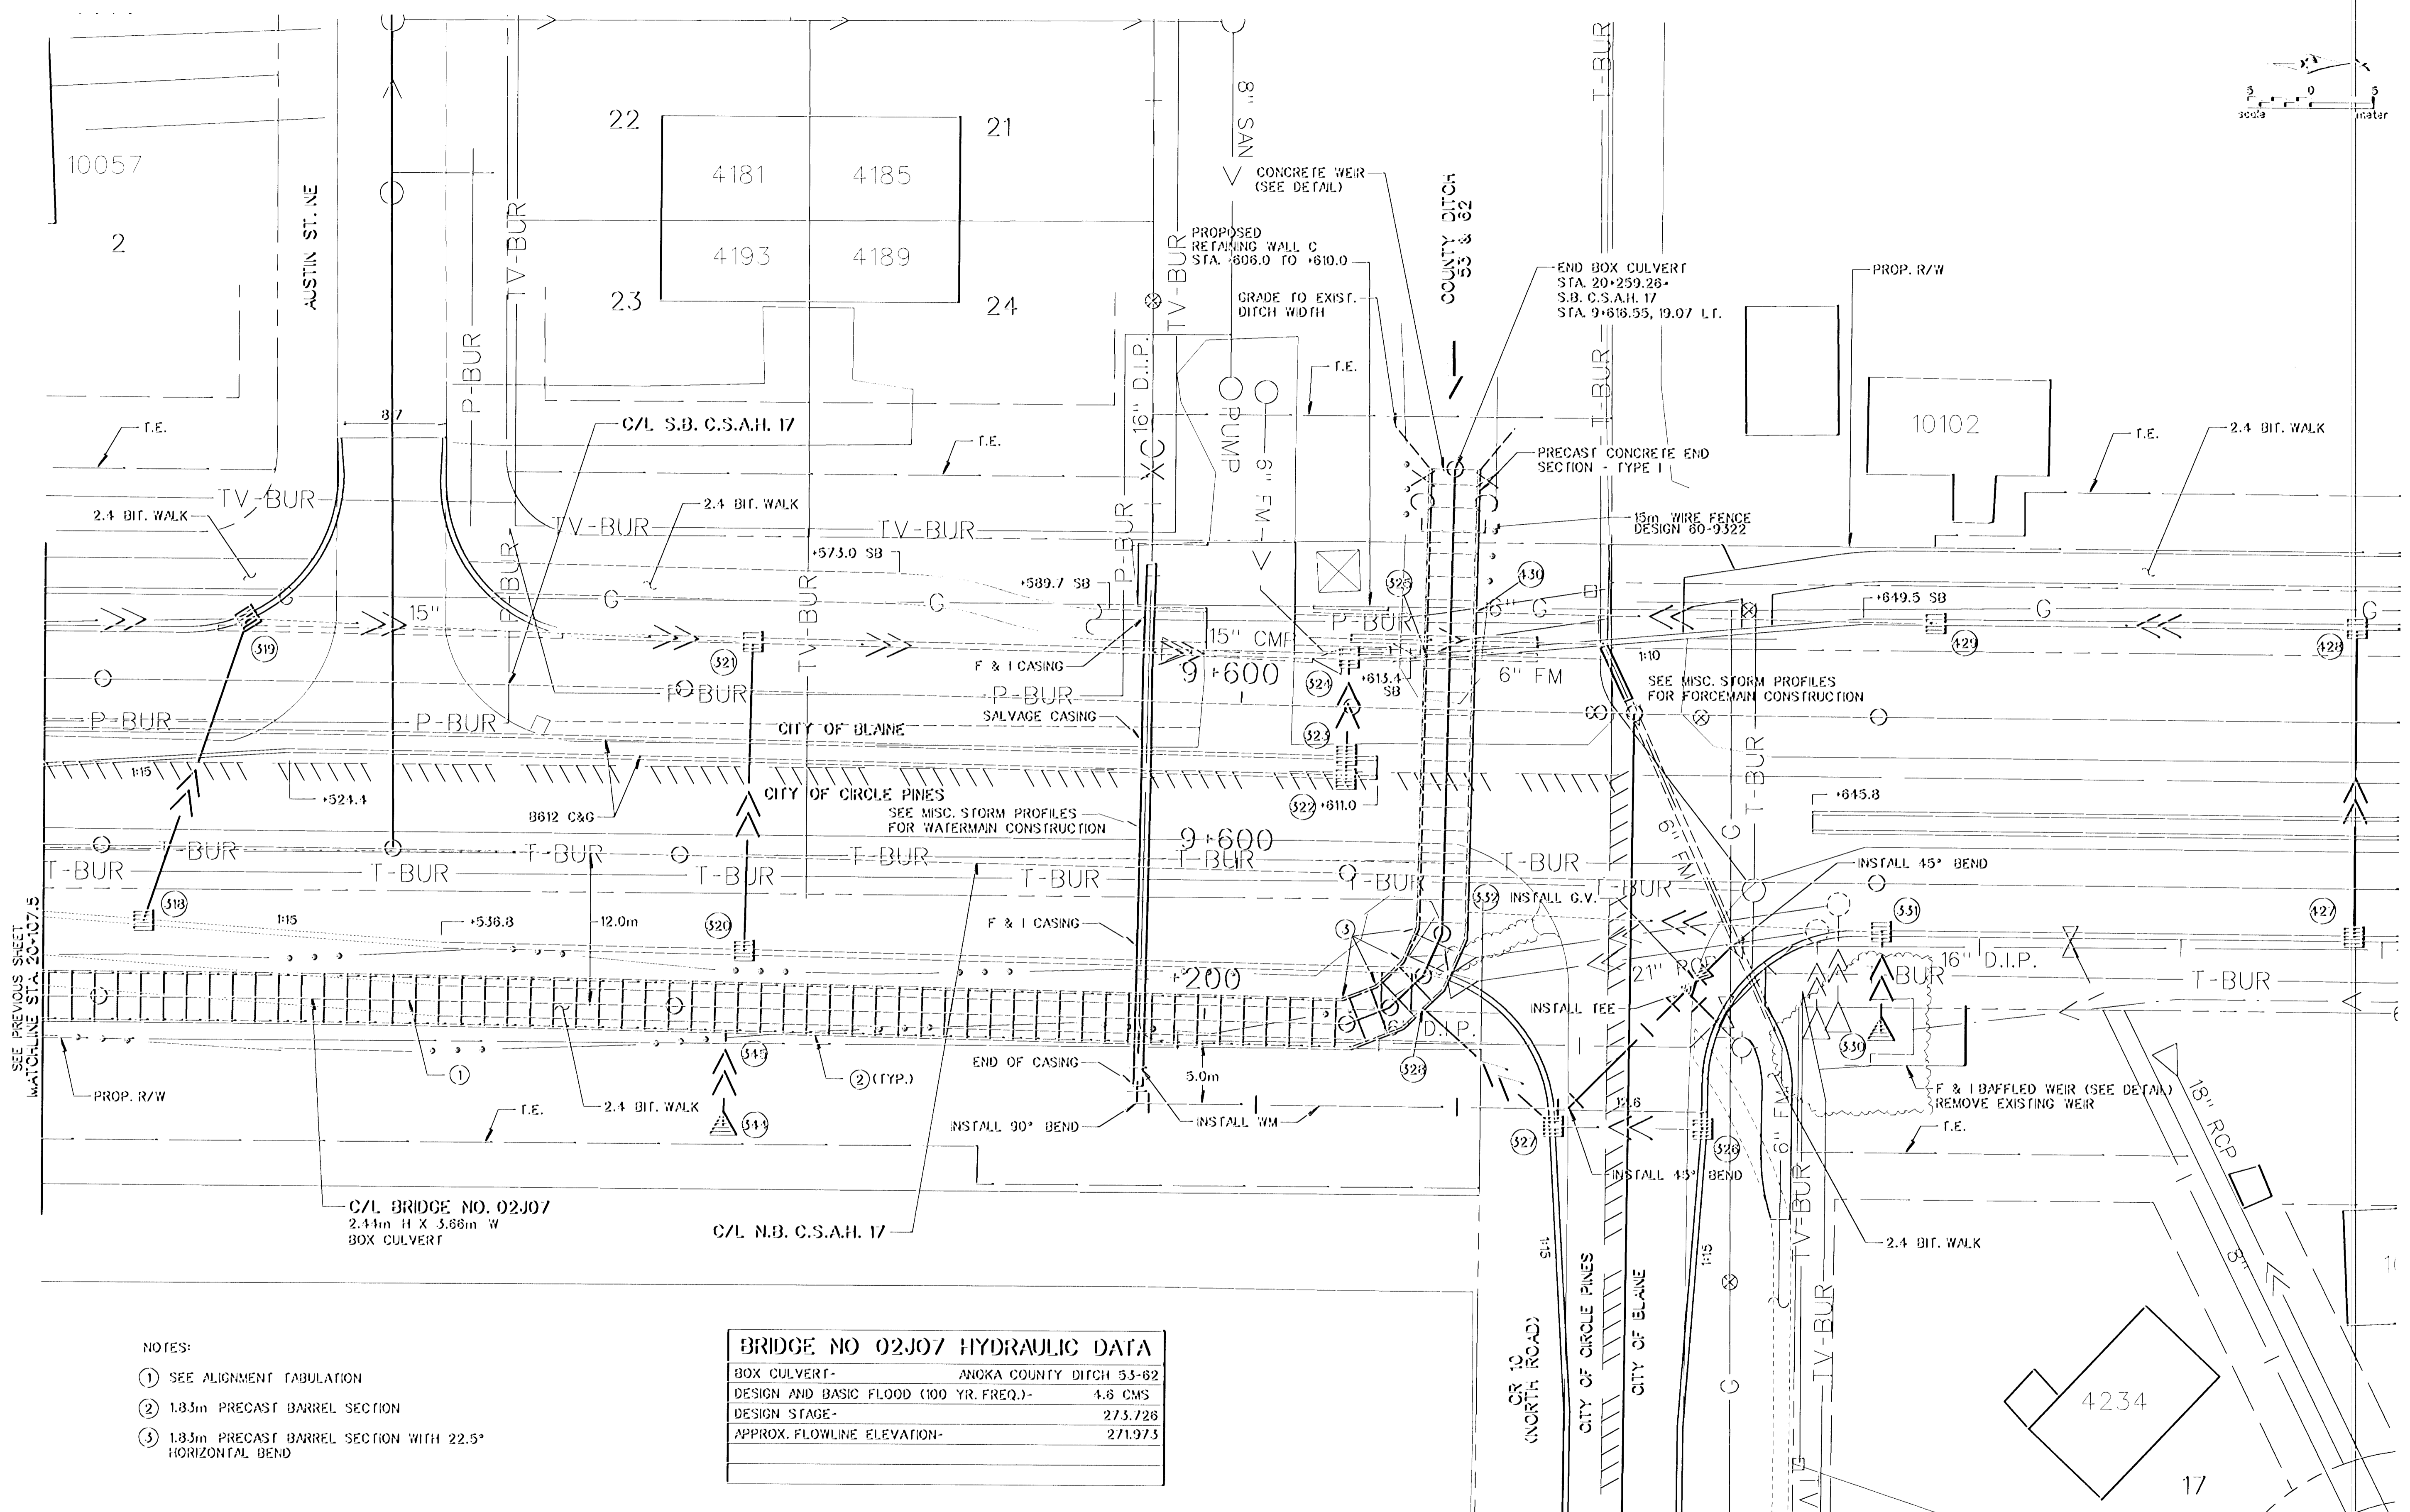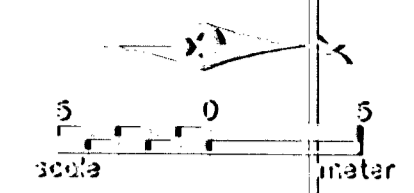

NOTES:

- ① SEE ALIGNMENT TABULATION
- ② 1.83m PRECAST BARREL SECTION
- ③ 1.83m PRECAST BARREL SECTION WITH 22.5° HORIZONTAL BEND

BRIDGE NO 02J07 HYDRAULIC DATA

BOX CULVERT-	ANOKA COUNTY DITCH 53-82
DESIGN AND BASIC FLOOD (100 YR. FREQ.)-	4.6 CMS
DESIGN STAGE-	275.726
APPROX. FLOWLINE ELEVATION-	271.973

NO	DATE	BY	CKD	APPR	REVISION

NAME: BC2 410.PLN DATE: Mar. 17, 1997

I hereby certify that this plan, specification or report was prepared by me or under my direct supervision and that I am a duly Registered Professional Engineer under the laws of the State of Minnesota.
 Date: 3-21-97 Reg. No. 15066

STATE AID PROJECT NO. S.A.P. 02-617-11
 S.A.P. 105-020-12
 S.A.P. 105-030-03
 CO. PROJECT NO.



DRAWN BY V. GRAF DATE 12-96
 DESIGNED BY L. ROBJENT 12-96
 CHECKED BY D. DEMERS 5-97
 COMM. NO. 0982410

SRI CONSULTING GROUP, INC.


ANOKA COUNTY
 BOX CULVERT CONSTRUCTION PLAN
 C.S.A.H. 17 RECONSTRUCTION
 STA. 20+107.5 TO STA. 20+259.26

SHEET 91 OF 236

PIPE CONNECTIONS (3)			
NO.	PIPE SIZE	STATION	INV.
341	800 mm	20+035.63 R.F.	272.556
345	575 mm	20+181.98 R.F.	272.892
328	500 mm	20+216.26 R.F.	272.900
552	900 mm	20+224.19 R.F.	272.557
525	800 mm	20+244.52 L.F.	272.506
450	825 mm	20+248 R.F.	272.204

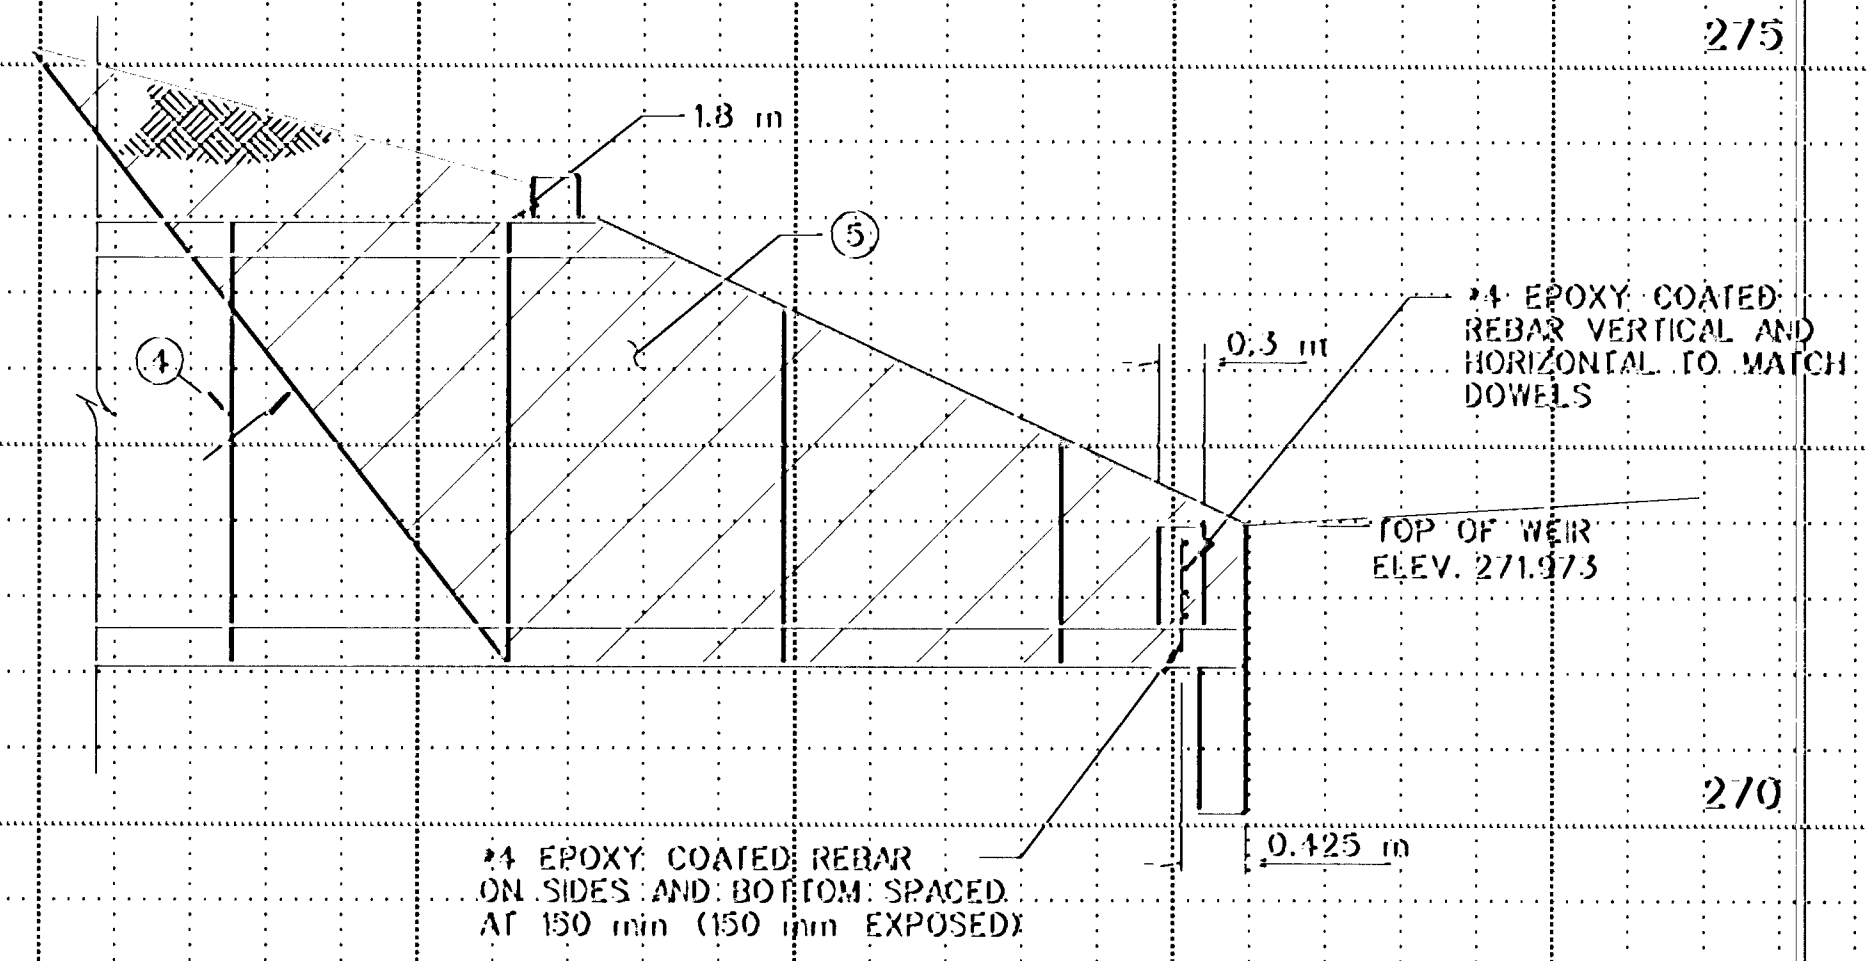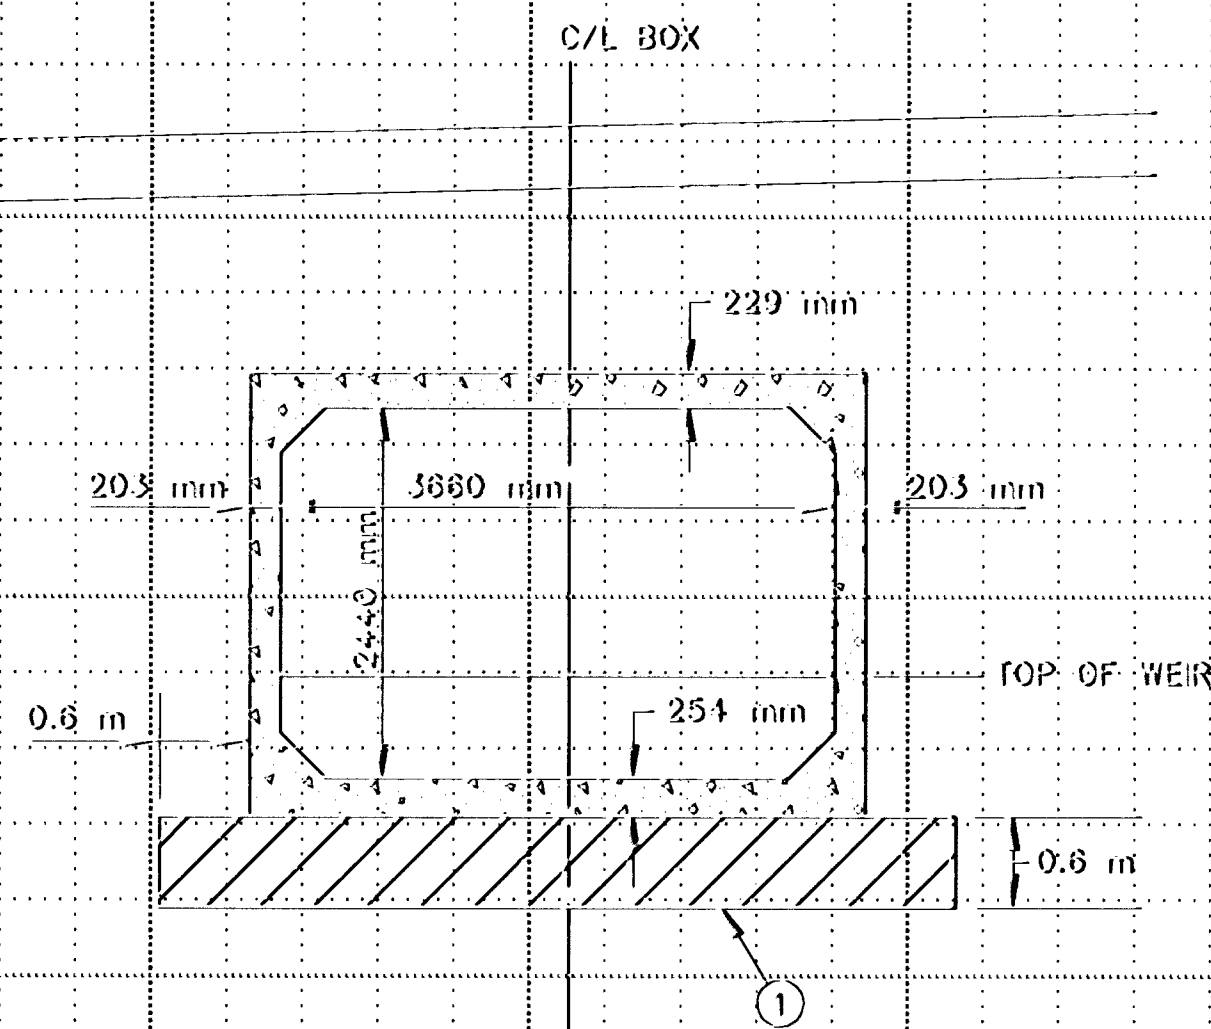

- (1) AGGREGATE BEDDING - 820 m³ SPEC. 3142-2G FOR BARREL SECTIONS. CLASS C BEDDING FOR END SECTIONS.
- (2) RIP RAP CLASS III - 22 m³ INCLUDES 100 m² GEOTEXTILE FILTER TYPE IV.
- (3) OPENINGS FOR PIPES ENTERING BOX CULVERT SHALL BE PLANT FABRICATED. OPENINGS SHALL BE CENTERED HORIZONTALLY IN 1.83 m PRECAST SECTION. FURNISH AND INSTALL TRASH GUARD (DESIGN SPECIAL) OVER EACH OPENING-SEE DETAILS.
- (4) JOINTS BETWEEN ALL SECTIONS SHALL HAVE MASTICSEALS ALL AROUND.
- (5) SELECTED PLASTIC SOILS CAP (MIN. 50% PASSING THE 75 MICROMETER SIEVE, MIN. 20% CLAY SIZE PARTICLES). SOILS CAP SHALL EXTEND 3.6 m EACH SIDE OF BARREL.

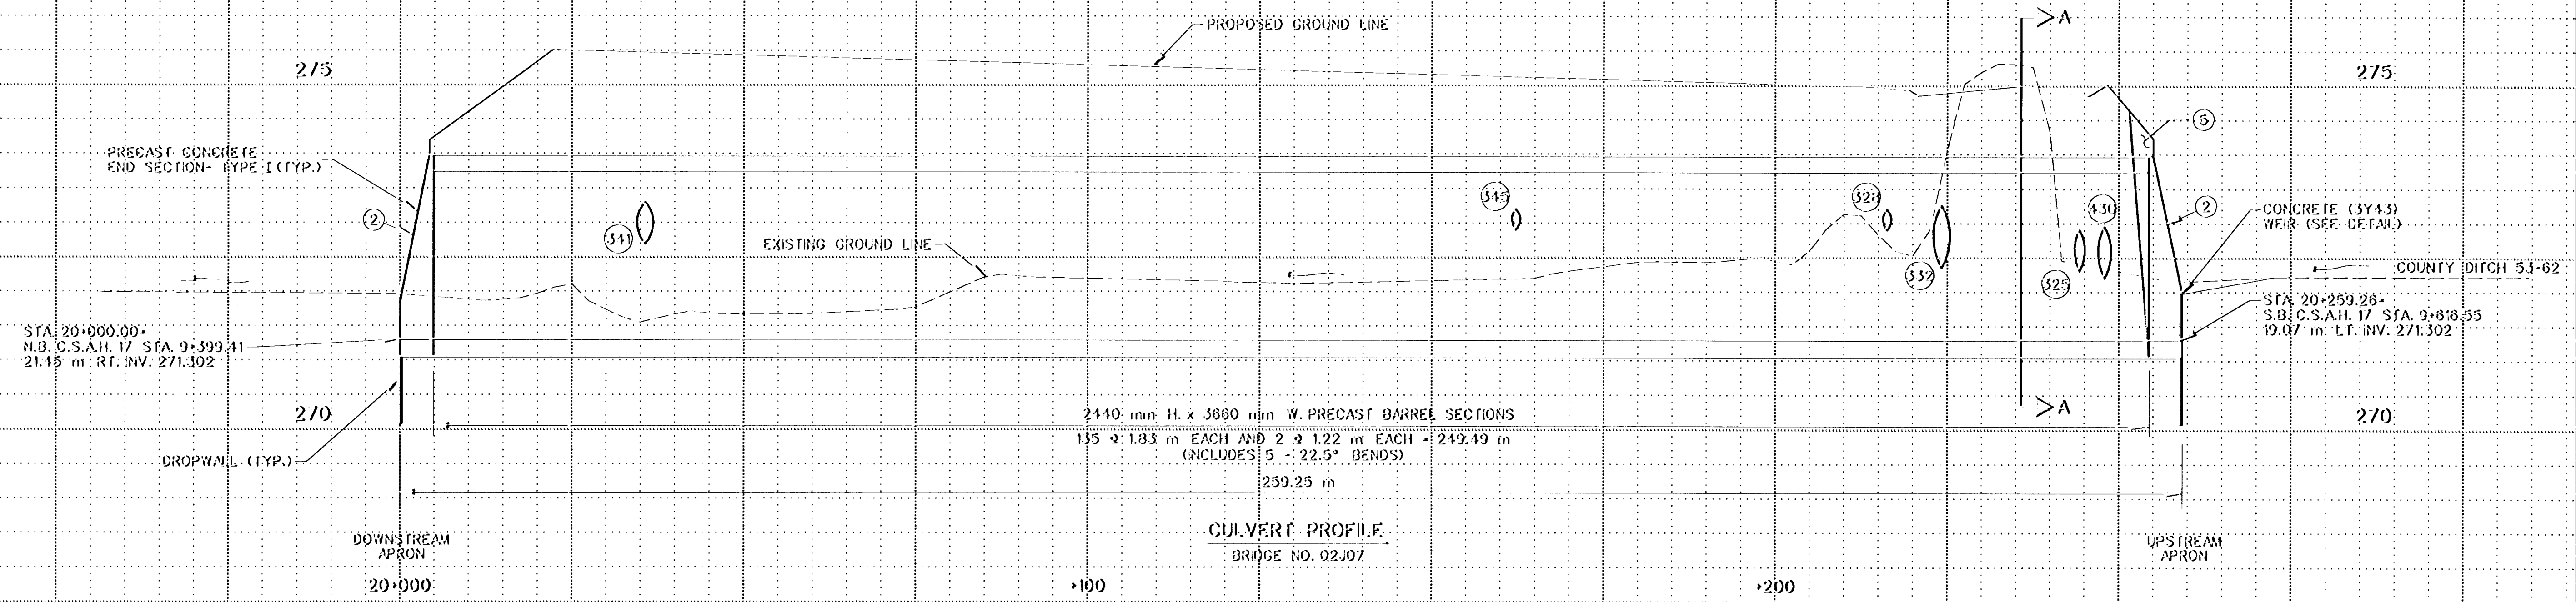

NO.	DATE	BY	CHKD	APPR	REVISION

NAME: BC5 410.PLN DATE: Mar. 17, 1997

minnesota metric

I hereby certify that this plan, specification or report was prepared by me or under my direct supervision and that I am a duly Registered Professional Engineer under the laws of the State of Minnesota.

Allegre
Date 3-21-97 Reg. No. 25066


STATE AID PROJECT NO. S.A.P. 02-617-11 S.A.P. 108-020-12 S.A.P. 108-030-03
CO. PROJECT NO.

DRAWN BY J. VAN BECK DATE 12-96
DESIGNED BY L. ROBJENT 12-96
CHECKED BY D. DEMERS 5-97
COMM. NO. 0962410


SRT CONSULTING GROUP, INC.

ANOKA COUNTY
BOX CULVERT PROFILE
C.S.A.H. 17 RECONSTRUCTION


SHEET 92 OF 236

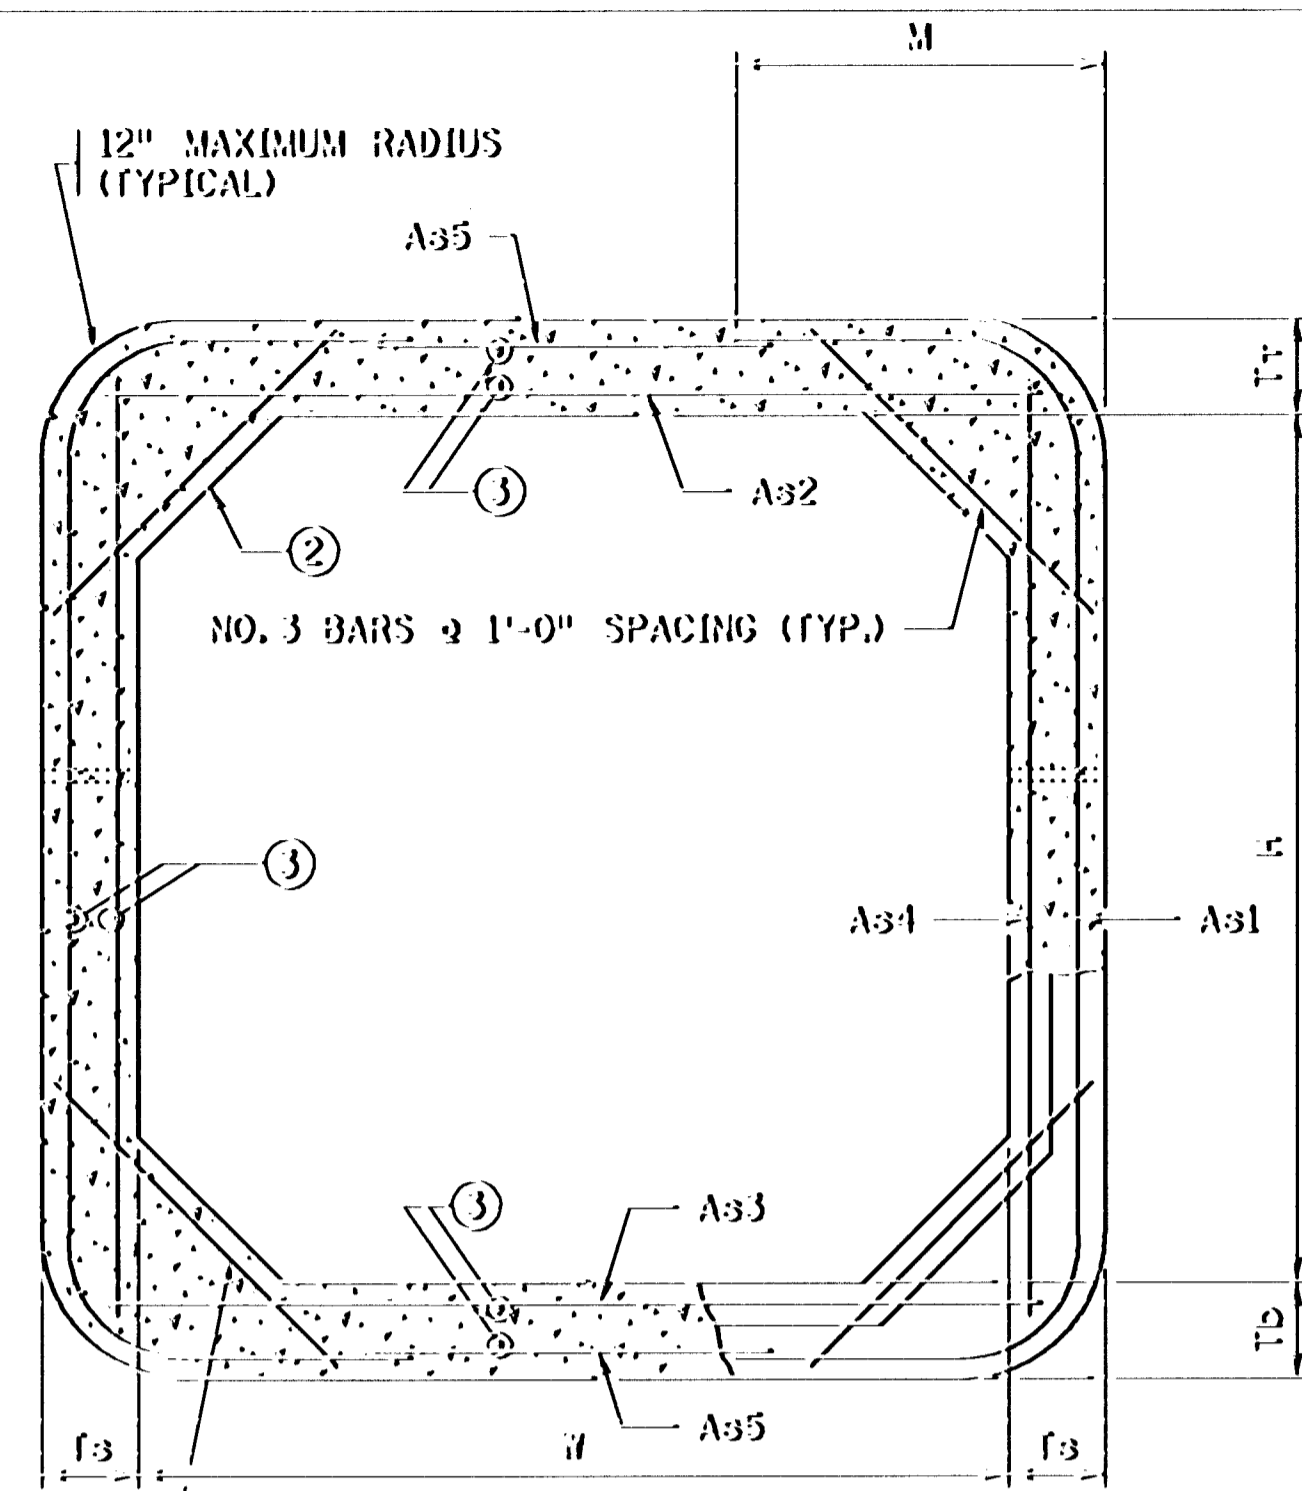


TRANSVERSE BARREL SECTION
(BAR REINFORCEMENT OPTION SHOWN)

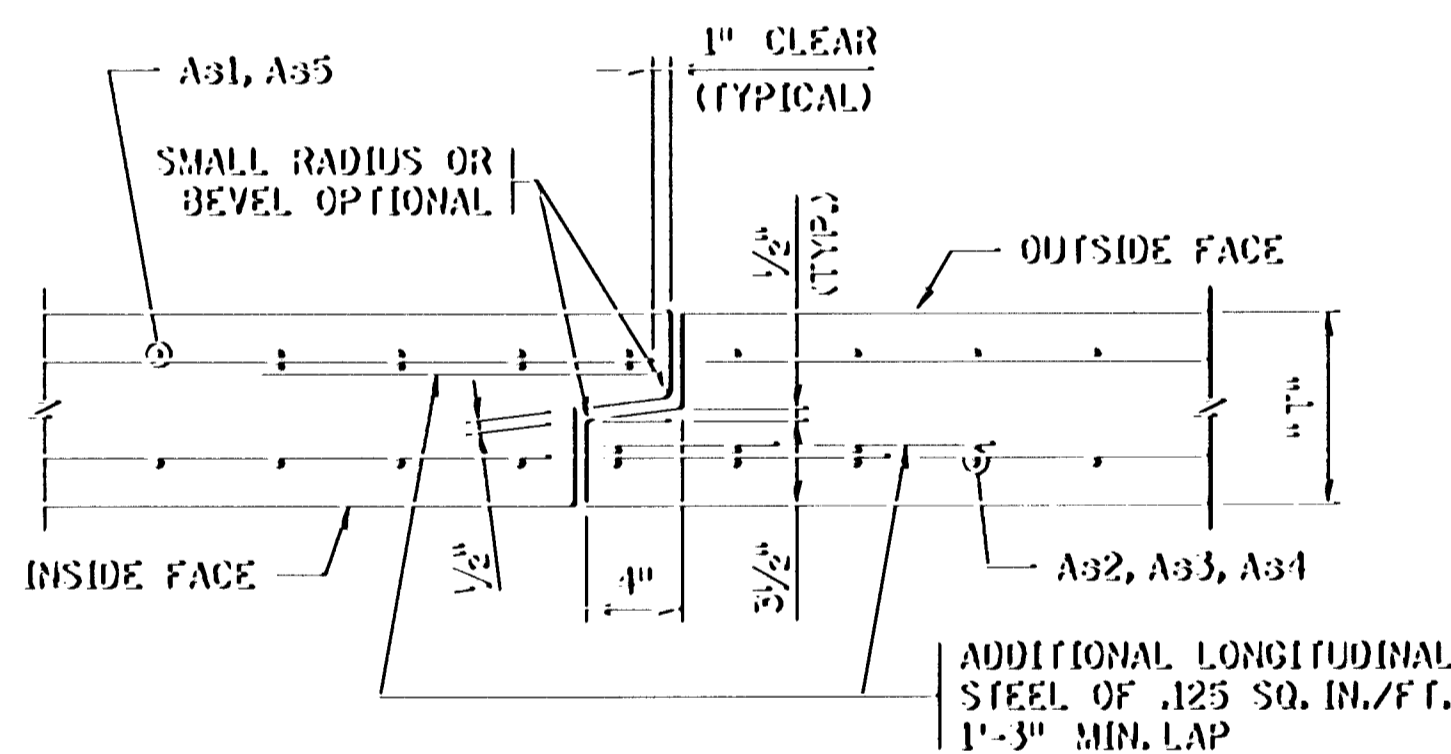


TONGUE AND GROOVE JOINT DETAIL

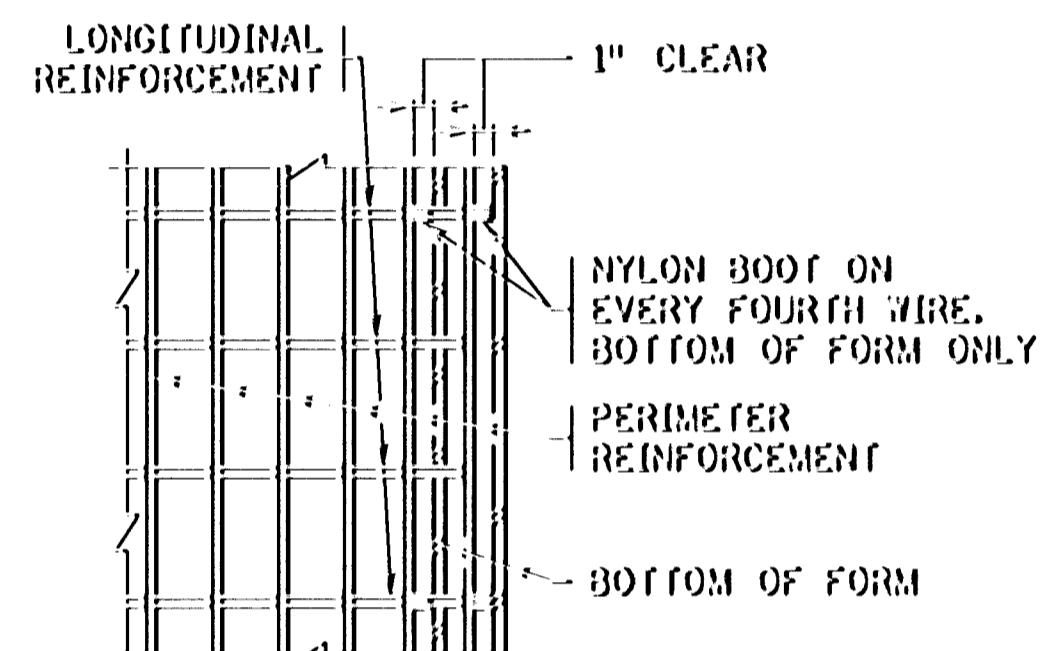


LONGITUDINAL BARREL SECTION
(BAR REINFORCEMENT OPTION SHOWN)

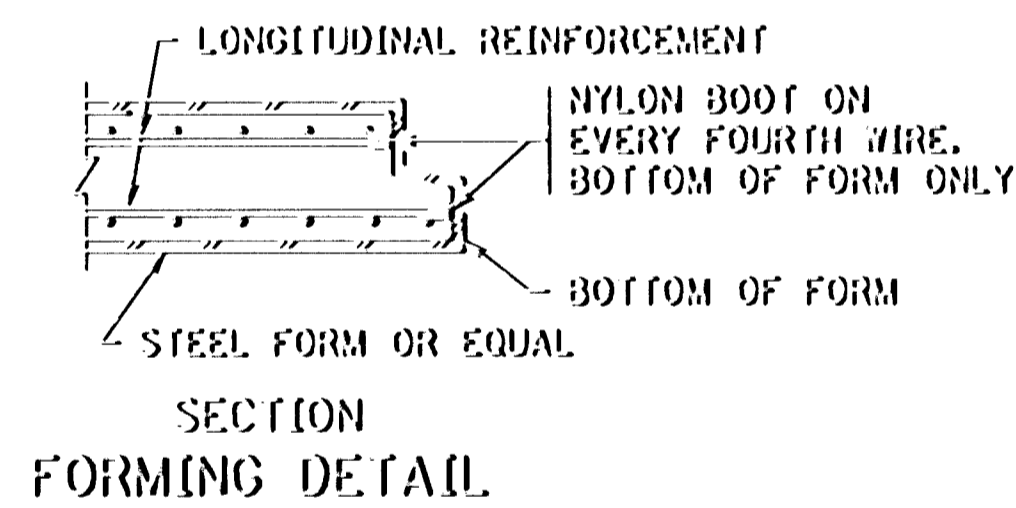

FORMING DETAIL

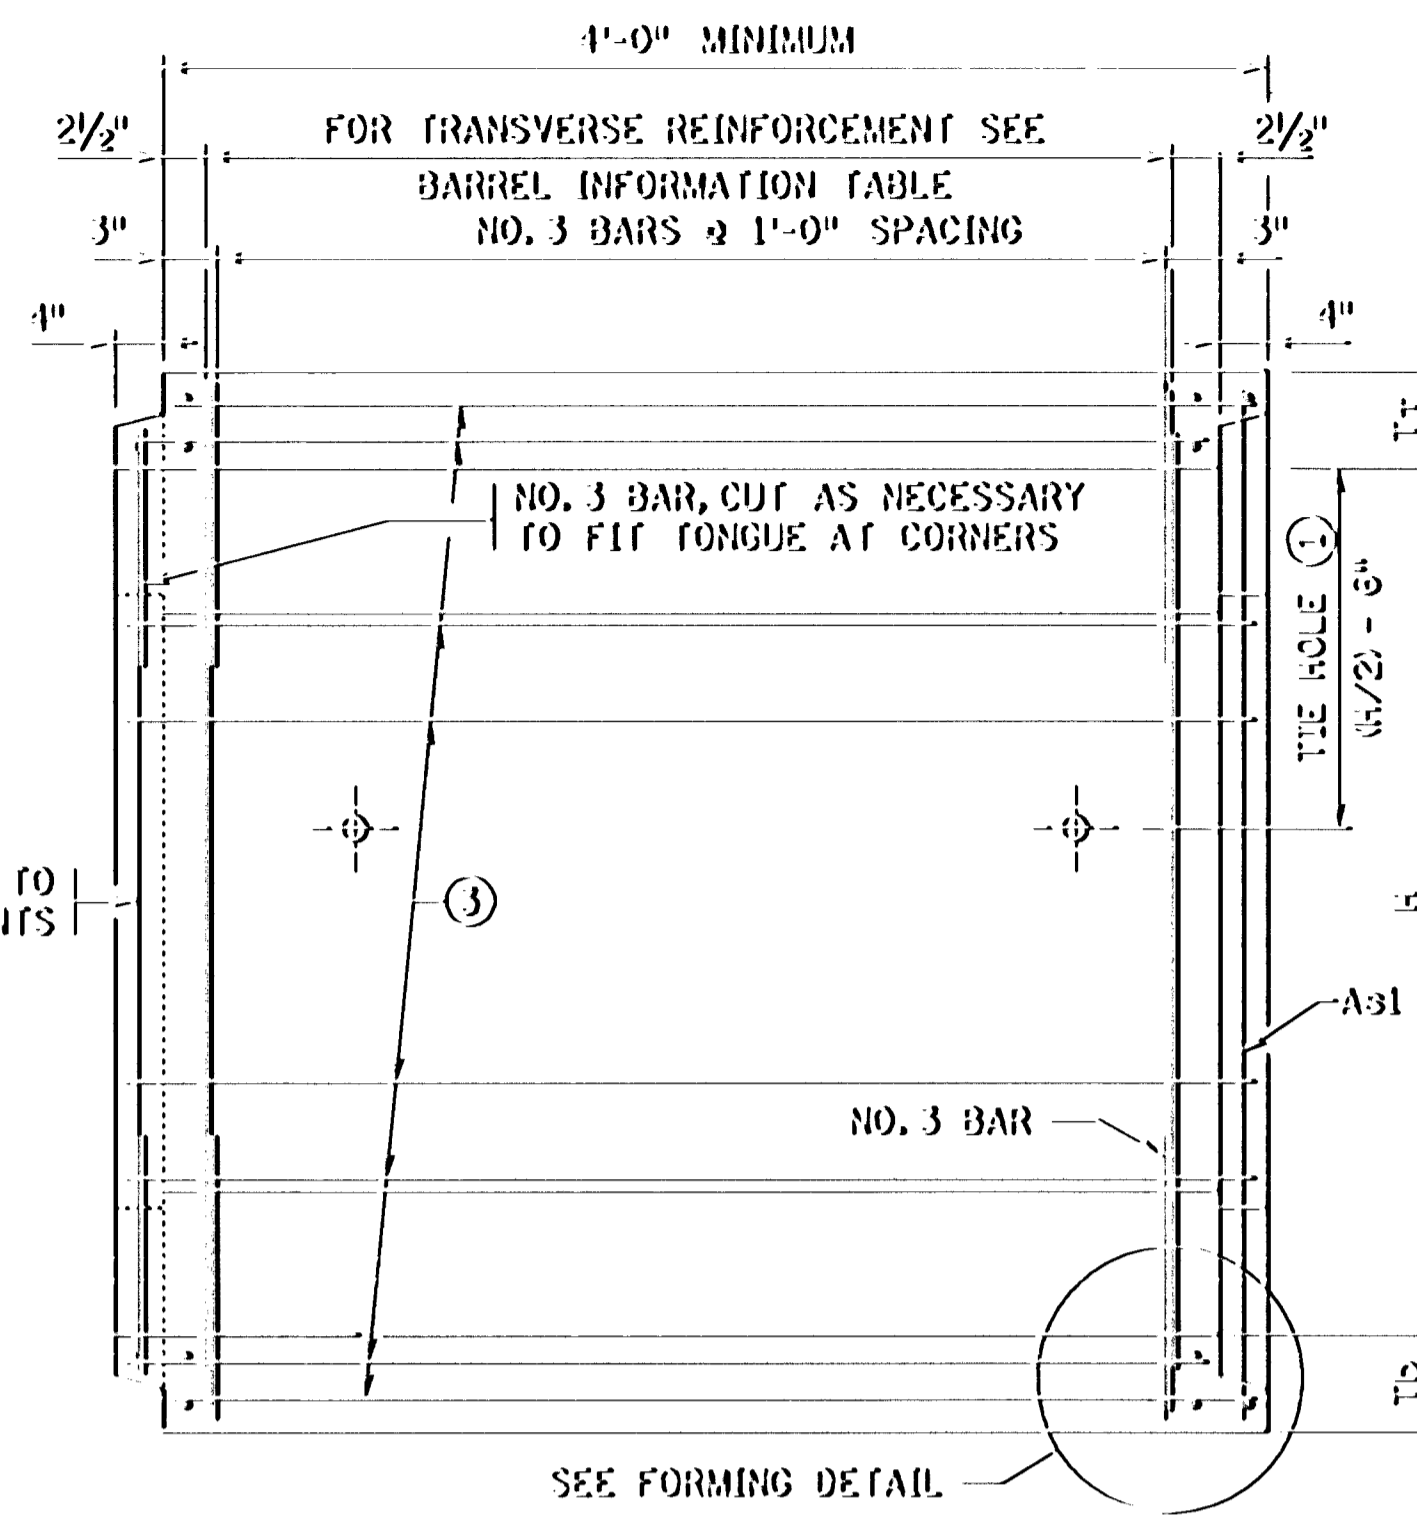

LONGITUDINAL BARREL SECTION
(FABRIC REINFORCEMENT OPTION SHOWN)

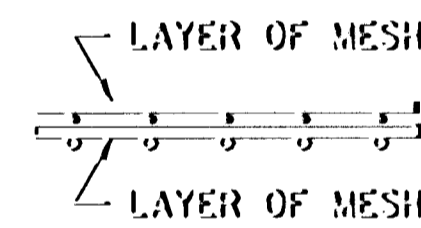

FABRIC LAYER DETAIL

WHEN MORE THAN ONE LAYER OF STEEL FABRIC IS USED TO OBTAIN THE REQUIRED REINFORCEMENT AREAS, THE WIRES OF THE STEEL FABRIC SHALL BE PLACED AS SHOWN

CONSTRUCTION NOTES:

- CULVERTS TO BE CONSTRUCTED AS PER SPEC. 2412 EXCEPT AS NOTED.
- THE STEEL FABRIC, SHEAR REINFORCEMENT AND REINFORCEMENT BARS SHALL CONFORM TO APPLICABLE REQUIREMENTS OF AASHTO M253.
- 1/2" MIN. AND 2" MAX. CONCRETE COVER ON ALL REINFORCEMENT, INCLUDING SHEAR REINFORCEMENT, EXCEPT FOR TONGUE AND GROOVE DETAIL.
- ANY OF THE FOLLOWING COMBINATIONS OF STEEL REINFORCEMENT MAY BE USED:
 - (a) 1 OR 2 LAYERS OF MESH OR
 - (b) 1 LAYER OF MESH AND 1 LAYER OF REINFORCEMENT BARS OR
 - (c) 1 LAYER OF REINFORCEMENT BARS.
- THE REINFORCEMENT SHALL BE DEVELOPED IN ACCORDANCE WITH AASHTO "STANDARD SPECIFICATIONS FOR HIGHWAY BRIDGES". IF BAR REINFORCEMENT IS SUBSTITUTED FOR WIRE MESH, THE AREAS OF REINFORCEMENT SHALL BE INCREASED BY 3%.
- THE MAXIMUM SIZE OF REINFORCEMENT BARS SHALL BE NO. 6. THE MAXIMUM MESH SIZE SHALL BE 1/2" DIA. PER LAYER (MAXIMUM OF 2 LAYERS).
- THE SPACING CENTER TO CENTER OF THE TRANSVERSE WIRES SHALL NOT BE LESS THAN 2 INCHES NOR MORE THAN 4 INCHES. THE SPACING CENTER TO CENTER OF THE LONGITUDINAL WIRES SHALL NOT BE MORE THAN 8 INCHES.
- WELDING WILL NOT BE ALLOWED ON REINFORCEMENT BARS OR STEEL FABRIC, EXCEPT THAT THE ORIGINAL WELDING REQUIRED TO MANUFACTURE WIRE FABRIC IS ACCEPTABLE.
- WHEN REINFORCEMENT IS CUT, ADDITIONAL REINFORCEMENT SHALL BE ADDED ON BOTH SIDES OF THE CUT MEMBER TO REPLACE OR EXCEED THE CUT STEEL.
- BARREL SECTIONS WHICH ARE CAST WITH A DRAFT IN THE FORMS SHALL BE LAID WITH THE NARROWEST PART OF THE SECTION DOWNSTREAM.
- CONCRETE SHALL BE MIX NO. 3W36 WITH NO CALCIUM CHLORIDE ALLOWED.
- ① CULVERT TIES ARE TO BE 1" DIAMETER RODS. SEE STANDARD PLATE NO. 3145 FOR CONNECTION DETAILS.
- ② HAUNCH SIZE AS FOLLOWS:
 - 6 AND 8 FT. WIDTHS - 6 TO 12 INCHES
 - 10 FT WIDTH - 10 TO 12 INCHES
 - 12 FT WIDTH - 12 INCHES
- ③ MINIMUM LONGITUDINAL STEEL SHALL BE 0.06 SQ. IN./FT.

BARREL INFORMATION

LOCATION	SIZE	CLASS	P/C (P.S.I.)	FILL HEIGHT RANGE (F.T.)	DIMENSIONS					WEIGHT (LBS./F.T.)	STEEL FABRIC REINFORCEMENT										
					W (F.T.)	H (F.T.)	R (IN.)	R _B (IN.)	R _S (IN.)		A31		A32		A33		A34		A35		
											AREA (IN. ² /F.T.)	LENGTH (F.T.)	AREA (IN. ² /F.T.)	LENGTH (F.T.)	AREA (IN. ² /F.T.)	LENGTH (F.T.)	AREA (IN. ² /F.T.)	LENGTH (F.T.)	AREA (IN. ² /F.T.)	LENGTH (F.T.)	
0553-62	12x8	2	5000	2-5	12	8	7	10	3	4930	0.74	14.58	3.17	1.11	12.67	1.06	12.67	0.20	3.67	0.06	9.00

I hereby certify that this plan, specification or report was prepared by me or under my direct supervision and that I am a duly Registered Professional Engineer under the laws of the State of Minnesota.

Date 3-21-97 Reg. No. 25066



 DES: L. ROBJERT DR:
 CHECK: R.A.S. CHECK:

SRI CONSULTING GROUP, INC.




STANDARD SHEET NO. 5-297,420 (1 OF 2)
 STATE BRIDGE ENGINEER APPROVAL: AUGUST 10, 1995
 S.A.P. 02-617-11, et al.

BRIDGE NO. 02J07
 BARREL DETAILS
 SHEET NO. 93 OF 236 SHEETS

SERVER: C:\AS\1\USER\STANDARDS FILE NAME: S2401985.DWG

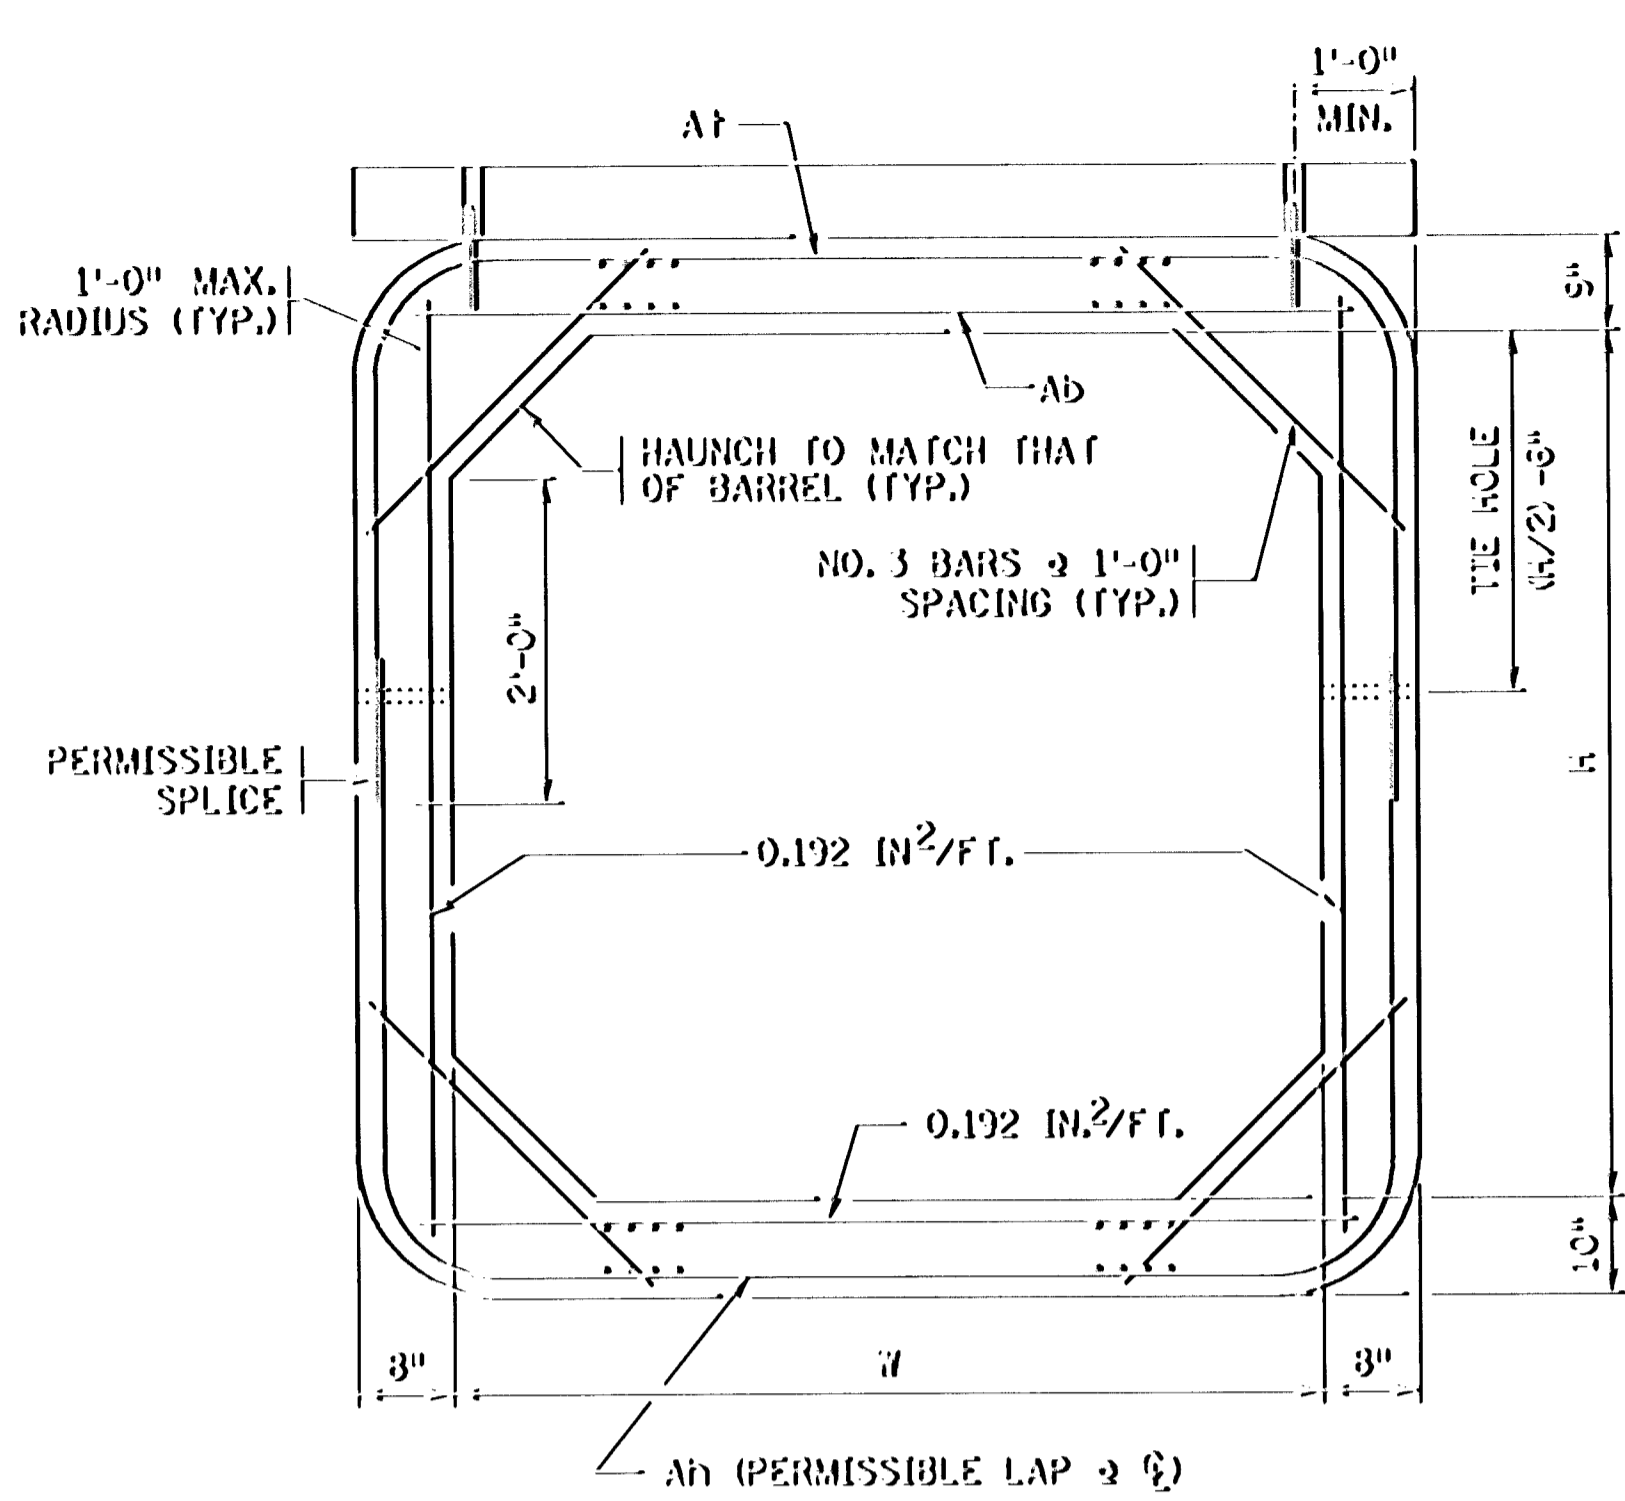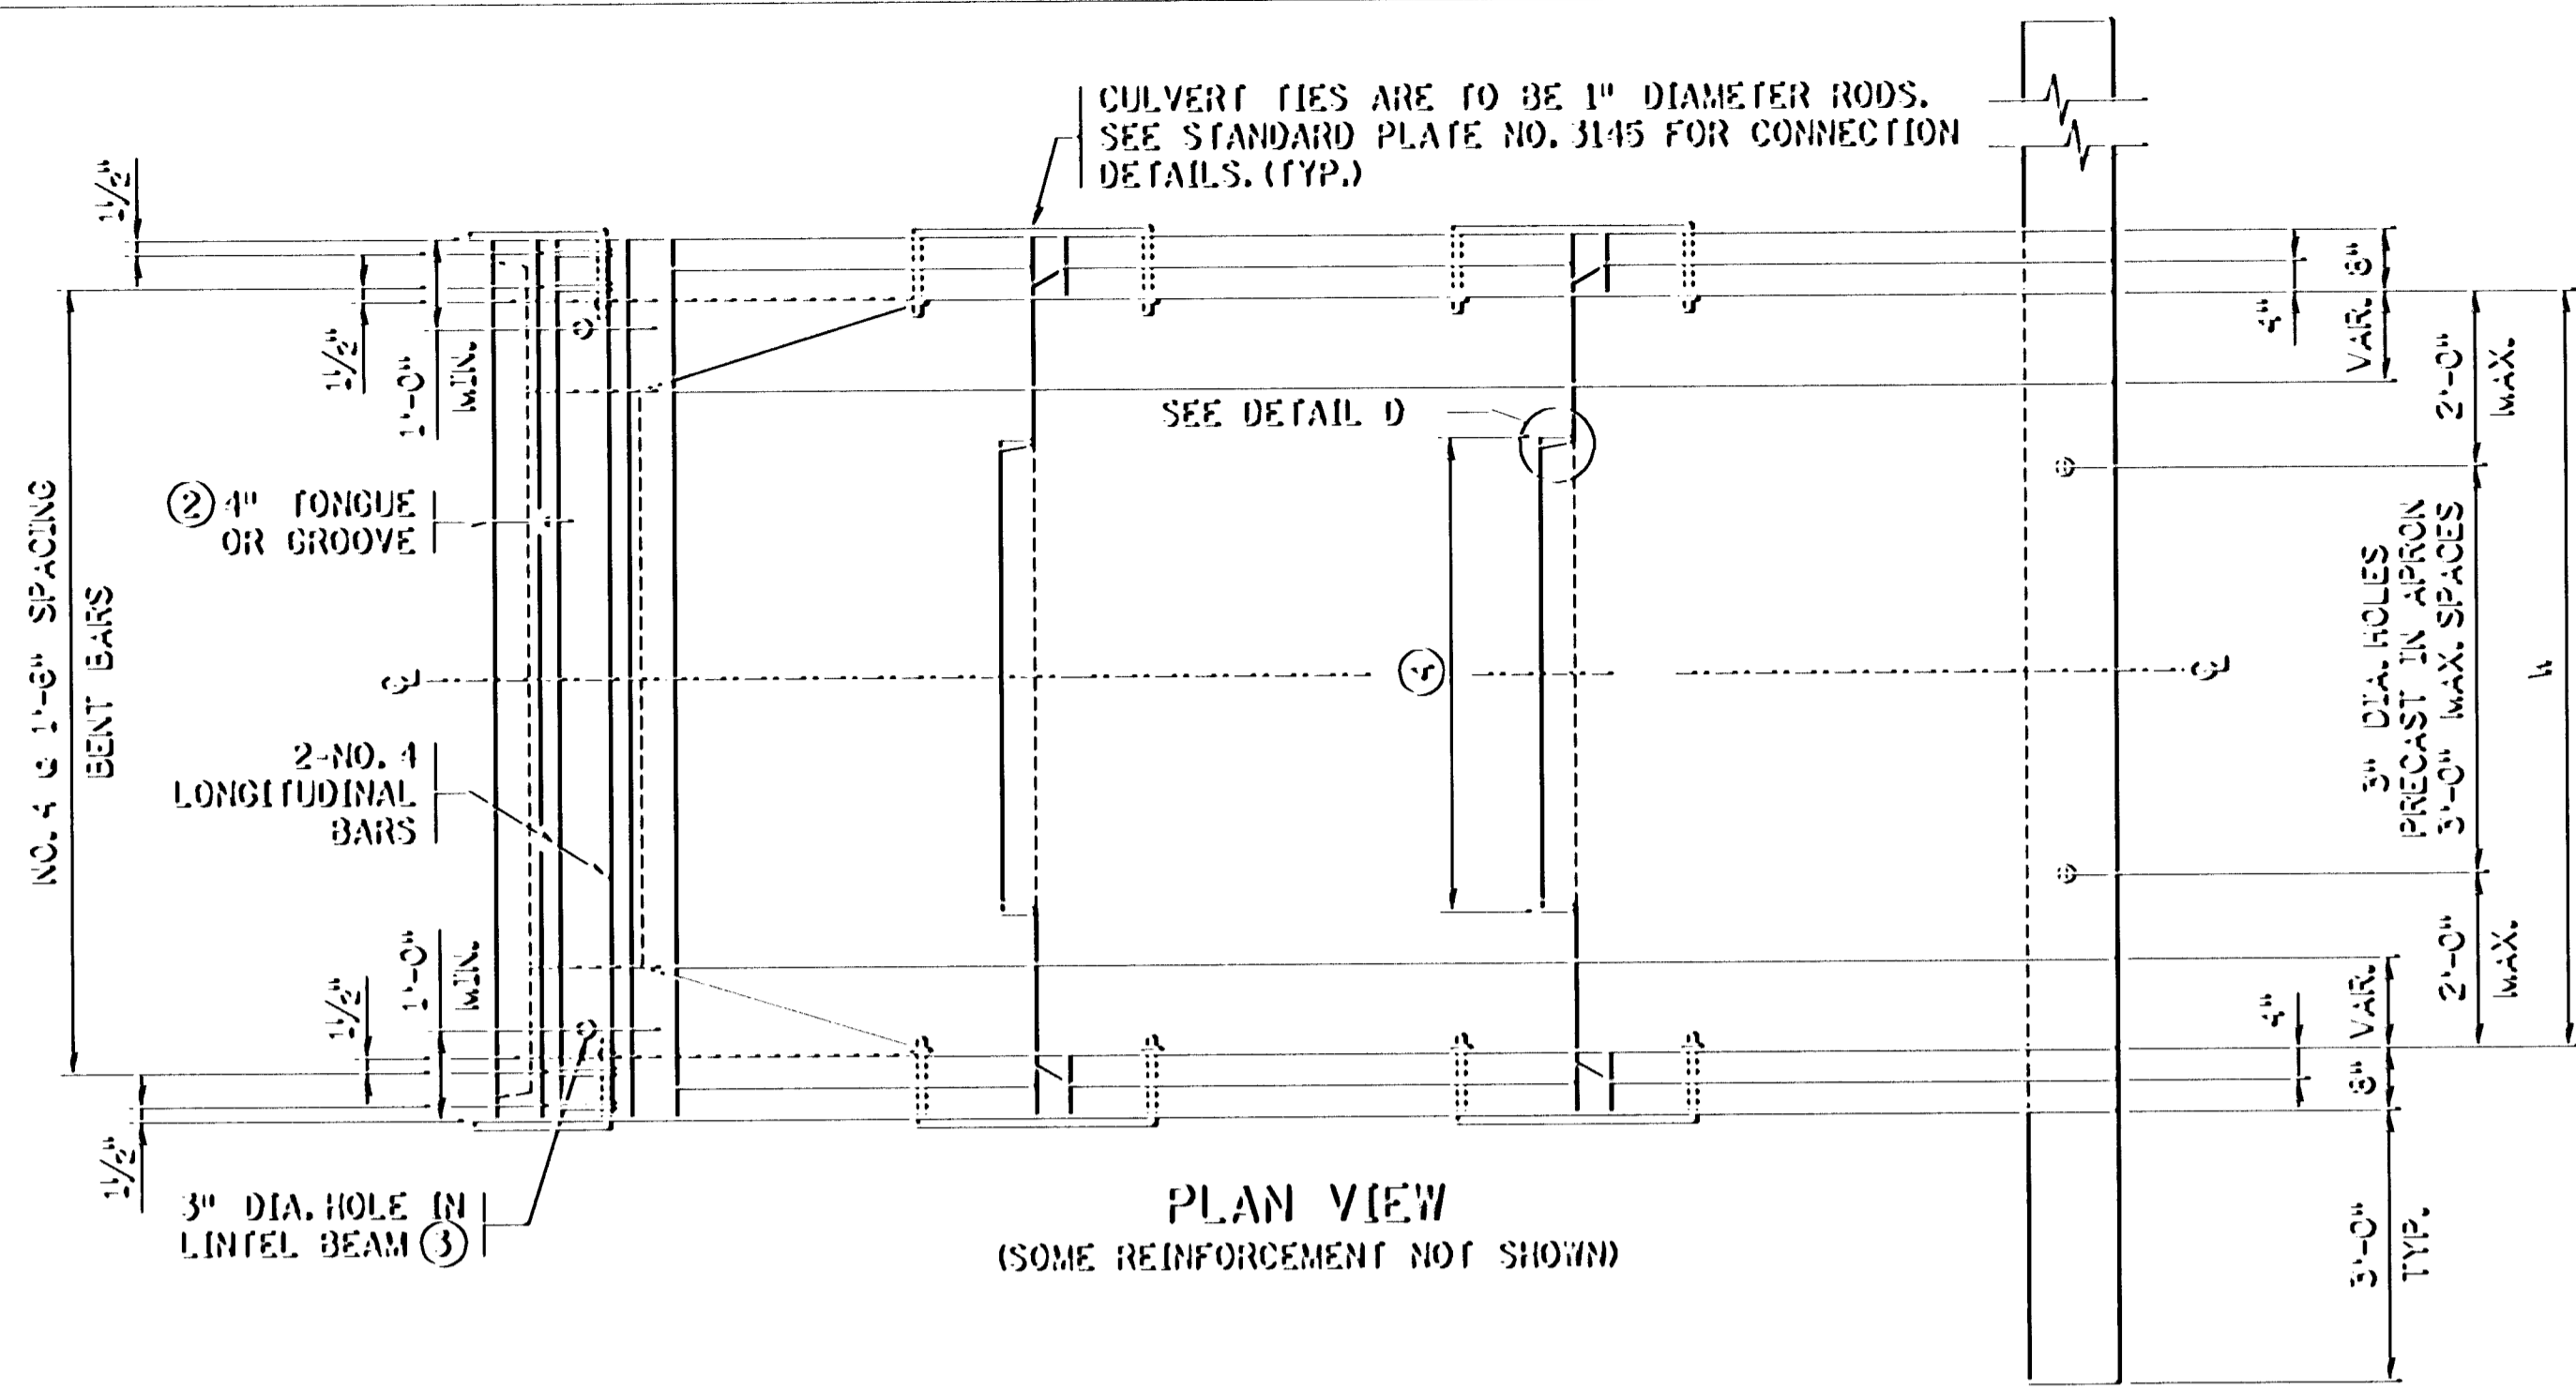


- NOTES:**
SEE 5-297.420, FOR DIMENSIONS AND CONSTRUCTION NOTES, EXCEPT AS NOTED.
- LONGITUDINAL REINFORCEMENT PARALLEL TO THE AXIS OF THE CULVERT SHALL HAVE A MINIMUM OF 0.06 SQUARE INCHES PER PERIPHERAL FOOT ON ALL FACES OF THE BARREL, EXCEPT IN THE TONGUE AND GROOVE AREA.
- SEE 5-297.425 FOR EMBANKMENT PROTECTION.
- FINISH ALL EDGES OF CONCRETE WITH 1/2" OR 3/4" CHAMFER UNLESS OTHERWISE NOTED.
- WITH MULTIPLE BOXES LOCATE DROPWALL JOINTS BETWEEN END SECTIONS. SEE 5-297.424 FOR ALTERNATE DROPWALLS. LIMITS OF EXCAVATION FOR DROPWALL TO BE APPROXIMATELY THE SAME AS DROPWALL DIMENSIONS. DROPWALL TO BE CONCRETE MIX NO. 1A43 OR 3Y43. FURNISHING AND INSTALLATION OF DROPWALL TO BE INCLUDED IN PRICE BID FOR END SECTIONS. DROPWALL NOT REQUIRED FOR NON-WATERWAY USE.
 - CHECK LOCATION TO DETERMINE WHETHER A TONGUE OR A GROOVE IS USED.
 - FILL HOLE WITH GROUT. GROUT SHALL CONSIST OF 1 PART CEMENT AND 2 PARTS SAND. USE TYPE 1A AIR ENTRAINED PORTLAND CEMENT. GROUT MIX SHALL HAVE A MAXIMUM SLUMP OF 4".
 - 3'-6" TONGUE AND 3'-7" GROOVE FOR 6'-0" WIDE CULVERTS. 5'-0" TONGUE AND 5'-1" GROOVE FOR CULVERTS OVER 6'-0" WIDE. CENTER TONGUE AND GROOVE ON 1/2 OF EACH APRON JOINT.

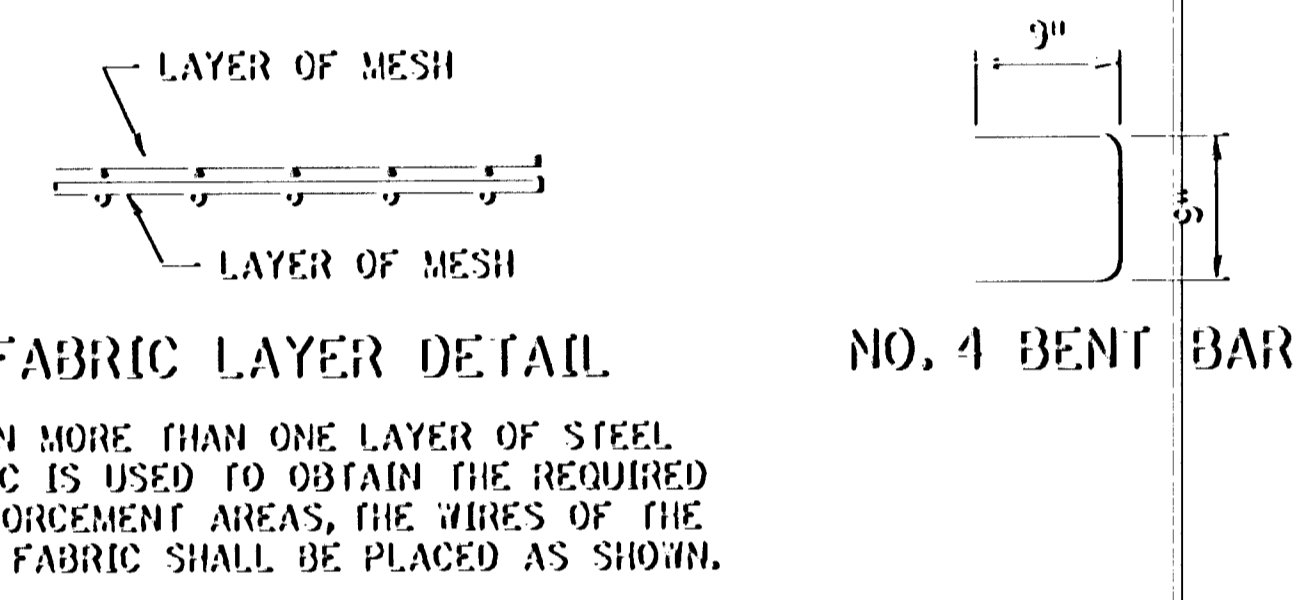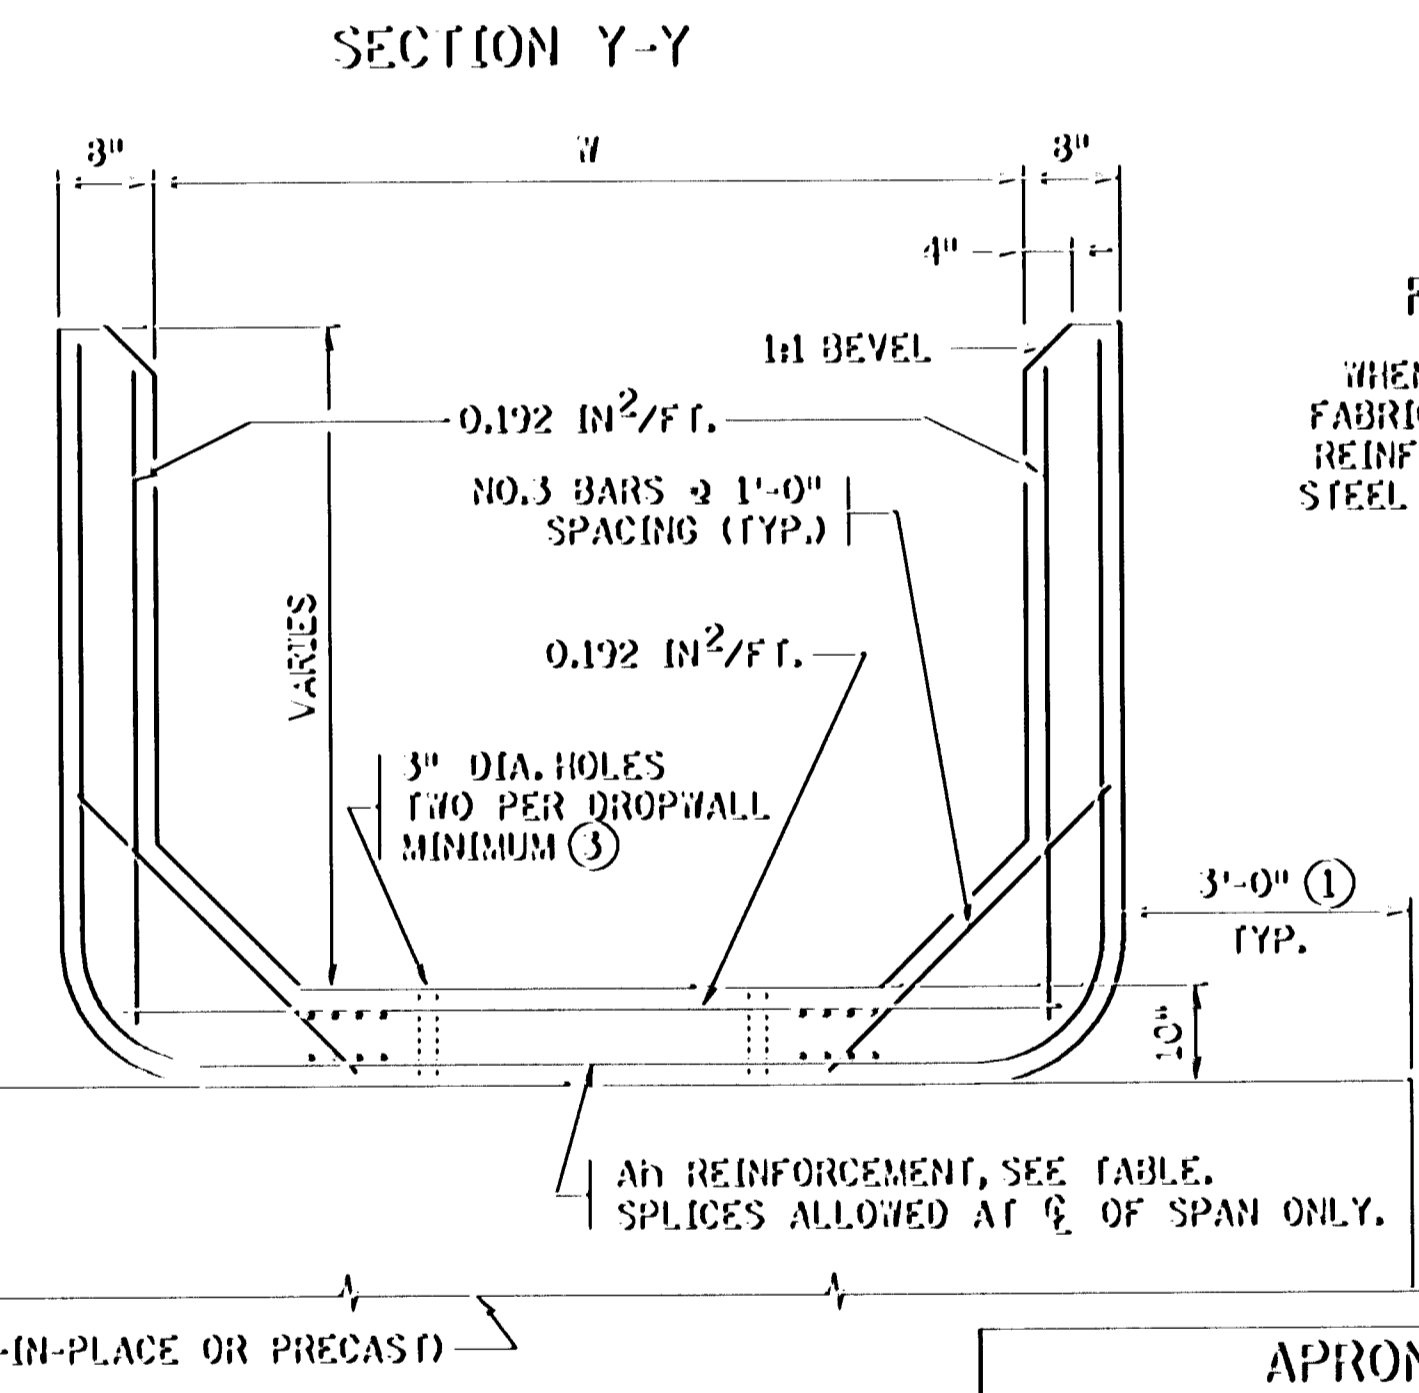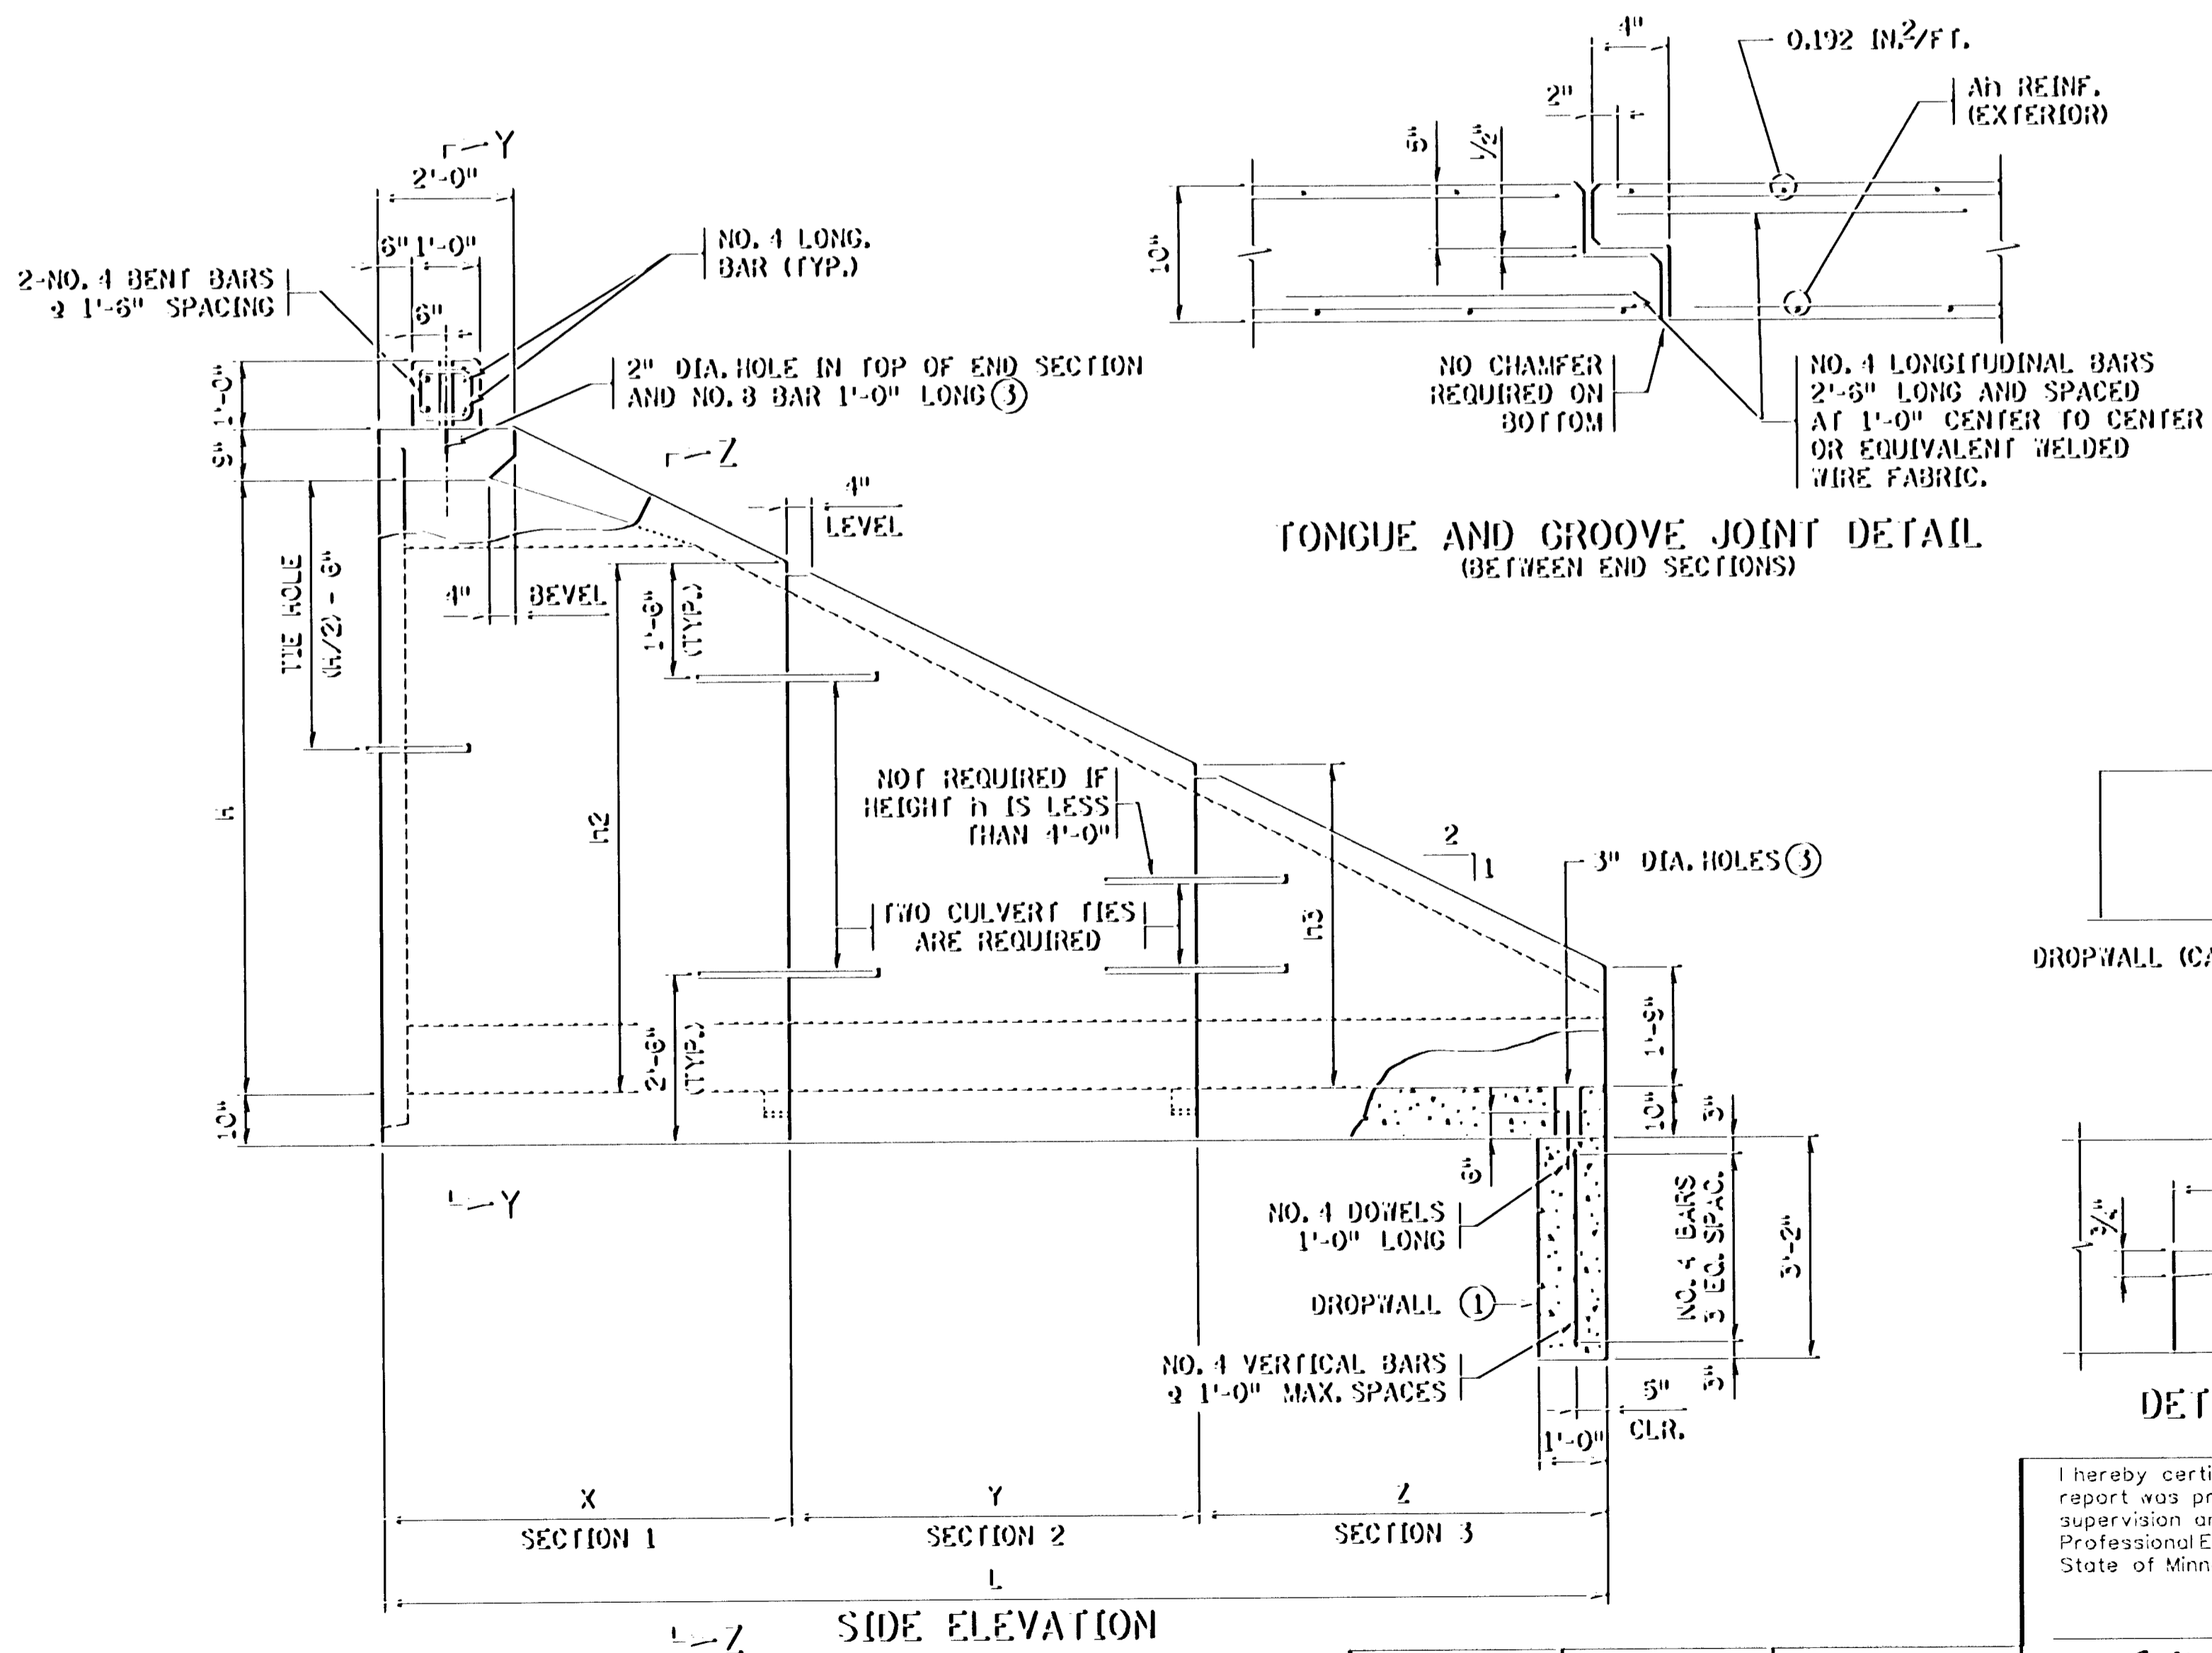

Ah, Ab REINFORCEMENT		
WIDTH (F.T.)	Ah (IN ² /F.T.)	Ab (IN ² /F.T.)
6	.27	.44
8	.47	.60
10	.62	.74
12	.88	1.06

APRON DIMENSIONS & Ah REINFORCEMENT													
H	L	SECTION 1	SECTION 2	SECTION 3	SECTION 4	SECTION 4		SECTION 4					
FT.	FT.	X	Y	Z	ZZ	ZZ	ZZ	ZZ	ZZ				
4	8	3'	0.192	1'-9"									
5	10	6'	0.192	3'-9"	4'	0.192	1'-9"						
6	12	6'	0.192	4'-9"	6'	0.192	1'-9"						
7	14	6'	0.192	5'-9"	8'	0.192	1'-9"						
8	16	6'	0.20	6'-9"	6'	0.192	3'-9"	4'	0.192	1'-9"			
9	18	6'	0.29	7'-9"	6'	0.20	4'-9"	6'	0.192	1'-9"			
10	20	6'	0.42	8'-9"	6'	0.29	5'-9"	8'	0.192	1'-9"			
11	22	6'	0.60	9'-9"	6'	0.42	6'-9"	6'	0.192	3'-9"	4'	0.192	1'-9"
12	24	6'	0.78	10'-9"	6'	0.60	7'-9"	6'	0.20	4'-9"	6'	0.192	1'-9"

NOTE: Ah IS AREA OF REINFORCEMENT PER FOOT OF LENGTH (IN²/FT.).

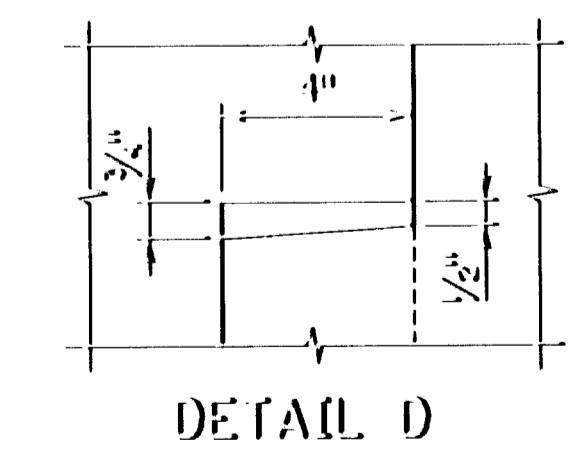

I hereby certify that this plan, specification or report was prepared by me or under my direct supervision and that I am a duly Registered Professional Engineer under the laws of the State of Minnesota.

Alger B.

Date 3-21-97 Reg. No. 25066

SRI CONSULTING GROUP, INC.

STANDARD SHEET NO. 5-297.421

STATE BRIDGE ENGINEER APPROVAL: AUGUST 10, 1995

FILE: PRECAST CONCRETE END SECTION TYPE I - SINGLE OR MULTI-BARREL FOR SKEWS UP TO 1/2

BRIDGE NO. 02J07

S.A.P. 02-617-11, et al.


SHEET NO. 94 OF 236

SHEET'S


SERVER: CAGSIL/USR/STANDARDS FILE NAME: S2ZLNSE.SFN

DES: L. ROBJENT DR: APPROVED:


CHK: R.A.S. CHK:

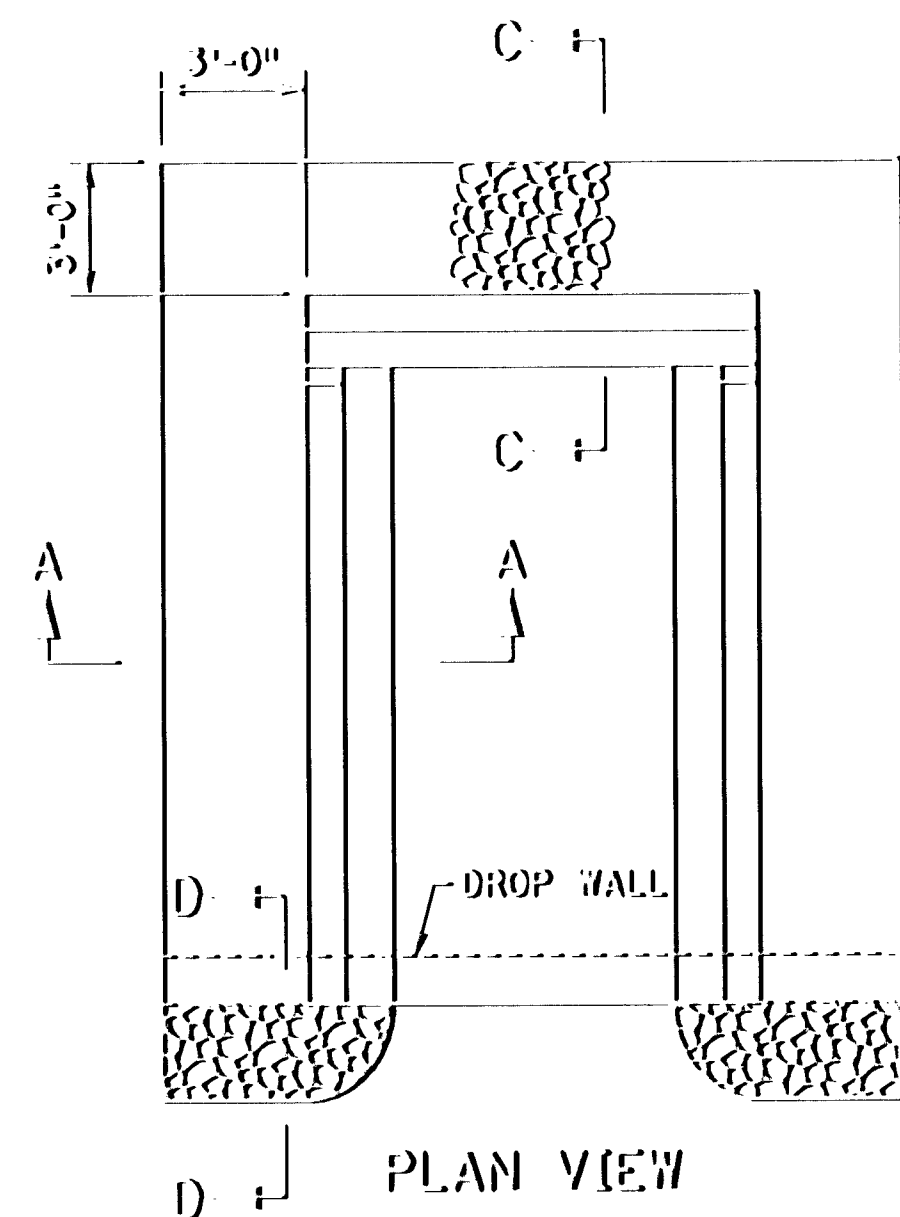


PLAN VIEW

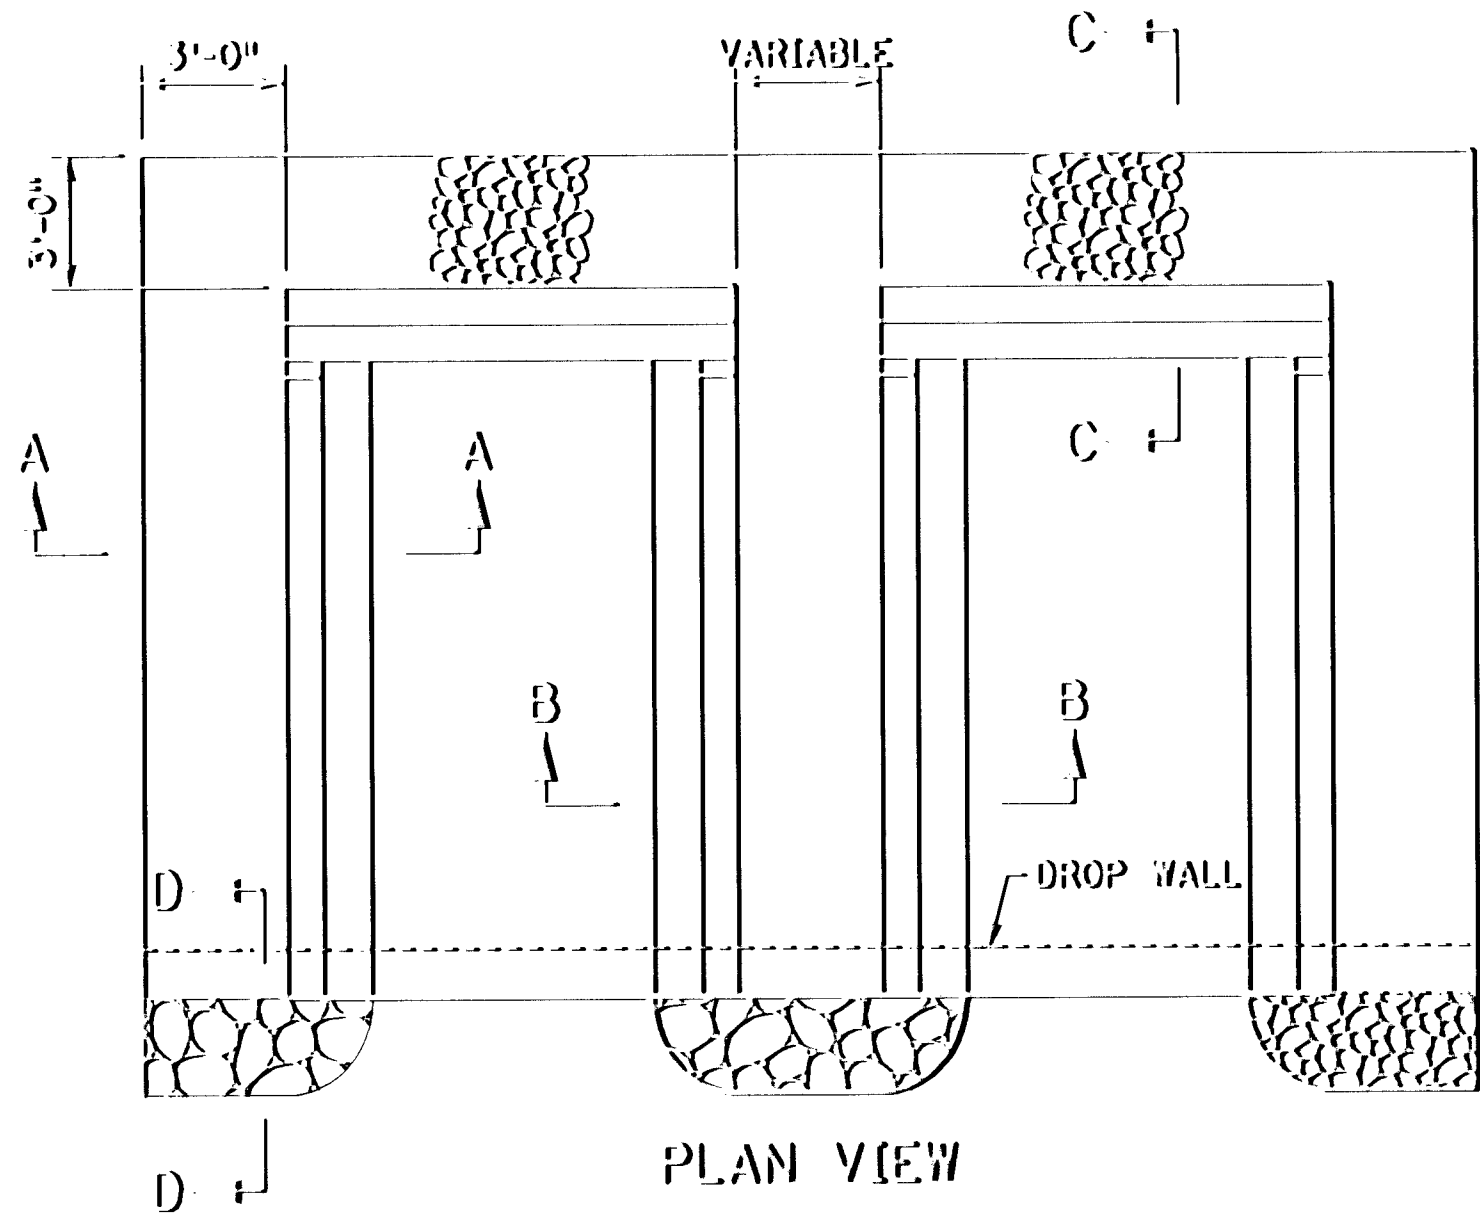


PLAN VIEW

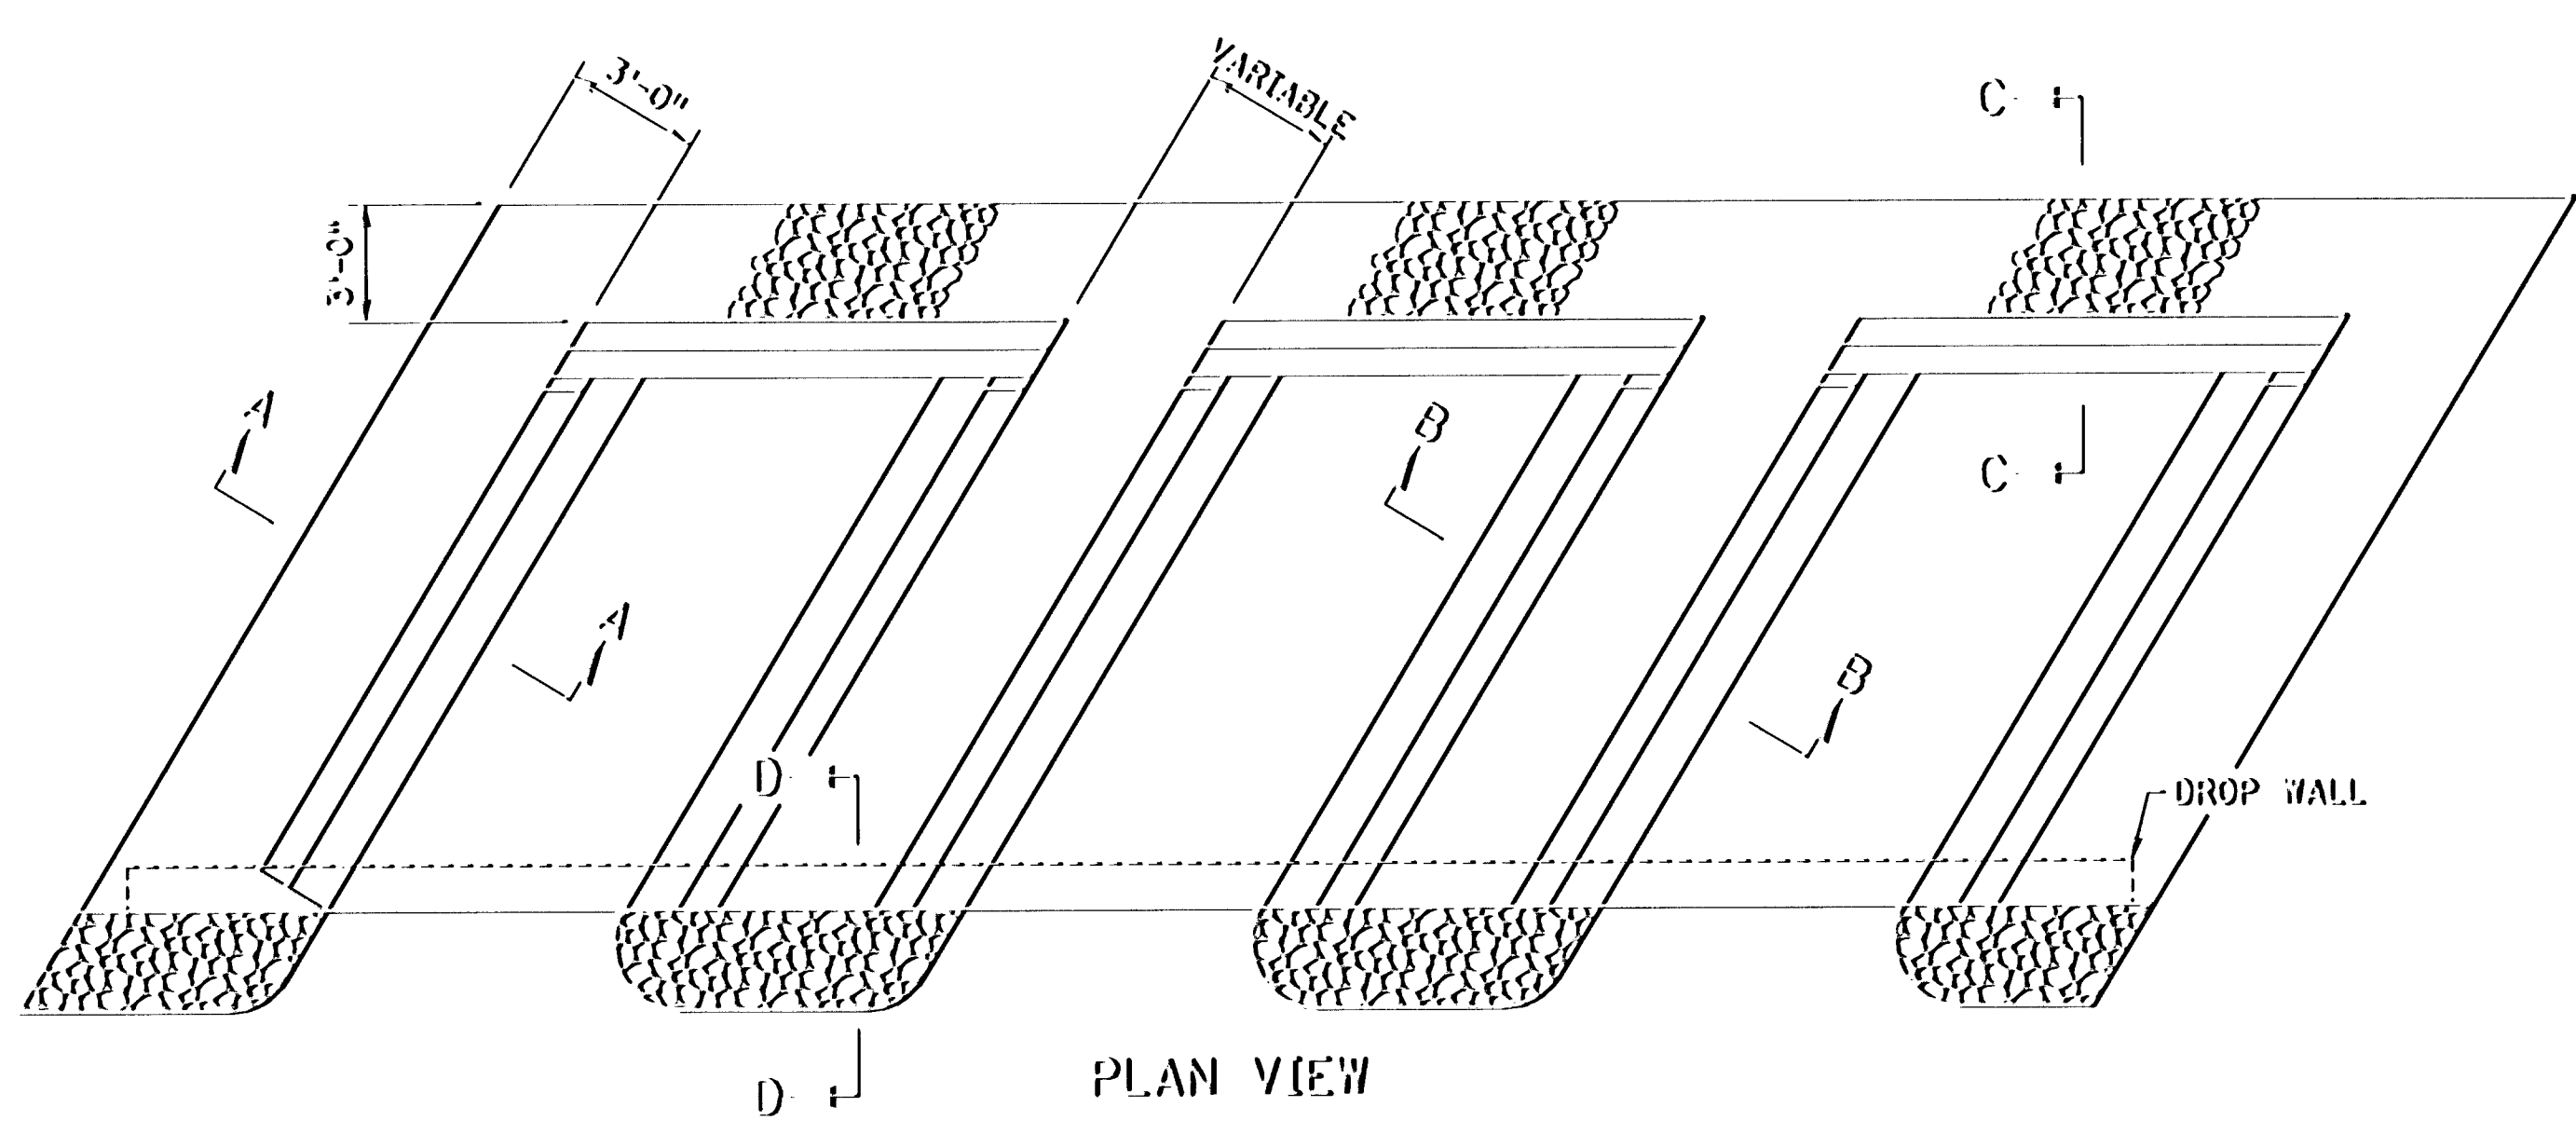


PLAN VIEW

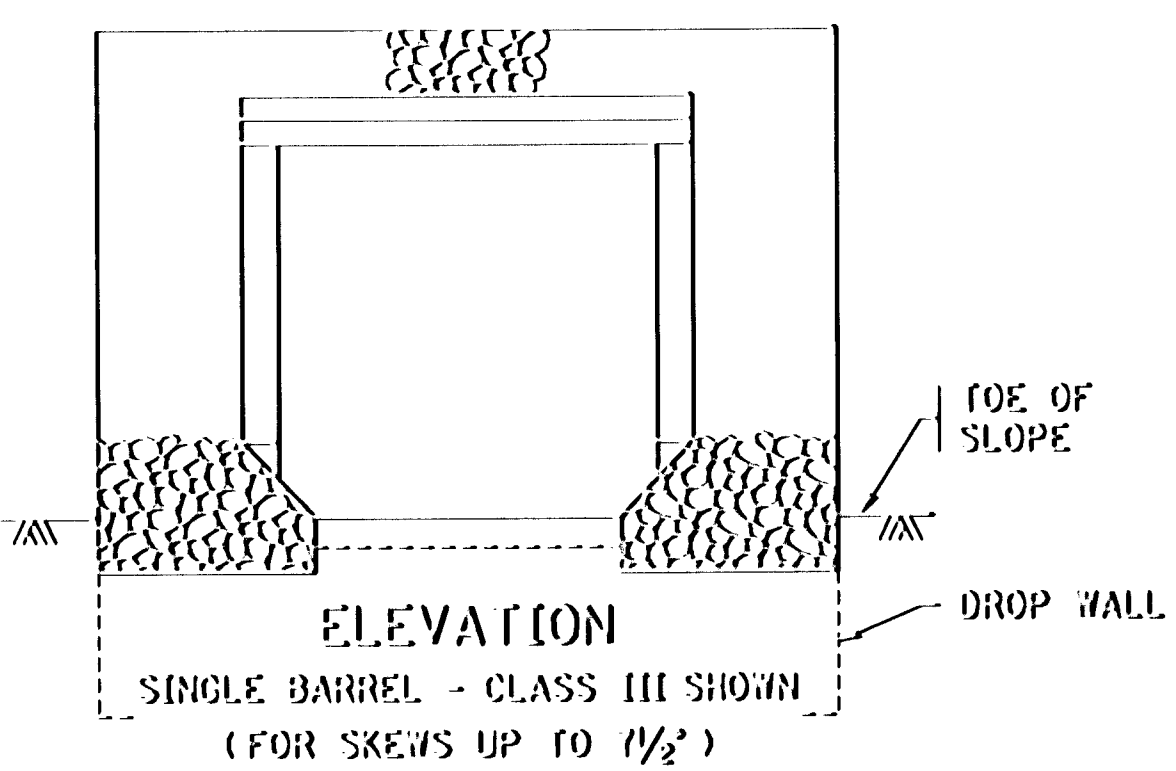


ELEVATION
SINGLE BARREL - CLASS III SHOWN
(FOR SKEWS UP TO 1/2')

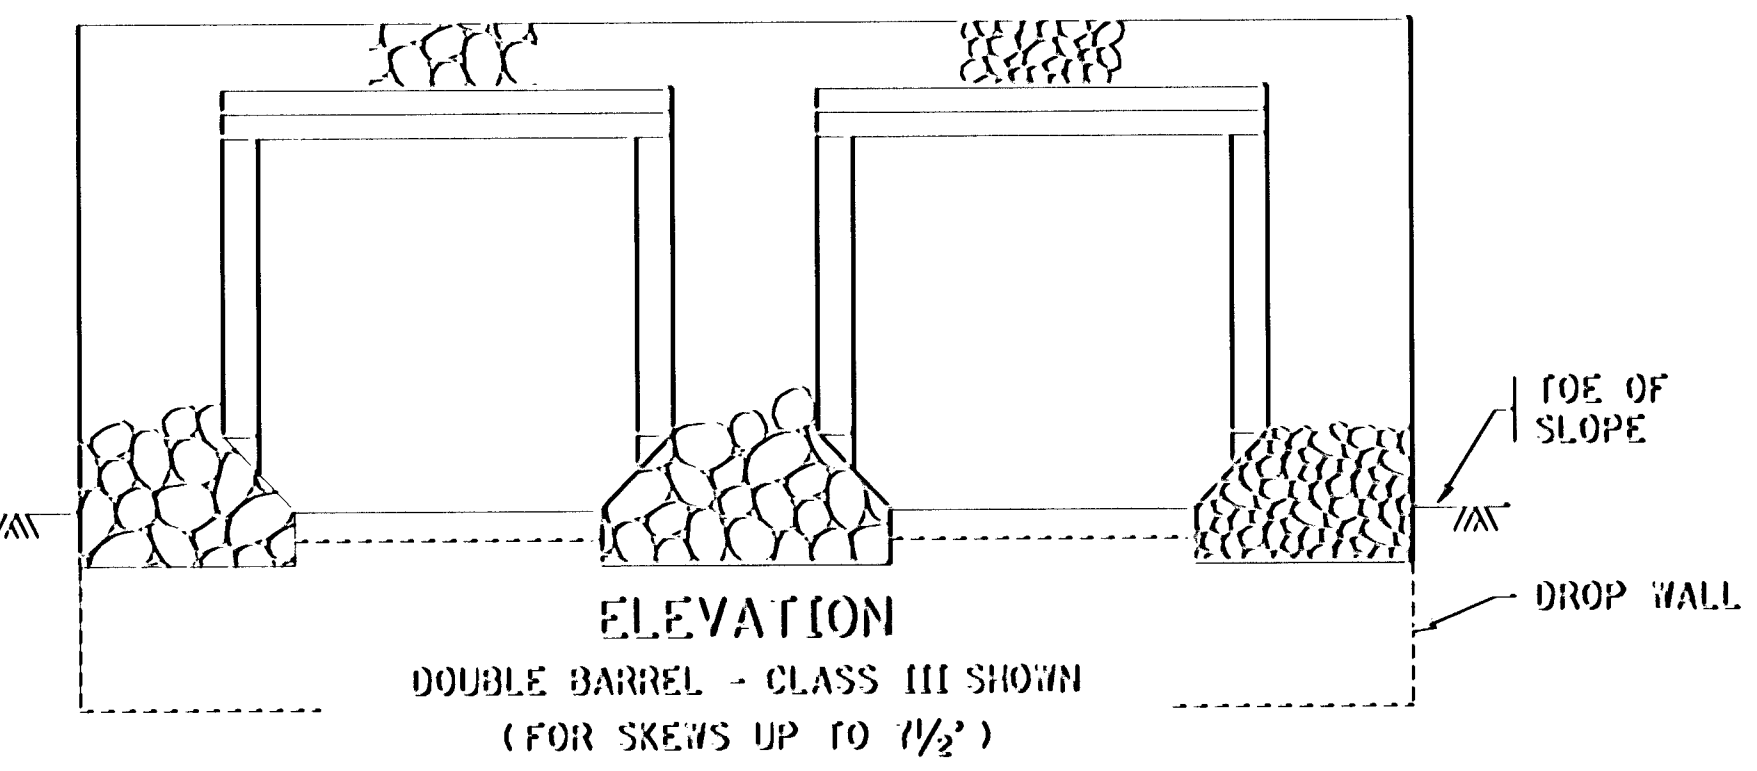


ELEVATION
DOUBLE BARREL - CLASS III SHOWN
(FOR SKEWS UP TO 1/2')

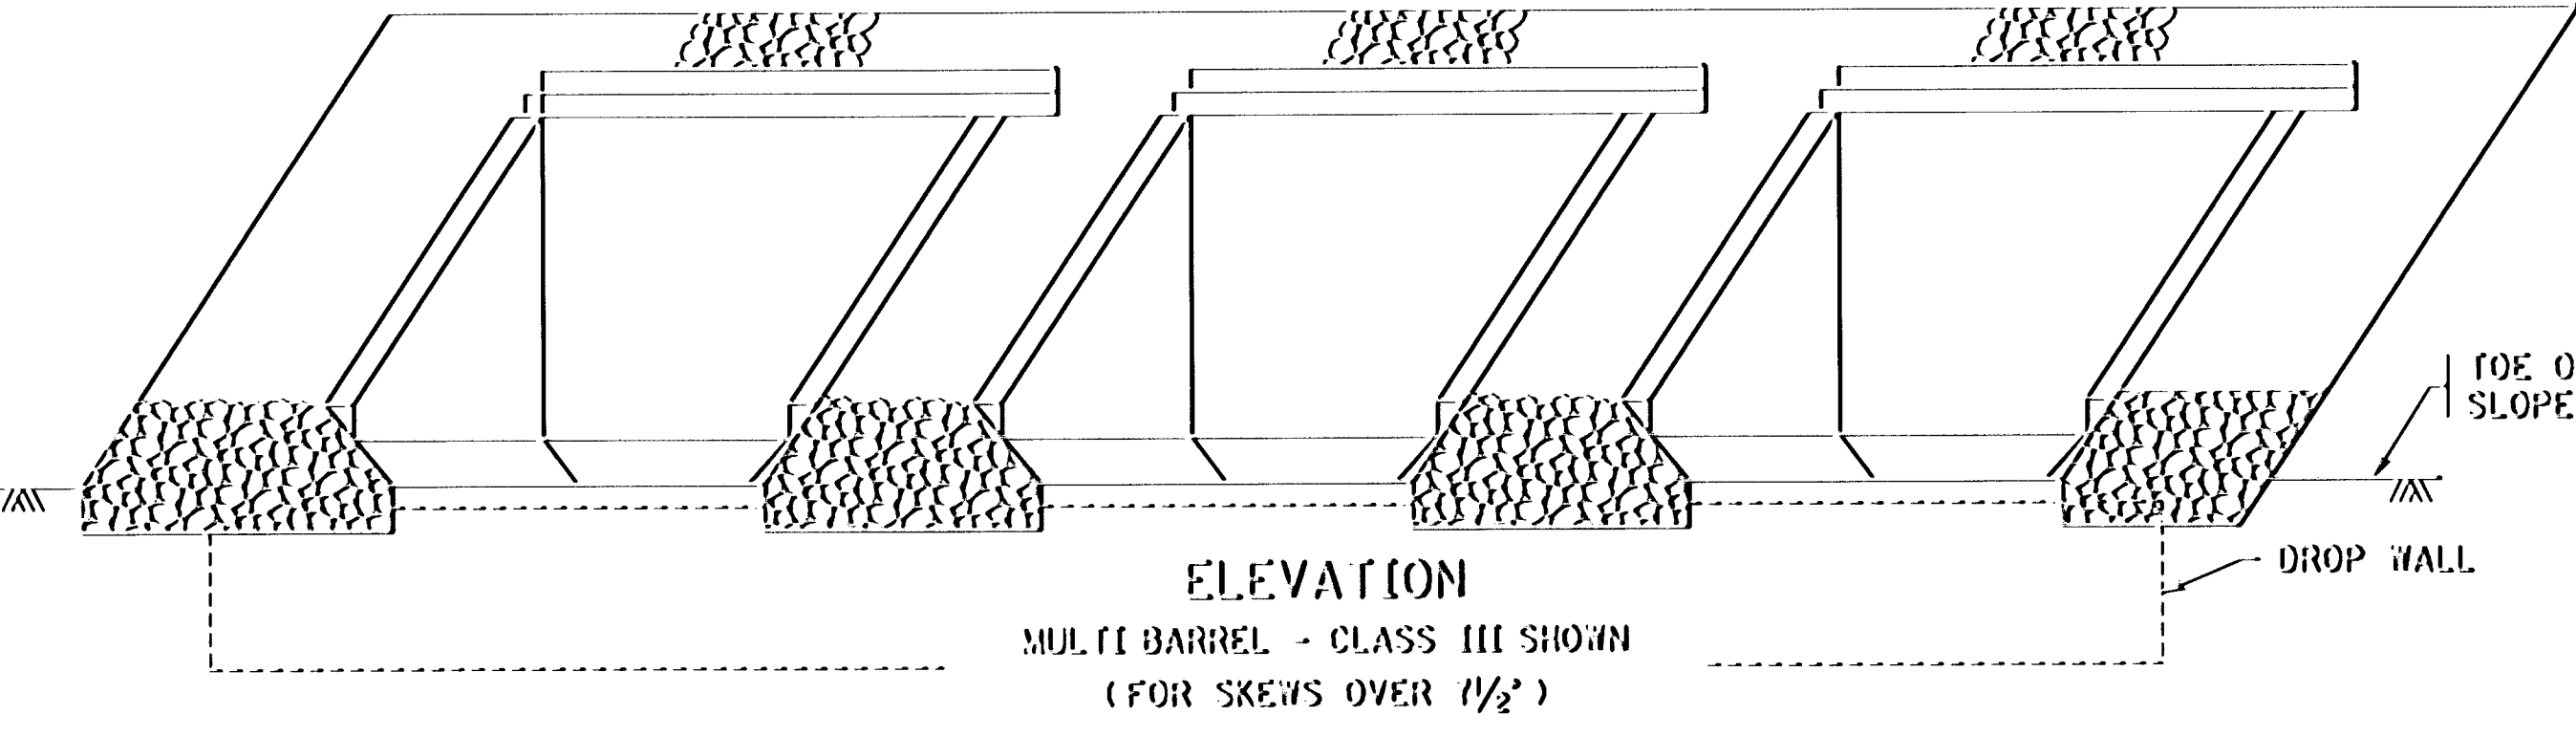


ELEVATION
MULTI BARREL - CLASS III SHOWN
(FOR SKEWS OVER 1/2')

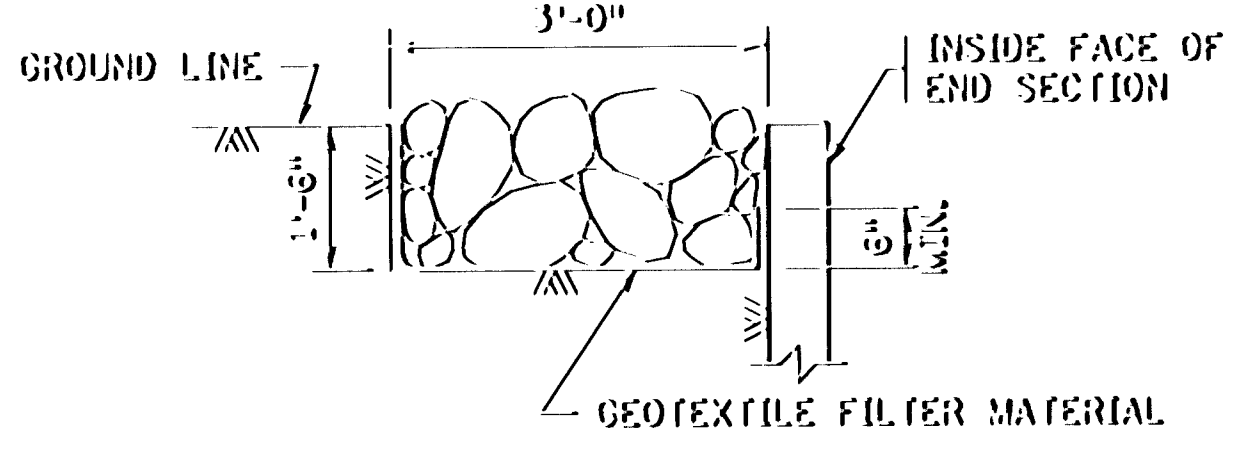


SECTION A-A

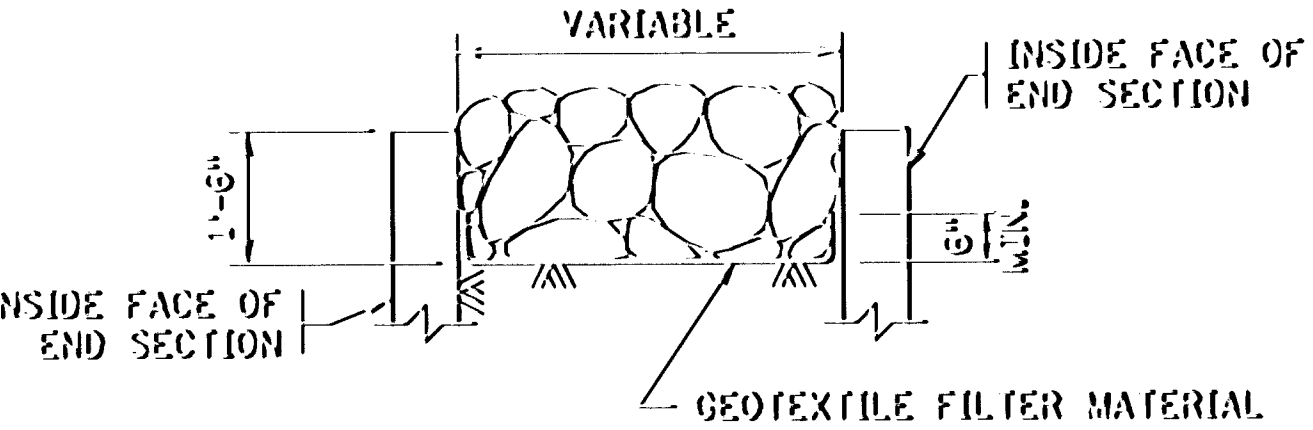


SECTION B-B

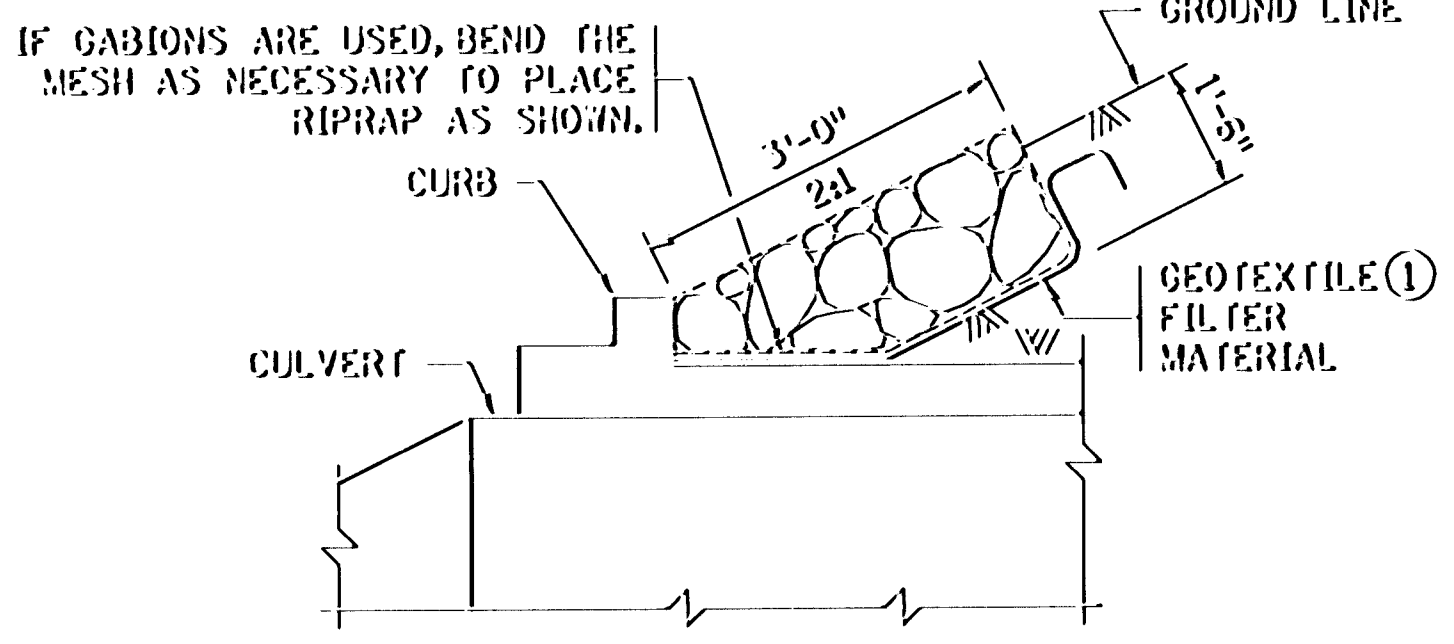

SECTION C-C

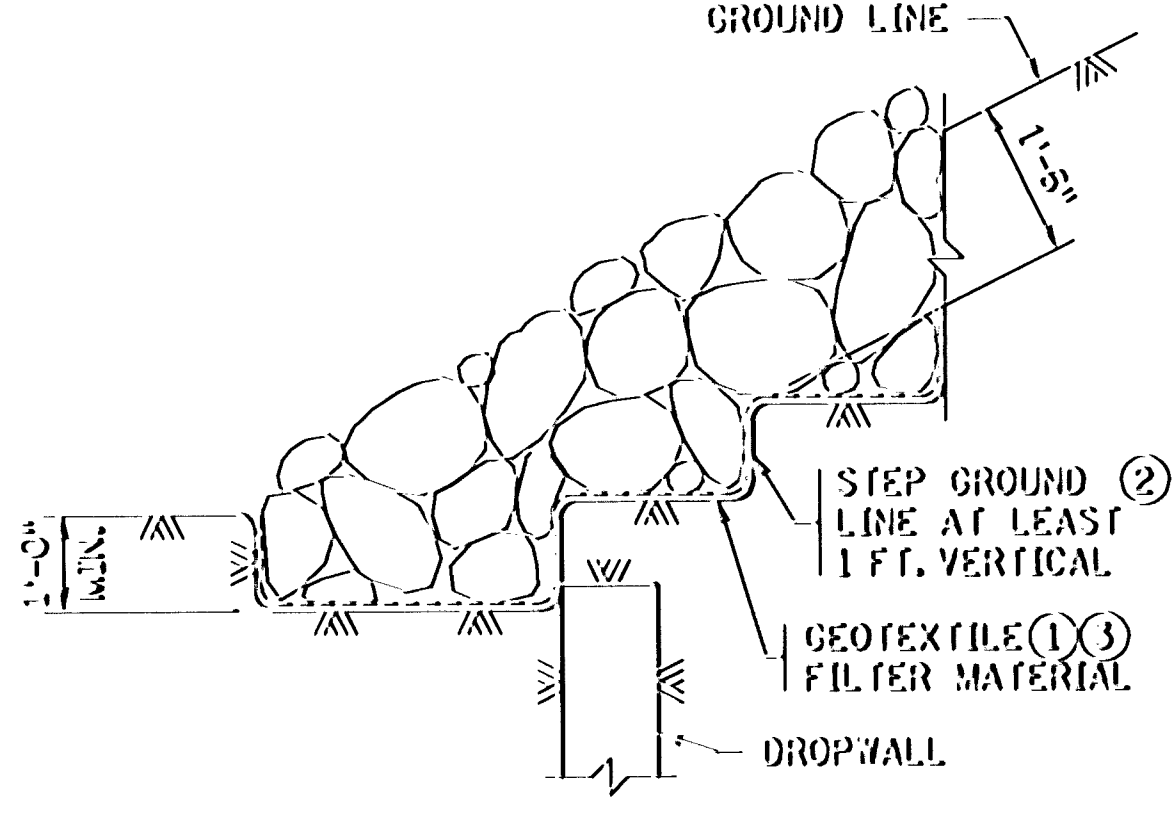

CLASS III RIPRAP OPTION

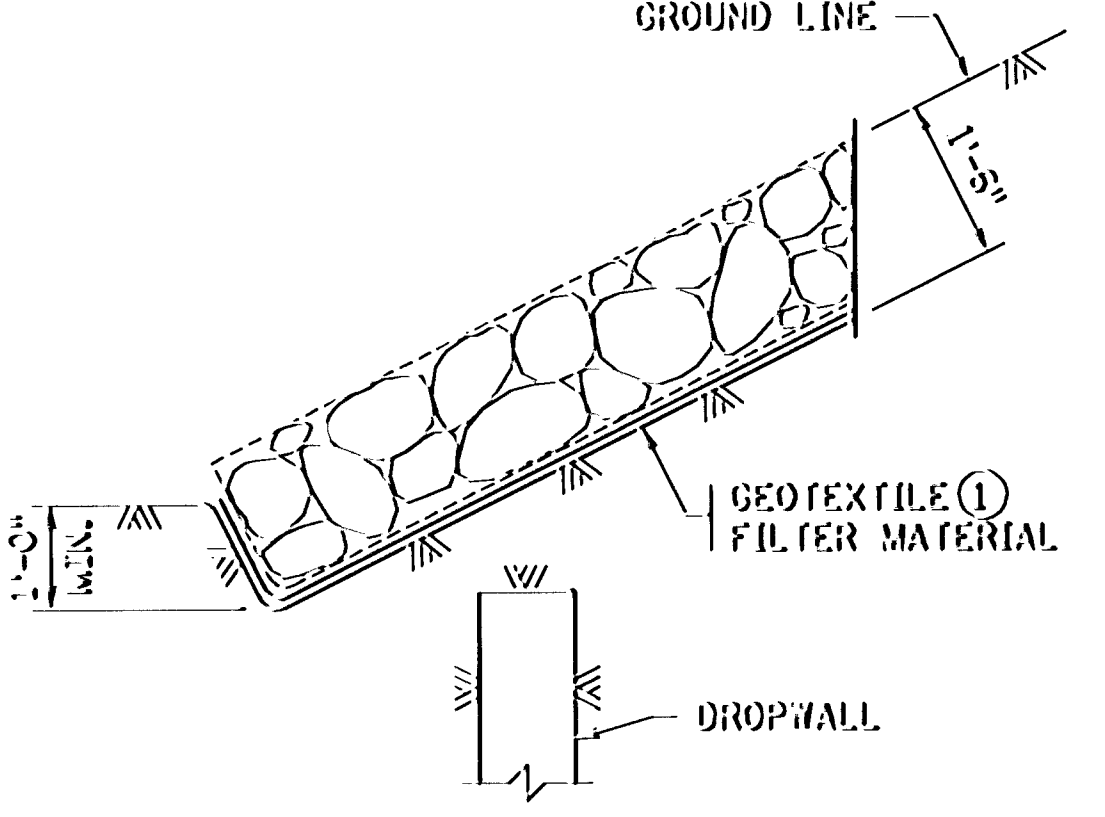

CLASS II RIPRAP IN GABIONS OPTION

- NOTES:**
- RIPRAP SHALL COMPLY WITH SPECS. 2511 AND 3601. THE CONTRACTOR MAY USE EITHER CLASS III, WITH GEOTEXTILE FILTER MATERIAL, OR CLASS II ENCLOSED IN GABIONS, WITH GEOTEXTILE FILTER MATERIAL. 4" TO 8" DIA. ROCK MAY BE USED IN GABIONS, IF THE MESH OPENINGS ARE 4" OR LESS. GABIONS SHALL BE RIVER TYPE, CODE "D", 3 FT. WIDE X 1.5 FT. DEEP.
 - ① FOR TYPE OF GEOTEXTILE FILTER MATERIAL REQUIRED, SEE SPEC. 3733. GEOTEXTILE STRIPS SHOULD BE CONTINUOUS WITHOUT OVERLAPS, EXCEPT FOR THE TOP STRIP, WHICH SHOULD SHINGLE VERTICAL STRIPS. THE TOP EDGE SHOULD BE BURIED TO PREVENT UNDERMINING (SPEC. 2511.3B).
 - ② SLOPES 2:1 TO 3:1 MUST BE STEPPED TO MINIMIZE SLIDING POTENTIAL.
 - ③ IF SLOPES ARE NOT STEPPED, GRANULAR FILTER SHOULD BE USED.

I hereby certify that this plan, specification or report was prepared by me or under my direct supervision and that I am a duly Registered Professional Engineer under the laws of the State of Minnesota.

[Signature]
Date 3-21-97 Reg. No. 25066

SRT CONSULTING GROUP, INC.

BRIDGE NO. 02J07

SECTION D-D

STANDARD SHEET NO. 5-297.425
STATE BRIDGE ENGINEER APPROVAL: AUGUST 10, 1995

EMBANKMENT PROTECTION FOR BOX CULVERTS

DES: L. ROBJENT DR:
CHK: R.A.S. CHK:


APPROVED:

S.A.P. 02-617-11, et al.


SHEET NO. 95 OF 236 SHEETS

SERVER: C:\B\SL\USR\STANDARDS FILE NAME: S25066.SPK

SERVER C:\AS\USER\STANDARDS FILE NAME SW10001.SPK

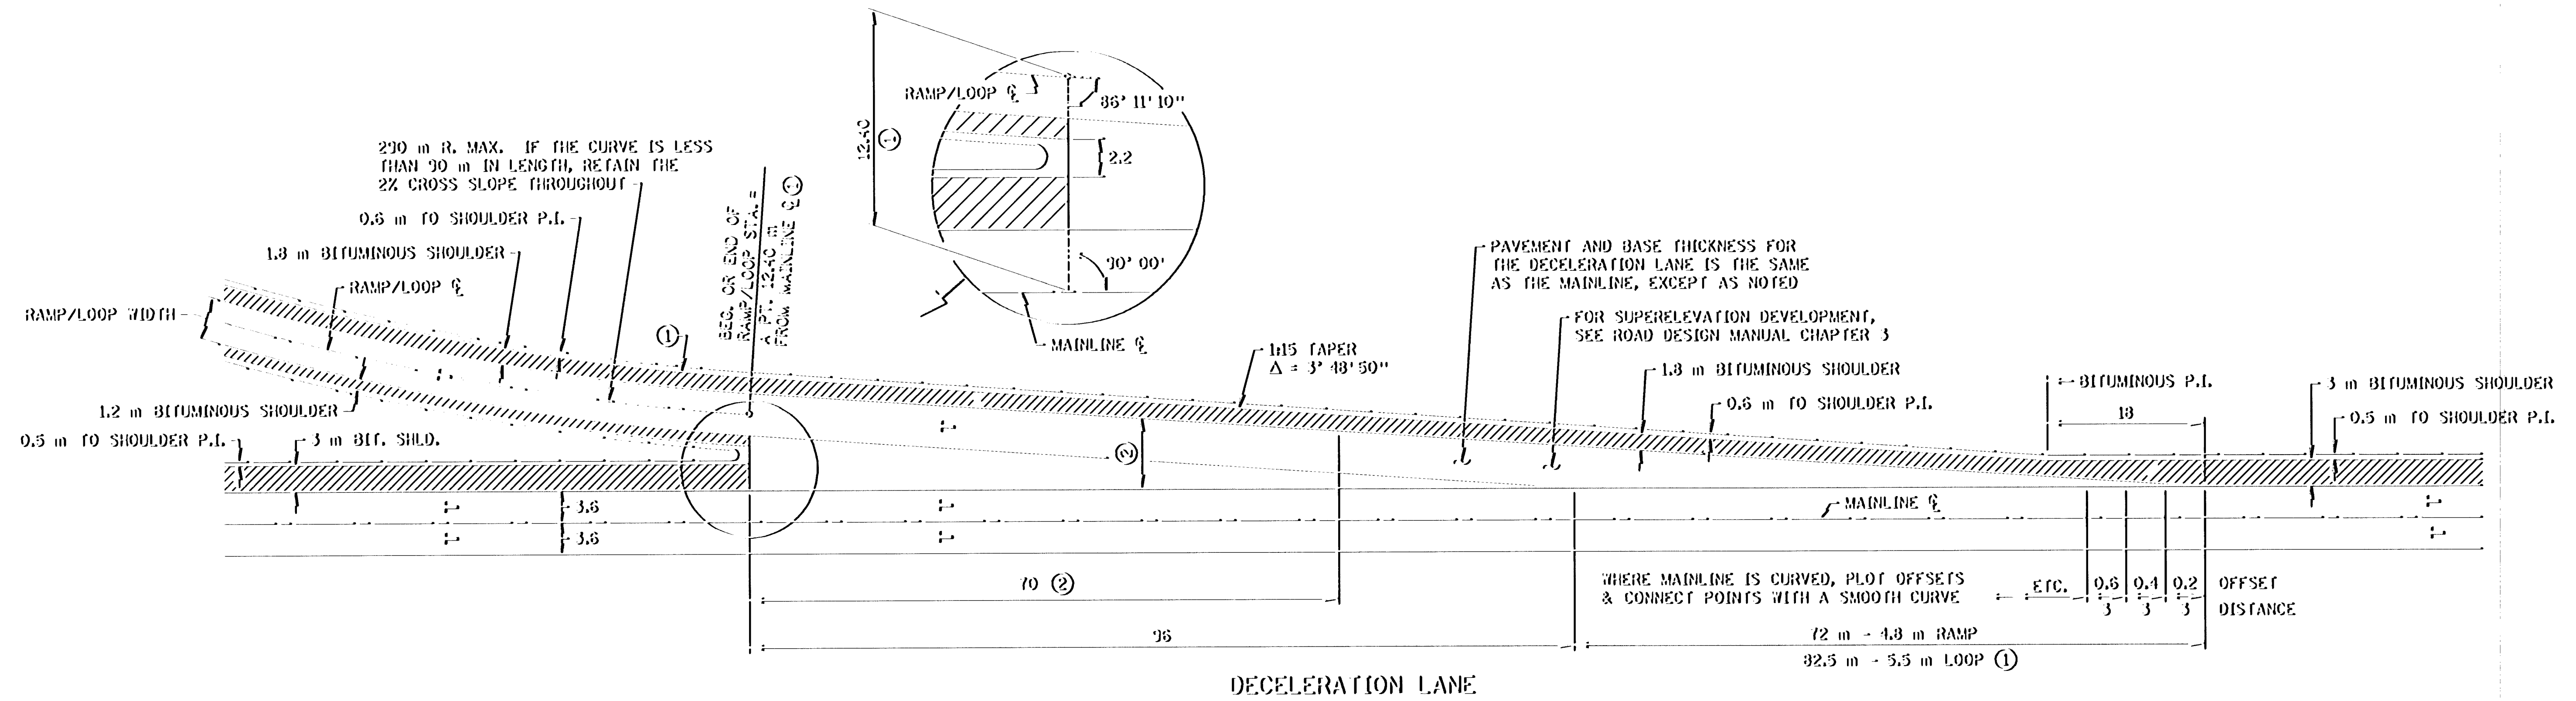


DECELERATION LANE

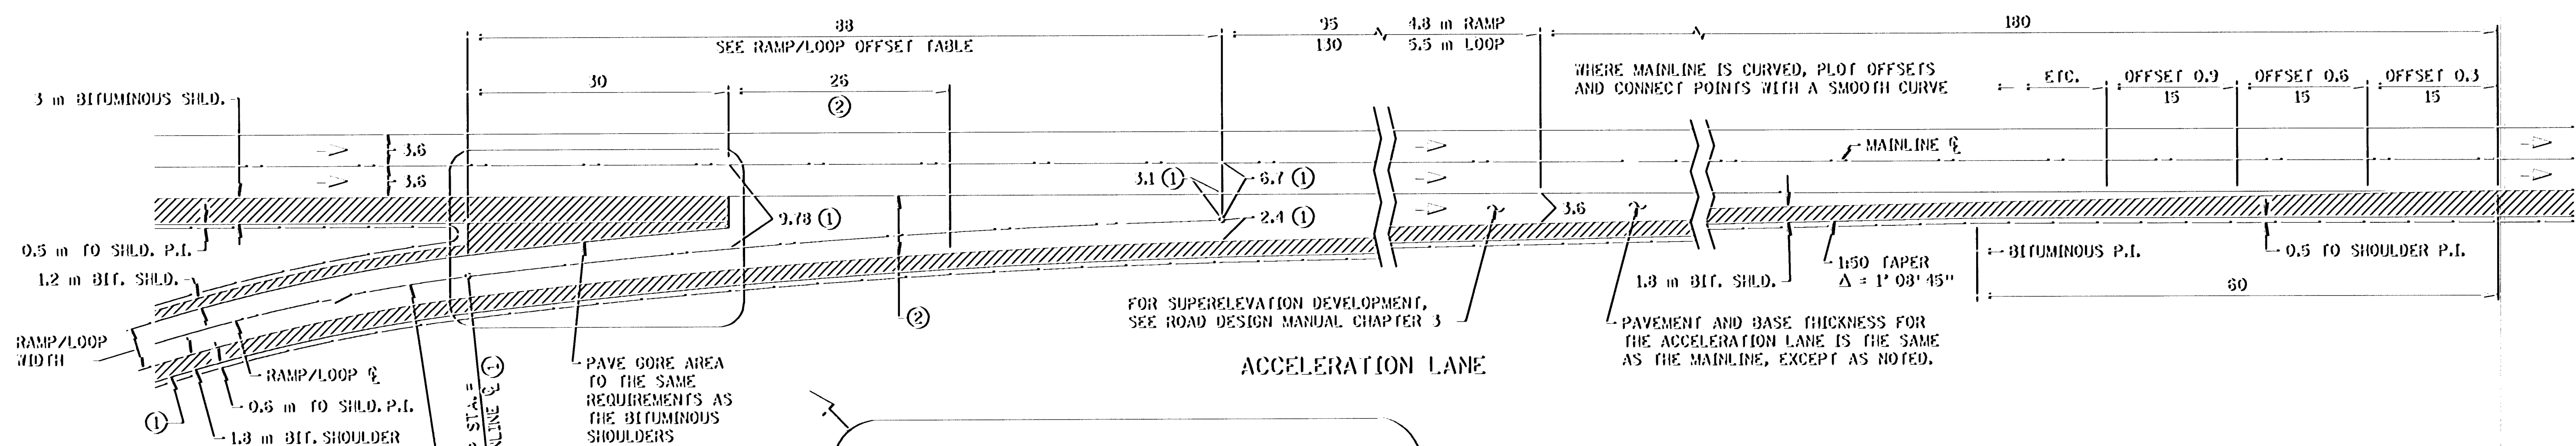

ACCELERATION LANE

4.8 m RAMP/LOOP OFFSET TABLE FOR APPROX. 875 m R. CURVE (1)
OFFSET FROM MAINLINE ϕ TO RAMP/LOOP ϕ

DISTANCE	0	6	12	18	24	30	36	42	48
OFFSET	6.706	6.343	7.030	7.255	7.522	7.831	8.179	8.585	9.020
DISTANCE	54	58	60	66	72	78	84	88	
OFFSET	9.450	9.779	9.980	10.521	11.124	11.769	12.459	12.916	

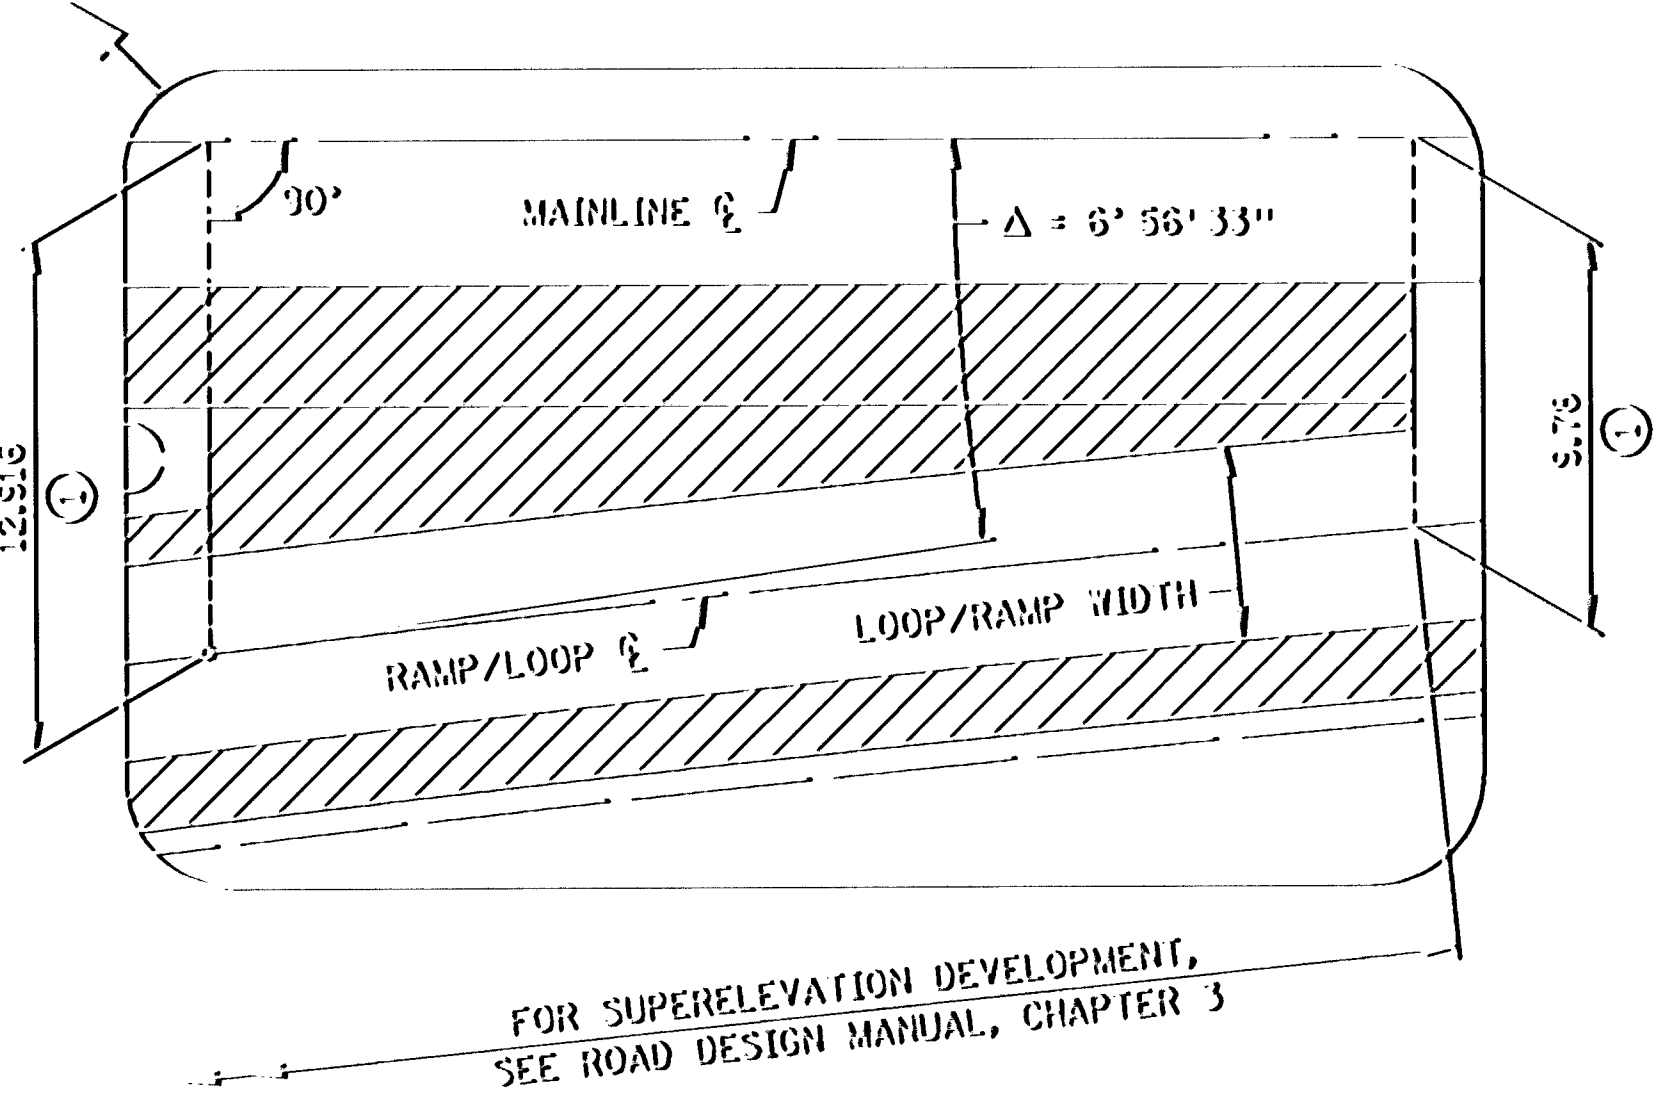


- NOTES:
- WHEN IT IS NECESSARY FOR RAMPS/LOOPS TO BE WIDER, SEE ROAD DESIGN MANUAL TABLE CHAPTER 6, WIDENING SHALL BE DONE ON THE OUTSIDE AND THE TAPER LENGTH INCREASED ACCORDINGLY.
 - THE AREA SHOWN SHALL BE GRADED FOR MAINLINE DEPTH. THE RAMP PAVEMENT THICKNESS WILL BE USED WITH ADDITIONAL DEPTH CORRECTED IN THE AGGREGATE BASE, OR GRADING MATERIAL, DEPENDING ON THE SURFACING TYPE.


NOTE: ALL DIMENSIONS ARE IN METERS, EXCEPT AS NOTED.

STANDARD SHEET NO.
5-297.106M
STANDARD APPROVED
JULY 30, 1991


STANDARD ACCELERATION AND DECELERATION LANES
(RURAL)
BITUMINOUS PAVEMENT

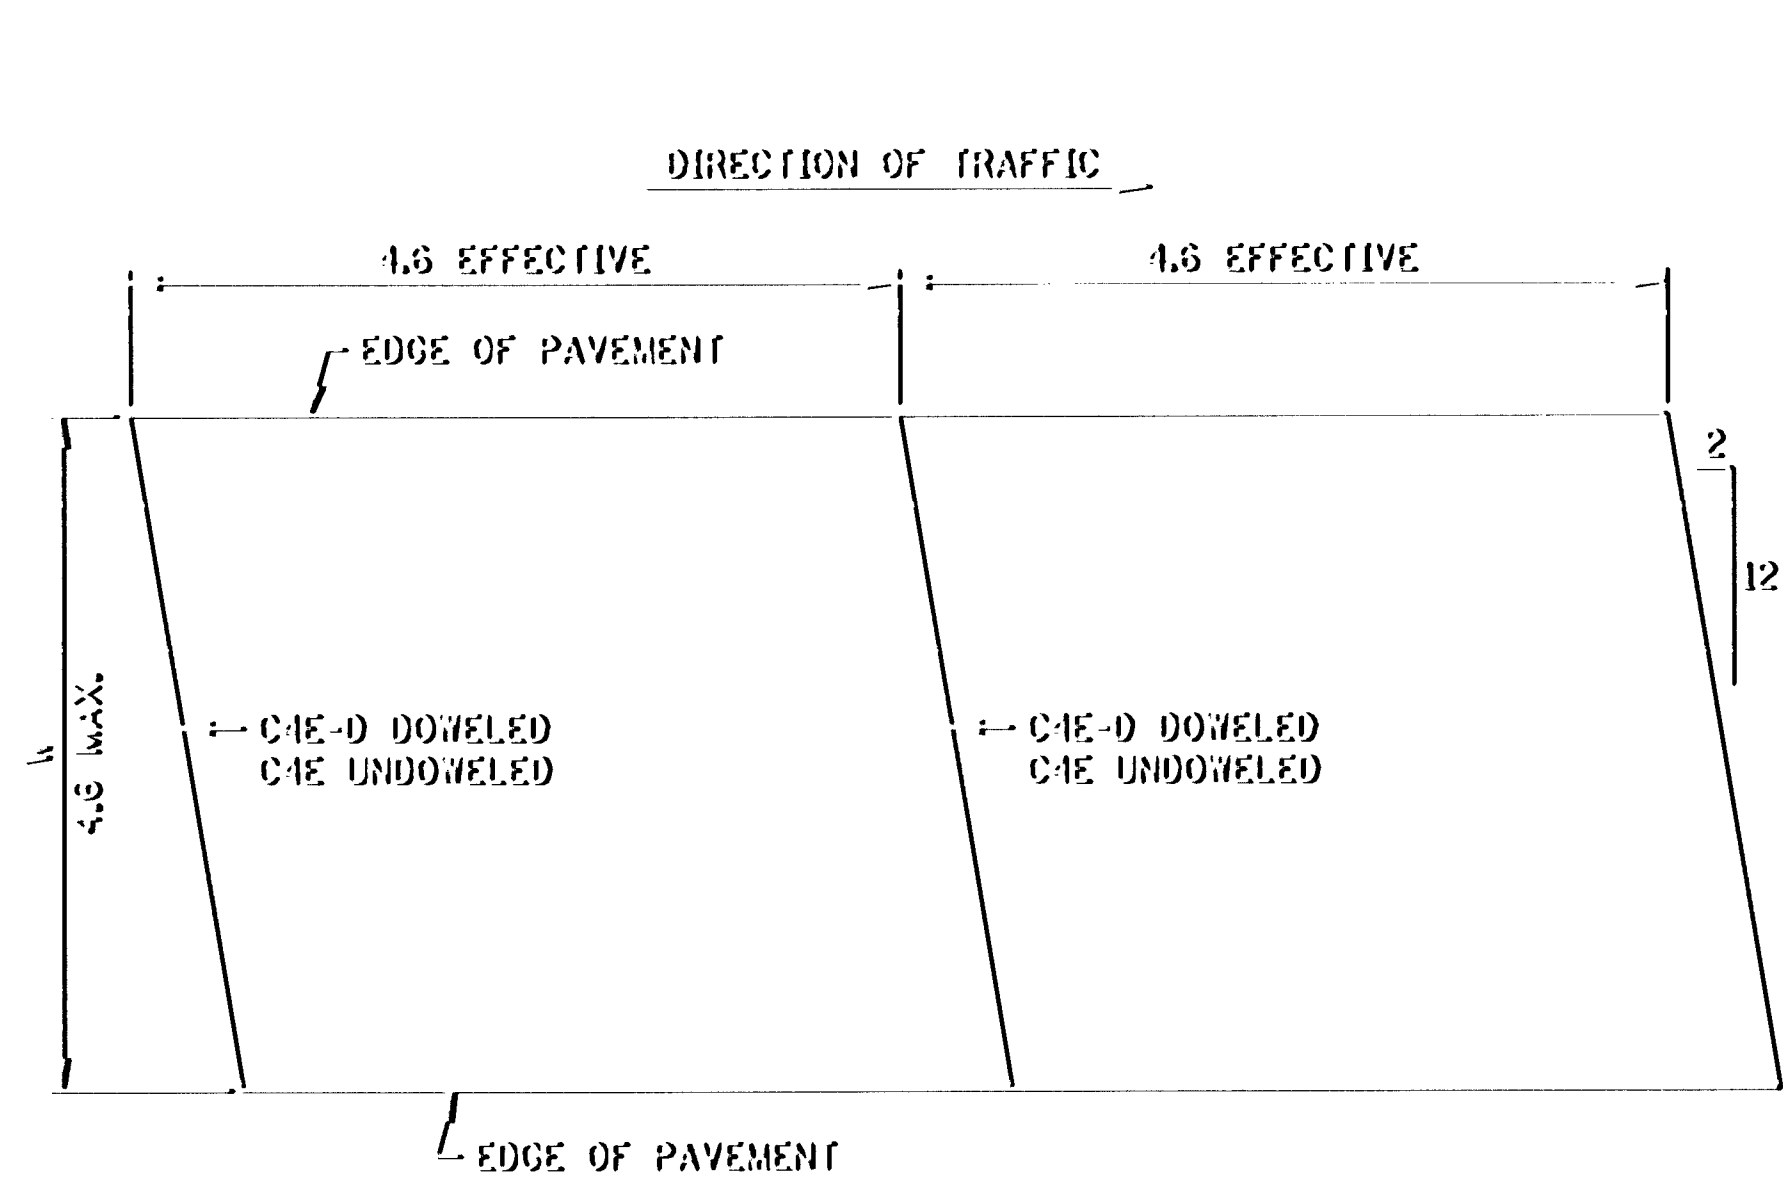


PAVEMENT 0.3 m THRU 4.6 m WIDTH

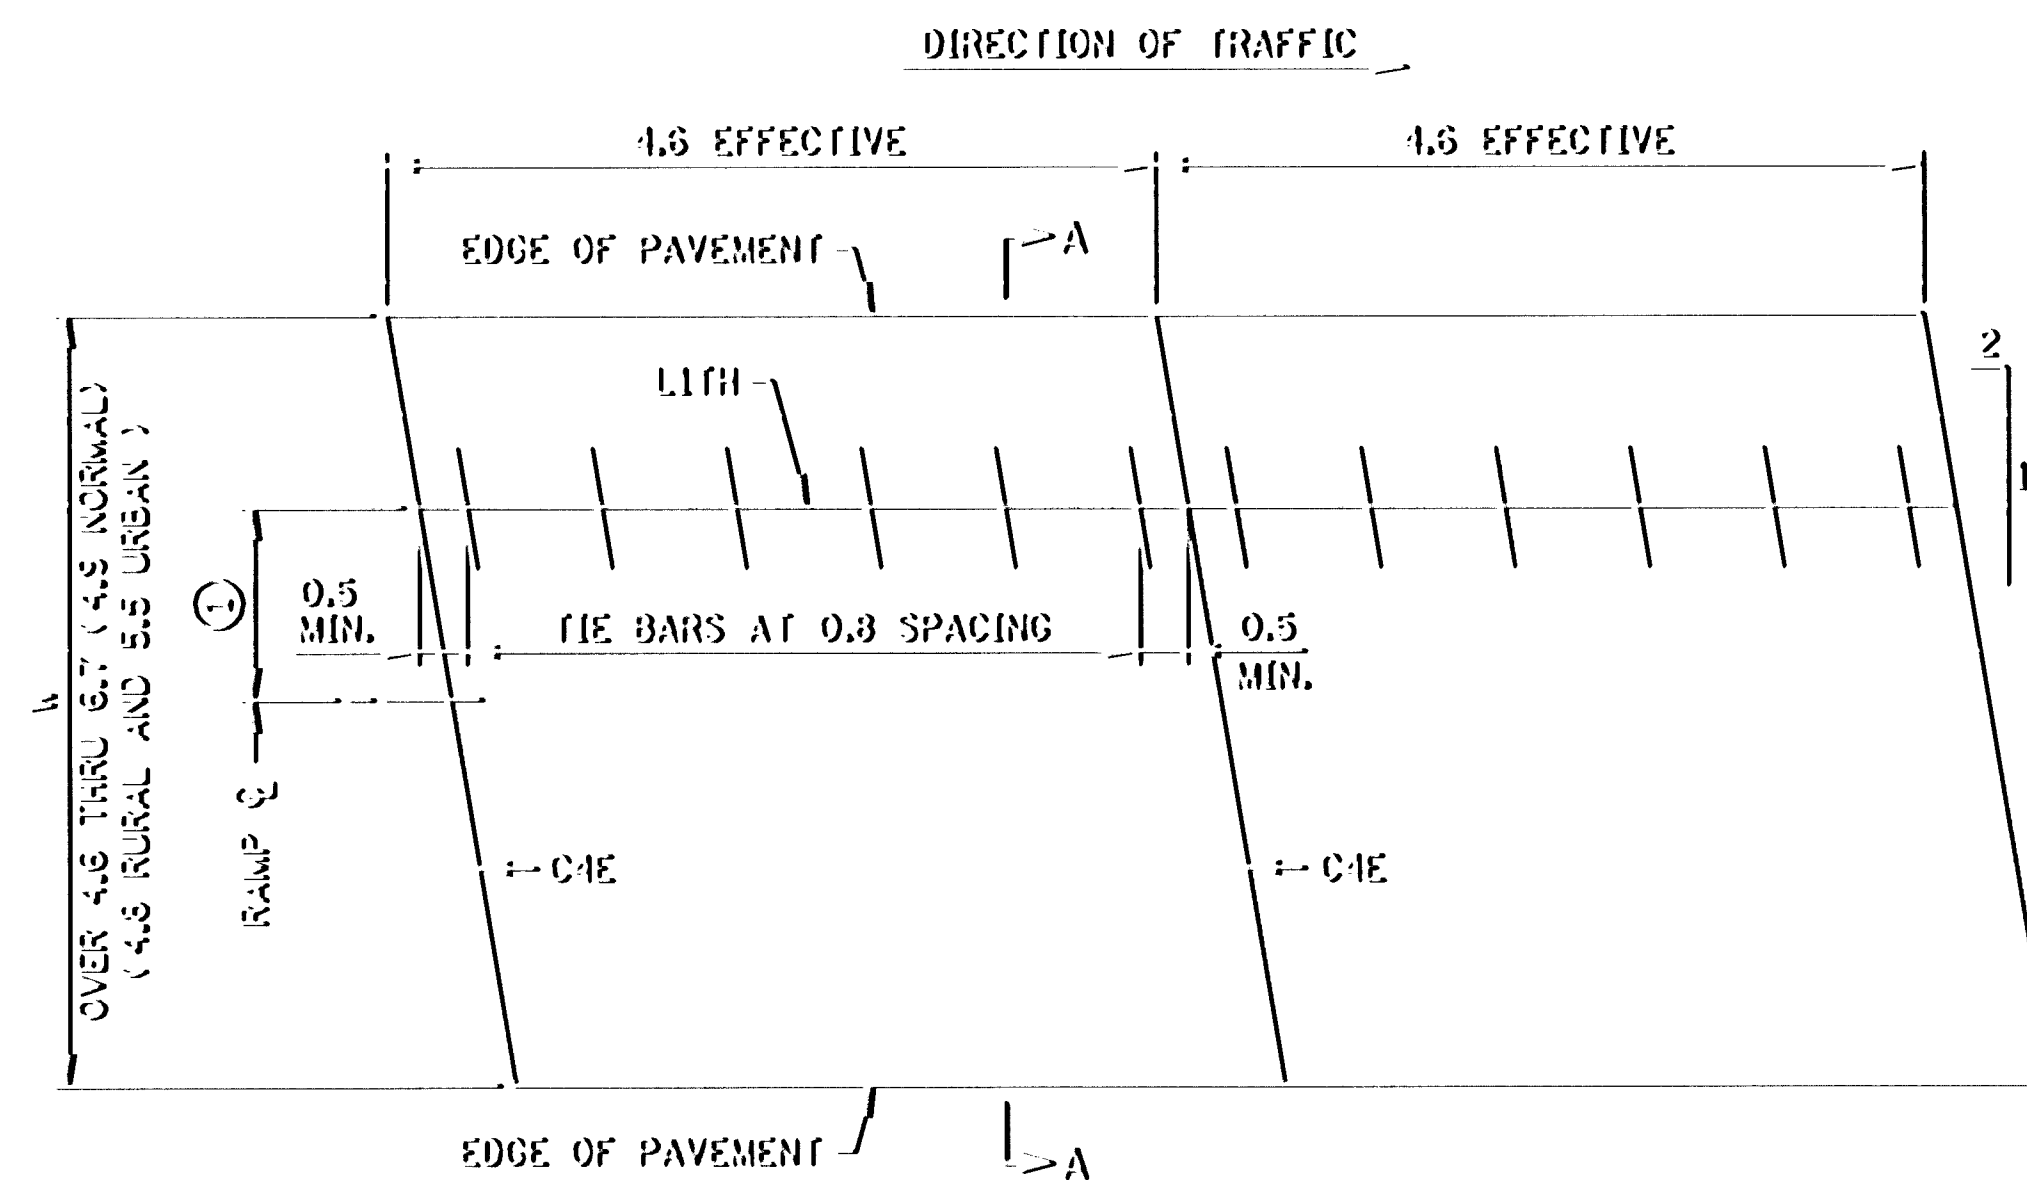


PAVEMENT OVER 4.6 m THRU 6.7 m WIDTH
UNDOWELED

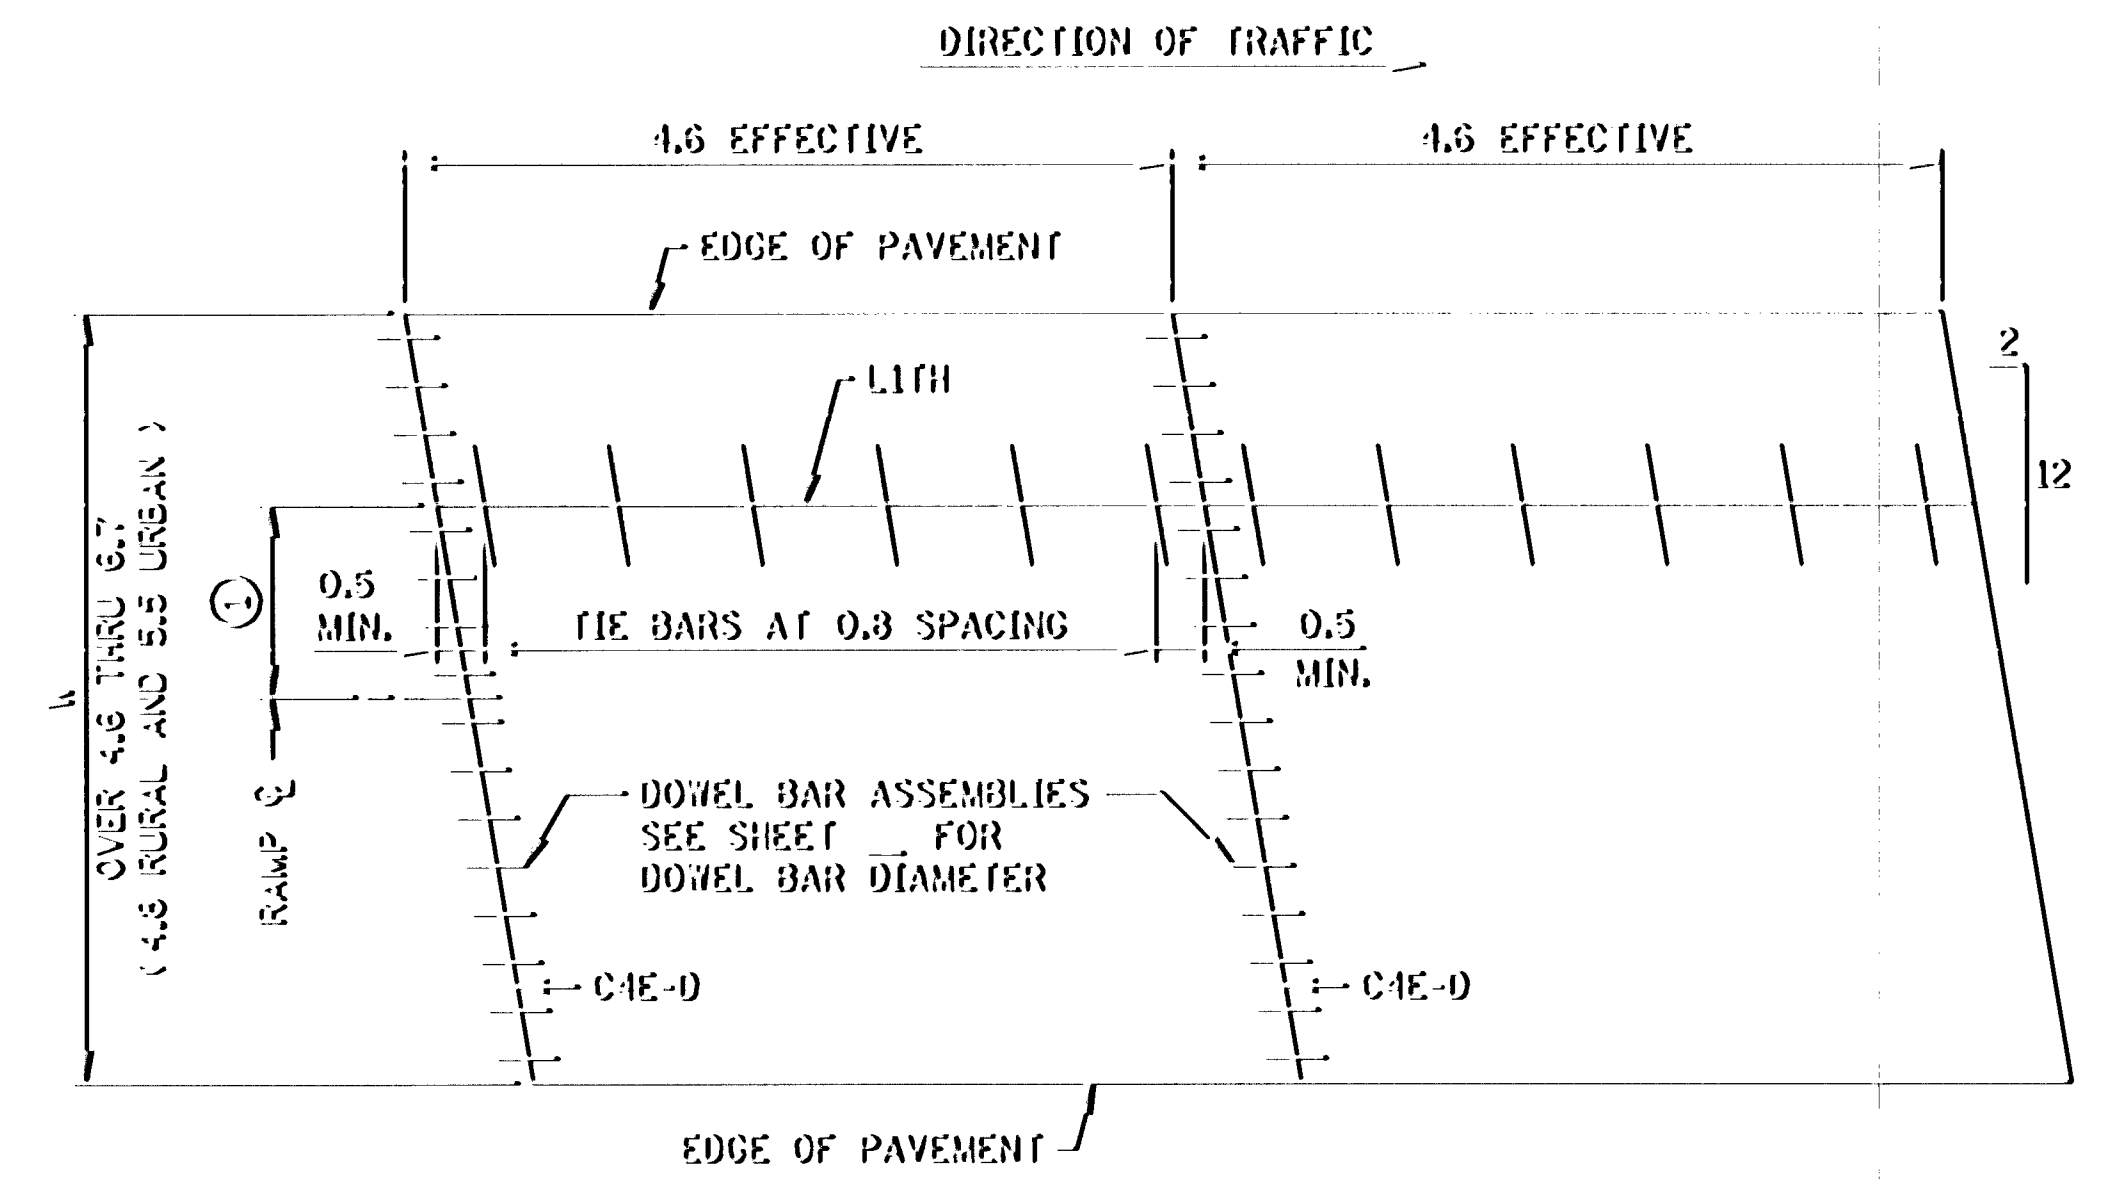


PAVEMENT OVER 4.6 m THRU 6.7 m WIDTH
DOWELED

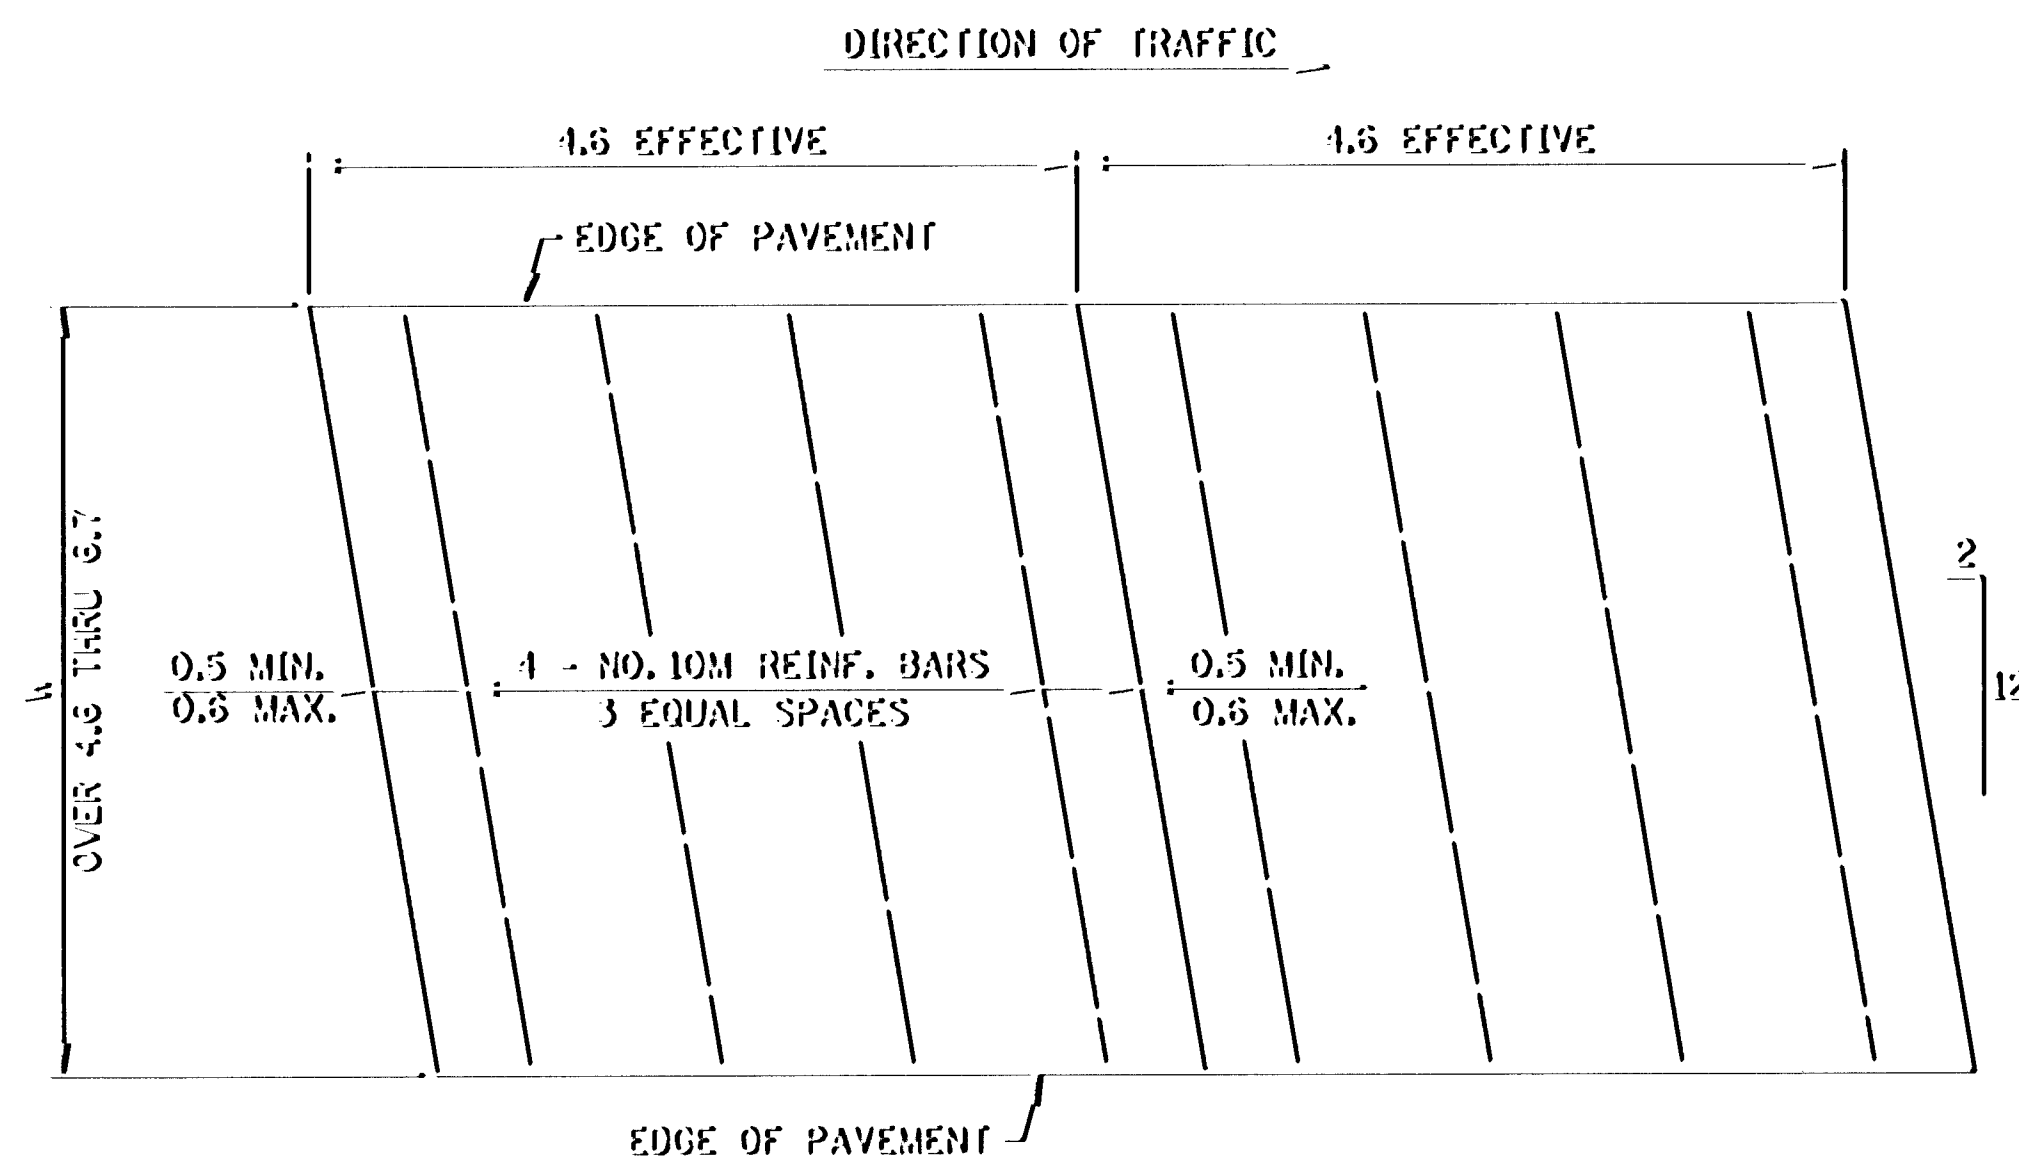

SUPPLEMENTAL PANEL REINFORCEMENT
PANELS OVER 4.6 m THRU 6.7 m WIDTHS

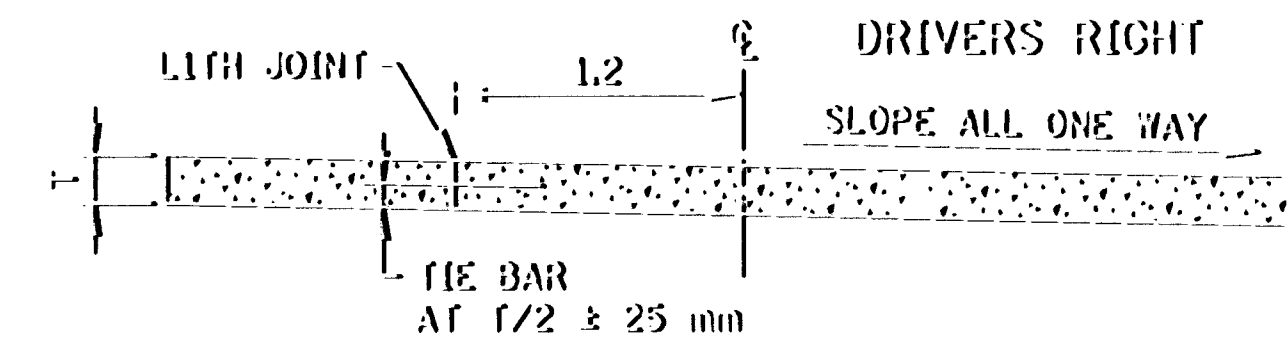

RURAL DESIGN RAMP
SECTION A-A

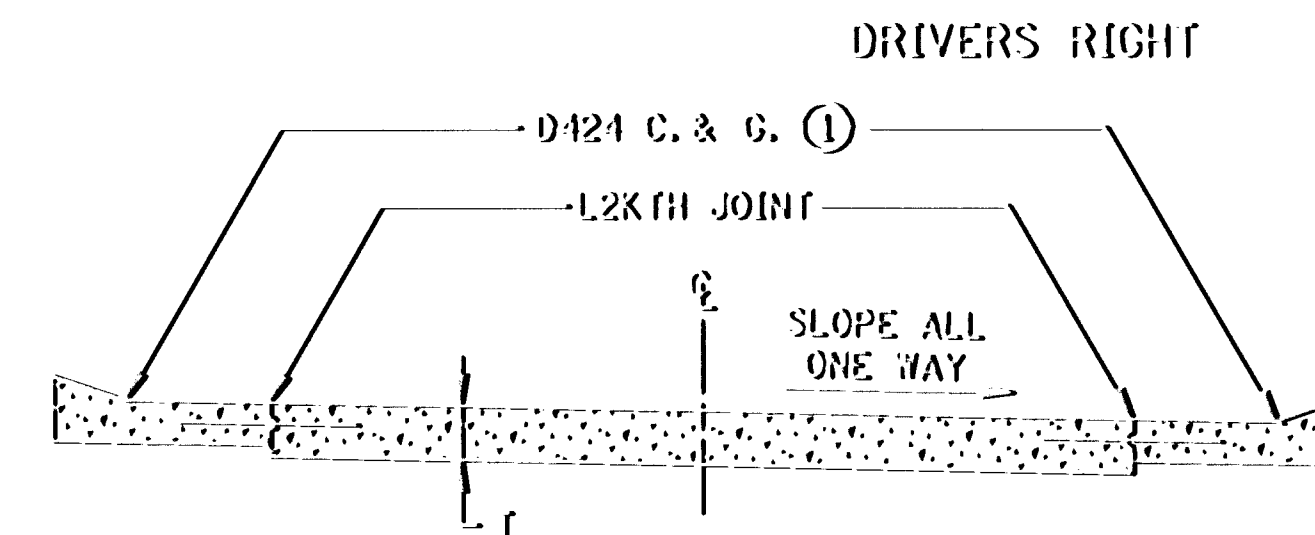

URBAN DESIGN RAMP
CROSS SECTION

GENERAL NOTES:

WHEN RIGID PAVEMENT ADJOINS FLEXIBLE PAVEMENT, BRIDGE APPROACHES, R. R. CROSSINGS OR OTHER TYPES OF FREE ENDS, THE FOLLOWING MODIFICATIONS SHALL BE MADE: THE FIRST OR LAST JOINTS SHALL BE DOWELED CONTRACTION JOINTS, C4E-D (SKEWED). TIE BARS SHALL BE SPACED AS SHOWN, EXCEPT THE FIRST AND LAST TIE BAR OF EACH PANEL SHALL BE 0.5 m FROM AND PARALLEL TO THE CONTRACTION JOINT.

4.6 m EFFECTIVE JOINT SPACING IS ACTUALLY 4.0 m, 4.9 m, 4.3 m, 5.2 m AND REPEAT JOINT SPACING.

DOWEL BAR ASSEMBLIES, WHEN REQUIRED, SHALL BE SIMILAR TO THOSE SHOWN ON STANDARD PLATE M103.

SEE TYPICAL SECTIONS AND PLAN SHEETS FOR CROSS SLOPES AND PAVEMENT THICKNESS T.

FOR URBAN DESIGN RAMPS, DELETE LIT JOINT ON LEFT SIDE OF RAMP AND USE URBAN DESIGN RAMP CROSS-SECTION.

ALL REINFORCING BARS SHALL BE EPOXY COATED IN ACCORDANCE WITH SPEC. 3301 AND SHALL MEET THE REQUIREMENTS OF GRADE 420 FOR AASHTO M-31M OR M-53. FOR ADDITIONAL REINFORCEMENT OVER CULVERTS, SEE STANDARD PLATE M1070.

TIE BARS:

FOR PAVEMENT THICKNESSES 250 mm OR LESS, USE NO. 10M BARS 0.3 m LONG, AT 0.3 m SPACING. FOR PAVEMENT THICKNESSES OVER 250 mm USE NO. 15M BARS 0.30 m LONG AT 0.3 m SPACING.


SUPPLEMENTAL PANEL REINFORCEMENT:
PLACE IN PANELS WHERE PAVEMENT WIDTHS EXCEED 4.8 m WITHOUT A LONGITUDINAL JOINT, AND IN THE MIDDLE LANE WHERE TIED PAVEMENT WIDTHS EXCEED 9.1 m, USE NO. 10M BARS FOR PAVEMENT THICKNESSES 250 mm OR LESS. USE NO. 15M BARS FOR THICKNESSES OVER 250 mm. PLACEMENT DEPTH SHALL BE PLANNED T/2 ± 25 mm.

SPECIFIC NOTES:


- ① THE CONTRACTOR SHALL HAVE THE OPTION TO CONSTRUCT INTEGRANT CURBS WITH ONE LIT JOINT, LOCATED 1.2 m FROM THE RAMP C ON THE DRIVERS LEFT SIDE, IN PLACE OF D424 CURB AND GUTTERS WITH L2KT JOINTS. IN EITHER OPTION, DOWEL BAR ASSEMBLIES WILL NOT BE REQUIRED IN THE CURB AND GUTTER AREA. PAYMENT WILL BE BASED ON THE D424 CURB AND GUTTER OPTION, REGARDLESS OF THE METHOD OF CONSTRUCTION USED.

NOTE: ALL DIMENSIONS ARE IN METERS, EXCEPT AS NOTED.


STANDARD SHEET NO. 5-297.219M (1 OF 2)	TITLE NON-REINFORCED CONCRETE RAMP PAVEMENT WITH SKEWED JOINTS
STANDARD APPROVED: JANUARY 25, 1993	4.6 m EFFECTIVE PANELS (T = 250 mm OR LESS)

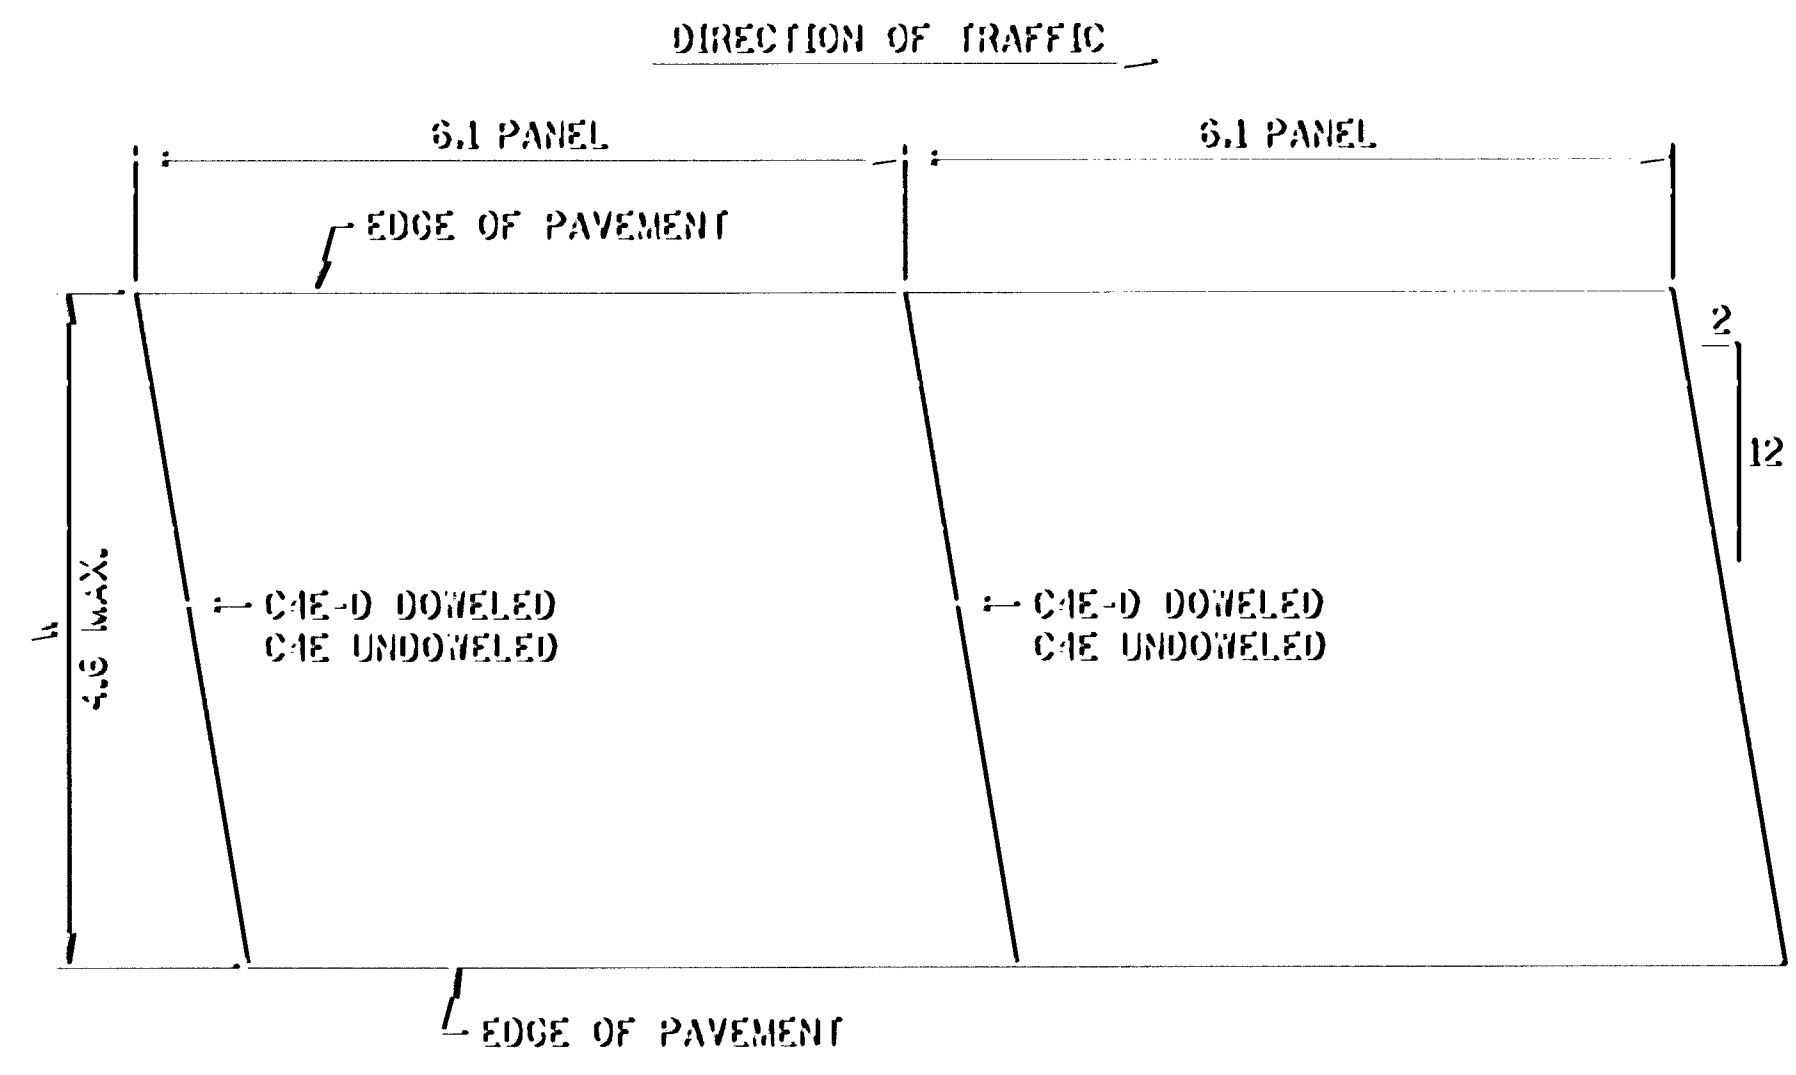


PAVEMENT 0.3 m THRU 4.6 m WIDTH

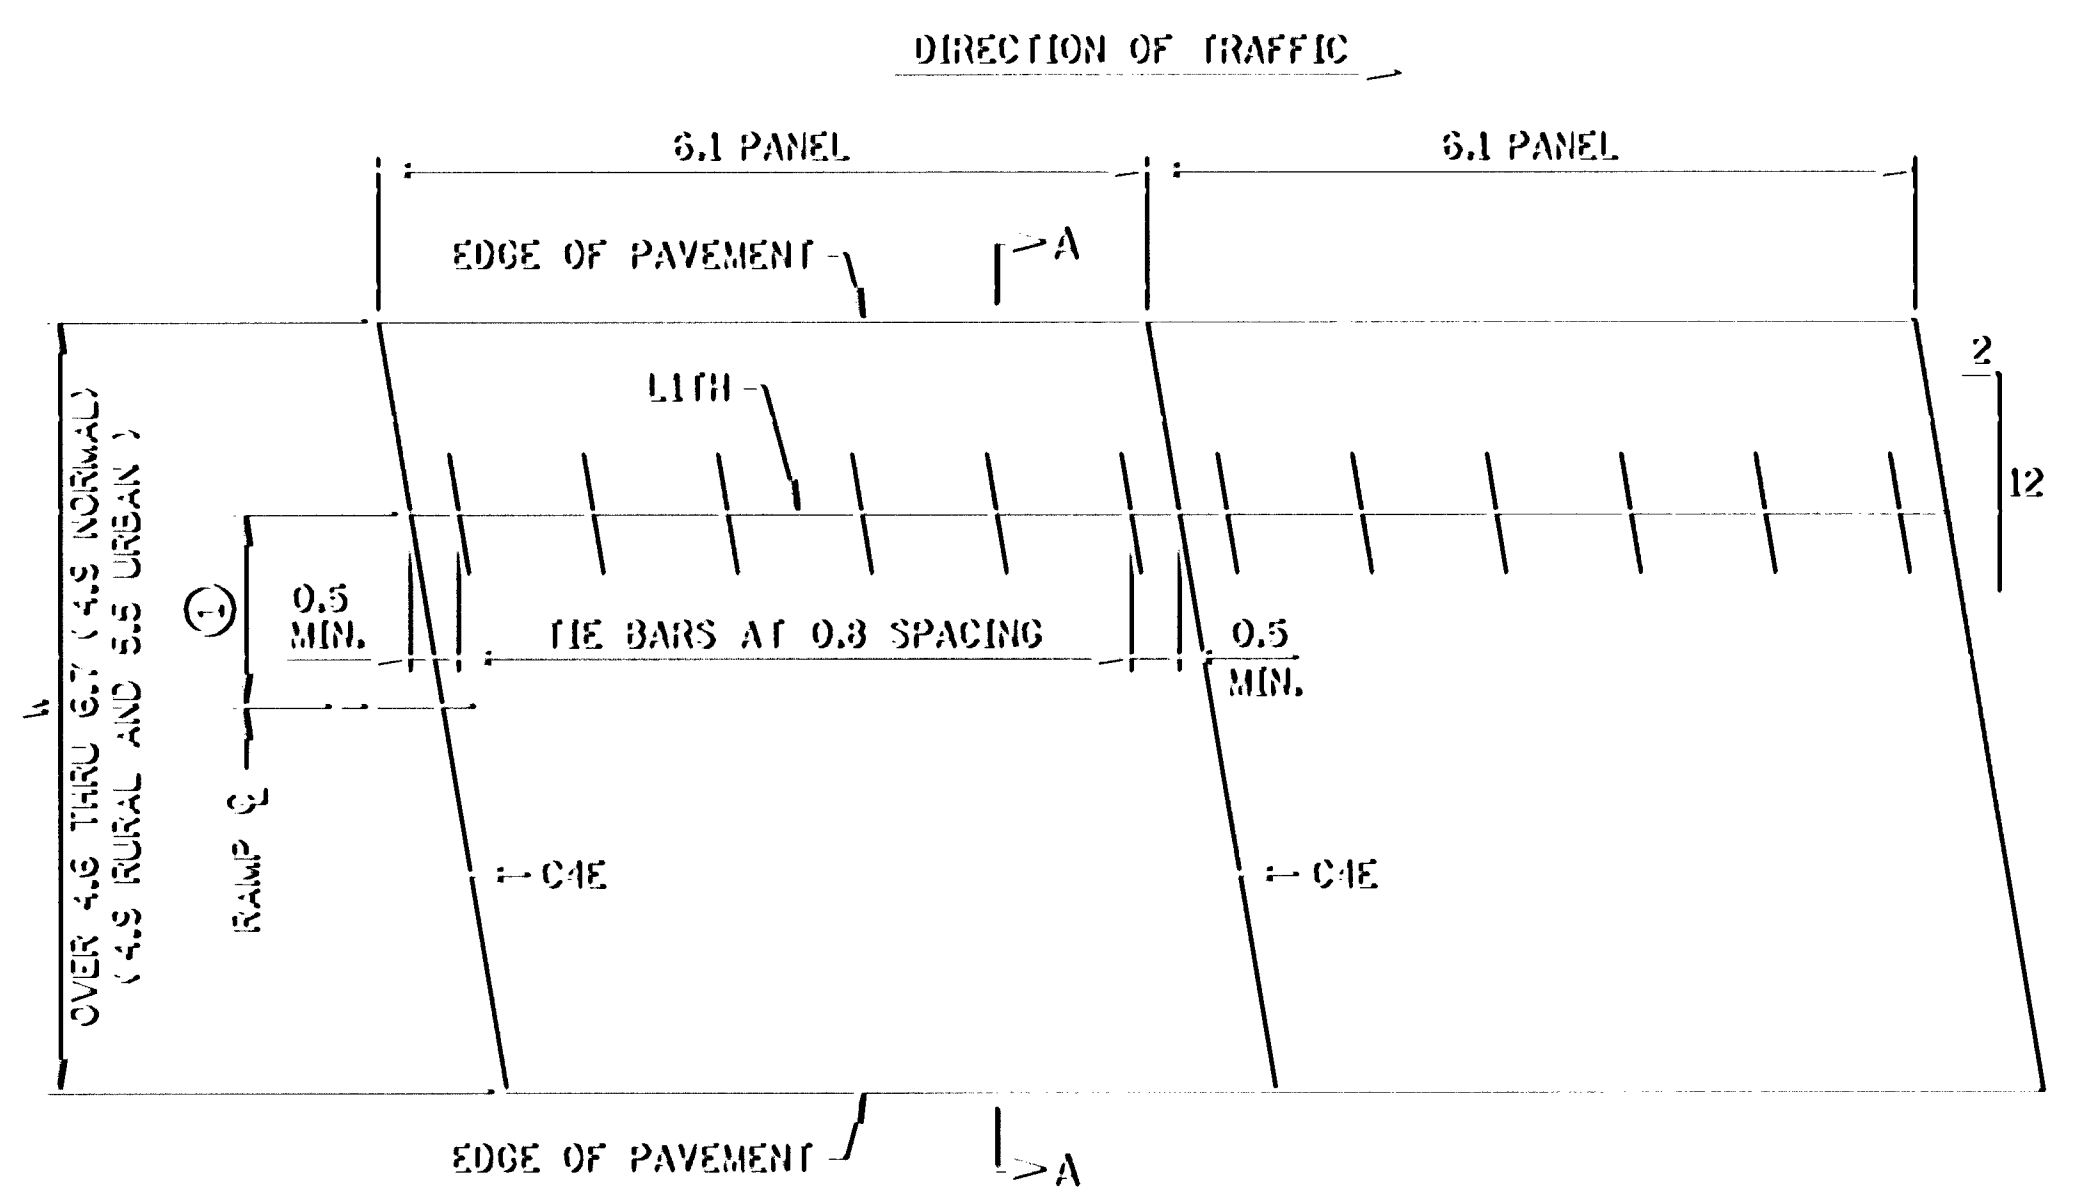


PAVEMENT OVER 4.6 m THRU 6.7 m WIDTH UNDOWELED

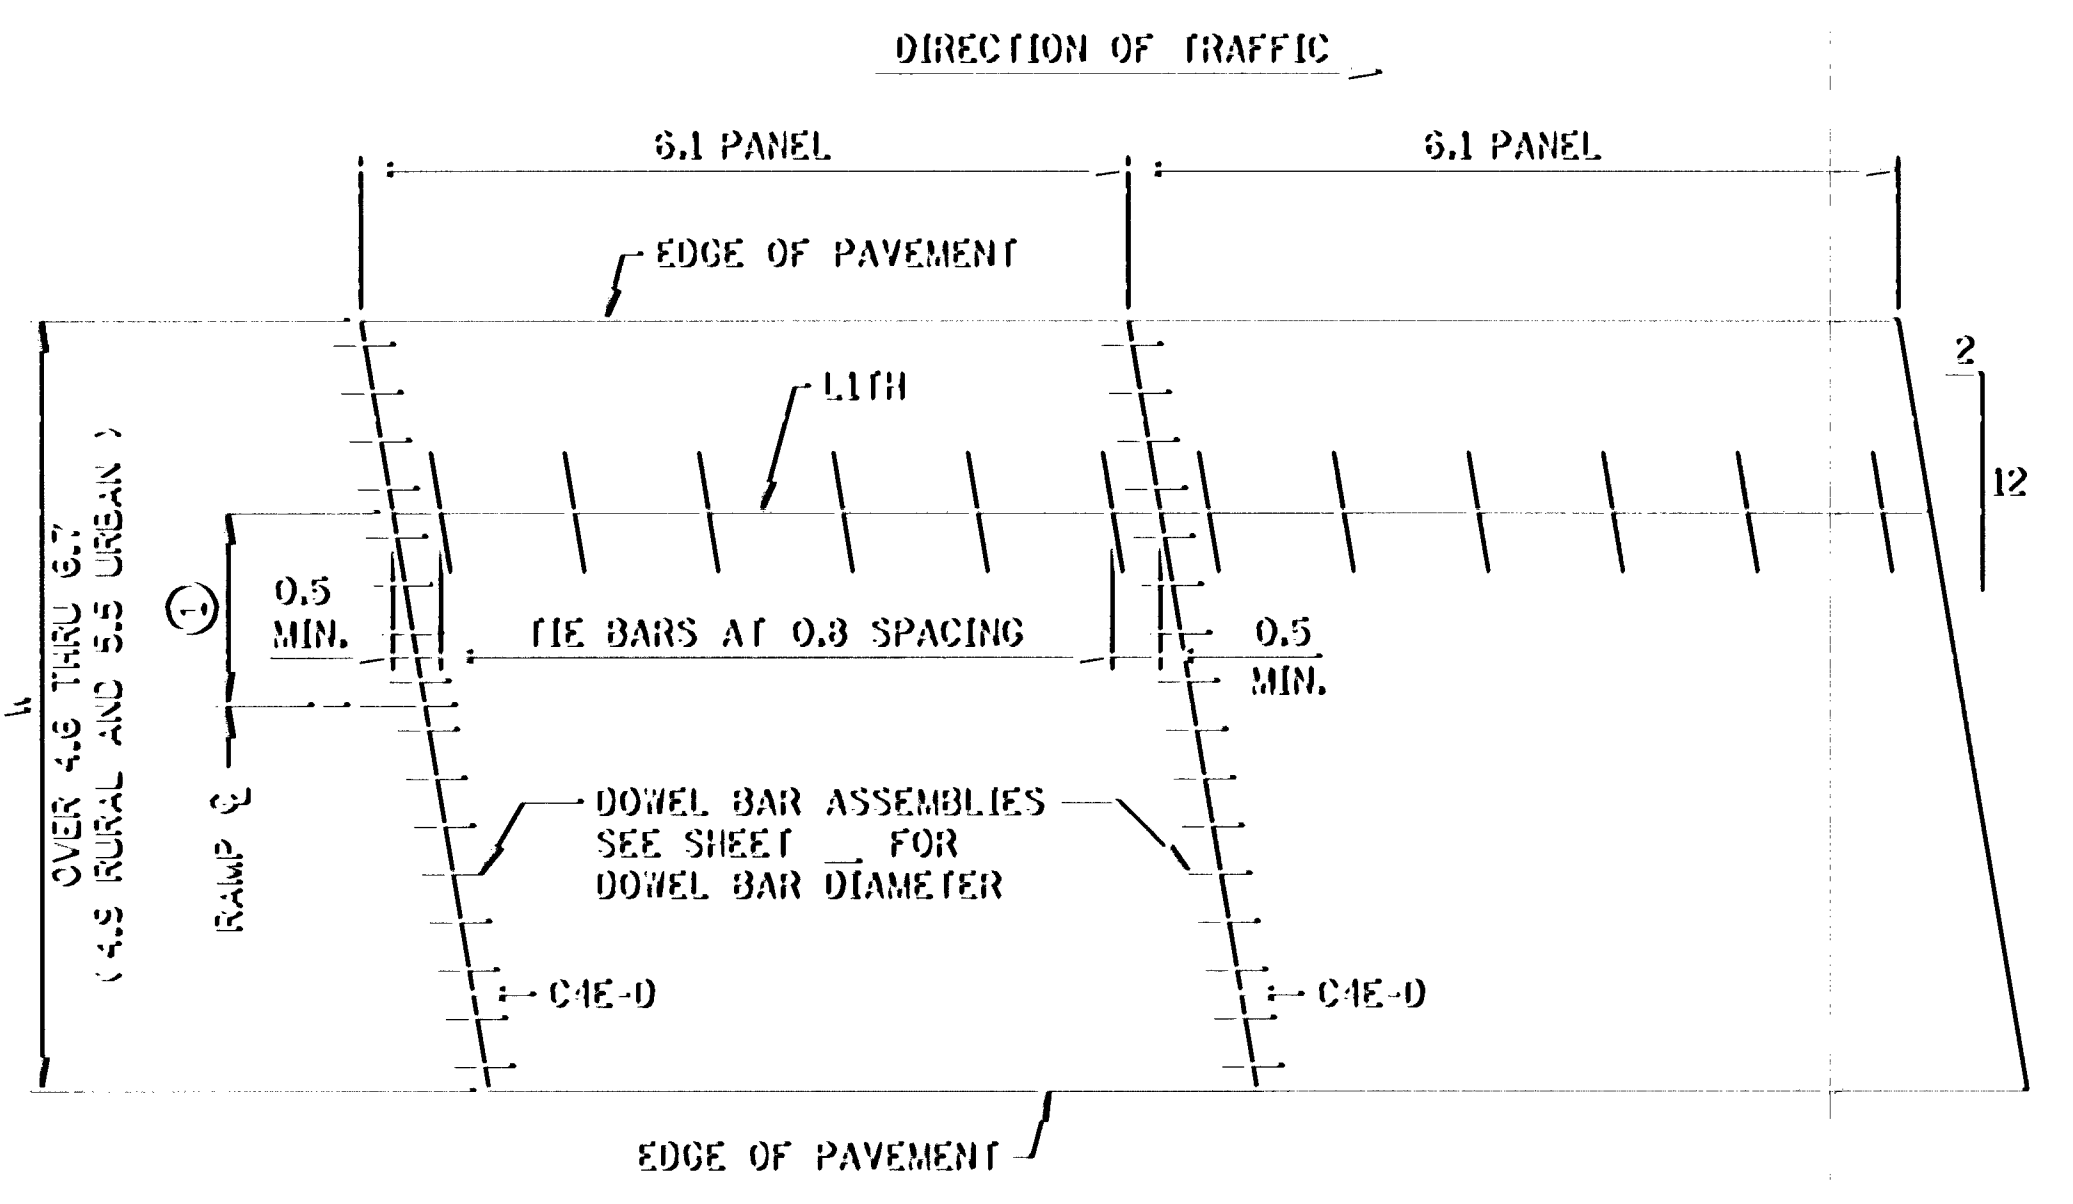


PAVEMENT OVER 4.6 m THRU 6.7 m WIDTH DOWELED

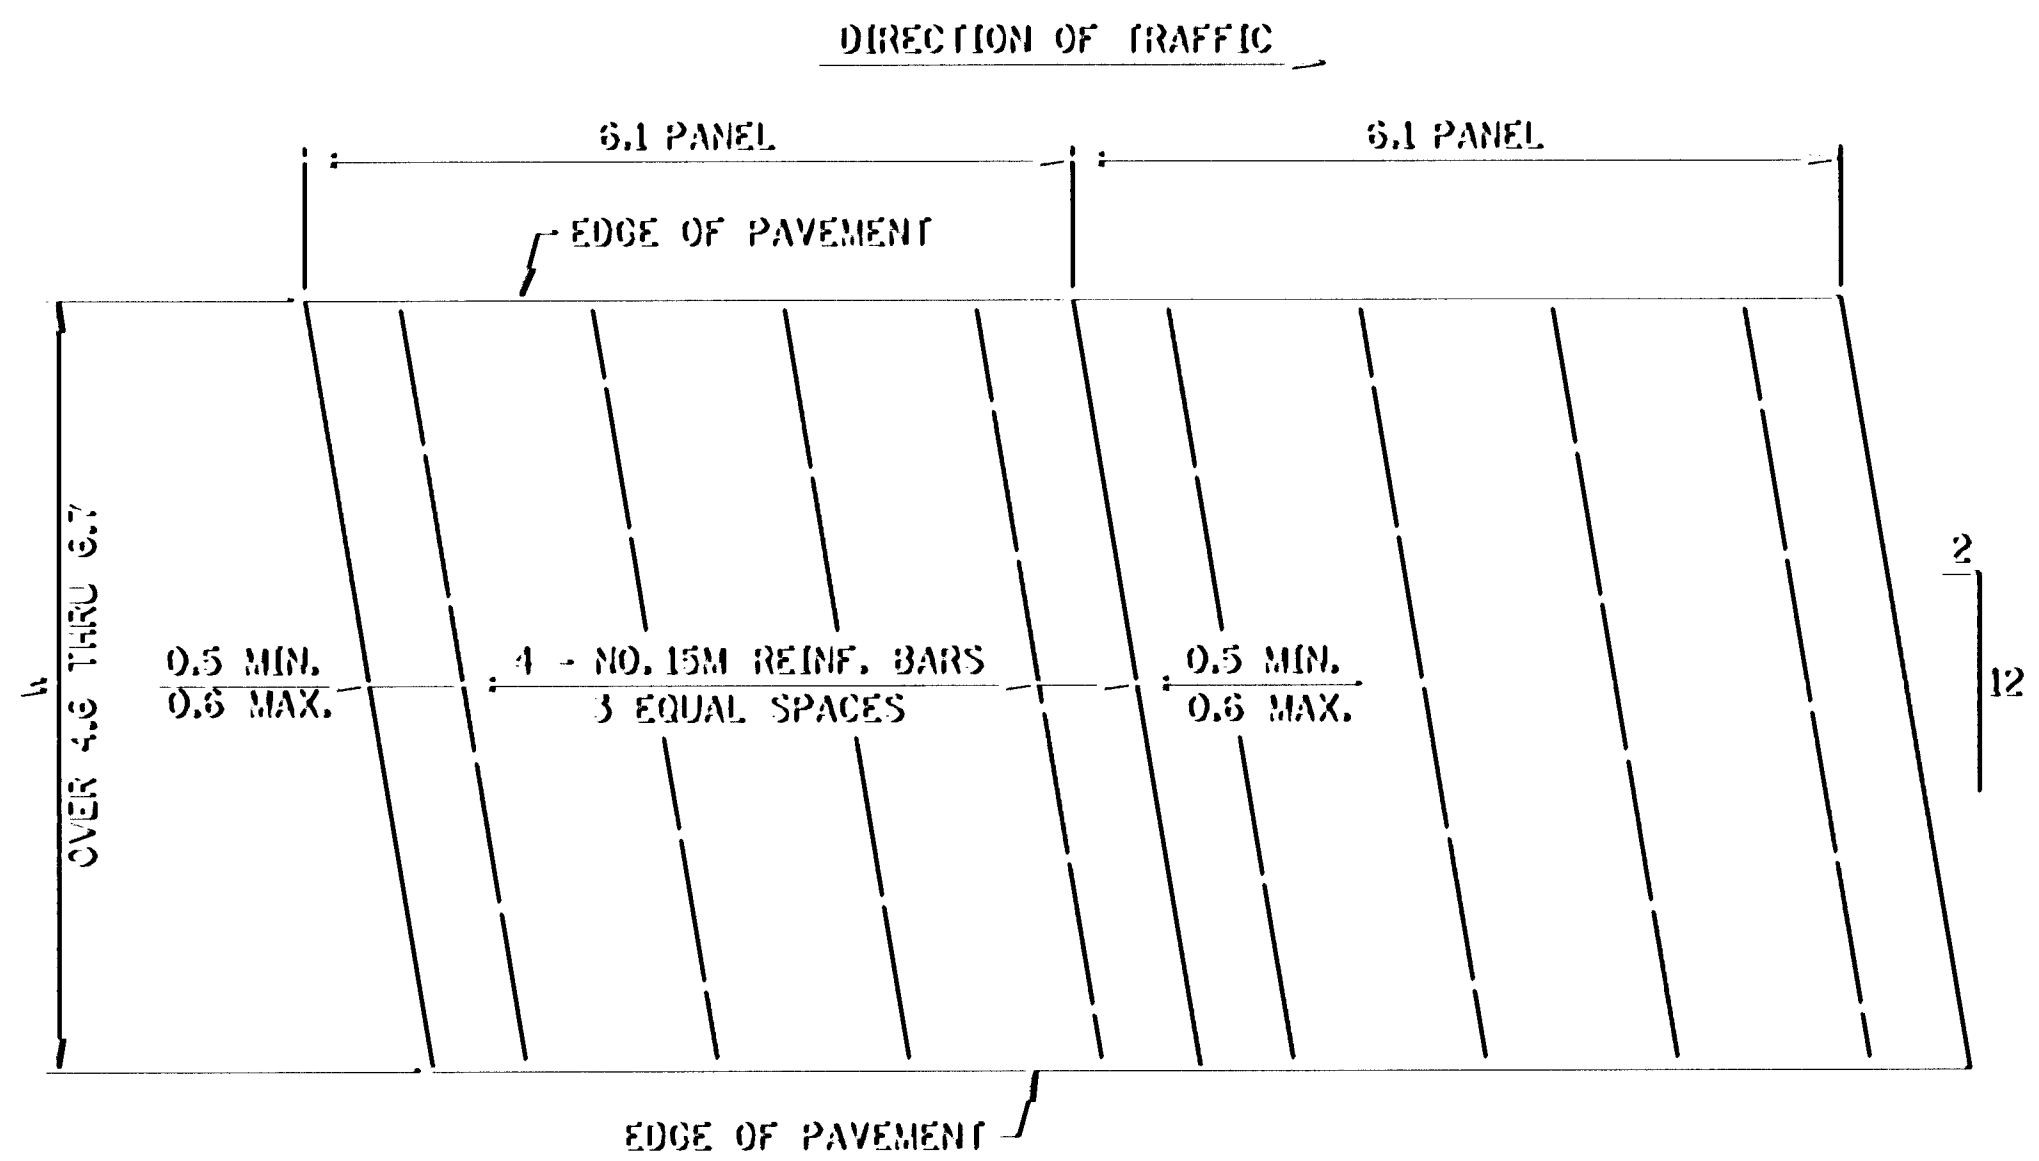

SUPPLEMENTAL PANEL REINFORCEMENT PANELS OVER 4.6 m THRU 6.7 m WIDTHS

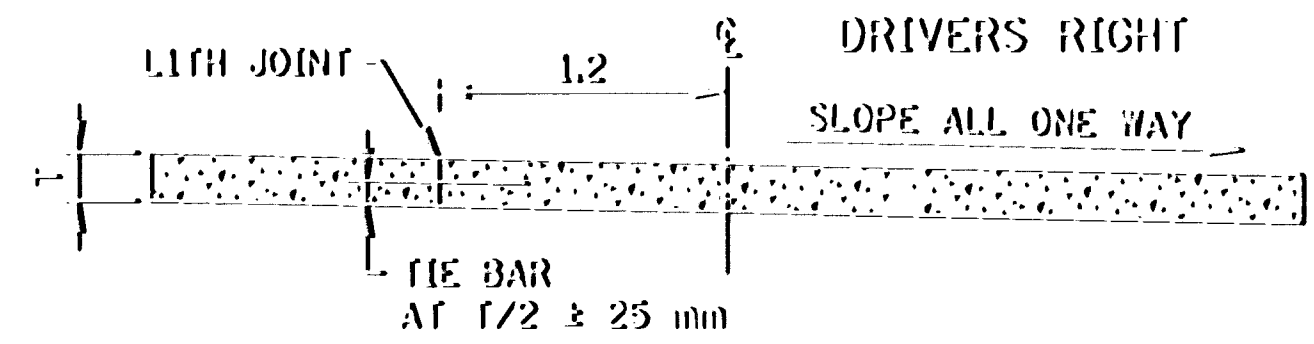

RURAL DESIGN RAMP SECTION A-A

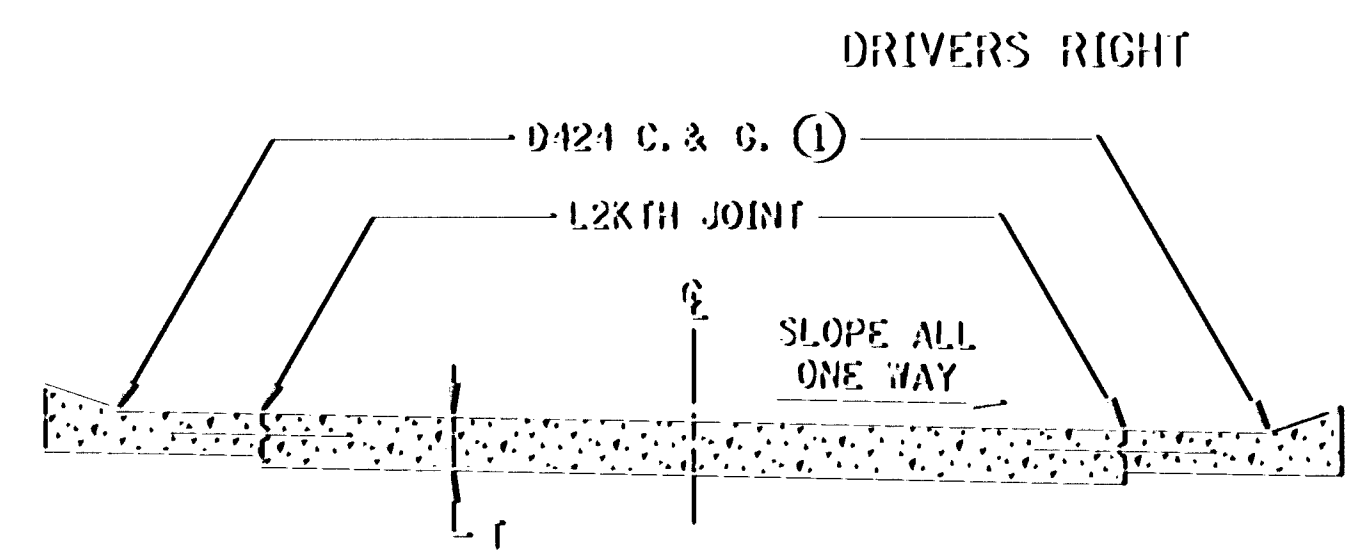

URBAN DESIGN RAMP CROSS SECTION

GENERAL NOTES:

- WHEN RIGID PAVEMENT ADJOINS FLEXIBLE PAVEMENT, BRIDGE APPROACHES, R.R. CROSSINGS OR OTHER TYPES OF FREE ENDS, THE FOLLOWING MODIFICATIONS SHALL BE MADE: THE FIRST OR LAST JOINTS SHALL BE DOWELED CONTRACTION JOINTS, C 1E-D (SKEWED). TIE BARS SHALL BE SPACED AS SHOWN, EXCEPT THE FIRST AND LAST TIE BAR OF EACH PANEL SHALL BE 0.5 m FROM AND PARALLEL TO THE CONTRACTION JOINT.
 - DOWEL BAR ASSEMBLIES, WHEN REQUIRED, SHALL BE SIMILAR TO THOSE SHOWN ON STANDARD PLATE M103. SEE TYPICAL SECTIONS AND PLAN SHEETS FOR CROSS SLOPES AND PAVEMENT THICKNESS T.
 - FOR URBAN DESIGN RAMP, DELETE L11H JOINT ON LEFT SIDE OF RAMP AND USE URBAN DESIGN RAMP CROSS-SECTION.
 - ALL REINFORCING BARS SHALL BE EPOXY COATED IN ACCORDANCE WITH SPEC. 3301 AND SHALL MEET THE REQUIREMENTS OF GRADE 420 FOR AASHTO M-31M OR M-53. FOR ADDITIONAL REINFORCEMENT OVER CULVERTS, SEE STANDARD PLATE M107D.
 - TIE BARS: USE NO. 15M BARS 0.9 m LONG, AT 0.8 m SPACING.
 - SUPPLEMENTAL PANEL REINFORCEMENT: PLACE NO. 15M BARS IN PANELS WHERE PAVEMENT WIDTHS EXCEED 4.8 m WITHOUT A LONGITUDINAL JOINT, AND IN THE MIDDLE LANE WHERE TIED PAVEMENT WIDTHS EXCEED 9.1 m. PLACEMENT DEPTH SHALL BE PLANNED T/2 ± 25 mm.
- SPECIFIC NOTES:**
- ① THE CONTRACTOR SHALL HAVE THE OPTION TO CONSTRUCT INTEGRANT CURBS WITH ONE L11H JOINT, LOCATED 1.2 m FROM THE RAMP C. ON THE DRIVERS LEFT SIDE, IN PLACE OF D424 CURB AND GUTTERS WITH L2KH JOINTS. IN EITHER OPTION, DOWEL BAR ASSEMBLIES WILL NOT BE REQUIRED IN THE CURB AND GUTTER AREA. PAYMENT WILL BE BASED ON THE D424 CURB AND GUTTER OPTION, REGARDLESS OF THE METHOD OF CONSTRUCTION USED.

NOTE: ALL DIMENSIONS ARE IN METERS, EXCEPT AS NOTED.


SERVER CAG4SL/USR/STANDARD/SW2152455.SPK

STANDARD SHEET NO. 5-297.219M (2 OF 2)	TITLE
STANDARD APPROVED: JANUARY 25, 1993	

NON-REINFORCED CONCRETE RAMP PAVEMENT WITH SKEWED JOINTS
6.1 m PANELS (T ≥ GREATER THAN 250 mm)


REQUIRED DIMENSIONS

JOINT TYPE	TRANSVERSE
NOMINAL SEALER SIZE	21 mm
A	20 mm ± 3.5 -1.3
B	2 mm ± 0.5
C	15 mm MIN.
D	20 mm MIN.
WEB AND WALL THICKNESS, UNLESS NOTED	0.8 mm MIN.

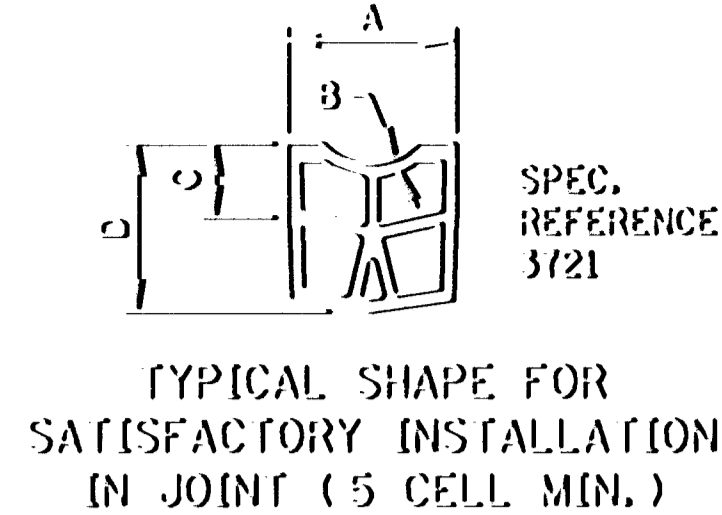

CONTRACTION JOINT SEALER
PREFORMED ELASTIC TYPE

NOTES:
"A" DIMENSION SHALL APPLY AT ANY POINT THROUGHOUT "C" DEPTH. IN ITS FINAL POSITION, THE TOP CORNERS OF THE PREFORMED JOINT SEALER SHALL BE PLACED NOT LESS THAN 3 mm, NOR MORE THAN 7 mm BELOW THE PAVEMENT SURFACE.
SHARP INTERNAL CORNERS WILL NOT BE PERMITTED. ALL CORNERS SHALL BE PROVIDED WITH SUITABLE FILLET. CURRENTLY APPROVED CONFIGURATIONS ARE ON FILE IN THE MATERIALS ENGINEERING SECTION, MINNESOTA DEPARTMENT OF TRANSPORTATION.

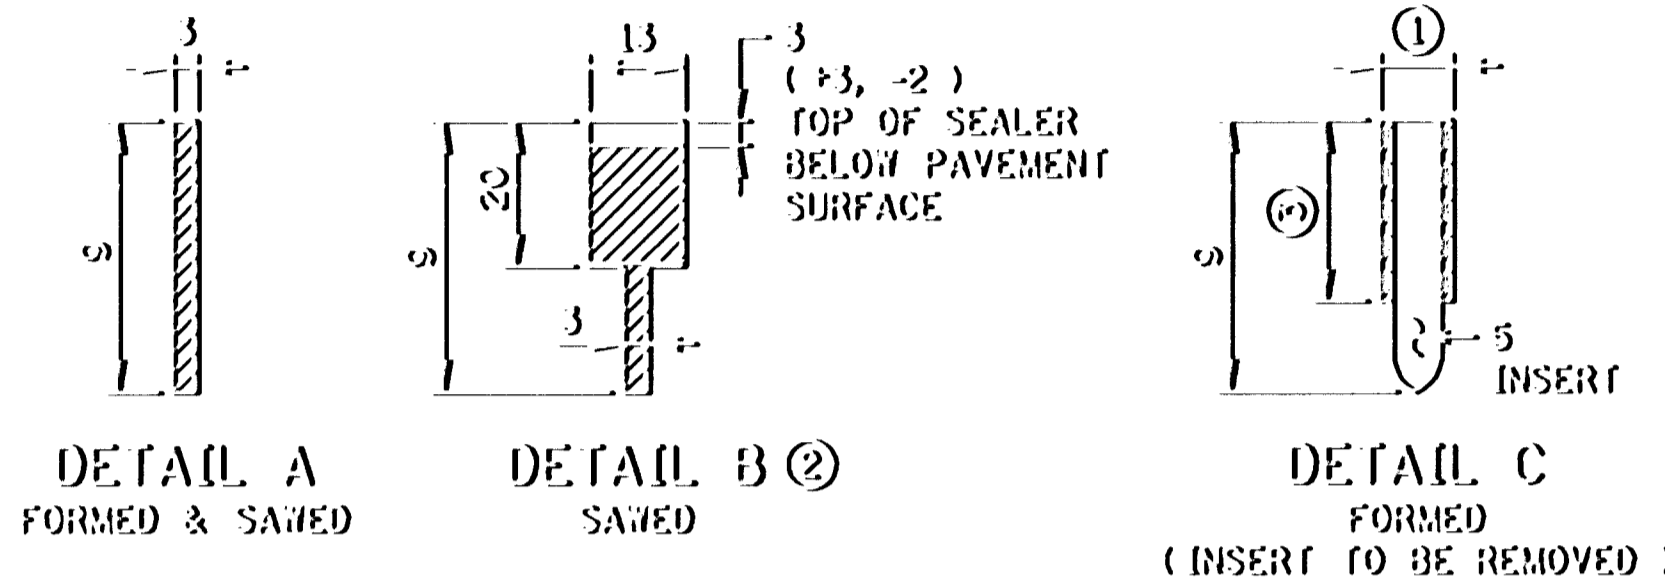


CONTRACTION JOINT CLASS DESIGNATION, DETAIL & SEALER SPEC. TABLE

CLASS DESIGNATION WITHOUT DOWELS	CLASS DESIGNATION WITH DOWELS	JOINT DETAIL	JOINT SEALER SPEC.
C2B	C2B-D	B	3723
C2X	C2X-D	B OR C	3723
C3D	C3D-D	D	3721
C3X	C3X-D	C OR D	3721
C4E	C4E-D	E	SILICONE

CONTRACTION JOINT DEPTH & DOWEL BAR TABLE

PAVEMENT THICKNESS †	CONCRETE PAVEMENT JOINT DEPTH ‡ (5)	CONCRETE BASE JOINT DEPTH ‡	DOWEL BAR DIAMETER
150-170	45	35	20
180-210	50	40	35
220-270	65	50	35
280-320	80	—	40
330-380	90	—	45

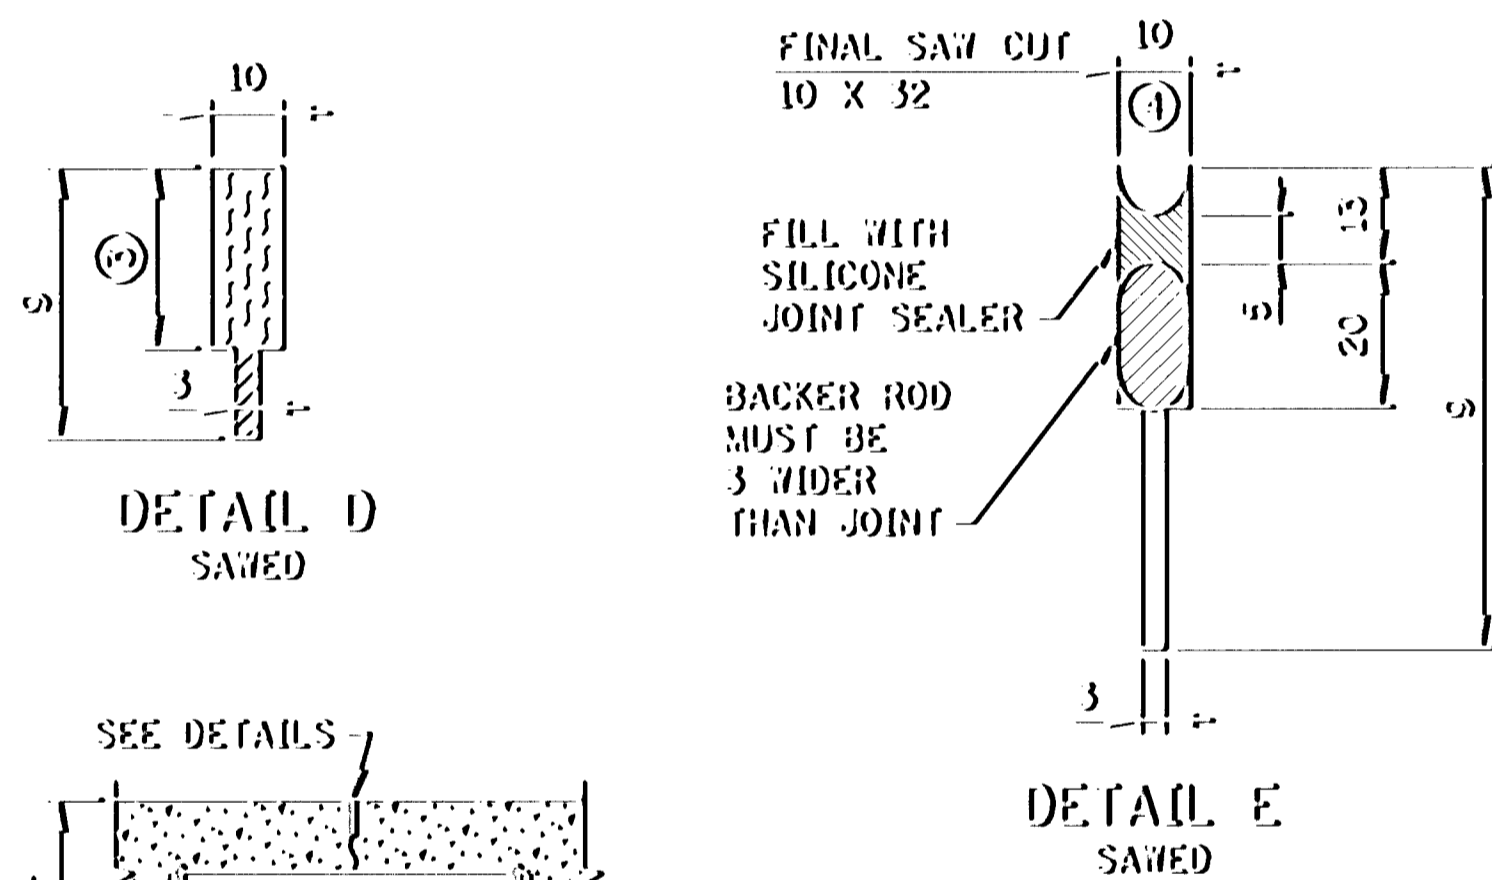

LEGEND
C = CONTRACTION JOINT
NO. = SEALANT TYPE
1 = UNSEALED
2 = 3723
3 = 3721
4 = SILICONE
LETTER = DETAIL
X = MORE THAN 1 DETAIL
-D = DOWEL BARS



NOTES:
① DESIGN C3X OR C3X-D - PRIOR TO INSTALLING PREFORMED JOINT SEALER IN THE FORMED JOINT (DETAIL C), THE JOINT SHALL BE WIDENED TO A NOMINAL WIDTH OF 10 mm BY SAWING ALONG THE FULL LENGTH OF THE FORMED JOINT.
DESIGN C2X OR C2X-D - PRIOR TO SEALING FORMED JOINT (DETAIL C), WITH HOT POUR SEALER, THE JOINT SHALL BE WIDENED TO A NOMINAL WIDTH OF 13 mm FOR A DEPTH OF 20 mm, ± 3 mm, 2 mm, BY SAWING ALONG THE FULL LENGTH OF THE FORMED JOINT. THE SEALER SHALL BE FILLED TO THE SAME DEPTH AS SHOWN IN DETAIL B.
② DESIGN C2B OR C2B-D - PRIOR TO SEALING JOINT (DETAIL B) WITH HOT POUR JOINT SEALER, A STRIP OF PAPER 13 mm WIDE SHALL BE PLACED ON THE BOTTOM OF THE 13 mm WIDE JOINT.
③ WHEN USING PREFORMED JOINT SEALER, THE DEPTH SHALL BE 5 mm MORE THAN THE PREFORMED SEALER, WHEN COMPRESSED, TO FIT THE JOINT DESIGN WIDTH.
④ THE JOINT FACES SHALL BE CLEANED AND DRIED BY SANDBLASTING AND AIR BLASTING. PRIOR TO SEALING THE JOINT, A 13 mm DIA. CLOSED CELL BACKER ROD SHALL BE PLACED SUCH THAT THE TOP OF THE BACKER ROD IS 13 mm BELOW THE SURFACE OF THE PAVEMENT. SILICONE SHALL BE FOOLED INTO THE JOINT MAINTAINING A SEALANT BEAD THICKNESS OF 5 mm.
⑤ FOR UNBONDED OVERLAYS, THE JOINT DEPTH "G" SHALL BE 1/3.

CONTRACTION JOINT NOTES:
IN CONCRETE BASE CONSTRUCTION THE CONTRACTION JOINTS SHALL BE SPACED AT 9 m INTERVALS AND AT RIGHT ANGLES TO THE LONGITUDINAL JOINTS, EXCEPT AS NOTED BELOW. WHERE THE CONCRETE BASE IS CONSTRUCTED ADJACENT TO EXISTING PAVEMENT OR BASE, THE CONTRACTION JOINTS IN THE NEW BASE SHALL MATCH THOSE IN THE EXISTING PAVEMENT OR BASE, EXCEPT THAT THE SPACING SHALL NOT BE LESS THAN 4.6 m, NOR MORE THAN 9 m. JOINT WIDTH TOLERANCES: ± 2 mm AND -1 mm.

GENERAL NOTES:
SEE THE FOLLOWING STANDARD PLATES AND STANDARD PLAN SHEET FOR ADDITIONAL DETAILS: DOWEL BAR ASSEMBLY, M1103; CONSTRUCTION OF HEADER JOINTS, M1150; AND CONCRETE PAVEMENT WITH SKEWED JOINTS, 5-297.215M - .219M. SEE PAVING LAYOUTS IN THE PLANS FOR JOINT CLASS DESIGNATION TO BE USED AND SPECIAL REINFORCEMENT REQUIRED.

CONTRACTION JOINTS
DESIGN C

① NOTE: REVISED DOWEL BAR TO 35mm FOR 180-210mm PAVEMENT THICKNESS

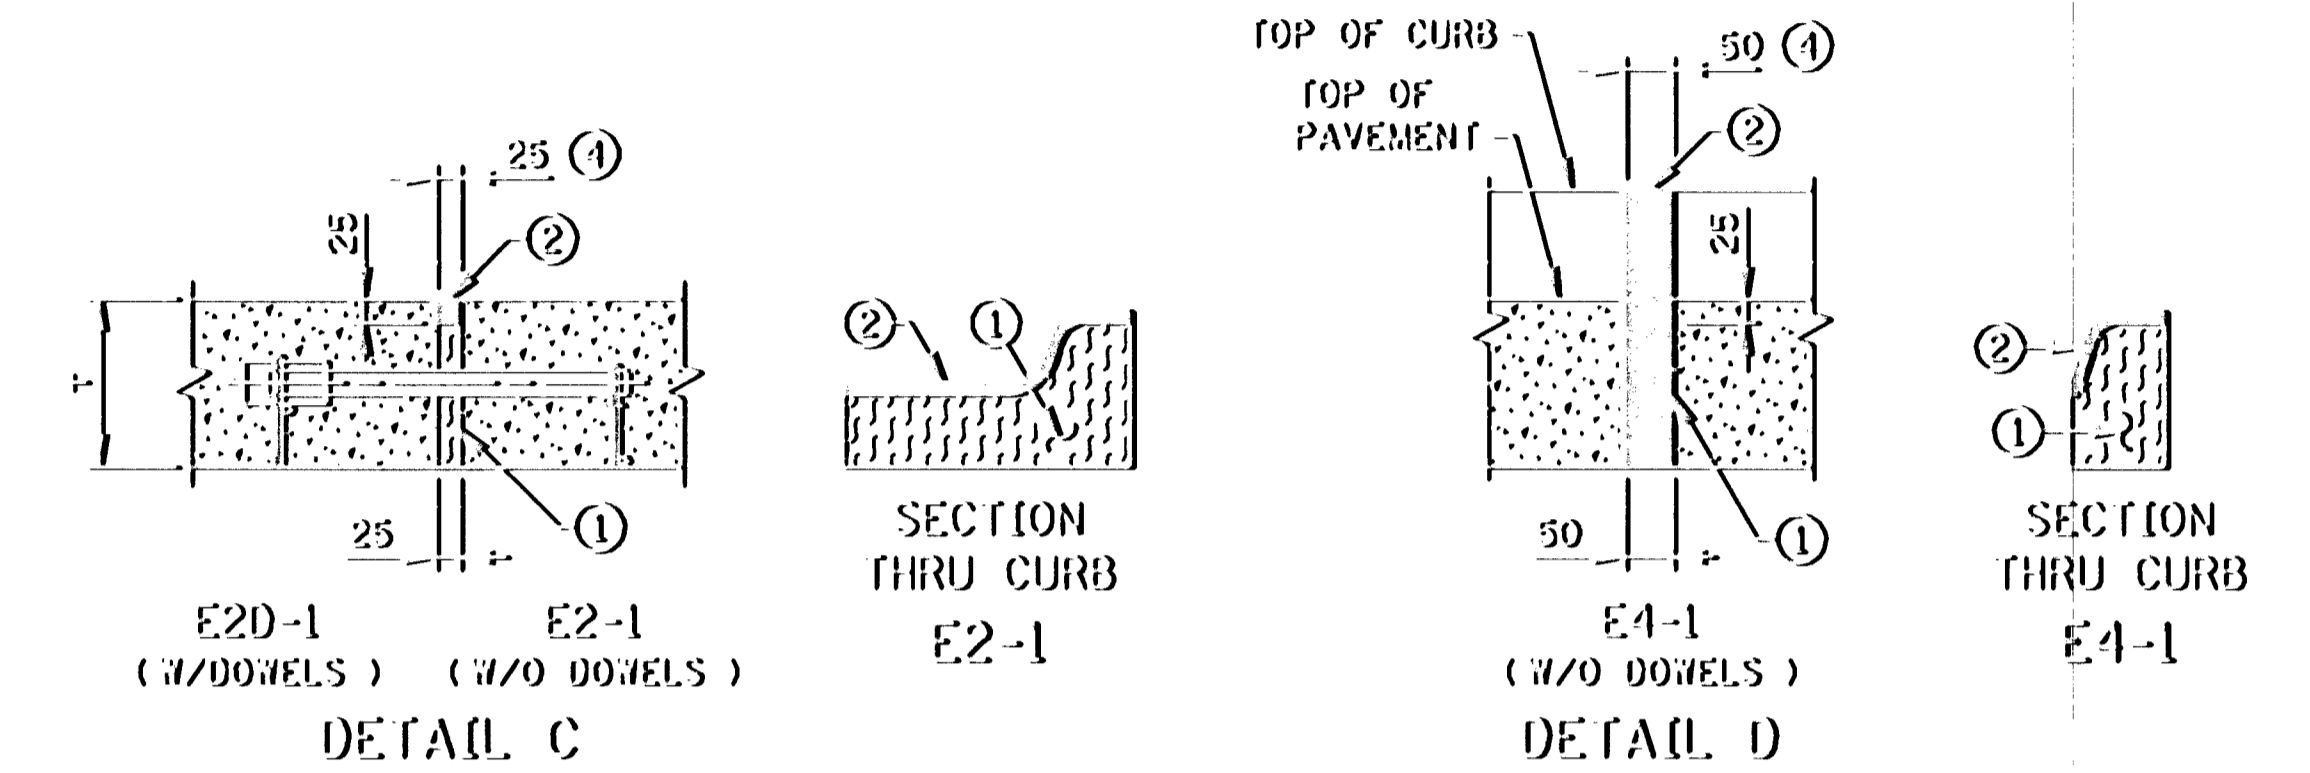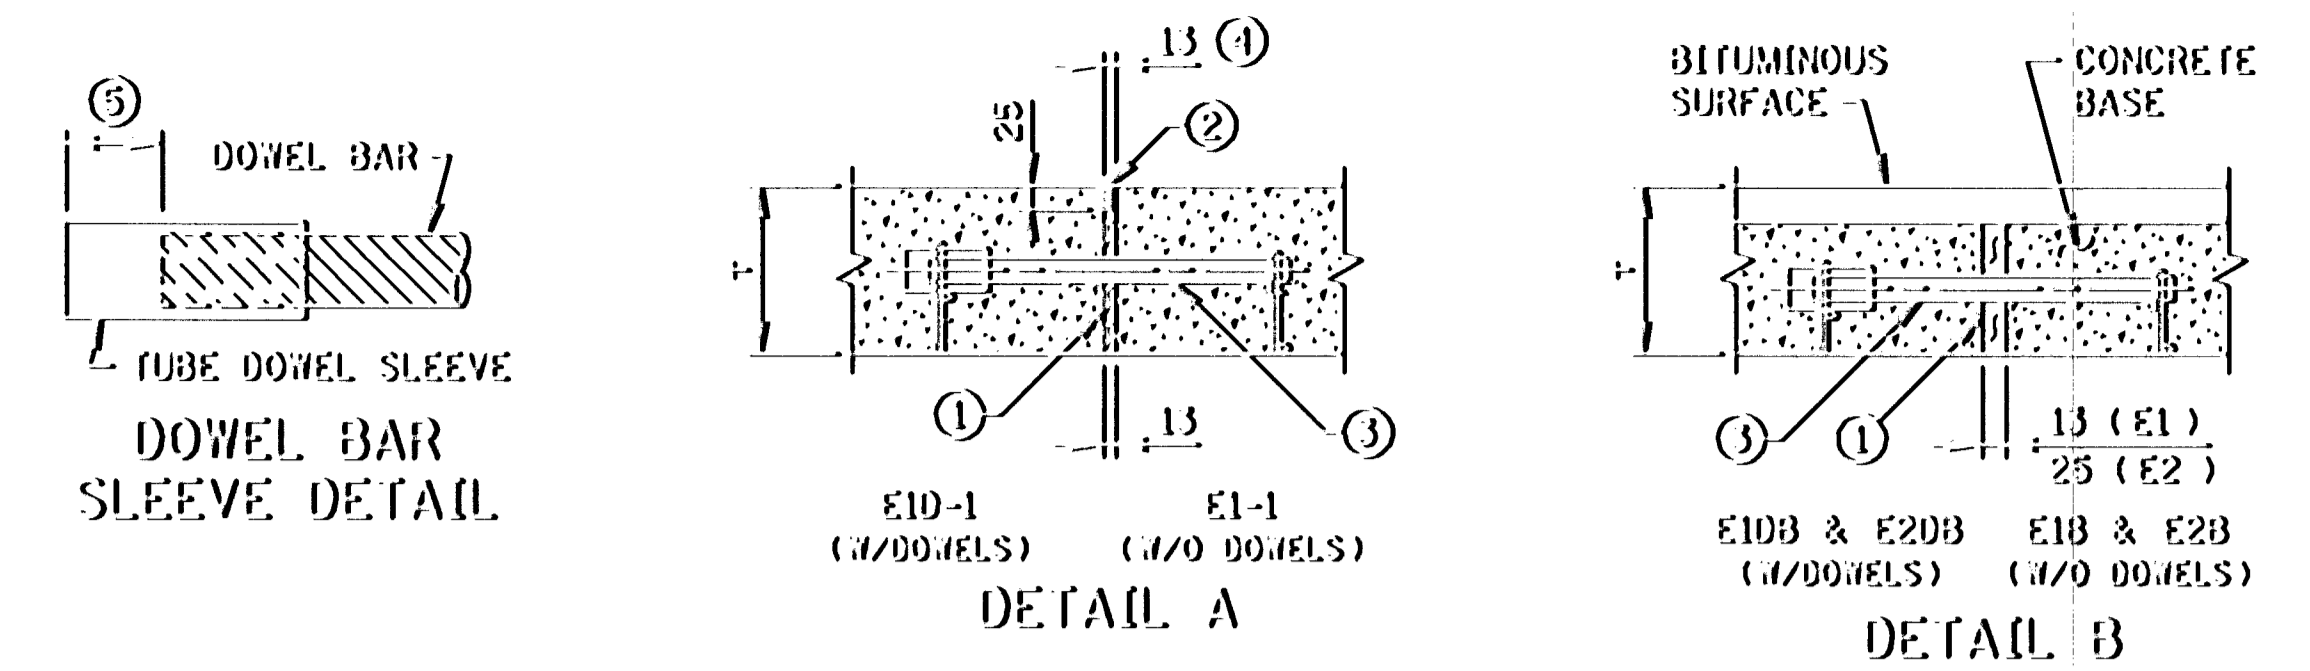

EXPANSION JOINTS

CLASS DESIGNATION WITH DOWELS	CLASS DESIGNATION WITHOUT DOWELS	JOINT DETAIL	JOINT SEALER SPEC.
E1D-1	E1-1	A	②
E1DB	E1B	B	UNSEALED
E2D-1	E2-1	C	②
E2DB	E2B	B	UNSEALED
E4D-1	E4-1	D	②
		E	②

LEGEND
= EXPANSION JOINT
= JOINT REFERENCE
E = HOT Poured SEAL ②
NO. = DOWEL BARS
-1 = CONCRETE BASE
D = CONCRETE SILL
B =

NOTES:
① PREFORMED JOINT FILLER MATERIAL, SPEC. 3702.
② JOINT SEALER SPEC. 3723. TOP OF SEALER, FLUSH TO 3 mm BELOW TOP OF PAVEMENT SURFACE. MAKE TOP OF SEALER FOR CURB SECTION E JOINTS FLUSH WITH SURFACE (0 IN.) ± 3 mm.
③ DOWEL BAR ASSEMBLY, SEE STANDARD PLATE M1103.
④ JOINT WIDTH IS EQUAL TO HALF OF THE JOINT NUMBER IN 13 mm INTERVALS (i.e., E1 = 13 mm, E2 = 25 mm, E3 = 38 mm, E4 = 50 mm, E5 = 100 mm).
⑤ SPACE FROM END OF DOWEL BAR TO END OF SLEEVE TO BE EQUAL TO EXPANSION JOINT WIDTH.

EXPANSION JOINTS
DESIGN E

NOTE: ALL DIMENSIONS ARE IN MILLIMETERS, EXCEPT AS NOTED.












I hereby certify that this plan, specification or report was prepared by me or under my direct supervision and that I am a duly Registered Professional Engineer under the laws of the State of Minnesota.
Donald A. Dimes
Date 3-21-97 Reg. No. 23397

STANDARD SHEET NO.
5-297.221M-(1 OF 2)
STANDARD APPROVED:
JANUARY 25, 1993

TITLE:
PAVEMENT JOINTS (MODIFIED)
CONTRACTION (DESIGN C) AND EXPANSION (DESIGN E)

S.A.P. 02-617-11, et al.

SHEET NO. 99 OF 236 SHEETS

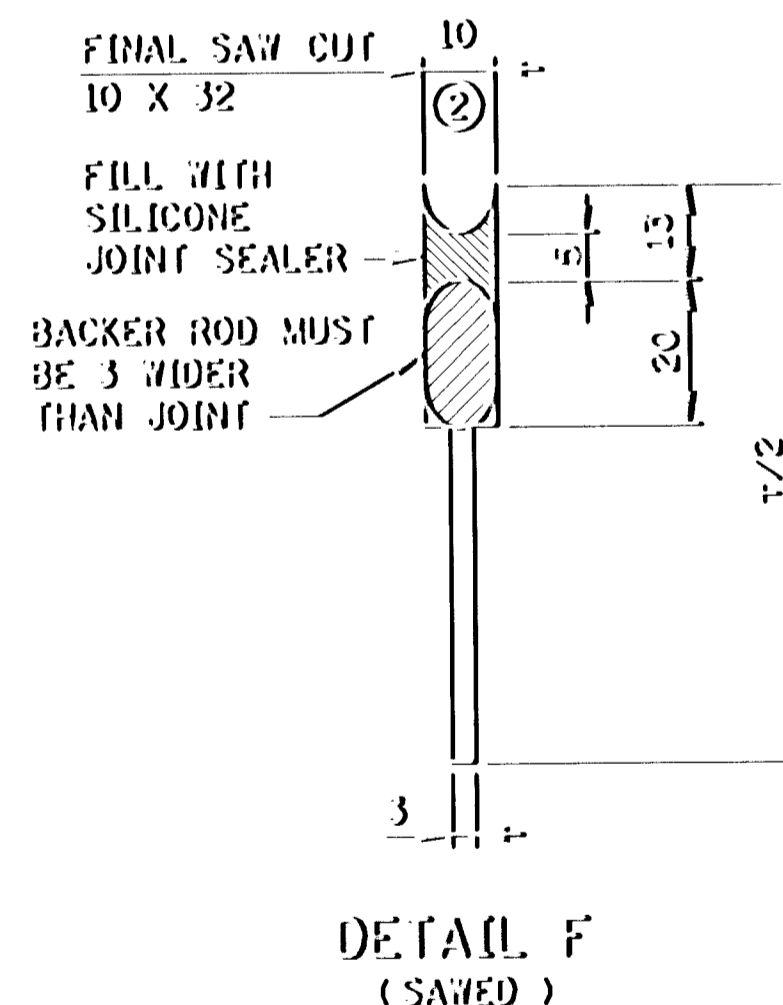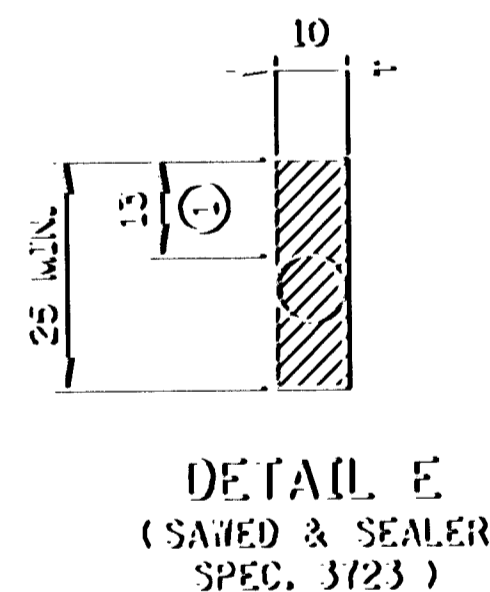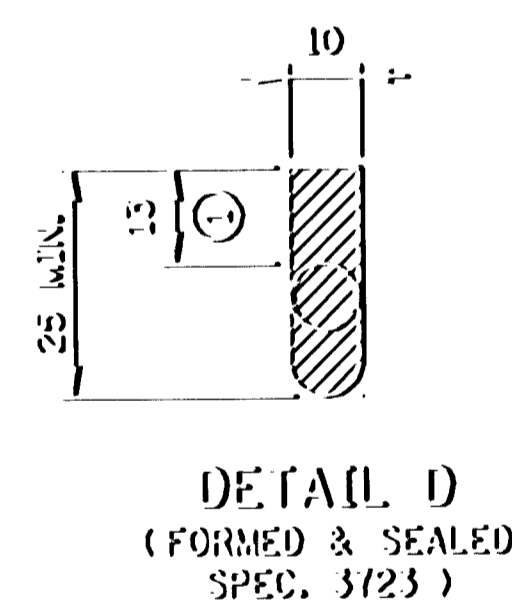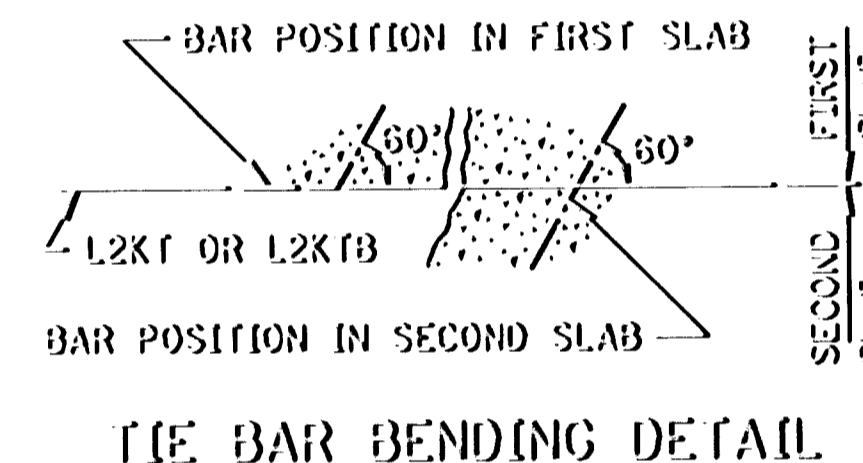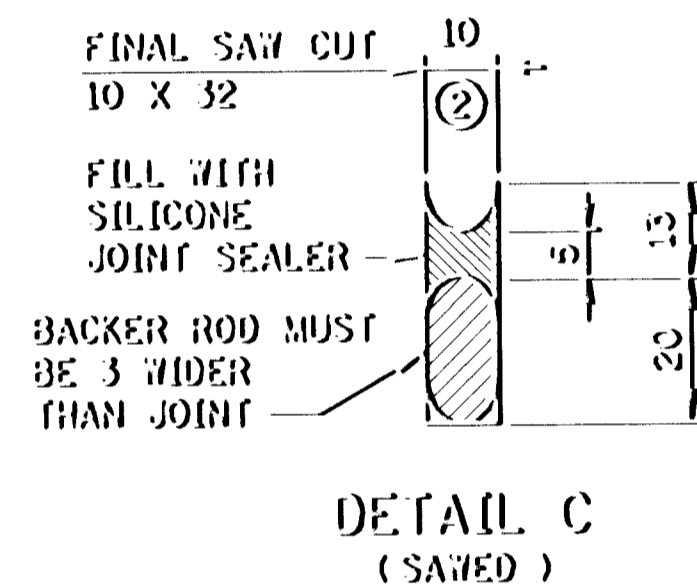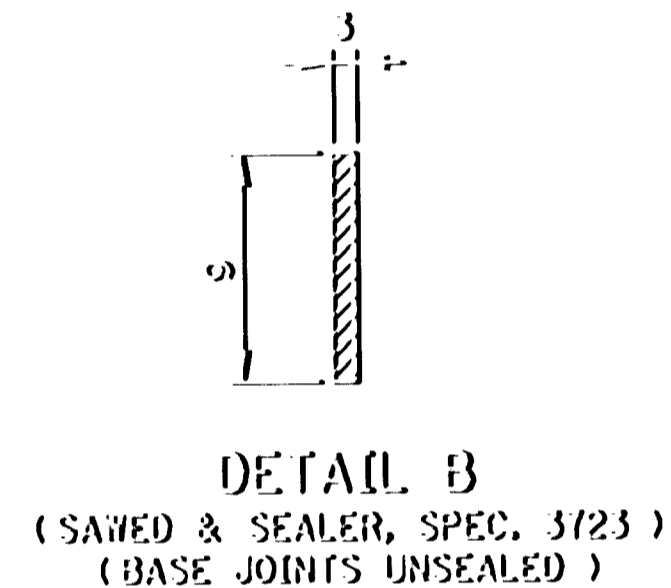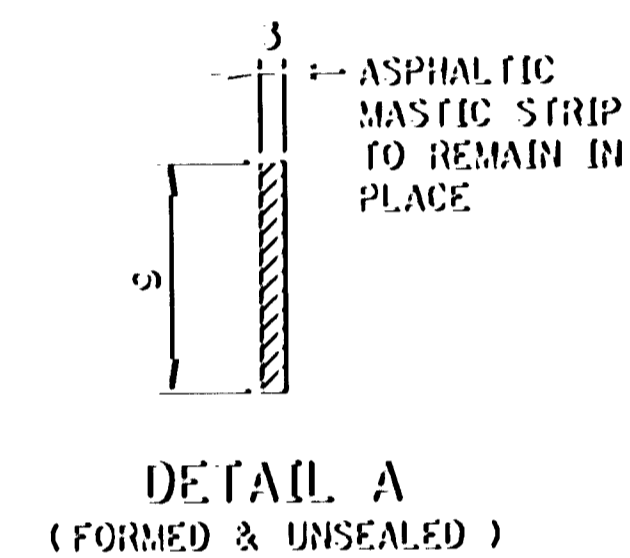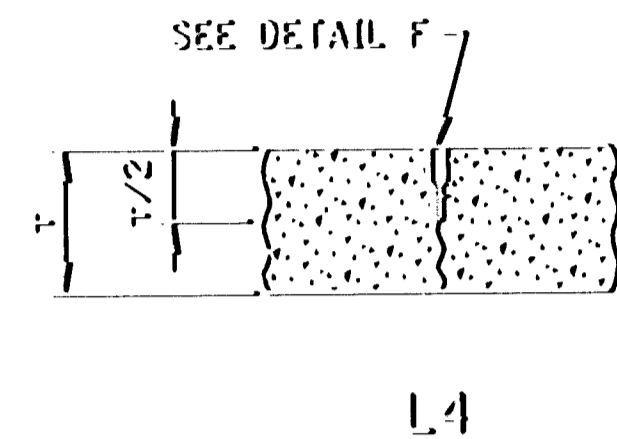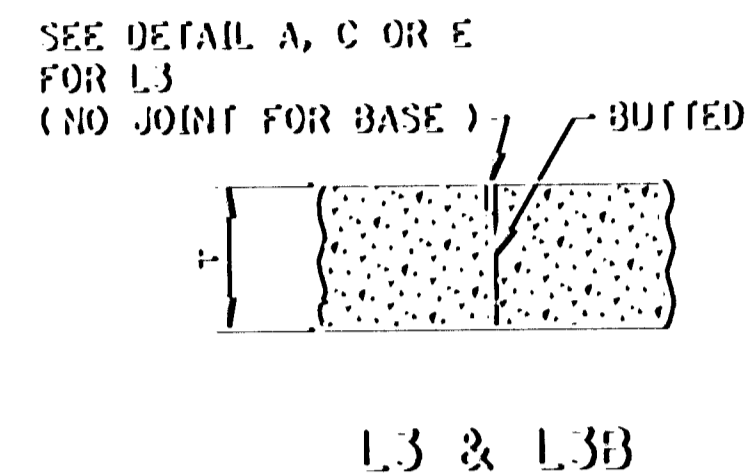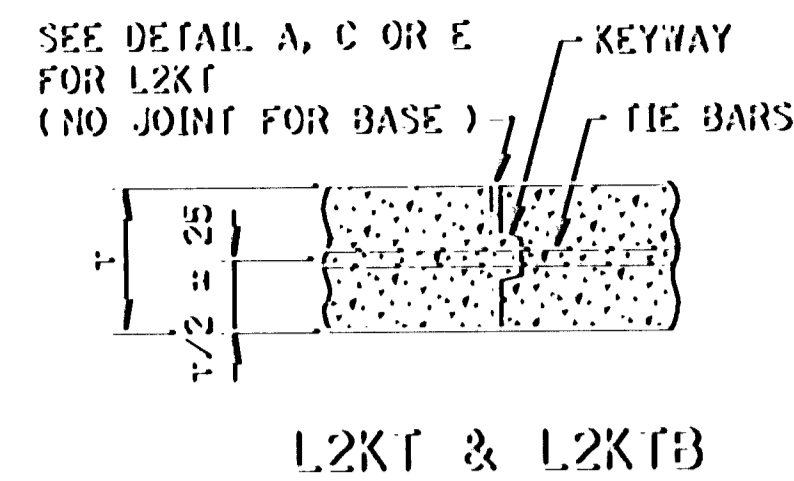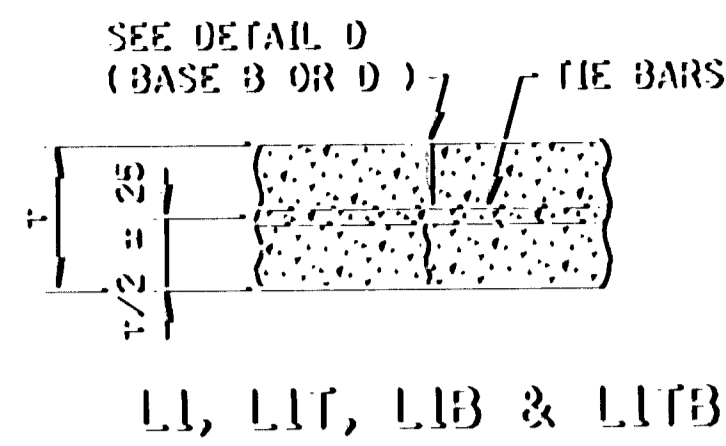

LONGITUDINAL JOINT CLASS DESIGNATION, DETAIL & SEALER SPECIFICATION TABLE

CLASS DESIGNATION			JOINT DETAIL	JOINT SEALER SPECIFICATION
WITHOUT TIE BARS	WITH TIE BARS	WITH KEYWAY & TIE BARS		
L1H	L1TH	L2KTH L2KTS	B	3/23
L1BU	L1TBU		A OR B	UNSEALED
			D OR E	3/23
			C	SILICONE
			L3H	D OR E
			L3S	C
L4S			F	SILICONE

LEGEND
 L = LONGITUDINAL JOINT
 NO. = JOINT REFERENCE
 K = KEYWAY
 T = TIE BARS
 B = CONCRETE BASE
 U = UNSEALED
 H = HOT POUR
 S = SILICONE

JOINT REFERENCE NUMBERS
 1 = SAWED TO A DEPTH OF 1/3
 2 = KEYED CONSTRUCTION JOINT
 3 = BUTTED CONSTRUCTION JOINT
 4 = SAWED TO A DEPTH OF 1/2

LONGITUDINAL JOINT DEPTH TABLE

PAVEMENT THICKNESS P	CONCRETE PAVEMENT JOINT DEPTH Q	CONCRETE BASE JOINT DEPTH Q
150	50	50
165	55	50
180	57	57
190	65	57
205	68	65
215	73	65
230	75	70
240	83	75
255	86	
265	90	
280	93	
290	98	
300	100	
315	105	
330	113	
345	115	
355	118	

LONGITUDINAL JOINT NOTES:

TIE BARS FOR L1TB JOINTS SHALL BE THE SAME SIZE AND SPACING AS SHOWN ON STANDARD PLAN SHEETS 5-297.216M - .219M.

EXCEPT WHEN NOTED OTHERWISE IN THE PLANS, THE TIE BAR SPACING FOR ALL L2KT AND L2KTb JOINTS SHALL BE 0.8 m C. TO C. AND BENT 60° AS SHOWN.

TIE BARS IN THE L2KT AND L2KTb JOINTS SHALL BE THE SAME SIZE AND LENGTH AS USED FOR THE L1T OR L1TB JOINTS, WHEN TYING PAVEMENT TO PAVEMENT OR BASE TO BASE. TIE BARS IN THE L2KT OR L2KTb JOINTS SHALL BE NO. 4 X 0.8 m, WHEN TYING CURB & GUTTER TO PAVEMENT OR BASE.

ALL TIE BARS SHALL MEET THE REQUIREMENTS OF GRADE 60 FOR AASHTO M-31 OR M-53.

NORMALLY, TIED PAVEMENT WIDTHS SHALL NOT EXCEED 3 METERS, EXCEPT BRIDGE APPROACH PANELS AND PAVEMENT TAPERS.

JOINT WIDTH TOLERANCE IS + 2 mm TO - 1 mm.

SPEC. 3/23 SEALER - TOP OF SEALER FLUSH TO - 4 mm BELOW TOP OF PAVEMENT SURFACE.

- THE JOINT FACES SHALL BE CLEANED AND DRIED BY SANDBLASTING AND AIR BLASTING. PRIOR TO SEALING THE JOINT, A CLOSED CELL BACKER ROD CAPABLE OF WITHSTANDING SEALANT TEMPERATURES OF 205 DEGREES C, WITH A DIAMETER 3 mm LARGER THAN THE JOINT OPENING, MAY BE PLACED 13 mm BELOW THE TOP OF THE PAVEMENT.
- THE JOINT FACES SHALL BE CLEANED AND DRIED BY SANDBLASTING AND AIR BLASTING. PRIOR TO SEALING THE JOINT, A 13 mm DIAMETER CLOSED CELL BACKER ROD SHALL BE PLACED SUCH THAT THE TOP OF THE BACKER ROD IS 13 mm BELOW THE SURFACE OF THE PAVEMENT. SILICONE SHALL BE TOOLED INTO THE JOINT MAINTAINING A SEALANT BEAD THICKNESS OF 5 mm.

GENERAL NOTES:

SEE THE FOLLOWING STANDARD PLATES AND STANDARD PLAN SHEETS FOR ADDITIONAL DETAILS: DOWEL BAR ASSEMBLY M1103, PAVEMENT KEYWAY M1141 AND CONCRETE PAVEMENT WITH SKEWED JOINTS 5-297.216M - .219M.

SEE PAVING LAYOUTS IN THE PLANS FOR JOINT CLASS DESIGNATIONS TO BE USED & SPECIAL REINFORCEMENT REQUIRED.

NOTE: ALL DIMENSIONS ARE IN MILLIMETERS, EXCEPT AS NOTED.


STANDARD SHEET NO.
5-297.221M (2 OF 2)
STANDARD APPROVED:
JANUARY 25, 1993

TITLE:


PAVEMENT JOINTS
LONGITUDINAL (DESIGN L)

S.A.P. 02-617-11, et al.

SHEET NO. 100 OF 236 SHEETS

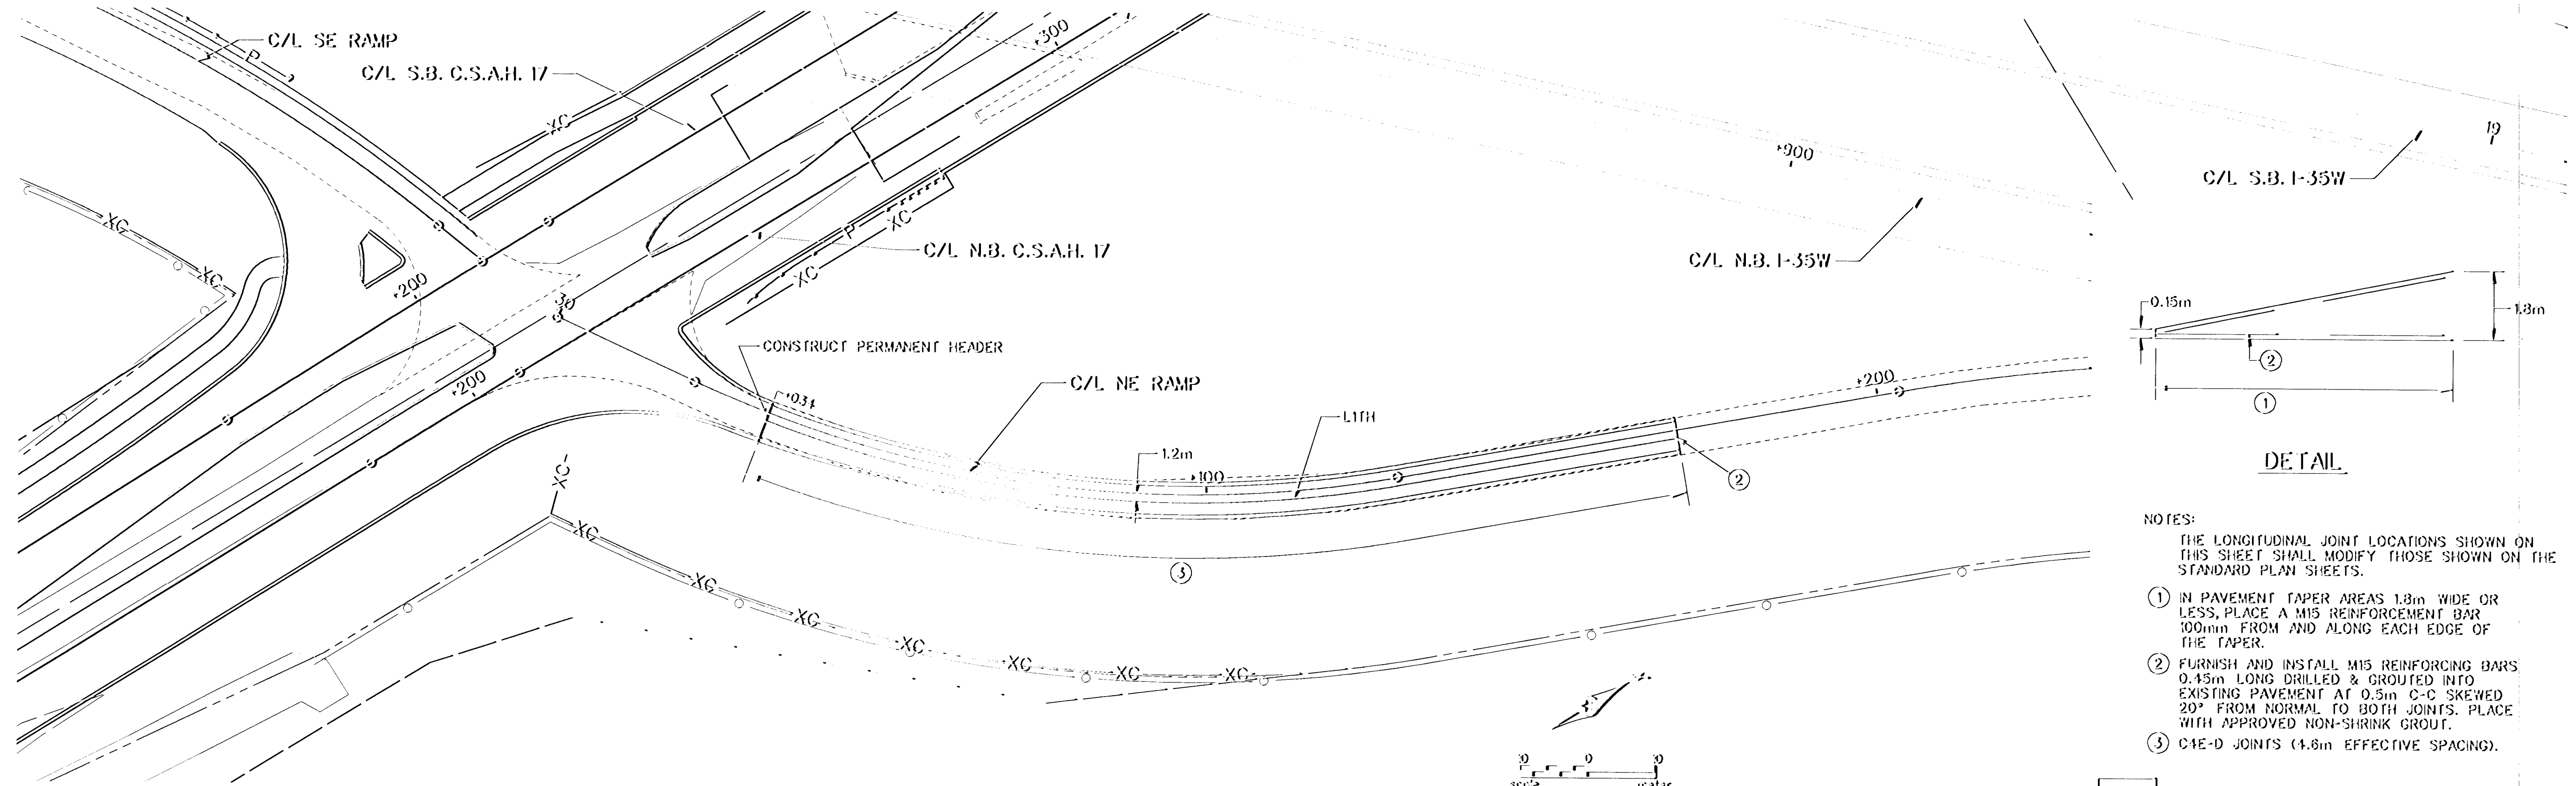

- DETAIL
- NOTES:
- THE LONGITUDINAL JOINT LOCATIONS SHOWN ON THIS SHEET SHALL MODIFY THOSE SHOWN ON THE STANDARD PLAN SHEETS.
- ① IN PAVEMENT TAPER AREAS 1.8m WIDE OR LESS, PLACE A M15 REINFORCEMENT BAR 100mm FROM AND ALONG EACH EDGE OF THE TAPER.
 - ② FURNISH AND INSTALL M15 REINFORCING BARS 0.45m LONG DRILLED & GROUTED INTO EXISTING PAVEMENT AT 0.5m C-C SKEWED 20° FROM NORMAL TO BOTH JOINTS. PLACE WITH APPROVED NON-SHRINK GROUT.
 - ③ C1E-D JOINTS (1.8m EFFECTIVE SPACING).
- DENOTES NEW CONCRETE PAVEMENT CONSTRUCTION

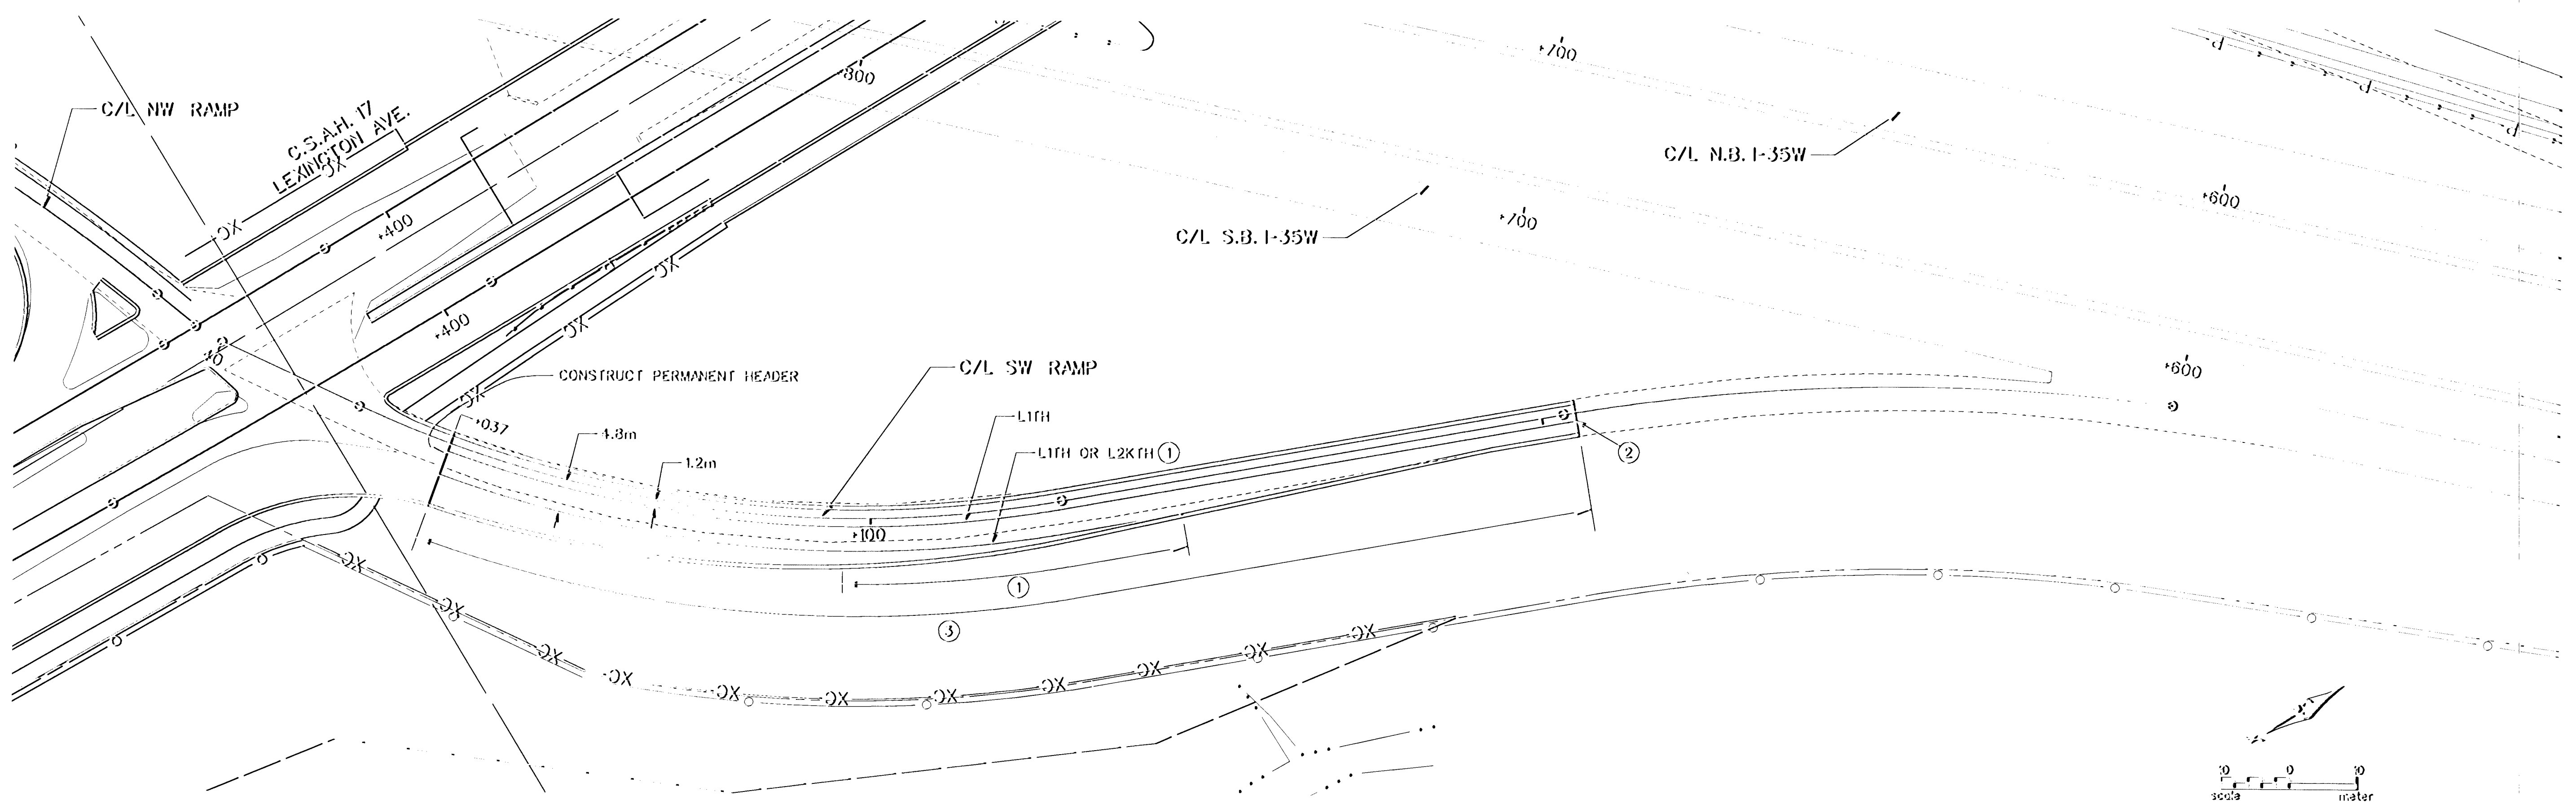

NO	DATE	BY	CKD	APPR	REVISION

NAME: PJ1 110.PLN DATE: Mar. 17, 1997

minnesota metric

I hereby certify that this plan, specification or report was prepared by me or under my direct supervision and that I am a duly Registered Professional Engineer under the laws of the State of Minnesota.

Donald A. Oames

Date: 3-21-97 Reg. No. 23377

STATE AID PROJECT NO. S.A.P. 02-617-11 S.A.P. 108-020-12 S.A.P. 108-030-03


CO. PROJECT NO.

DRAWN BY V. GRAF DATE 12-98

DESIGNED BY D. DEMERS 12-98

CHECKED BY D. DEMERS 1-97

COMM. NO. 0982410

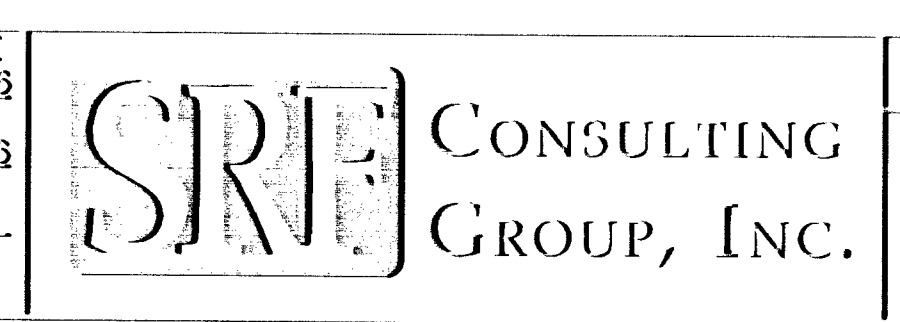










ANOKA COUNTY

PAVEMENT JOINT LAYOUT

C.S.A.H. 17 RECONSTRUCTION

NE RAMP AND SW RAMP

SHEET 101 OF 236

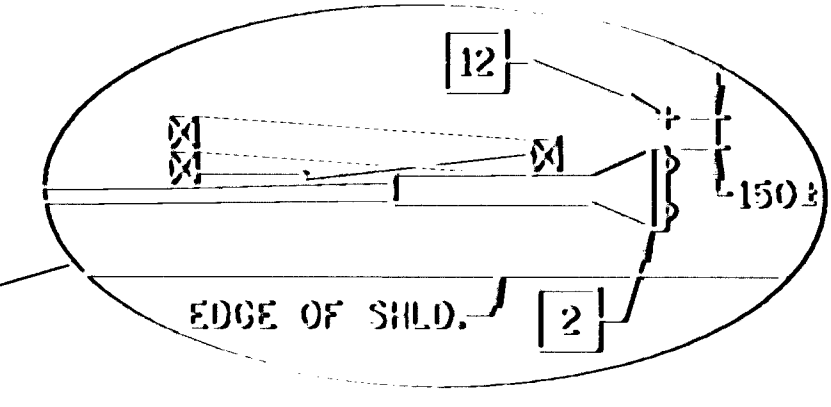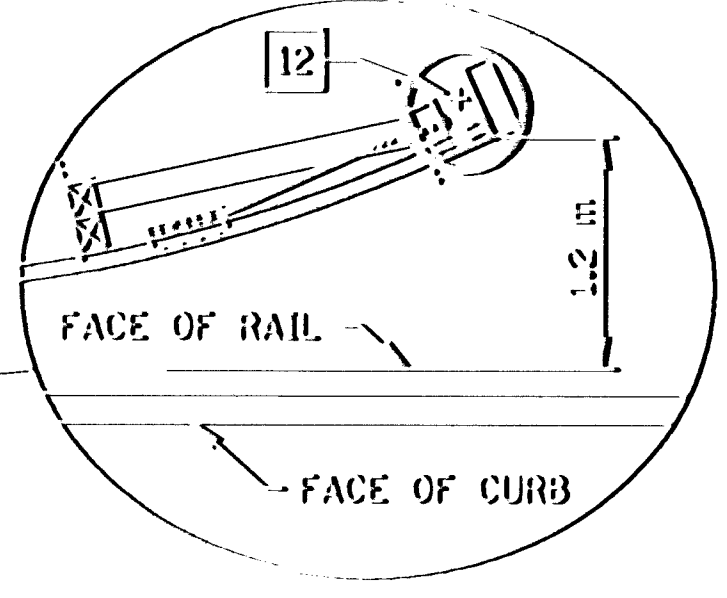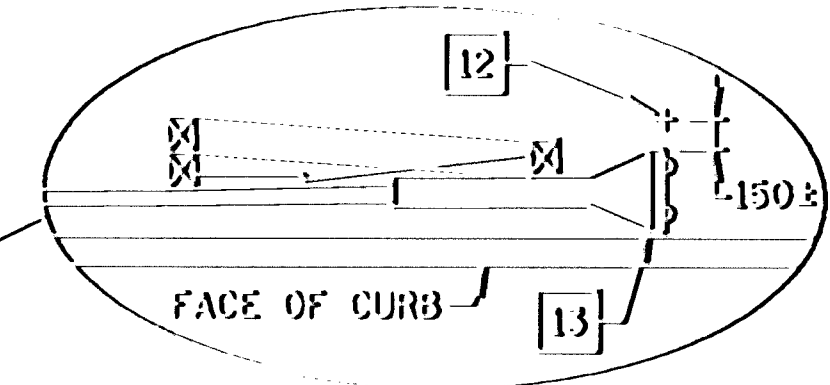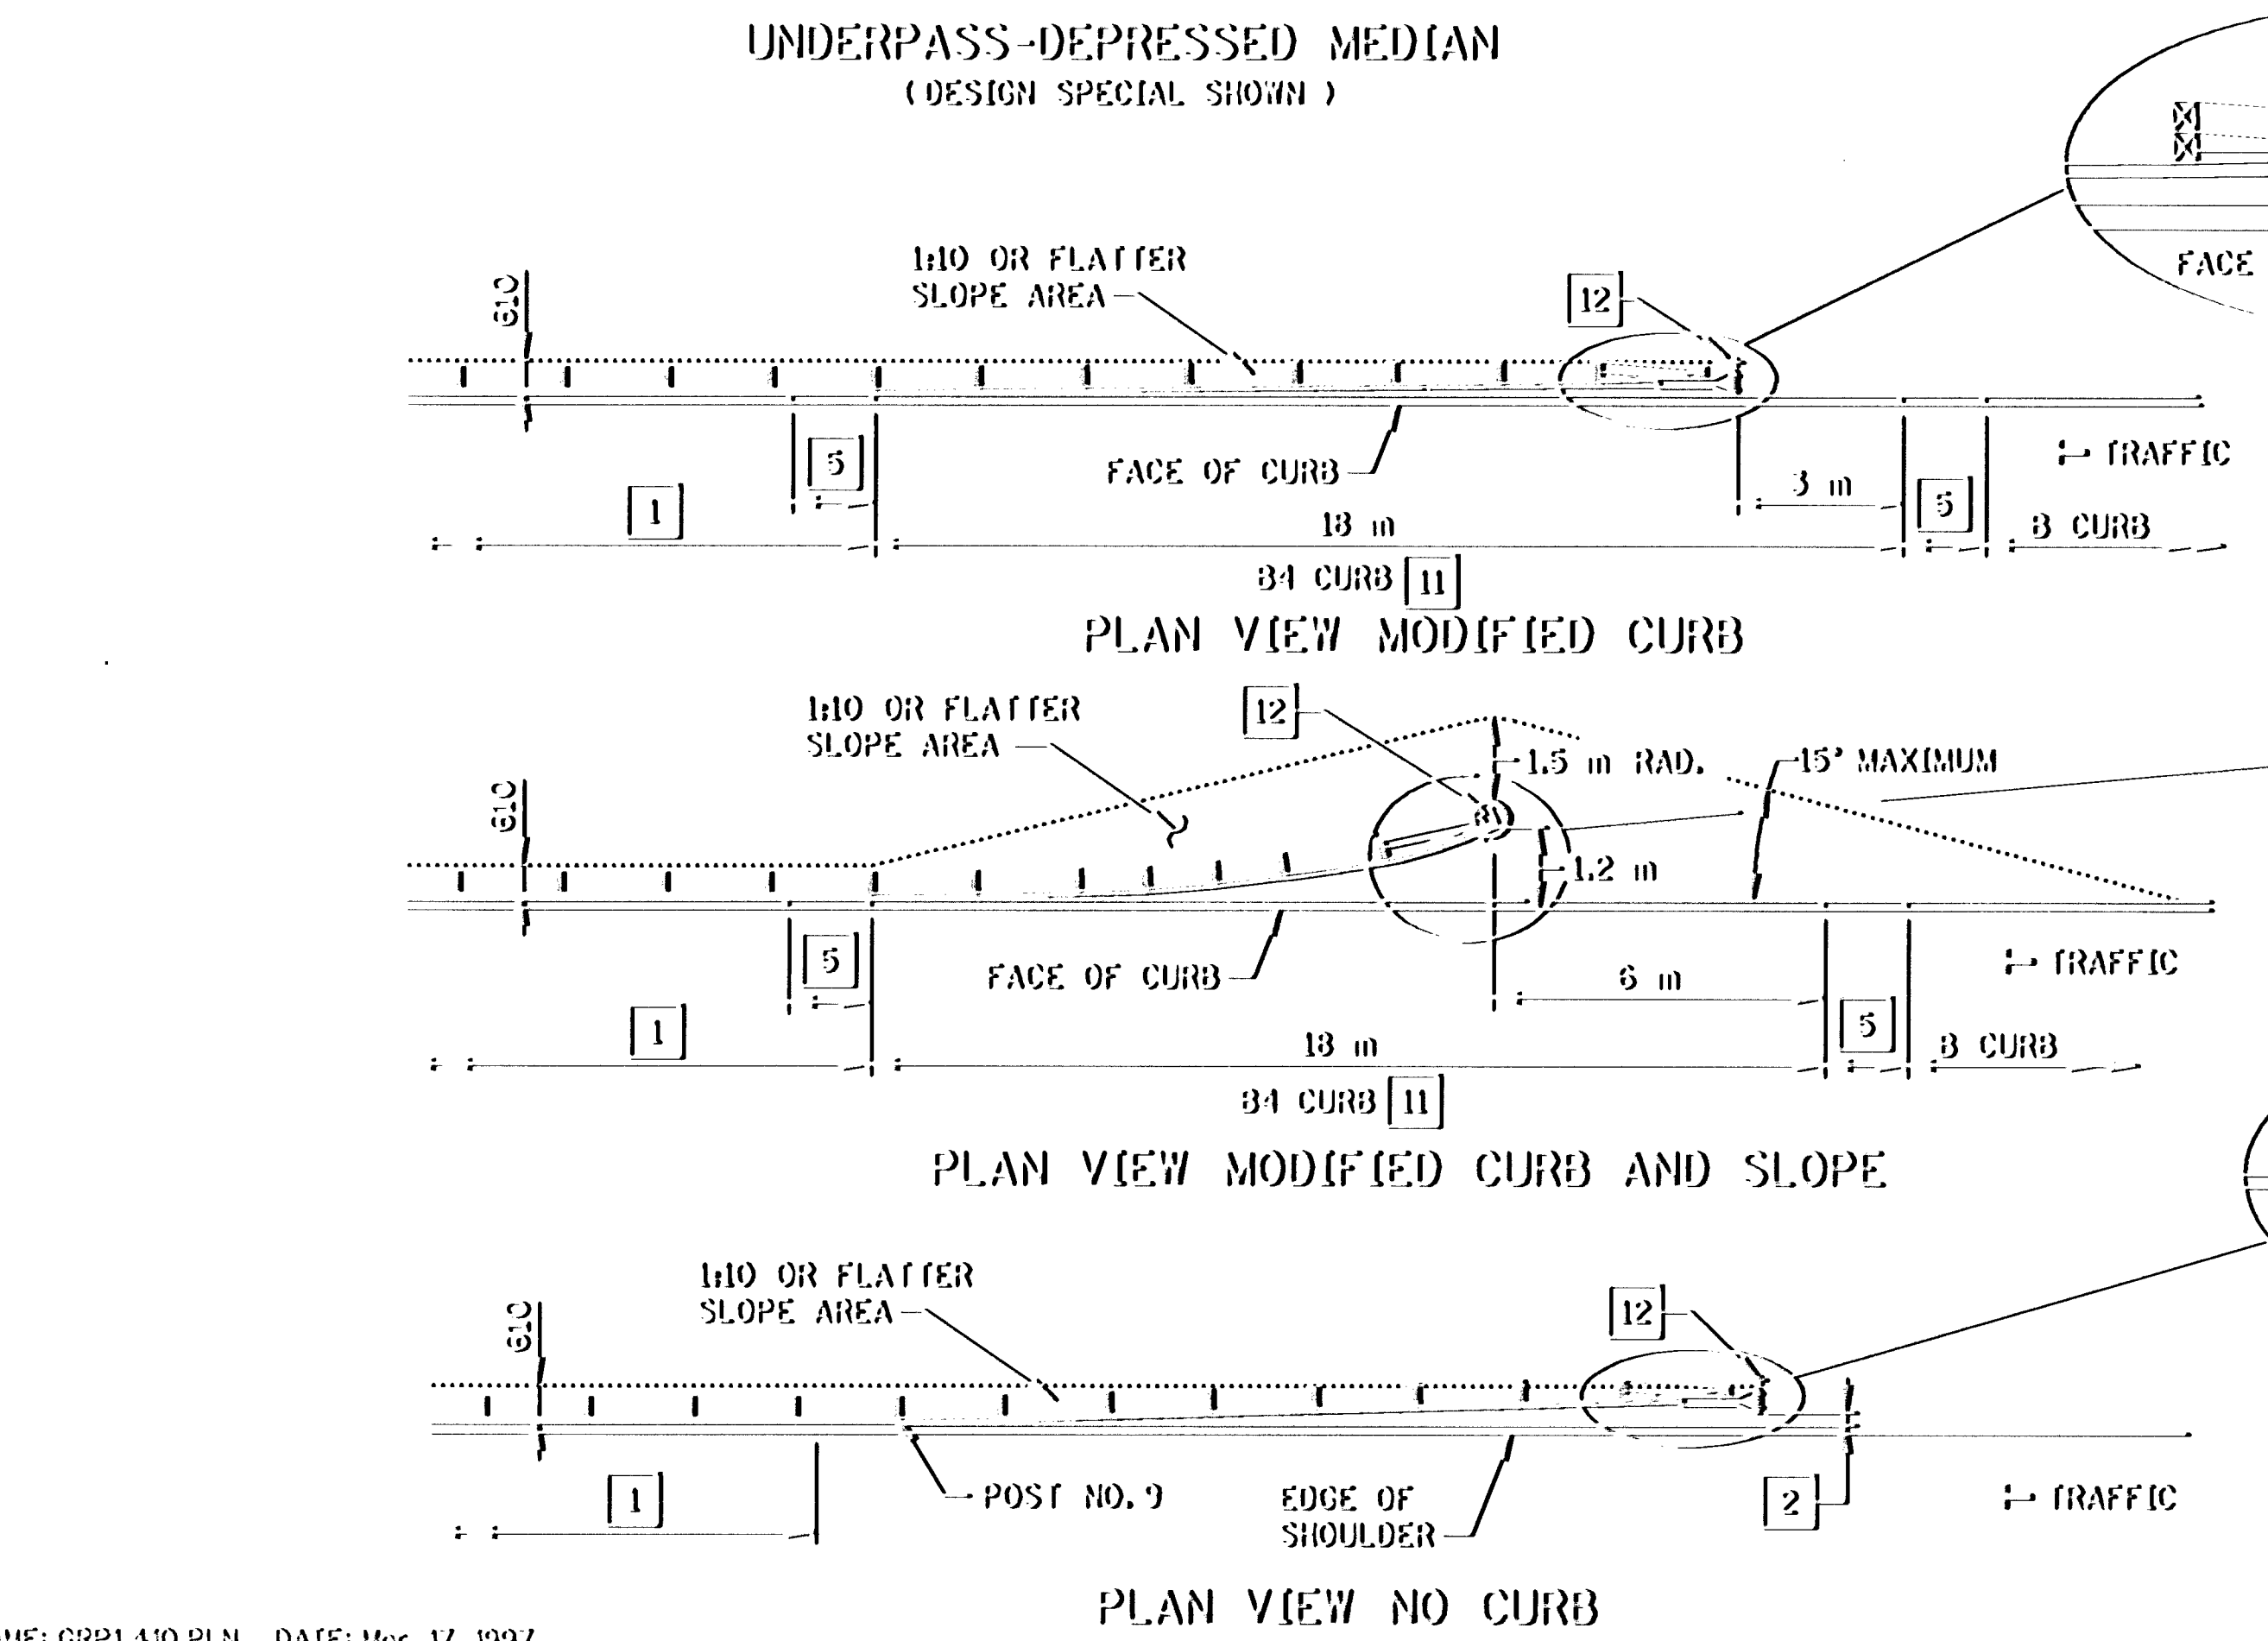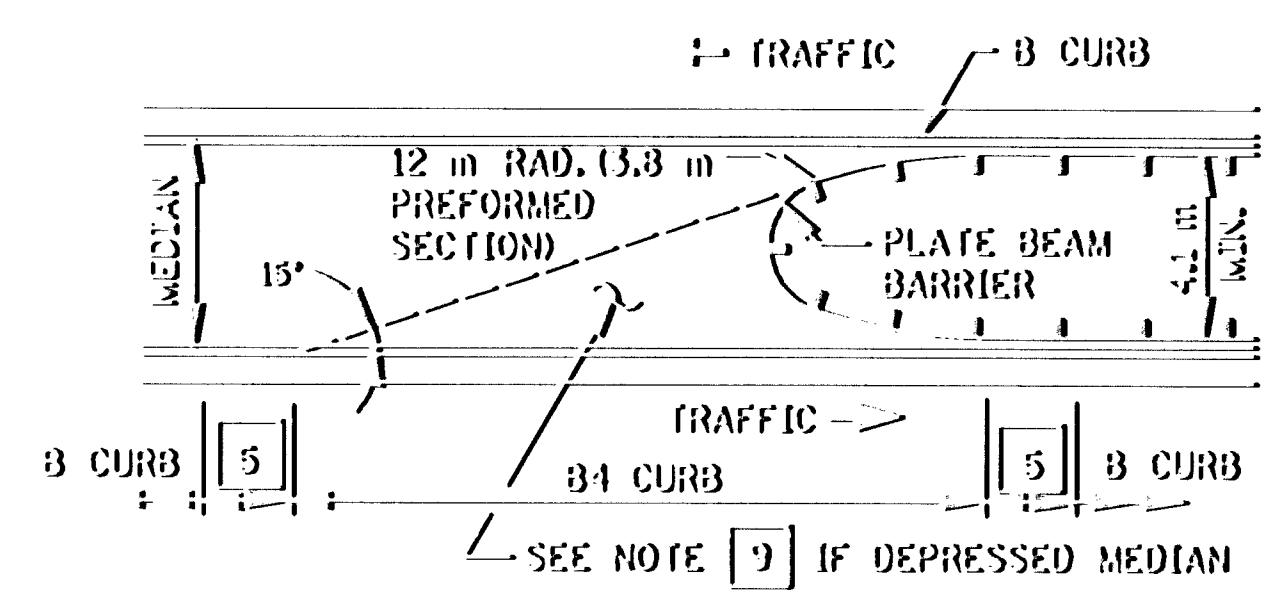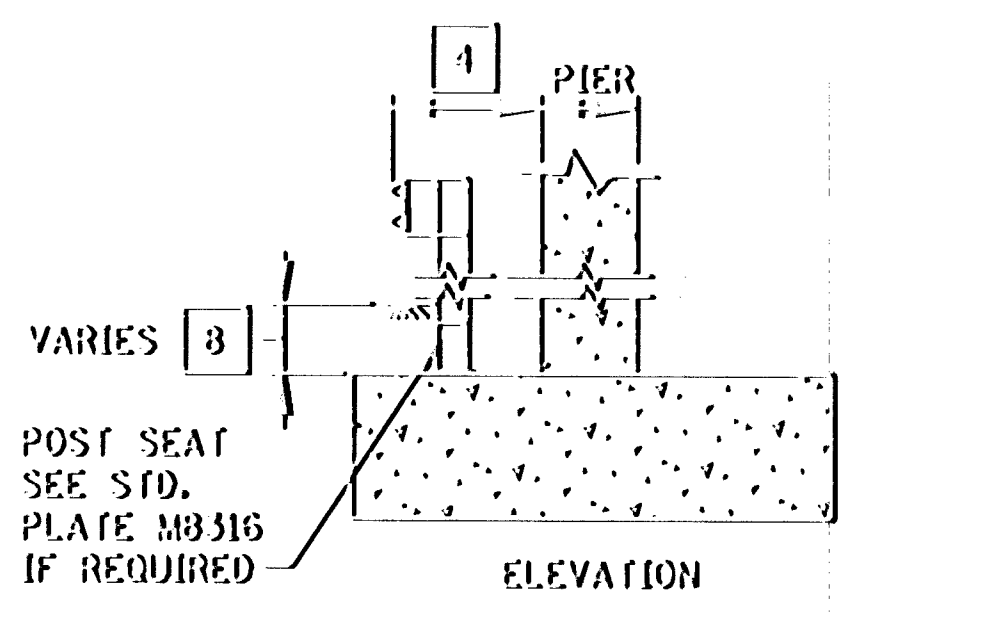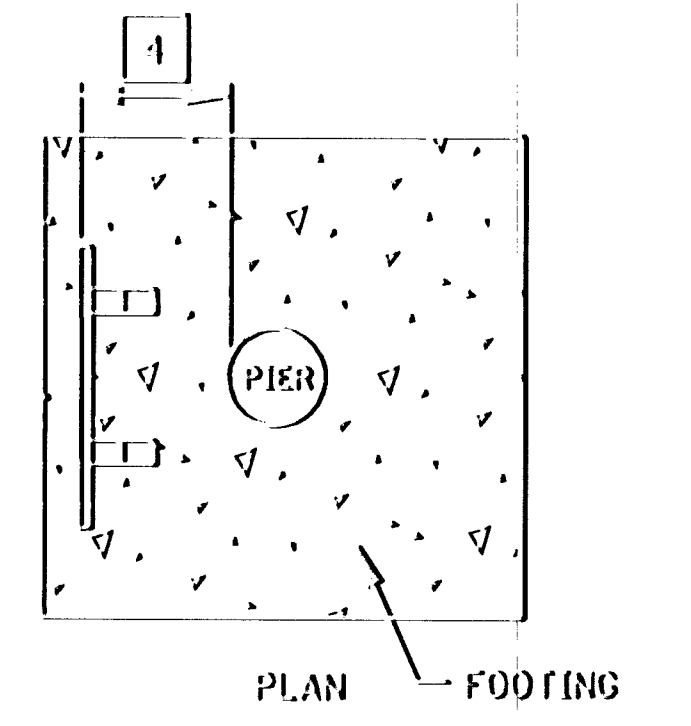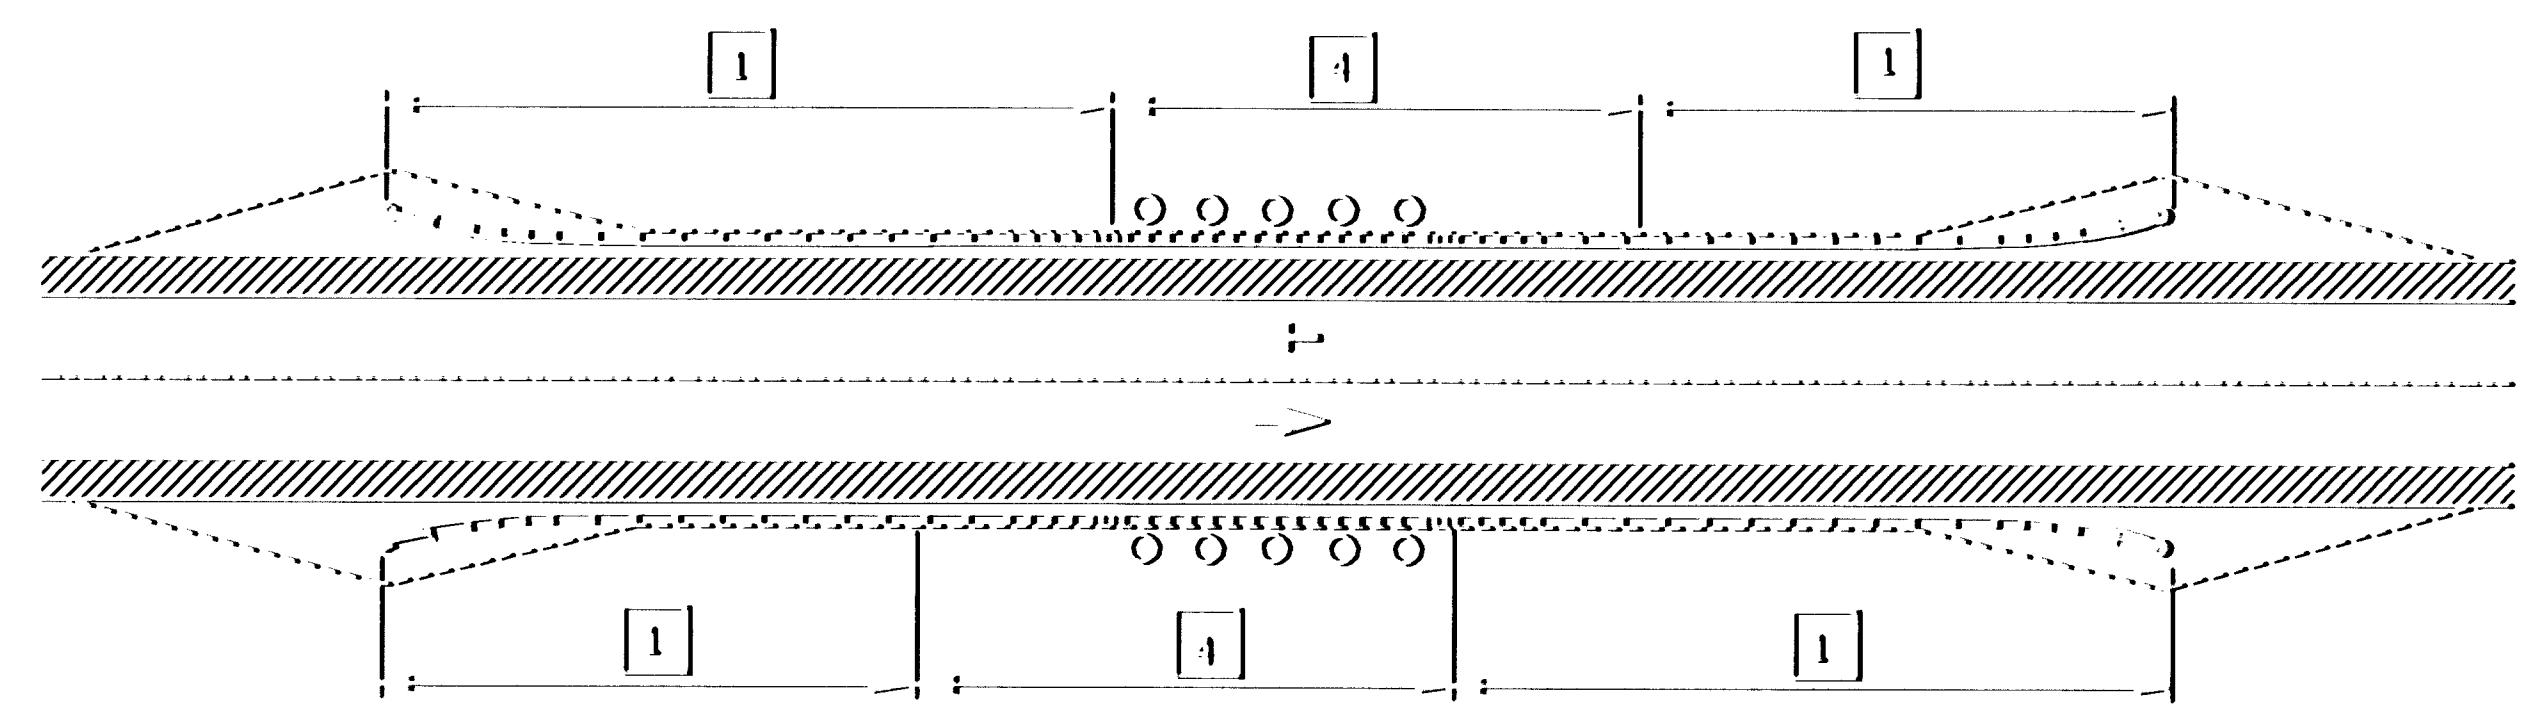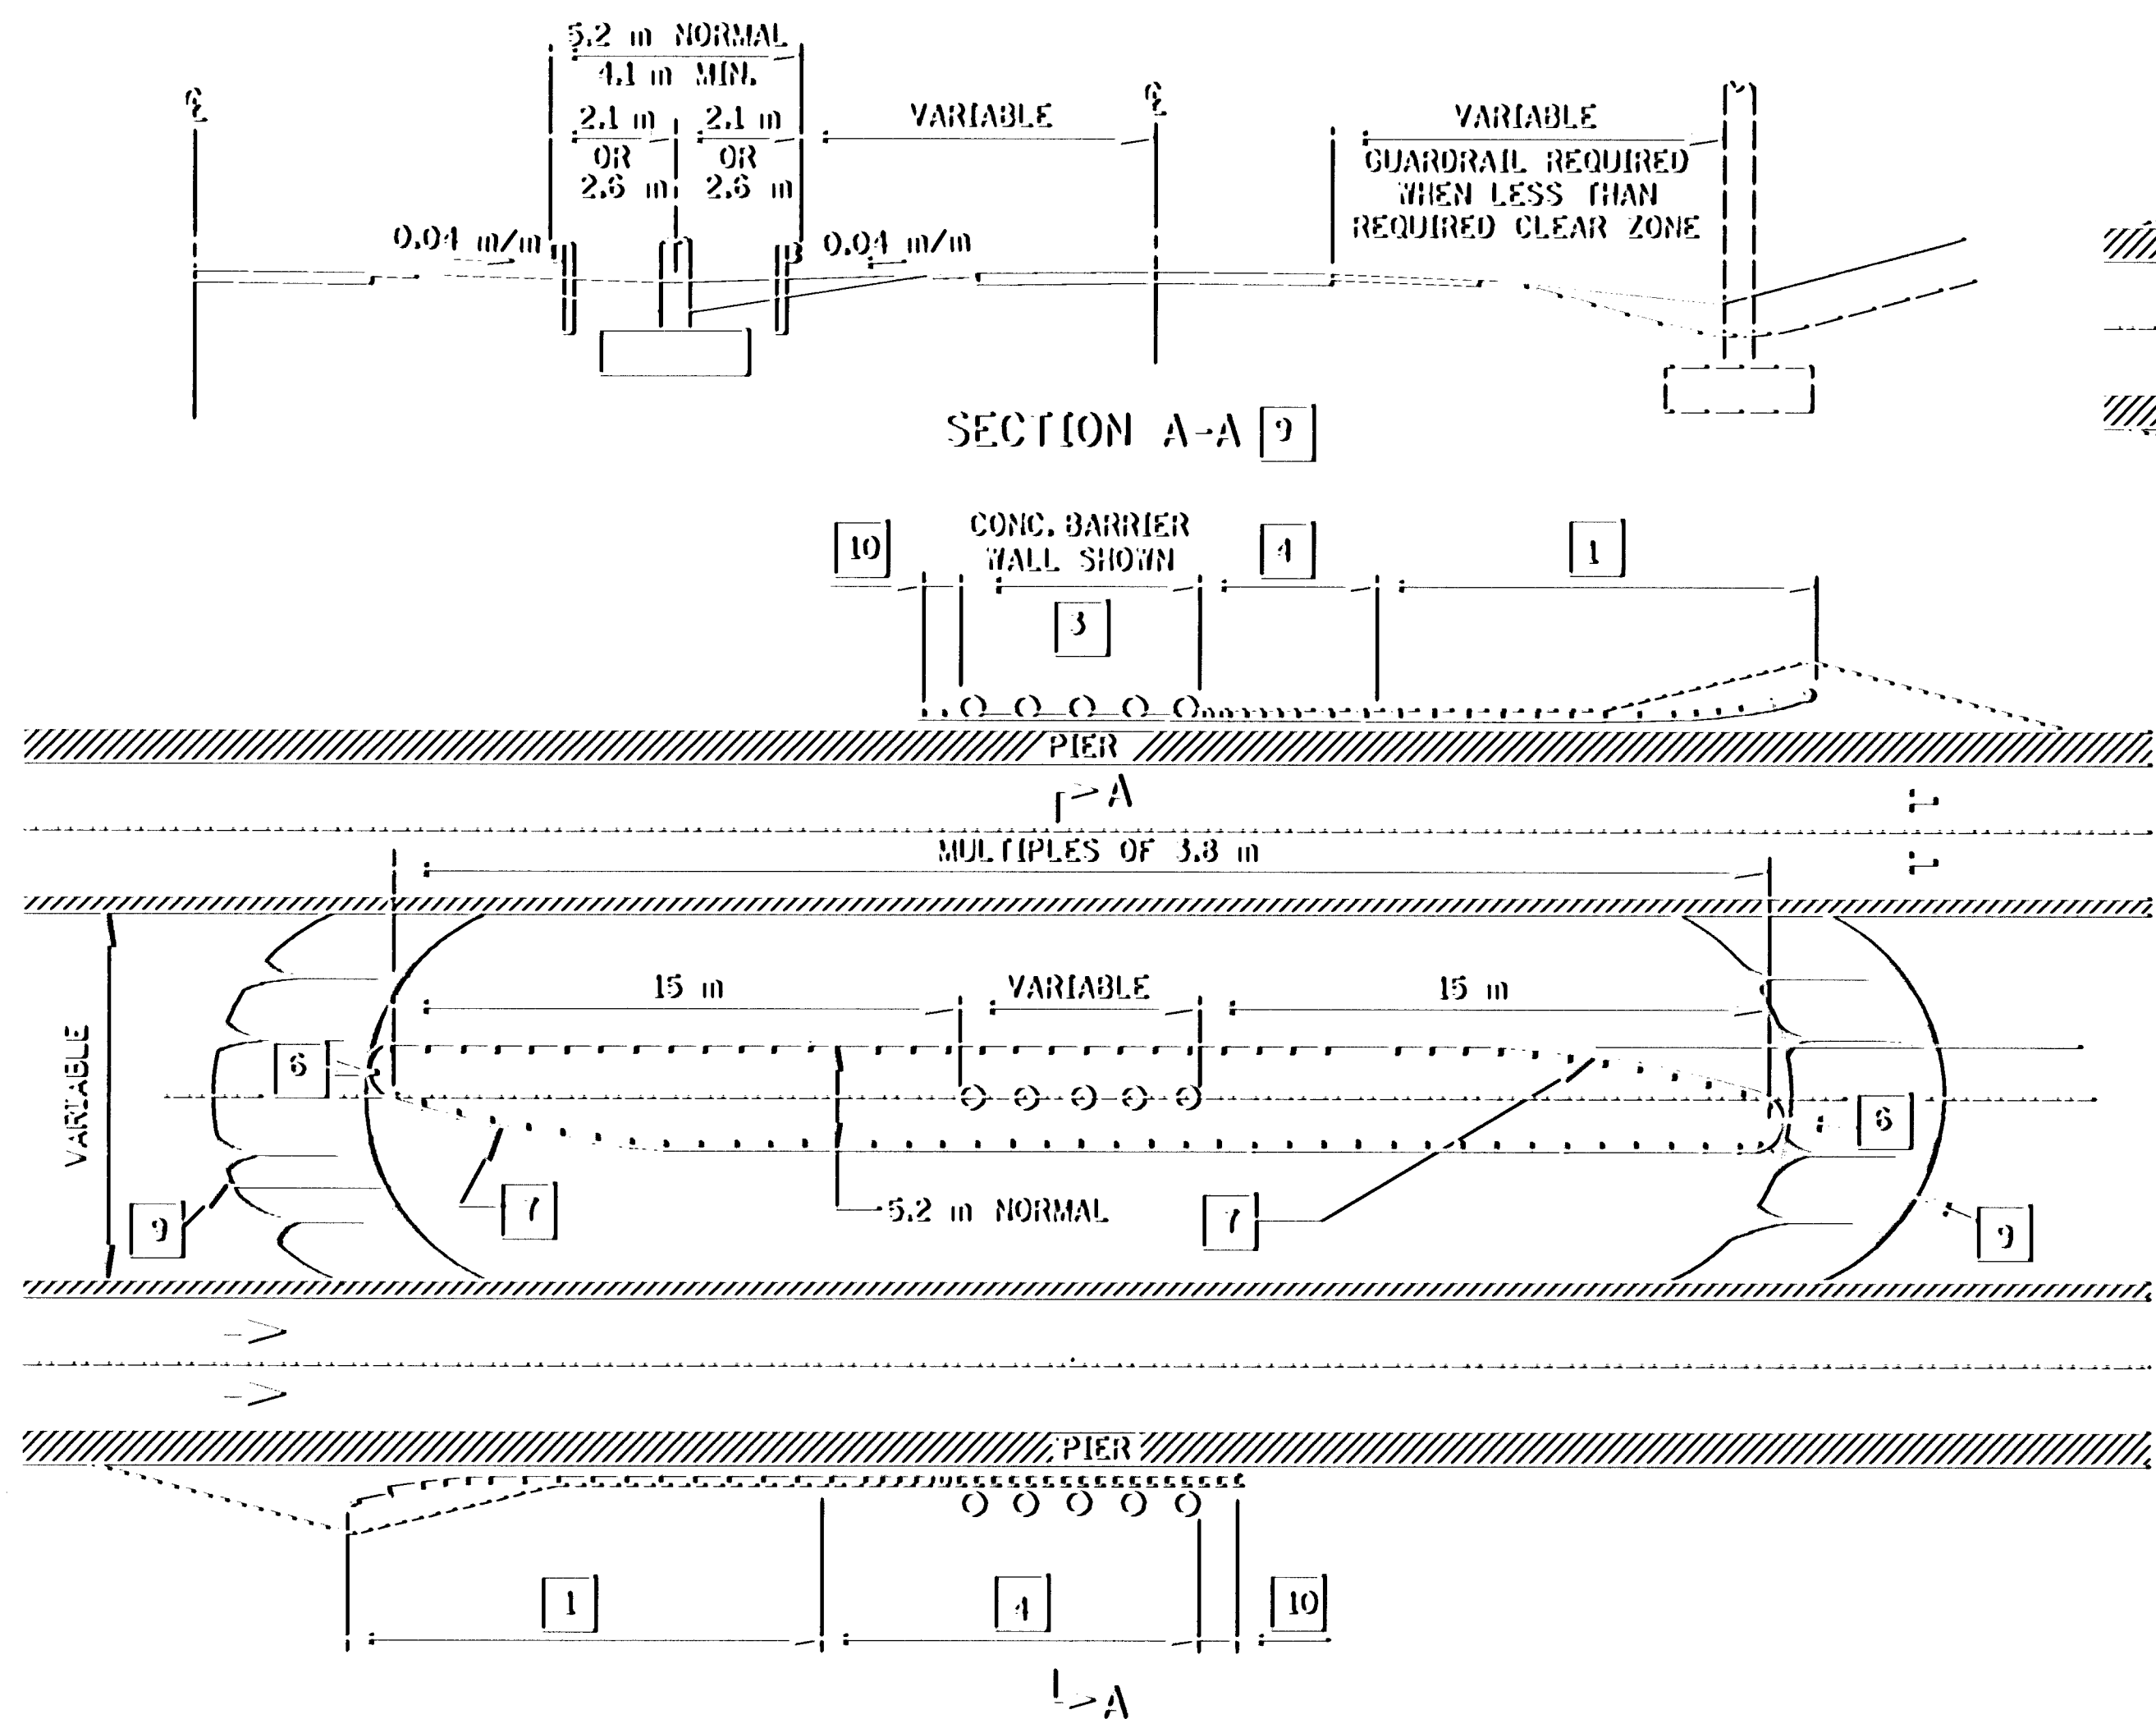


NOTES:


- 1 FOR REQUIRED L LENGTH SEE DESIGN MANUAL 10-7.03 FOR DESIGN PARAMETERS SEE STD. PLATE M8329 FOR END TREATMENT SHOWN.
 - 2 SET EDGE OF EXTRUDER BOX 230 mm FROM FACE OF RAIL EXTENDED FROM POST NO. 9.
 - 3 CONCRETE BARRIER WALL BETWEEN PIER COLUMNS MAY BE USED. SEE SHEET NO. ... OF ... FOR WALL DETAILS. CONNECT GUARDRAIL TO BARRIER WALL ANCHORAGE PLATE SEE SHEET NO. ... OF ... FOR DETAILS.
 - 4
- | DISTANCE FROM FACE OF RAIL TO HAZARD | GUARDRAIL POST SPACING |
|--------------------------------------|------------------------|
| OVER 1.2 m | 1.9 m |
| 1.2 m TO 600 mm | 950 mm |
| LESS THAN 600 mm | DESIGN SPECIAL & 3 |
- 5 1.5 m CURB TRANSITION, USE IF ADJACENT CURB IS A DIFFERENT TYPE OR HEIGHT.
 - 6 1.5 m RADIUS NOSE SECTION (3.8 m PREFORMED CURVED RAIL SECTION, SEE DETAIL, ON SHEET 1 OF 2).
 - 7 7.5 m OF PREFORMED (12 m RADIUS) RAIL SECTIONS.
 - 8 IF EMBEDMENT IS GREATER THAN 915 mm OR IF EMBEDMENT IS 760 mm TO 915 mm AND ADJACENT POSTS ARE EMBEDDED 915 mm OR MORE, POST SEAT IS NOT REQUIRED.
 - 9 THE MEDIAN DITCH SHALL BE FILLED TO PROVIDE AN ELEVATION OF GUARDRAIL APPROXIMATELY (WITHIN 150 mm) THE SAME AS IF INSTALLED ON THE SHOULDER. EXTEND FILL TO GUARDRAIL NOSE AND TAPER TO MEDIAN DITCH ON 1:10 SLOPE.
 - 10 3800 mm MINIMUM, IF ONE WAY TRAFFIC.
 - 11 IF 150 mm+ HIGH CURB, MILL TO 75 mm HEIGHT. NEW: CONSTRUCT 100 mm HIGH CURB.
 - 12 SNOW PLOW MARKER (X4-5) WITH A 3 kg/m DELINEATOR POST 2.4 m LG. (SPEC. 340) DRIVEN INTO GROUND. EXTEND 915 mm ABOVE TERMINAL.
 - 13 SET EDGE OF EXTRUDER BOX 230 mm FROM FACE OF CURB.

NOTE: ALL DIMENSIONS ARE IN MILLIMETERS, EXCEPT AS NOTED.


STANDARD SHEET NO. 5-297.601M (1 OF 2)	FILE:	GUARDRAIL INSTALLATIONS AT MEDIANS AND END TREATMENTS
STANDARD APPROVED: MARCH 17, 1994		
S.A.P. 02-617-11, et al.		SHEET NO. 102 OF 236 SHEETS

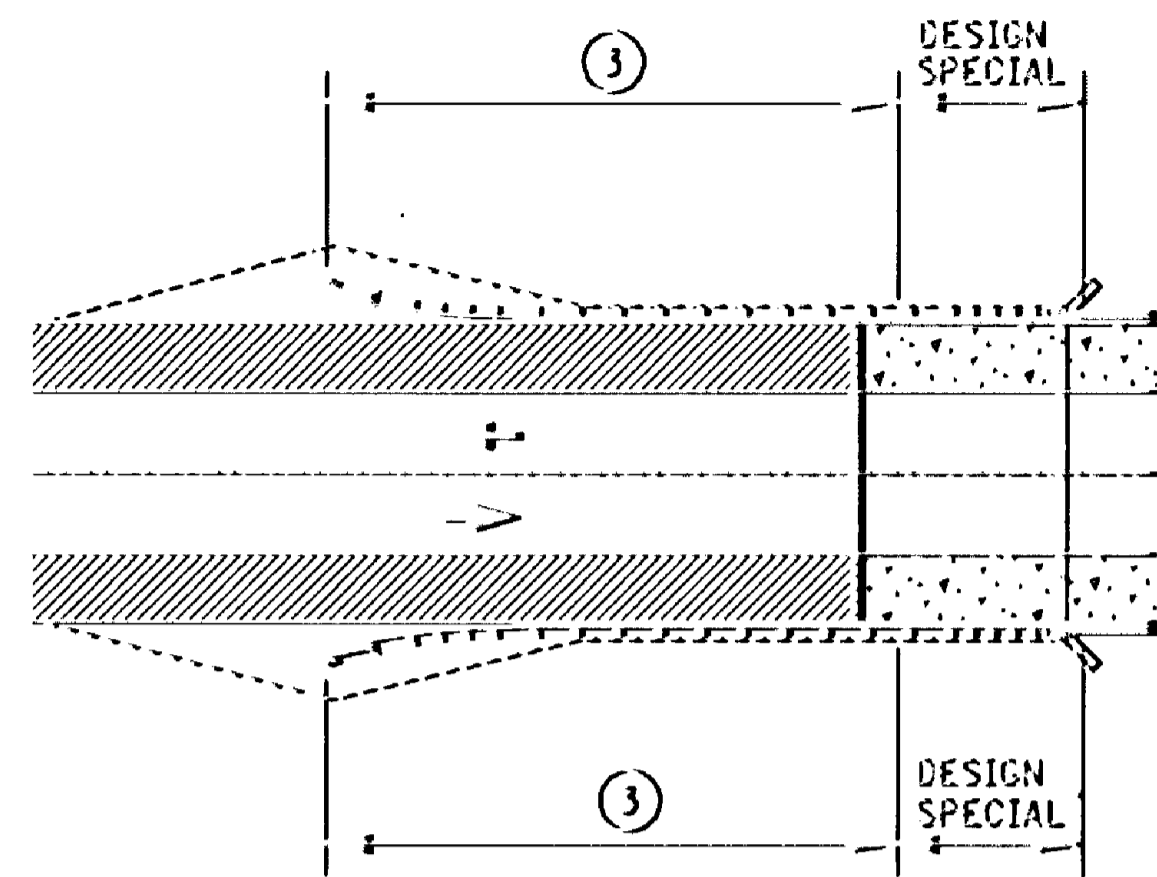


TWO - WAY BRIDGE WITH FULL SHOULDERS

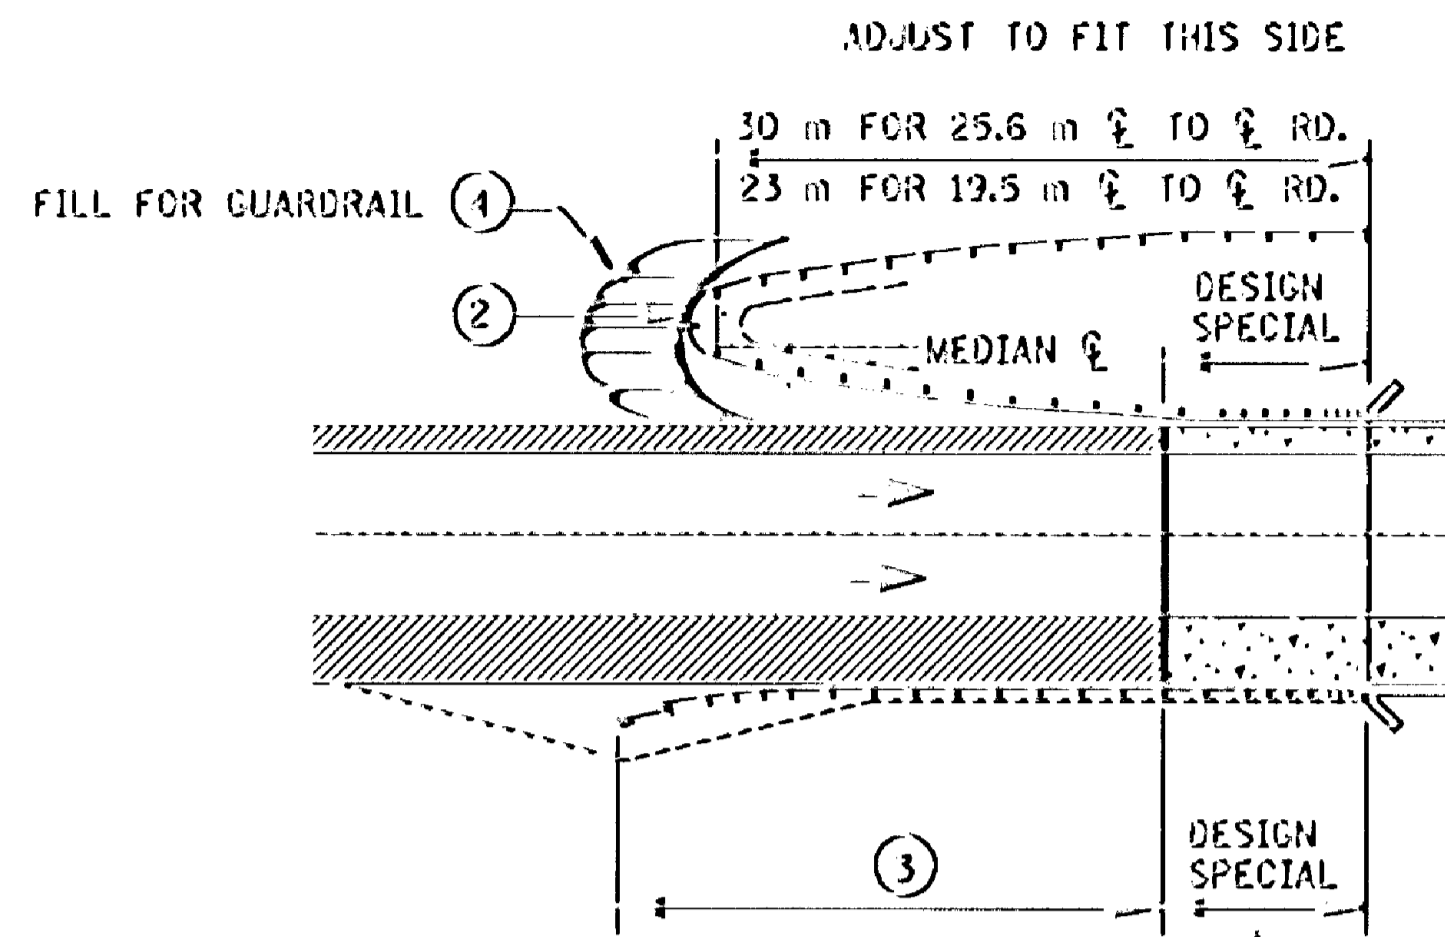


ONE - WAY BRIDGE WITH FULL RIGHT SHOULDER

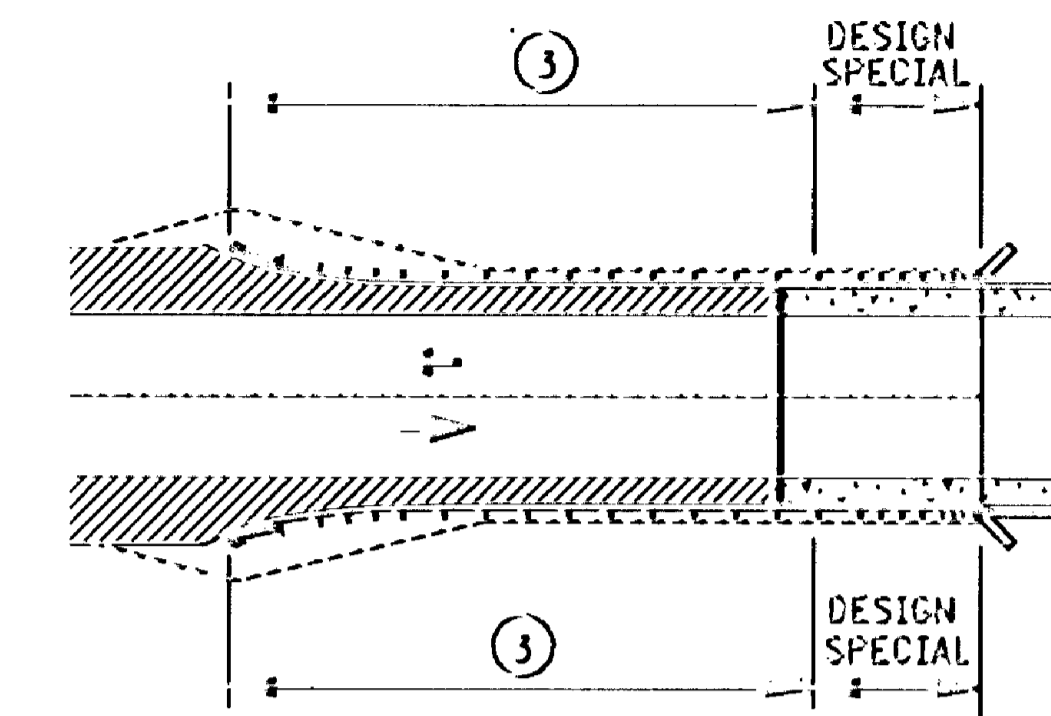


TWO - WAY BRIDGE WITHOUT FULL SHOULDERS

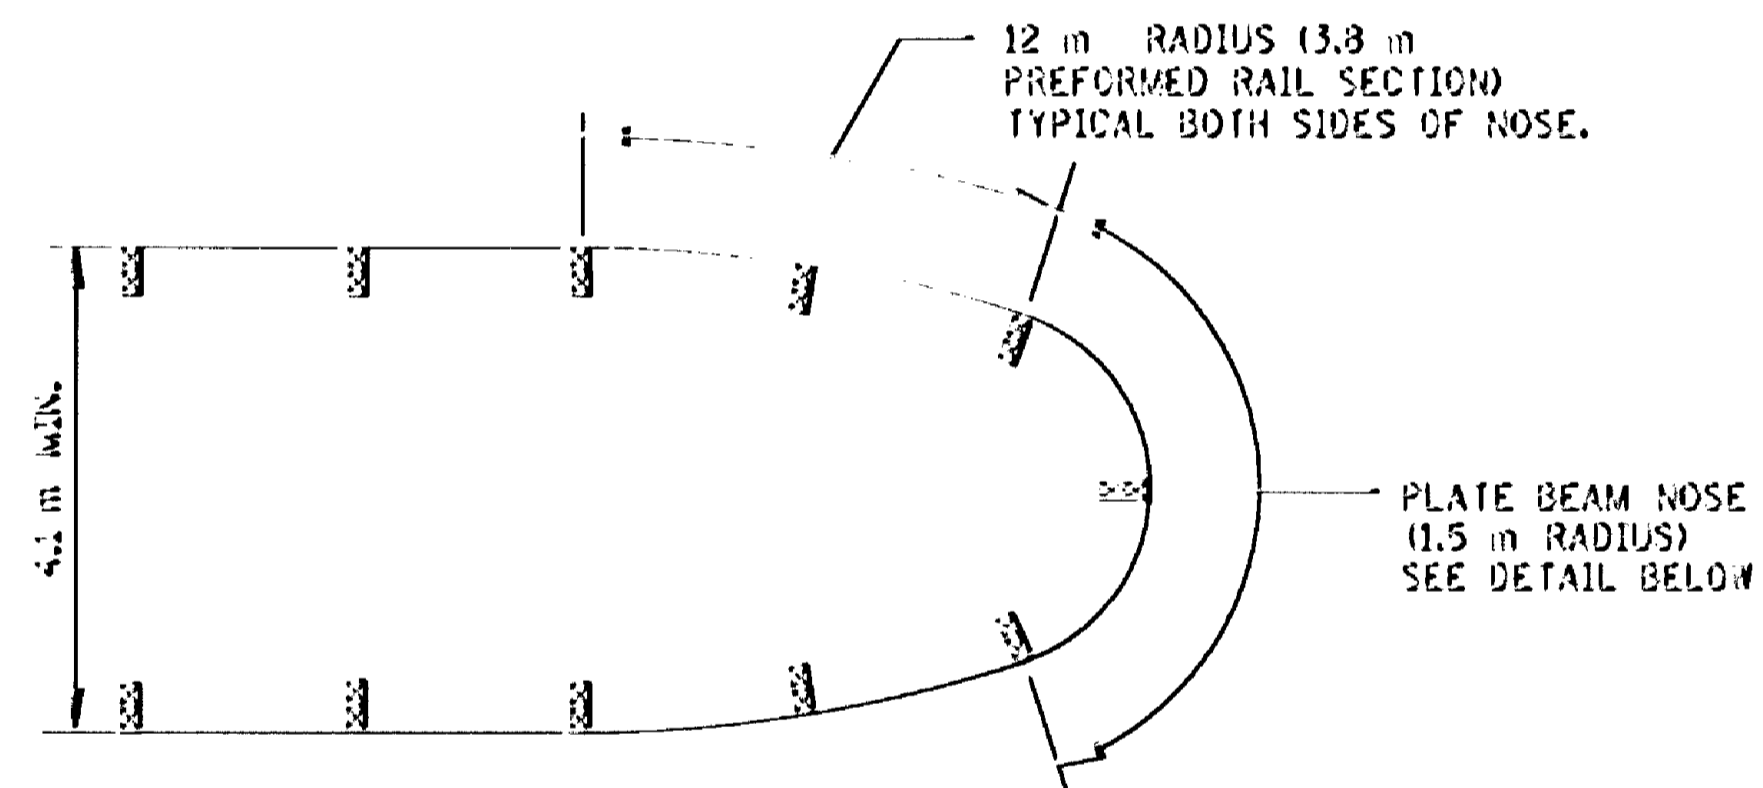

OPTIONAL GUARDRAIL INSTALLATION ①

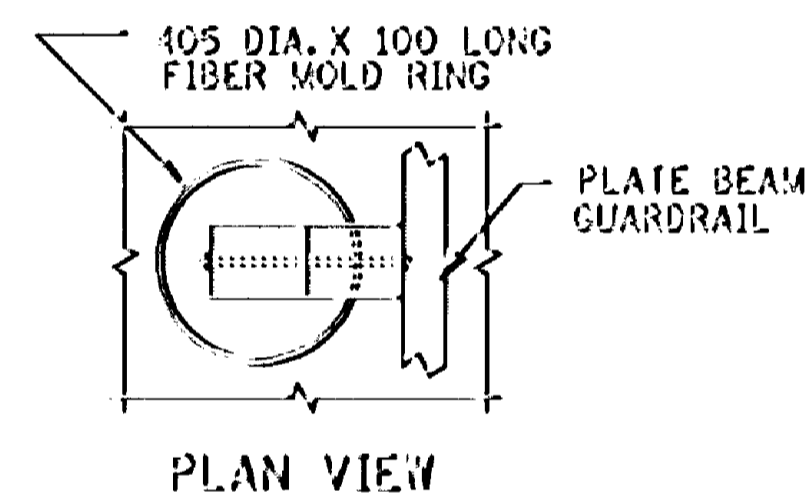

PLAN VIEW

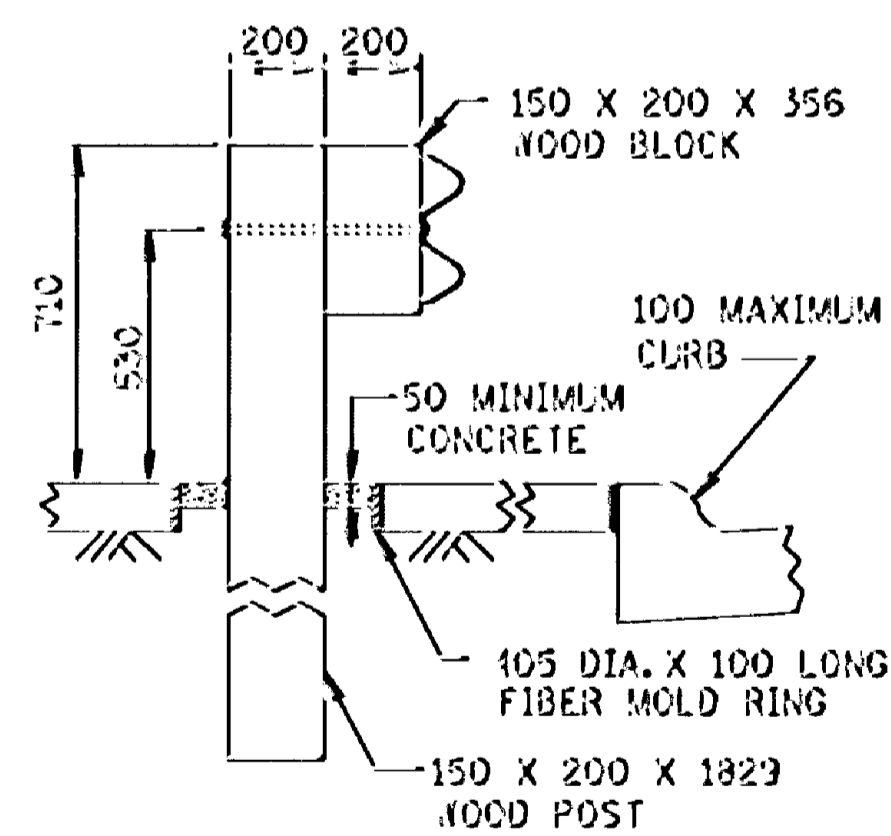

ELEVATION

TYPICAL SECTION AT POST SET IN CONCRETE

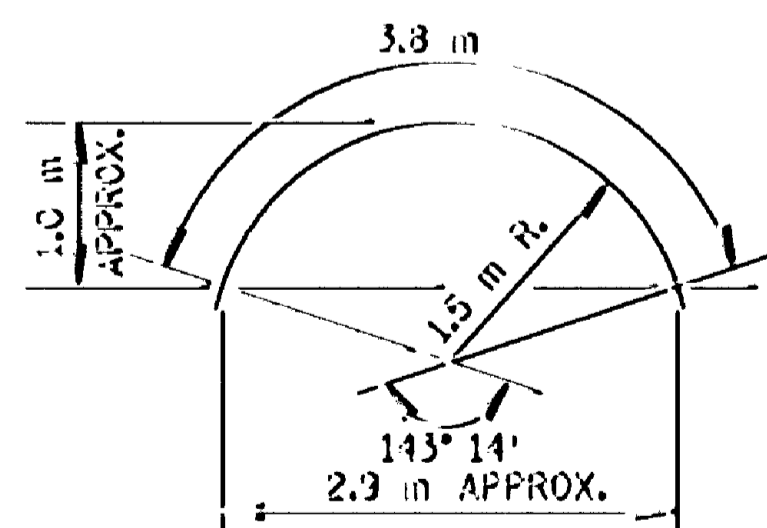


PLATE BEAM NOSE ⑤ (1.5 m RADIUS)

NOTES:

ALL GUARDRAIL POSTS SHALL BE 1.9 m CTR. TO CTR., EXCEPT WHERE NOTED. WHEN THE APPROACHING PLATE BEAM FLARE CAN BE BURIED IN THE BACKSLOPE ELIMINATE THE END TREATMENT AND ADD REQUIRED RAIL LENGTH TO REACH BACKSLOPE. THE LATEST APPROVED VERSION OF STANDARD PLATES SHOWN OR AS INDICATED IN THE PLANS SHALL APPLY.

- ① OPTIONAL GUARDRAIL AS DETERMINED BY THE DESIGNER AND SPECIFIED ON SHEET NO. _____ OF _____.
- ② 1.5 m RADIUS NOSE SECTION (3.8 m PREFORMED CURVED RAIL SECTION, SEE DETAIL).
- ③ FOR THE REQUIRED L LENGTH SEE ROAD DESIGN MANUAL 10-7.03 FOR DESIGN PARAMETERS. SEE STANDARD PLATE M8329 FOR END TREATMENT SHOWN.
- ④ THE MEDIAN DITCH SHALL BE FILLED TO PROVIDE AN ELEVATION OF GUARDRAIL APPROXIMATELY (WITHIN 150 mm) THE SAME AS IF INSTALLED ON THE SHOULDER. EXTEND FILL TO GUARDRAIL NOSE AND TAPER TO MEDIAN DITCH ON 10:1 SLOPE.
- ⑤ STANDARD PLATE BEAM GUARDRAIL SECTION HAVING STANDARD PUNCHING AT BOTH ENDS WITH INTERMEDIATE 13 mm X 62 mm SLOT. SEE STANDARD PLATE M8307.


NOTE: ALL DIMENSIONS ARE IN MILLIMETERS, EXCEPT AS NOTED.

STANDARD SHEET NO.
5-297.601M (2 OF 2)
STANDARD APPROVED
MARCH 17, 1994


TITLE:
GUARDRAIL INSTALLATIONS AT MEDIANS
AND END TREATMENTS

S.A.P. 02-617-11, et al.

SHEET NO. 103 OF 236 SHEETS

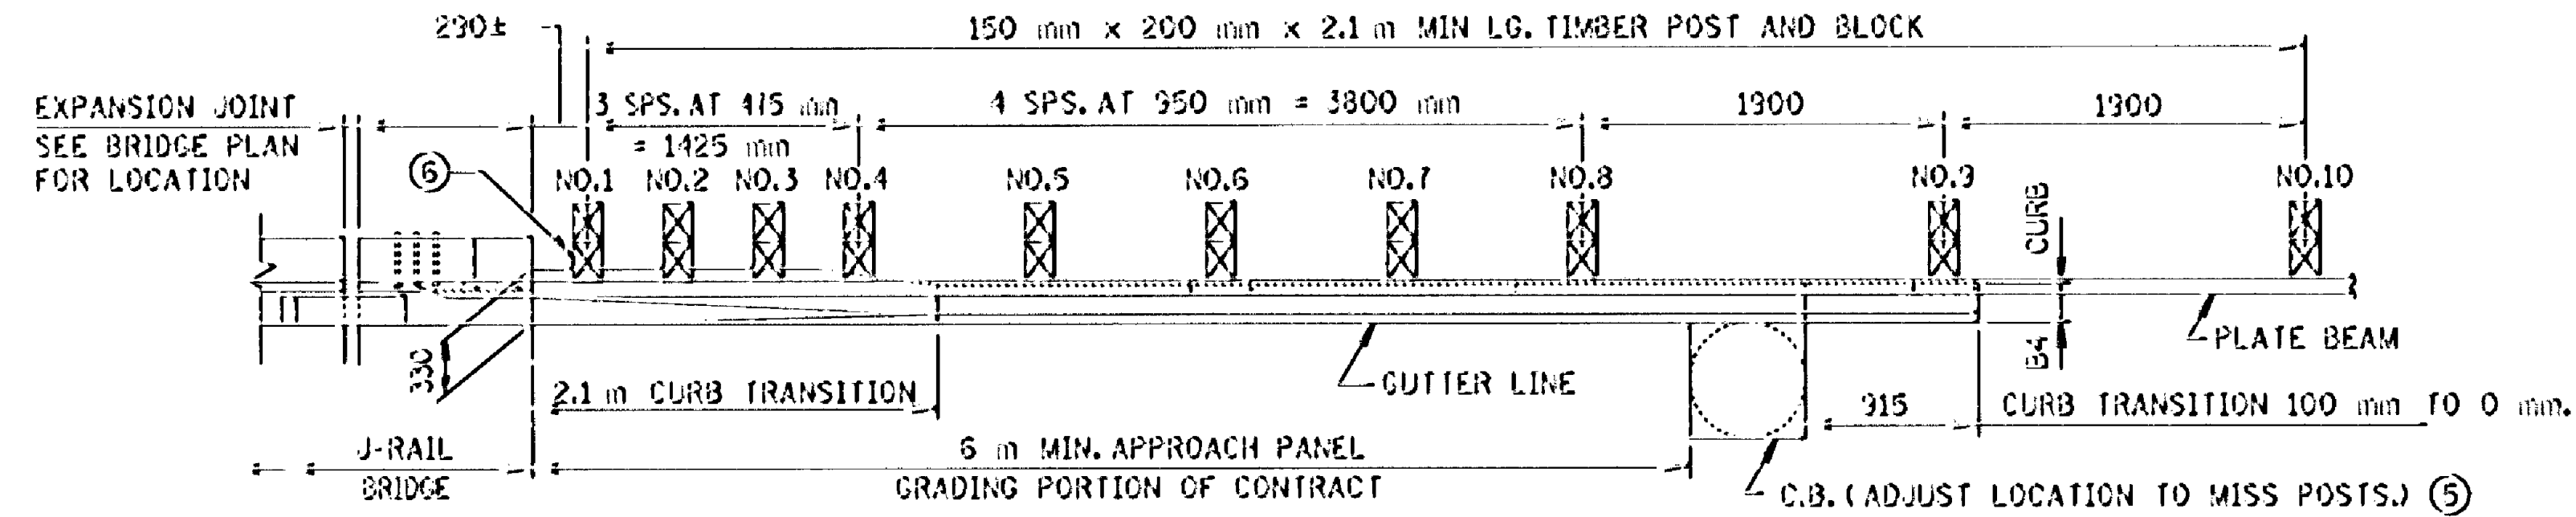


PLAN

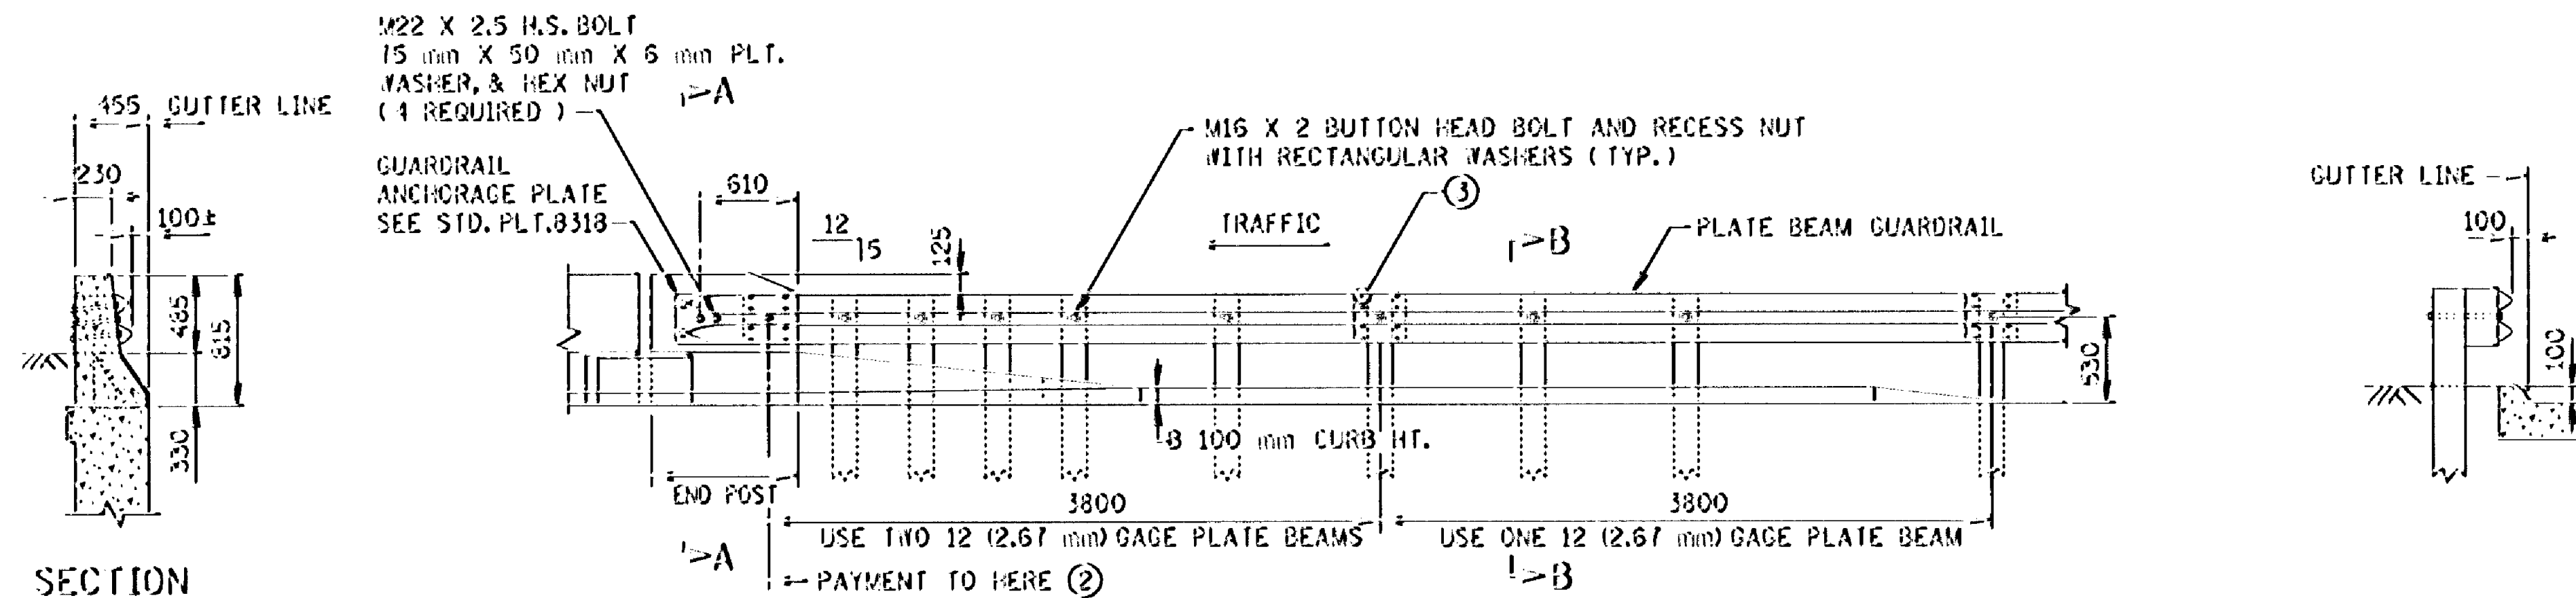


ELEVATION

SECTION A-A
(PARALLEL WINGWALL SHOWN)

SECTION B-B

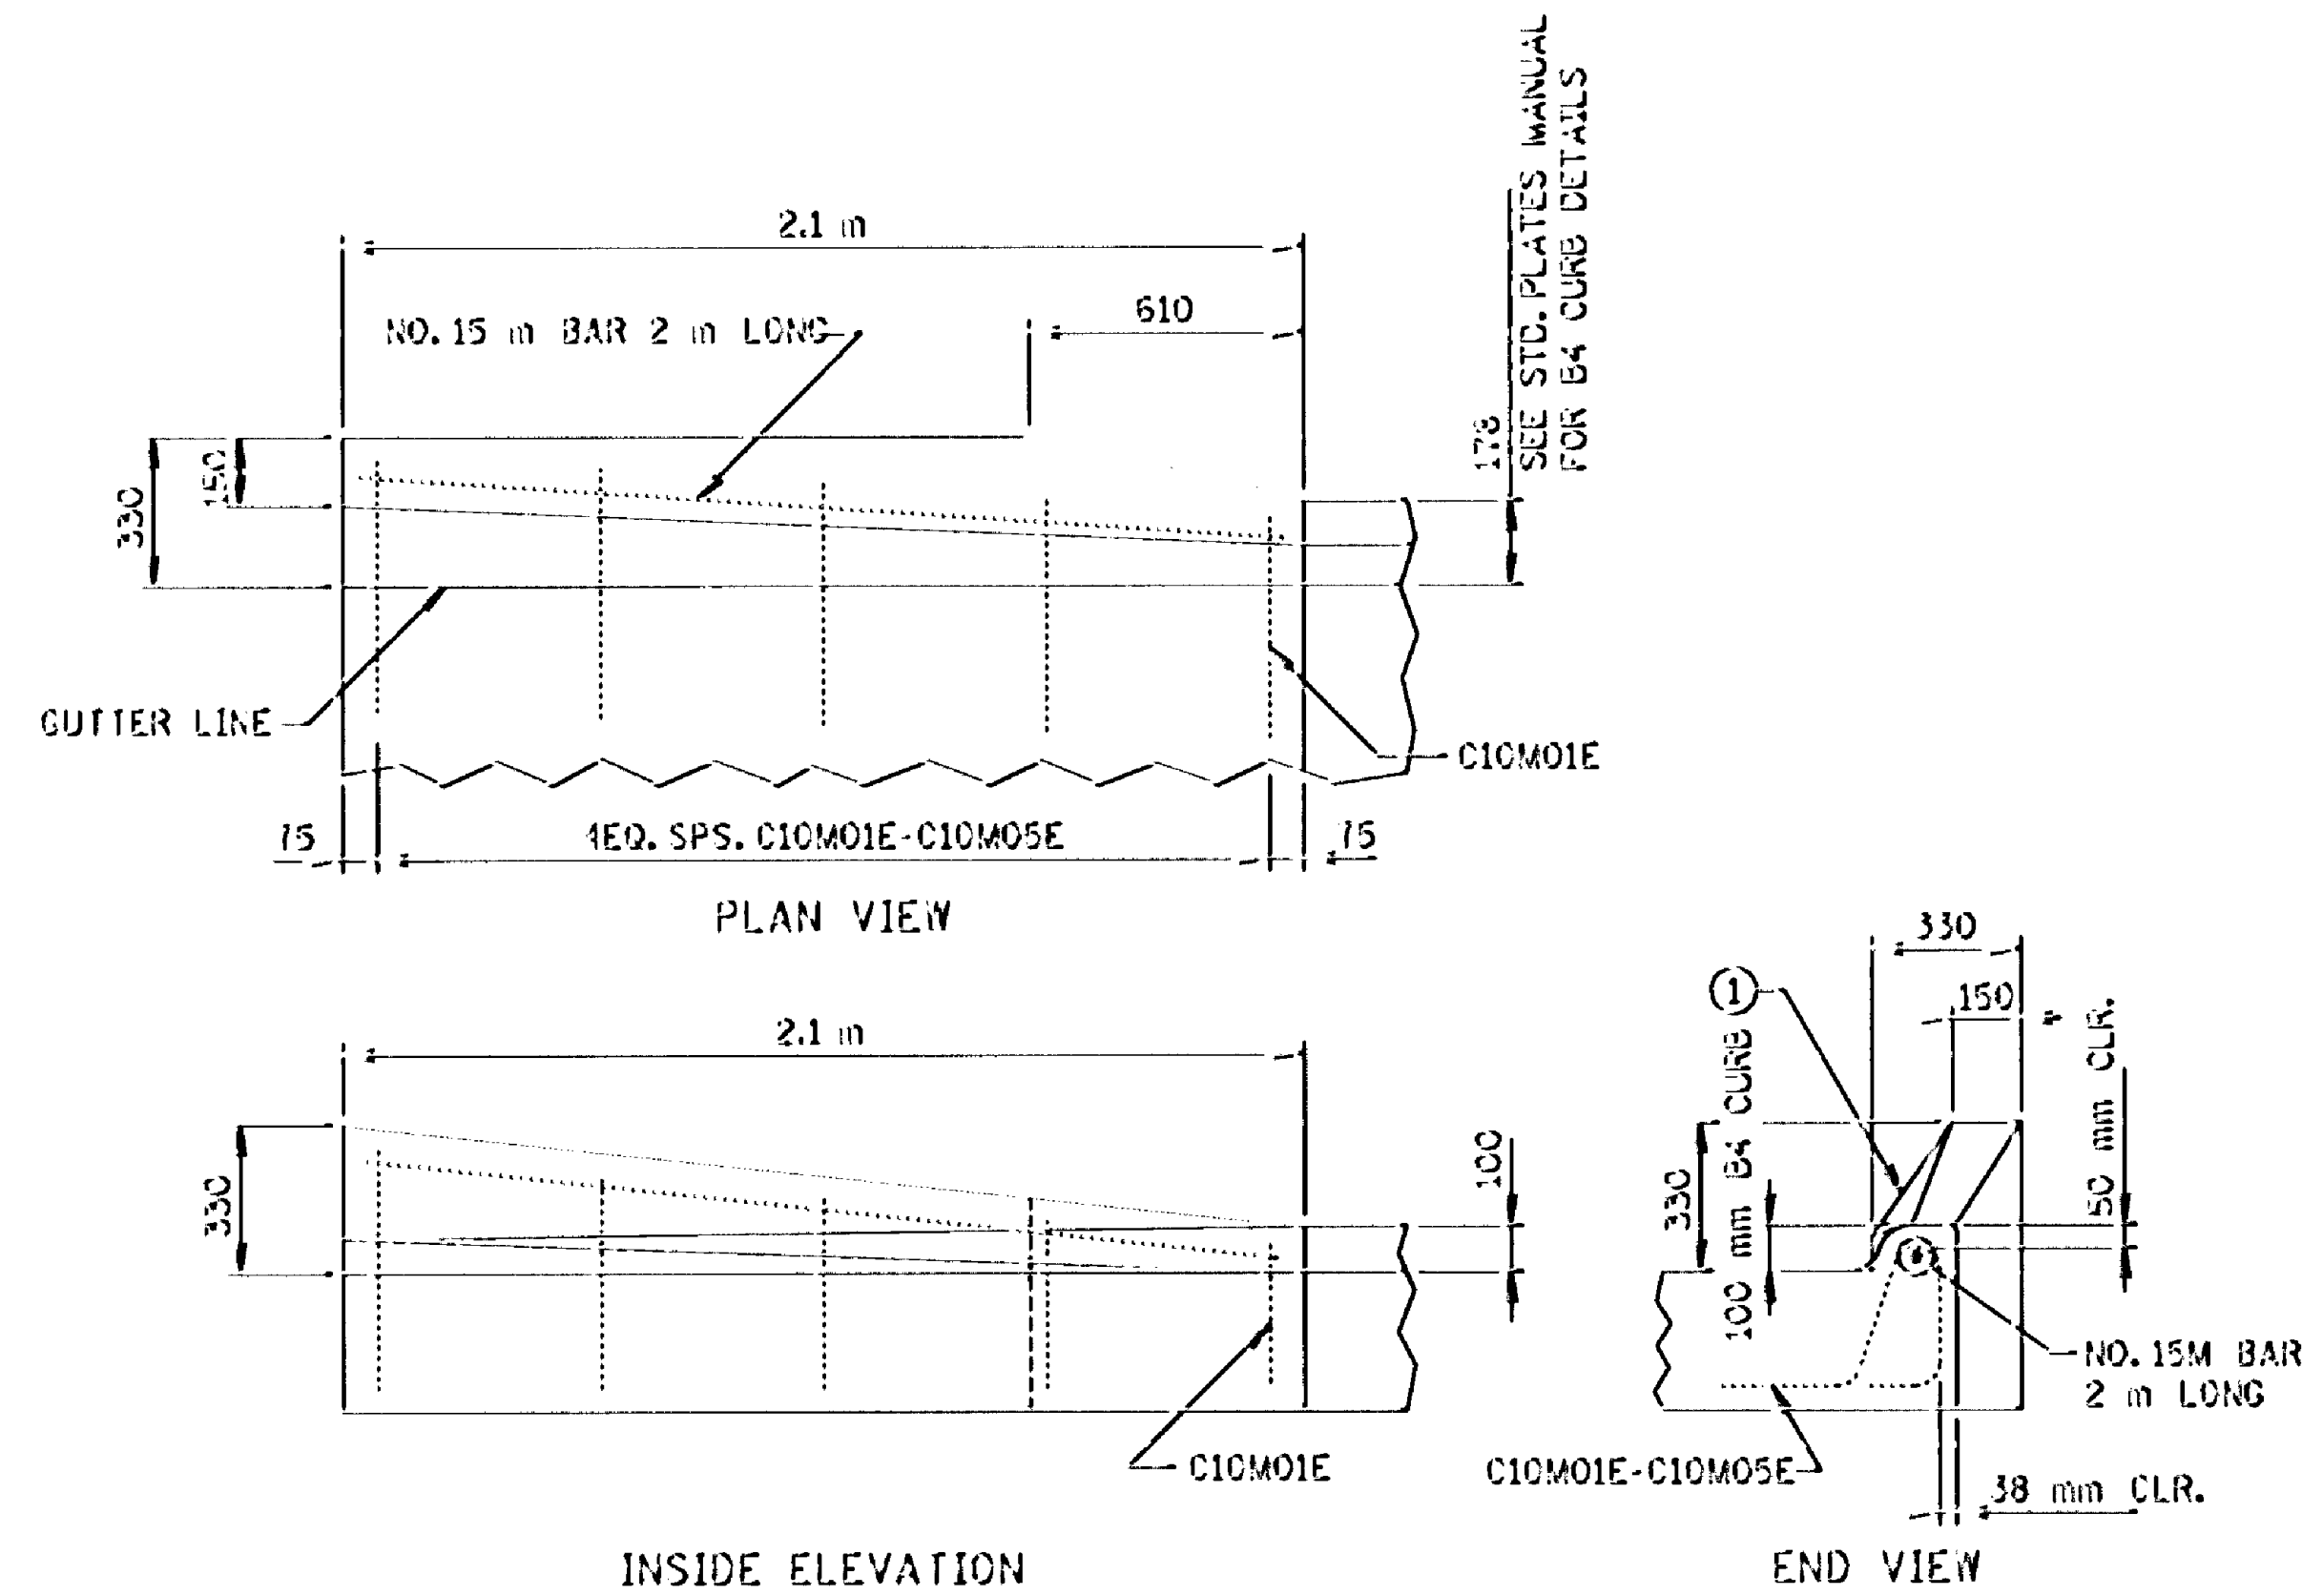

CURB TRANSITION DETAILS

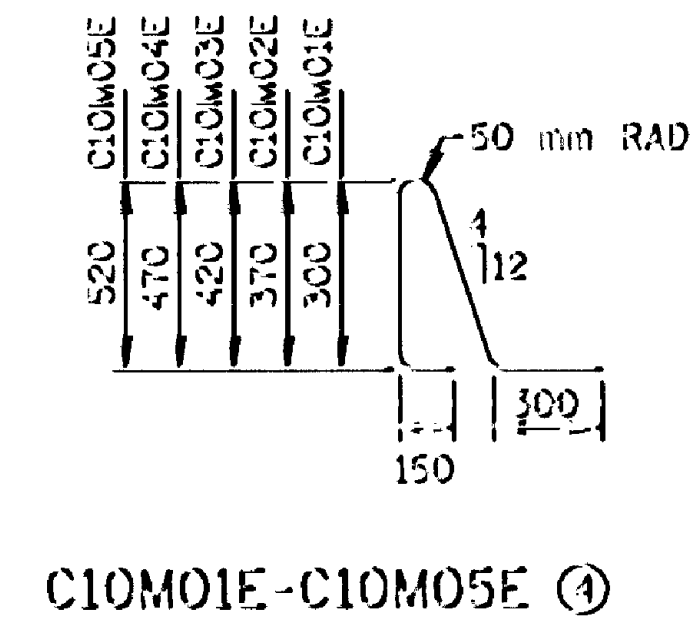

C10M01E-C10M05E ③

NOTES:


- ① END OF TRANSITION TO MATCH BRIDGE RAIL SURFACE.
- ② PAY LENGTH IS 7.6 METERS.
- ③ M16 X 2 X 32 mm LG. BUTTON HEAD BOLTS AND NUTS TYPICAL AT SPLICES.
- ④ REINFORCEMENT TO BE EPOXY COATED AS PER SPEC. 3301.
- ⑤ SEE ROAD PLANS TO VERIFY ACTUAL DIMENSION AND LOCATION.
- ⑥ ADDITIONAL BLOCKING MAY BE REQUIRED TO CLEAR BRIDGE STRUCTURE. VERIFY IN FIELD.

NOTE: ALL DIMENSIONS ARE IN MILLIMETERS, EXCEPT AS NOTED.

STANDARD SHEET NO.
5-297.605M
STANDARD APPROVED:
JANUARY 23, 1992


TITLE:
GUARDRAIL TRANSITION FOR NEW TYPE J RAILING
WITH APPROACH CURB

TYPE "C" & "D" POST

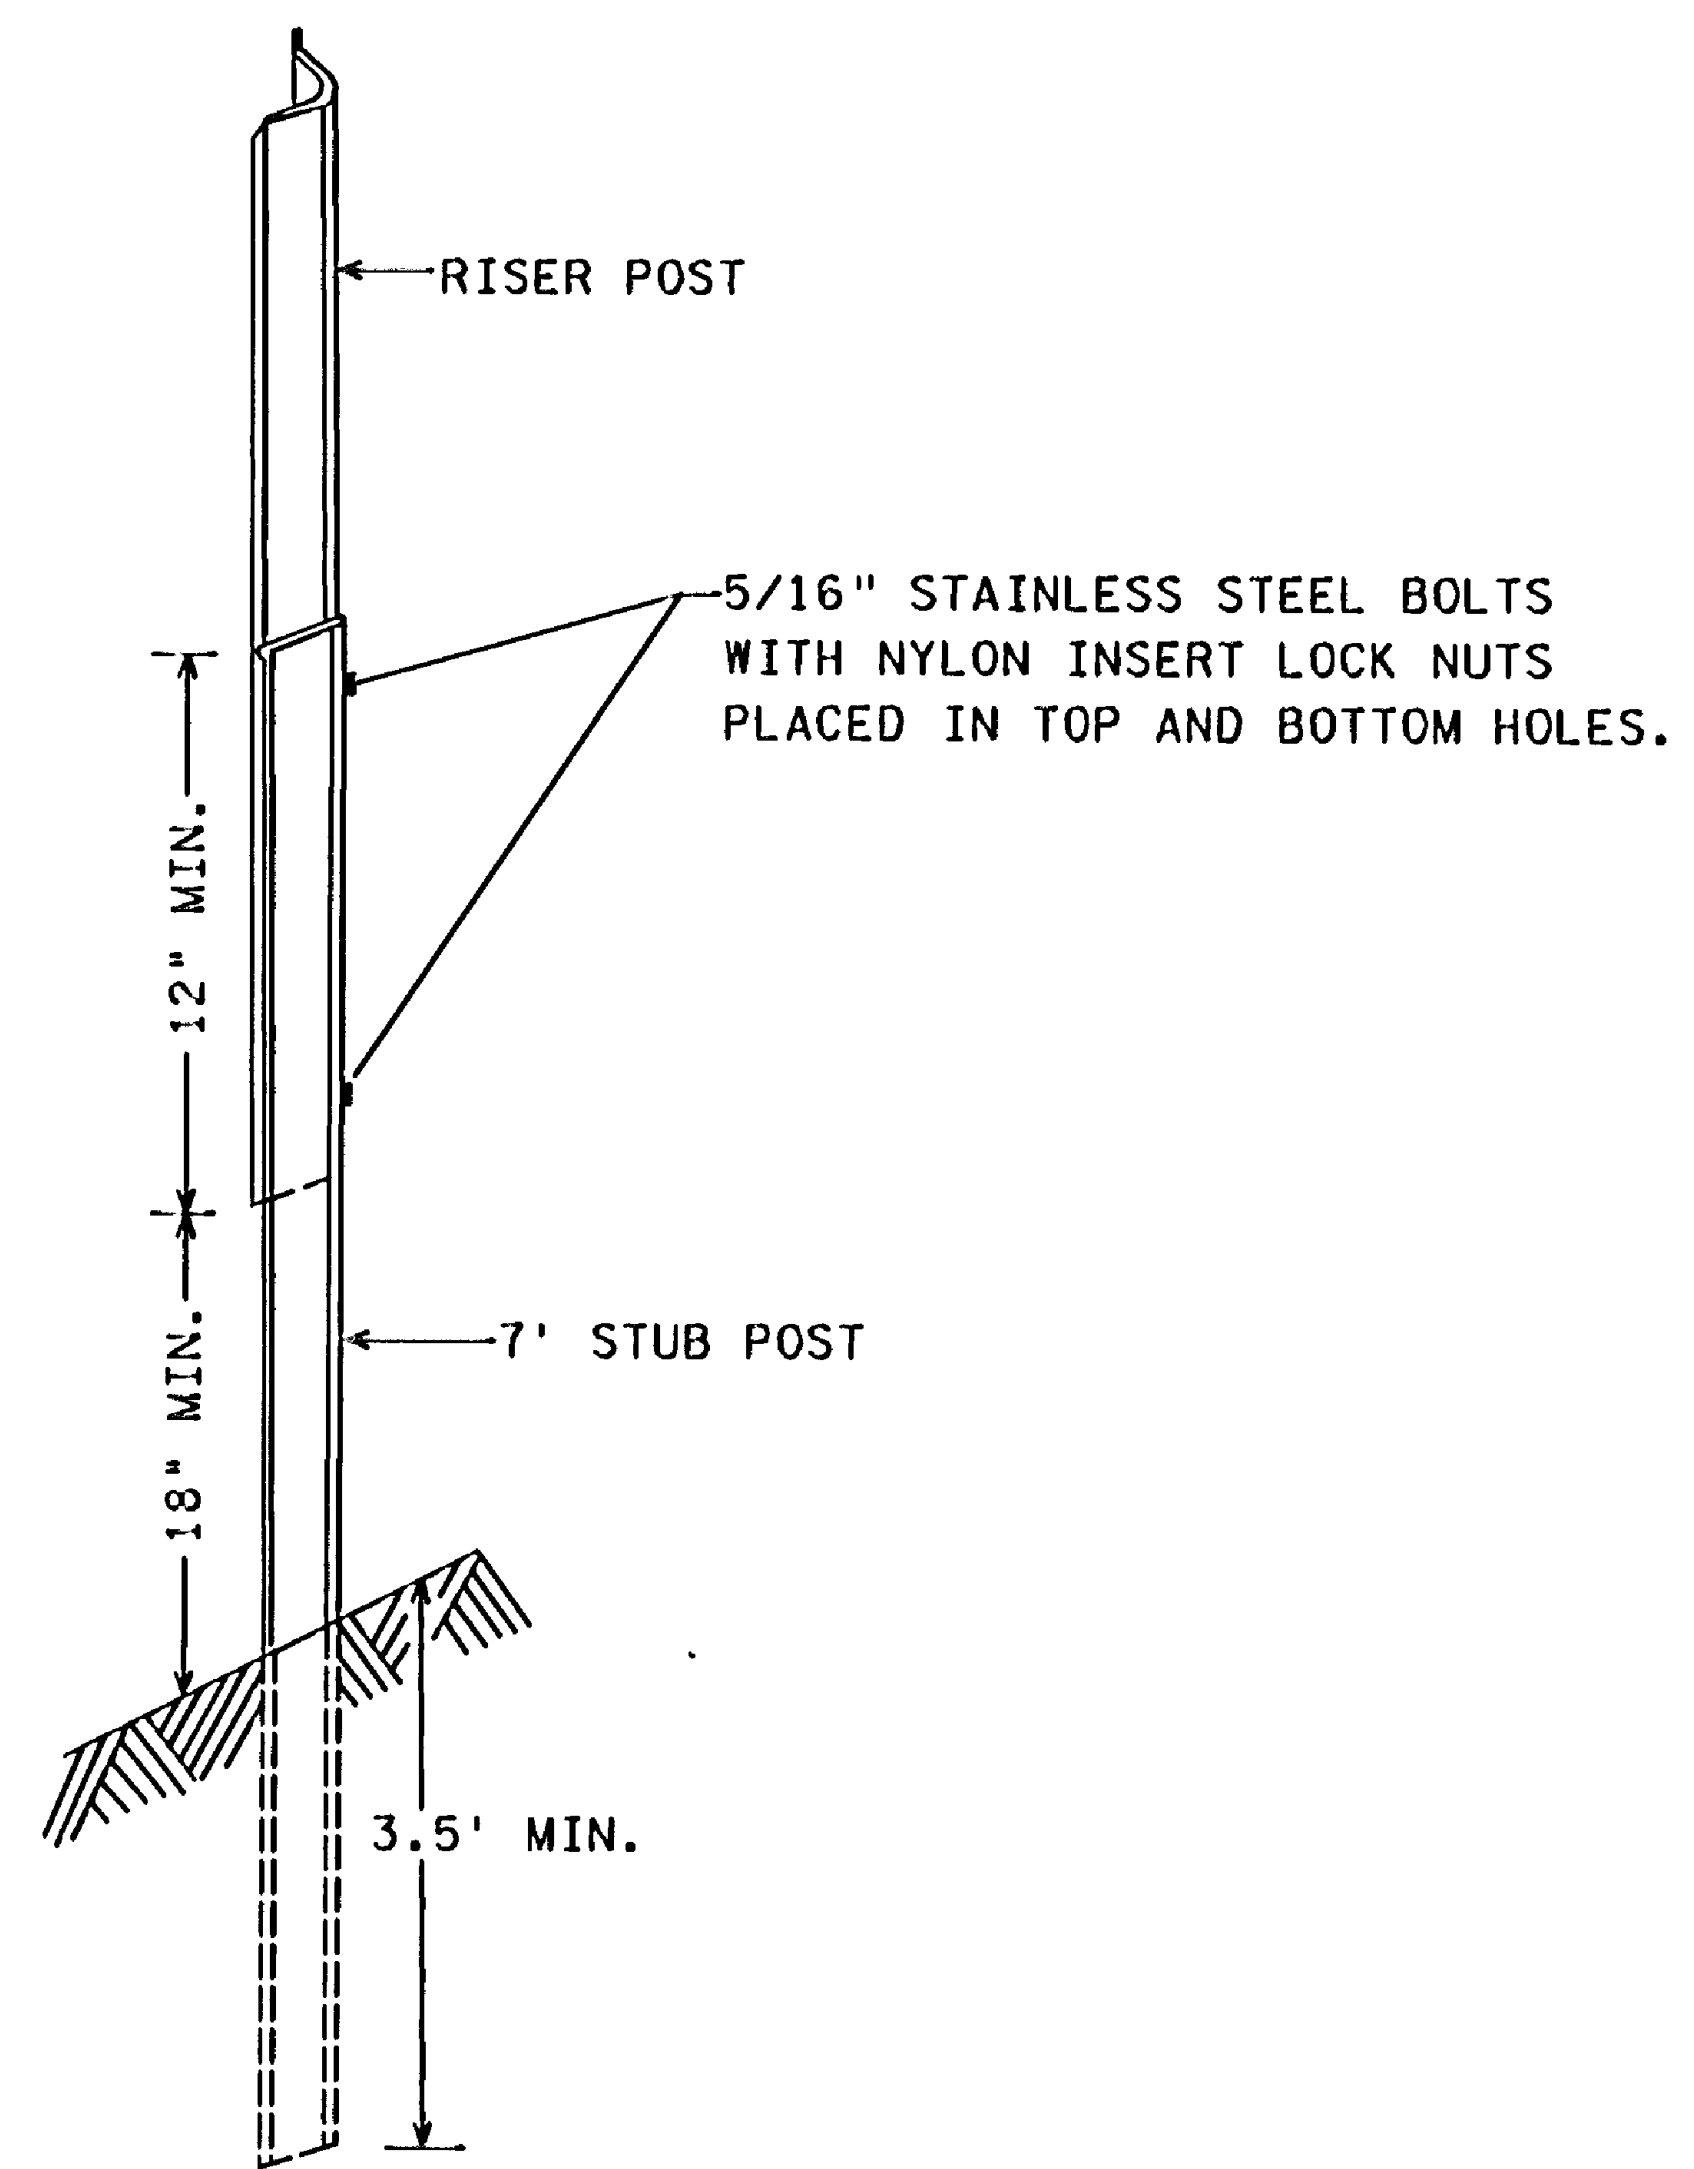


"U POST" SPLICE


STAINLESS STEEL WASHER AND NYLON WASHER
(T= 1/32" MIN., I.D.= 3/8" MAX., O.D.= 7/8" MAX.)

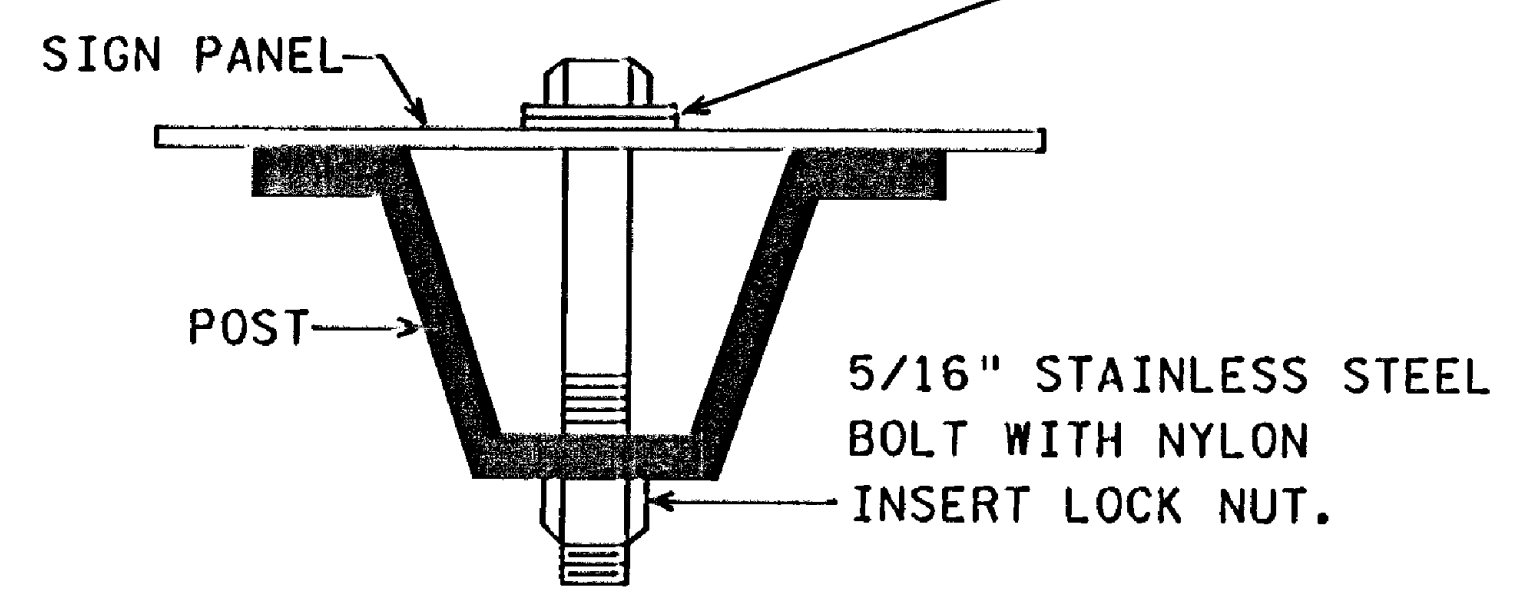

"U POST" MOUNTING
TYPE "C" SIGNS

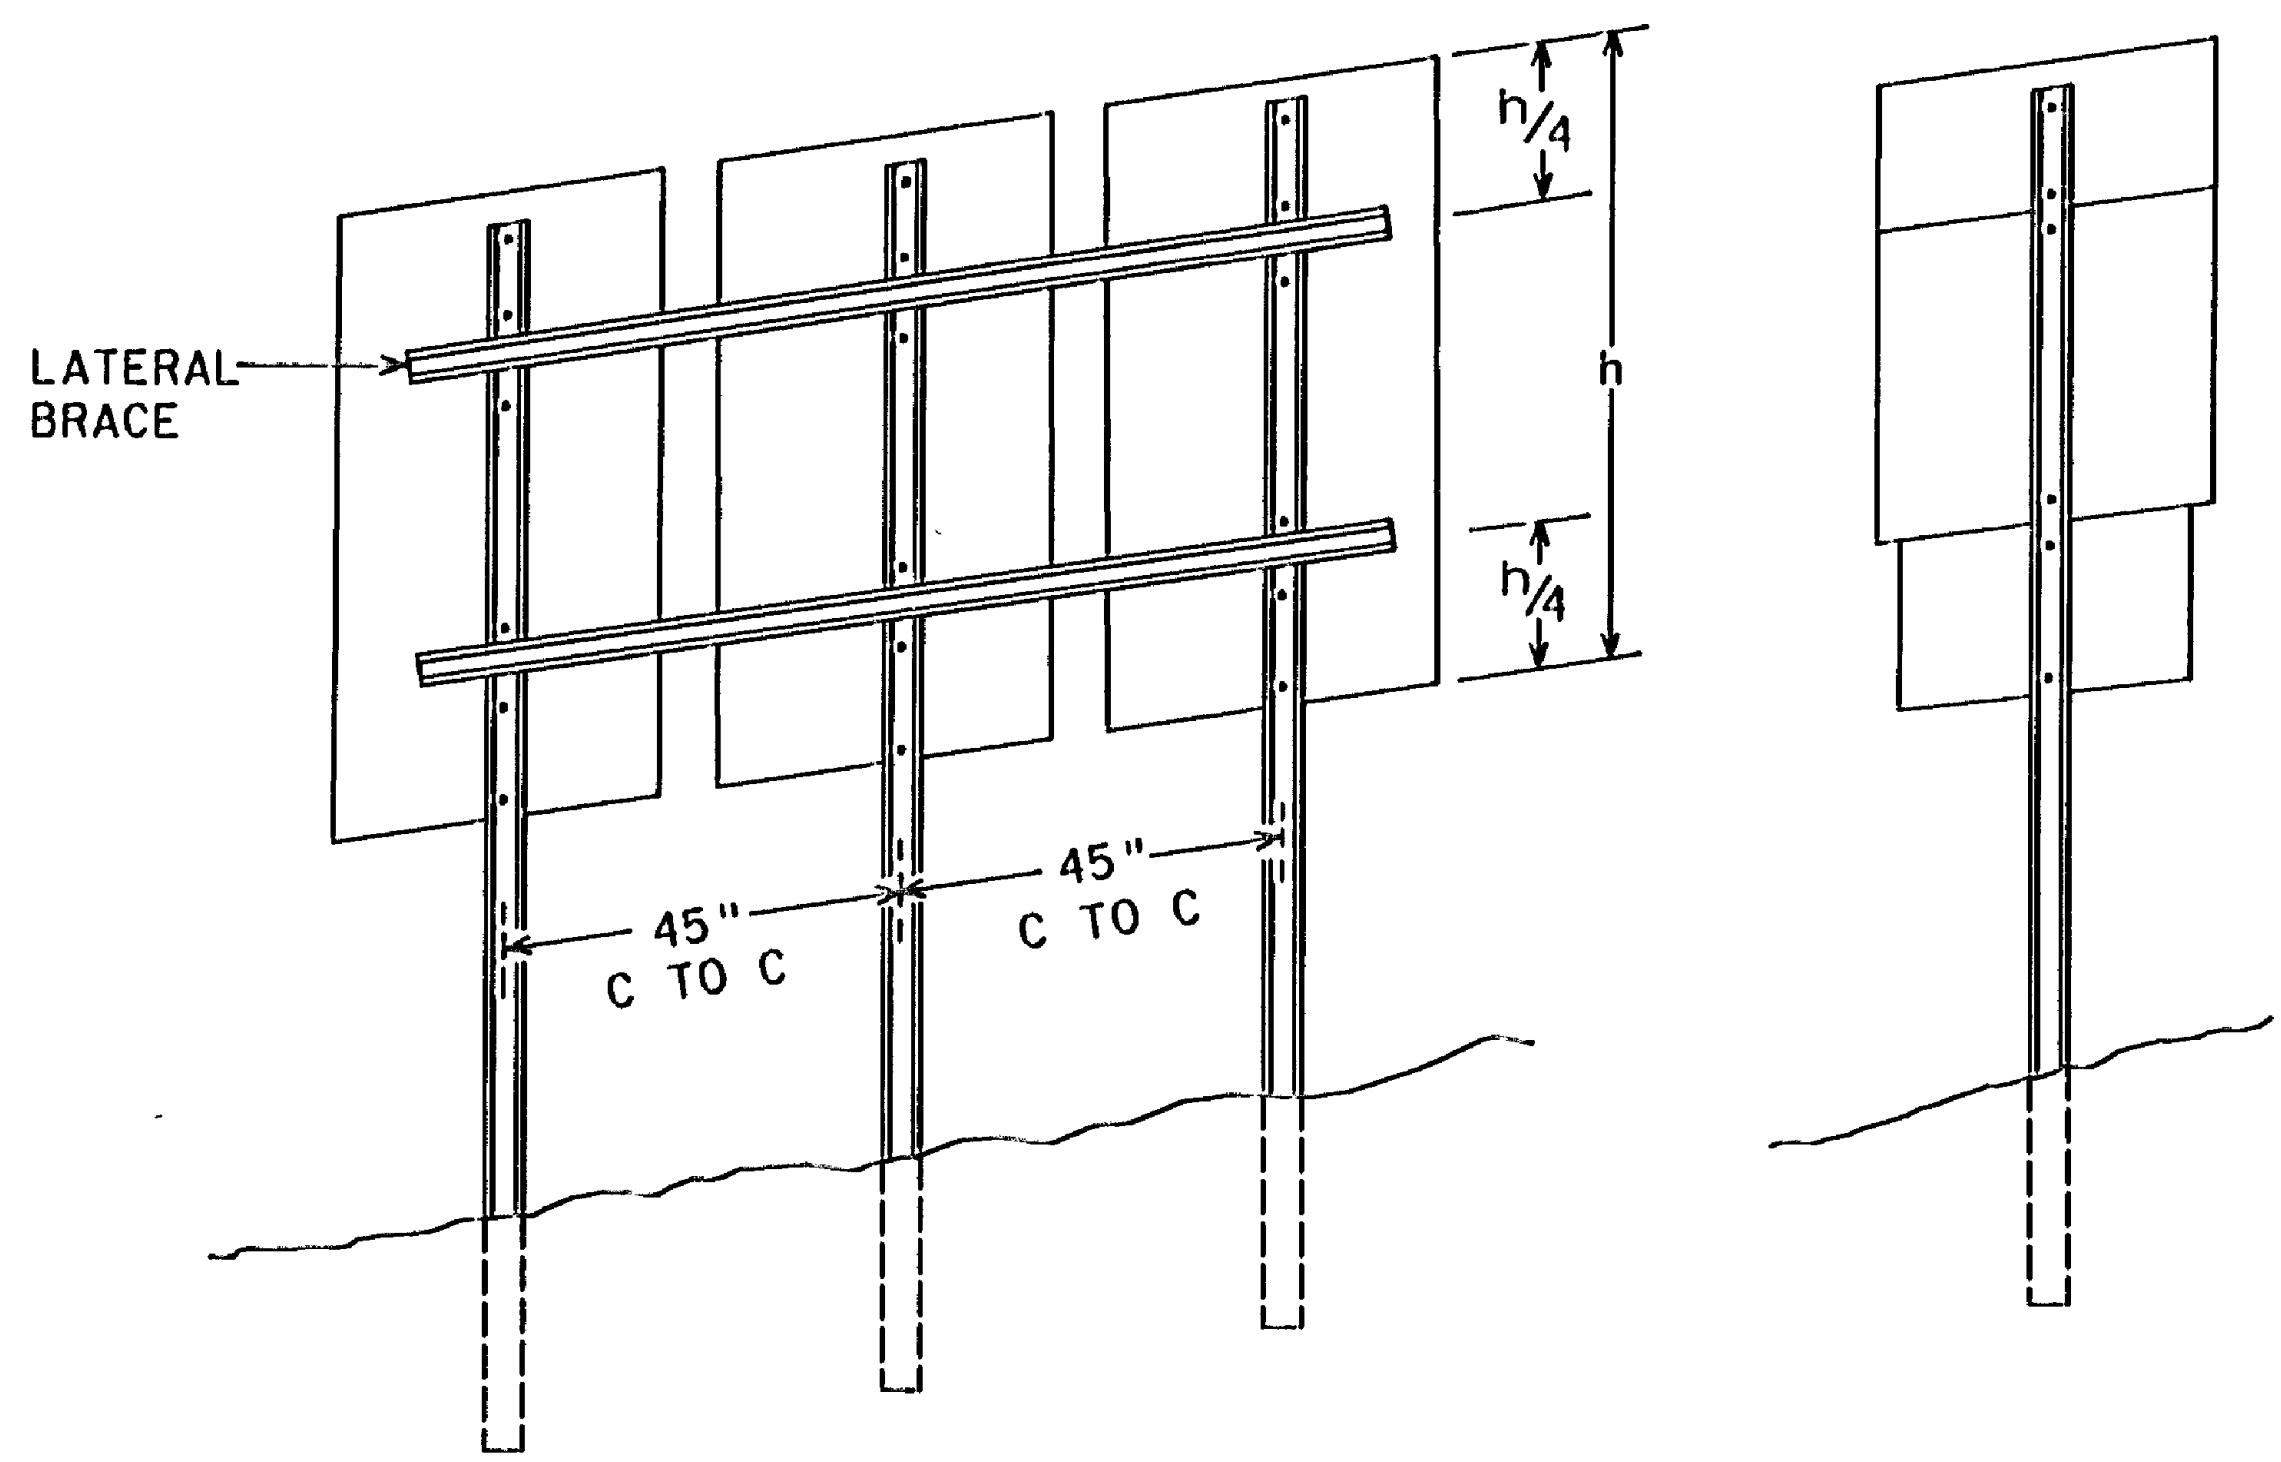

TYPICAL TYPE "C" INSTALLATIONS

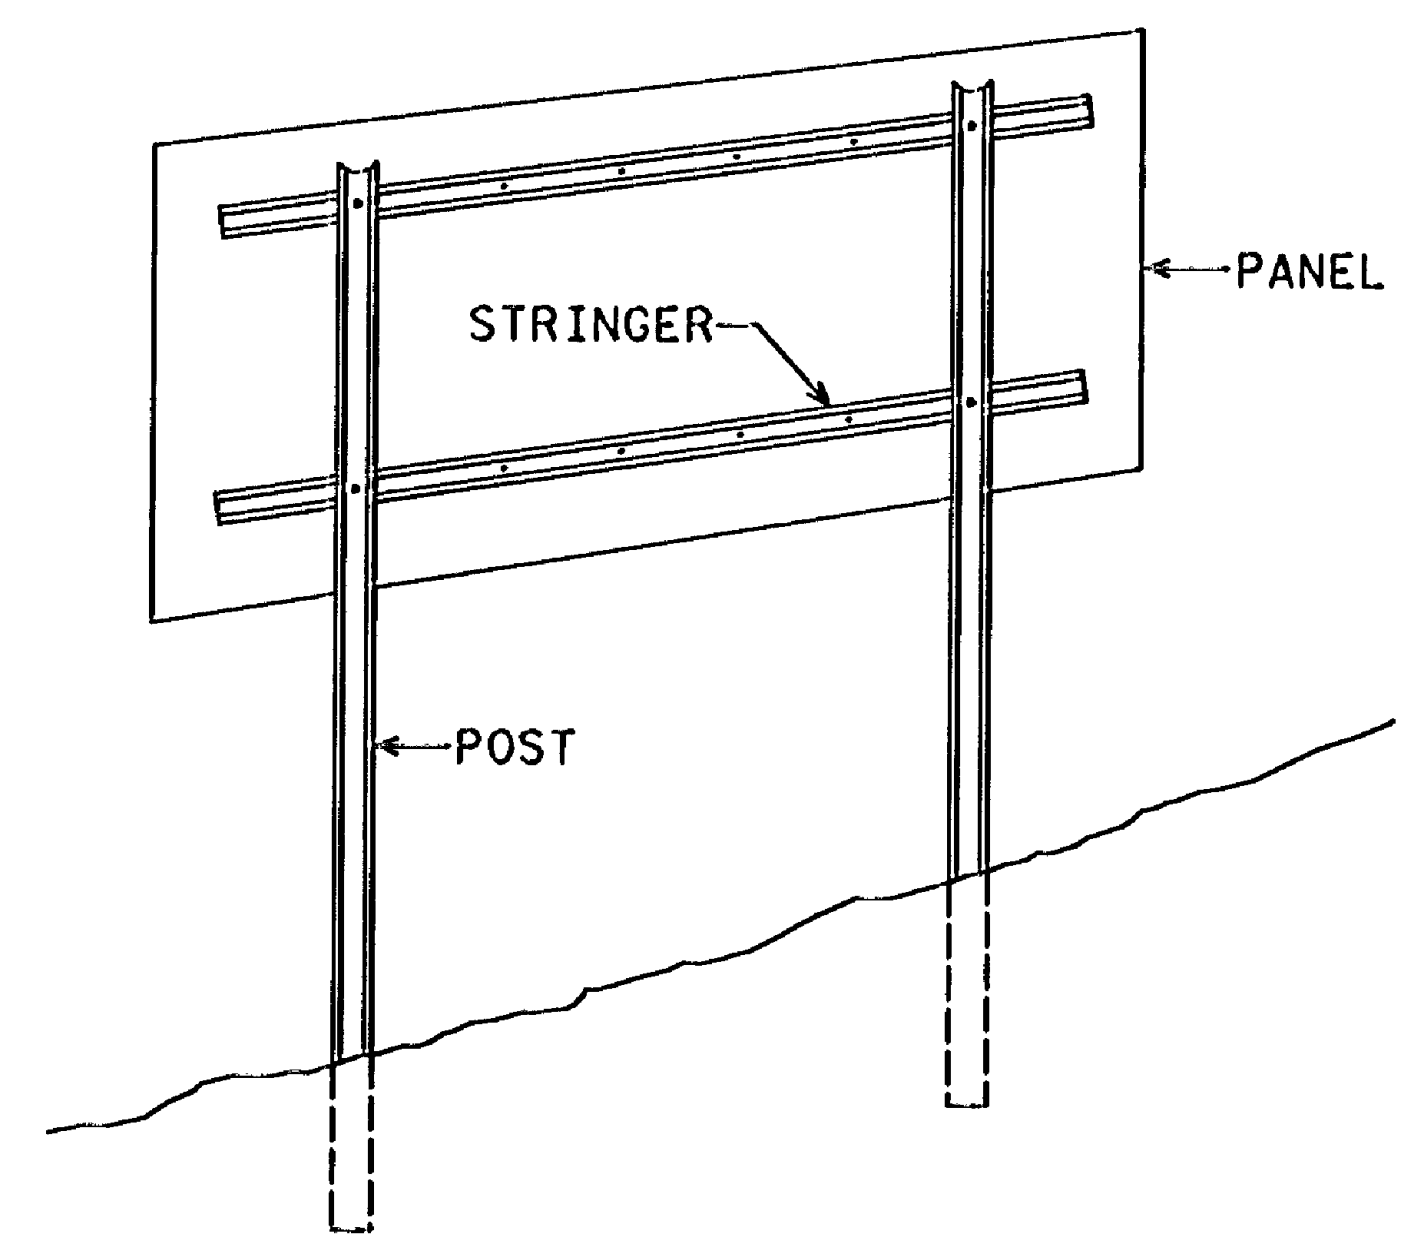

TYPICAL TYPE "D" INSTALLATION

NOTES:


1. USE 3# STUB POSTS, RISER POSTS, STRINGERS, KNEE BRACES, LATERAL BRACES AND KNEE BRACE STUB POSTS. ALL SHALL CONFORM TO MN/DOT 3401.
2. FOR TYPE "D" SIGN POST LENGTHS AND SPACINGS, SEE SIGN DATA SHEET.
3. TYPE "D" SIGN PANELS SHALL BE BOLTED TO STRINGERS AT 24" MAXIMUM INTERVALS IN ACCORDANCE WITH TYPE "D" STRINGER AND PANEL-JOINT DETAIL (SEE STANDARD SIGNS MANUAL).
4. MOUNTING (PUNCHING CODE) FOR TYPE "C" SIGN PANELS SHALL BE AS INDICATED IN THE STANDARD SIGNS MANUAL UNLESS OTHERWISE SPECIFIED.
5. ALL RISER (VERTICAL) "U POSTS" SHALL BE SPLICED. DRIVEN STUB POSTS SHALL BE AT LEAST 7' LONG.
6. USE STAINLESS STEEL 5/16" BOLTS, WASHERS, AND NYLON INSERT LOCK NUTS AS SHOWN FOR ALL GROUND MOUNTED AND OVERHEAD MOUNTED SIGNS.
7. STAINLESS STEEL WASHER WITH SAME DIMENSIONS SHALL BE PROVIDED BETWEEN ALL NYLON WASHERS AND BOLT HEADS.
8. BRACING STUBS SHALL BE NO MORE THAN 4" ABOVE GROUND AND EMBEDDED AT LEAST 3 1/2'.
9. A-FRAME BRACKET SHALL BE STEEL CONFORMING TO MN/DOT 3306 AND GALVANIZED IN ACCORDANCE WITH MN/DOT 3394.
10. COLLARS SHALL BE USED TO SHIM OVERLAYS AND DEMOUNTABLE LEGEND AWAY FROM PANEL WHERE INTERFERENCE WITH BOLT HEADS IS ENCOUNTERED. MN/DOT 3352.2A7.
11. 2 AND 3 POST TYPE "C" SIGNS SHALL BE REINFORCED WITH AT LEAST ONE LATERAL BRACE. INSTALLATIONS WHERE THE TOTAL PANEL HEIGHT IS 60" OR MORE SHALL HAVE TWO LATERAL BRACES LOCATED APPROXIMATELY AT THE QUARTER POINTS.
12. WHERE 2 OR MORE SINGLE POST SIGNS (TYPE "C") ARE MOUNTED SIDE BY SIDE, THEY SHALL BE REINFORCED Laterally BY AT LEAST 2 POST SECTIONS, BOLTED AT EACH POST AND LOCATED APPROXIMATELY AT THE QUARTER POINTS AS SHOWN IN SKETCH.

"C" & "D" SIGN DETAILS


DESIGN A
Sheet 1 of 3

NOTE: THIS SHEET IN ENGLISH UNITS


CUSTOM STR 001 6-9-94

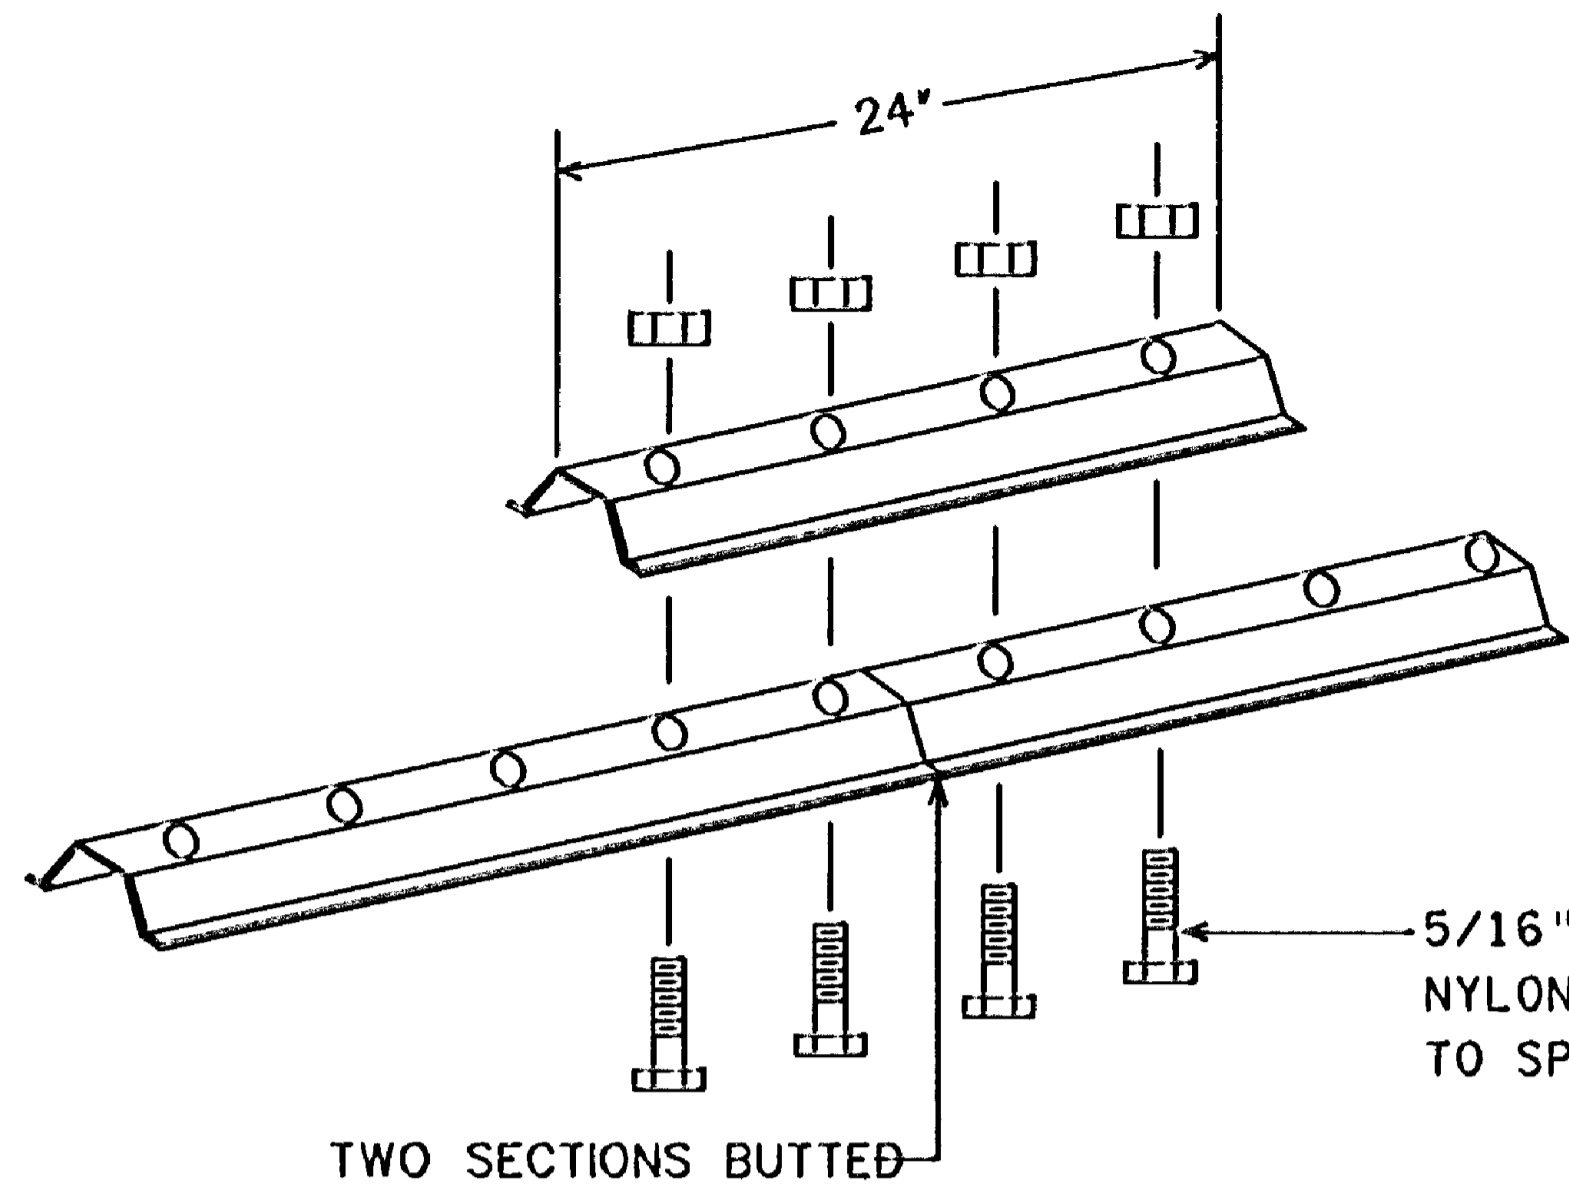

Lateral Brace or Stringer. Splice Detail (Exploded View)

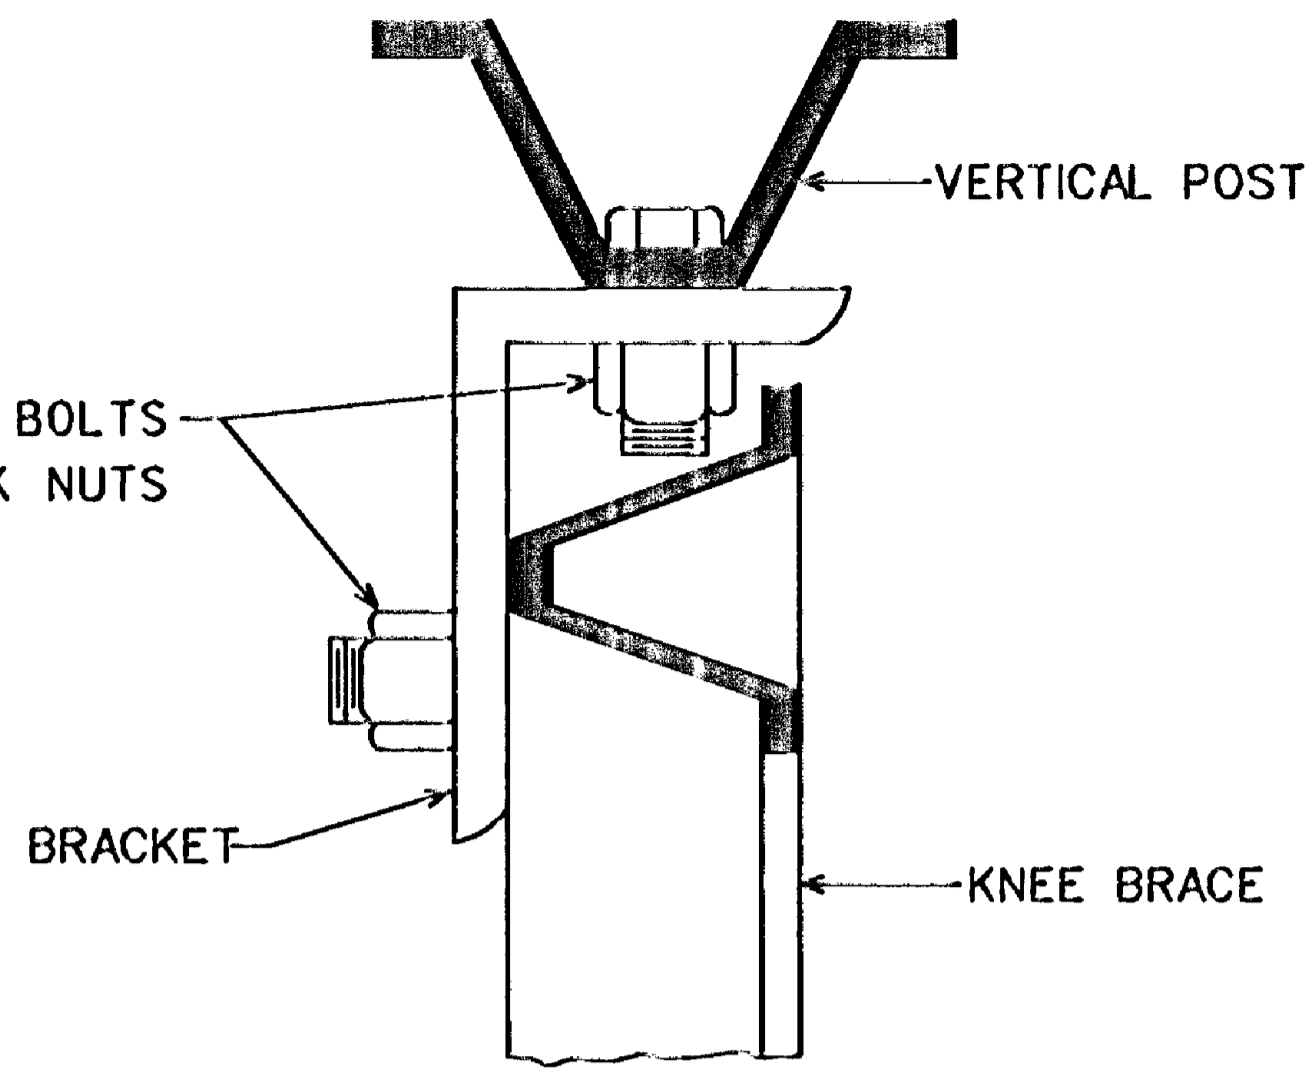


Section A-A

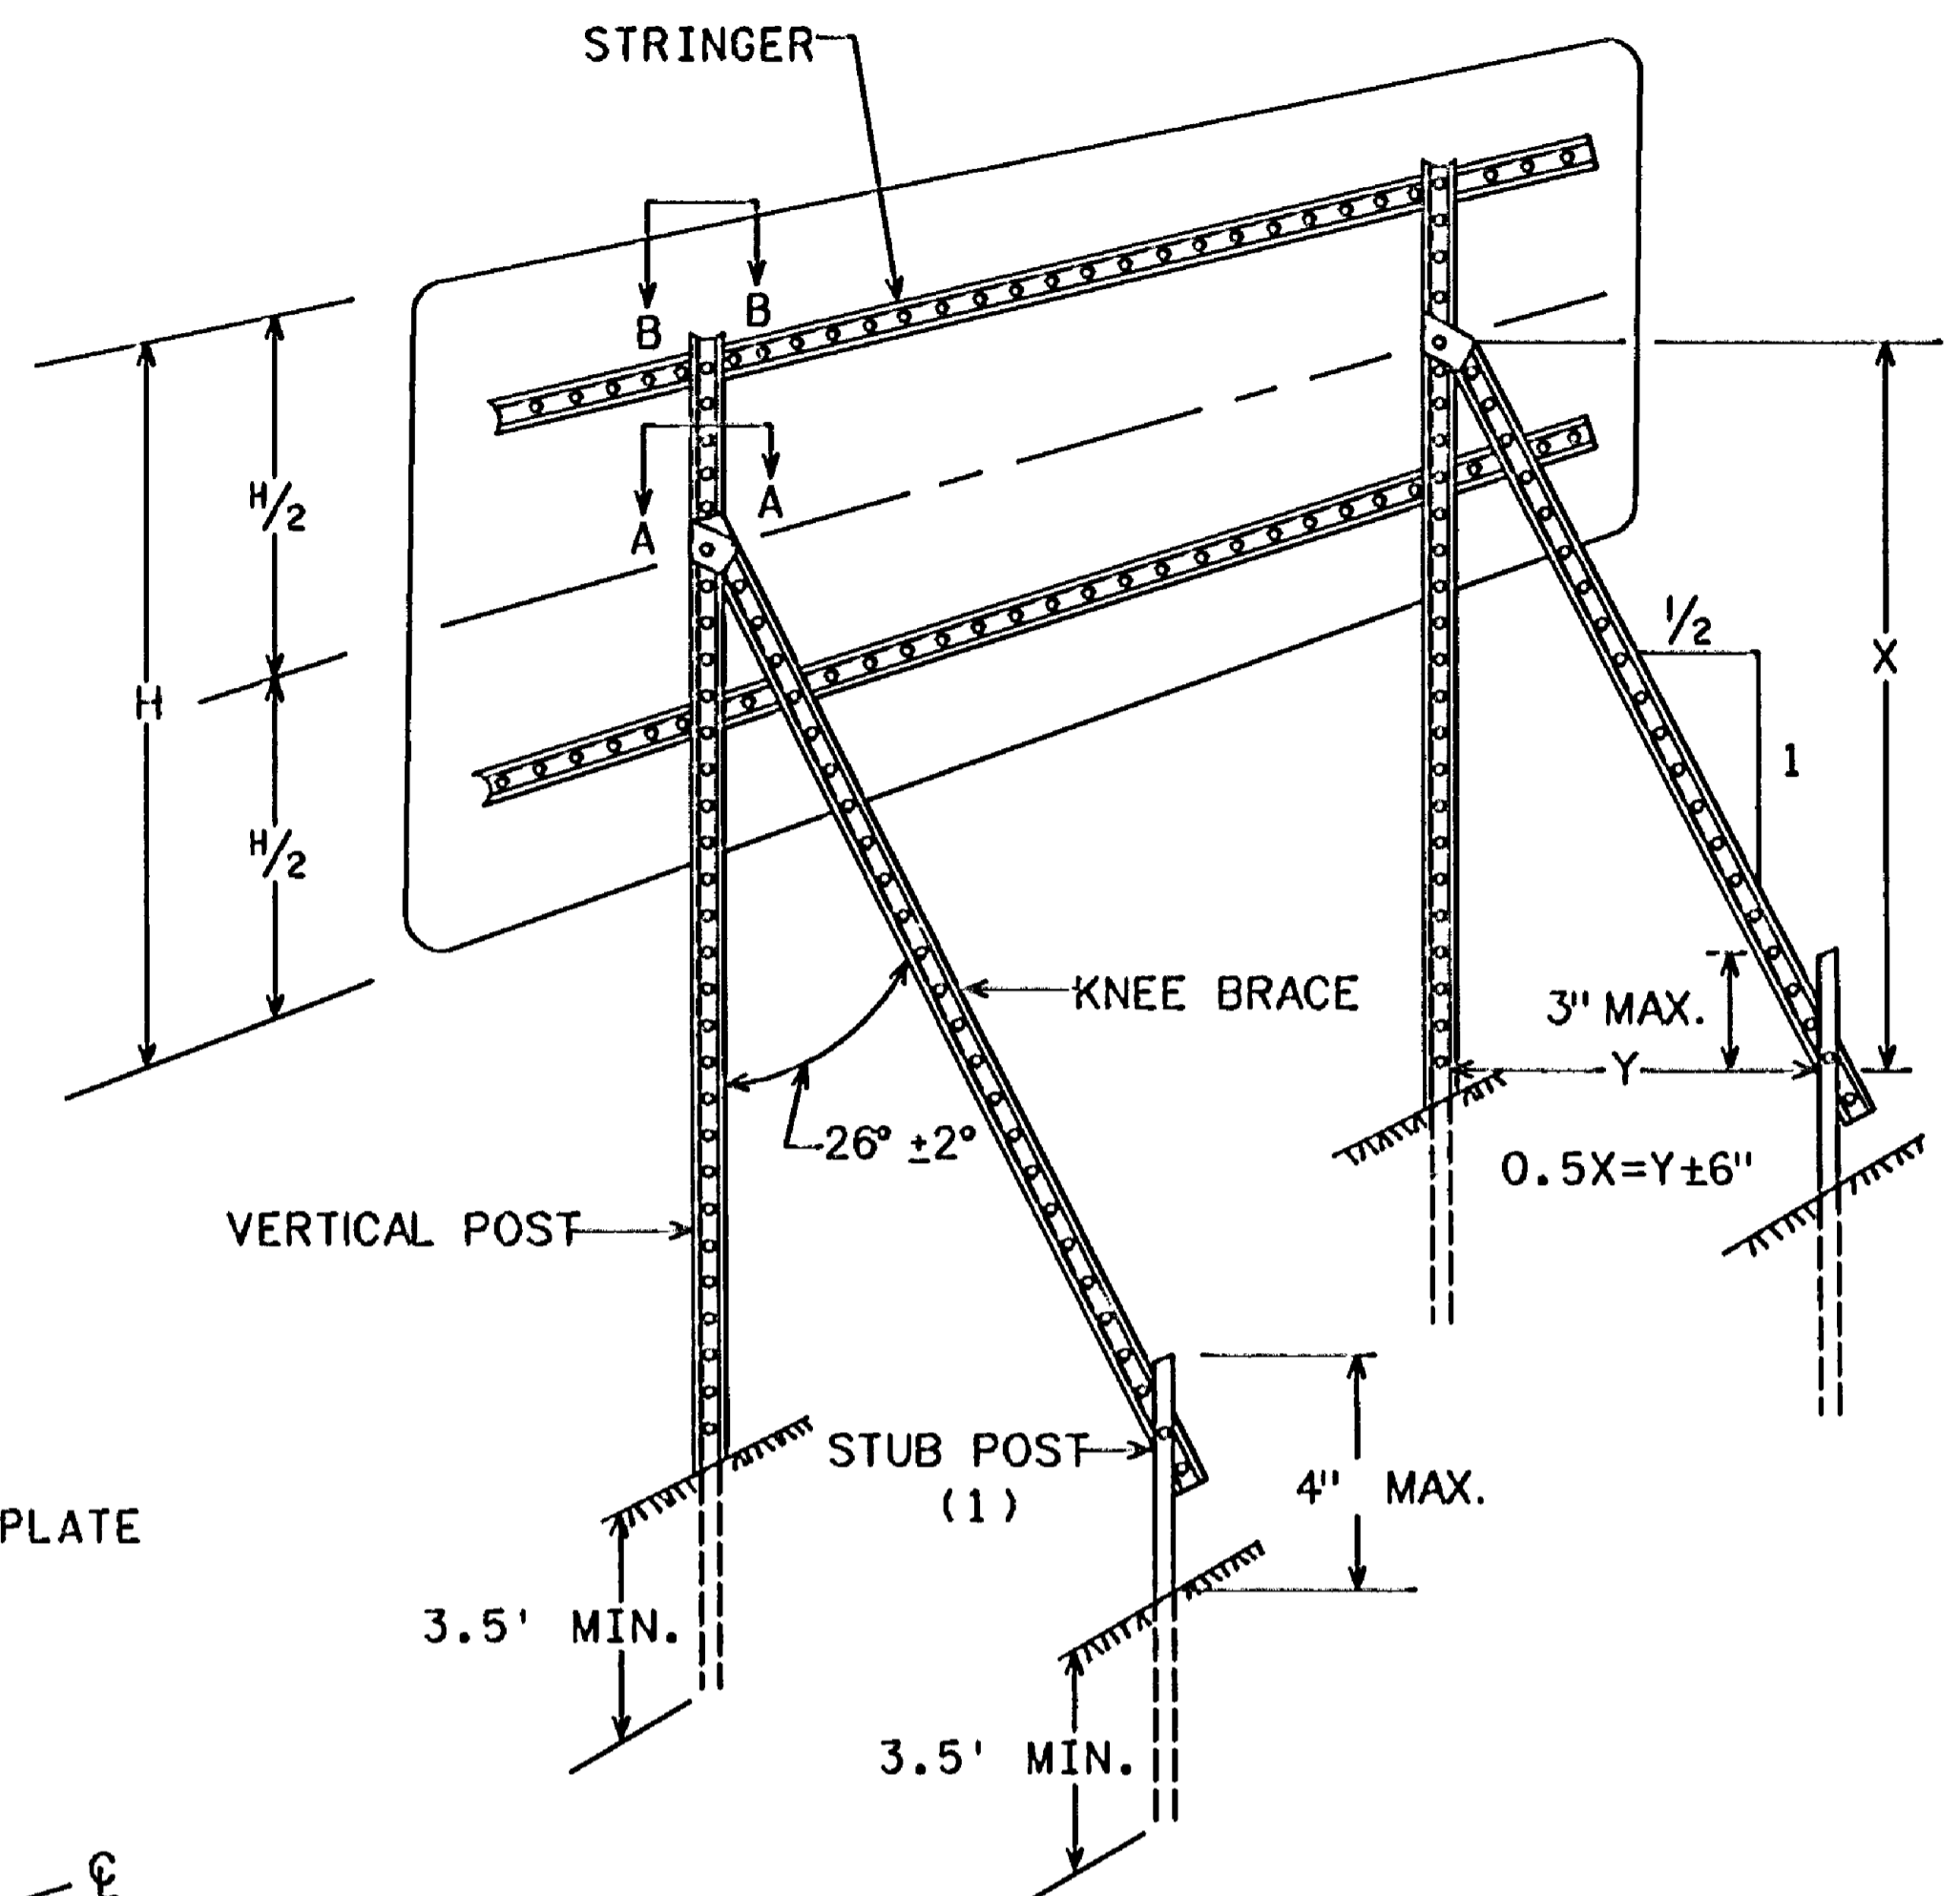


Typical "A-Frame" Installation Type "D" Signs


(1) Offset stub post 1' toward roadway relative to vertical post.

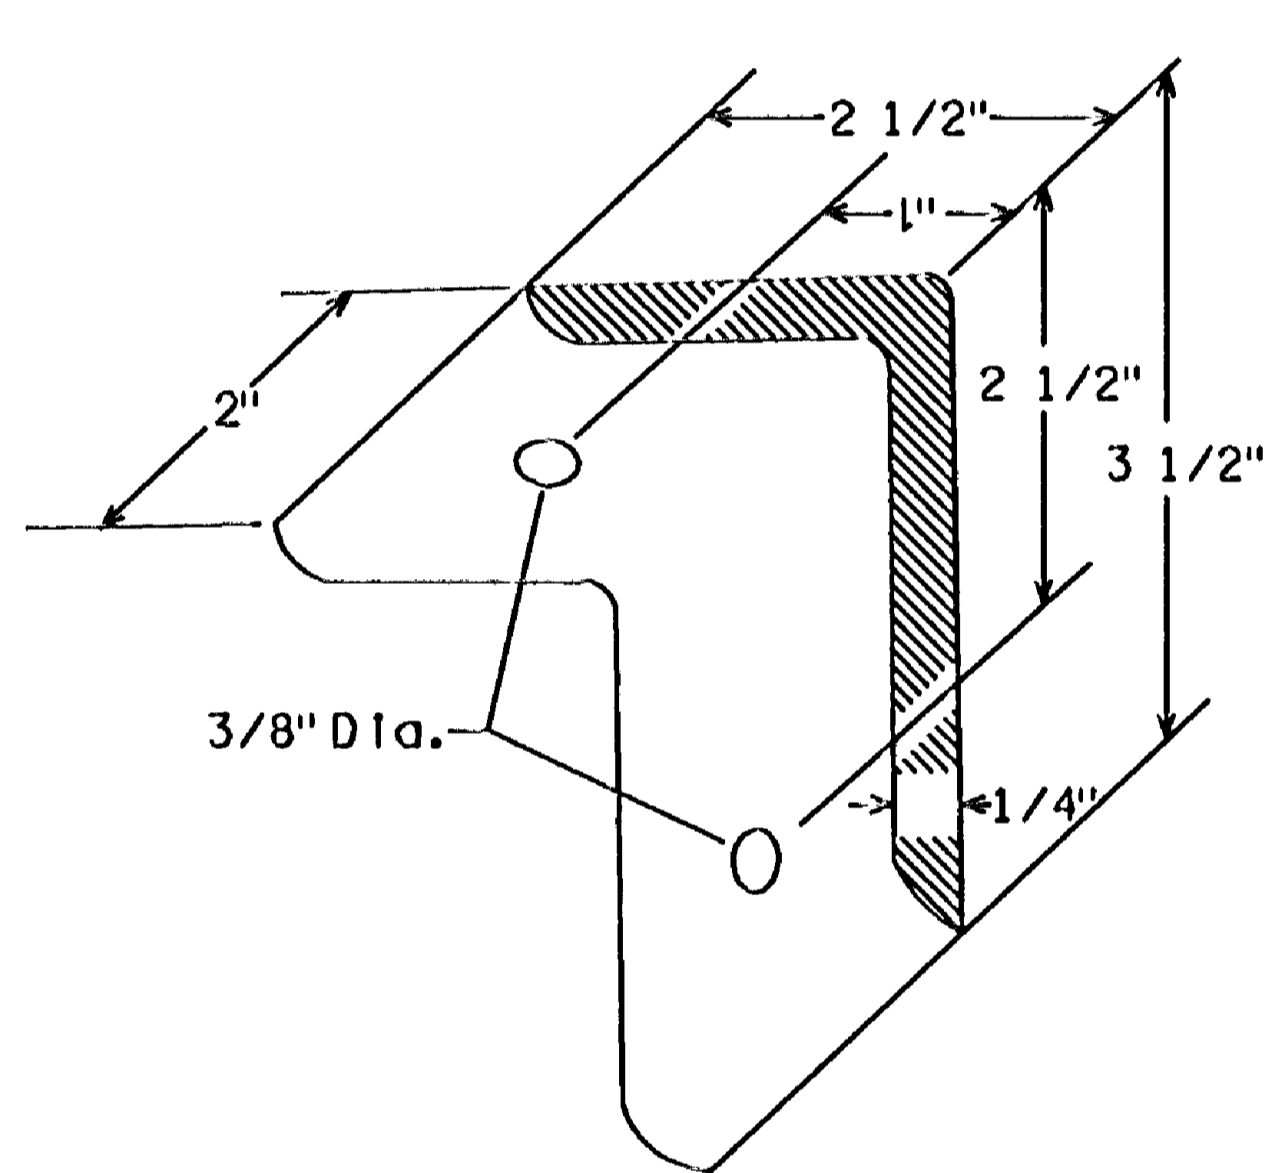


A-Frame Bracket
(Steel Mn/DOT 3306 galvanized per Mn/DOT 3394)

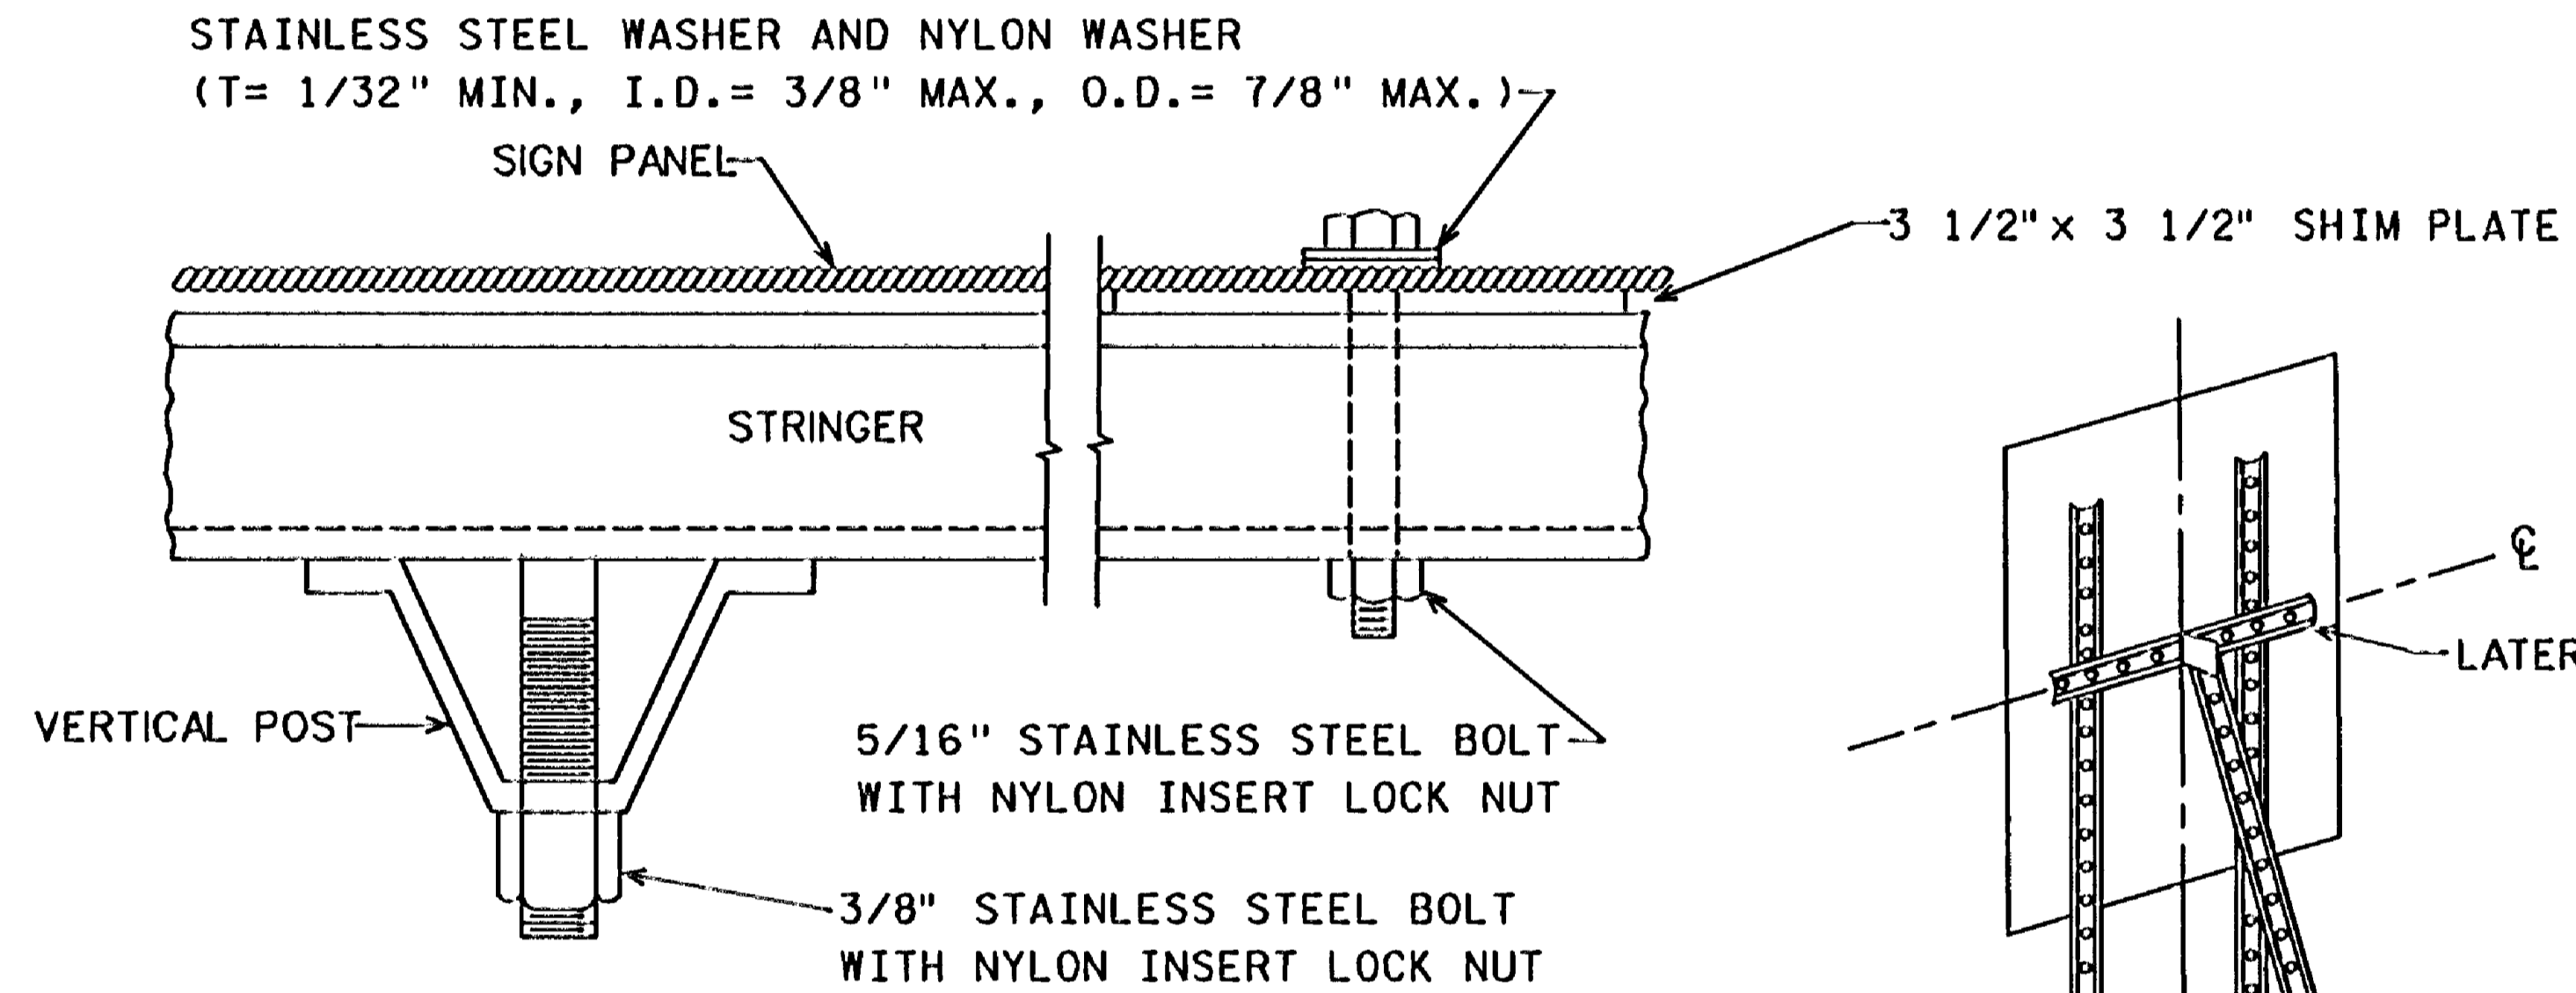


Section B-B

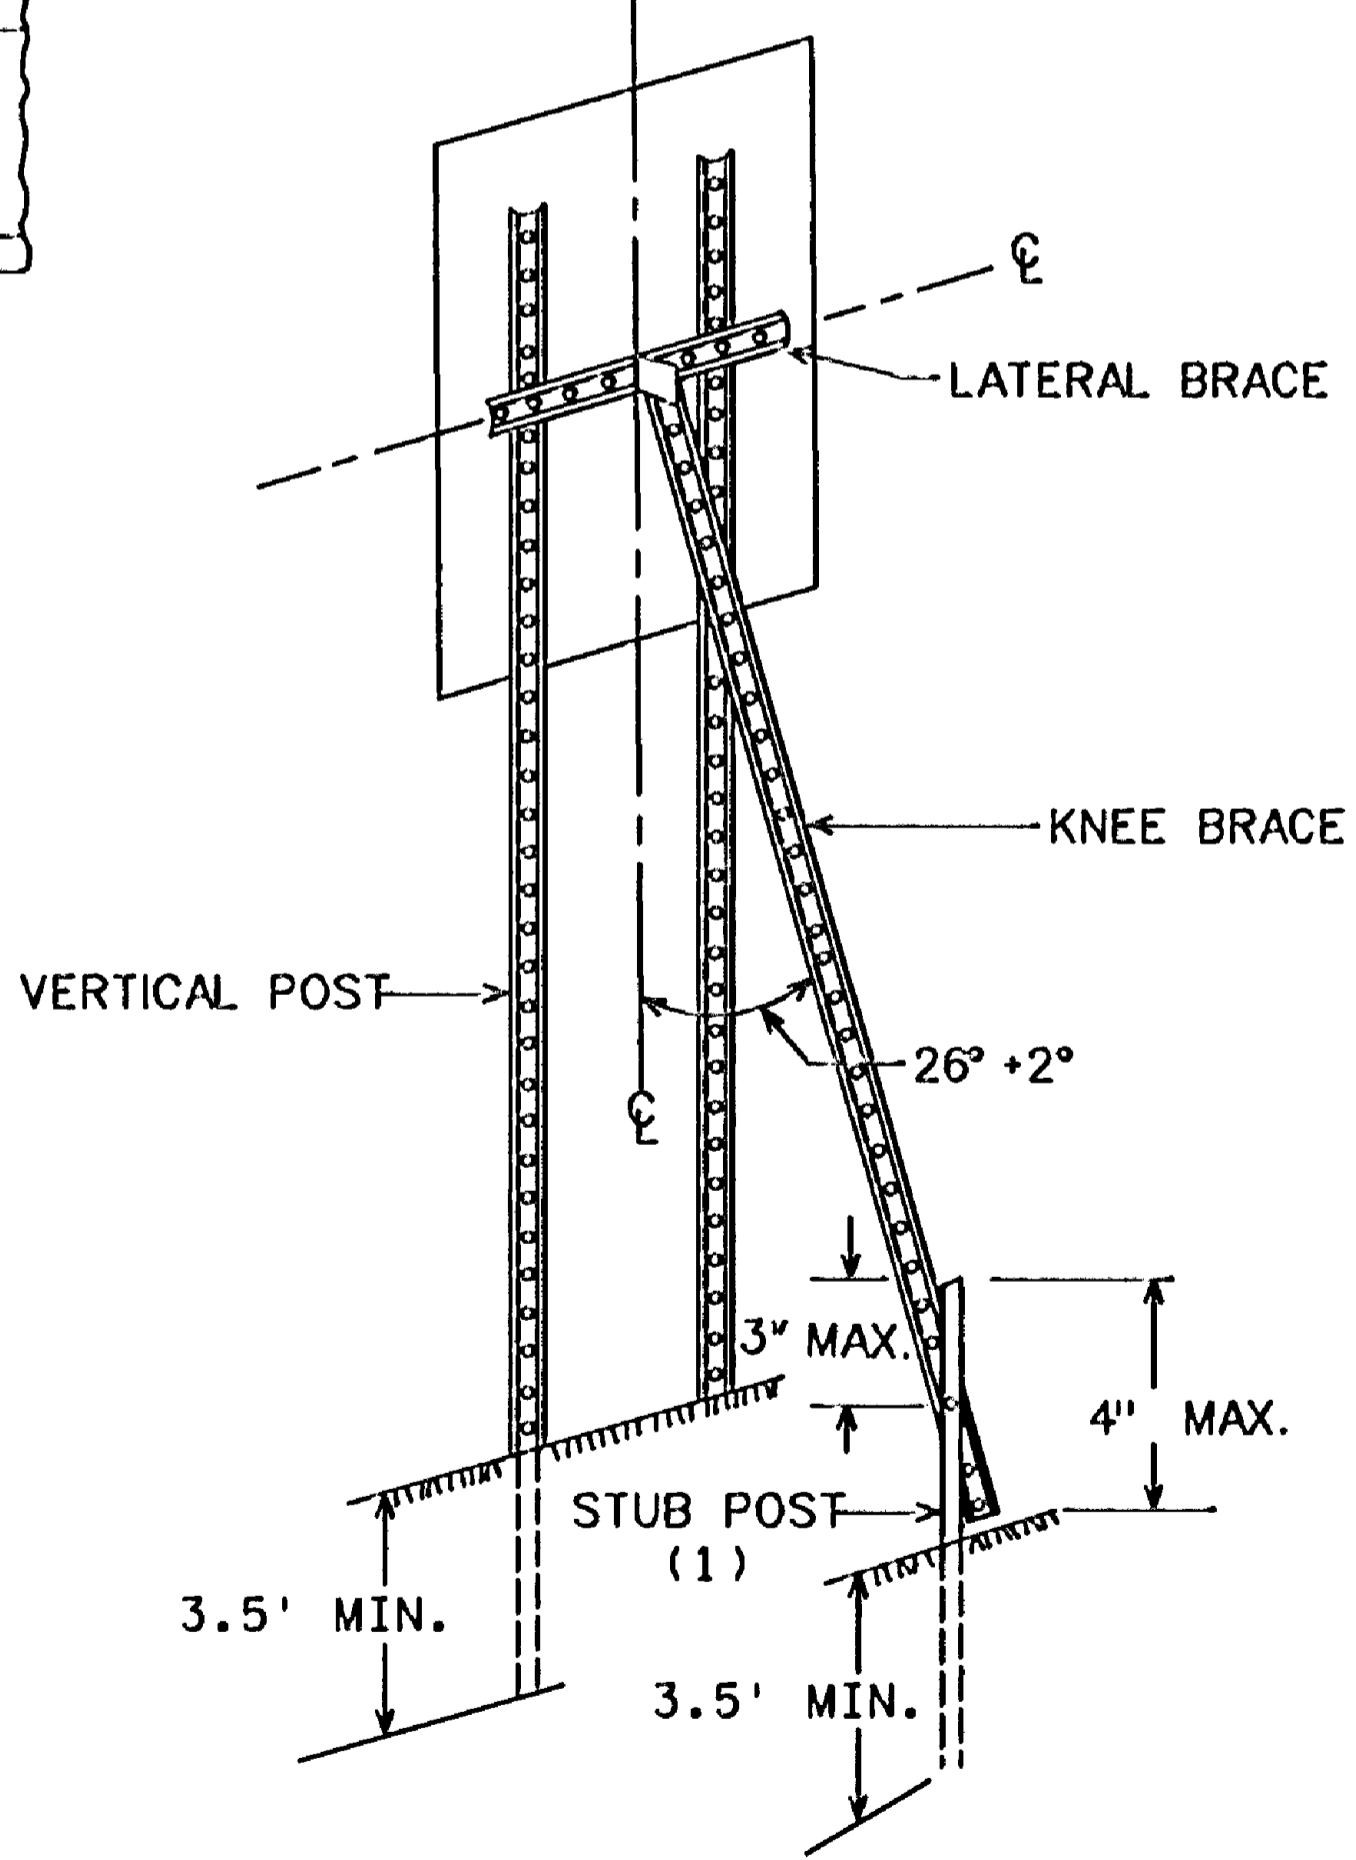

Typical "A-Frame" Installation Type C Signs

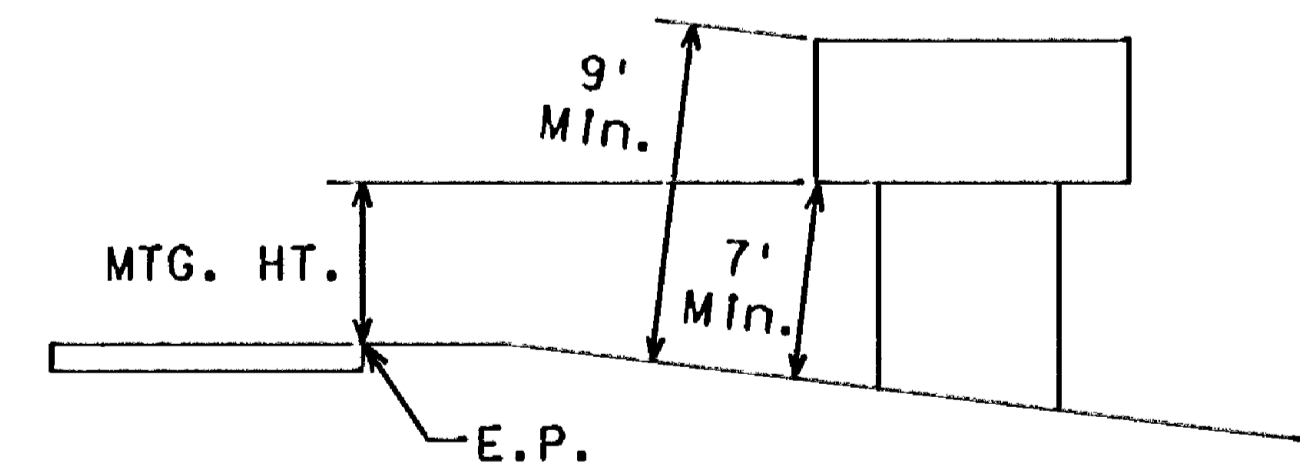

Typical Mounting

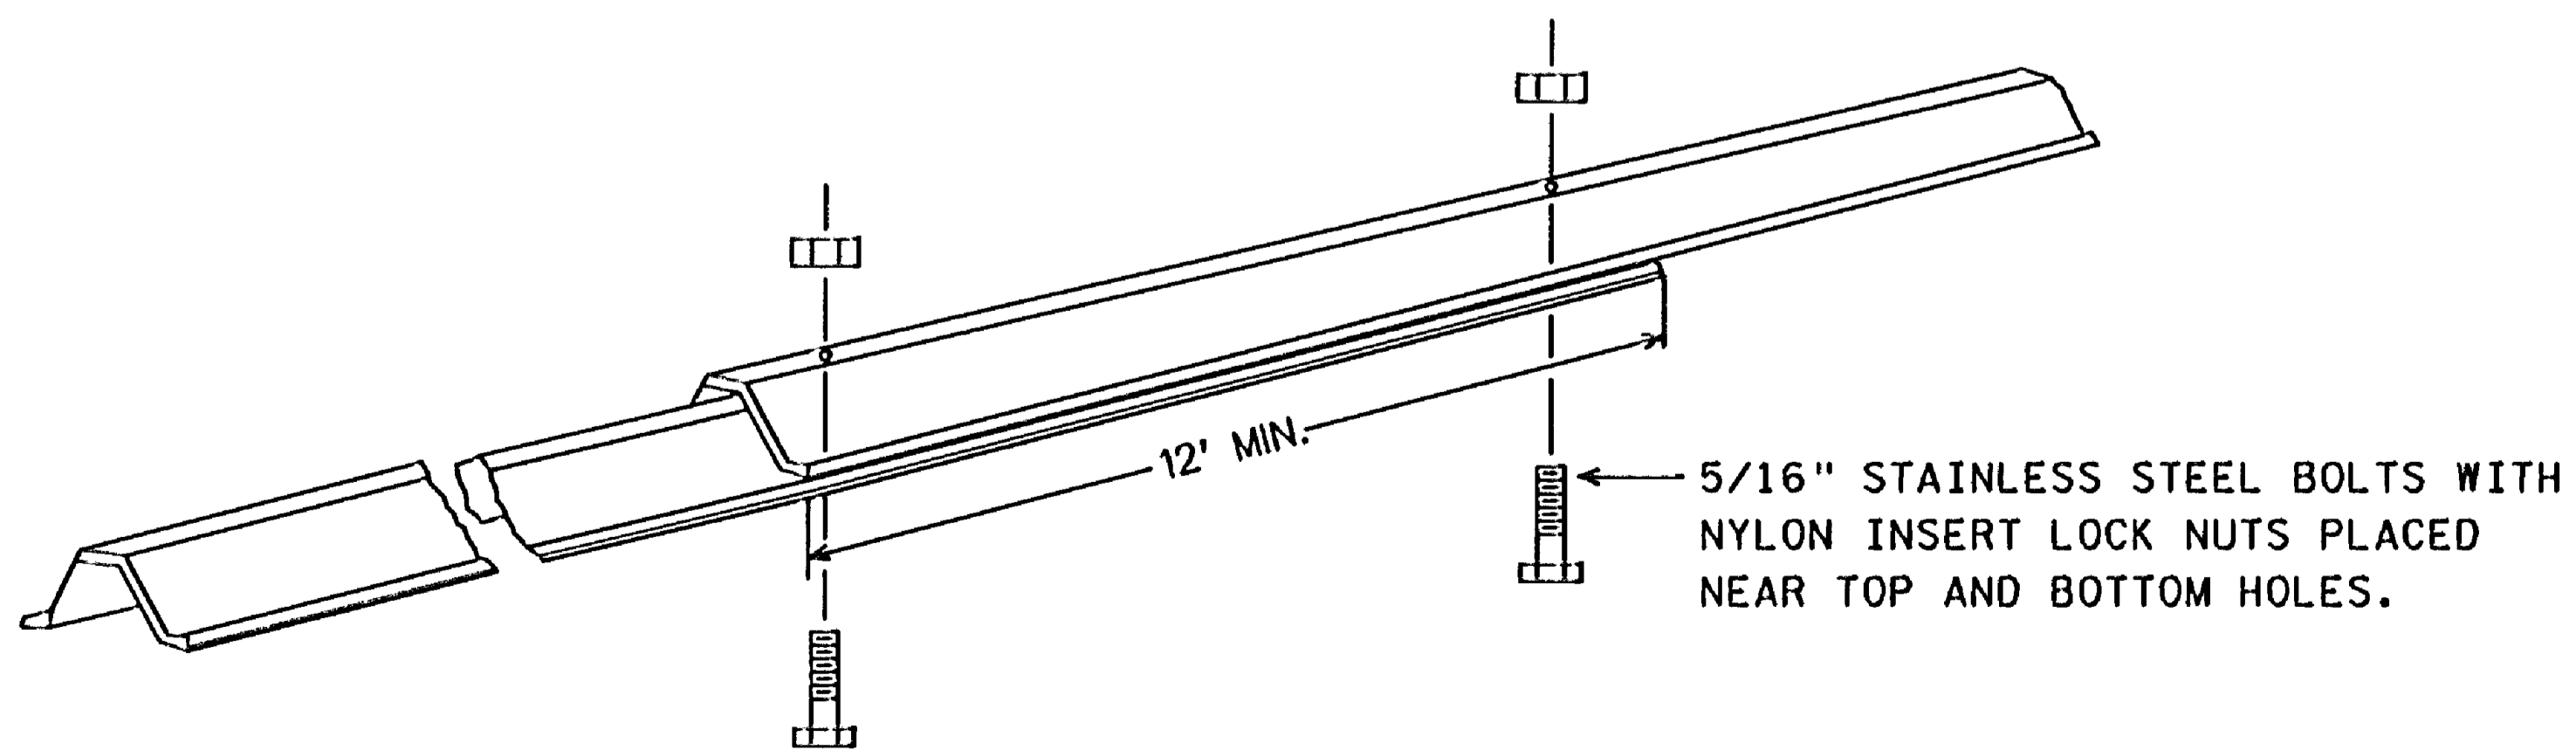

Knee Brace Splice

Rev. 3-31-93
Rev. 3-23-90


NOTE: THIS SHEET IN ENGLISH UNITS

S.A.P. 02-617-11, et al.


"C" & "D" SIGN DETAILS

DESIGN A
Sheet 2 of 3


Sheet No. 106 of 236 Sheets

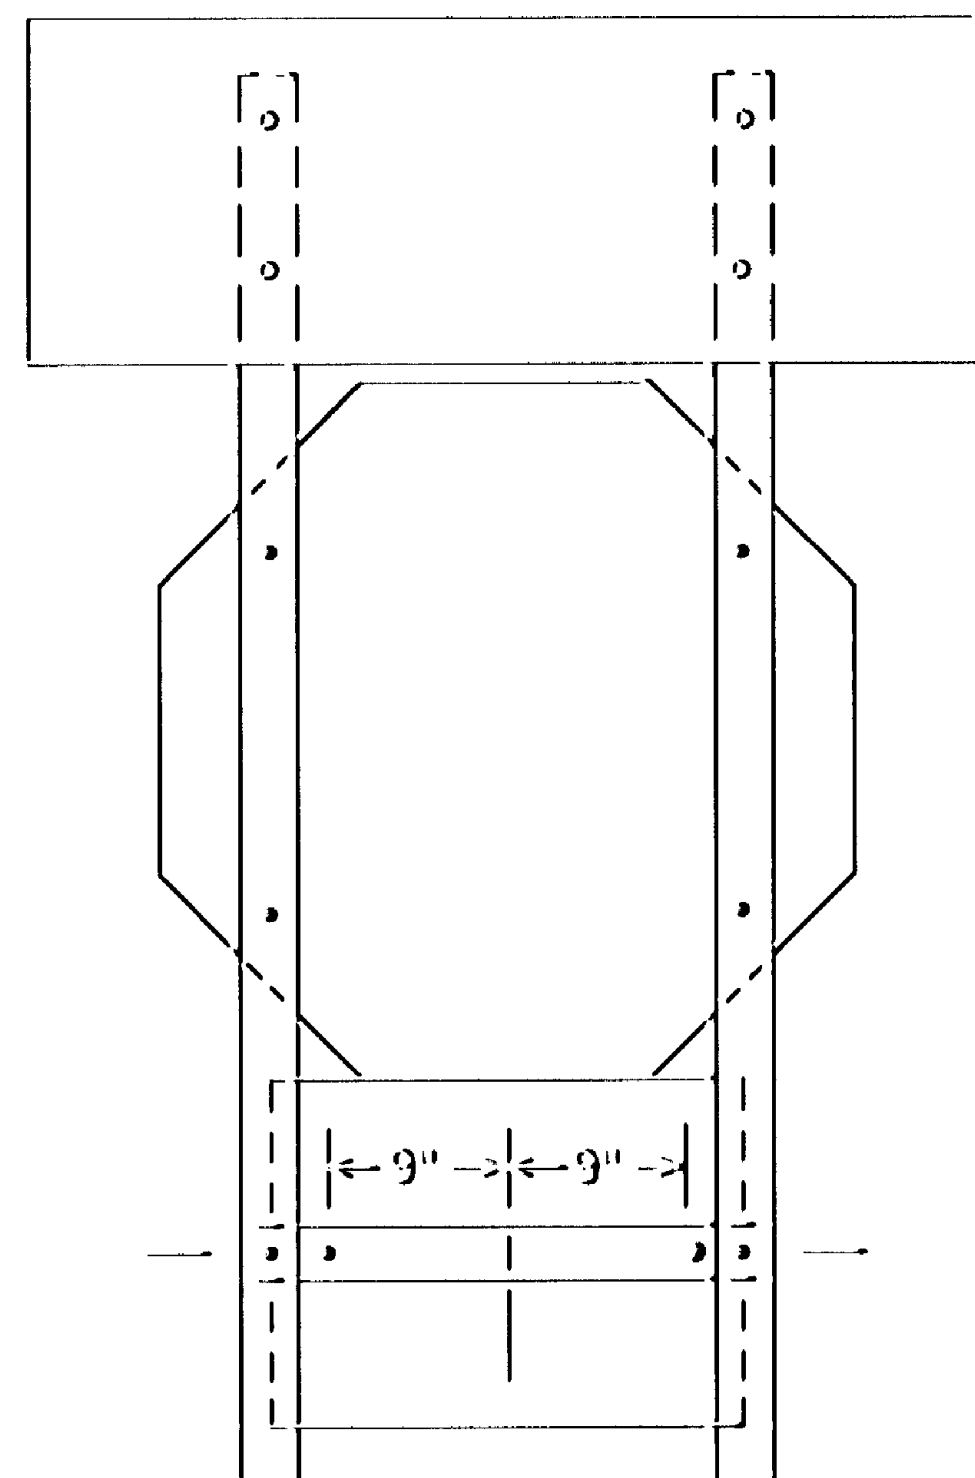


R6-1, R1-1 & (R6-3 or R6-3a)
Mounting

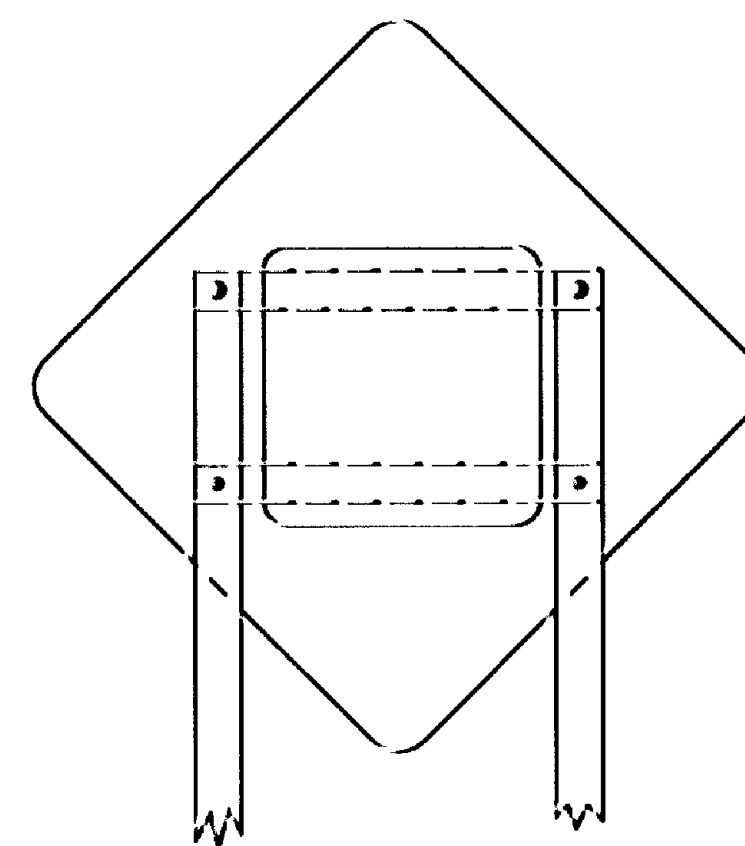


Back to back mounting
of R4-7 and W9-2

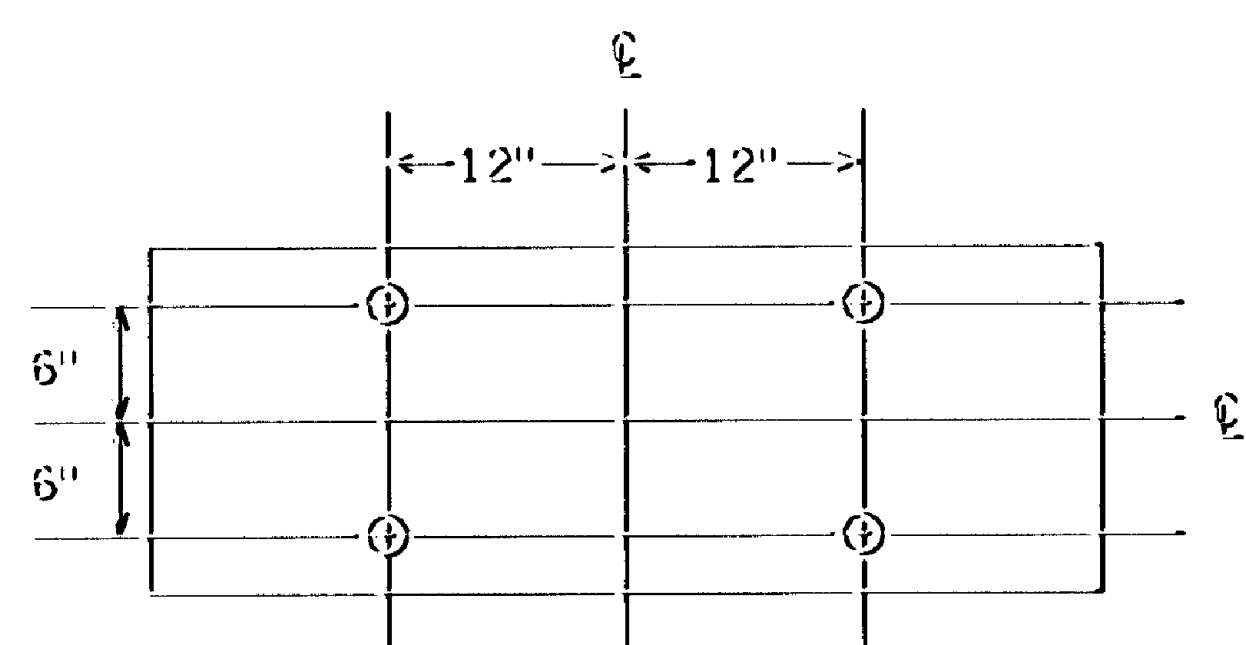


Punching for R6-1 (48x18")

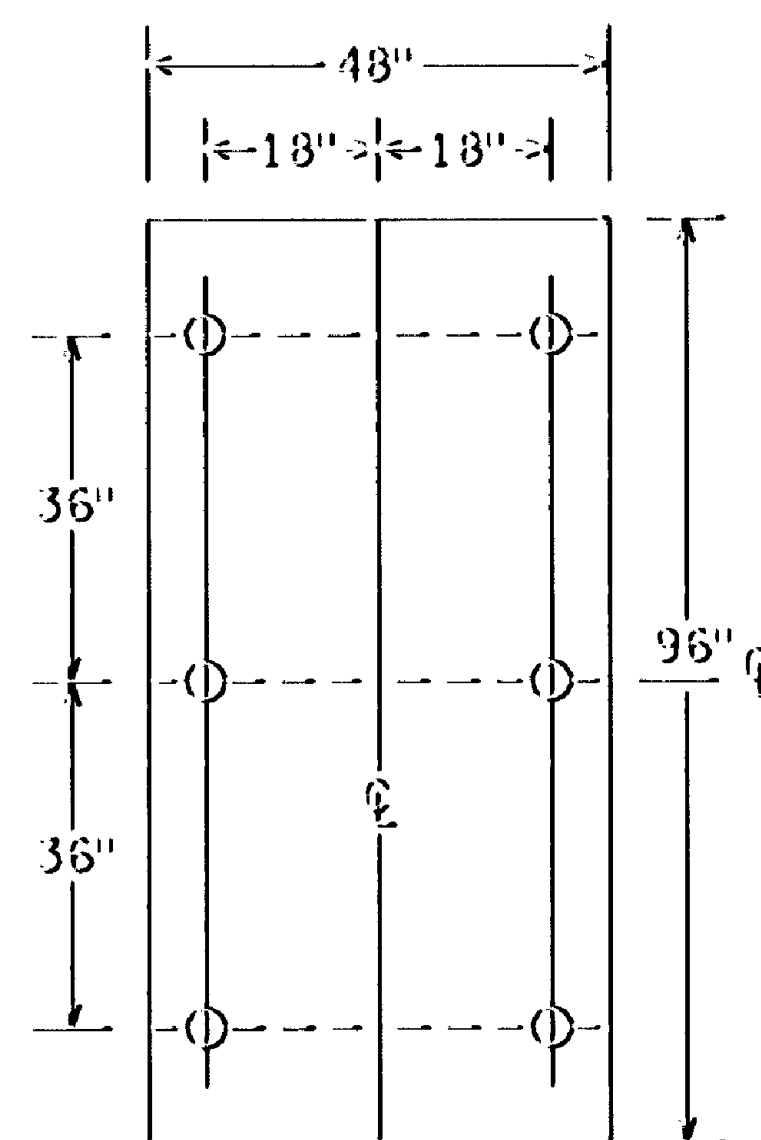

Punching for R2-4a
SPEED LIMIT

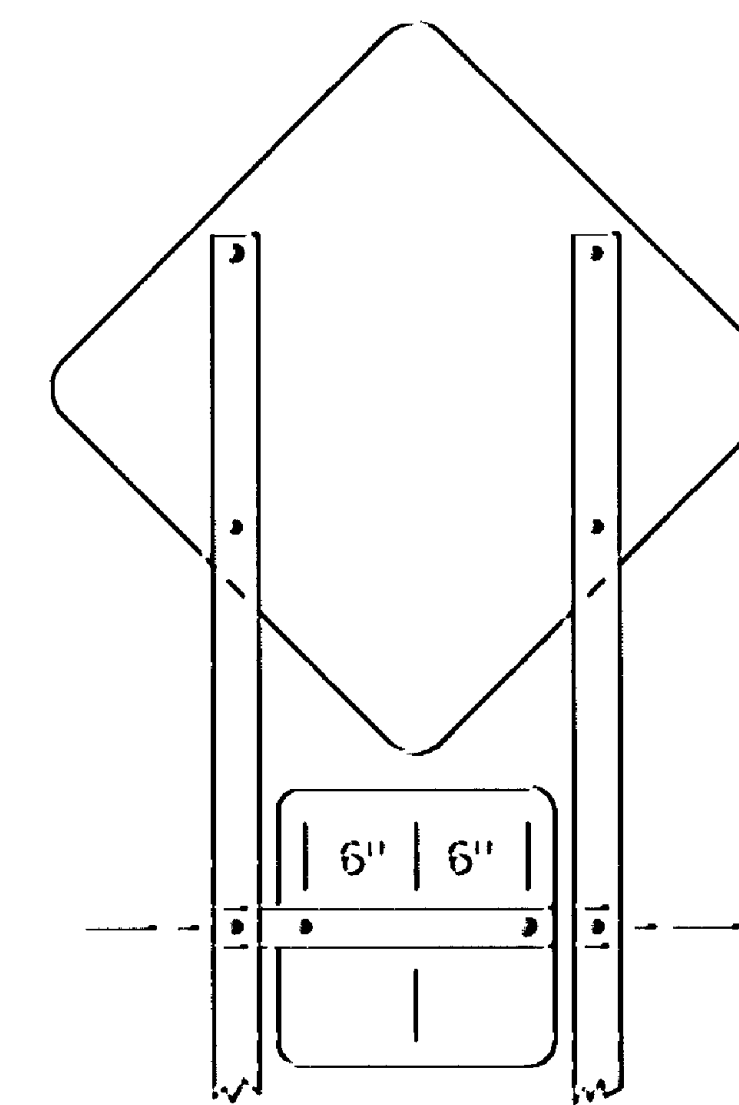

(W1-1, W1-2, W1-3, W1-4 or W1-5) & W13-1
Mounting

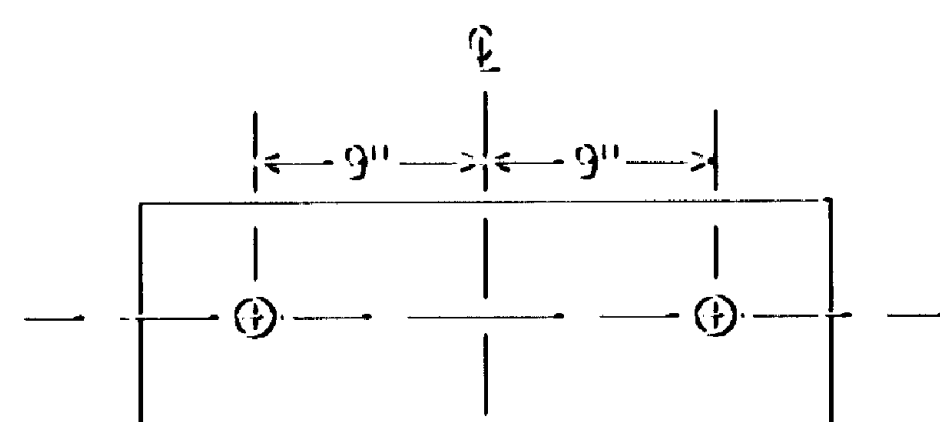

Punching for R6-1 (36x12")

"C" & "D" SIGN DETAILS


DESIGN A
Sheet 3 of 3

Rev. 3-31-93
Rev. 3-23-90


NOTE: THIS SHEET IN ENGLISH UNITS

S.A.P. 02-617-11, et al.

Sheet No. 107 of 236 Sheets

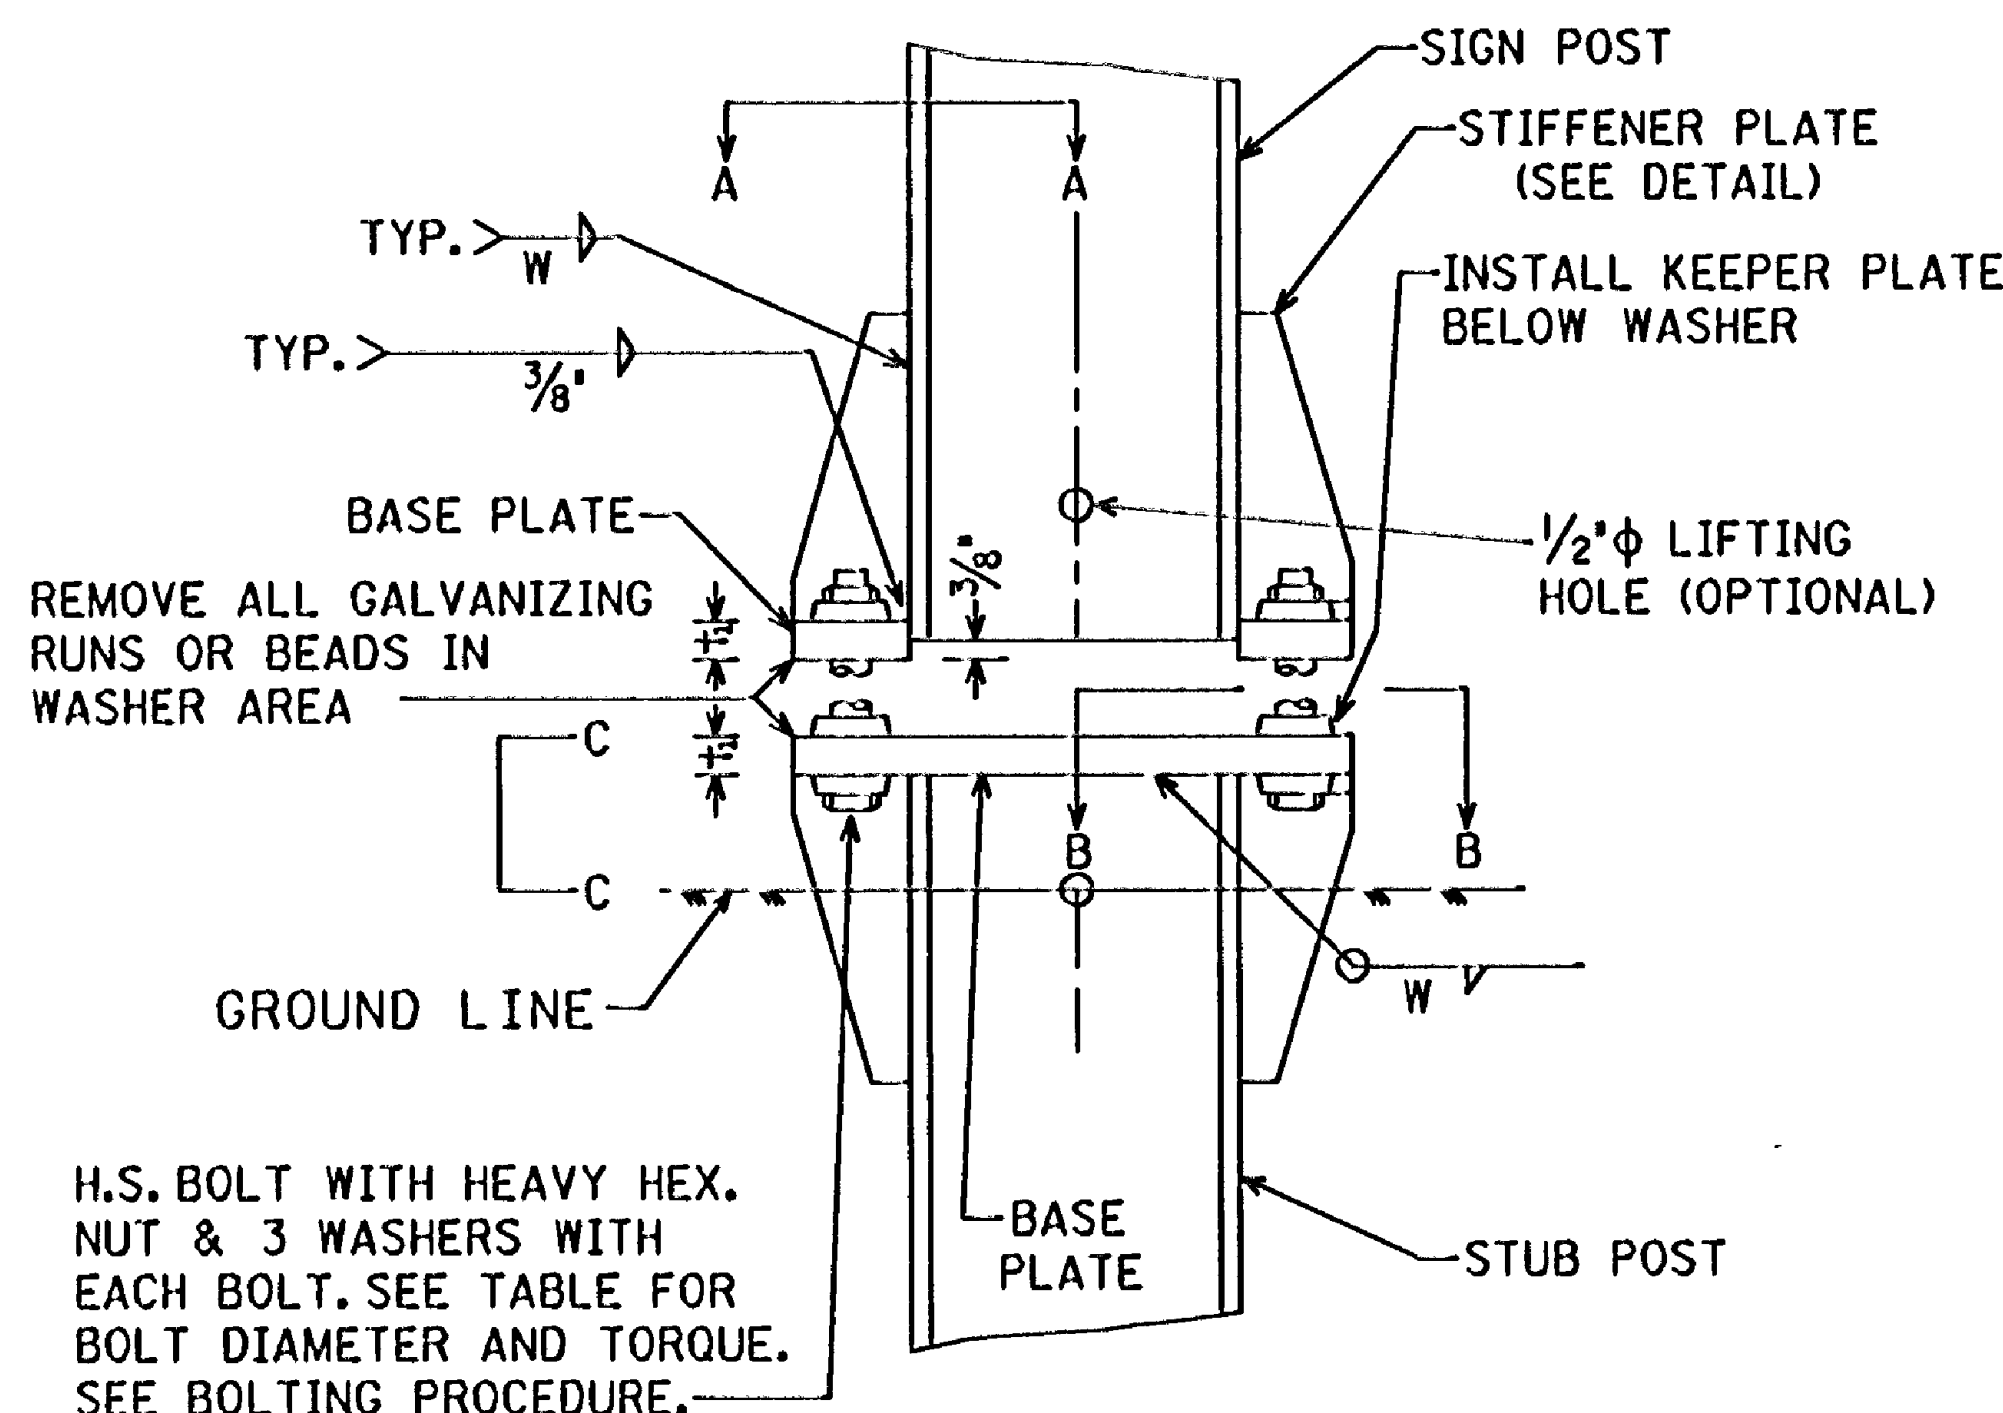


SIGN POST AND STUB POST ELEVATION

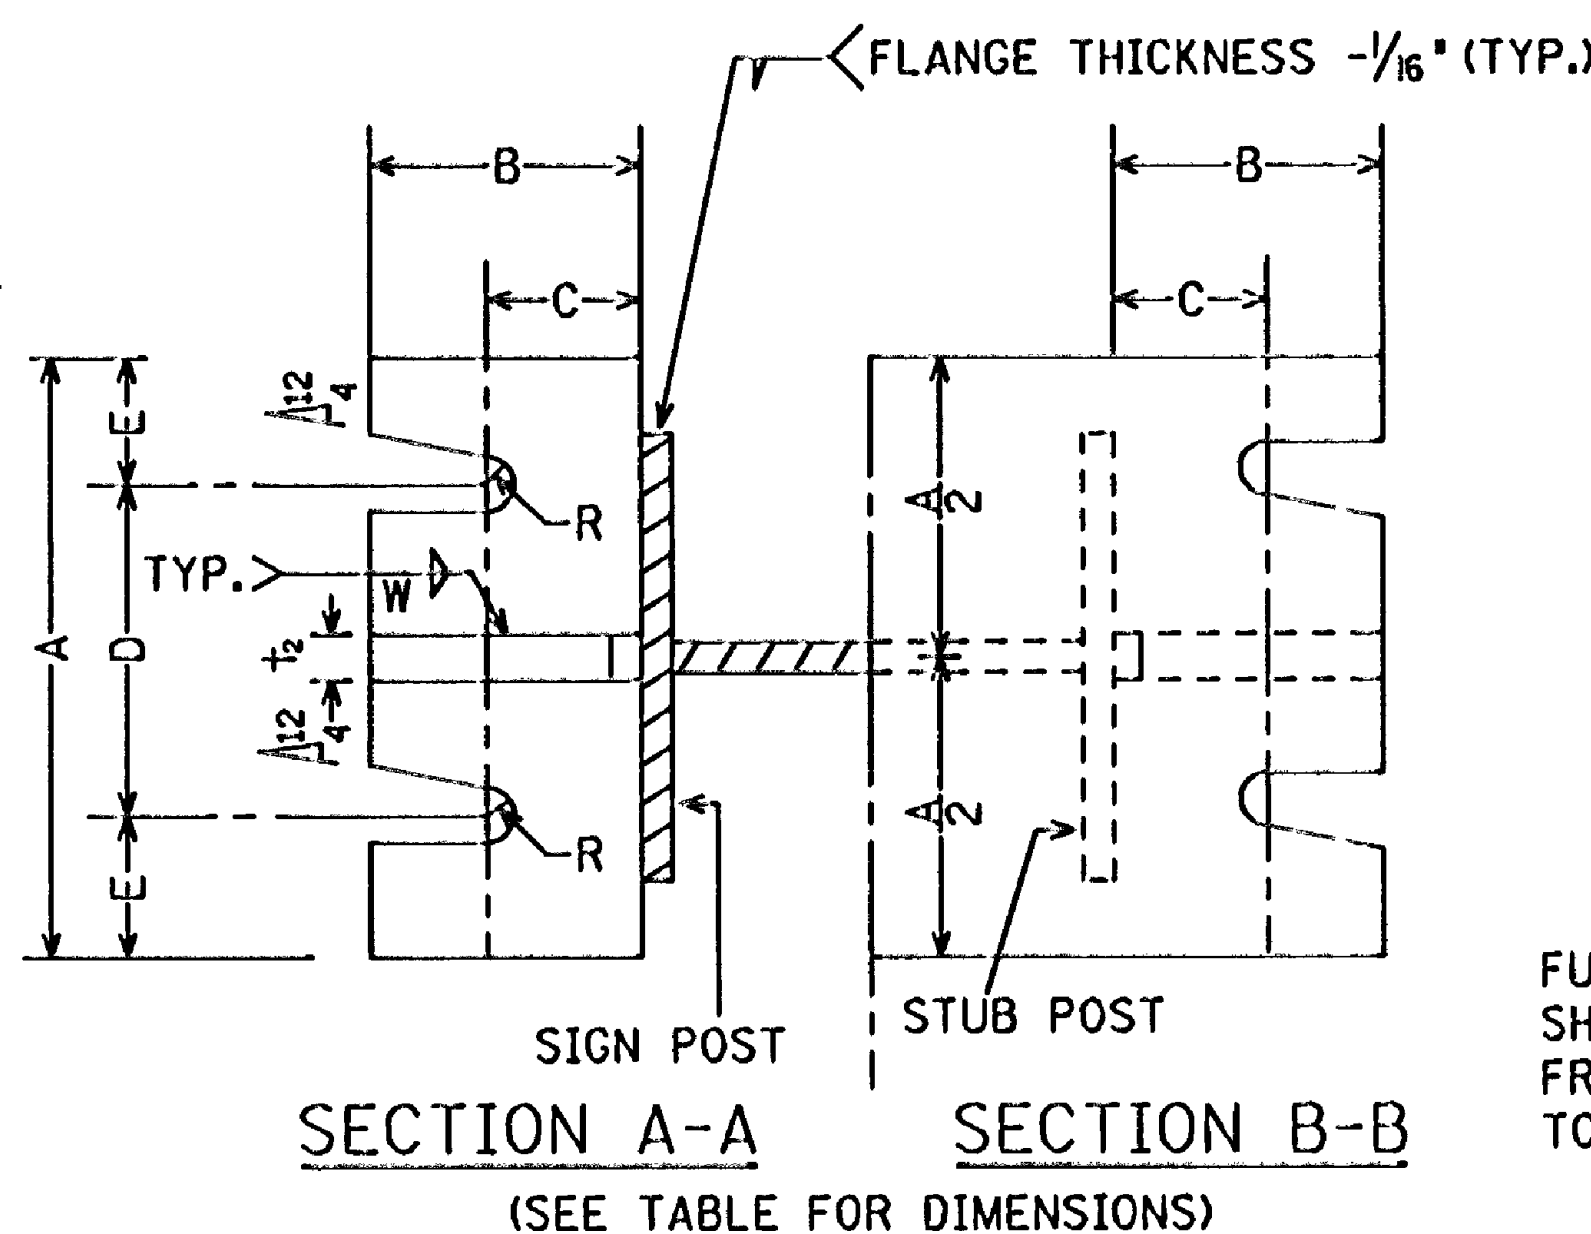

SECTION A-A SECTION B-B
(SEE TABLE FOR DIMENSIONS)

FURNISH 2-.012± THICK AND 2-.032± THICK SHIMS PER POST. SHIMS SHALL BE FABRICATED FROM BRASS SHIM STOCK OR STRIP CONFORMING TO A.S.T.M. B36.

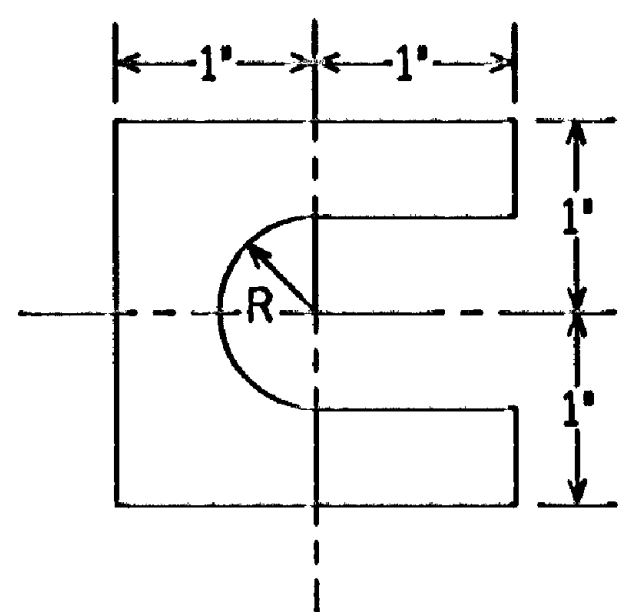


SHIM DETAIL

SECTIONS SHOWN ARE FOR INSTALLATIONS ON RIGHT SHOULDER AND IN GORE. PLATE SLOT BEVELS ARE OPPOSITE HAND FROM THAT SHOWN FOR INSTALLATIONS ON LEFT SHOULDER.


BOLTING PROCEDURE - BASE CONNECTION

1. ASSEMBLE SIGN POST TO STUB POST WITH BOLTS AND WITH ONE OF THE FLAT WASHERS ON EACH BOLT BETWEEN PLATES.
2. SHIM AS REQUIRED TO PLUMB POST.
3. TIGHTEN ALL BOLTS THE MAXIMUM POSSIBLE WITH 12" OR 15" WRENCH TO BED WASHERS AND SHIMS AND TO CLEAN BOLT TREADS, THEN LOOSEN EACH BOLT IN TURN AND RETIGHTEN IN A SYSTEMATIC ORDER TO THE PRESCRIBED TORQUE. (SEE TABLE)
4. BURR TREADS AT JUNCTION WITH NUT USING A CENTER PUNCH TO PREVENT NUT LOOSENING.


H.S. BOLT WITH HEAVY HEX. NUT & 3 WASHERS WITH EACH BOLT. SEE TABLE FOR BOLT DIAMETER AND TORQUE. SEE BOLTING PROCEDURE.

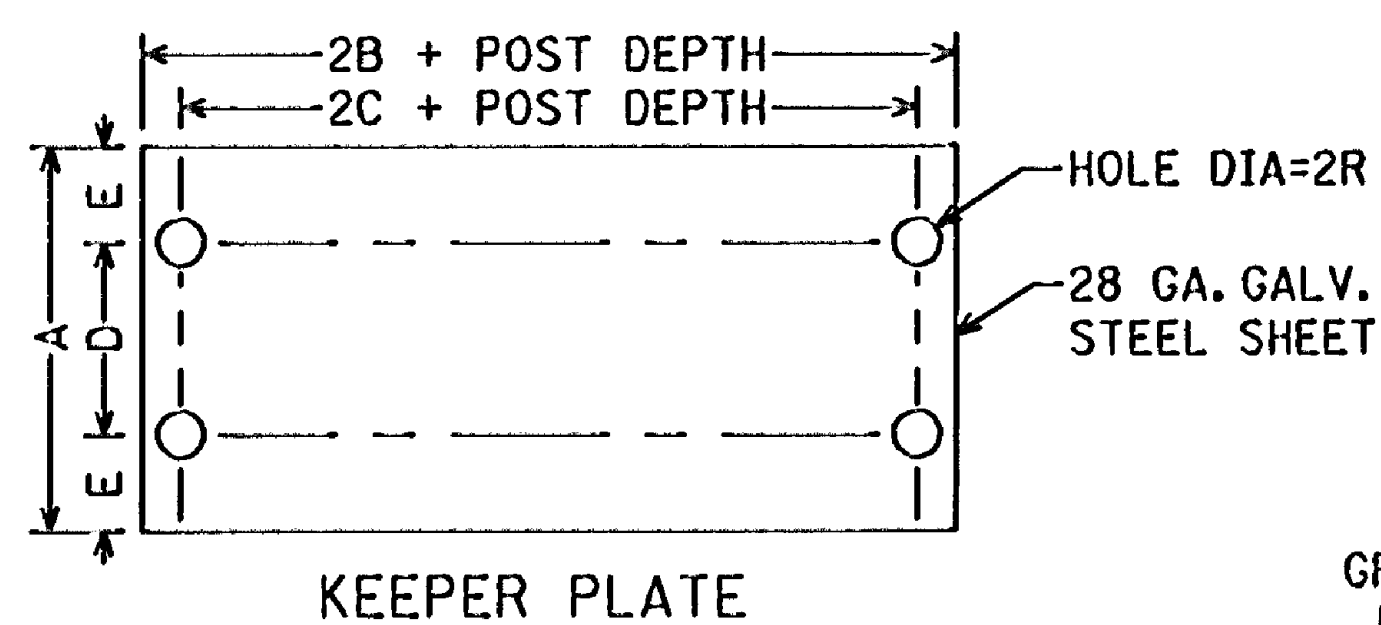

KEEPER PLATE

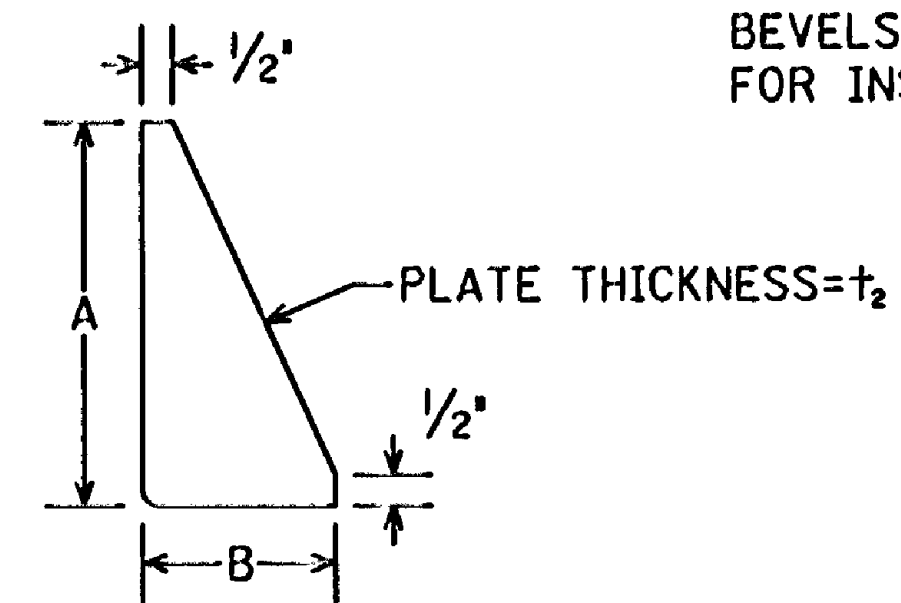


STIFFENER PLATE DETAIL
(SEE TABLE FOR DIMENSIONS)

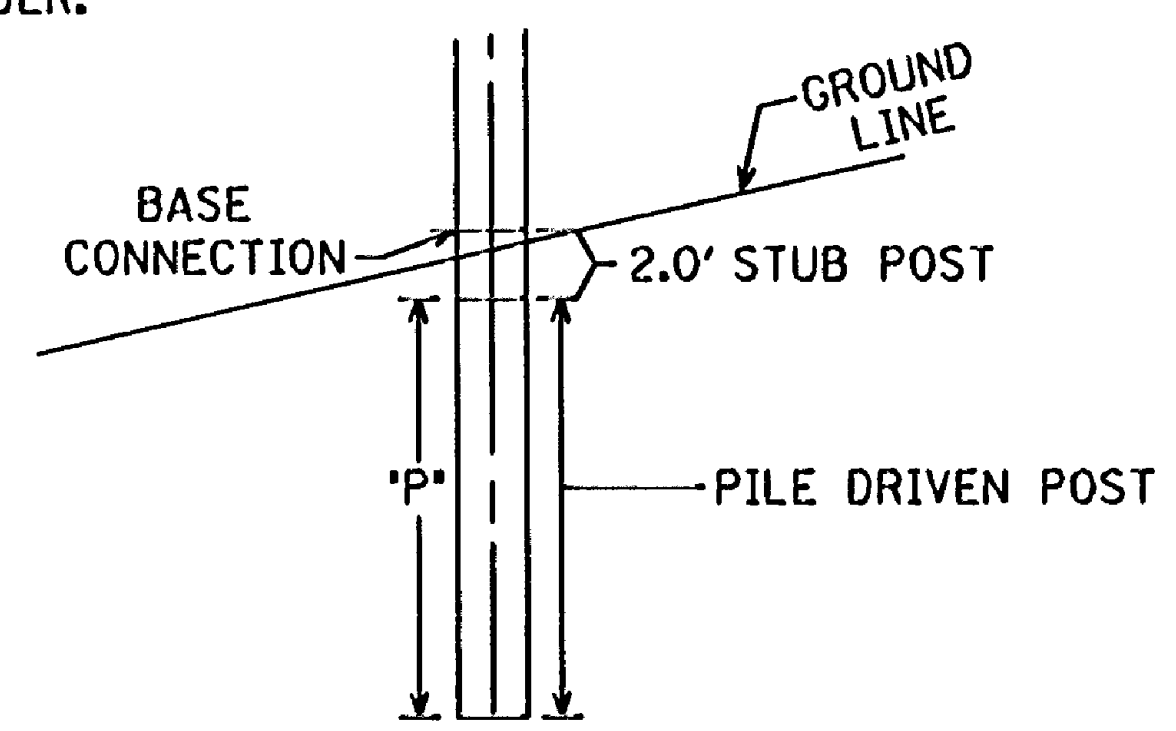


H-PILE FOOTING

MAXIMUM PROJECTION OF STUB POST SHALL NOT EXTEND BEYOND A LINE ABOVE AND 4" PARALLEL TO ANY CHORD WHICH IS PERPENDICULAR TO (OR ALIGNED RADIALLY TO) THE CENTERLINE OF THE HIGHWAY AND HAS ITS (THE CHORD'S) END POINTS ON THE GROUND SURFACE ON OPPOSITE SIDES OF THE STUB POST.

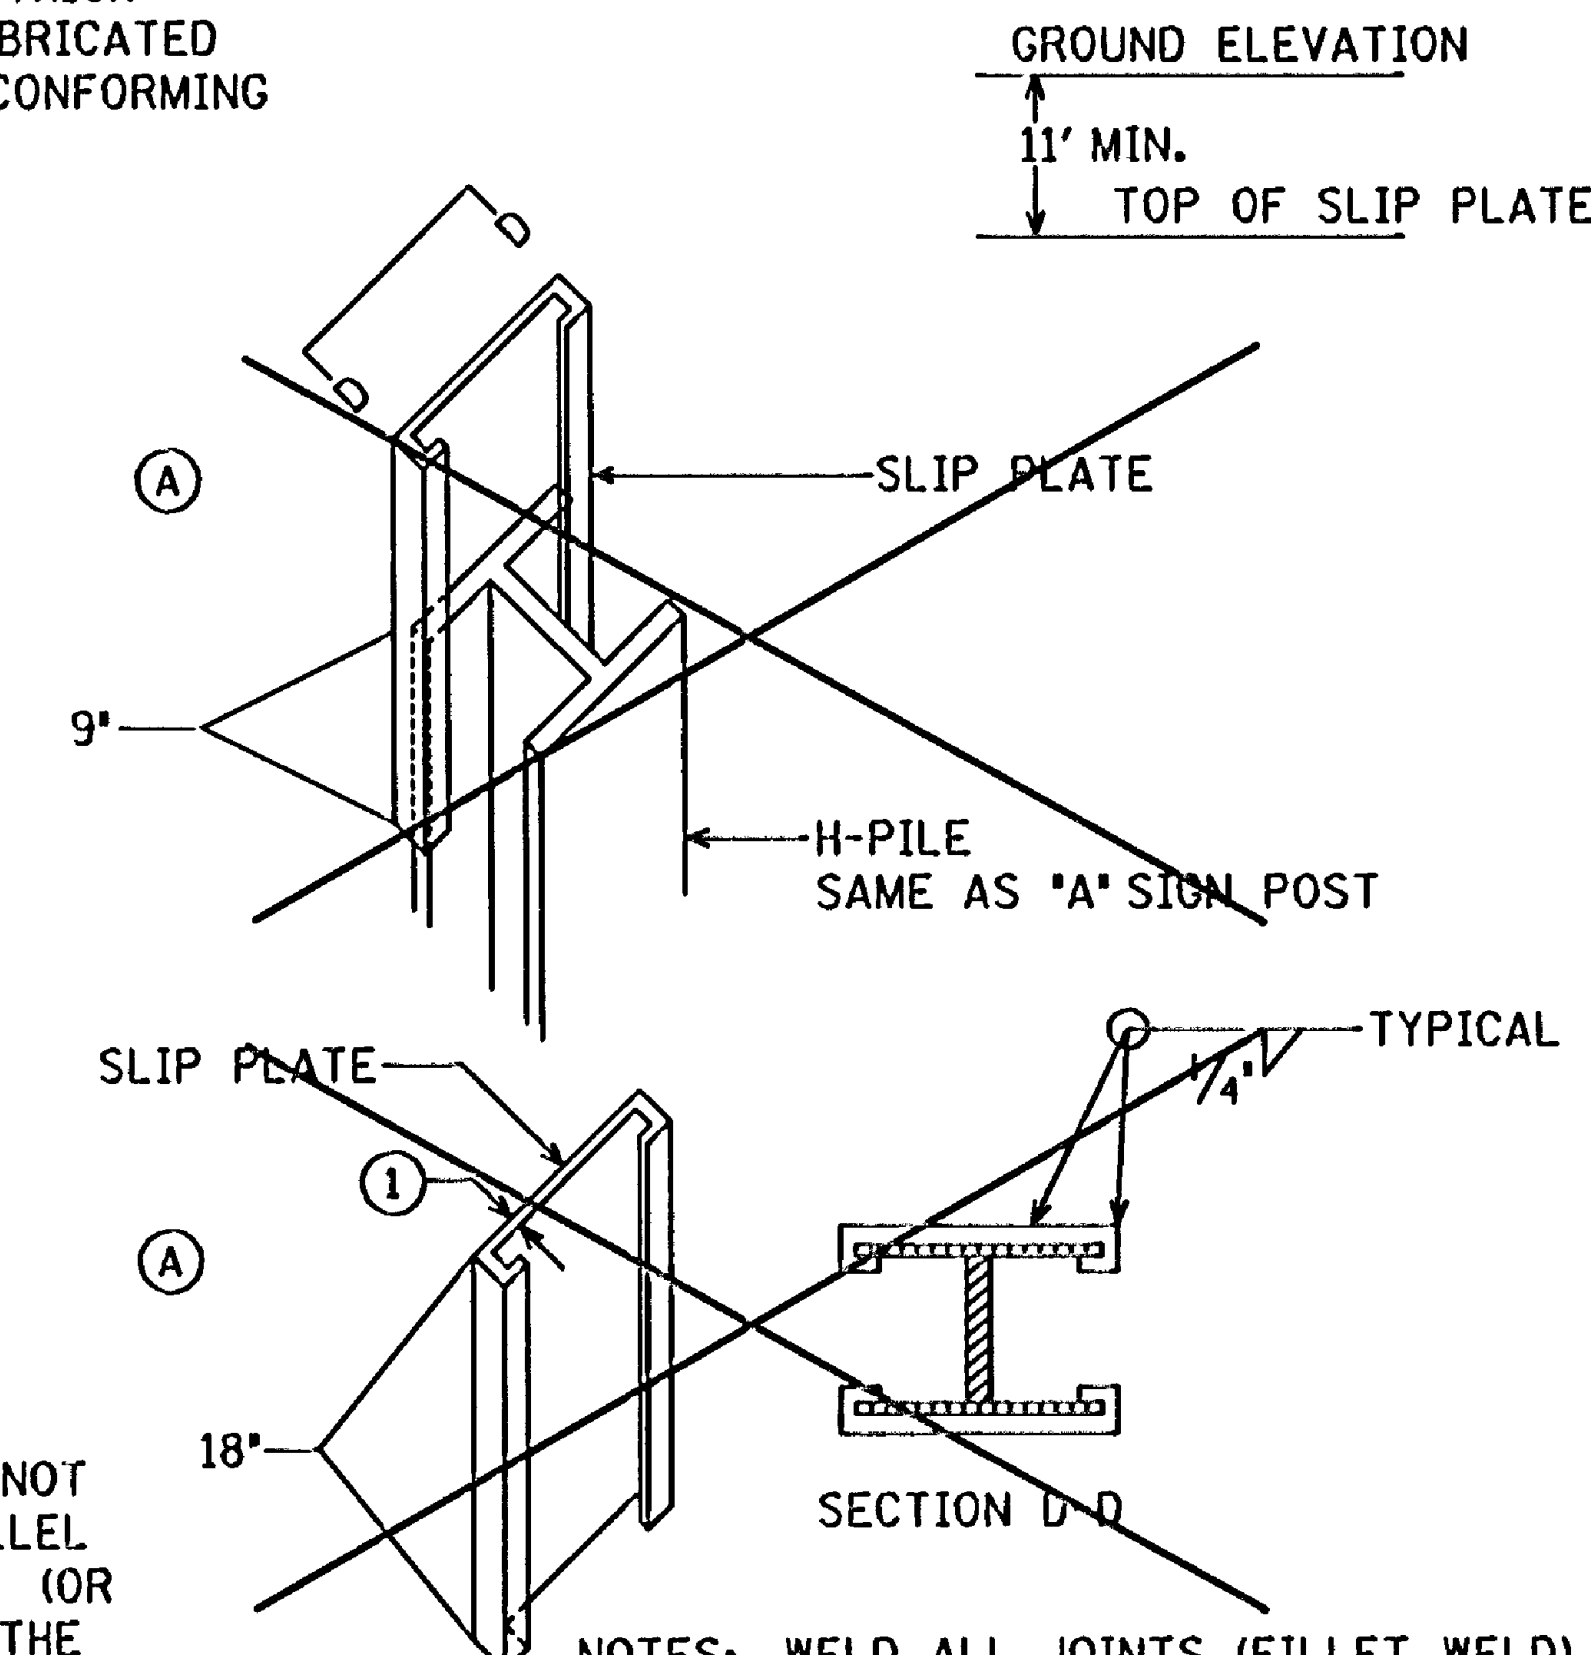

NOTES: WELD ALL JOINTS (FILLET WELD) DRIVE H-PILE FIRST. TOP OF SLIP PLATE SHALL BE A MINIMUM OF 11' BELOW GROUND ELEVATION.

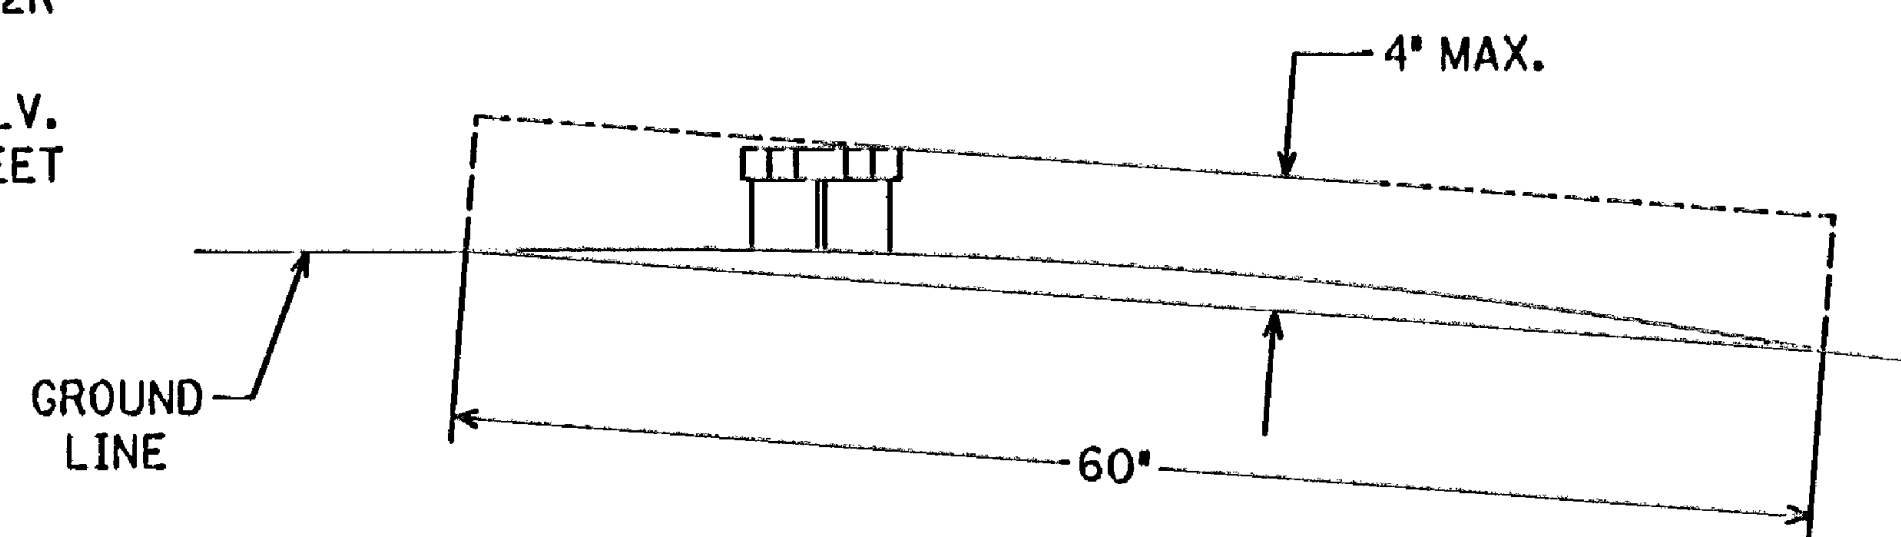

VIEW C-C

DIMENSION POST SIZE	BASE CONNECTION DATA	FUSE AND HINGE PLATE DATA										FOOTING DATA											
		BOLT SIZE AND TORQUE	A	B	C	D	E	t ₁	t ₂	W	R	G	H	J	K	L	M	d ₁	d ₂	t ₃	BOLT DIA.	STUB POST LENGTH (2)	H PILE POST P (MIN. LENGTH)
W4X13	3/4"φ × 3-1/2" TORQUE=600**	6"	2-1/2"	1-1/2"	3-1/2"	1-1/4"	1"	1/2"	1/4"	13/32"	2"	1-1/4"	4"	2-1/4"	7/8"	1"	11/16"	3/4"	3/8"	5/8"	5/8"	2'	12'
W5X16	7/8"φ × 4-1/4" TORQUE=800**	8"	3"	1-3/4"	4"	2"	1-1/4"	1/2"	1/4"	15/32"	2-1/2"	1-1/4"	5"	2-3/4"	1-1/8"	1-1/8"	13/16"	7/8"	3/8"	3/4"	3/4"	2'	12'
W6X20	1"φ × 5" TORQUE=1000**	8"	3"	2"	4"	2"	1-1/2"	3/4"	5/16"	11/32"	2-1/2"	1-1/2"	6-1/2"	3-1/2"	1-1/2"	1-1/2"	1-5/8"	1-1/16"	1-1/8"	1/2"	1"	2'	12'
W8X24	1-1/8"φ × 5" TORQUE=1200**	9"	3-1/2"	2"	5"	2"	1-1/2"	3/4"	5/16"	19/32"	3"	1-3/4"	8"	5-1/2"	1-1/4"	2"	1-1/16"	1-1/2"	1/2"	1"	1"	2'	12'
W8X28																							
W8X31																							
W10X39																							

SPECIFIC NOTES:

- ① SAME THICKNESS AS SIGN POST
- ② MEASURED FROM TOP OF BASE PLATE
- ③ OLD BEAM DEPTH = 10". NEW REVISED BEAM DEPTH = 9-7/8". KEEPER PLATES MUST BE FABRICATED ACCORDINGLY

STRUCTURAL DETAILS

TYPE "A" SIGNS (BREAKAWAY)


(H-PILE FOOTING)

REV. (A) DELETE SLIP PLATE DETAIL 4-24-97


REV. DATE 1-10-91
9-4-92

NOTE: THIS SHEET IN ENGLISH UNITS

ASGN. STR. # 6-9-94

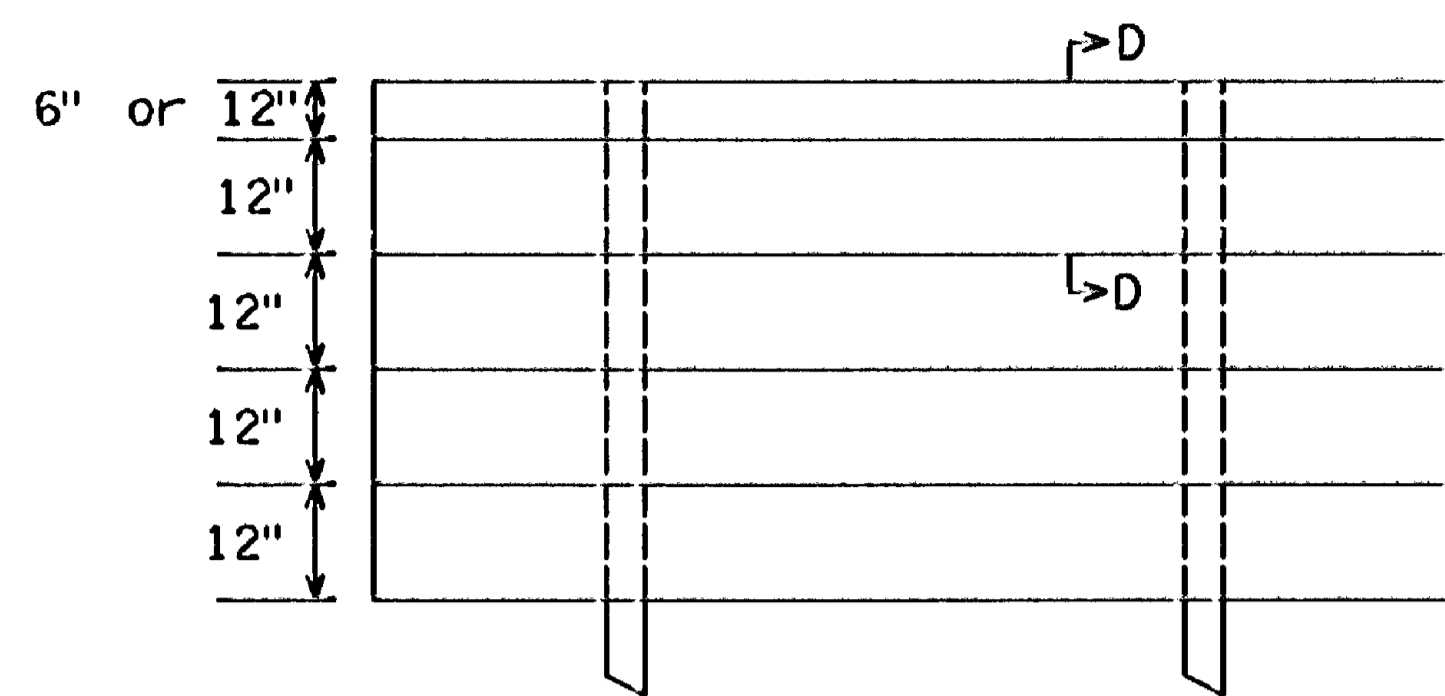


TYPICAL PANEL MOUNTING

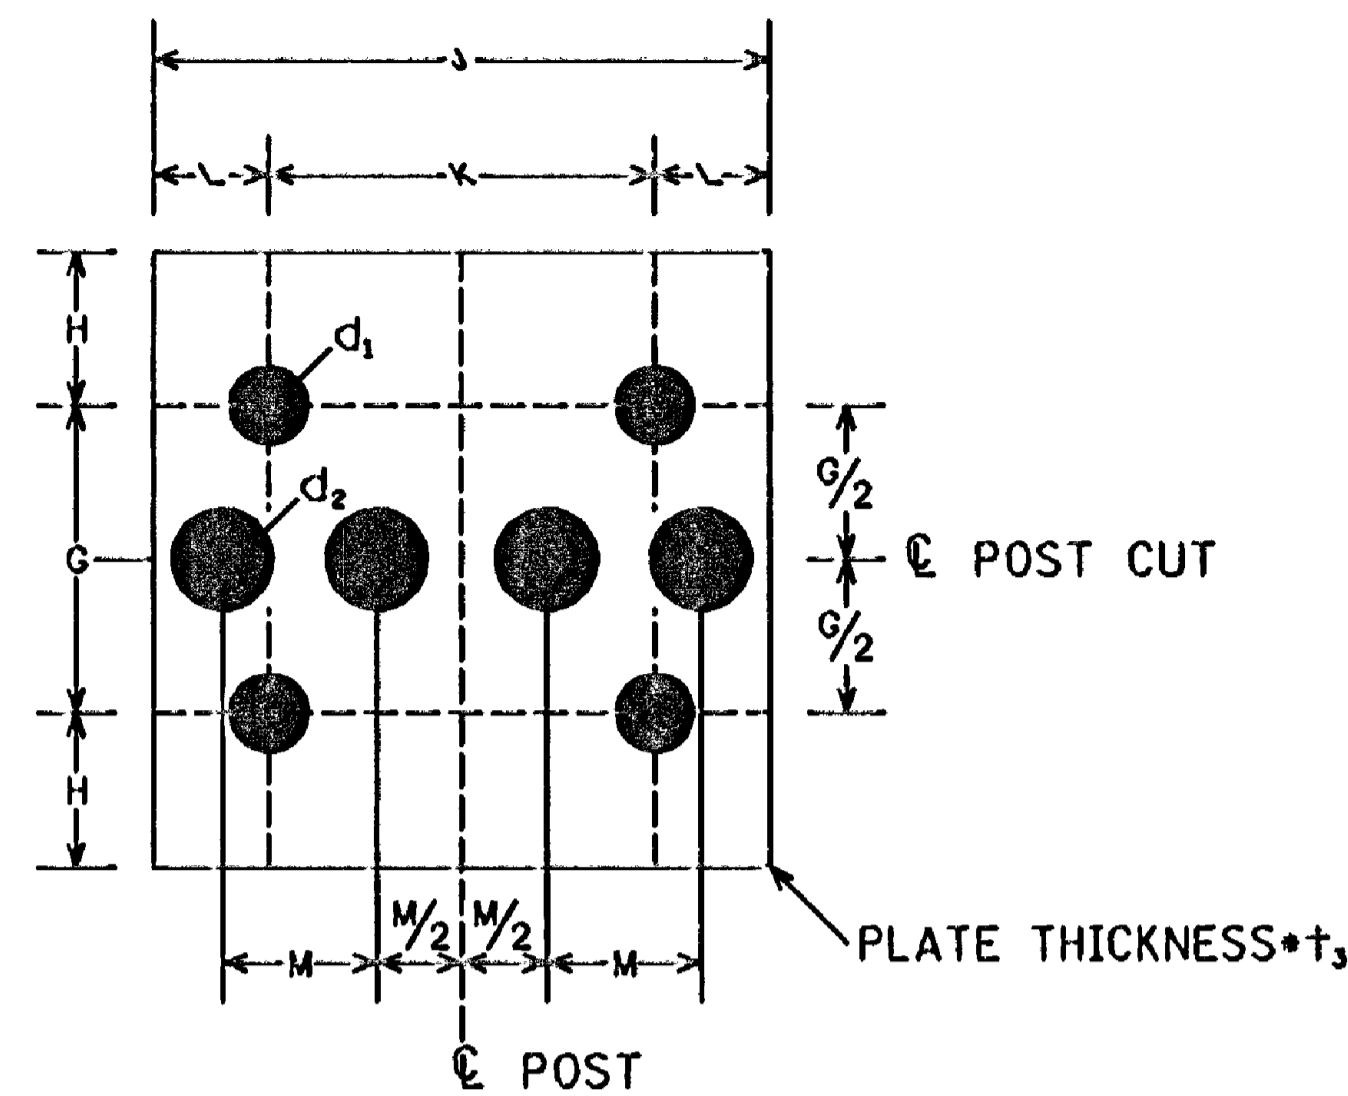


FRICITION FUSE PLATE DETAIL

(SEE TABLE ON SHEET 1 OF 2 FOR DIMENSIONS)

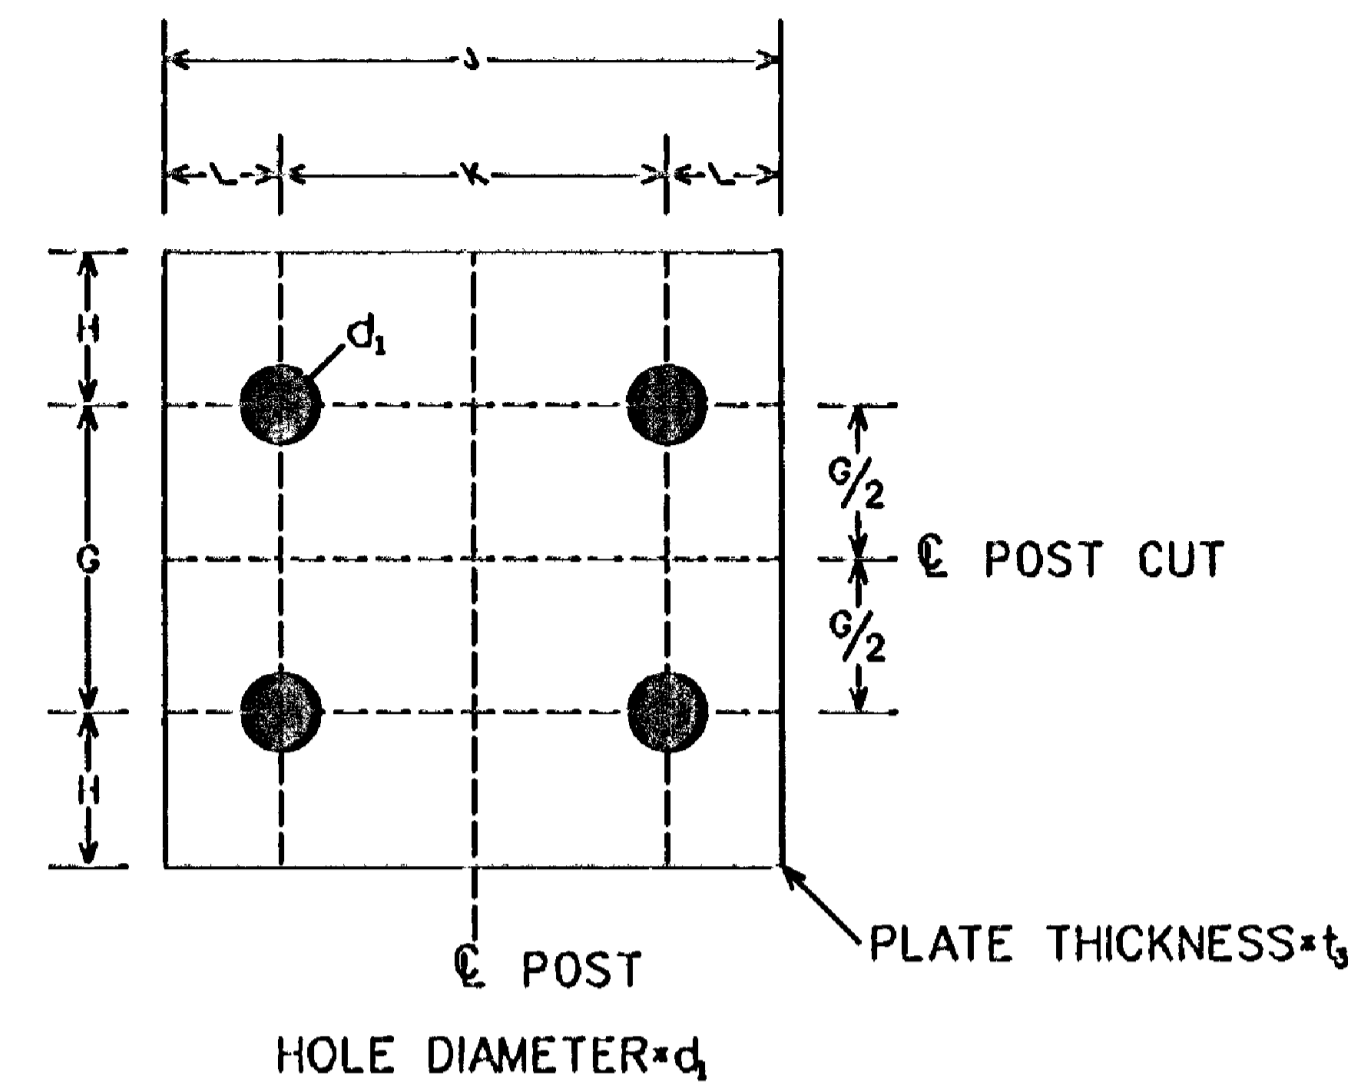


HINGE PLATE DETAIL


(SEE TABLE ON SHEET 1 OF 2 FOR DIMENSIONS)

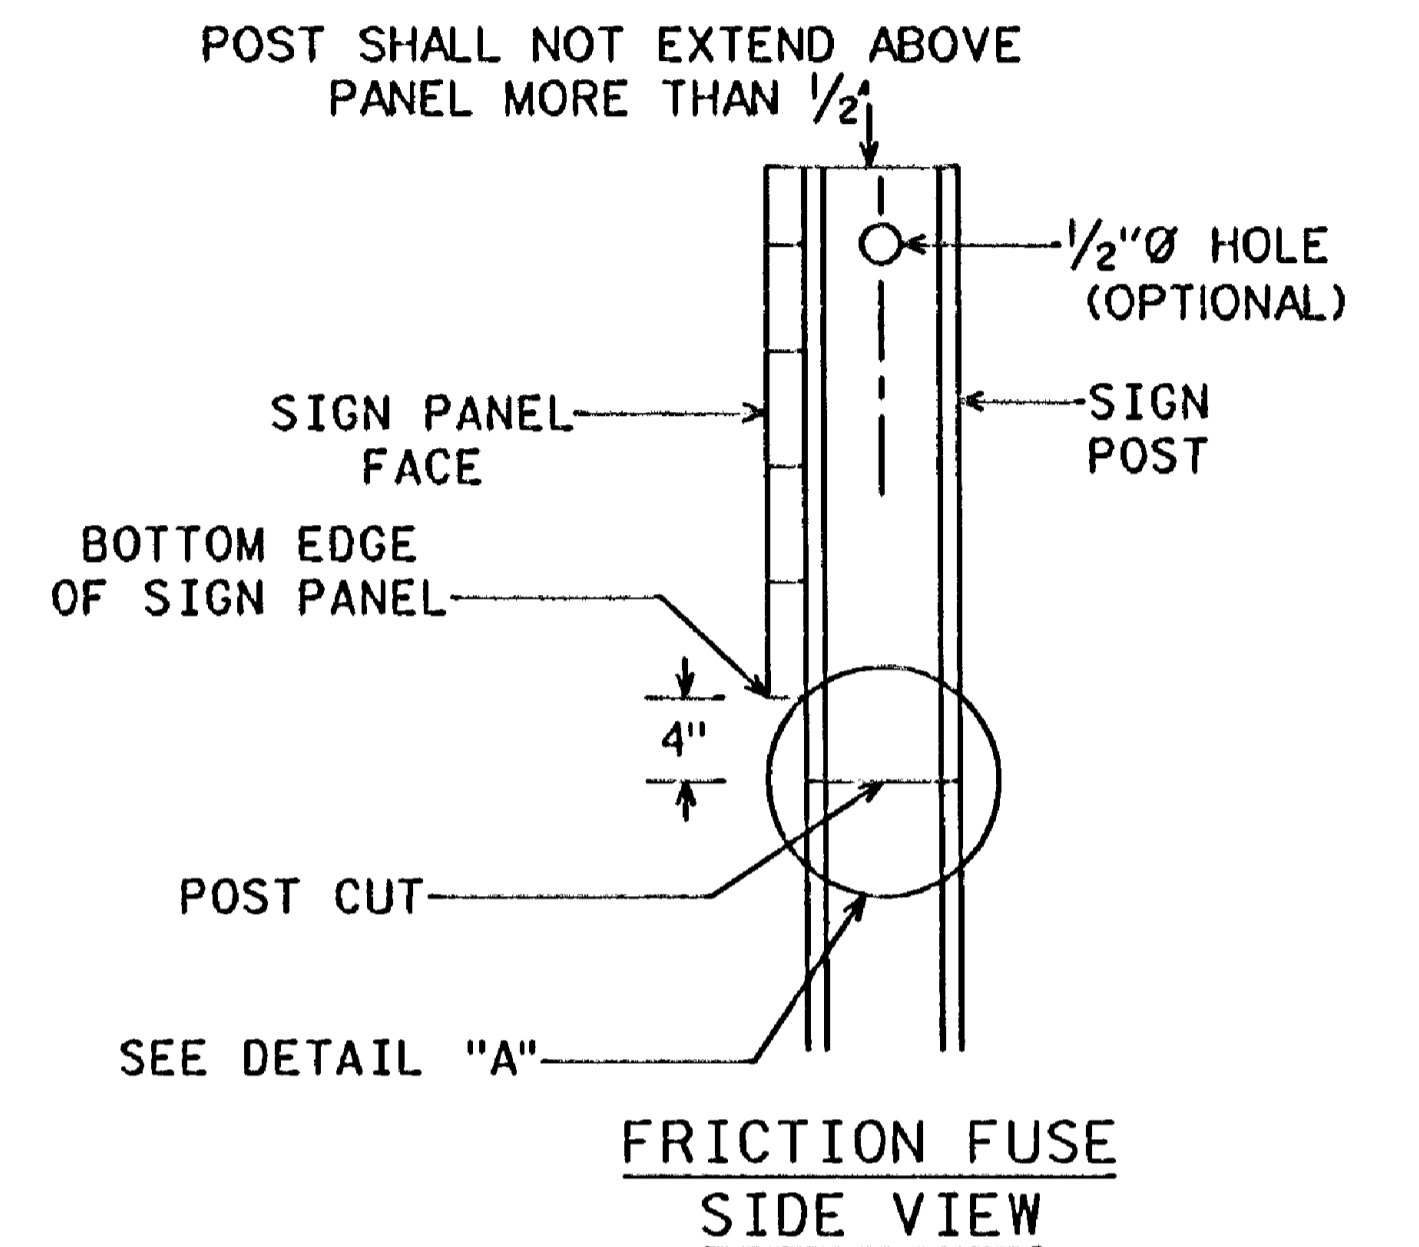


FRICITION FUSE SIDE VIEW

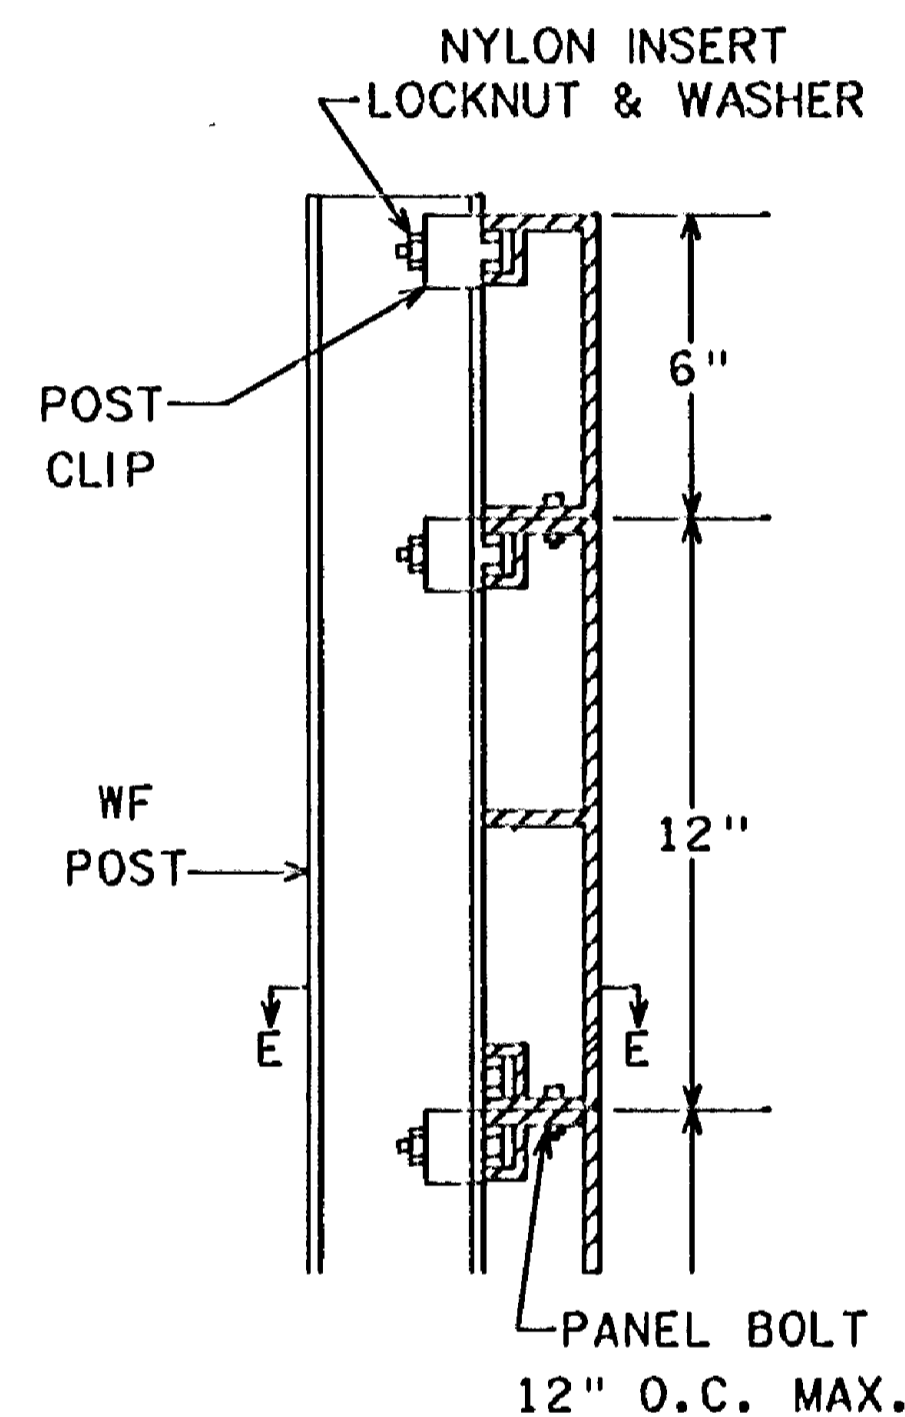

SECTION D-D

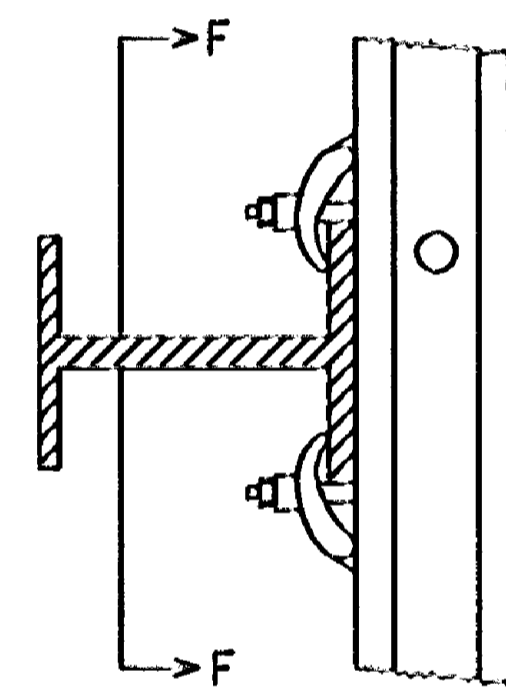

SECTION E-E

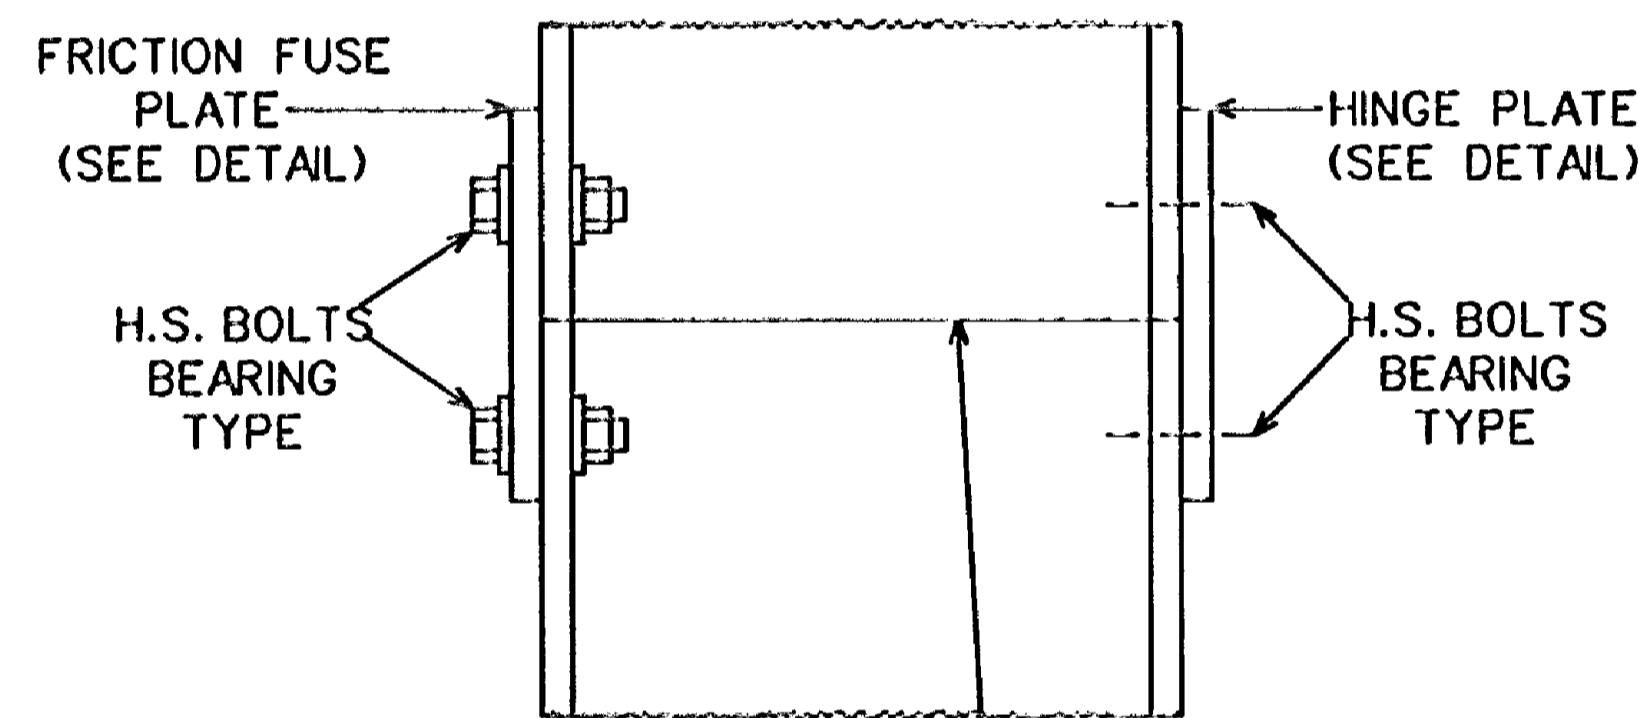

DETAIL "A" FRICTION FUSE

POST SHALL BE SAW CUT BEFORE GALVANIZING. USE H.S. BOLTS WITH HEX. HD., HEX. NUT, AND TWO FLAT WASHERS.


CONTRACTOR NOTE: ALL FRICTION FUSE BOLTS SHALL BE TORQUE WRENCH TIGHTENED IN THE FIELD IN THE PRESENCE OF THE ENGINEER OR HIS REPRESENTATIVE. NUTS SHALL HAVE BEEN RETAPPED AND BOLT THREADS SHALL HAVE BEEN CLEANED WITH A 1/64" OVERSIZED RETHREADING DIE AFTER GALVANIZING. BEFORE TIGHTENING MAY BEGIN, THE TORQUE WRENCH SHALL BE CALIBRATED WITH A BOLT-TENSION-CALIBRATOR USING TYPICAL BOLT-NUT-WASHER ASSEMBLIES OF EACH SIZE AND LOT TO BE USED SO AS TO SHOW THE TORQUE NECESSARY TO OBTAIN THE FOLLOWING MINIMUM RESIDUAL TENSION IN EACH BOLT.

BOLT SIZE	MIN. RESIDUAL BOLT TENSION
1/2" ø	12,050*
5/8" ø	19,200*
3/4" ø	28,400*
7/8" ø	39,250*
1" ø	51,500*
1 1/8" ø	56,450*

GENERAL NOTES:

1. Structural steel shall conform to Mn/DOT 3308. Reinforcing bars shall conform to Mn/DOT 3301. Spirals shall conform to Mn/DOT 3305-no splices. High Strength bolts shall conform to A.S.T.M.-A325.
2. Forms will be required for the exposed vertical surfaces of the footings.
3. Refer to "SIGN DATA" sheet for specific data on each individual sign installation.
4. Friction Fuse Plate shall be installed on side of post facing traffic.
5. All post cuts shall be saw cuts. Plates may be sheared or flame cut using a mechanically guided cutting torch. Edge preparation shall be in accordance with Mn/DOT 2471.3C4 and Mn/DOT 2471.3D4.

NOTE: POST CLIPS SHALL BE INSTALLED ON BOTH SIDES OF EACH POST AT EACH PANEL JOINT AS INDICATED.

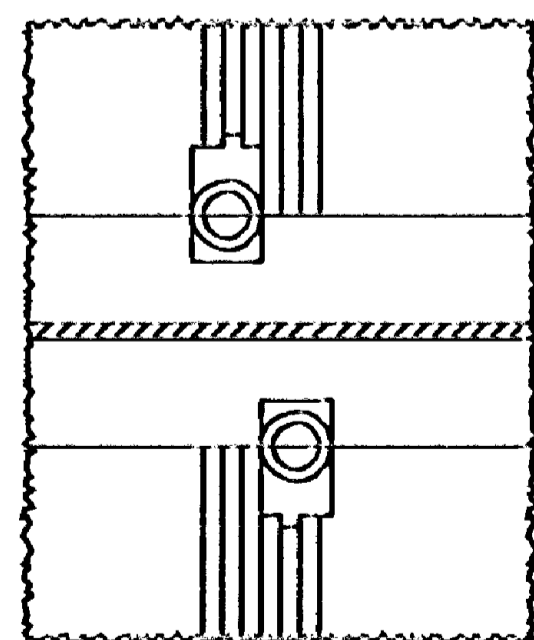

SECTION F-F

ASNG-STR 2 6-9-84


REV. DATE
6-12-81
1-3-89

NOTE: THIS SHEET IN ENGLISH UNITS

STRUCTURAL DETAILS


TYPE "A" SIGNS (BREAKAWAY)

SHEET 2 OF 2

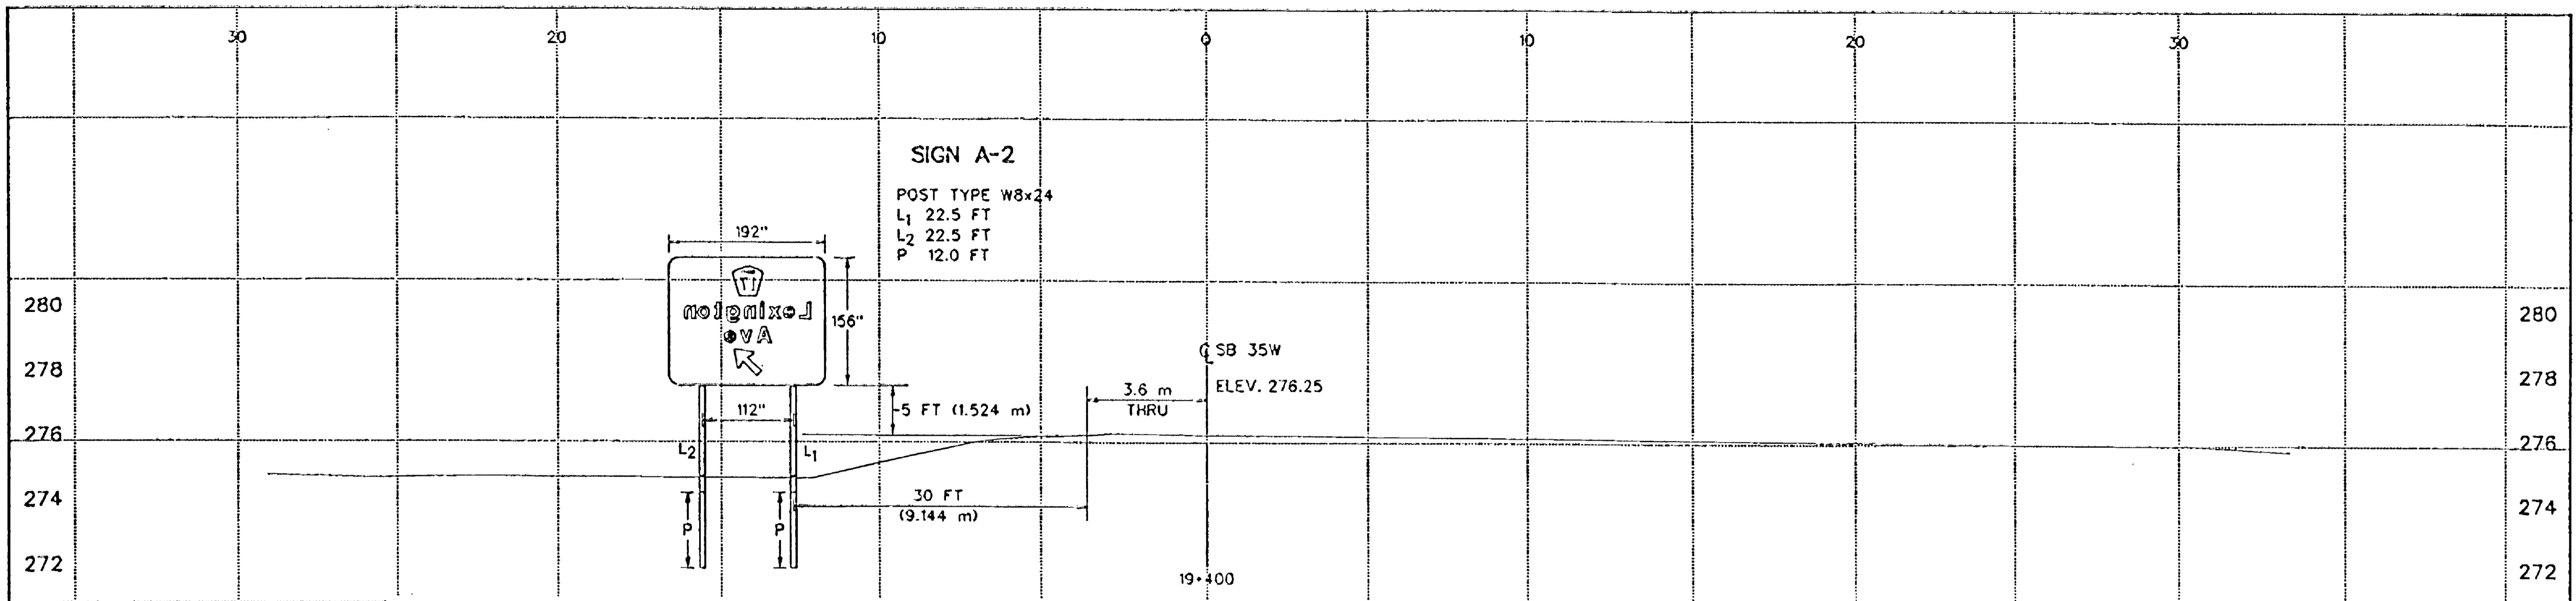

TYPE "A" SIGNS																			
SIGN NO.	ALIGNMENT	STATION	OFFSET		PANELS 1		QUANTITY	POSTS					PILE						
			LT	RT	SIZE (IN.)	AREA (SQ. FT.)		SIZE	L1 (FT.)	L2 (FT.)	ADDITIONAL STEEL PER POST (LBS)	WEIGHT (LBS)	c (IN.)	d (IN.)	"P" (FT.)	WEIGHT (LBS)	"X" (FT.)	"H" (FT.)	
A-1	NB I-35W	18+220		X	192 x 156	208	W8 x 24	2	24.5	24.5	118	1412	40	112	12	576	42.65	5	
A-2	SB I-35W	19+400	X		192 x 156	208	W8 x 24	2	22.5	22.5	118	1316	40	112	12	576	30.00	5	
PROJECT TOTALS:								4				2728				1152			




NOTES: 1 EXISTING SIGN PANEL SIZES SHOWN FOR INFORMATION ONLY. SIGN PANELS TO BE REINSTALLED ON NEW POSTS AT LOCATION INDICATED IN TAB. EXISTING SIGN PANELS HAVE OVERLAY PANELS IN PLACE.

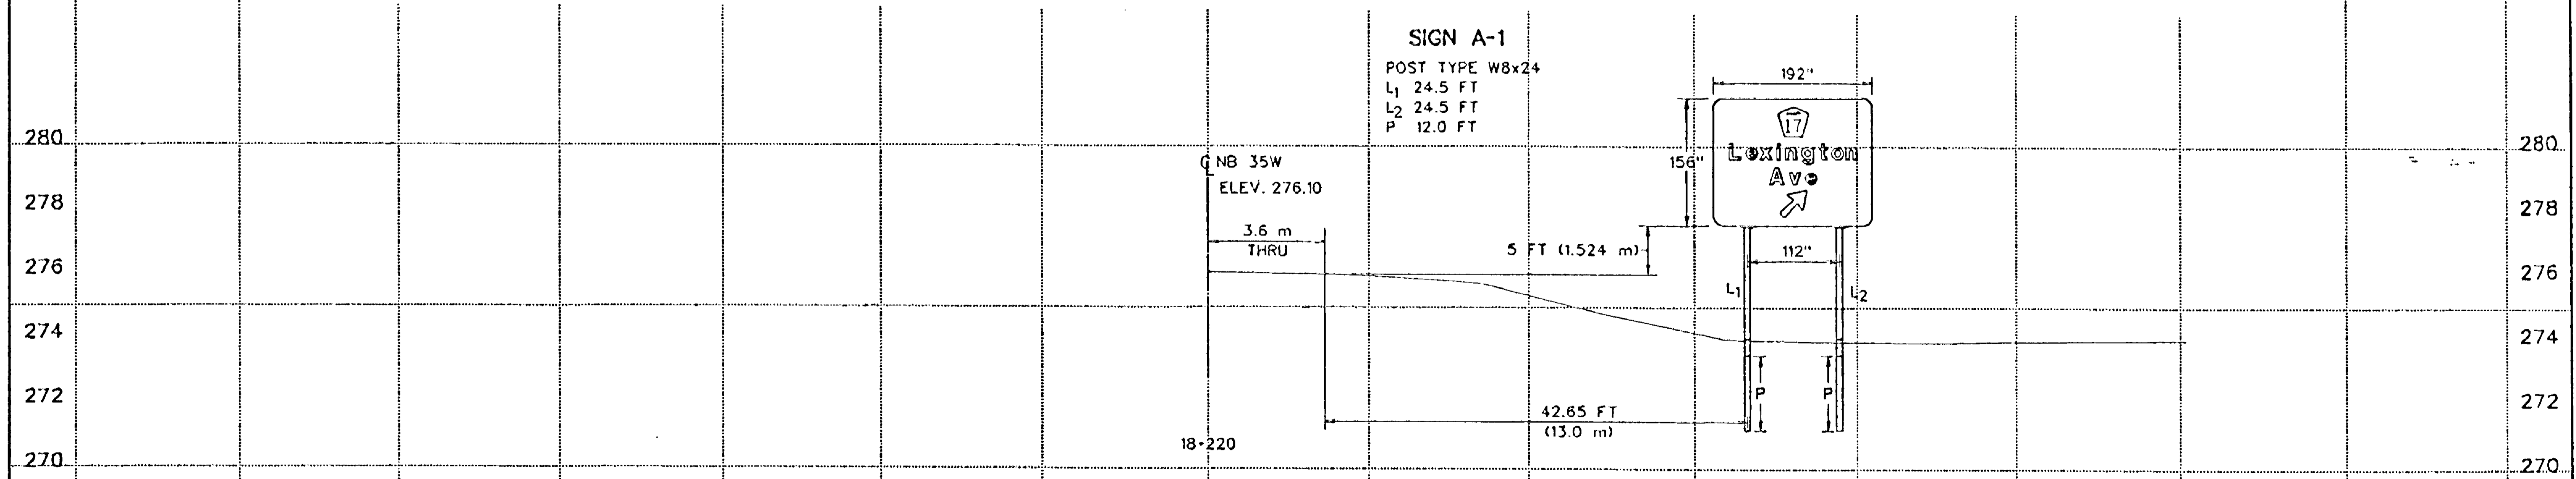


NOTE: DIMENSIONS ON THIS SHEET IN ENGLISH UNITS

PERMANENT SIGN INSTALLATIONS										
SIGN DESIGNATION	SIGN SIZE	SIGN AREA (FT ²)	SIGN AREA (m ²)	TOTAL INSTALLATIONS	TOTAL AREA (m ²)	MOUNTING HEIGHT (FT)	POSTS PER INSTALLATION	GROUND MOUNT	MEDIAN MOUNT	NOTES
R1-2	36"x36"x36"	3.90	0.362	3	1.087	7	2	3		
R7-1	12"x18"	1.50	0.139	19	2.648	7	1	19		
R3-2	24"x24"	4.00	0.372	2	0.743	7	1			R
R3-3FL	36"x30"	7.50	0.697	2	1.394	7	2		2	
R3-3b	24"x36"	6.00	0.557	5	2.787	7	1	5		
R3-X1	30"x30"	6.25	0.581	8	4.645	7	1	8		
R3-X2	30"x30"	6.25	0.581	9	5.225	7	1		9	
R4-7	24"x30"	5.00	0.465	16	7.432	7	1		16	
R4-7	30"x36"	7.50	0.697	1	0.697	7	1		1	
R1-1	30"x30"	6.25	0.581	10	5.806	7	1	10		
R5-1	30"x30"	6.25	0.581	15	8.710	7	1	2	13	
R6-1R	36"x12"	3.00	0.279	14	3.902					S
R6-1L	36"x12"	3.00	0.279	15	4.181			4	1	T
R2-1	24"x30"	5.00	0.465	8	3.716	7	1	8		
R5-10d	18"x24"	3.00	0.279	2	0.557	7	1	2		
R16-X4	36"x36"	9.00	0.836	2	1.672	7	2	2		
R3-3FR	36"x30"	7.50	0.697	2	1.394	7	2	2		
R5-1A	36"x24"	6.00	0.557	2	1.115	7	2	2		
R3-8G	48"x30"	10.00	0.929	4	3.716	7	2	4		
X4-2	18"x18"	2.25	0.209	20	4.181	4	1		2	U
X4-5	6"x12"	0.50	0.046	7	0.325	4	1		7	
W9-1R	36"x36"	9.00	0.836	1	0.836	7	2	1		
W6-1	36"x36"	9.00	0.836	1	0.836	7	2	1		
W4-2R	36"x36"	9.00	0.836	2	1.672	7	2	2		
W1-7	48"x24"	8.00	0.743	1	0.743	7	2	1		
W3-3	36"x36"	9.00	0.836	2	1.672	7	2	2		
W9-2	36"x36"	9.00	0.836	1	0.836	7	2	1		
M6-1A	21"x15"	2.19	0.203	5	1.017					V
M4-6	24"x12"	2.00	0.186	2	0.372					V
M2-X1	24"x12"	2.00	0.186	2	0.372					V
M4-5A	24"x12"	2.00	0.186	1	0.186					V
M3-1A	24"x12"	2.00	0.186	4	0.743					V
M3-3A	24"x12"	2.00	0.186	1	0.186					V
M3-2A	24"x12"	2.00	0.186	1	0.186					V
M3-4A	24"x12"	2.00	0.186	1	0.186					V
M1-1	30"x24"	5.00	0.465	1	0.465	7	1	1		
M1-6	24"x24"	4.00	0.372	17	6.317	7	1	17		
M2-1A	21"x15"	2.19	0.203	6	1.221					V
M6-4A	21"x15"	2.19	0.203	1	0.203					V
PROJECT TOTALS:				216	83.982					


NOTE: THIS TABLE ILLUSTRATES QUANTITIES FOR F&I NEW TYPE "C" SIGNS ONLY. MOUNTING HEIGHTS INDICATED IN THIS TABLE ARE TO THE BOTTOM OF THE SIGN PANEL.

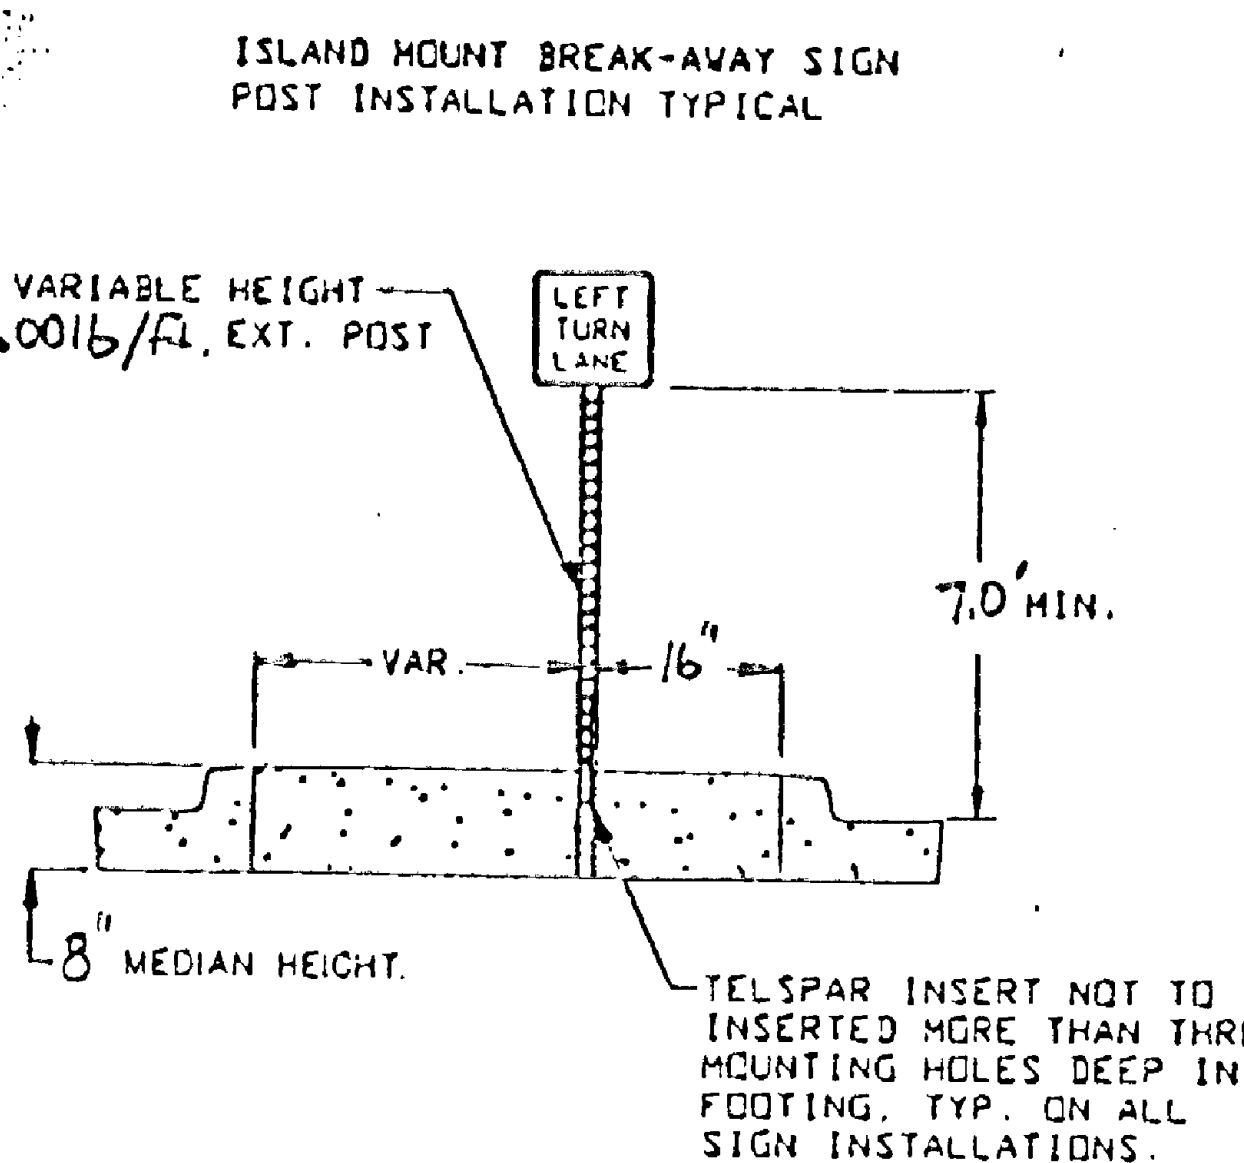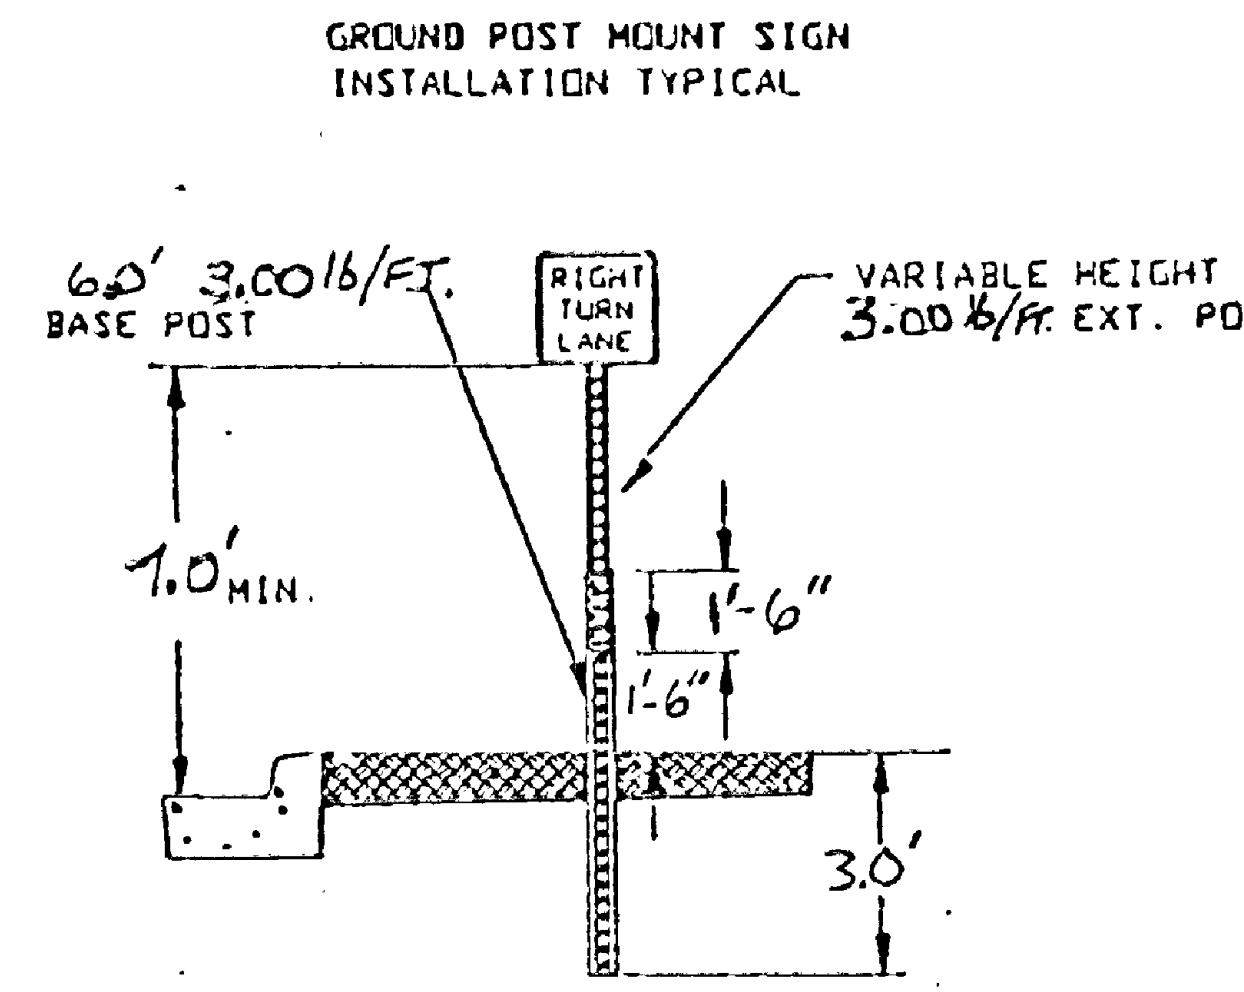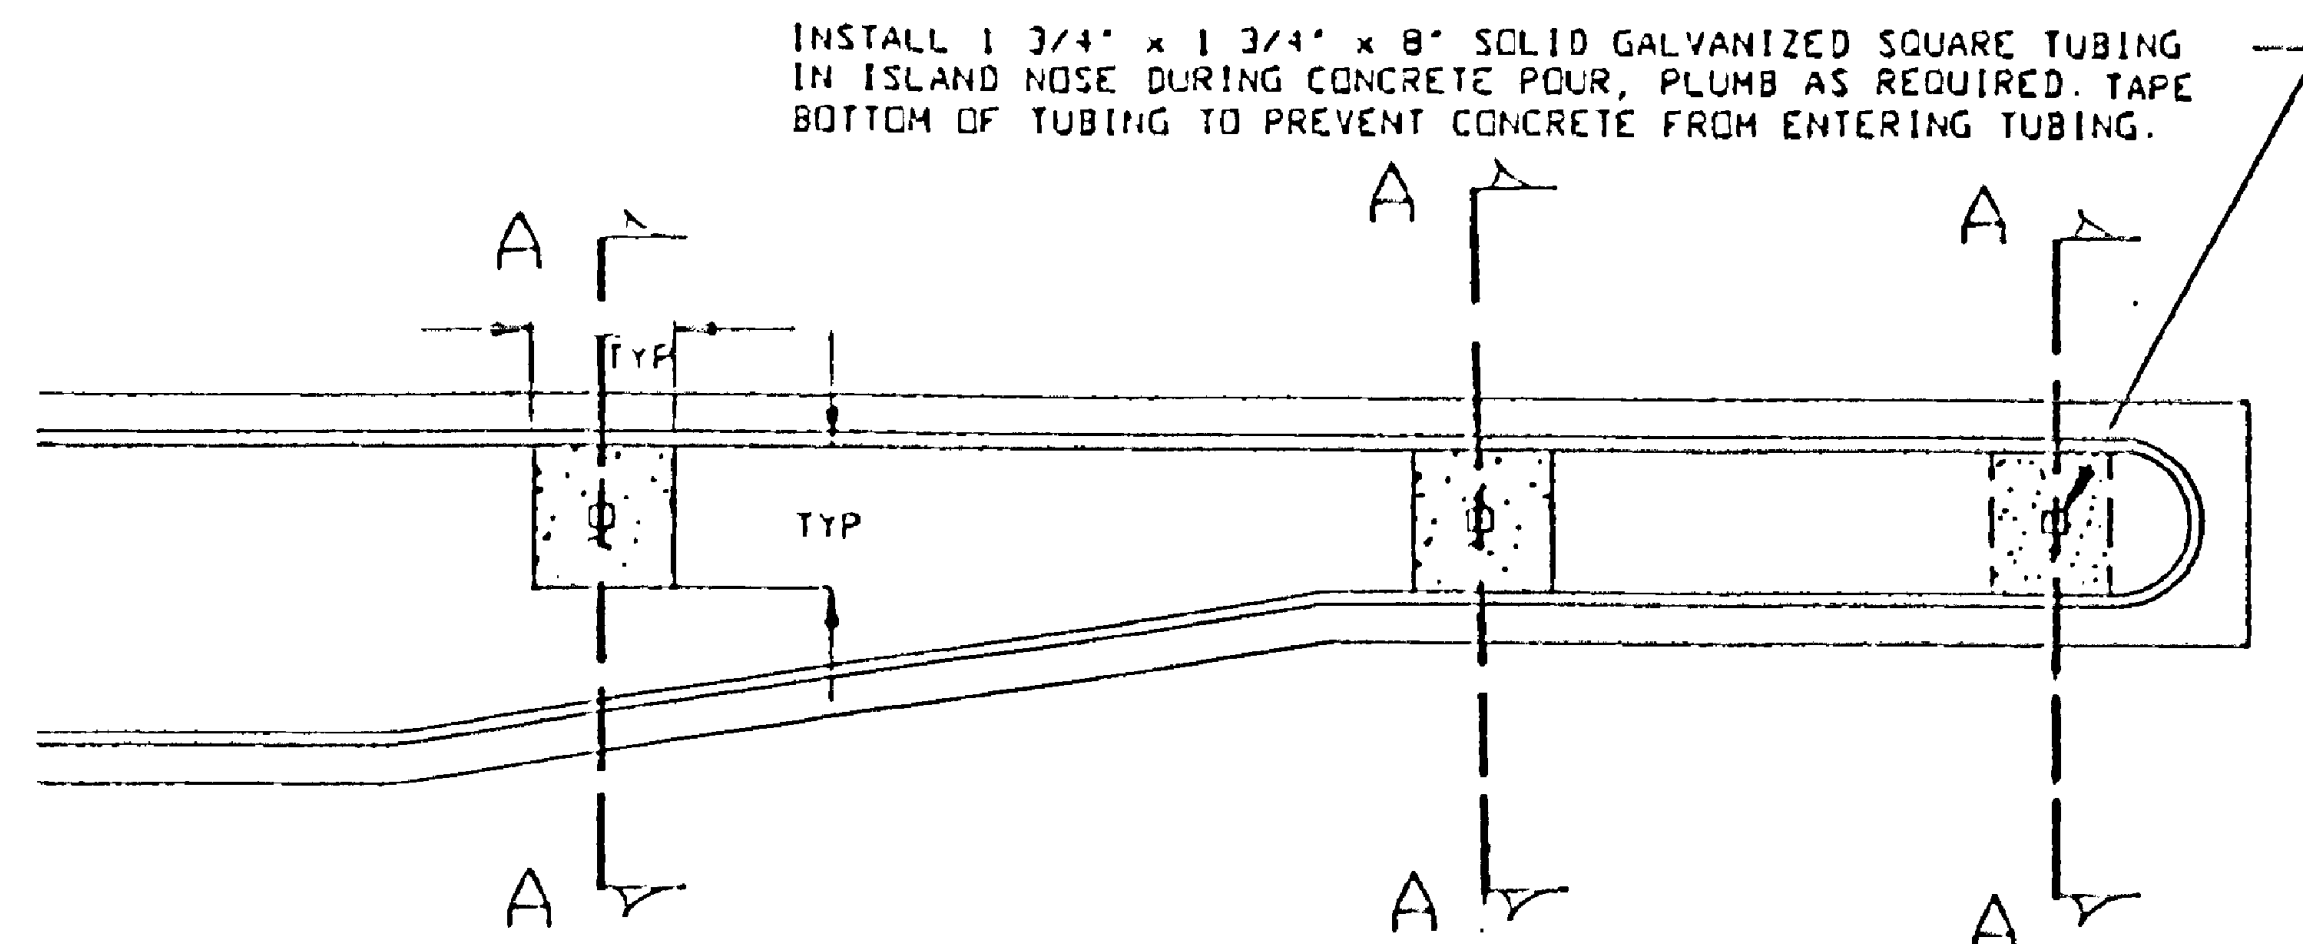


- GENERAL NOTES:
 ALL STRIPING DIMENSIONS ARE IN MILLIMETERS UNLESS NOTED OTHERWISE.
 ALL STRIPING SHALL BE PAINT UNLESS NOTED OTHERWISE.
 PROPOSED SIGN DIMENSIONS ARE GIVEN IN ENGLISH UNITS OF INCHES. (ENGLISH VALUE (1/16") x 0.092903 = METRIC VALUE (m²))
- ANY EXISTING SIGNING NOT SHOWN ON THIS PLAN WHICH FALLS WITHIN THE CONSTRUCTION LIMITS AND WHICH IS STILL APPROPRIATE UNDER THE PERMANENT CONDITION, IN THE OPINION OF THE ENGINEER, SHALL BE TEMPORARILY RELOCATED OUTSIDE OF THE CONSTRUCTION LIMITS BY THE CONTRACTOR. FOLLOWING CONSTRUCTION, THE CONTRACTOR SHALL RELOCATE THE SIGNS AS NEAR AS POSSIBLE TO THEIR ORIGINAL LOCATIONS.
- EXISTING SIGNING NOT SHOWN ON THIS PLAN WHICH IS NOT APPROPRIATE UNDER THE PERMANENT CONDITION, IN THE OPINION OF THE ENGINEER, SHALL BE REMOVED BY THE CONTRACTOR. SUCH REMOVALS SHALL BE CONSIDERED INCIDENTAL TO PERMANENT SIGNING CONSTRUCTION AND NO DIRECT COMPENSATION SHALL BE MADE THEREFOR.
- (A) INSTALL SALVAGED SIGN PANEL.
 - (B) SIGN TO REMAIN IN PLACE.
 - (C) 100 mm SOLID LINE WHITE
 - (D) 100 mm SOLID LINE YELLOW
 - (E) 100 mm BROKEN LINE YELLOW. SKIP RATIO SHALL BE 2.0 m LINE FOLLOWED BY 8.0 m GAP.
 - (F) 100 mm BROKEN LINE WHITE. SKIP RATIO SHALL BE 2.0 m OF LINE FOLLOWED BY 8.0 m GAP FOR C.S.A.H. 17. SKIP RATIO SHALL BE 3.048 m OF LINE FOLLOWED BY 12.192 m GAP FOR I-35W
 - (H) 300 CROSSWALK LINE WHITE.
 - (J) 600 STOP LINE WHITE.
 - (K) PAVEMENT MESSAGE (ARROW)
 - (L) PAVEMENT MESSAGE (ONLY)
 - (N) CROSSWALK MARKING.
 - (P) THIS SIGN OWNED BY:
MINNESOTA LOGOS
201 W. TRAVELERS TRAIL, SUITE 230
BURNSVILLE, MN, 55337
PHONE 895-8499
CONTRACTOR SHALL CONTACT OWNER OF SIGN TO REMOVE AND REINSTALL.
 - (Q) F & I SIGN PANEL ON SIGNAL POLE
 - (R) MOUNTED ON BACK OF R4-7 SIGN POST ASSEMBLY
 - (S) 8 SIGNS MOUNTED ON SIGNAL POLES. REMAINDER MOUNTED ON R1-1 SIGN POST ASSEMBLIES
 - (T) 8 SIGNS MOUNTED ON SIGNAL POLES. 2 SIGNS MOUNTED ON R1-1 SIGN POST ASSEMBLIES.
 - (U) 2 SIGNS MOUNTED IN FREE RIGHT ISLANDS. REMAINDER MOUNTED ON R4-7 SIGN POST ASSEMBLIES.
 - (V) SIGN MOUNTED ON M1-8 SIGN POST ASSEMBLY.
 - (G) NOT USED

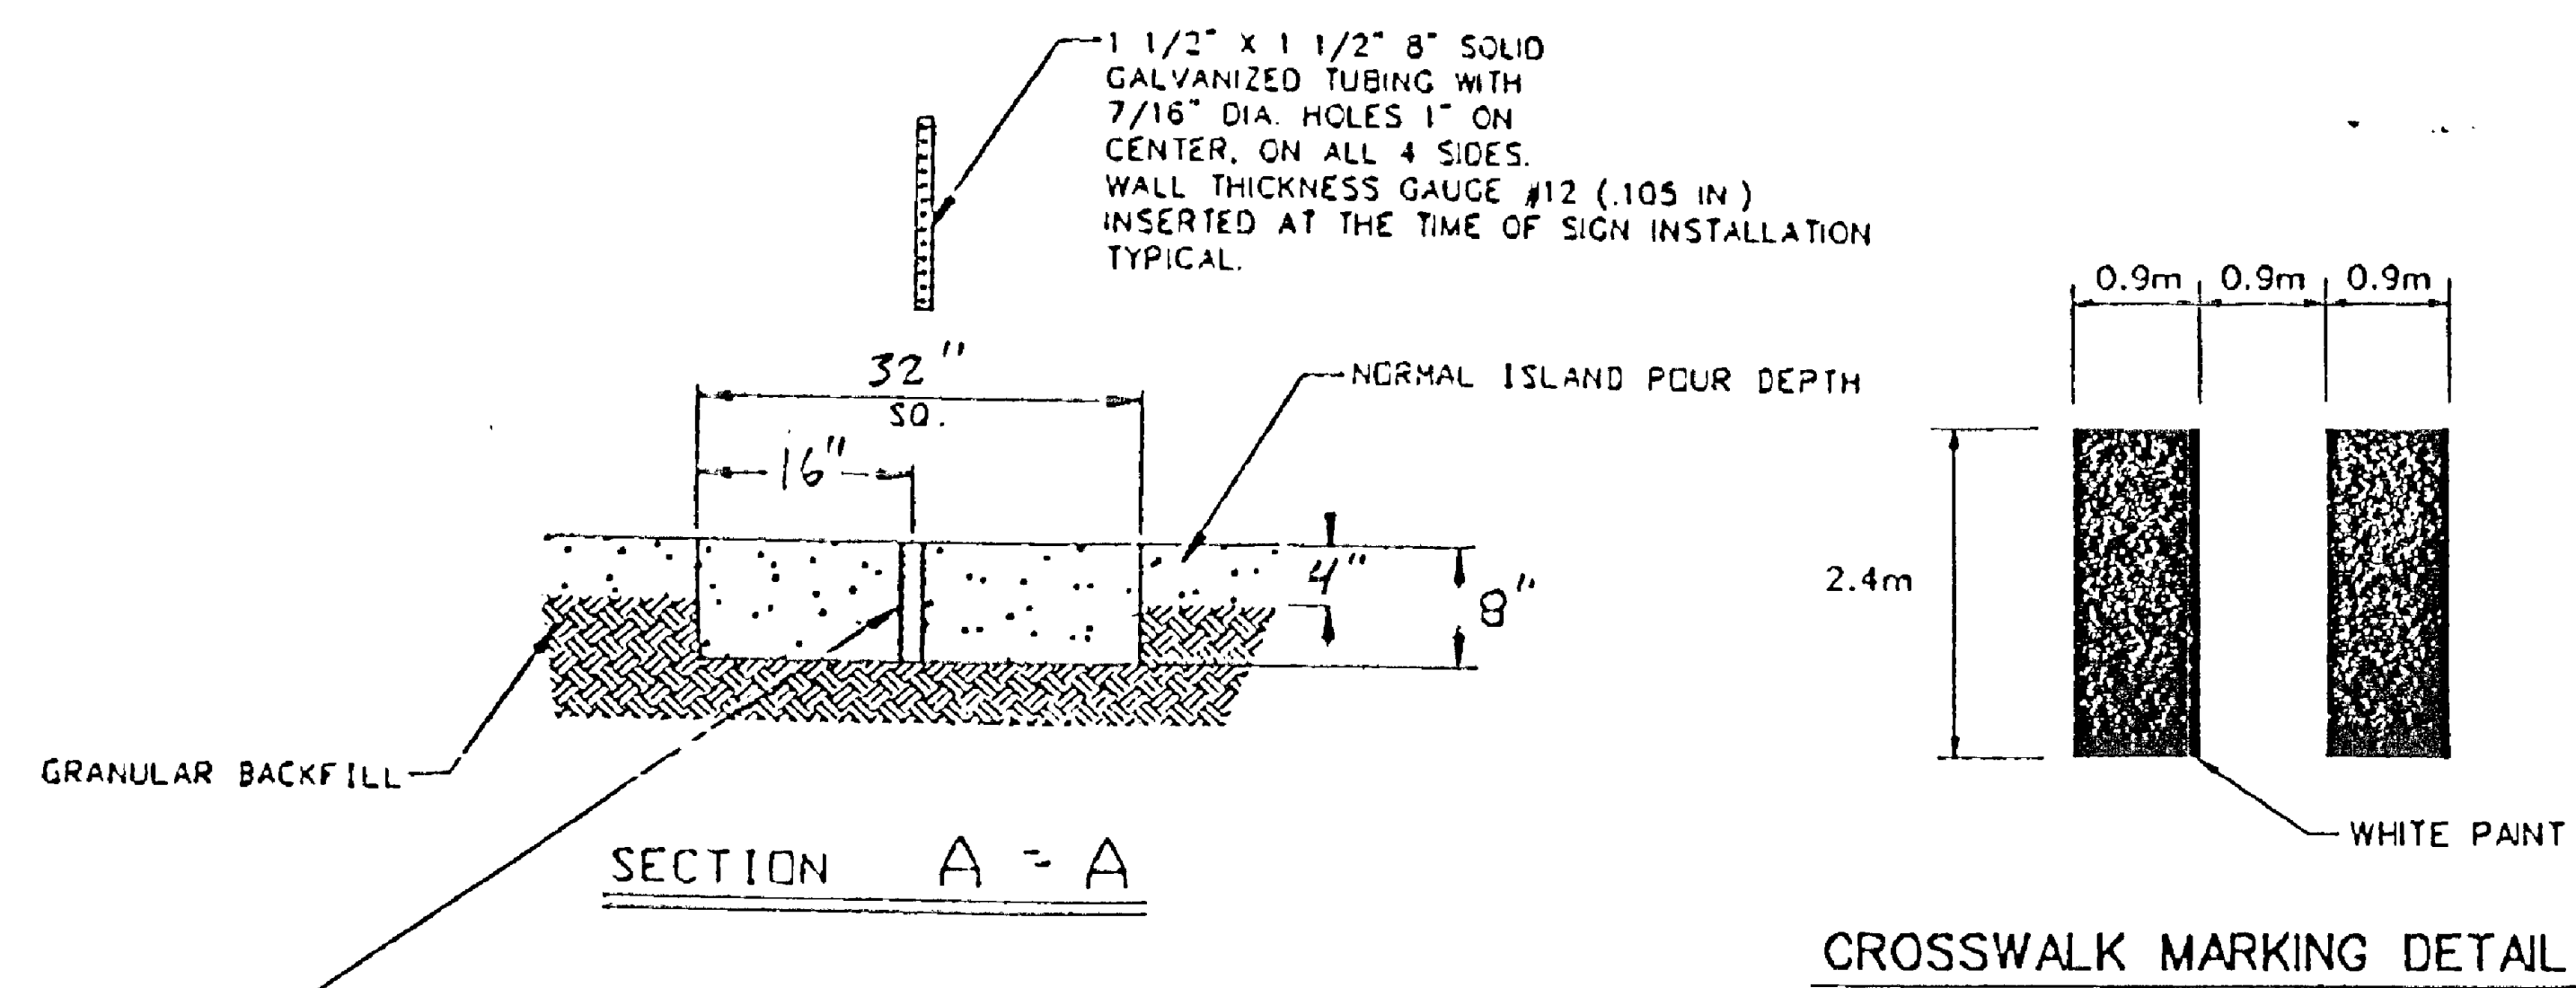


NOTE: SIGN DIMENSIONS IN ENGLISH UNITS THIS SHEET

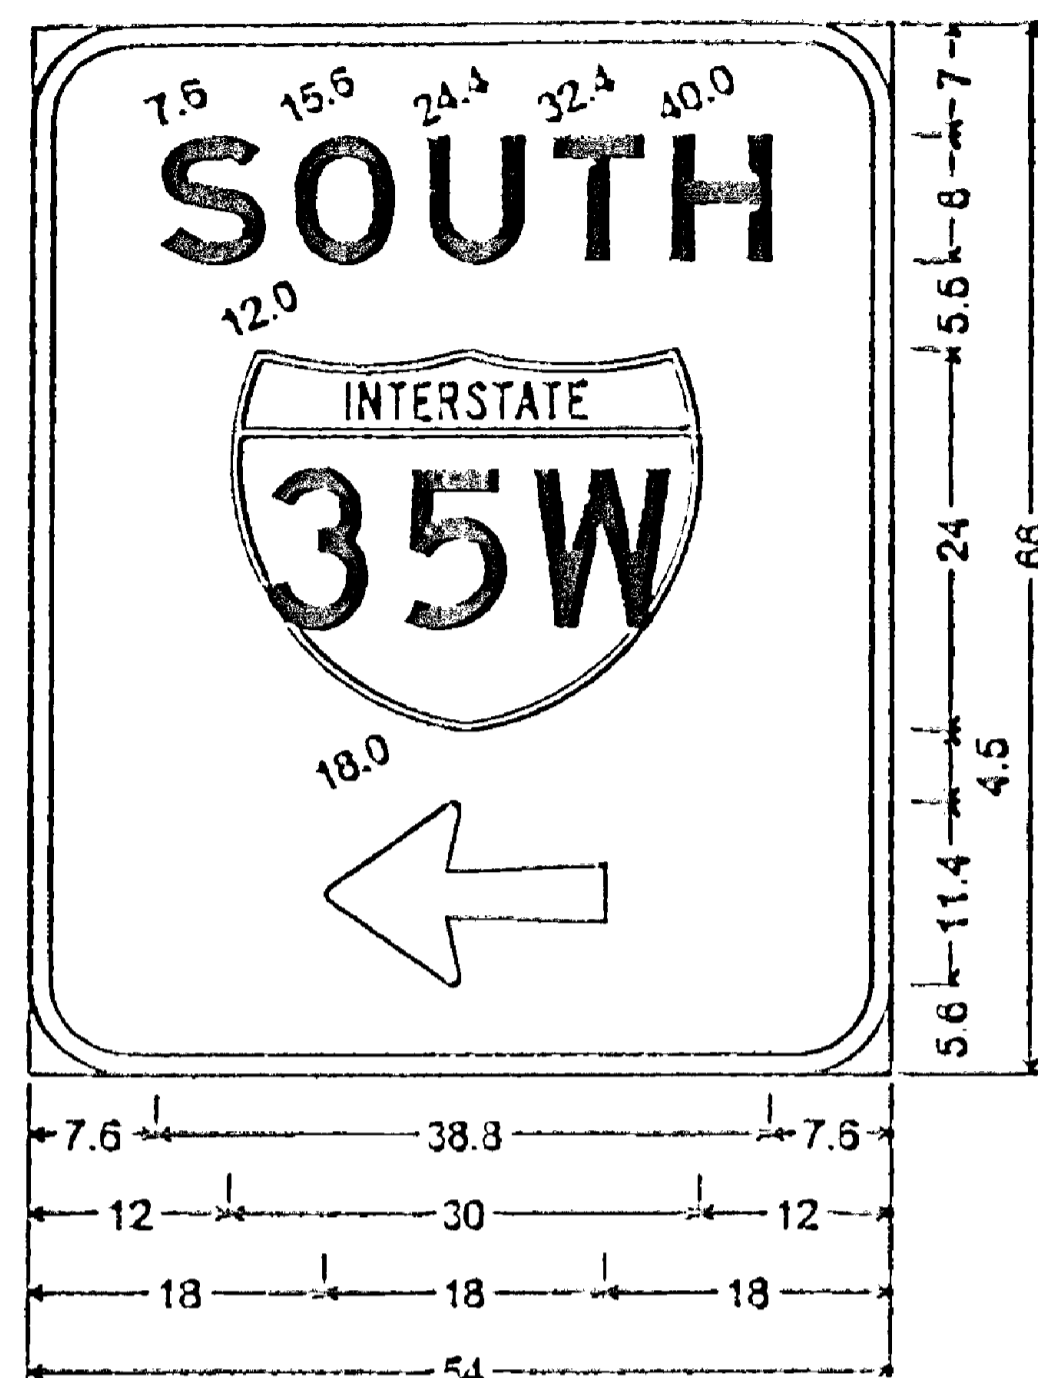


D 1;
6.0" Radius, 1.2" Border, White on Green;
"SOUTH" E Mod; Arrow 14 - 18.0" 180";

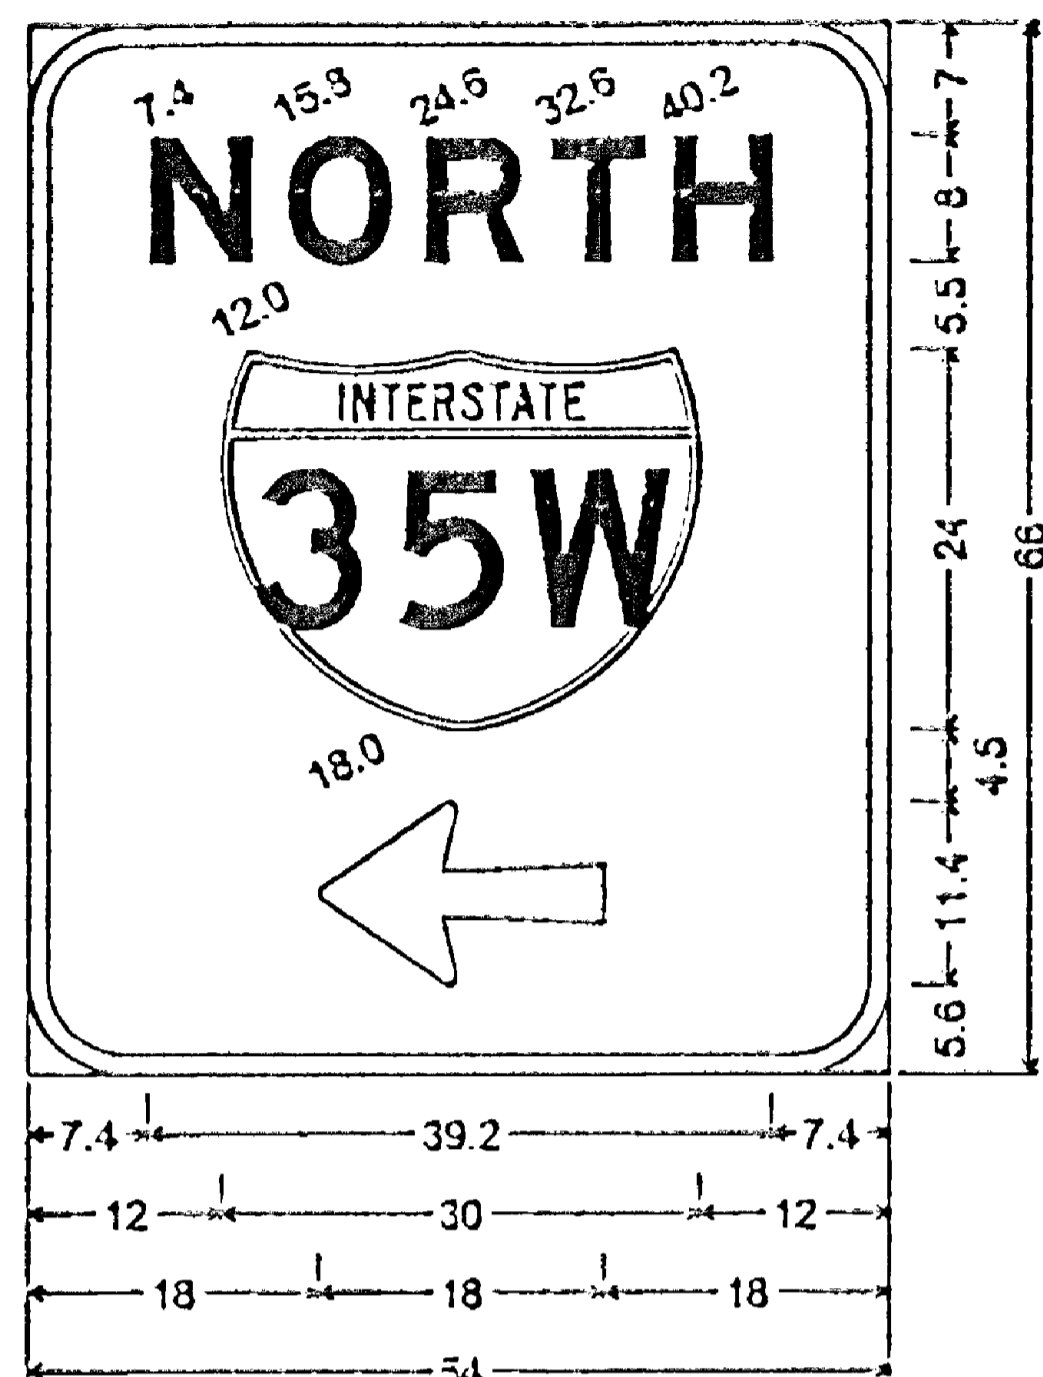

D 2;
6.0" Radius, 1.2" Border, White on Green;
"NORTH" E Mod; Arrow 14 - 18.0" 180";

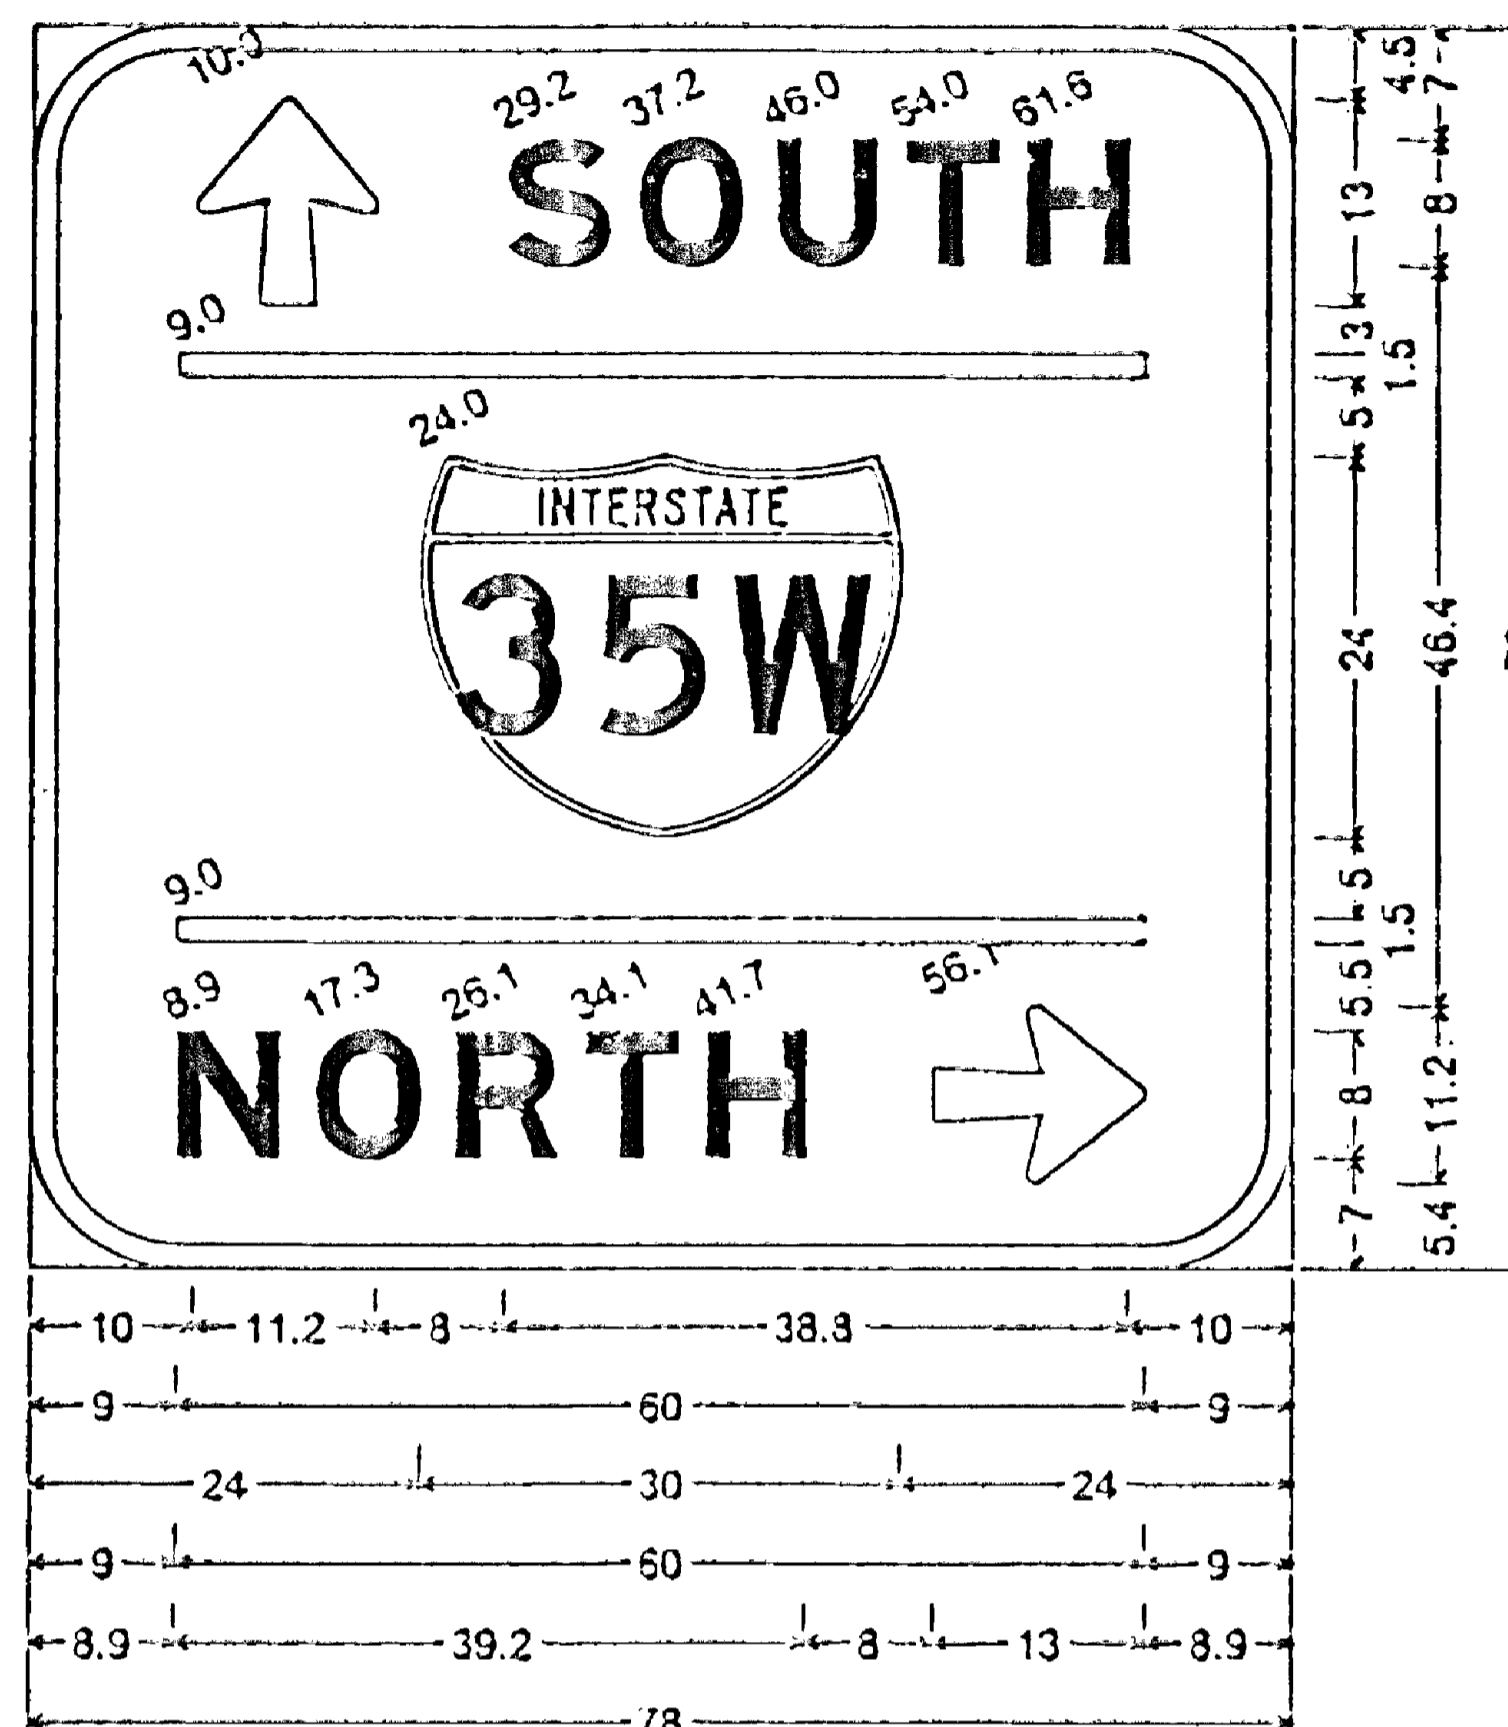

D 3; 9.0" Radius, 1.5" Border, White on Green;
Arrow 5 - 13.0" 90"; "SOUTH" E Mod; "NORTH" E Mod;
Arrow 5 - 13.0" 0";

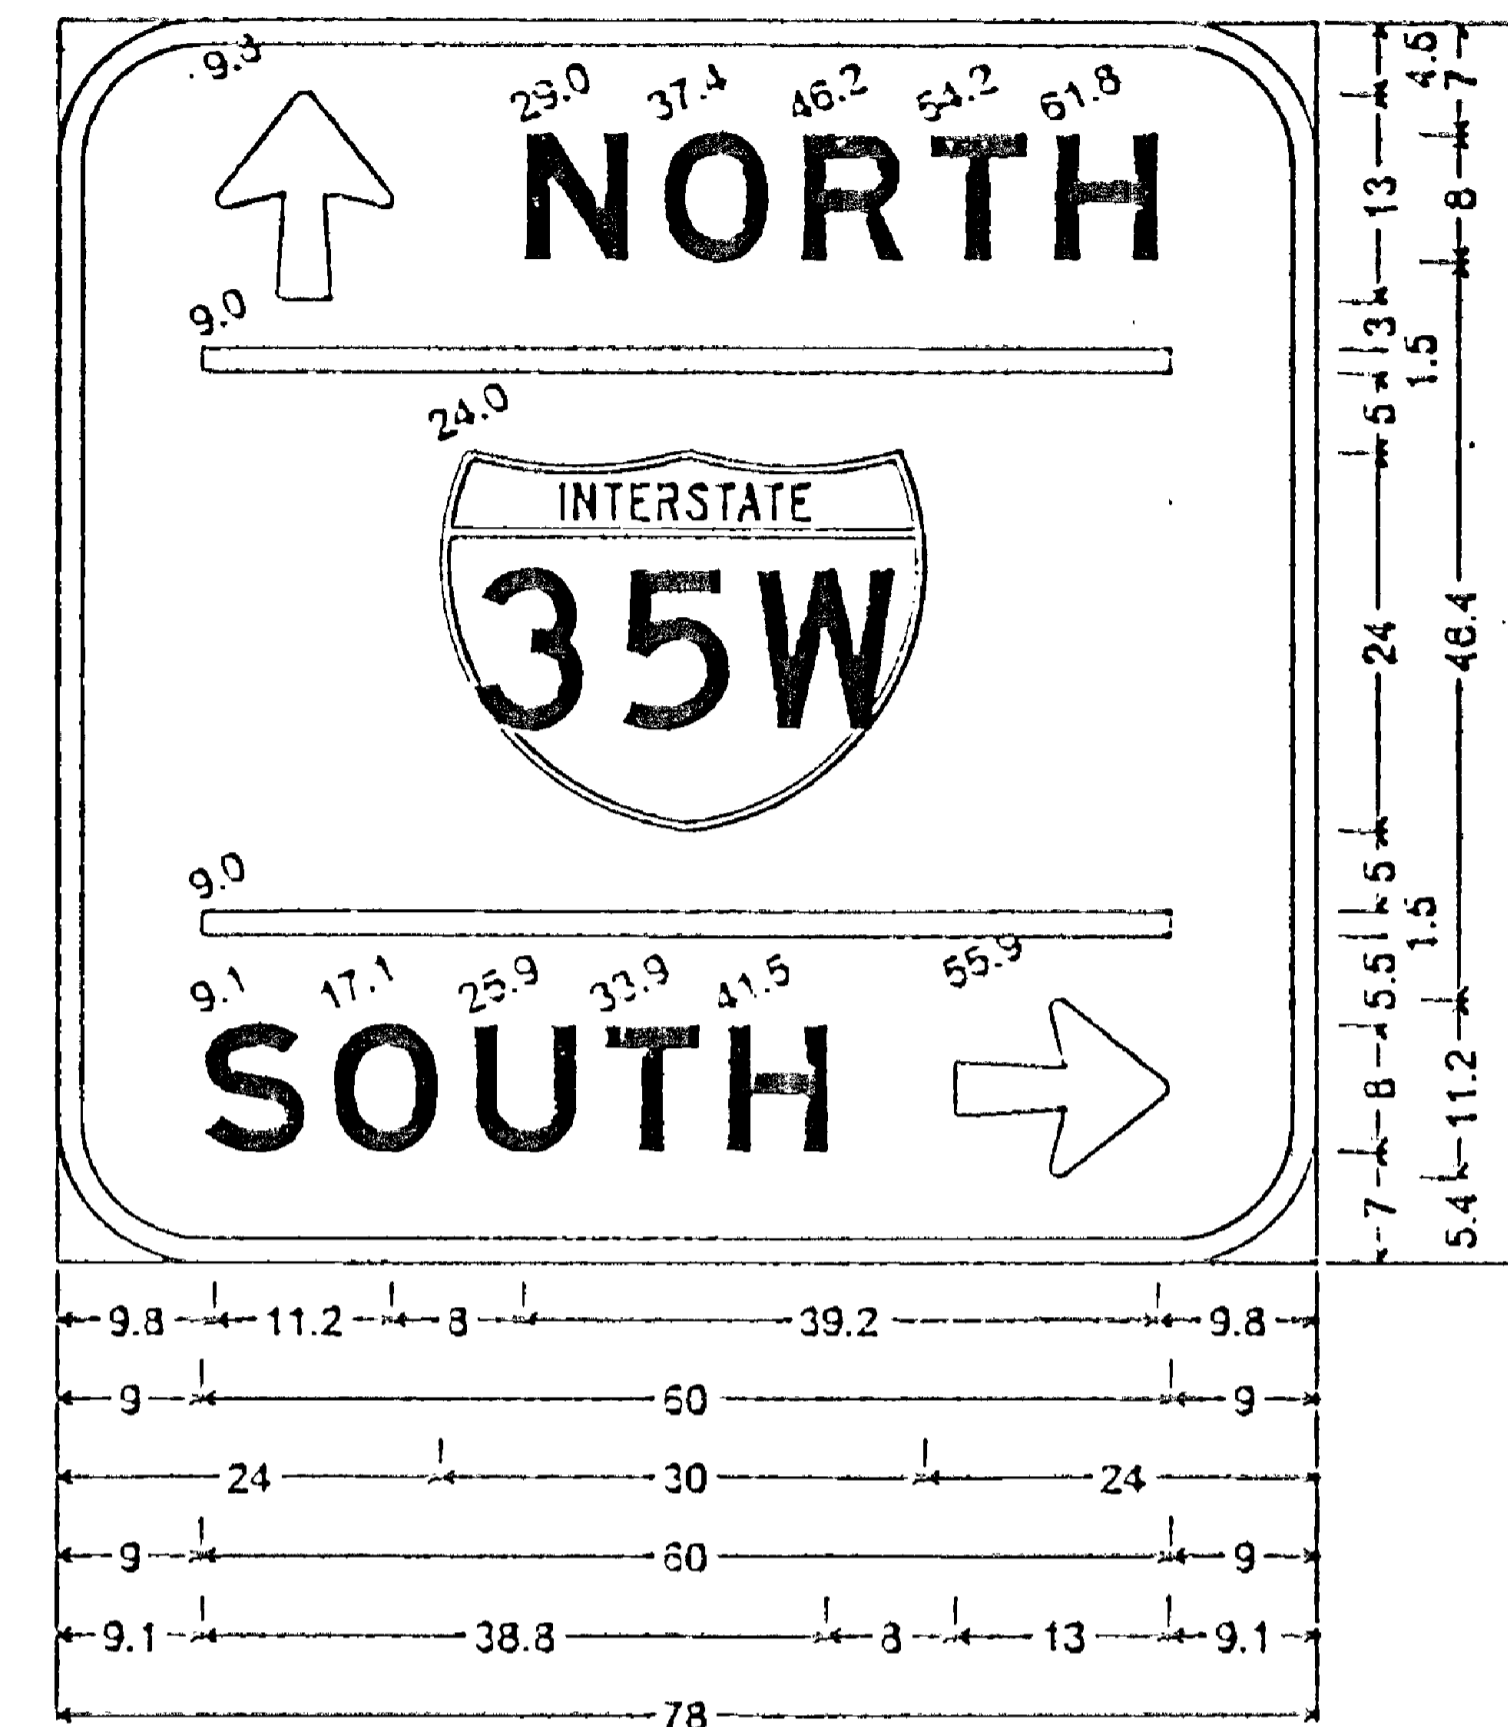

D 4; 9.0" Radius, 1.5" Border, White on Green;
Arrow 5 - 13.0" 90"; "NORTH" E Mod; "SOUTH" E Mod;
Arrow 5 - 13.0" 0";

NOTES:

- 1) COLOR - HIGH INTENSITY WHITE LEGEND AND BORDER ON HIGH INTENSITY GREEN BACKGROUND, FULLY REFLECTORIZED.
- 2) CORNERS EXTENDING BEYOND THE BORDER SHALL NOT BE TRIMMED.
- 3) SEE STANDARD SIGN MANUAL FOR ARROW DETAILS.
- 4) FOR STRUCTURAL DETAILS, TYPE "D" SIGNS, SEE STANDARD SIGNS MANUAL, PAGE 105B.
- 5) FOR TYPE "D" STRINGER AND PANEL - JOINT DETAIL, SEE STANDARD SIGNS MANUAL, PAGE 105.

NOTE: THIS SHEET IN ENGLISH UNITS.

1	4-24-97	MAB	CMS	REVISE SIGN PANEL
NO	DATE	BY	CHKD	APPROV
				REVISION
NAME: H:\CIVIL\SGN4R410.PLN DATE: APRIL 24, 1997				

I hereby certify that this plan, specification or report was prepared by me or under my direct supervision and that I am a duly Registered Professional Engineer under the laws of the State of Minnesota.
George M. Stuempfig
Date: 4/24/97 Reg. No. 21849



STATE AID PROJECT NO. SAP 02-617-11
STATE PROJECT NO. SP 0280-47

DRAWN BY DATE M. ISAKKA 3-97
DESIGNED BY M. BRESSLER 3-97
CHECKED BY G. STUEMPFIG 3-97
COMM. NO. 0962410




ANOKA COUNTY
TYPE "D" SIGN DETAILS
C.S.A.H. 17 RECONSTRUCTION


SHEET 112 OF 236

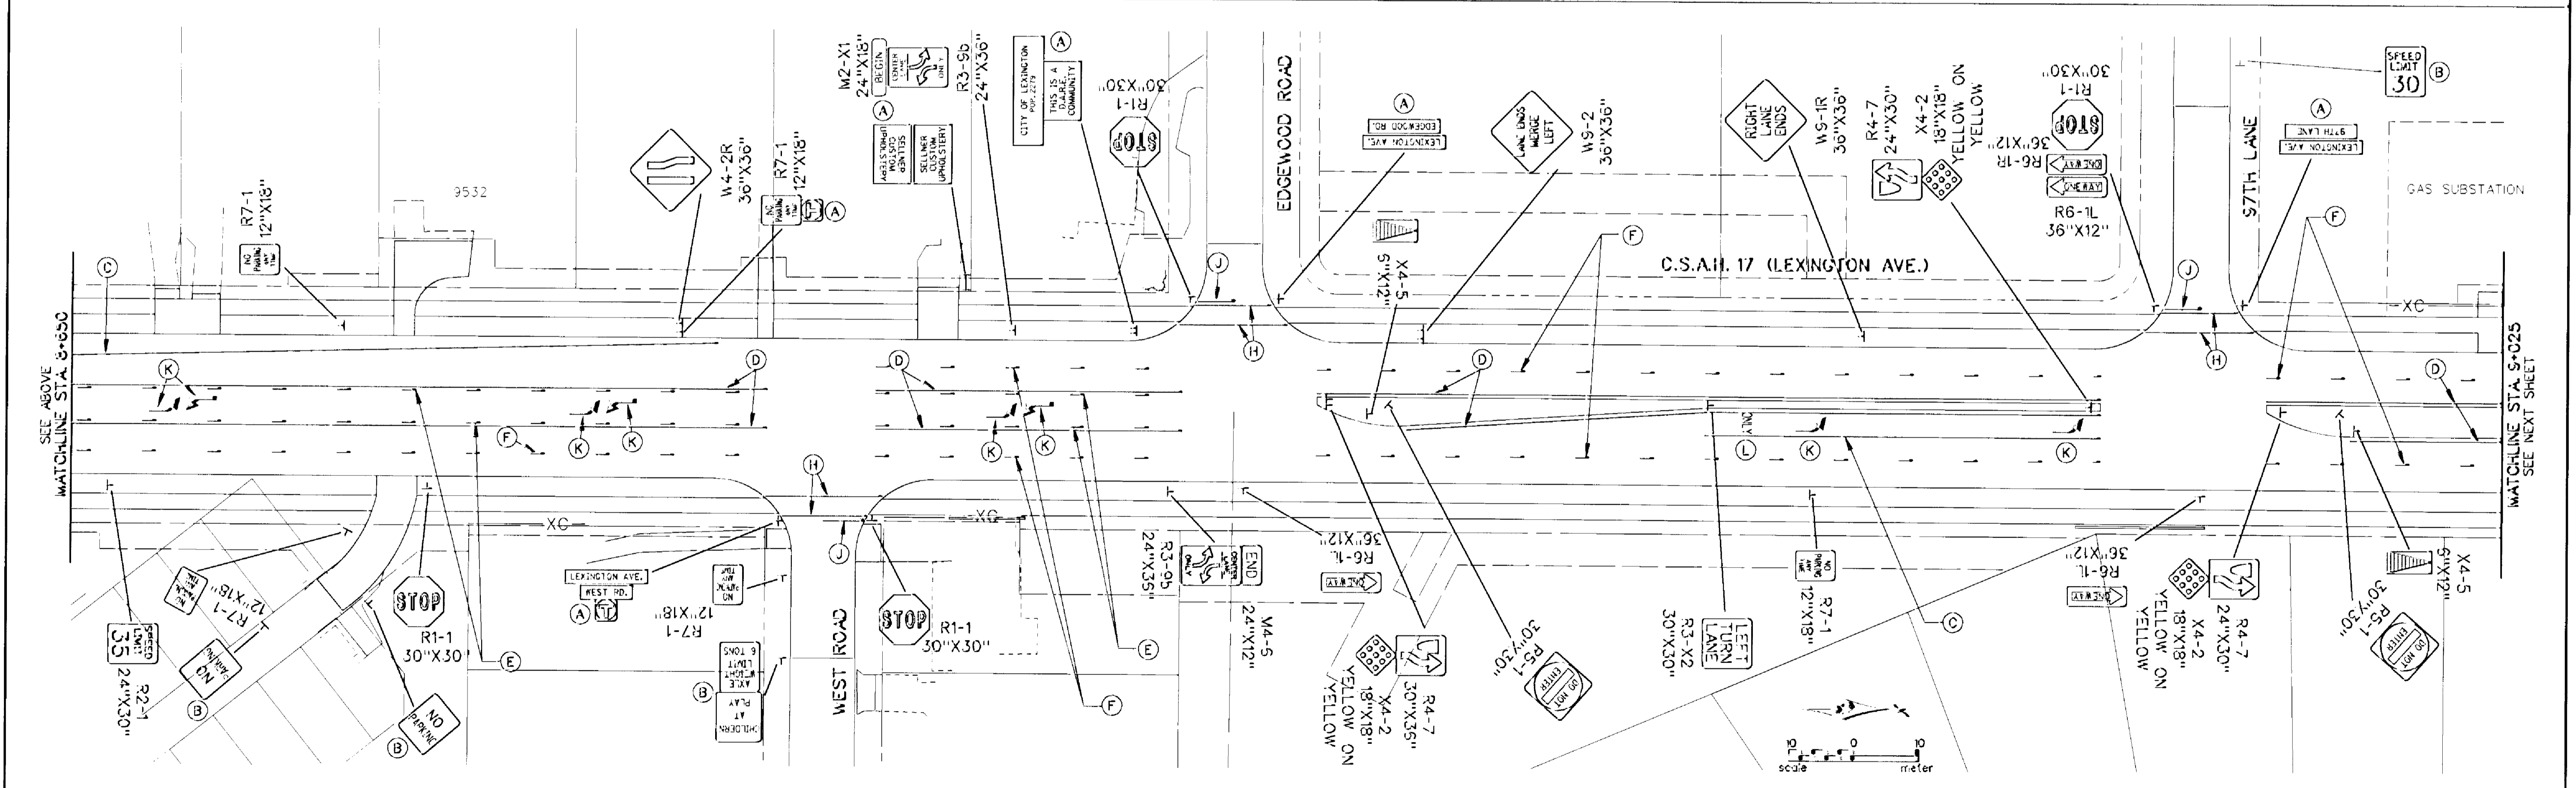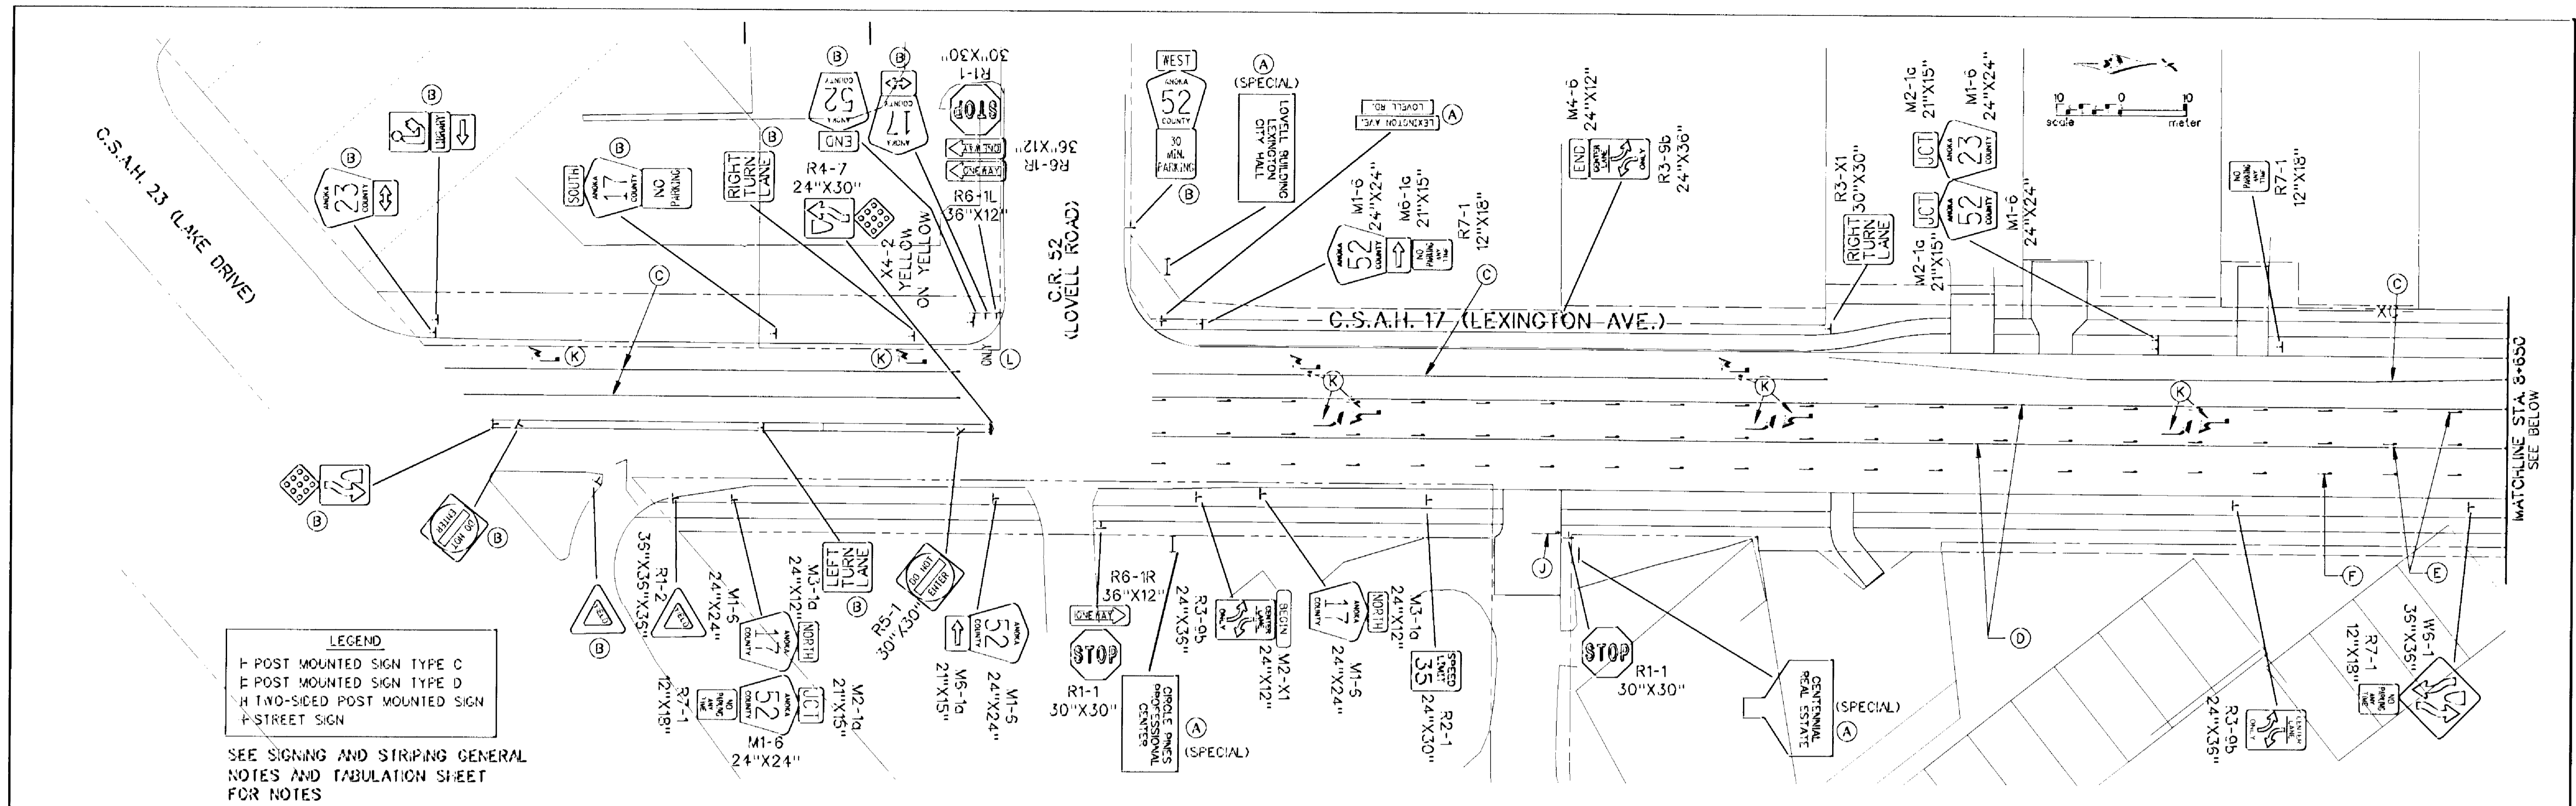



1	3-28-97	MCI	DAD	ACHD	COMMENT
NO	DATE	BY	CHKD	APPR	REVISION
NAME: SSP1 410.PLN DATE: Mar. 20, 1997					


 I hereby certify that this plan, specification or report was prepared by me or under my direct supervision and that I am a duly Registered Professional Engineer under the laws of the State of Minnesota.
Donald A. Omes
 Date 3-21-97 Reg. No. 23397

STATE AID PROJECT NO. S.A.P. 02-617-11
 S.A.P. 108-020-12
 S.A.P. 108-030-03
 CO. PROJECT NO. COMM. NO. 0962410

DRAWN BY V. GRAF DATE 11-98
 DESIGNED BY D. DEMERS DATE 11-98
 CHECKED BY B. MOORE DATE 3-97


ANOKA COUNTY
 SIGNING AND STRIPING PLAN
 C.S.A.H. 17 RECONSTRUCTION
 STA. 8+358 TO STA. 9+025
 SHEET 113 OF 236

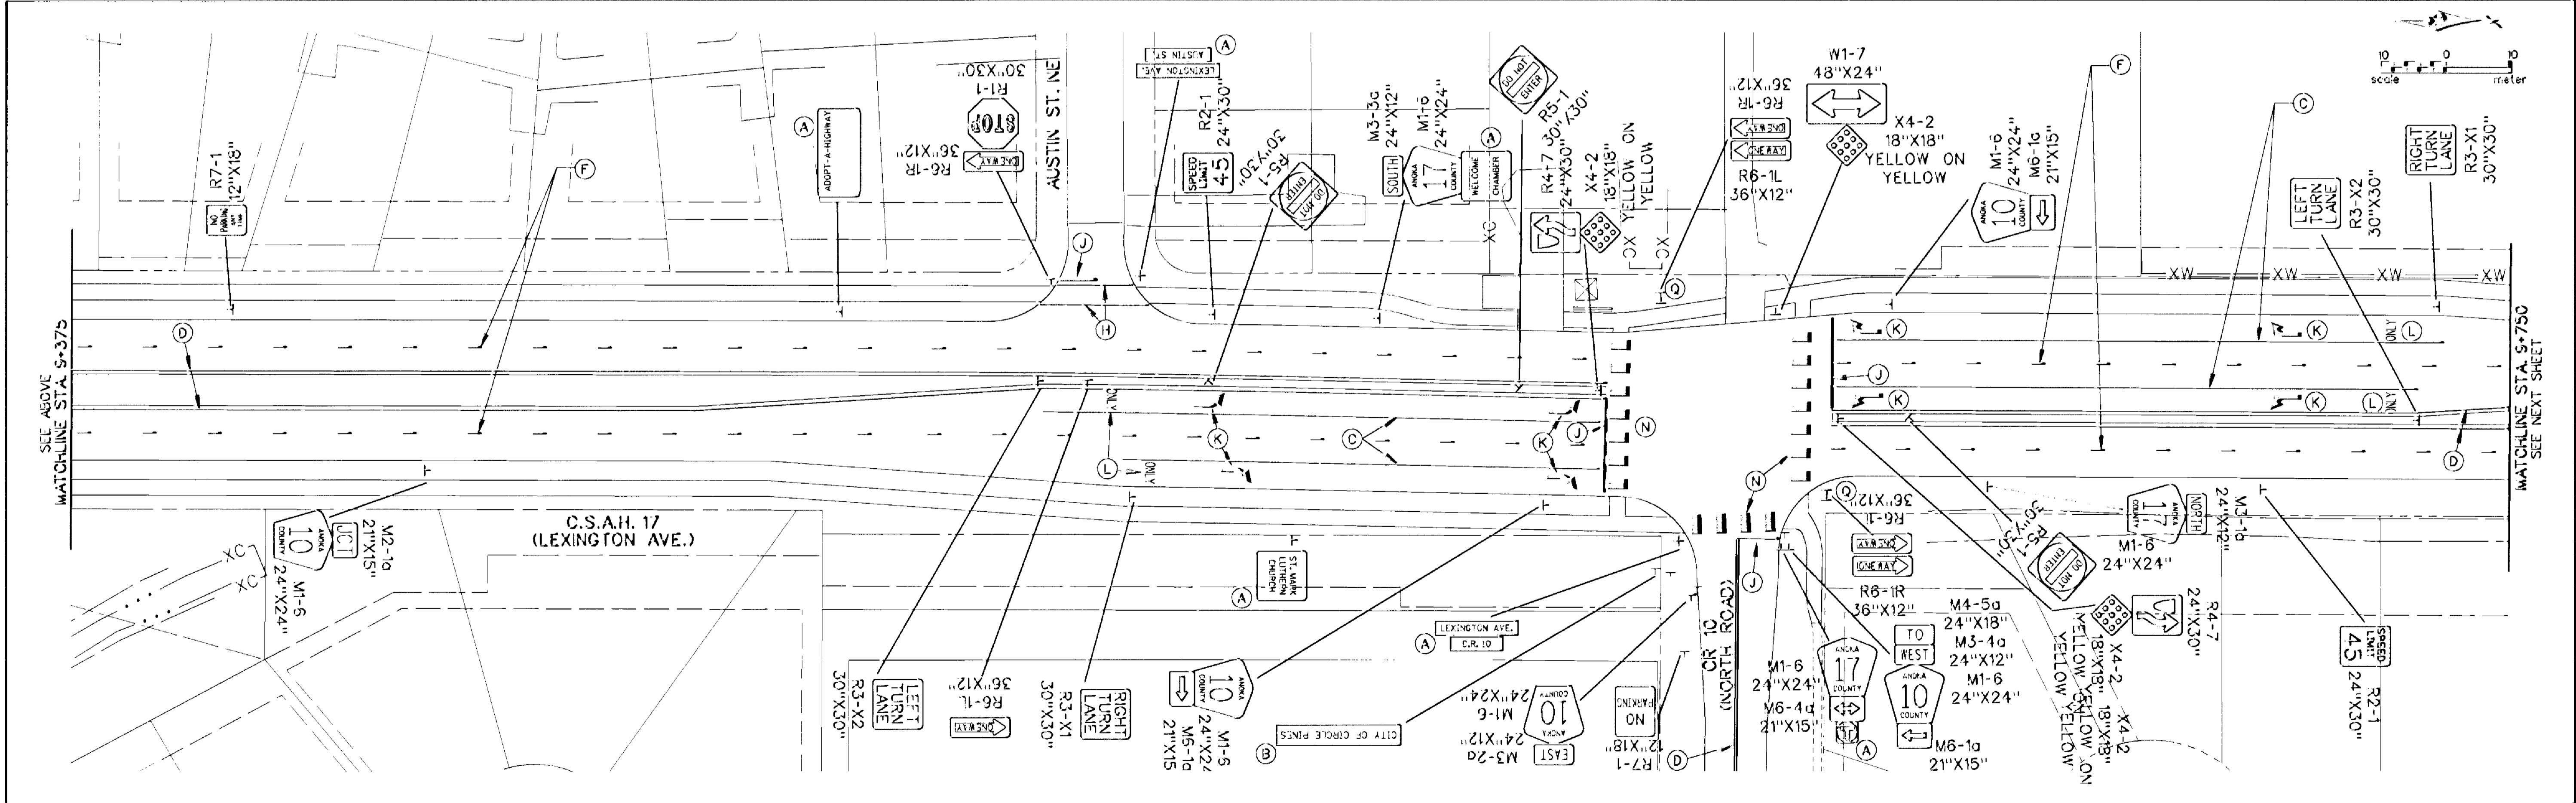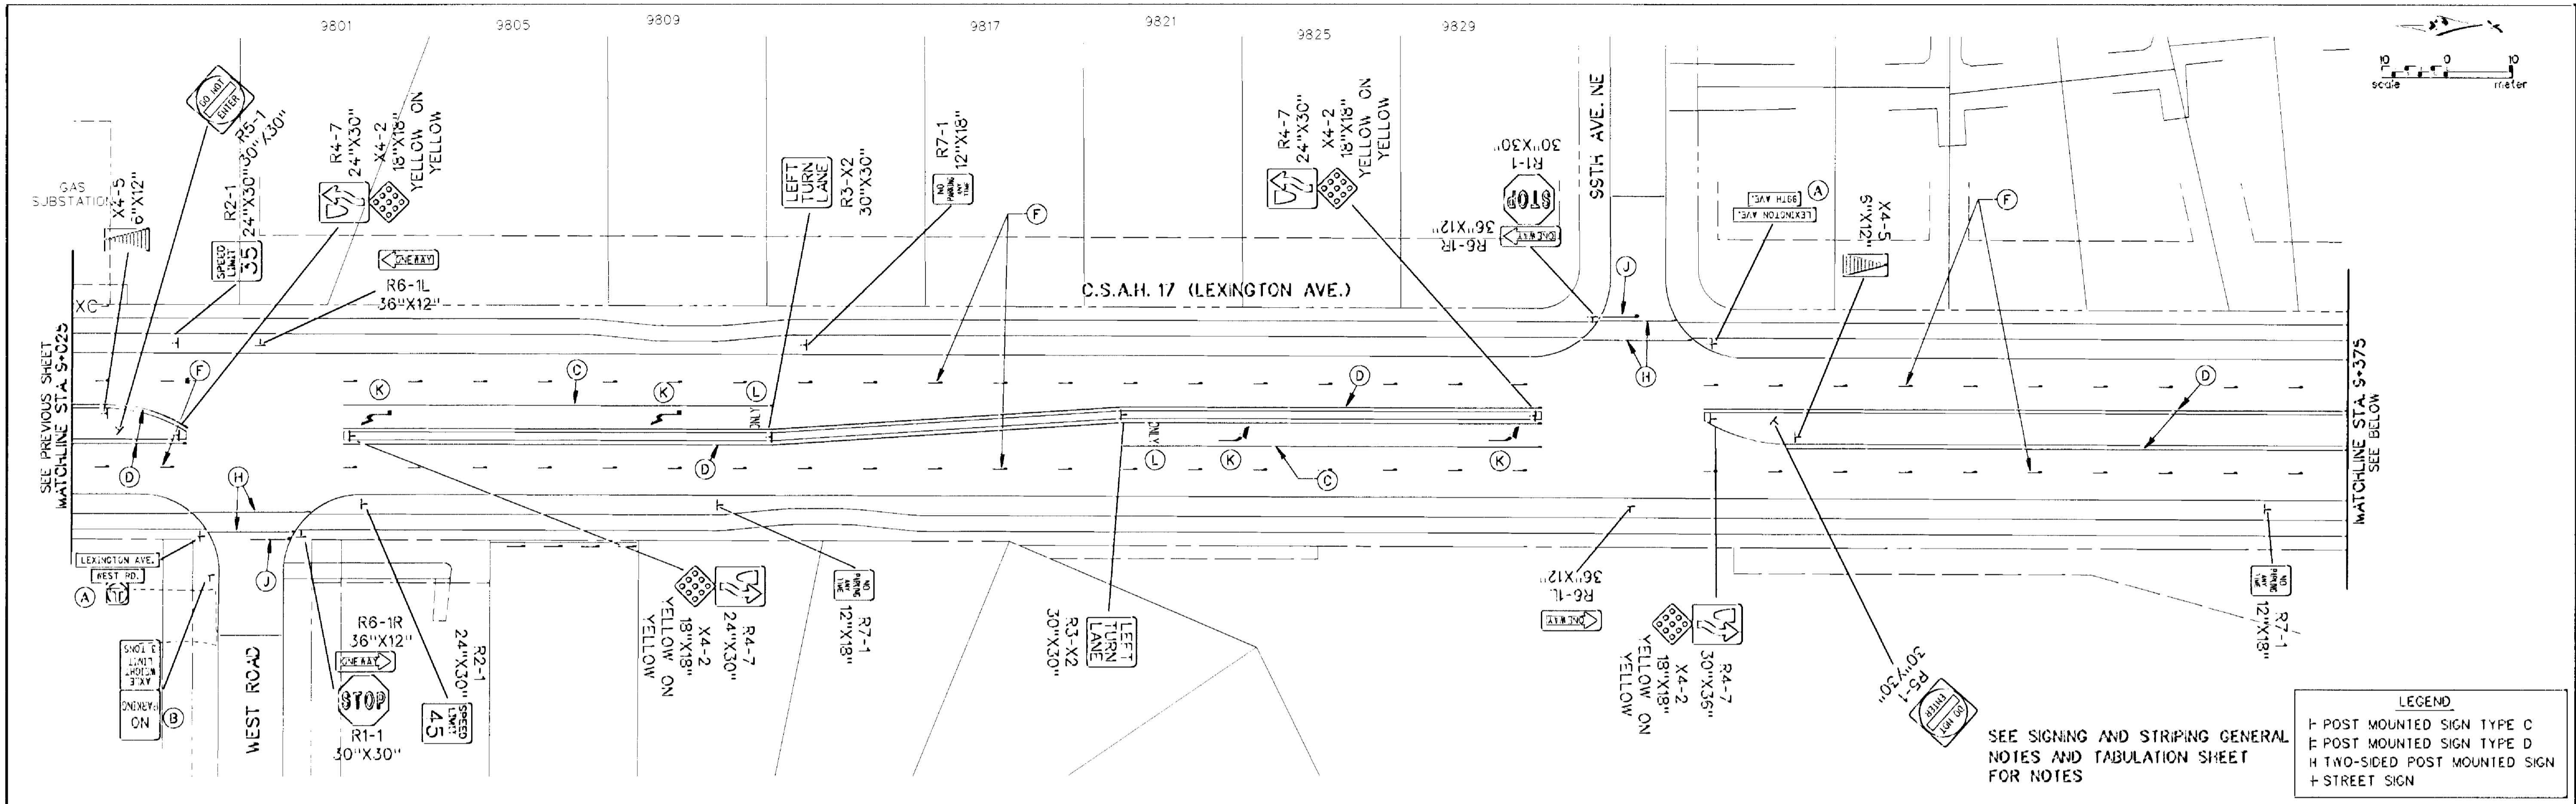

NO.	DATE	BY	CHK	APPR	REVISION

NAME: SSP2 410.PLN DATE: Mar. 17, 1997

minnesota metric


I hereby certify that this plan, specification or report was prepared by me or under my direct supervision and that I am a duly Registered Professional Engineer under the laws of the State of Minnesota.

Donald A. Demus

Date: 3-21-97 Reg. No. 23397



STATE AID PROJECT NO. S.A.P. 02-617-11 S.A.P. 108-020-12 S.A.P. 108-030-03 CO. PROJECT NO.

DRAWN BY: M. GRAF DATE: 11-96
 DESIGNED BY: D. DEMERS DATE: 11-96
 CHECKED BY: B. MOORE DATE: 3-97
 COMM. NO.: 0962410

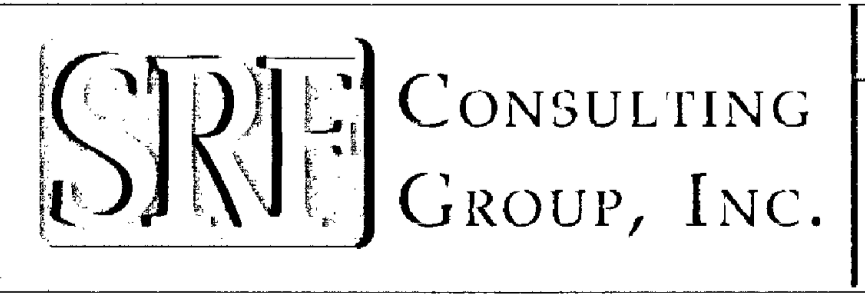


ANOKA COUNTY
 SIGNING AND STRIPING PLAN
 C.S.A.H. 17 RECONSTRUCTION
 STA. 9+025 TO STA. 9+750

SHEET 114 OF 236

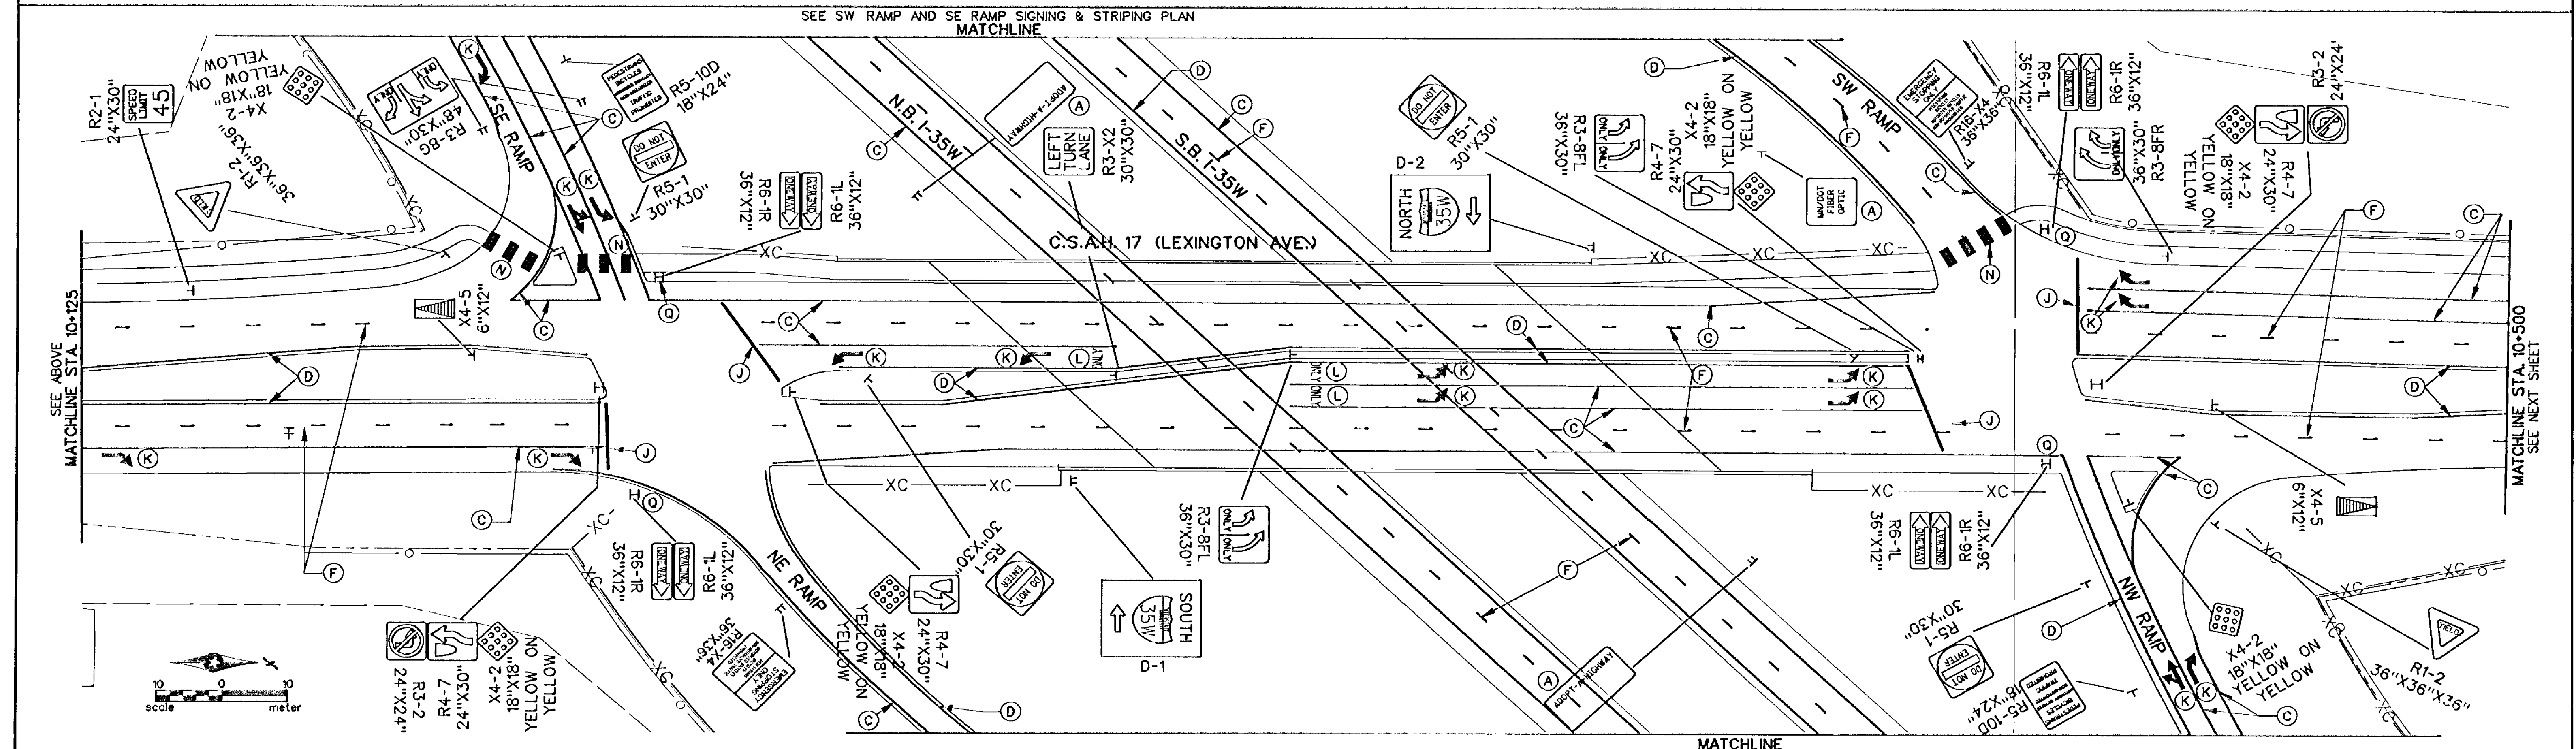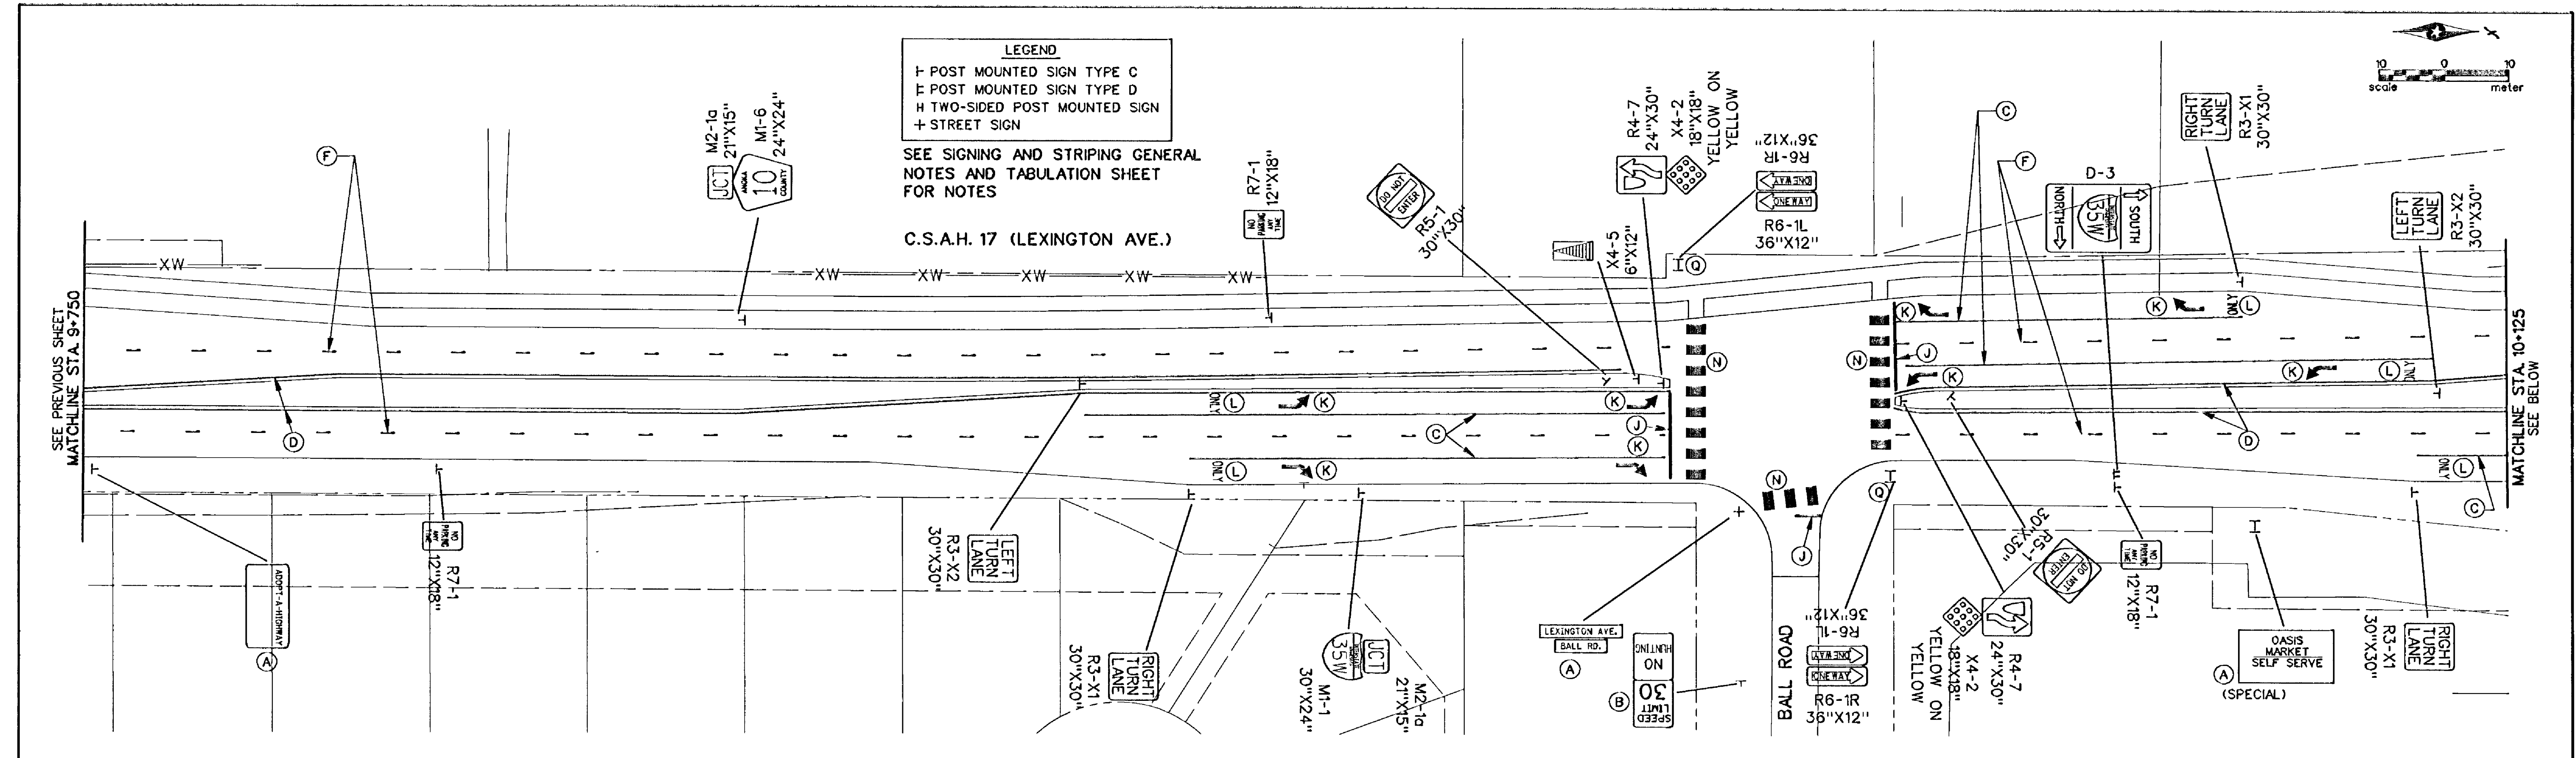

NO	DATE	BY	CHKD	APPR	REVISION
1	3-28-97	MCI		DAD	REVISE NORTH MEDIAN NOSE AT BALL RD.
2	4-24-97	MCI		DAD	DELETE R3-4, R8-1R TO NEAR SIDE

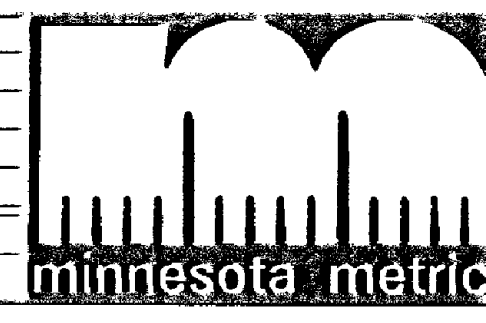

I hereby certify that this plan, specification or report was prepared by me or under my direct supervision and that I am a duly Registered Professional Engineer under the laws of the State of Minnesota.

Donald A. Demers
 Date 3-21-97 Reg. No. 23317


STATE AID PROJECT NO.
 S.A.P. 02-617-11
 S.A.P. 108-020-12
 S.A.P. 106-030-03
 CO. PROJECT NO.

DRAWN BY DATE
 V. GRAF 11-98
 DESIGNED BY
 D. DEMERS 11-98
 CHECKED BY
 B. MOORE 3-97
 COMM. NO.
 0962410




ANOKA COUNTY
 SIGNING AND STRIPING PLAN
 C.S.A.H. 17 RECONSTRUCTION
 STA. 9+750 TO STA. 10+500

SHEET
 115
 OF
 236

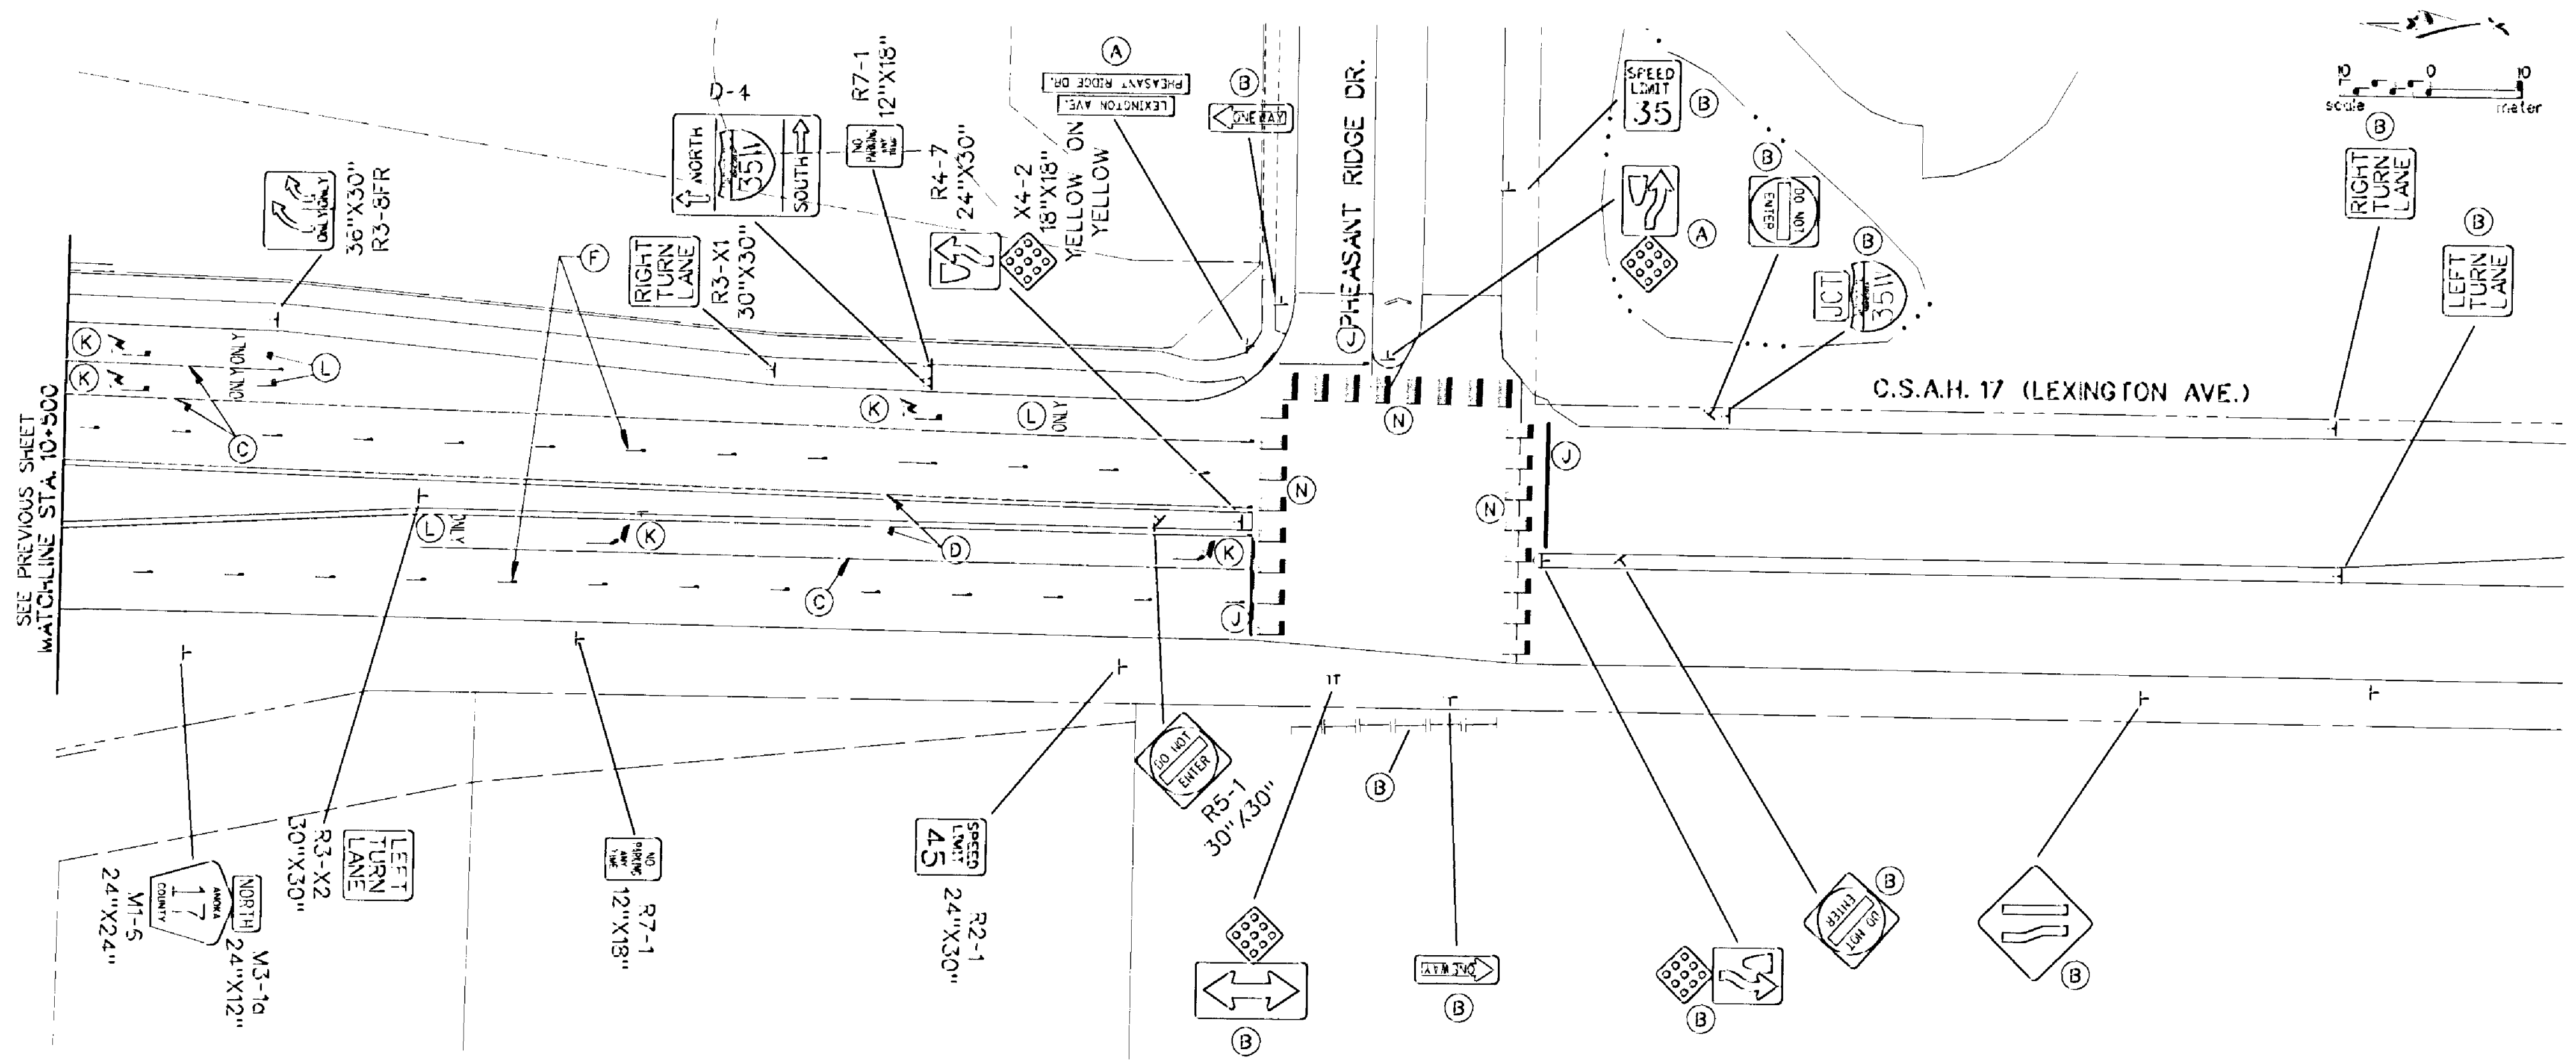

LEGEND
 F POST MOUNTED SIGN TYPE C
 F POST MOUNTED SIGN TYPE D
 H TWO-SIDED POST MOUNTED SIGN
 + STREET SIGN

SEE SIGNING AND STRIPING GENERAL NOTES AND TABULATION SHEET FOR NOTES

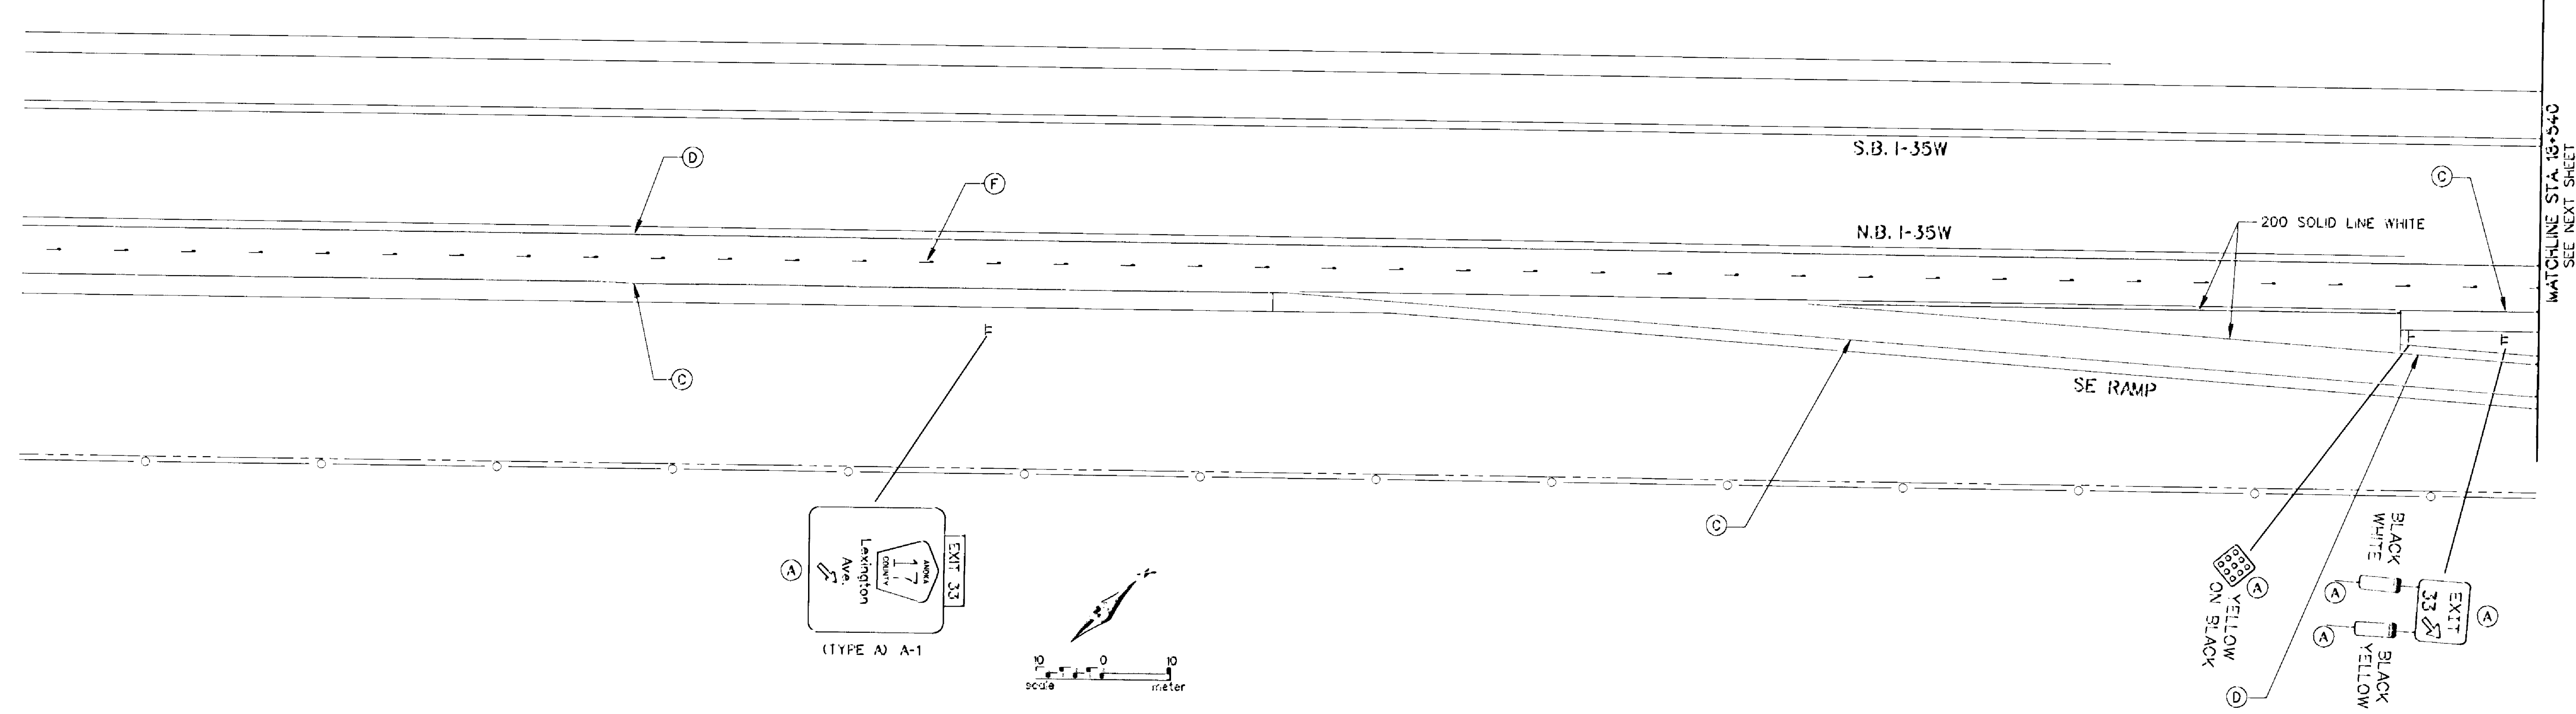

1	3-26-97	MCI	DAD	REVISE WEST MEDIAN NOSE
NO	DATE	BY	CKD	APPR
NAME: SSP 410.PLN DATE: Mar. 20, 1997				

minnesota metric
 I hereby certify that this plan, specification or report was prepared by me or under my direct supervision and that I am a duly Registered Professional Engineer under the laws of the State of Minnesota.
Donald A. Demers
 Date 3-21-97 Reg. No. 23397


STATE AND PROJECT NO.
 S.A.P. 02-617-11
 S.A.P. 108-020-12
 S.A.P. 108-030-03
 CO. PROJECT NO.
 DRAWN BY V. GRAF DATE 11-96
 DESIGNED BY D. DEMERS DATE 11-96
 CHECKED BY B. MOORE DATE 3-97
 COMM. NO. 0962410

SRTI CONSULTING GROUP, INC.


ANOKA COUNTY
 SIGNING AND STRIPING PLAN
 C.S.A.H. 17 RECONSTRUCTION
 STA. 10+500 TO STA. 10+660 AND SE RAMP

SHEET 116 OF 236

LEGEND	
F	POST MOUNTED SIGN TYPE C
F	POST MOUNTED SIGN TYPE D
H	TWO-SIDED POST MOUNTED SIGN
+	STREET SIGN

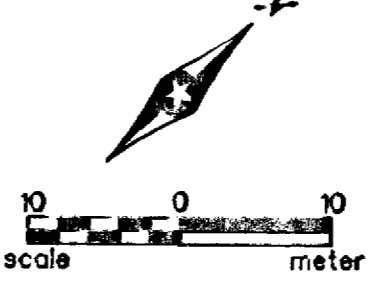

SEE SIGNING AND STRIPING GENERAL NOTES AND TABULATION SHEET FOR NOTES

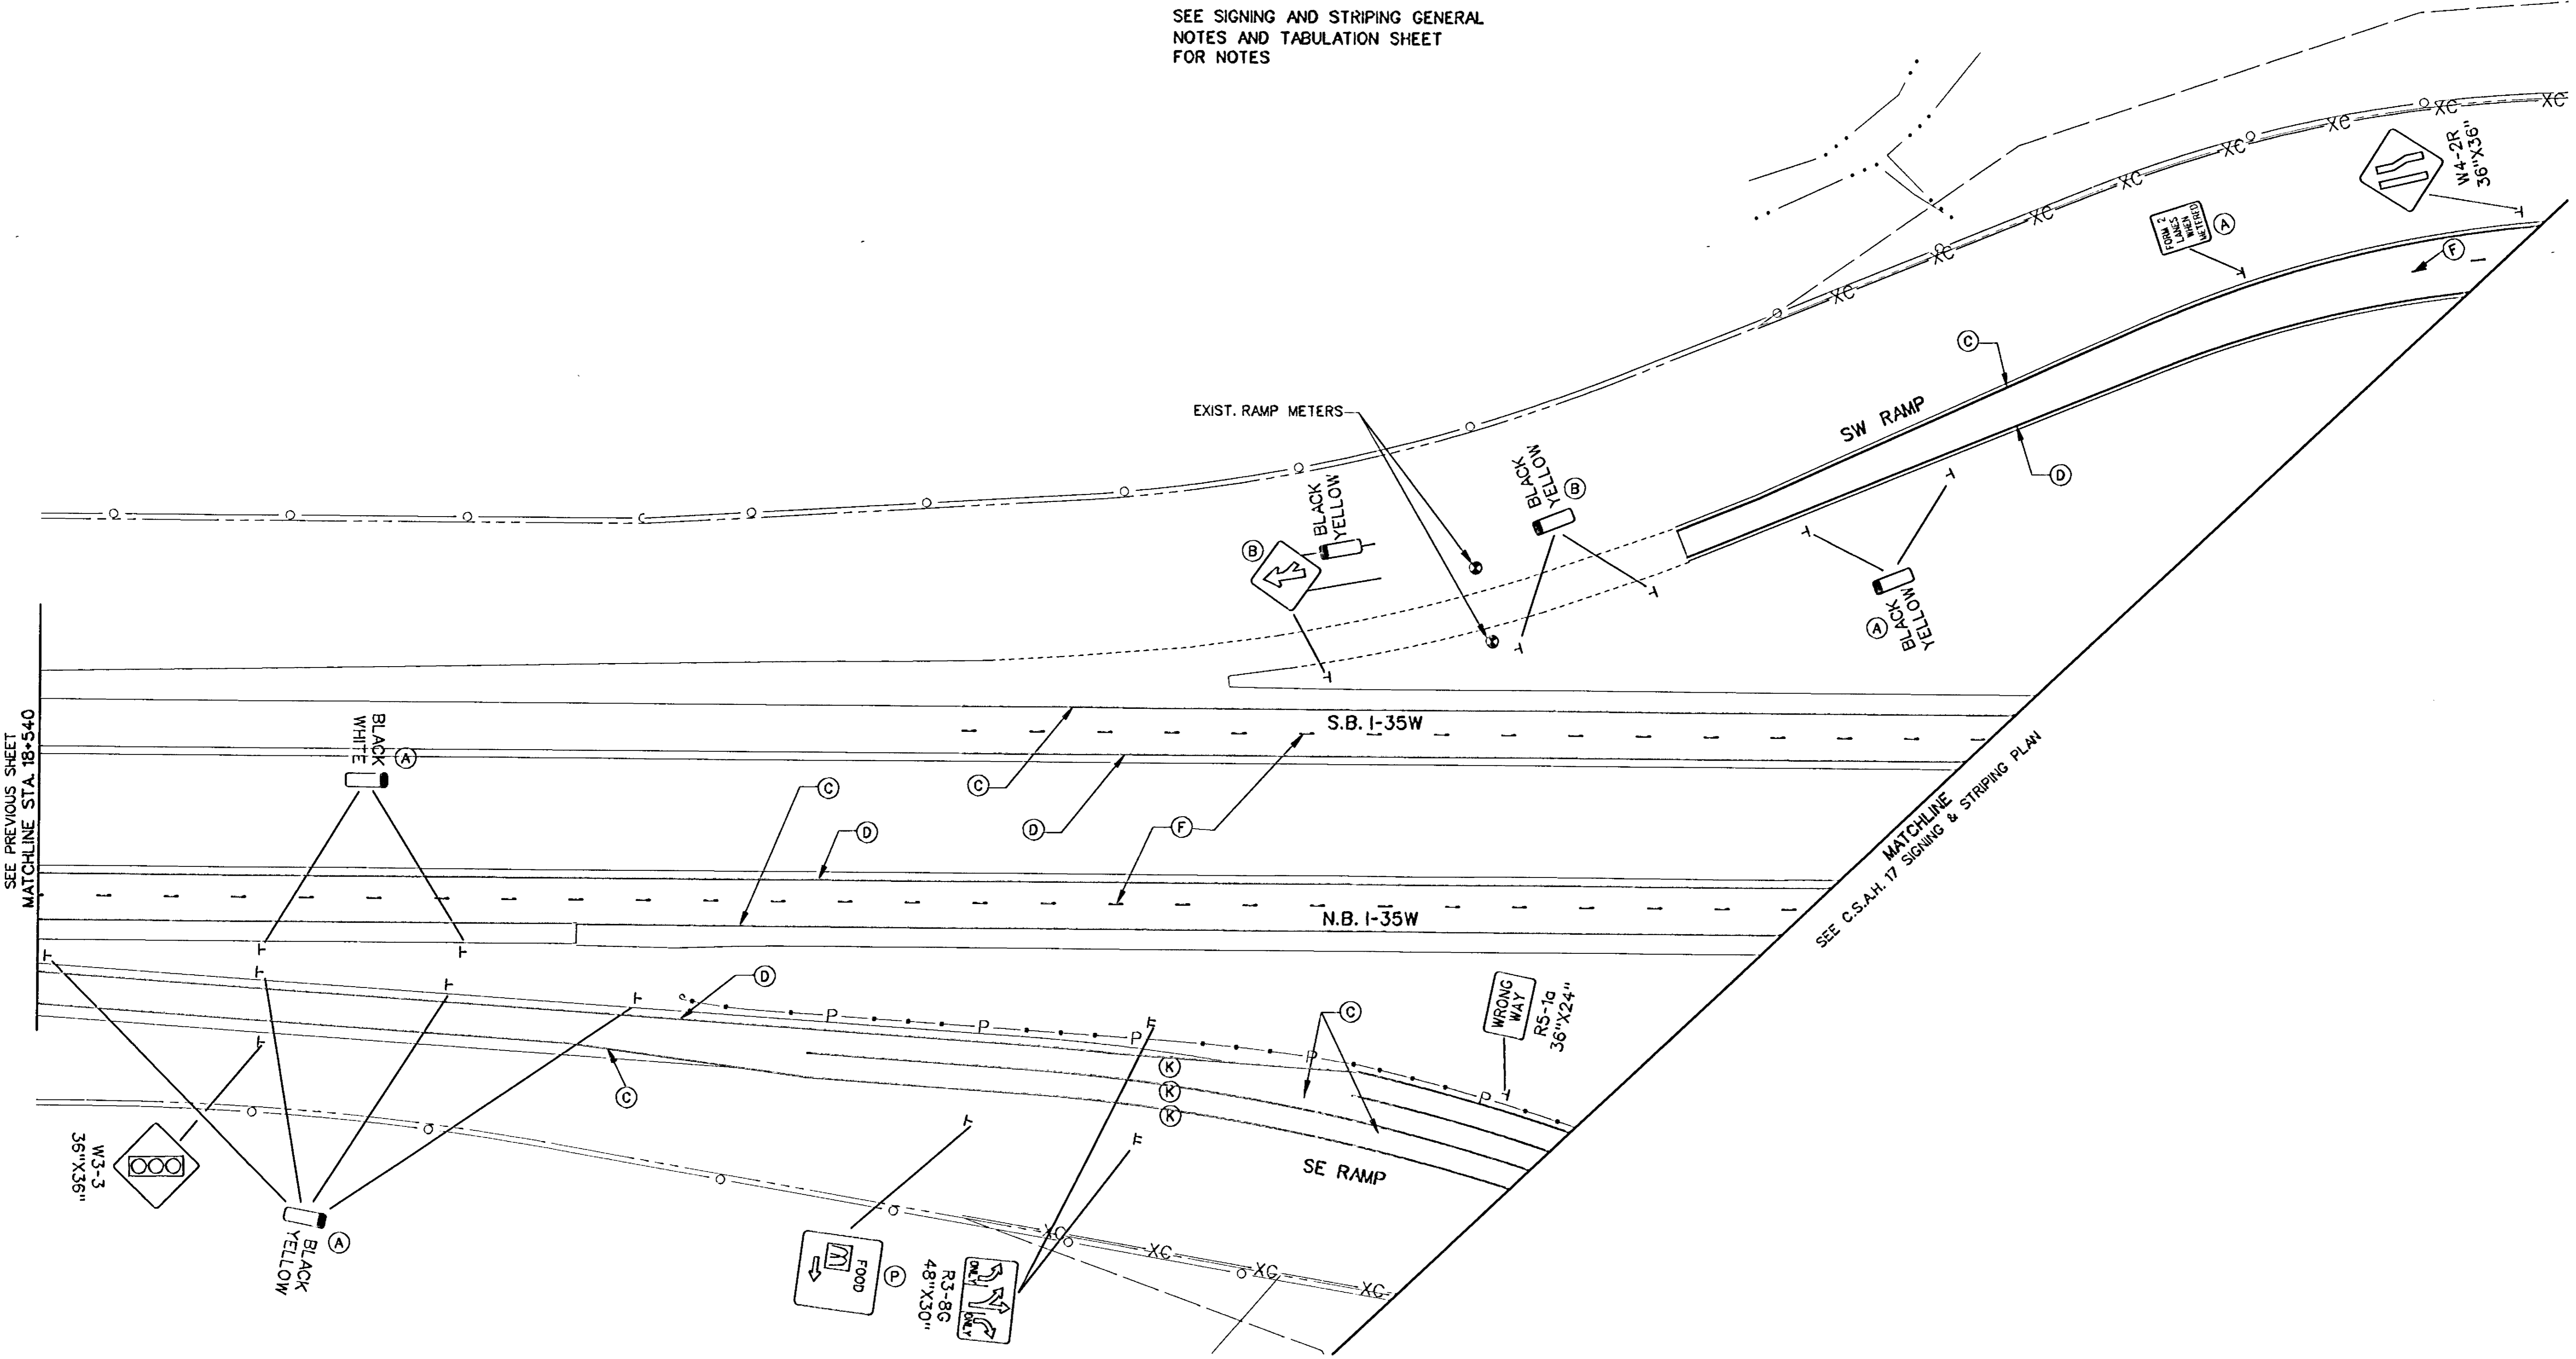

SEE PREVIOUS SHEET
MATCHLINE STA. 18+540

MATCHLINE
SEE C.S.A.H. 17 SIGNING & STRIPING PLAN

1	4-24-97	MCI	DAD	DELETE D-5 SIGN
NO	DATE	BY	CKD	APPR
NAME: SSP5 410.PLN	DATE: Mar. 20, 1997			



I hereby certify that this plan, specification or report was prepared by me or under my direct supervision and that I am a duly Registered Professional Engineer under the laws of the State of Minnesota.
Donald A. Demers
Date 3-21-97 Reg. No. 23377

STATE AID PROJECT NO.
S.A.P. 02-617-11
S.A.P. 108-020-12
S.A.P. 108-030-03
CO. PROJECT NO.


DRAWN BY V. GRAF DATE 11-98
DESIGNED BY D. DEMERS 11-98
CHECKED BY B. MOORE 3-97
COMM. NO. 0962410



ANOKA COUNTY
SIGNING AND STRIPING PLAN
C.S.A.H. 17 RECONSTRUCTION
SW RAMP AND SE RAMP



SHEET 117 OF 236

LEGEND
 F POST MOUNTED SIGN TYPE C
 F POST MOUNTED SIGN TYPE D
 H TWO-SIDED POST MOUNTED SIGN
 + STREET SIGN

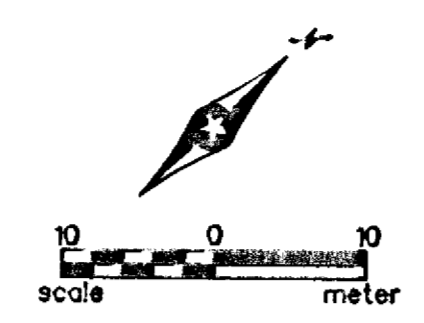


SEE SIGNING AND STRIPING GENERAL NOTES AND TABULATION SHEET FOR NOTES

SEE C.S.A.H. 17 SIGNING & STRIPING PLAN MATCHLINE

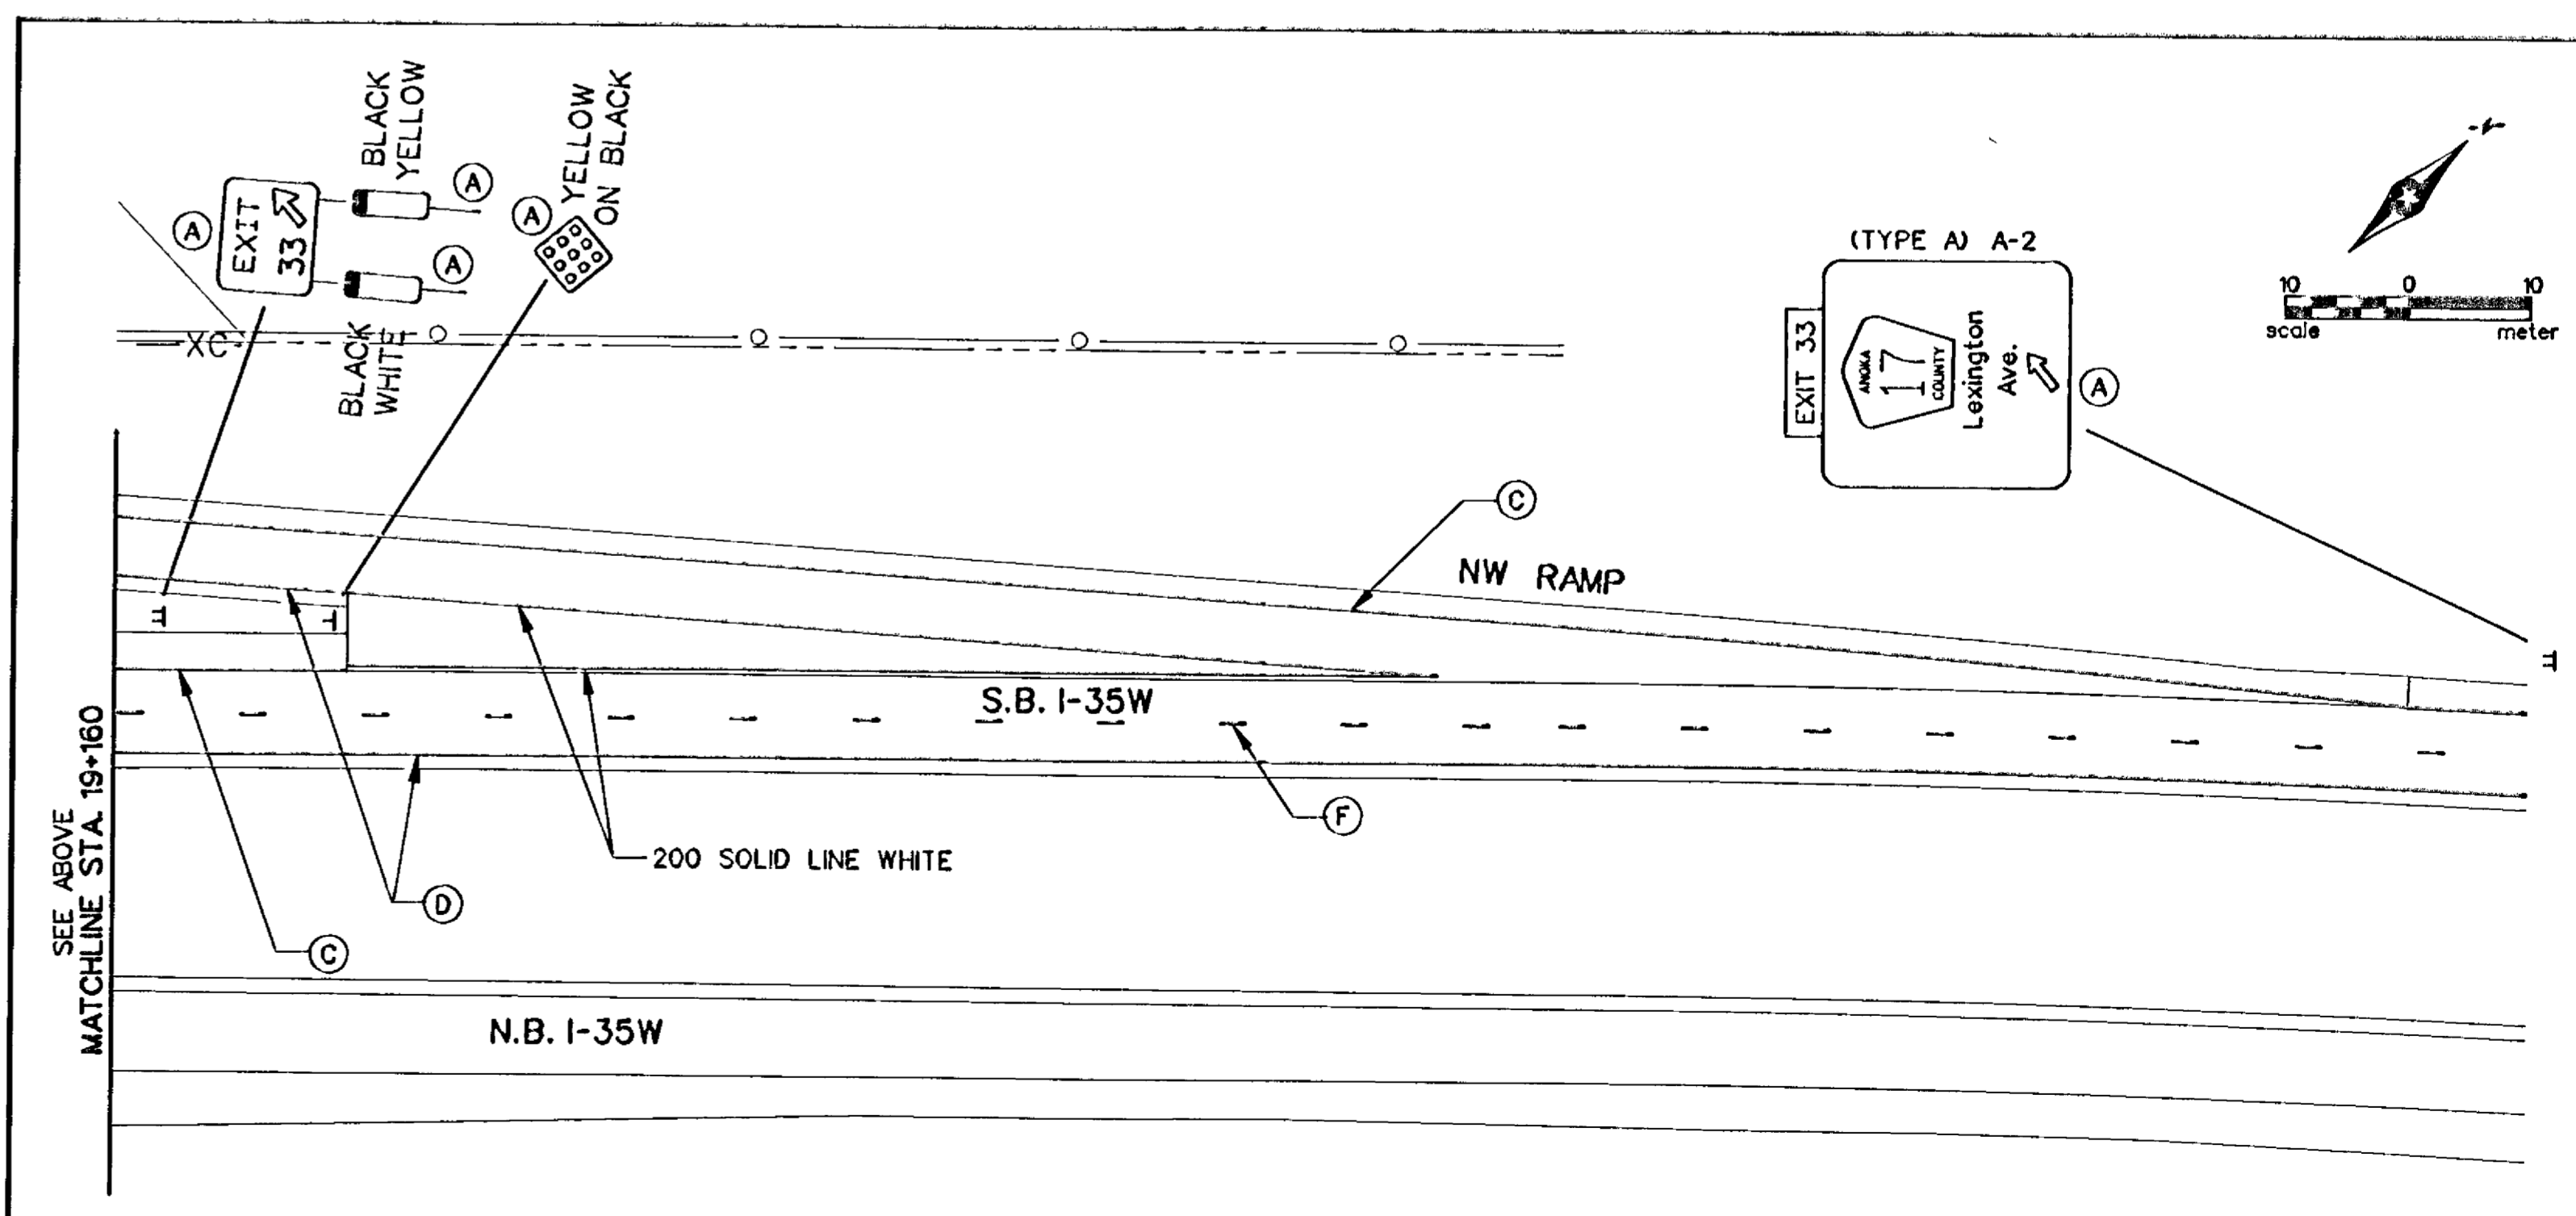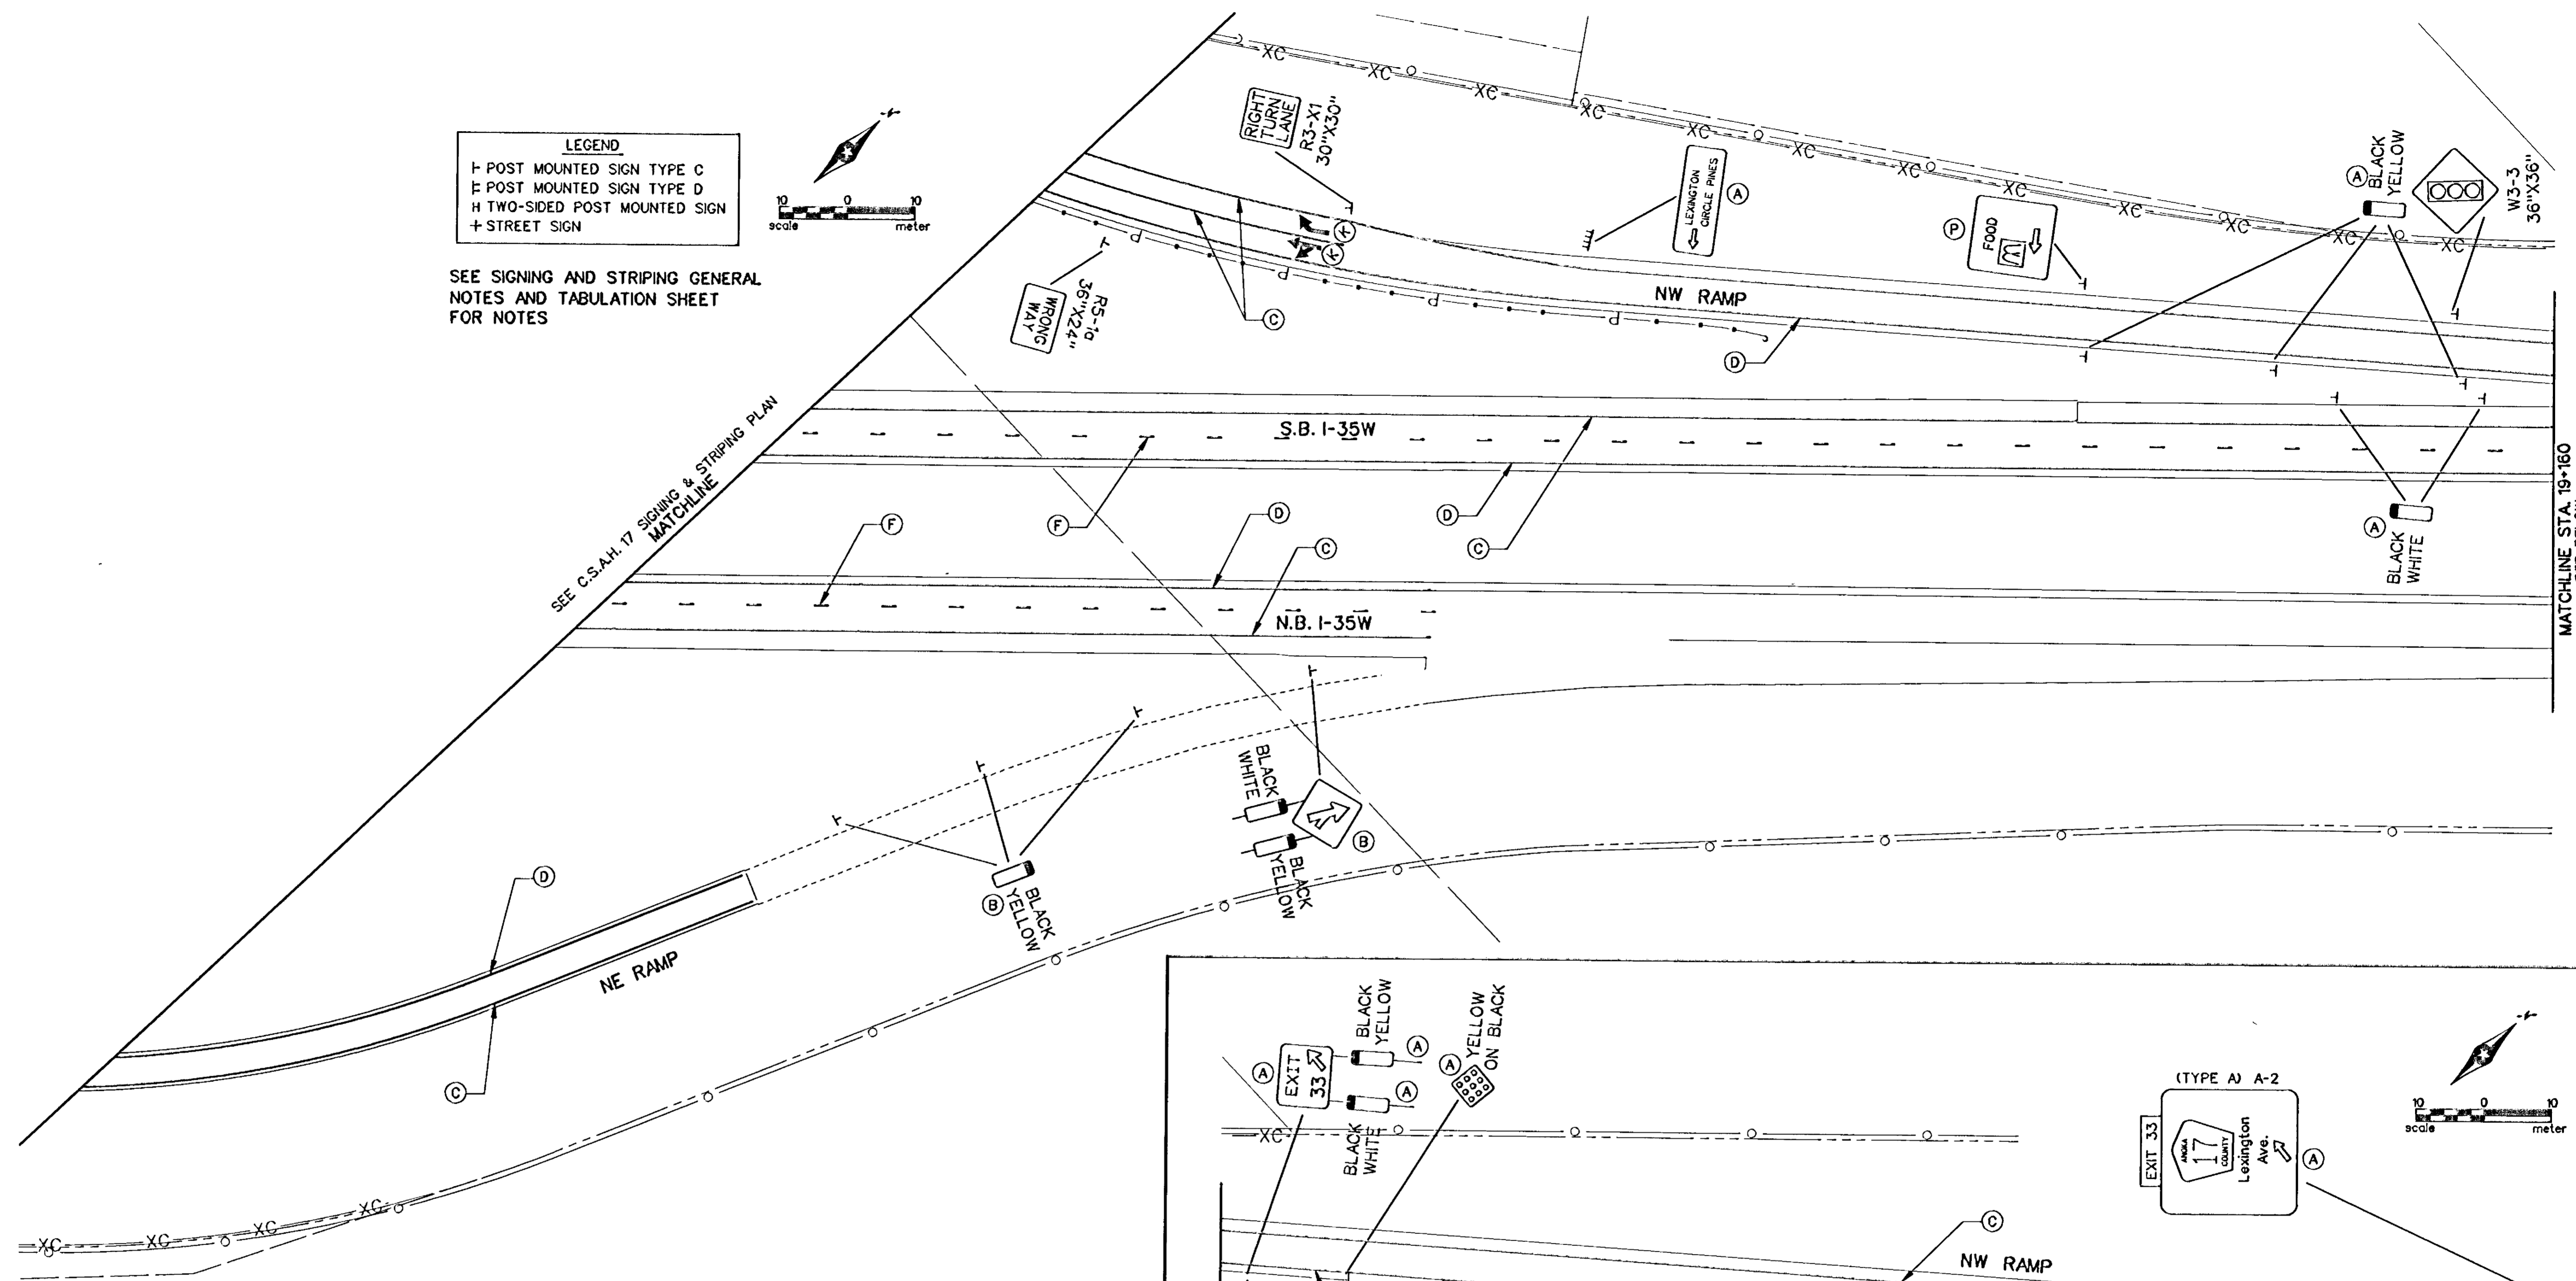

1	4-24-97	MCI	DAD	DELETE D-5 SIGN
NO	DATE	BY	CKD APPR	REVISION
NAME: SSP6 410.PLN DATE: Mar. 20, 1997				

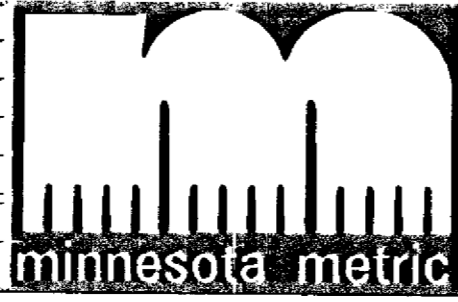

I hereby certify that this plan, specification or report was prepared by me or under my direct supervision and that I am a duly Registered Professional Engineer under the laws of the State of Minnesota.
Donald A. Demers
 Date 3-21-97 Reg. No. 23377

STATE AID PROJECT NO. S.A.P. 02-617-11
 S.A.P. 108-020-12
 S.A.P. 108-030-03
 CO. PROJECT NO.

DRAWN BY V. GRAF DATE 11-96
 DESIGNED BY D. DEMERS 11-96
 CHECKED BY B. MOORE 3-97
 COMM. NO. 0962410




ANOKA COUNTY
 SIGNING AND STRIPING PLAN
 C.S.A.H. 17 RECONSTRUCTION
 NW RAMP AND NE RAMP

SHEET 118 OF 236


CONSTRUCTION NOTES

ENCLOSURE SHALL BE FABRICATED FROM #12 GA. ALL WELDED COLD ROLLED STEEL FOR OUTDOOR WEATHER PROOF SERVICE. DOORS TO BE GASKETED, ALL HINGES, PINS AND LOCKS TO BE OF NON CORRODING CONSTRUCTION. CABINET TO BE PRIMED INSIDE AND OUT WITH RUST INHIBITTING PRIMER. FINISH PER MN/DOT #3527. ENCLOSURE SHALL BE 'UL' APPROVED


N.S.P. METER SOCKET, 5-TERMINAL w/ POSITIVE BY-PASS MECHANISM MILBANK CAT. No. U-2272-RL.

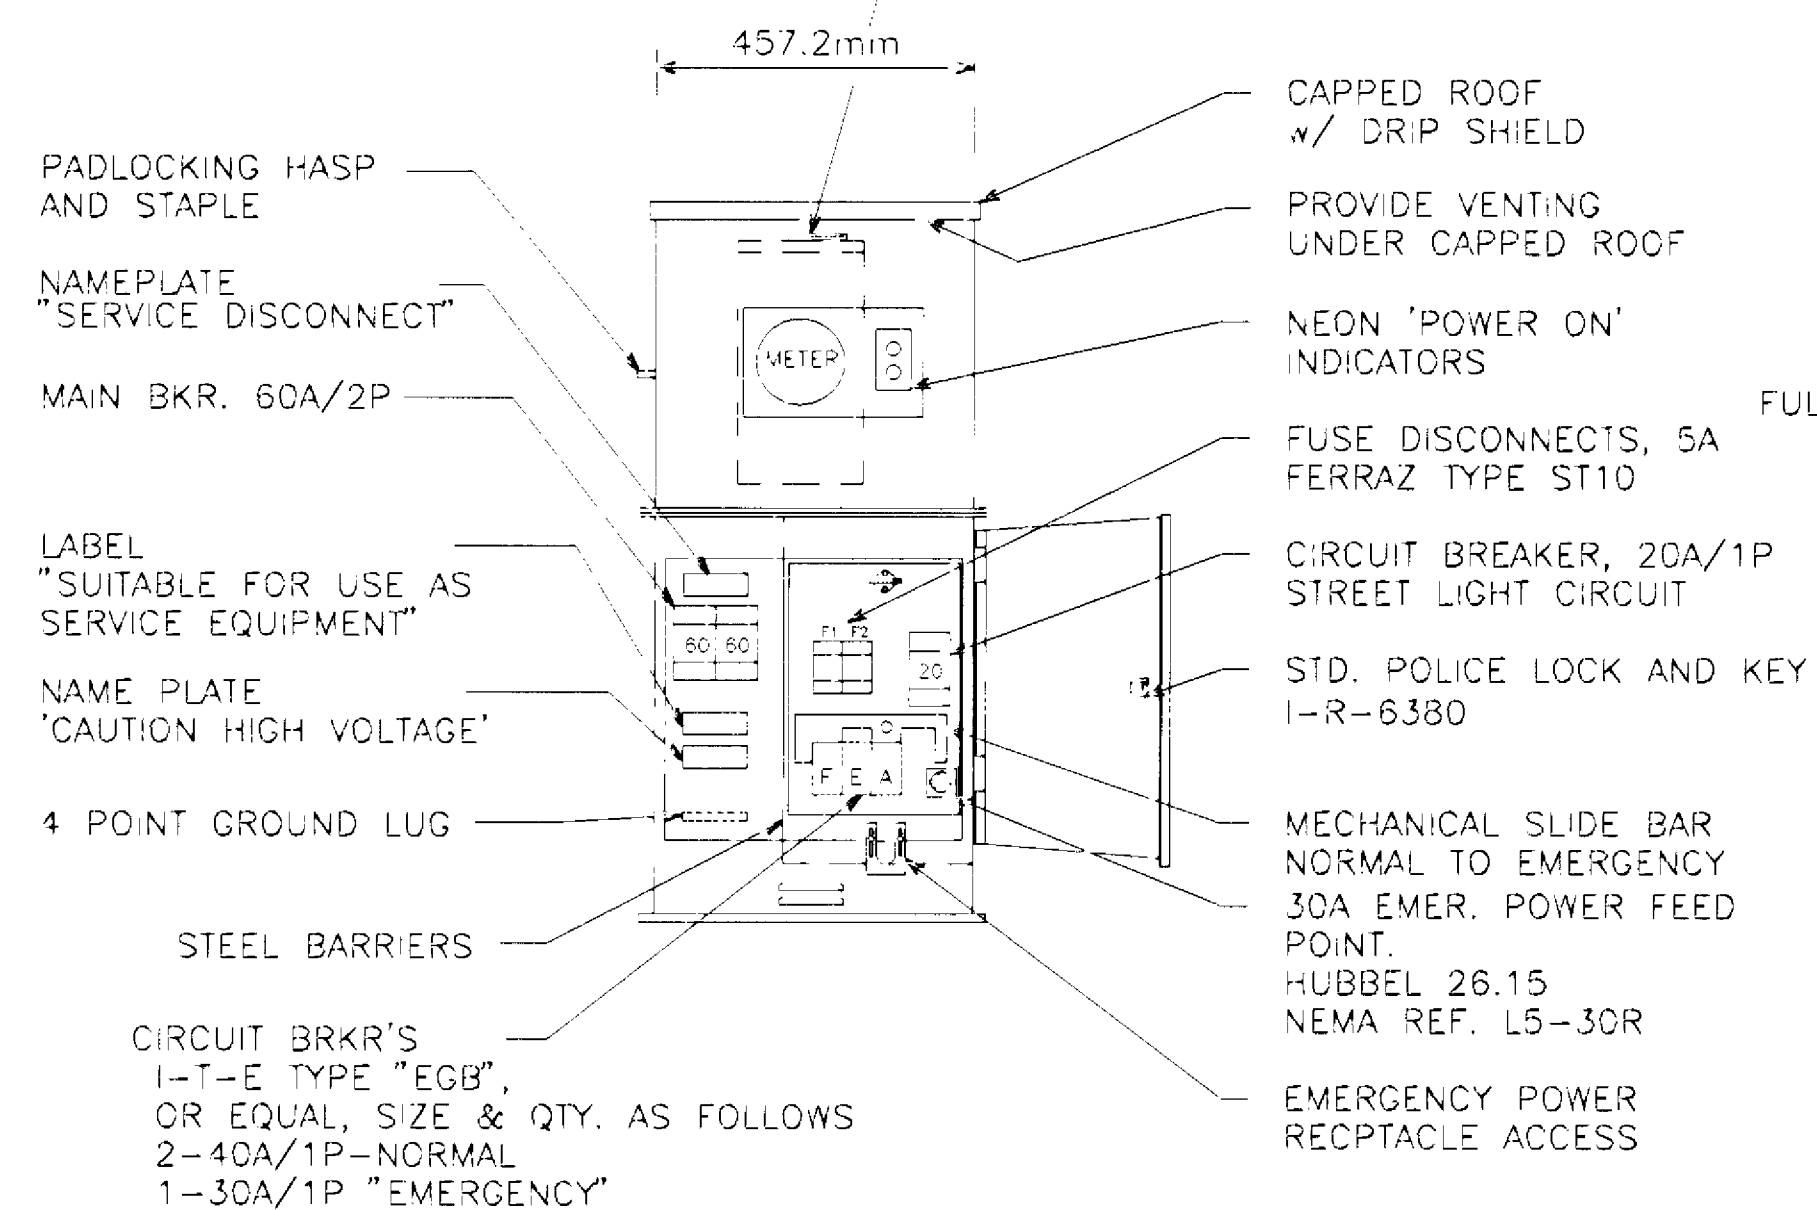

FRONT ELEV.

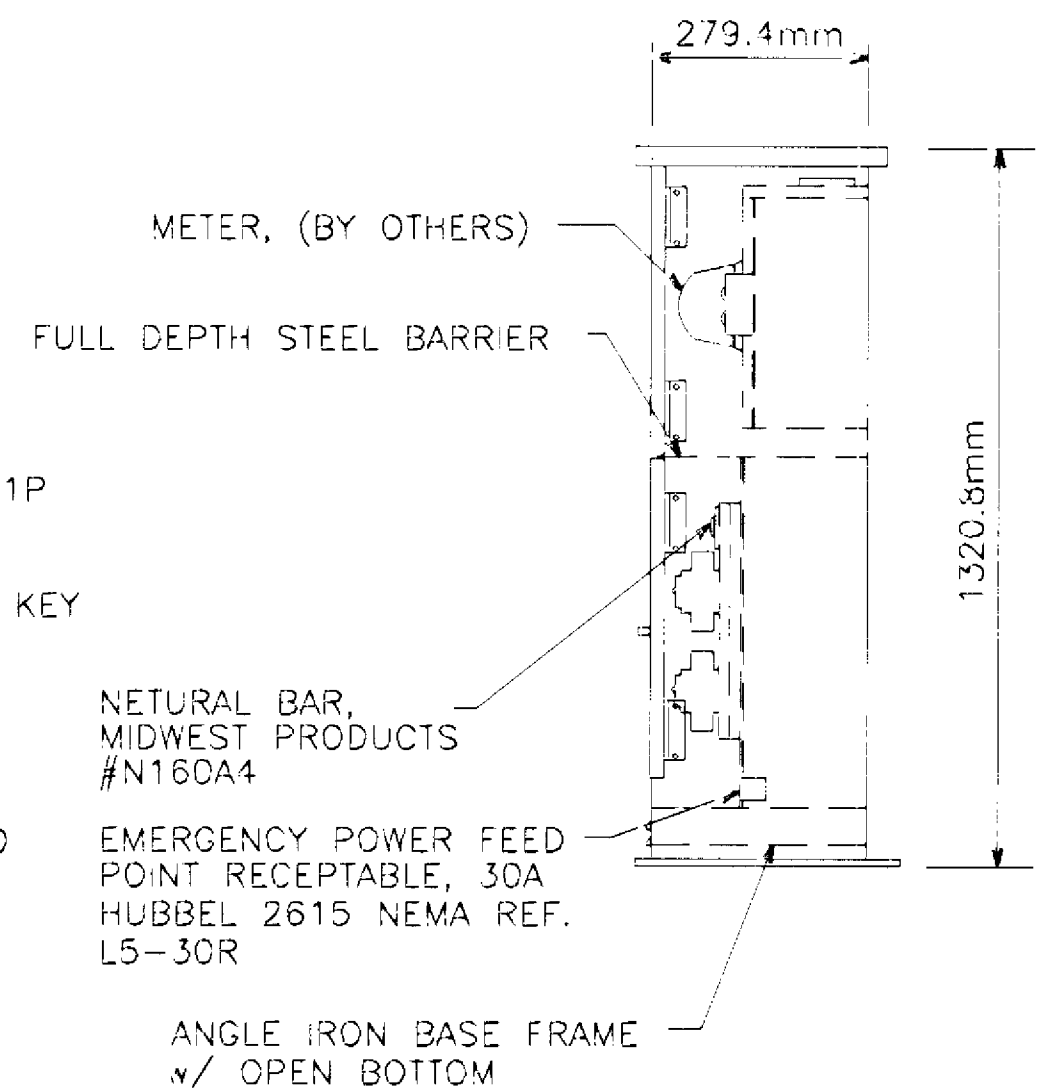


RIGHT SIDE ELEV.

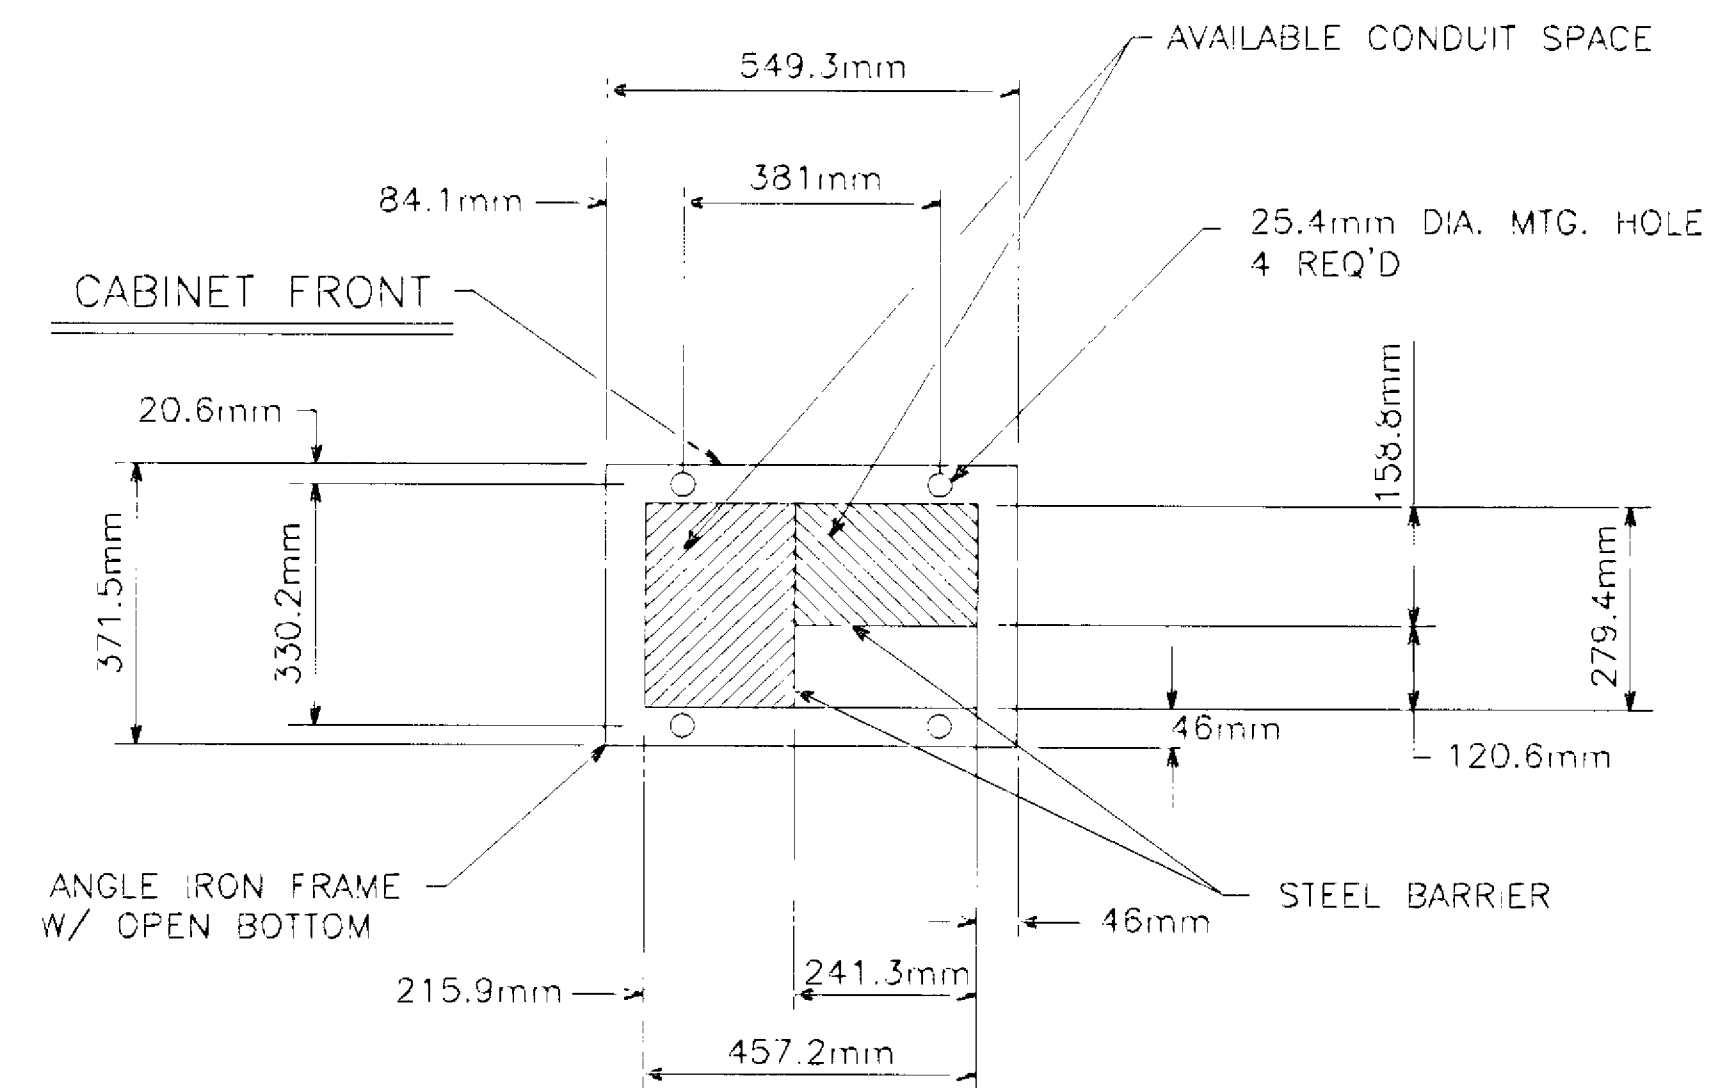

BASE VIEW


SERVICE CABINET FOUNDATION

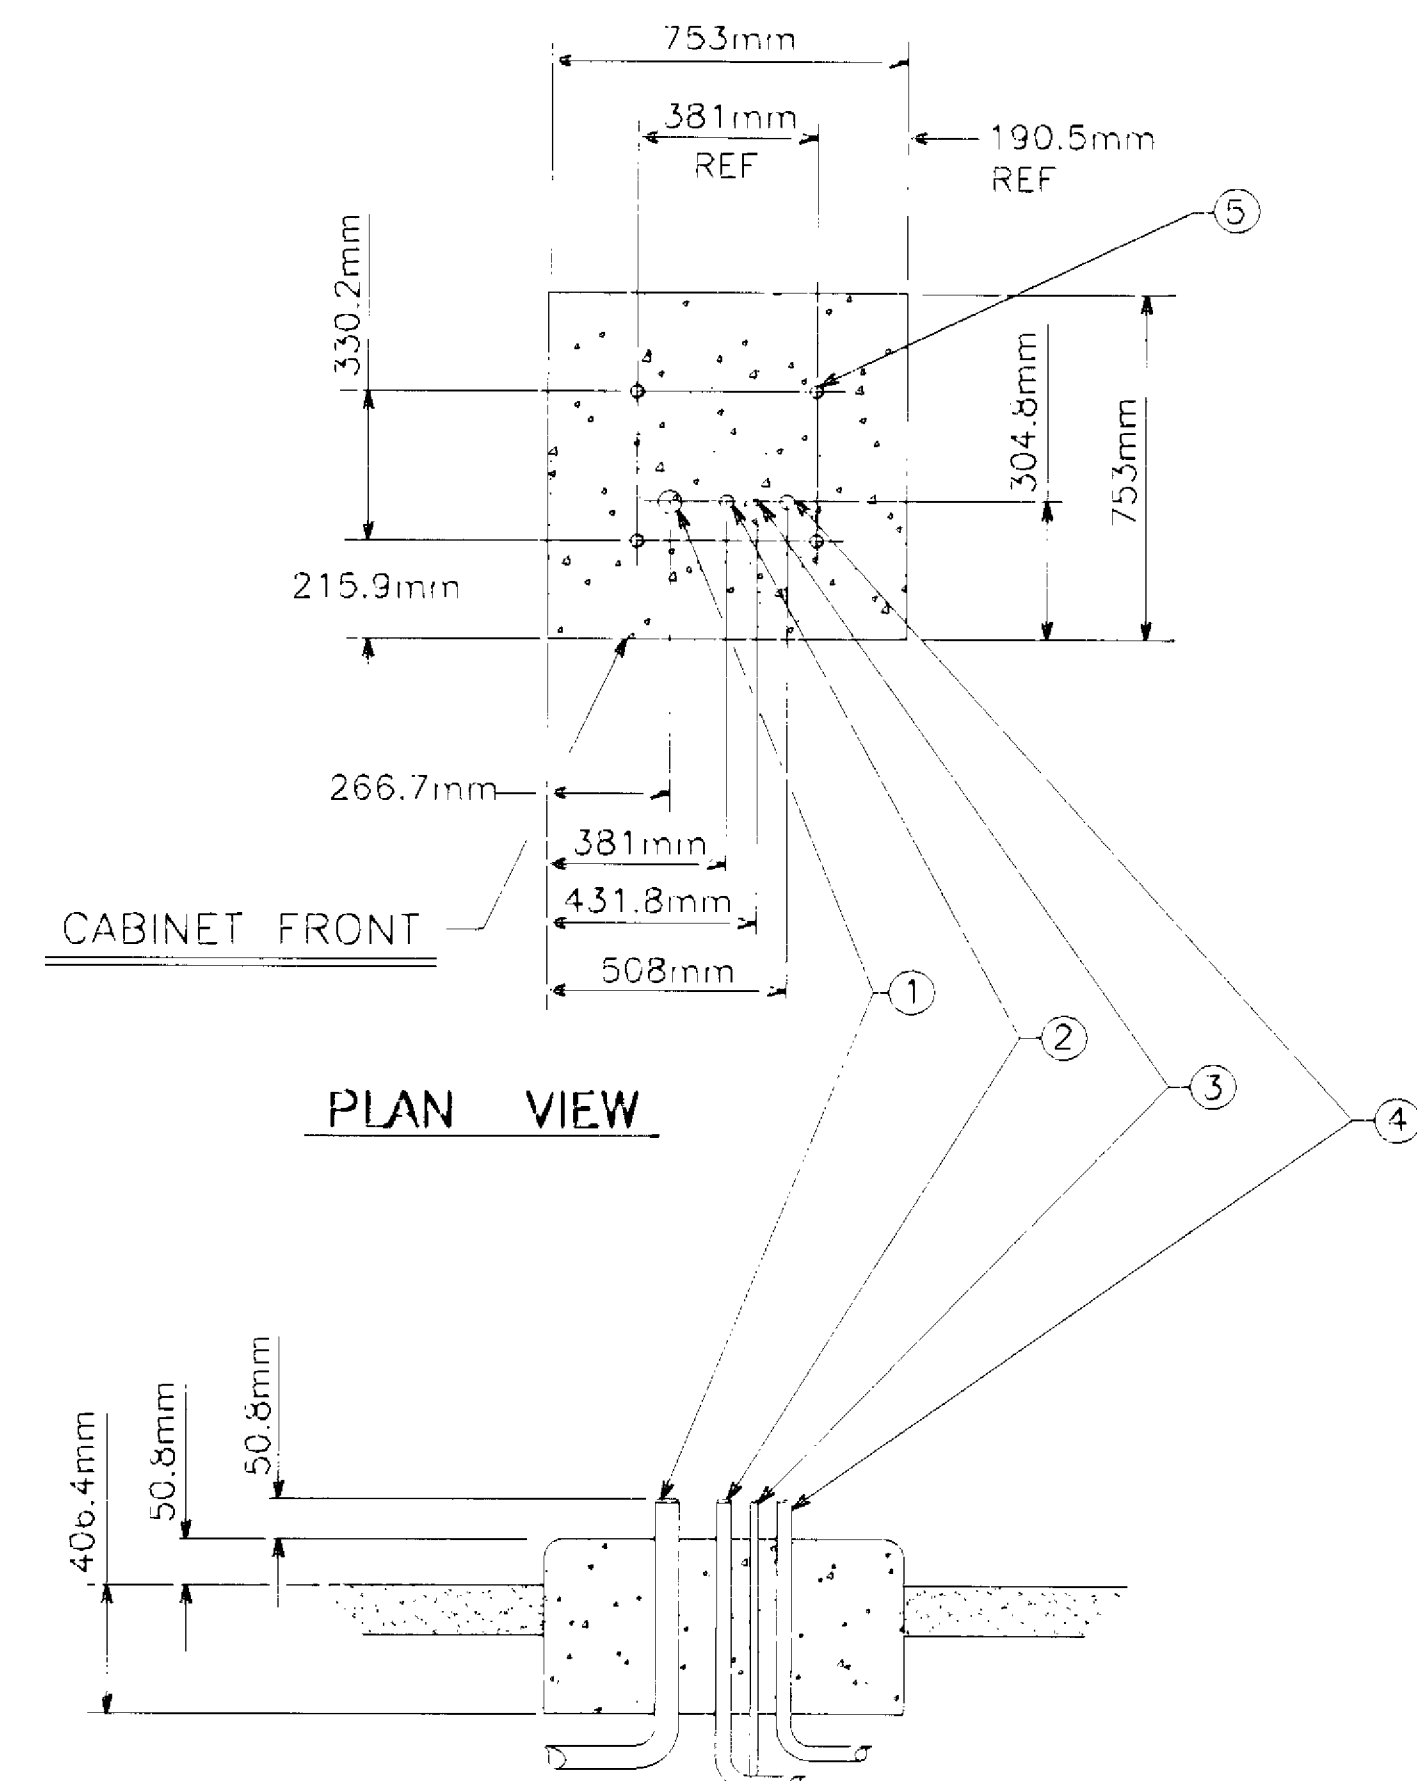

- ① 53mm RSC FROM SOURCE OF POWER
- ② 53mm RSC TO CONTROLLER CABINET
- ③ GROUNDING ROD
- ④ 53mm RSC WITH STREET LIGHTING CONDUCTORS
- ⑤ ANCHOR BOLT LOCATIONS (4 REQUIRED)

SIGNAL SERVICE CABINET

- A 53mm RSC FOR SERVICE CONNECTION FROM SERVICE CABINET
- B 103mm RSC WITH SIGNAL CONDUCTORS
- C 103mm RSC WITH SIGNAL CONDUCTORS
- D 2-78mm RSC STUBOUTS, THREAD & CAP BOTH ENDS.
- E 15.9mm DIA X 4.6m GROUND ROD

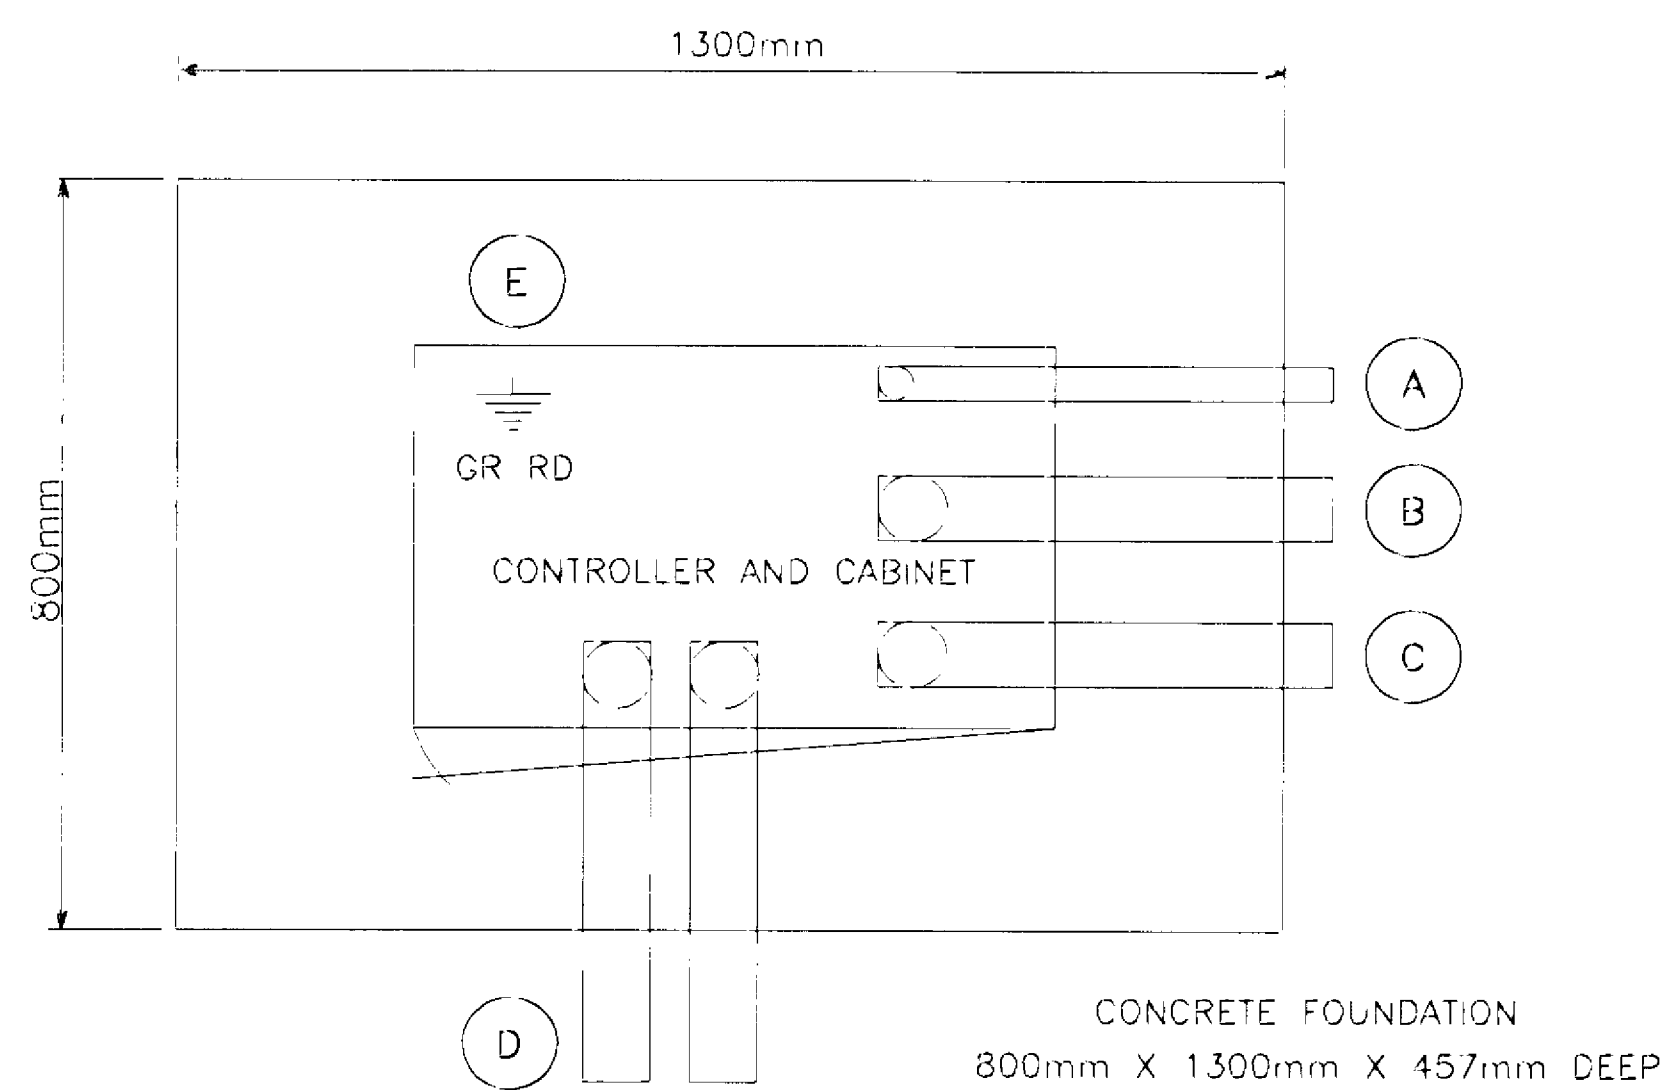


SEE INTERSECTION LAYOUT FOR CONDUIT & CABLE INFORMATION

CONTROLLER CABINET PAD LAYOUT (TYP.)

NO SCALE

NO	DATE	BY	CHK	APPR	REVISION
1	3-27-97	MAB	GMS	DRE	CHANGED CONTROLLER CABINET PAD DIMENSIONS
NAME: H:\SIGNALS\2410\10-CAB.DWG DATE: MAR 27, 1997 TIME: 10:25 AM					

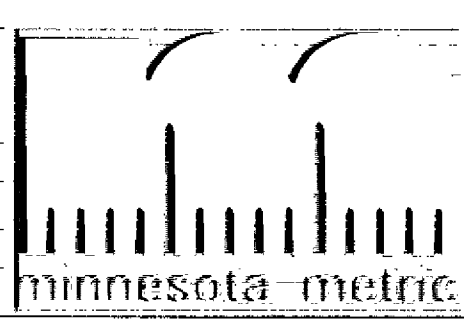

I hereby certify that this plan, specification or report was prepared by me or under my direct supervision and that I am a duly Registered Professional Engineer under the laws of the State of Minnesota.
George W. Stuenkel
 Date 3/21/97 Reg No. 21849




STATE AID PROJECT NO. SAP 02-617-11
 STATE PROJECT NO. SP 0280-47

DRAWN BY R.W. SMITH DATE 9-96
 DESIGNED BY P. CORNELL DATE 9-96
 CHECKED BY G. STUEMPFIG DATE 9-96
 COMM. NO. 0962410



ANOKA COUNTY
 SIGNAL SERVICE CABINET AND CONTROLLER CABINET DETAILS
 C.S.A.H.17 RECONSTRUCTION

SHEET 119 OF 236

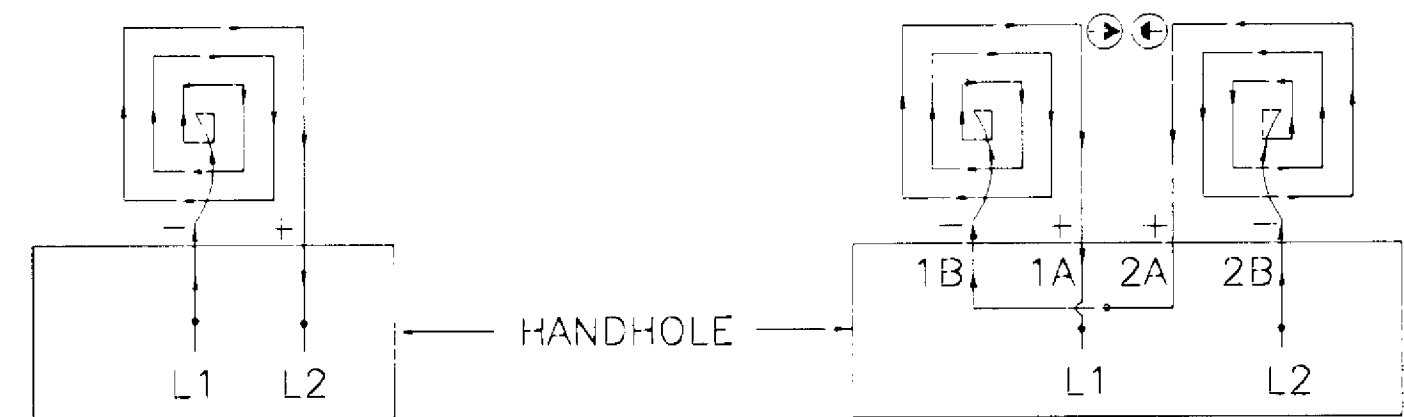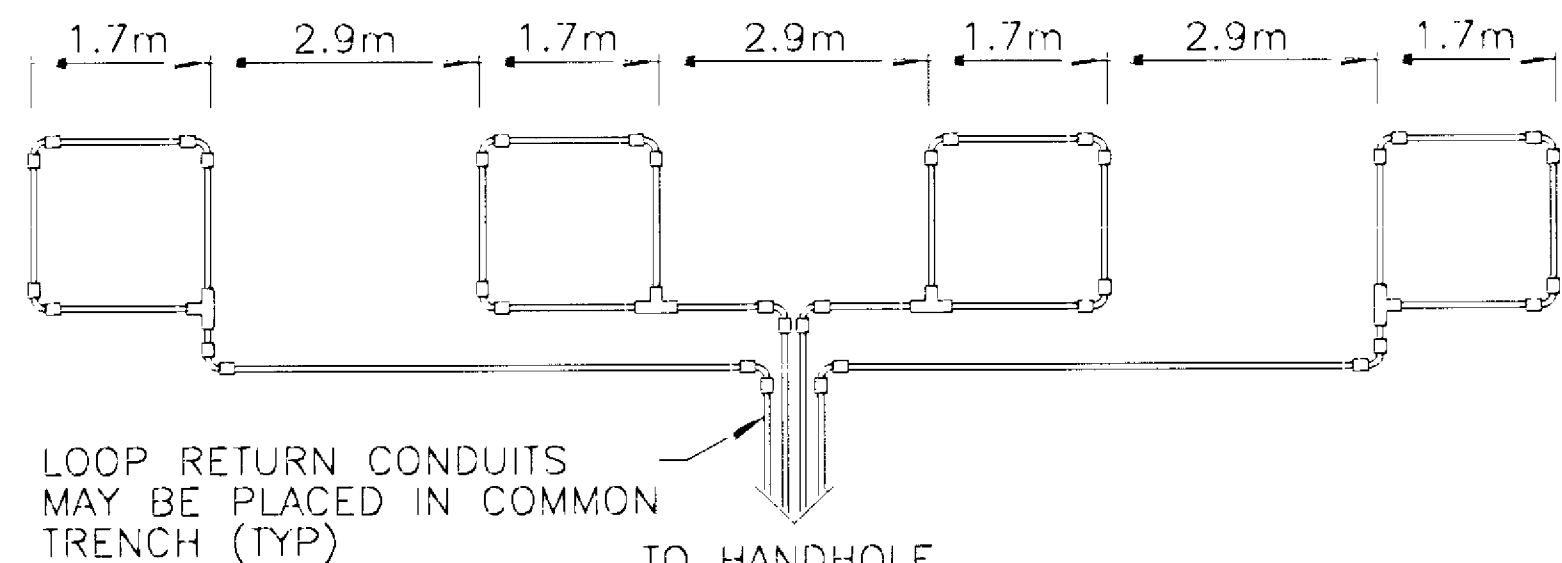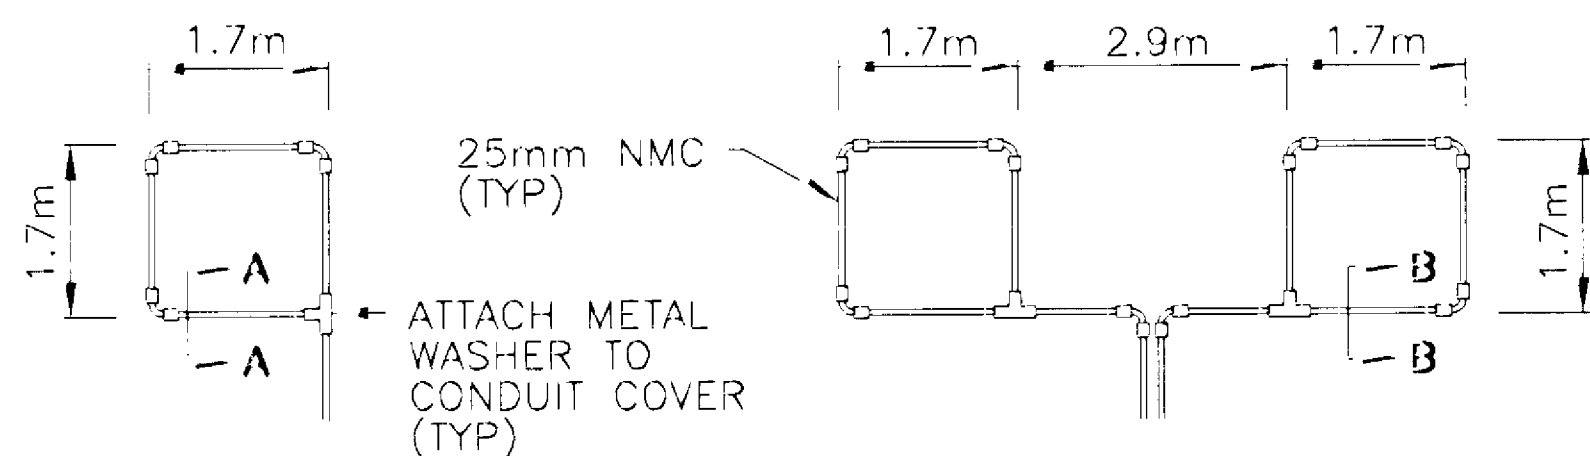


LOOP CONNECTIONS SHALL BE LABELED AND SPLICED IN THE HANDHOLE AS FOLLOWS:

- L1 TO 1A
- 1B TO 2A
- 2B TO L2

LOOP DETECTOR DETAIL 'A'
(LOOP PHASING FOR SINGLE CONNECTION)

LOOP DETECTOR DETAIL 'B'
(LOOP PHASING FOR SERIES CONNECTION)

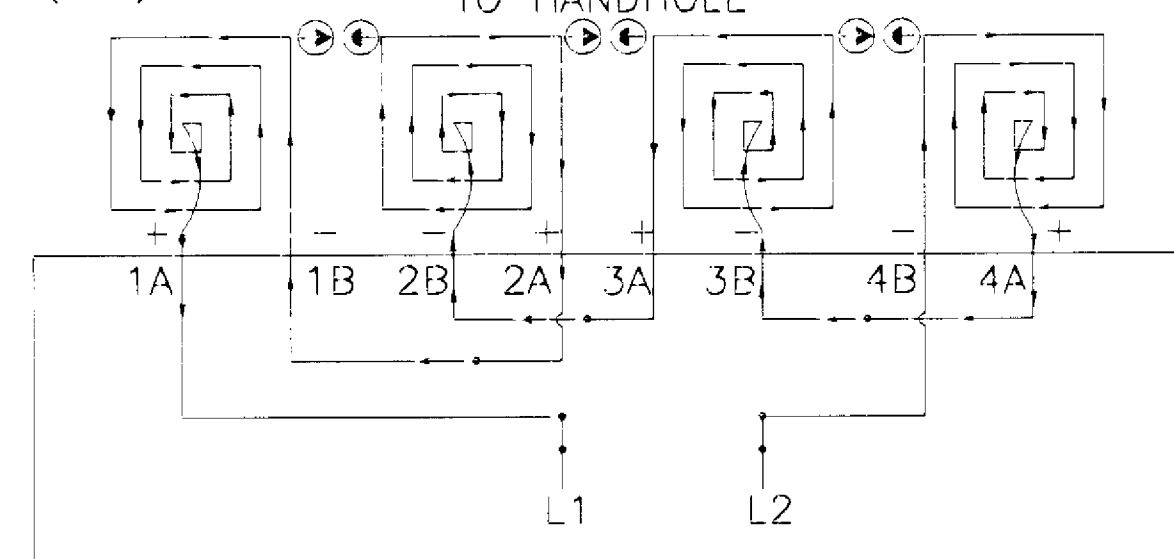

LOOP CONNECTIONS SHALL BE LABELED AND SPLICED IN THE HANDHOLE AS FOLLOWS:

- L1 TO 1A
- 1B TO 2A
- 2B TO 3A
- 3B TO 4A
- 4B TO L2

SPLICE CONTROL CABLE TO L1 & L2 IN HANDHOLE. ALL CONDUCTORS SHALL BE TAGGED IN HANDHOLE (1A, 1B, ECT)


LOOP DETECTOR DETAIL 'C'
(LOOP PHASING FOR SERIES CONNECTION)

LOOP DETECTOR WIRING


- 1) ALL CORNERS SHALL BE 90° CONDUIT BENDS.
- 2) CONNECT WIRES IN HANDHOLES USING SPLICE KIT METHOD DESCRIBED IN THE SPECIAL PROVISIONS.
- 3) LOOP DETECTOR WIRES SHALL BE #12 AWG CROSSED LINKED POLYETHYLENE (XLP). SEE SPECIAL PROVISIONS.
- 4) LOOP LEAD IN WIRES SHALL BE TWISTED A MIN. OF (5) TURNS PER FOOT THROUGH THE CONDUIT TO THE HANDHOLE.
- 5) NMC DESIGNATES NON-METALLIC CONDUIT (SPEC. 3803)
- 6) LOOPS 1.7m x 1.7m THRU 1.7m x 4.3m SHALL HAVE (4) TURNS.
- 7) LOOPS 1.7m x 4.6m AND LARGER SHALL HAVE (2) TURNS.

LEGEND OF SYMBOLS

CONTROLLER AND SERVICE EQUIP. NO.'s	(A)
SIGNAL BASE NO.	(B)
SIGNAL FACE NO.	(C)
LUMINAIRE NO.	(D)
CONTROLLER AND CABINET	(E)
CONTROLLER AND CABINET - IN PLACE	(F)
HANDHOLE - IN PLACE	(G)
RIGID STEEL CONDUIT (RSC)	(H)
RIGID STEEL CONDUIT (RSC) - IN PLACE	(I)
SIGNAL FACE WITH BACKGROUND SHIELD	(J)
SIGNAL FACE W/O BACKGROUND SHIELD	(K)
SIGNAL FACE - IN PLACE	(L)
PEDESTRIAN INDICATORS	(M)
PEDESTRIAN INDICATORS - IN PLACE	(N)
PEDESTRIAN PUSH BUTTONS ON PEDESTAL OR POLE	(O)
PEDESTRIAN PUSH BUTTON STATION	(P)
TRAFFIC SIGNAL PEDESTAL	(Q)
TRAFFIC SIGNAL PEDESTAL - INPLACE	(R)
TRAFFIC SIGNAL POLE AND MAST ARM	(S)
TRAFFIC SIGNAL POLE AND MAST ARM - IN PLACE	(T)
STREET LIGHT POLE AND LUMINAIRE	(U)
STREET LIGHT POLE AND LUMINAIRE - IN PLACE	(V)
MAST ARM AND LUMINAIRE	(W)
MAST ARM AND LUMINAIRE - INPLACE	(X)
WOOD POLE	(Y)
WOOD POLE - IN PLACE	(Z)
SOURCE OF POWER	(AA)
RAILROAD SIGNAL - IN PLACE	(AB)
RIGHT OF WAY LINE	(AC)
CENTERLINE	(AD)
EDGE OF ROADWAY	(AE)
SHOULDERLINE	(AF)
CURB LINE	(AG)
STOP BAR	(AH)

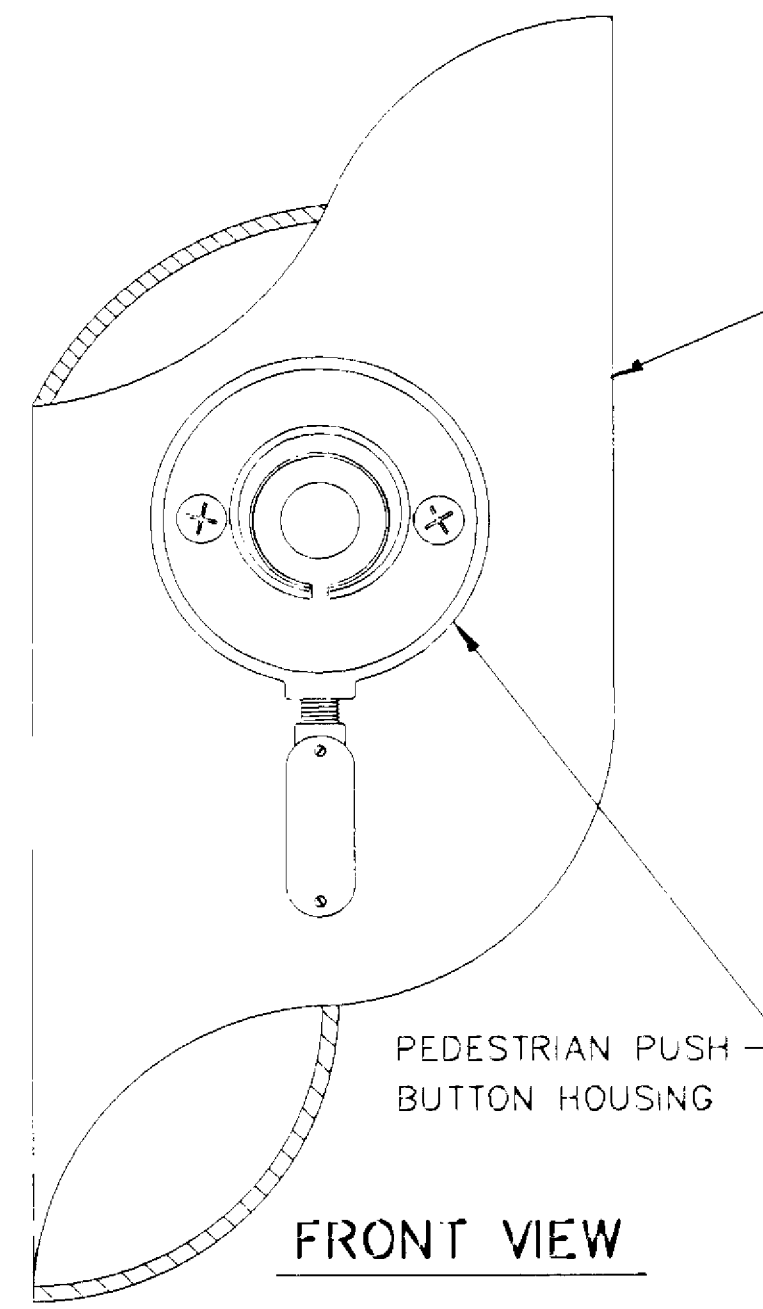

FRONT VIEW

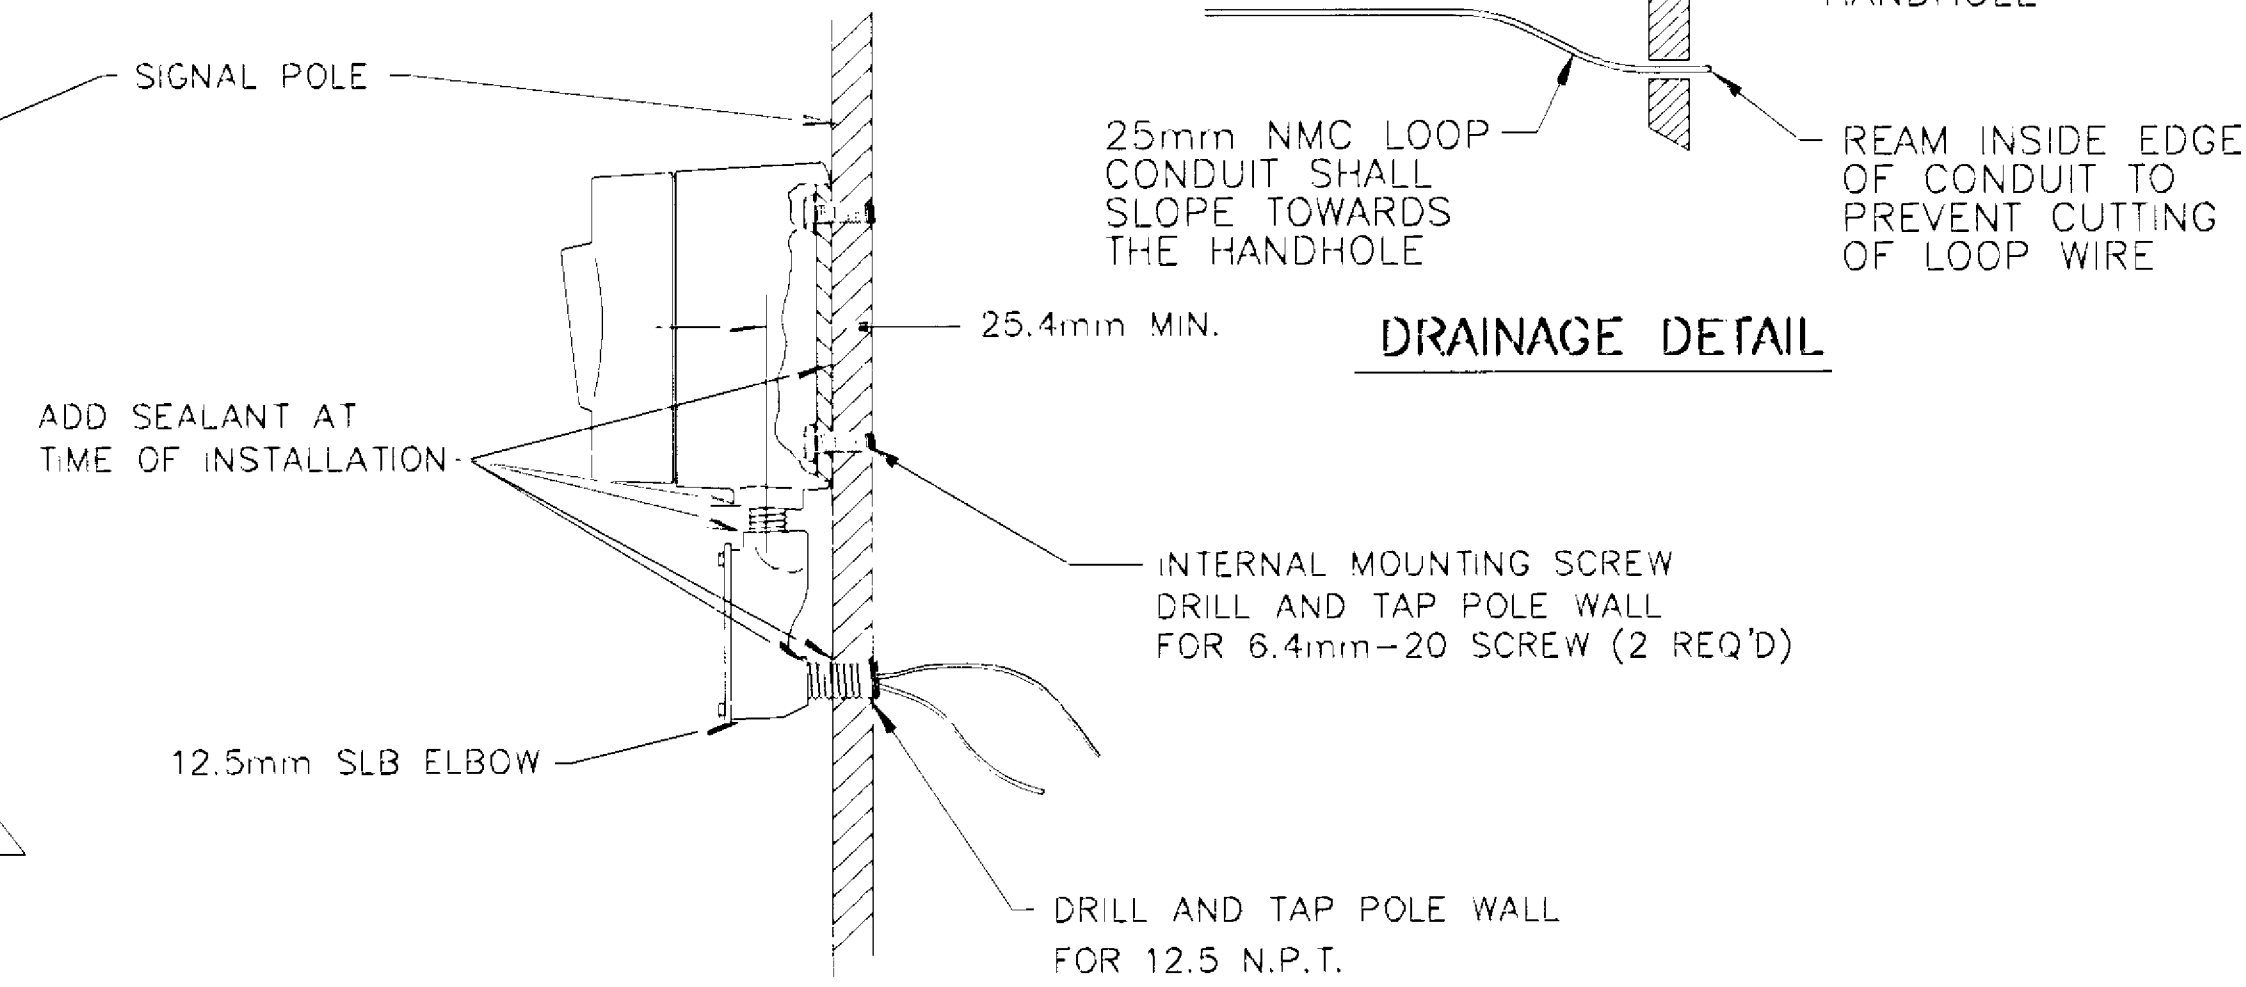

SIDE VIEW

MAST ARM POLE PEDESTRIAN PUSH BUTTON DETAIL

ABBREVIATIONS

3-1(EG) SIGNAL HEAD PHASE "3" - NO. "1"	P2-1(EG) PEDESTRIAN INDICATION PHASE "2"-NO."1"
BR. GR. BARE GROUND	PB PUSH BUTTON
CH. SW. CHECK SWITCH	PB2-1(EG) PUSH BUTTON PHASE "2"-NO. "1"
CLR CLEAR	PEC PHOTOELECTRIC CELL
D2-1(EG) DETECTOR PHASE "2" - NO. "1"	PED PEDESTRIAN
DWK DON'T WALK	R RED
EQG EQUIPMENT GROUND	R&S REMOVE AND SALVAGE
EVP EMERGENCY VEHICLE PRE-EMPTION	RLTA RED LEFT TURN ARROW
F&I FURNISH AND INSTALL	RRTA RED RIGHT TURN ARROW
FL FLASH/FLASHING	RSC RIGID STEEL CONDUIT
G GREEN	SCP SOURCE OF POWER
GLTA GREEN LEFT TURN ARROW	SPR SPARE
GRN GREEN	ST. LHT. STREET LIGHT
GR. R. GROUND ROD	STA STATION
GRTA GREEN RIGHT TURN ARROW	SW SWITCH
GTHA GREEN THRU ARROW	SWD SWITCHED
HH HANDHOLE	TDW TELEPHONE DROP WIRE
HPS HIGH PRESSURE SODIUM	WLK WALK
JB JUNCTION BOX	YEL YELLOW
LUM LUMINAIRE	YLTA YELLOW LEFT TURN ARROW
NEU NEUTRAL	YRTA YELLOW RIGHT TURN ARROW
NMC NONMETALLIC CONDUIT	YTHA YELLOW THRU ARROW

CONDUCTOR COLOR CODE

R	RED
O	ORANGE
BL	BLUE
WH	WHITE
R/BLK	RED WITH BLACK TRACER
O/BLK	ORANGE WITH BLACK TRACER
BL/BLK	BLUE WITH BLACK TRACER
WH/BLK	WHITE WITH BLACK TRACER
BLK	BLACK
BLK/WH	BLACK WITH WHITE TRACER
G/BLK	GREEN WITH BLACK TRACER
G	GREEN

NO.	DATE	BY	CHKD	APPR	REVISION


NAME: H:\SIGNALS\2410\10-LOOP.DWG DATE: MAR 17, 1997 TIME: 1:31 PM



I hereby certify that this plan, specification or report was prepared by me or under my direct supervision and that I am a duly Registered Professional Engineer under the laws of the State of Minnesota.
George M. Stumpfig
Date: 3/21/97 Reg. No. 21849

STATE AID PROJECT NO. SAP 02-617-11
STATE PROJECT NO. SP 0280-47

DRAWN BY R.W. SMITH DATE 9-96
DESIGNED BY P. CORNLE 9-96
CHECKED BY G. STUMPFIG 9-96
COMM. NO. 0962410

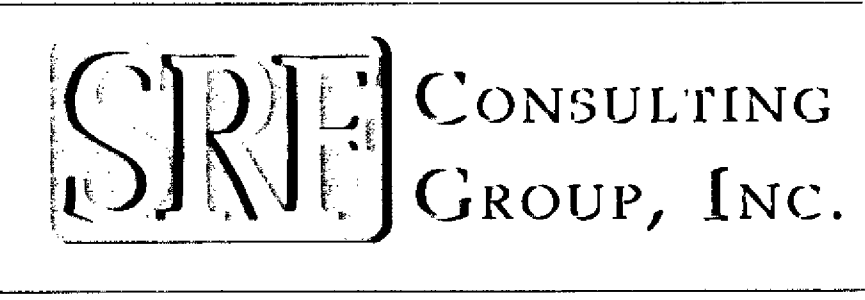

ANOKA COUNTY
LOOP DETECTOR DETAILS
C.S.A.H.17 RECONSTRUCTION

SHEET 120 OF 236

LOOP DETECTOR CHART			DISTANCE FROM STOP LINE
DESIGNATION	SIZE	FUNCTION	
D1-1	2-1.7m x 1.7m	(1)	0.6,9.8m
D1-2	2-1.7m x 1.7m	(1)	-4.0,5.2m
D2-1	1-1.7m x 1.7m	(1)	92m
D2-2	1-1.7m x 1.7m	(1)	92m
D4-1	1-1.7m x 3.4m	(7)	0m
D5-1	2-1.7m x 1.7m	(1)	1.3,10.5m
D5-2	2-1.7m x 1.7m	(1)	-3.3,5.9m
D6-1	1-1.7m x 1.7m	(1)	92m
D6-2	1-1.7m x 1.7m	(1)	92m
D8-1	1-1.7m x 1.7m	(3)	55m
D8-2	3-1.7m x 1.7m	(7)	-5.6,-1.0,3.6m
D8-3	1-1.7m x 1.7m	(7)	-7.6m

FUNCTIONS:
 (1) - CALL AND EXTEND
 (3) - EXTEND ONLY
 (7) - IMMEDIATE EXTEND, DELAY CALL



2 TYPE PA100-A15.2m-D12.2m-2.7m (DAVIT AT 350°)
 PA100 POLE FOUNDATION
 3 - ONE WAY SIGNALS (OVERHEAD)
 (0m, 3.4m AND 7.0m FROM END OF MAST ARM)
 ONEWAY EVP DETECTOR AND LIGHT
 (1.8m FROM END OF MAST ARM), 19mm HUB
 TYPE 10B AT 0°
 TYPE 10B AT 270°
 LUMINAIRE - 250 WATT H.P.S. W/PEC & CHECK SWITCH
 2 - PEDESTRIAN PUSH BUTTON & SIGN
 EXTEND INTO HH 7A
 78mm RSC
 2-12/C *12
 4-3/C *12
 1-3/C *12 (LUM)
 1-2/C *14
 1-3/C *20
 1-NYLON ROPE

3 TYPE PA90-A9.1m
 PA100 POLE FOUNDATION
 1 - ONE WAY SIGNALS (OVERHEAD)
 (0m FROM END OF MAST ARM)
 ONEWAY EVP DETECTOR AND LIGHT
 (1.8m FROM END OF MAST ARM), 19mm HUB
 TYPE 10B AT 0°
 TYPE 10B AT 270°
 2 - PEDESTRIAN PUSH BUTTON & SIGN
 EXTEND INTO HH 12A
 78mm RSC
 2-12/C *12
 2-3/C *12
 1-3/C *20

78mm RSC
 2-12/C *12
 4-3/C *12
 1-3/C *12 (LUM)
 1-2/C *14
 1-3/C *20
 1-NYLON ROPE

78mm RSC
 2-12/C *12
 2-3/C *12
 1-3/C *20

*K-DESIGNATES ITEMS TO BE INCLUDED IN THE INTERCONNECT SYSTEM PAY ITEM

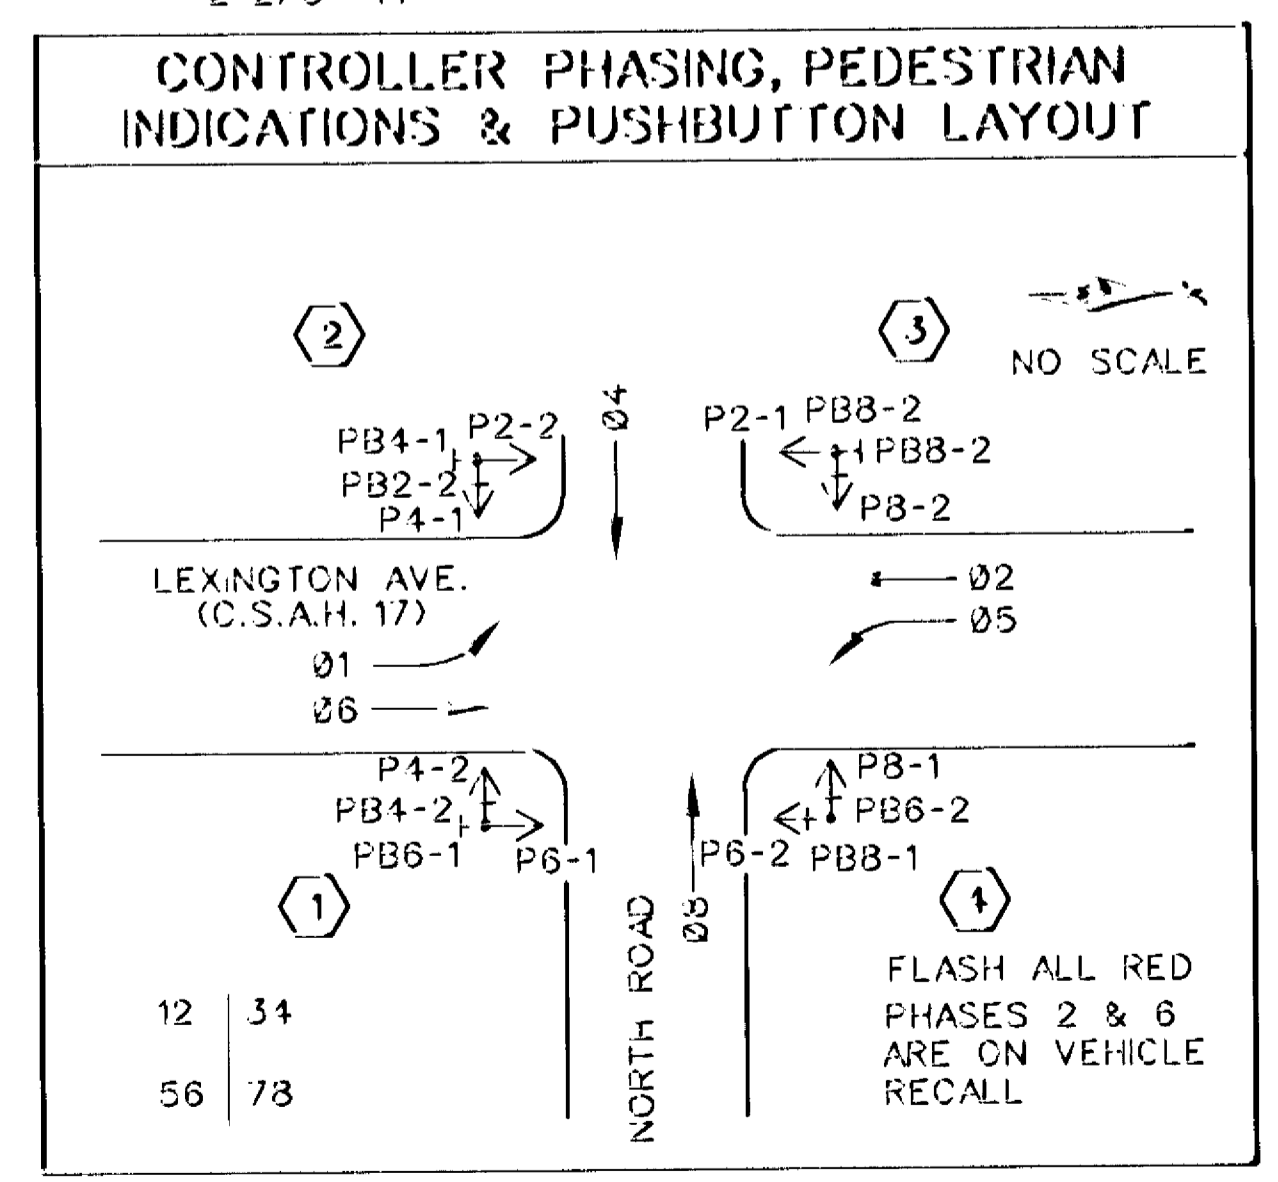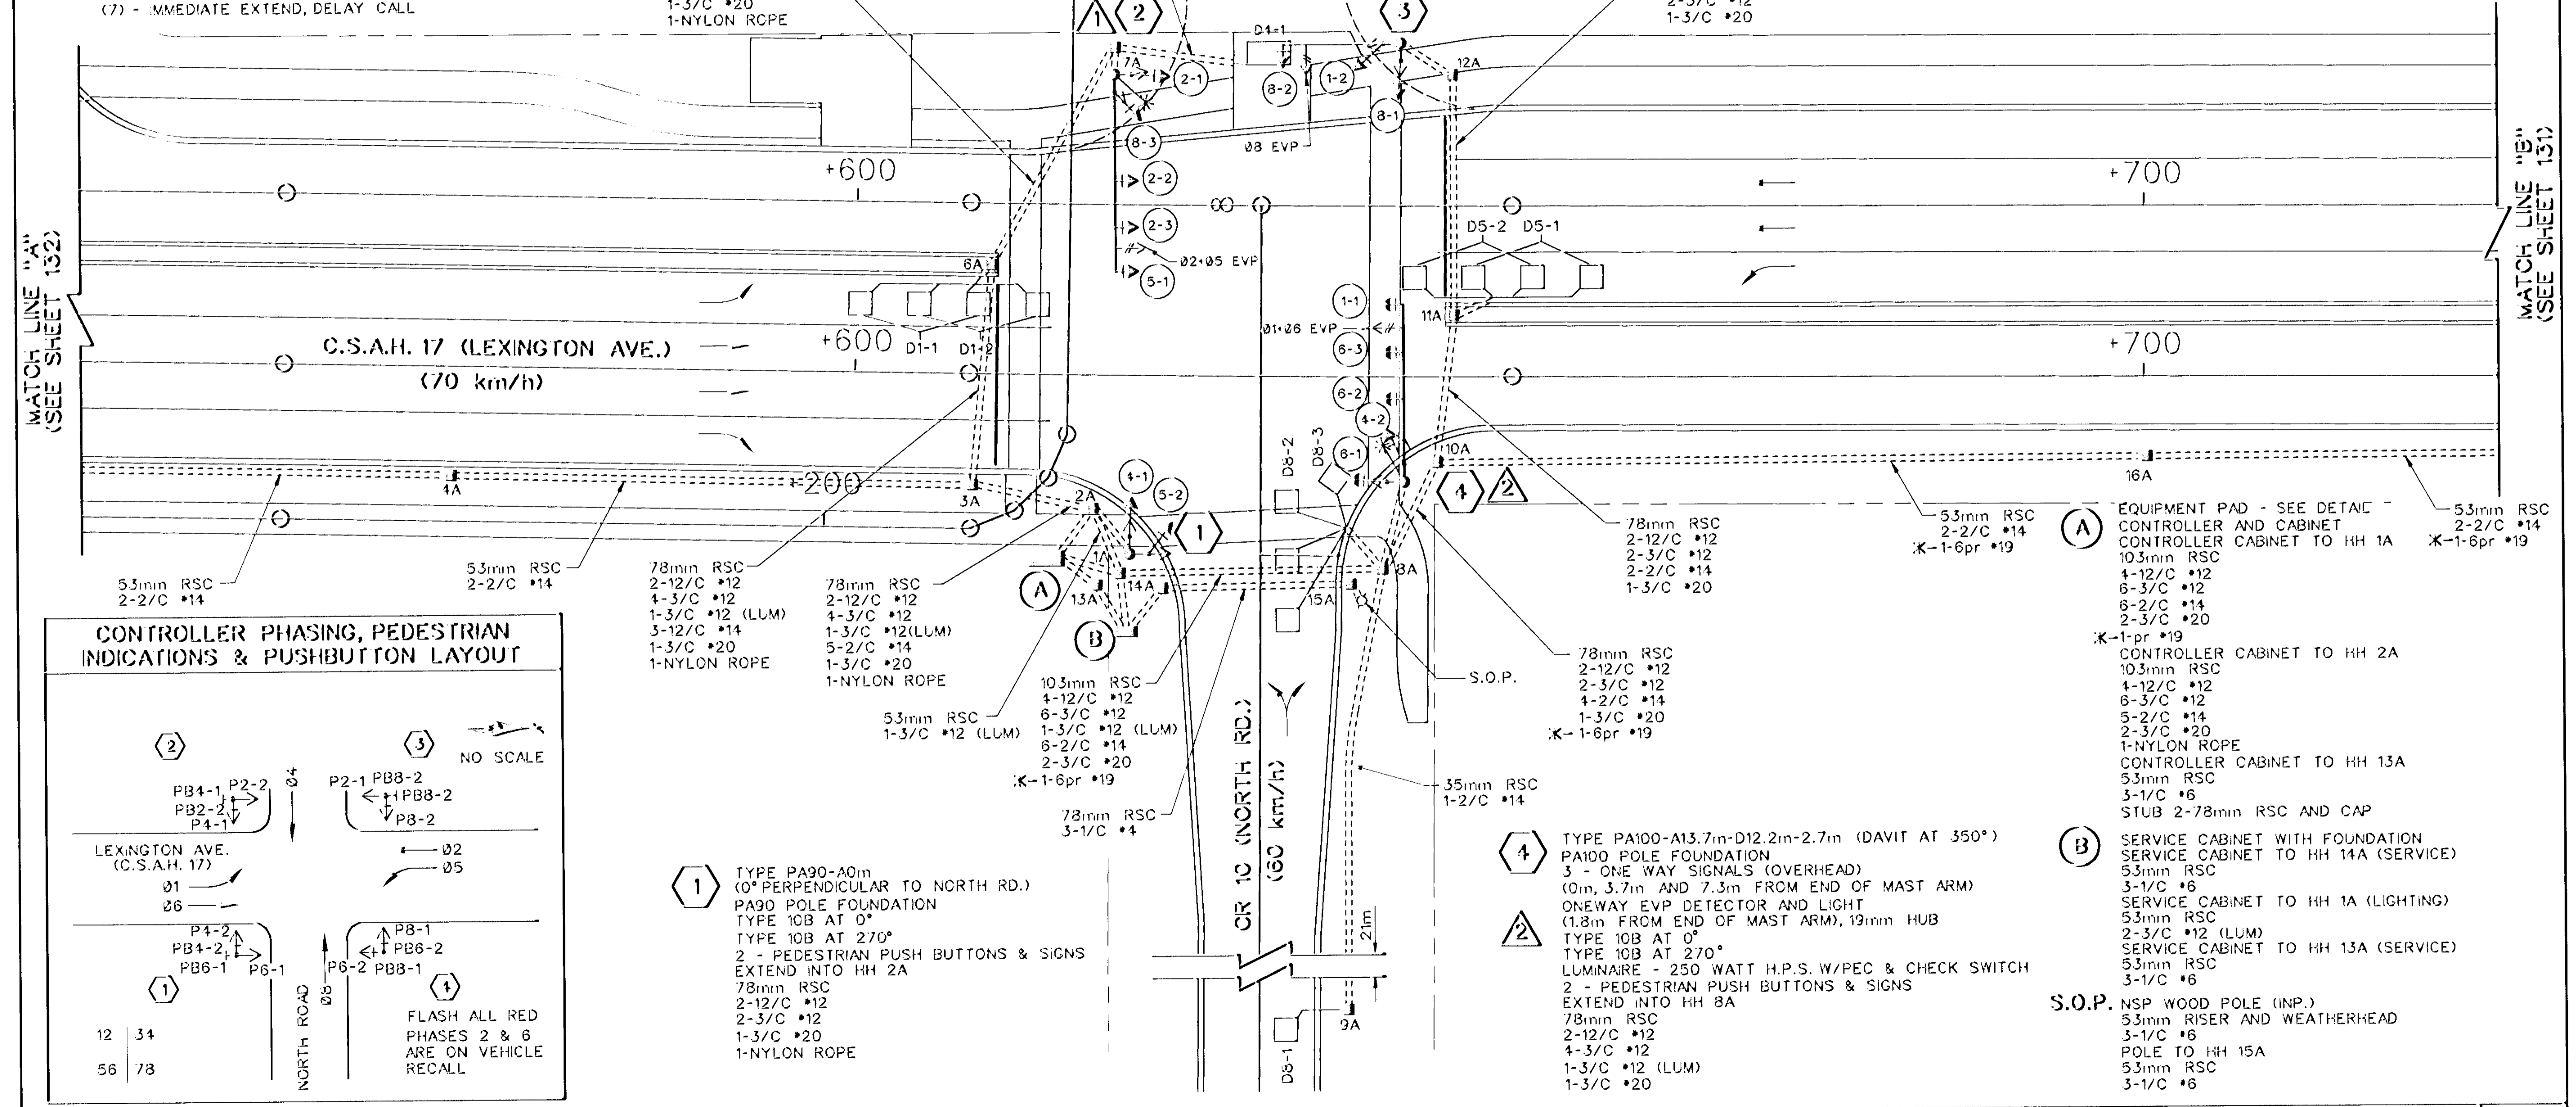


1 TYPE PA90-A0m
 (0° PERPENDICULAR TO NORTH RD.)
 PA90 POLE FOUNDATION
 TYPE 10B AT 0°
 TYPE 10B AT 270°
 2 - PEDESTRIAN PUSH BUTTONS & SIGNS
 EXTEND INTO HH 2A
 78mm RSC
 2-12/C *12
 2-3/C *12
 1-3/C *20
 1-NYLON ROPE

4 TYPE PA100-A13.7m-D12.2m-2.7m (DAVIT AT 350°)
 PA100 POLE FOUNDATION
 3 - ONE WAY SIGNALS (OVERHEAD)
 (0m, 3.7m AND 7.3m FROM END OF MAST ARM)
 ONEWAY EVP DETECTOR AND LIGHT
 (1.8m FROM END OF MAST ARM), 19mm HUB
 TYPE 10B AT 0°
 TYPE 10B AT 270°
 LUMINAIRE - 250 WATT H.P.S. W/PEC & CHECK SWITCH
 2 - PEDESTRIAN PUSH BUTTONS & SIGNS
 EXTEND INTO HH 8A
 78mm RSC
 2-12/C *12
 4-3/C *12
 1-3/C *12 (LUM)
 1-3/C *20

A EQUIPMENT PAD - SEE DETAIL
 CONTROLLER AND CABINET
 CONTROLLER CABINET TO HH 1A
 103mm RSC
 4-12/C *12
 6-3/C *12
 6-2/C *14
 2-3/C *20
 *K-1-pr *19
 CONTROLLER CABINET TO HH 2A
 103mm RSC
 4-12/C *12
 6-3/C *12
 5-2/C *14
 2-3/C *20
 1-NYLON ROPE
 CONTROLLER CABINET TO HH 13A
 53mm RSC
 3-1/C *6
 STUB 2-78mm RSC AND CAP

B SERVICE CABINET WITH FOUNDATION
 SERVICE CABINET TO HH 14A (SERVICE)
 53mm RSC
 3-1/C *6
 SERVICE CABINET TO HH 1A (LIGHTING)
 53mm RSC
 2-3/C *12 (LUM)
 SERVICE CABINET TO HH 13A (SERVICE)
 53mm RSC
 3-1/C *6

S.O.P. NSP WOOD POLE (INP.)
 53mm RISER AND WEATHERHEAD
 3-1/C *6
 POLE TO HH 15A
 53mm RSC
 3-1/C *6

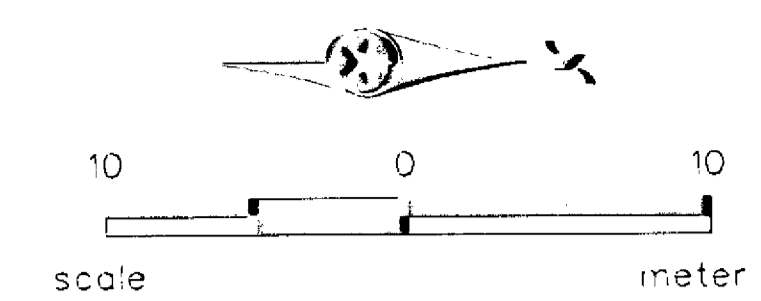

NOTES:

- SEE SPECIAL PROVISIONS FOR COUNTY FURNISHED EQUIPMENT.
- EACH SIGNAL FACE SHALL HAVE A BACKGROUND SHIELD.
- SEE SHEET 119 AND SPECIAL PROVISIONS FOR SERVICE CABINET DETAILS.
- TYPE D SIGNS SHALL BE FURNISHED AND INSTALLED ON MAST ARM POLES 1.2.3. AND 4. SEE SPECIAL PROVISIONS.
- SEE SPECIAL PROVISIONS FOR HANDHOLE TYPE.
- SEE SPECIAL PROVISIONS FOR CONTRACTORS RESPONSIBILITY FOR LOCATION OF UTILITIES.
- ALL PEDESTRIAN INDICATIONS SHALL BE MAN/HAND (SEE SPECIAL PROVISIONS).
- ALL SIGNAL FACES SHALL BE 300mm - 3 SECTION R-Y-G, EXCEPT (1-1) (1-2) (5-1) (5-2) WHICH SHALL BE 300mm - 3 SECTION RLTA, YLTA AND GLTA.
- ALL VEHICLE SIGNAL INDICATIONS AND PEDESTRIAN INDICATIONS SHALL USE GLASS LENSES, EXCEPT RED INDICATIONS WHICH SHALL USE LED TECHNOLOGY.

NO	DATE	BY	CHKD	APPR	REVISION

NAME: AINT DATE: Dec. 19, 1996

I hereby certify that this plan, specification or report was prepared by me or under my direct supervision and that I am a duly Registered Professional Engineer under the laws of the State of Minnesota.

Robert Thomas Bell
 Date: 3/21/97 Reg. No. 24761

STATE AID PROJECT NO.
 SAP 02-617-11

DRAWN BY DATE
 R.V. SMITH 9-96
 DESIGNED BY
 P. CORKLE 9-96
 CHECKED BY
 G. STUEMPFIG 9-96
 COMM. NO.
 0982410

SRI CONSULTING GROUP, INC.

ANOKA COUNTY
 INTERSECTION LAYOUT
 C.S.A.H. 17 RECONSTRUCTION
 C.S.A.H. 17 & CR 10 (NORTH RD.) (SYSTEM A)

SHEET
 121
 OF
 236

LOOP DETECTOR CHART			
DESIGNATION	SIZE	FUNCTION	DISTANCE FROM STOP LINE
D1-1	2-1.7m x 1.7m	(1)	4.6,13.8m
D1-2	2-1.7m x 1.7m	(1)	0,9.2m
D2-1,D2-2	1-1.7m x 1.7m	(1)	92m
D5-1	2-1.7m x 1.7m	(1)	4.6,13.8m
D5-2	2-1.7m x 1.7m	(1)	0,9.2m
D6-1,D6-2	1-1.7m x 1.7m	(1)	92m
D8-1	1-1.7m x 1.7m	(3)	46m
D8-2	2-1.7m x 1.7m	(7)	-3.2,1.4,6m
	1-1.7m x 3.0m		


FUNCTIONS:

- (1) - CALL AND EXTEND
- (3) - EXTEND ONLY
- (7) - IMMEDIATE EXTEND, DELAY CALL

3 TYPE PA100-A12.2m-D12.2m-2.7m (DAVIT AT 350°)
 PA100 POLE FOUNDATION
 3 - ONE WAY SIGNALS (OVERHEAD)
 (0m, 3.8m AND 7.4m FROM END OF MAST ARM)
 ONE WAY EVP DETECTOR AND LIGHT
 TYPE 10B AT 0°
 TYPE 10A AT 270°
 LUMINAIRE - 250 WATT H.P.S. W/PEC & CHECK SWITCH
 1 - PEDESTRIAN PUSH BUTTON & SIGN
 EXTEND INTO HH 7B
 78mm RSC
 2-12/C *12
 4-3/C *12
 1-3/C *12 (LUM)
 1-3/C *20



2 TYPE PA100-A0m (0° PERPENDICULAR TO Q BALL RD.)
 PA100 POLE FOUNDATION
 TYPE 10B AT 0°
 TYPE 30A AT 270°
 2 - PEDESTRIAN PUSH BUTTONS & SIGNS
 EXTEND INTO HH 3B
 78mm RSC
 2-12/C *12
 4-3/C *12
 1-3/C *20

4 TYPE PA100-A13.7m
 PA100 POLE FOUNDATION
 1 - ONE WAY SIGNAL (OVERHEAD)
 (0m FROM END OF MAST ARM)
 ONE WAY EVP DETECTOR AND LIGHT
 (1.8m FROM END OF MAST ARM), 19mm HUB
 TYPE 10A AT 0°
 TYPE 10B AT 270°
 1 - PEDESTRIAN PUSH BUTTON & SIGN
 EXTEND INTO HH 8B
 78mm RSC
 1-12/C *12
 4-3/C *12
 1-3/C *20

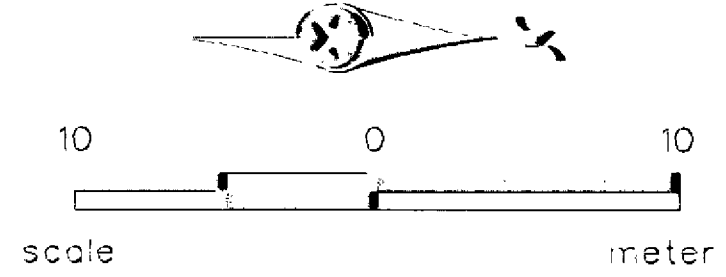

NOTES:

- 1) SEE SPECIAL PROVISIONS FOR COUNTY FURNISHED EQUIPMENT.
- 2) EACH SIGNAL FACE SHALL HAVE A BACKGROUND SHIELD.
- 3) SEE SHEET 119 AND SPECIAL PROVISIONS FOR SERVICE CABINET DETAILS.
- 4) TYPE D SIGNS SHALL BE FURNISHED AND INSTALLED ON MAST ARM POLES 1,2,3 AND 4. SEE SPECIAL PROVISIONS.
- 5) SEE SPECIAL PROVISIONS FOR HANDHOLE TYPE.
- 6) SEE SPECIAL PROVISIONS FOR CONTRACTORS RESPONSIBILITY FOR LOCATION OF UTILITIES.
- 7) ALL PEDESTRIAN INDICATIONS SHALL BE MAN/HAND (SEE SPECIAL PROVISION).
- 8) ALL SIGNAL FACES SHALL BE 300mm - 3 SECTION R-Y-G, EXCEPT (1-1) (1-2) (5-1) (5-2) WHICH SHALL BE 300mm - 3 SECTION RLTA, YLTA AND GLTA.
- 9) ALL VEHICLE SIGNAL INDICATIONS AND PEDESTRIAN INDICATIONS SHALL USE GLASS LENSES, EXCEPT RED INDICATIONS WHICH SHALL USE LED TECHNOLOGY.

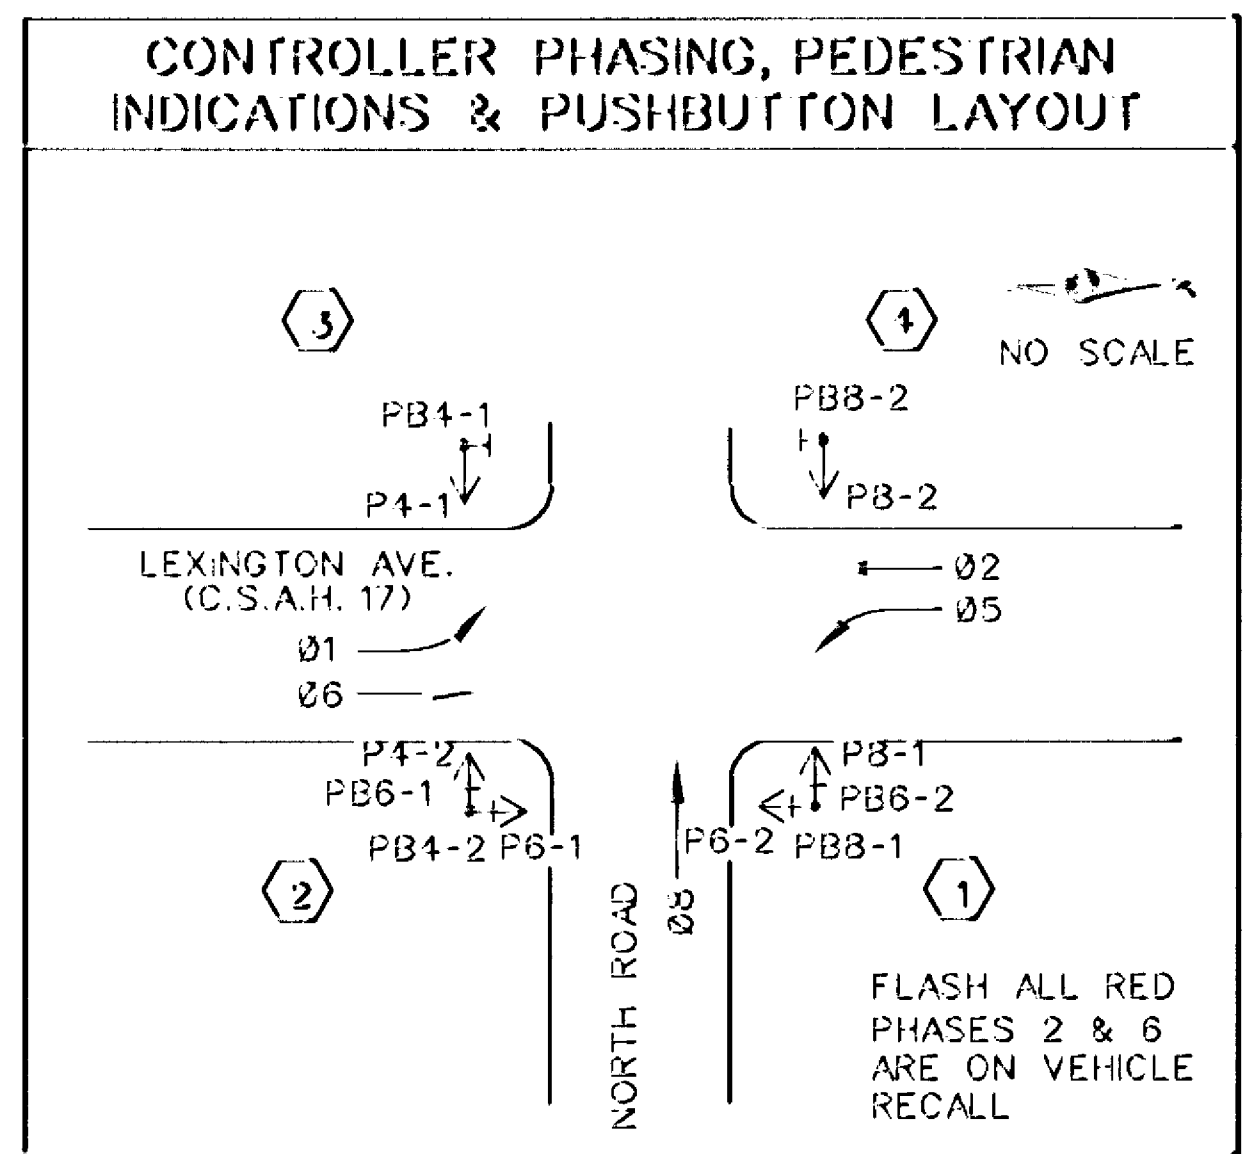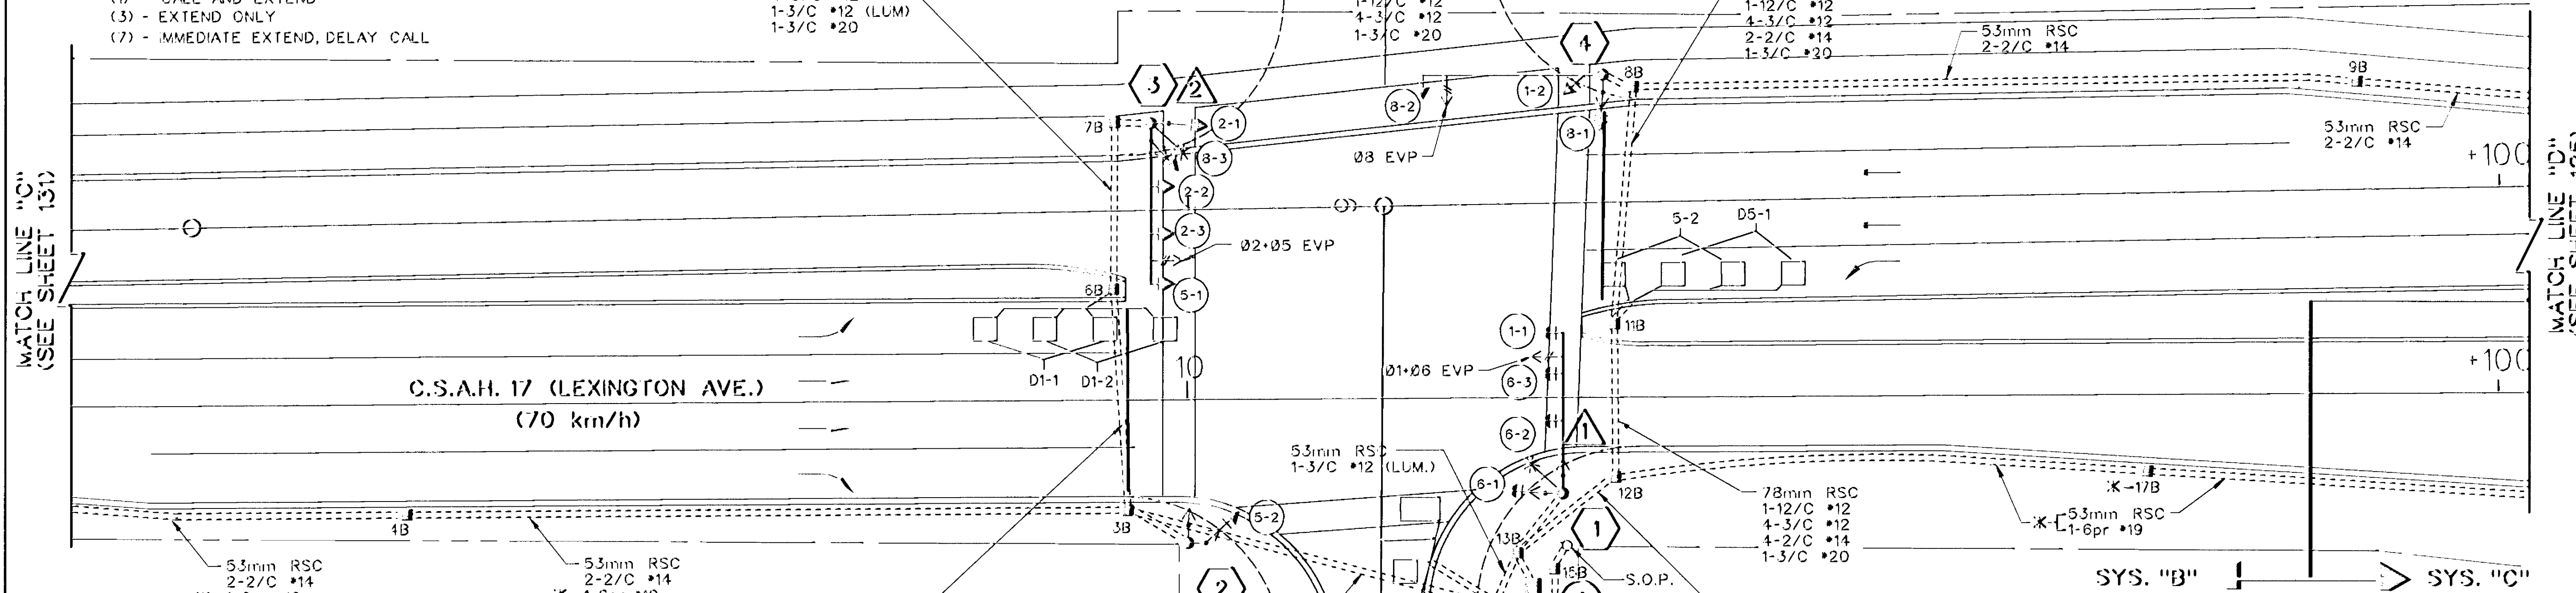

- SYSTEM BOUNDARY**
- (A) EQUIPMENT PAD - SEE DETAIL
 CONTROLLER AND CABINET
 CONTROLLER CABINET TO HH 1B
 103mm RSC
 4-12/C *12
 8-3/C *12
 6-2/C *14
 2-3/C *20
 K-1-6pr *19
 CONTROLLER CABINET TO HH 13B
 103mm RSC
 3-12/C *12
 8-3/C *12
 4-2/C *14
 2-3/C *20
 K-1-6pr *19
 CONTROLLER CABINET TO HH 14B
 53mm RSC
 3-1/C *6
 STUB OUT AND CAP
 2-78mm RSC TO WEST
 - (B) SERVICE CABINET FOUNDATION
 SERVICE CABINET TO HH 14B (SERVICE)
 53mm RSC
 3-1/C *6
 SERVICE CABINET TO HH 1B (LIGHTING)
 53mm RSC
 2-3/C *12
 SERVICE CABINET TO HH 15B (SERVICE)
 53mm RSC
 3-1/C *6
 - S.O.P. NSP WOOD POLE (INP.)
 53mm RSC RISER AND WEATHERHEAD
 3-1/C *6
 POLE TO HH 15B
 53mm RSC
 3-1/C *6

1	3-27-97	MAB	GMS	DRE	ADJUST CROSSWALK LOCATIONS
NO	DATE	BY	CKD	APFR	REVISION
NAME: B.J.N.T DATE: Mar. 27, 1997					

I hereby certify that this plan, specification or report was prepared by me or under my direct supervision and that I am a duly Registered Professional Engineer under the laws of the State of Minnesota.
George M. Stuempfig
 Date: 3/21/97 Reg. No. 21849

STATE AID PROJECT NO.
 SAP 02-617-11


DRAWN BY R.W. SMITH DATE 9-96
 DESIGNED BY C. LEIGHT 9-96
 CHECKED BY G. STUEMPFIG 9-96
 COMM. NO. 0962410



ANOKA COUNTY
 INTERSECTION LAYOUT
 C.S.A.H. 17 RECONSTRUCTION
 C.S.A.H. 17 & BALL RD. (SYSTEM B)

SHEET 123 OF 236


CONTROLLER CABINET

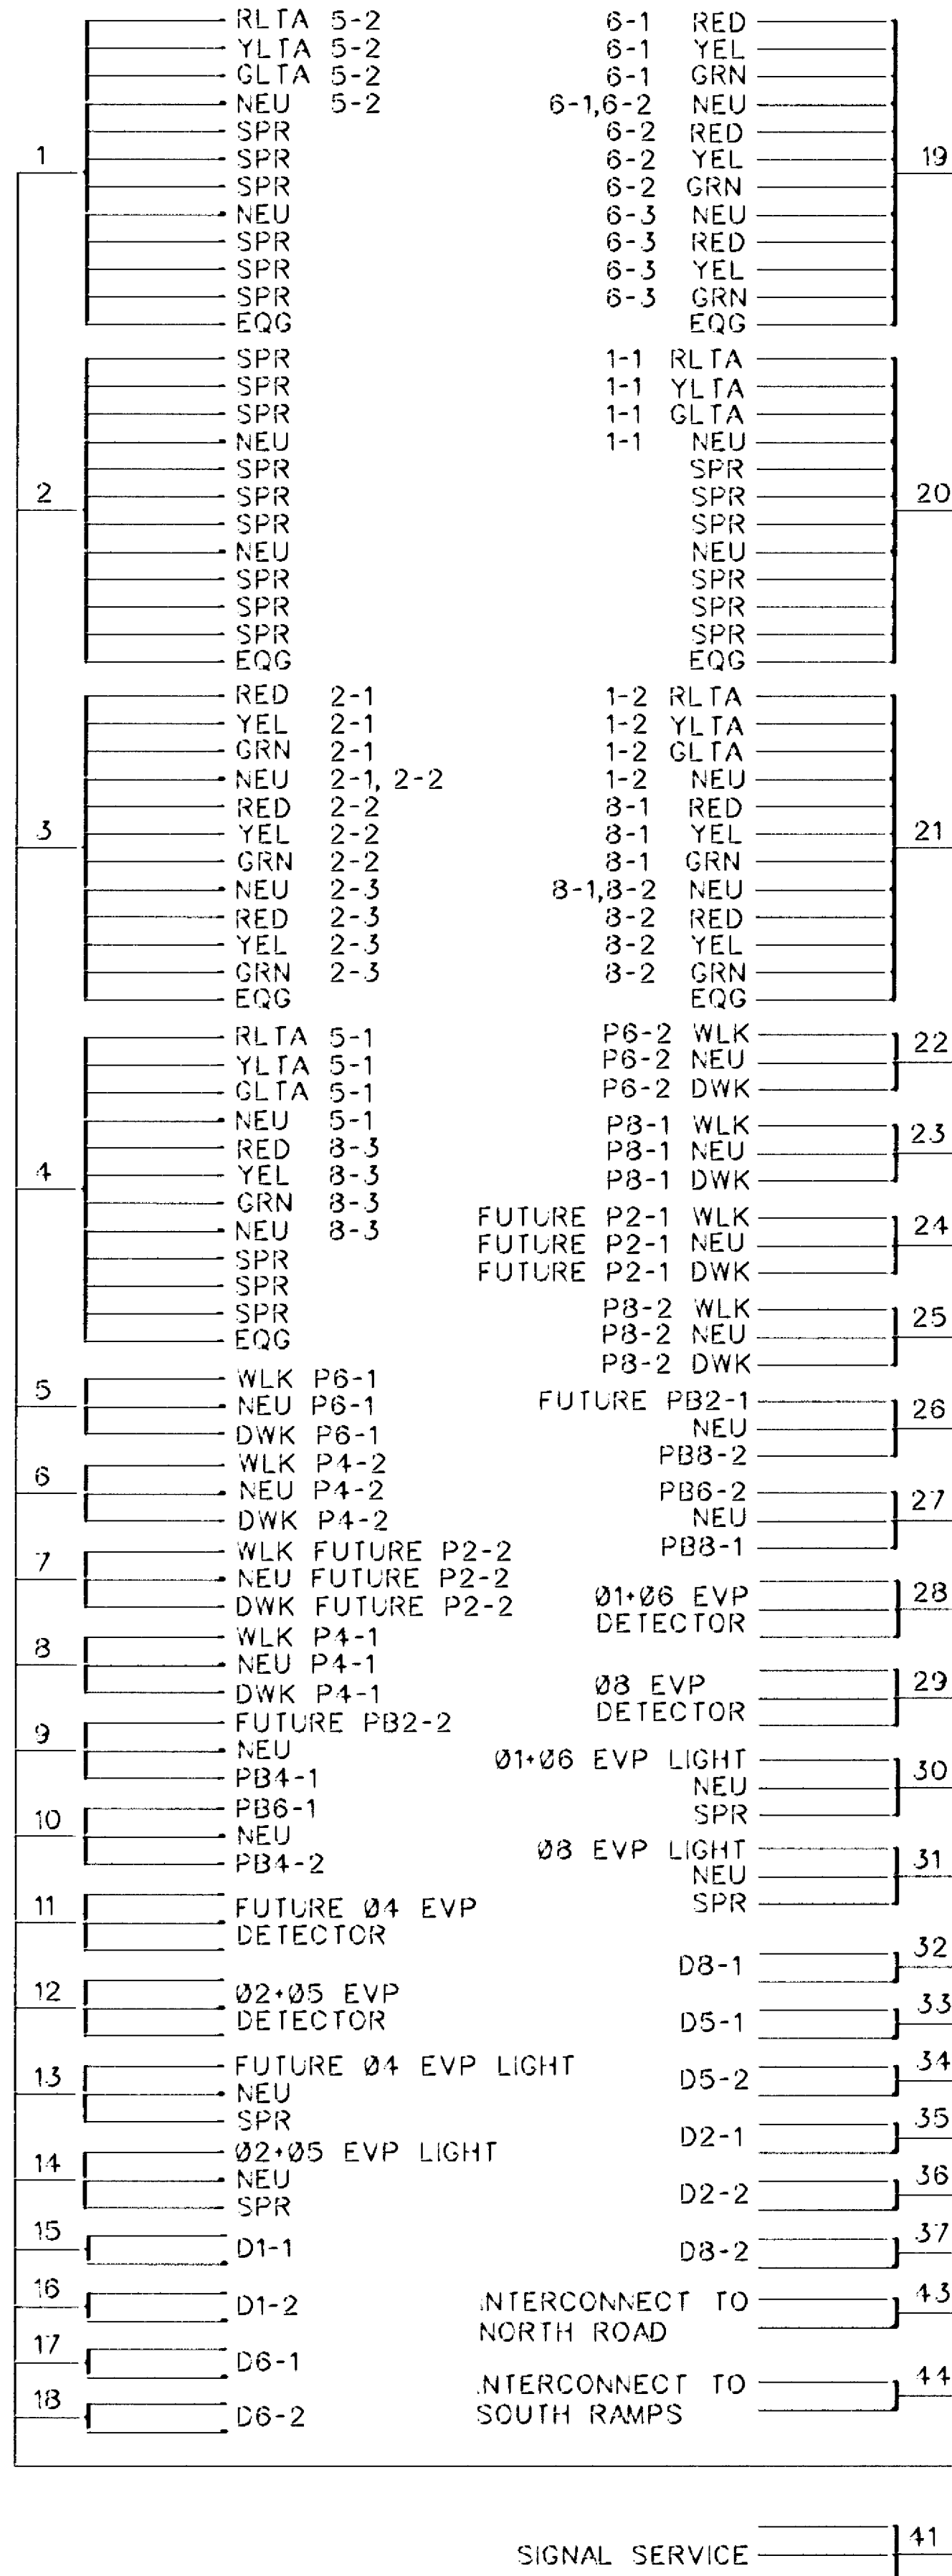

CONDUCTOR COLOR CODING

R	3/C*12
WH	
BLK	
CLR	2/C*14
BLK	
BR. GR.	SHEILDDED CABLE
BLK	2-1/C*6
WH	
R	2-1/C*10
WH	

NOTE: ALL TERMINAL BLOCK CONNECTIONS SHALL BE ARRANGED AS SPECIFIED ABOVE.

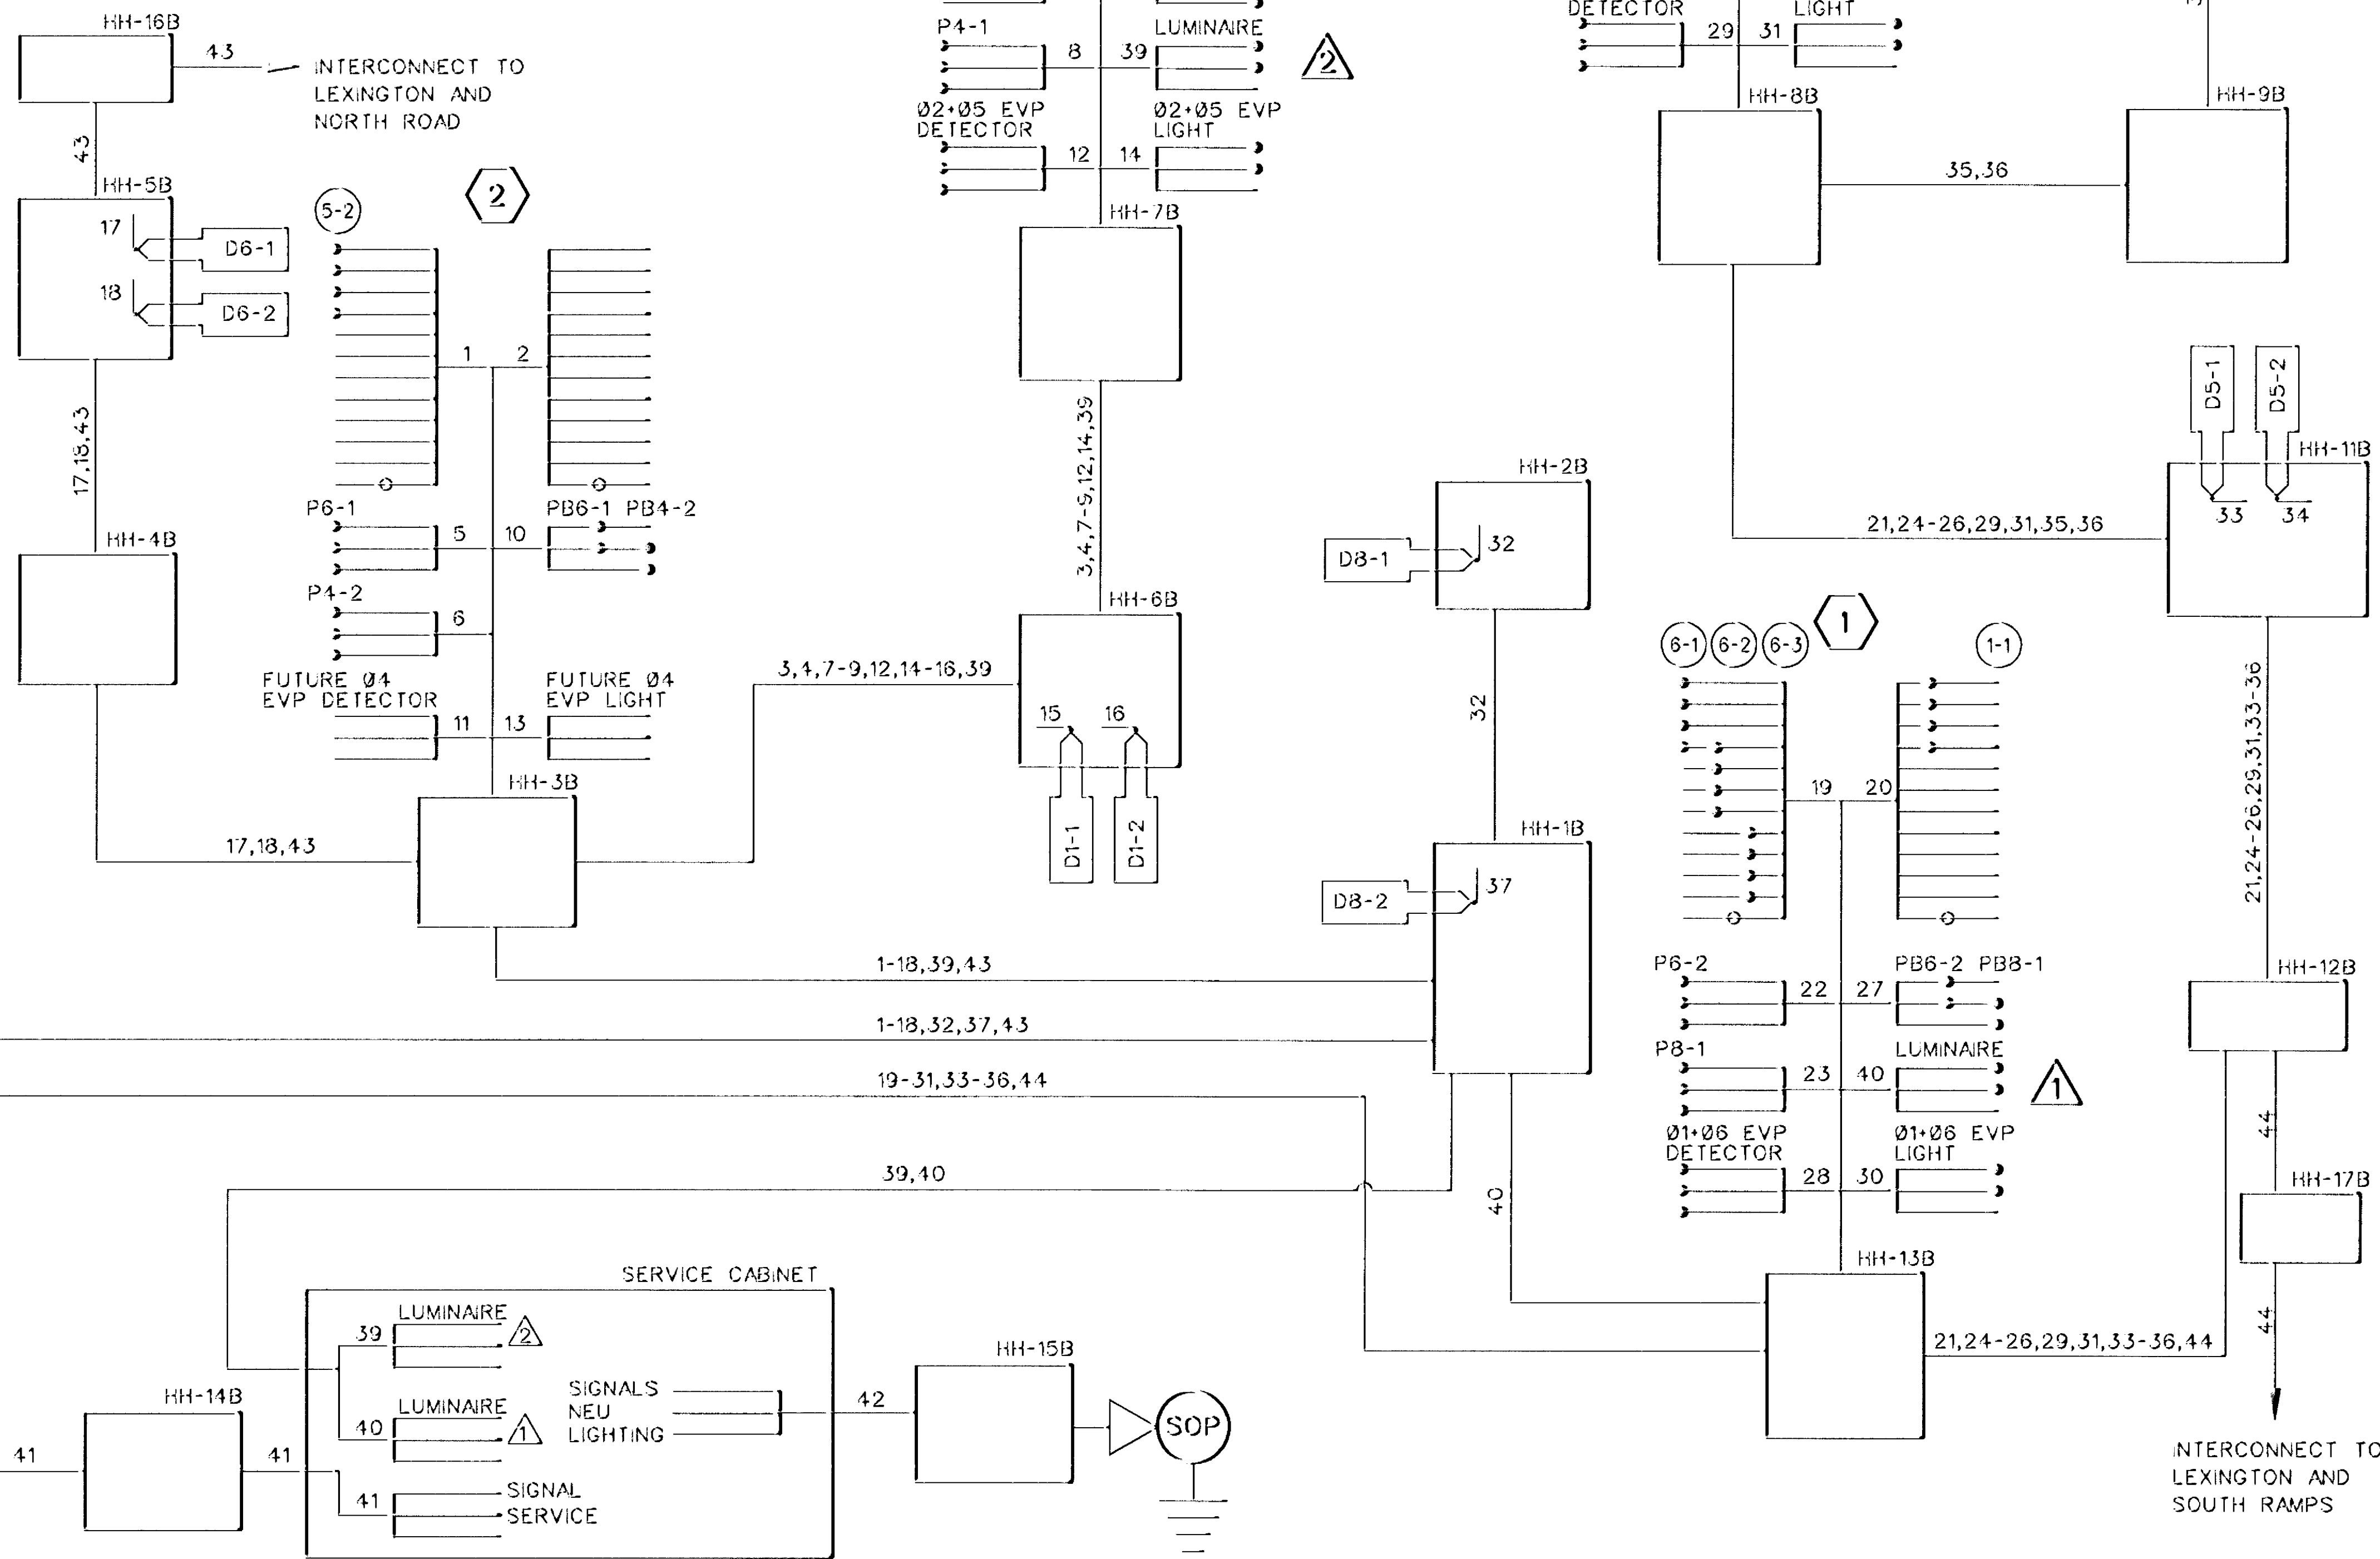

NO.	DATE	BY	CHK	APPR	REVISION

NAME: B.WD DATE: Mar. 18, 1997

minnesota metric

I hereby certify that this plan, specification or report was prepared by me or under my direct supervision and that I am a duly Registered Professional Engineer under the laws of the State of Minnesota.

George M. Stumpff
Date: 3/21/97 Reg. No. 21849

STATE AID PROJECT NO. SAP 02-617-11

DRAWN BY R.W. SMITH DATE 9-96
DESIGNED BY C. LEIGHT 9-96
CHECKED BY G. STUEMPFF 9-96
COMM. NO. 0962410


SRT CONSULTING GROUP, INC.

ANOKA COUNTY
FIELD WIRING DIAGRAM
C.S.A.H. 17 RECONSTRUCTION
C.S.A.H. 17 & BALL RD. (SYSTEM B)

SHEET 124 OF 236



LOOP DETECTOR CHART			DISTANCE FROM STOP LINE
DESIGNATION	SIZE	FUNCTION	
D2-1	1-1.7m x 1.7m	(1)	92m
D2-2	1-1.7m x 1.7m	(1)	92m
D4-1	1-1.7m x 1.7m	(3)	35m
D4-2	1-1.7m x 1.7m	(3)	35m
D4-3	2-1.7m x 1.7m	(1)	0m, 4.6m
D4-4	2-1.7m x 1.7m	(1)	0m, 4.6m
D5-1	2-1.7m x 1.7m	(1)	6.1m, 15.2m
D5-2	2-1.7m x 1.7m	(1)	1.5m, 10.7m
D6-1	1-1.7m x 1.7m	(1)	92m
D6-2	1-1.7m x 1.7m	(1)	92m

- ③ TYPE PA90-A9.1m-D12.2m-2.7m (DAVIT AT 350°)
PA90 POLE FOUNDATION
2 - ONE WAY SIGNALS (OVERHEAD)
(0m AND 3.3m FROM END OF MAST ARM)
ONEWAY EVP DETECTOR AND LIGHT
(1.2m FROM END OF MAST ARM), 19mm HUB
TYPE 10B AT 270°
LUMINAIRE - 250 WATT H.P.S.
WITH PEC & CHECK SWITCH
1- PEDESTRIAN PUSH BUTTON & SIGN
EXTEND INTO HH 5C
- ② TYPE PA90-A10.7m
PA90 POLE FOUNDATION
1 - ONE WAY SIGNALS (OVERHEAD)
(0m FROM END OF MAST ARM)
ONEWAY EVP DETECTOR AND LIGHT
(1.8m FROM END OF MAST ARM), 19mm HUB
TYPE 10A AT 0°
TYPE 10A AT 270°
1-R9-3a SIGN FACING ③
EXTEND INTO HH 4C
78mm RSC
1-12/C *12
1-3/C *12
1-3/C *20

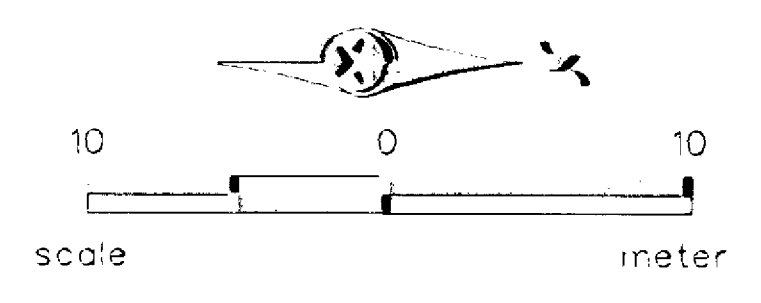

- NOTES:**
- SEE SPECIAL PROVISIONS FOR COUNTY FURNISHED EQUIPMENT.
 - EACH SIGNAL FACE SHALL HAVE A BACKGROUND SHIELD.
 - SEE SHEET 119 AND SPECIAL PROVISIONS FOR SERVICE CABINET DETAILS.
 - TYPE D SIGNS SHALL BE FURNISHED AND INSTALLED ON MAST ARM POLES 1,2,3 AND 4. SEE SPECIAL PROVISIONS.
 - SEE SPECIAL PROVISIONS FOR HANDHOLE TYPE.
 - SEE SPECIAL PROVISIONS FOR CONTRACTORS RESPONSIBILITY FOR LOCATION OF UTILITIES.
 - ALL PEDESTRIAN INDICATIONS SHALL BE MAN/HAND (SEE SPECIAL PROVISIONS).
 - ALL SIGNAL FACES SHALL BE 300mm - 3 SECTION R-Y-G, EXCEPT ⑤-1 ⑤-2 WHICH SHALL BE 300mm - 3 SECTION RLTA, YLTA AND GLTA.
 - ALL VEHICLE SIGNAL INDICATIONS AND PEDESTRIAN INDICATIONS SHALL USE GLASS LENSES, EXCEPT RED INDICATIONS WHICH SHALL USE LED TECHNOLOGY.
 - CONDUIT AND JUNCTION BOXES ON BRIDGE TO BE INCLUDED IN BRIDGE PAY ITEMS.

- FUNCTIONS:**
- (1) - CALL AND EXTEND
 - (3) - EXTEND ONLY
 - (7) - IMMEDIATE EXTEND, DELAY CALL

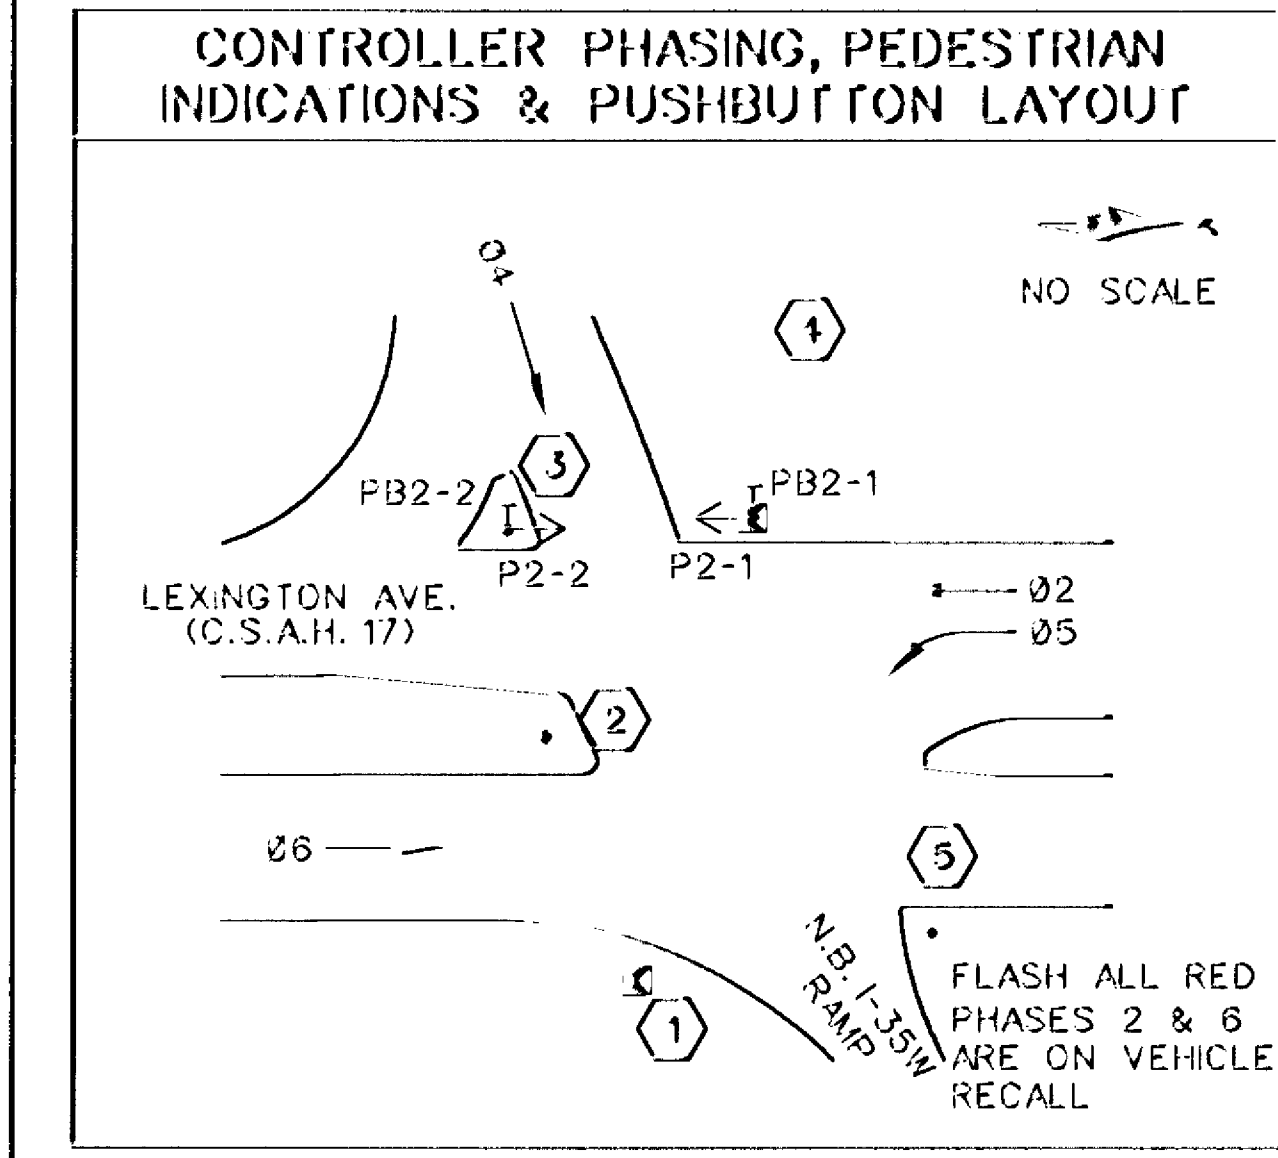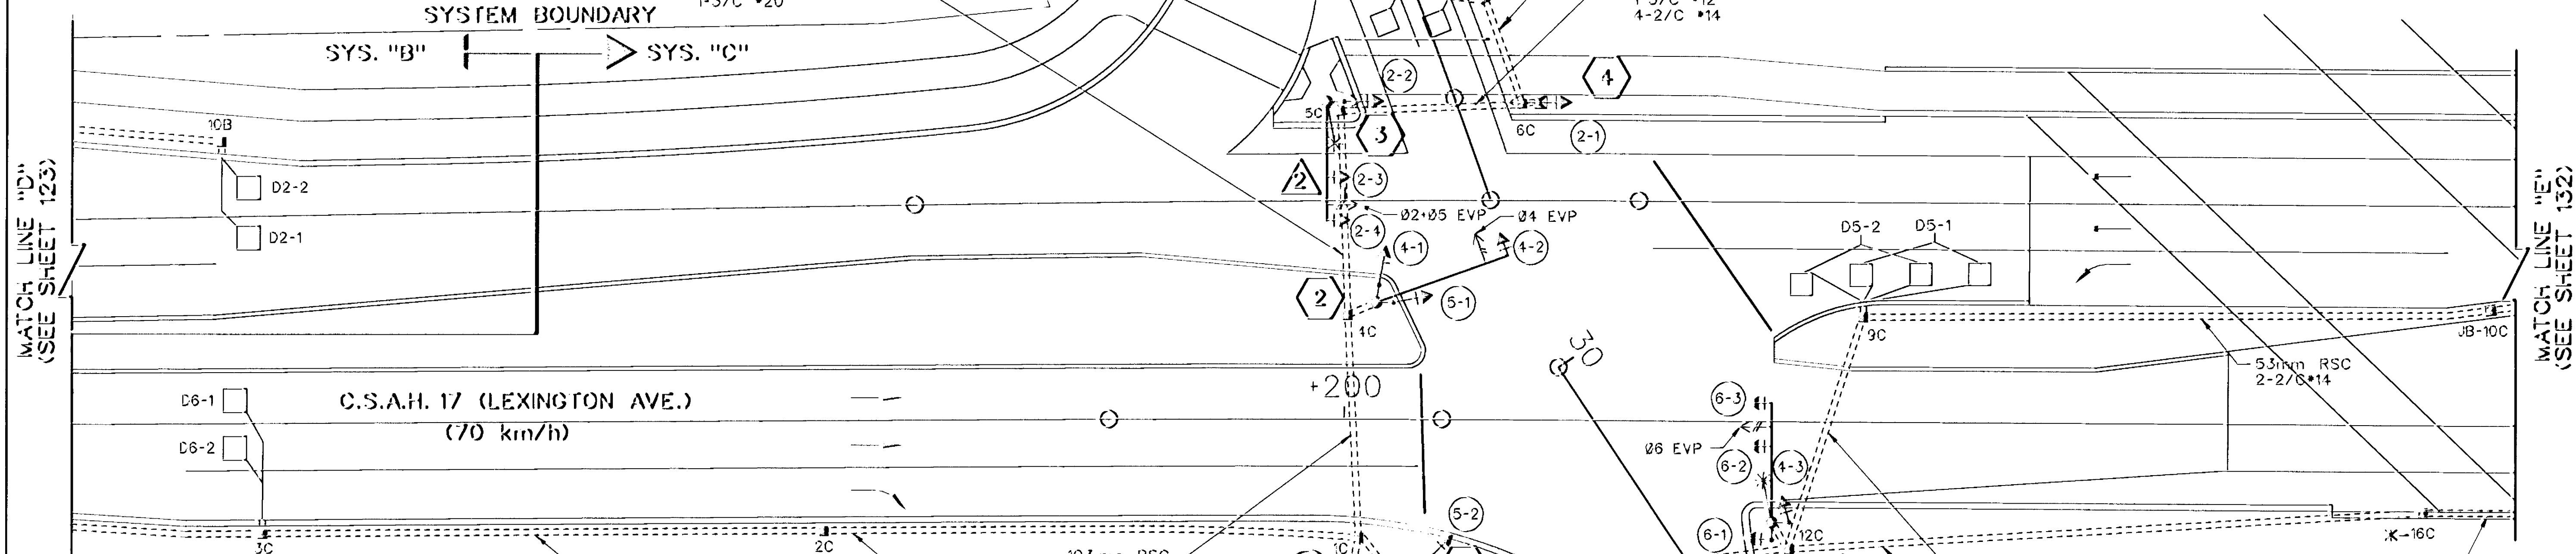

- ① 10' PEDESTAL AND BASE PEDESTAL FOUNDATION TYPE 1A
EXTEND INTO HH 13C
53mm RSC
1-12/C *12
- ② SERVICE CABINET FOUNDATION SERVICE CABINET TO HH 14C (SERVICE)
53mm RSC
3-1/C *6
SERVICE CABINET TO HH 13C (LIGHTING)
53mm RSC
2-3/C *12 (LUM)
SERVICE CABINET TO HH 15C
53mm RSC
3-1/C *6

- ④ 10' PEDESTAL AND BASE PEDESTAL FOUNDATION TYPE 1B
1 - PEDESTRIAN PUSH BUTTON & SIGN
EXTEND INTO HH 6C
53mm RSC
1-12/C *12
1-3/C *12
1-3/C *20
- ⑤ TYPE PA90-A9.1m-D12.2m-2.7m (DAVIT AT 350°)
PA90 POLE FOUNDATION
2 - ONE WAY SIGNALS (OVERHEAD)
(0m AND 3.3m FROM END OF MAST ARM)
ONEWAY EVP DETECTOR AND LIGHT
(1.2m FROM END OF MAST ARM), 19mm HUB
TYPE 10A AT 90°
TYPE 10A AT 180°
LUMINAIRE - 250 WATT H.P.S.
WITH PEC & CHECK SWITCH
1-R9-3a SIGN FACING ③
EXTEND INTO HH 12C
78mm RSC
2-12/C *12
1-3/C *12
1-3/C *20

- ⑤ TYPE PA90-A9.1m-D12.2m-2.7m (DAVIT AT 350°)
PA90 POLE FOUNDATION
2 - ONE WAY SIGNALS (OVERHEAD)
(0m AND 3.3m FROM END OF MAST ARM)
ONEWAY EVP DETECTOR AND LIGHT
(1.2m FROM END OF MAST ARM), 19mm HUB
TYPE 10A AT 180°
LUMINAIRE - 250 WATT H.P.S.
WITH PEC & CHECK SWITCH
1-R9-3a SIGN FACING ③
EXTEND INTO HH 12C
78mm RSC
2-12/C *12
1-3/C *12
1-3/C *20

*K- DESIGNATES ITEMS TO BE INCLUDED IN THE INTERCONNECT SYSTEM PAY ITEM

NO	DATE	BY	CHKD	APPR	REVISION

NAME: C.INT DATE: Mar. 18, 1997

I hereby certify that this plan, specification or report was prepared by me or under my direct supervision and that I am a duly Registered Professional Engineer under the laws of the State of Minnesota.

George M. Stuenkel
Date: 3/21/97 Reg. No. 21849

STATE AID PROJECT NO.
SAP 02-617-11

STATE PROJECT NO.
SP 0280-47

DRAWN BY
R.W. SMITH

DESIGNED BY
G. STUEMPF

CHECKED BY
C. LEIGHT

DATE
9-96

DATE
9-96

CCMM. NO.
0962410





ANOKA COUNTY

INTERSECTION LAYOUT

C.S.A.H. 17 RECONSTRUCTION

C.S.A.H. 17 & I-35W SOUTH RAMPS (SYSTEM C)

SHEET 125 OF 236

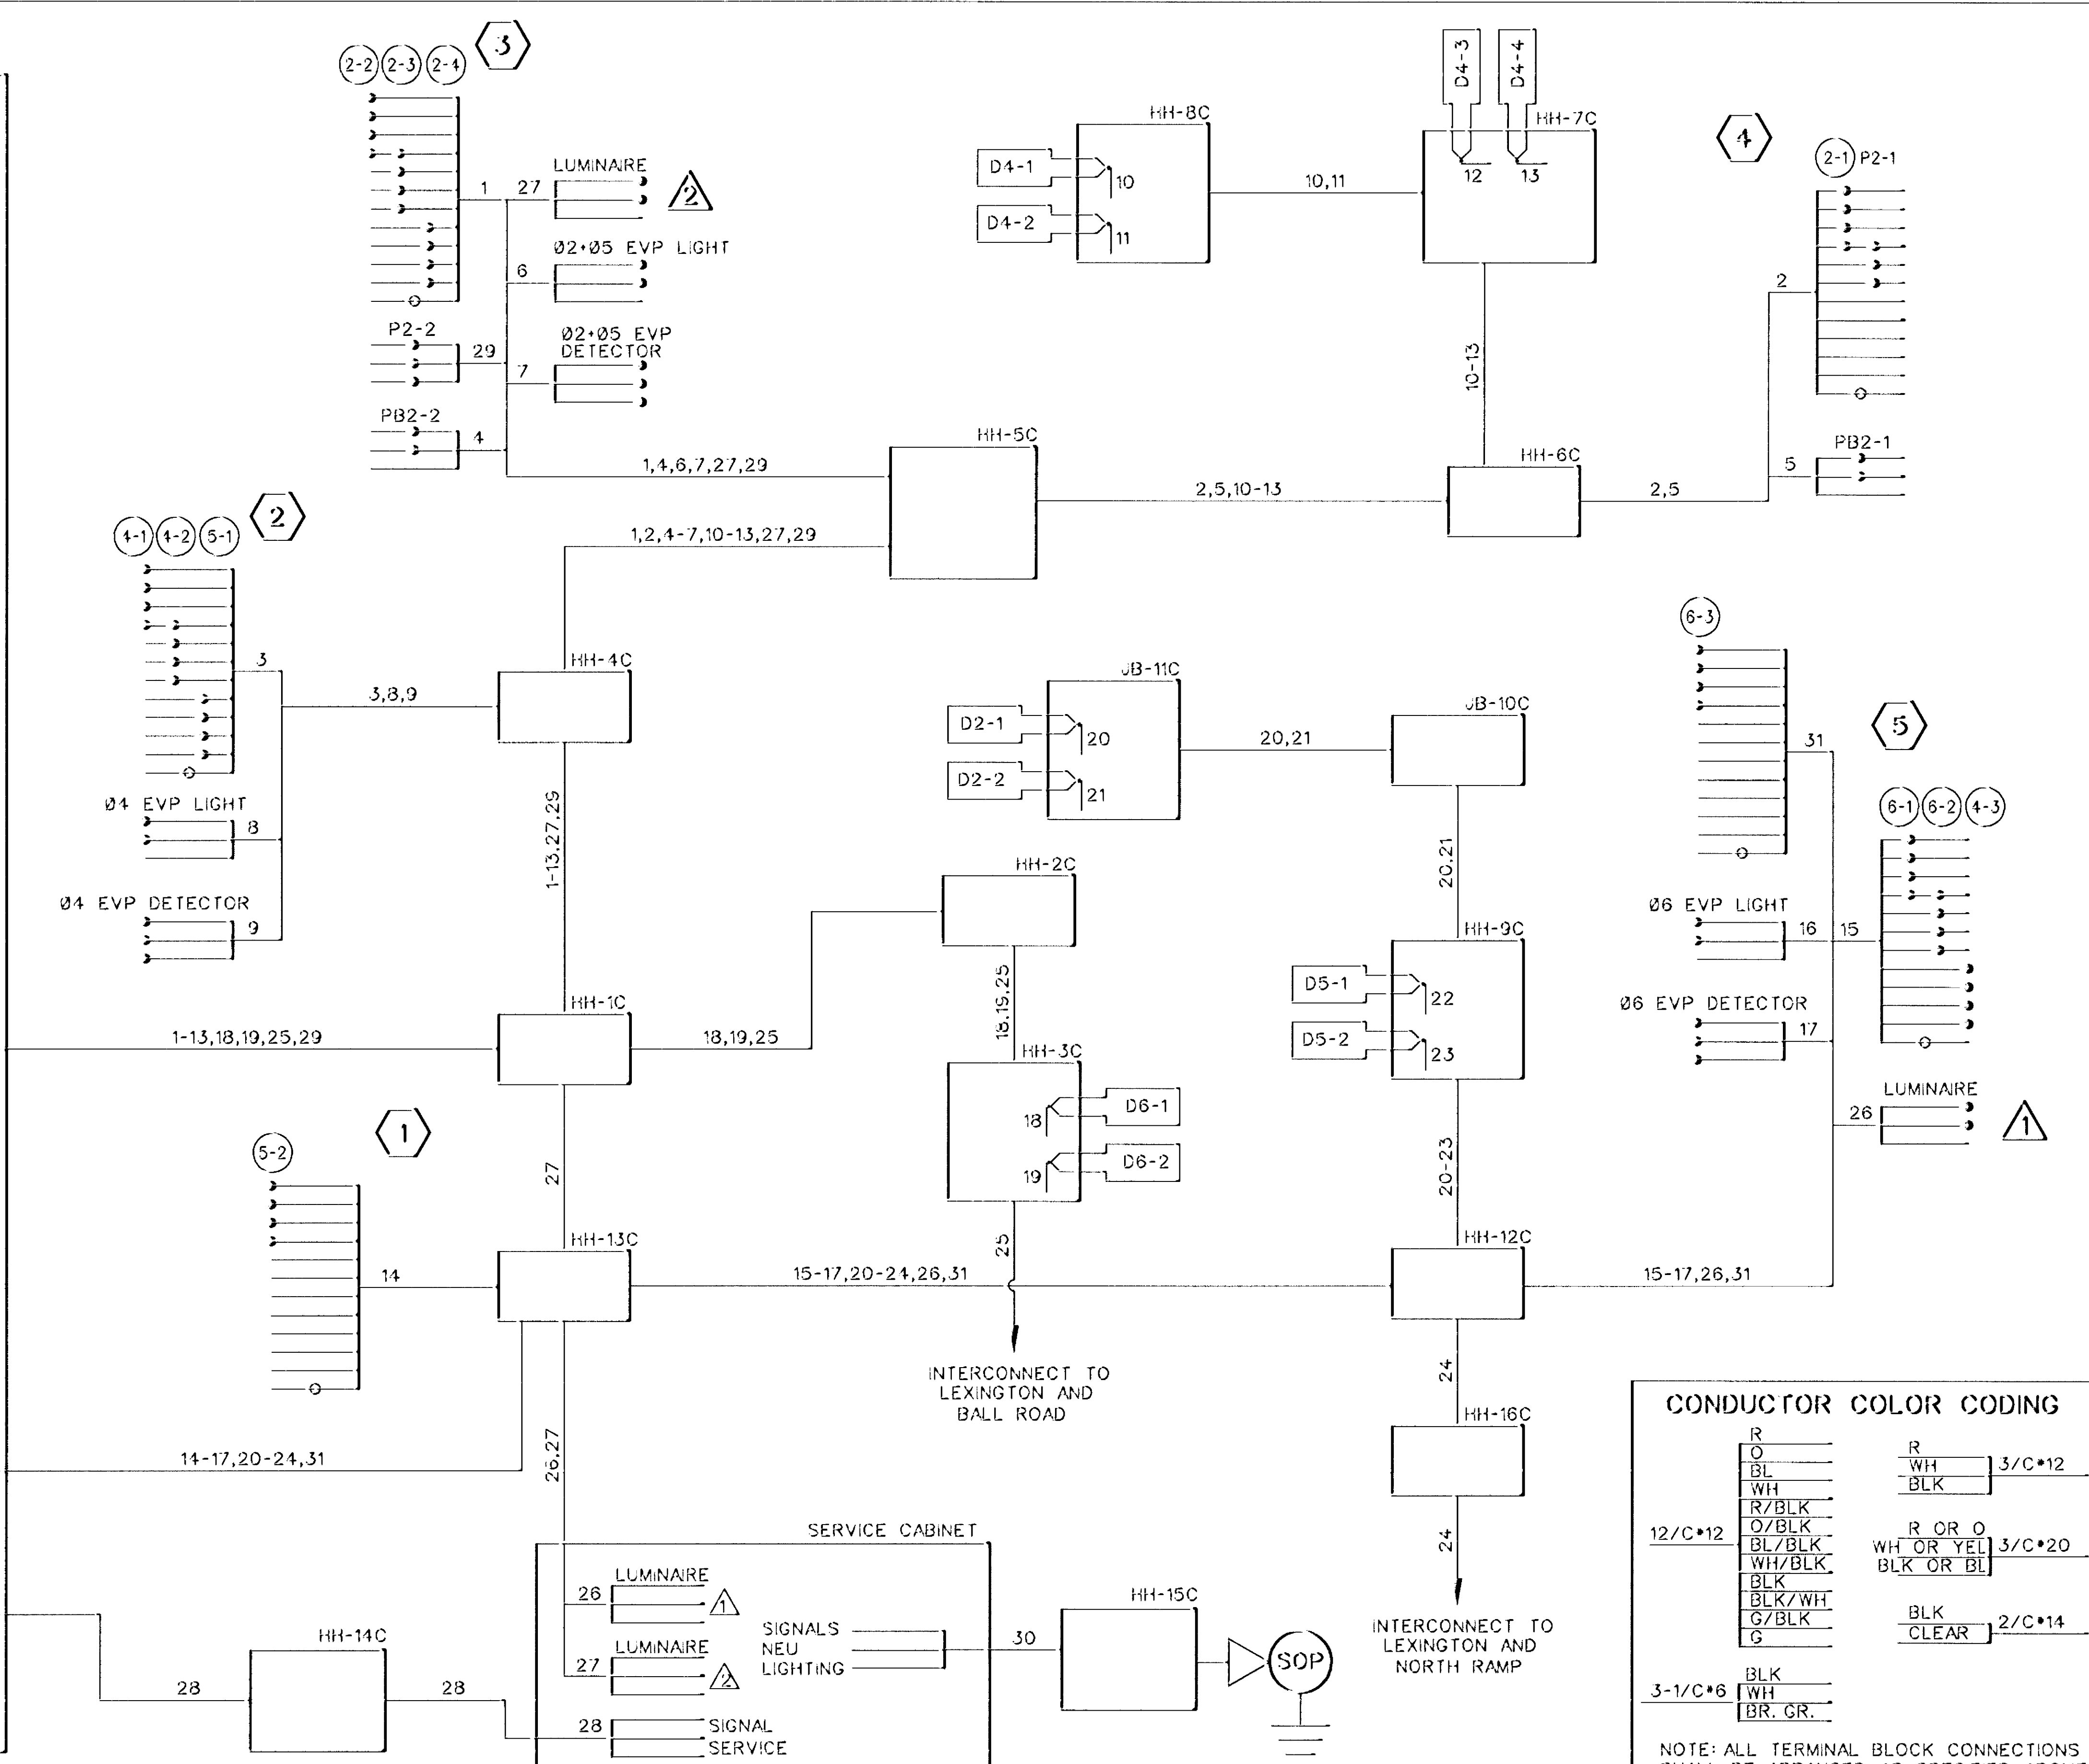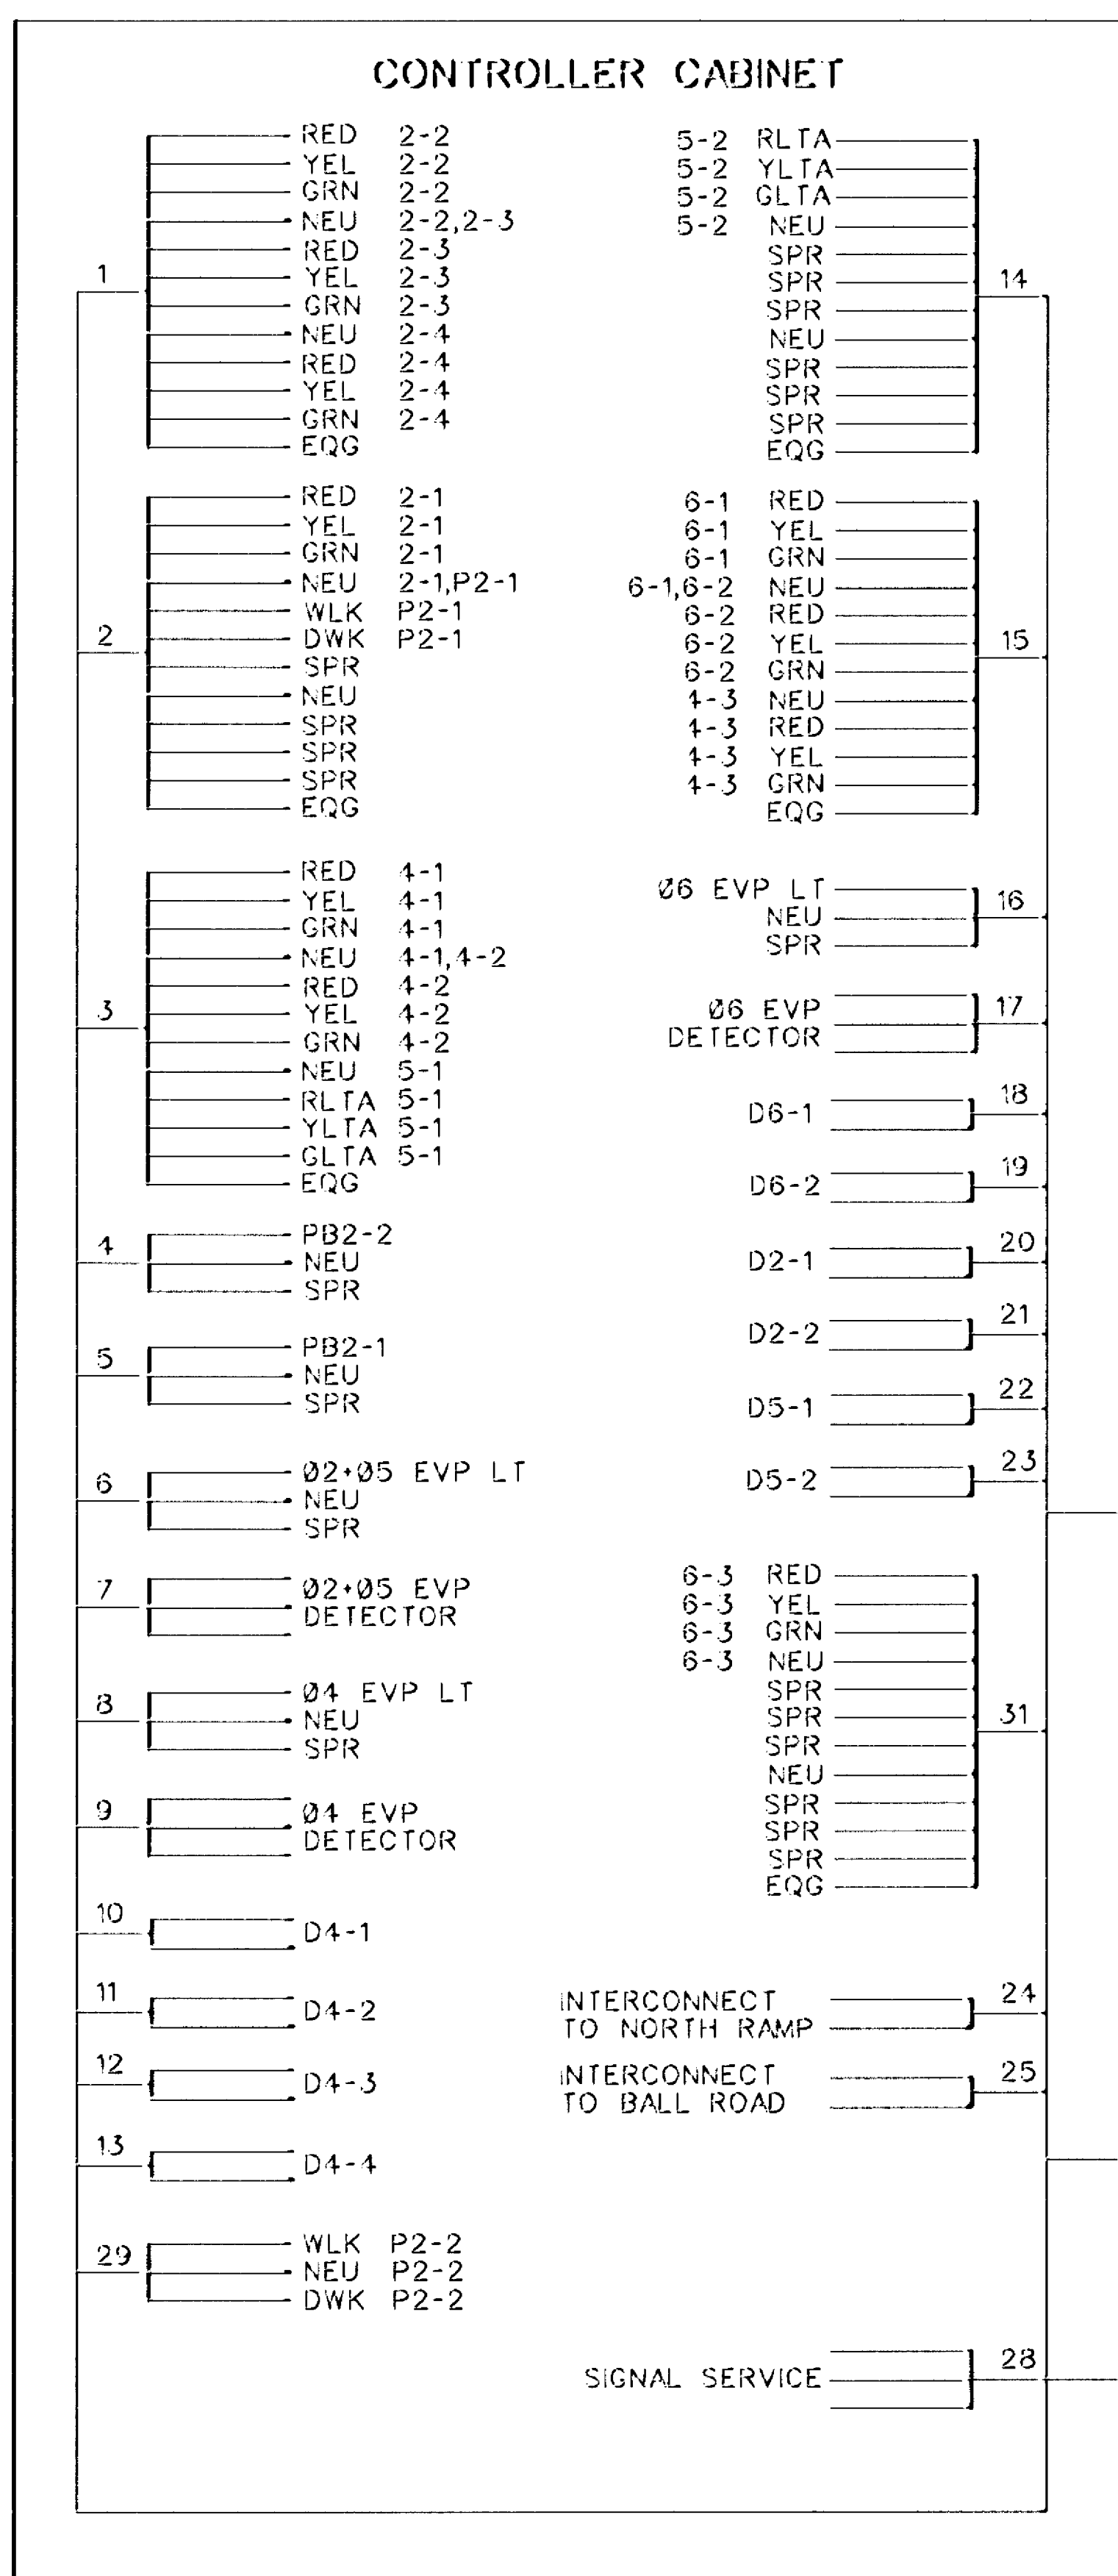

CONDUCTOR COLOR CODING

R	R
O	WH
BL	BLK
WH	3/C*12
R/BLK	
O/BLK	
BL/BLK	R OR O
WH/BLK	WH OR YEL
BLK	BLK OR BL
BLK/WH	3/C*20
O/BLK	
G	BLK
	CLEAR
	2/C*14
3-1/C*6	BLK
	WH
	BR. GR.

NOTE: ALL TERMINAL BLOCK CONNECTIONS SHALL BE ARRANGED AS SPECIFIED ABOVE.

LOOP DETECTOR CHART			
DESIGNATION	SIZE	FUNCTION	DISTANCE FROM STOP LINE
D1-1,D1-3	2-1.7m x 1.7m	(1)	6.1,15.2m
D1-2,D1-4	2-1.7m x 1.7m	(1)	1.5,10.7m
D3-1,D3-2	1-1.7m x 1.7m	(1)	92m
D3-3,D3-4	2-1.7m x 1.7m	(1)	1.5,6.1m
D6-1,D6-2	1-1.7m x 1.7m	(1)	92m
D8-1	1-1.7m x 1.7m	(3)	35m
D8-2	2-1.7m x 1.7m	(1)	1.5,6.1m

LOOP DETECTOR CHART
 (1) - CALL AND EXTEND
 (3) - EXTEND ONLY

2 TYPE PA90-A10.7m-D12.2m-2.7m (DAVIT AT 350°)
 PA90 POLE FOUNDATION
 2 - ONE WAY SIGNALS (OVERHEAD)
 (0m AND 3.4m FROM END OF MAST ARM)
 ONE WAY EVP DETECTOR AND LIGHT
 (1.2m FROM END OF MAST ARM)
 TYPE 10A AT 0°
 TYPE 10B AT 270°
 LUMINAIRE - 250 WATT H.P.S.
 W/PEC & CHECK SWITCH
 1 - PEDESTRIAN PUSH BUTTON & SIGN
 EXTEND INTO HH 8D
 78mm RSC
 2-12/C *12
 2-3/C *12
 1-3/C *12 (LUM.)
 1-3/C *20

3 TYPE PA90-A9.1m
 PA90 POLE FOUNDATION
 1 - ONE WAY SIGNAL (OVERHEAD)
 (0m FROM END OF MAST ARM)
 ONE WAY EVP DETECTOR AND LIGHT
 (1.8m FROM END OF MAST ARM)
 TYPE 10A AT 180°
 TYPE 10B AT 0°
 TYPE 10A AT 180°
 1 - PEDESTRIAN PUSH BUTTON & SIGN
 EXTEND INTO HH 9D
 78mm RSC
 2-12/C *12
 2-3/C *12
 1-3/C *20


4 10' PEDESTAL AND BASE
 PEDESTAL FOUNDATION
 TYPE 2A
 1-R9-3a SIGN FACING (3)
 EXTEND INTO HH 10D
 78mm RSC
 1-12/C *12

NOTES:


- SEE SPECIAL PROVISIONS FOR COUNTY FURNISHED EQUIPMENT.
- EACH SIGNAL FACE SHALL HAVE A BACKGROUND SHIELD.
- SEE SHEET 119 AND SPECIAL PROVISIONS FOR SERVICE CABINET DETAILS.
- TYPE D SIGNS SHALL BE FURNISHED AND INSTALLED ON MAST ARM POLES 1, 2 AND 3. SEE SPECIAL PROVISIONS.
- SEE SPECIAL PROVISIONS FOR HANDHOLE TYPE.
- SEE SPECIAL PROVISIONS FOR CONTRACTORS RESPONSIBILITY FOR LOCATION OF UTILITIES.
- ALL PEDESTRIAN INDICATIONS SHALL BE MAN/HAND (SEE SPECIAL PROVISIONS).
- ALL SIGNAL FACES SHALL BE 300mm - 3 SECTION R-Y-G, EXCEPT (1-1) (1-2) WHICH SHALL BE 300mm - 3 SECTION RLTA, YLTA AND GLTA. (3-1) (3-2) WHICH SHALL BE 300mm - 3 SECTION RRTA, YRTA AND GRTA.
- ALL VEHICLE SIGNAL INDICATIONS AND PEDESTRIAN INDICATIONS SHALL USE GLASS LENSES, EXCEPT RED INDICATIONS WHICH SHALL USE LED TECHNOLOGY.
- CONDUIT AND JUNCTION BOXES ON BRIDGE TO BE INCLUDED IN BRIDGE PAY ITEMS.

MATCH LINE "F"
(SEE SHEET 132)

MATCH LINE "G"
(SEE SHEET 129)

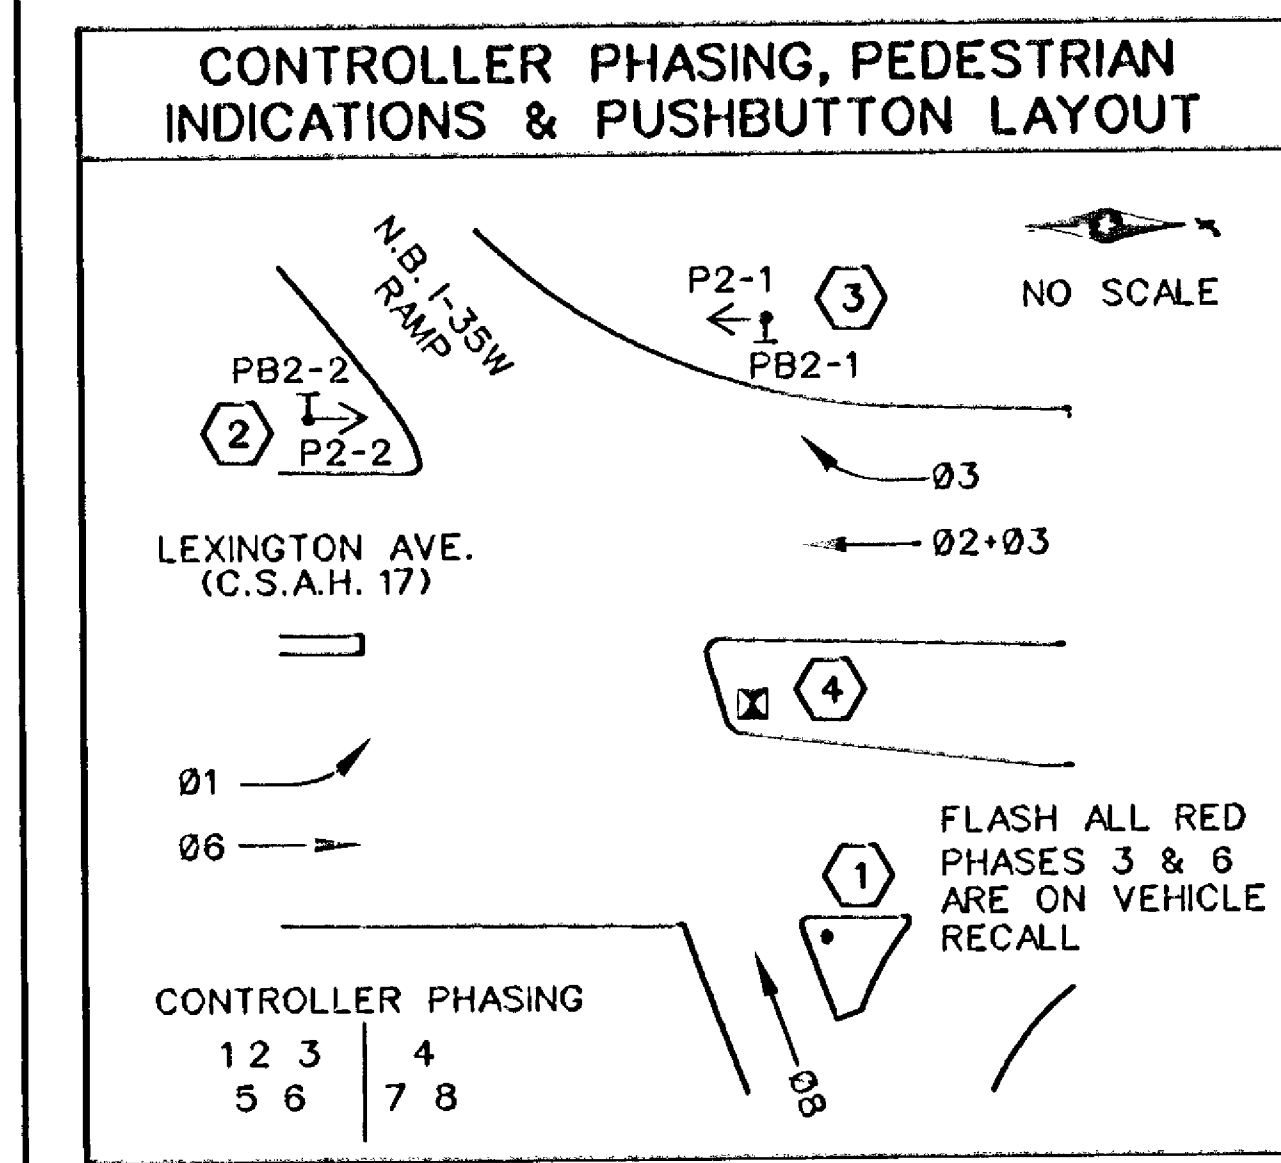

NO	DATE	BY	CHKD	APPR	REVISION
1	4/9/97	RWS	GMS	DRE	CHANGE 3-2 TO 3-SECTION RTA HEAD

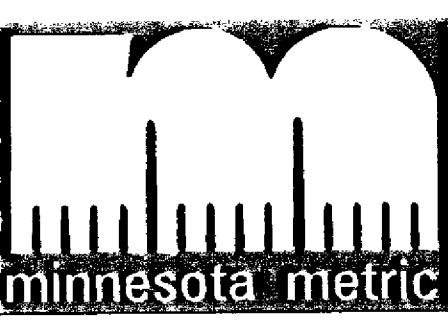

I hereby certify that this plan, specification or report was prepared by me or under my direct supervision and that I am a duly Registered Professional Engineer under the laws of the State of Minnesota.
George M. Stuenkel
 Date: 3/21/97 Reg. No. 21849


STATE AID PROJECT NO.
SAP 02-617-11
STATE PROJECT NO.
SP 0280-47

DRAWN BY
R.W. SMITH
DATE
9-96
DESIGNED BY
G. STUENKEL
9-96
CHECKED BY
P. CORKLE
9-96
COMM. NO.
0962410



ANOKA COUNTY
 INTERSECTION LAYOUT
 C.S.A.H. 17 RECONSTRUCTION
 C.S.A.H. 17 & I-35W NORTH RAMPS (SYSTEM D)

SHEET
127
OF
236

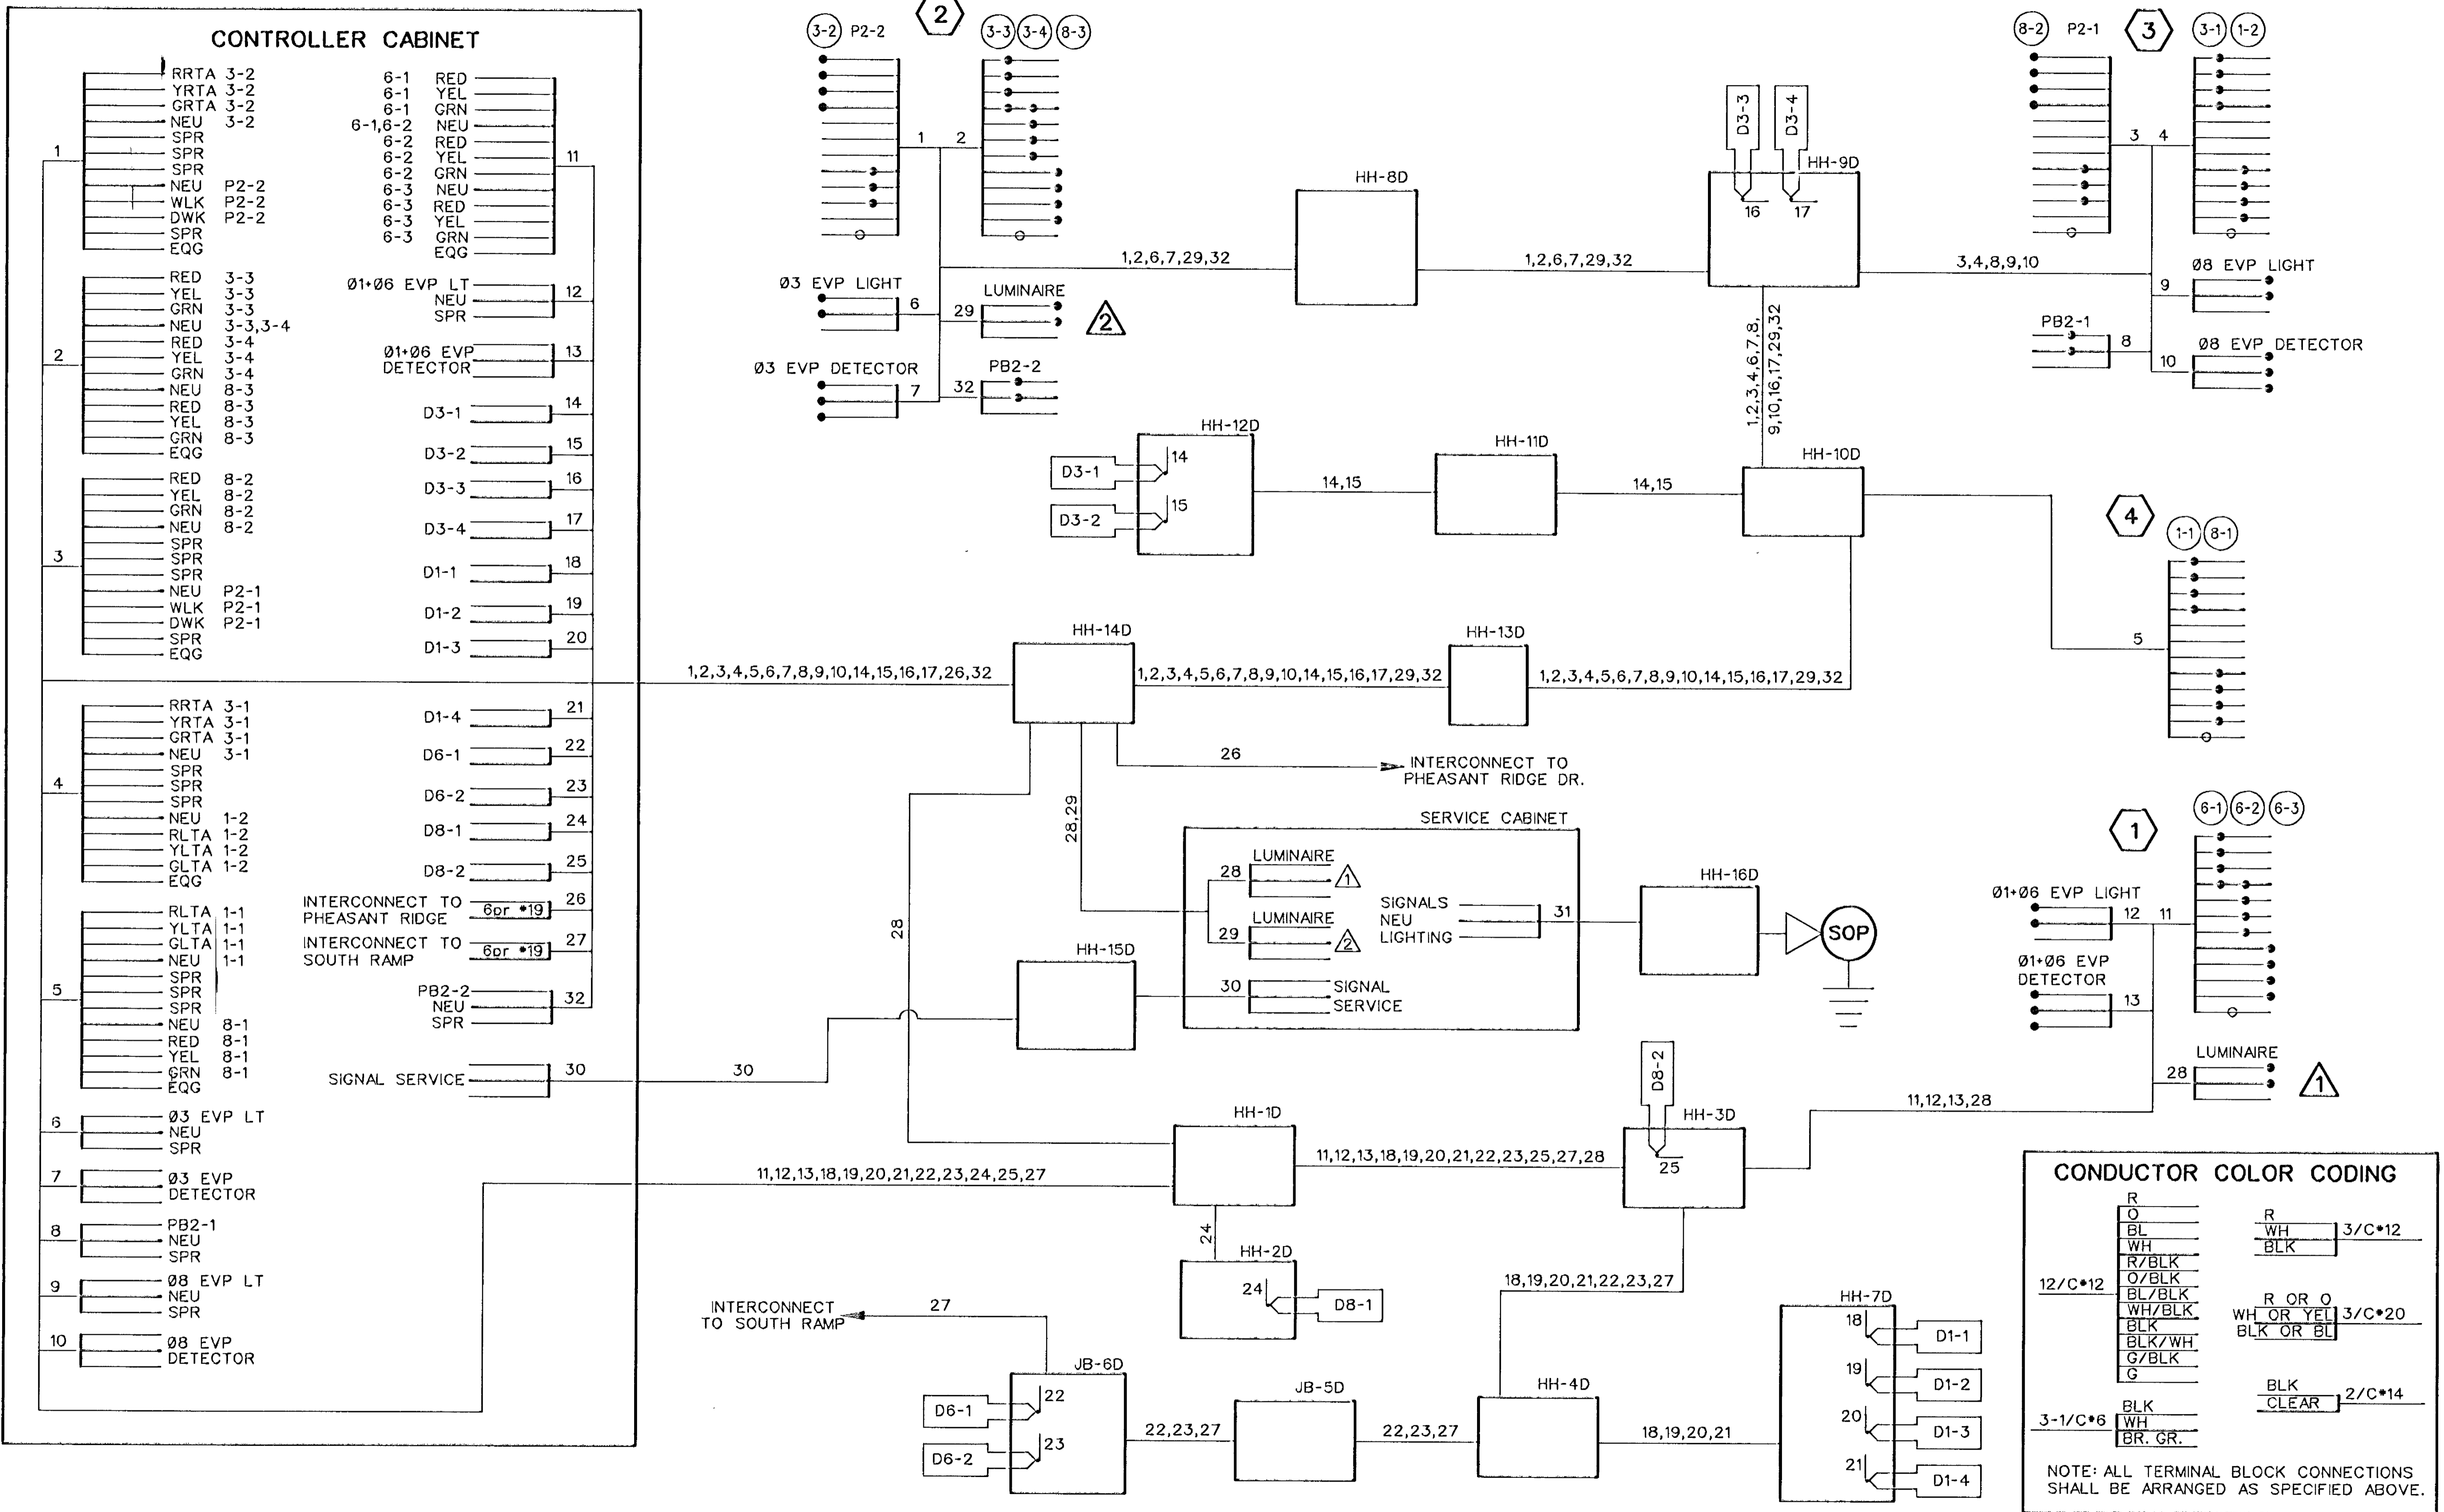

CONDUCTOR COLOR CODING

R	WH	3/C*12
O	BLK	
BL		
WH		
R/BLK		
O/BLK		
BL/BLK	R OR O	3/C*20
WH/BLK	WH OR YEL	
BLK	BLK OR BL	
BLK/WH		
G/BLK		
G		
BLK	BLK	2/C*14
3-1/C*6	CLEAR	
WH		
BR. GR.		

NOTE: ALL TERMINAL BLOCK CONNECTIONS SHALL BE ARRANGED AS SPECIFIED ABOVE.

NO	DATE	BY	CKD	APPR	REVISION
1	4/9/97	RWS	GMS	DRE	CHANGE 3-2 TO 3-SECTION RTA HEAD
NAME: D.WD DATE: Apr. 09, 1997					

minnesota metric

I hereby certify that this plan, specification or report was prepared by me or under my direct supervision and that I am a duly Registered Professional Engineer under the laws of the State of Minnesota.

George M. Stumpflig
Date 3/21/97 Reg. No. 21849

STATE AID PROJECT NO.
SAP 02-617-11

STATE PROJECT NO.
SP 0280-47

DRAWN BY M.BRESSLER DATE 9-96
DESIGNED BY G.STUEMPFFIG 9-96
CHECKED BY D.EYLER 9-96
COMM. NO. 0962410



ANOKA COUNTY
FIELD WIRING DIAGRAM
C.S.A.H. 17 RECONSTRUCTION
C.S.A.H. 17 & I-35W NORTH RAMPS (SYSTEM D)

SHEET
128
OF
236


LOOP DETECTOR CHART			DISTANCE FROM STOP LINE	NOTES
DESIGNATION	SIZE	FUNCTION		
D1-1	4-1.7m x 1.7m	(1)	-0.6,4.0,8.6,13.2m	F & I
D2-1,D2-2	1-1.7m x 1.7m	(1)	117m	INP.
D4-1,D4-2	1-1.7m x 1.7m	(3)	89m	INP.
D4-3	2-1.7m x 1.7m	(1)	-1.7,2.9m	F & I
D4-4	2-1.7m x 1.7m	(7)	-1.7,2.9m	F & I
D4-5	1-1.7m x 1.7m	(7)	-2.9m	F & I
D5-1	4-1.7m x 1.7m	(1)	1.4,6.0,10.6,15.2m	INP.
D6-1,D6-2	1-1.7m x 1.7m	(1)	92m	F & I

FUNCTIONS:

- (1) - CALL AND EXTEND
- (3) - EXTEND ONLY
- (7) - IMMEDIATE EXTEND, DELAY CALL



REMOVE & SALVAGE P100 POLE FOUNDATION
2 - STEEL GUARD POSTS
D9.1m-2.7m (DAVIT AT 355°)
2 - ONE WAY SIGNALS (OVERHEAD)
(0m AND 3.6m FROM END OF MAST ARM)
TYPE 10C AT 270°
LUMINAIRE - 250 WATT H.P.S.
2 - PEDESTRIAN PUSH BUTTONS & SIGNS
PA100 POLE FOUNDATION
PA100-A15.2m
1 - ONE WAY SIGNAL (OVERHEAD)
(7.2m FROM END OF MAST ARM)
ONEWAY EVP DETECTOR AND LIGHT
(1.8m FROM END OF MAST ARM), 19mm HUB
EXTEND INTO HH 20

MATCH LINE "J"
(SEE SHEET 132)

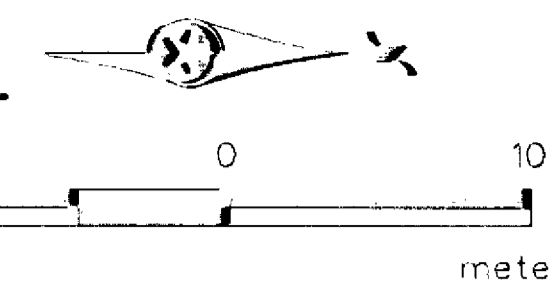

NOTES:

- 1) SEE SPECIAL PROVISIONS FOR EXPLANATION OF WORK.
- 2) THE CONTRACTOR SHALL FURNISH AND INSTALL A NEW TYPE D SIGN ON MAST ARM POLE 2, WHICH SHALL BE CONSIDERED INCIDENTAL WORK.
- 3) SEE SPECIAL PROVISIONS FOR HANDHOLE TYPE.
- 4) SEE SPECIAL PROVISIONS FOR CONTRACTORS RESPONSIBILITY FOR LOCATION OF UTILITIES.
- 5) EACH SIGNAL FACE HAS A BACKGROUND SHIELD.
- 6) ALL EXISTING PEDESTRIAN INDICATIONS SHALL BE REUSED.
- 7) THE SIGNAL FACES ARE 300mm - 3 SECTION R-Y-G, EXCEPT (1-1) (1-2) (5-1) (5-2) WHICH ARE 300mm - 3 SECTION RLTA, YLTA AND GLTA.
- 8) REMOVE AND SALVAGE EXISTING CONTROLLER AND CABINET. INSTALL COUNTY FURNISHED CONTROLLER AND CABINET ON EXISTING EQUIPMENT PAD.
- 9) REMOVE AND REPLACE EXISTING CONCRETE STEP IN FRONT OF EQUIPMENT PAD AS DIRECTED BY THE ENGINEER.
- 10) REMOVE AND SALVAGE EXISTING SERVICE CABINET. FURNISH AND INSTALL NEW SERVICE CABINET ON EXISTING FOUNDATION.

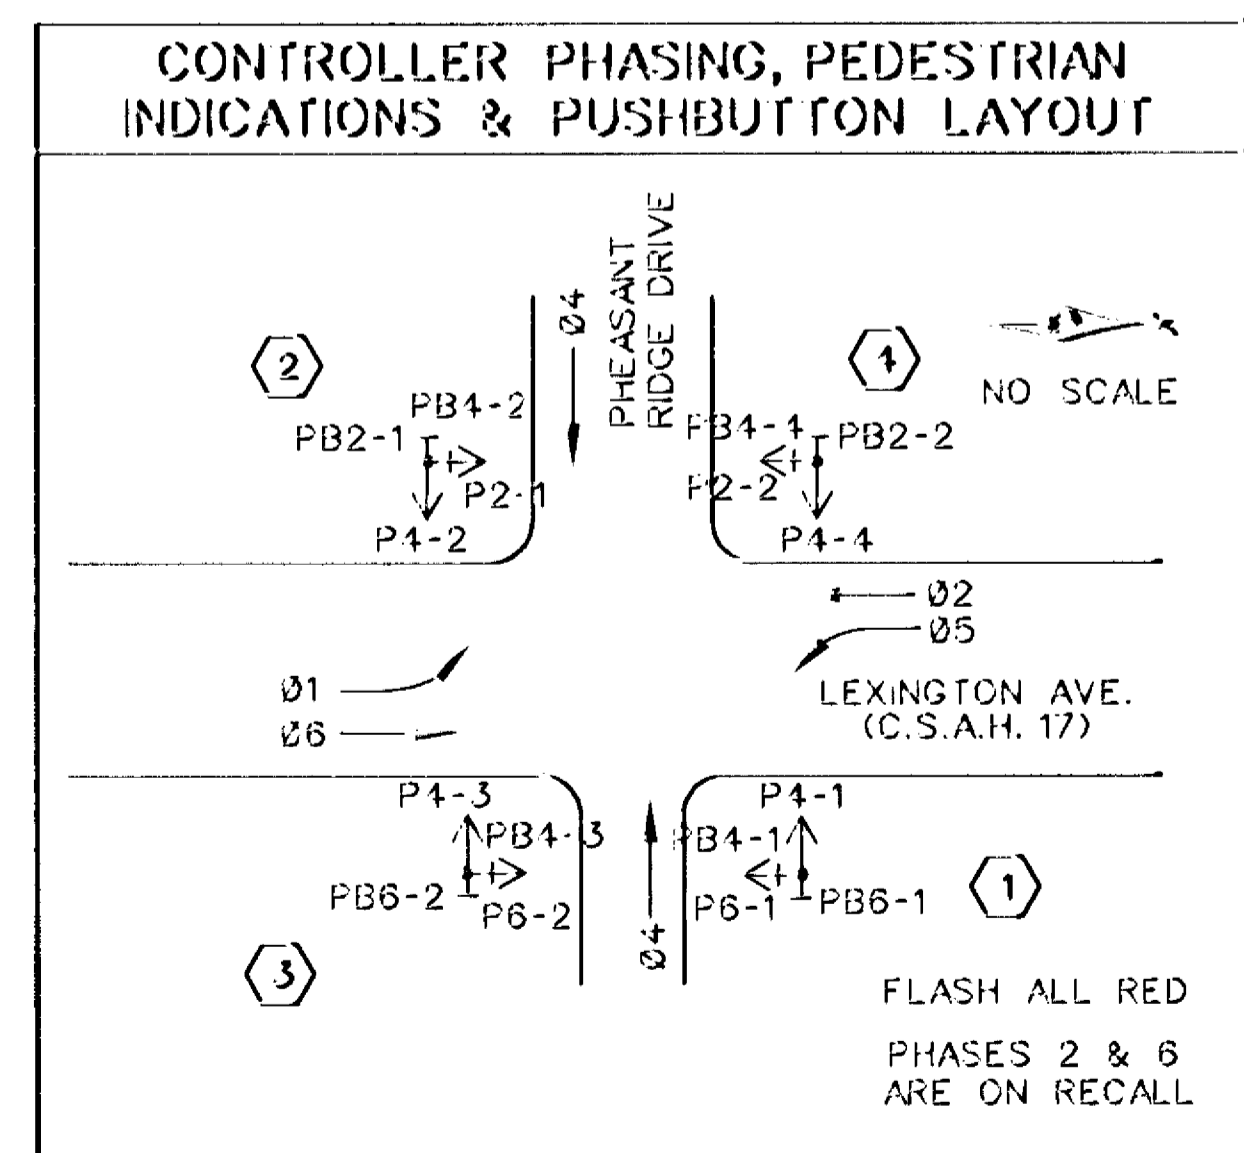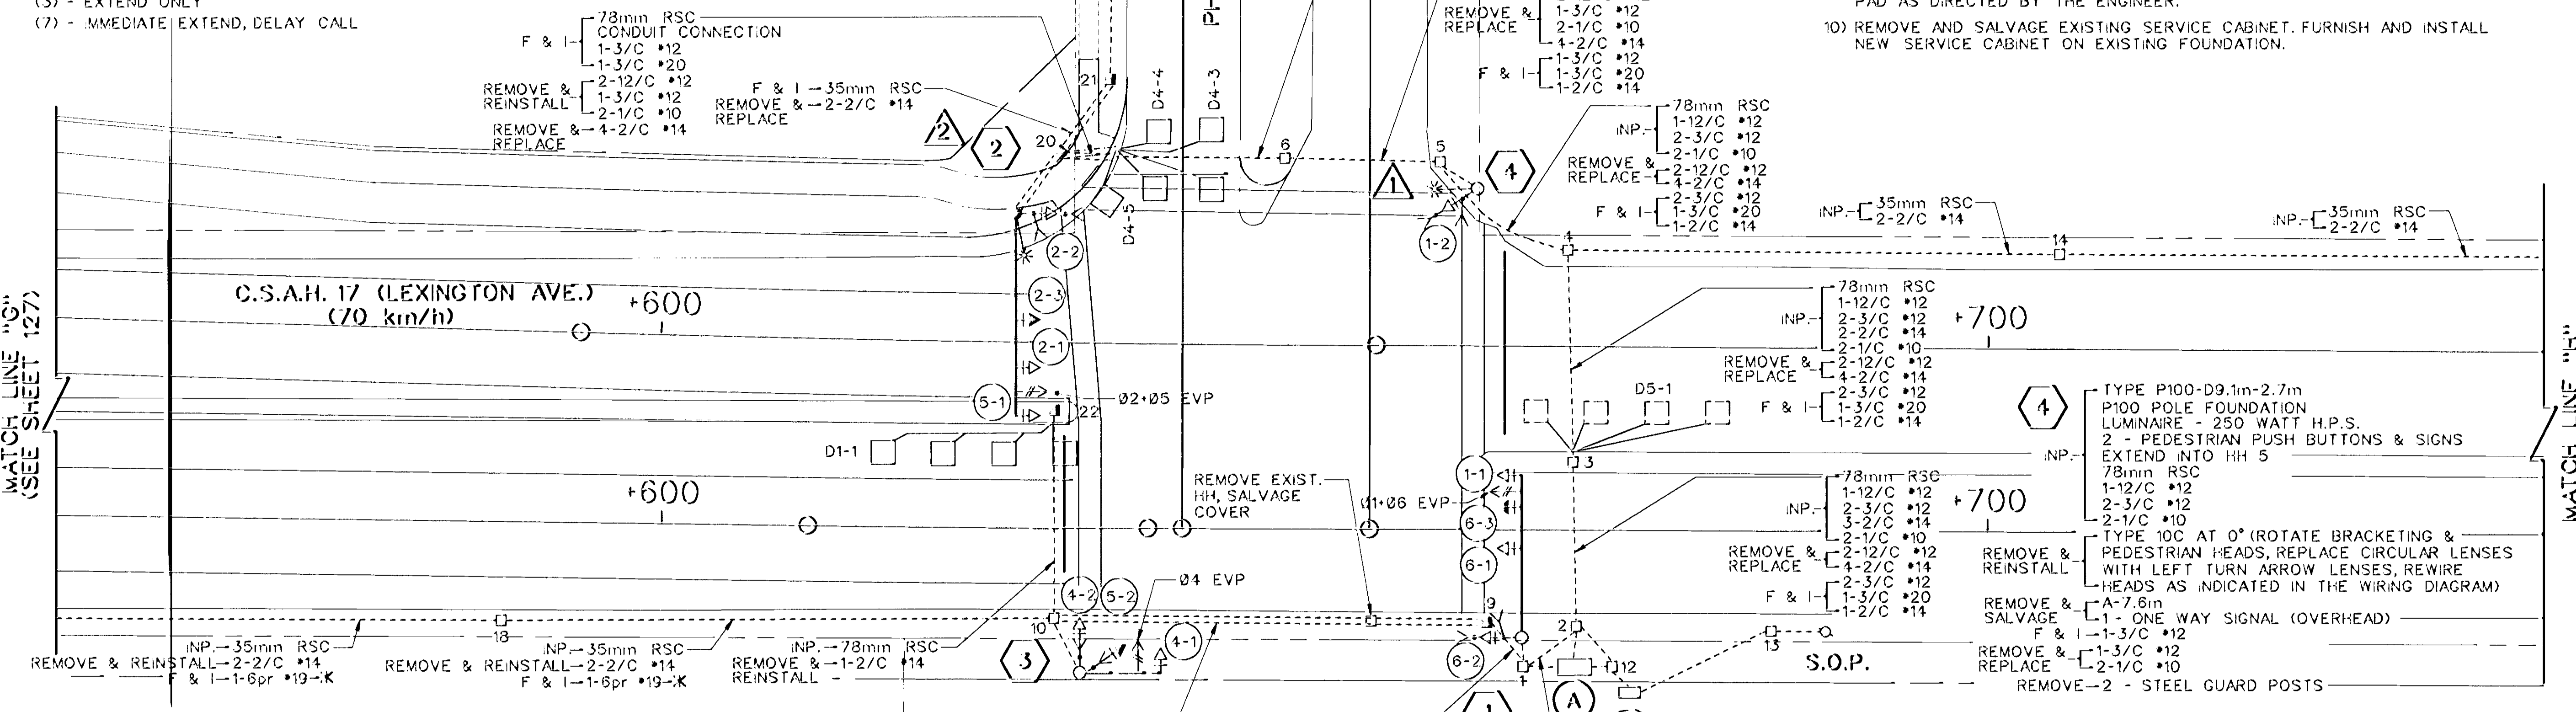

REMOVE & SALVAGE P100-A7.6m
P100 POLE FOUNDATION
1 - ONE WAY SIGNAL (OVERHEAD)
TYPE 10B AT 270°
(REMOVE 1 - PED. HEAD FROM EXISTING TYPE 10C)
2 - PEDESTRIAN PUSH BUTTONS & SIGNS
EXTEND INTO HH 1
78mm RSC
1-12/C *12
2-3/C *12

REMOVE & SALVAGE A-12.2m
2 - ONE WAY SIGNALS (OVERHEAD)
(0m, 5.5m FROM END OF MAST ARM)
TYPE P100
P100 POLE FOUNDATION
TYPE 10C MOUNTED AT 270°
2 - PEDESTRIAN PUSH BUTTONS & SIGNS
EXTEND INTO HH 1
78mm RSC
1-12/C *12
2-3/C *12

REMOVE & SALVAGE A-12.2m
1 - ONE WAY SIGNAL (OVERHEAD)
(2.4m FROM END OF MAST ARM)
ONE WAY EVP DETECTOR & LIGHT
(1.2m FROM END OF MAST ARM), 19mm HUB
1-3/C *12
1-3/C *20
1-3/C *20


REMOVE & SALVAGE 2 - STEEL GUARD POSTS
REMOVE & SALVAGE SERVICE CABINET
SERVICE CABINET FOUNDATION
SERVICE CABINET TO HH 13 (SERVICE)
35mm RSC
3-1/C *4
1-1/C *6 BR.GR.
SERVICE CABINET TO HH 12 (SIGNAL & LIGHTING)
35mm RSC
2-1/C *6
1-1/C *6 BR.GR.
2-1/C *10
1-1/C *6 BR.GR.

NO.	DATE	BY	CHKD	APPR	REVISION
1	3-27-97	MAB	GMS	DRE	ADJUST CROSSWALK LOCATIONS

I hereby certify that this plan, specification or report was prepared by me or under my direct supervision and that I am a duly Registered Professional Engineer under the laws of the State of Minnesota.
George W. Stumpf
Date 3/21/97 Reg. No. 21849


STATE AID PROJECT NO. SAP 02-617-11

DRAWN BY M.BRESSLER DATE 9-96
DESIGNED BY P.CORKLE DATE 9-96
CHECKED BY G.STUEMPF DATE 9-96
CCMM NO. 0962410

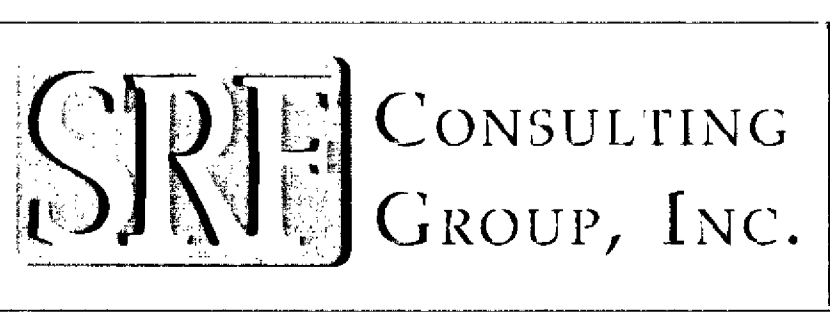

ANOKA COUNTY
REVISED INTERSECTION LAYOUT
C.S.A.H. 17 RECONSTRUCTION
C.S.A.H. 17 & PHEASANT RIDGE DR. (SYSTEM E)

SHEET 129 OF 236

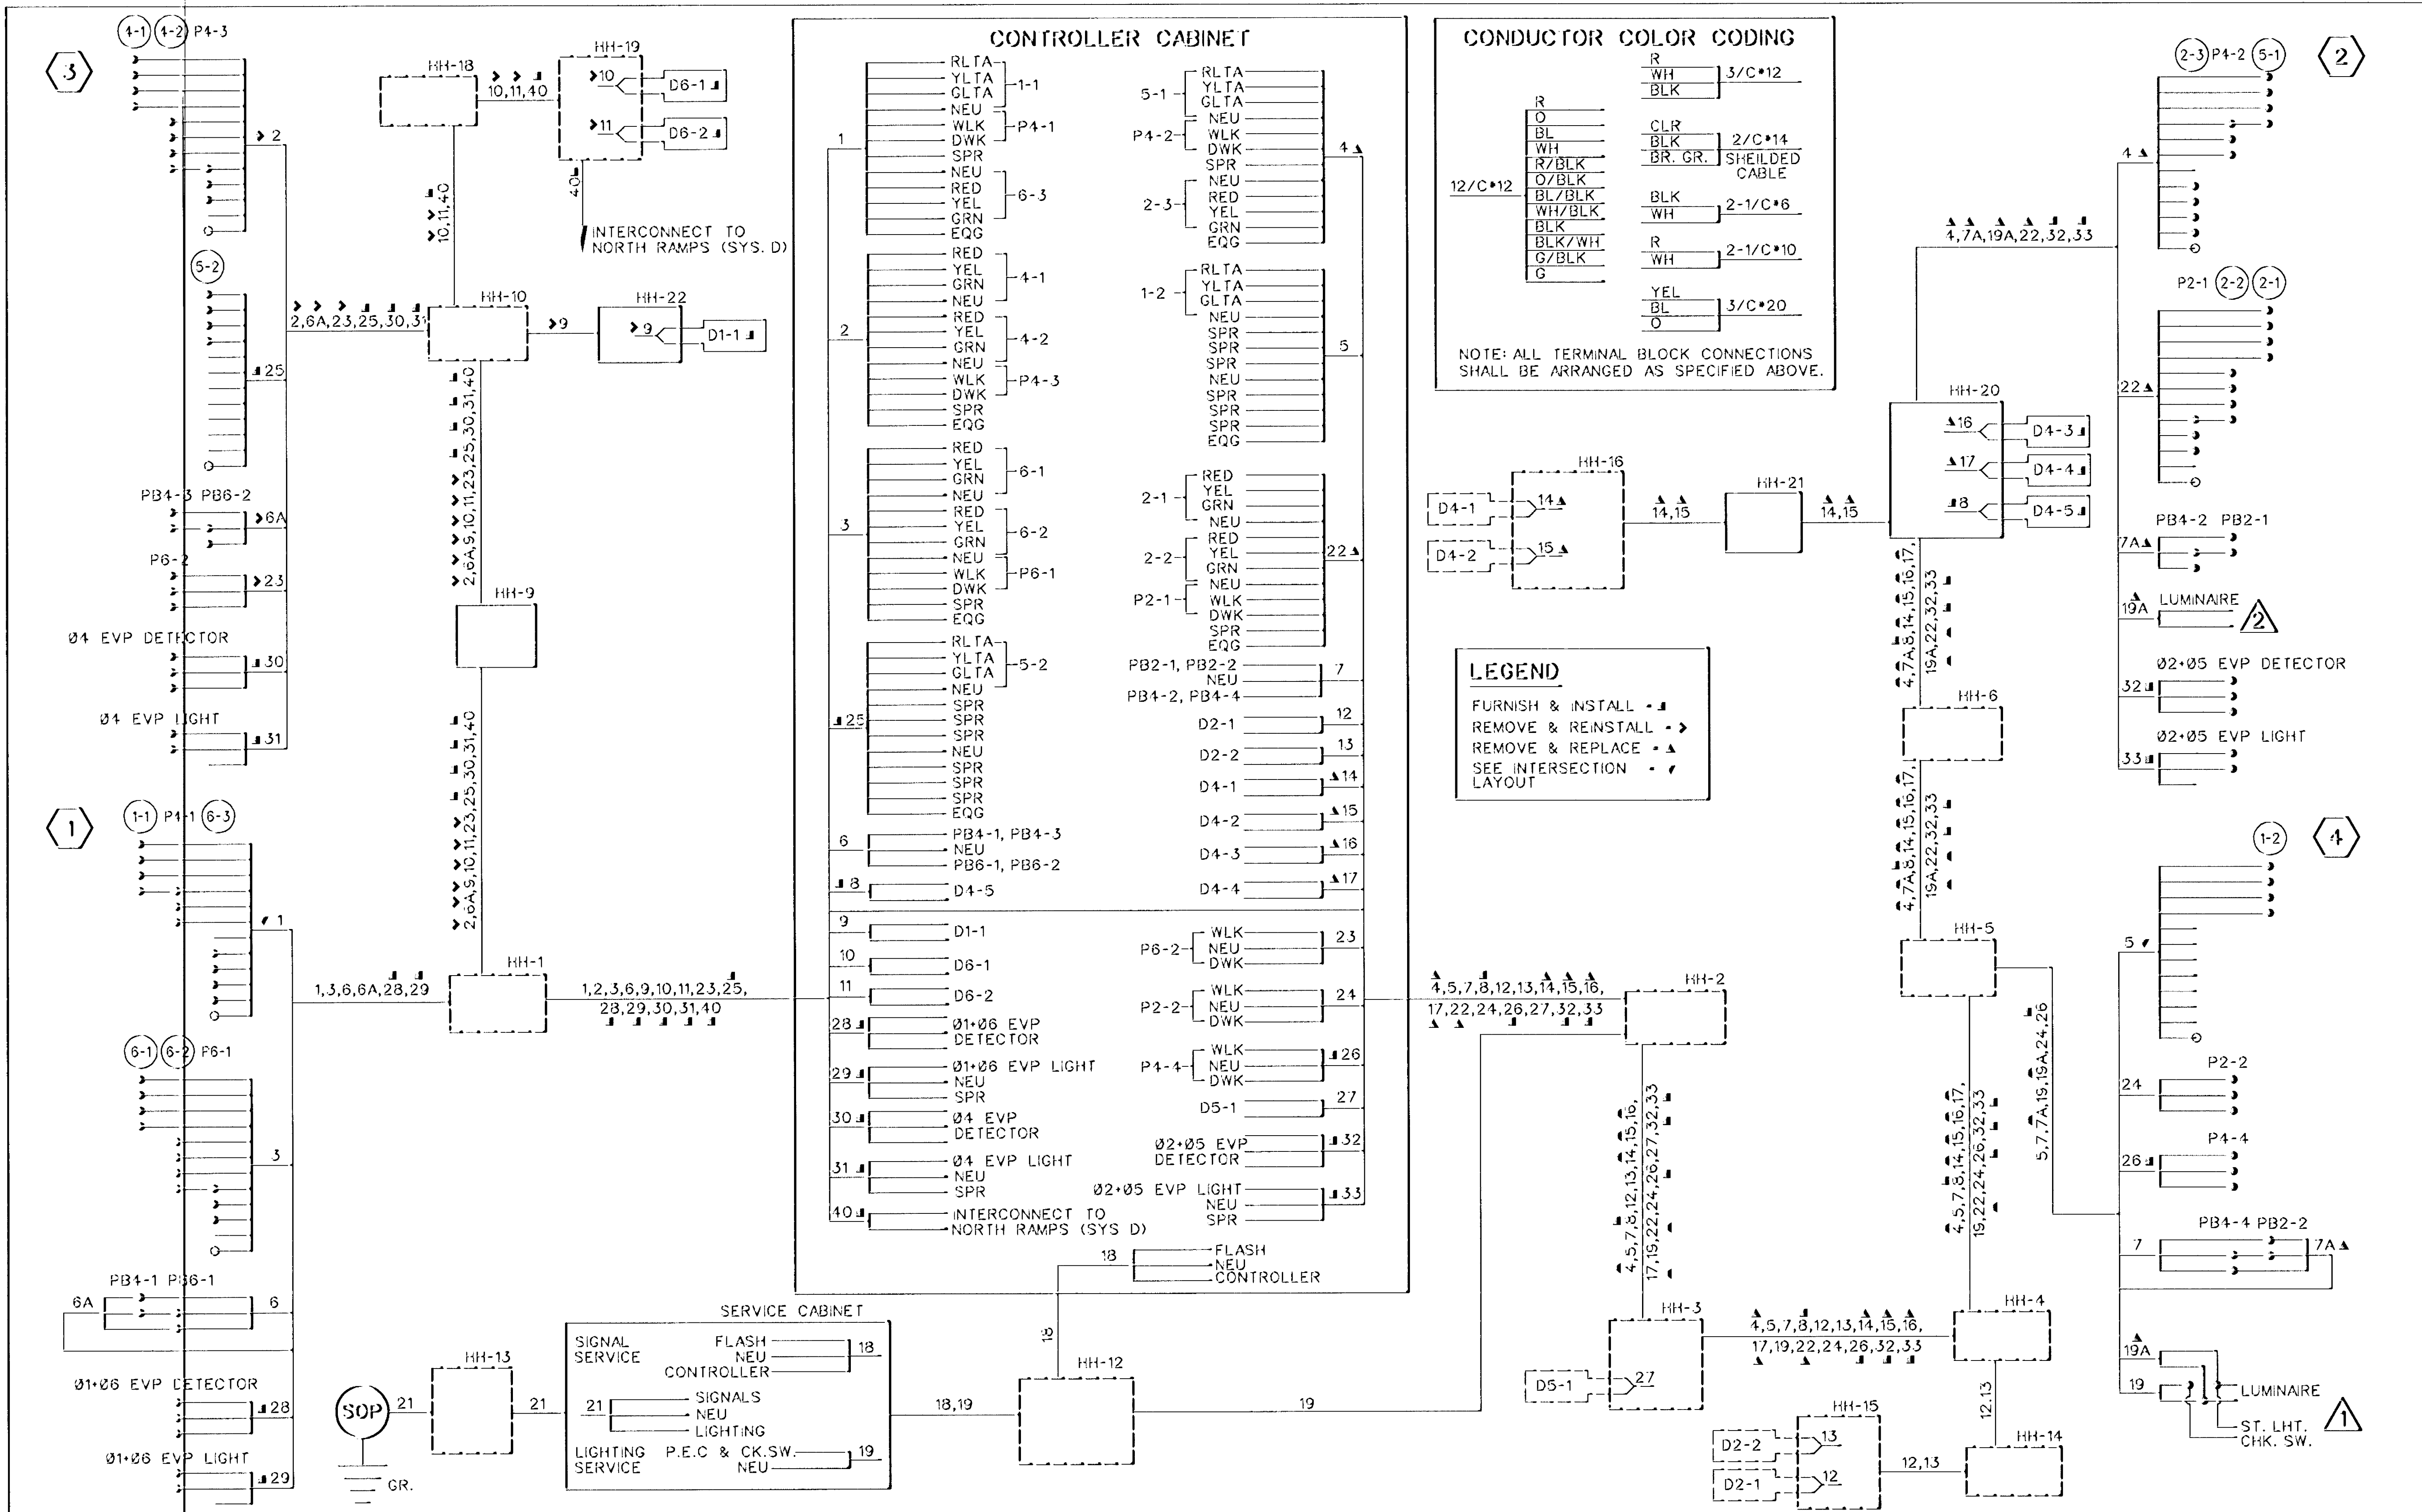

NO.	DATE	BY	CD	APPR	REVISION

NAME: E. WD DATE: Mar. 20, 1997

minnesota electric

I hereby certify that this plan, specification or report was prepared by me or under my direct supervision and that I am a duly Registered Professional Engineer under the laws of the State of Minnesota.

George M. Stuenkel
Date: 3/21/97 Reg. No. 21849


STATE AID PROJECT NO. SAP 02-617-11

DRAWN BY M. BRESSLER DATE 9-96
DESIGNED BY P. CORKLE 9-96
CHECKED BY D. EYLER 9-96
COMM. NO. 0962410


SRI CONSULTING GROUP, INC.

ANOKA COUNTY
REVISED FIELD WIRING DIAGRAM
C.S.A.H. 17 RECONSTRUCTION
C.S.A.H. 17 & PHEASANT RIDGE DR. (SYSTEM E)

SHEET 130 OF 236

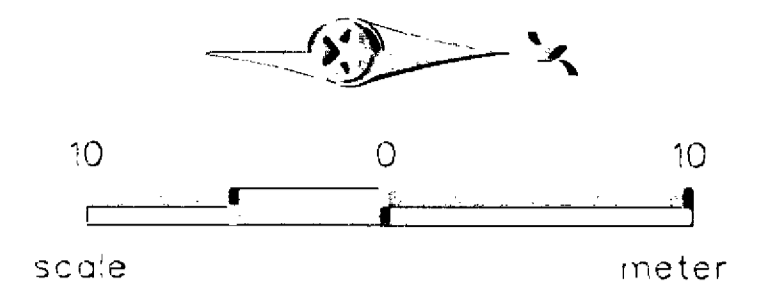

SYSTEM BOUNDARY
 SYS. "A" |> SYS. "B"

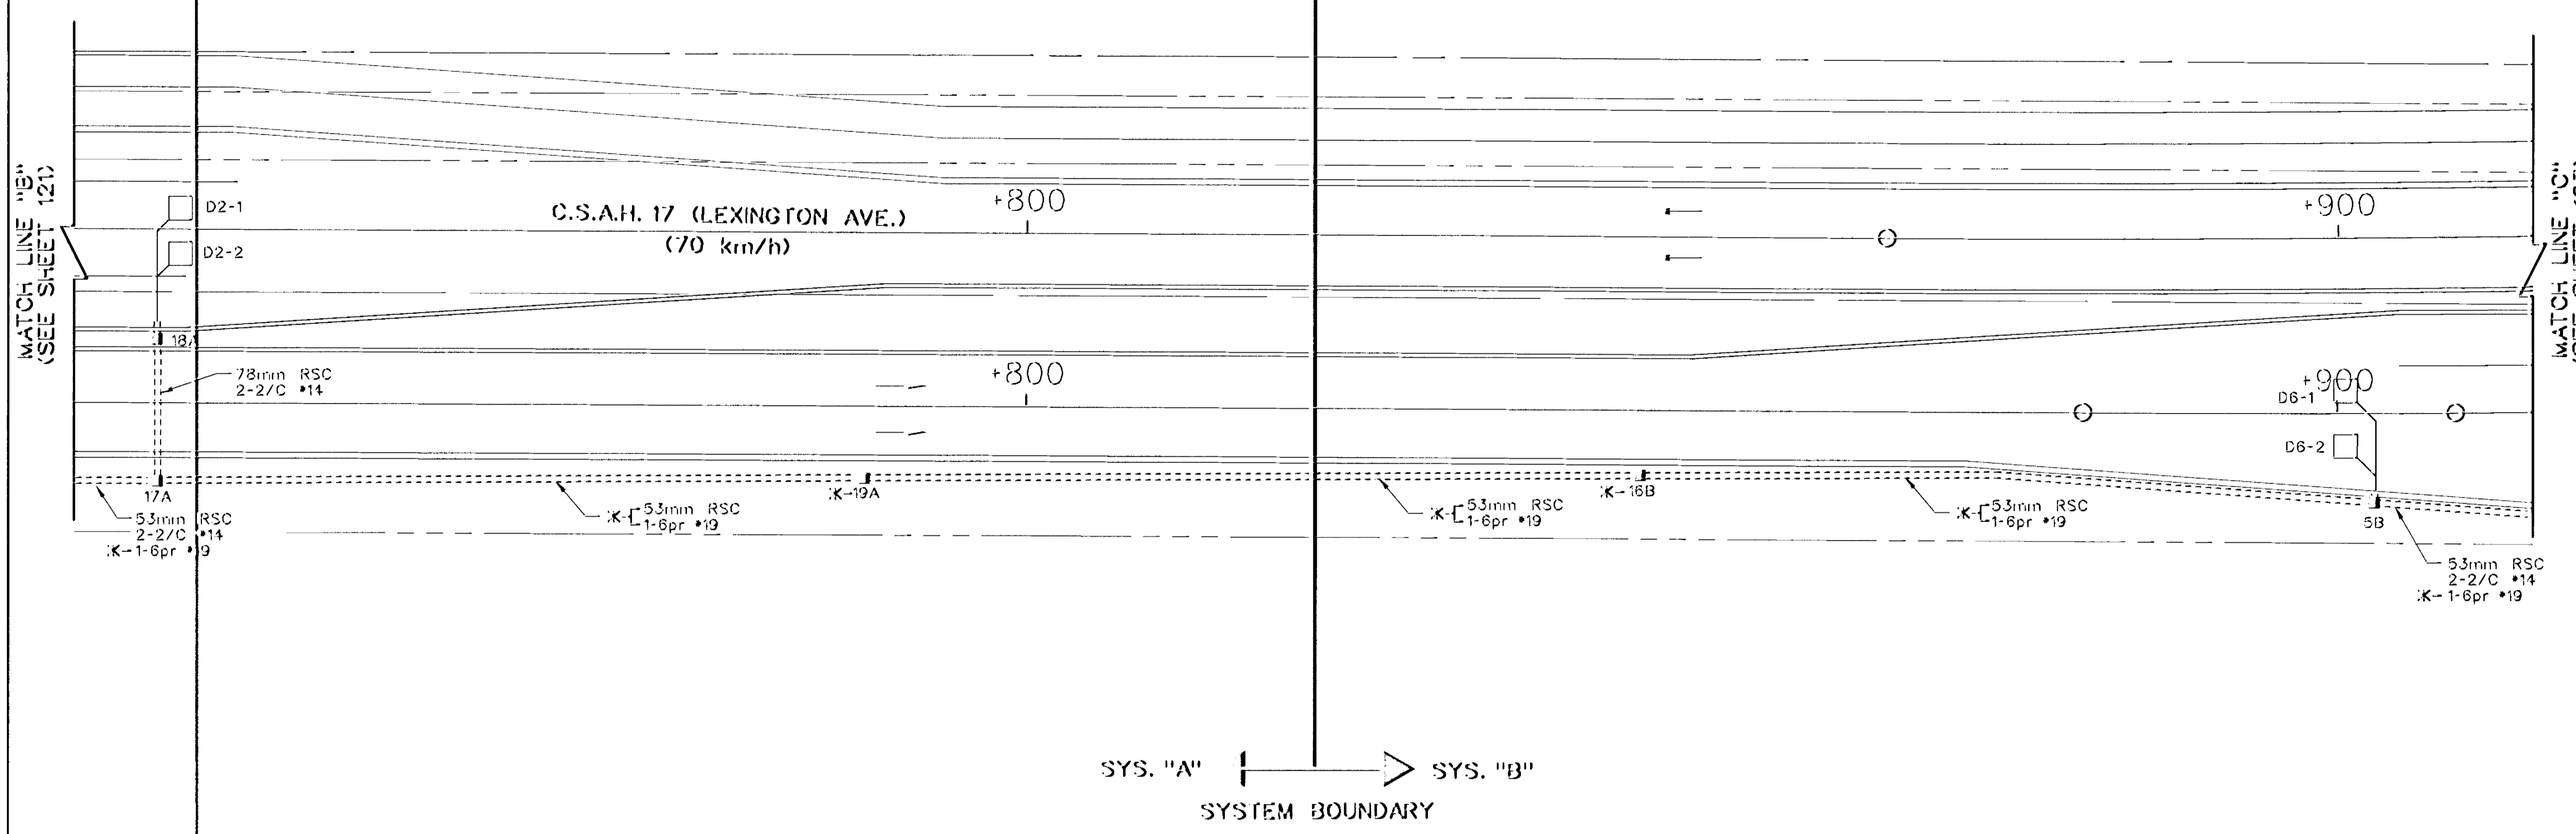

SYSTEM BOUNDARY
 SYS. "A" |> SYS. "B"

MATCH LINE "B"
 (SEE SHEET 121)

MATCH LINE "C"
 (SEE SHEET 123)

.K- DESIGNATES ITEMS TO BE INCLUDED IN THE INTERCONNECT SYSTEM PAY ITEM

NO	DATE	BY	CD	APPR	REVISION


NAME: MATCH.LIN DATE: Dec. 18, 1996

I hereby certify that this plan, specification or report was prepared by me or under my direct supervision and that I am a duly Registered Professional Engineer under the laws of the State of Minnesota.

George M. Stuenkel
 Date: 3/2/97 Reg. No. 21849



STATE AID PROJECT NO.
 SAP 02-617-11

DRAWN BY: R.W. SMITH DATE: 9-96
 DESIGNED BY: P. CORKLE DATE: 9-96
 CHECKED BY: G. STUENKEL DATE: 9-96
 COMM. NO.: 0962410



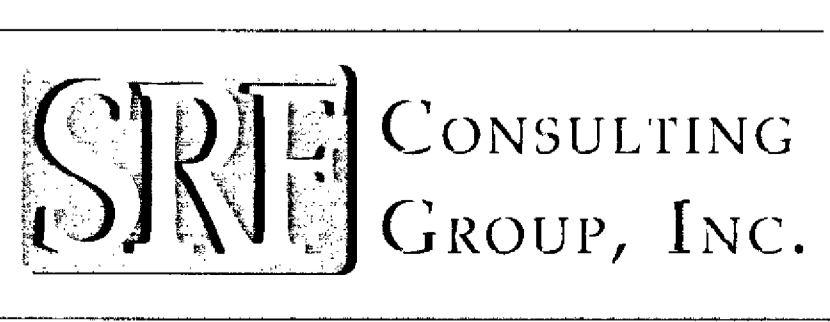


ANOKA COUNTY
 MATCH LINE LAYOUT
 C.S.A.H. 17 RECONSTRUCTION
 C.S.A.H. 17 (SYSTEMS A AND B)

SHEET
 131
 OF
 236

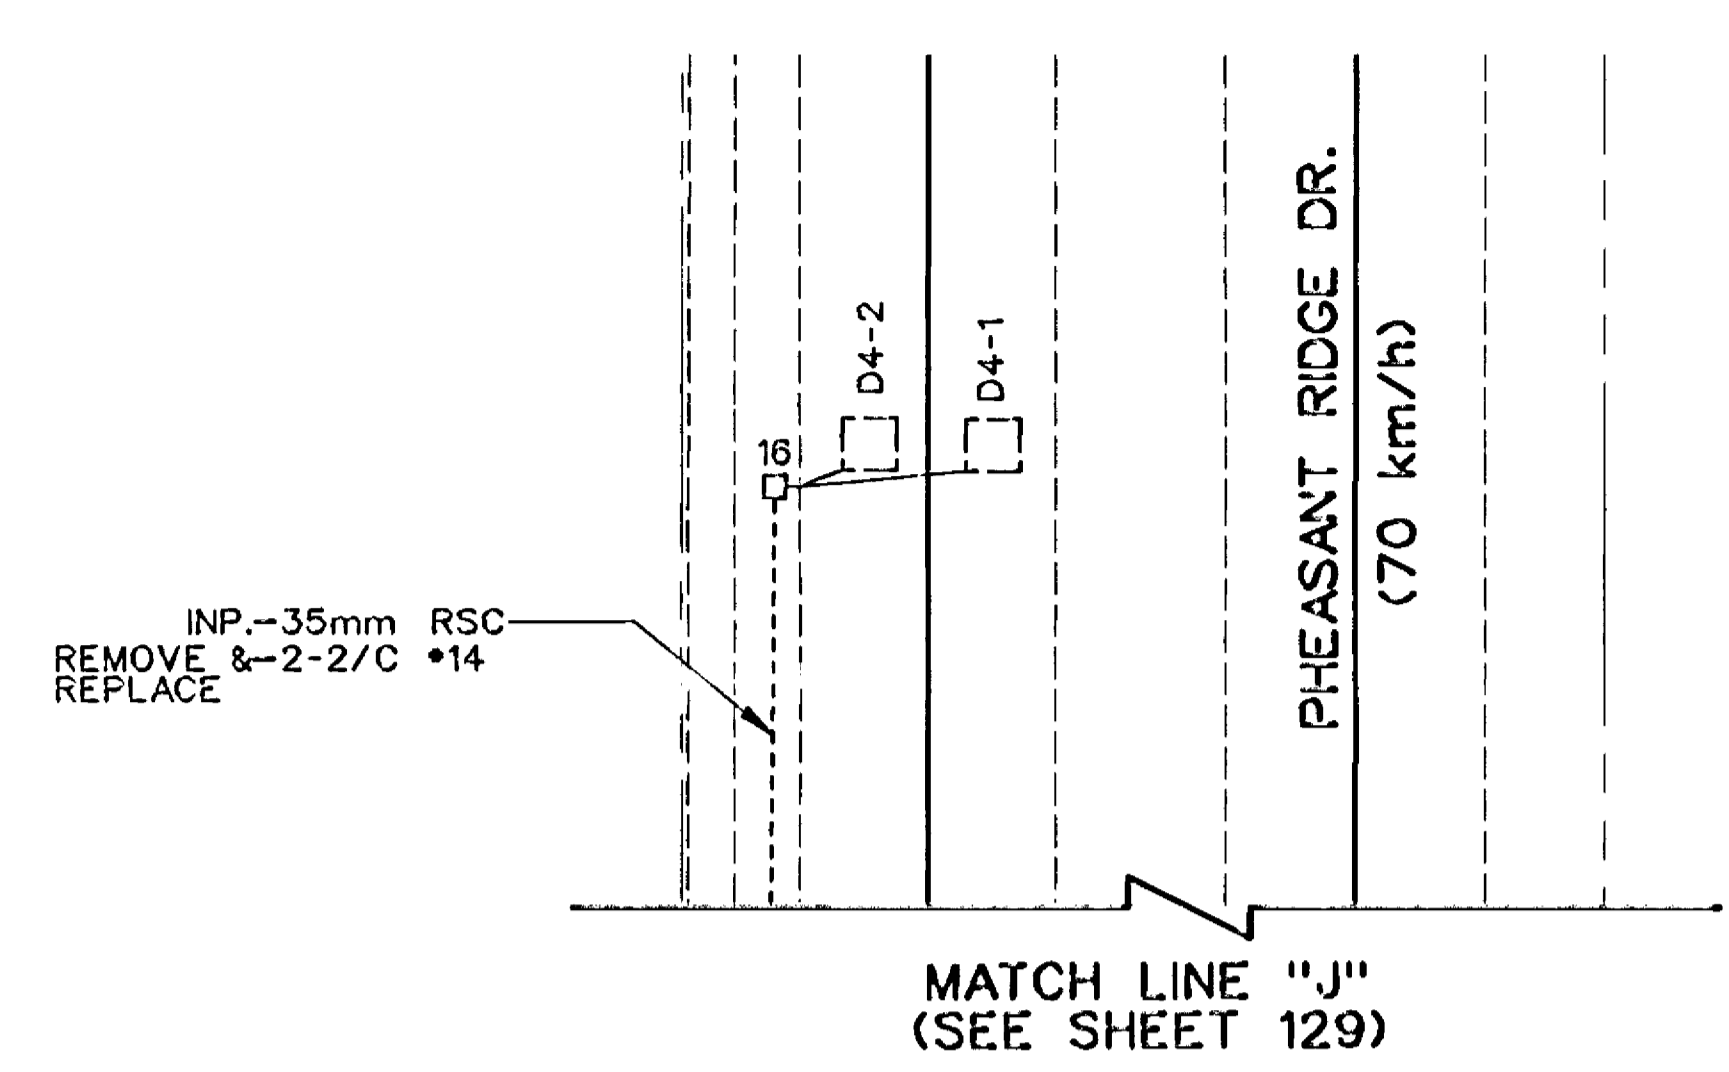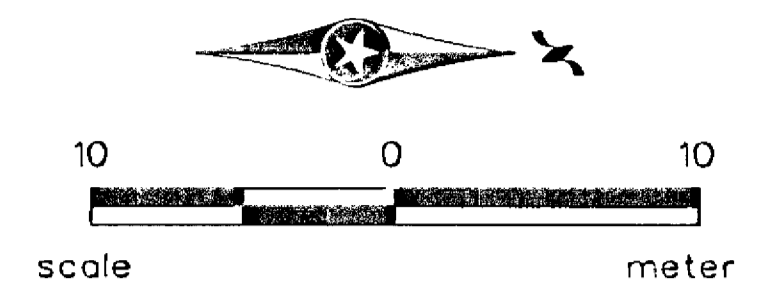


NOTE:
CONDUIT AND JUNCTION BOXES ON BRIDGE TO BE INCLUDED IN BRIDGE PAY ITEMS.

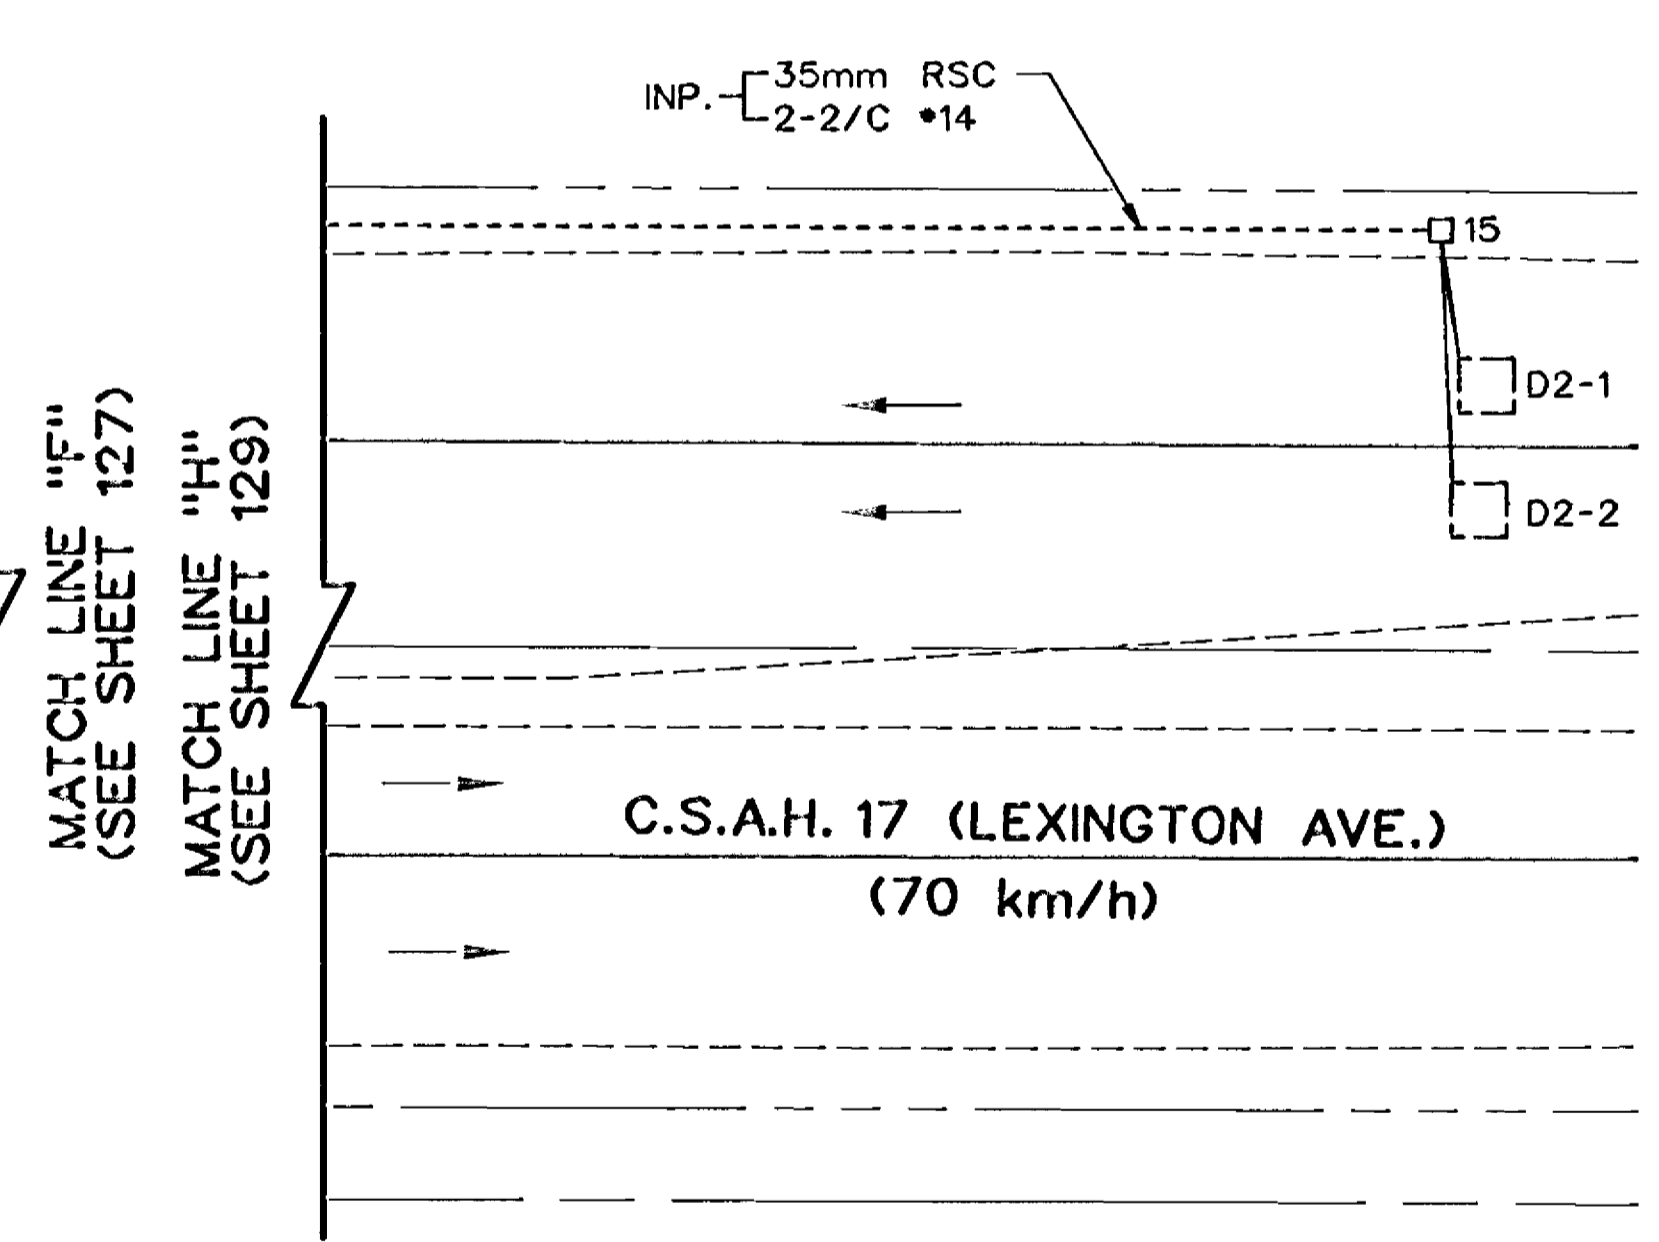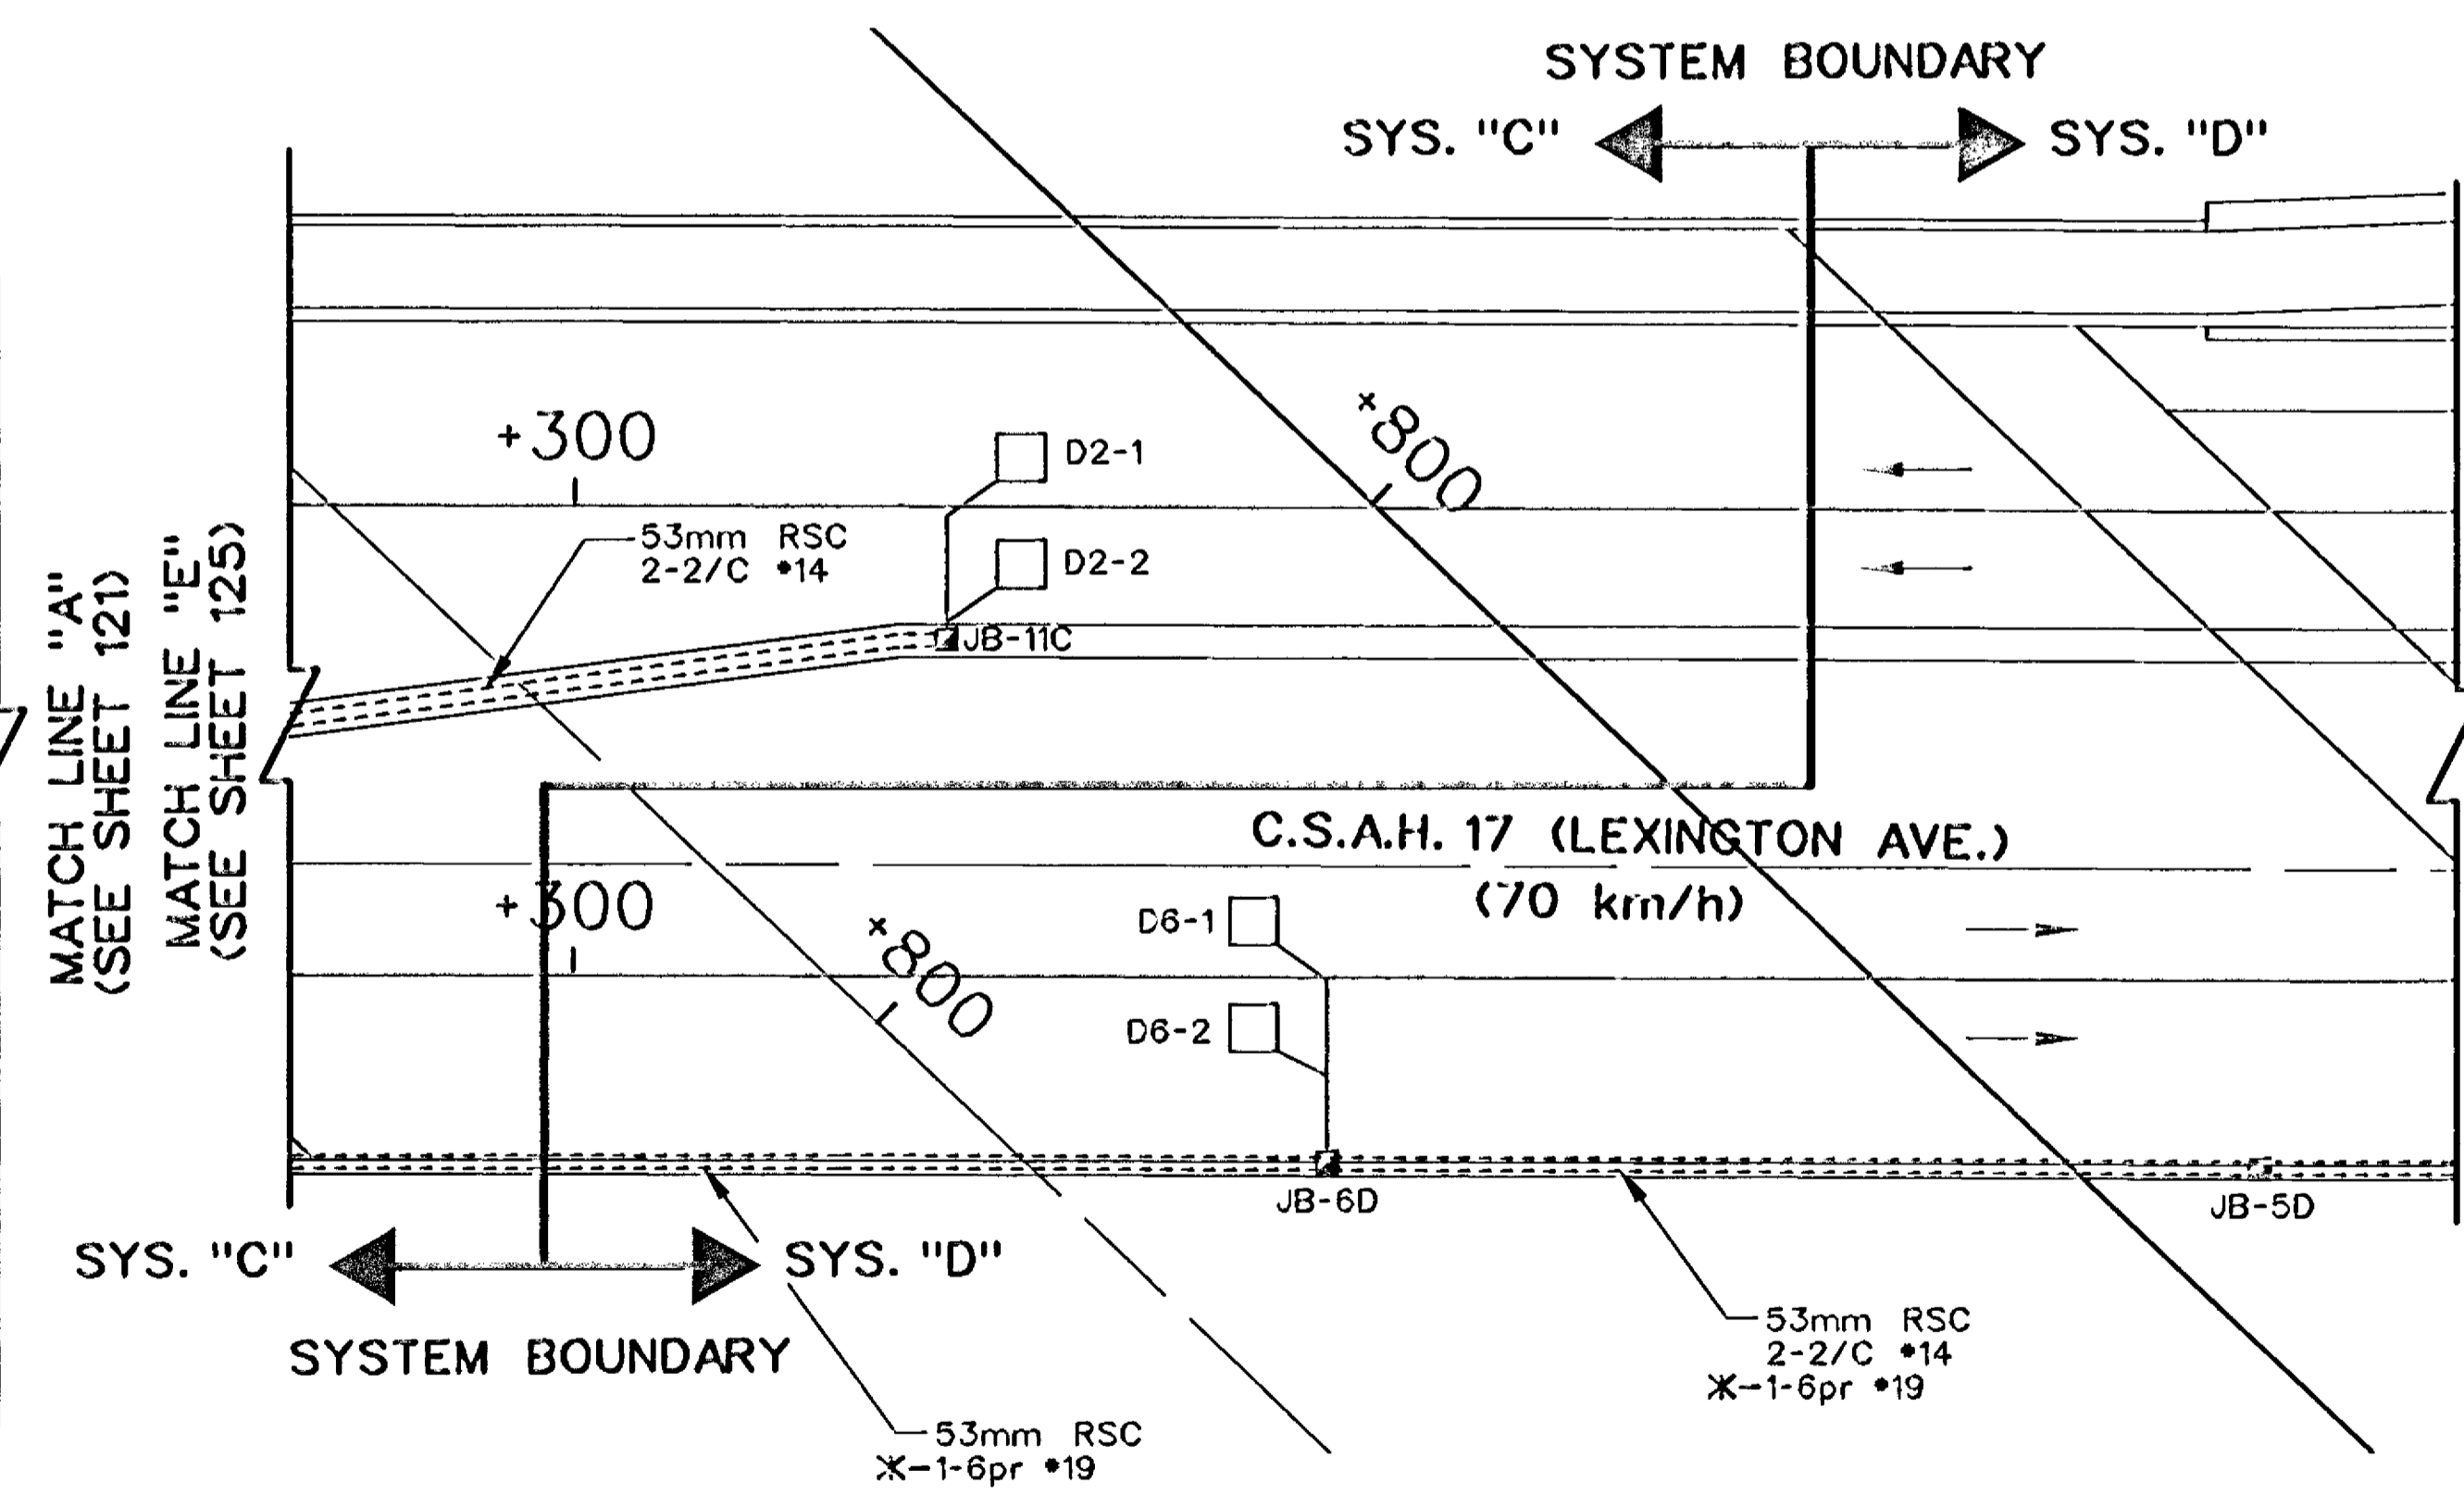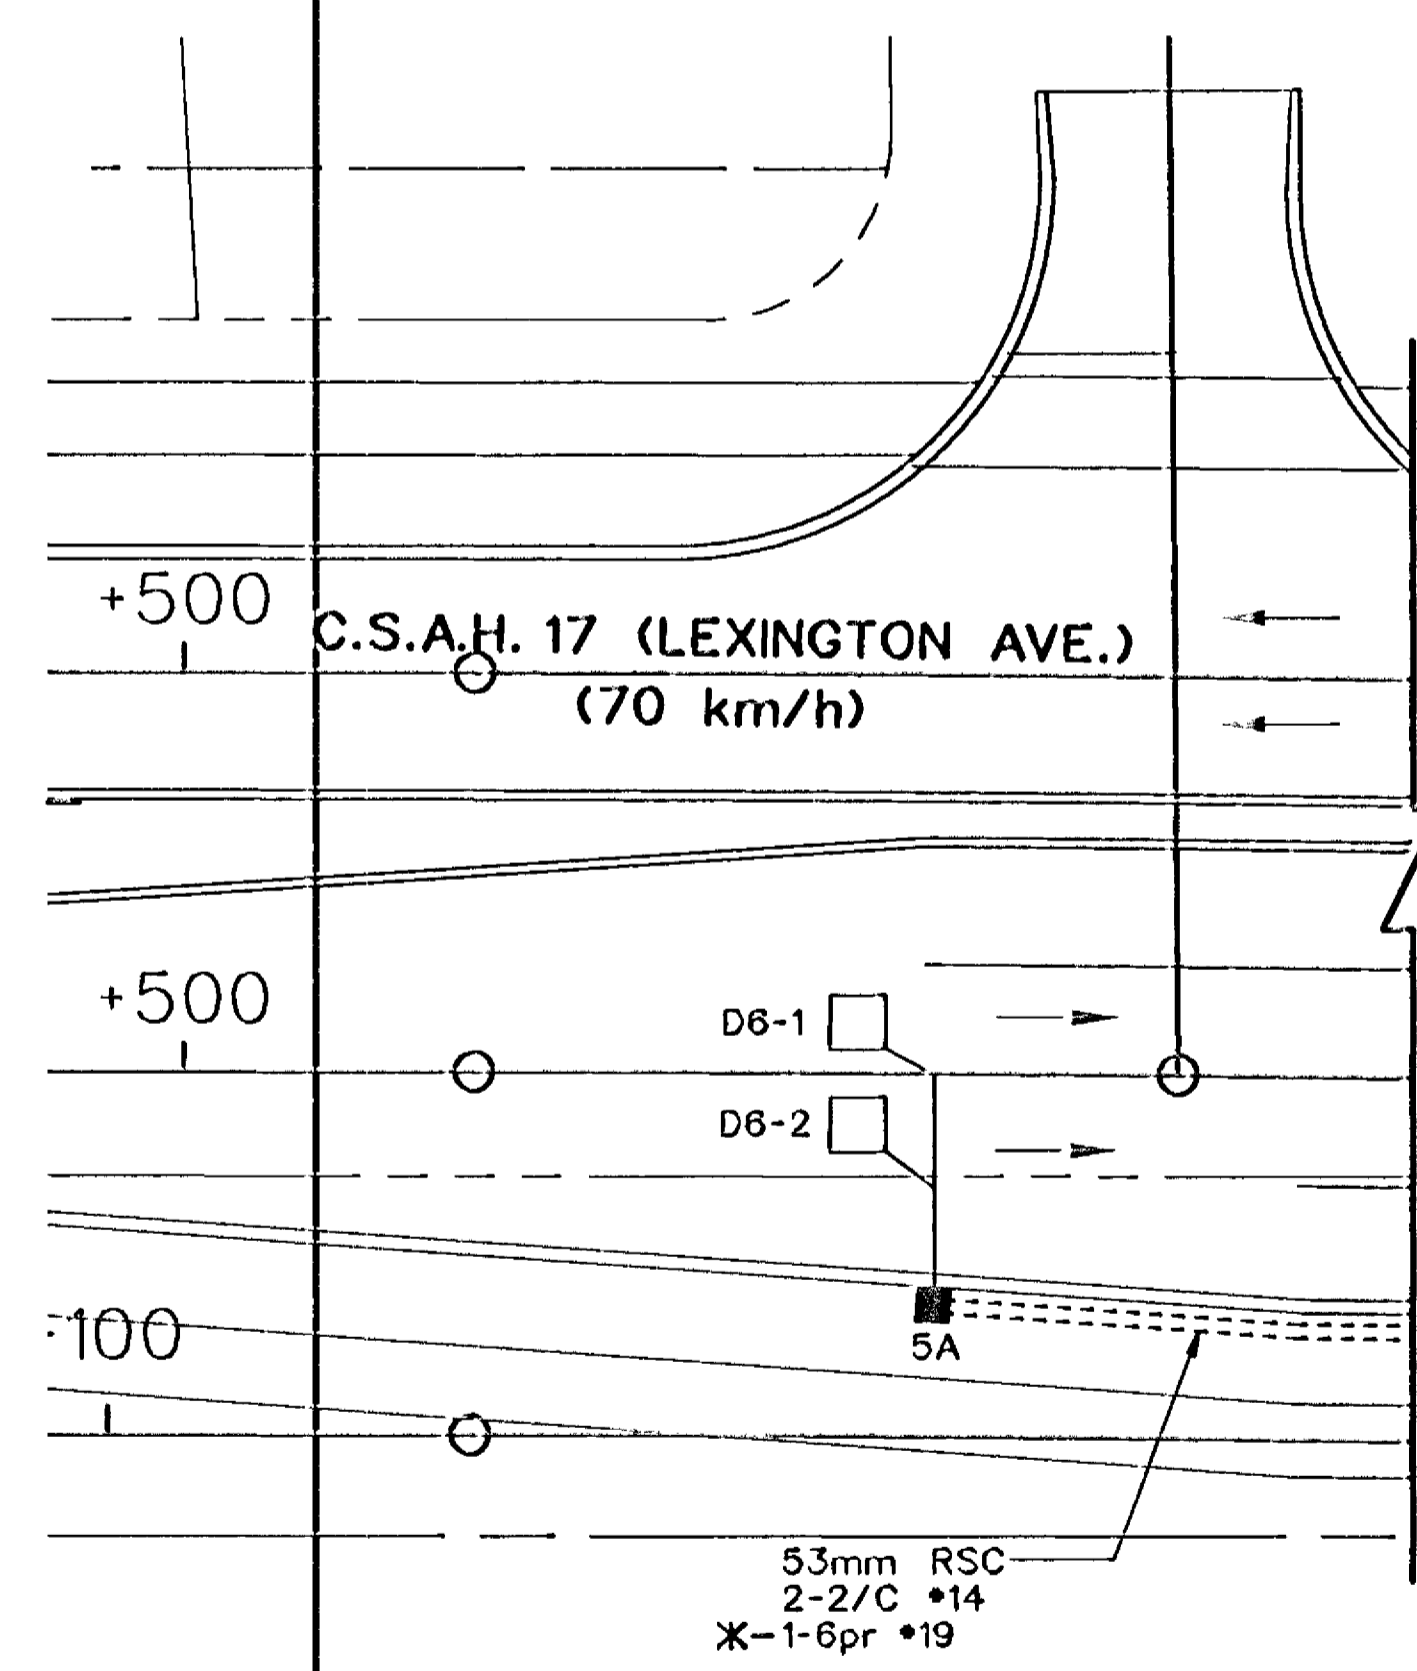

*-DESIGNATES ITEMS TO BE INCLUDED IN THE INTERCONNECT SYSTEM PAY ITEM

NO	DATE	BY	CHKD	APPR	REVISION


NAME: MATCH2.INT DATE: Mar. 19, 1997

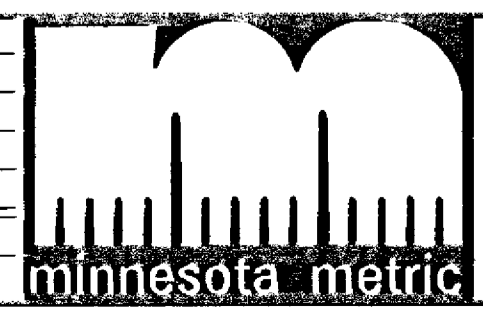

I hereby certify that this plan, specification or report was prepared by me or under my direct supervision and that I am a duly Registered Professional Engineer under the laws of the State of Minnesota.
George M. Stuempfig
Date: 3/21/97 Reg. No. 21249


STATE AID PROJECT NO. SAP 02-617-11
STATE PROJECT NO. SP 0280-47

DRAWN BY R.W. SMITH DATE 9-96
DESIGNED BY P. CORKLE DATE 9-96
CHECKED BY G. STUEMPFIG DATE 9-96
COMM. NO. 0982410

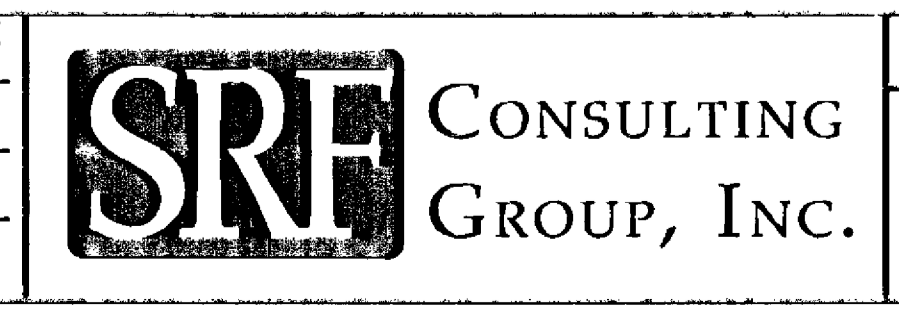


ANOKA COUNTY
MATCH LINE LAYOUT
C.S.A.H. 17 RECONSTRUCTION
C.S.A.H. 17 (SYSTEMS A,C,D AND E)


SHEET 132 OF 236

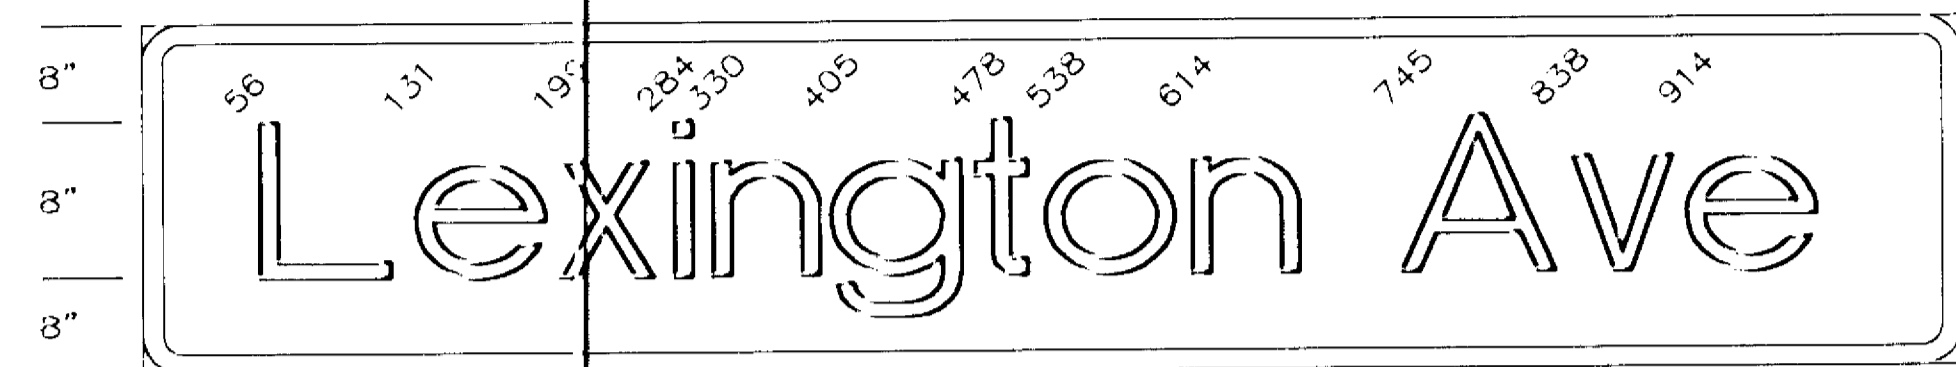


D-1 102" X 24", 3.0 R. 1.0 B.
LINE 1 = 90.83" : 8"-6" "E" MOD.

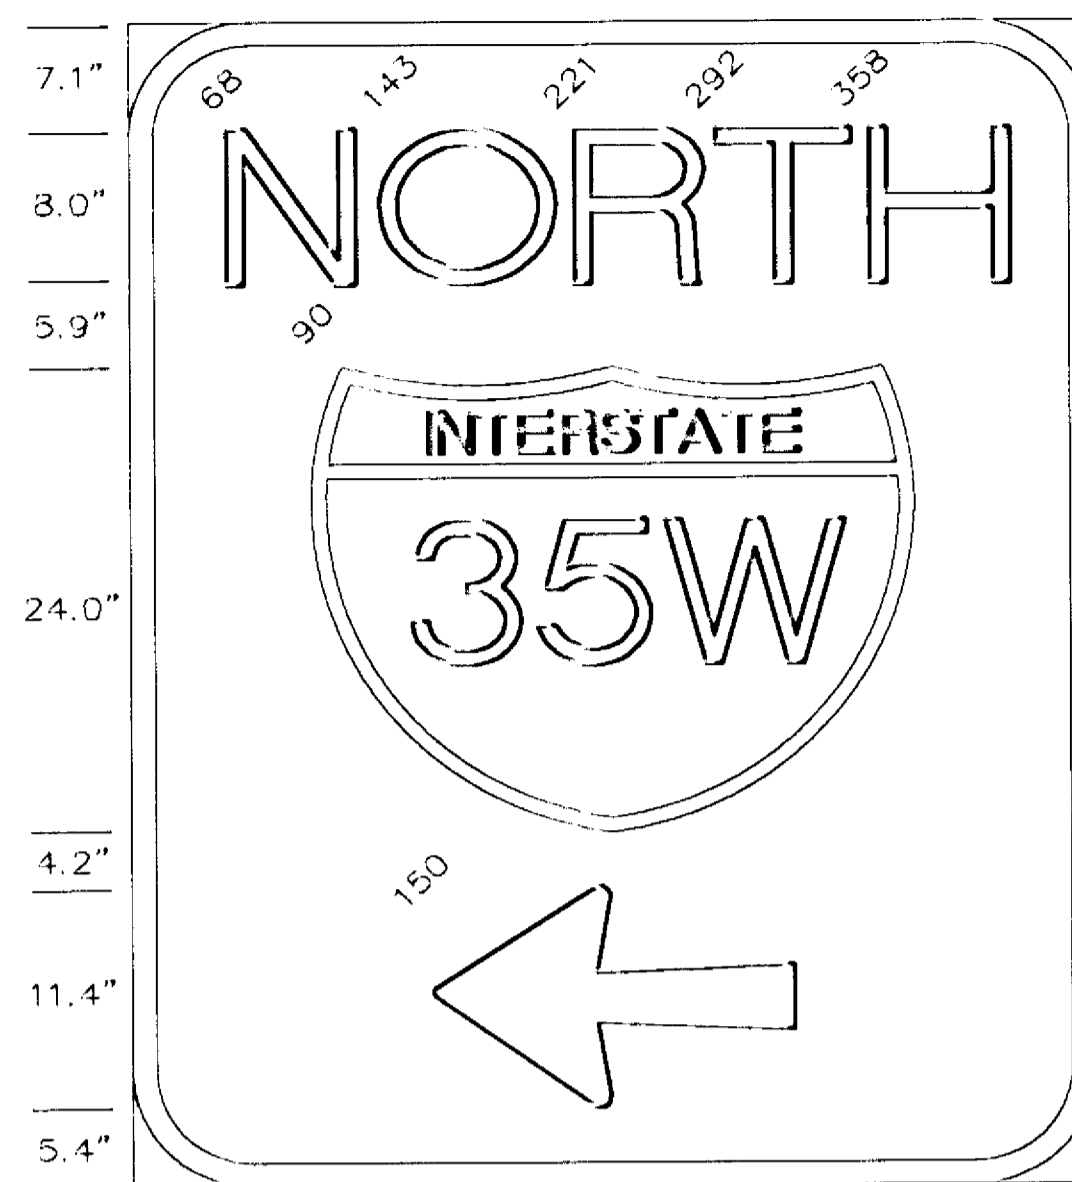


D-2 48" x 66", 6" R. 1.2" B.
D-3 48" x 66", 6" R. 1.2" B.
LINE 1 = 34.43 : 8" "D" MOD., 1.2"
LINE 2 = 30.0 : 30" x 24" --- 10" NUM.
LINE 3 = 18.0 : 14--18 ARROW - 180 = D-2
ARROW - 0 = D-3

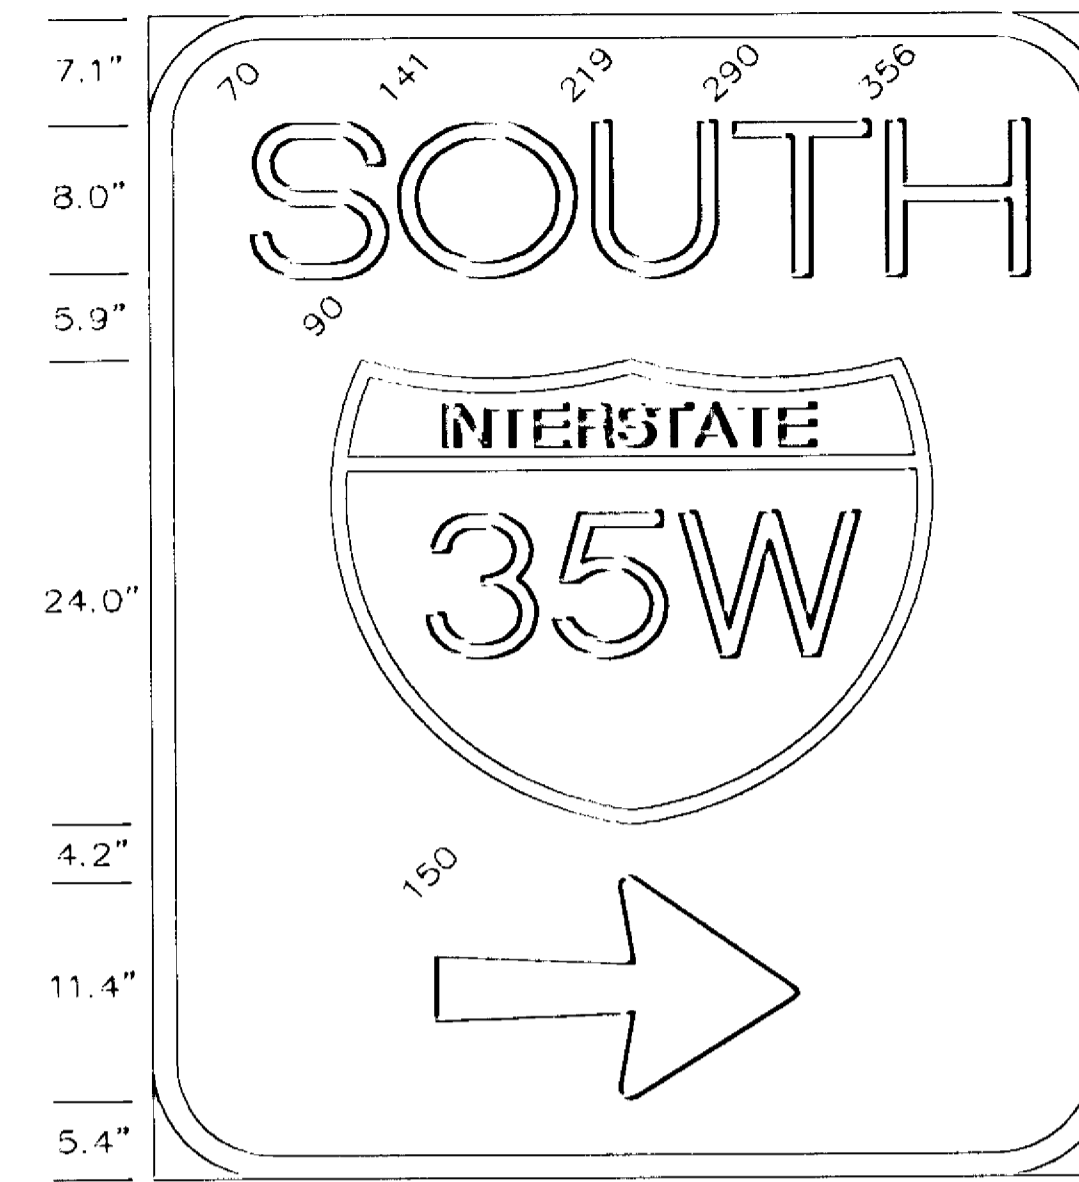

D-4 48" x 66", 6" R. 1.2" B.
D-5 48" x 66", 6" R. 1.2" B.
LINE 1 = 34.00 : 8" "D" MOD., 1.2"
LINE 2 = 30.0 : 30" x 24" --- 10" NUM.
LINE 3 = 18.0 : 14--18 ARROW - 0 = D-4
ARROW - 180 = D-5

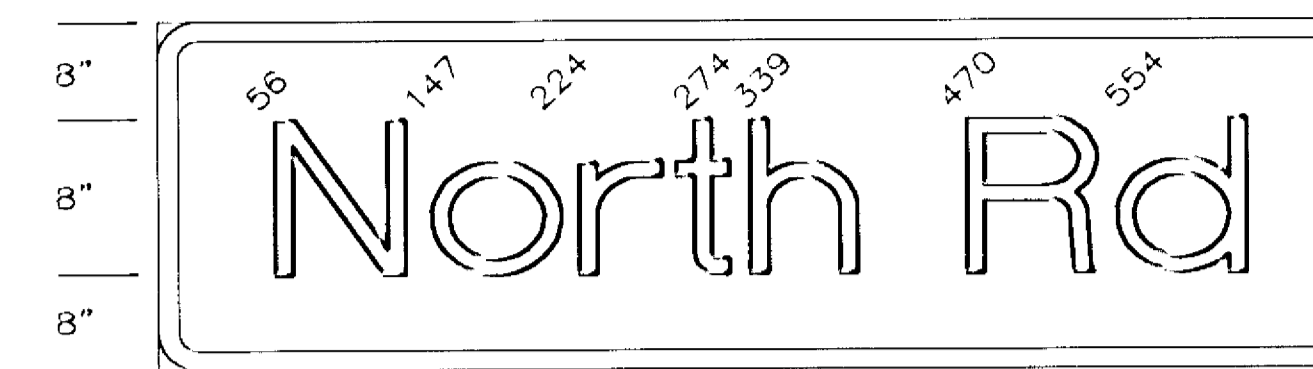


D-6 66" X 24", 3.0 R. 1.0 B.
LINE 1 = 54.85" : 8"-6" "E" MOD.

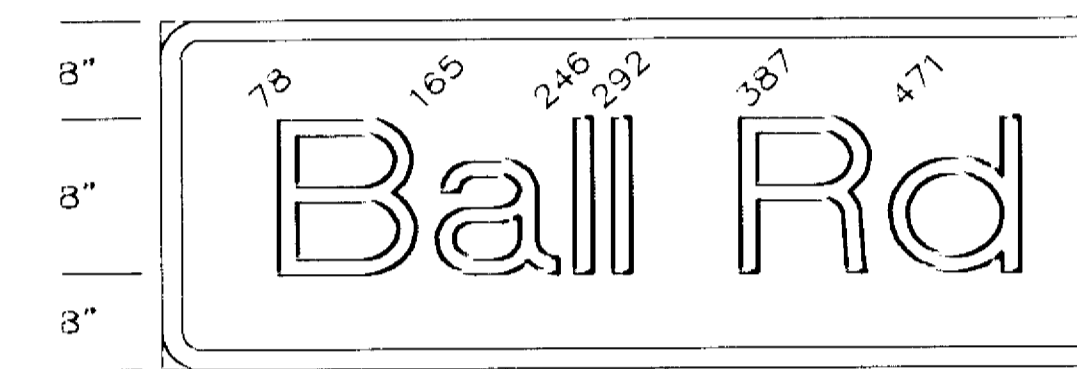


D-7 60" X 24", 3.0 R. 1.0 B.
LINE 1 = 44.32" : 8"-6" "E" MOD.



D-9 48" x 66", 6" R. 1.2" B.
LINE 1 = 34.43 : 8" "D" MOD.
LINE 2 = 30.0 : 30" x 24" --- 10" NUM.
LINE 3 = 11.16 : 5--13 ARROW - 90

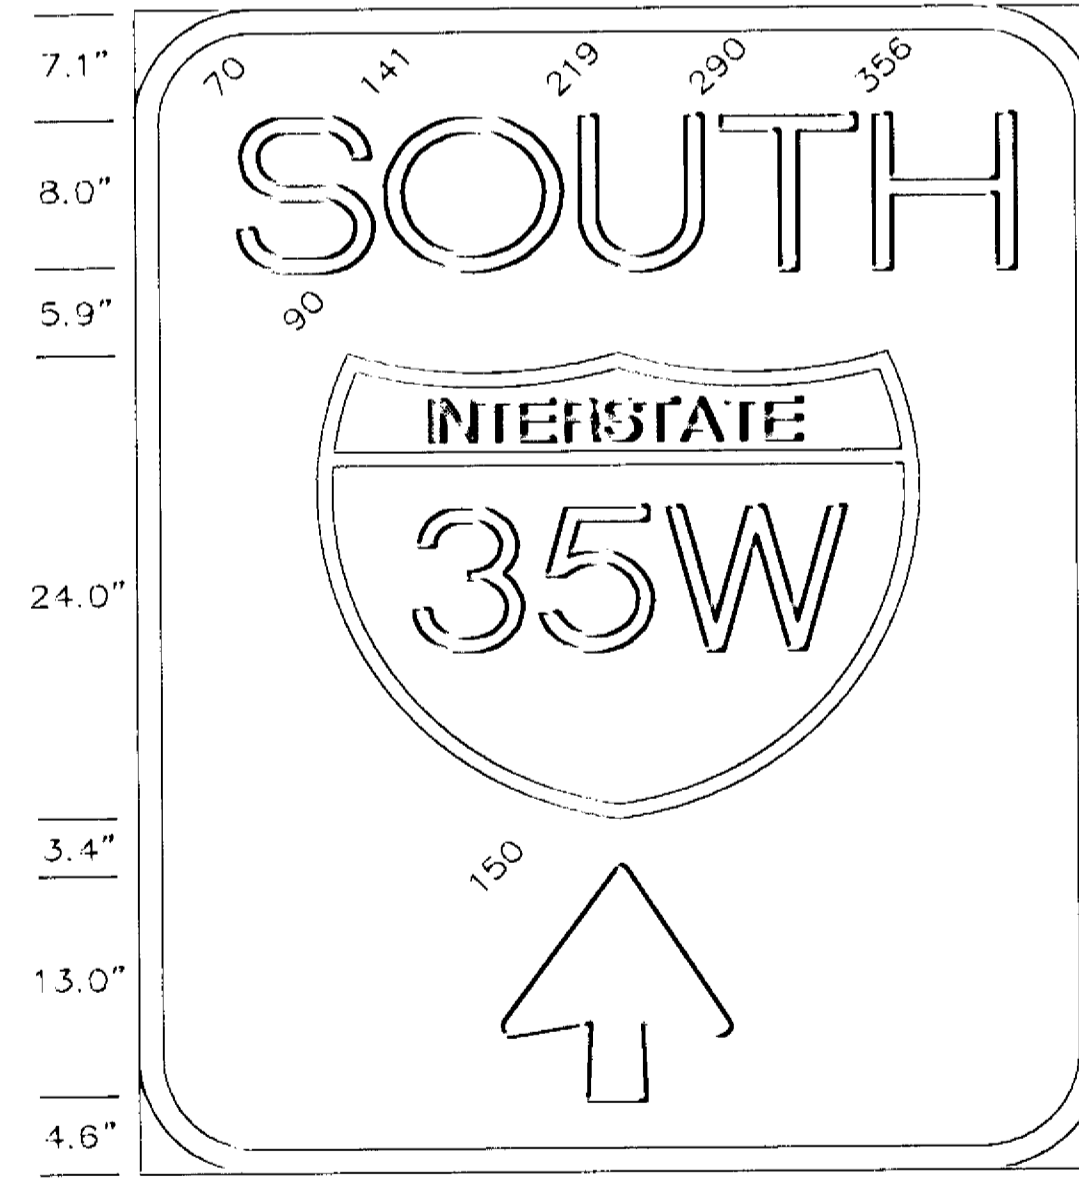

D-10 48" x 66", 6" R. 1.2" B.
LINE 1 = 34.00 : 8" "D" MOD.
LINE 2 = 30.0 : 30" x 24" --- 10" NUM.
LINE 3 = 11.16 : 5--13 ARROW - 90

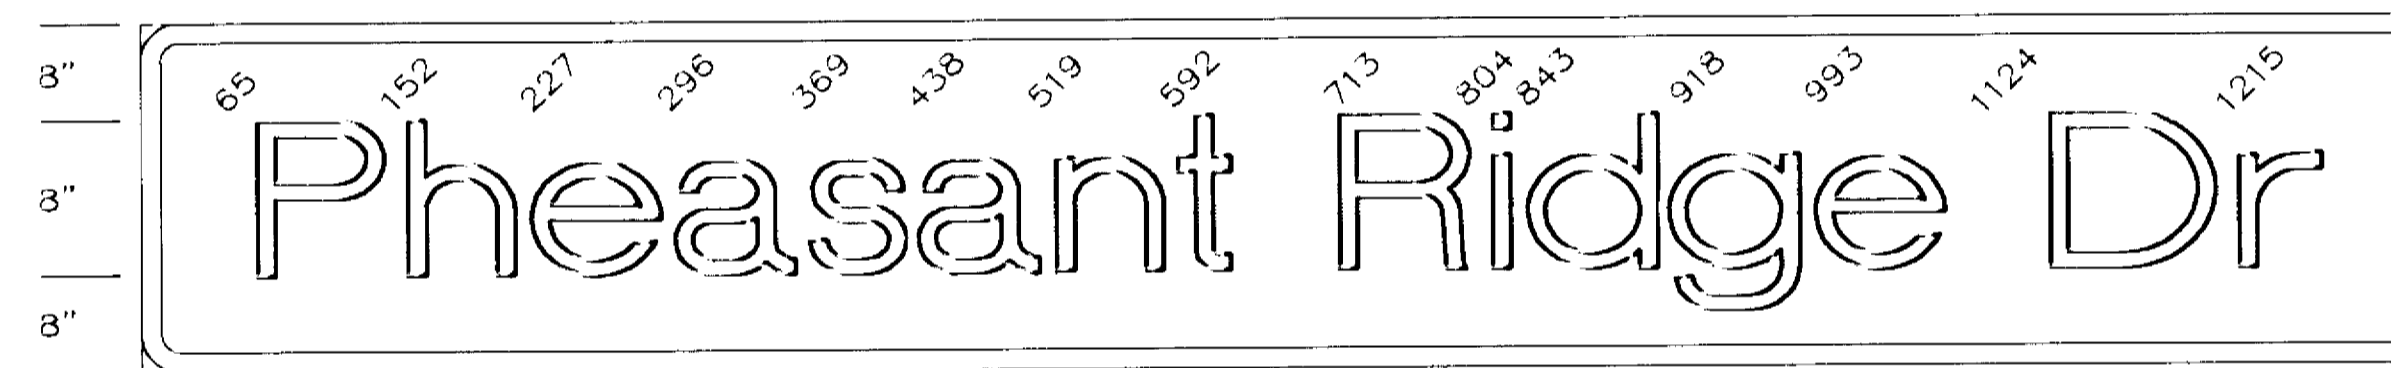

D-8 132" X 24", 3.0 R. 1.0 B.
LINE 1 = 118.92" : 8"-6" "E" MOD.

NOTES:

- 1) COLOR - HIGH INTENSITY WHITE LEGEND AND BORDER ON HIGH INTENSITY GREEN BACKGROUND, FULLY REFLECTORIZED.
- 2) CORNERS EXTENDING BEYOND THE BORDER SHALL NOT BE TRIMMED.
- 3) BORDERS SHALL BE AS SHOWN ON PLANS.
- 4) FOR STRUCTURAL DETAILS, TYPE "D" SIGNS, SEE STANDARD SIGNS MANUAL, PAGE 105B.
- 5) FOR TYPE "D" STRINGER AND PANEL - JOINT DETAIL, SEE STANDARD SIGNS MANUAL, PAGE 105.
- 6) LETTERING STYLE SHALL BE HIGHWAY GOTHIC CONFORMING TO MN/DOT STANDARDS.

NO.	DATE	BY	CHKD	APPR

REVISION	DATE	TIME



I hereby certify that this plan, specification or report was prepared by me or under my direct supervision and that I am a duly Registered Professional Engineer under the laws of the State of Minnesota.
George M. Stimpff
Date: 3/21/97 Reg. No. 21849


STATE AID PROJECT NO. SAP 02-617-11
STATE PROJECT NO. SP 0280-47

DRAWN BY R.W. SMITH DATE 9-96
DESIGNED BY P. CORKLE 9-96
CHECKED BY G. STUEMPF 9-96
COMM. NO. 0962410




ANOKA COUNTY
MAST ARM SIGN DETAILS
C.S.A.H. 17 RECONSTRUCTION


SHEET 133 OF 236

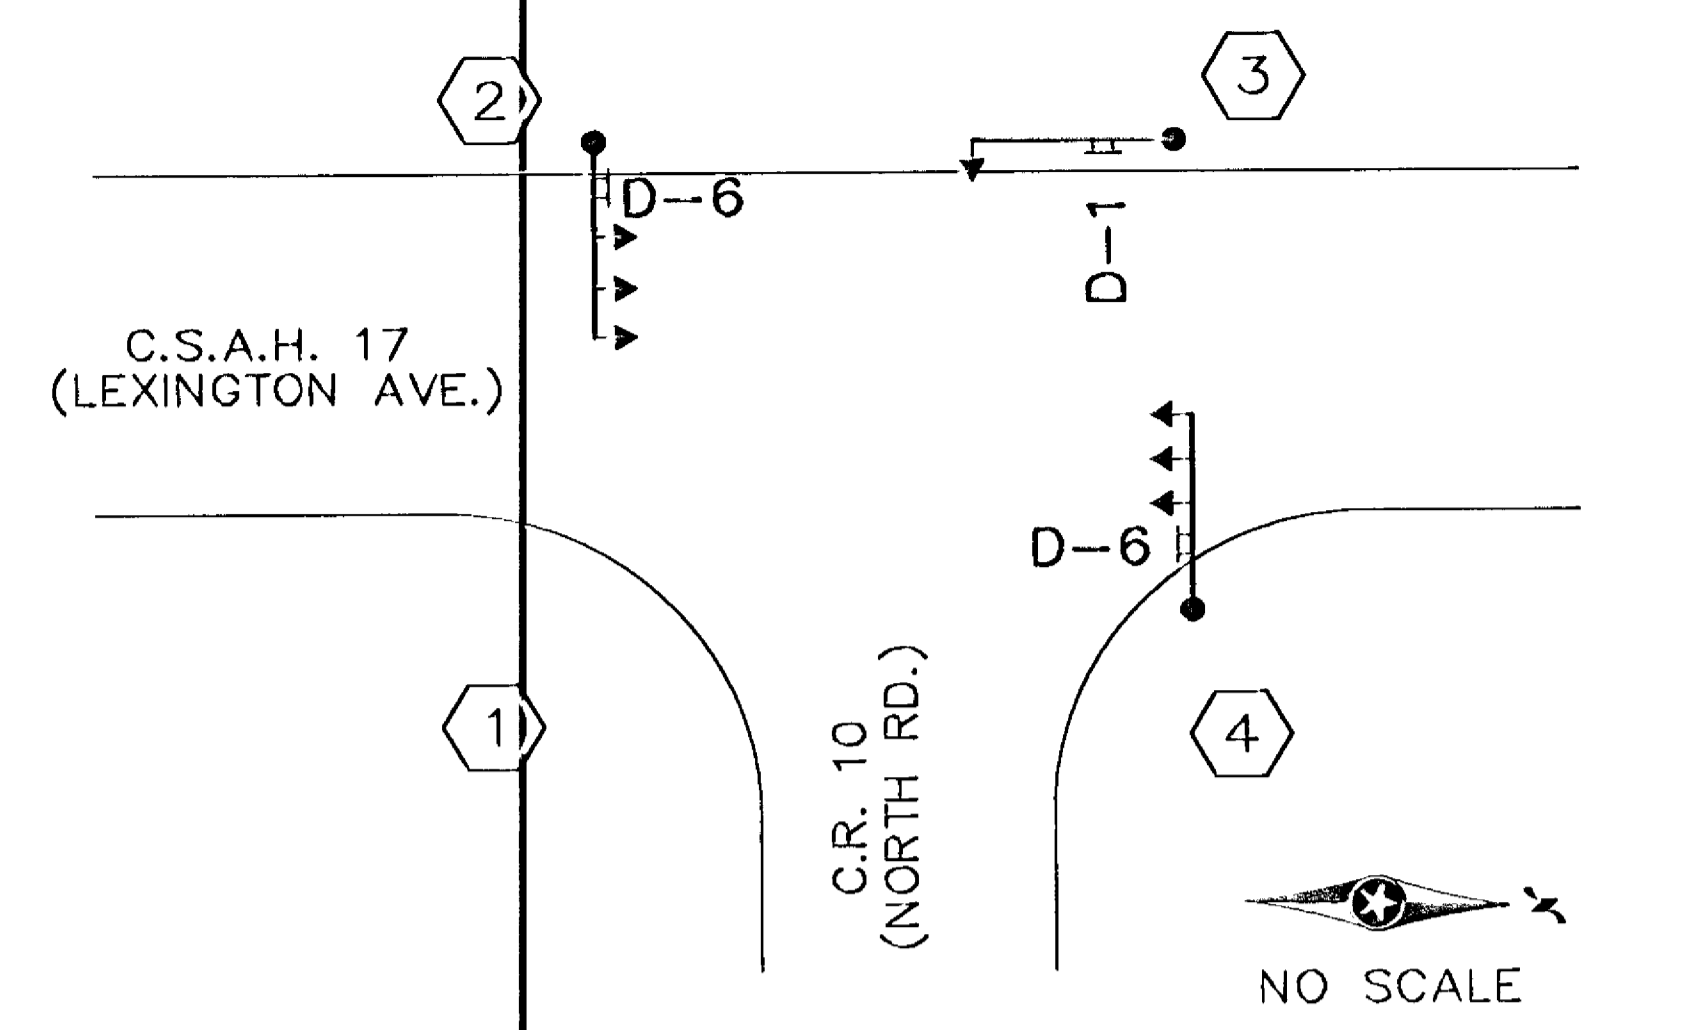


C.S.A.H. 17 (LEXINGTON AVE.) & C.R. 10 (NORTH RD.)
SIGN LAYOUT (SYSTEM "A")

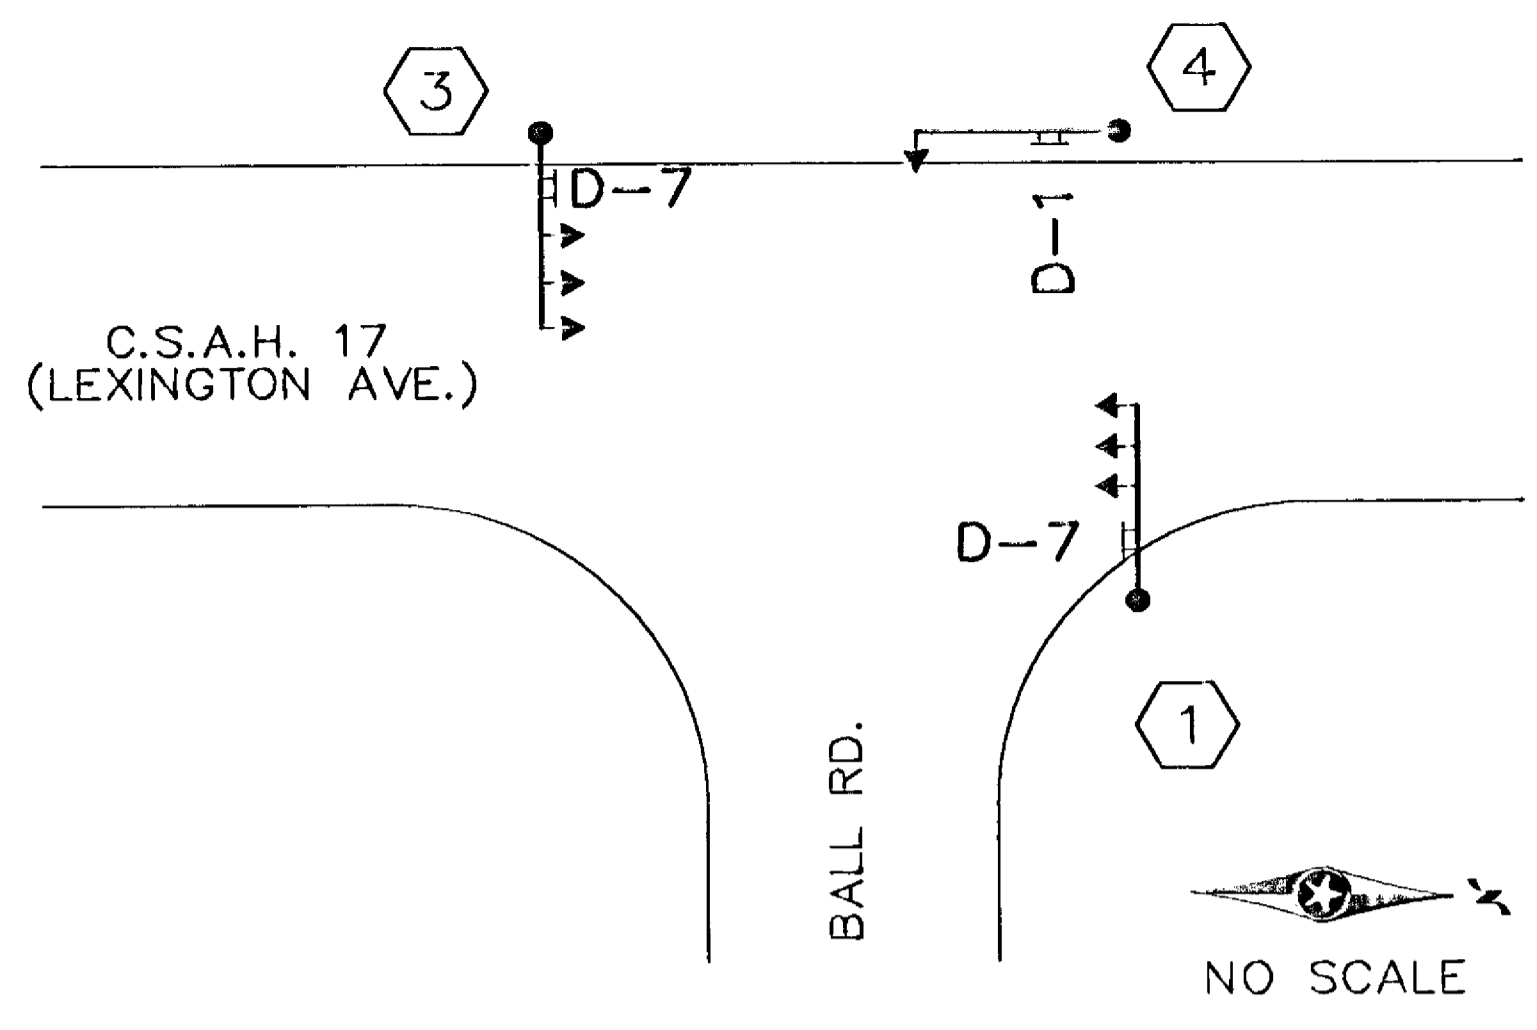


C.S.A.H. 17 (LEXINGTON AVE.) & BALL ROAD
SIGN LAYOUT (SYSTEM "B")

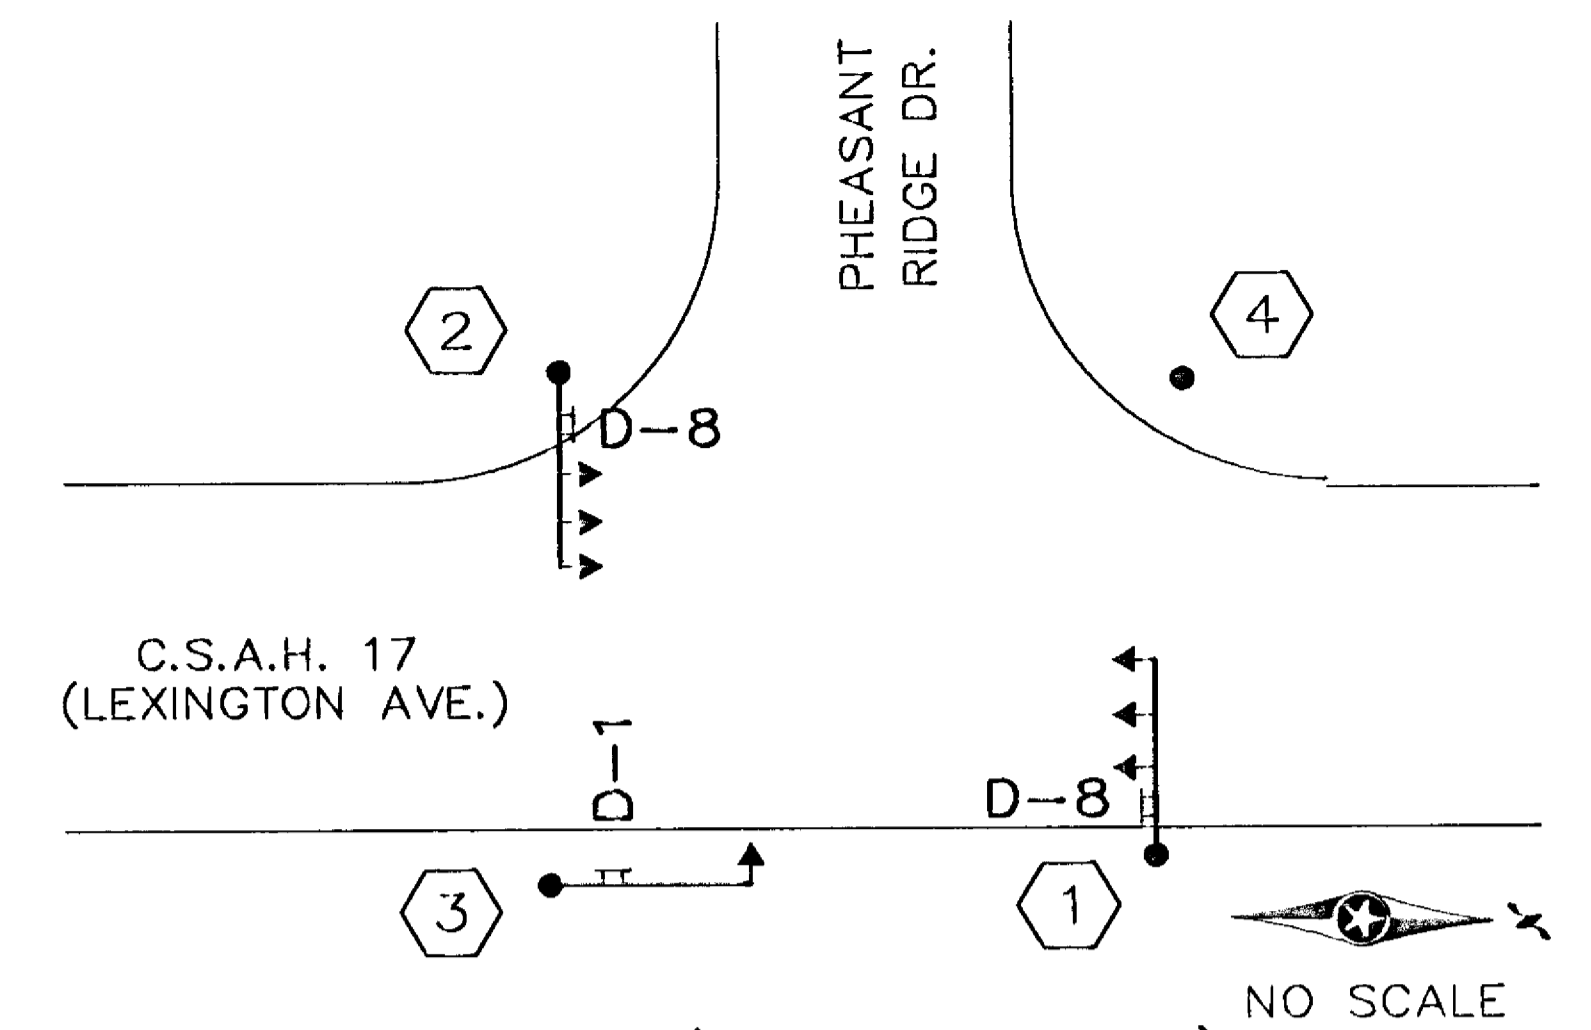

C.S.A.H. 17 (LEXINGTON AVE.) & PHEASANT RIDGE DR.
(SYSTEM "E") SIGN LAYOUT

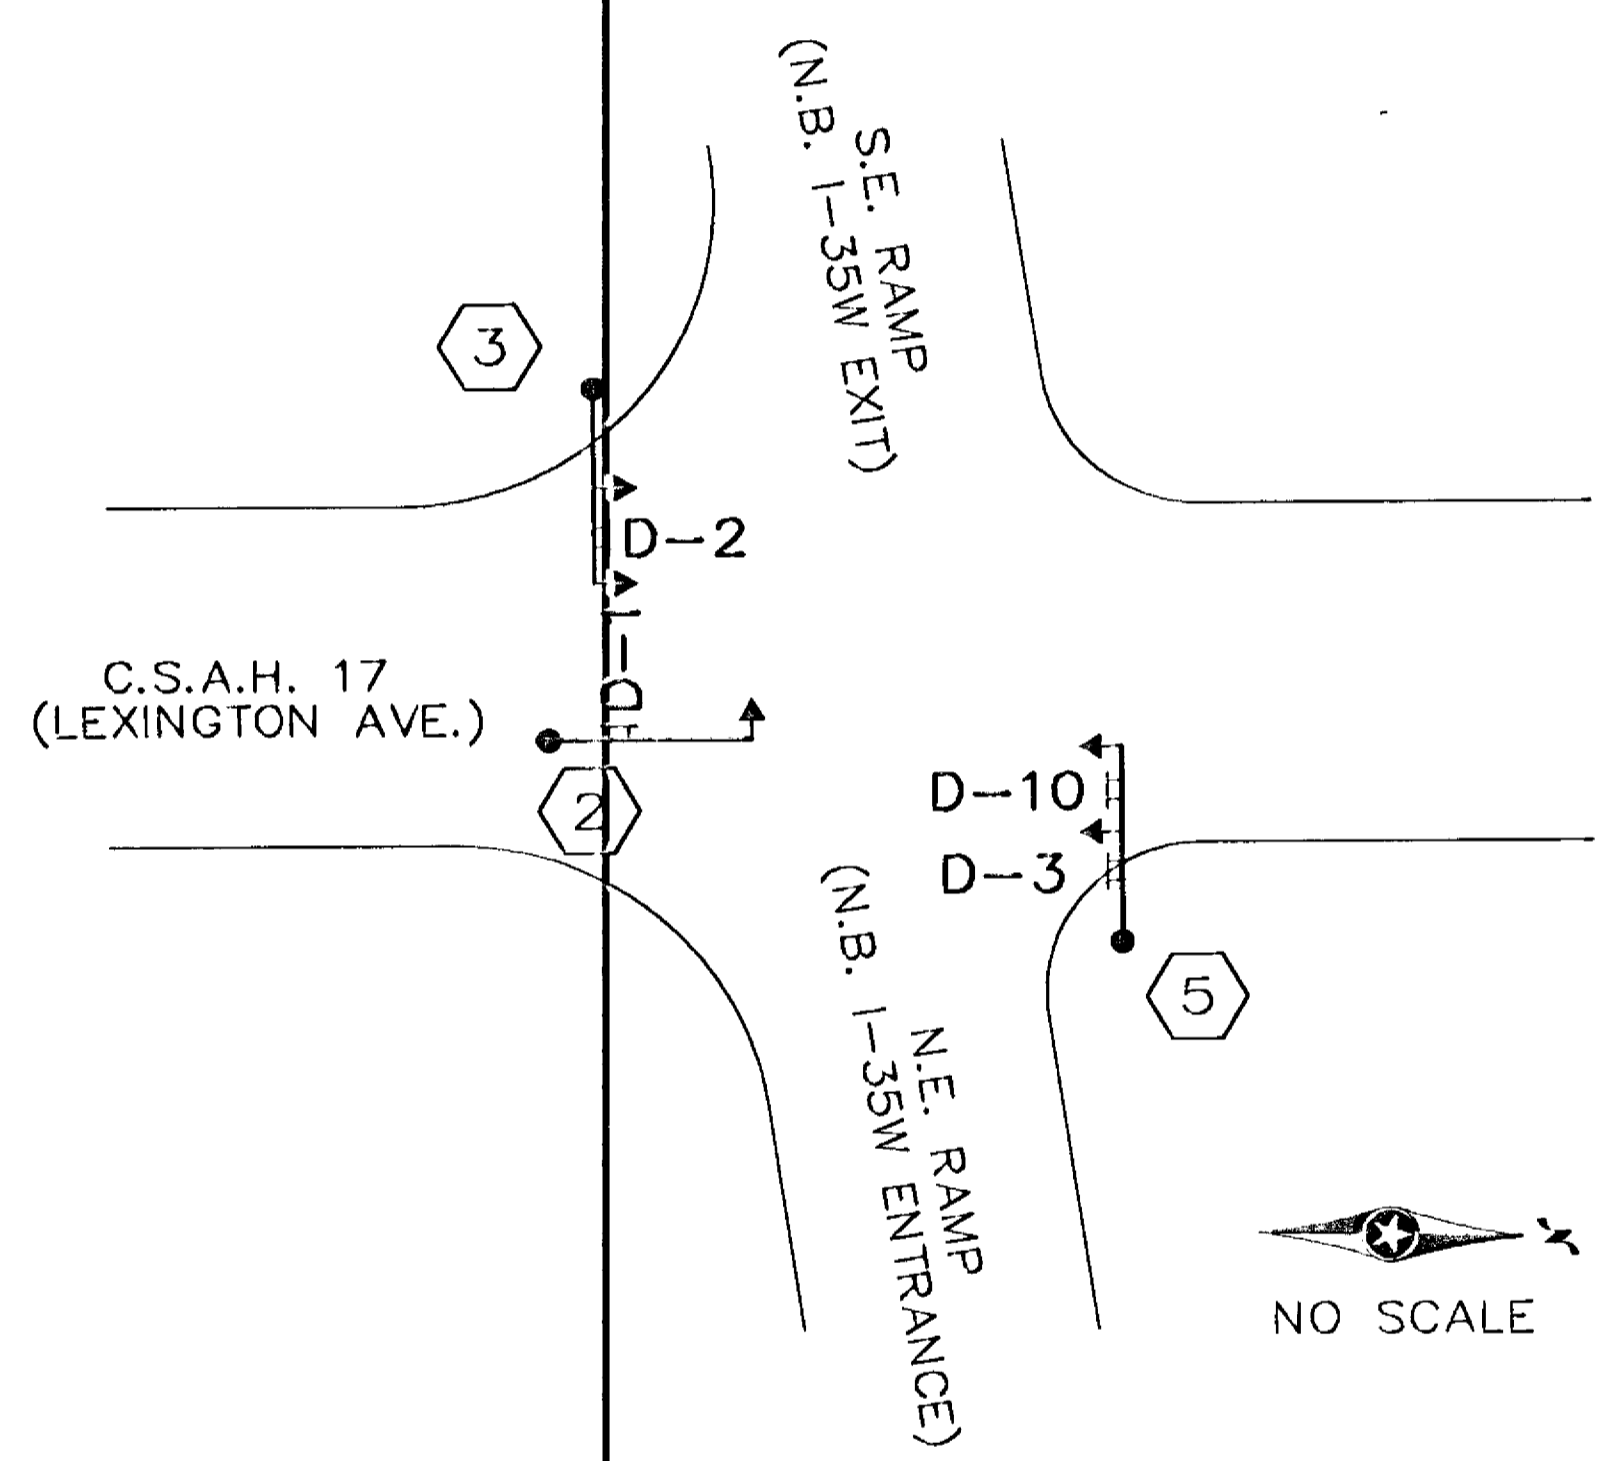


C.S.A.H. 17 (LEXINGTON AVE.) & I-35W SOUTH RAMP
SIGN LAYOUT (SYSTEM "C")

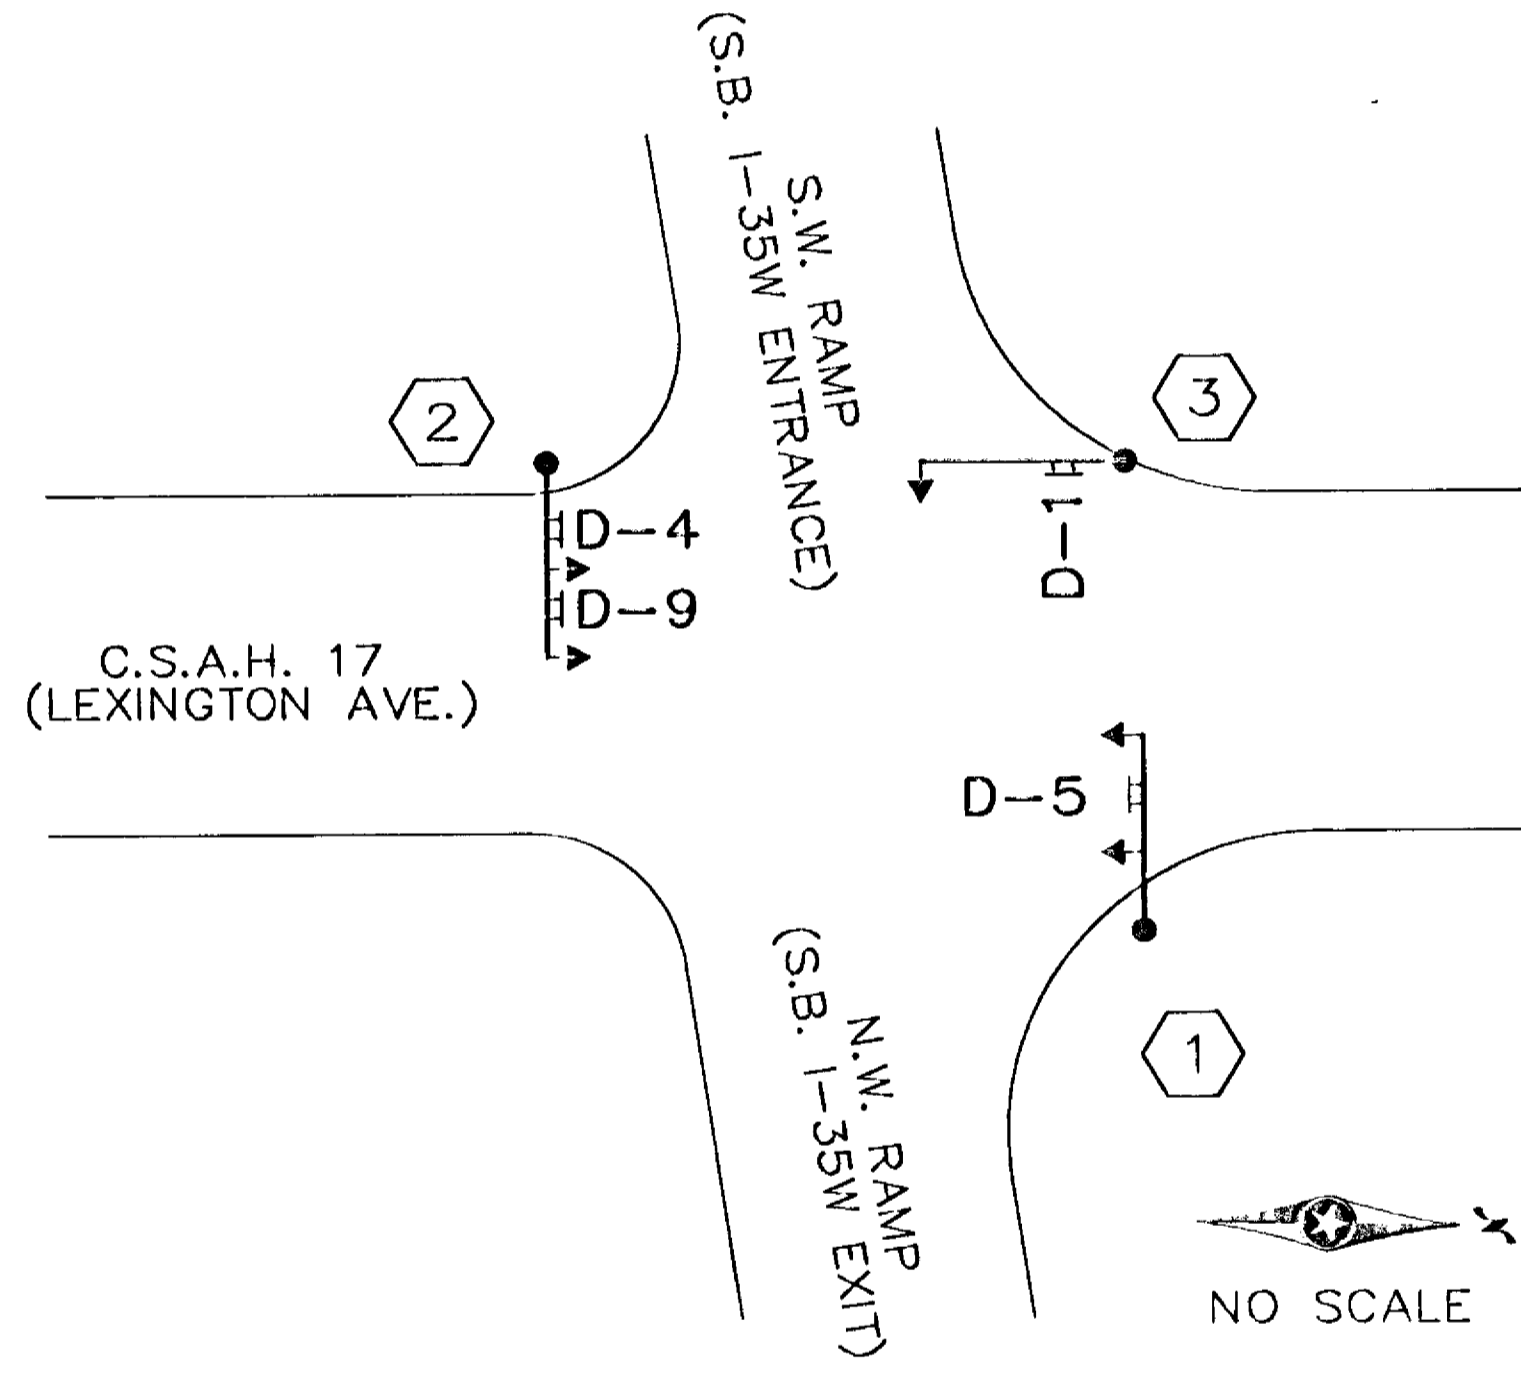

C.S.A.H. 17 (LEXINGTON AVE.) & I-35W NORTH RAMP
SIGN LAYOUT (SYSTEM "D")

OVERLAYS				
CODE NO.	QUANTITY	SIZE	LEGEND	SQ. FT. PER OVERLAY
M1-1	6	30" x 24"	35W	5

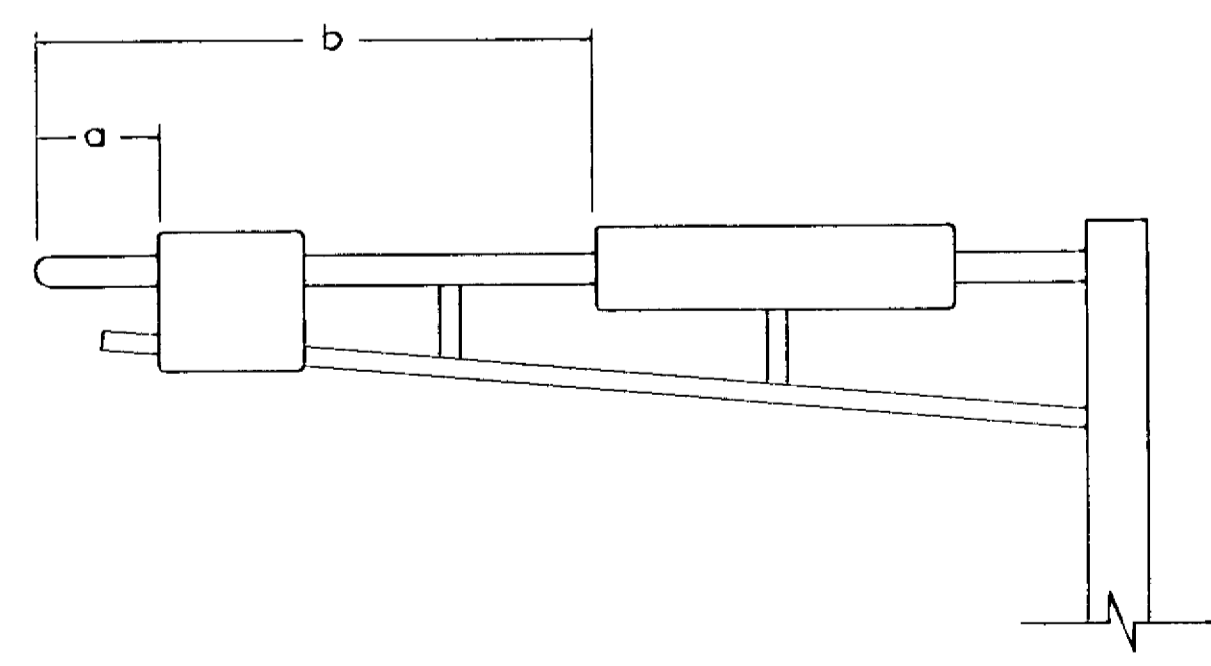

MAST ARM SIGN DIMENSIONING DETAIL

TYPE "D" SIGNS (SYSTEM A)								
SIGN PANEL	SIZE	NUMBER REQUIRED	BRACKETS PER SIGN	BRACKET SPACING	SQUARE FT. PER SIGN	a	b	POLE NUMBER
D-1	102" x 24"	1	2	54"	17		15'	③
D-6	66" x 24"	2	2	42"	11		30'	② ④

TYPE "D" SIGNS (SYSTEM B)								
SIGN PANEL	SIZE	NUMBER REQUIRED	BRACKETS PER SIGN	BRACKET SPACING	SQUARE FT. PER SIGN	a	b	POLE NUMBER
D-1	102" x 24"	1	2	54"	17		25'	④
D-7	60" x 24"	2	2	36"	10		30'	① ③


TYPE "D" SIGNS (SYSTEM C)								
SIGN PANEL	SIZE	NUMBER REQUIRED	BRACKETS PER SIGN	BRACKET SPACING	SQUARE FT. PER SIGN	a	b	POLE NUMBER
D-1	102" x 24"	1	2	54"	17		16'	②
D-2	48" x 66"	1	2	24"	22	5'		③
D-3	48" x 66"	1	2	24"	22	16'		⑤
D-10	48" x 66"	1	2	24"	22	5'		⑤

TYPE "D" SIGNS (SYSTEM D)								
SIGN PANEL	SIZE	NUMBER REQUIRED	BRACKETS PER SIGN	BRACKET SPACING	SQUARE FT. PER SIGN	a	b	POLE NUMBER
D-1	102" x 24"	1	2	54"	17		12'	③
D-4	48" x 66"	1	2	24"	22	21'		②
D-5	48" x 66"	1	2	24"	22	5'		①
D-9	48" x 66"	1	2	24"	22	5'		②

TYPE "D" SIGNS (SYSTEM E)								
SIGN PANEL	SIZE	NUMBER REQUIRED	BRACKETS PER SIGN	BRACKET SPACING	SQUARE FT. PER SIGN	a	b	POLE NUMBER
D-1	102" x 24"	1	2	18"	17		12'	③
D-8	132" x 24"	1	3	42"	22		24'	①
D-8	132" x 24"	1	3	42"	22		30'	②

NO.	DATE	BY	CHKD	APPR	REVISION
1	3-27-97	MAB	GMS	DRE	ADD MAST ARM SIGNS AT SYSTEMS C, D AND E

NAME: H:\SIGNALS\2410\10-SIGN2.DWG DATE: MAR 27, 1997 TIME: 10:39 AM

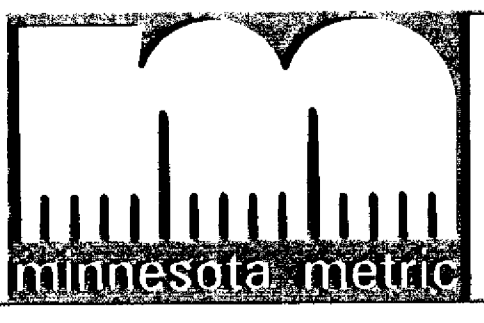

I hereby certify that this plan, specification or report was prepared by me or under my direct supervision and that I am a duly Registered Professional Engineer under the laws of the State of Minnesota.
George M. Stueffig
 Date: 4/21/97 Reg. No. 21849

STATE AID PROJECT NO. SAP 02-617-11
 STATE PROJECT NO. SP 0280-47

DRAWN BY R.W. SMITH DATE 9-96
 DESIGNED BY P. CORKLE 9-96
 CHECKED BY G. STUEFFIG 9-96
 COMM. NO. 0962410



ANOKA COUNTY
 MAST ARM SIGN DETAILS
 C.S.A.H. 17 RECONSTRUCTION

SHEET 134 OF 236

LEGEND OF SYMBOLS	
	CABLE TRAY
	CONDUIT - F&I
	CONDUIT - INPLACE
	DETECTOR (SPECIFY) - (SPECIFY)
	DIRECT BURIED COMMUNICATION CABLE - F&I
	DIRECT BURIED COMMUNICATION CABLE - INPLACE
	DIRECT BURIED POWER CABLE - F&I
	DIRECT BURIED POWER CABLE - INPLACE
	FLASHER - F&I
	FLASHER - INPLACE
	FLASHING BEACON - F&I
	FOUNDATION F&I, GATE ARM - F&I
	FOUNDATION INPLACE, GATE ARM - F&I
	GATE ARM - INPLACE
	GUARDRAIL END TREATMENT (SPECIFY) - (SPECIFY)
	GUARDRAIL (PLATE BEAM) - (SPECIFY)
	HANDHOLE - F&I
	HANDHOLE - INPLACE
	JUNCTION BOX OR CONDULET - F&I
	JUNCTION BOX OR CONDULET - INPLACE
	LANE ARROW
	OVERHEAD SIGN - F&I
	OVERHEAD SIGN - INPLACE
	PAD (SPECIFY) - F&I
	PAD (SPECIFY) - INPLACE
	PEDESTAL - F&I
	PEDESTAL - INPLACE
	RAMP CONTROL SIGNAL (DESIGN ONE-WAY) - F&I
	RAMP CONTROL SIGNAL (DESIGN TWO-WAY) - F&I
	RAMP CONTROL SIGNAL (DESIGN ONE-WAY) - INPLACE
	RAMP CONTROL SIGNAL (DESIGN TWO-WAY) - INPLACE
	SHELTER (TMS) - F&I
	SHELTER (TMS) - INPLACE
	SIGN (TYPE A OR D) - (SPECIFY)
	SIGN (TYPE C) - (SPECIFY)

LEGEND OF SYMBOLS	
	SIGN (TYPE CMS) - (SPECIFY)
	SIGNAL FACE - F&I
	SIGNAL FACE - INPLACE
	SPLICE CABINET (SPECIFY) - (SPECIFY)
	SPLICE VAULT (FIBER OPTIC) - (SPECIFY)
	TELEVISION CAMERA (CCTV) - (SPECIFY)
	WOOD POLE - F&I
	WOOD POLE - INPLACE
	WOOD POLE F&I, SERVICE INSTALLATION - F&I
	WOOD POLE INPLACE, SERVICE INSTALLATION - F&I
	WOOD POLE INPLACE, SERVICE INSTALLATION - INPLACE

ABBREVIATIONS

BR.GR. - BARE GROUND	J.B. - JUNCTION BOX
C.B. - CIRCUIT BREAKER	LCS - LANE CONTROL SIGNAL
CCTV - CLOSED CIRCUIT TELEVISION	LUM - LUMINAIRE
CMS - CHANGEABLE MESSAGE SIGN	NEU - NEUTRAL
DNL - DOWNLIGHT	NMC - NON METALLIC CONDUIT
EQG - EQUIPMENT GROUND	RCS - RAMP CONTROL SIGNAL
FL - FLASH / FLASHING	R&S - REMOVE AND SALVAGE
F&I - FURNISH AND INSTALL	RSC - RIGID STEEL CONDUIT
GR.R. - GROUND ROD	SOP - SOURCE OF POWER
H.H. - HANDHOLE	SPR - SPARE CONDUCTOR
HAR - HIGHWAY ADVISORY RADIO	TDW - TELEPHONE DROP WIRE
IMC - INTERMEDIATE METAL CONDUIT	TMC - TRAFFIC MANAGEMENT CENTER
INP - INPLACE	TMS - TRAFFIC MANAGEMENT SYSTEM

STANDARD PLATES

THE FOLLOWING STANDARD PLATES, APPROVED BY THE FEDERAL HIGHWAY ADMINISTRATION, SHALL APPLY ON THIS PROJECT

PLATE NO.	DESCRIPTION
8119 C	GROUND MOUNTED CABINET FOUNDATION

TABULATION OF ESTIMATED QUANTITIES				
ITEM NO.	ITEM	UNIT	02-617-11	
			EST QUAN	FINAL QUAN
	SALVAGE MISCELLANEOUS STRUCTURES	LUMP SUM	1	
	REMOVE MISCELLANEOUS STRUCTURES	LUMP SUM	1	
	HAUL SALVAGED MATERIAL	LUMP SUM	1	
	SYSTEMS INTEGRATION	LUMP SUM	1	
	CABINET FOUNDATION	EACH	1	
	SERVICE FOUNDATION	EACH	1	
	HANDHOLE, TYPE PVC CONCRETE COVER	EACH	7	
	FIBEROPTIC SPLICE VAULT	EACH	1	
	OUTDOOR FIBER SPLICE ENCLOSURE	EACH	1	
	50 mm NON-METALLIC CONDUIT (1)	m	205	
	75 mm NON-METALLIC CONDUIT	m	170	
	100 mm NON-METALLIC CONDUIT	m	10	
	75 mm PUSHED CONDUIT	m	45	
	POWER CABLE 1 CONDUCTOR NO. 6	m	400	
	POWER CABLE 1 CONDUCTOR NO. 8	m	150	
	LEAD-IN CABLE 2 CONDUCTOR NO. 14	m	1580	
	SIGNAL CONTROL CABLE 5 CONDUCTOR NO. 12	m	240	
	CONTROL CABLE 15 CONDUCTOR NO. 18	m	50	
	VIDEO CABLE RG11	m	50	
	ARMORED FIBEROPTIC PIGTAIL	EACH	1	
	1.7 m X 1.7 m LOOP DETECTOR DESIGN SAWCUT	EACH	2	
	LOOP DETECTOR SPLICE	EACH	6	
	INSTALL CABINET	EACH	1	
	DOCUMENTATION & TRAINING	LUMP SUM	1	

(1) 20 m OF 50 mm NMC IS HD NMC UNDER ROADWAY SURFACE

TMS CONSTRUCTION PLAN

CERTIFIED BY *P.M. Bellamy* REG. NO. 18491 MAR 13 1997
PROFESSIONAL ENGINEER

STATE PROJ. NO. 02-617-11


SHEET NO. 135 OF 236 SHEETS

- 1 INPLACE CCTV ASSEMBLY & FOUNDATION (CAM NO.644)
- 2 INPLACE 50 mm NMC, 3-1/C NO.10, 1-27/C NO.18 & 1-RG11
REMOVE CABLES AND ABANDON CONDUIT
- 3 INPLACE 334Z CABINET & FOUNDATION CAB NO.35W-33.55
SALVAGE CABINET (SEE SPECIAL PROVISIONS)
REMOVE FOUNDATION (SEE SPECIAL PROVISIONS)
- 4 INPLACE 50 mm NMC, 6-2/C NO.14 & 2-5/C NO.12
REMOVE CABLES & ABANDON CONDUIT
- 5 SALVAGE INPLACE 1-FO PIGTAIL (SEE SPECIAL PROVISIONS)
- 6 INPLACE 1-FO SPLICE VAULT & OUTDOOR FIBER SPLICE ENCLOSURE
SALVAGE 1-FO SPLICE VAULT & OUTDOOR FIBER SPLICE ENCLOSURE (SEE SPECIAL PROVISIONS)
- 7 INPLACE 53 mm RSC & 2-2/C NO.14
REMOVE CABLES & ABANDON CONDUIT
INPLACE 53 mm RSC & 3-1/C NO.6
REMOVE CABLES & ABANDON CONDUIT
- 8 INPLACE 53 mm RSC & 3-1/C NO.6
REMOVE CABLES & ABANDON CONDUIT
- 9 INPLACE S.O.P. ADDRESS (10400 LEXINGTON AVE)
DISCONNECT & REMOVE INSTALLATION
- 10 INPLACE 53 mm NMC & 2-2/C NO.14
REMOVE CABLES & ABANDON CONDUIT
- 11 INPLACE 50 mm NMC & 2-2/C NO.14
REMOVE CABLES
- 12 INPLACE 50 mm NMC & 1-2/C NO.14
REMOVE CABLES
- 13 ABANDON INPLACE LOOP DETECTOR
- 14 INPLACE 53 mm RSC & 1-2/C NO.14
REMOVE CABLES
- 15 INPLACE LOOP DETECTOR
- 16 INPLACE 1-FO CABLE(12MM, 18SM) & 1-12/PR NO.19




I-35W

LEXINGTON

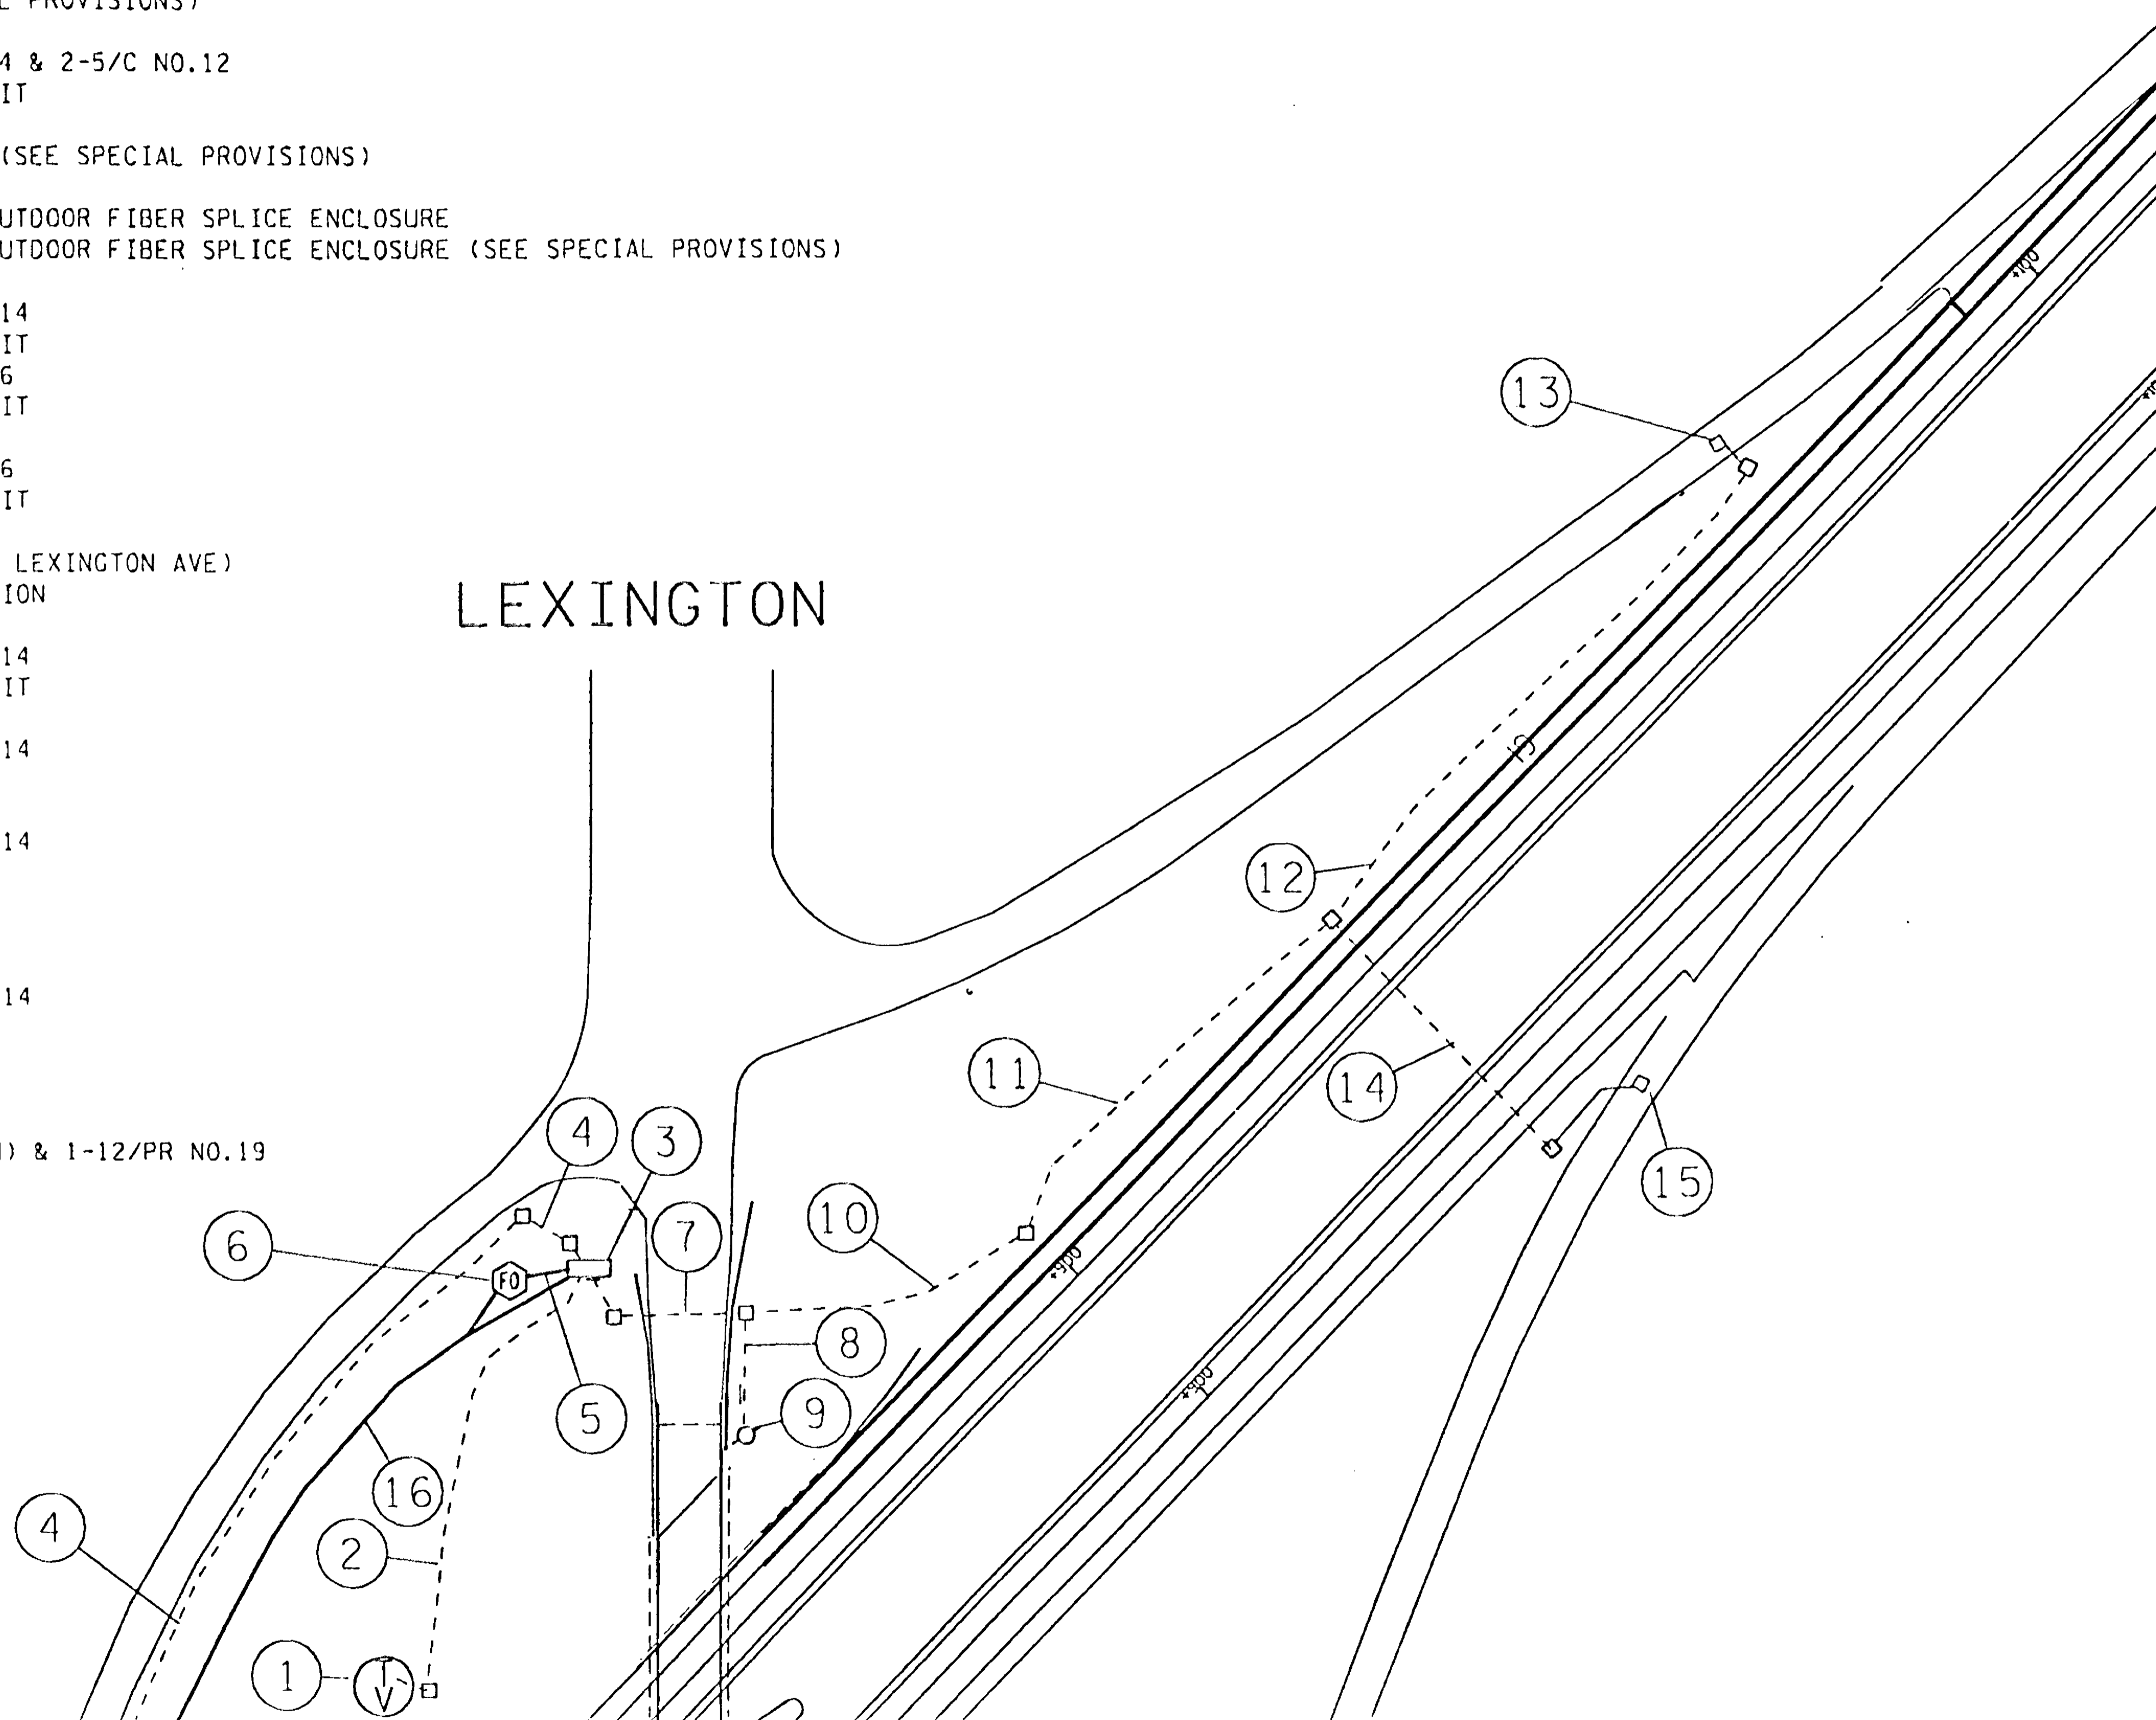

MATCH LINE B

INPLACE TMS LAYOUT

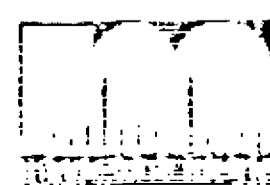


CERTIFIED BY P.M. Beltran REG. NO. 18491 MAR 13 1997 STATE PROJ. NO. 02-617-11 SHEET NO. 136 OF 236 SHEETS

MATCH LINE B




- 1 INPLACE RAMP CONTROL SIGNAL & FOUNDATION
- 2 INPLACE 78 mm RSC, 1-5/C NO.12, 1-FO CABLE(12MM, 185M) & 1-12/PR NO.19
- 3 INPLACE LOOP DETECTOR
- 4 INPLACE 53 mm RSC & 3-2/C NO.14
REMOVE CABLES
- 5 INPLACE 50 mm NMC & 1-2/C NO.14
REMOVE CABLES
- 6 ABANDON INPLACE LOOP DETECTOR
- 7 INPLACE 1-FO CABLE (12MM, 185M) & 1-12/PR NO.19
- 8 INPLACE 50 mm NMC, 6-2/C NO.14 & 2-5/C NO.12
REMOVE CABLES & ABANDON CONDUIT

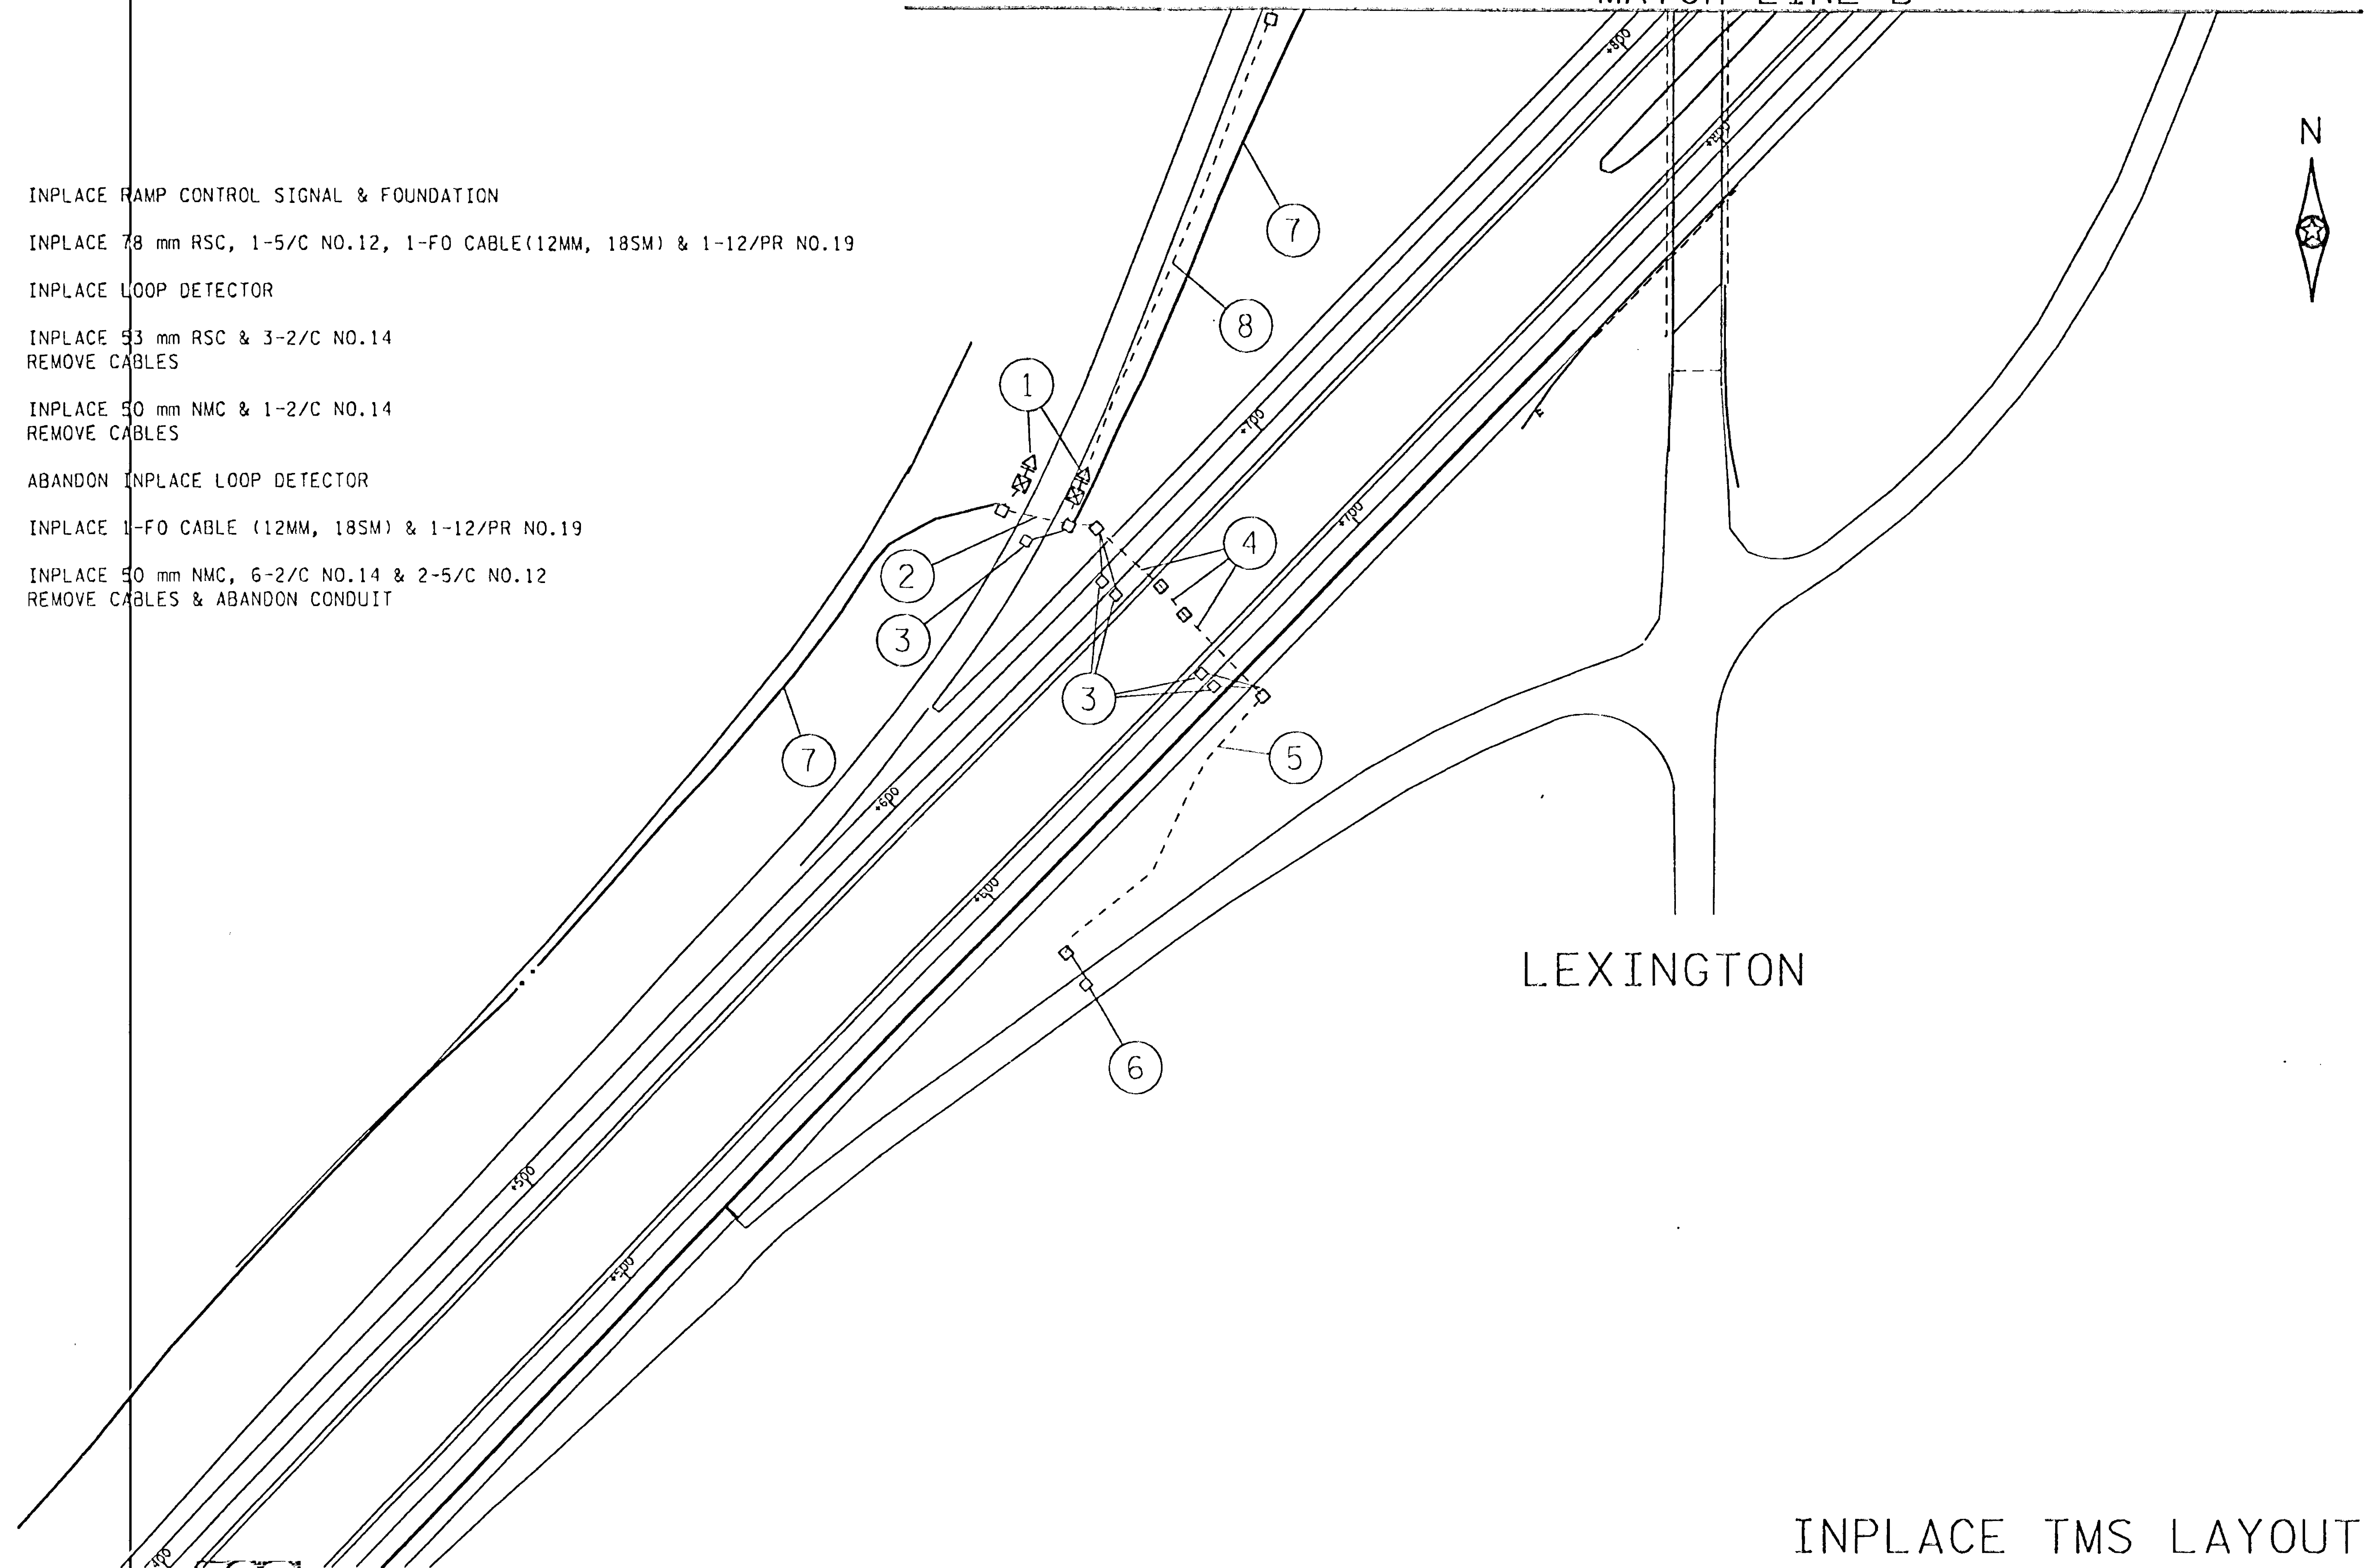

LEXINGTON

INPLACE TMS LAYOUT

I-35W

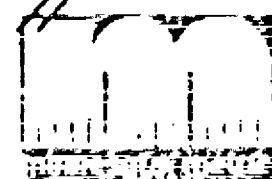

CERTIFIED BY *P.M. Bednar*
PROFESSIONAL ENGINEER


REG. NO. 18491 MAR 13 1997

STATE PROJ. NO. 02-617-11

SHEET NO. 137 OF 236 SHEETS




- 1 INPLACE CCTV ASSEMBLY & FOUNDATION (CAM NO.644)
- 2 F&I 50 mm NMC, 3-1/C NO.8, 1-15/C NO.18 & 1-RG11
- 3 F&I 100 mm NMC, 2-5/C NO.12, 6-2/C NO.14, 3-1/C NO.8, 1-15/C NO.18 & 1-RG11
- 4 F&I 334 FOUNDATION (SEE DETAIL & SPECIAL PROVISIONS)
INSTALL SALVAGED 334Z CAB NO.35W-33.55 (SEE SPECIAL PROVISIONS)
- 5 F&I 75 mm NMC, 6-2/C NO.14 & 2-5/C NO.12
- 6 F&I 100 mm NMC, 2-2/C NO.14 & 1-FO PIGTAIL (SEE SPECIAL PROVISIONS)
- 7 F&I 1-FO PIGTAIL (SEE SPECIAL PROVISIONS)
- 8 F&I SAWCUT LOOP DETECTOR (SEE DETAILS & SPECIAL PROVISIONS)
- 9 F&I 50 mm NMC & 1-2/C NO.14
- 10 INPLACE 50 mm NMC
F&I 1-2/C NO.14
- 11 INPLACE LOOP DETECTOR
F&I LOOP DETECTOR SPLICE IN HANDHOLE (SEE SPECIAL PROVISIONS)
- 12 INPLACE 53 mm RSC
F&I 1-2/C NO.14
- 13 INPLACE 50 mm NMC
F&I 2-2/C NO.14
- 14 F&I 50 mm NMC & 2-2/C NO.14
- 15 F&I 75 mm HD NMC PUSH, 3-1/C NO.6 & 2-2/C NO.14
- 16 F&I 75 mm NMC & 2-2/C NO.14
F&I 50 mm NMC & 3-1/C NO.6
- 17 F&I 1-FO SPLICE VAULT & OUTDOOR FIBER SPLICE ENCLOSURE
HAND DIG INPLACE FIBER OPTIC CABLE AND COIL 15 m
OF CABLE IN SPLICE VAULT
- 18 INPLACE 1-FO CABLE (12MM, 18SM) & 1-12/PR NO.19
HAND DIG 1-12/PR NO.19 AND ROUTE INTO
INSTALLED 334Z CABINET

- 19 INPLACE POWER POLE
F&I WEATHER HEAD, RISER & 3-1/C NO.6
- 20 F&I 50 mm NMC & 3-1/C NO.6
- 21 F&I SERVICE FOUNDATION (SEE DETAIL & SPECIAL PROVISIONS)
- 22 F&I 50 mm HD NMC & 3-1/C NO.6
- 23 F&I HANDHOLES 1-7

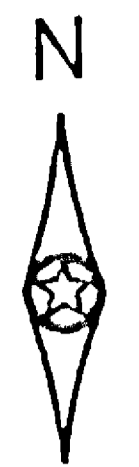


I-35W

LEXINGTON

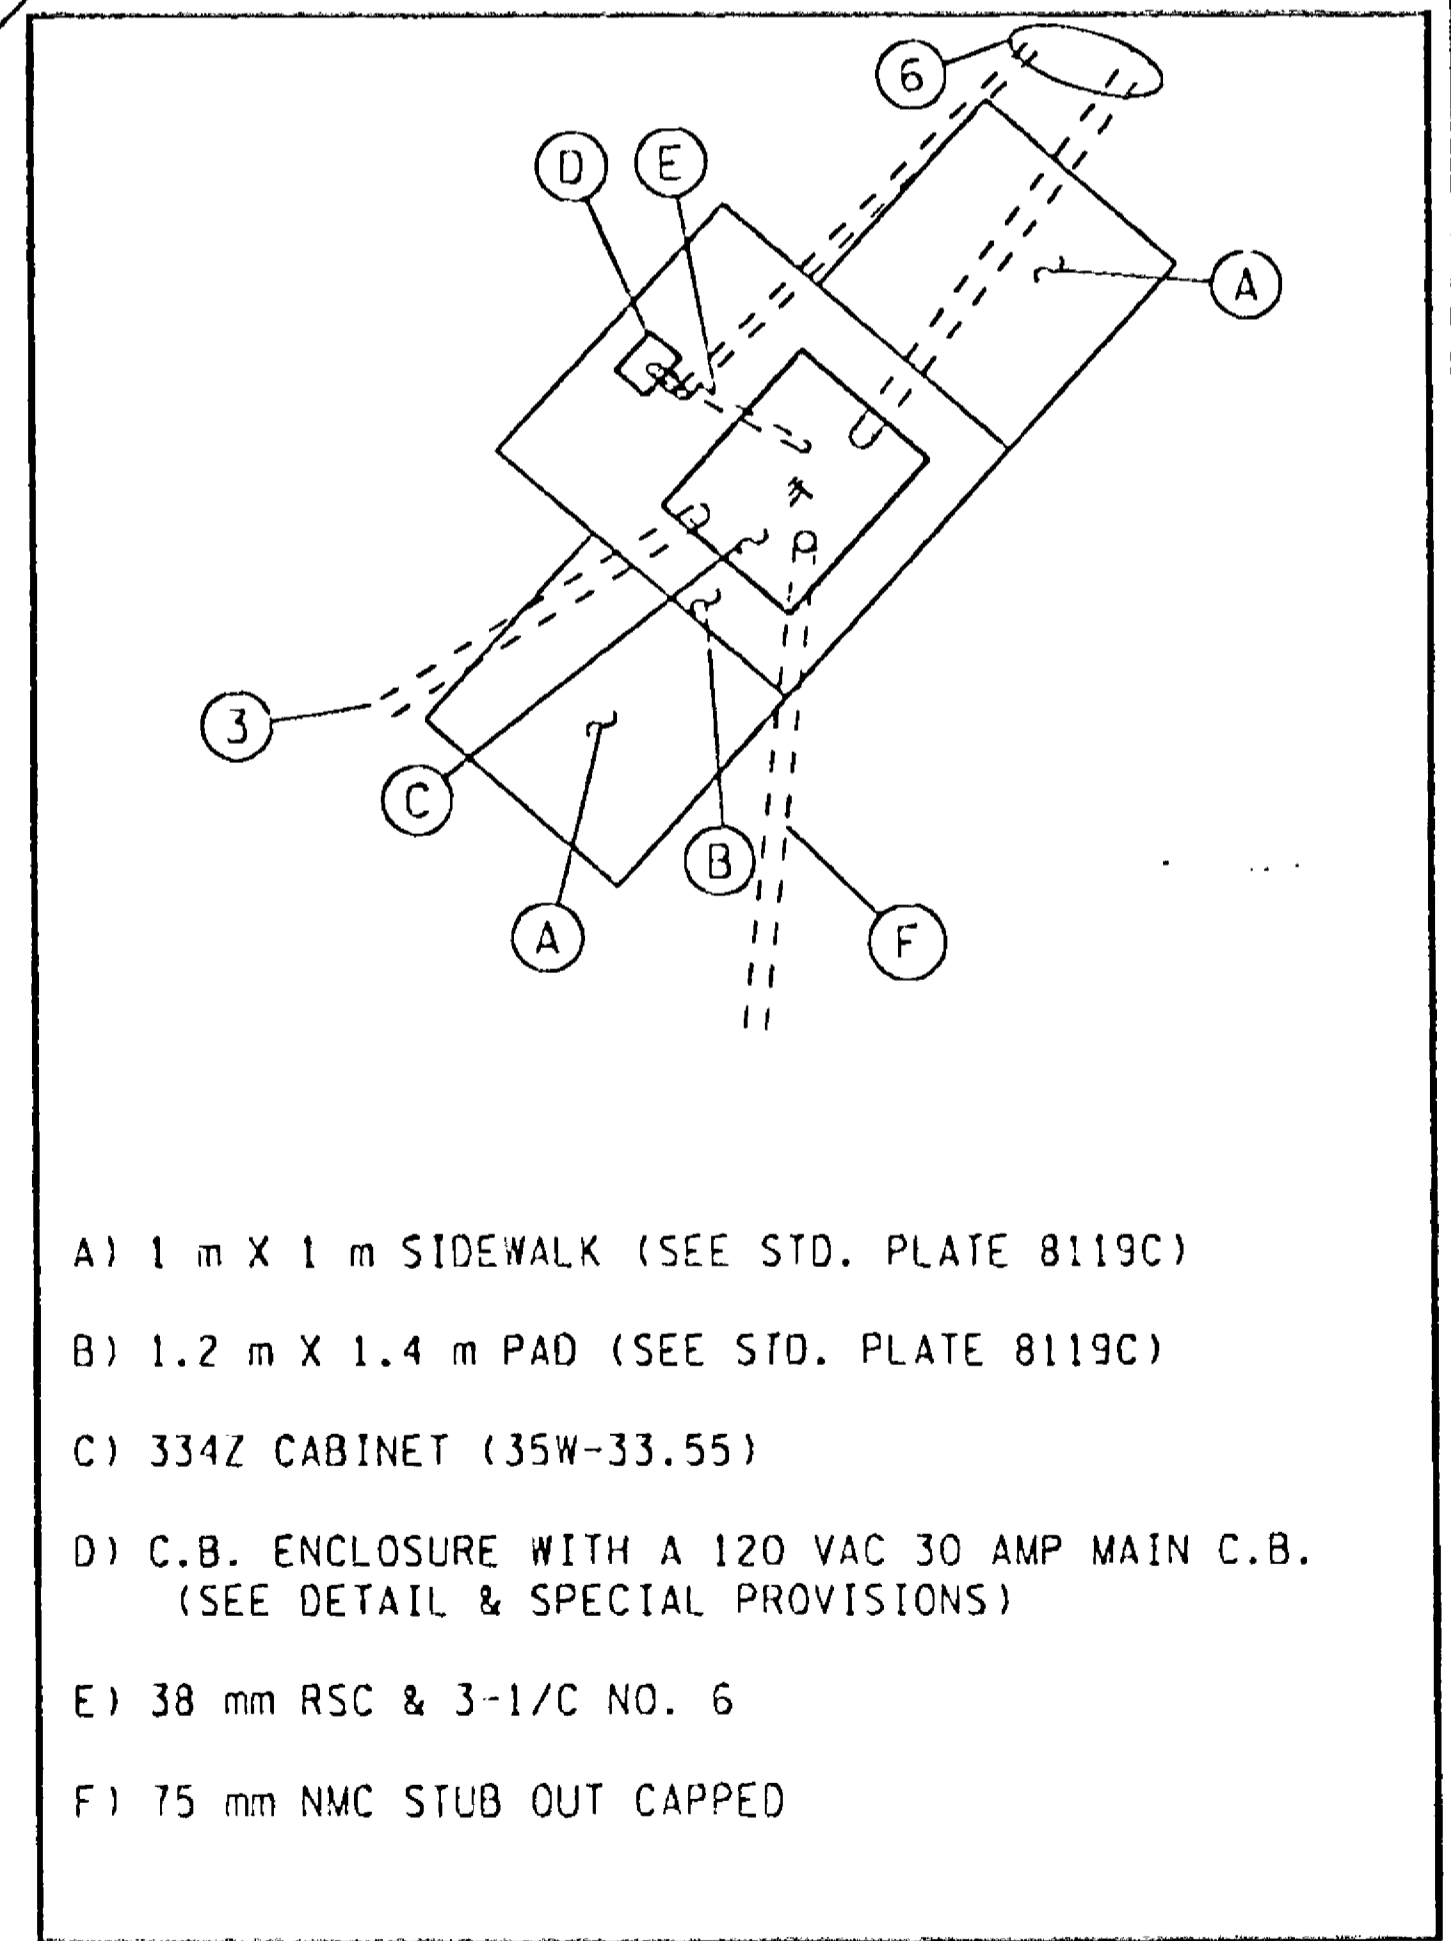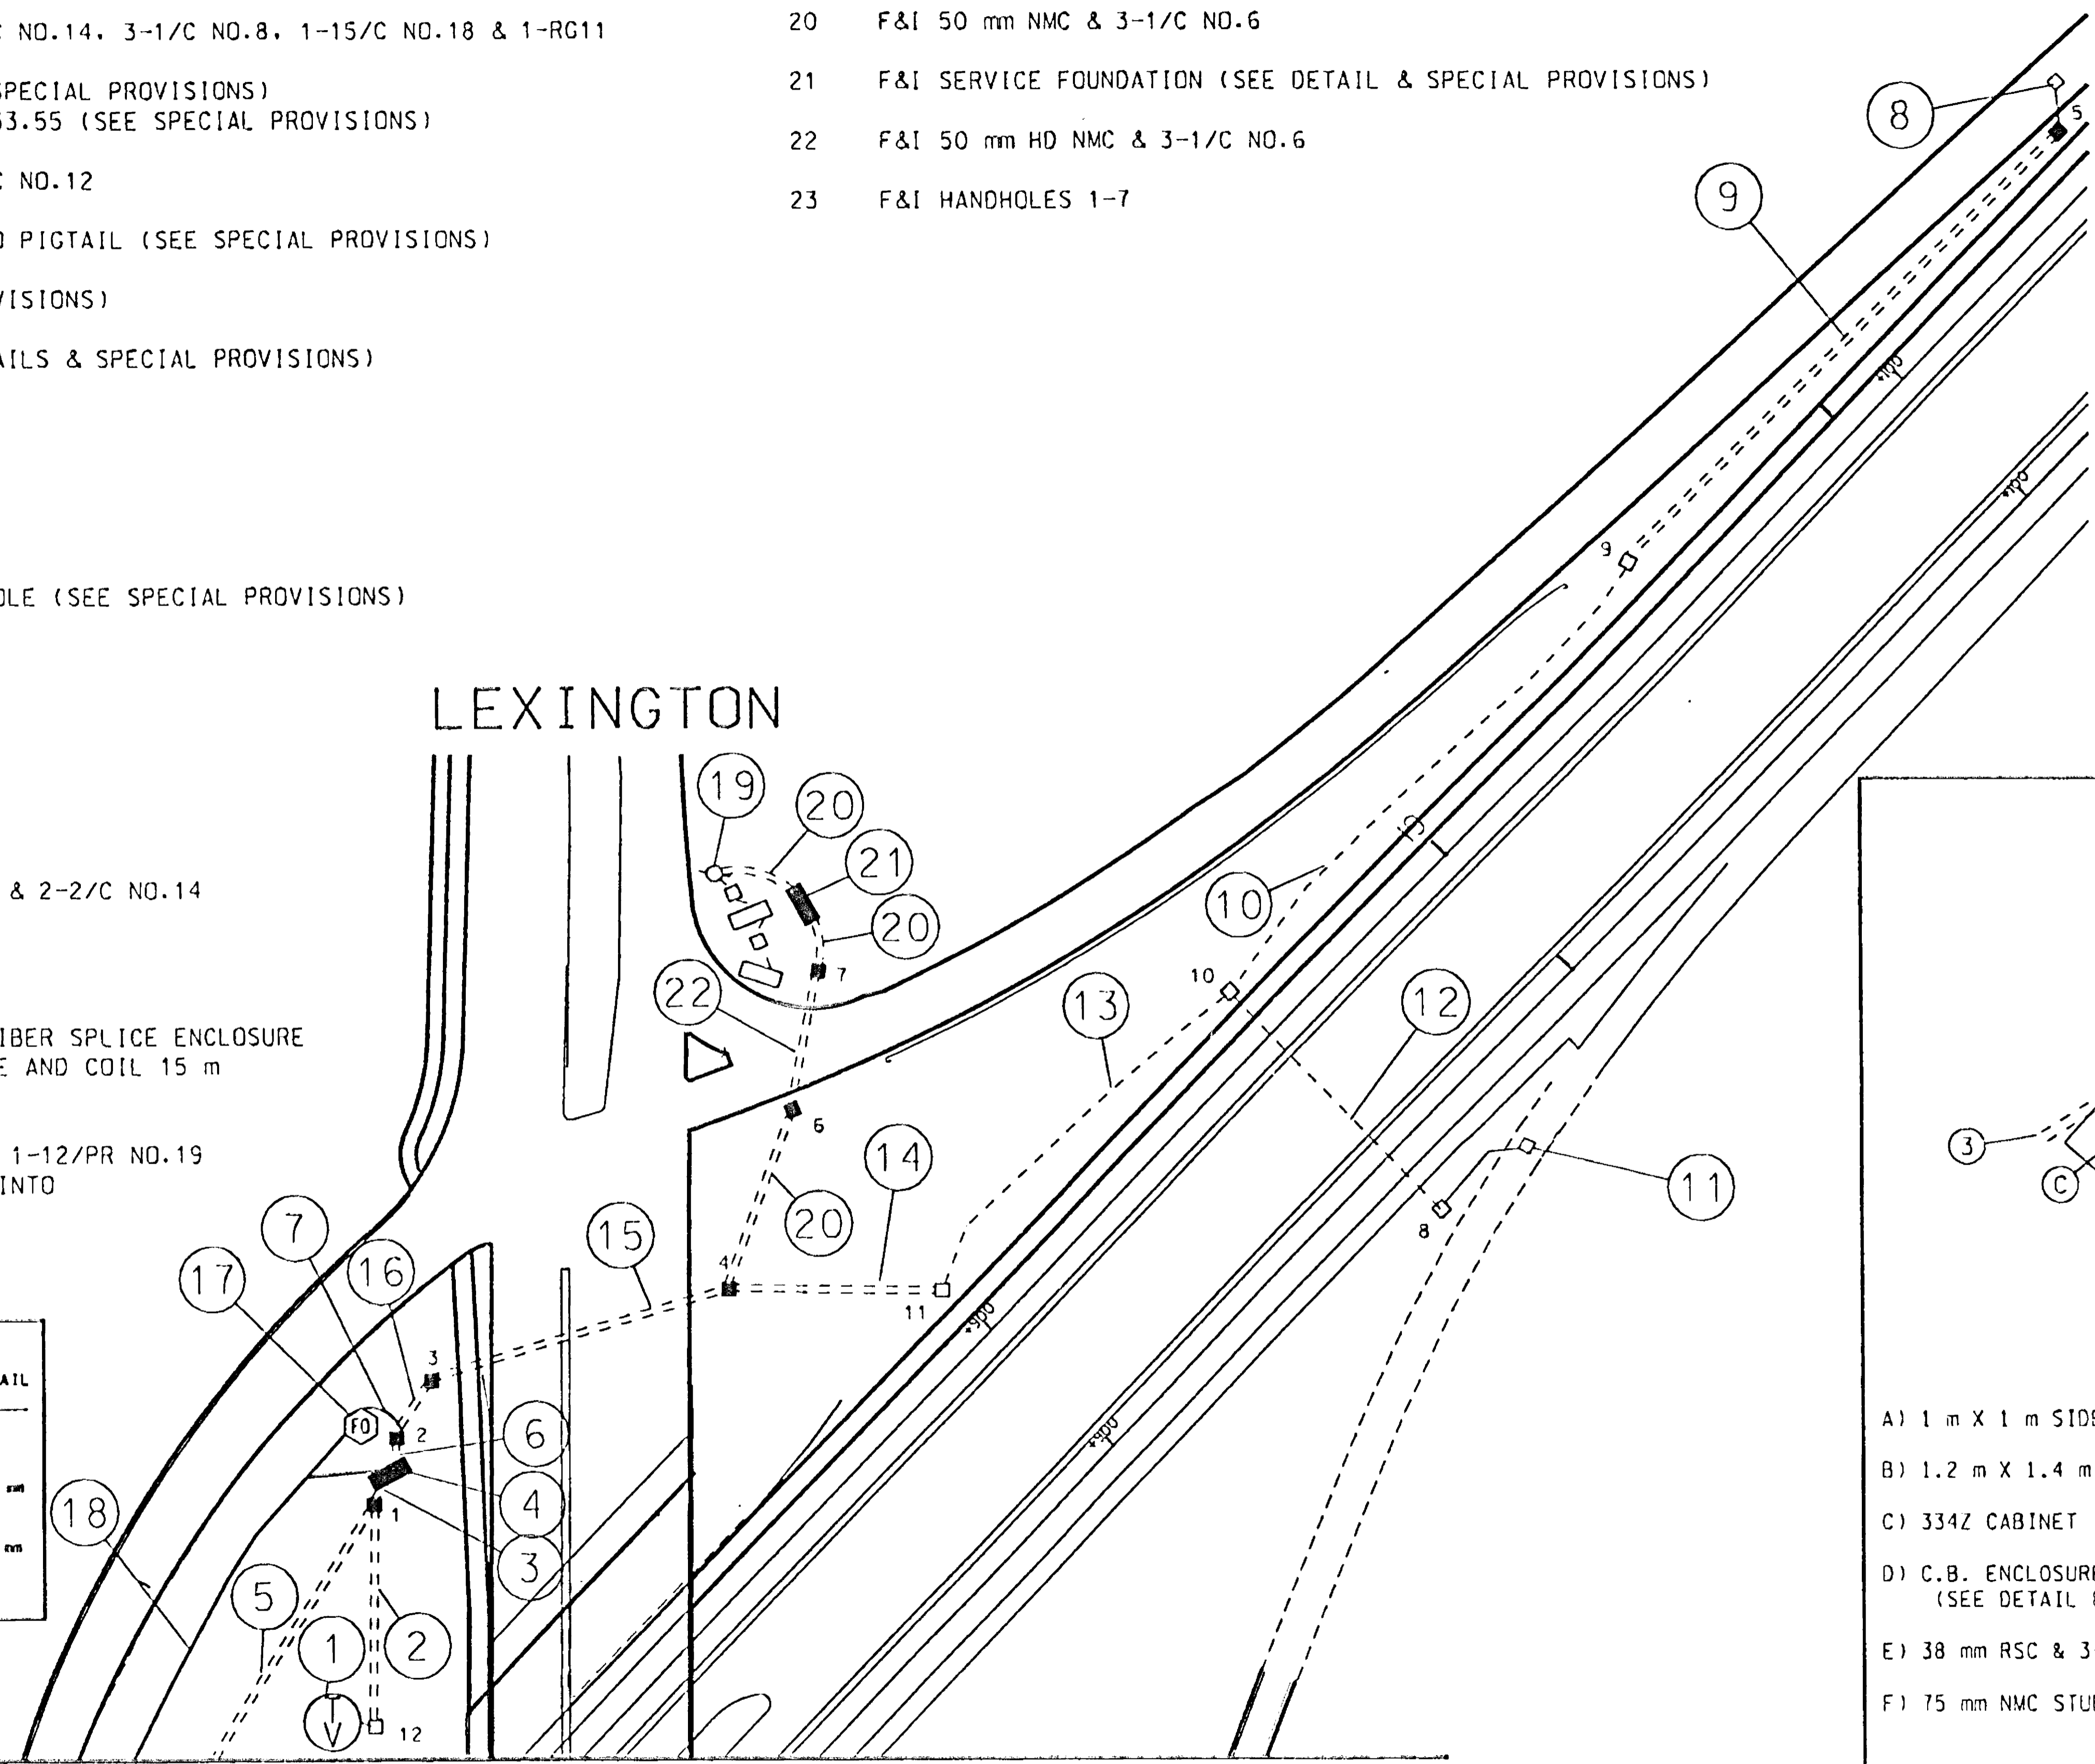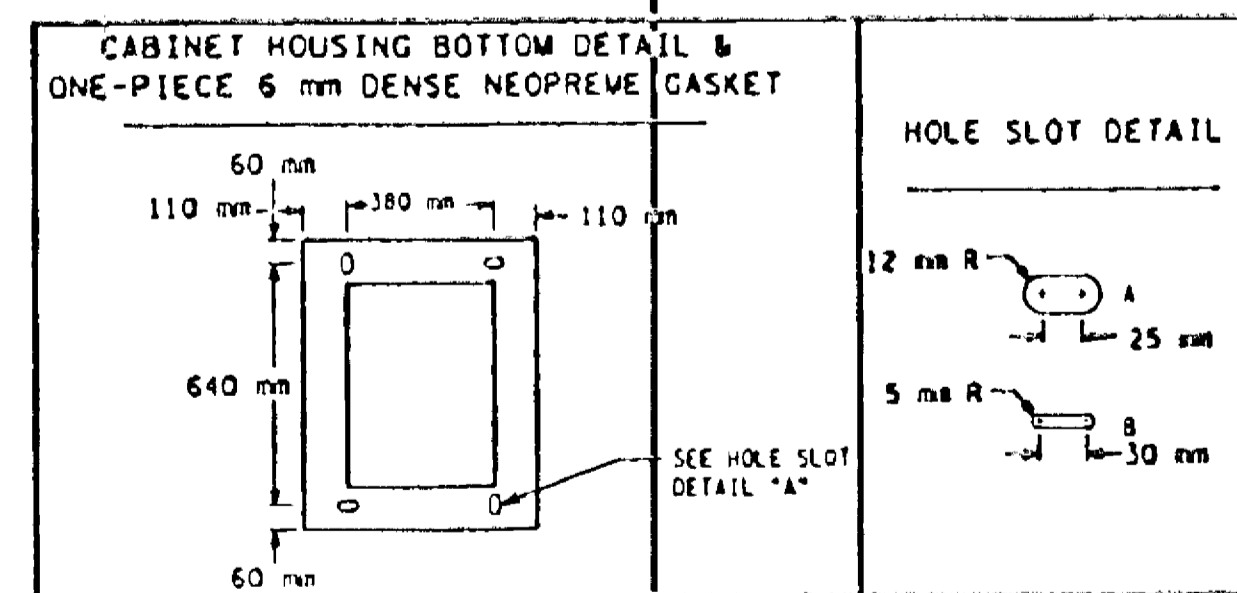

MATCH LINE A

FINAL TMS LAYOUT

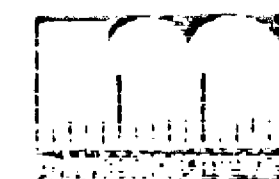


CERTIFIED BY *P.M. Bednar*
PROFESSIONAL ENGINEER

REG. NO. 18491 MAR 13 1997


STATE PROJ. NO. 02-617-11

SHEET NO. 138 OF 236 SHEETS

- 1 F&I SAWCUT LOOP DETECTOR (SEE DETAIL & SPECIAL PROVISIONS)
- 2 F&I 50 mm NMC & 1-2/C NO.14
- 3 INPLACE 50 mm NMC
F&I 1-2/C NO.14
- 4 INPLACE 50 mm RSC
F&I 3-2/C NO.14
- 5 INPLACE LOOP DETECTOR
F&I LOOP DETECTOR SPLICE IN HANDHOLE
- 6 INPLACE RAMP CONTROL SIGNALS
- 7 INPLACE 53 mm RSC, 1-5/C NO.12, 1-FO CABLE (12MM, 18SM) & 1-12/PR NO.19
- 8 F&I 75 mm NMC, 2-5/C NO.12 & 6-2/C NO.14
- 9 INPLACE 1-FO CABLE (12MM, 18SM) & 1-12/PR NO.19
- 10 F&I HANDHOLES 1 & 2

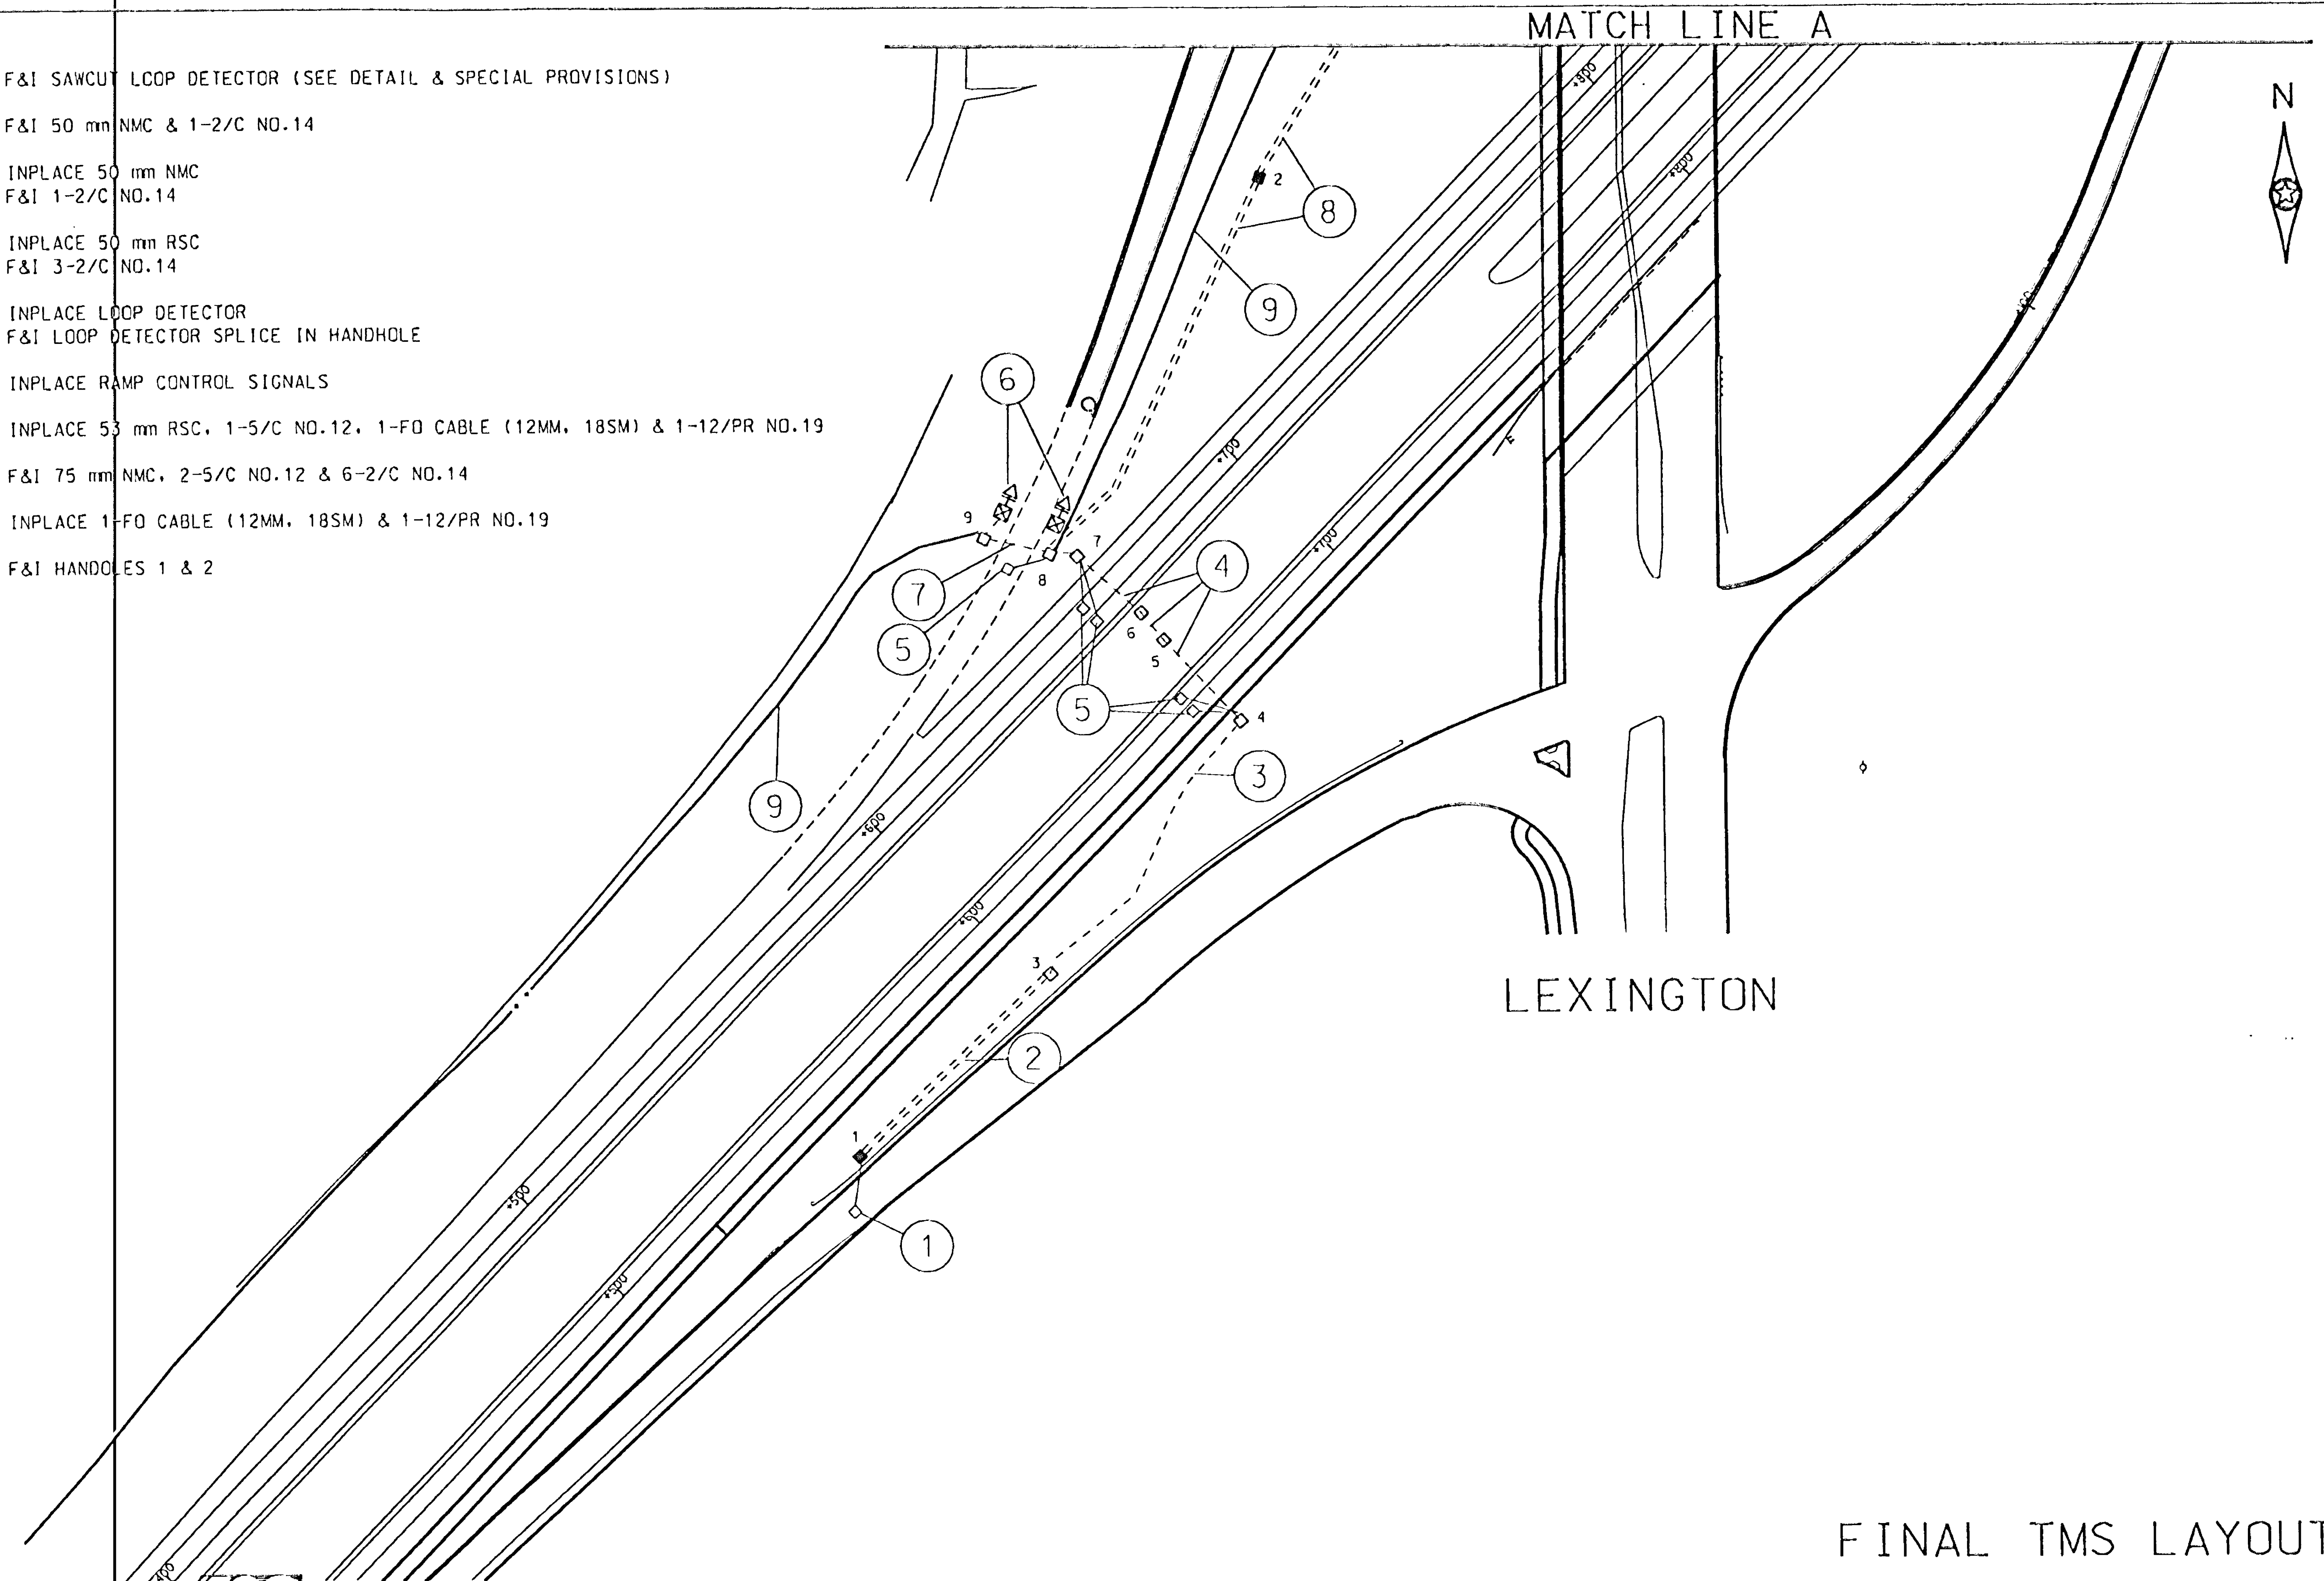

I-35W

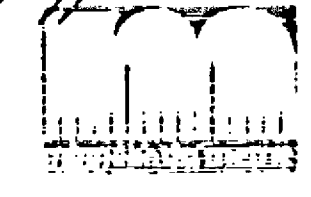



CERTIFIED BY *Paul Behrens*
PROFESSIONAL ENGINEER

REG. NO. 18491 MAR 13 1997

STATE PROJ. NO. 02-617-11

FINAL TMS LAYOUT


SHEET NO. 139 OF 236 SHEETS

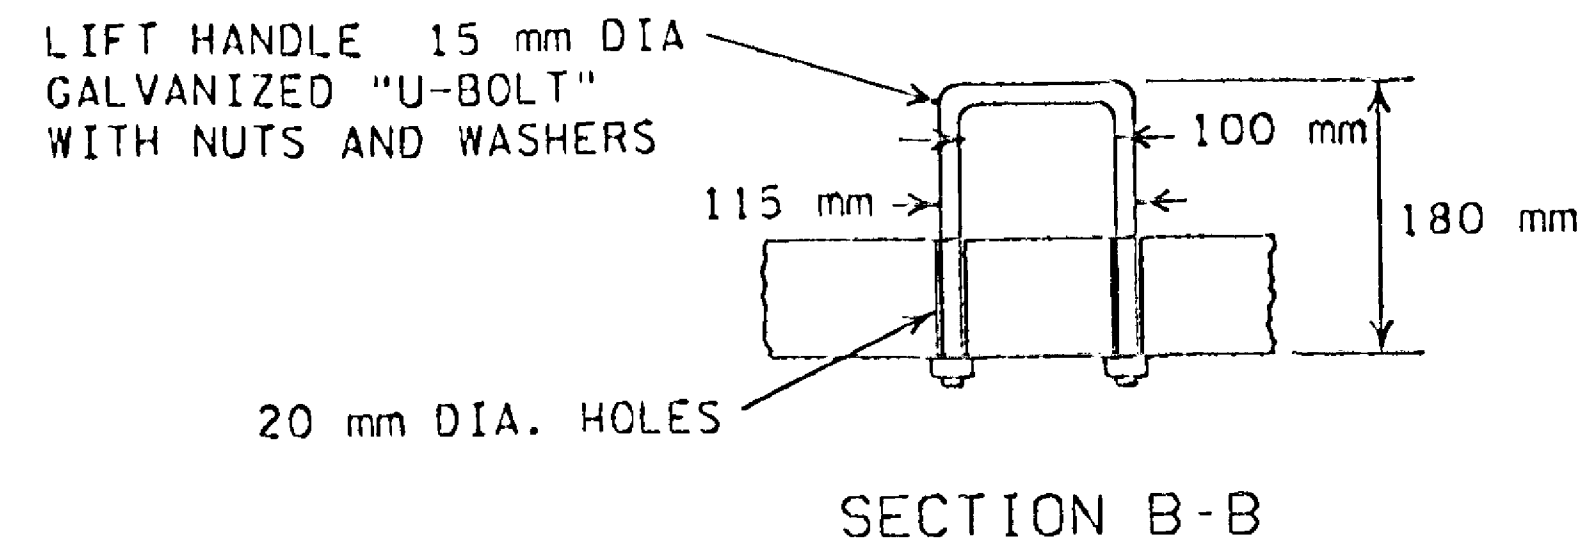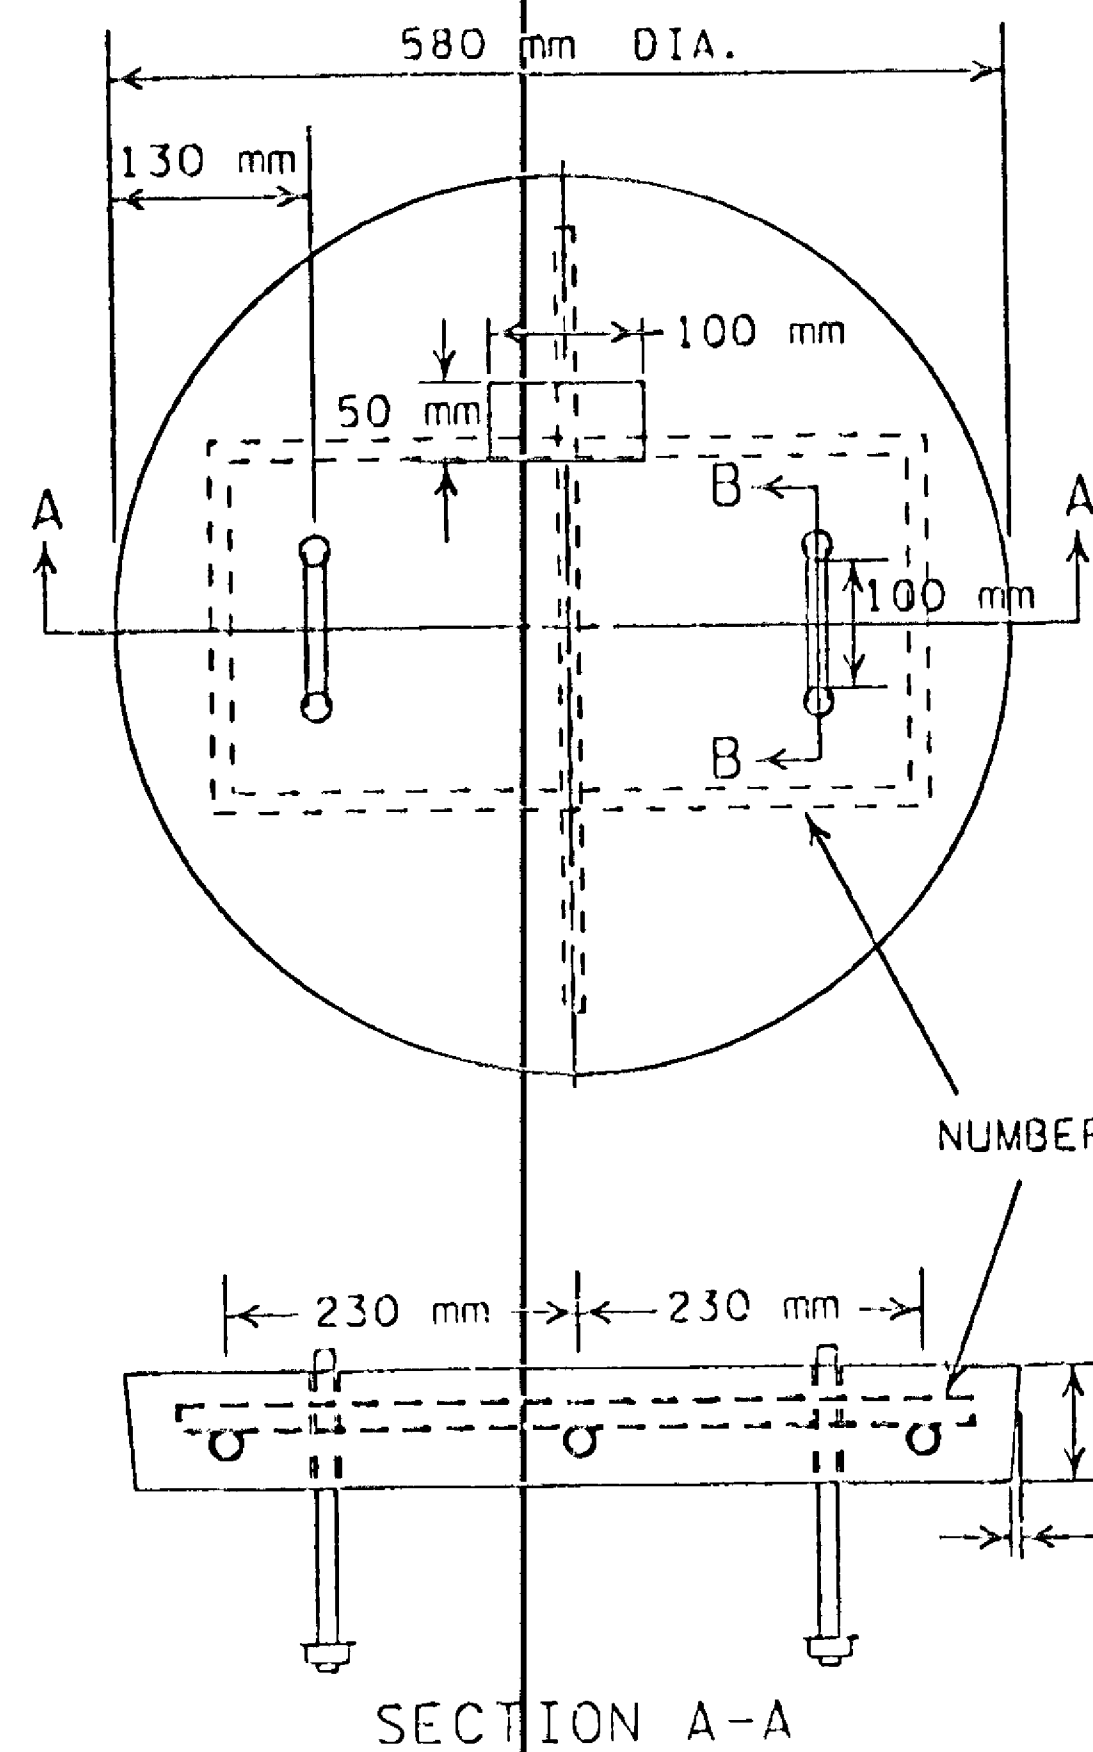


NOTES:

1. INSTALL NUMBER 3 STEEL REINFORCEMENT BARS IN 230 mm RECTANGLES, COAT THE BARS WITH EPOXY AS PER MN/DOT 3301
2. COAT THE ENTIRE COVER WITH EPOXY, AS PER MN/DOT CONCRETE MANUAL 5-694.184E, AS RECOMMENDED BY THE MANUFACTURER.
3. USE 3U32 CONCRETE AS PER MN/DOT 2461.
4. EMBOSS THE CONCRETE COVER WITH "TMS" IN 50 mm LETTERS 5 mm DEEP.

CONCRETE COVER

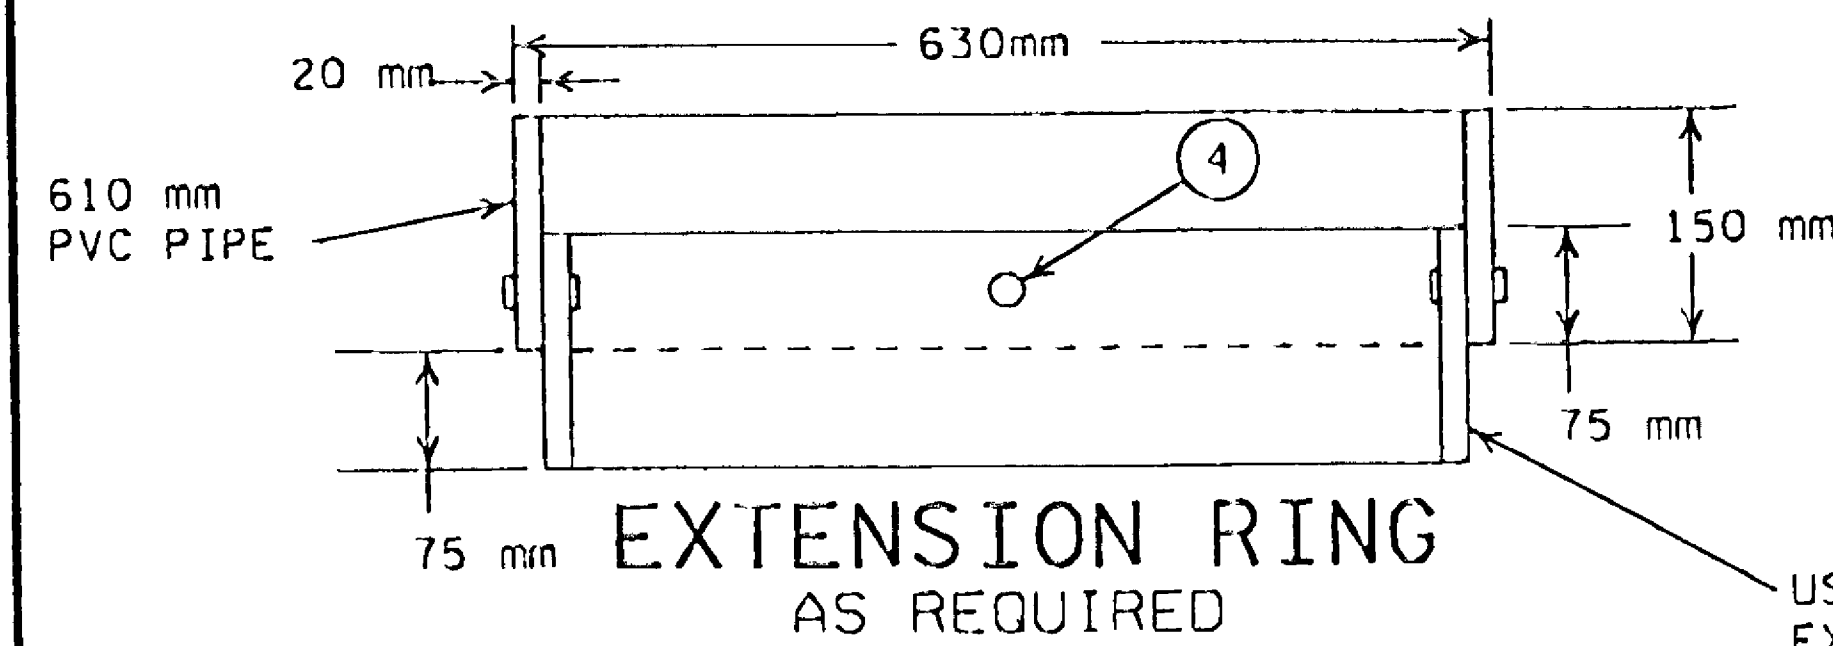


USE APPROVED P.V.C. GLUE TO ATTACH EXTENSION RING TO HANDHOLE

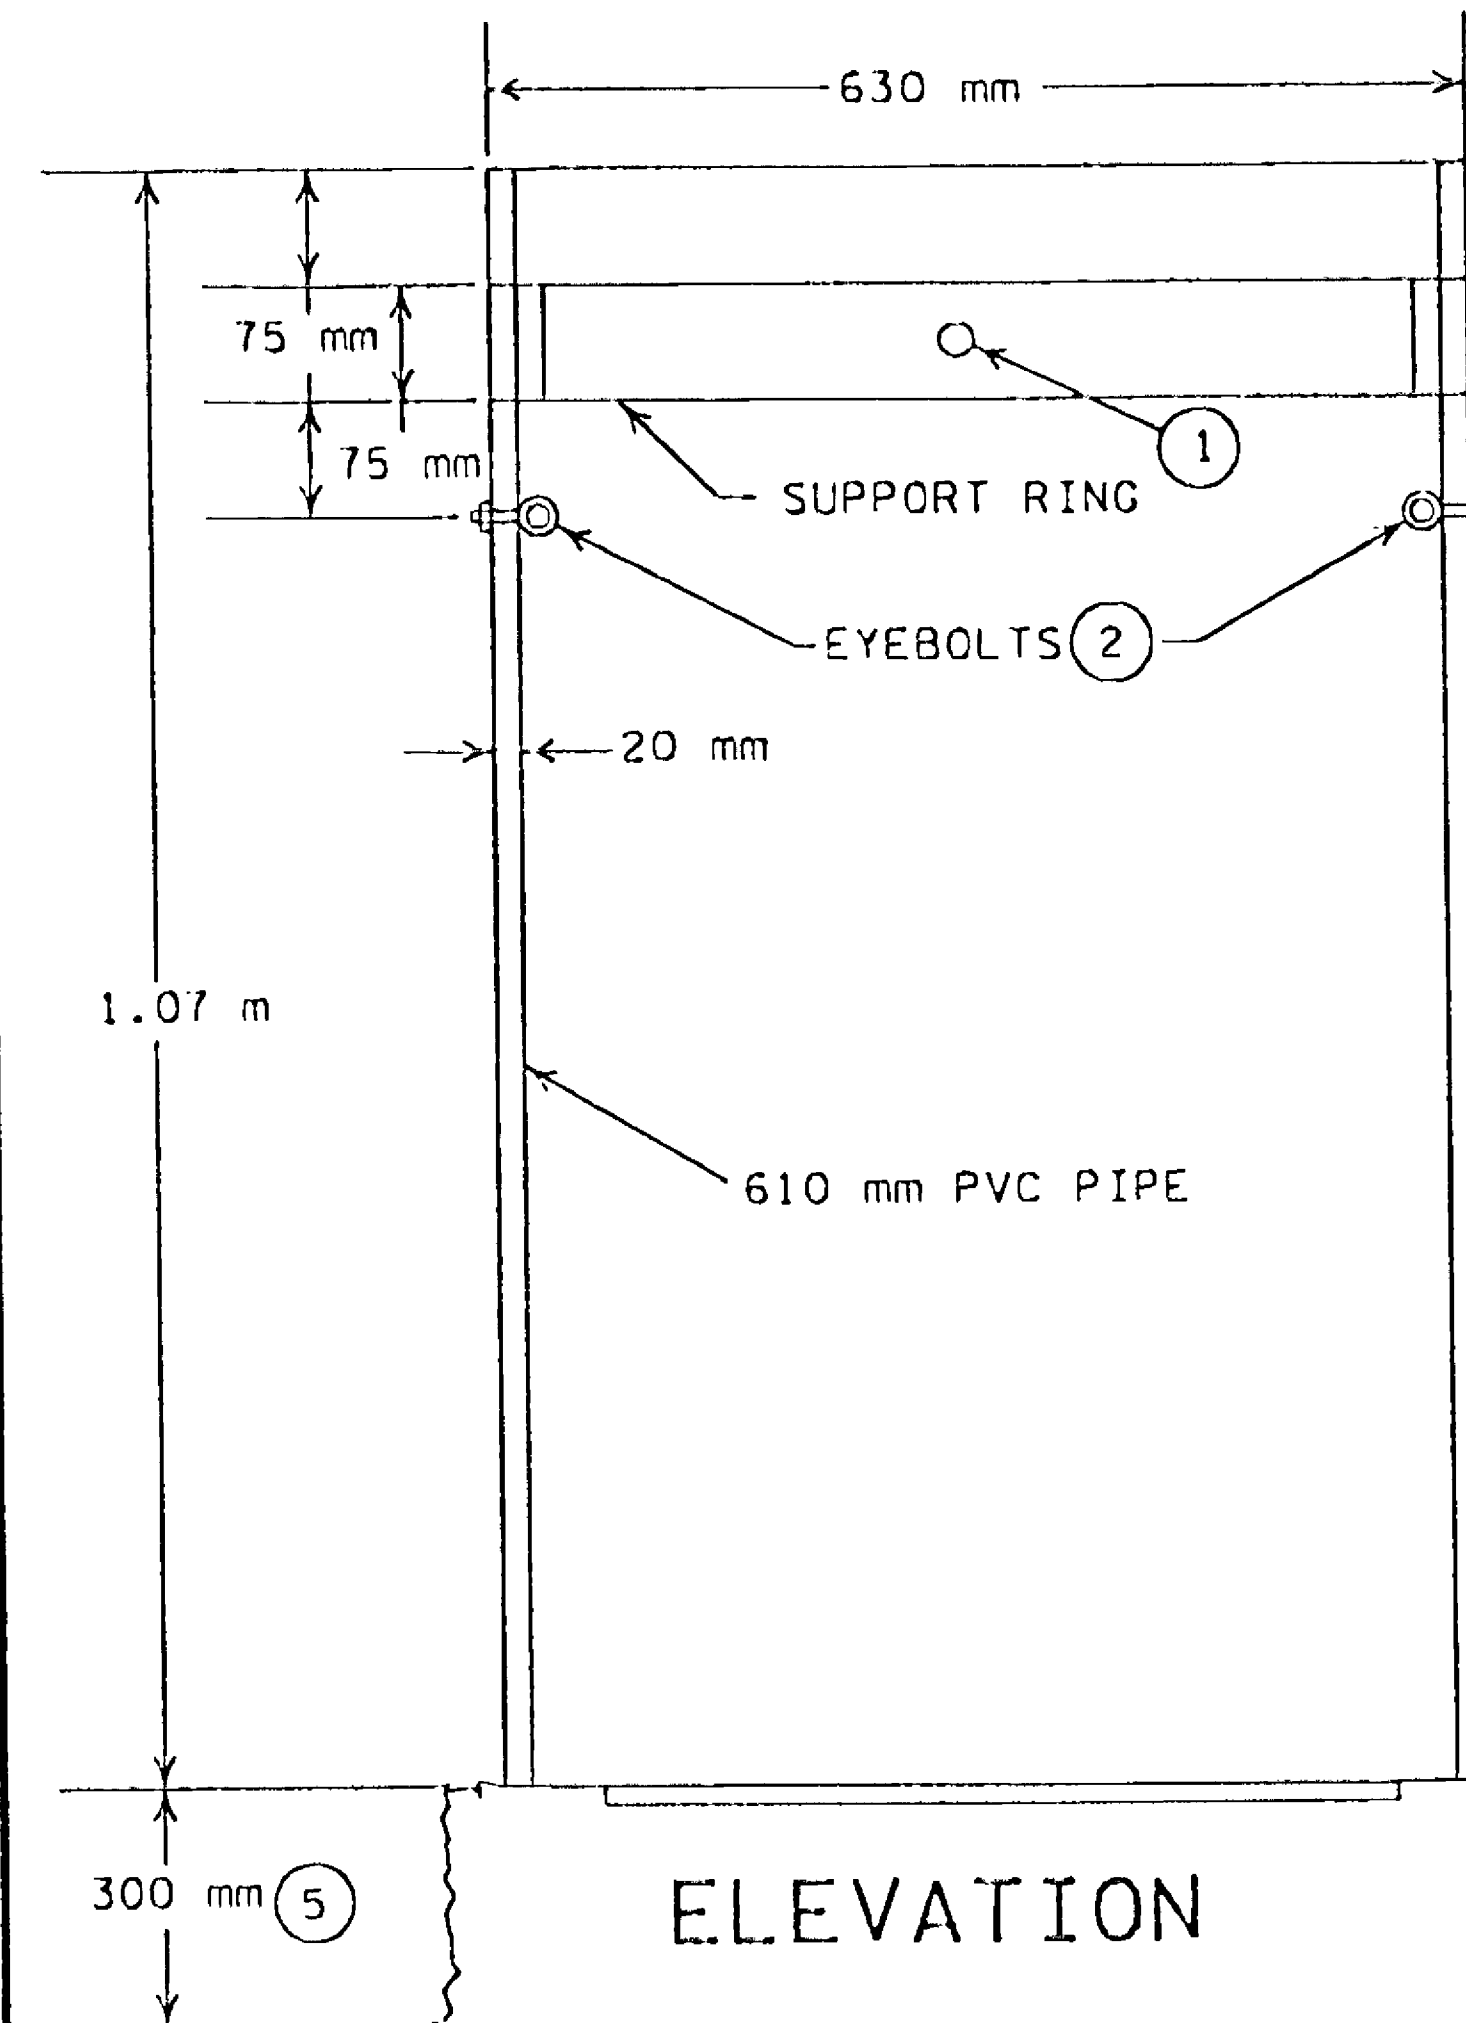


- ① ATTACH SPLIT 610 mm DIA. P.V.C. COVER SUPPORT RING WITH FOUR 10mm DIA. X 50 mm LONG BOLTS AND NUTS AT 90° APART.
- ② TWO TYPE 2 SHOULDER EYEBOLTS, 10 mm DIA. X 30 mm SHANK LENGTH, WITH HEX. NUTS AT 180° APART (FOR LIFTING HANDHOLES AND SUPPORTING ELECTRICAL CABLES).
- ③ FOUR 6.4 mm X 30 mm LONG GALVANIZED LAG SCREWS.
- ④ ATTACH SPLIT 610 mm DIA. PVC EXTENSION RING WITH FOUR 10 mm DIA. X 50mm LONG BOLTS AT 90° APART. THE BOLTS & NUTS COMPLY WITH MN/DOT 3392.2E, THE OTHER HARDWARE WITH 3392.
- ⑤ COMPACT AGGREGATE, COMPLYING WITH MN/DOT 3149.2H, TO A 300 mm DEPTH.
- 6 CONDUIT ENTRANCES IN THE BARREL ARE SIZED 25 mm LARGER THAN THE CONDUIT USED.
- 7 AFTER HANDHOLE AND CONDUIT INSTALLATION, SEAL ALL INSIDE WALLS WATER TIGHT.
- 8 THE PVC PIPE COMPLIES WITH ASTM F679T-1.

ELEVATION

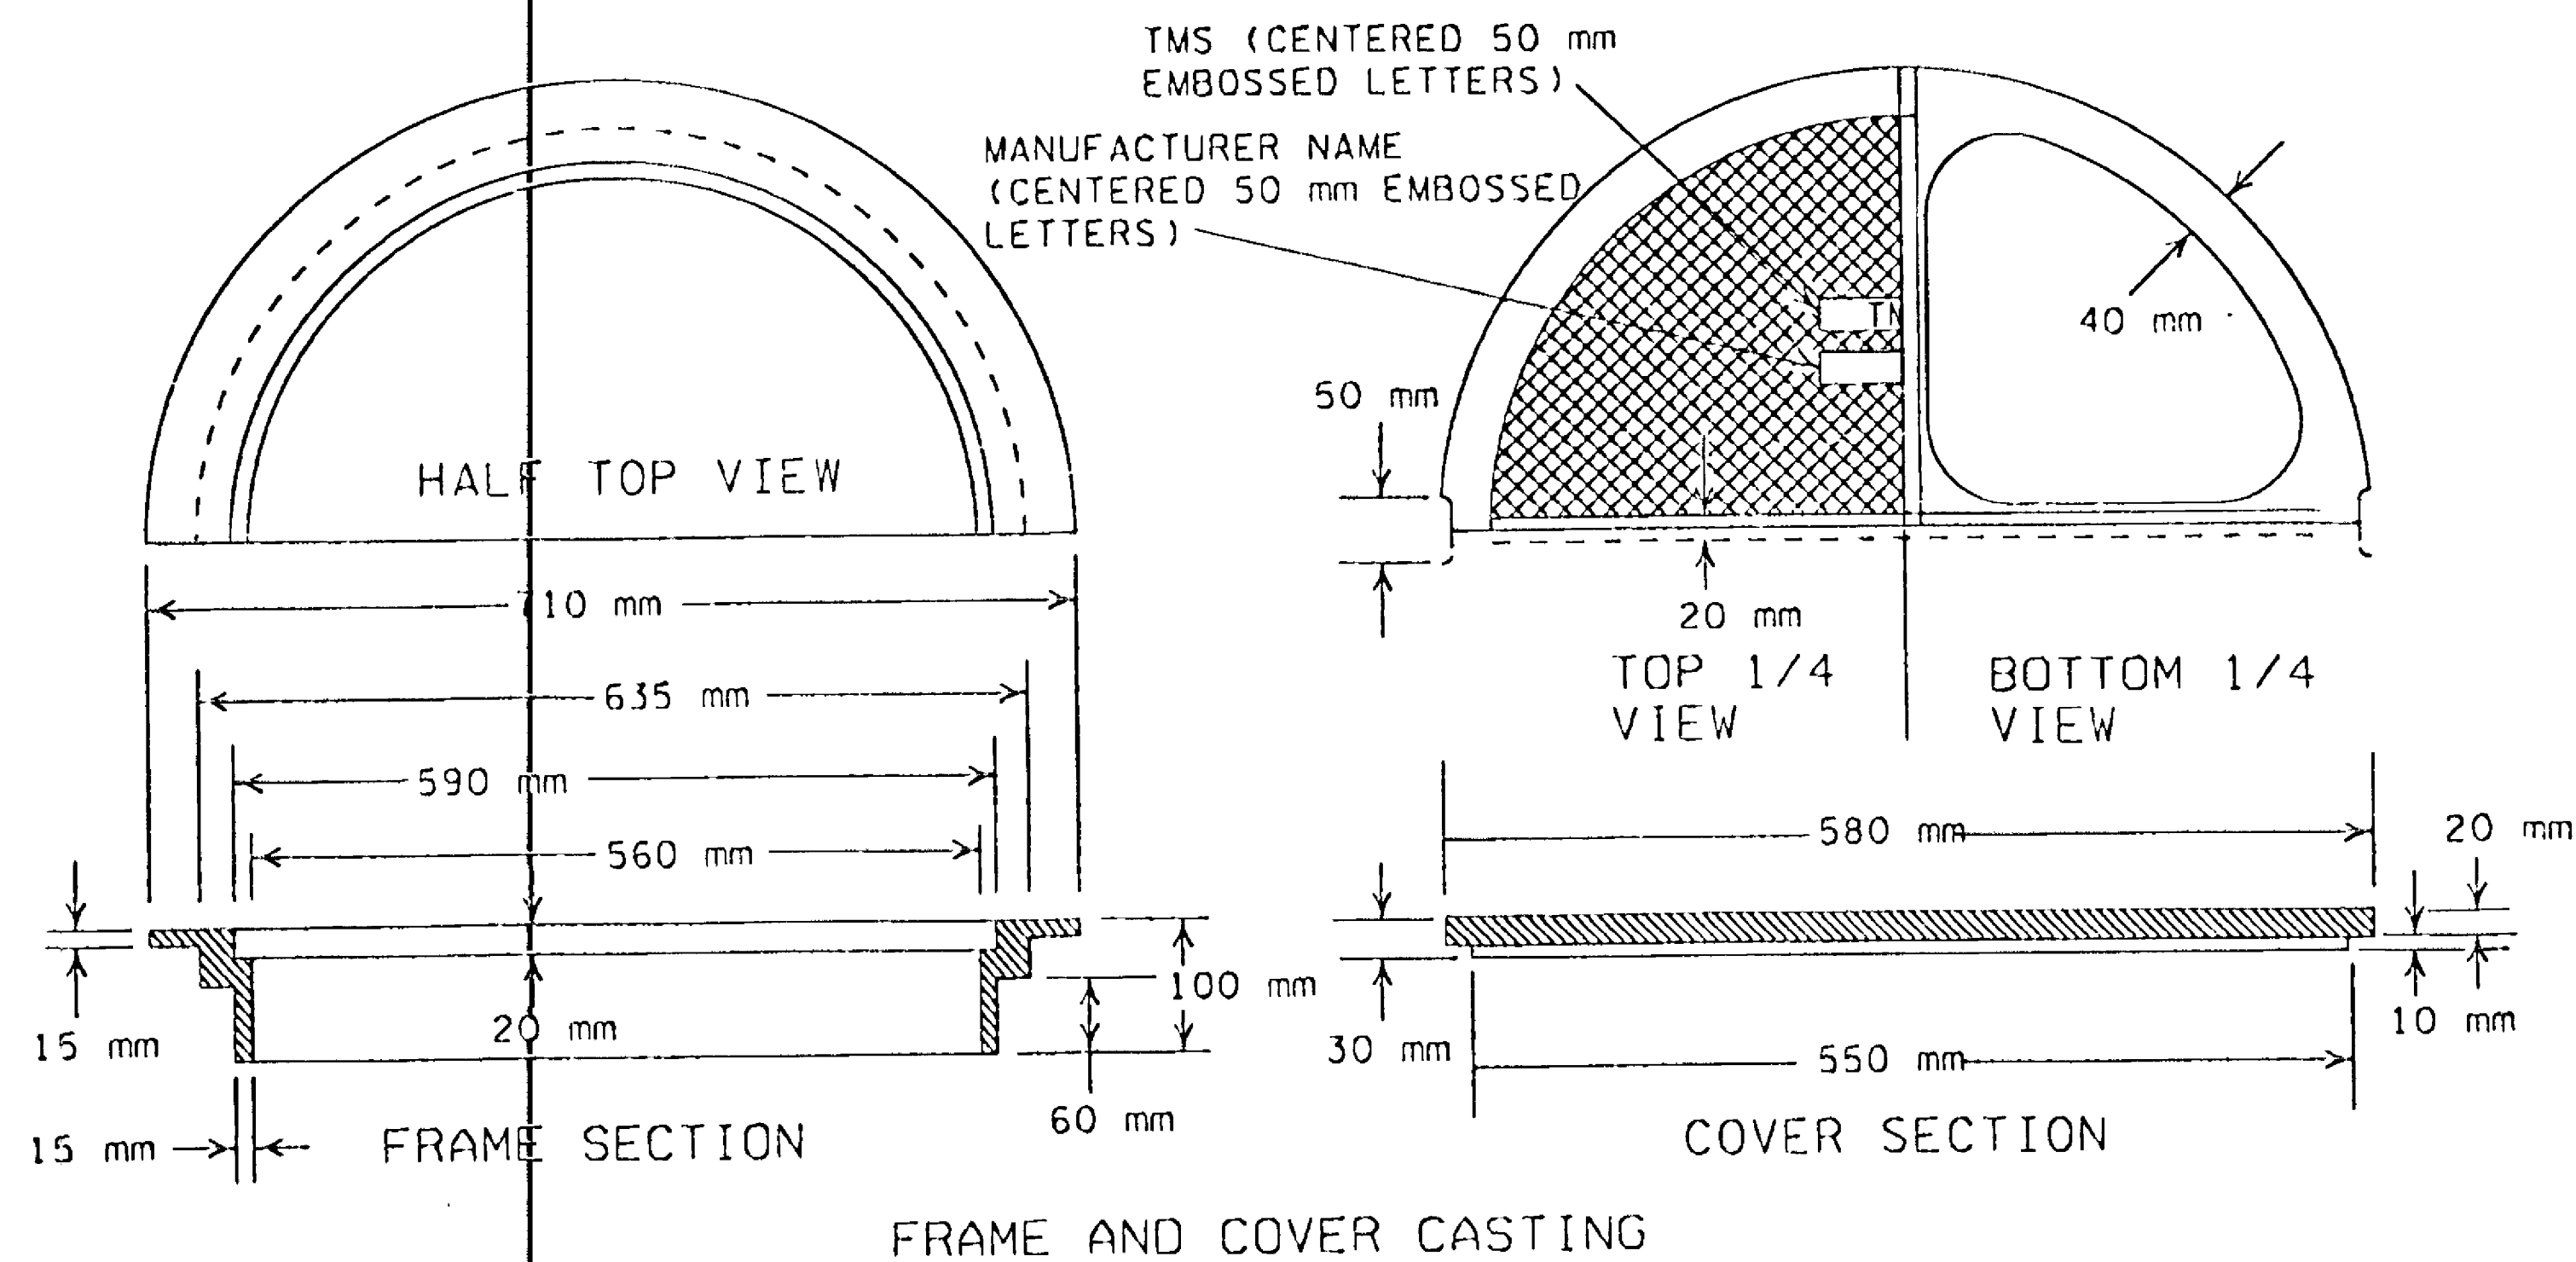

NOTE:
ALL CASTINGS ARE GRAY IRON PER
MN/DOT SPEC. 3321 CLASS 35B

LIGHT DUTY METAL COVER

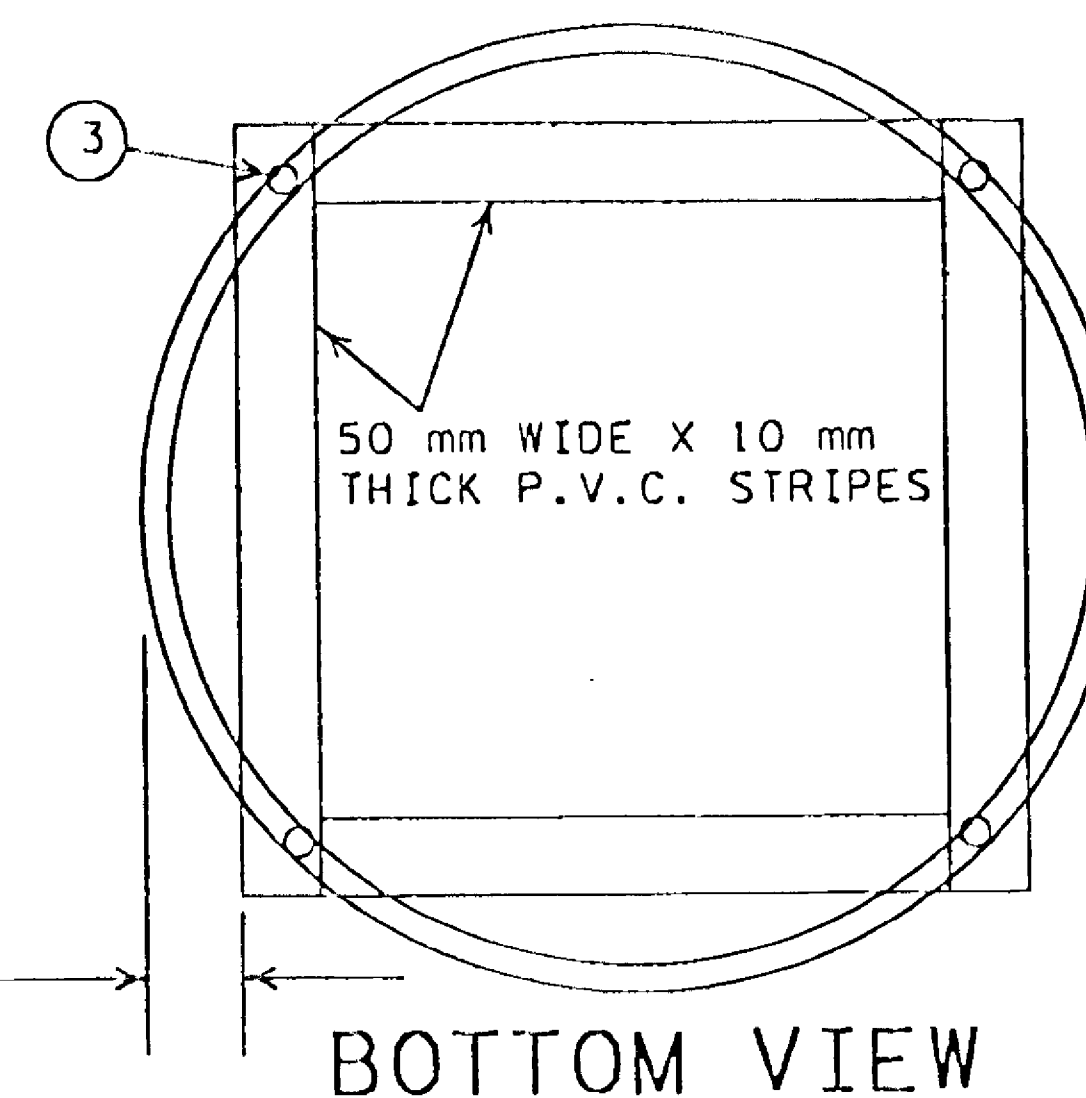

HANDHOLE DETAIL

CERTIFIED BY



P. M. Beland
PROFESSIONAL ENGINEER

REG. NO. 18491 MAR 13 1997

STATE PROJ. NO. 02-617-11

SHEET NO. 140 OF 236 SHEETS

FIBER OPTIC SPLICE VAULT

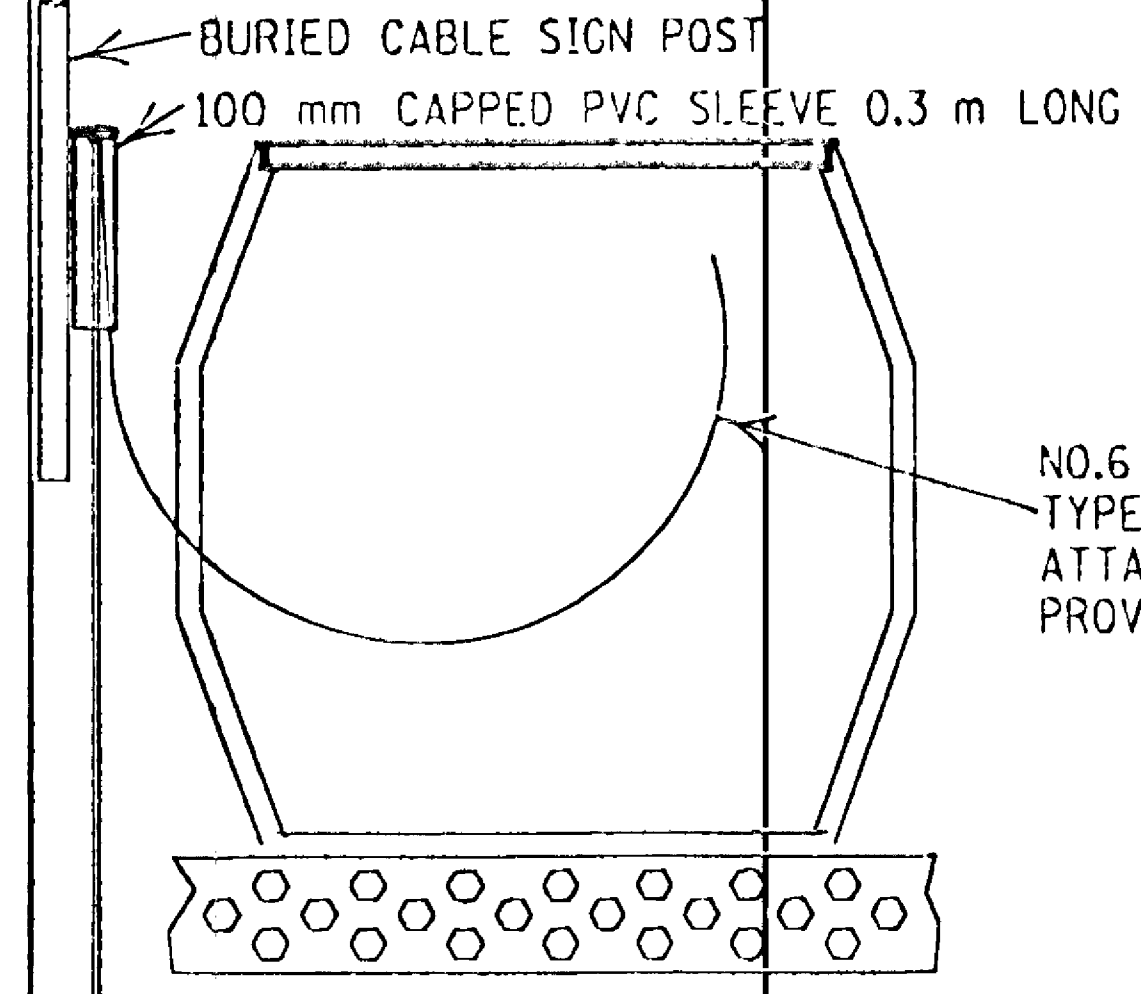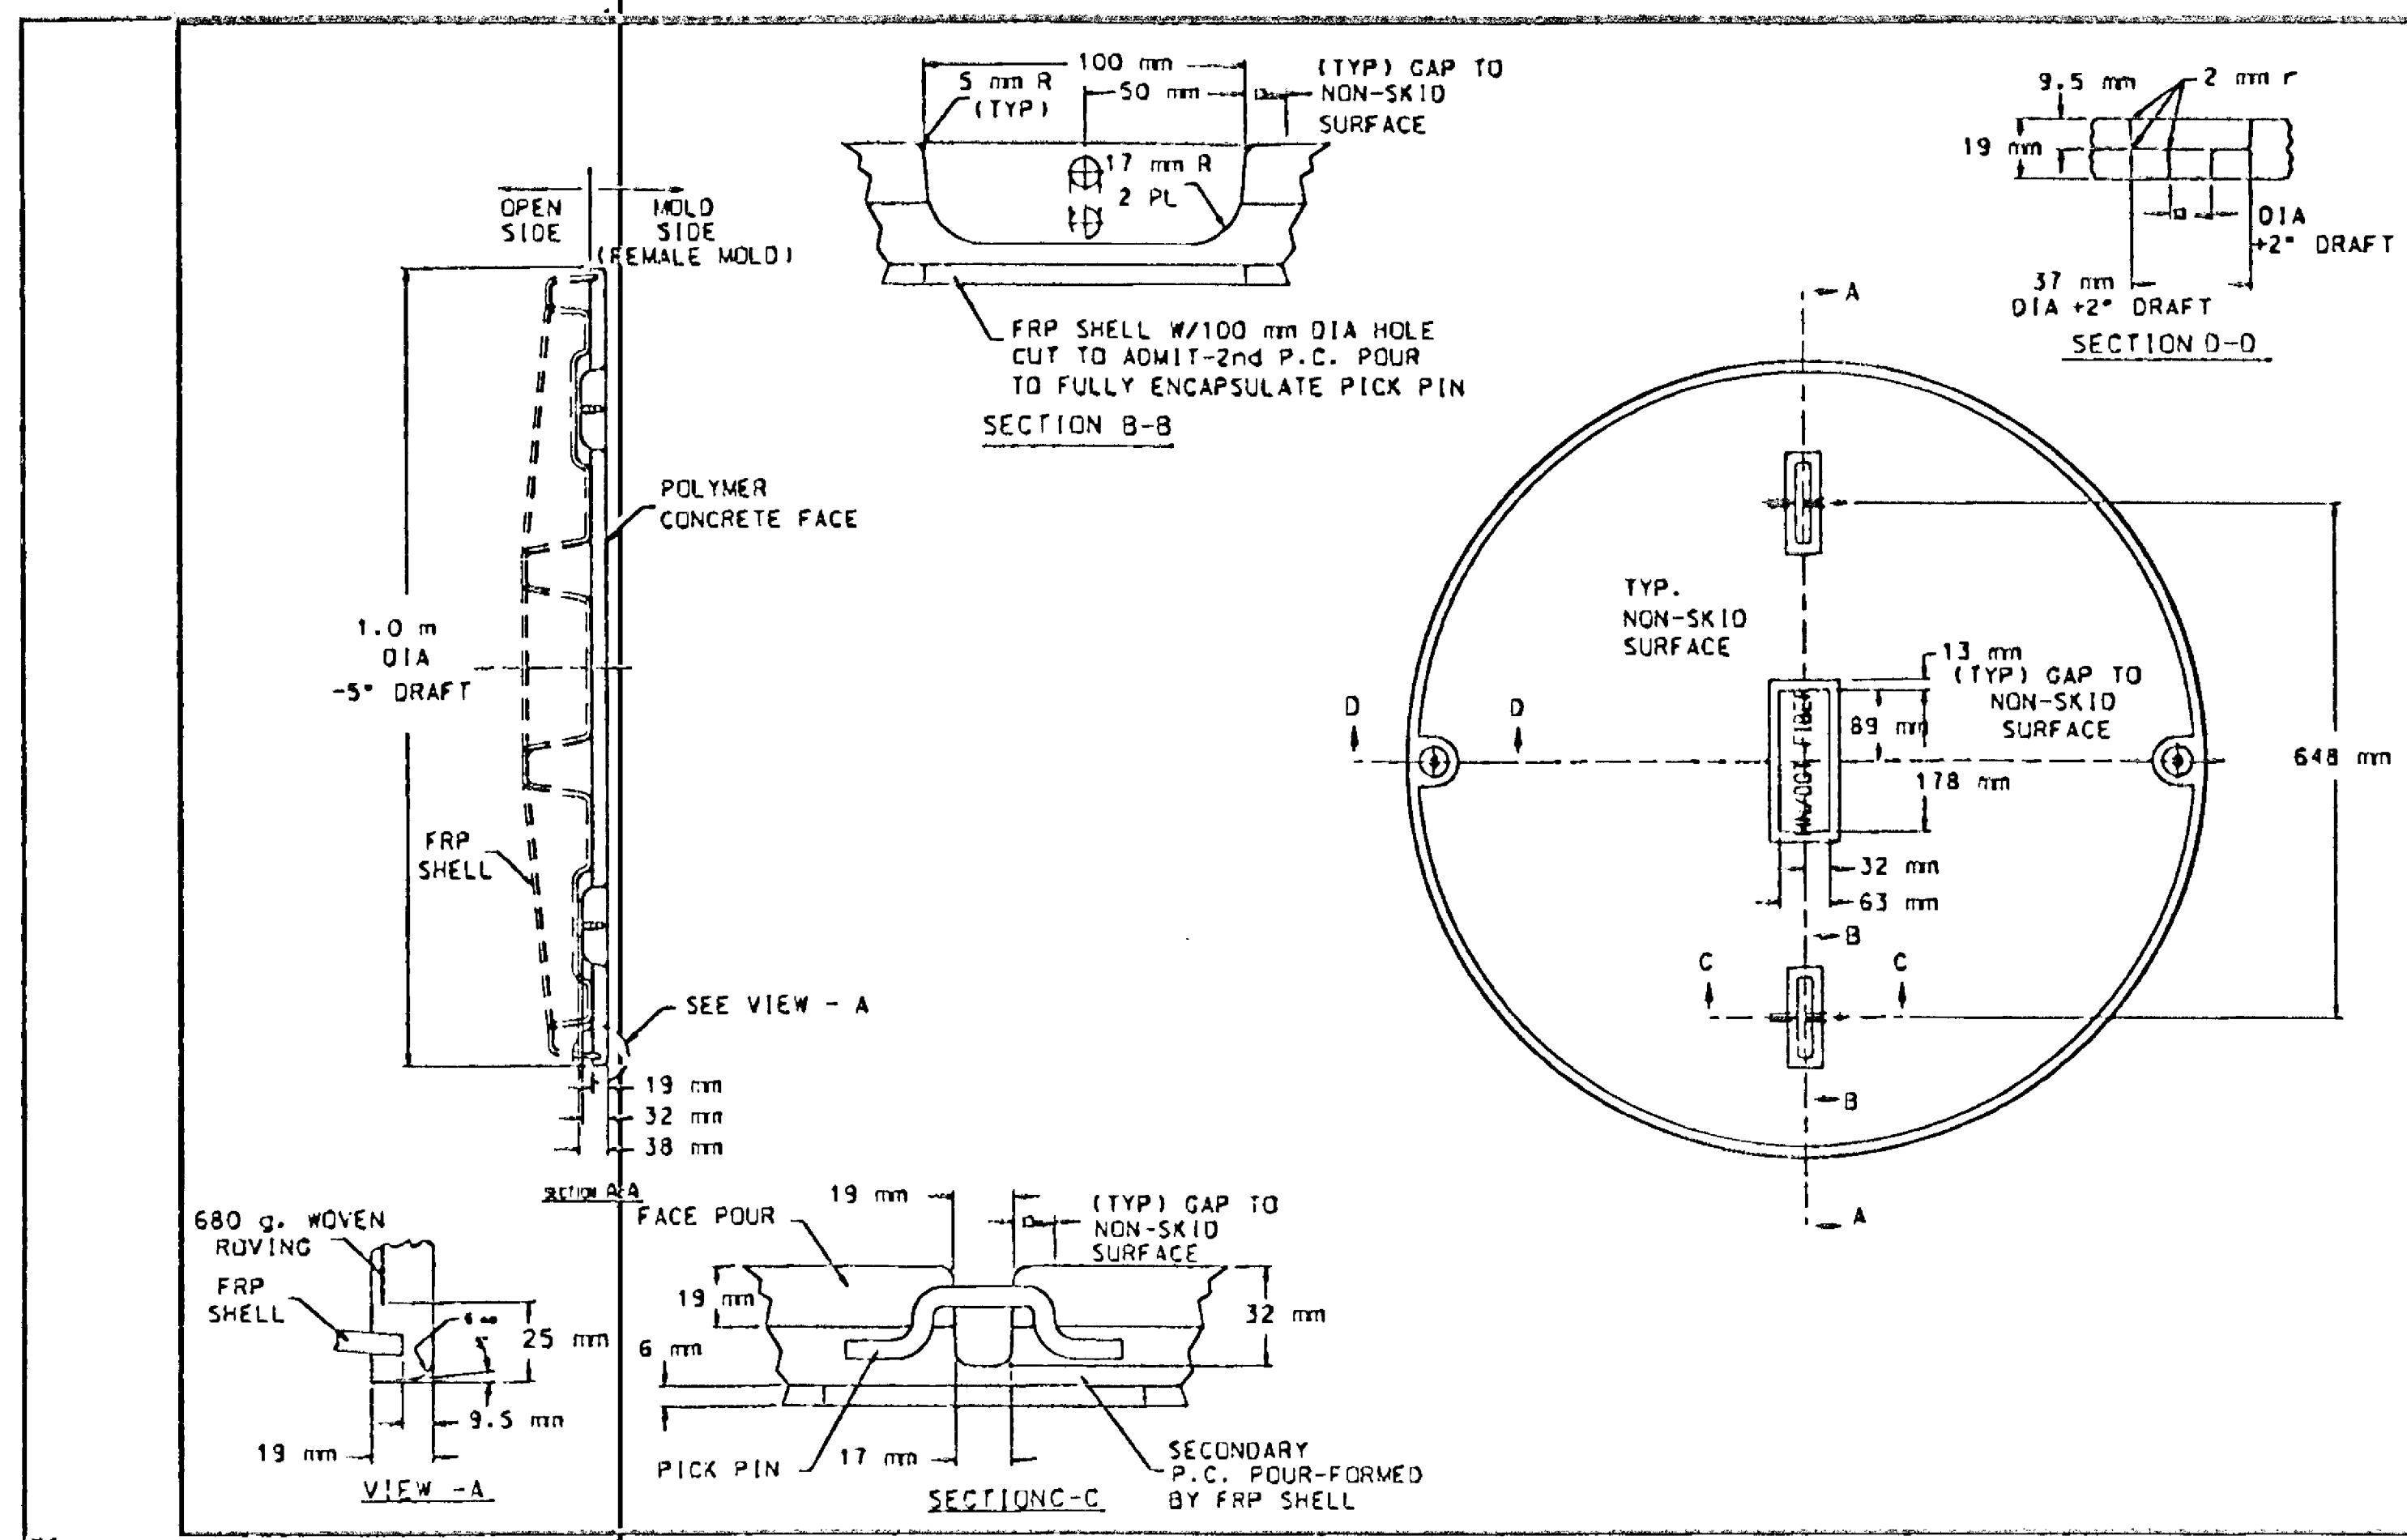

NO.6 AWG GREEN INSULATED TYPE USE-2 RATED WIRE ATTACHED TO GROUNDING PROVISION ON SPLICE ENCLOSURE

5 m GROUND ROD INSTALLED IN ACCORDANCE TO MN/DOT 2565.3J

GENERAL NOTES

1. CONDUITS SHALL BE SEALED WITH MATERIAL COMPATIBLE SEALANT.
2. GROUND CONNECTIONS SHALL BE COATED WITH OXIDATION PROHIBITING COMPOUND.
3. CABLE SHALL ENTER BELOW THE SUPPORT BRACKETS WITH 16 m OF EXTRA CABLE FOR EACH CABLE COILED AROUND INSIDE OF SUPPORT BRACKETS
4. SEE SPECIAL PROVISIONS
5. DRAWING NOT TO SCALE.

THE FRAME AND LID OF THE VAULT SHALL BE IN ACCORDANCE WITH AASHTO LOAD RATING H-10


INSTALL 0.3 m AGGREGATE BASE UNDER VAULT IN ACCORDANCE WITH MN/DOT 3129.2J

CABLES SHALL BE CUT TO THE SAME LENGTH AND SPLICED. SPLICE SHALL BE ENCAPSULATED WITH RE-ENTERABLE COMPOUND IN A PRESSURIZED ENCLOSURE.

PROVIDE MOUNTING ANGLES & 1 m CHANNEL FOR ATTACHING OUTDOOR FIBER SPLICE ENCLOSURE TO SIDE WALL

COVER FEATURES

- * WHEEL LOAD : H-10 LBS. ULTIMATE
- * APPROX WT. : 68 kg
- * TWO SS BOLTS ENGAGING FLOATING NUTS. 9.5 mm -16 X 90 mm LONG
- * POLYMER CONCRETE/FRP CONSTRUCTION
- * IDENTIFICATION/LOGO: Mn/DOT FIBER
- * NON-SKID SURFACE

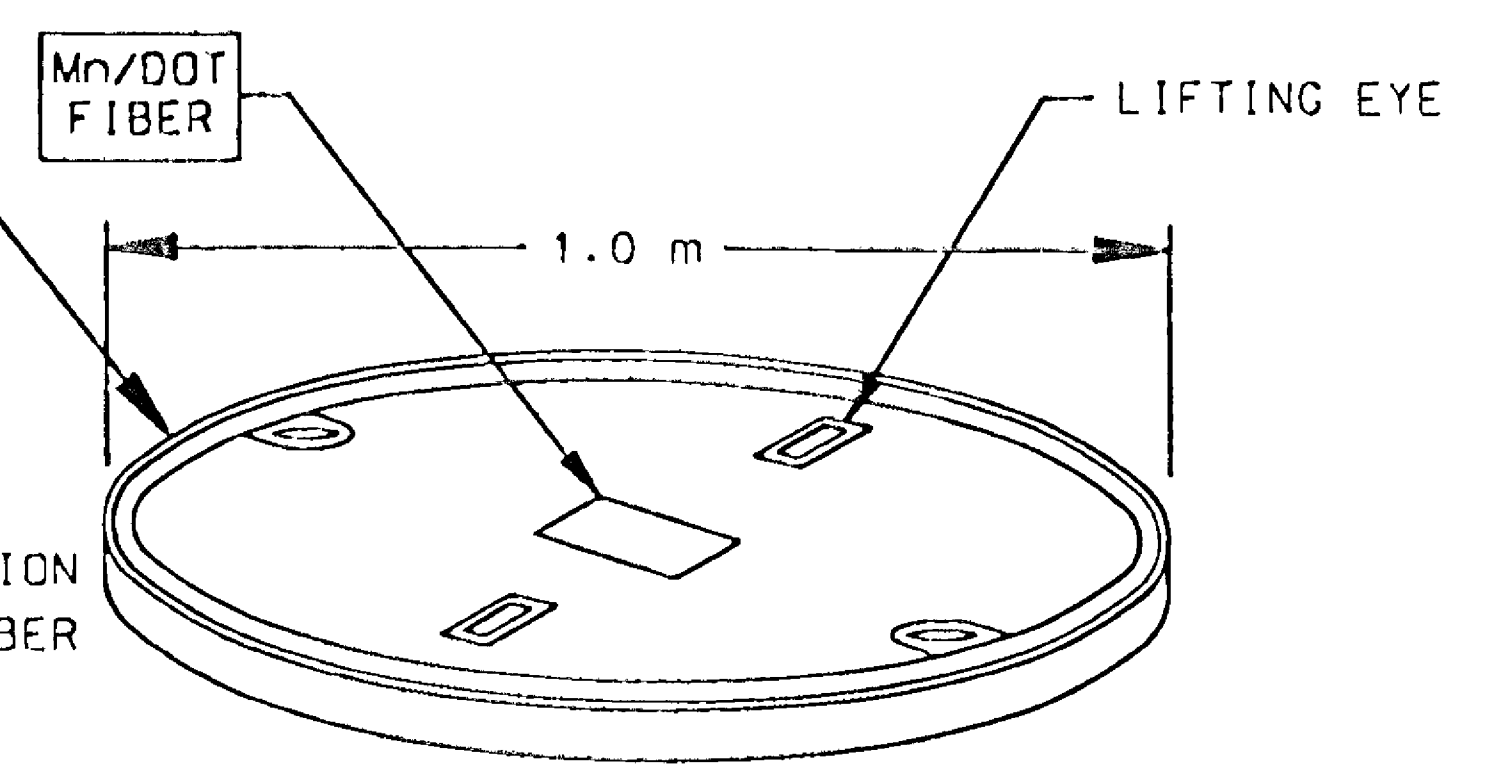

- FRP TAPERED CONE
- * WT. : 27.2 kg EACH
- * ALL BOLTS STAINLESS STEEL
- * CONCRETE INTERLOCK FEATURES

- BOLT DOWN
- 10 PLACES EACH END
- 13 mm DIA. X 40 mm LONG
- SS HH BOLTS



- STAINLESS STEEL COILING BRACKETS (4 EACH)
- 9.5 mm DIA. X 113 mm LONG
- SS HH BOLTS WITH SS TAPERED SPRING 16 mm LONG AND SS "NYLOCK" STYLE LOCKNUT

- 305 mm FRP EXTENSION
- 2 PIECES BOLTED TOGETHER
- 1.22 m INSIDE DIMENSION
- WT: 13.6 kg ASSEMBLED

PLACE TWO 50 mm KNOCK OUT OPENINGS 180 DEGREES APART AND 100 mm BELOW SUPPORT BRACKETS, THAT ALLOW CABLE TO ENTER VAULT IN THE SAME CIRCULAR DIRECTION


- FRP TAPERED CONE

- 13 mm DRAIN HOLE EVERY 250 mm

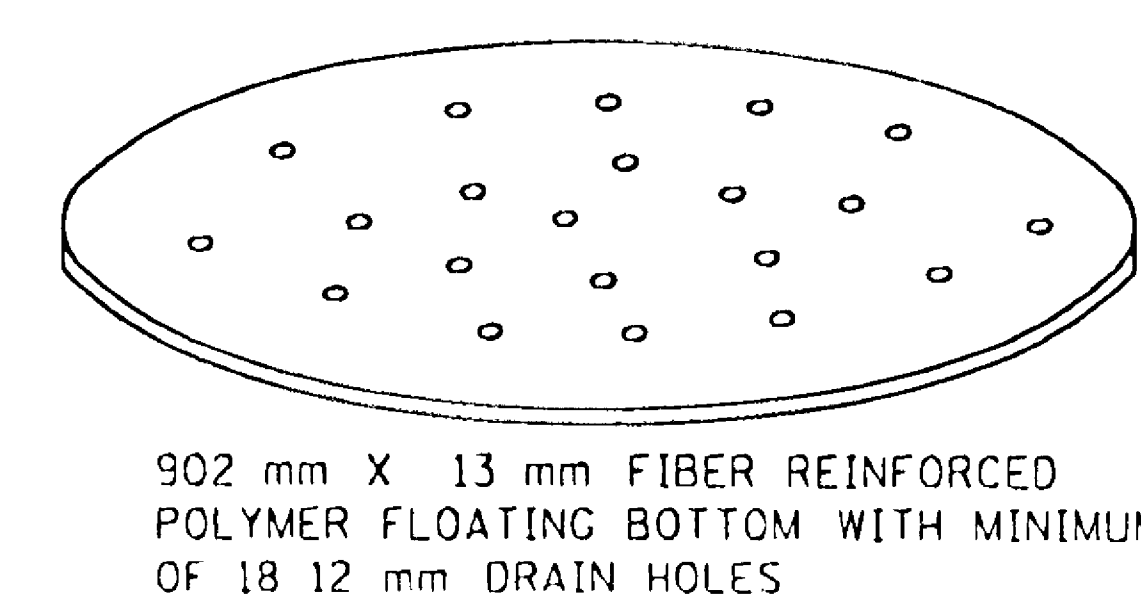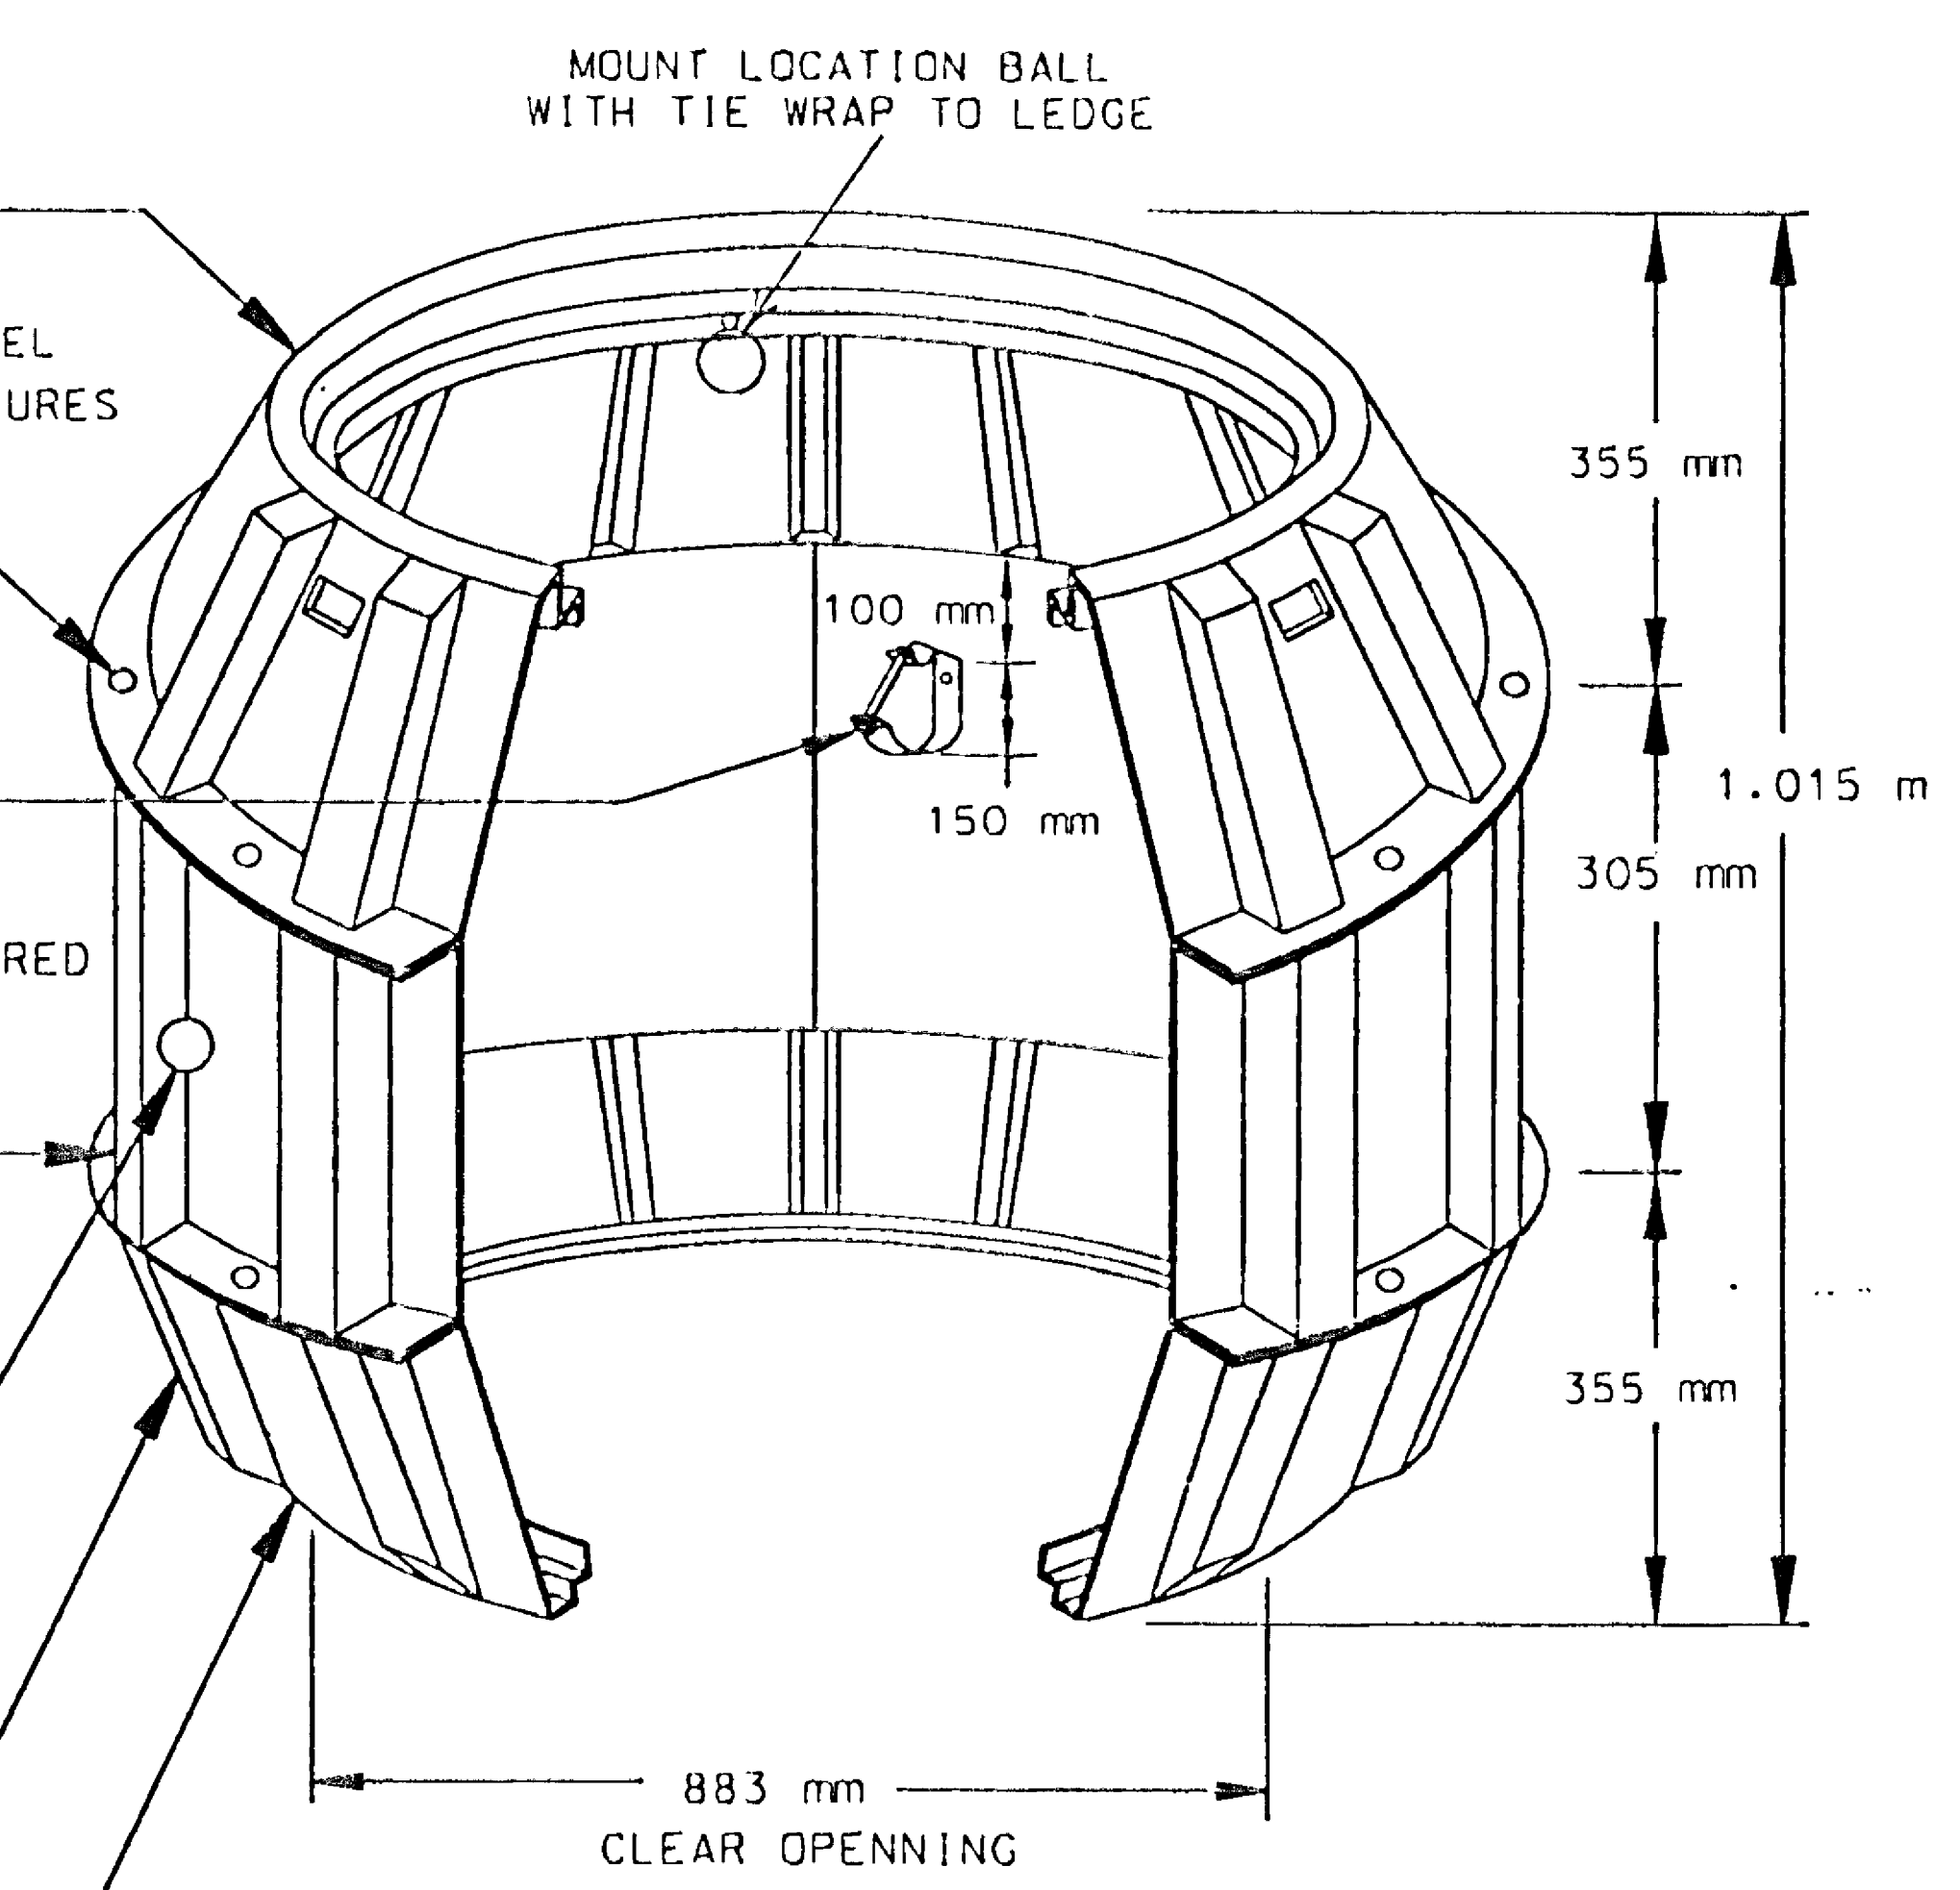

VAULT

FRP = FIBER REINFORCED POLYMER

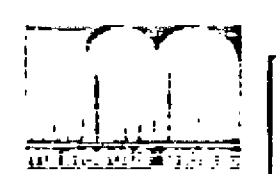


CERTIFIED BY *AM Behrman* REG. NO. 18491 MAR 13 1997


STATE PROJ. NO. 02-617-11 SHEET NO. 141 OF 236 SHEETS

1. SAW CUT LOOP DETECTORS ARE VARIABLE SIZED, AND INSTALLED IN THE CENTER OF THE LANE.
 2. THE LOOP DETECTOR CONDUCTOR IS 1/C NO.16 STRANDED COPPER, POLYESTER INSULATED WIRE OR COPPER, XLP INSULATED WIRE. THE WIRE IS CONTAINED IN A FLEXIBLE POLYESTER TUBING.
 3. USE A SEALANT MADE SPECIFICALLY TO SEAL LOOP DETECTOR SAW CUTS IN CONCRETE ROADWAYS. USE AN APPROVED SEALANT IN BITUMINOUS ROADWAYS AND CONCRETE ROADWAYS THAT ARE TO BE OVERLAYED WITH BITUMINOUS.
 4. INSTALL THE LOOP CONDUCTOR TO LEAD-IN SPLICE IN A PLASTIC TUBE WITH END CAPS THAT FUNCTION AS SPOUTS. AND A TWO PART PLASTIC ENVELOPE CONTAINING RESINS THAT TURN BLACK WHEN MIXED AND BECOME HARD WHEN CURED. INSTALL BOTH LOOP CONDUCTORS AND LEAD-IN INTO THE SAME END OF THE TUBE AND ENCAPSULATING THE SPLICE.
 5. THE LEAD-IN CABLE SHALL CONFORM TO MN/DOT 3809.
- METHOD**
6. CLEAN ALL DEBRIS FROM THE ENTIRE LOOP DETECTOR AREA.
 7. MARK THE LOOP DETECTOR AND LEAD-IN SAW CUTS ON THE ROADWAY
 8. SAW THE CUT TO 65 mm +/- 5 mm DEEP BY 3 mm WIDER THAN THE "OD" OF THE CONDUCTOR. SMOOTH THE BOTTOM AND ANGLES TO PREVENT DAMAGE TO INSULATION.
 9. REAM THE CONDUIT ENDING IN THE ROADWAY. PLUG THE CONDUIT IN THE ROADWAY TO PREVENT THE LOOP SEALANT OR DUCT SEAL FROM ENTERING THE CONDUIT.
 10. DRILL THE CORNERS 5 mm DEEPER THAN THE SAW SLOT AND SMOOTH THE HOLE CORNERS.
 11. AGAIN, CLEAN AND DRY THE ENTIRE LOOP DETECTOR AREA.
 12. INSTALL BEAD OF LOOP DETECTOR SEALANT TO WITHIN 150 mm OF LOOP CONDUCTORS CONDUIT. INSTALL CLEAN, DRY LOOP CONDUCTOR, STAYING TO THE OUTSIDE OF THE CORNERS. DO NOT INSTALL THE CONDUCTOR TIGHT. PUSH THE CONDUCTORS TO THE BOTTOM OF THE SAWSLOT WITH A BLUNT TOOL.
 13. INSTALL 15 mm DIAMETER BY 50 mm FOAM BACKER ROD AT 600 mm INTERVALS TO HOLD THE CONDUCTOR AT THE BOTTOM OF THE SAWSLOT. INSTALL LOOP SEALANT.
 14. INSTALL A JOINT INSTALLATION EACH TIME A JOINT OR PAVEMENT CRACK IS CROSSED.
 15. TWIST THE CONDUCTORS 3 TURNS PER 0.3 m IN THE CONDUIT FROM THE ROADWAY TO THE HANDHOLE.
 16. SOLDER THE LOOP CONDUCTOR TO LEAD-IN SPLICE, INSTALL THE SPLICE IN WIRE NUT, THEN PLACE IT INTO THE SPLICE ENCAPSULATOR
 17. THE LOOP INSULATION RESISTANCE READING MUST BE GREATER THAN 100 MEG OHM.
 18. SAWCUTS SHALL REMAIN 0.6 m FROM OTHER SAWCUTS.
 19. FILL SAW SLOT UNIFORMLY ACCORDING TO THE LOOP SEALANT MANUFACTURERS RECOMMENDED DEPTH.


NOTE: WIPE ALL EXCESS SEALANT MATERIAL FROM ROADWAY SURFACE

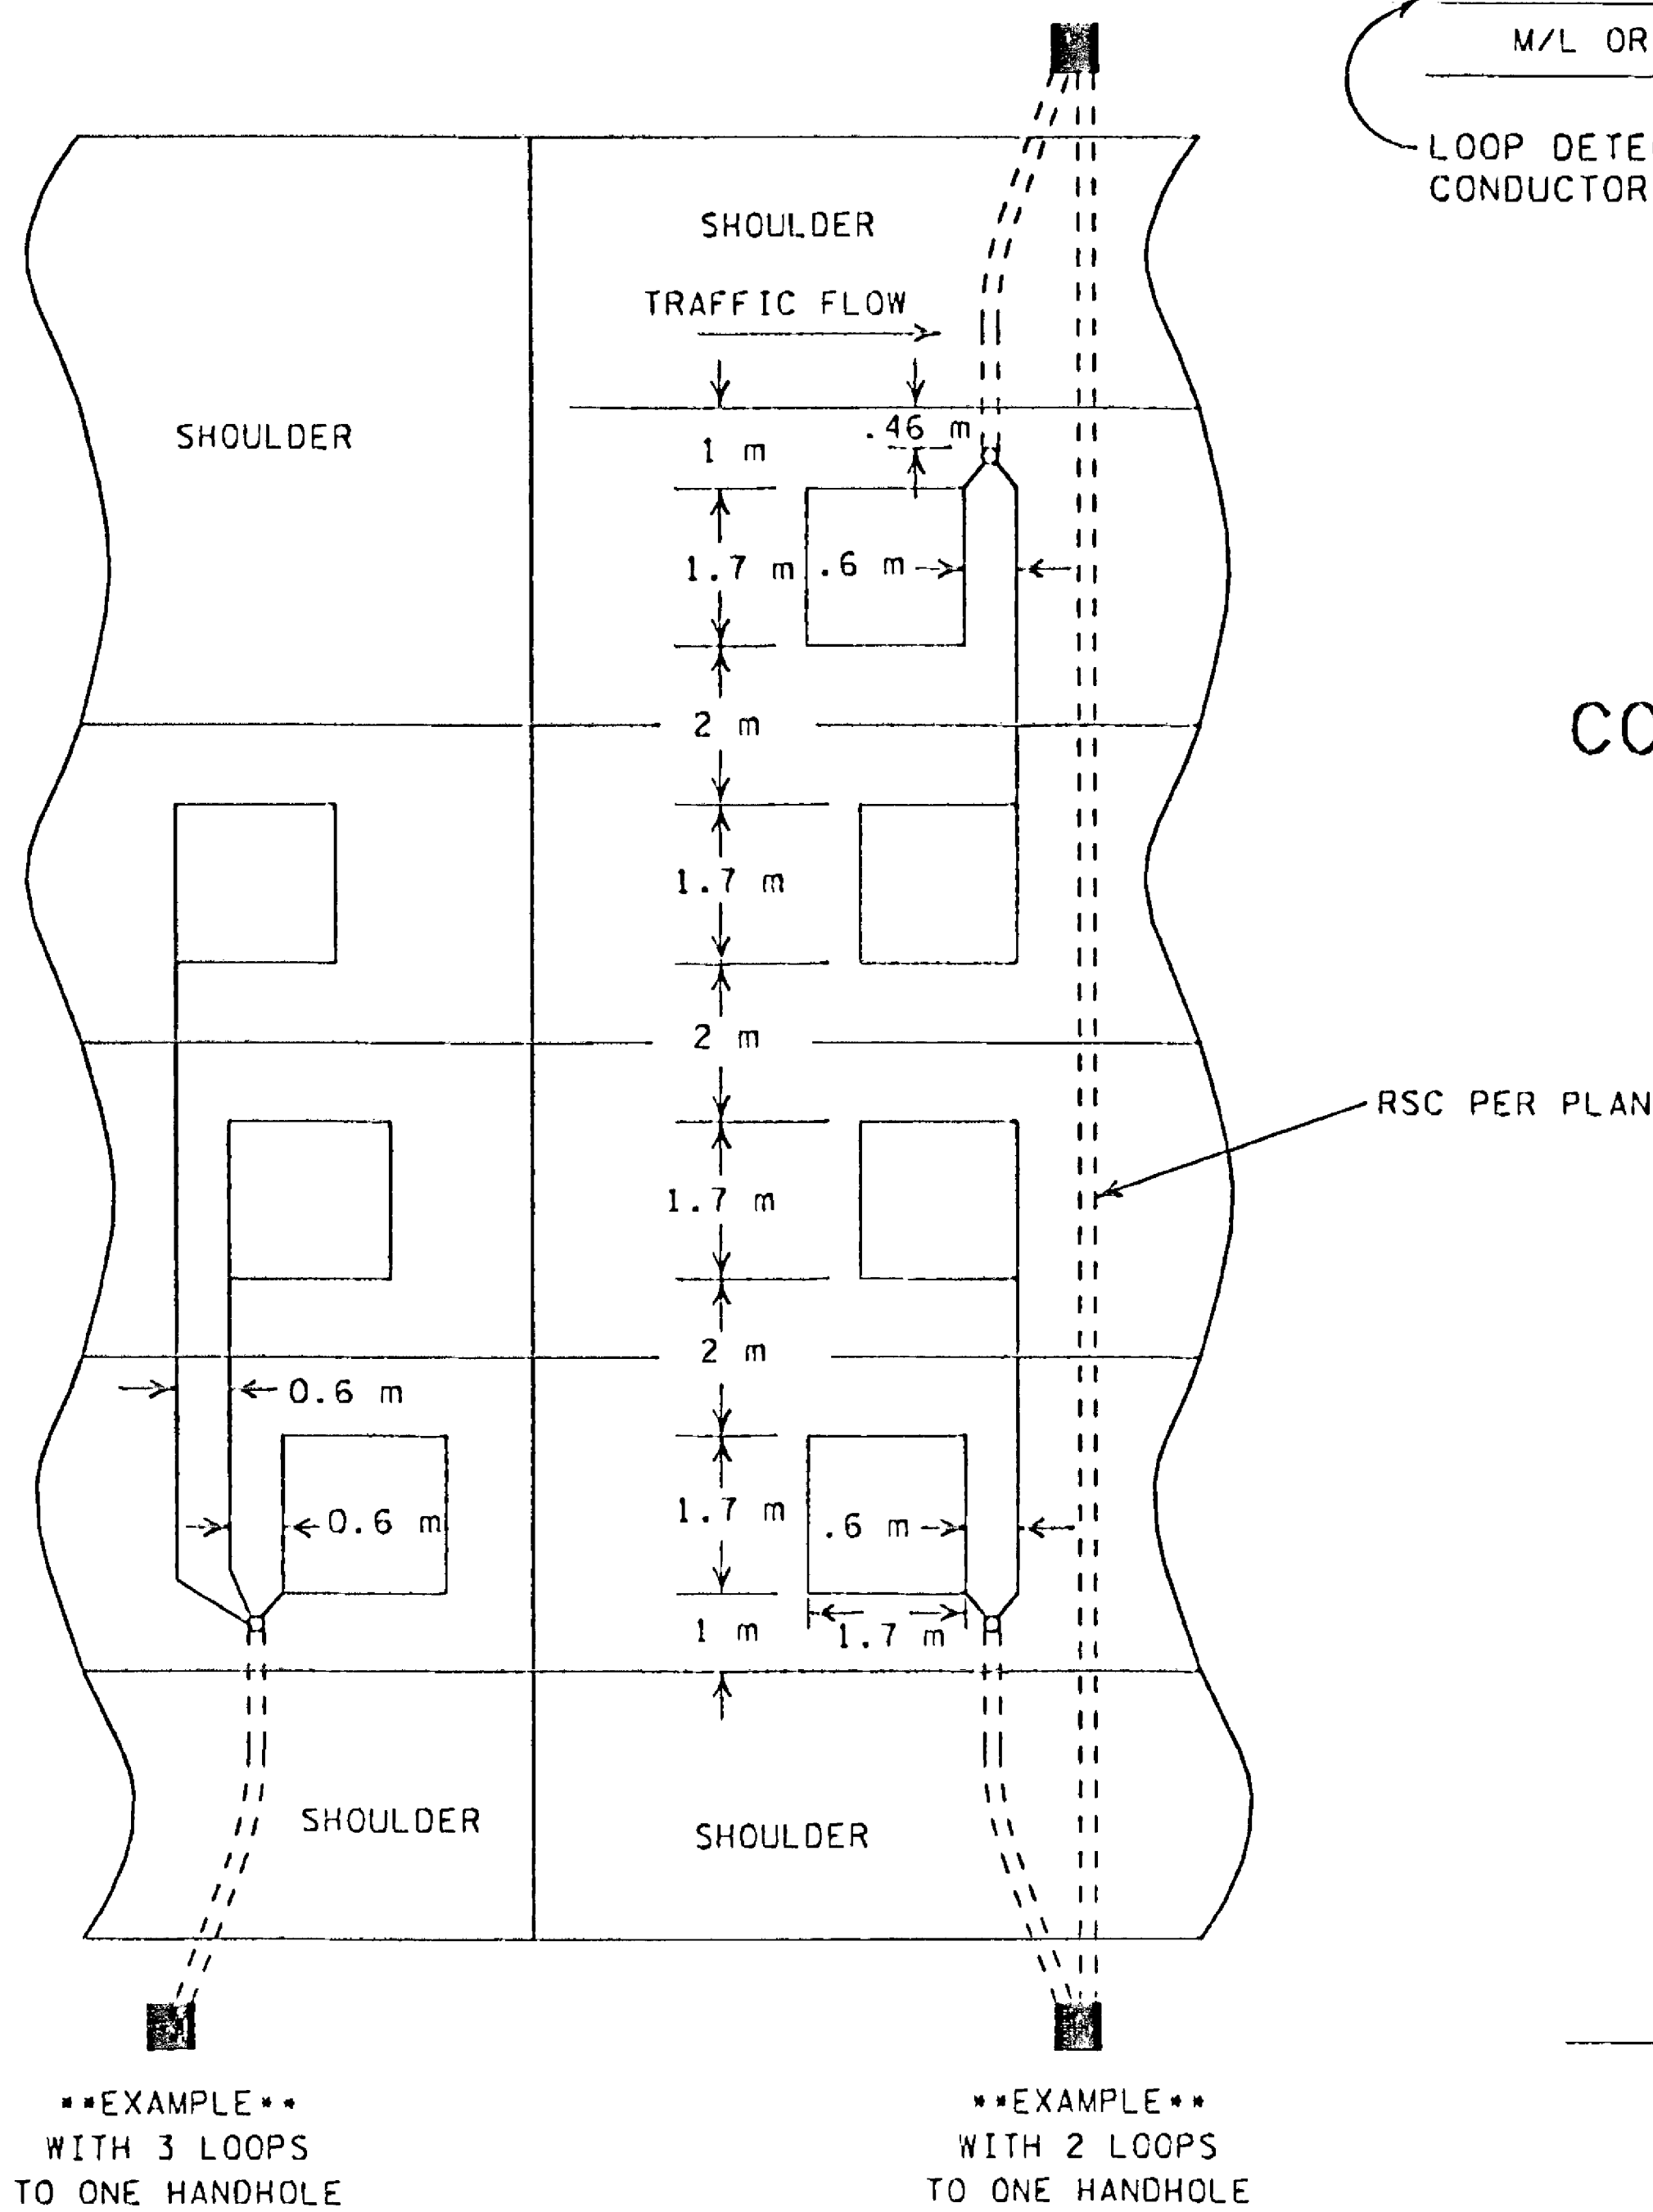


MAINLINE DETECTORS

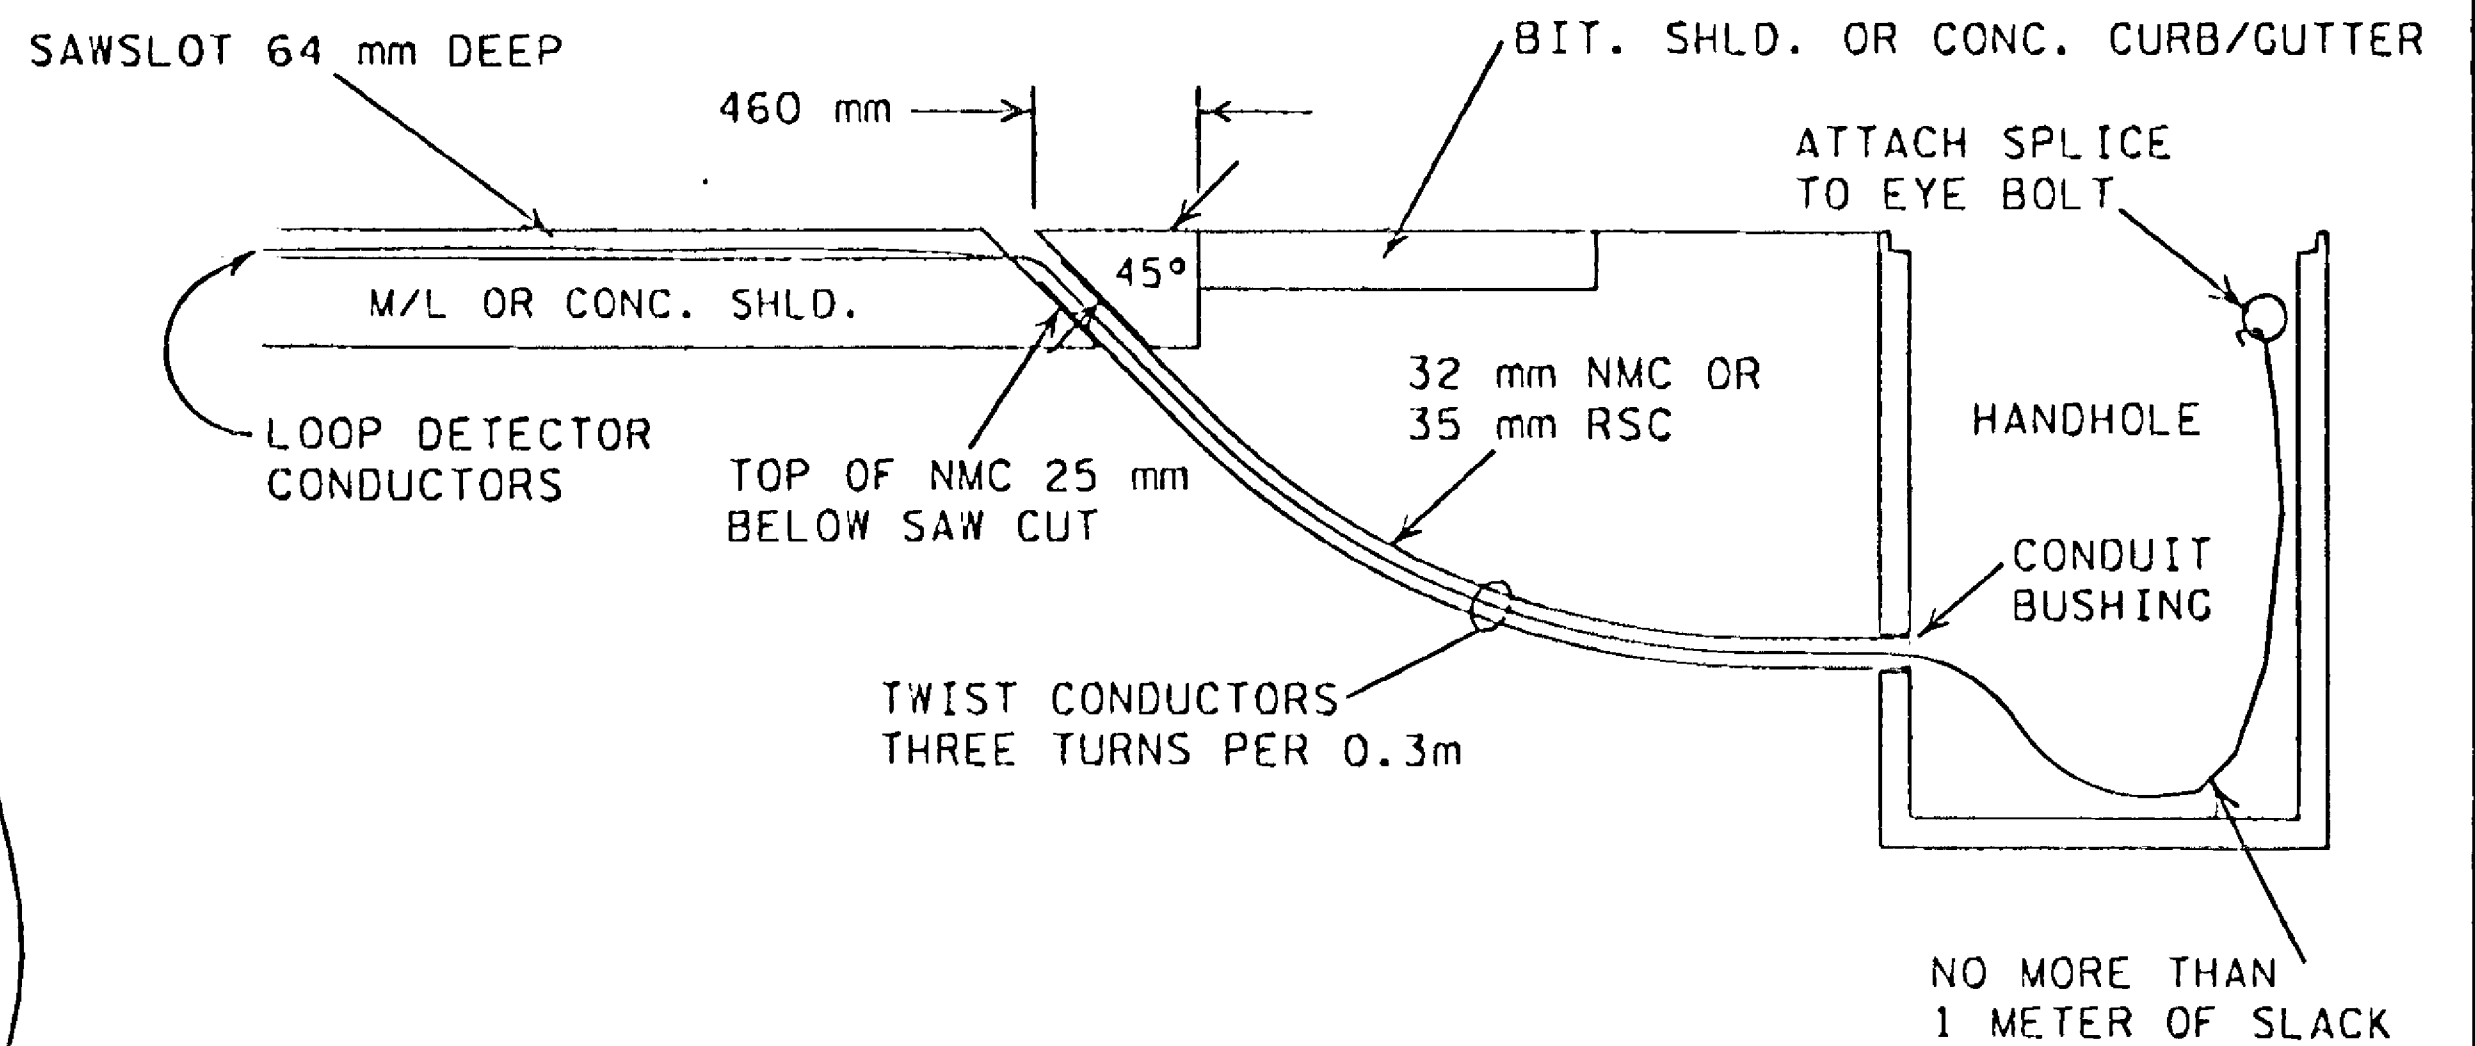

CONDUIT/HANDHOLE INSTALLATION

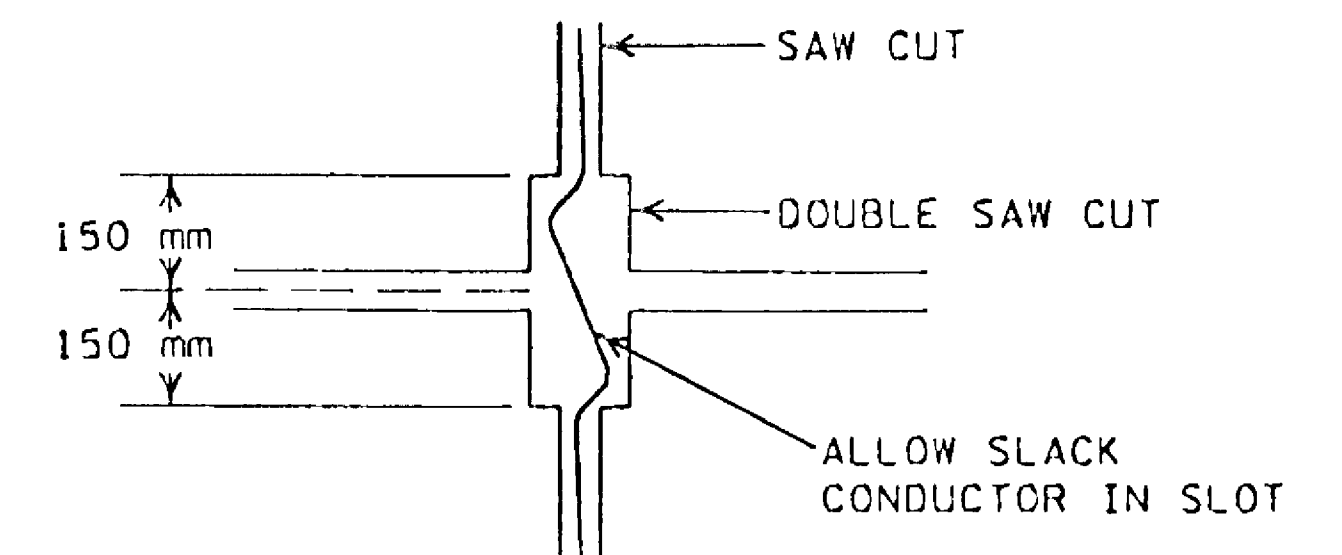

CONCRETE JOINT INSTALLATION

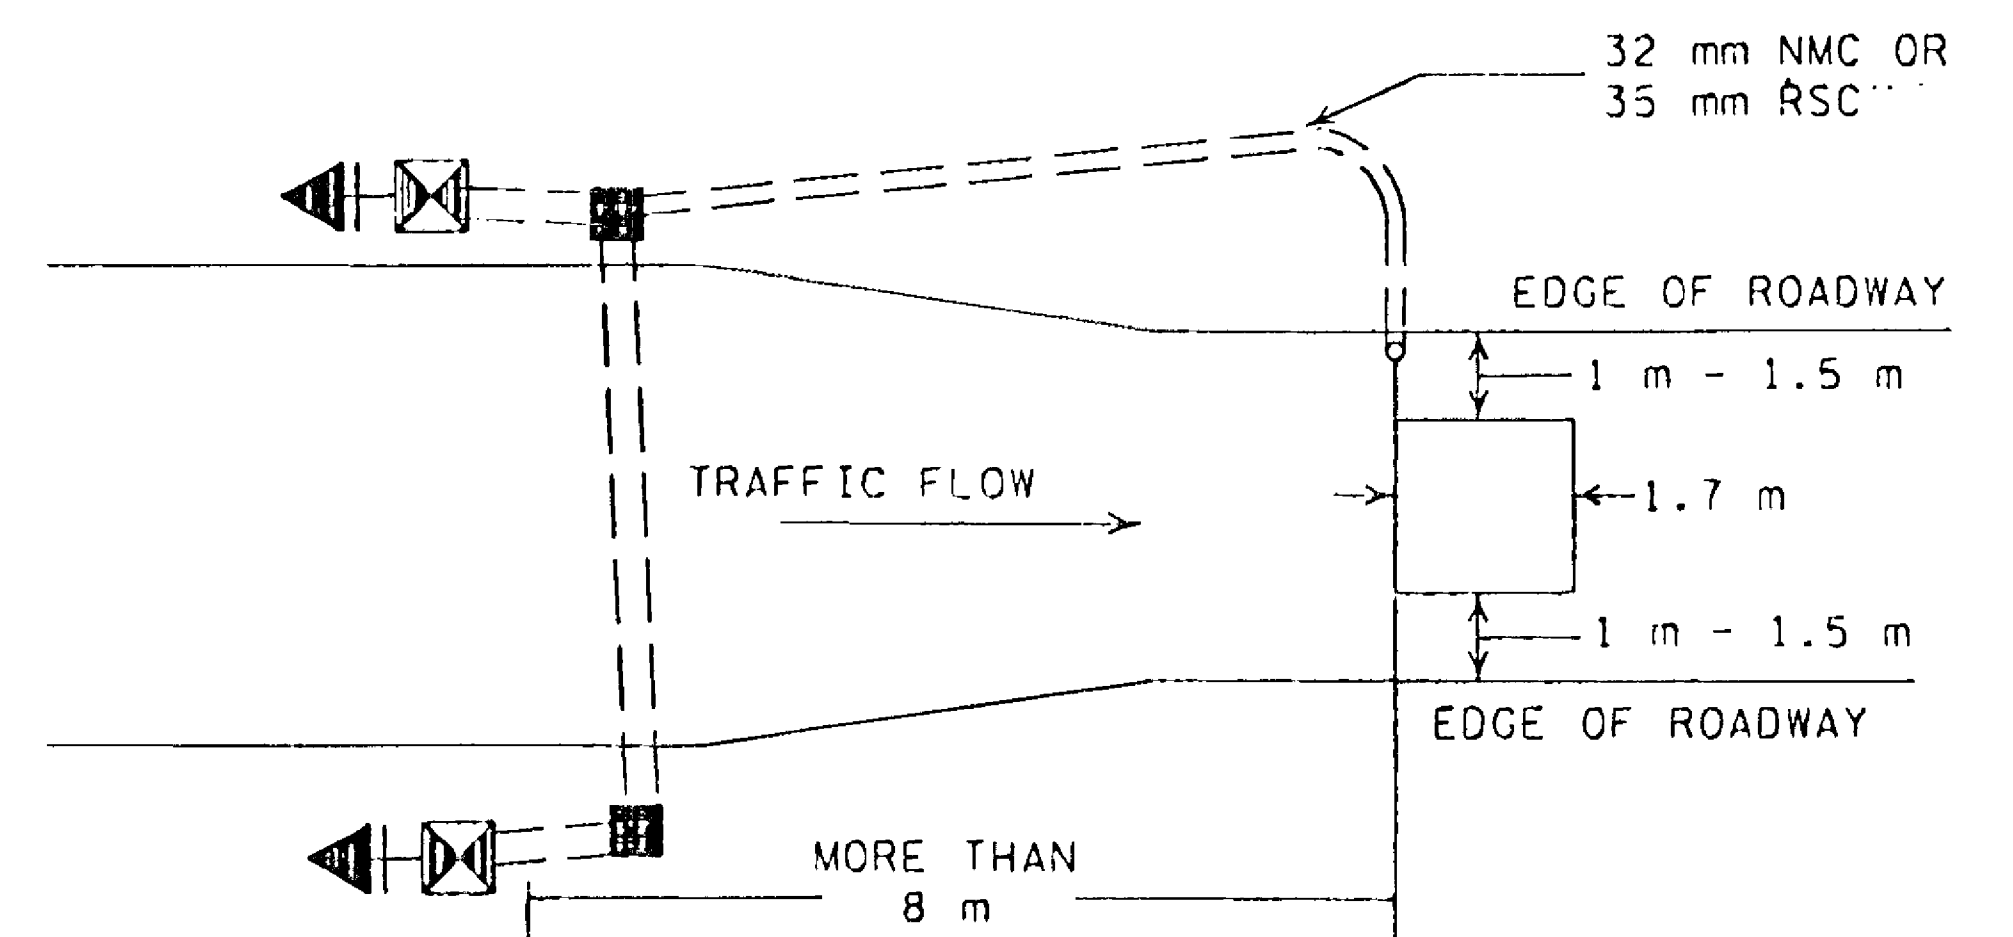

LOOP/RAMP DETECTION

OHMS	LEAD-IN LENGTH (METERS)		NUMBER OF LOOP TURNS			
	0-150	210	300	365		
#12 LOOP AT HH	0.345	0.387	0.429	0.472		
#14 LOOP AT HH	0.539	0.605	0.671	0.737		
#16 LOOP AT HH	0.862	0.968	1.074	1.179		

TABLE A

TMC SAW CUT LOOP DETECTOR TYPICAL - PART ONE

CERTIFIED BY *Paul Belcher*
PROFESSIONAL ENGINEER

REG. NO. 18491 MAR 13 1997

STATE PROJ. NO. 02-617-11

SHEET NO. 142 OF 236 SHEETS

LOOP DETECTOR TYPICAL - PART TWO

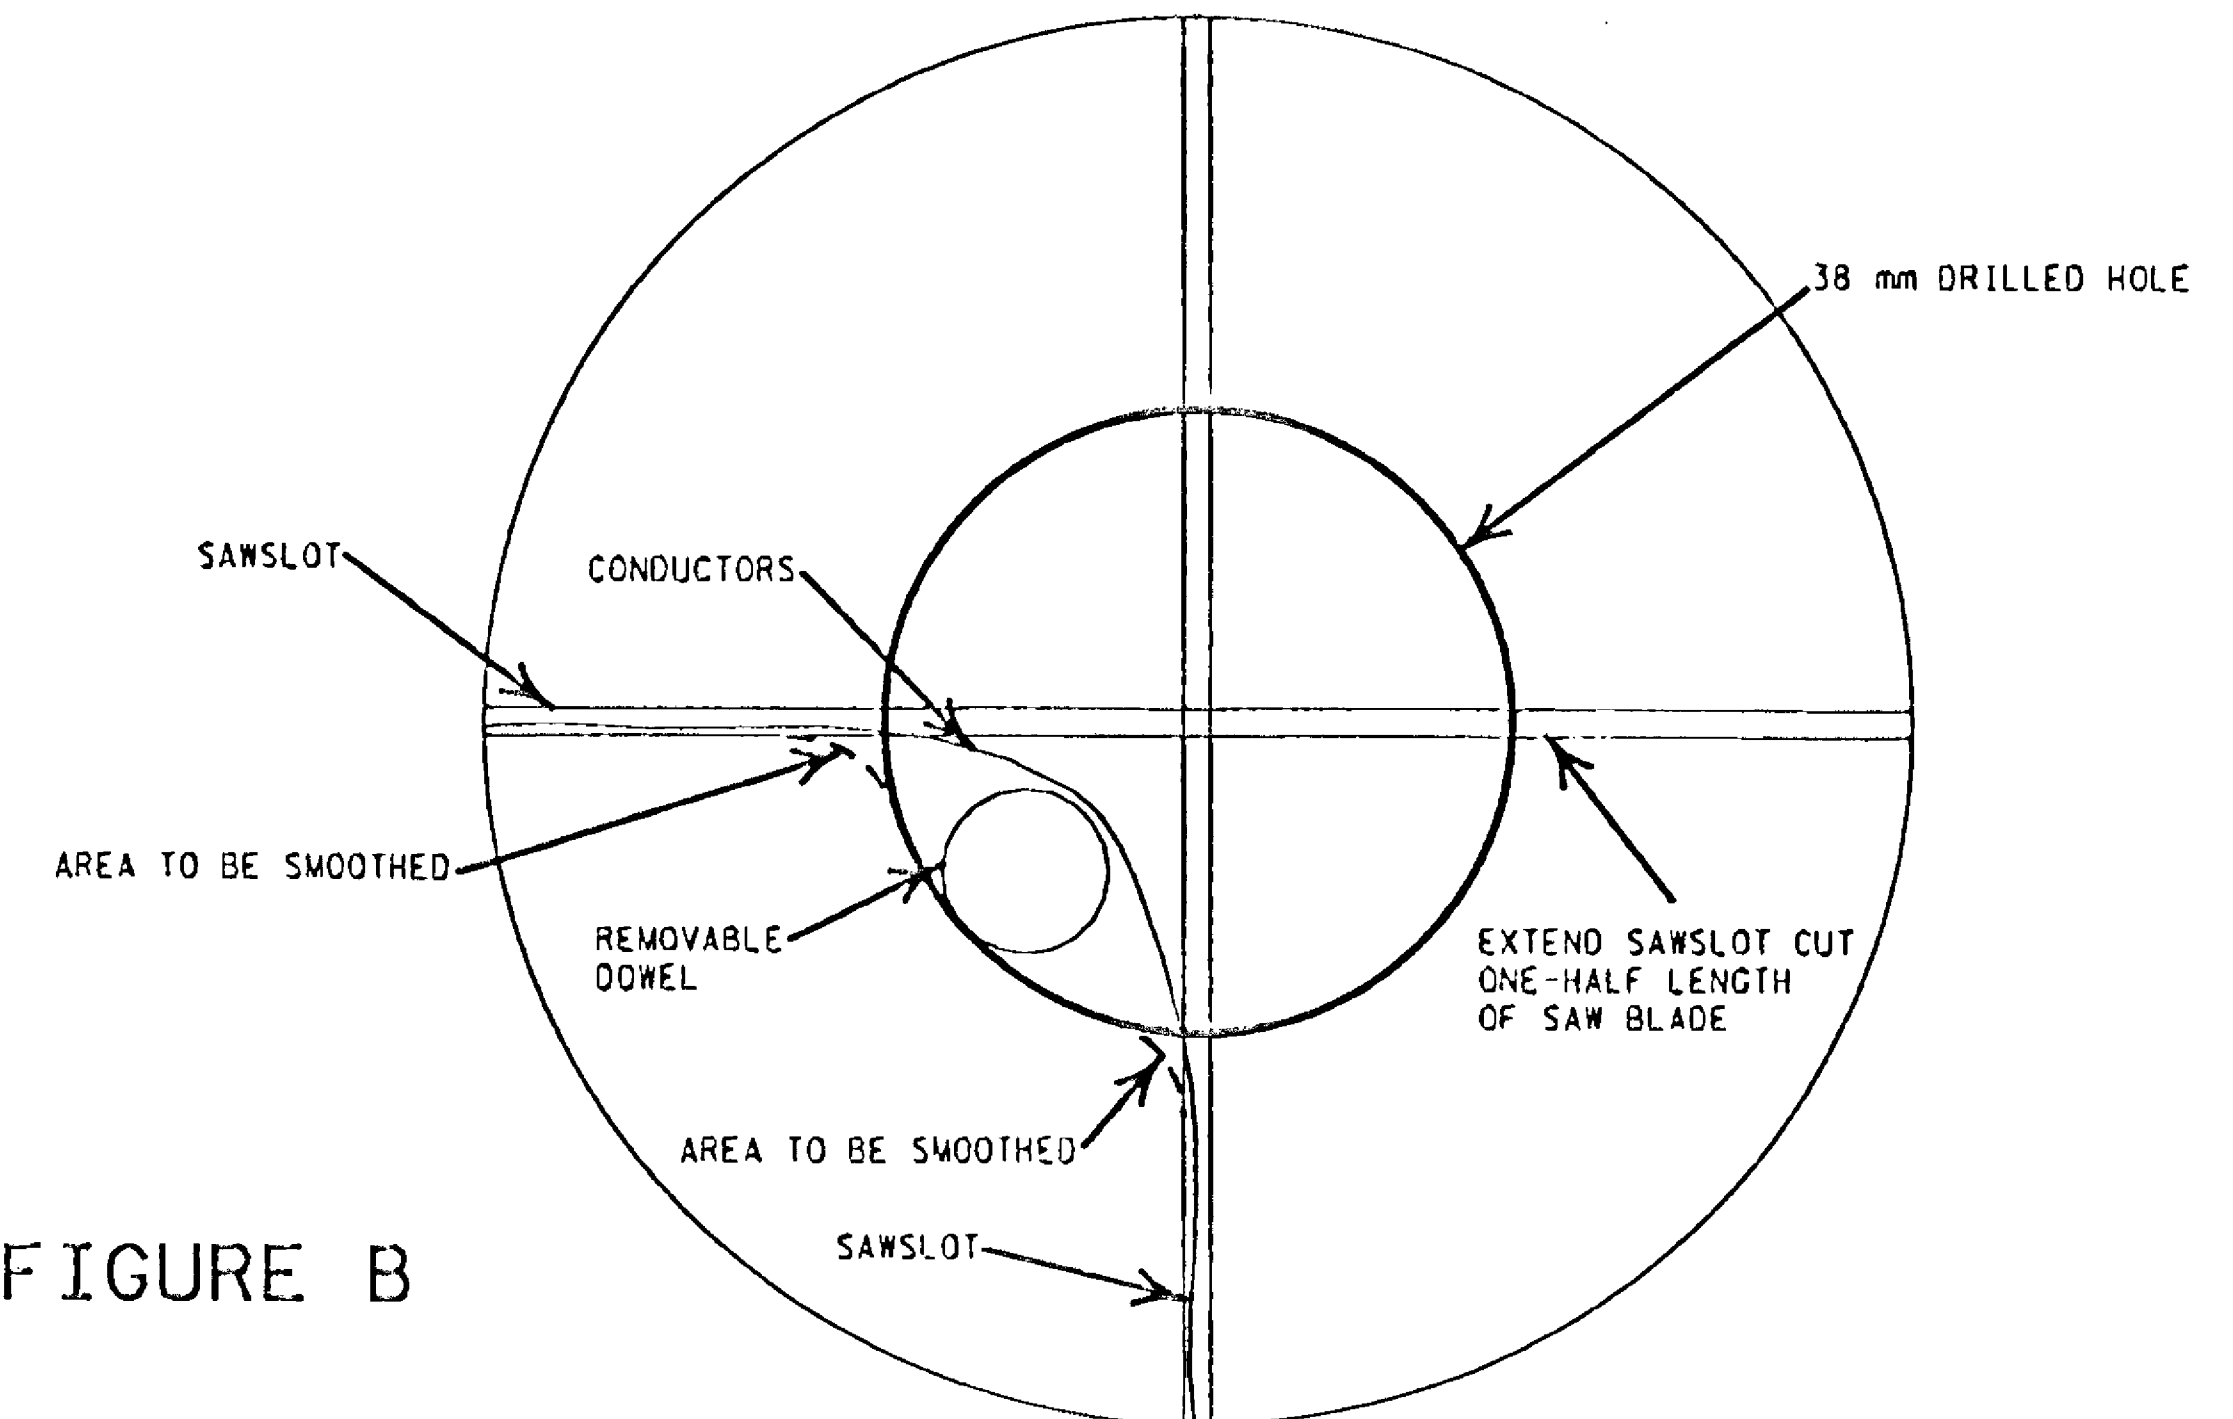


FIGURE B



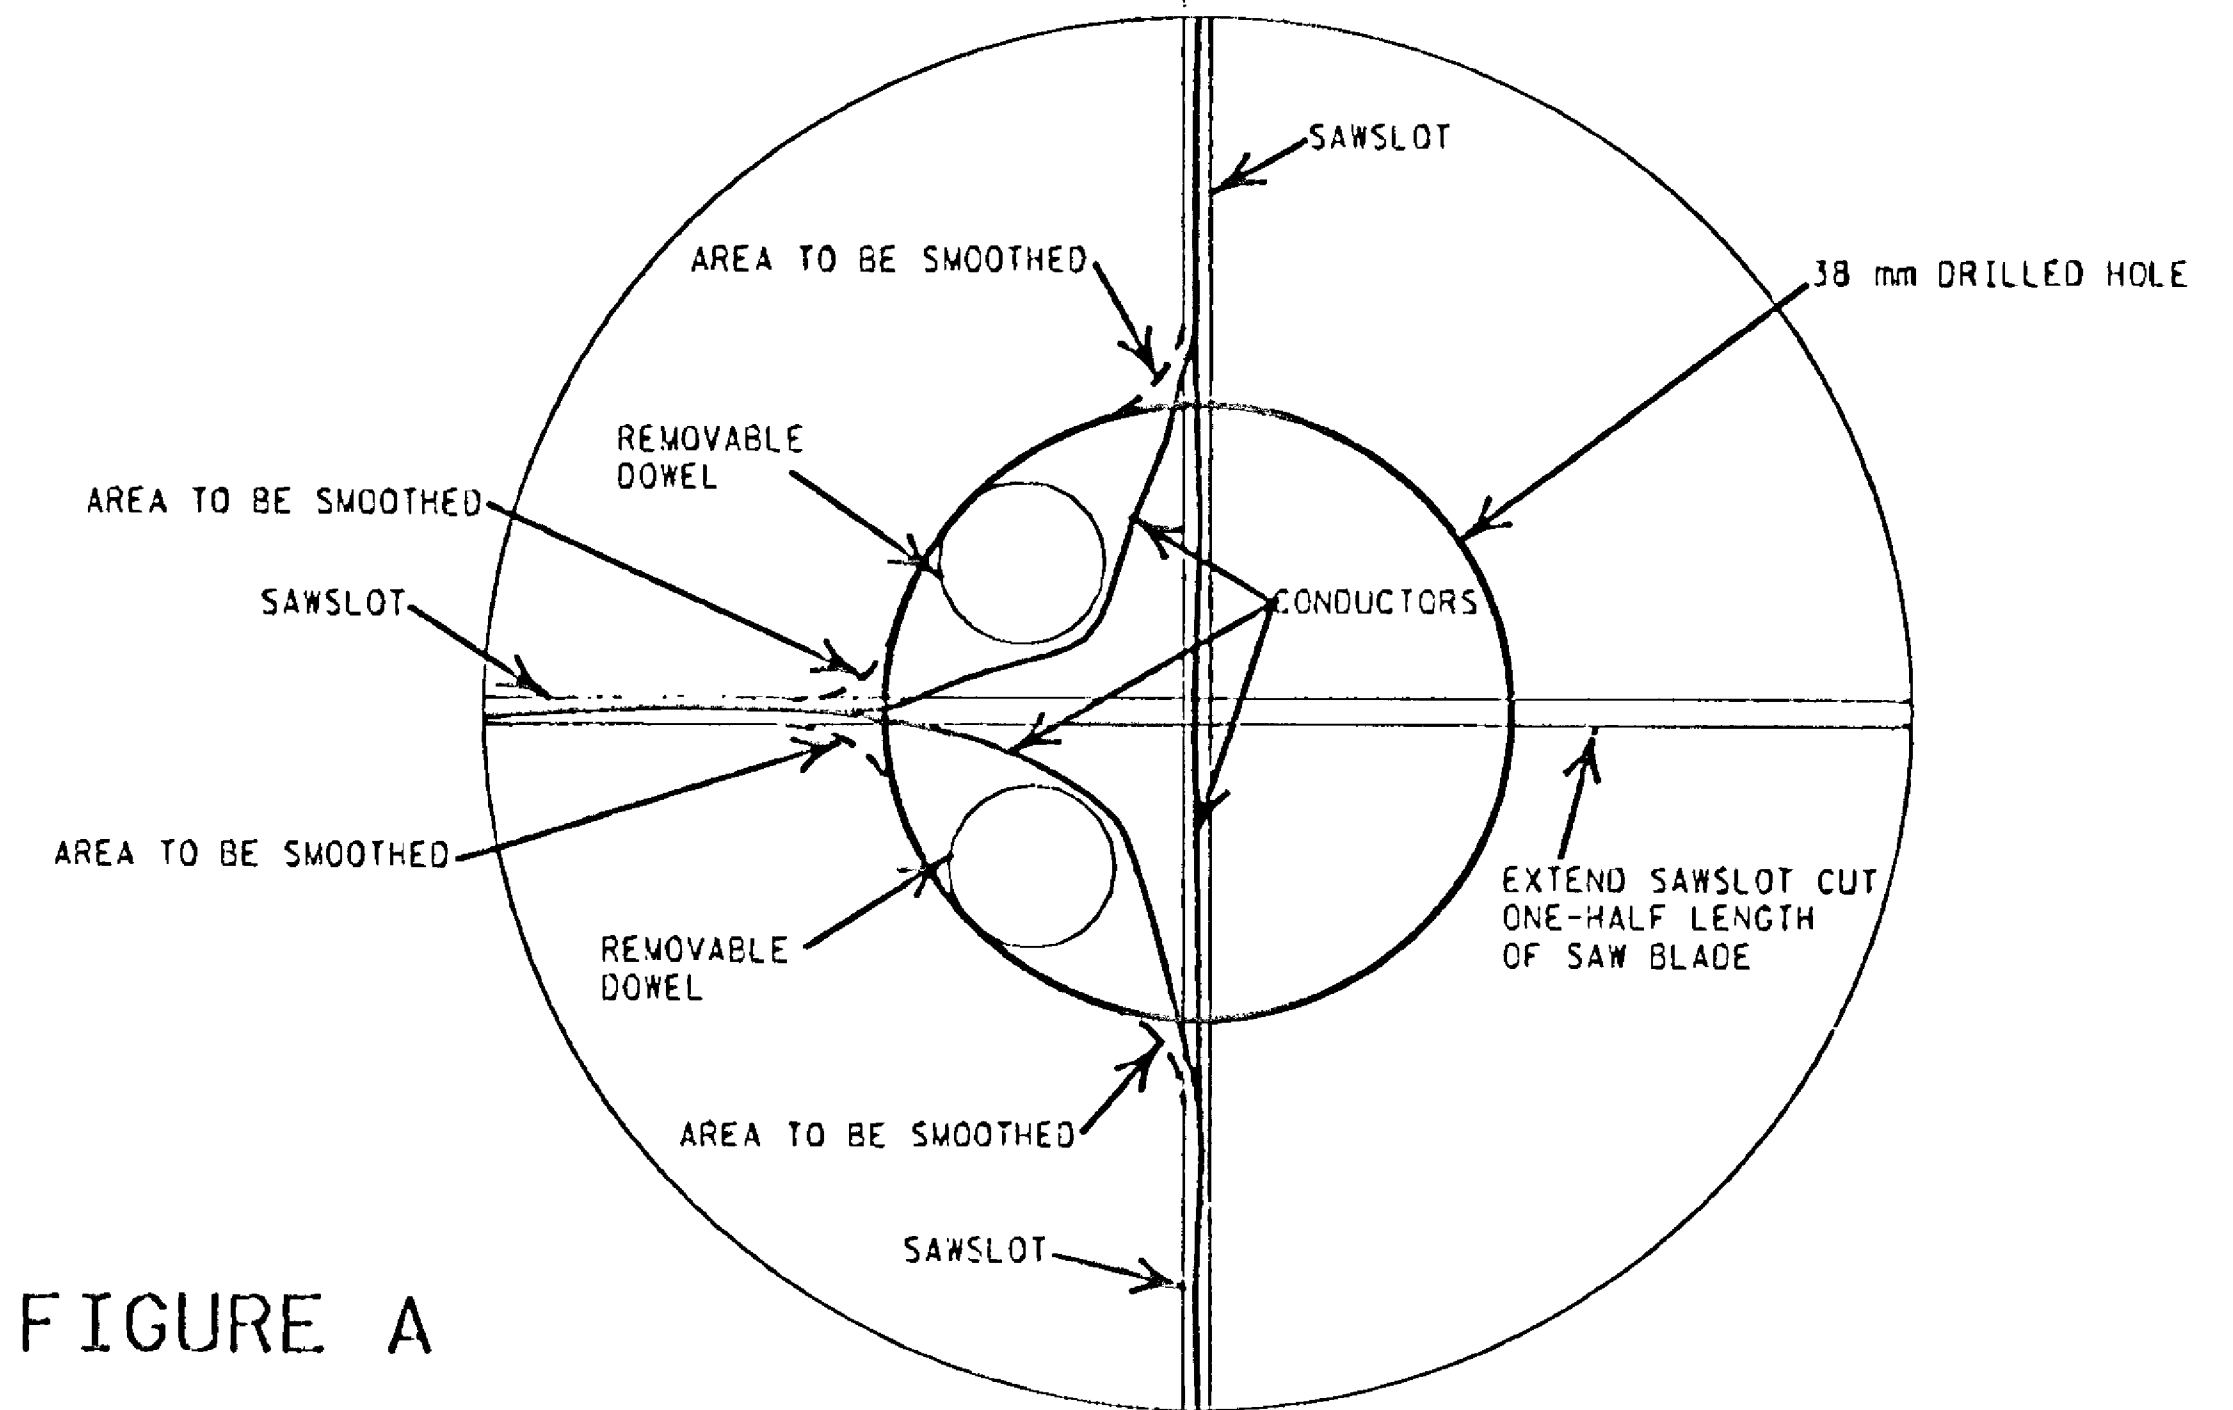


FIGURE A

NOTE: THE LEAD-IN LENGTH IS 2/C NO. 14 FROM THE SPLICE TO THE CABINET TERMINATION POINT.

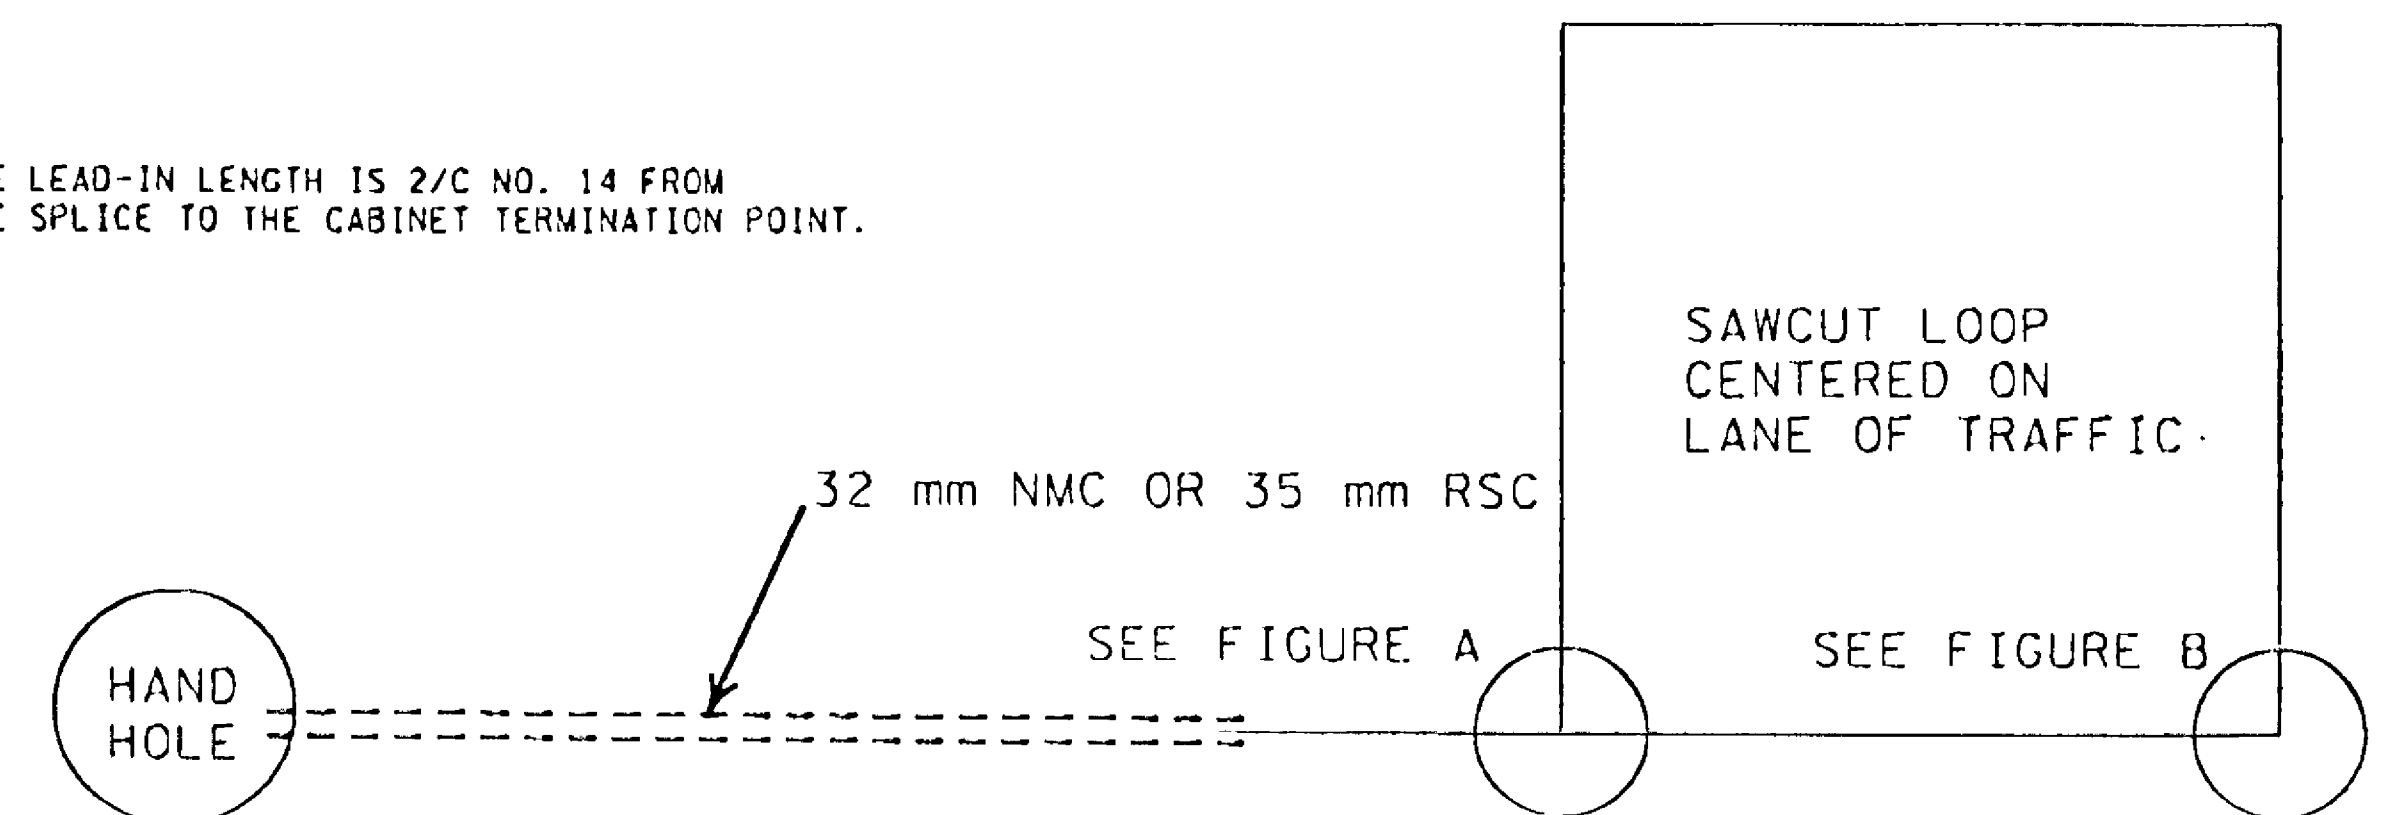




SEE SPECIAL PROVISIONS FOR LOOP TESTING FORM

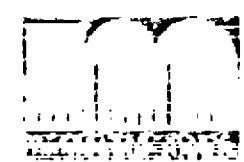



CERTIFIED BY *PM Beltrami* REG. NO. 18491 MAR 13 1997
PROFESSIONAL ENGINEER

STATE PROJ. NO. 02-617-11

SHEET NO. 143 OF 236 SHEETS

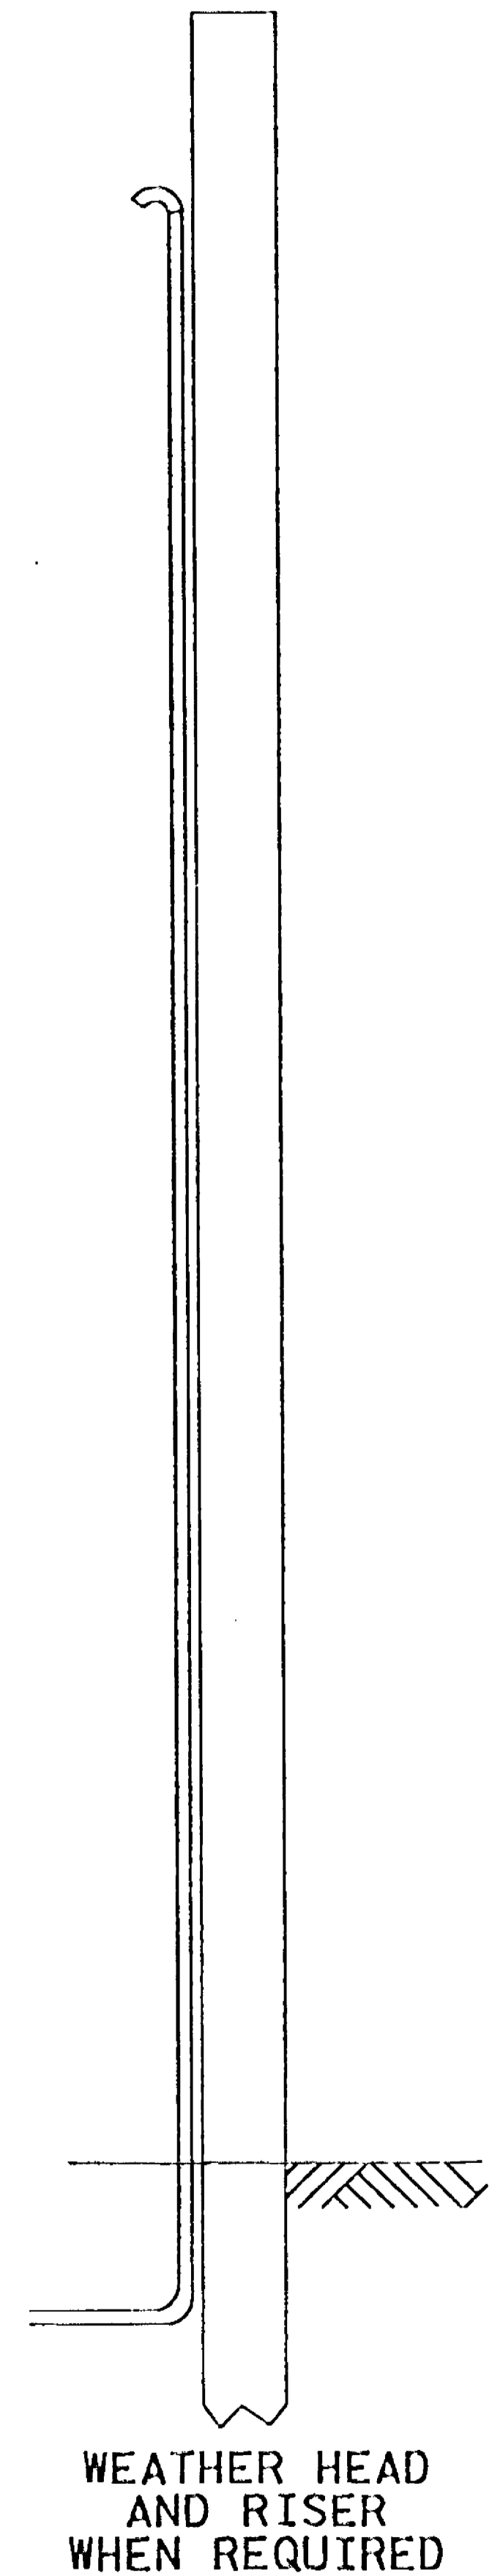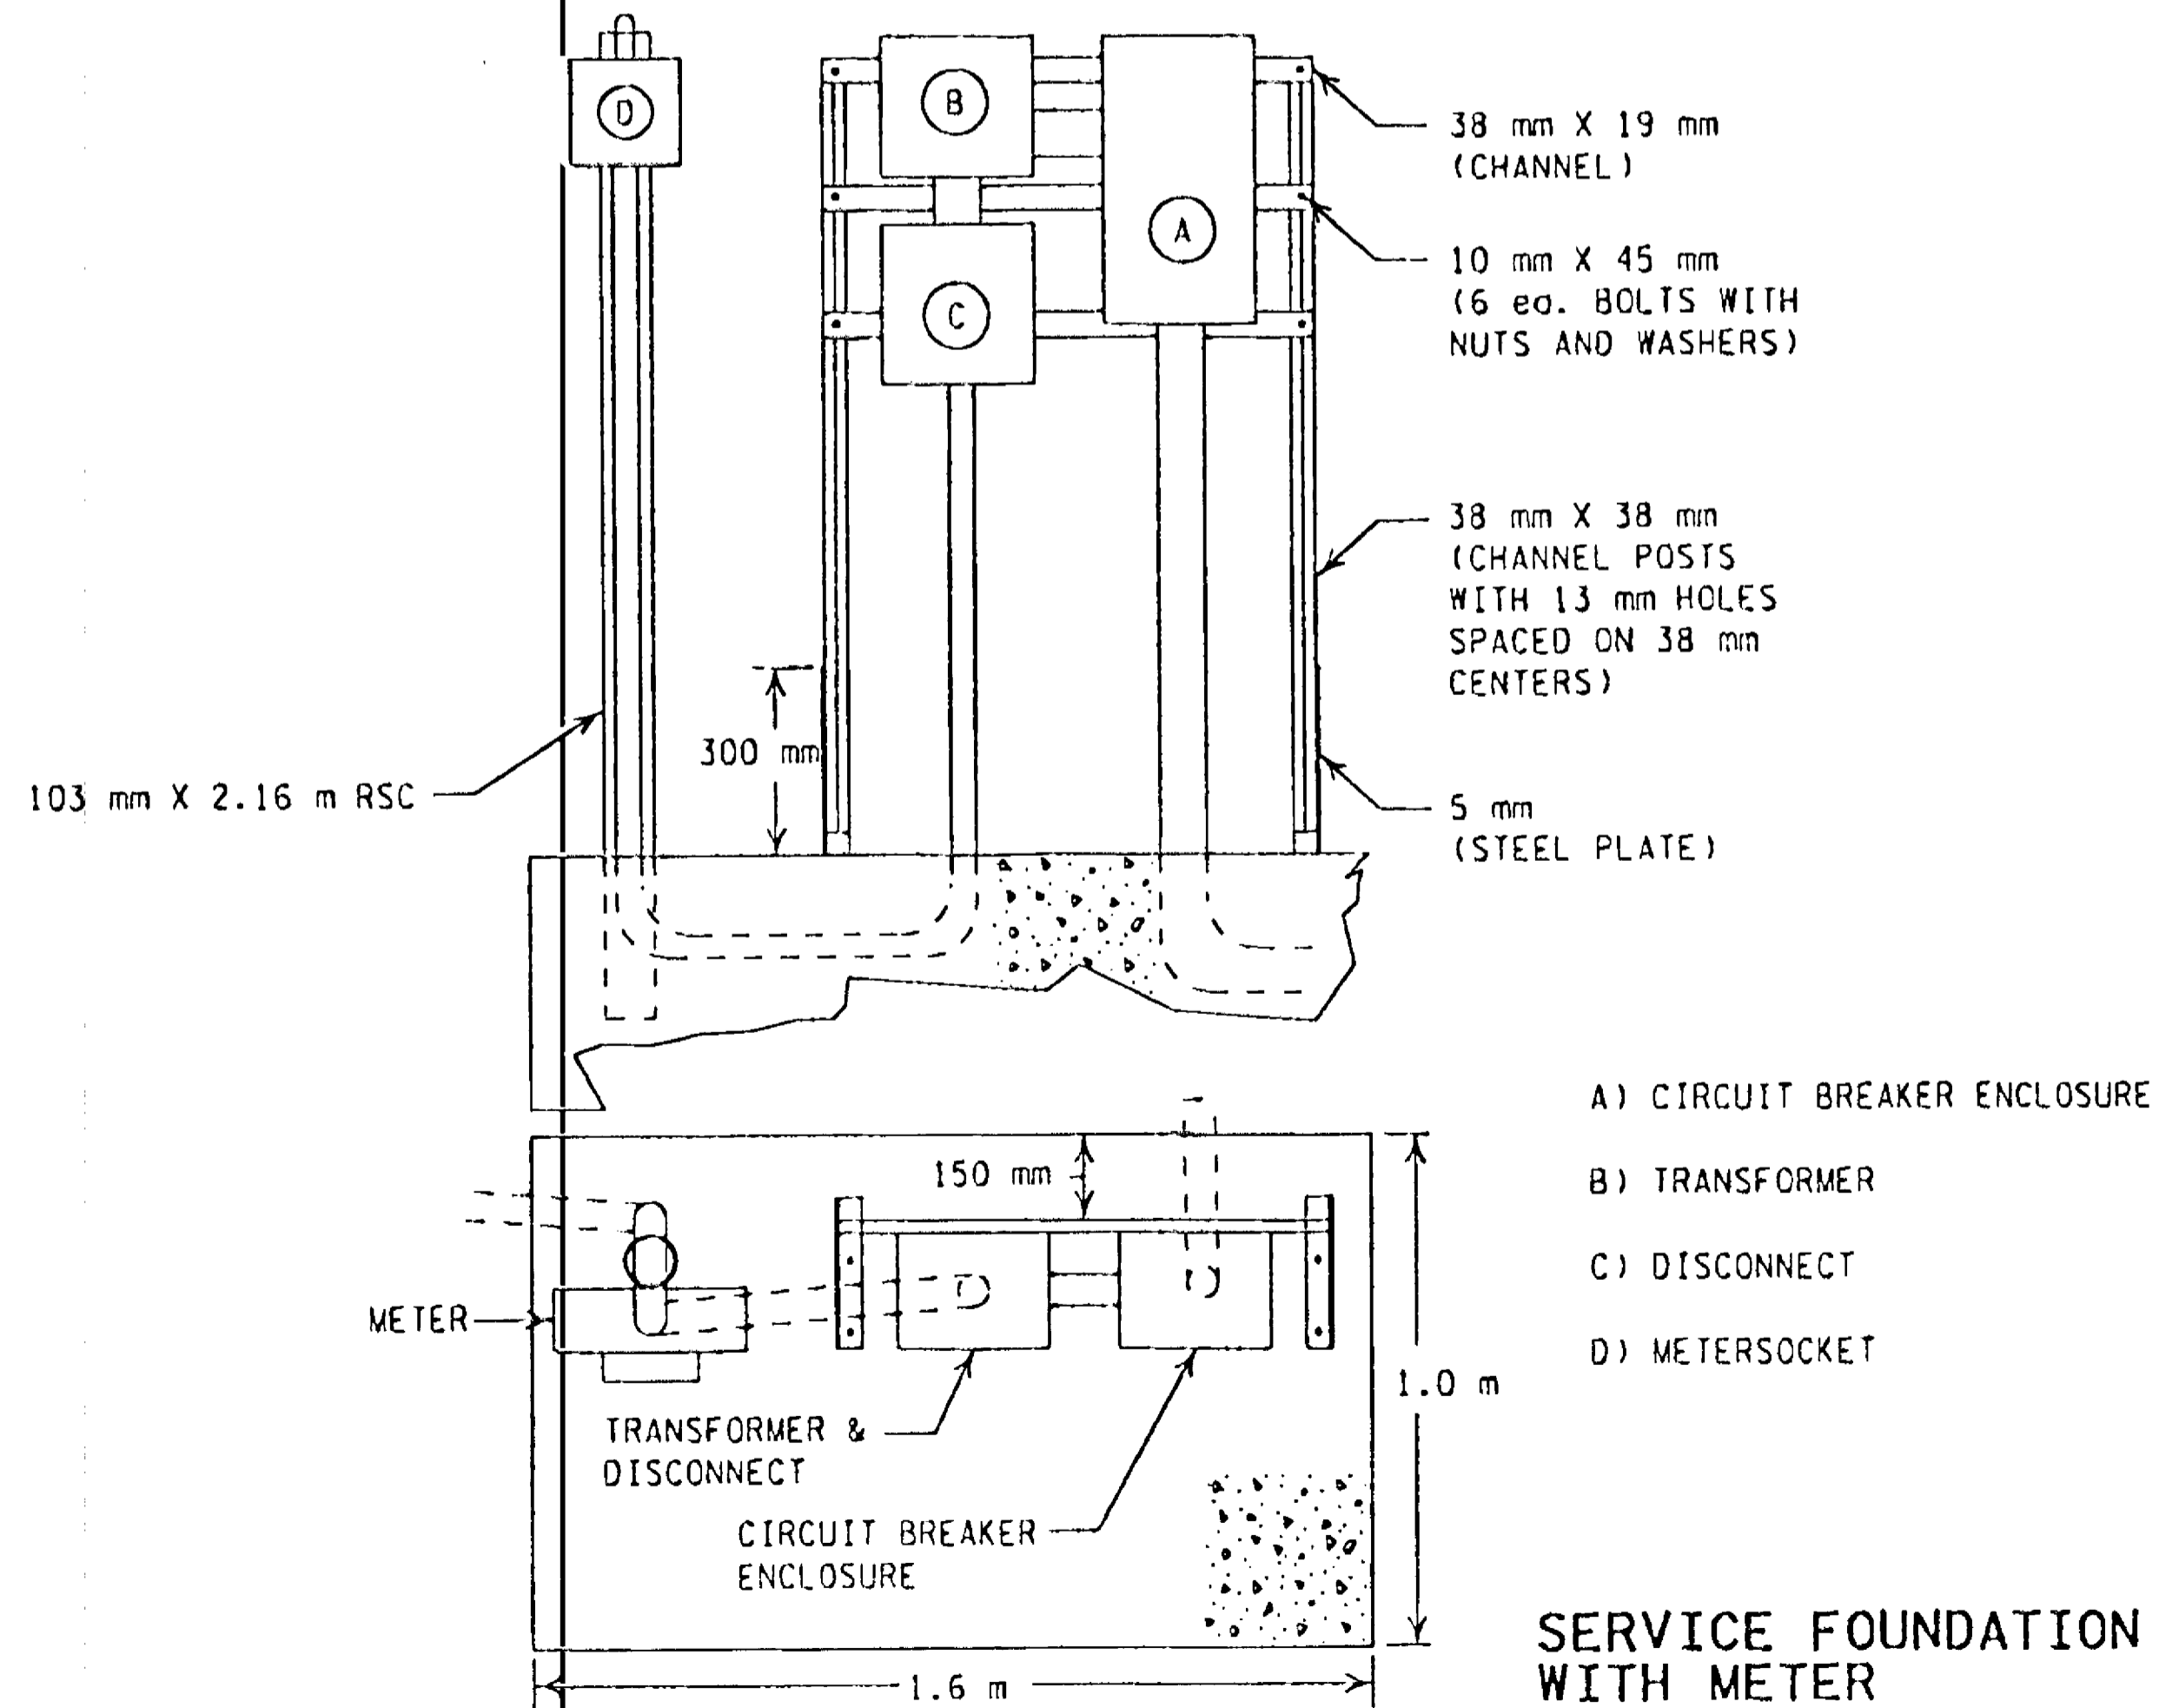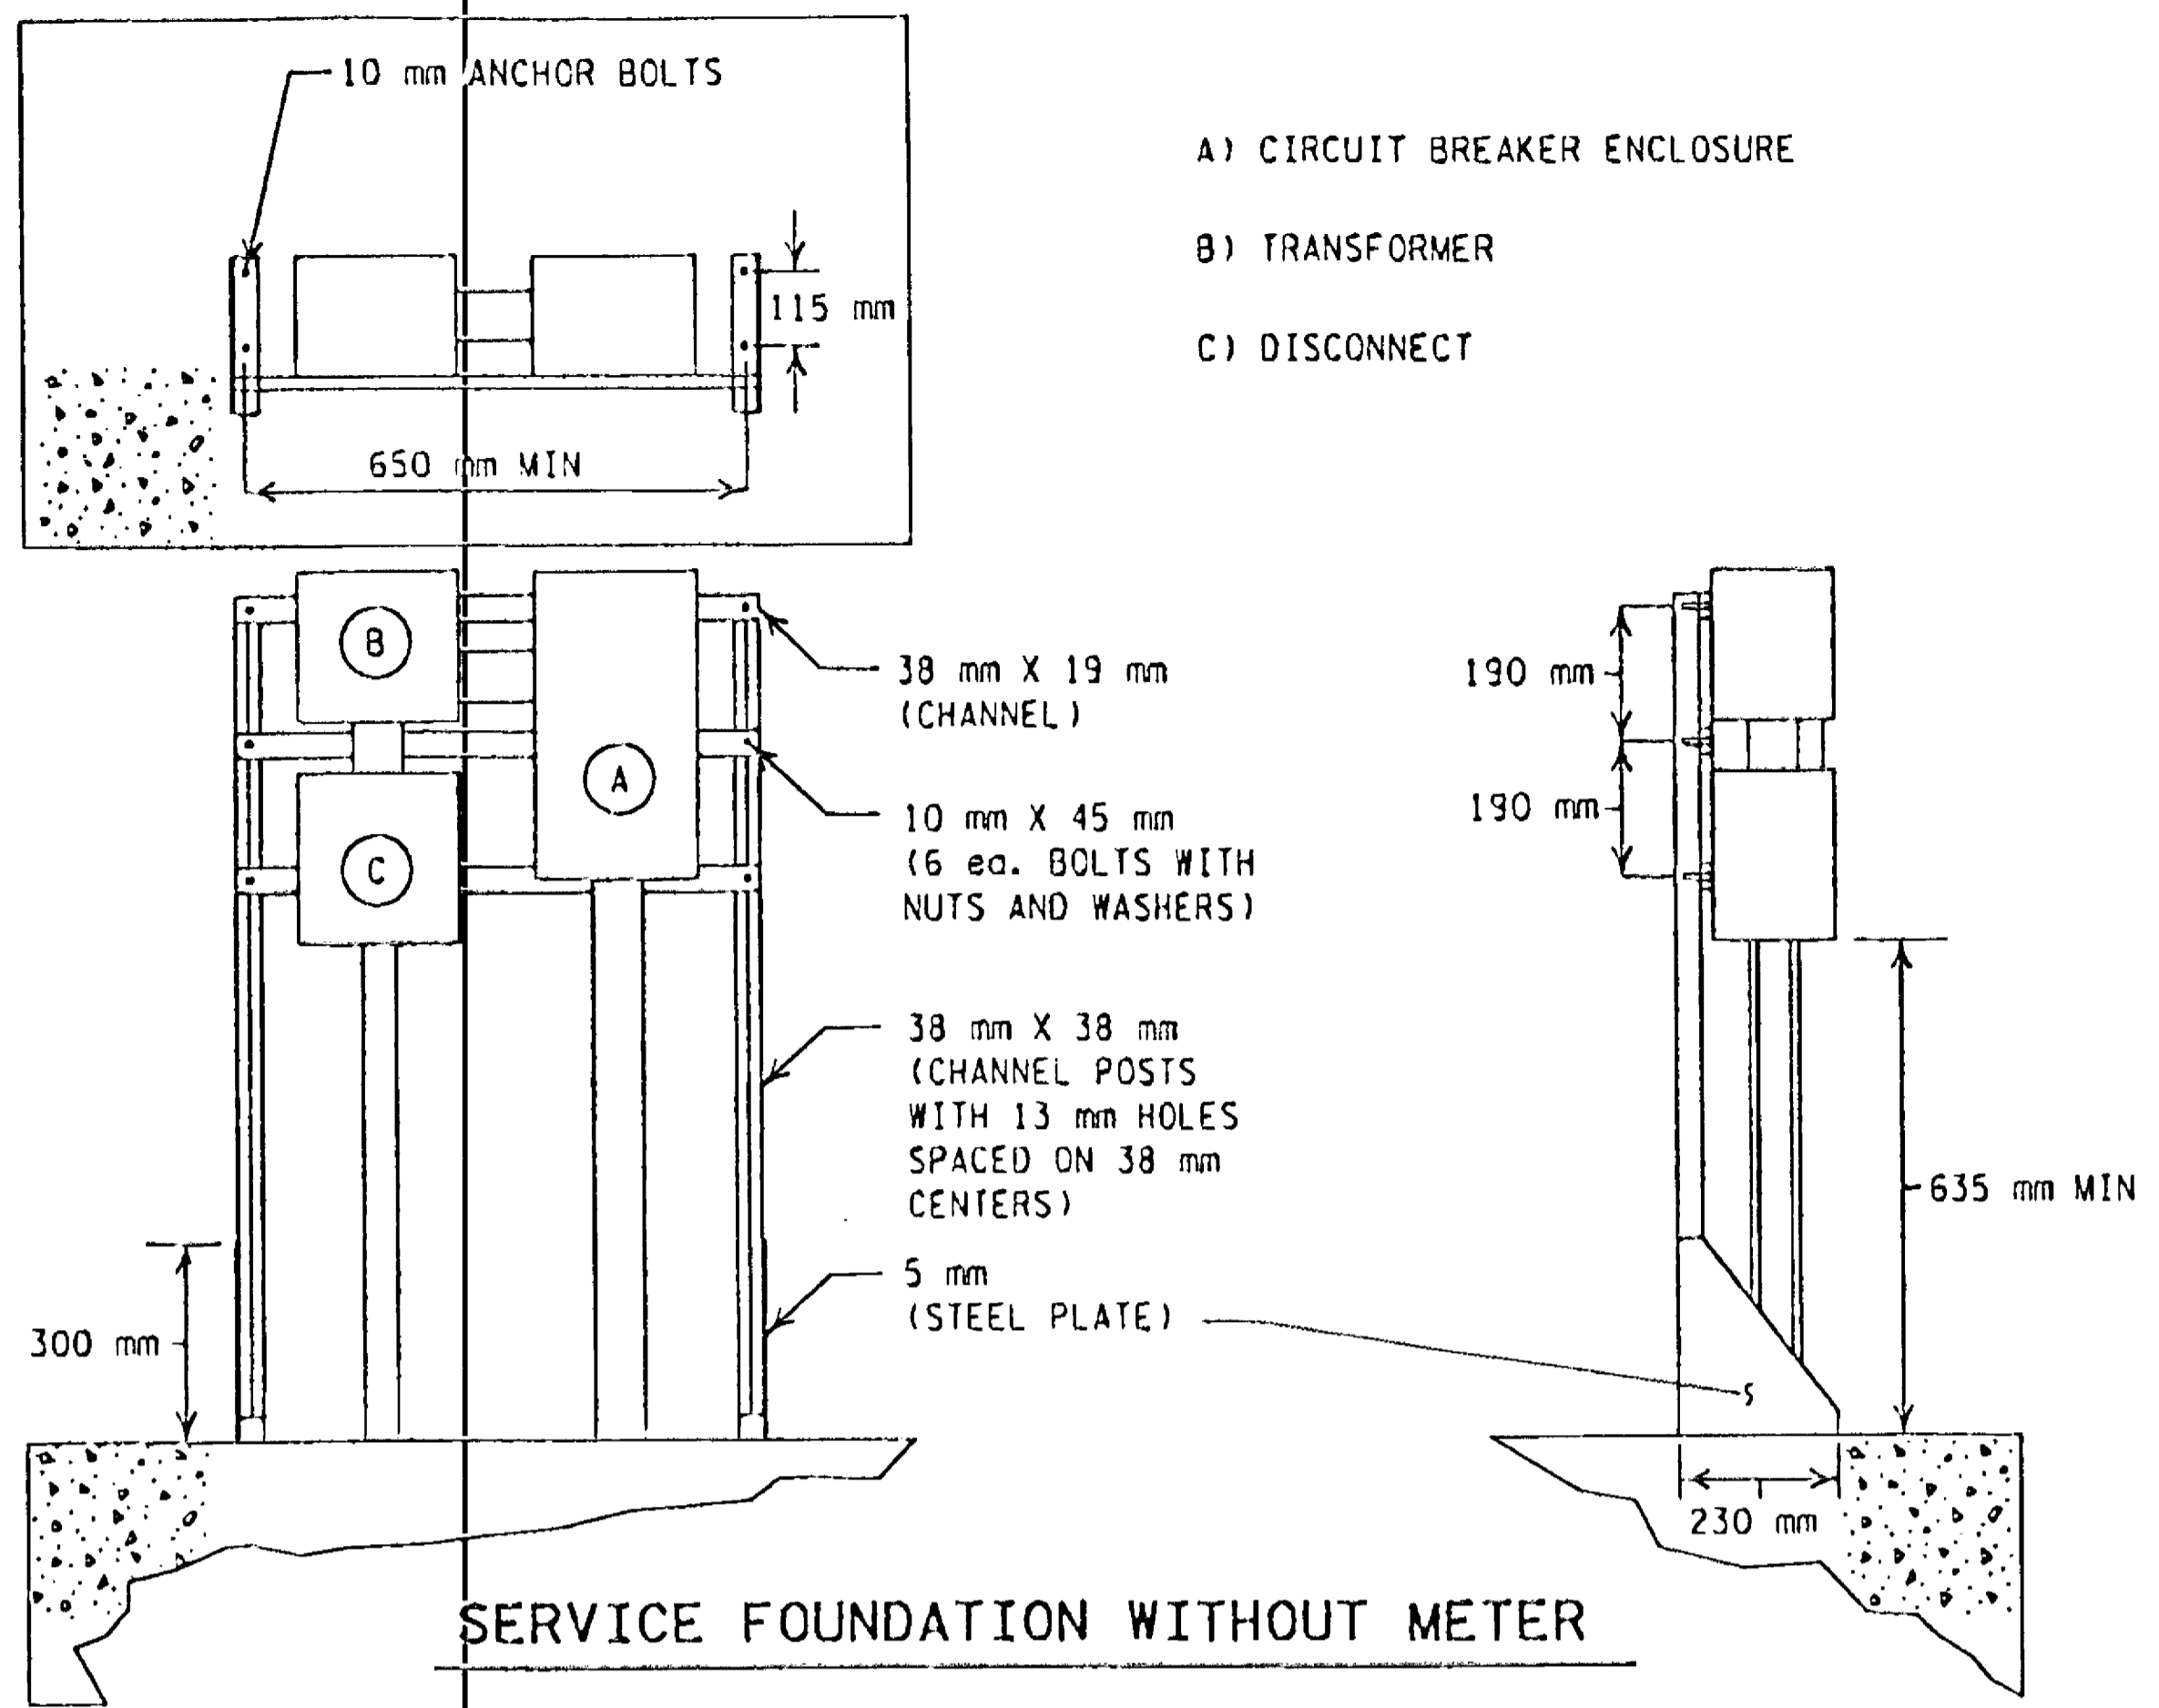

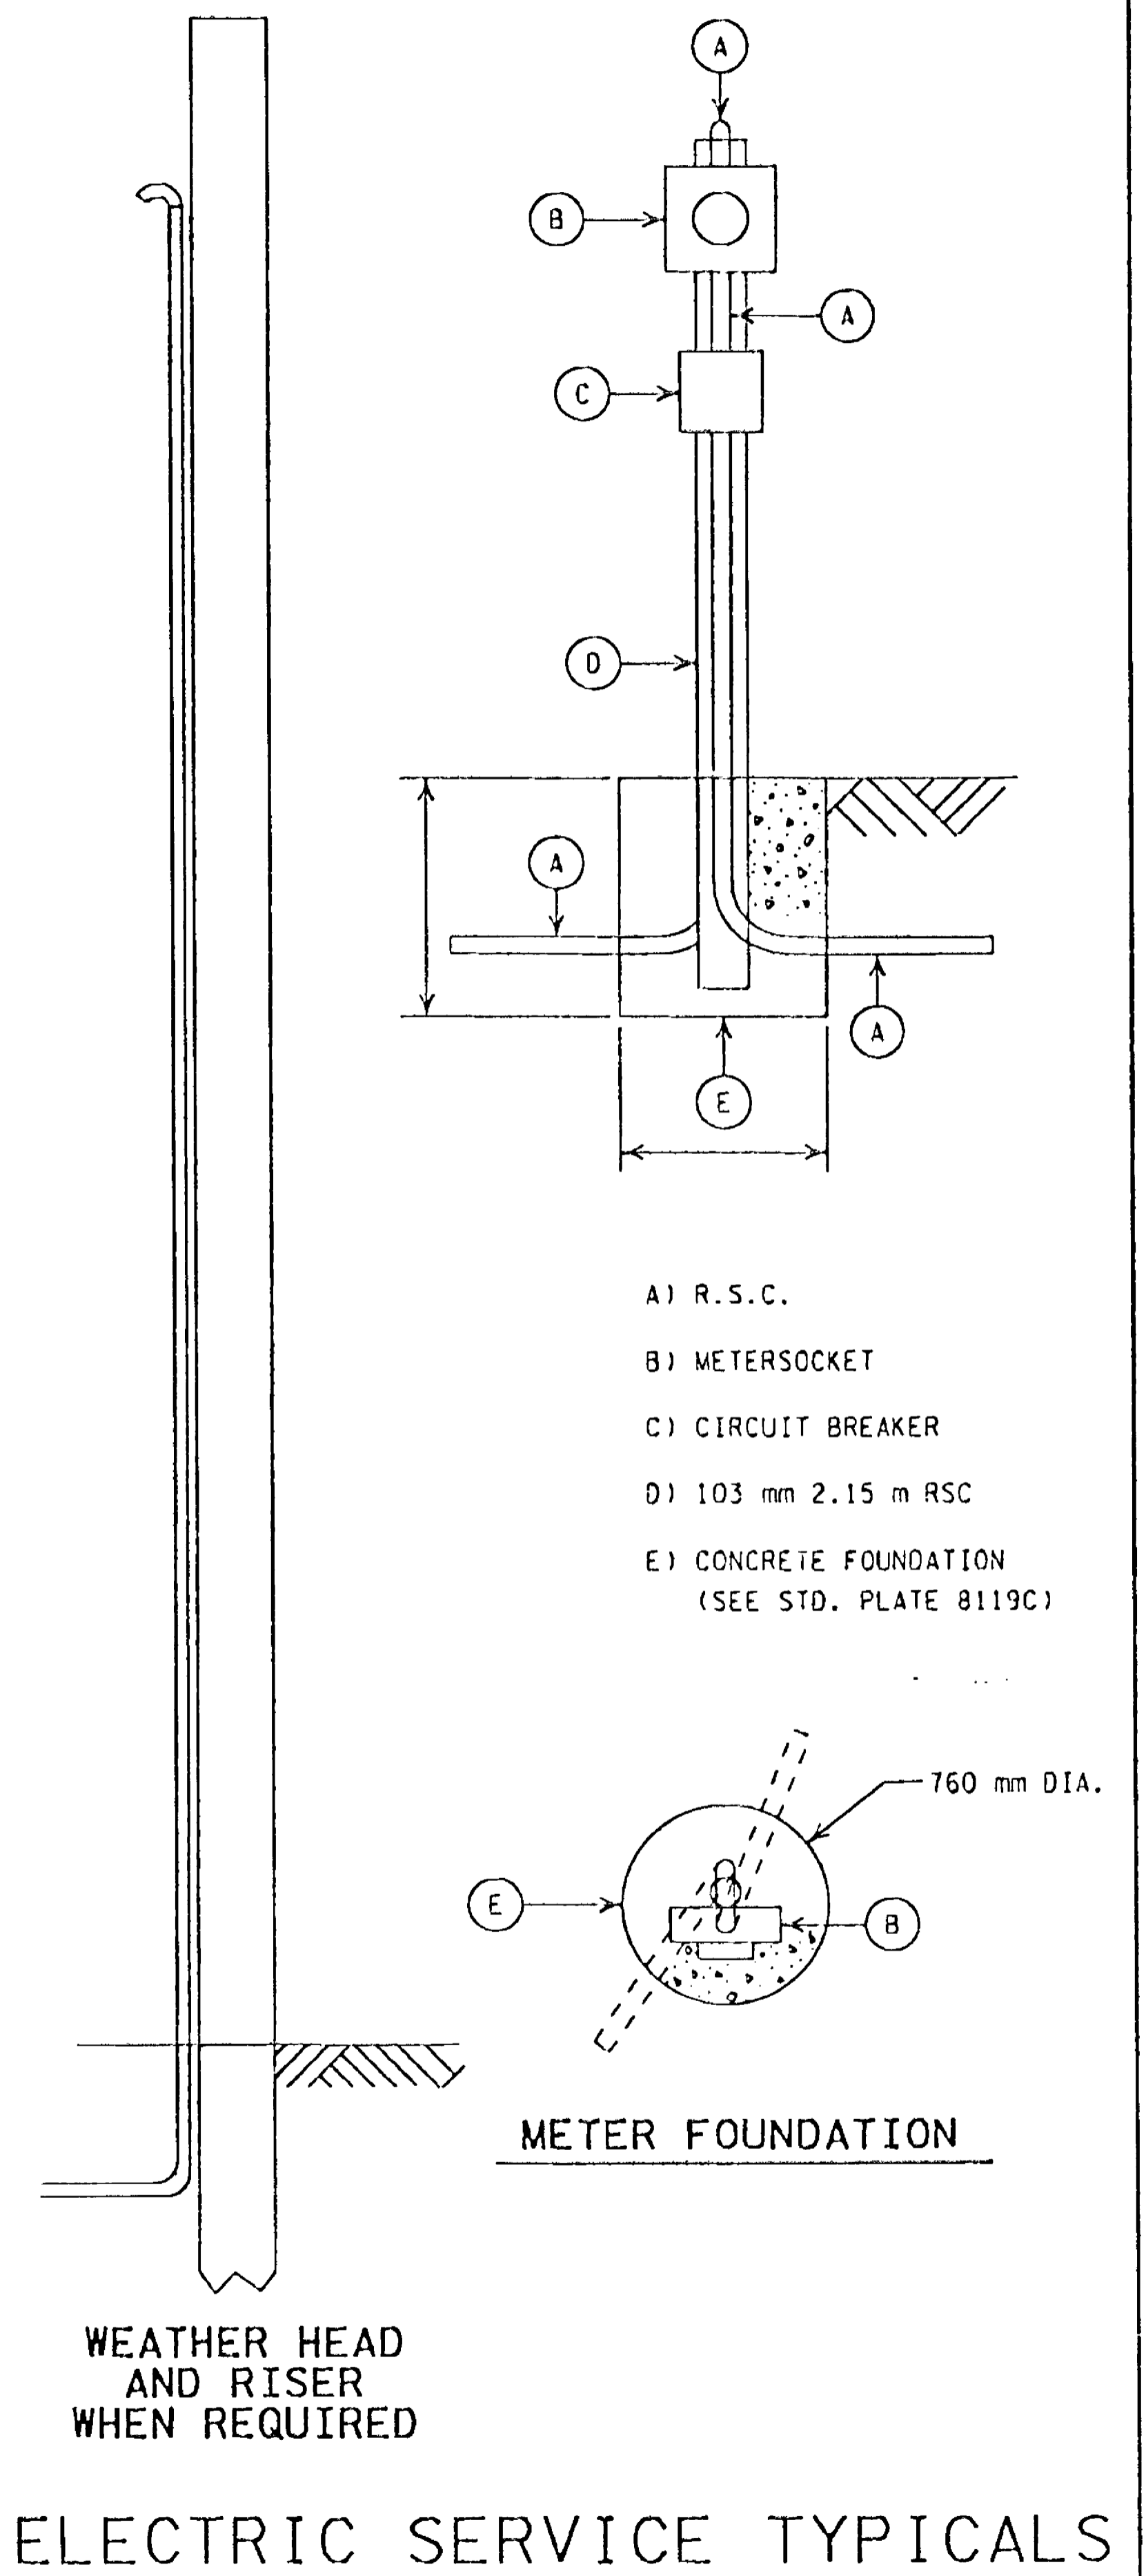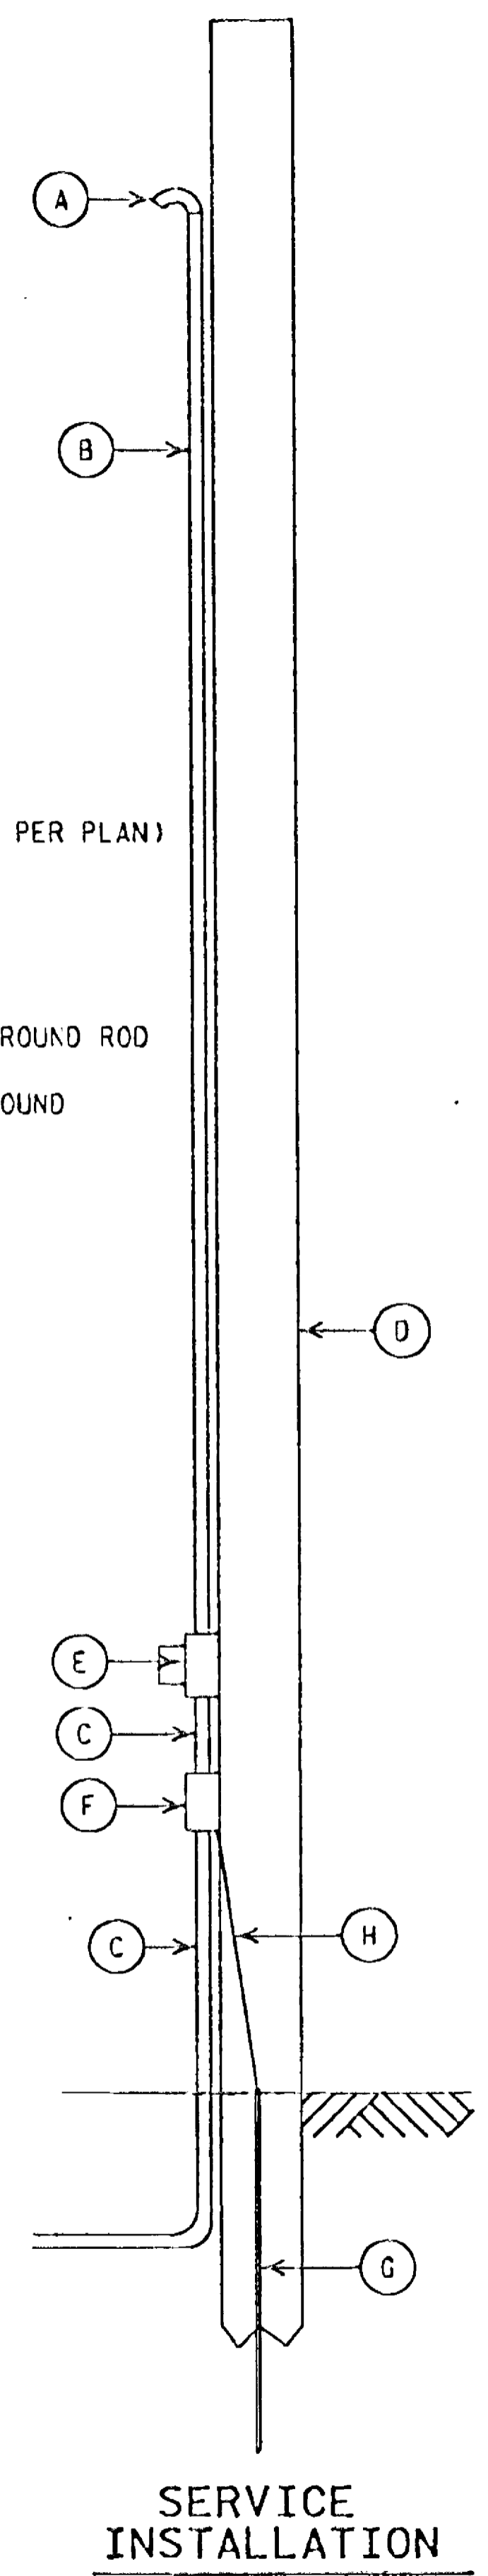

- A) WEATHERHEAD
- B) RISER
- C) 53 mm RSC
- D) WOOD POLE (AS PER PLAN)
- E) METERSOCKET
- F) DISCONNECT
- G) 16 mm X 5 m GROUND ROD
- H) No. 4 BARE GROUND





NOTES:

ALL CONDUIT IS NOT SHOWN ON THIS PLAN.
SEE TABULATIONS FOR MORE INFORMATION
SEE NEXT SHEET FOR WIRING DIAGRAM


LEGEND

- ⊙* EXISTING LIGHTING UNIT
- * LIGHTING UNIT
- === 78mm RIGID STEEL CONDUIT
- DIRECT BURIED ARMORED POWER CABLE
- ⊘ PERMANENT GROUND ROD
-  INDICATES EXISTING LIGHTING UNIT LOCATION
-  INDICATES PROPOSED LIGHTING UNIT LOCATION

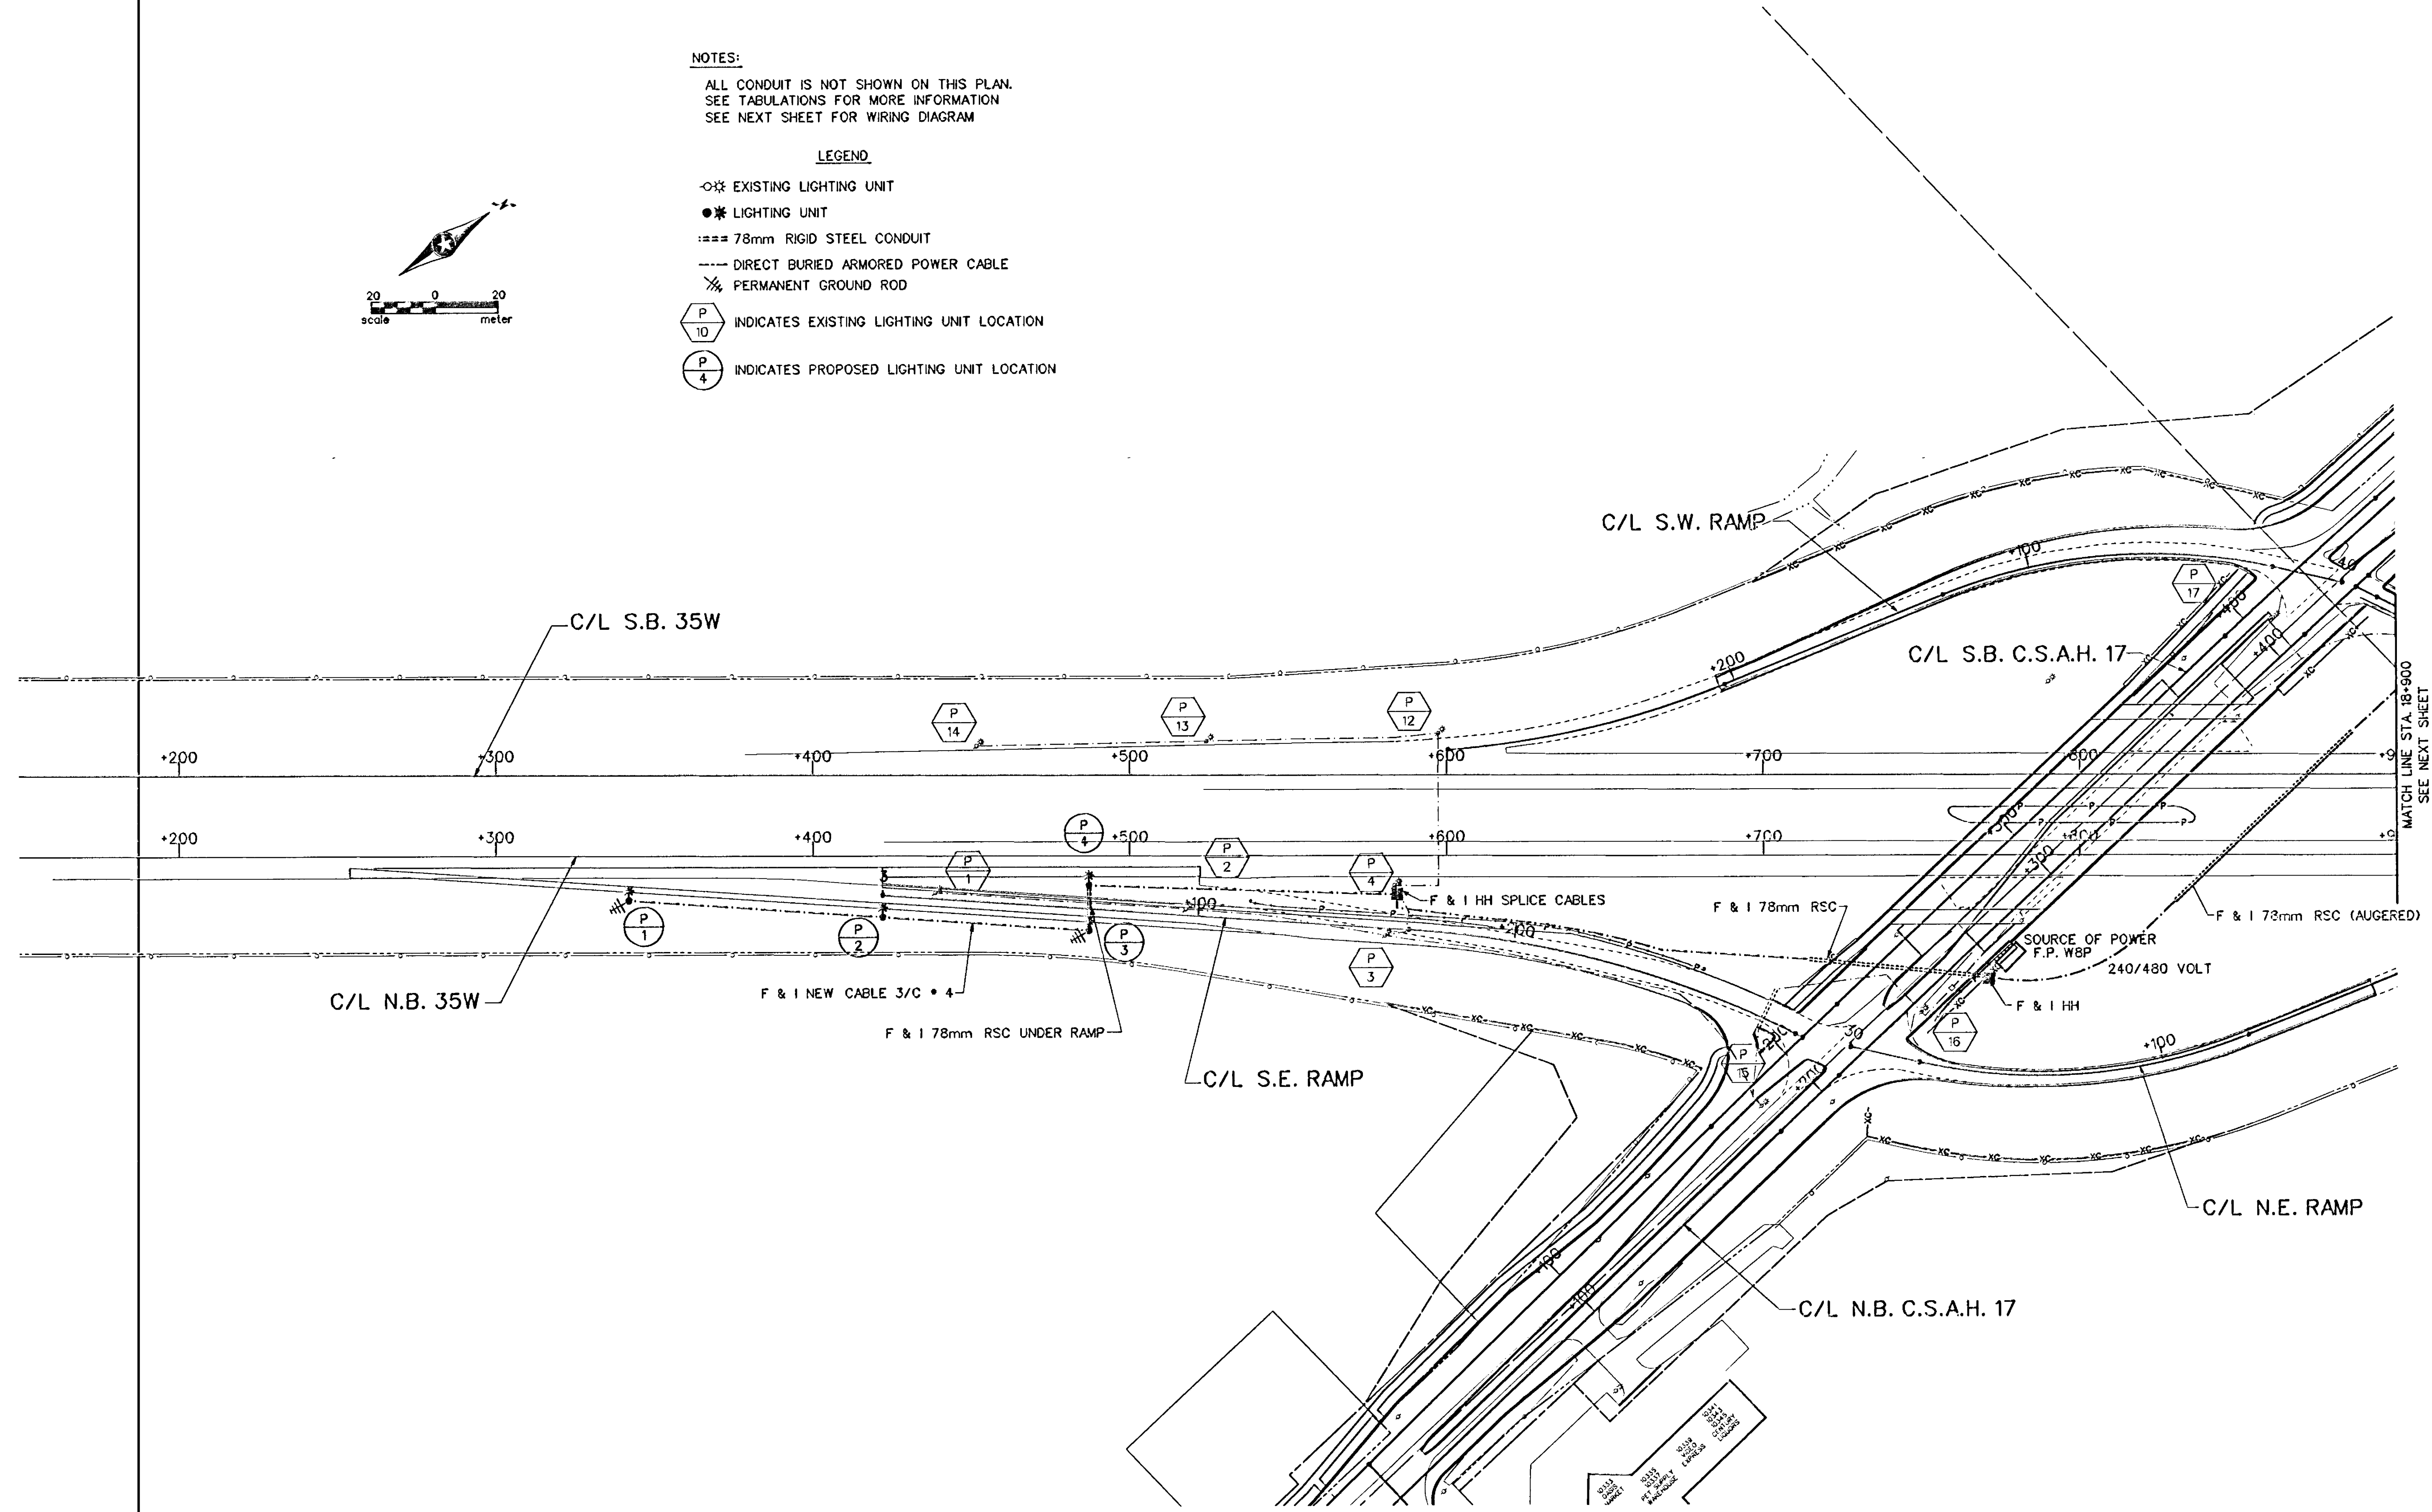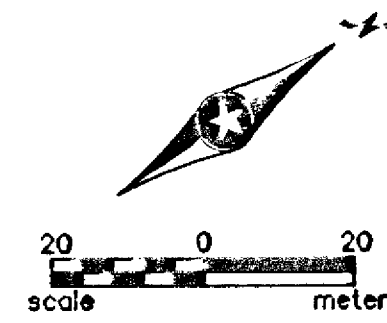

MATCH LINE STA. 18+900
SEE NEXT SHEET


1	4-24-97	MCI	DAD	ADD 240/480 VOLT AT S.O.P.
NO	DATE	BY	CHKD	APPR
				REVISION
NAME: LP1 410.PLN DATE: Mar. 17, 1997				

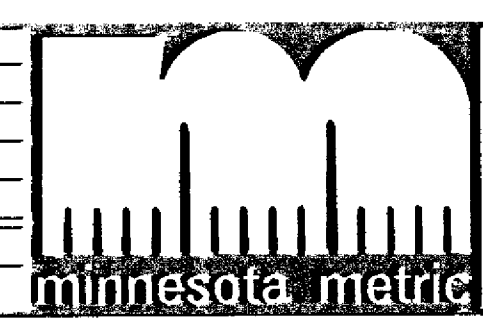

I hereby certify that this plan, specification or report was prepared by me or under my direct supervision and that I am a duly Registered Professional Engineer under the laws of the State of Minnesota.
Donald A. Domes
Date: 3-21-97 Reg. No. 23317


STATE AID PROJECT NO.
S.A.P. 02-617-11
S.A.P. 108-020-12
S.A.P. 108-030-03
CO. PROJECT NO.

DRAWN BY DATE
M. ISAKKA 12-98
DESIGNED BY
D. DEMERS 12-98
CHECKED BY
D. MICHALKO 1-97
COMM. NO.
0962410

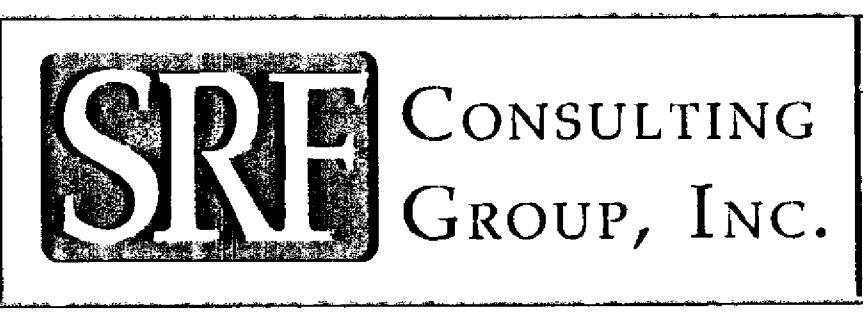

ANOKA COUNTY
LIGHTING PLAN
C.S.A.H. 17 RECONSTRUCTION

SHEET
145
OF
236

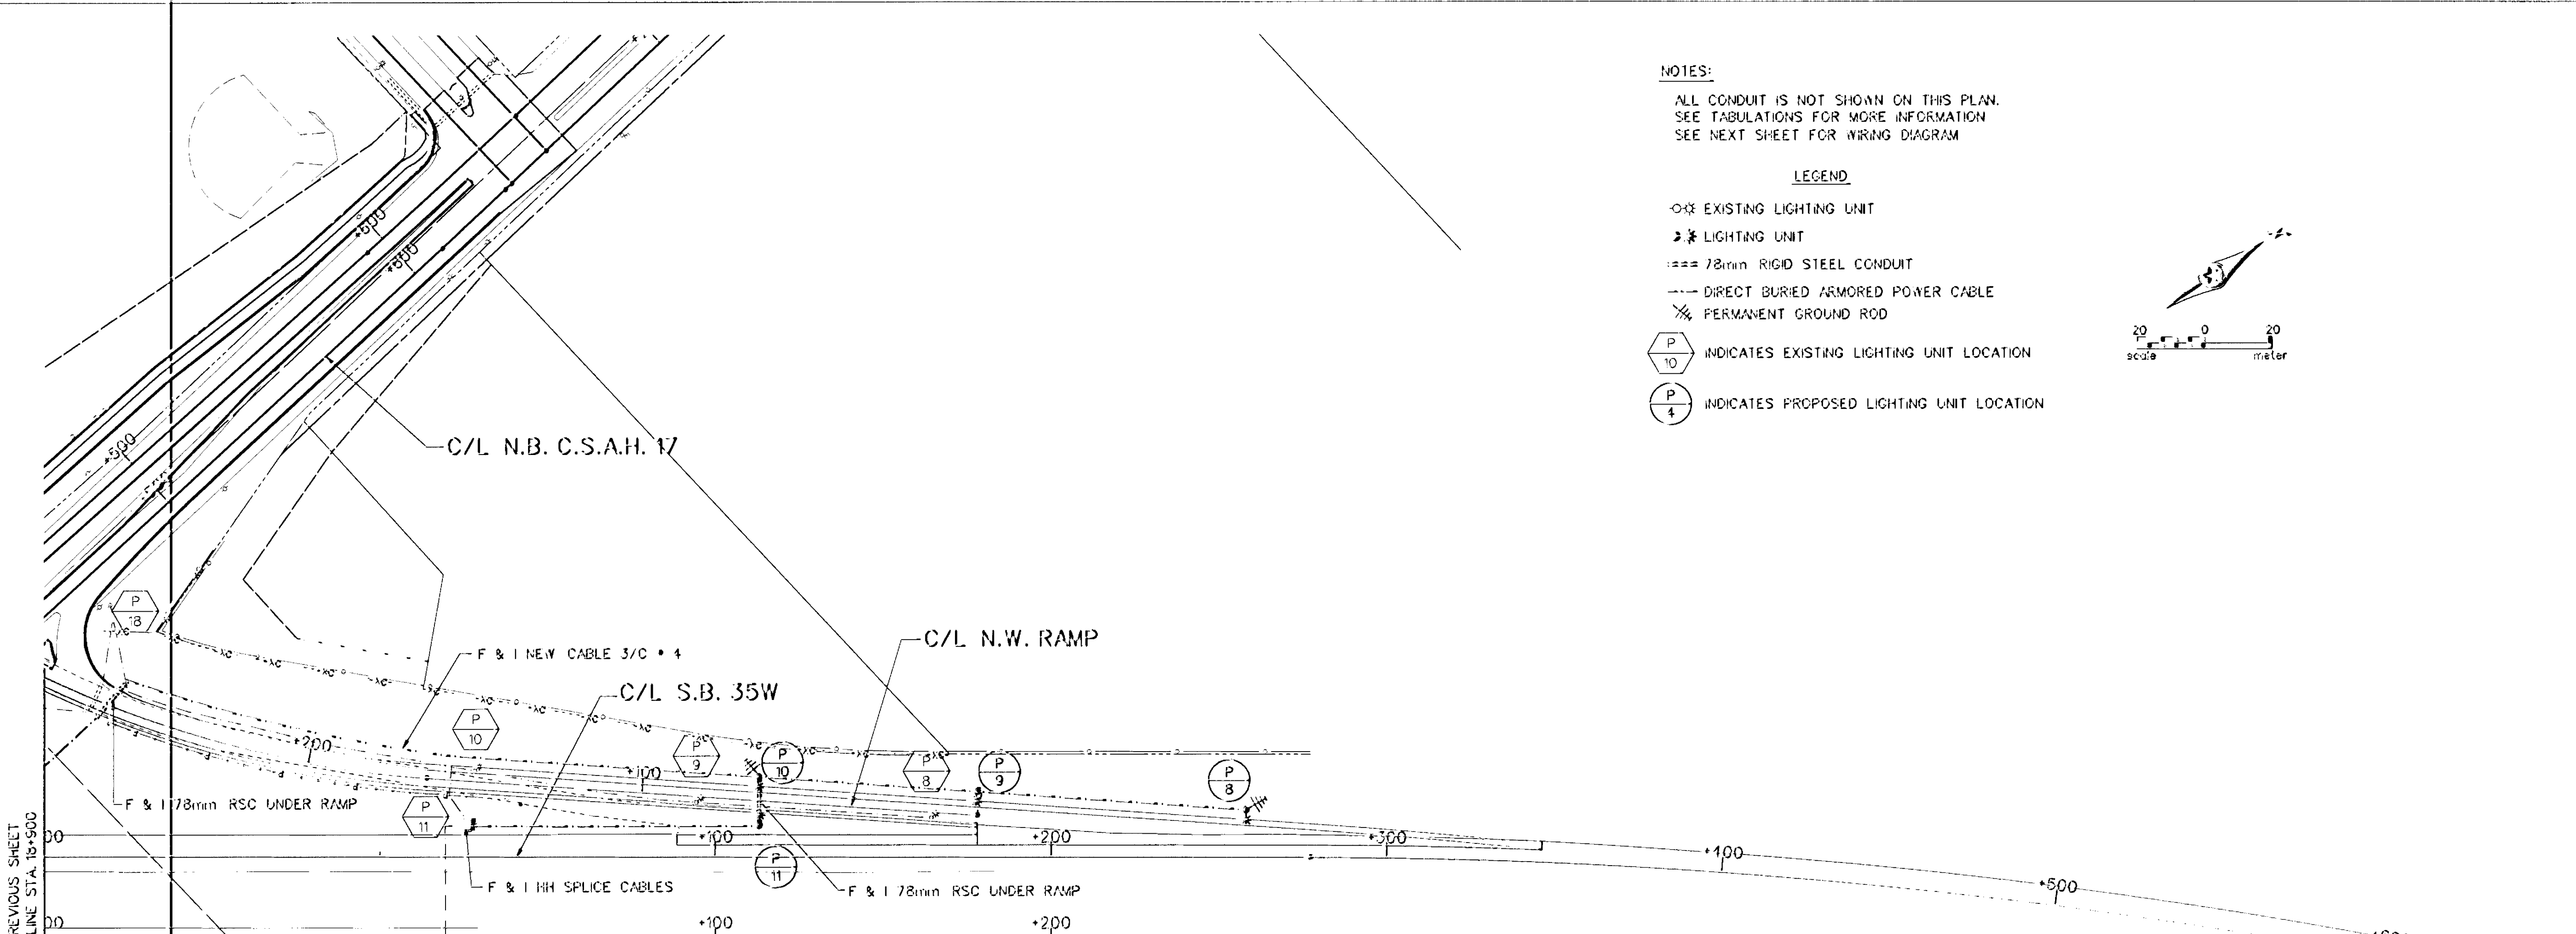


NOTES:

ALL CONDUIT IS NOT SHOWN ON THIS PLAN.
SEE TABULATIONS FOR MORE INFORMATION
SEE NEXT SHEET FOR WIRING DIAGRAM

LEGEND

- ⊗ EXISTING LIGHTING UNIT
- ⊗ LIGHTING UNIT
- === 78mm RIGID STEEL CONDUIT
- DIRECT BURIED ARMORED POWER CABLE
- ⊗ PERMANENT GROUND ROD
- (P 10) INDICATES EXISTING LIGHTING UNIT LOCATION
- (P 4) INDICATES PROPOSED LIGHTING UNIT LOCATION

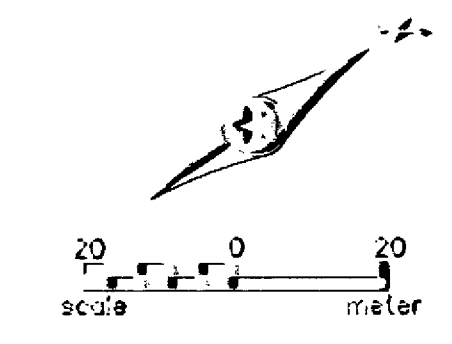


SEE PREVIOUS SHEET
MATCH LINE STA. 10+500

SOURCE OF POWER
F.P. WBP
240/180 V.
4- 20 AMP CIRCUIT BREAKERS
R W B

NOTES:
-B AND R DENOTE CURRENT CARRYING CONDUCTORS
-1/C * 6 BARE GROUND IS REQUIRED IN ALL NMC
(GROUND WIRE NOT SHOWN IN CIRCUIT DIAGRAMS)


- (P XX) INDICATES PROPOSED LIGHTING UNIT
- (P XX) INDICATES EXISTING LIGHTING UNIT

WIRING DIAGRAM

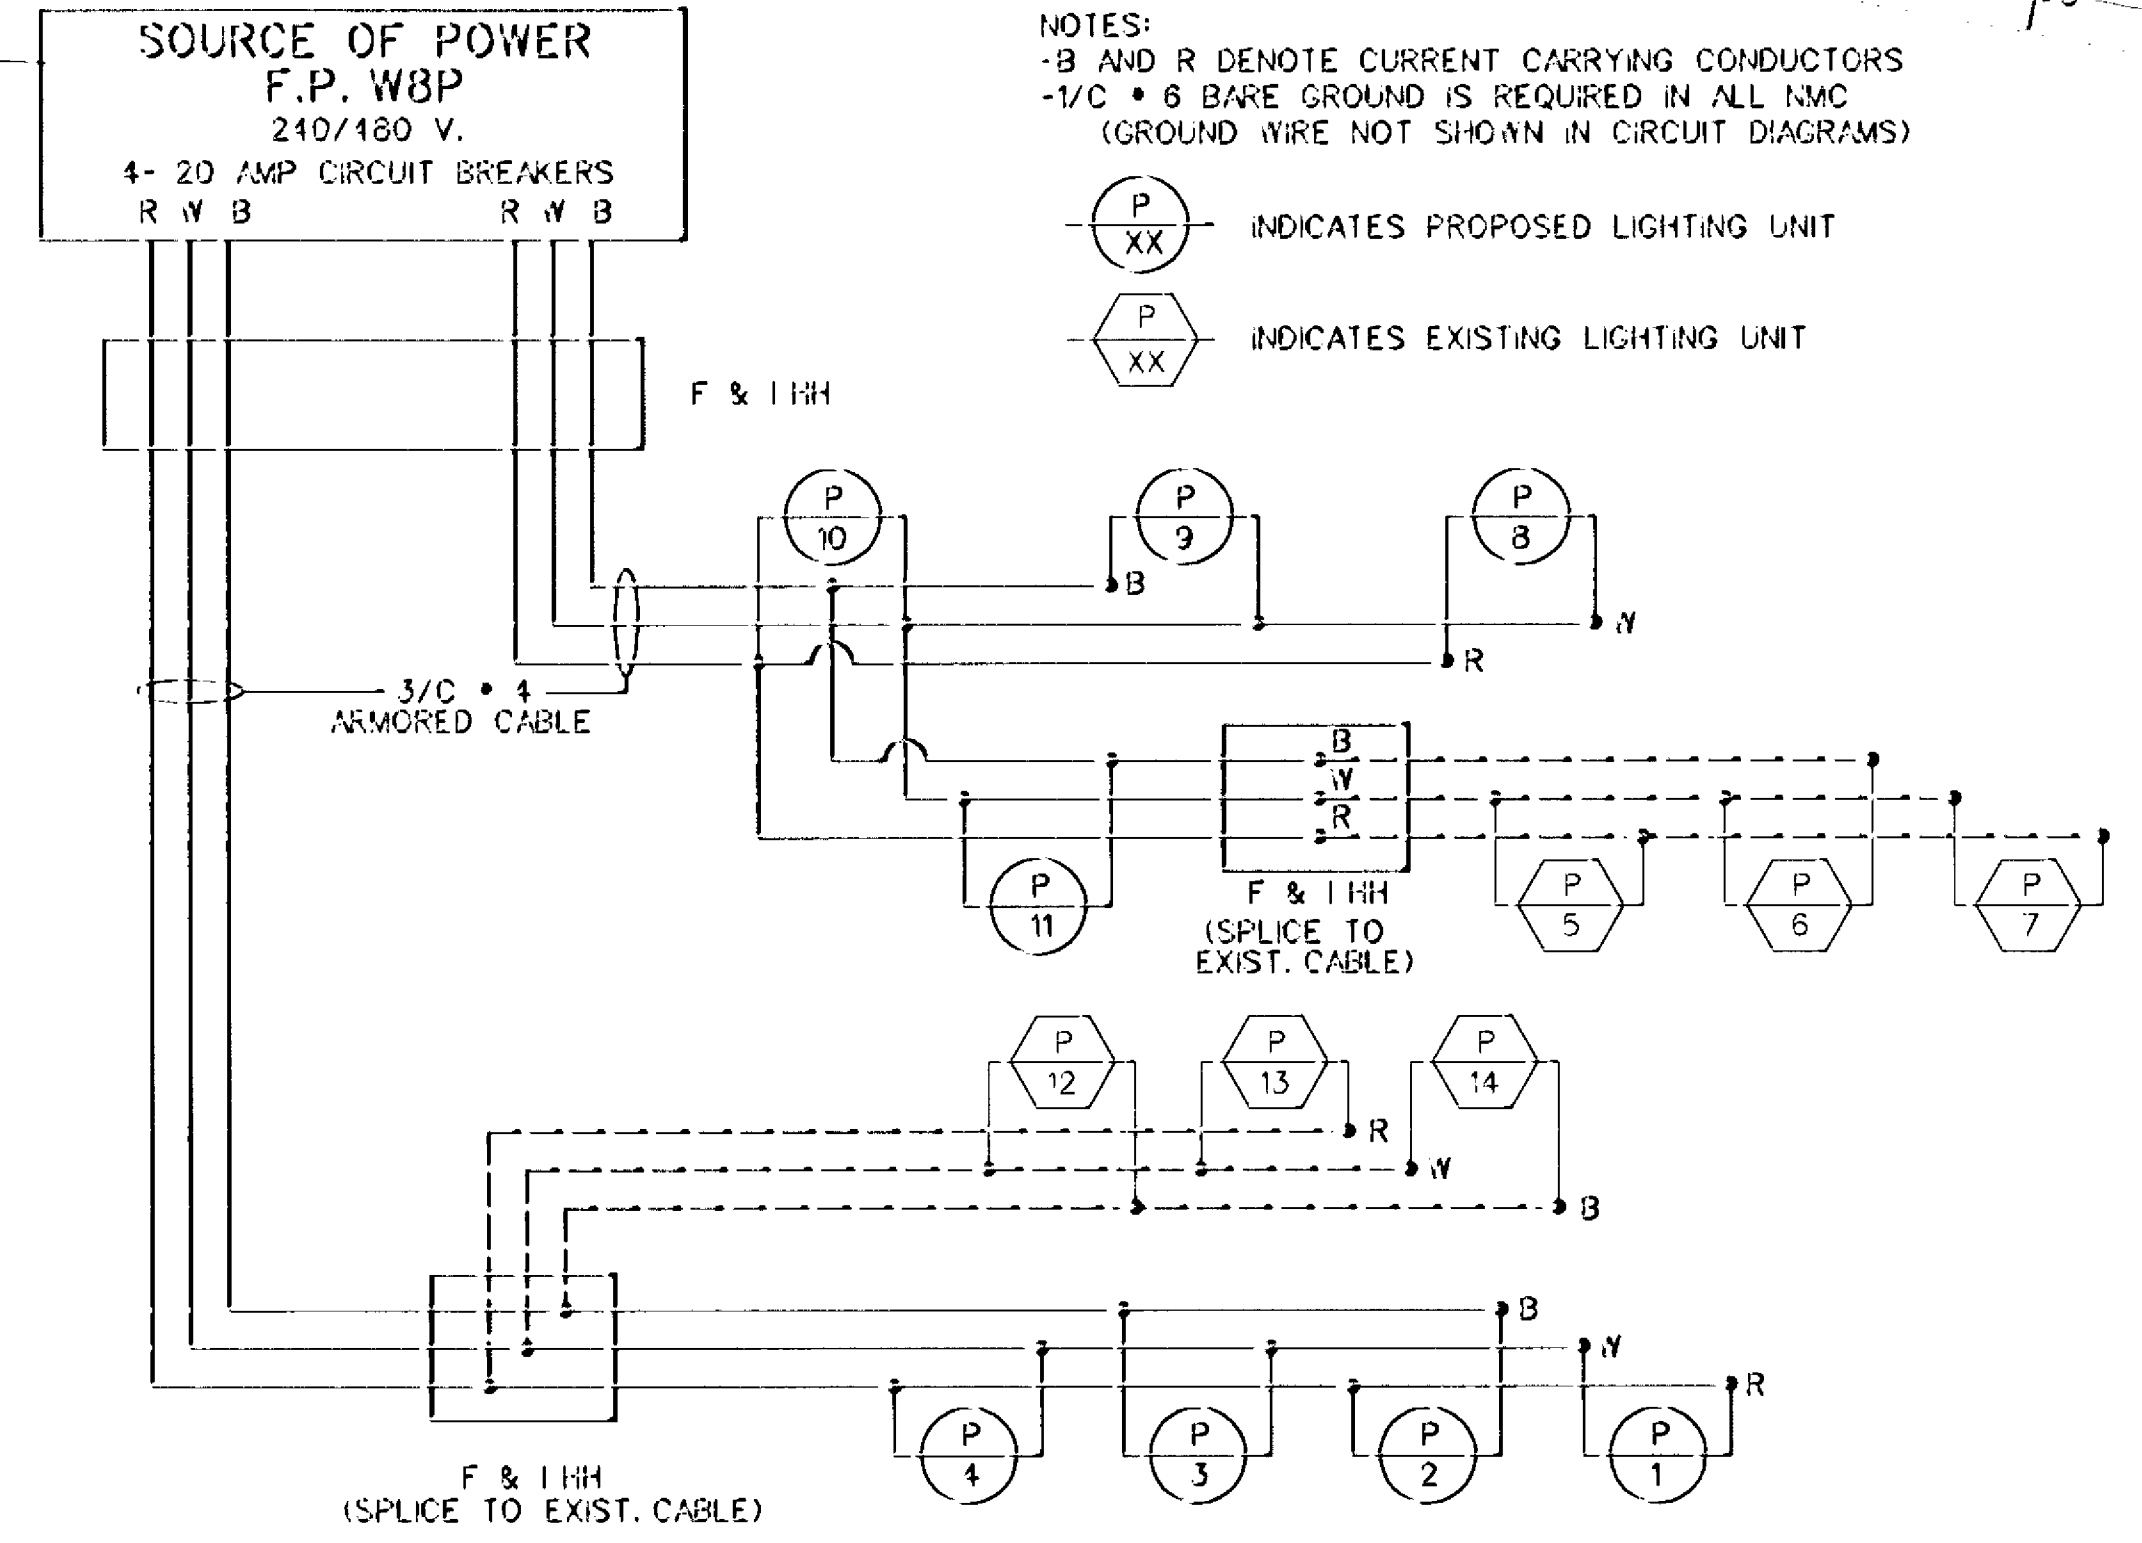

NO.	DATE	BY	C.D.	APPR.	REVISION

NAME: LP2 410.PLN DATE: Mar. 17, 1997

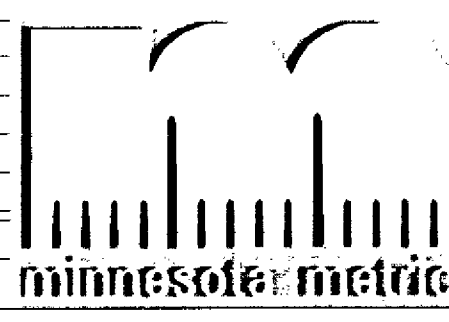


I hereby certify that this plan, specification or report was prepared by me or under my direct supervision and that I am a duly Registered Professional Engineer under the laws of the State of Minnesota.

Donald A. Demers
Date: 3-21-97 Reg. No. 23397


STATE AID PROJECT NO.
S.A.P. 02-617-11
S.A.P. 106-020-12
S.A.P. 106-030-03
CO. PROJECT NO.

DRAWN BY M. ISAKKA DATE 12-96
DESIGNED BY D. DEMERS 12-96
CHECKED BY D. MICHALKO 1-97
COMM. NO. 0962410


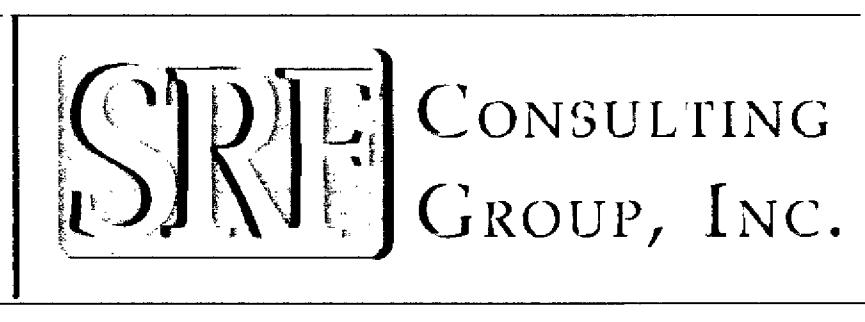


ANOKA COUNTY
LIGHTING PLAN
C.S.A.H. 17 RECONSTRUCTION

SHEET
146
OF
236

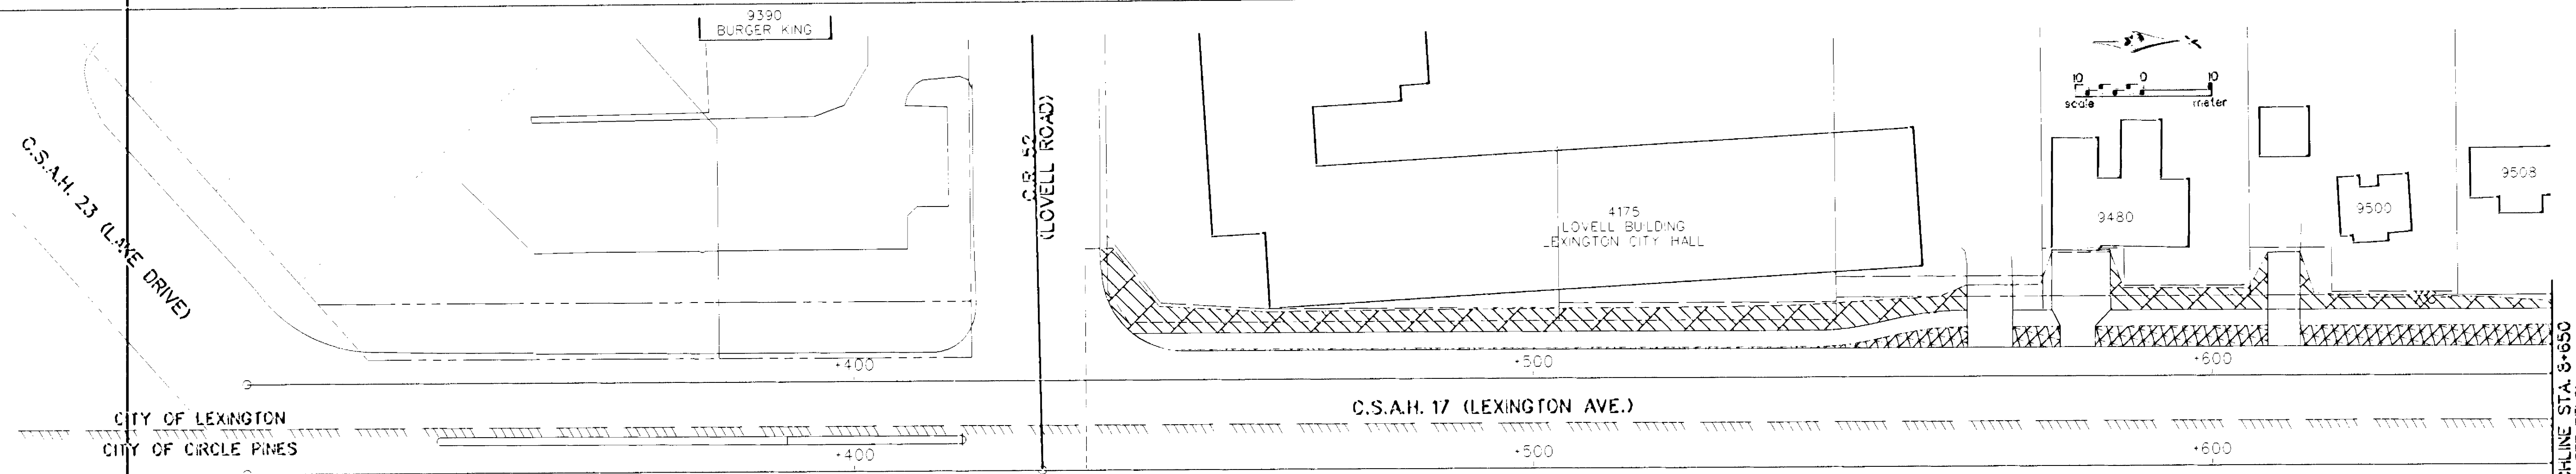

LEGEND	
SILT FENCE	
BALE CHECKS	
SEED (MIXTURE 20A)	
SEED (MIXTURE 25A)	
SOD (TYPE LAMN)	
SOD (SALT RESISTANT)	
SEED (MIXTURE 20A) STRAW 2S BLANKET	
PLACE SOD AT APRON END SEE STD. PLATE 9102	(S)
PLACE RIPRAP AT APRON END SEE STD. PLATE 3133	(R)

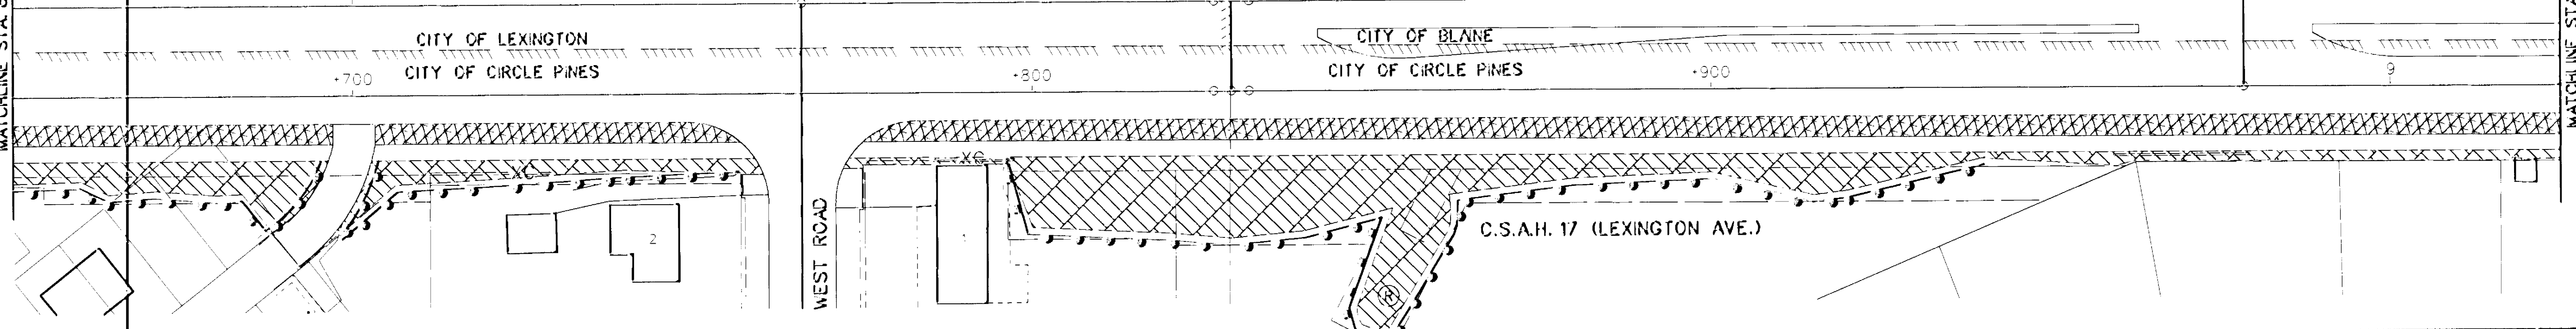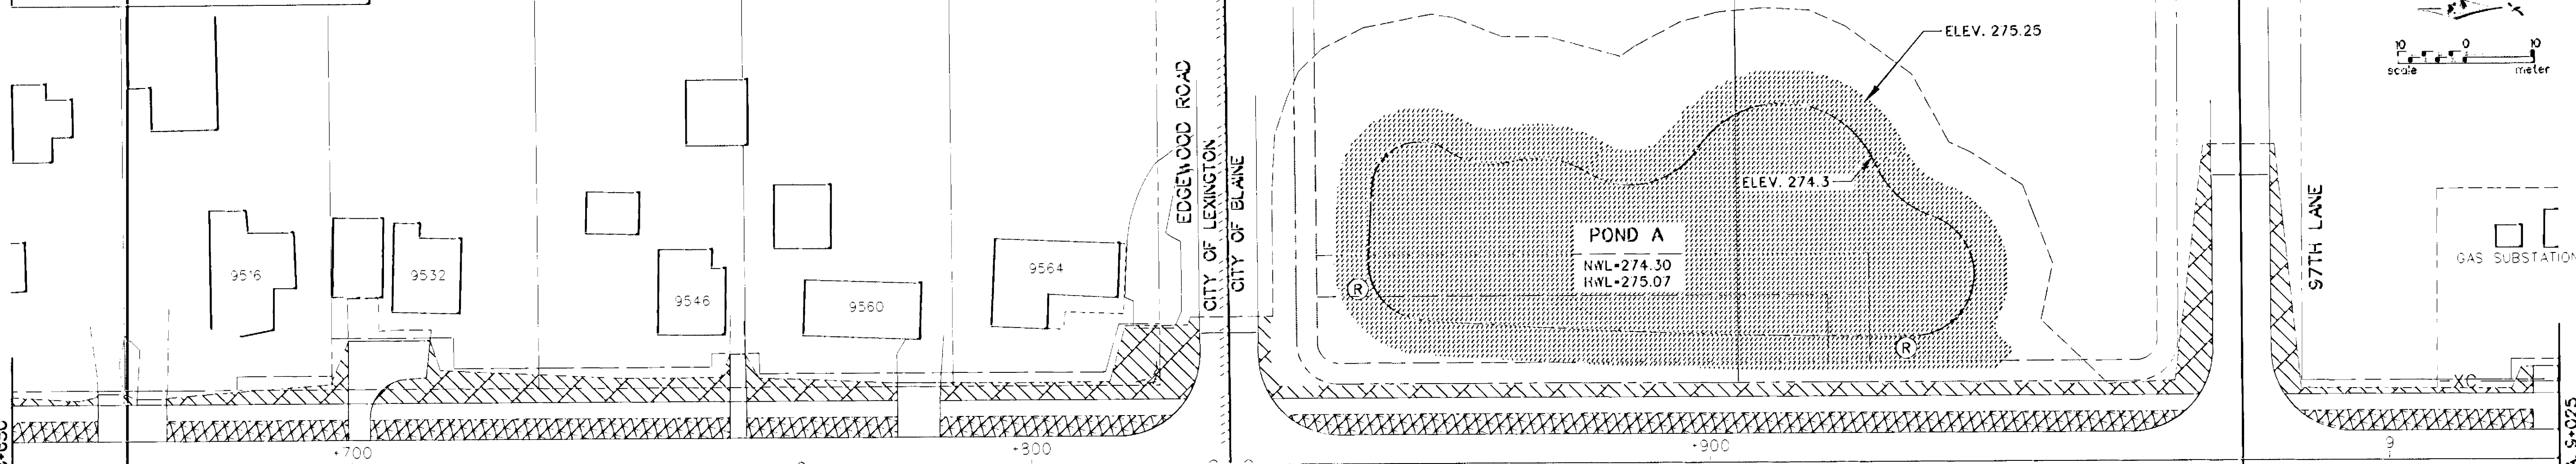

NO	DATE	BY	CHKD	APPR	REVISION
1	3-26-97	MCI		DAD	ADD R NOTE AT 234
2	4-1-97	MCI		DAD	REVISE SEED MX FROM 20A TO 25A

I hereby certify that this plan, specification or report was prepared by me or under my direct supervision and that I am a duly Registered Professional Engineer under the laws of the State of Minnesota.

Donald A. James



 Date 3-21-97 Reg. No. 23397

STATE AID PROJECT NO. _____
 S.A.P. 02-617-11
 S.A.P. 106-020-12
 S.A.P. 106-030-03
 CO. PROJECT NO. _____
 DRAWN BY M. WSAKKA DATE 12-96
 DESIGNED BY B. URBANEK DATE 12-96
 CHECKED BY D. DEMERS DATE 1-97
 COMM. NO. 0962410

CONSULTING GROUP, INC.

ANOKA COUNTY
 TURF ESTABLISHMENT/ EROSION CONTROL PLAN
 C.S.A.H. 17 RECONSTRUCTION
 STA. 8+358 TO STA. 9+025

SHEET 147 OF 236

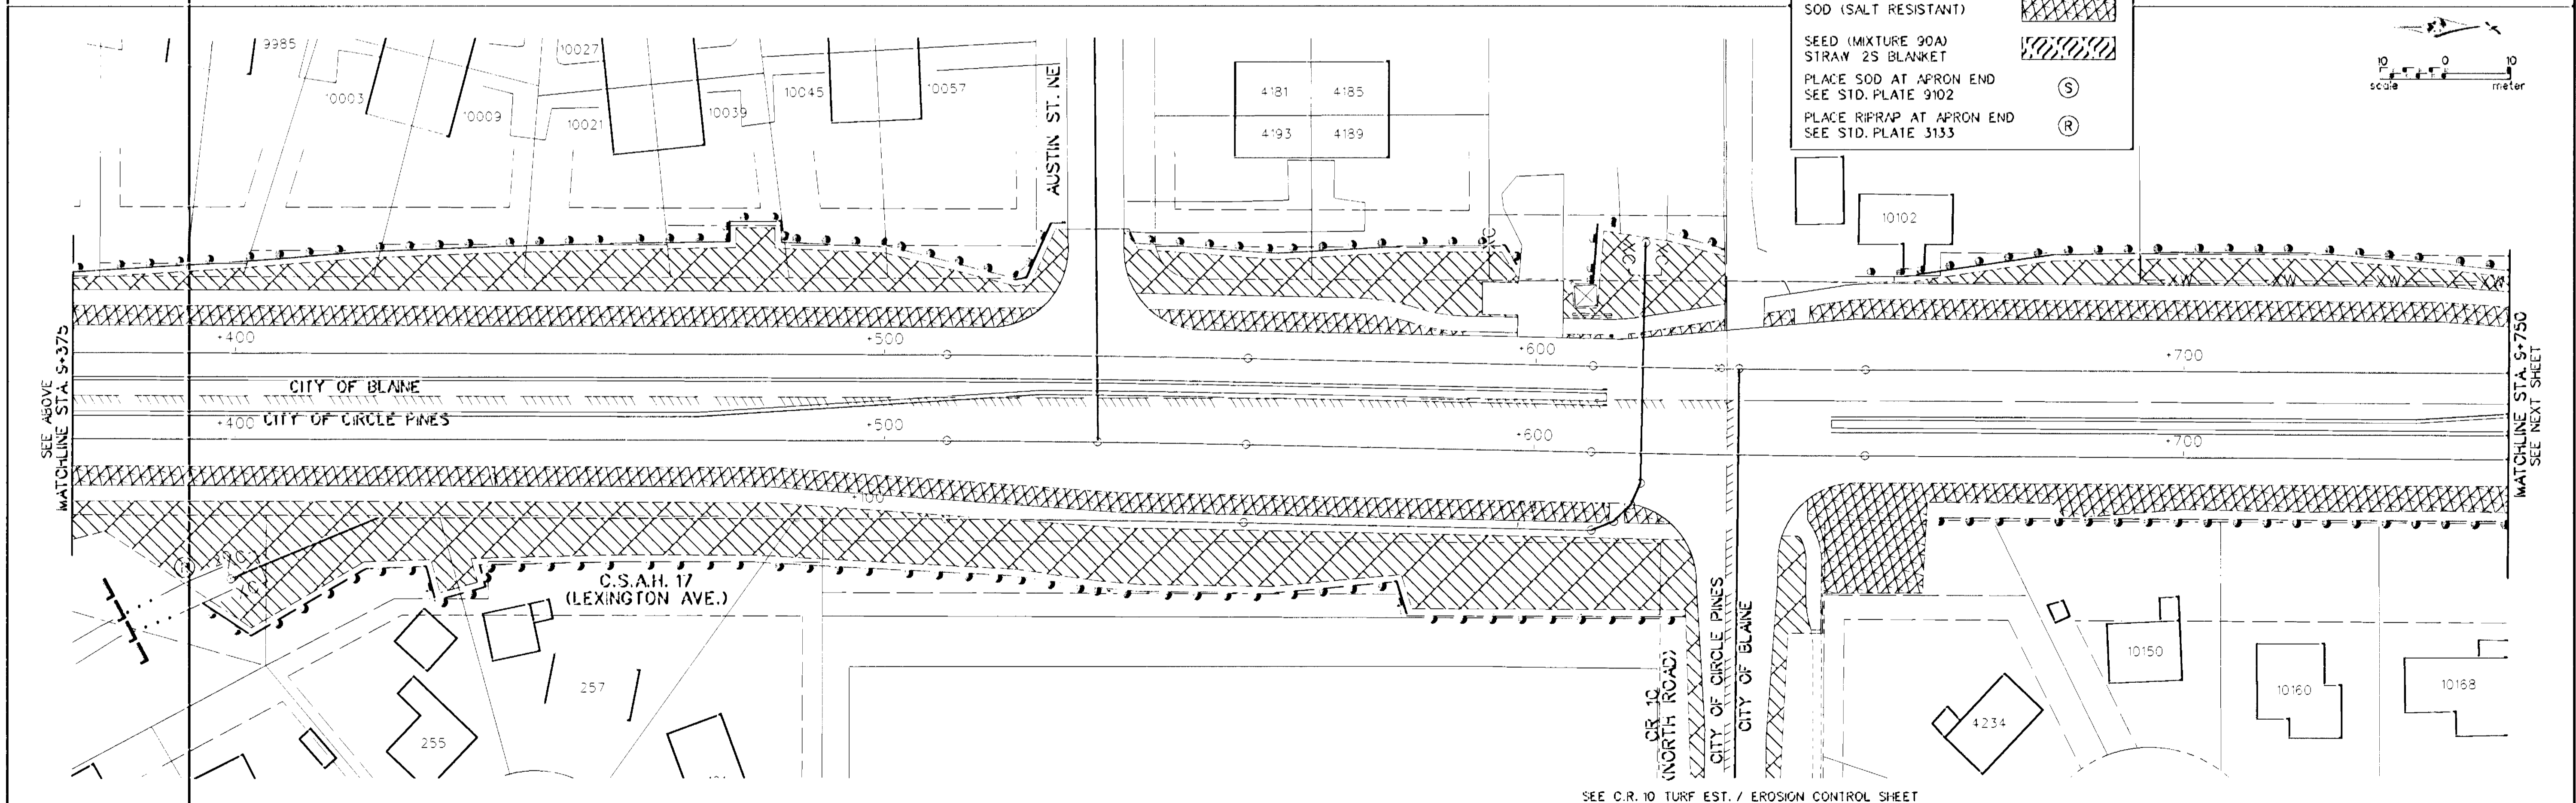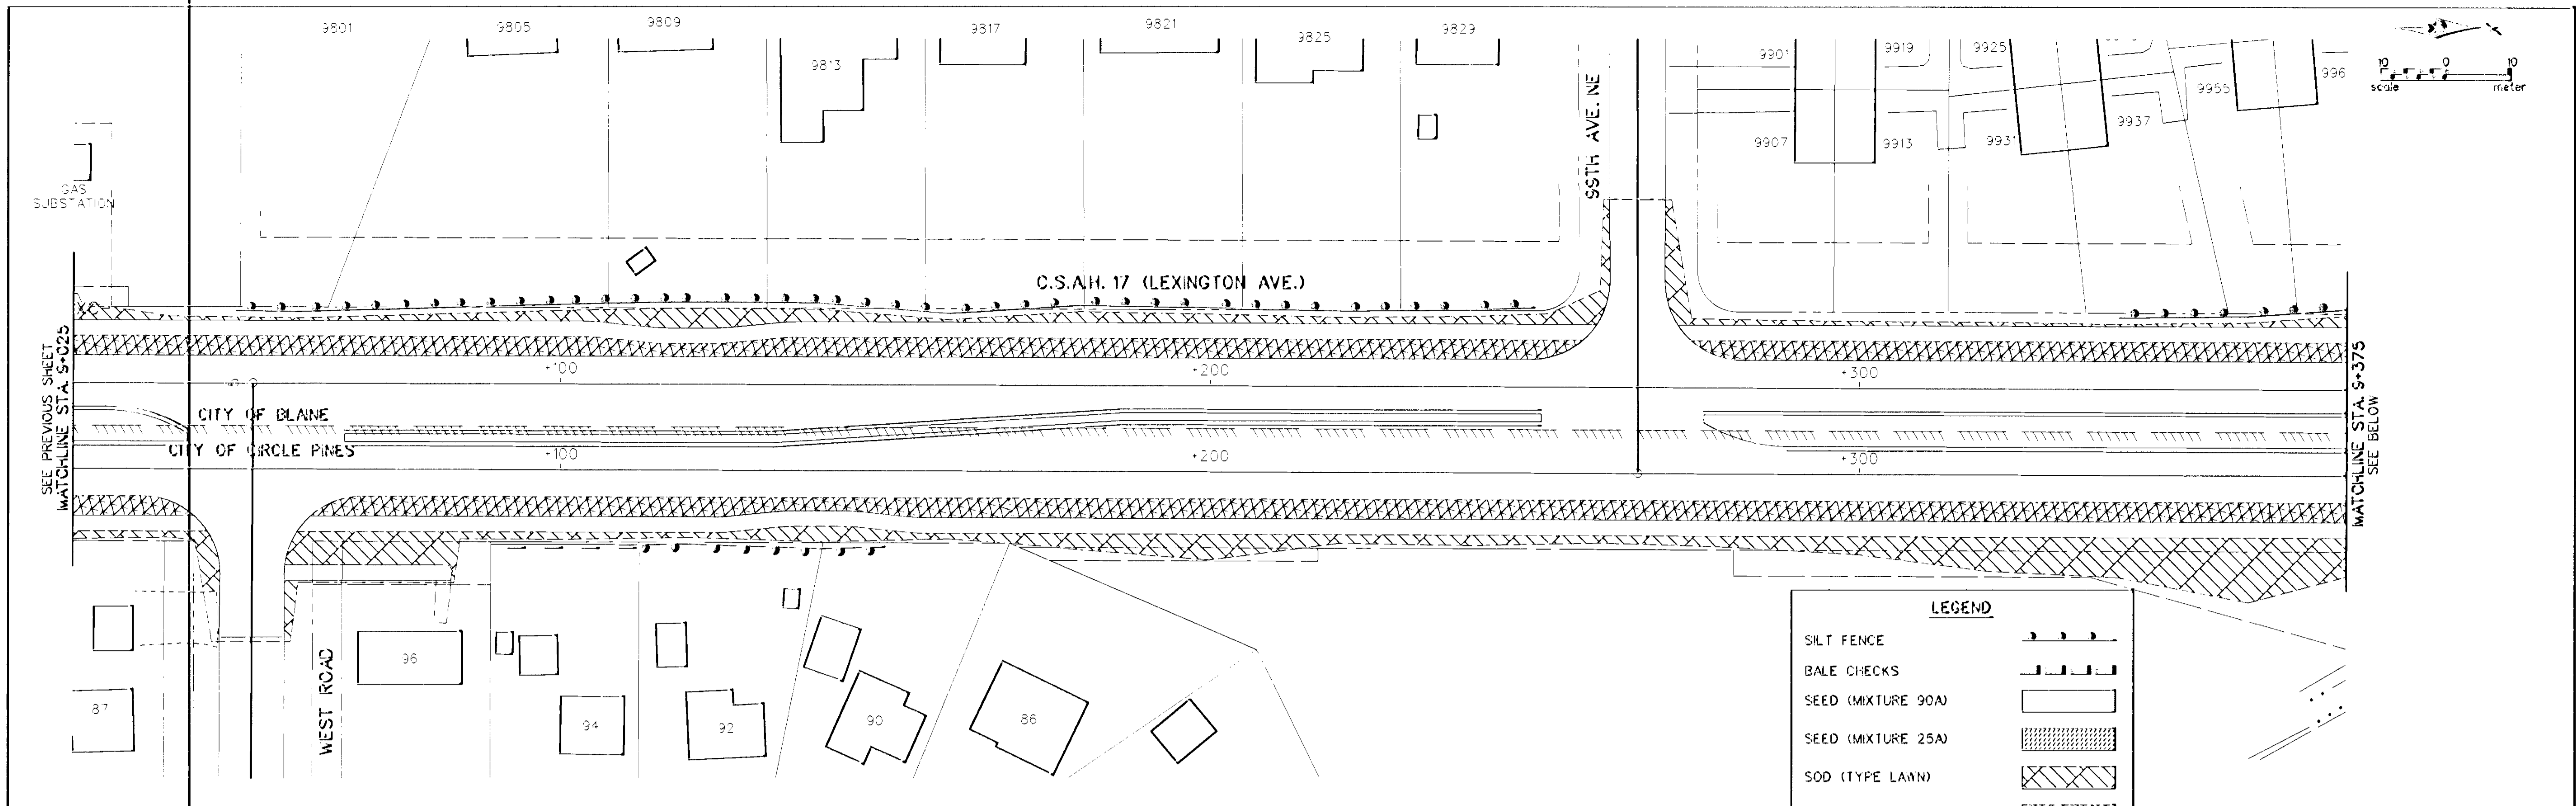

LEGEND

SILT FENCE	
BALE CHECKS	
SEED (MIXTURE 90A)	
SEED (MIXTURE 25A)	
SOD (TYPE LAWN)	
SOD (SALT RESISTANT)	
SEED (MIXTURE 90A) STRAW 2S BLANKET	
PLACE SOD AT APRON END SEE STD. PLATE 9102	(S)
PLACE RIPRAP AT APRON END SEE STD. PLATE 3133	(R)

1	3-26-97	MCI	DAD	ADD R NOTE AT 309 TEMP.	
2	4-1-97	MCI	DAD	REVISE SEED MIX FROM 20A TO 25A	
NO	DATE	BY	CHK	APPR	REVISION
NAME: TE2 410.PLN DATE: Mar. 17, 1997					

I hereby certify that this plan, specification or report was prepared by me or under my direct supervision and that I am a duly Registered Professional Engineer under the laws of the State of Minnesota.

Donald A. Demas
Date: 3-21-97 Reg. No. 23397

STATE NO. PROJECT NO.
S.A.P. 02-617-11
S.A.P. 108-020-12
S.A.P. 106-030-03
CO. PROJECT NO.





DRAWN BY DATE
M. ISAKKA 12-96
DESIGNED BY
B. URBANEK 12-96
CHECKED BY
D. DEMERS 1-97
COMM. NO.
0962410

SRT CONSULTING GROUP, INC.

ANOKA COUNTY
TURF ESTABLISHMENT/ EROSION CONTROL PLAN
C.S.A.H. 17 RECONSTRUCTION
STA. 9+025 TO STA. 9+750


SHEET 148 OF 236

LEGEND			
SILT FENCE		SOD (SALT RESISTANT)	
BALE CHECKS		SEED (MIXTURE 90A) W/ STRAW 2S BLANKET	
SEED (MIXTURE 90A)		PLACE SOD AT APRON END SEE STD. PLATE 3102	(S)
SOD (TYPE LAWN)		PLACE RIFRAP AT APRON END SEE STD. PLATE 3133	(R)

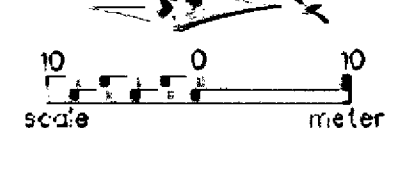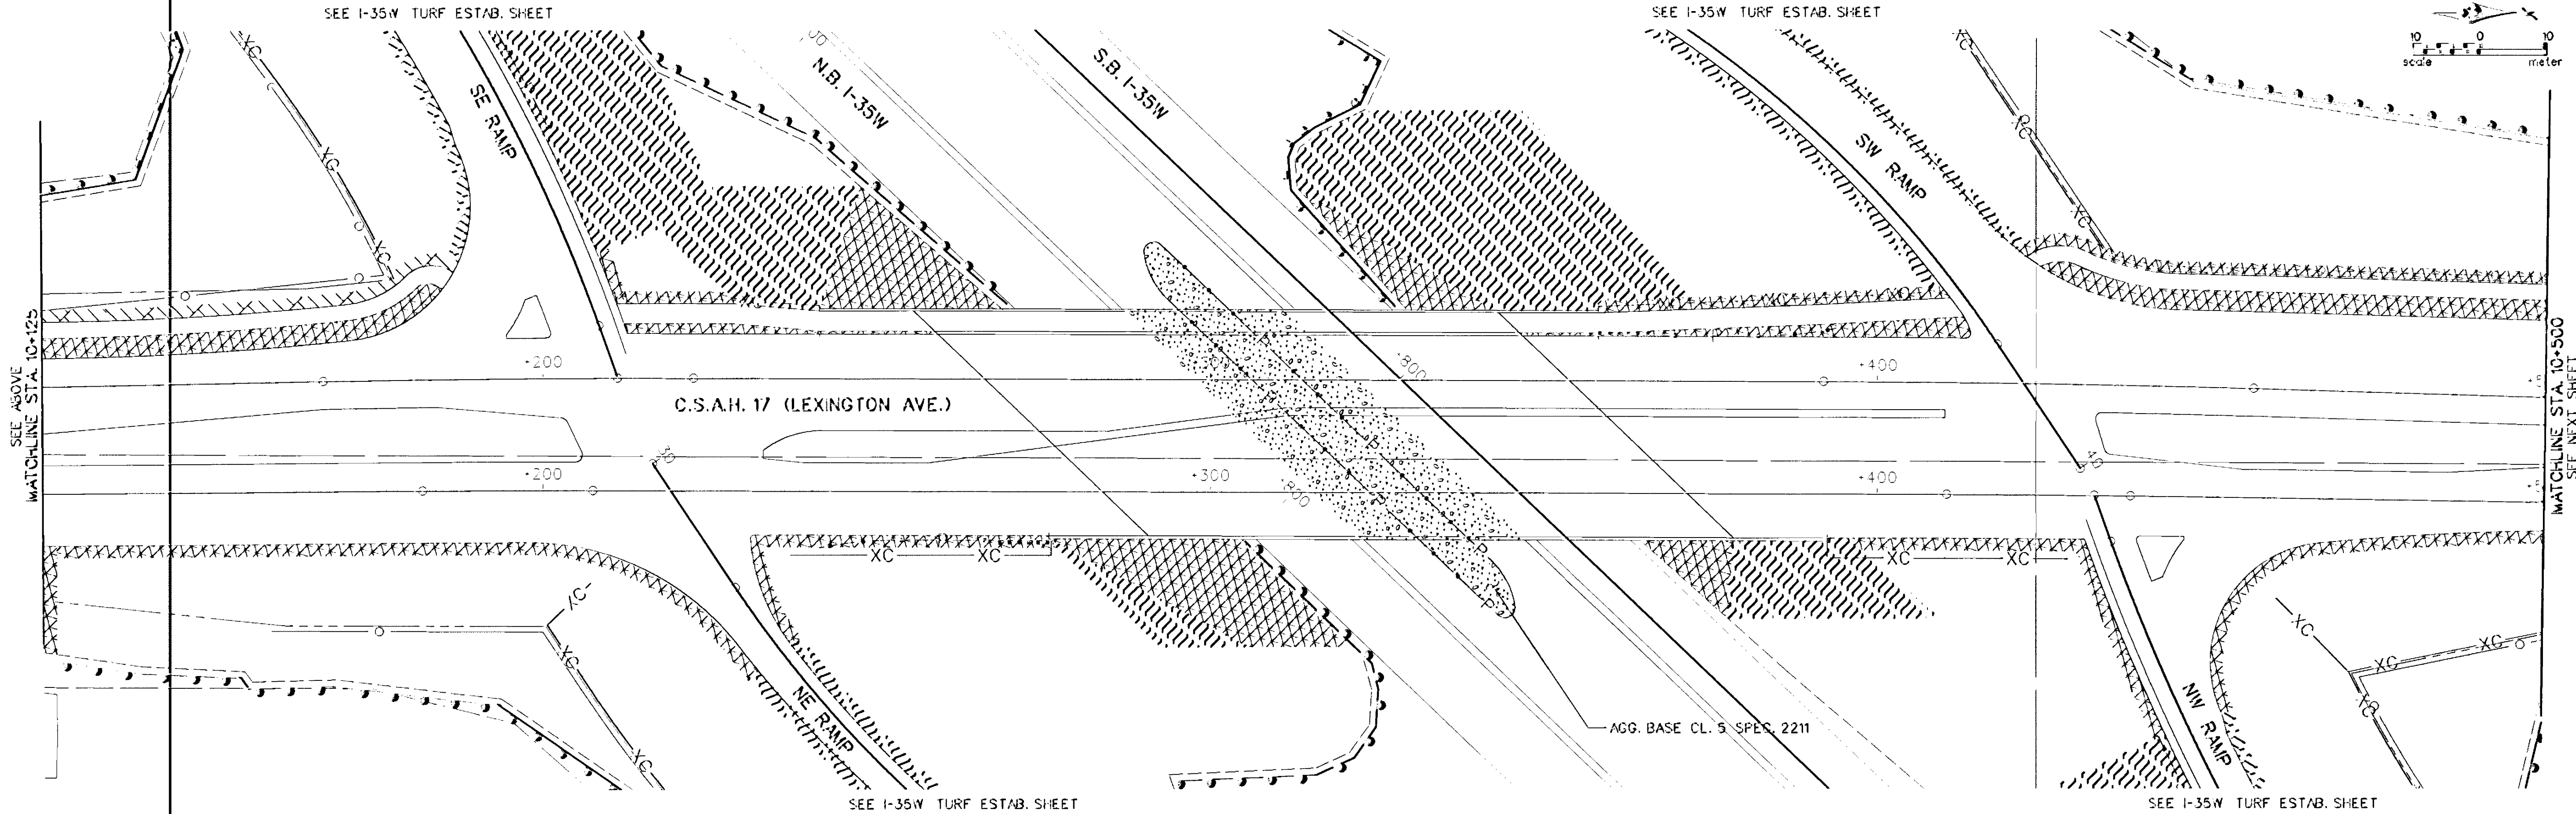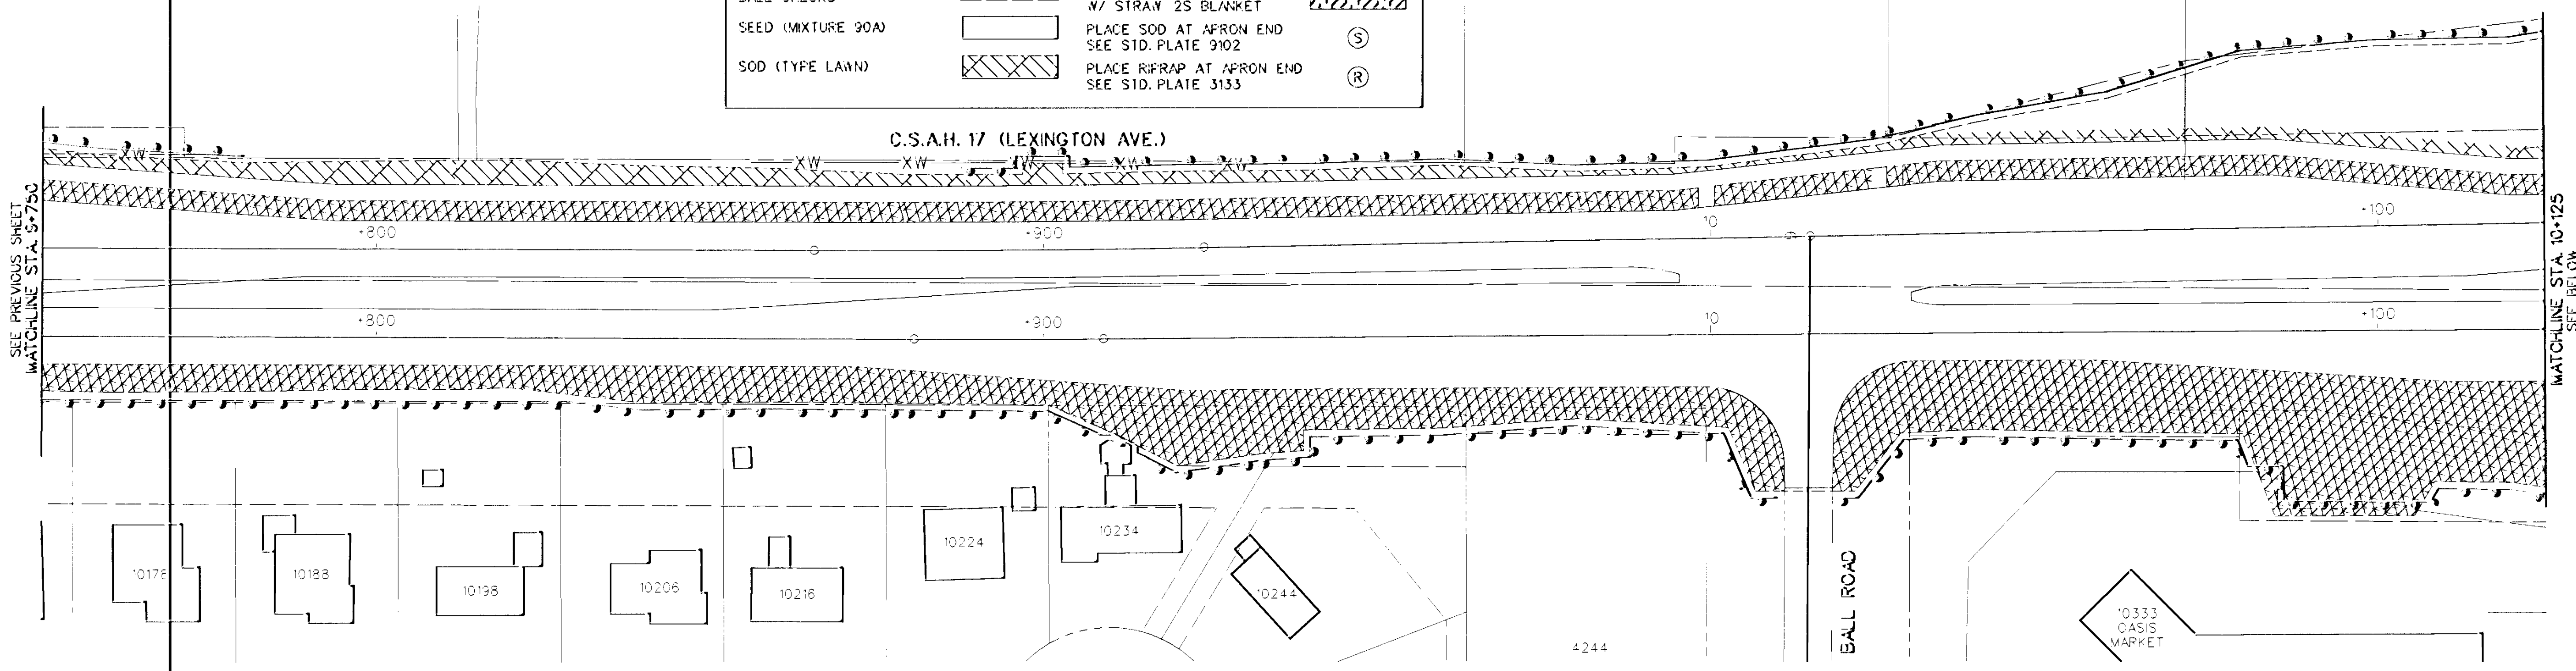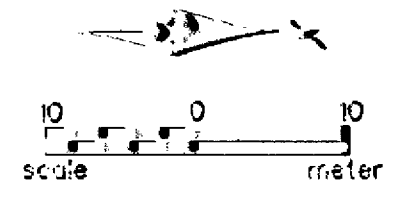

NO.	DATE	BY	CD	APPR	REVISION

NAME: TE3 410.PLN DATE: Mar. 17, 1997

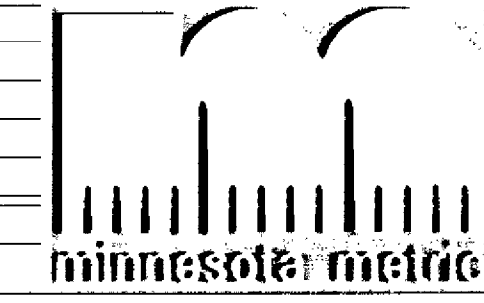

I hereby certify that this plan, specification or report was prepared by me or under my direct supervision and that I am a duly Registered Professional Engineer under the laws of the State of Minnesota.

Donell A. Jones
 Date: 3-21-97 Reg. No. 23397


STATE AID PROJECT NO.
 S.A.P. 02-617-11
 S.A.P. 106-020-12
 S.A.P. 106-030-03

DRAWN BY DATE
 M. LISAKKA 12-96
 DESIGNED BY
 B. URBANEK 12-96
 CHECKED BY
 D. DEMERS 1-97
 COMM. NO.
 0362410






ANOKA COUNTY
 TURF ESTABLISHMENT/ EROSION CONTROL PLAN
 C.S.A.H. 17 RECONSTRUCTION
 STA. 9+750 TO STA. 10+500

SHEET
 149
 OF
 236

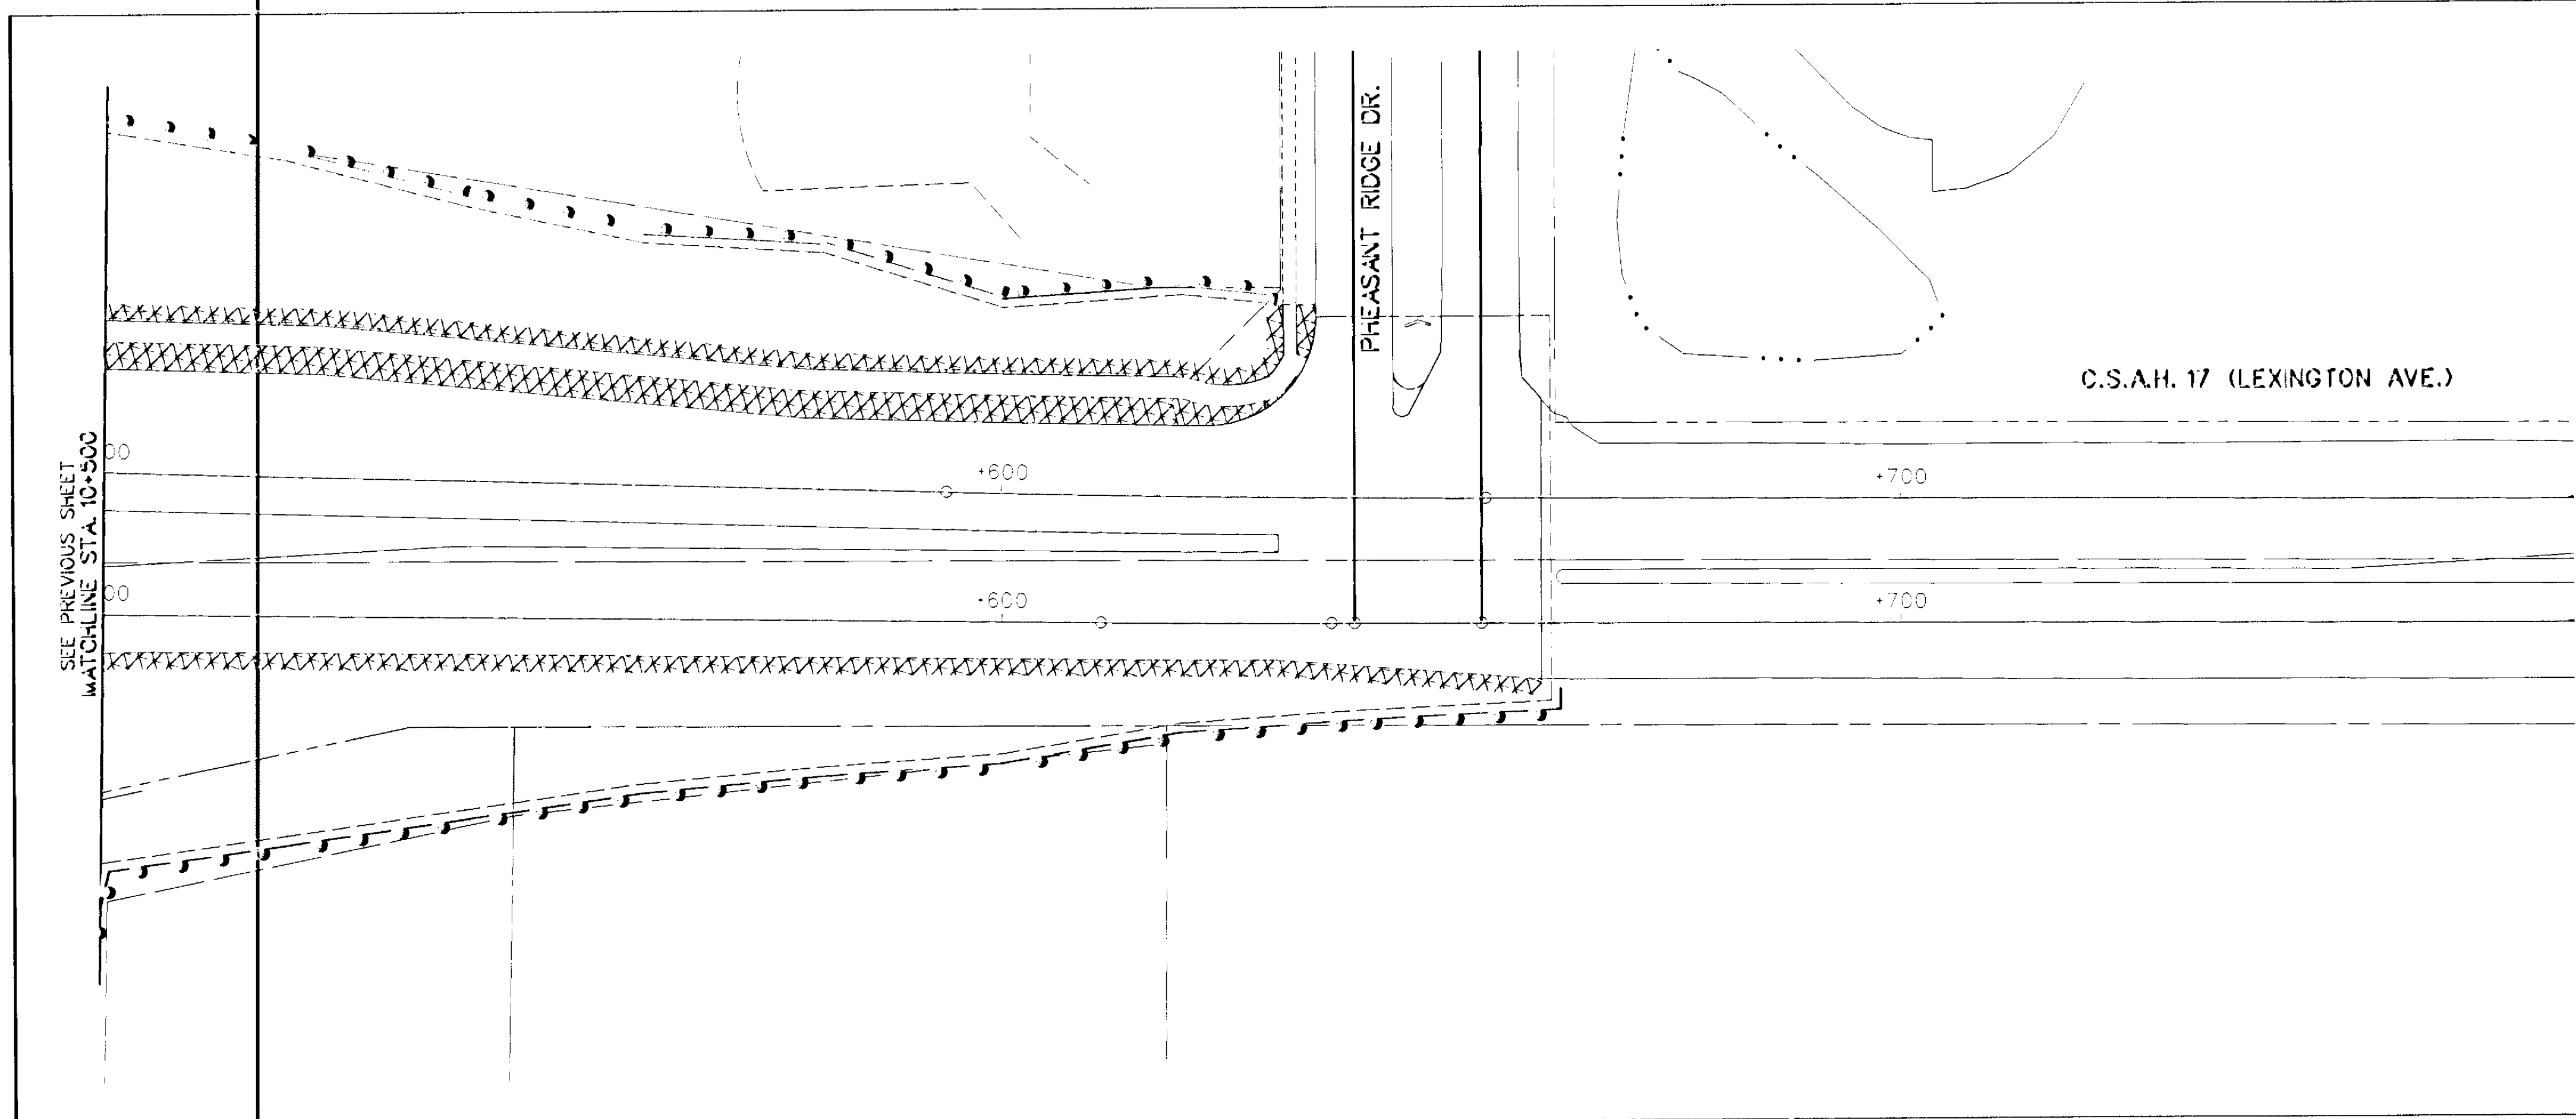

LEGEND	
SILT FENCE	
BALE CHECKS	
SEED (MIXTURE 90A)	
SEED (MIXTURE 25A)	
SOD (TYPE LAWN)	
SOD (SALT RESISTANT)	
SEED (MIXTURE 90A) STRAW 2S BLANKET	
PLACE SOD AT APRON END SEE STD. PLATE 9102	(S)
PLACE RIPRAP AT APRON END SEE STD. PLATE 3133	(R)

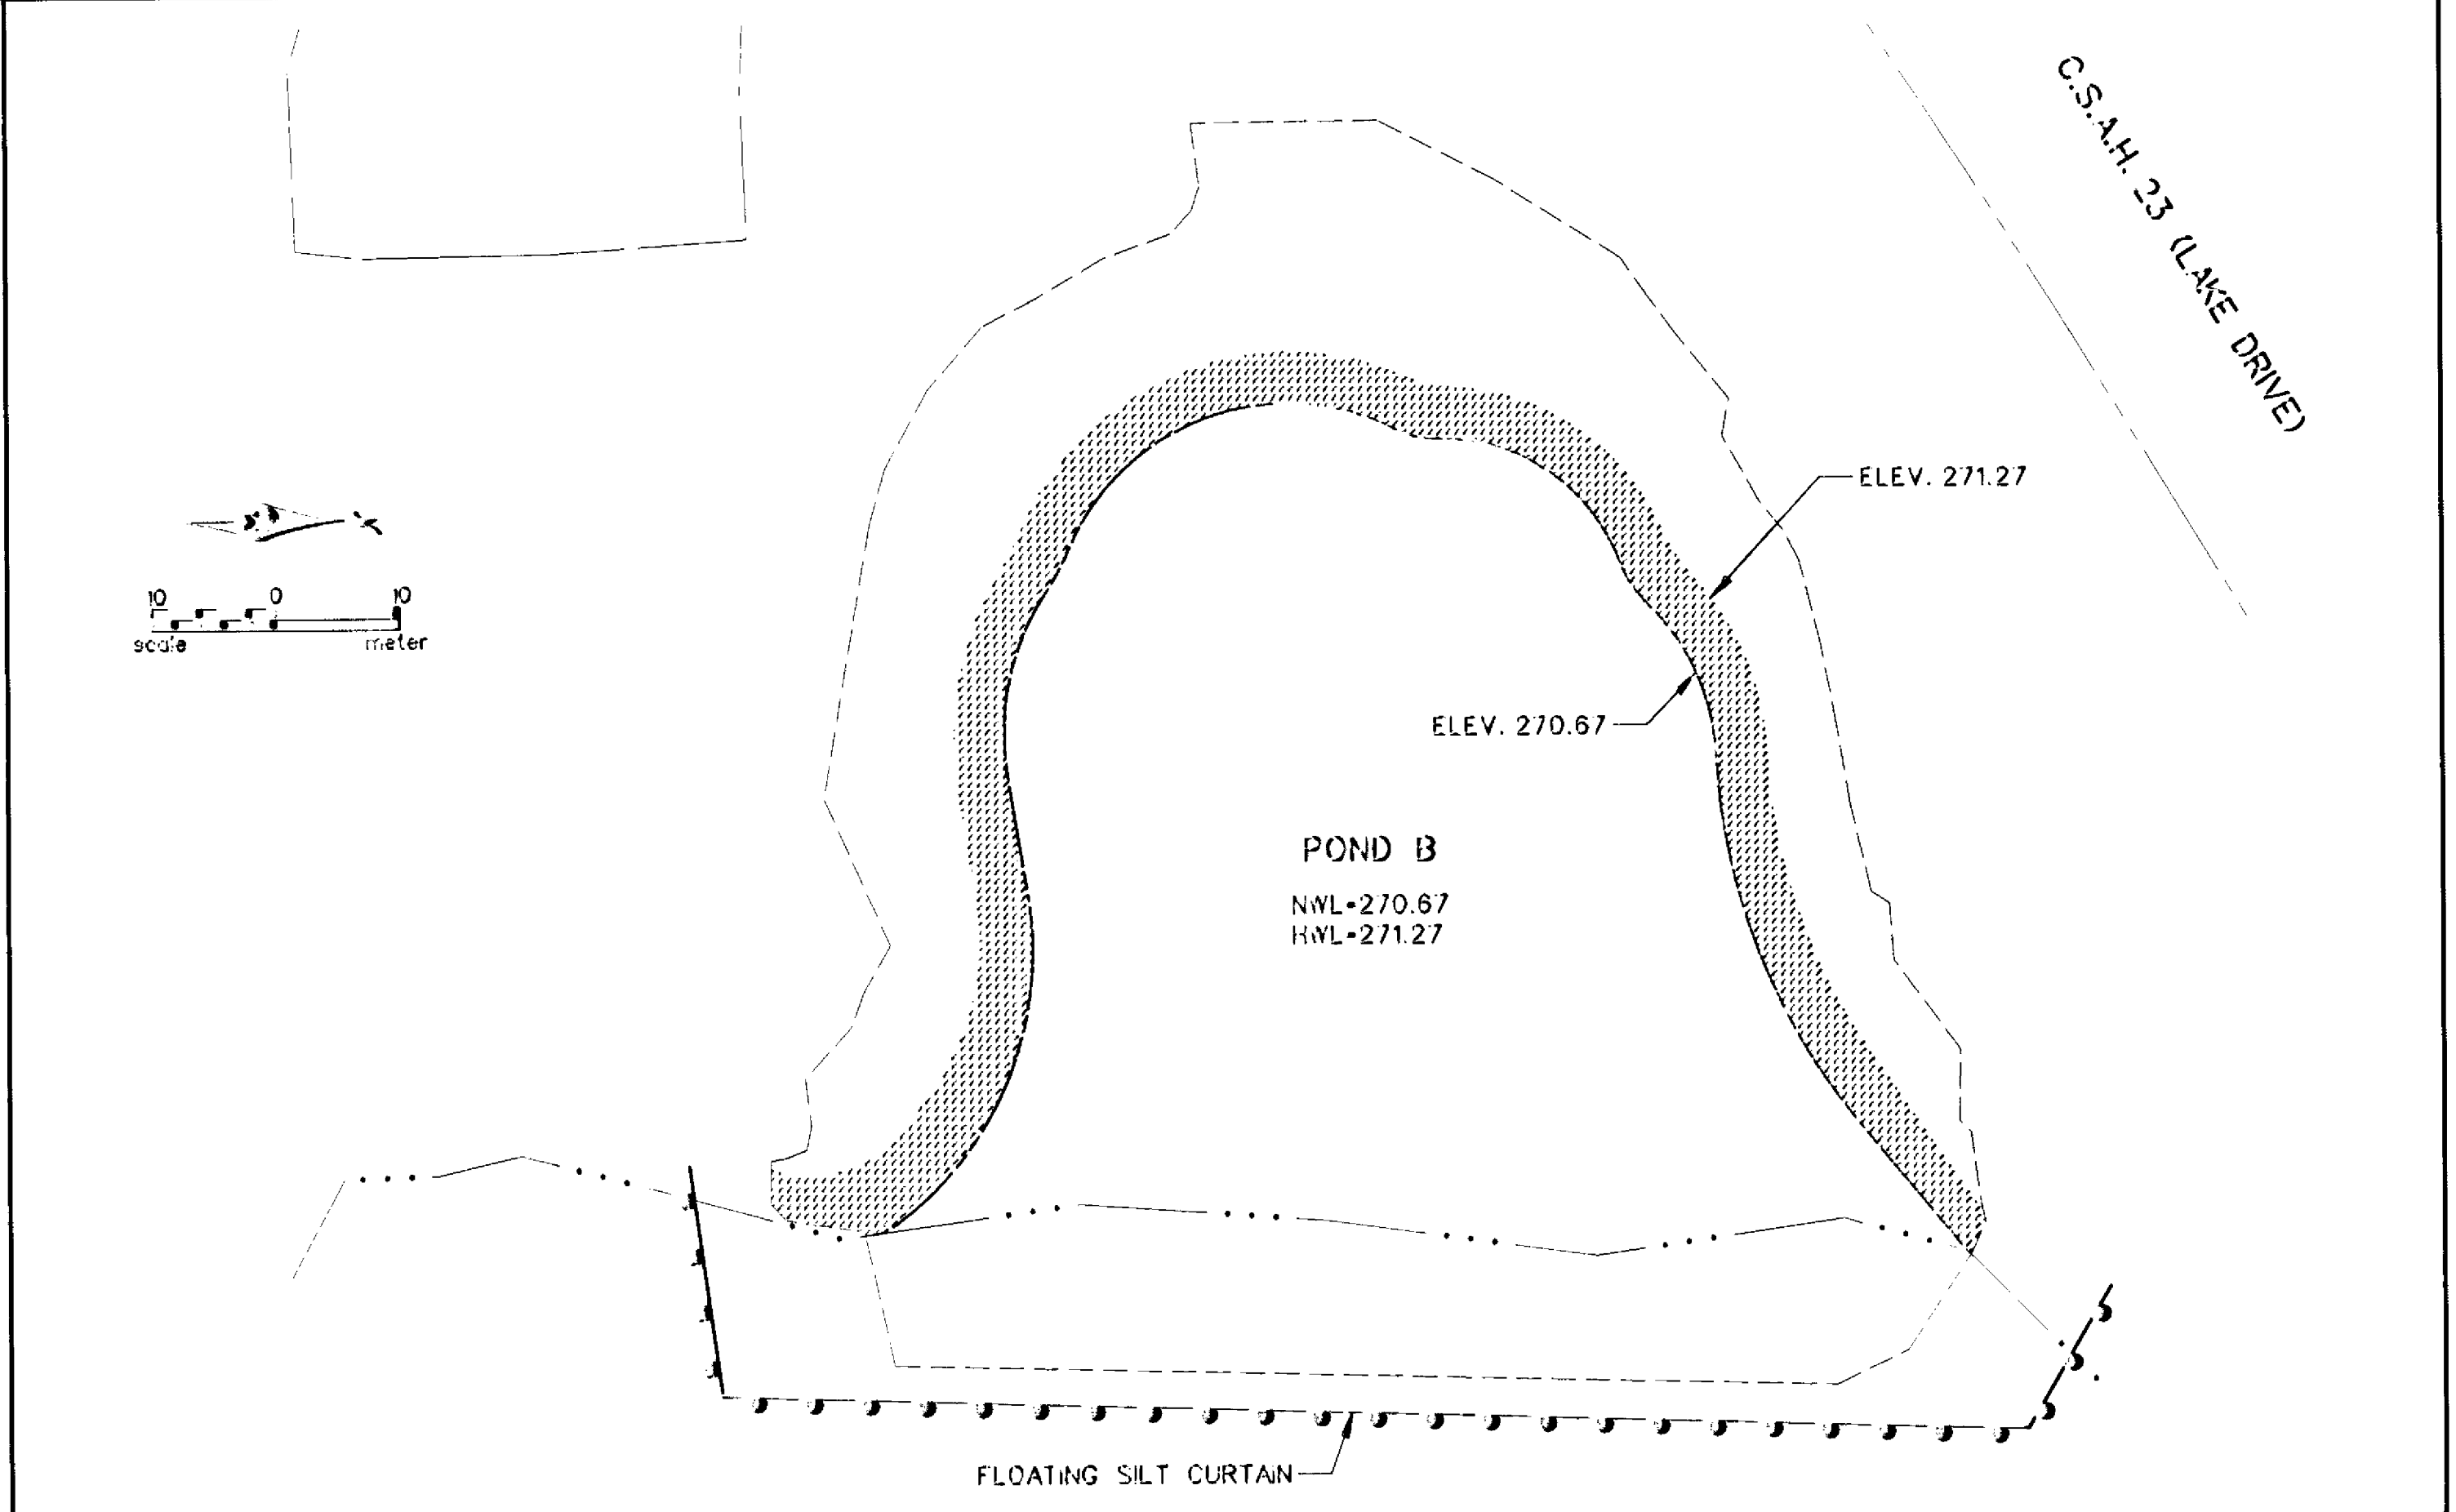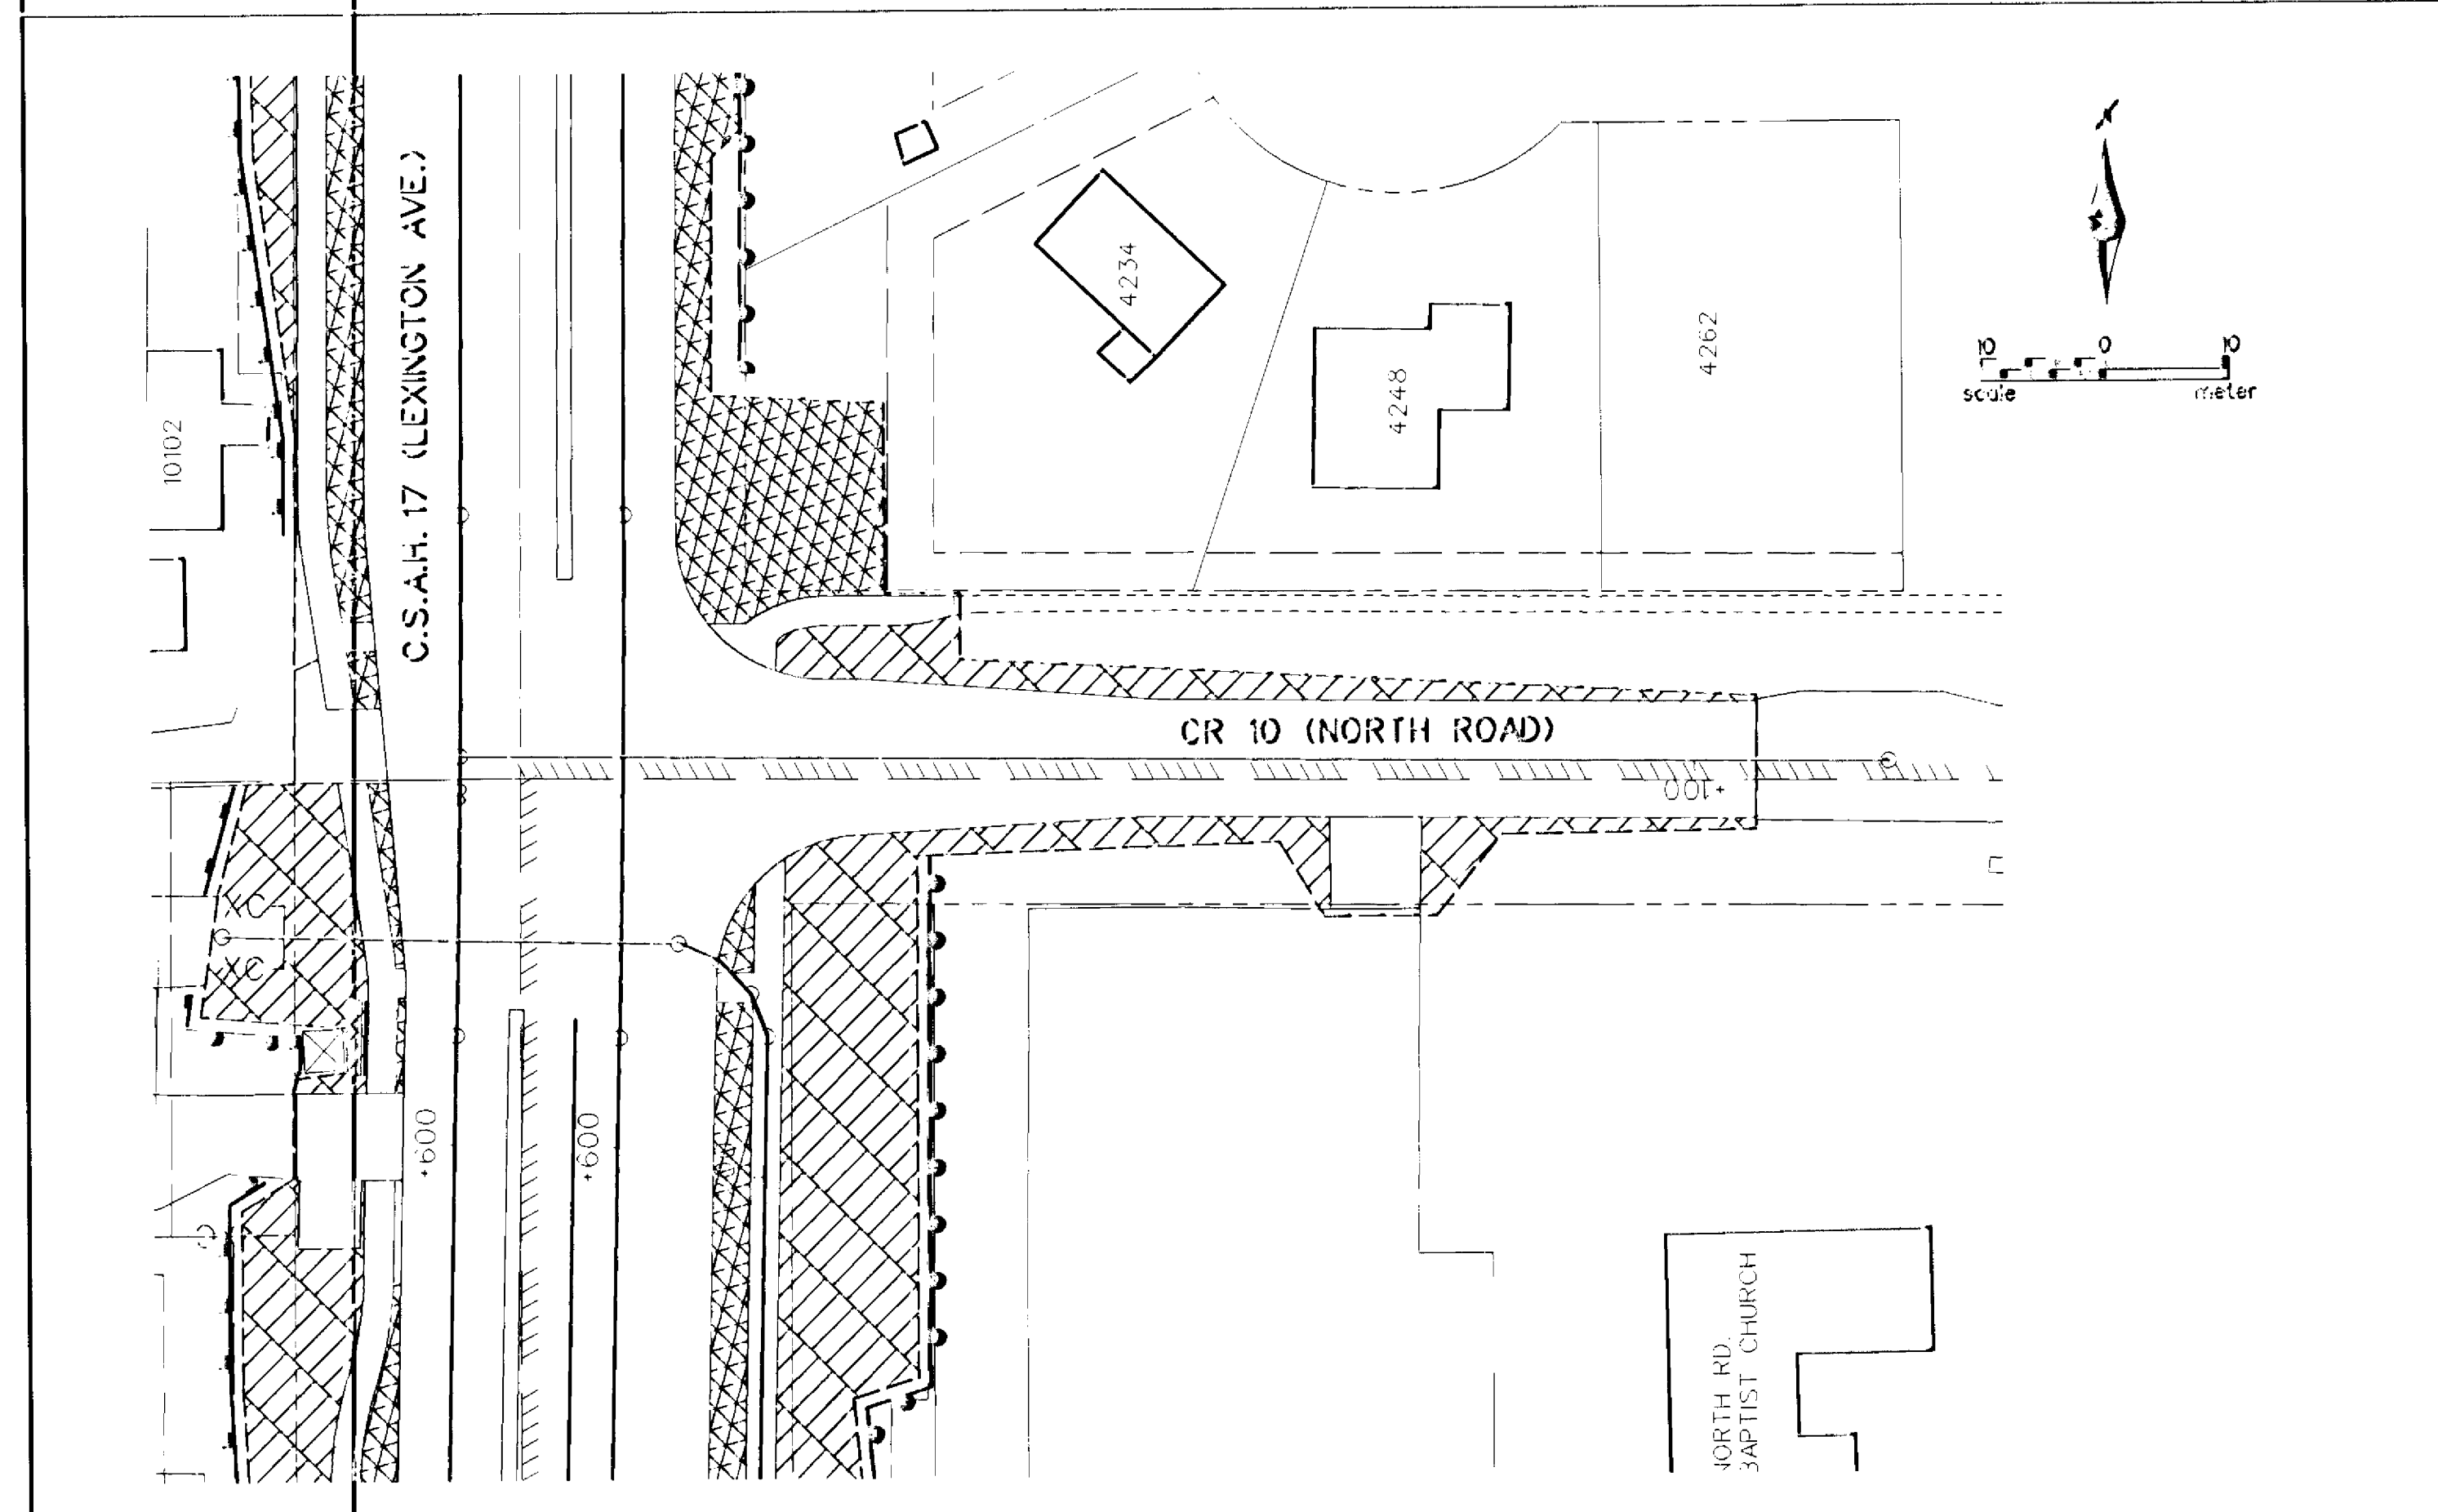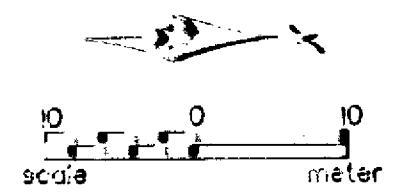

NO	DATE	BY	CHKD	APPR	REVISION
2	4-1-97	MCI		DAD	REVISE SEED MIX FROM 20A TO 25A

I hereby certify that this plan, specification or report was prepared by me or under my direct supervision and that I am a duly Registered Professional Engineer under the laws of the State of Minnesota.

Donald A. James
Date 3-21-97 Reg. No. 23397


STATE AID PROJECT NO. _____
 S.A.P. 02-617-11
 S.A.P. 106-020-12
 S.A.P. 106-030-03
 CO. PROJECT NO. _____

DRAWN BY M. IISAKKA DATE 12-96
 DESIGNED BY B. URBANEK DATE 12-96
 CHECKED BY D. DEMERS DATE 1-97
 COMM. NO. 0962410




ANOKA COUNTY
 TURF ESTABLISHMENT/ EROSION CONTROL PLAN
 C.S.A.H. 17 RECONSTRUCTION
 STA. 10+500 TO STA. 10+660, C.R. 10, POND B


SHEET 150 OF 236

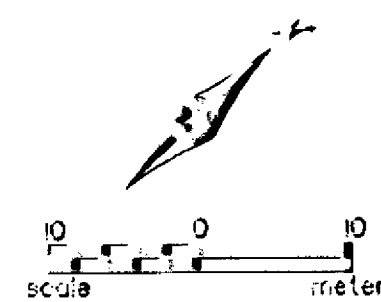

LEGEND	
SILT FENCE	
BALE CHECKS	
SEED (MIXTURE 90A)	
SEED (MIXTURE 25A)	
SOD (TYPE LAWN)	
SOD (SALT RESISTANT)	
SEED (MIXTURE 90A) STRAW 2S BLANKET	
PLACE SOD AT AFRON END SEE STD. PLATE 9102	(S)
PLACE RIPRAP AT AFRON END SEE STD. PLATE 3133	(R)

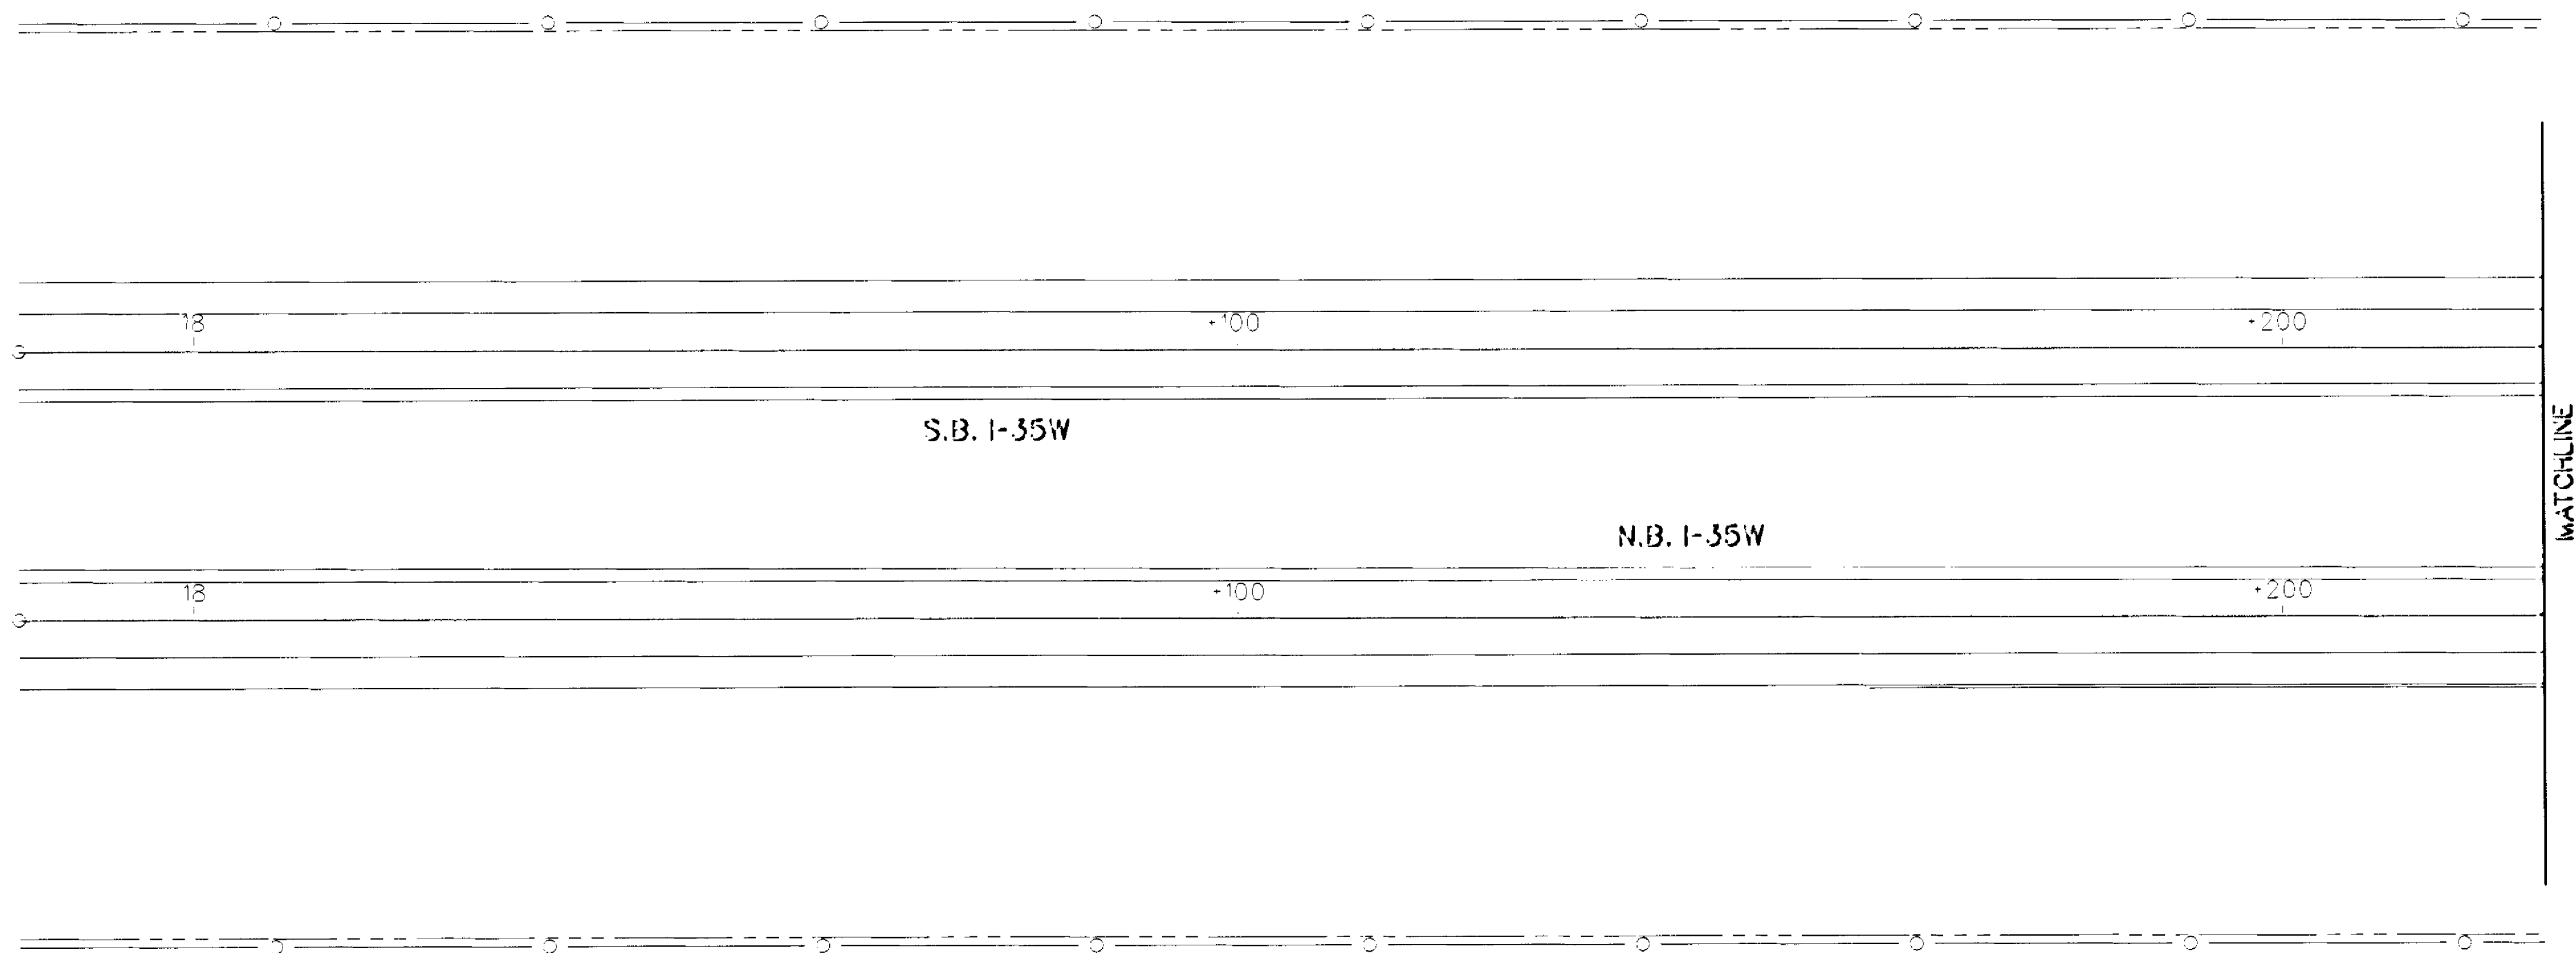


MATCHLINE
SEE BELOW

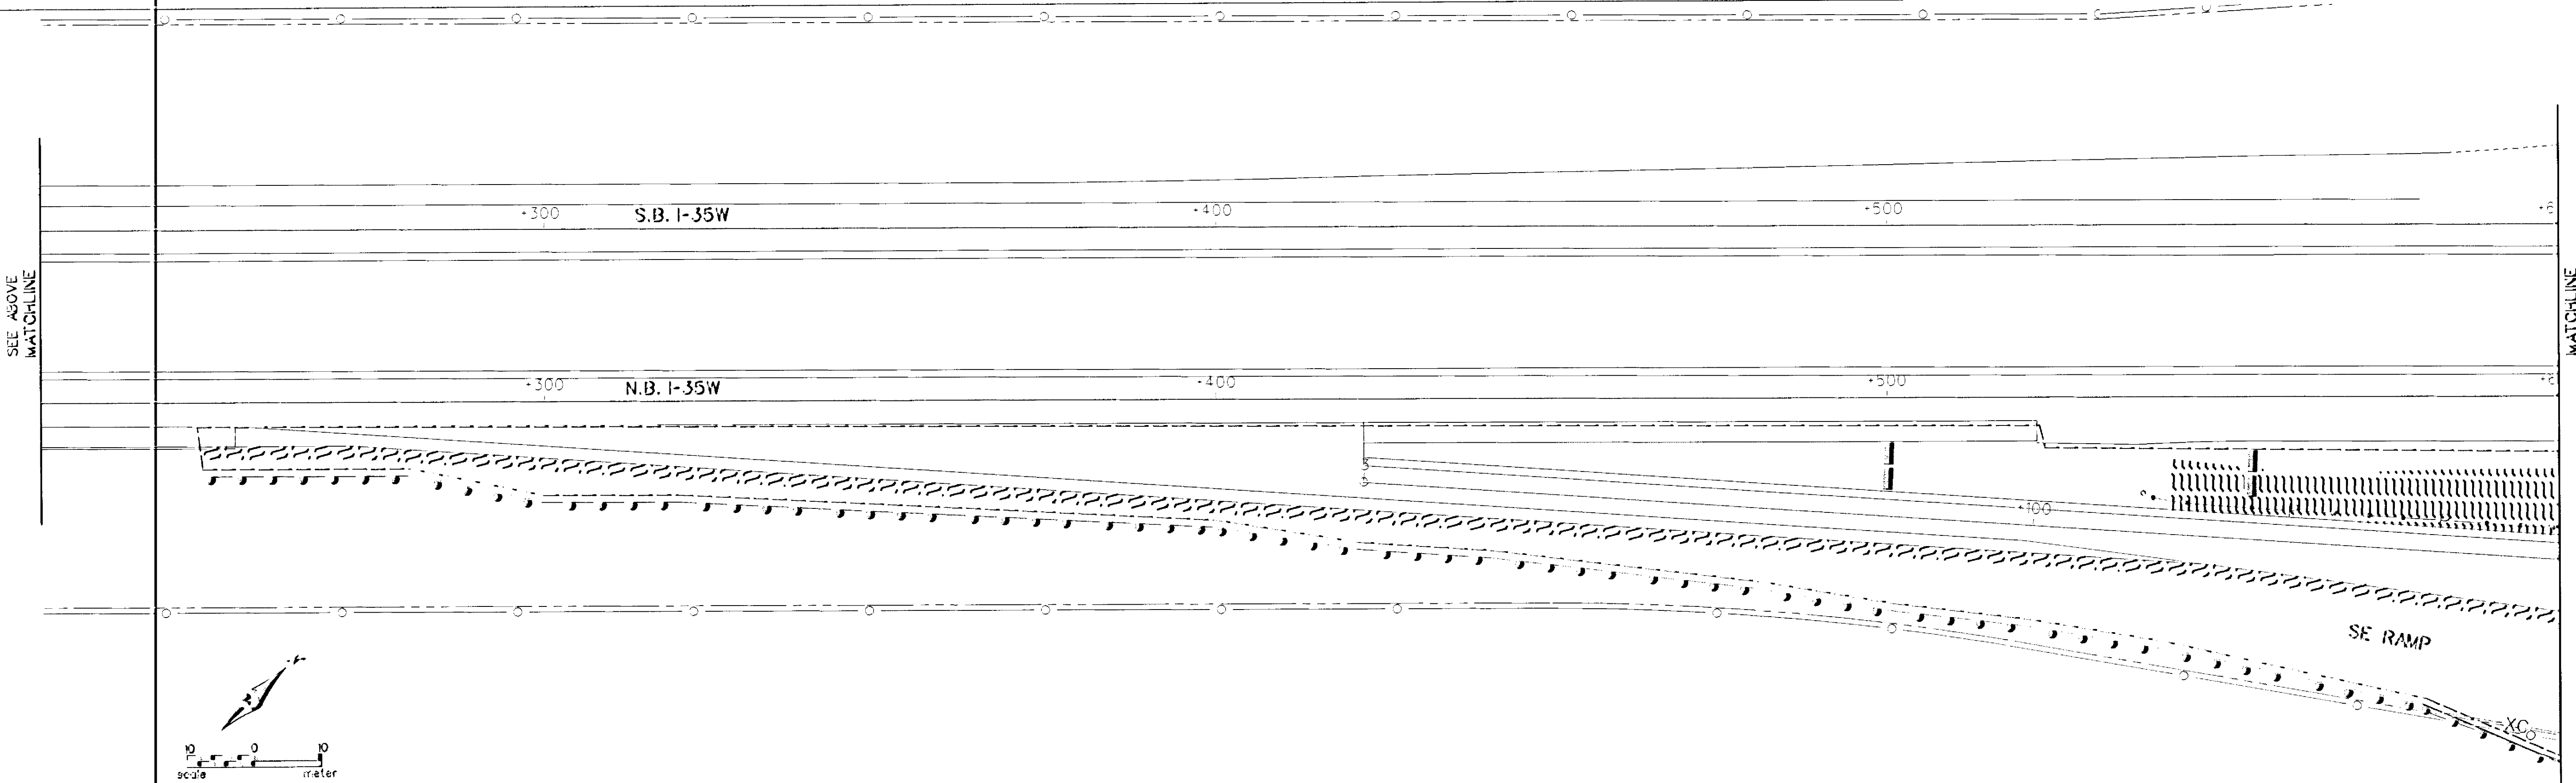


SEE ABOVE
MATCHLINE

MATCHLINE
SEE NEXT SHEET

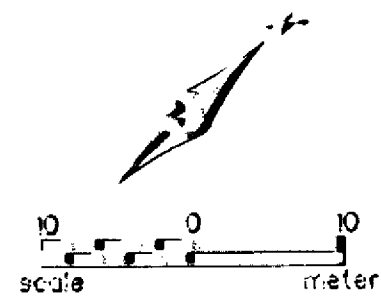

NO	DATE	BY	CHKD	APPR	REVISION
2	4-1-97	MCI		DAD	REVISE SEED MIX FROM 20A TO 25A

NAME: IES 410.PLN DATE: Mar. 17, 1997

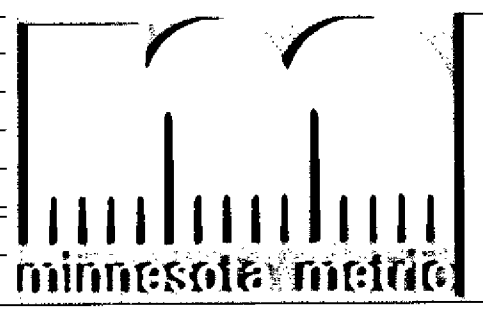

I hereby certify that this plan, specification or report was prepared by me or under my direct supervision and that I am a duly Registered Professional Engineer under the laws of the State of Minnesota.

Donald A. James
Date: 3-21-97 Reg. No. 233977

STATE AID PROJECT NO.
S.A.P. 02-617-11
S.A.P. 108-020-12
S.A.P. 108-030-03
CO. PROJECT NO.


DRAWN BY DATE
V. GRAF 12-96
DESIGNED BY
B. URBANEK 12-96
CHECKED BY
D. DEMERS 1-97
COMM. NO.
0962410




ANOKA COUNTY
TURF ESTABLISHMENT/ EROSION CONTROL PLAN
C.S.A.H. 17 RECONSTRUCTION
INTERSTATE 35W

SHEET
151
OF
236

LEGEND	
SILT FENCE	
BALE CHECKS	
SEED MIXTURE 90A	
SEED MIXTURE 25A	
SOD (TYPE LAWN)	
SOD (SALT RESISTANT)	
SEED MIXTURE 90A STRAW 25 BLANKET	
PLACE SOD AT APRON END SEE STD. PLATE 9102	(S)
PLACE RIPRAP AT APRON END SEE STD. PLATE 3133	(R)

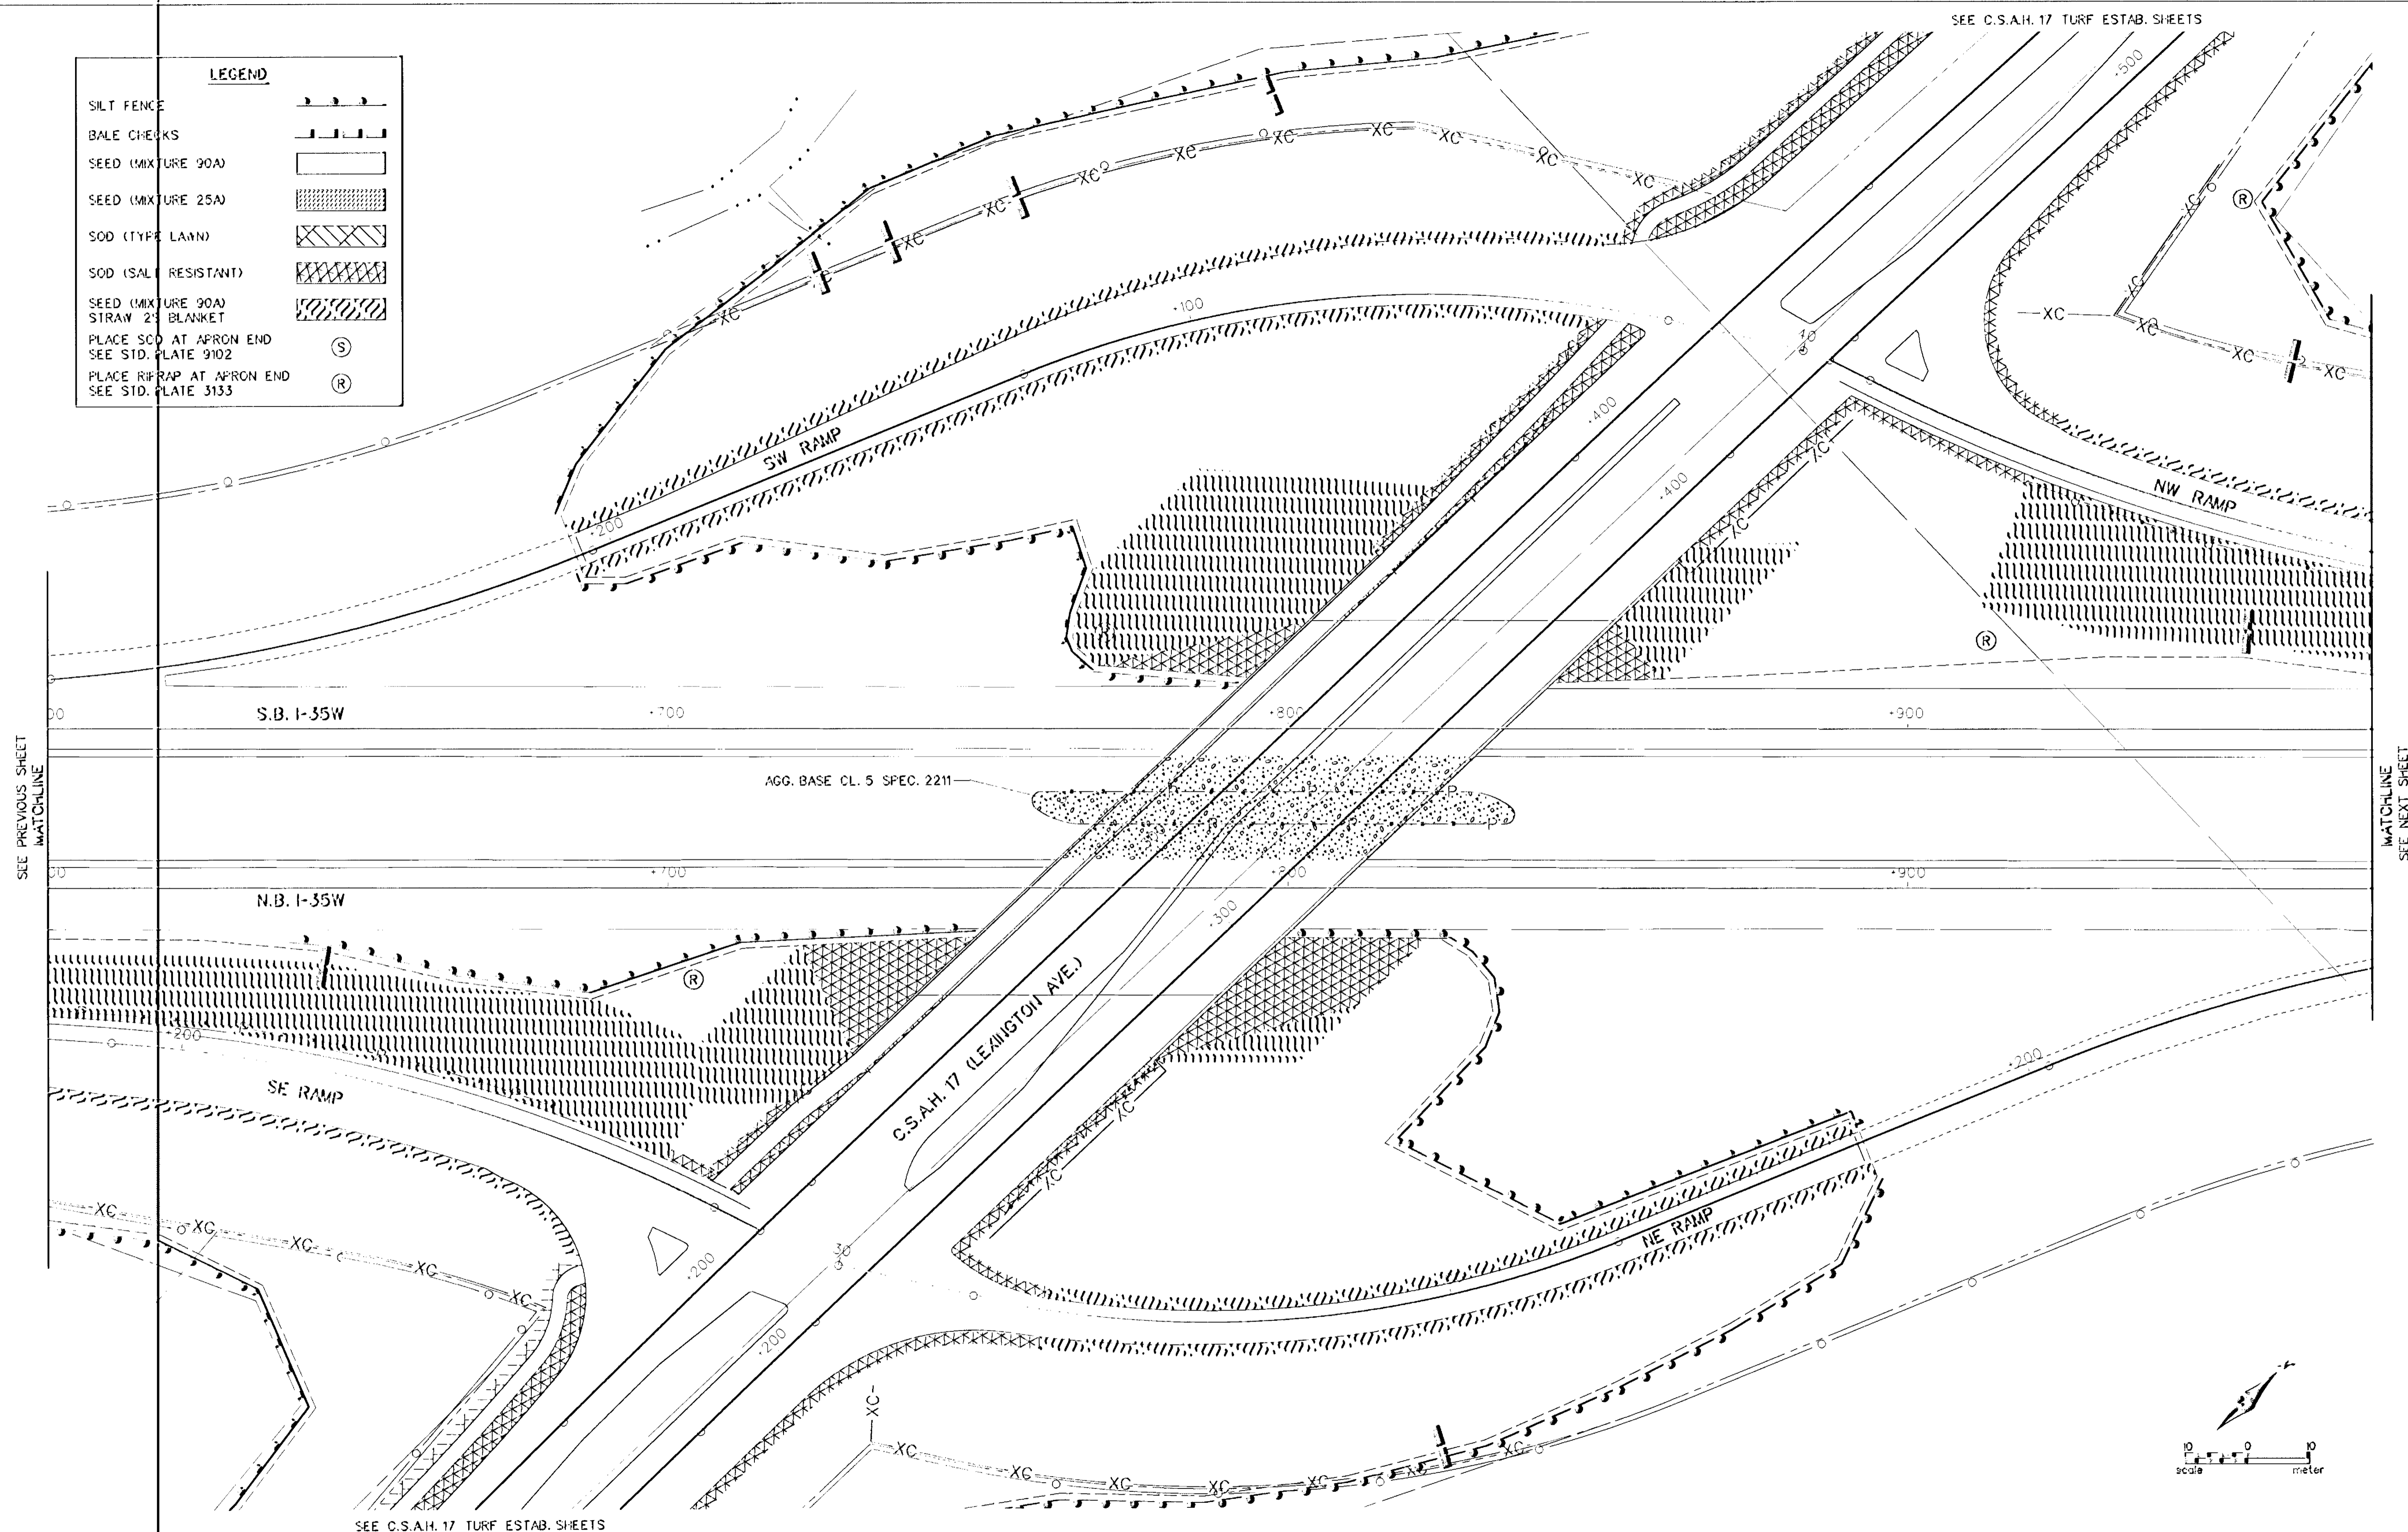

1	3-26-97	MCI	DAD	ADD R NOTE AT APRONS	
2	4-1-97	MCI	DAD	REVISE SEED MIX FROM 20A TO 25A	
NO	DATE	BY	CHKD	APPR	REVISION
NAME: TEG 410.PLN DATE: Mar. 17, 1997					

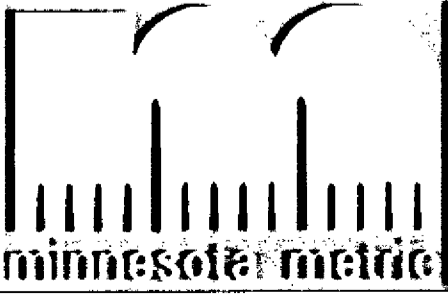

I hereby certify that this plan, specification or report was prepared by me or under my direct supervision and that I am a duly Registered Professional Engineer under the laws of the State of Minnesota.

Donald A. Jensen
Date: 3-21-97 Reg. No. 23397





STATE AND PROJECT NO.
S.A.P. 02-617-11
S.A.P. 106-020-12
S.A.P. 106-030-03
CO. PROJECT NO.

DRAWN BY M. ISAKKA DATE 12-96
DESIGNED BY B. URBANEK DATE 12-96
CHECKED BY D. DEMERS DATE 1-97
COMM. NO. 0962410

SRIE CONSULTING GROUP, INC.

ANOKA COUNTY
TURF ESTABLISHMENT/ EROSION CONTROL PLAN
C.S.A.H. 17 RECONSTRUCTION
INTERSTATE 35W


SHEET 152 OF 236

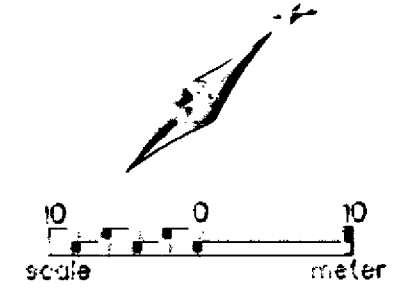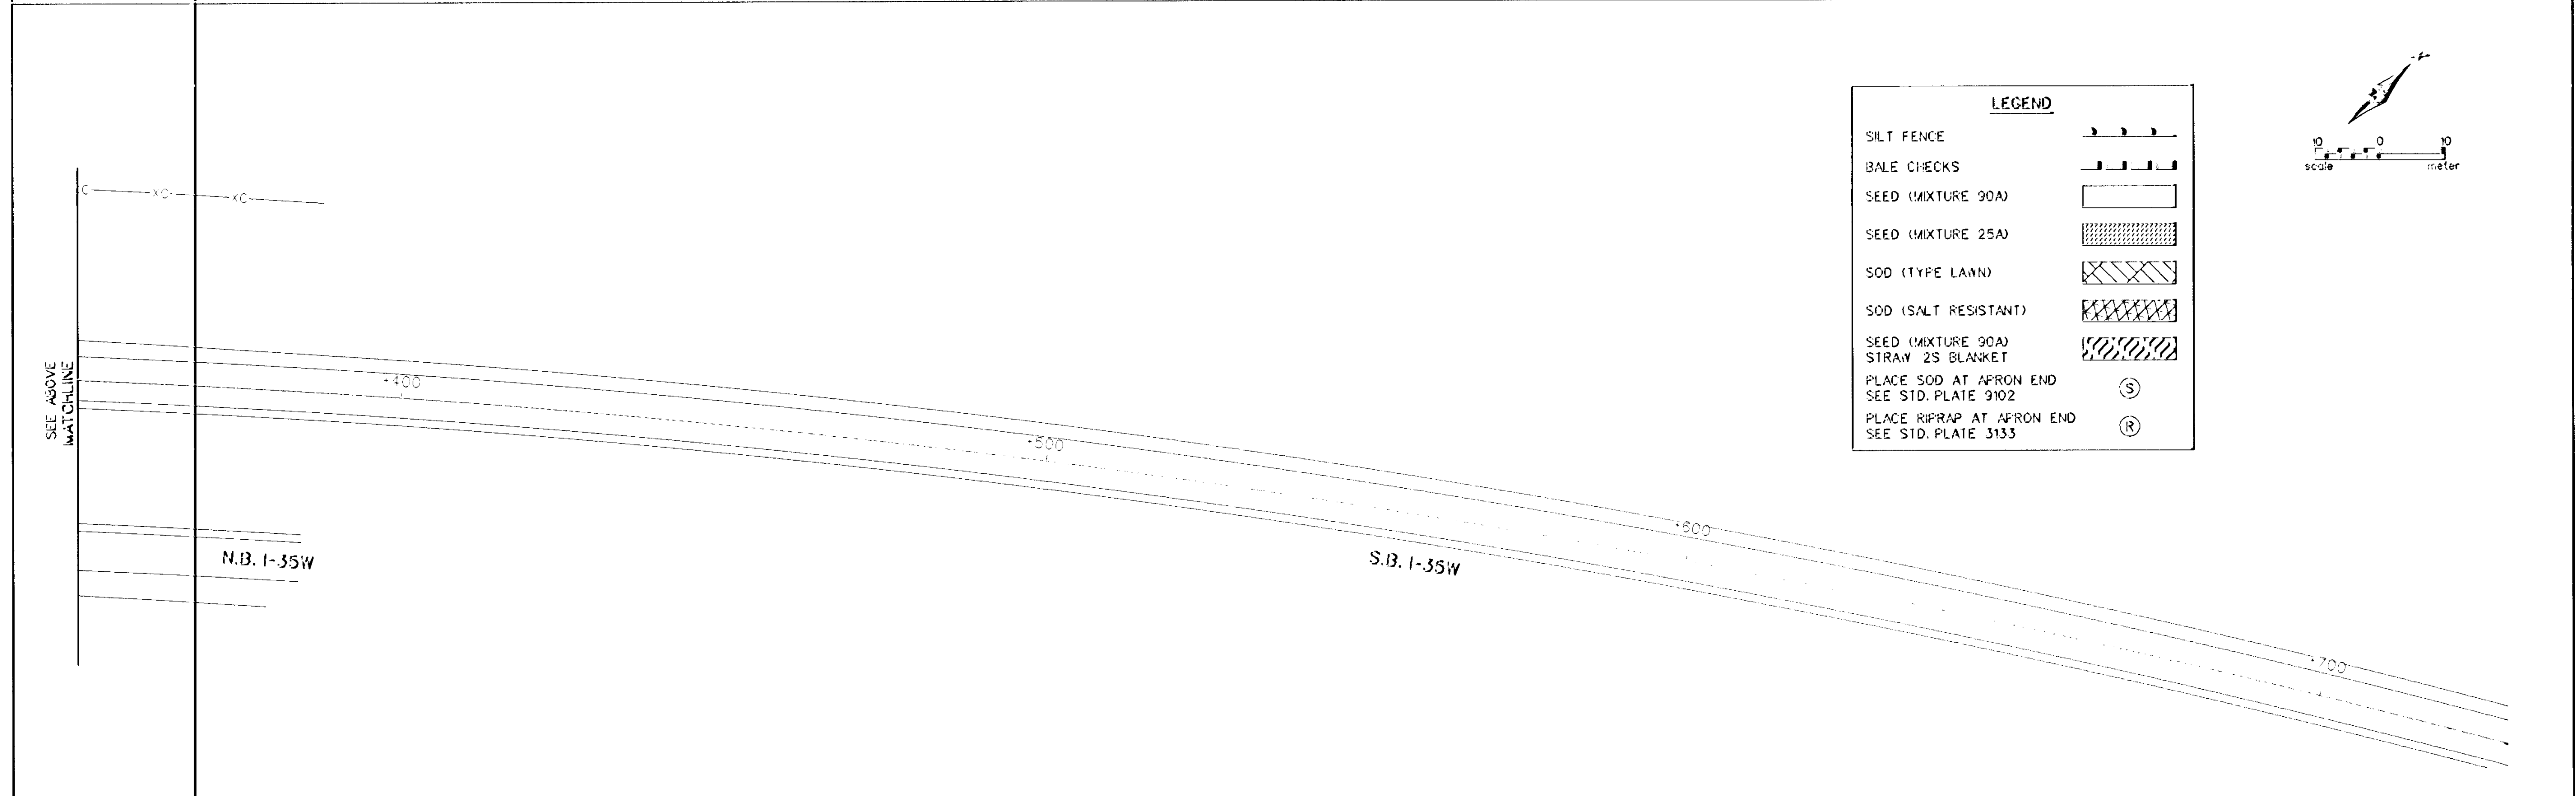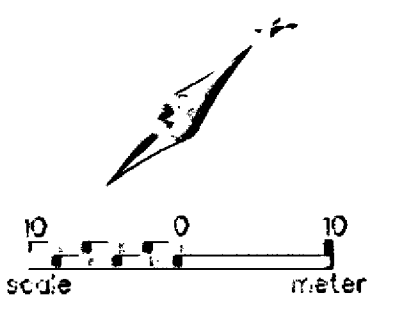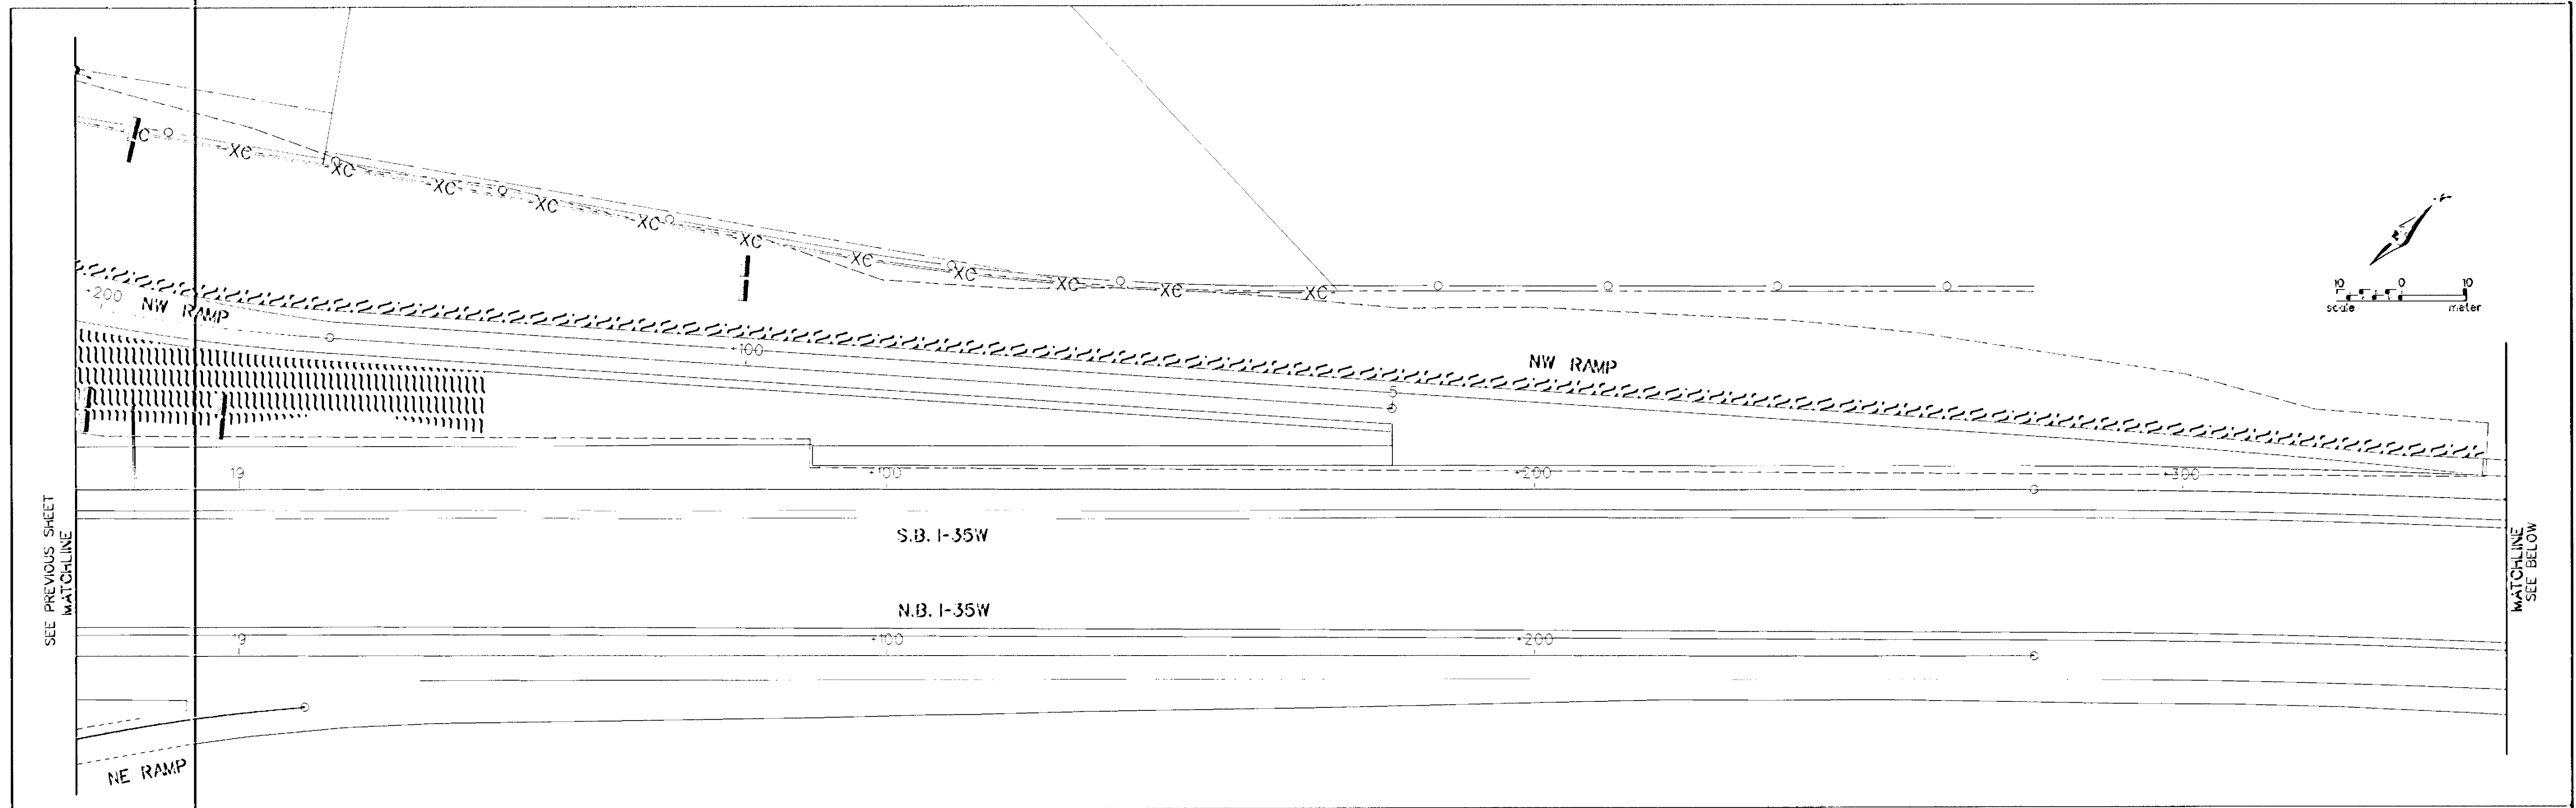

LEGEND	
SILT FENCE	
BALE CHECKS	
SEED (MIXTURE 90A)	
SEED (MIXTURE 25A)	
SOD (TYPE LAWN)	
SOD (SALT RESISTANT)	
SEED (MIXTURE 90A) STRAW 2S BLANKET	
PLACE SOD AT APRON END SEE STD. PLATE 9102	(S)
PLACE RIPRAP AT APRON END SEE STD. PLATE 3133	(R)

NO	DATE	BY	CHKD	APPR	REVISION
2	4-1-97	MCI		DAD	REVISE SEED MIX FROM 20A TO 25A

NAME: TE7 410.PLN DATE: Mar. 17, 1997

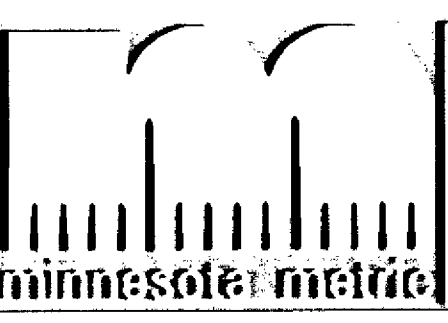


I hereby certify that this plan, specification or report was prepared by me or under my direct supervision and that I am a duly Registered Professional Engineer under the laws of the State of Minnesota.

Donald A. Demers
Date: 3-21-97 Reg. No. 23397


STATE AID PROJECT NO.
S.A.P. 02-617-11
S.A.P. 106-020-12
S.A.P. 106-030-03

DRAWN BY DATE
M. ISAKKA 12-96
DESIGNED BY
B. URBANEK 12-96
CHECKED BY
D. DEMERS 1-97
COMM. NO.
0982410

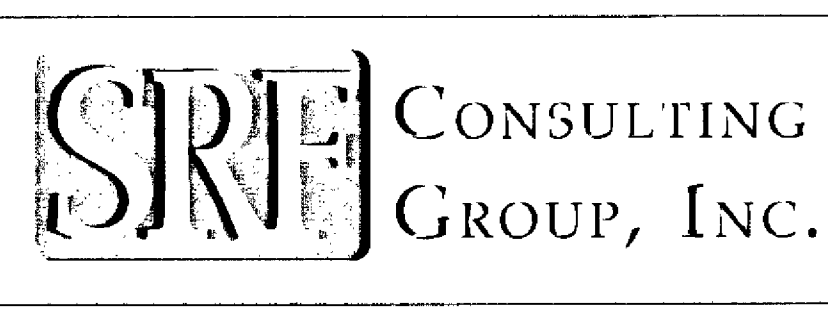


ANOKA COUNTY
TURF ESTABLISHMENT/ EROSION CONTROL PLAN
C.S.A.H. 17 RECONSTRUCTION
INTERSTATE 35W


SHEET 153 OF 236

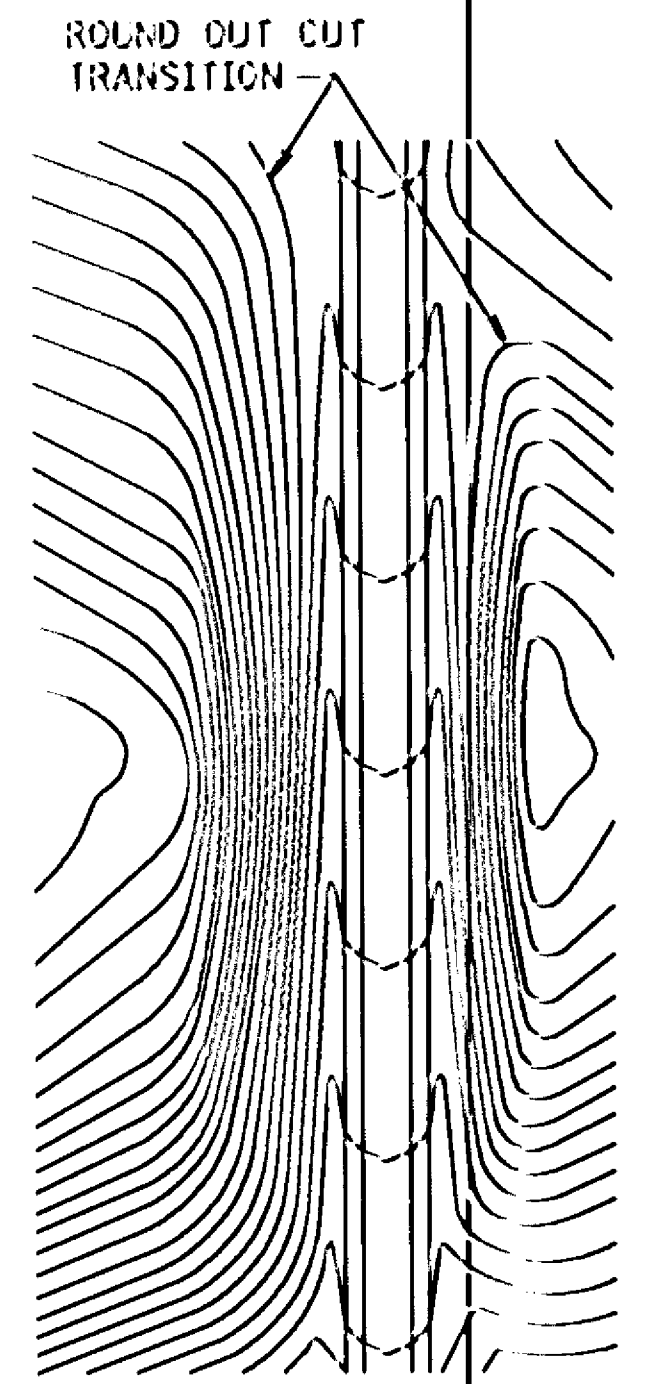


CONTOURING ROAD CUTS

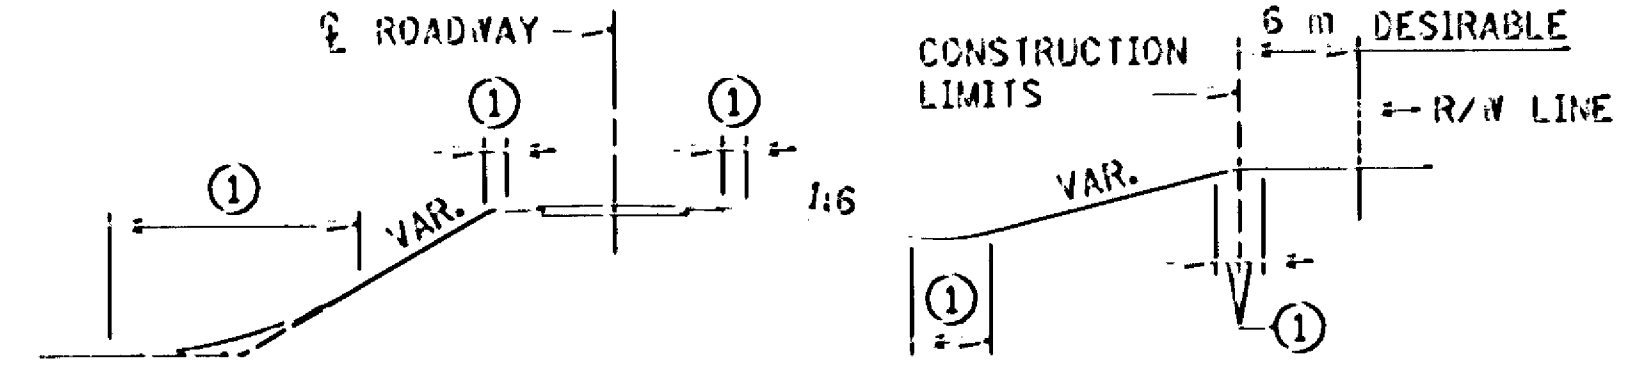


ROUNDING SHOULDERS AND BACKSLOPES

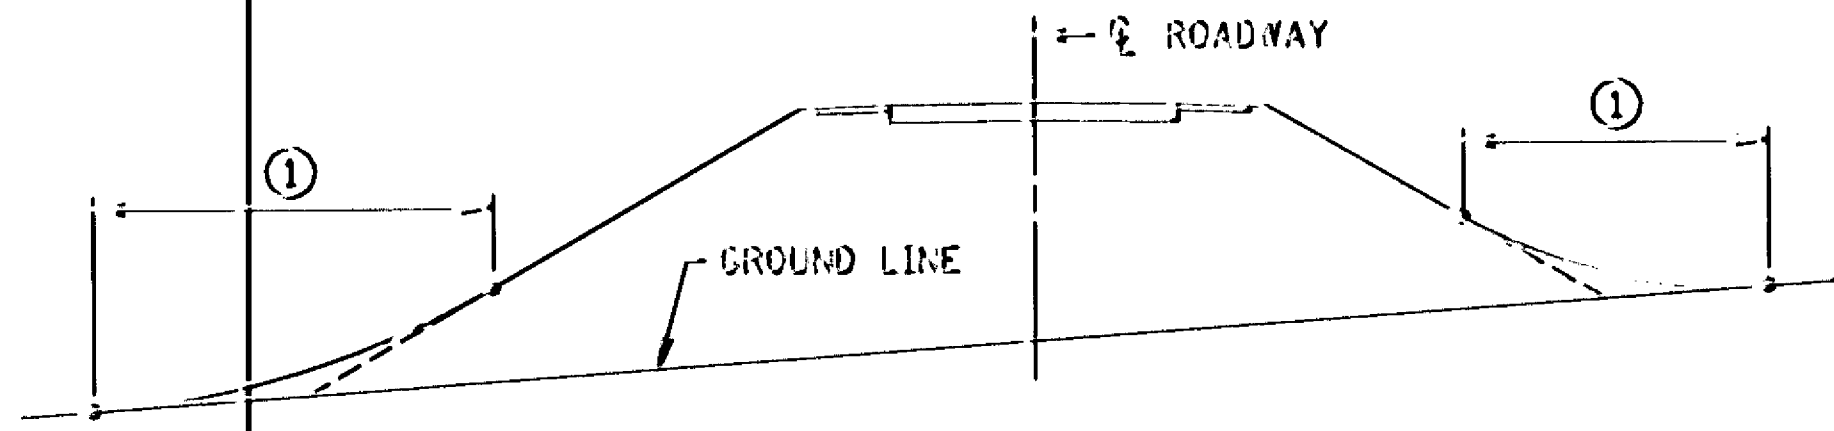


SHAPING FOR DRAINAGE ALONG THE TOE OF FILL SLOPES

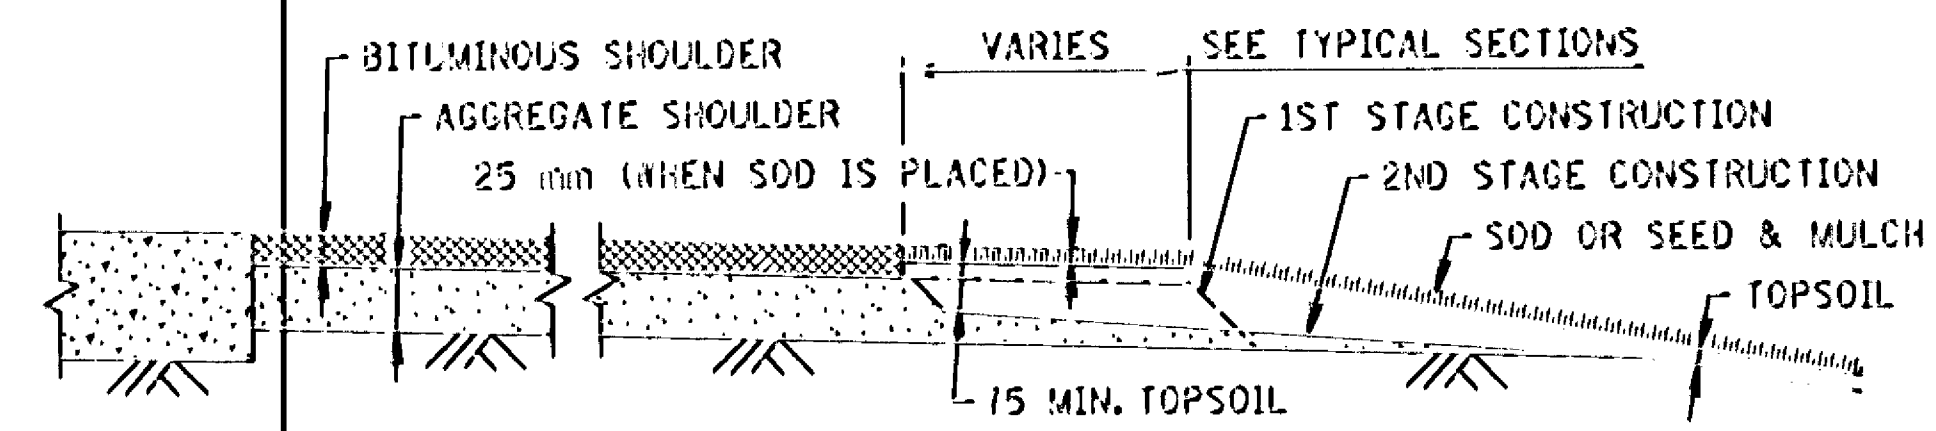


SHAPING AND TOPSOILING INSLOPES

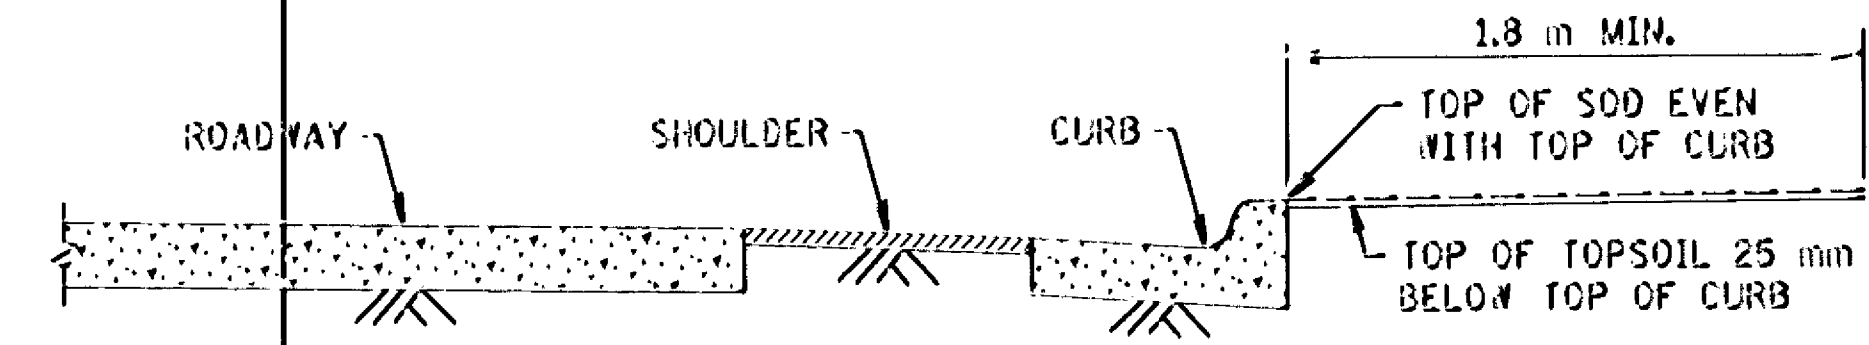


SHAPING ADJACENT TO CURBS WHEN SOD IS PLACED

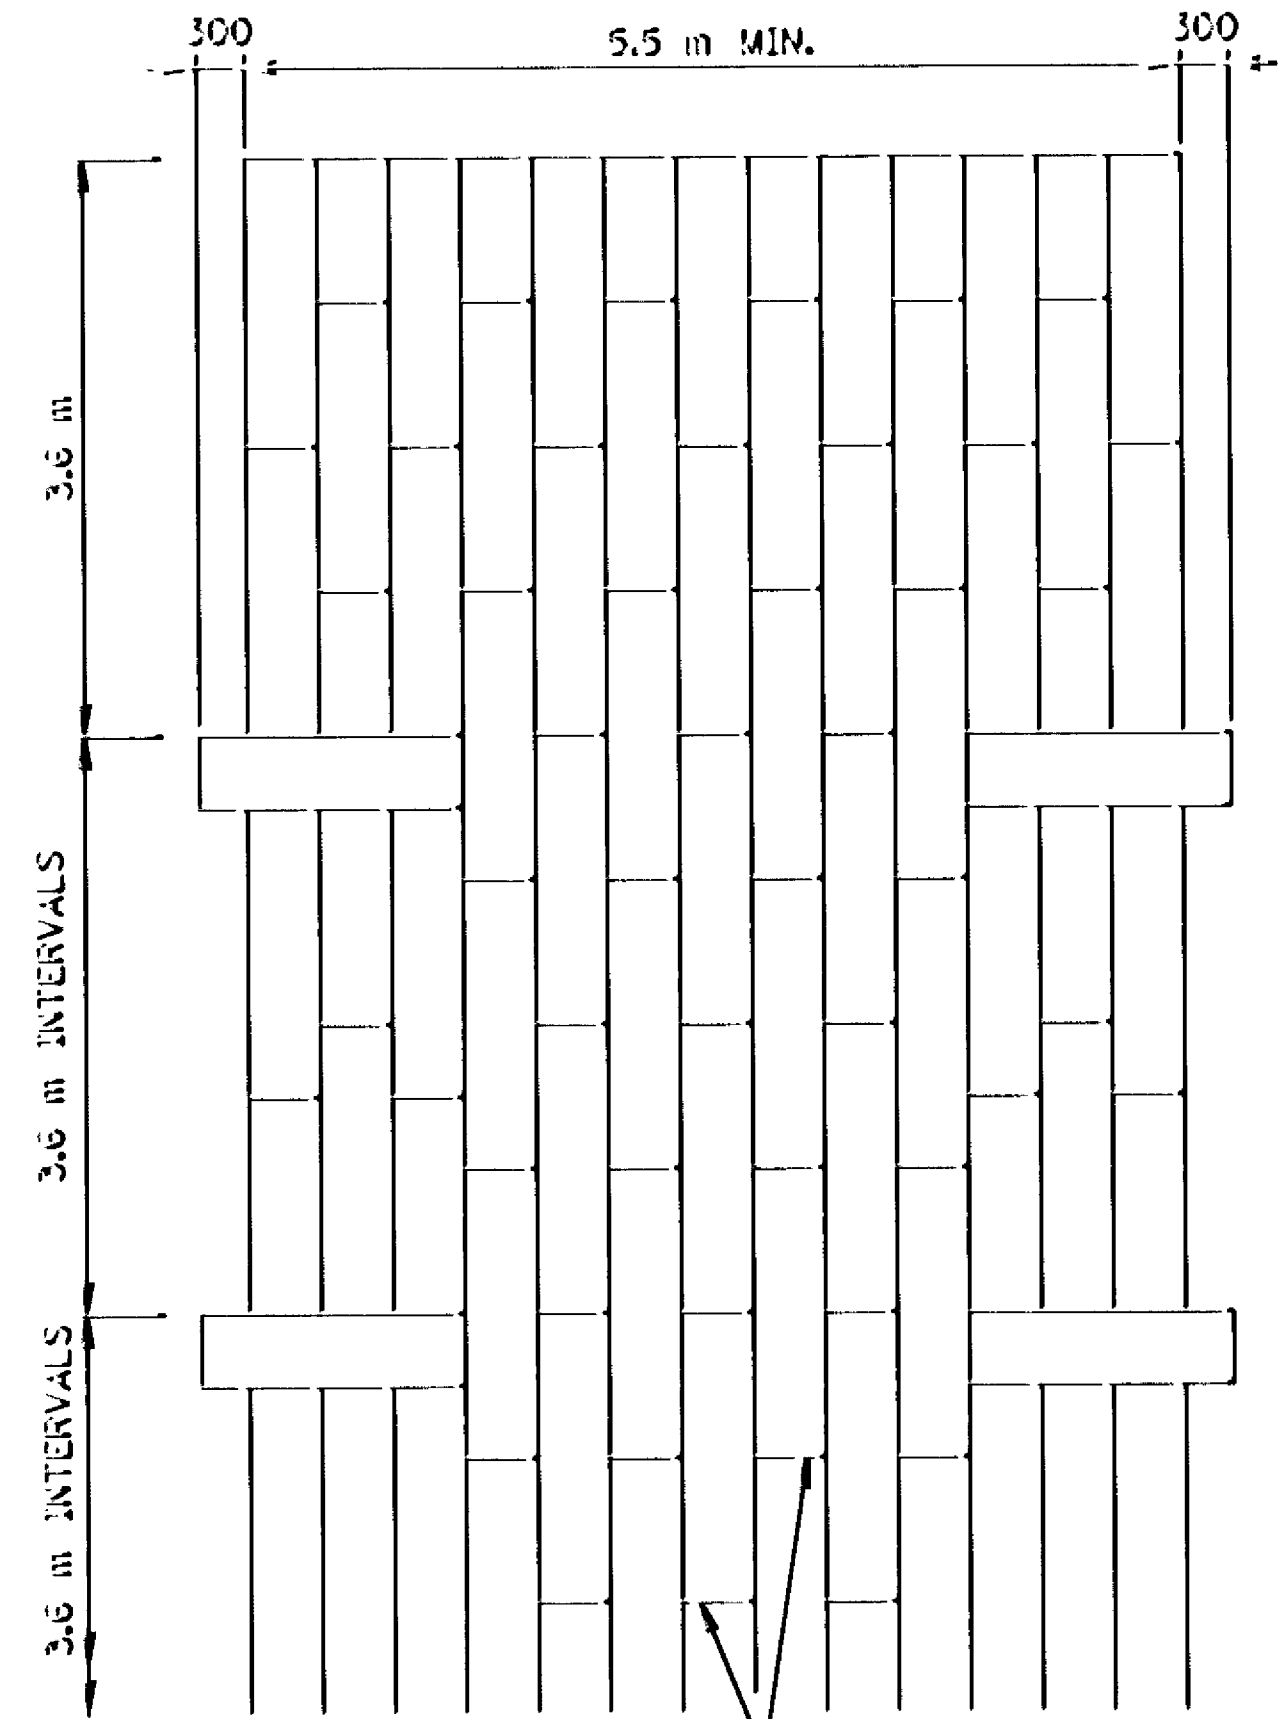


PLAN VIEW

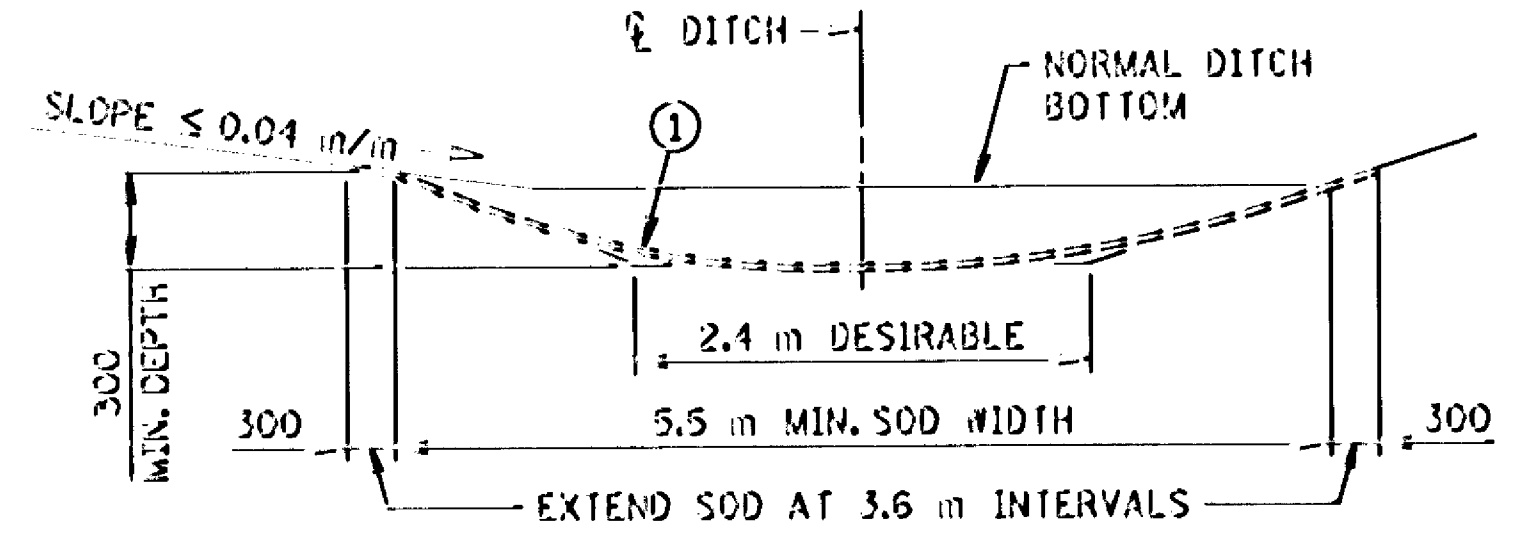


SODDED DITCH CROSS SECTION WHERE FRONT OR BACK SLOPE IS FLAT (LESS THAN 0.04 m/m), FIRST NOTCH DITCH AND THEN PROVIDE ROUNDING.

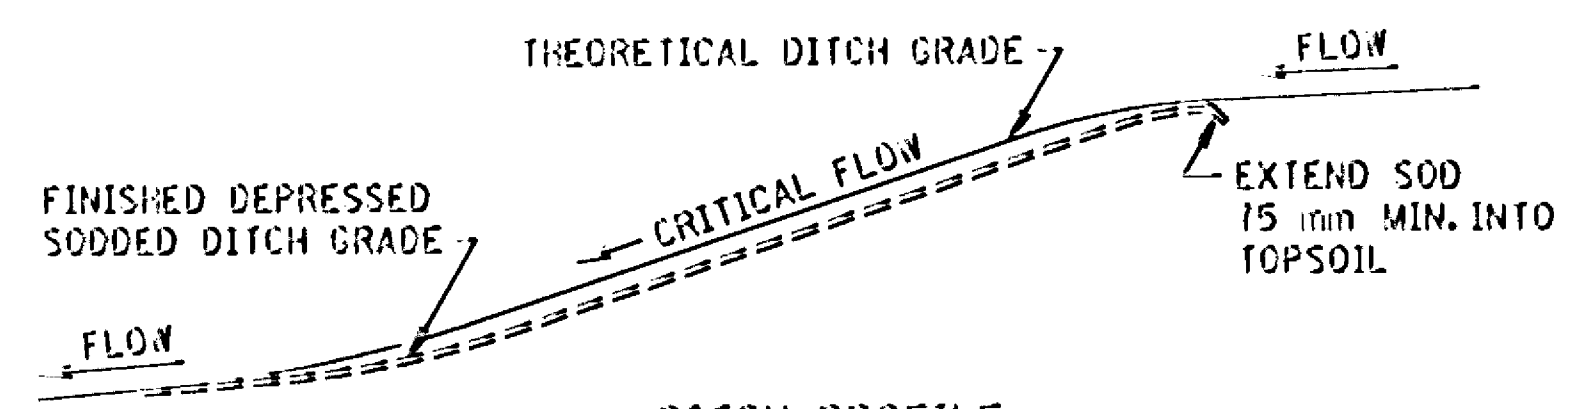


DITCH PROFILE SODDED DITCH DETAILS

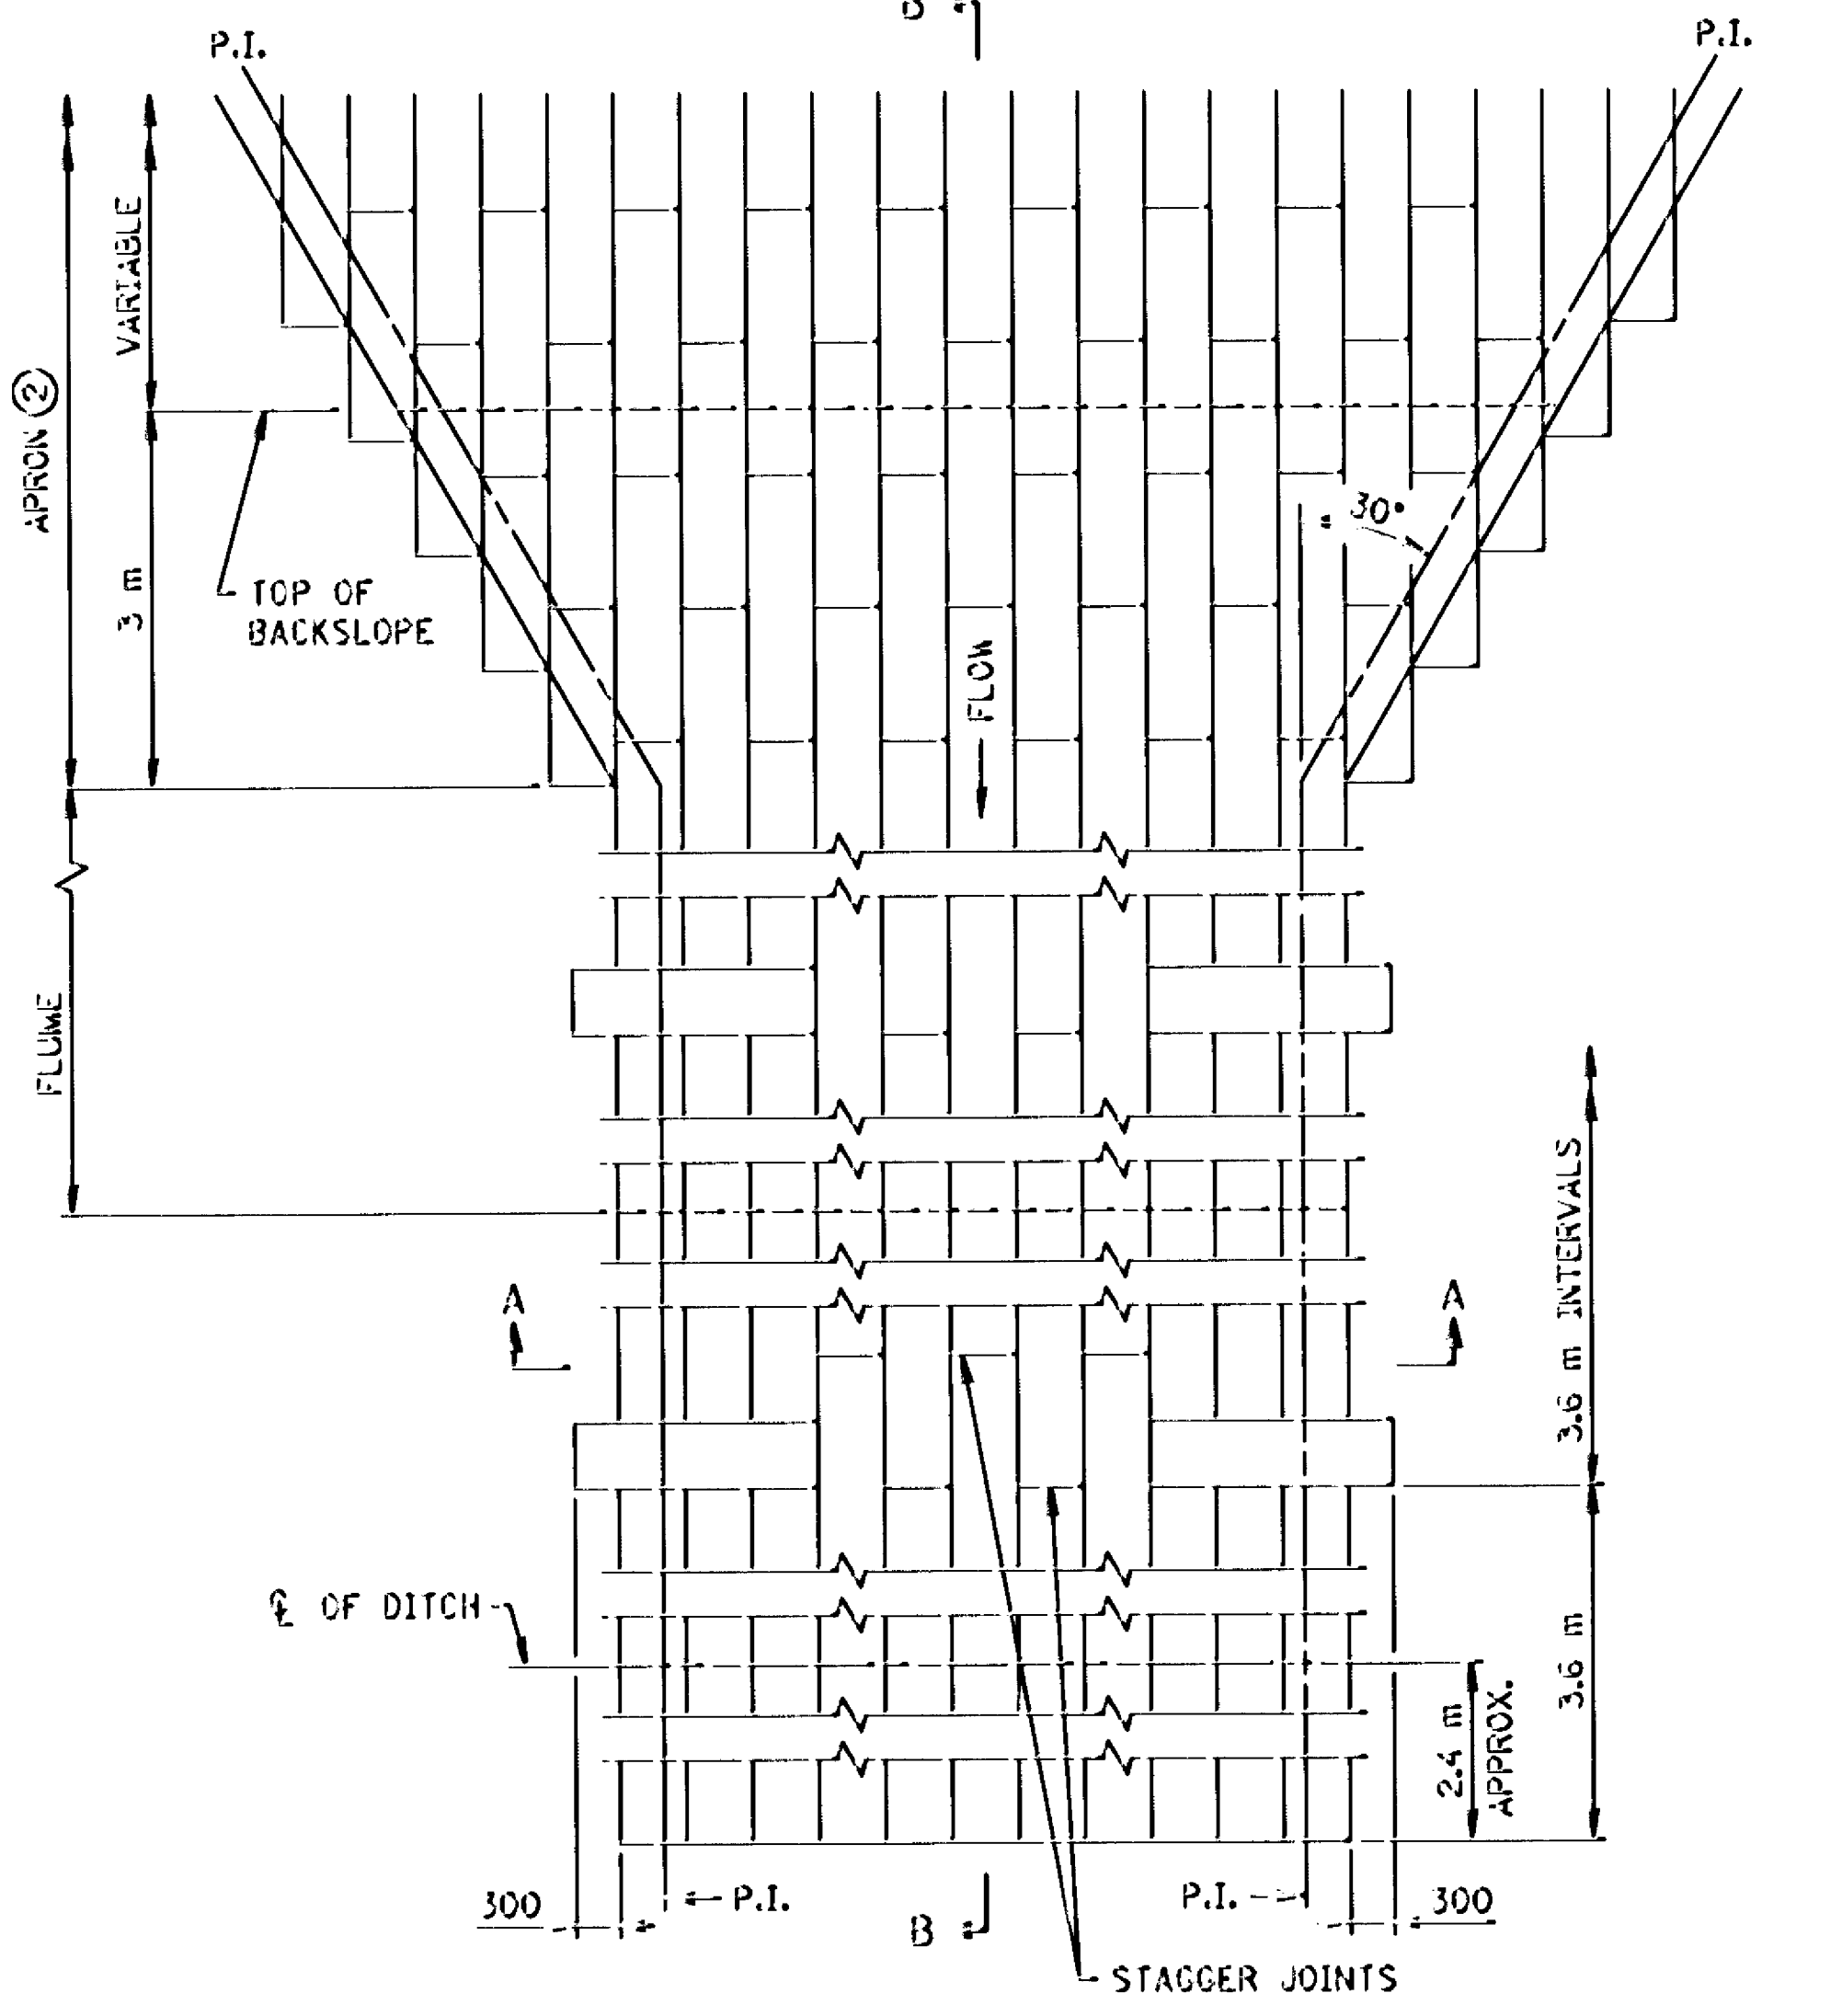

PLAN VIEW

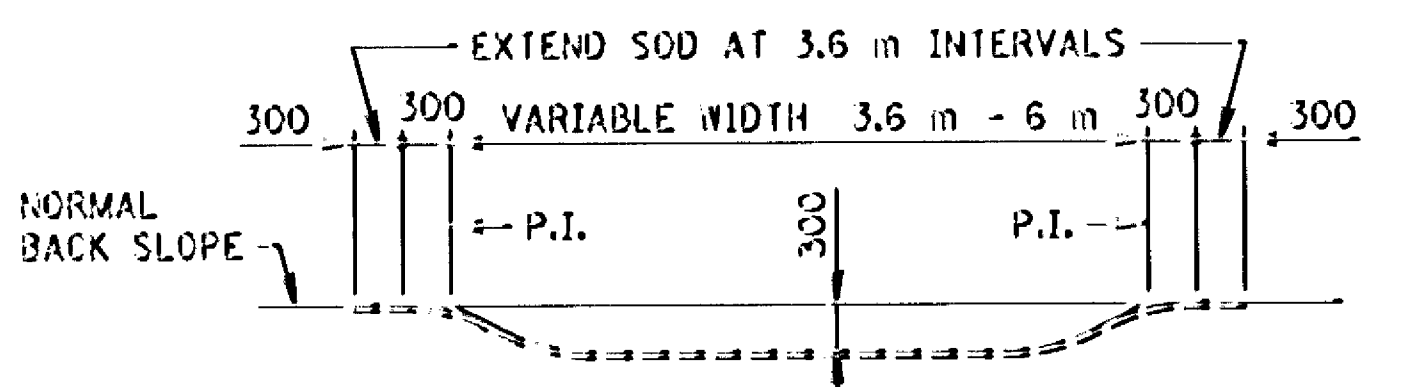

SECTION A-A

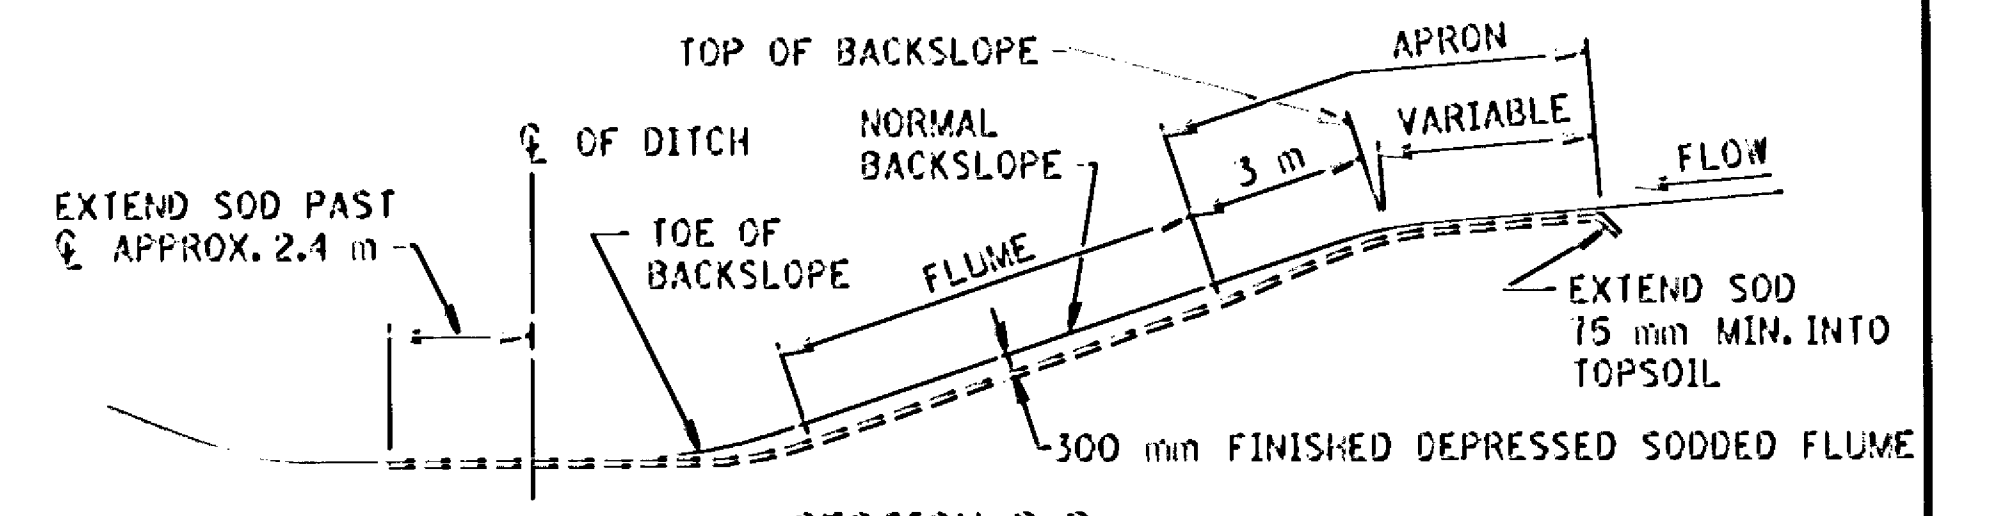


SECTION B-B SODDED FLUME DETAILS

NOTE: ALL DIMENSIONS ARE IN MILLIMETERS, EXCEPT AS NOTED.

- NOTES:
 SEE SPEC. 2515.3 FOR ADDITIONAL INFORMATION.
 ① FOR ROUNDING, SEE ROAD DESIGN MANUAL.
 ② CONSTRUCT TAPER AS DIRECTED BY THE ENGINEER.


STANDARD SHEET NO. 5-297.404M
 STANDARD APPROVED: DECEMBER 19, 1990

TITLE: PERMANENT EROSION CONTROL ALONG ROADWAYS, DITCHES AND FLUMES

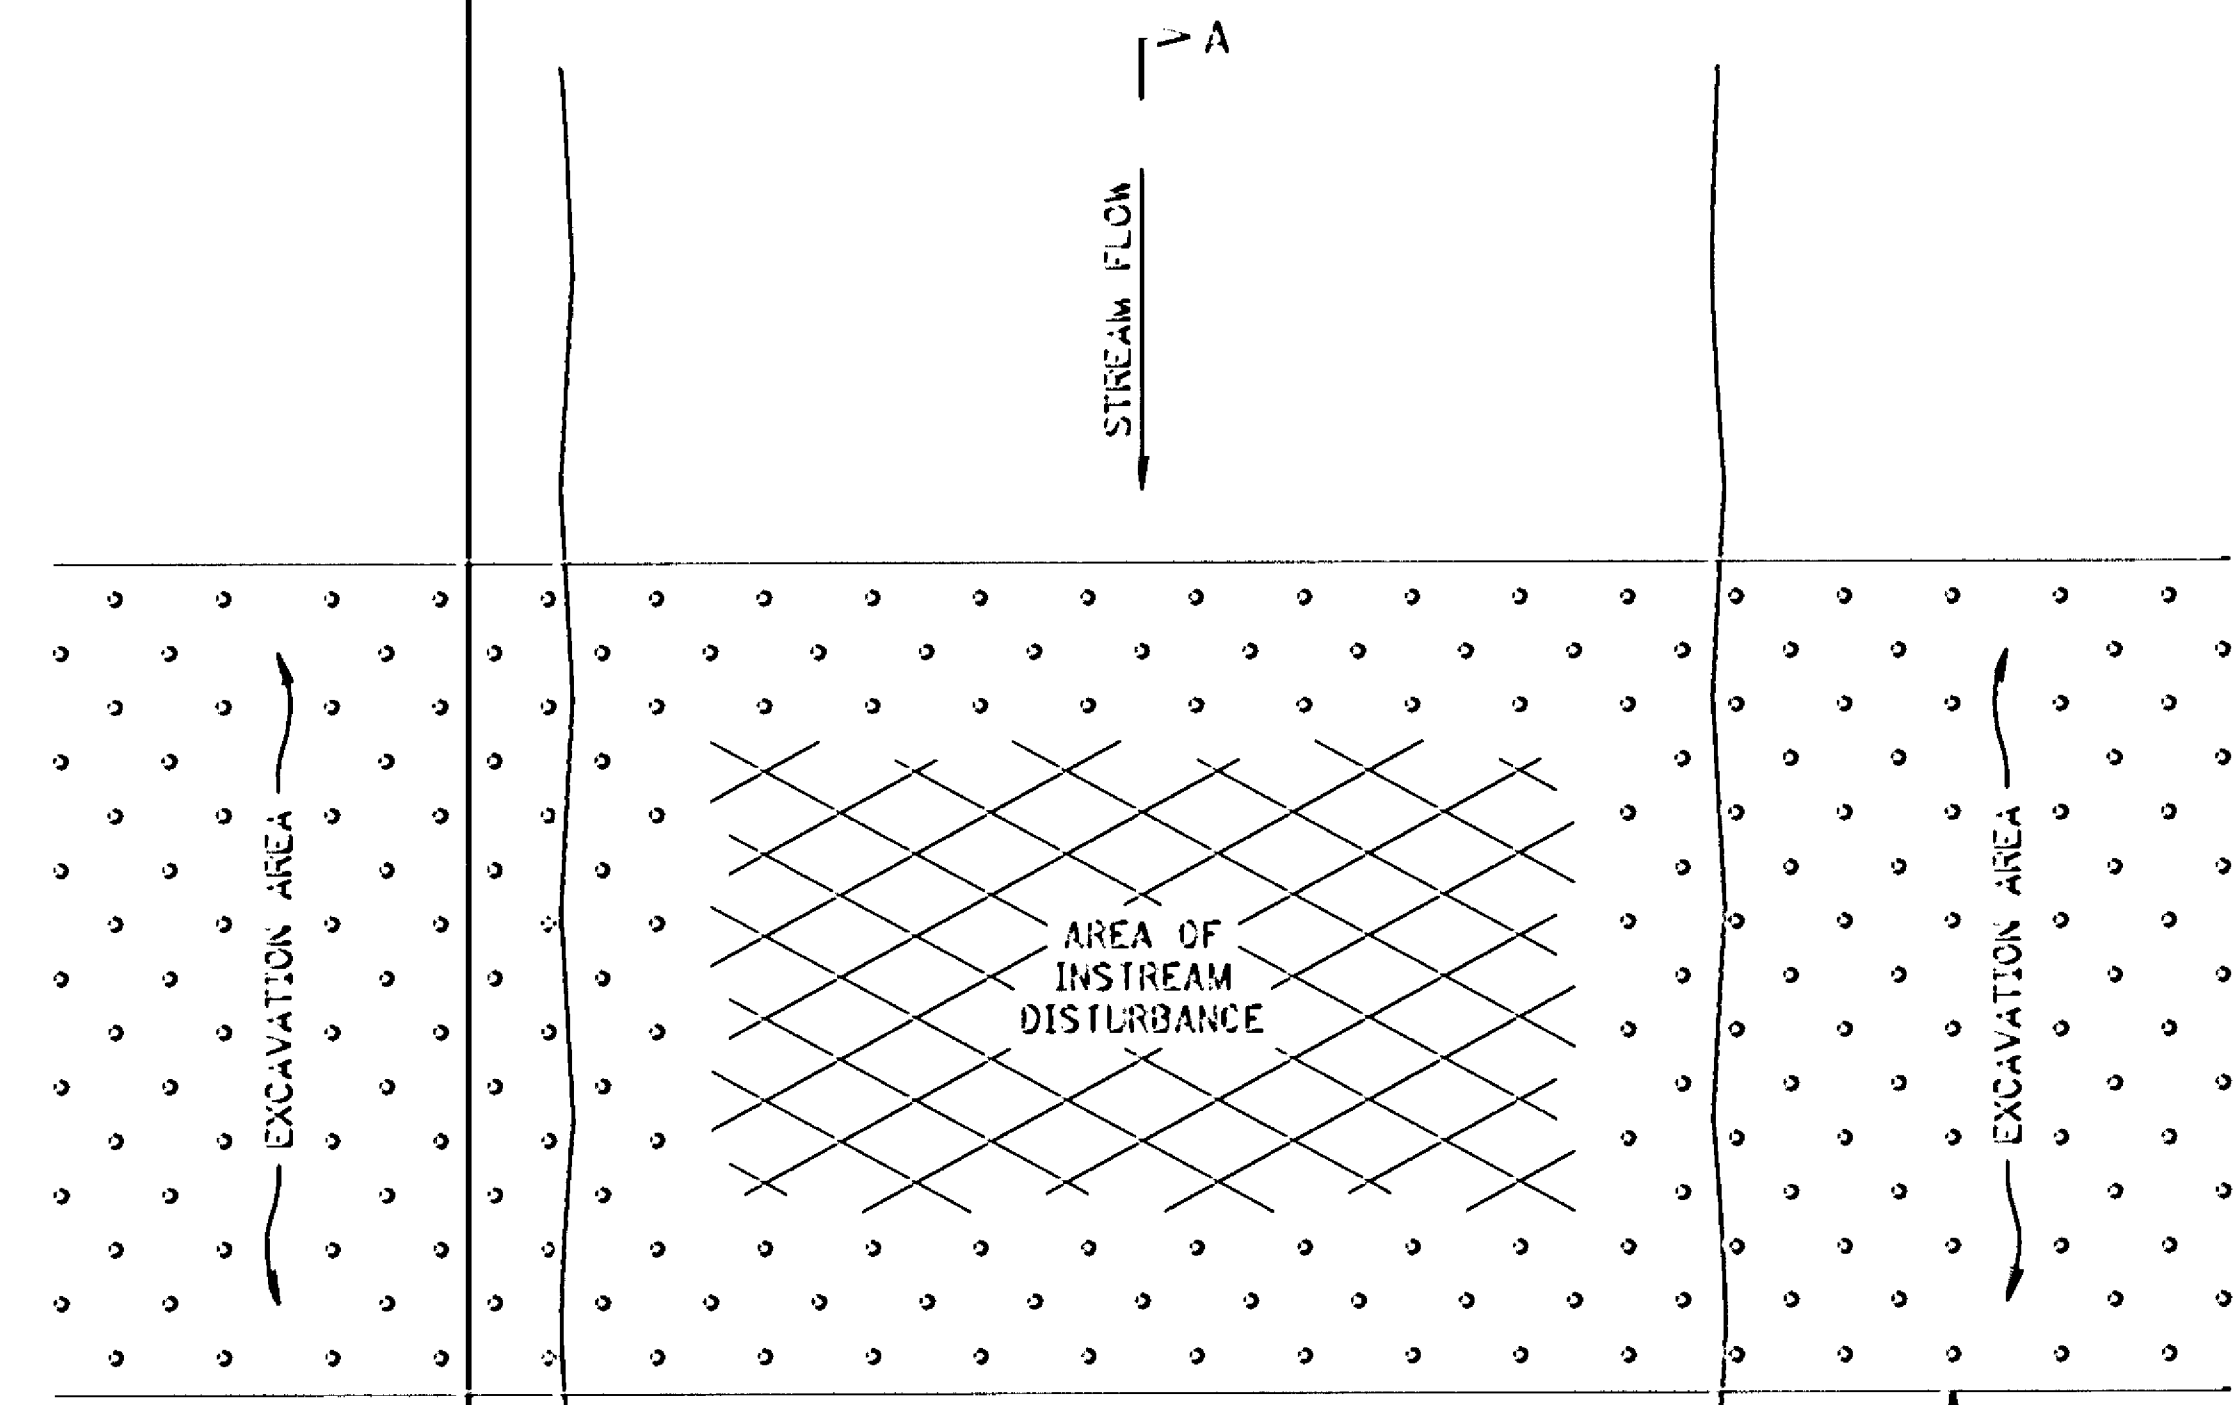

1.2 m MIN. DOWNSTREAM COVERAGE OF SEDIMENT MATS FOR EACH 0.3 m/SEC. OF WATER VELOCITY


STAKE AT 0.3 m INTERVALS

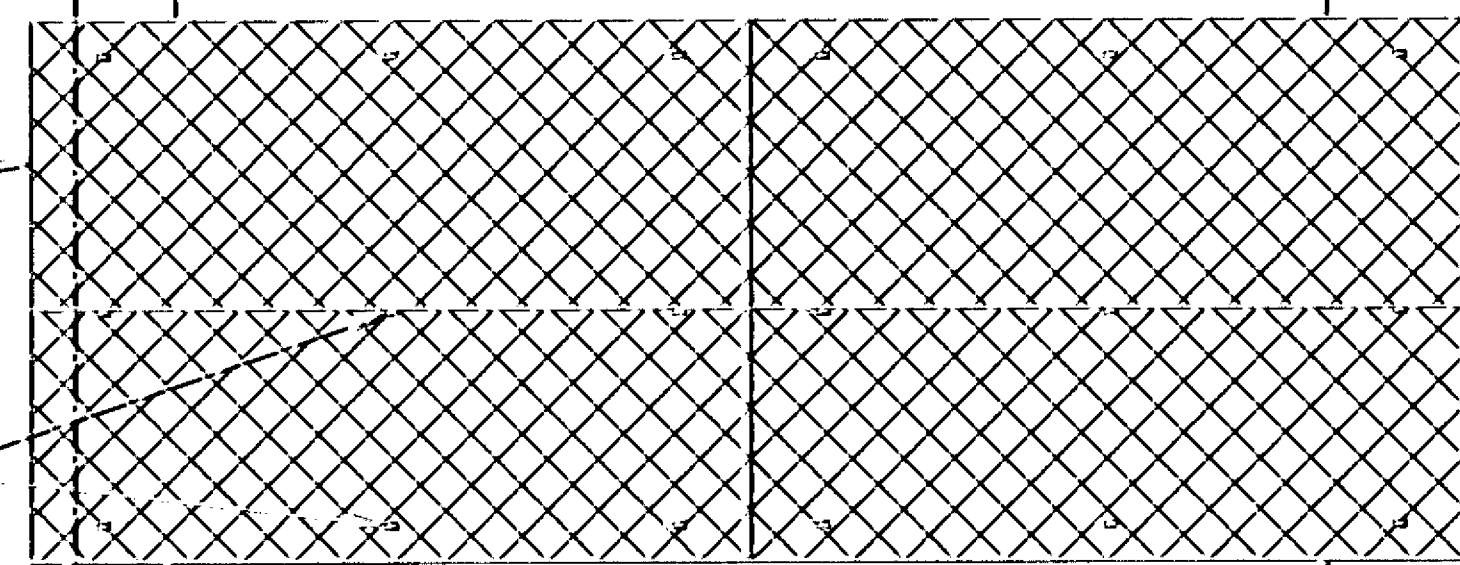

SEDIMENT MATS

EDGE OF STREAM


PLAN VIEW

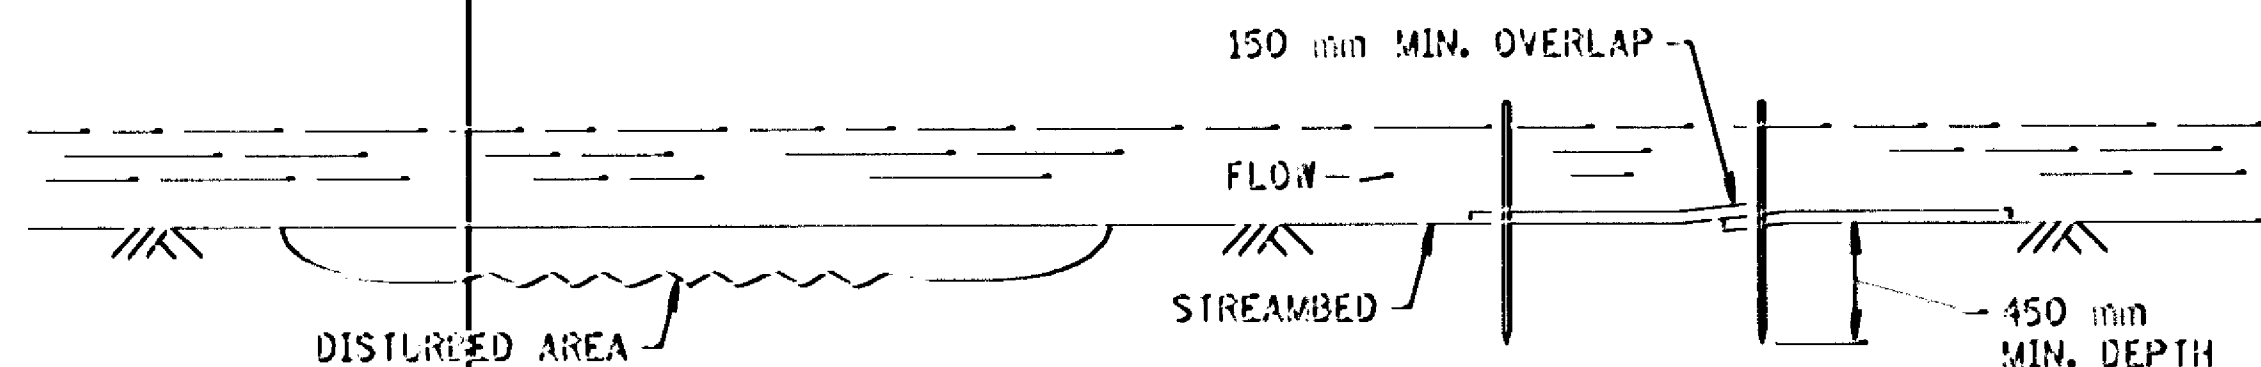

SECTION A-A

SEDIMENT MAT
TYPICAL STREAMBED INSTALLATION


DESIGN CRITERIA:
MAXIMUM FLOW VELOCITY: 1.5 m/SEC.
MAXIMUM FLOW DEPTH: 0.6 m

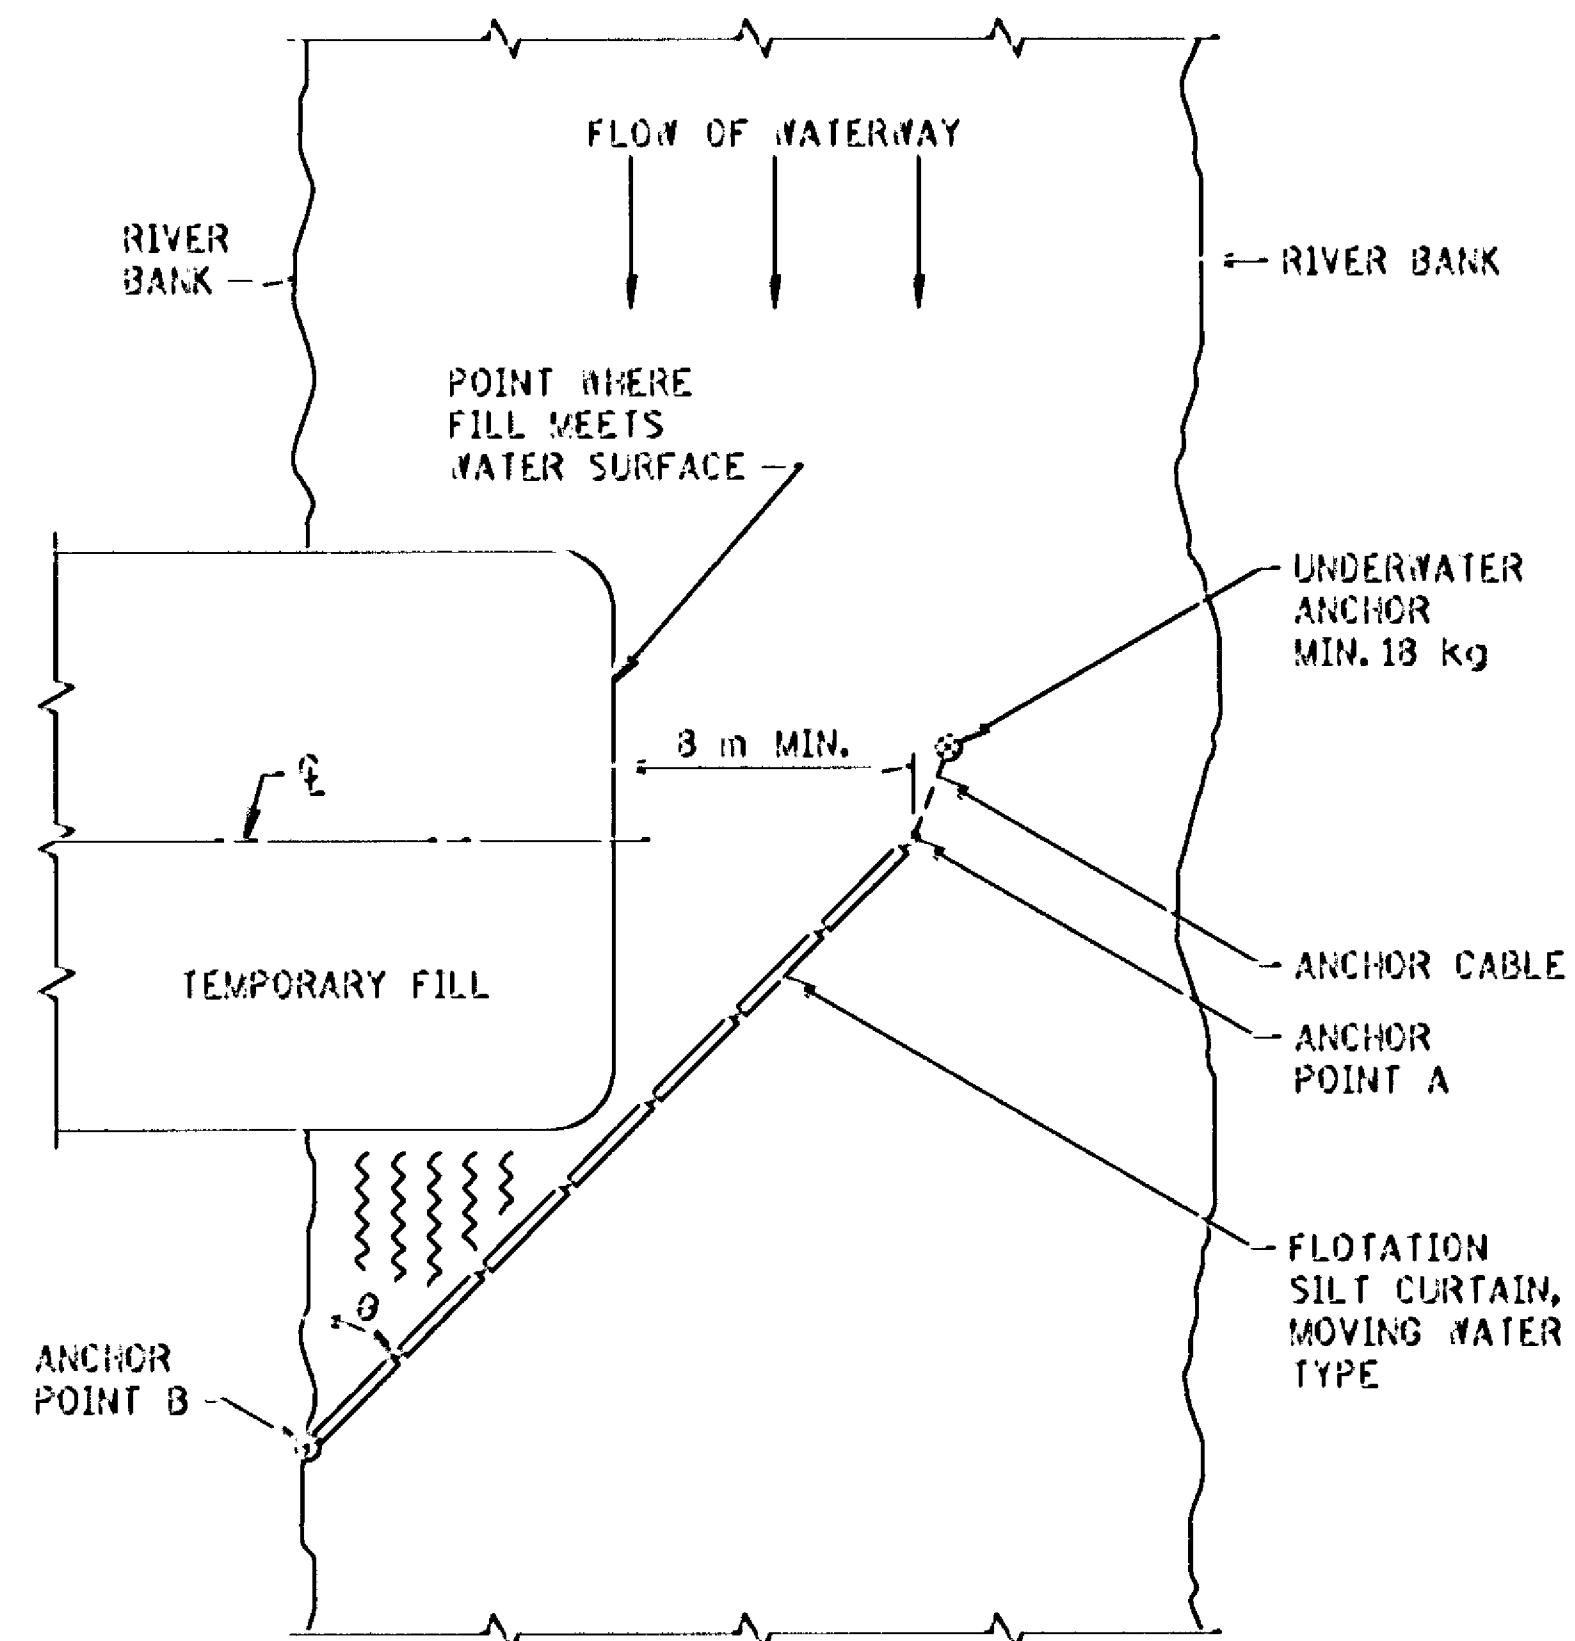


$\angle \theta$	RIVER VELOCITY
45°	SLOW, LESS THAN 1.5 m/SEC.
35°	MODERATE, 1.5 m - 2 m/SEC.

PLAN VIEW OF SILT CURTAIN - MOVING WATER

DESIGN CRITERIA:
MAXIMUM WATER DEPTH: 3.6 m
MAXIMUM WATER VELOCITY: 2.1 m/SEC.

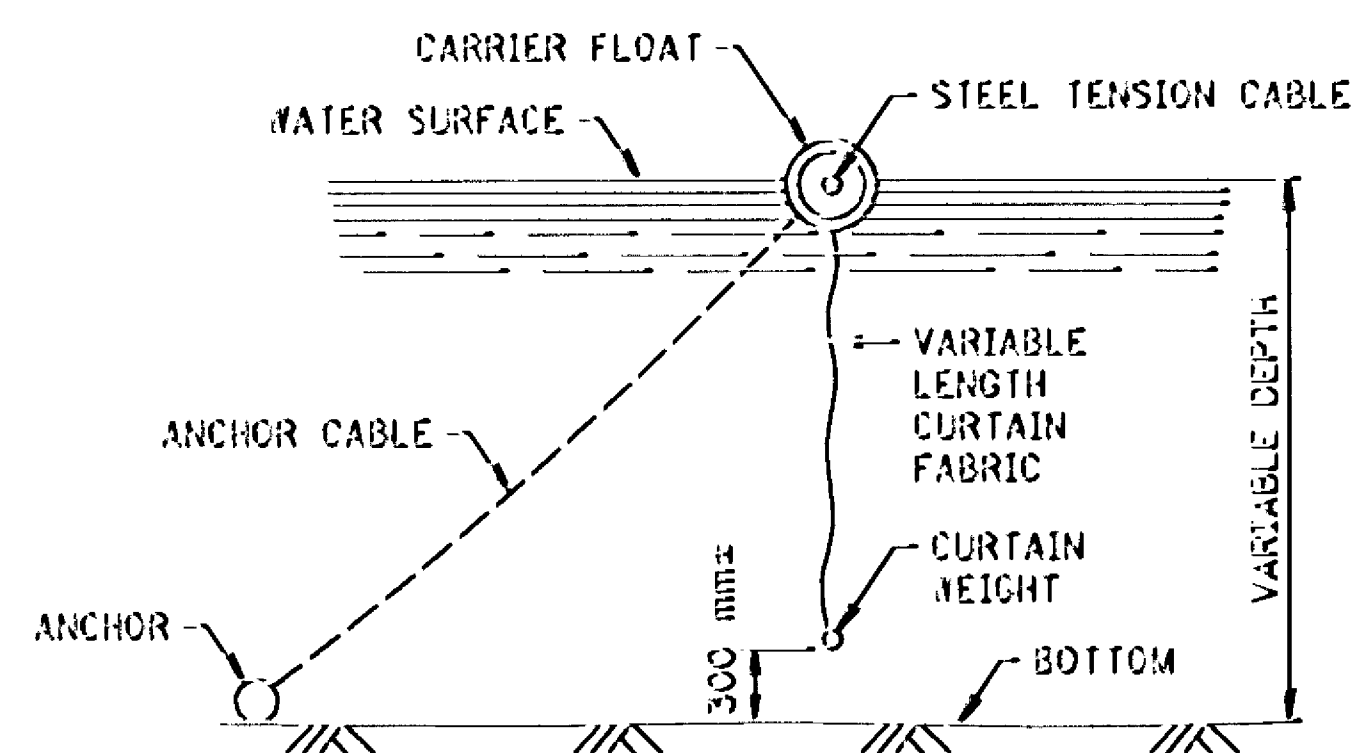


FLOTATION SILT CURTAIN DETAIL
(SEE SPEC. 3887)

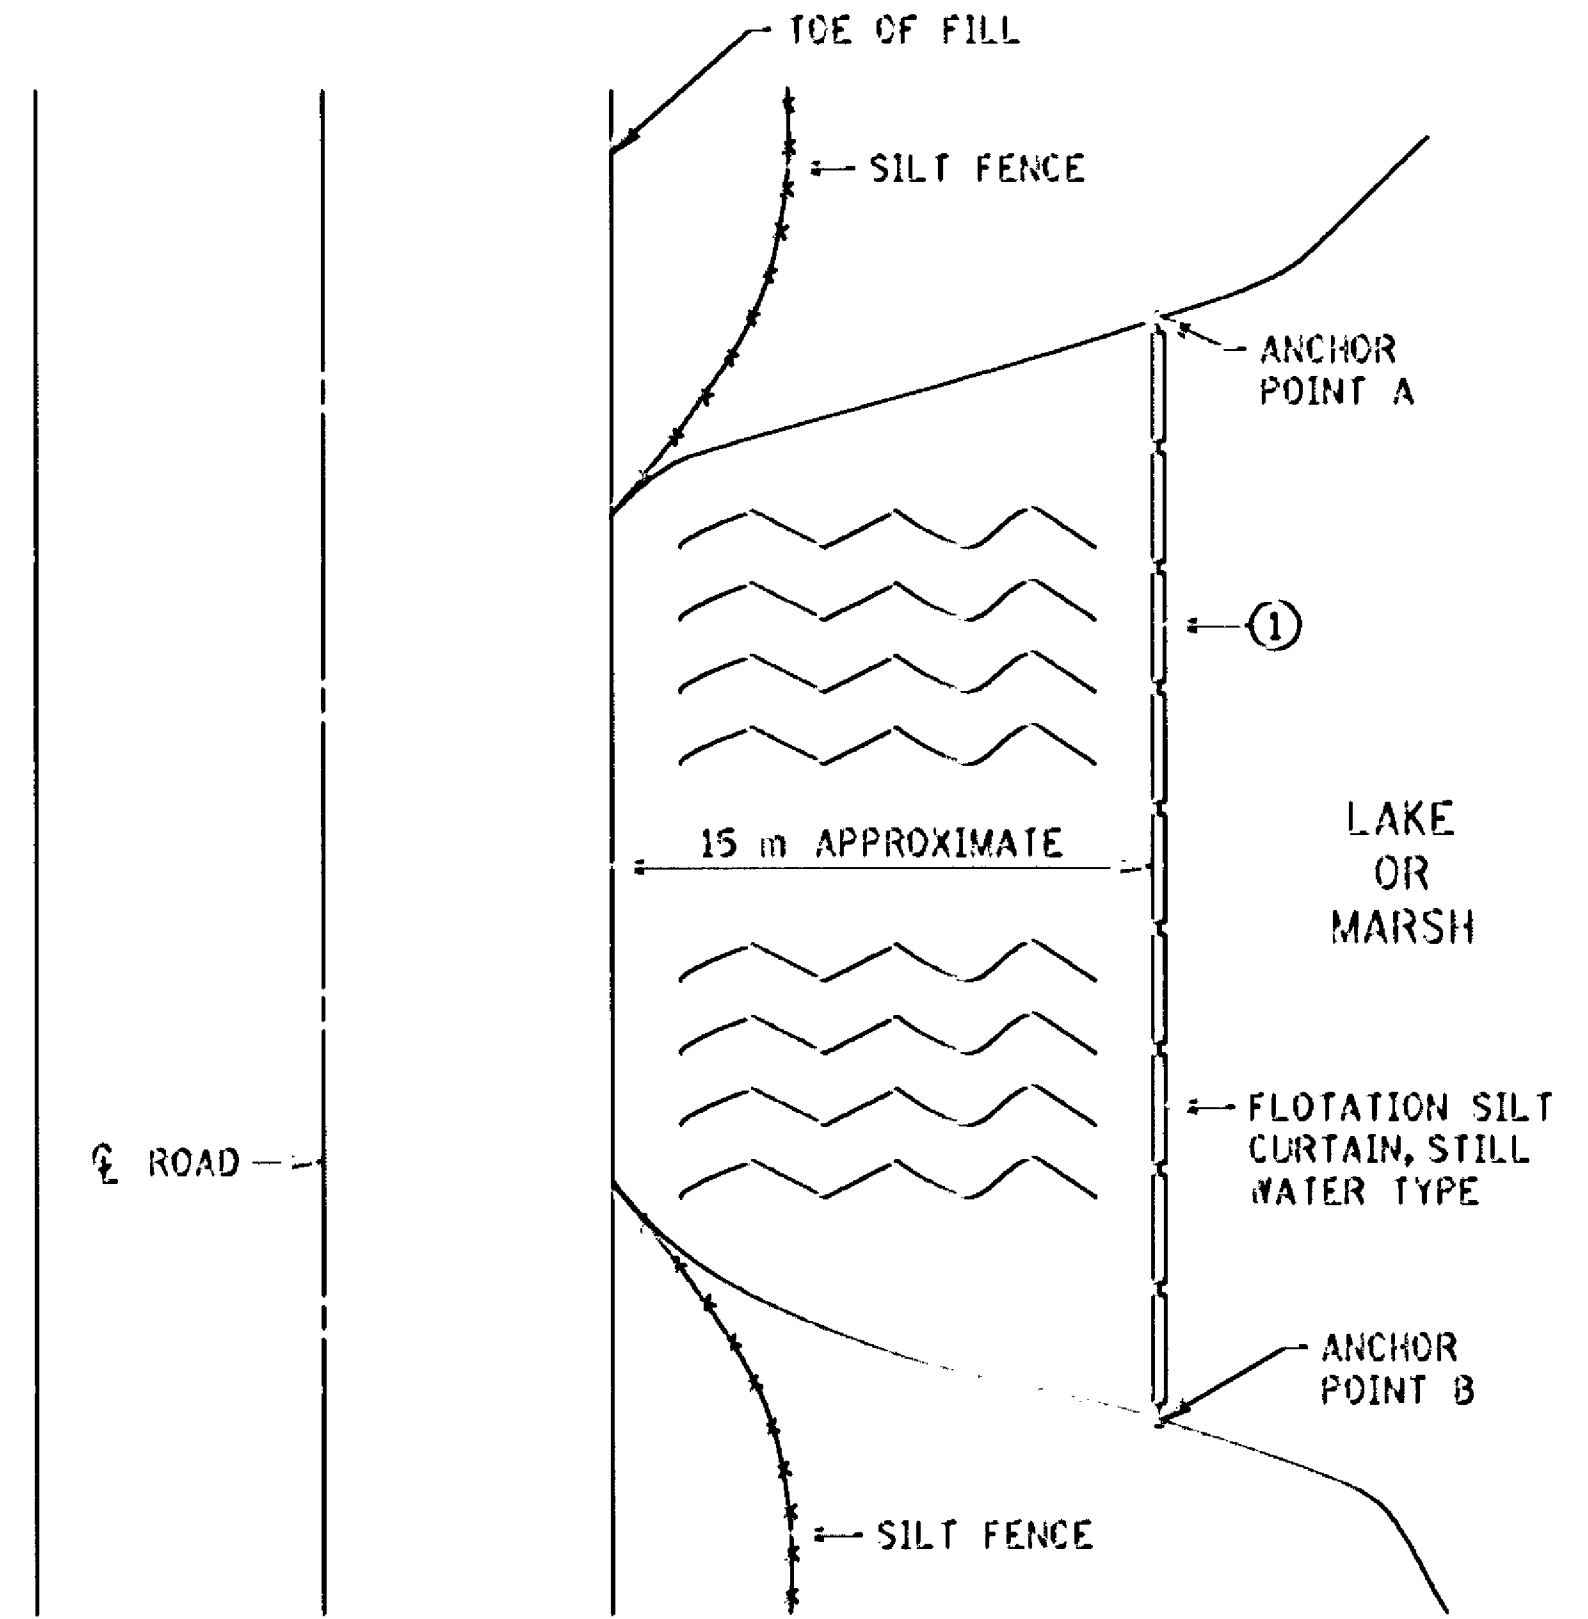


PLAN VIEW OF SILT CURTAIN - STILL WATER

DESIGN CRITERIA:
MAXIMUM WATER DEPTH: 3.6 m

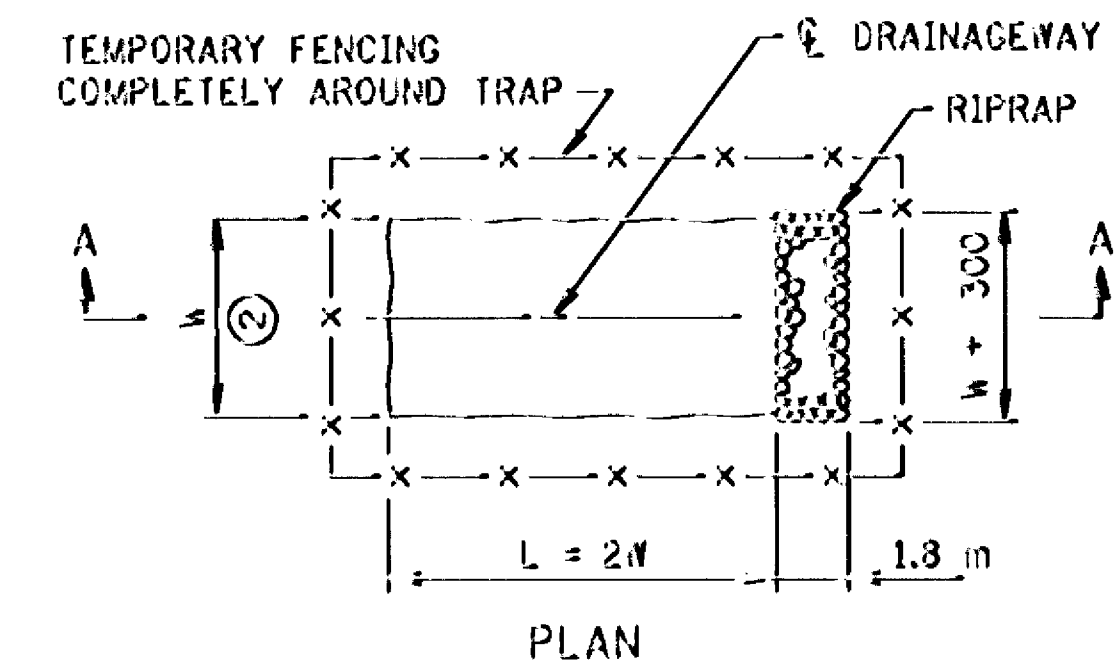

PLAN

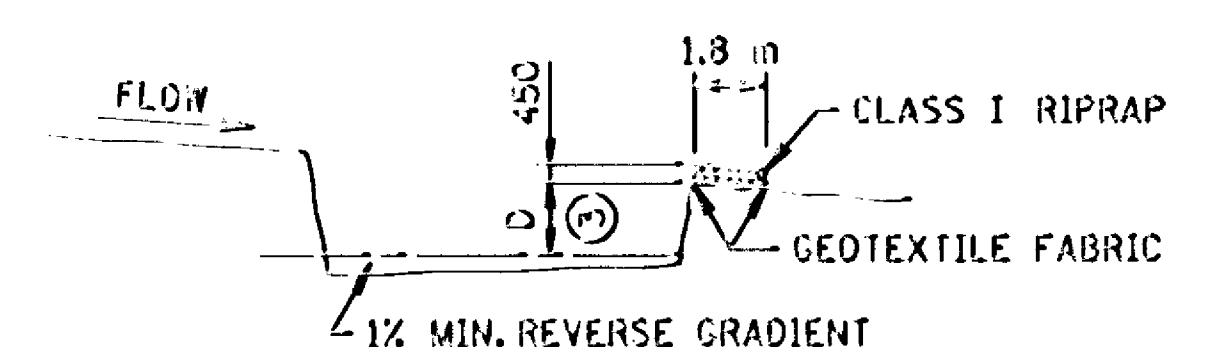

SECTION A-A

TEMPORARY SEDIMENT TRAP DETAIL

- NOTES:
- ① CURTAIN 300 mm FROM BOTTOM
 - ② W = 3 m MIN., 6 m MAX.
 - ③ D = 1 m MIN., 1.8 m MAX.

NOTE: ALL DIMENSIONS ARE IN MILLIMETERS, EXCEPT AS NOTED.


STANDARD SHEET NO.
5-297.405M (1 OF 3)
STANDARD APPROVED:
MAY 1, 1995

TITLE:

TEMPORARY EROSION CONTROL


S.A.P. 02-617-11, et al.

SHEET NO. 155 OF 245 SHEETS

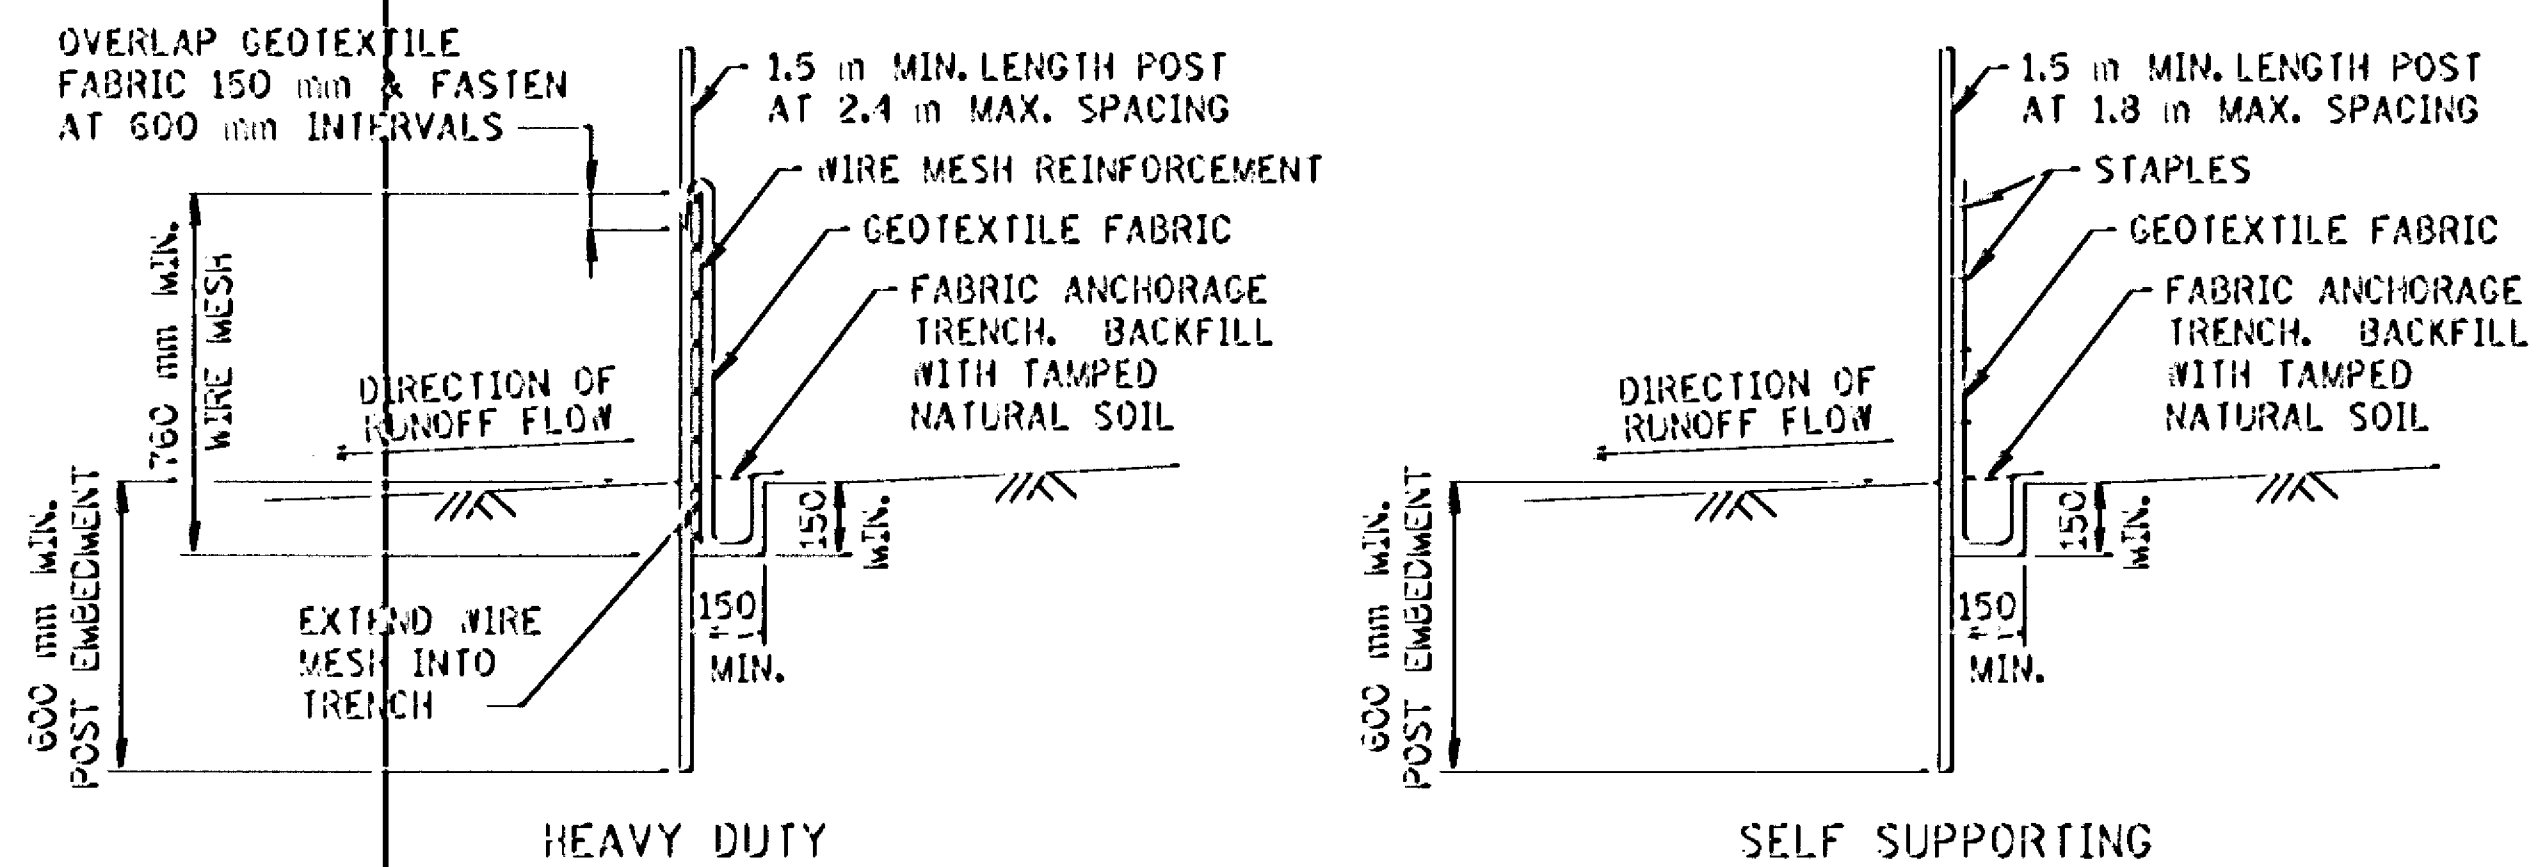


SILT FENCE DETAILS
TO PROTECT AREAS FROM SHEET FLOW
(SEE SPEC. 3886)


DESIGN CRITERIA:
MAXIMUM CONTRIBUTING AREA: 1.2 ha

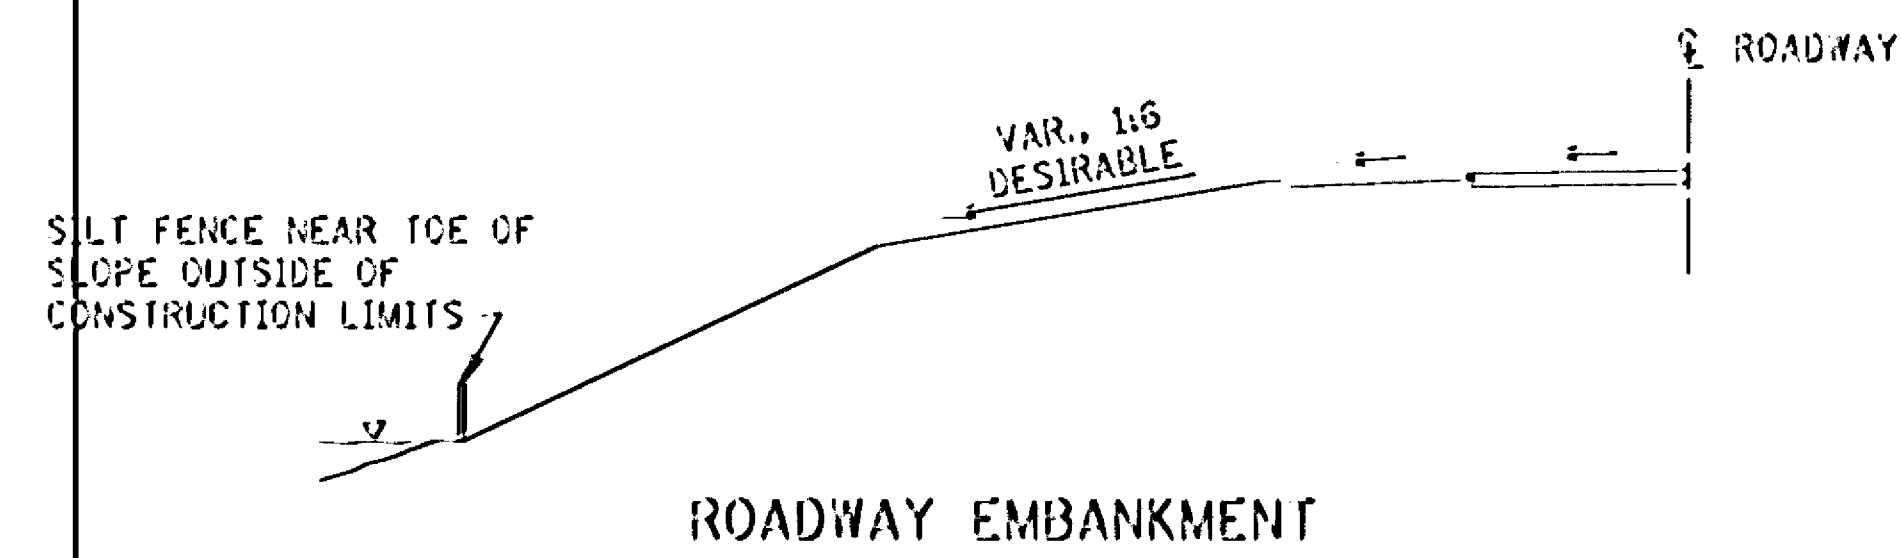

ROADWAY EMBANKMENT

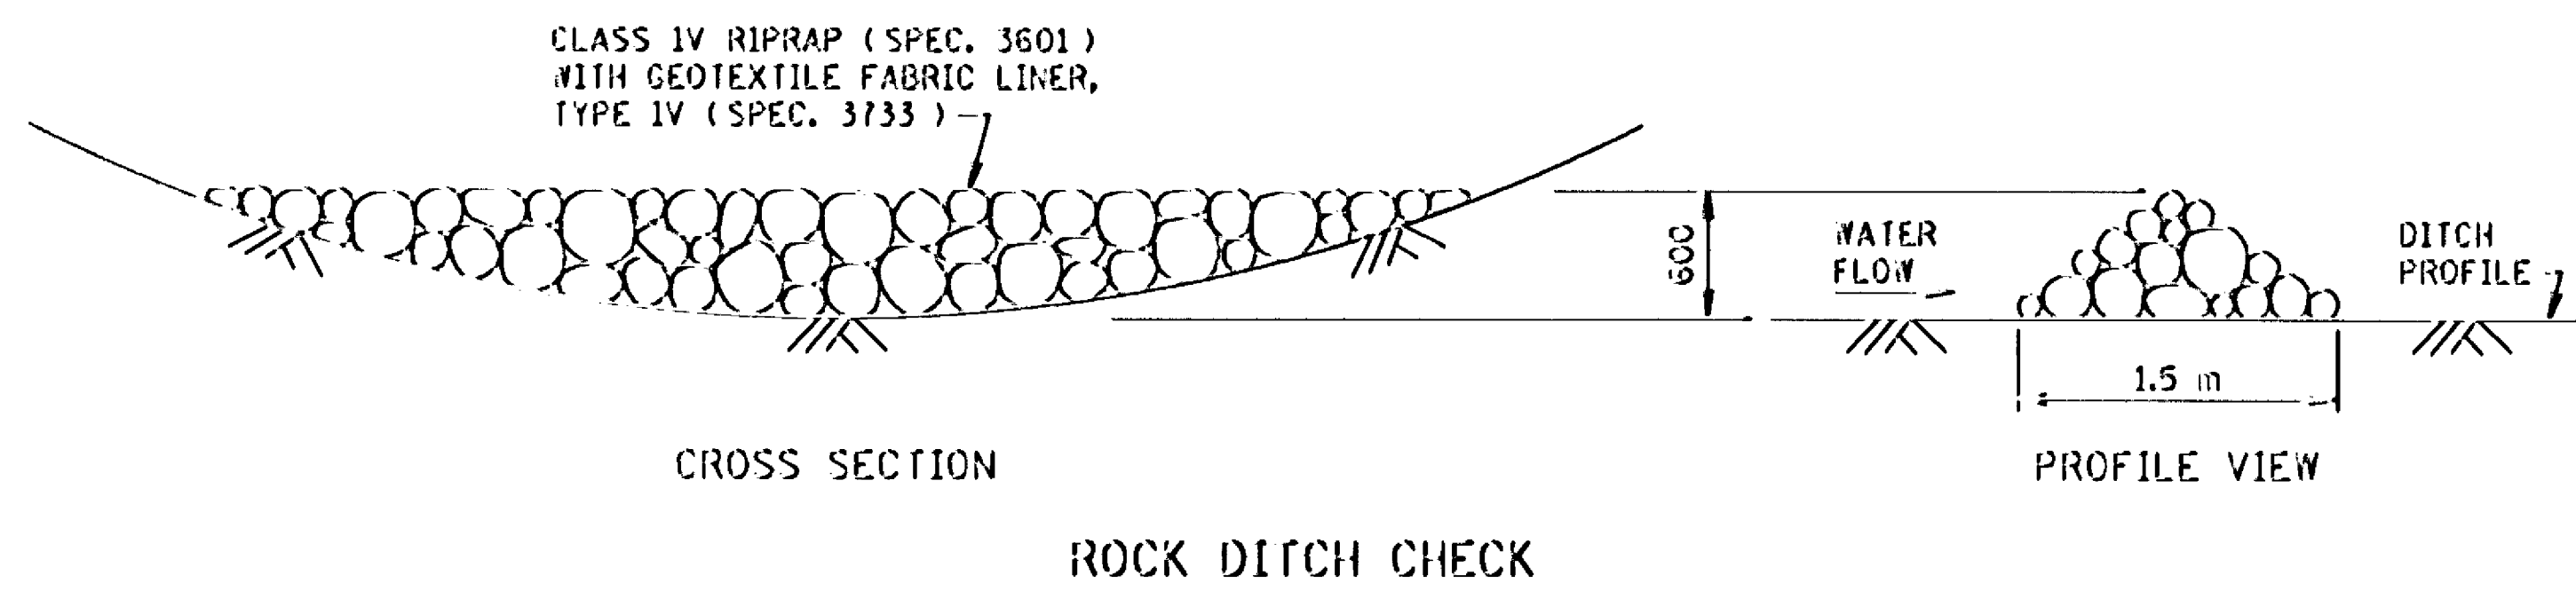


ROCK DITCH CHECK


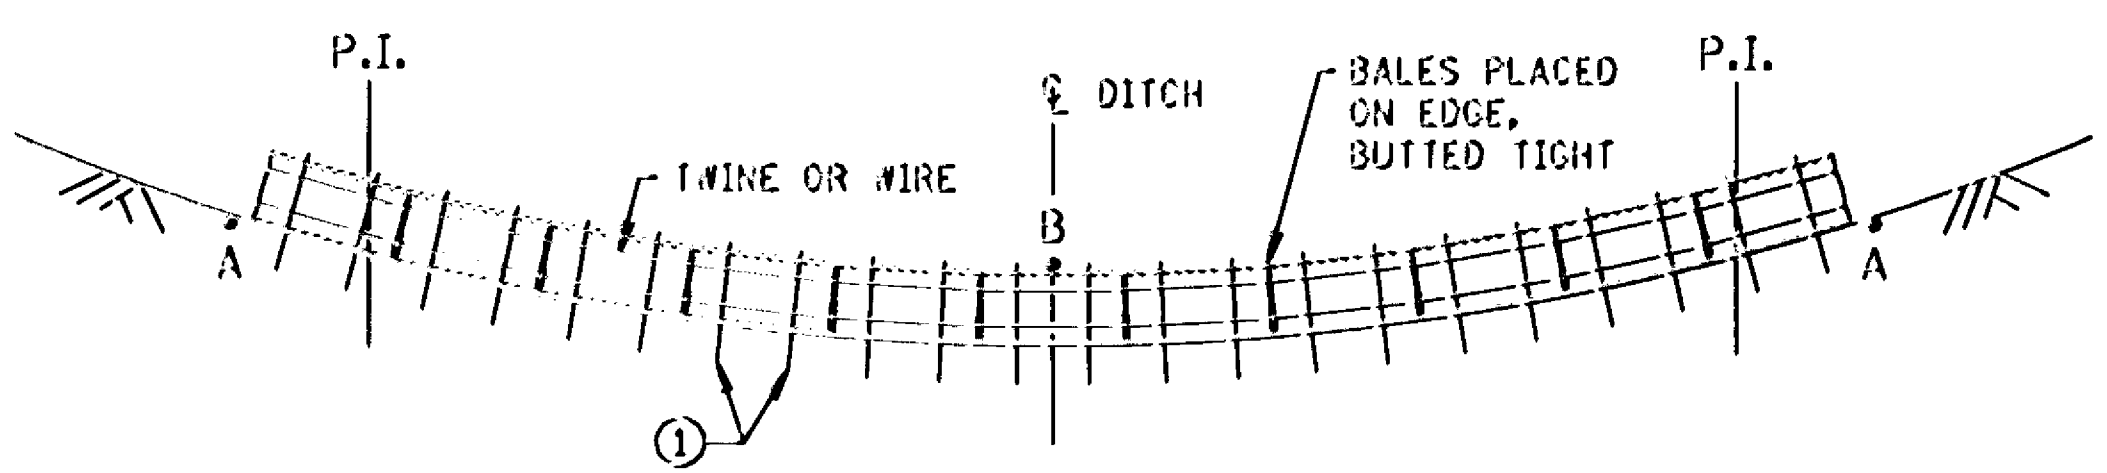


NOTE:
POINT A MUST BE HIGHER THAN POINT B

BALE DITCH SEDIMENT CHECK

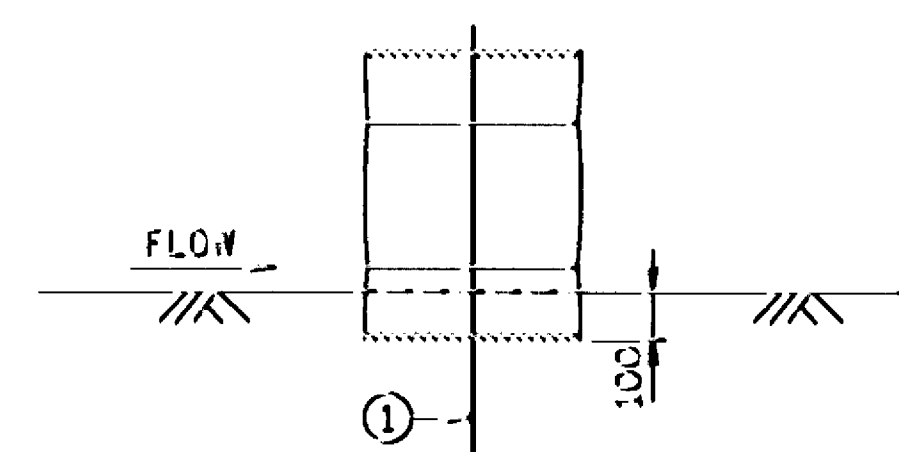

BALE CHECK DETAIL

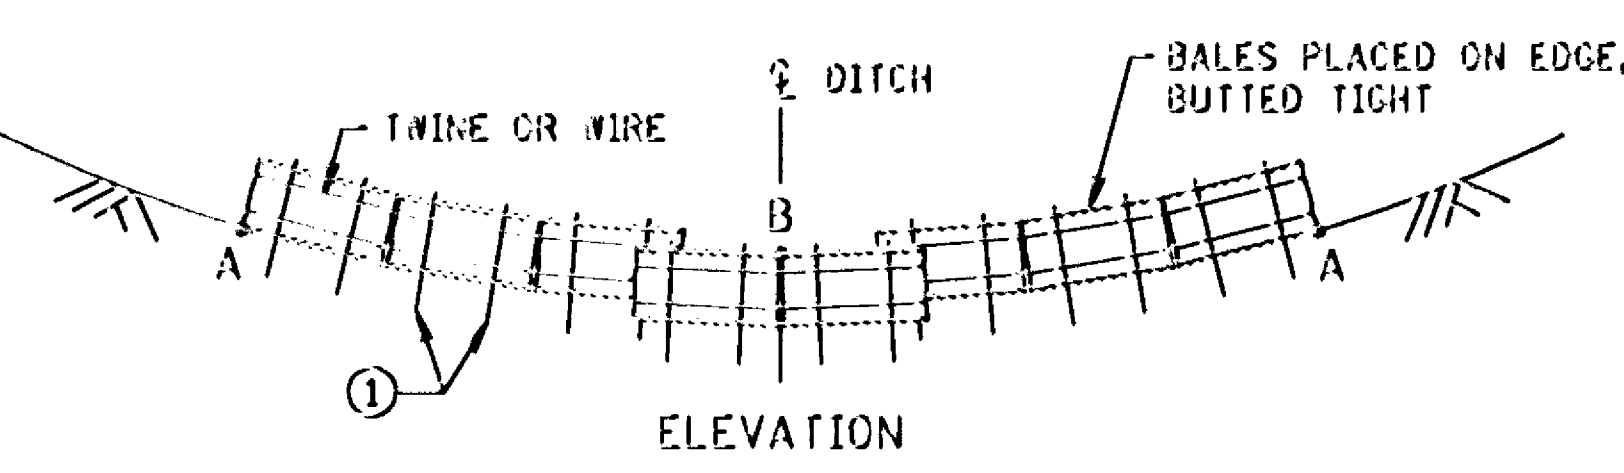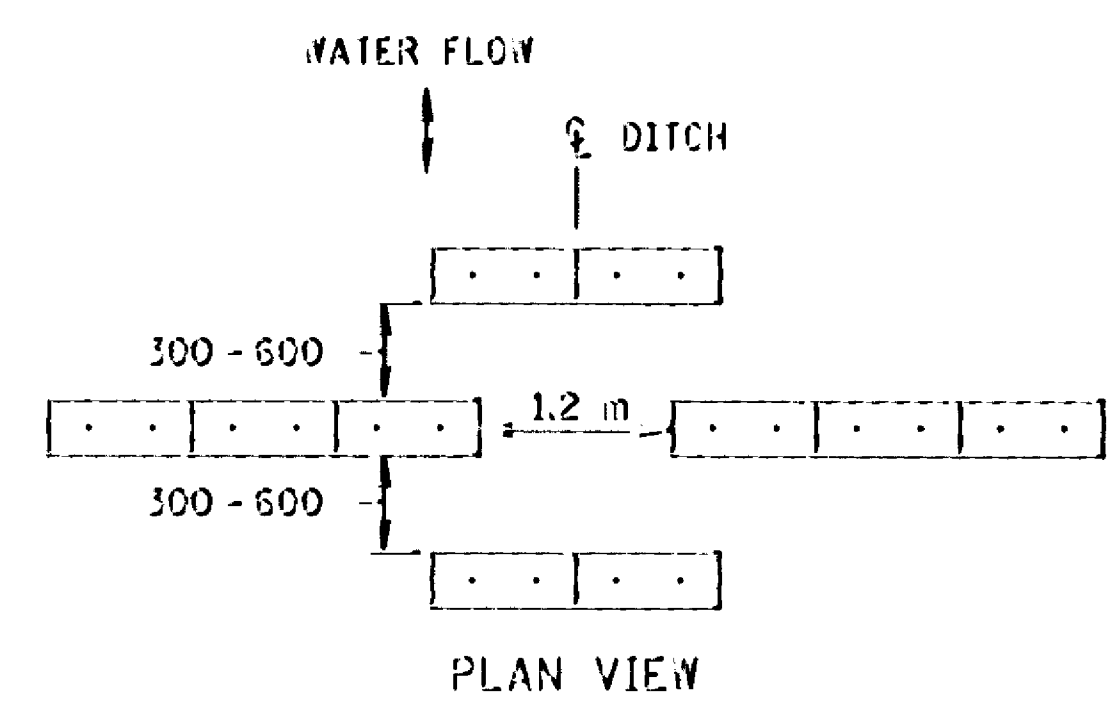

NOTE:
POINT A MUST BE HIGHER THAN POINT B

BALE DITCH VELOCITY CHECKS
(WILL REQUIRE A MINIMUM OF 10 BALES PER SITE)

RECOMMENDED SPACING BETWEEN DITCH CHECKS	
DITCH GRADE (%)	SPACING (m)
2	30
4	23
6	15
8	12
10	8

DESIGN CRITERIA:

	BALE	ROCK
STORM FREQUENCY:	2 YR. - 24 HR.	10 YR. - 24 HR.
MAX. FLOW VELOCITY:	1.5 m/SEC.	3.6 m/SEC.
MAX. DITCH GRADE:	5%	—
MAX. DRAINAGE AREA:	0.8 ha	2.0 ha

NOTE:
① TWO 50 mm X 50 mm WOOD STAKES OR REINFORCING BARS IN EACH BALE AND EMBEDDED IN THE GROUND 250 mm MINIMUM.

NOTE: ALL DIMENSIONS ARE IN MILLIMETERS, EXCEPT AS NOTED.



STANDARD SHEET NO.
5-297.405M (2 OF 3)
STANDARD APPROVED:
MAY 1, 1995

TEMPORARY EROSION CONTROL

S.A.P. 02-617-11, et al.


SHEET NO. 156 OF 245 SHEETS

SERVER C:\GKS1\USK\STANDARDS FILE NAME SIM05255.SPM

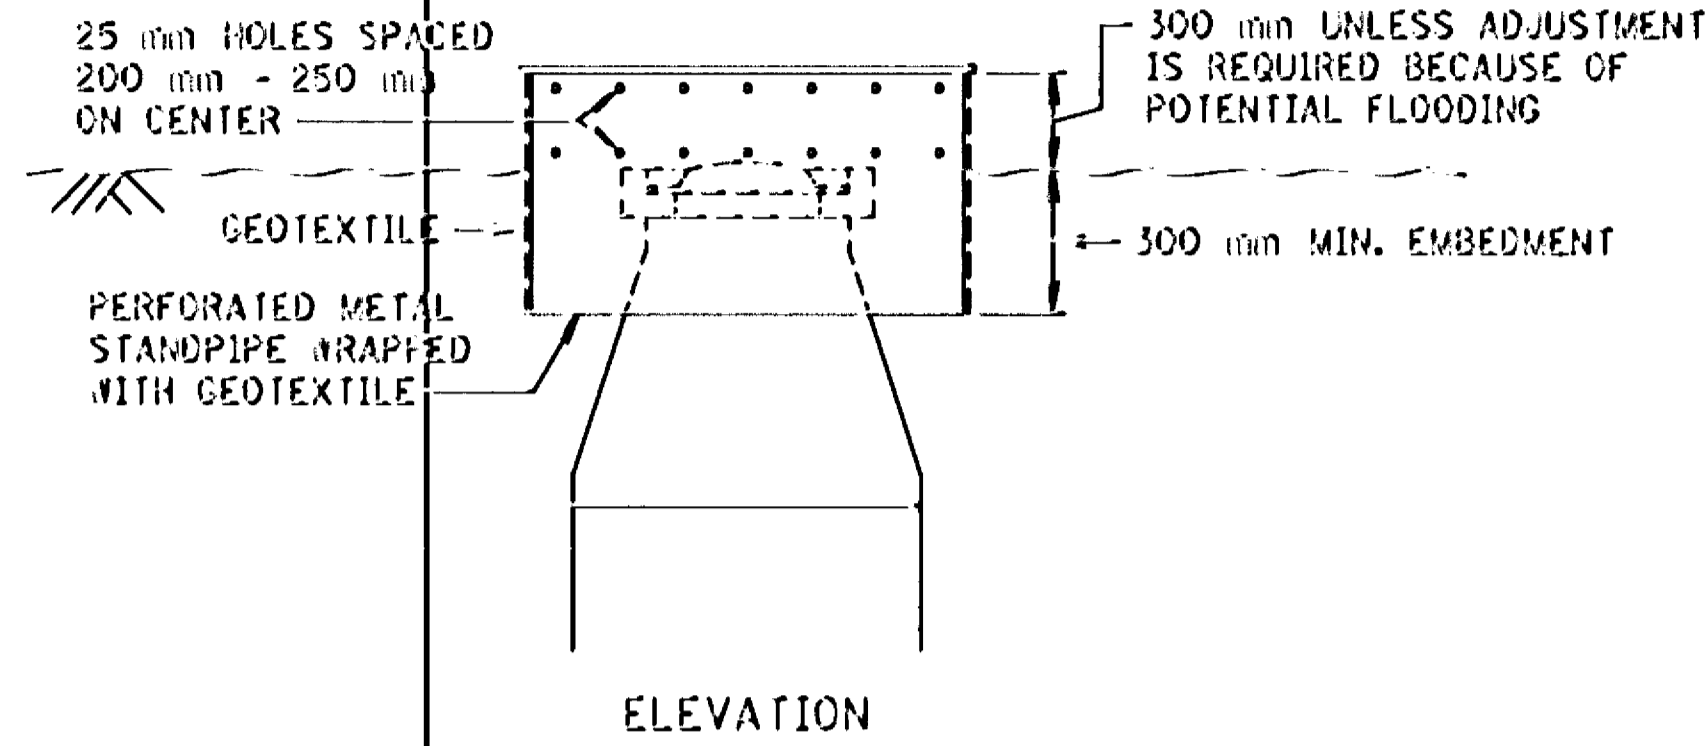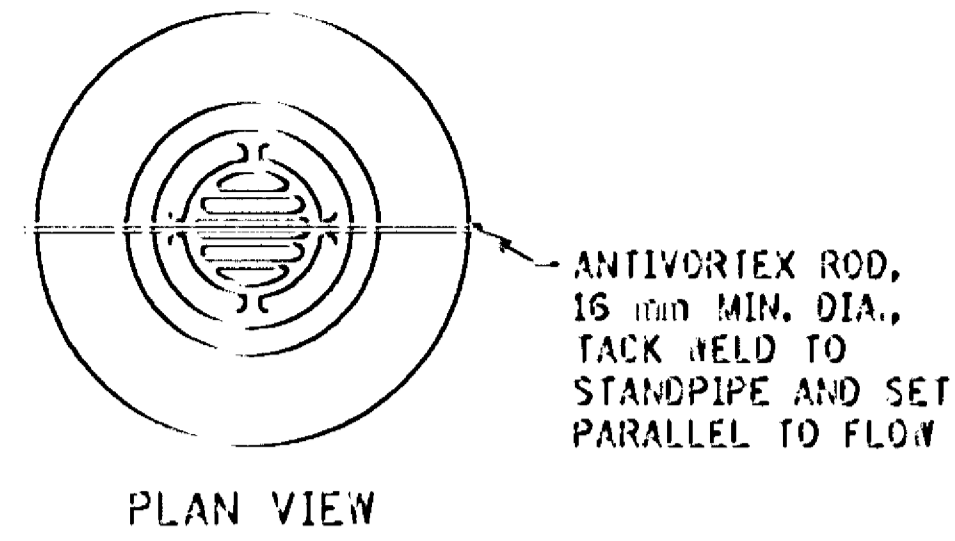


TEMPORARY STANDPIPE
TO PROTECT DROP INLET

DESIGN CRITERIA:
STORM FREQUENCY: 10 YEAR - 24 HOUR.

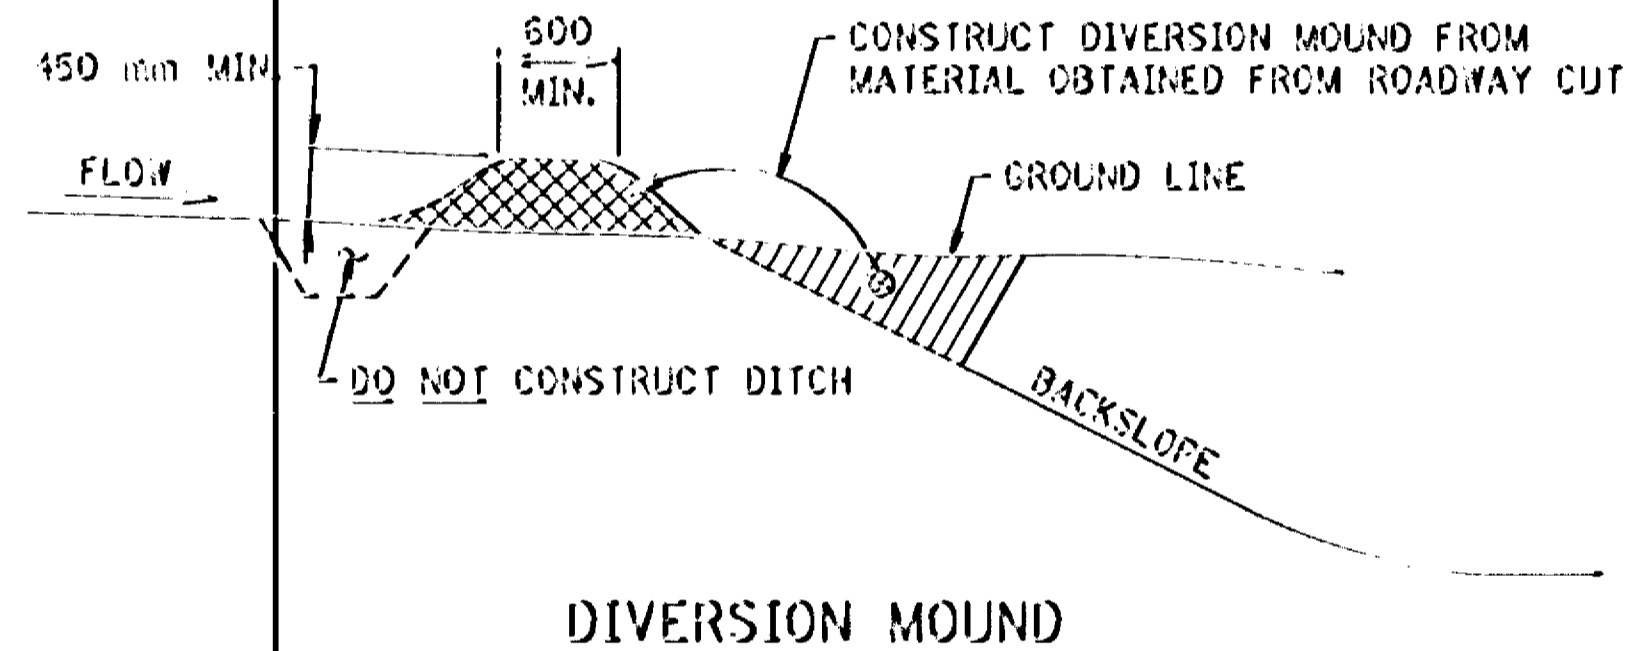


DESIGN CRITERIA:
STORM FREQUENCY: 10 YEAR - 24 HOUR
MAXIMUM DRAINAGE AREA: 2 ha
MAXIMUM DIVERSION: GRADE 5%

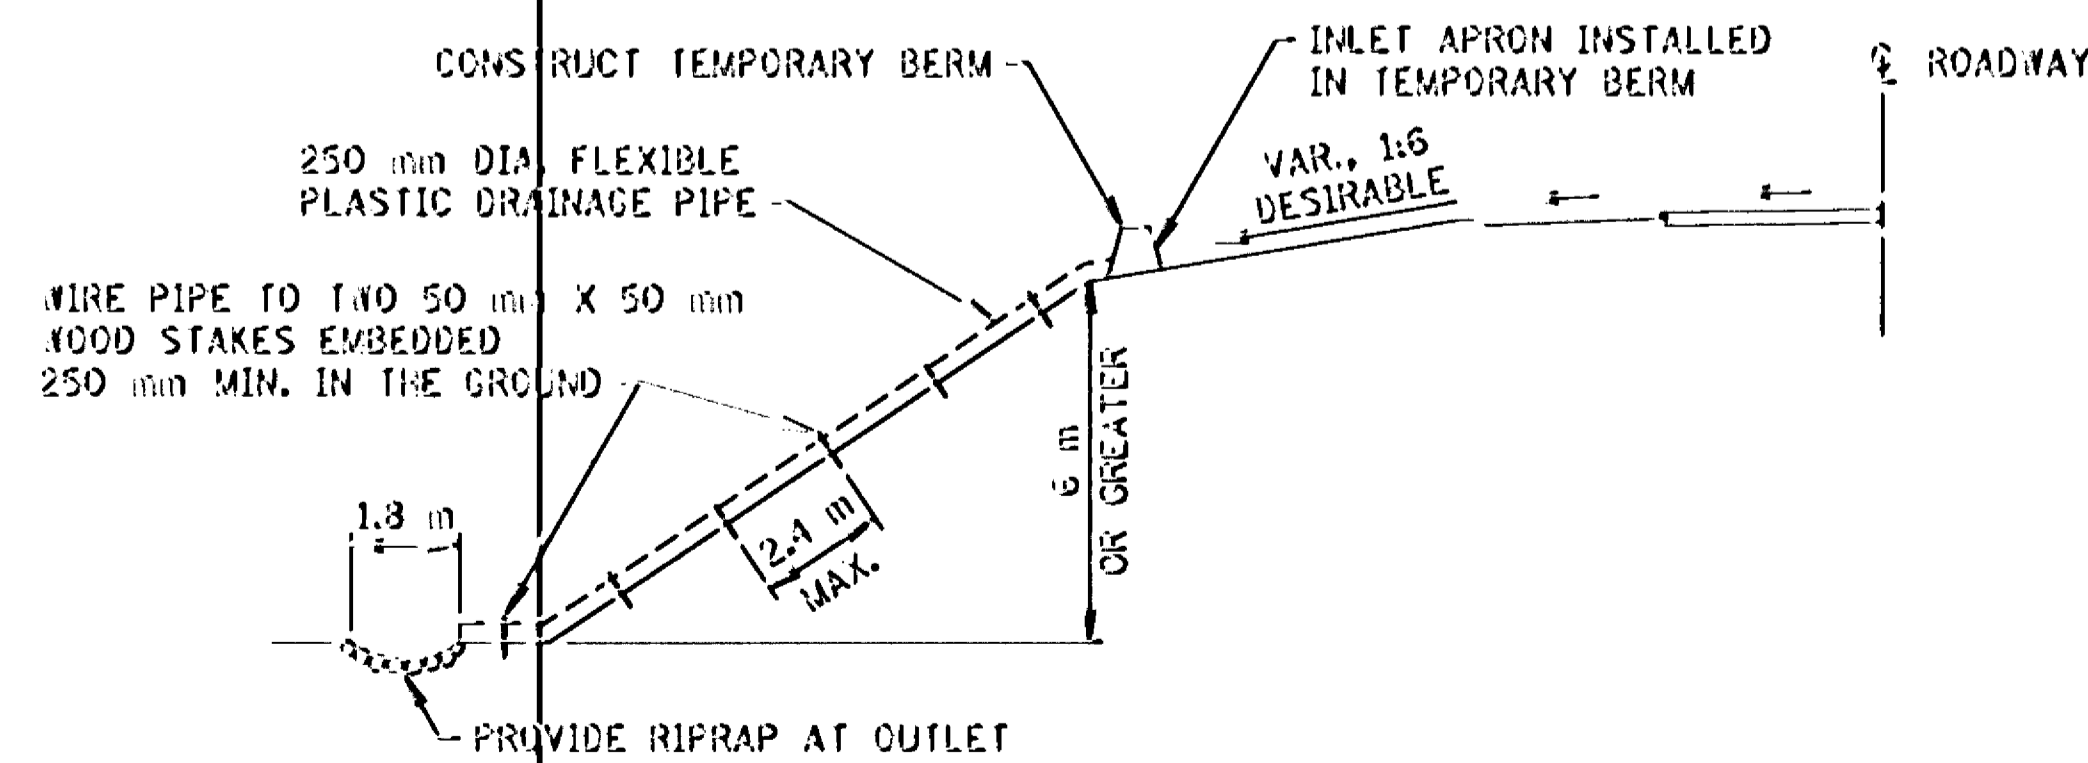

TEMPORARY DRAIN ON FILL SLOPE


DESIGN CRITERIA:
STORM FREQUENCY: 2 YEAR - 24 HOUR
MAXIMUM DRAINAGE AREA: 1.2 ha

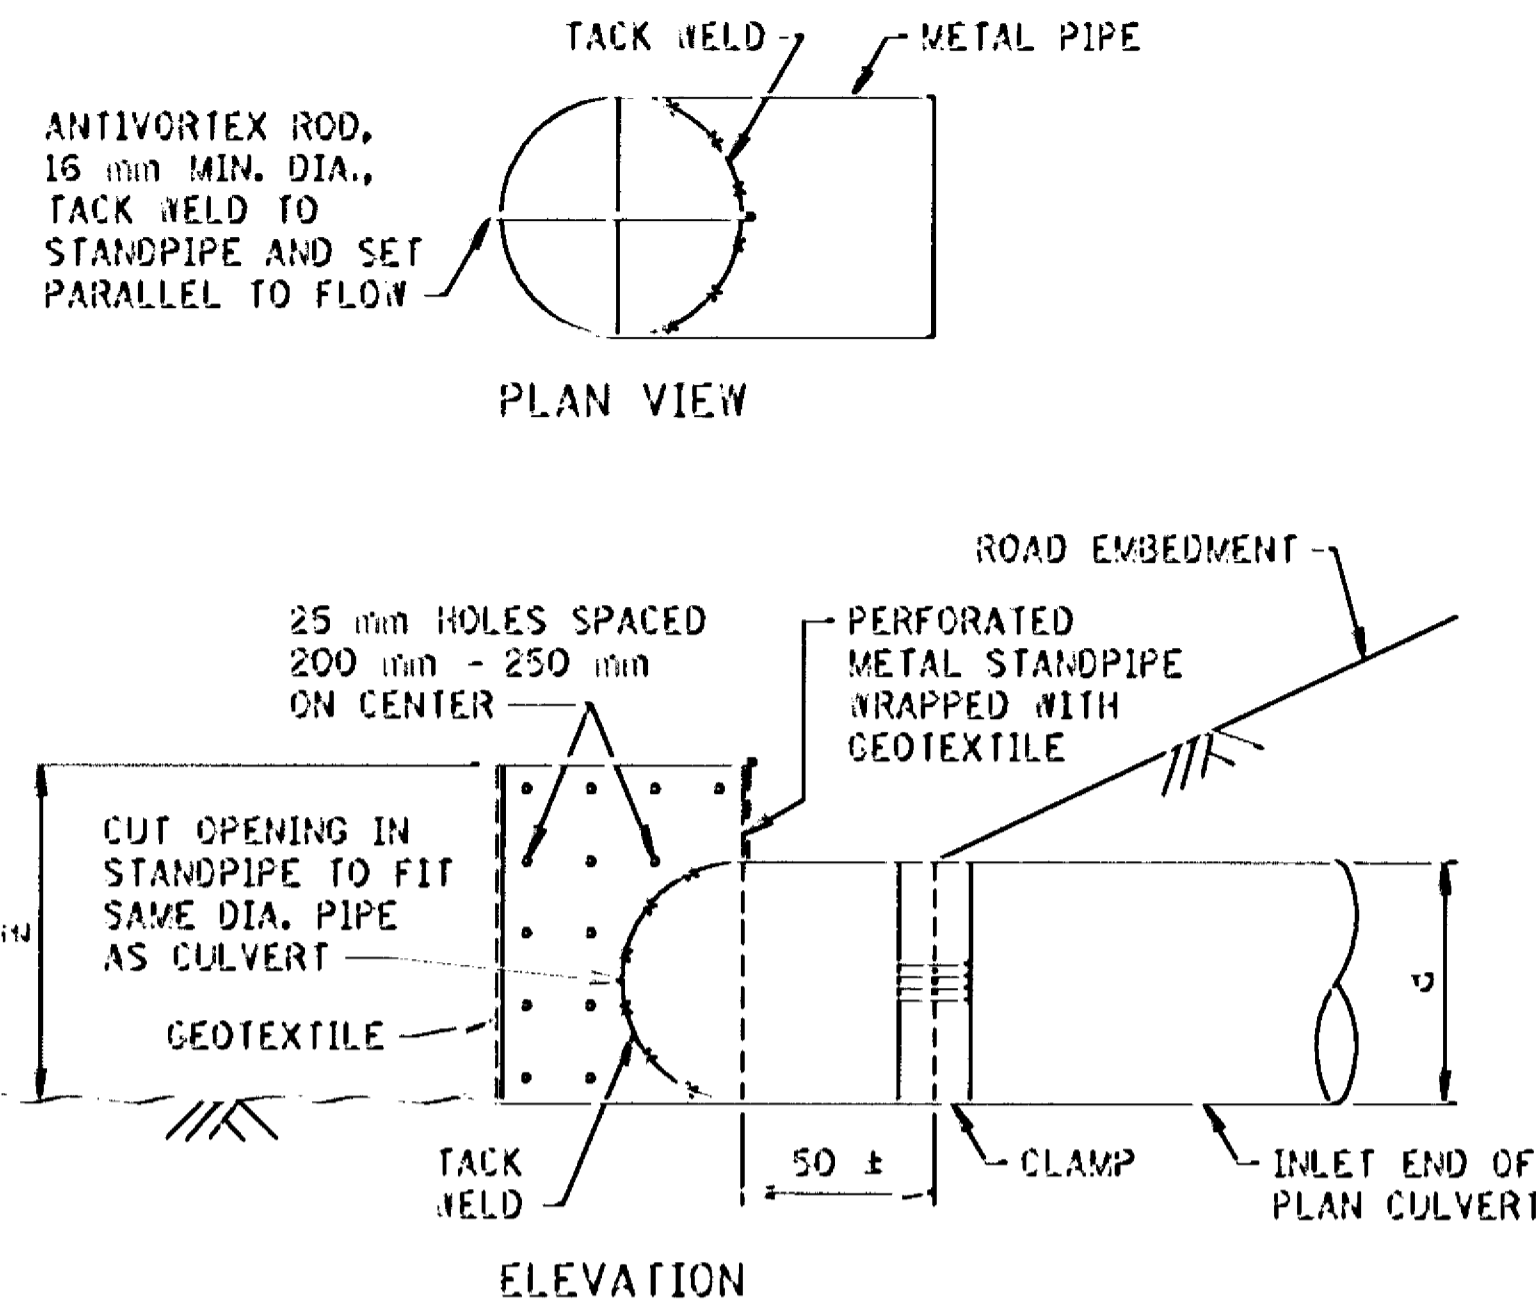


TEMPORARY STANDPIPE
FOR SEDIMENT CONTROL ON CULVERT INLET

d = DIA. OF STANDPIPE EQUAL TO DIA. OF PLAN CULVERT
Z = LENGTH OF PERFORATED STANDPIPE (d + 300 mm)


DESIGN CRITERIA:
CULVERT SIZE: 300 - 300 mm
STORM FREQUENCY: 10 YR. - 24 HR.

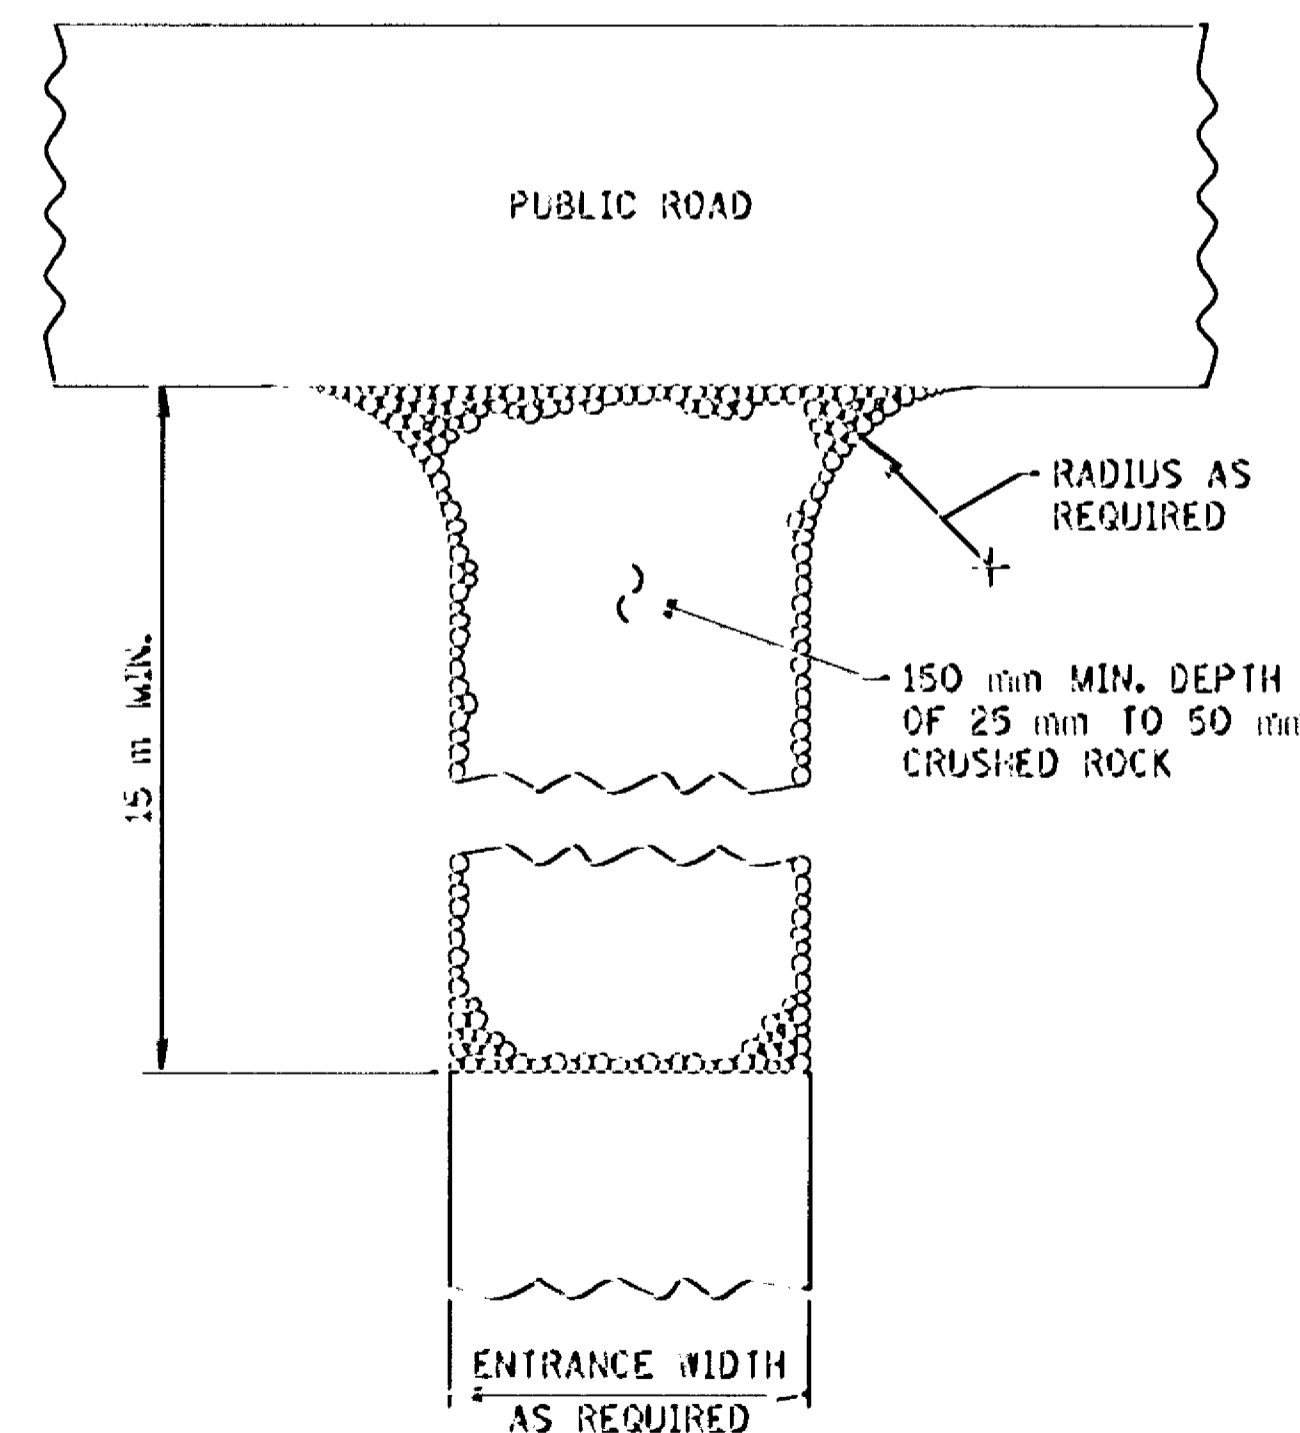


ROCK CONSTRUCTION ENTRANCE

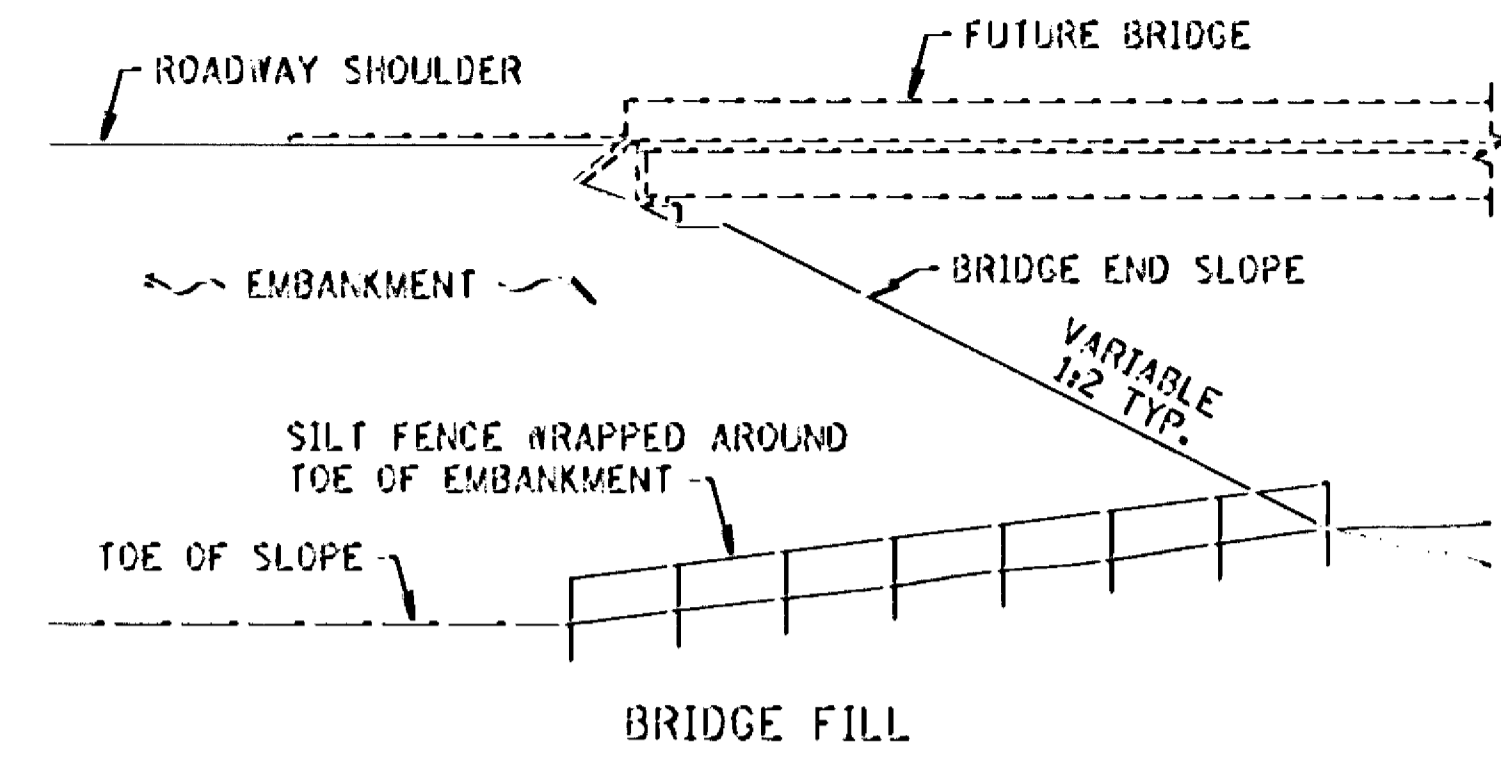

DESIGN CRITERIA:
WATER COURSE FLOW VELOCITY: STAGNANT
CONTRIBUTING SLOPE AREA: 0.2 ha

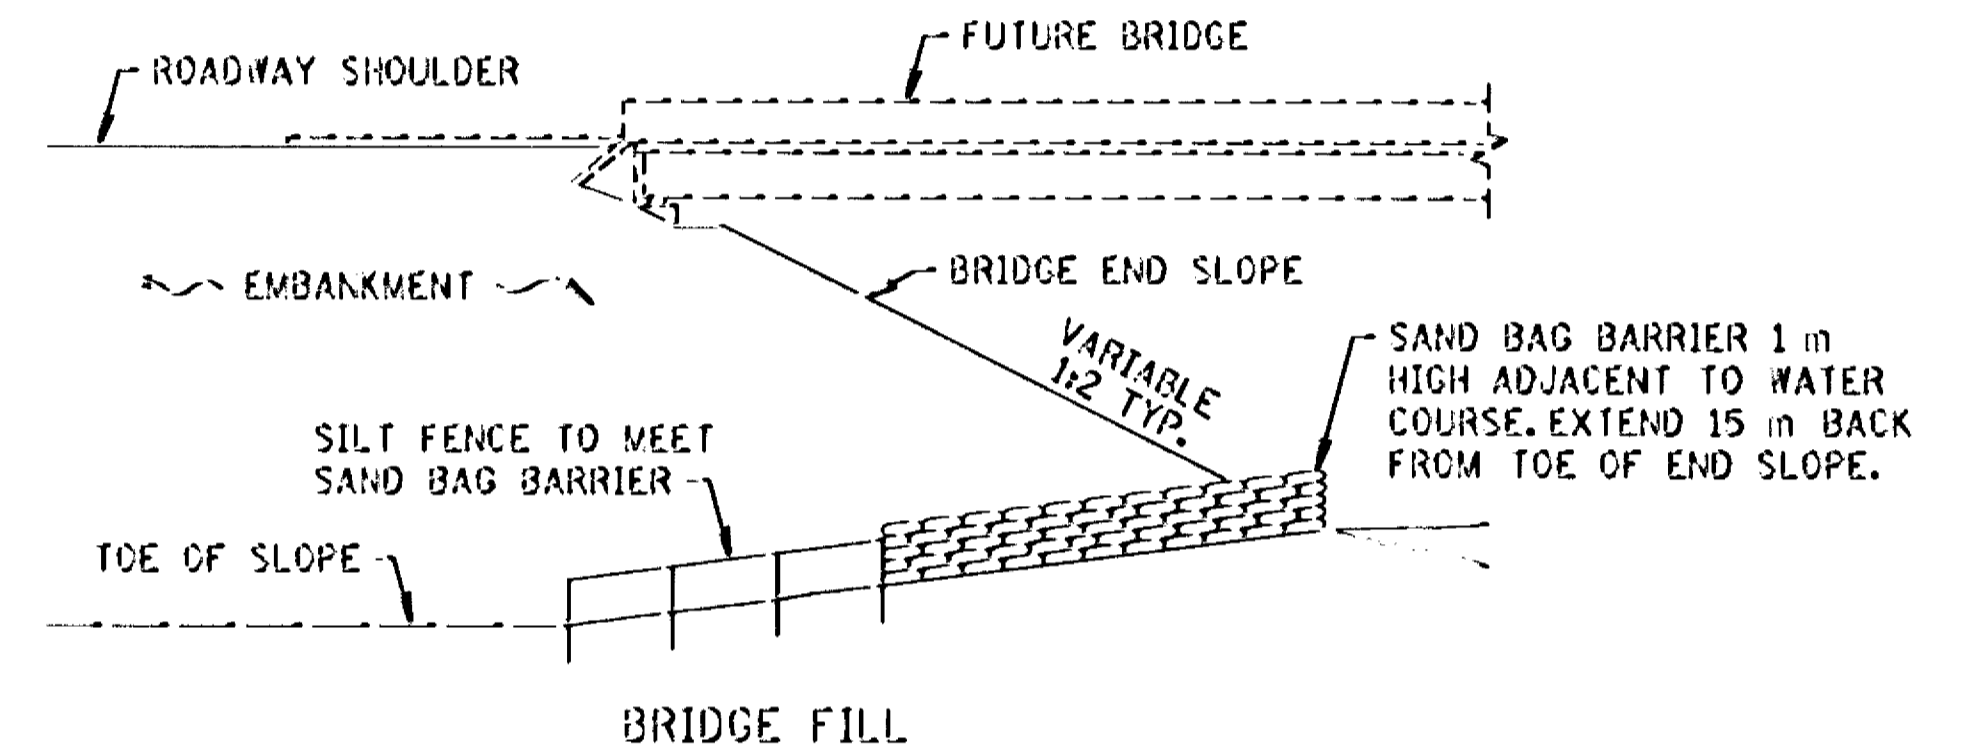

DESIGN CRITERIA:
MAX. WATER COURSE FLOW VELOCITY: 2 m/SEC.
CONTRIBUTING SLOPE AREA: 0.4 ha

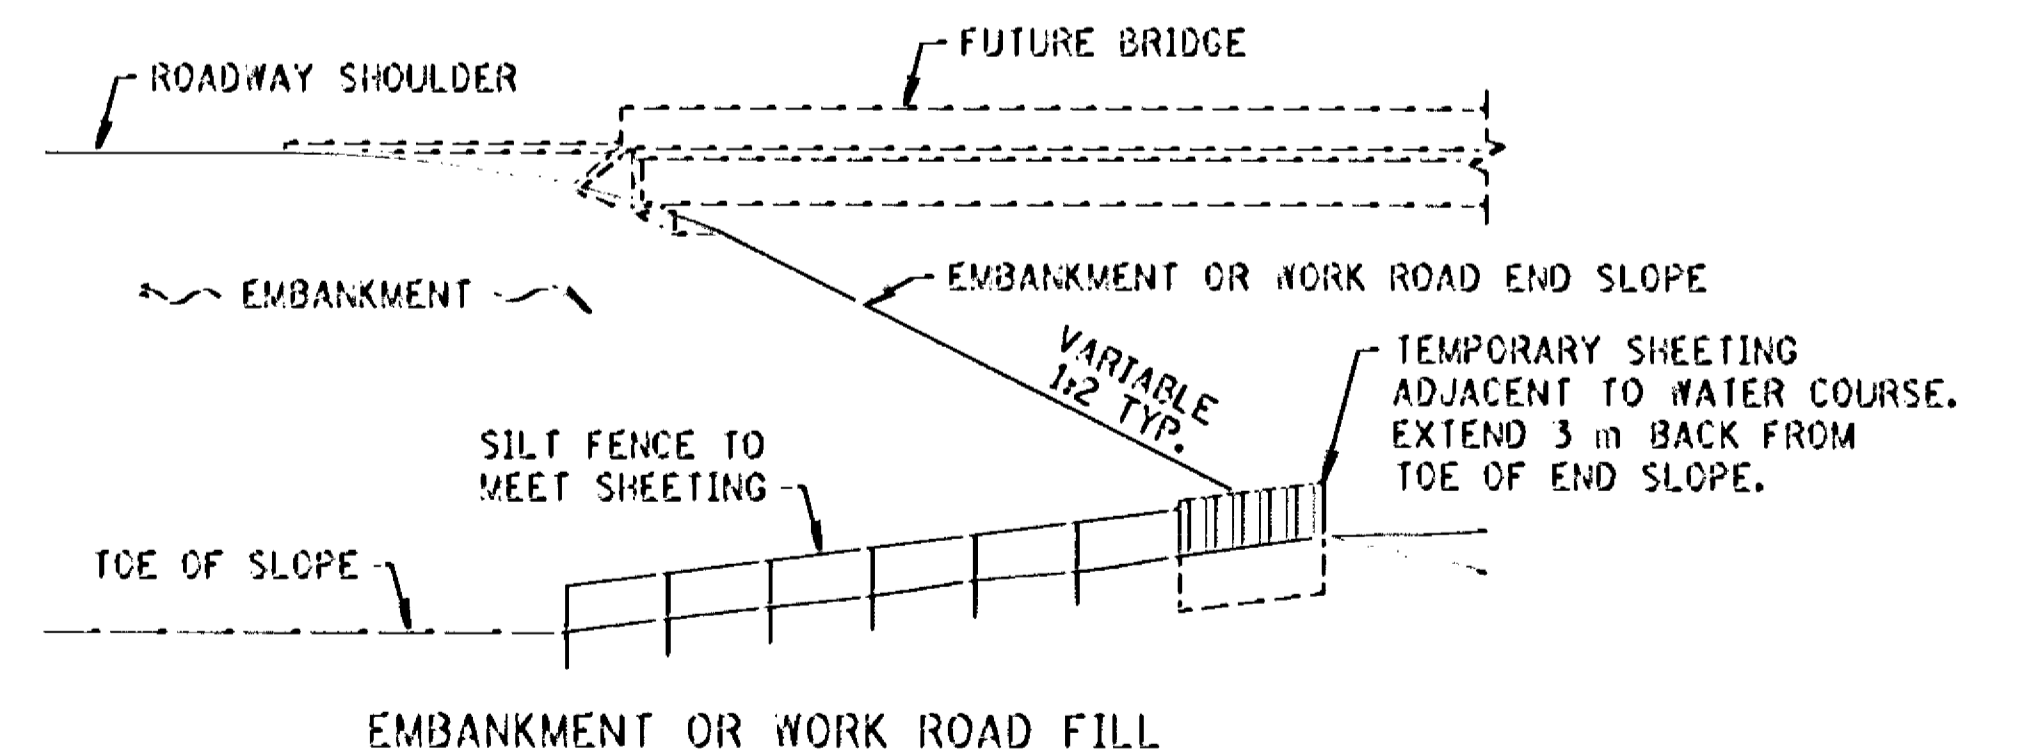

DESIGN CRITERIA:
MAX. WATER COURSE FLOW VELOCITY: 4.5 m/SEC.
CONTRIBUTING SLOPE AREA: 1.2 ha


NOTE: ALL DIMENSIONS ARE IN MILLIMETERS, EXCEPT AS NOTED.

STANDARD SHEET NO.
5-297.405M (3 OF 3)
STANDARD APPROVED:
MAY 1, 1995


TITLE:
TEMPORARY EROSION CONTROL

S.A.P. 02-617-11, et al.


SHEET NO. 157 OF 245 SHEETS

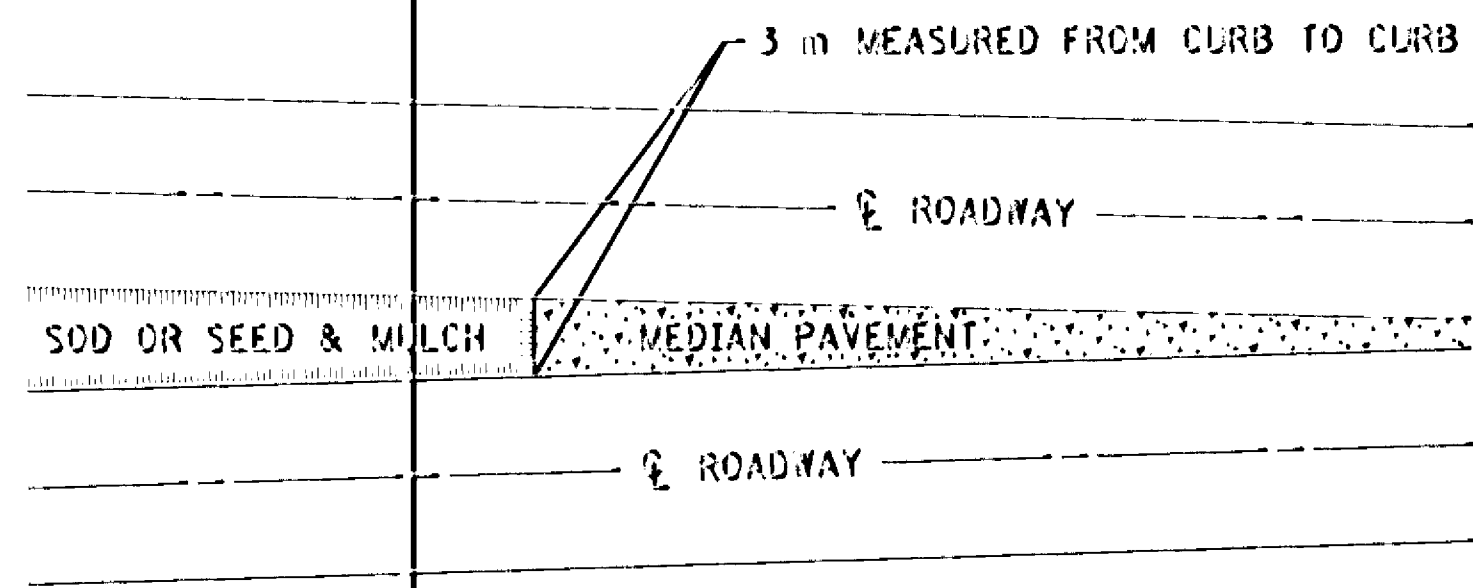

SODDING LIMITS AT GORE AREA

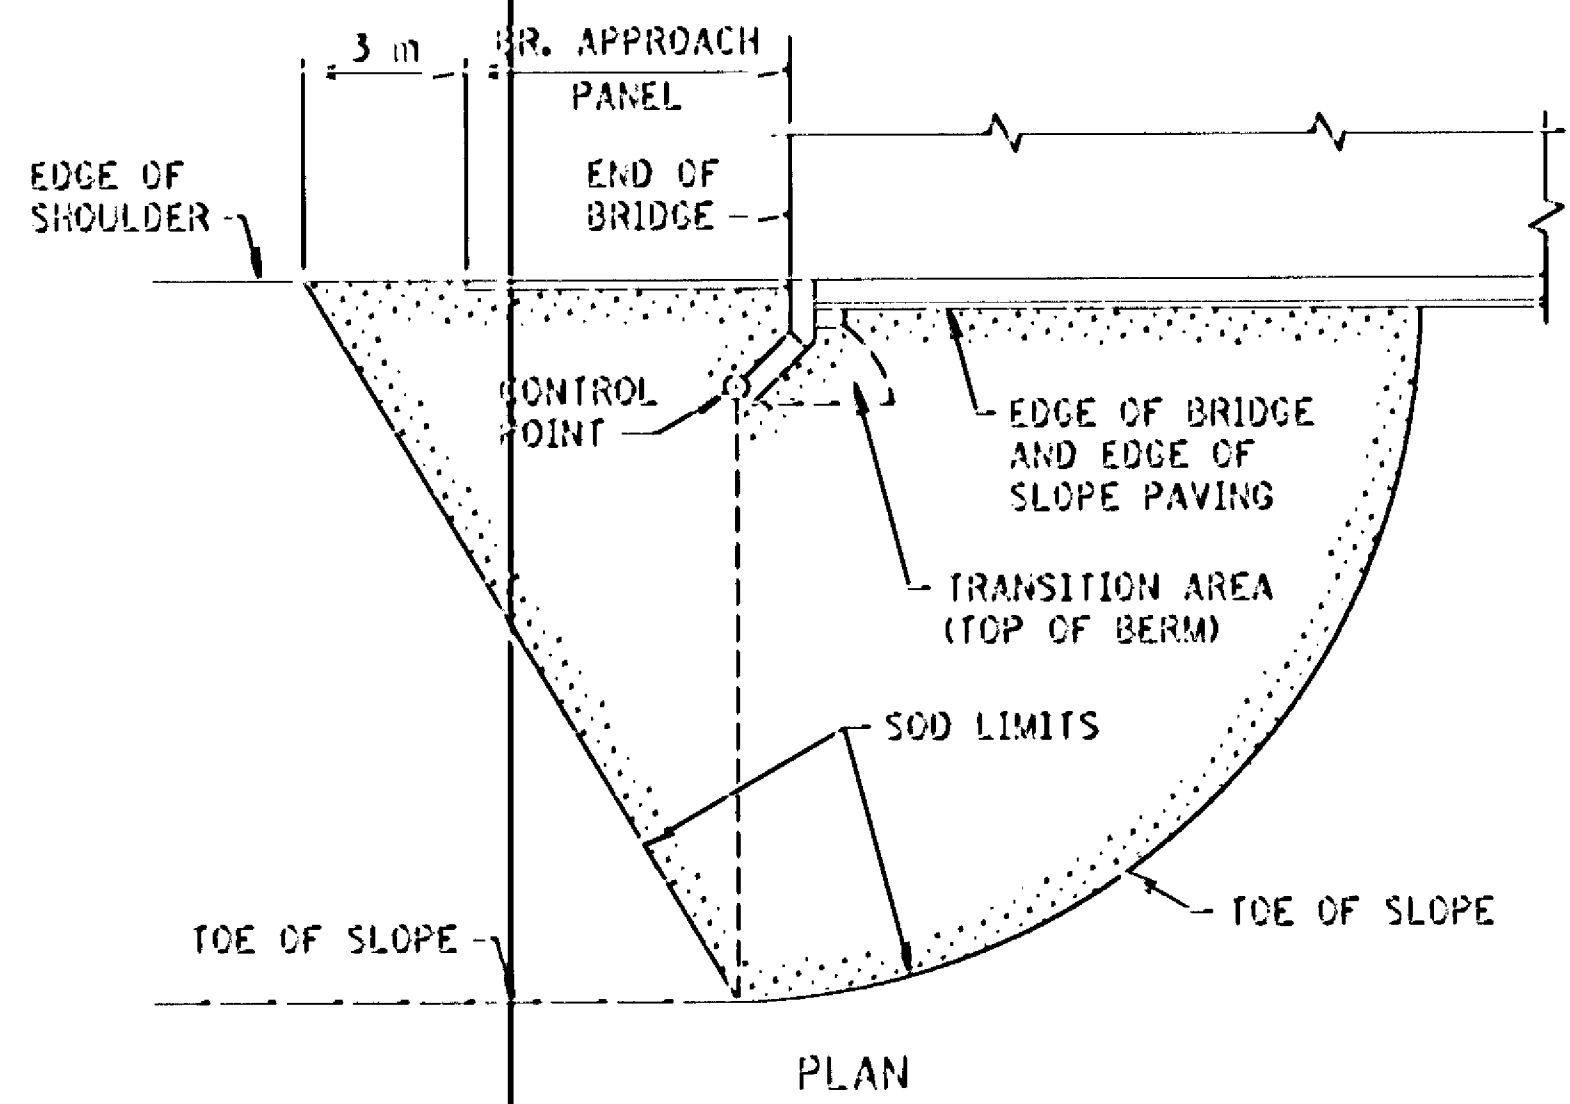


PLAN

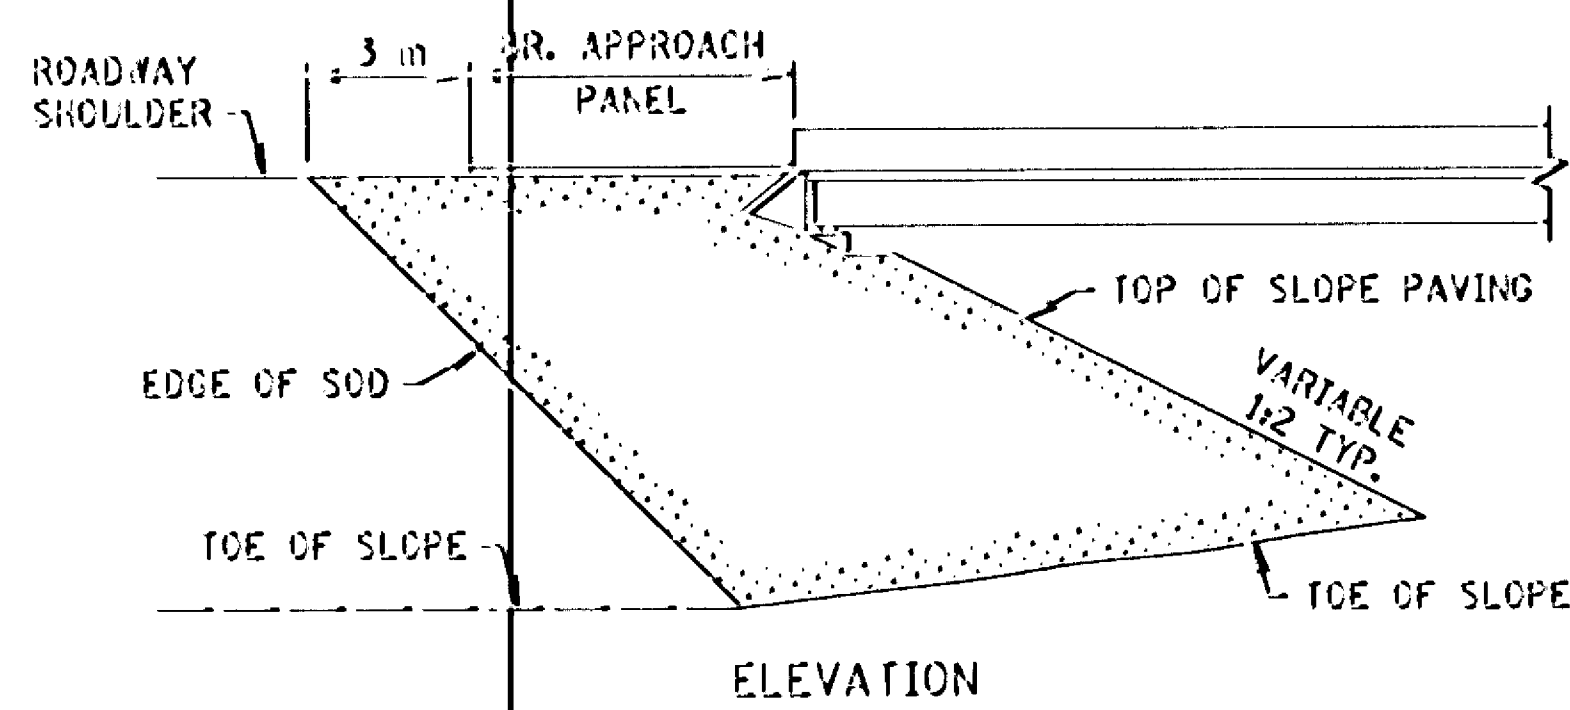


ELEVATION

SODDING LIMITS AT BRIDGE APPROACH FILLS

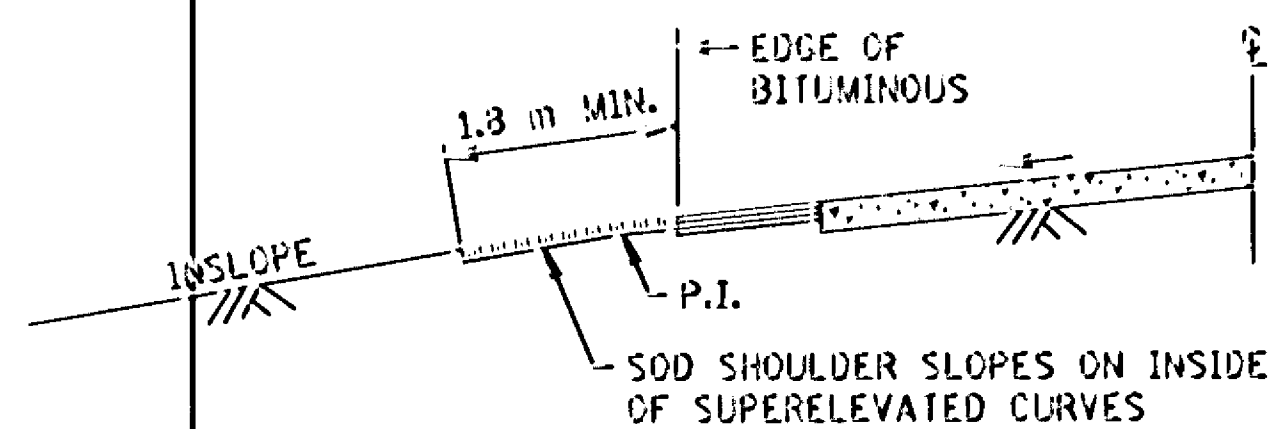


SODDING INSLOPES OF SUPERELEVATED CURVES

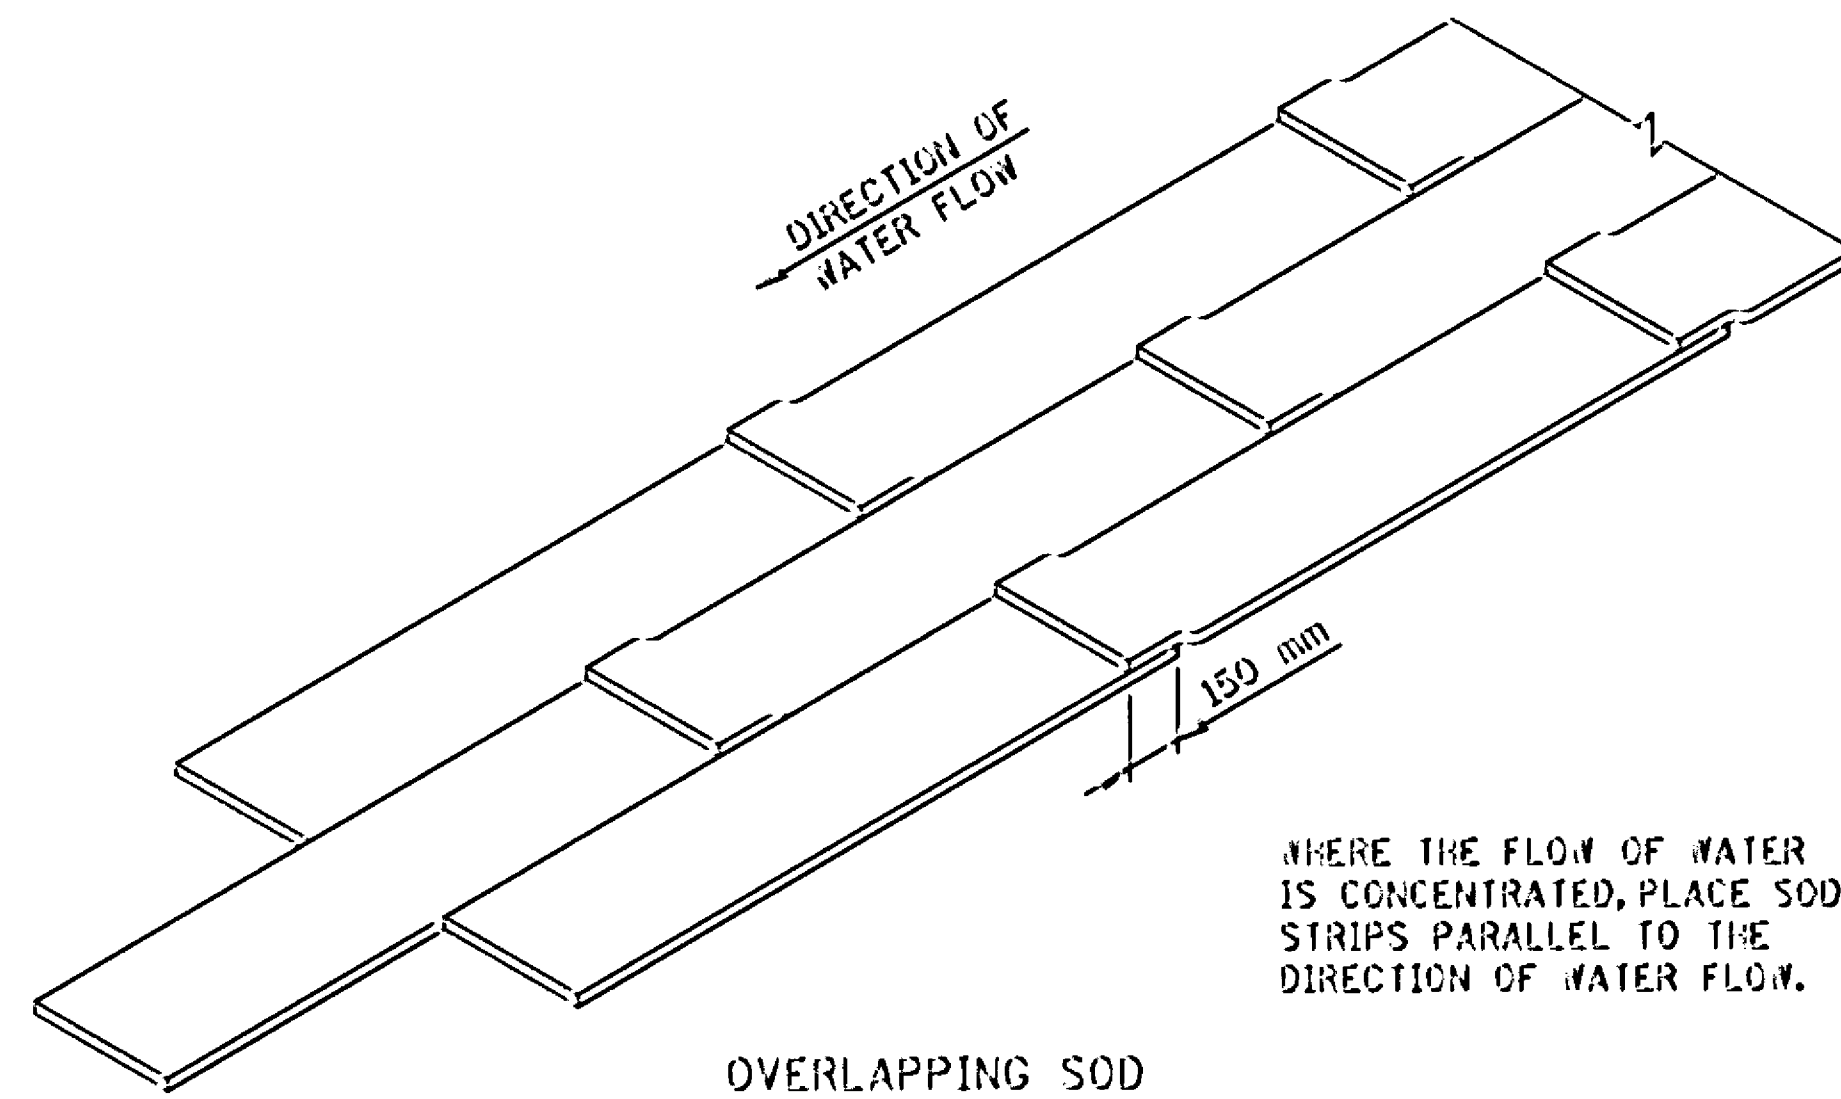

OVERLAPPING SOD


WHERE THE FLOW OF WATER IS CONCENTRATED, PLACE SOD STRIPS PARALLEL TO THE DIRECTION OF WATER FLOW.

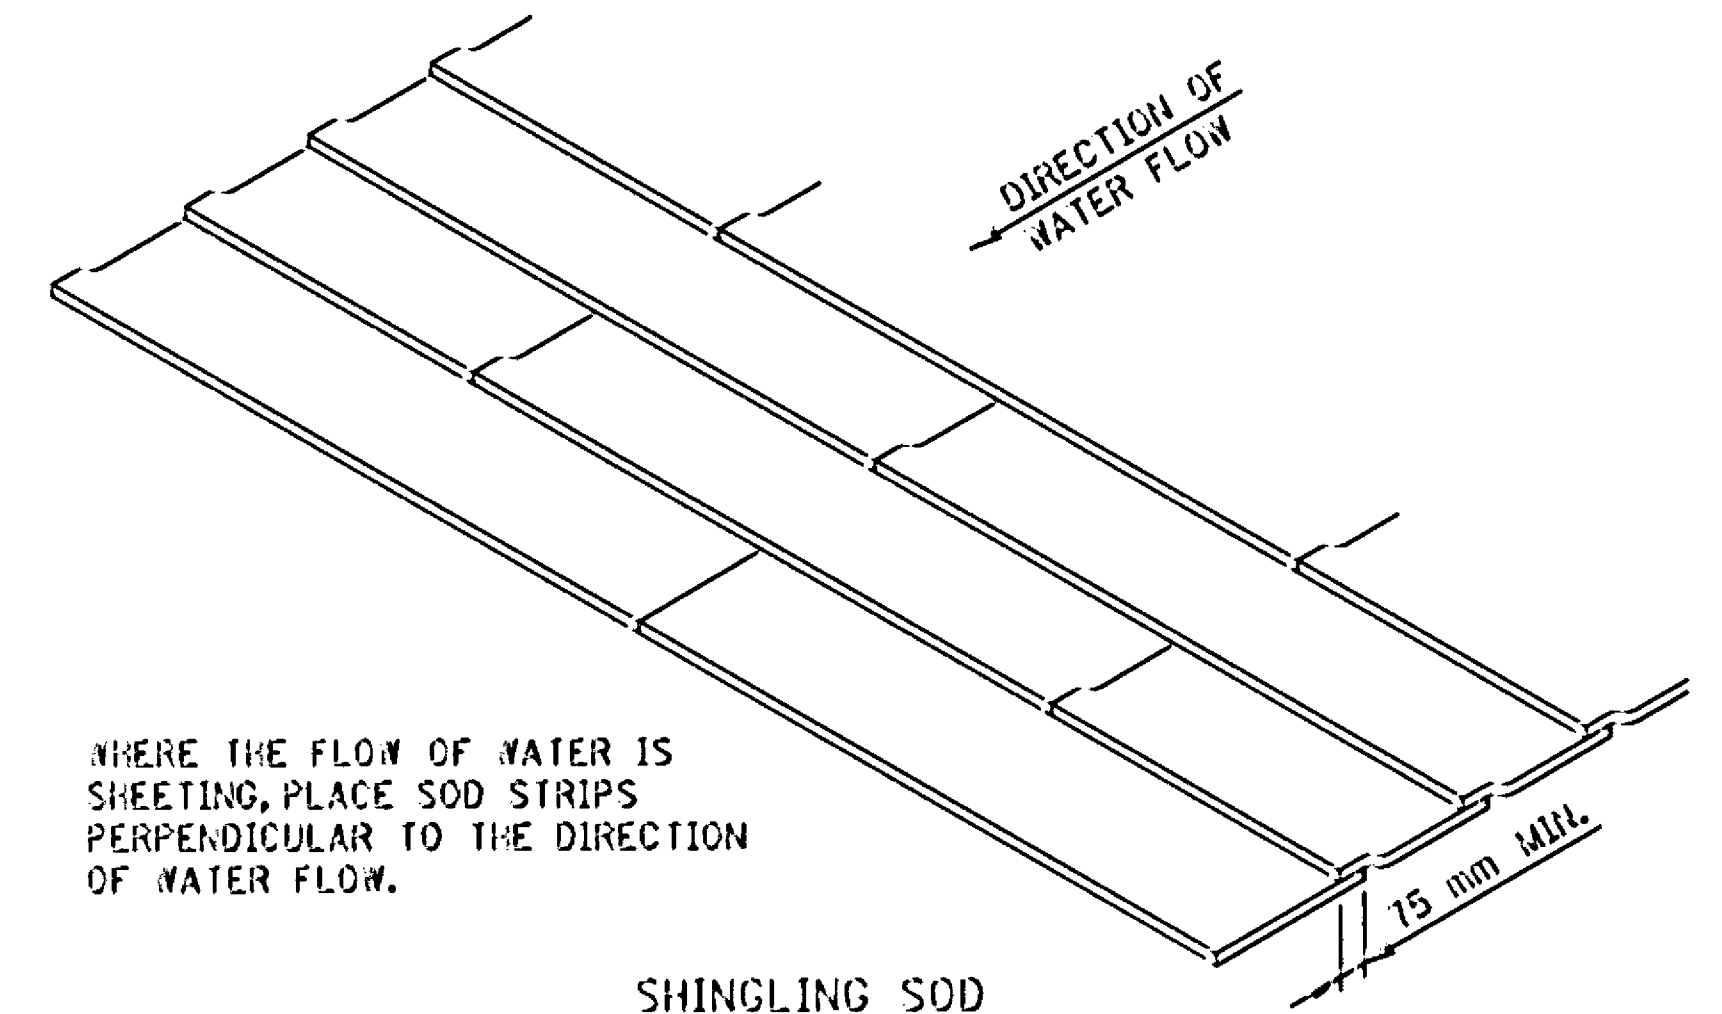


SHINGLING SOD

WHERE THE FLOW OF WATER IS SHEETING, PLACE SOD STRIPS PERPENDICULAR TO THE DIRECTION OF WATER FLOW.


SPECIAL SOD PLACEMENT TECHNIQUES

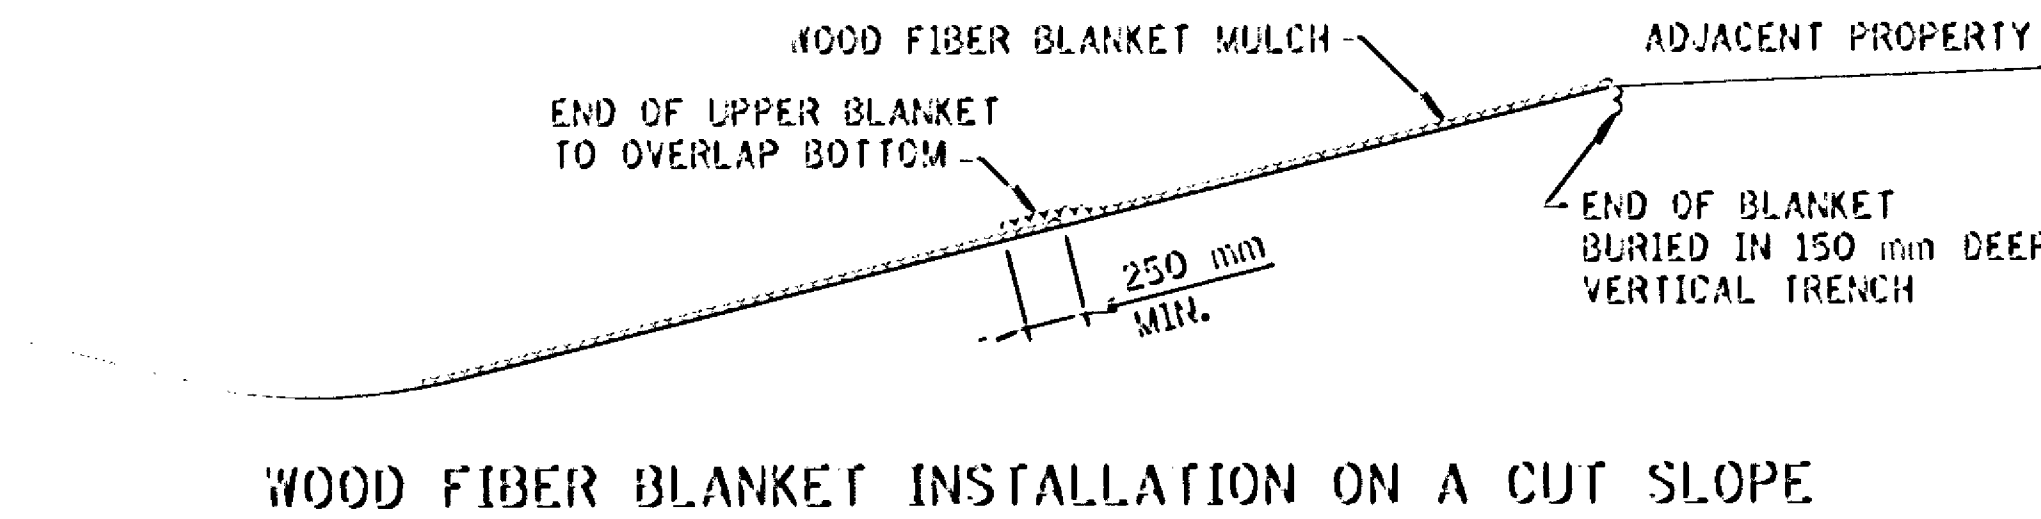


WOOD FIBER BLANKET INSTALLATION ON A CUT SLOPE

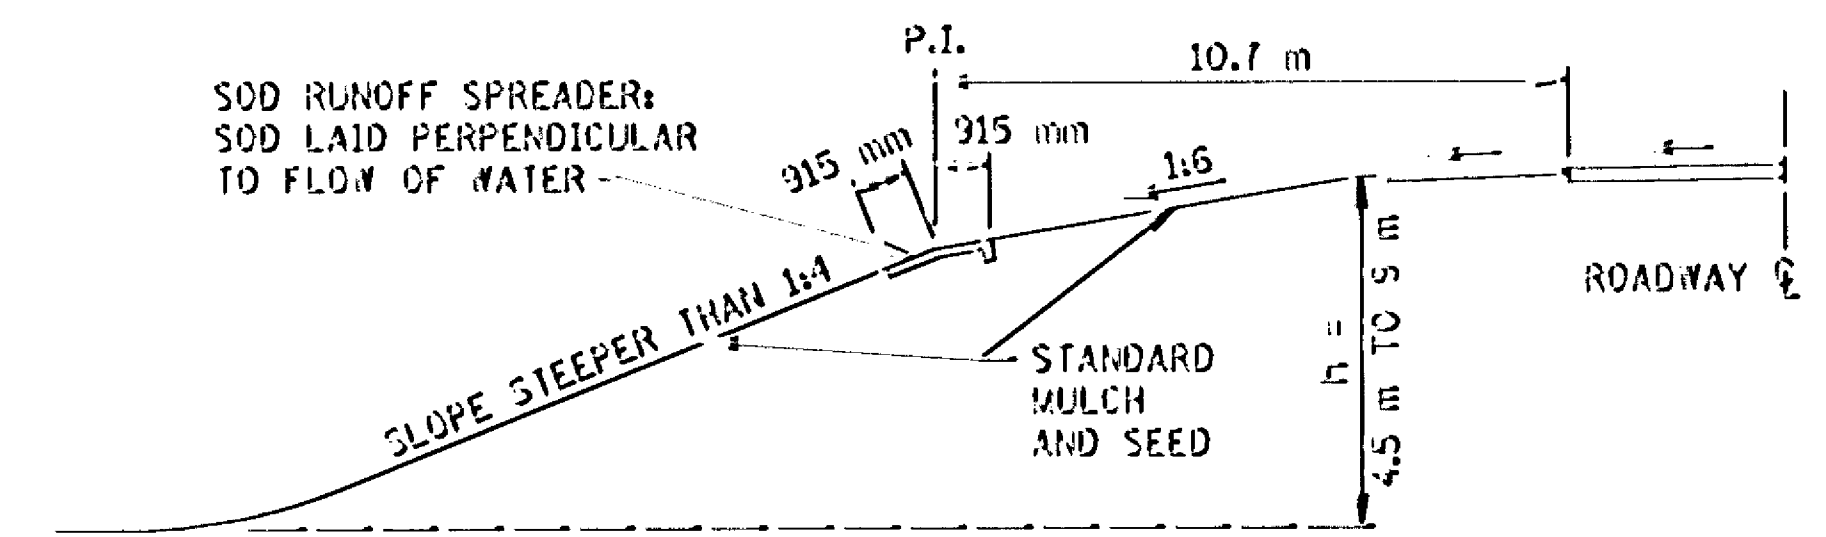

BROKEN-BACK SAFETY FILL SLOPE

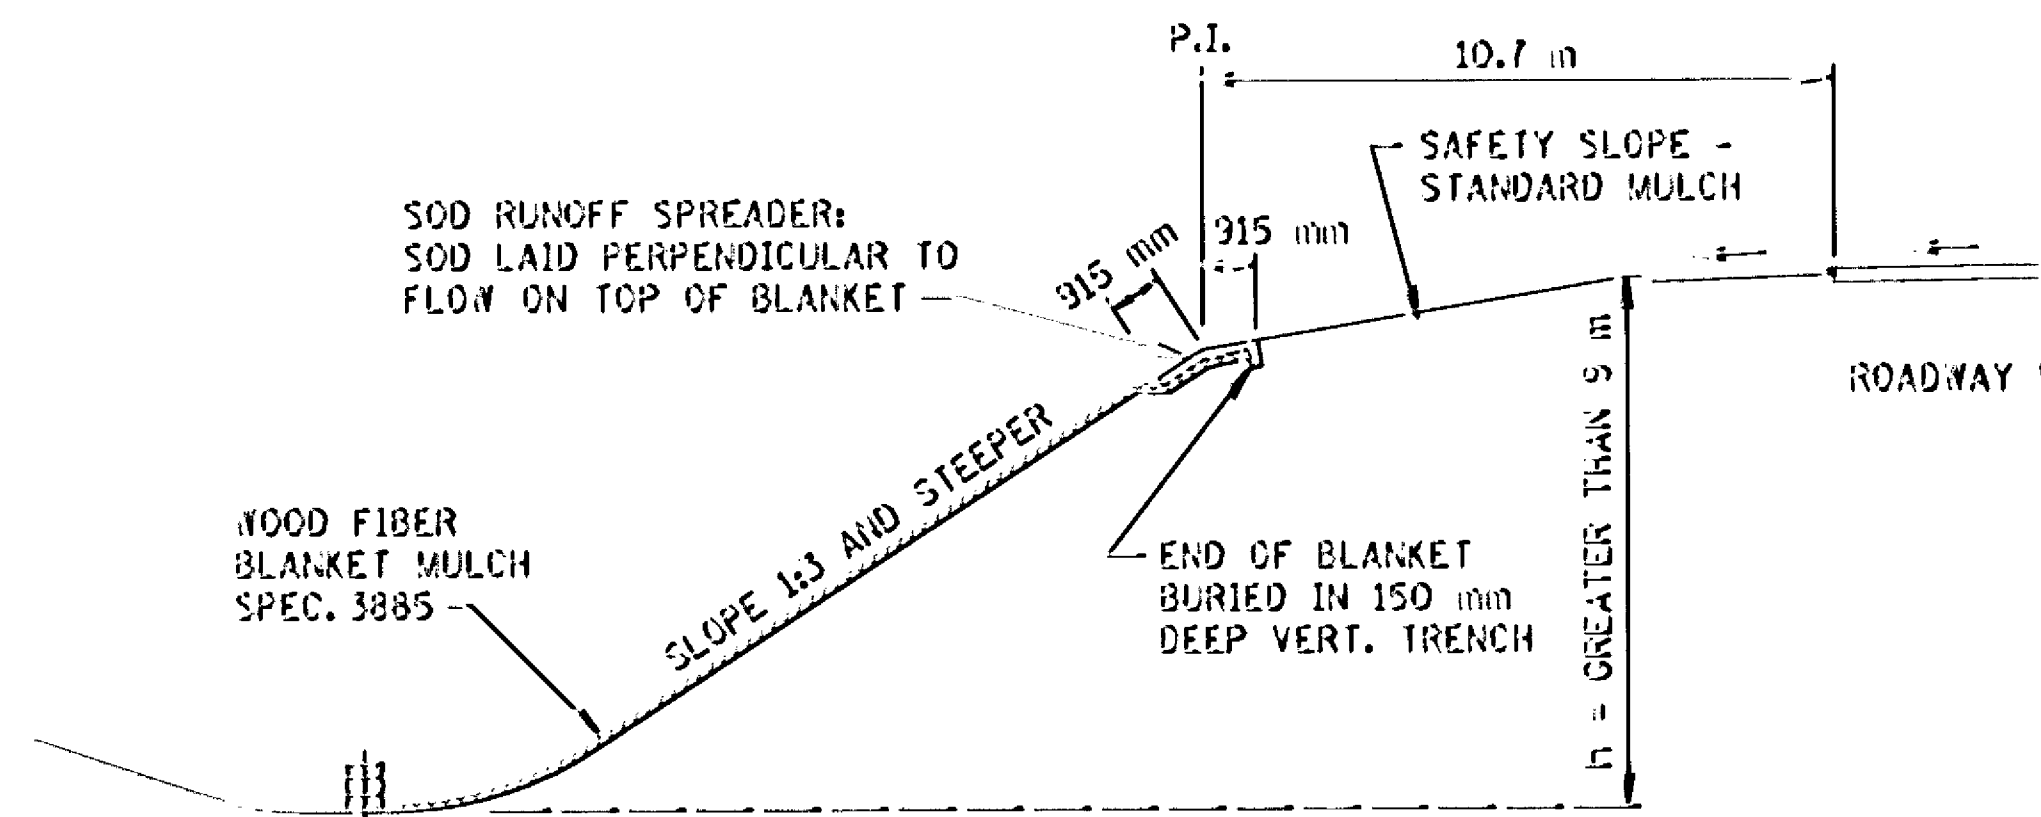


WOOD FIBER BLANKET INSTALLATION ON AN INSLOPE (WHEN REQUIRED)

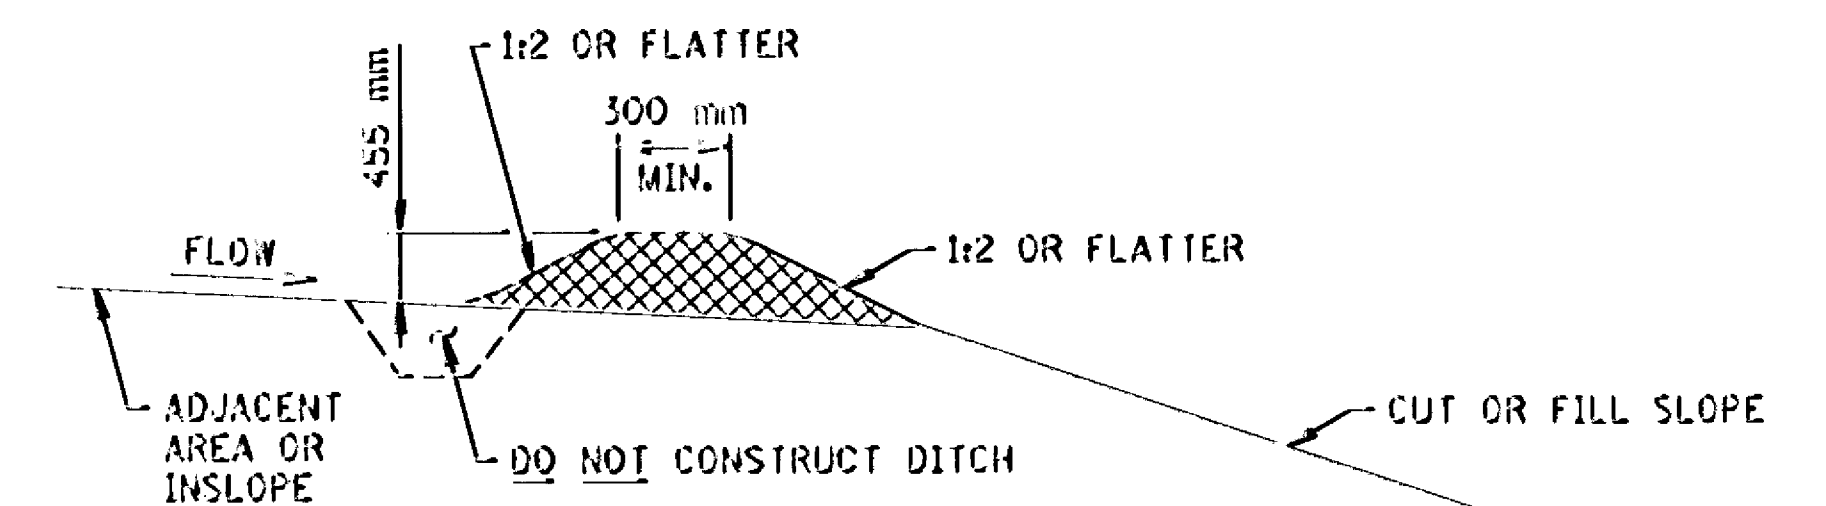

PERMANENT SLOPE PROTECTION DIKE

STANDARD SHEET NO. 5-297.406M	TITLE: PERMANENT EROSION CONTROL ALONG ROADWAYS AND AT GORE AREAS & BRIDGE APPROACH FILLS
STANDARD APPROVED: JANUARY 31, 1985	
4-27-95	S.A.P. 02-617-11, et al.
	SHEET NO. 158 OF 245 SHEETS

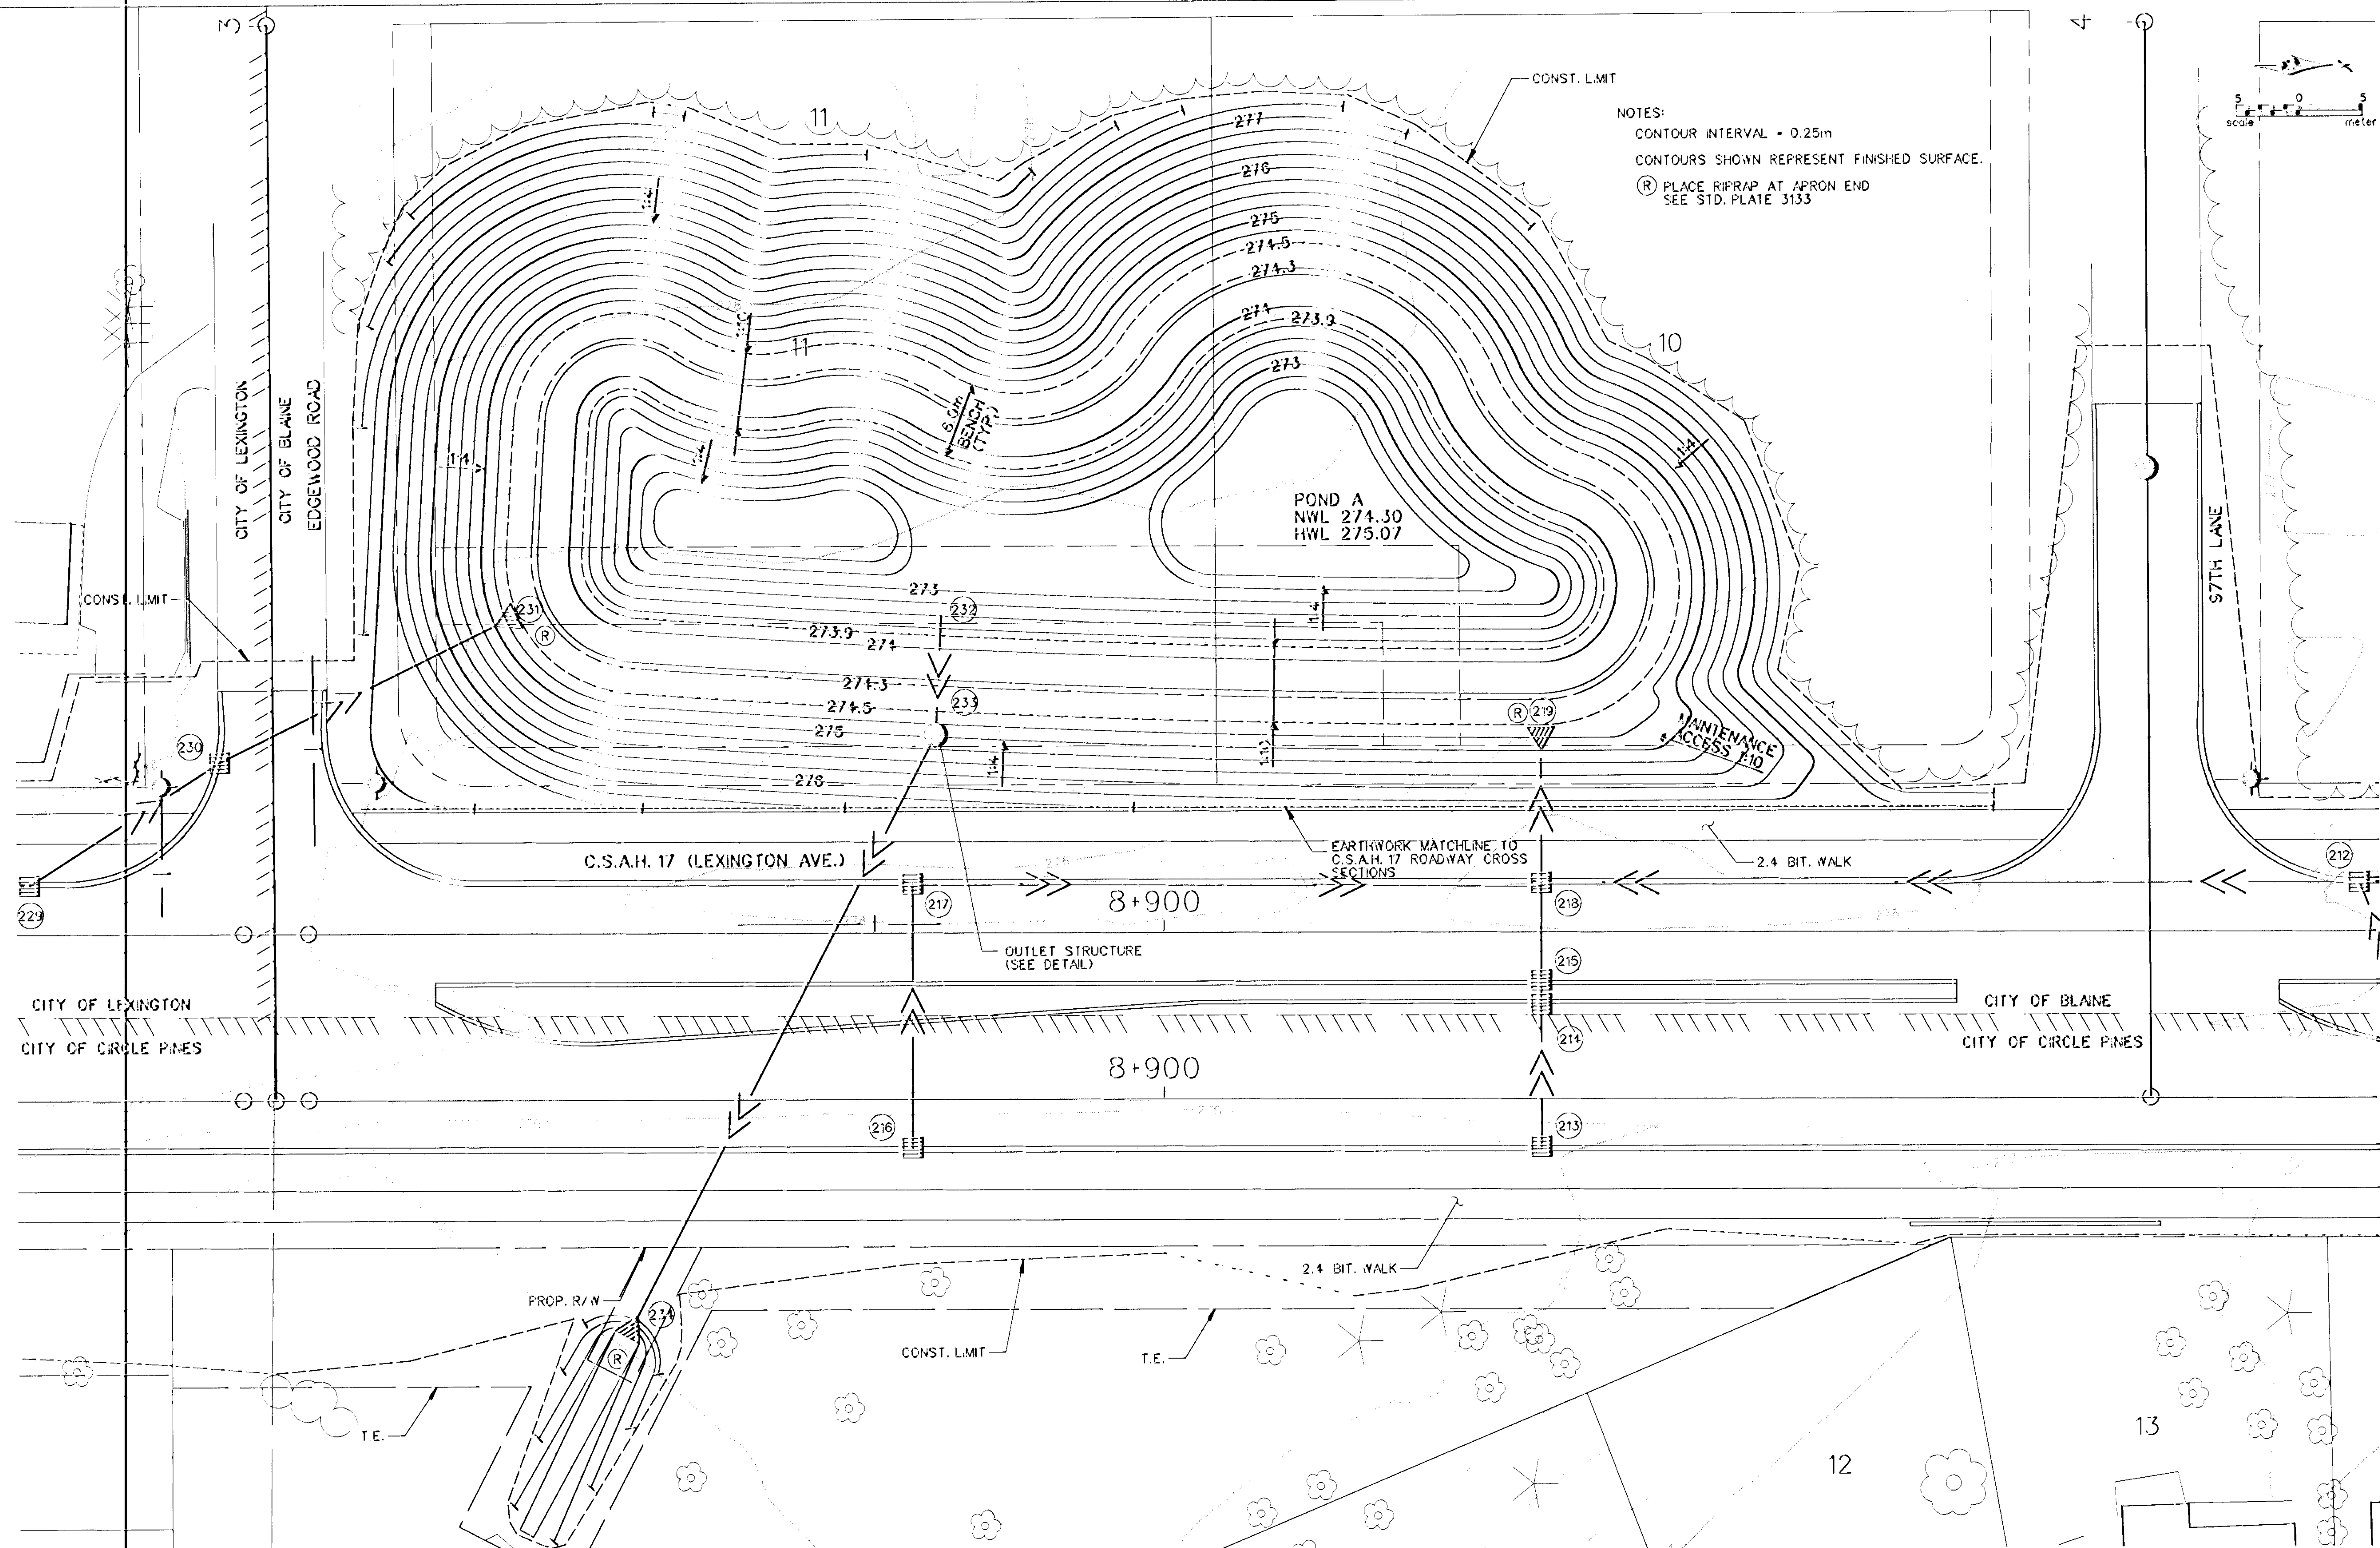

NOTES:
 CONTOUR INTERVAL = 0.25m
 CONTOURS SHOWN REPRESENT FINISHED SURFACE.
 (R) PLACE RIPRAP AT APRON END
 SEE STD. PLATE 3133

1	3-26-97	MCI	DAD	ADD R NOTE AT 234
NO	DATE	BY	CHKD	APPR
NAME: MCP1 410.PLN	DA	E: Mar. 17, 1997		

I hereby certify that this plan, specification or report was prepared by me or under my direct supervision and that I am a duly Registered Professional Engineer under the laws of the State of Minnesota.

Donald A. Demes
 Date 3-21-97 Reg. No. 23397

STATE AID PROJECT NO.
 S.A.P. 02-617-11
 S.A.P. 108-020-12
 S.A.P. 108-030-03
 CO. PROJECT NO.

DRAWN BY DATE
 V. GRAF 12-98
 DESIGNED BY
 L. ROBJENT 12-98
 CHECKED BY
 L. ROBJENT 1-97
 COMM. NO.
 0962410


SRI CONSULTING GROUP, INC.

ANOKA COUNTY
 MISCELLANEOUS GRADING PLAN
 C.S.A.H. 17 RECONSTRUCTION
 POND A

SHEET
 159
 OF
 236




NOTES:
 CONTOUR INTERVAL = 0.25m
 CONTOURS SHOWN REPRESENT FINISHED SURFACE.

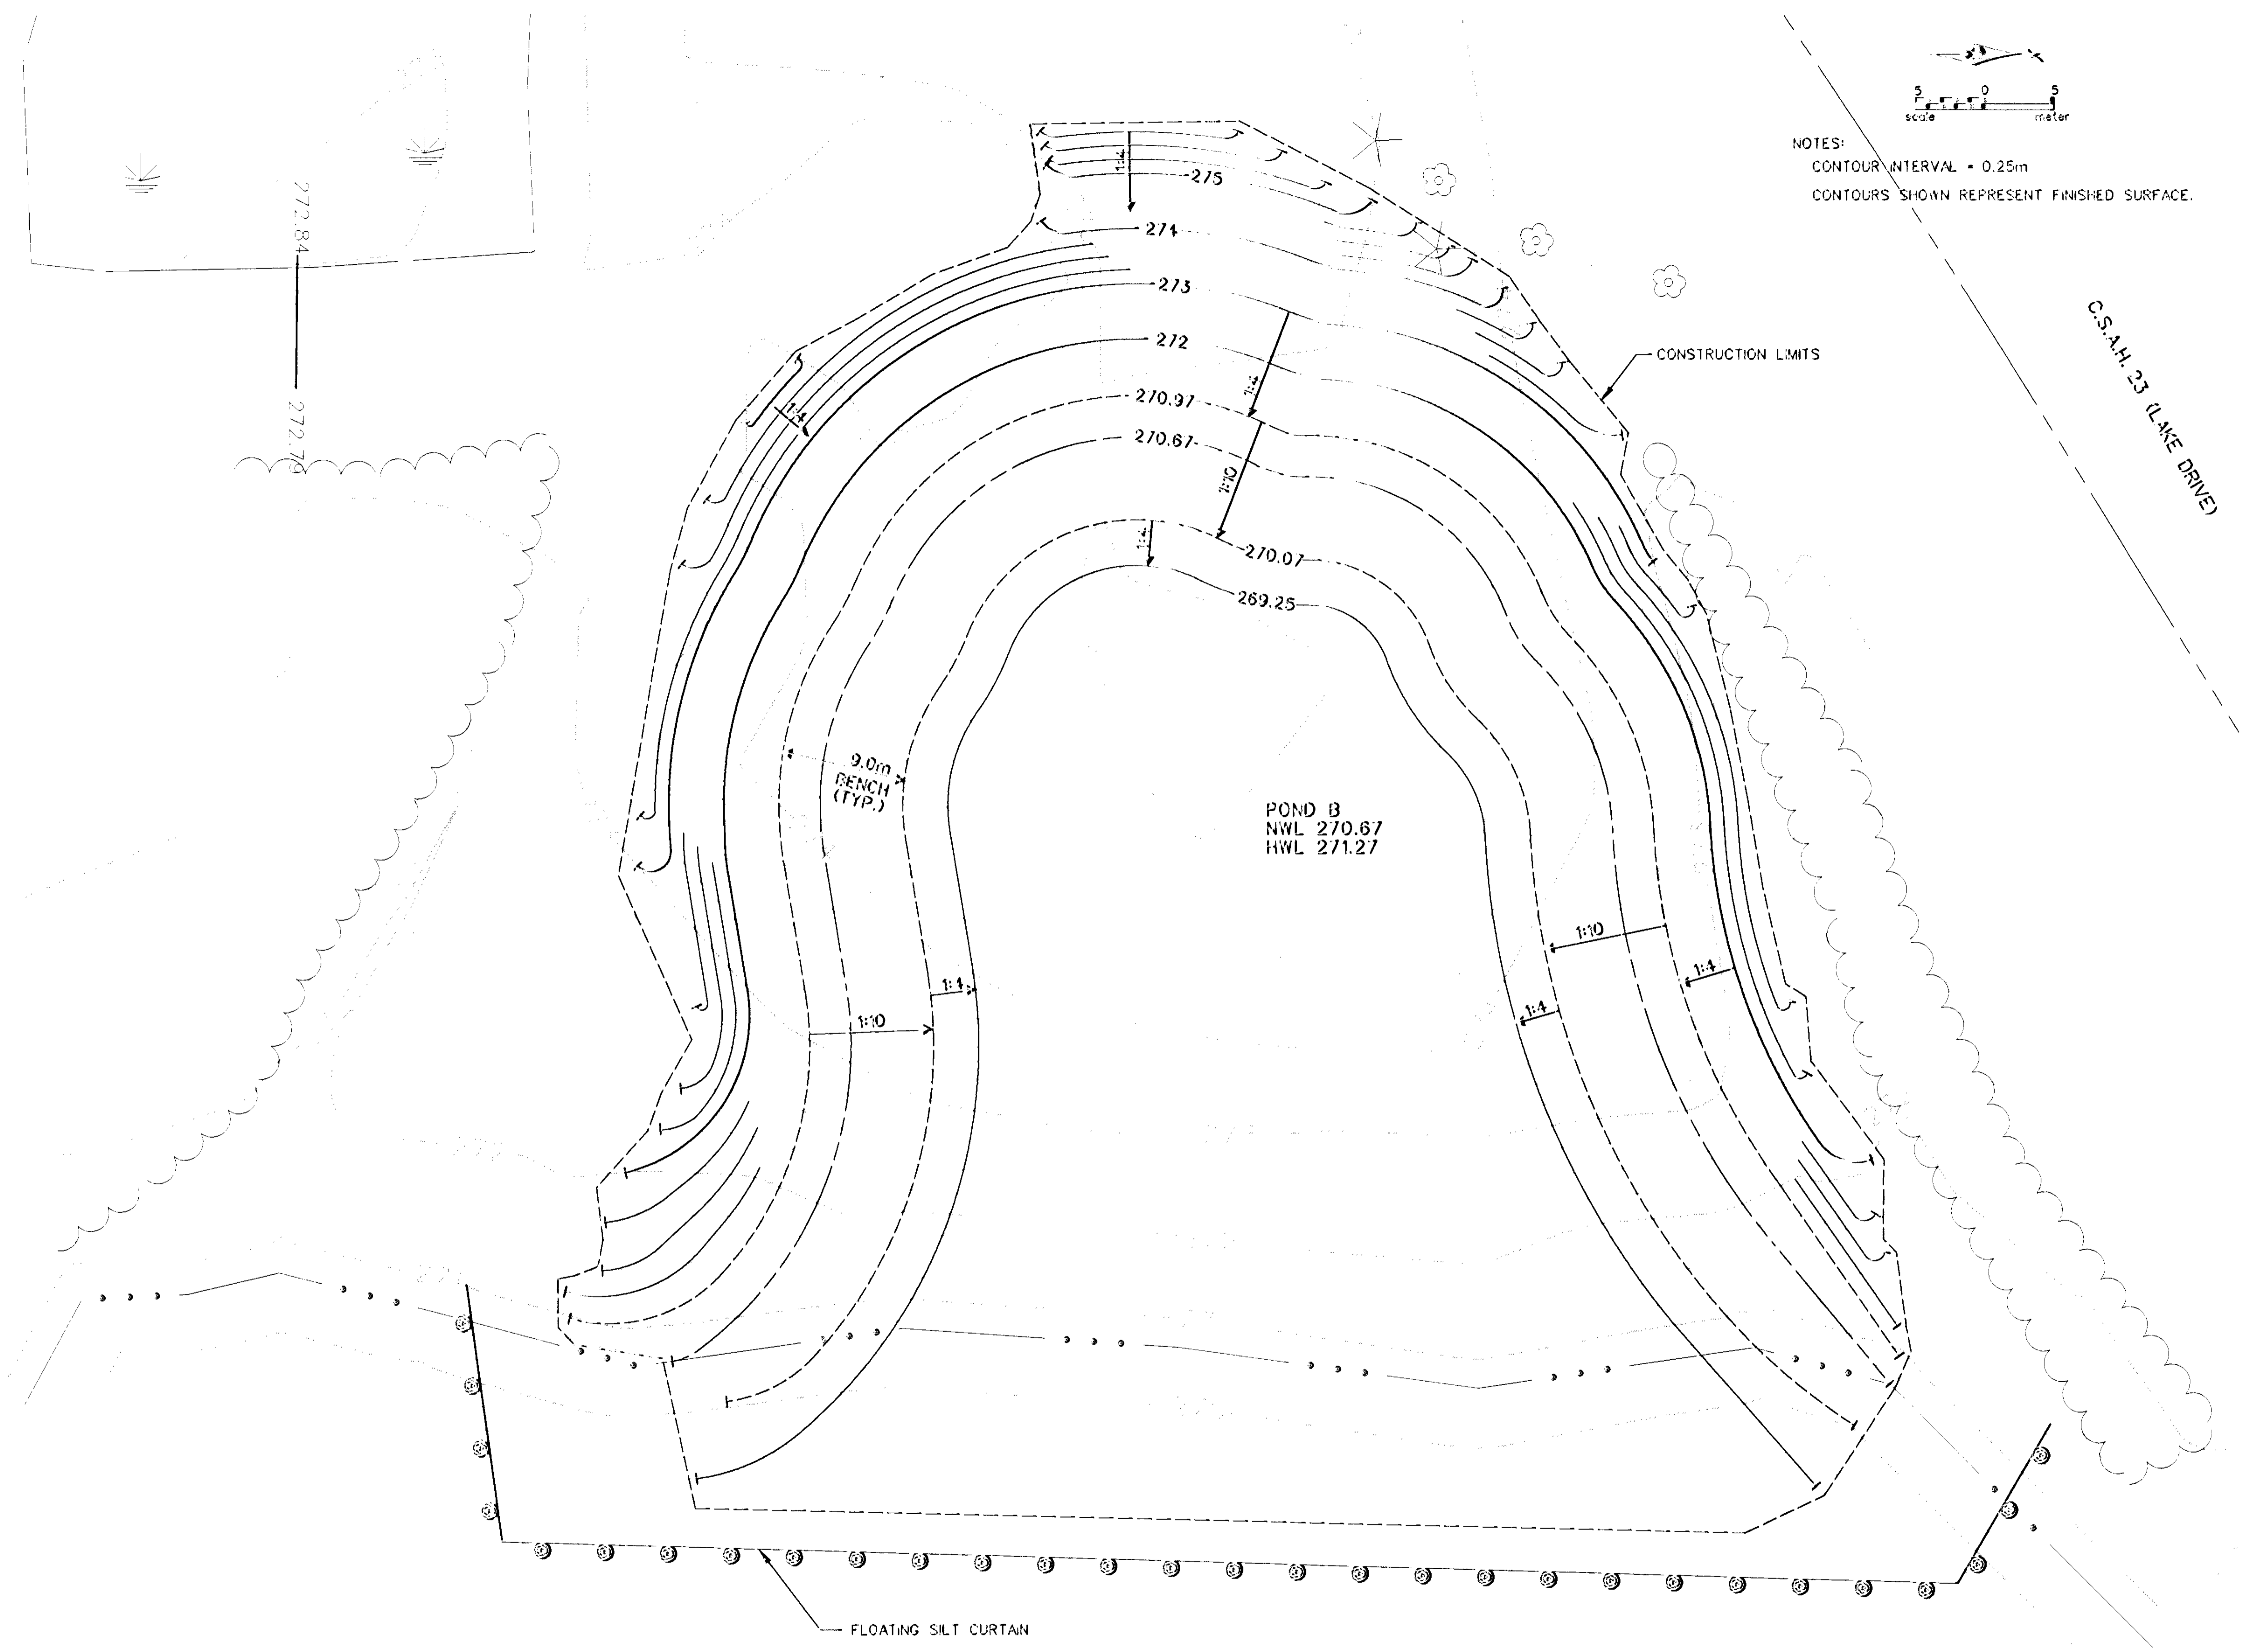

POND B
 NWL 270.67
 HWL 271.27

NO	DATE	BY	CHKD	APPR	REVISION

NAME: MGP2 410.PLN DATE: Mar. 17, 1997

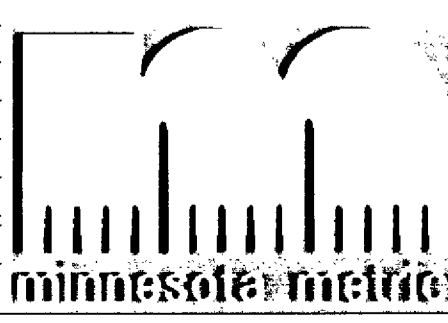


I hereby certify that this plan, specification or report was prepared by me or under my direct supervision and that I am a duly Registered Professional Engineer under the laws of the State of Minnesota.

Signature
 Date: 3-21-97 Reg. No. 25066



STATE AID PROJECT NO.
 S.A.P. 02-617-11
 S.A.P. 106-020-12
 S.A.P. 106-030-03
 CO. PROJECT NO.

DRAWN BY DATE
 M. IISAKKA 12-96
 DESIGNED BY
 L. ROBJENT 12-96
 CHECKED BY
 L. ROBJENT 1-97
 COMM. NO.
 0362410

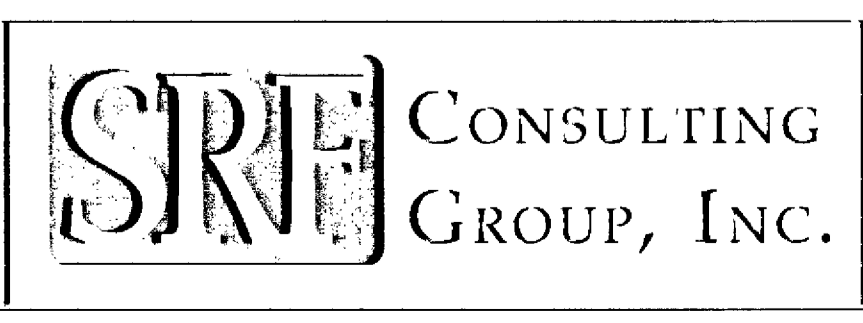

ANOKA COUNTY
 MISCELLANEOUS GRADING PLAN
 C.S.A.H. 17 RECONSTRUCTION
 POND B

SHEET
 160
 OF
 236

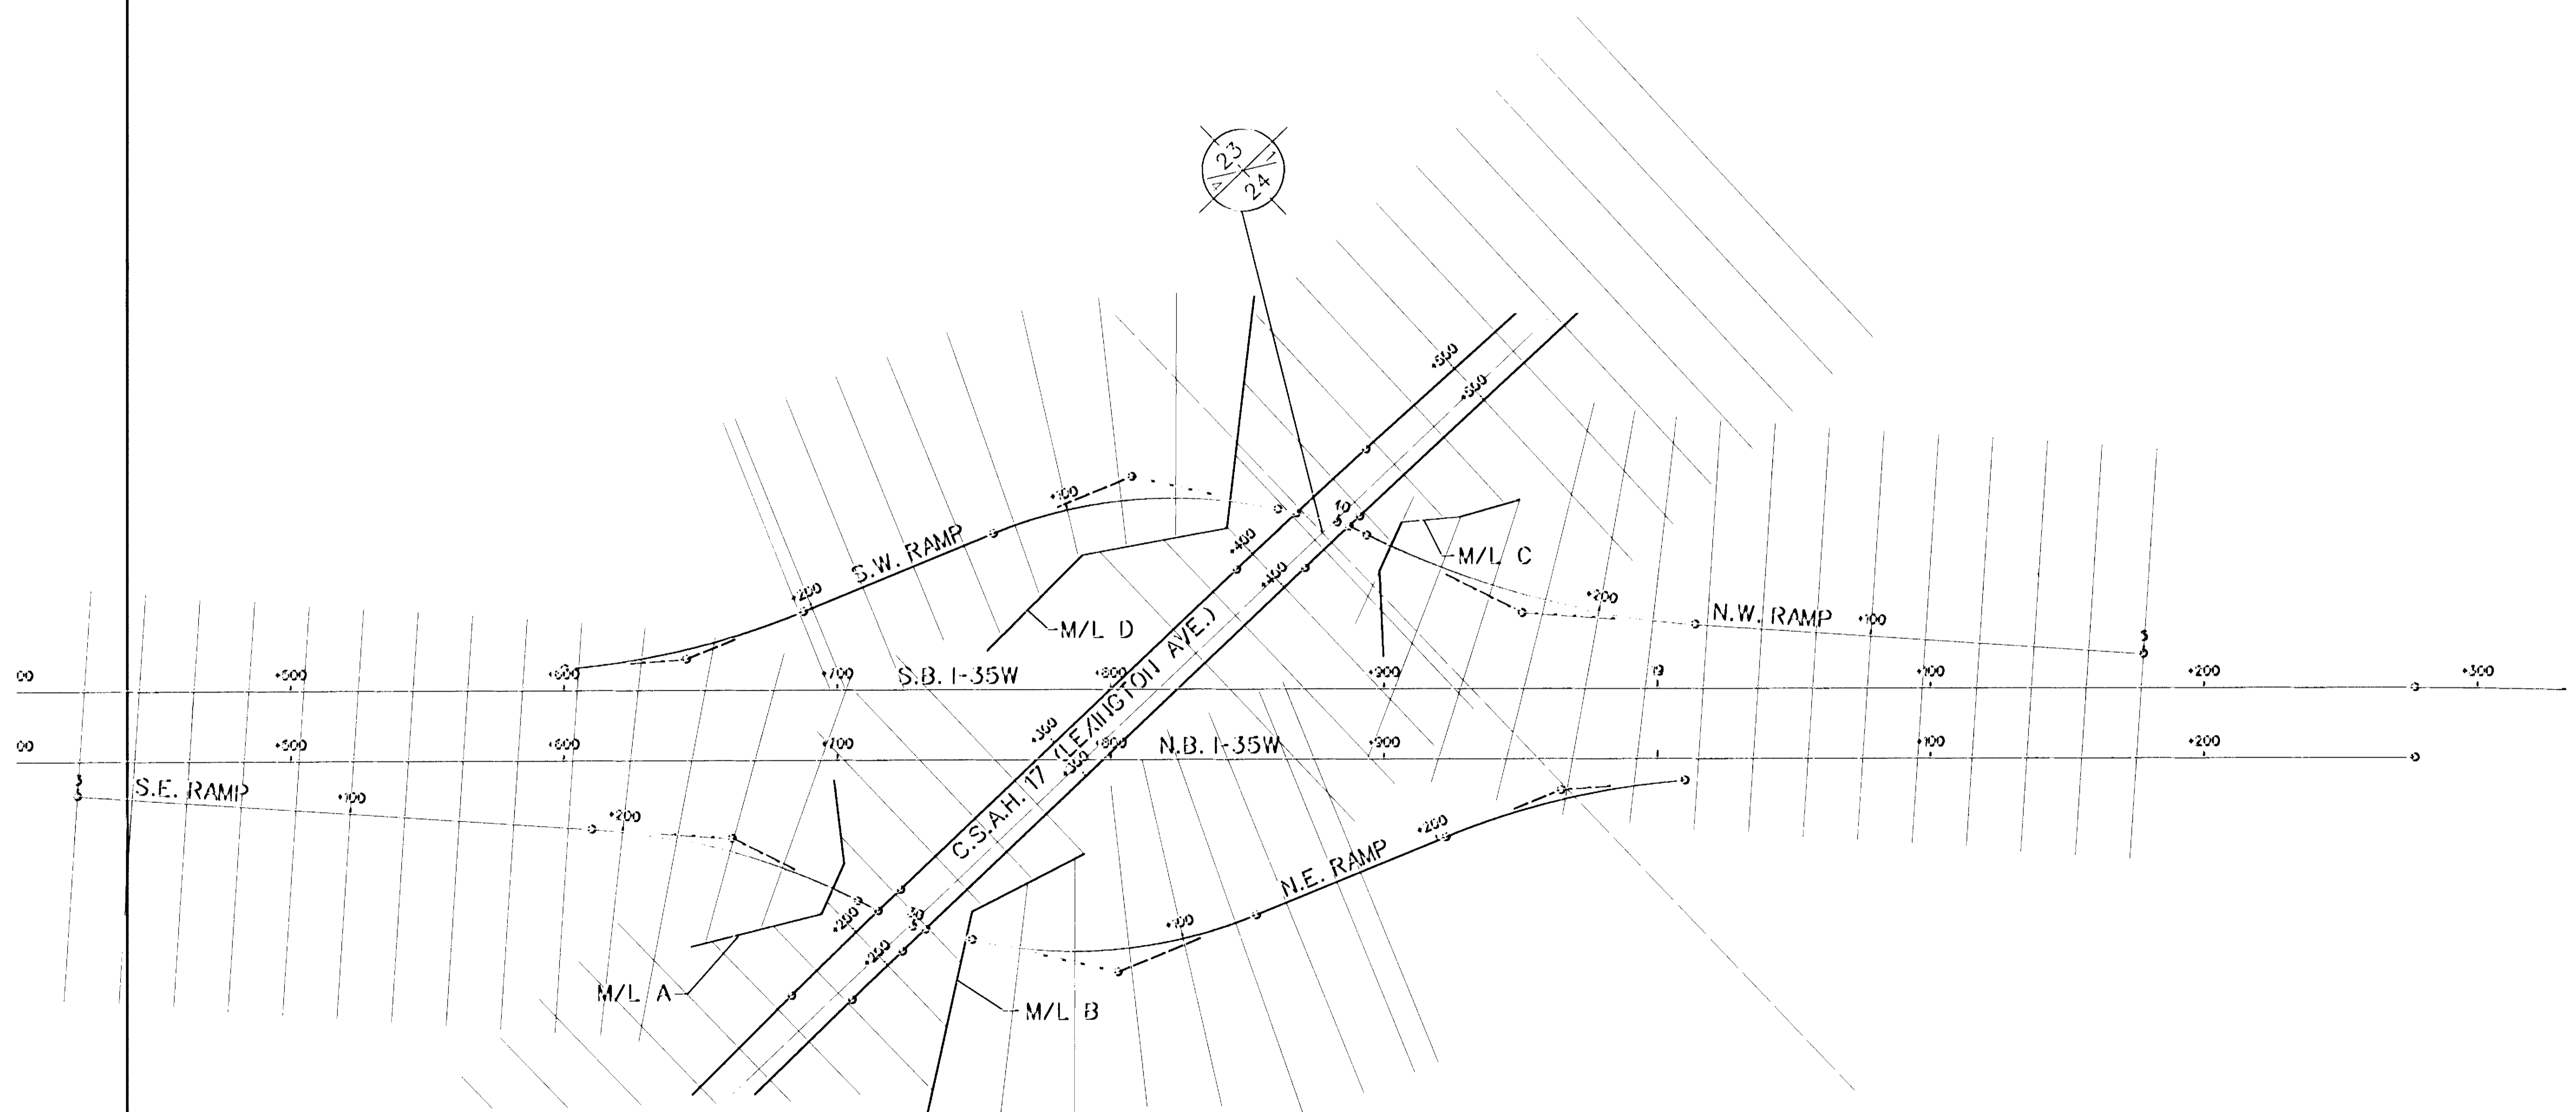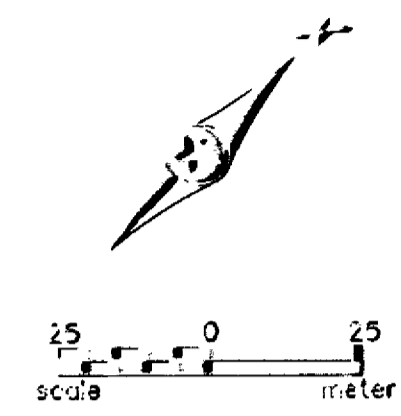

NO.	DATE	BY	CHKD	APPR	REVISION

NAME: XL1 410.PLN DATE: Mar. 17, 1997



I hereby certify that this plan, specification or report was prepared by me or under my direct supervision and that I am a duly Registered Professional Engineer under the laws of the State of Minnesota.

Donald A. Jones
 Date: 3-21-97 Reg. No. 23397

STATE AID PROJECT NO.
 S.A.P. 02-617-11
 S.A.P. 106-020-12
 S.A.P. 106-030-03
 CO. PROJECT NO.




DRAWN BY DATE
 M. IISAKKA 12-98
 DESIGNED BY
 B. URBANEK 12-98
 CHECKED BY
 D. DEMERS 1-97
 COMM. NO.
 0362410

SJRE CONSULTING GROUP, INC.


ANOKA COUNTY
 CROSS SECTION MATCHLINES
 C.S.A.H. 17 RECONSTRUCTION
 C.S.A.H. 17 AT INTERSTATE 35W

SHEET 161 OF 236


30 20 10 0 10 20 30

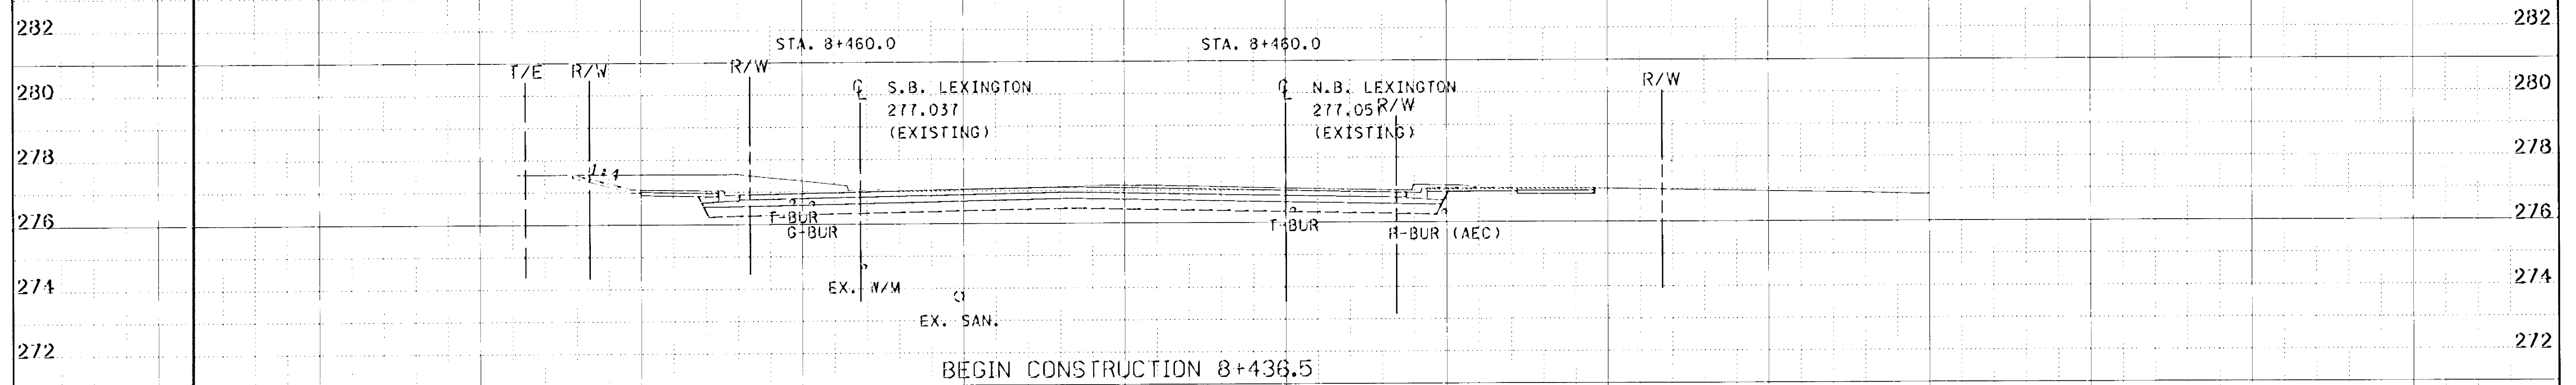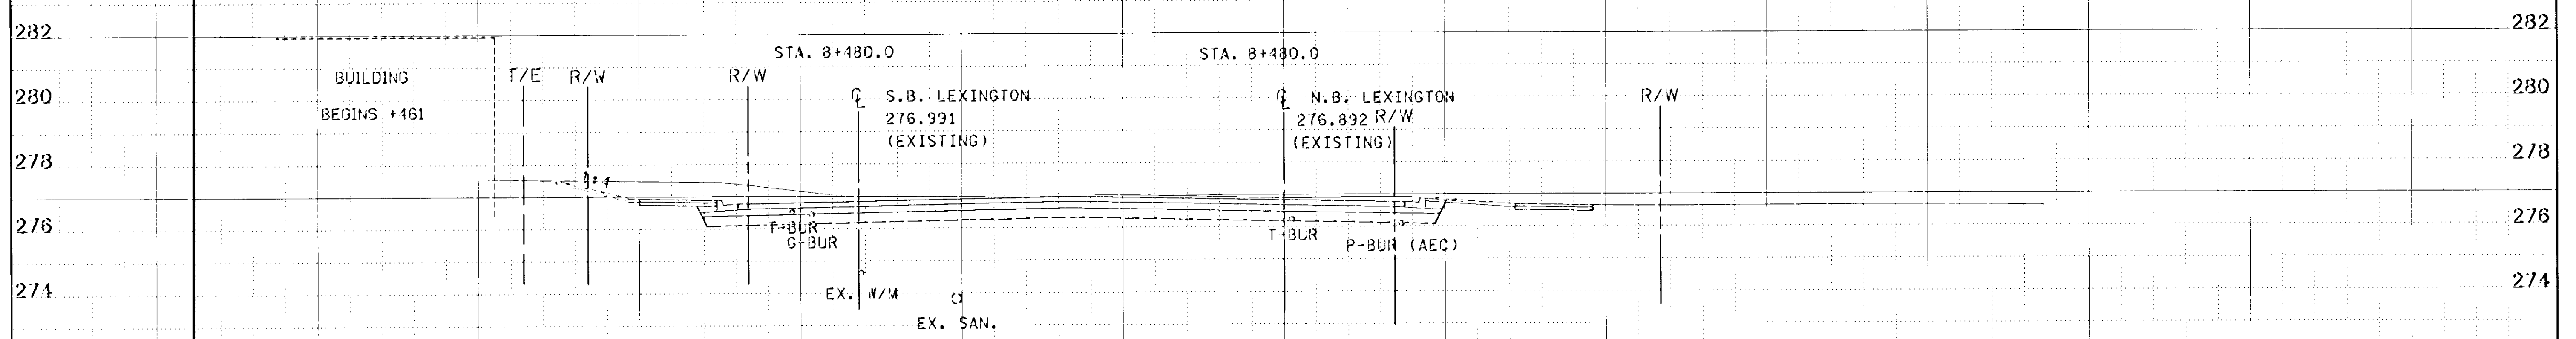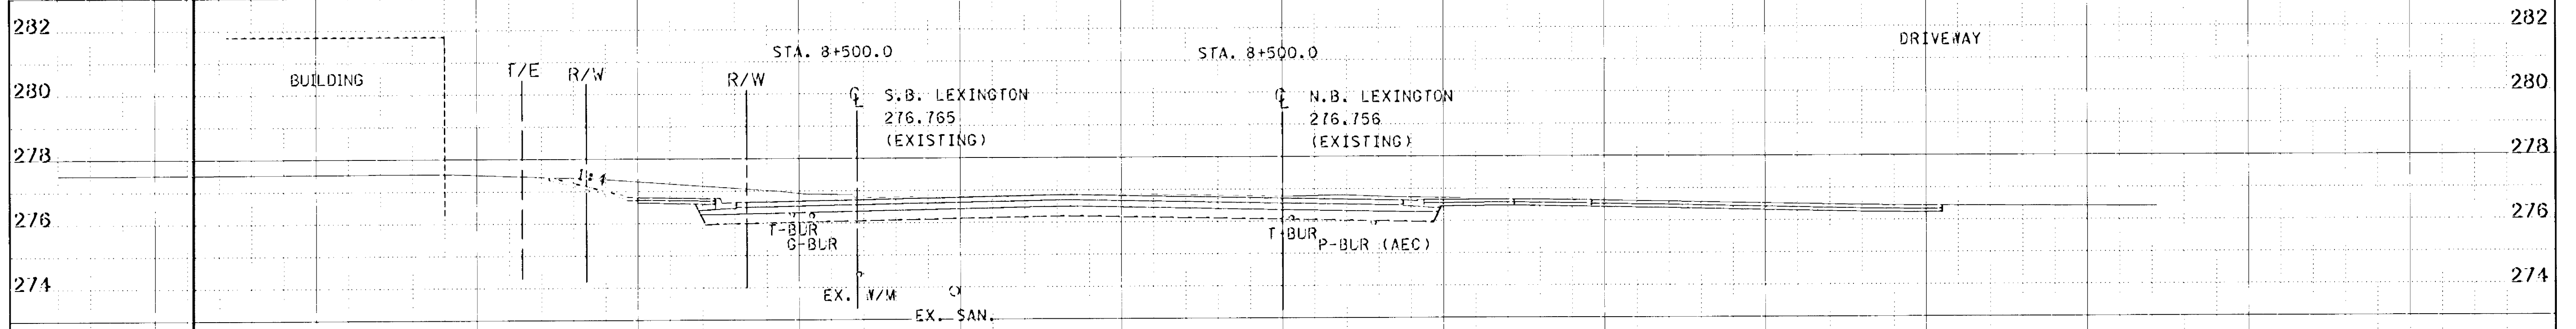


C.S.A.H. 17 (LEXINGTON AVENUE)
STA. 8+400.000 TO STA. 8+500.000

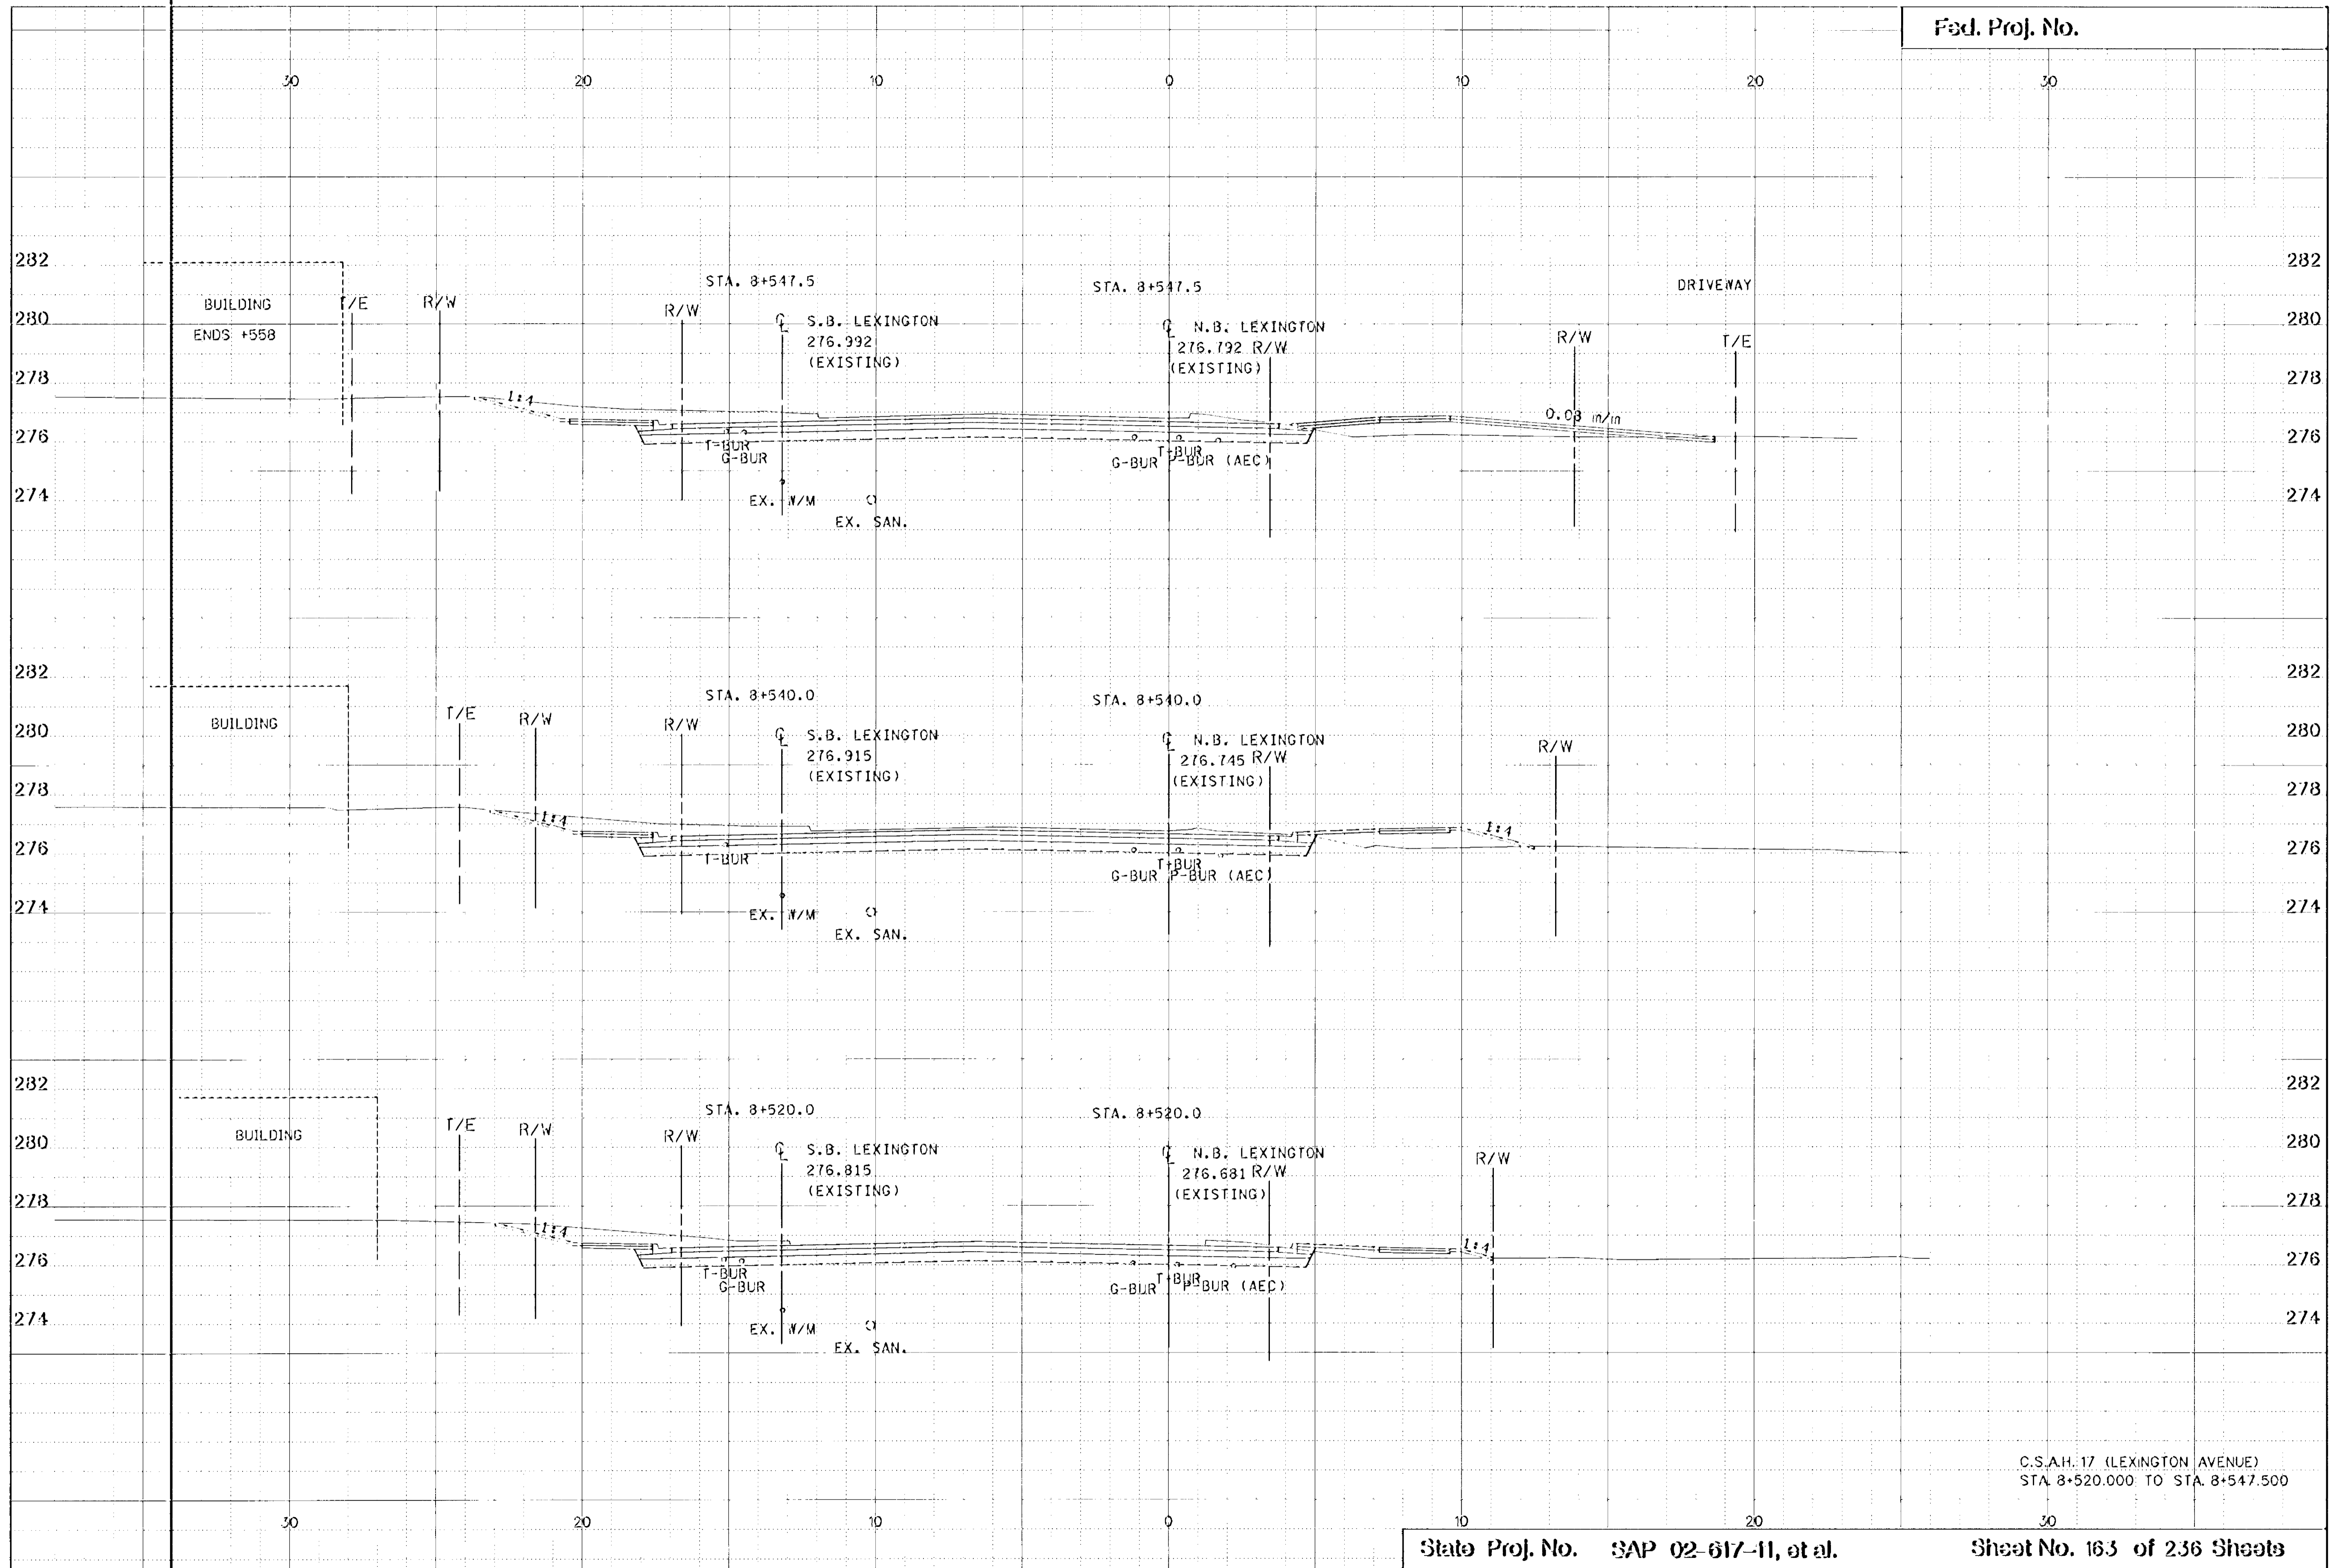


C.S.A.H. 17 (LEXINGTON AVENUE)
STA 8+520.000 TO STA. 8+547.500

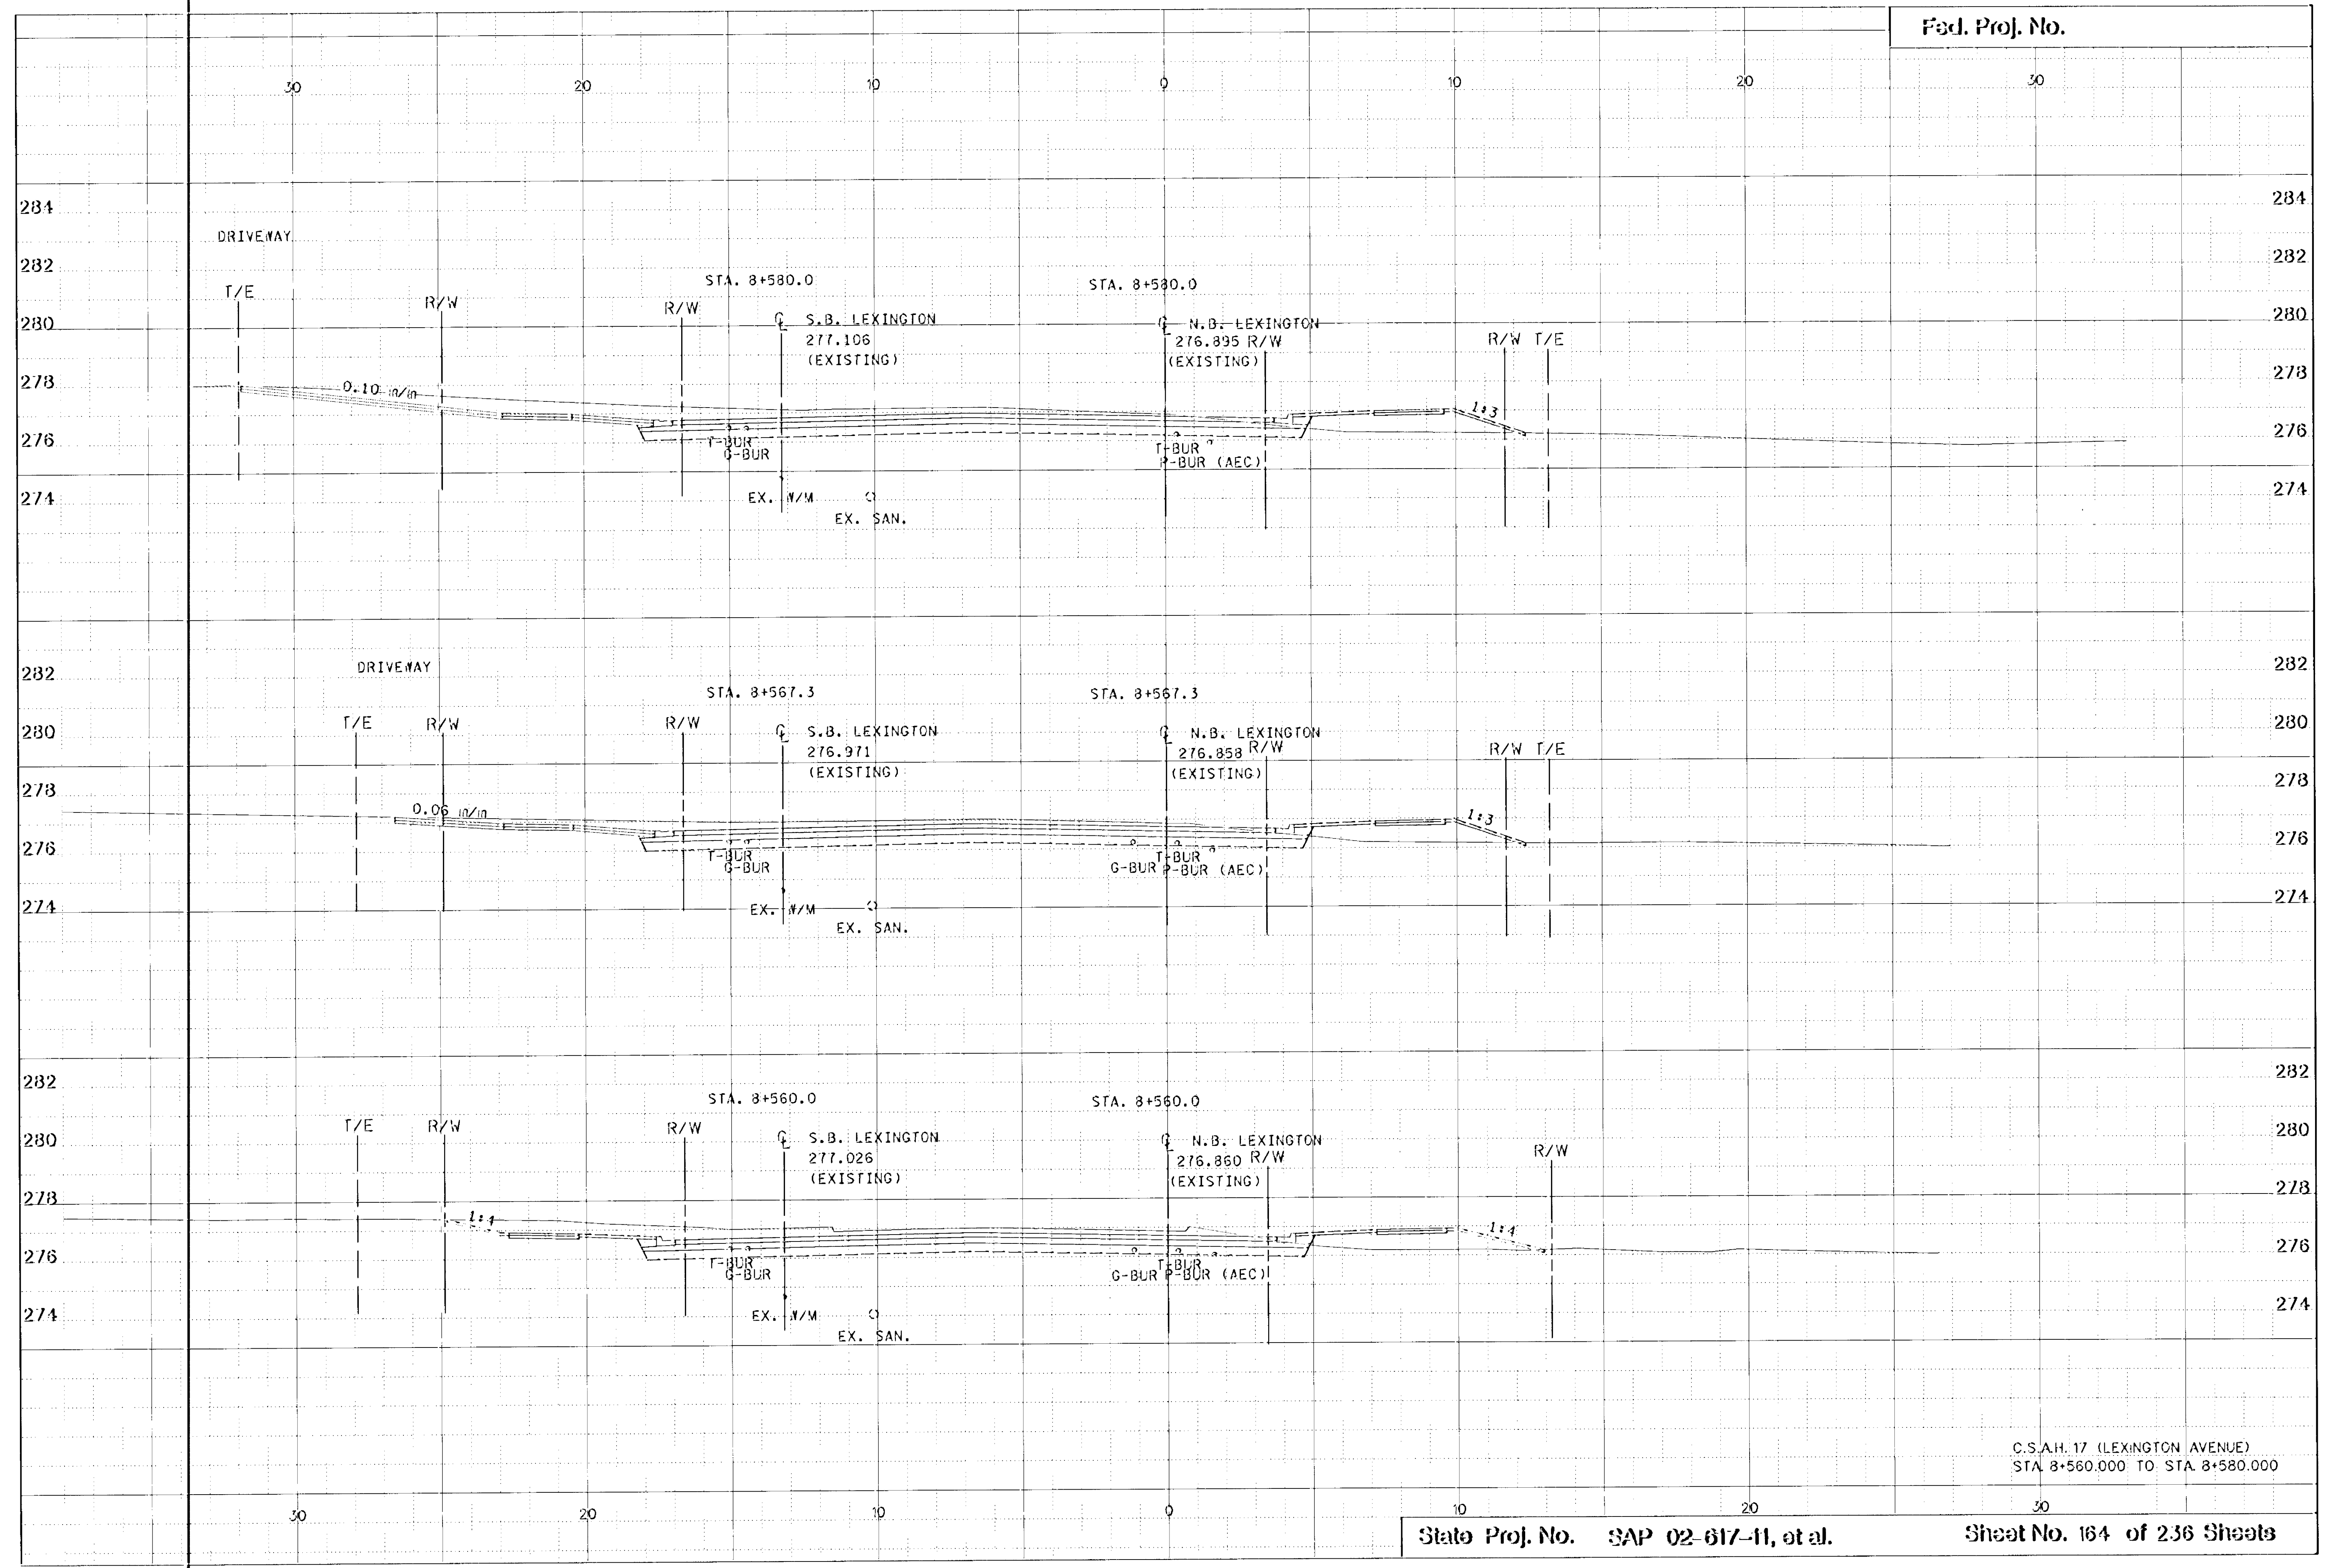




C.S.A.H. 17 (LEXINGTON AVENUE)
STA. 8+560.000 TO STA. 8+580.000

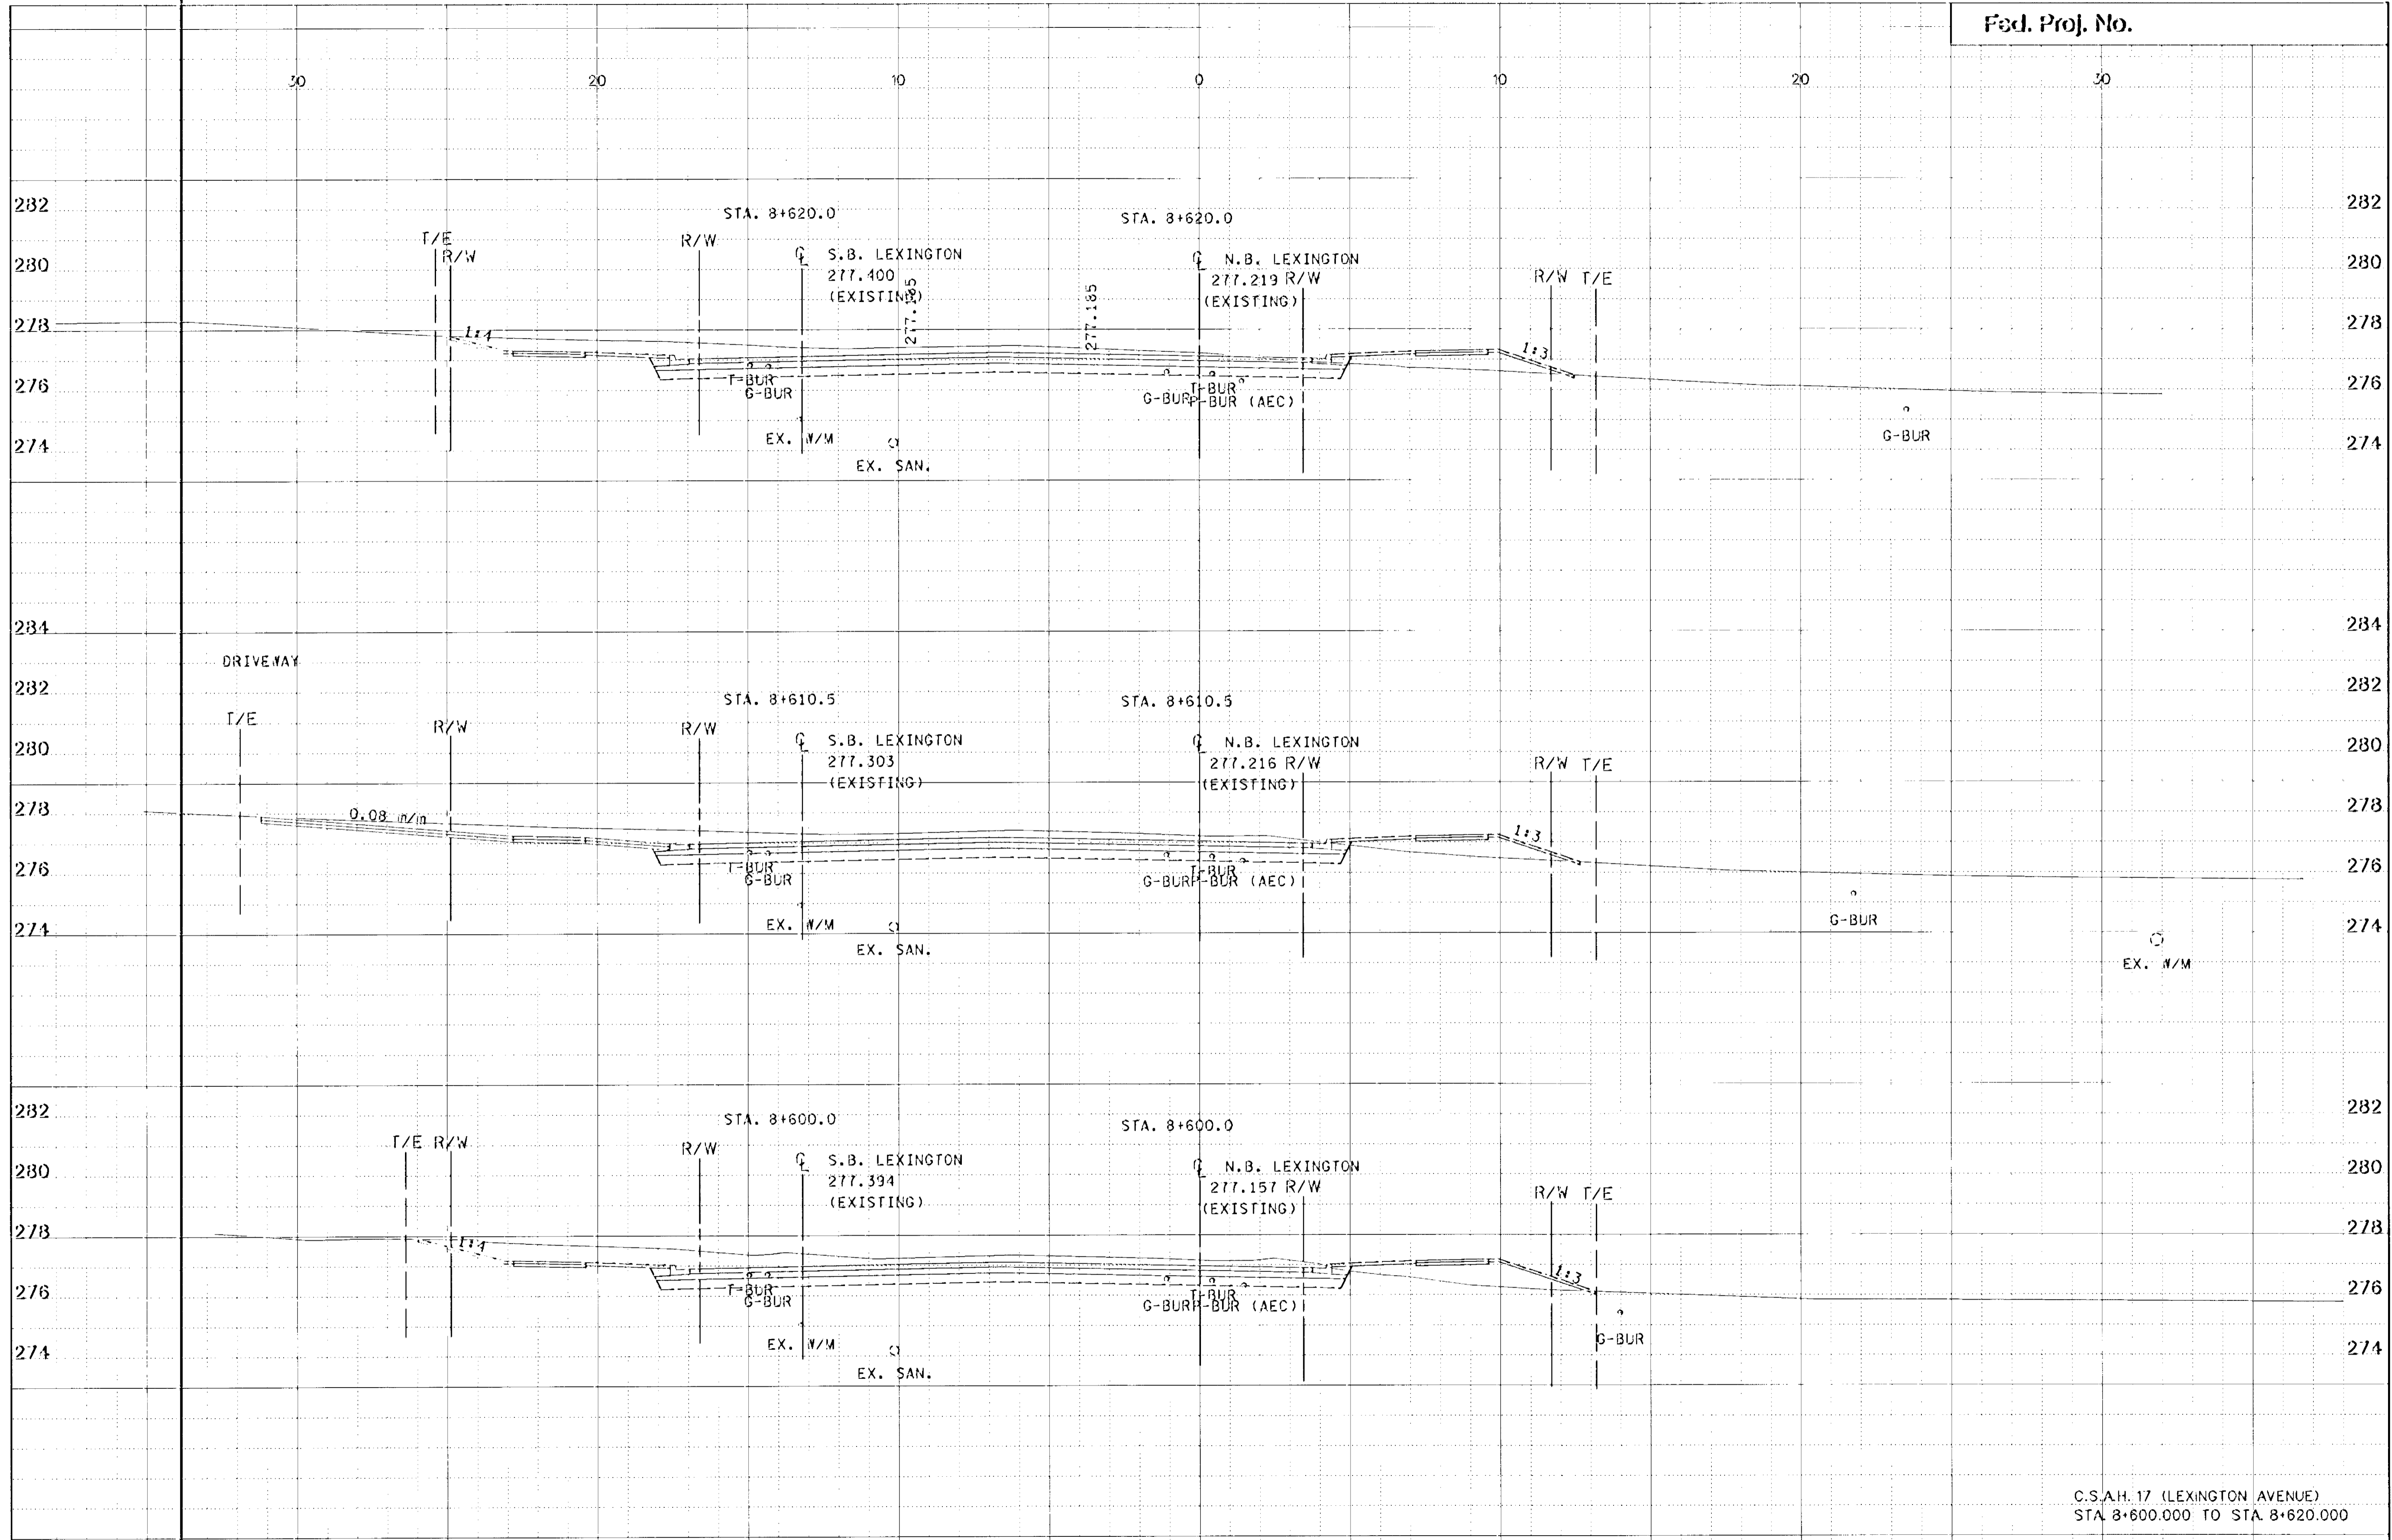


C.S.A.H. 17 (LEXINGTON AVENUE)
STA 8+600.000 TO STA 8+620.000

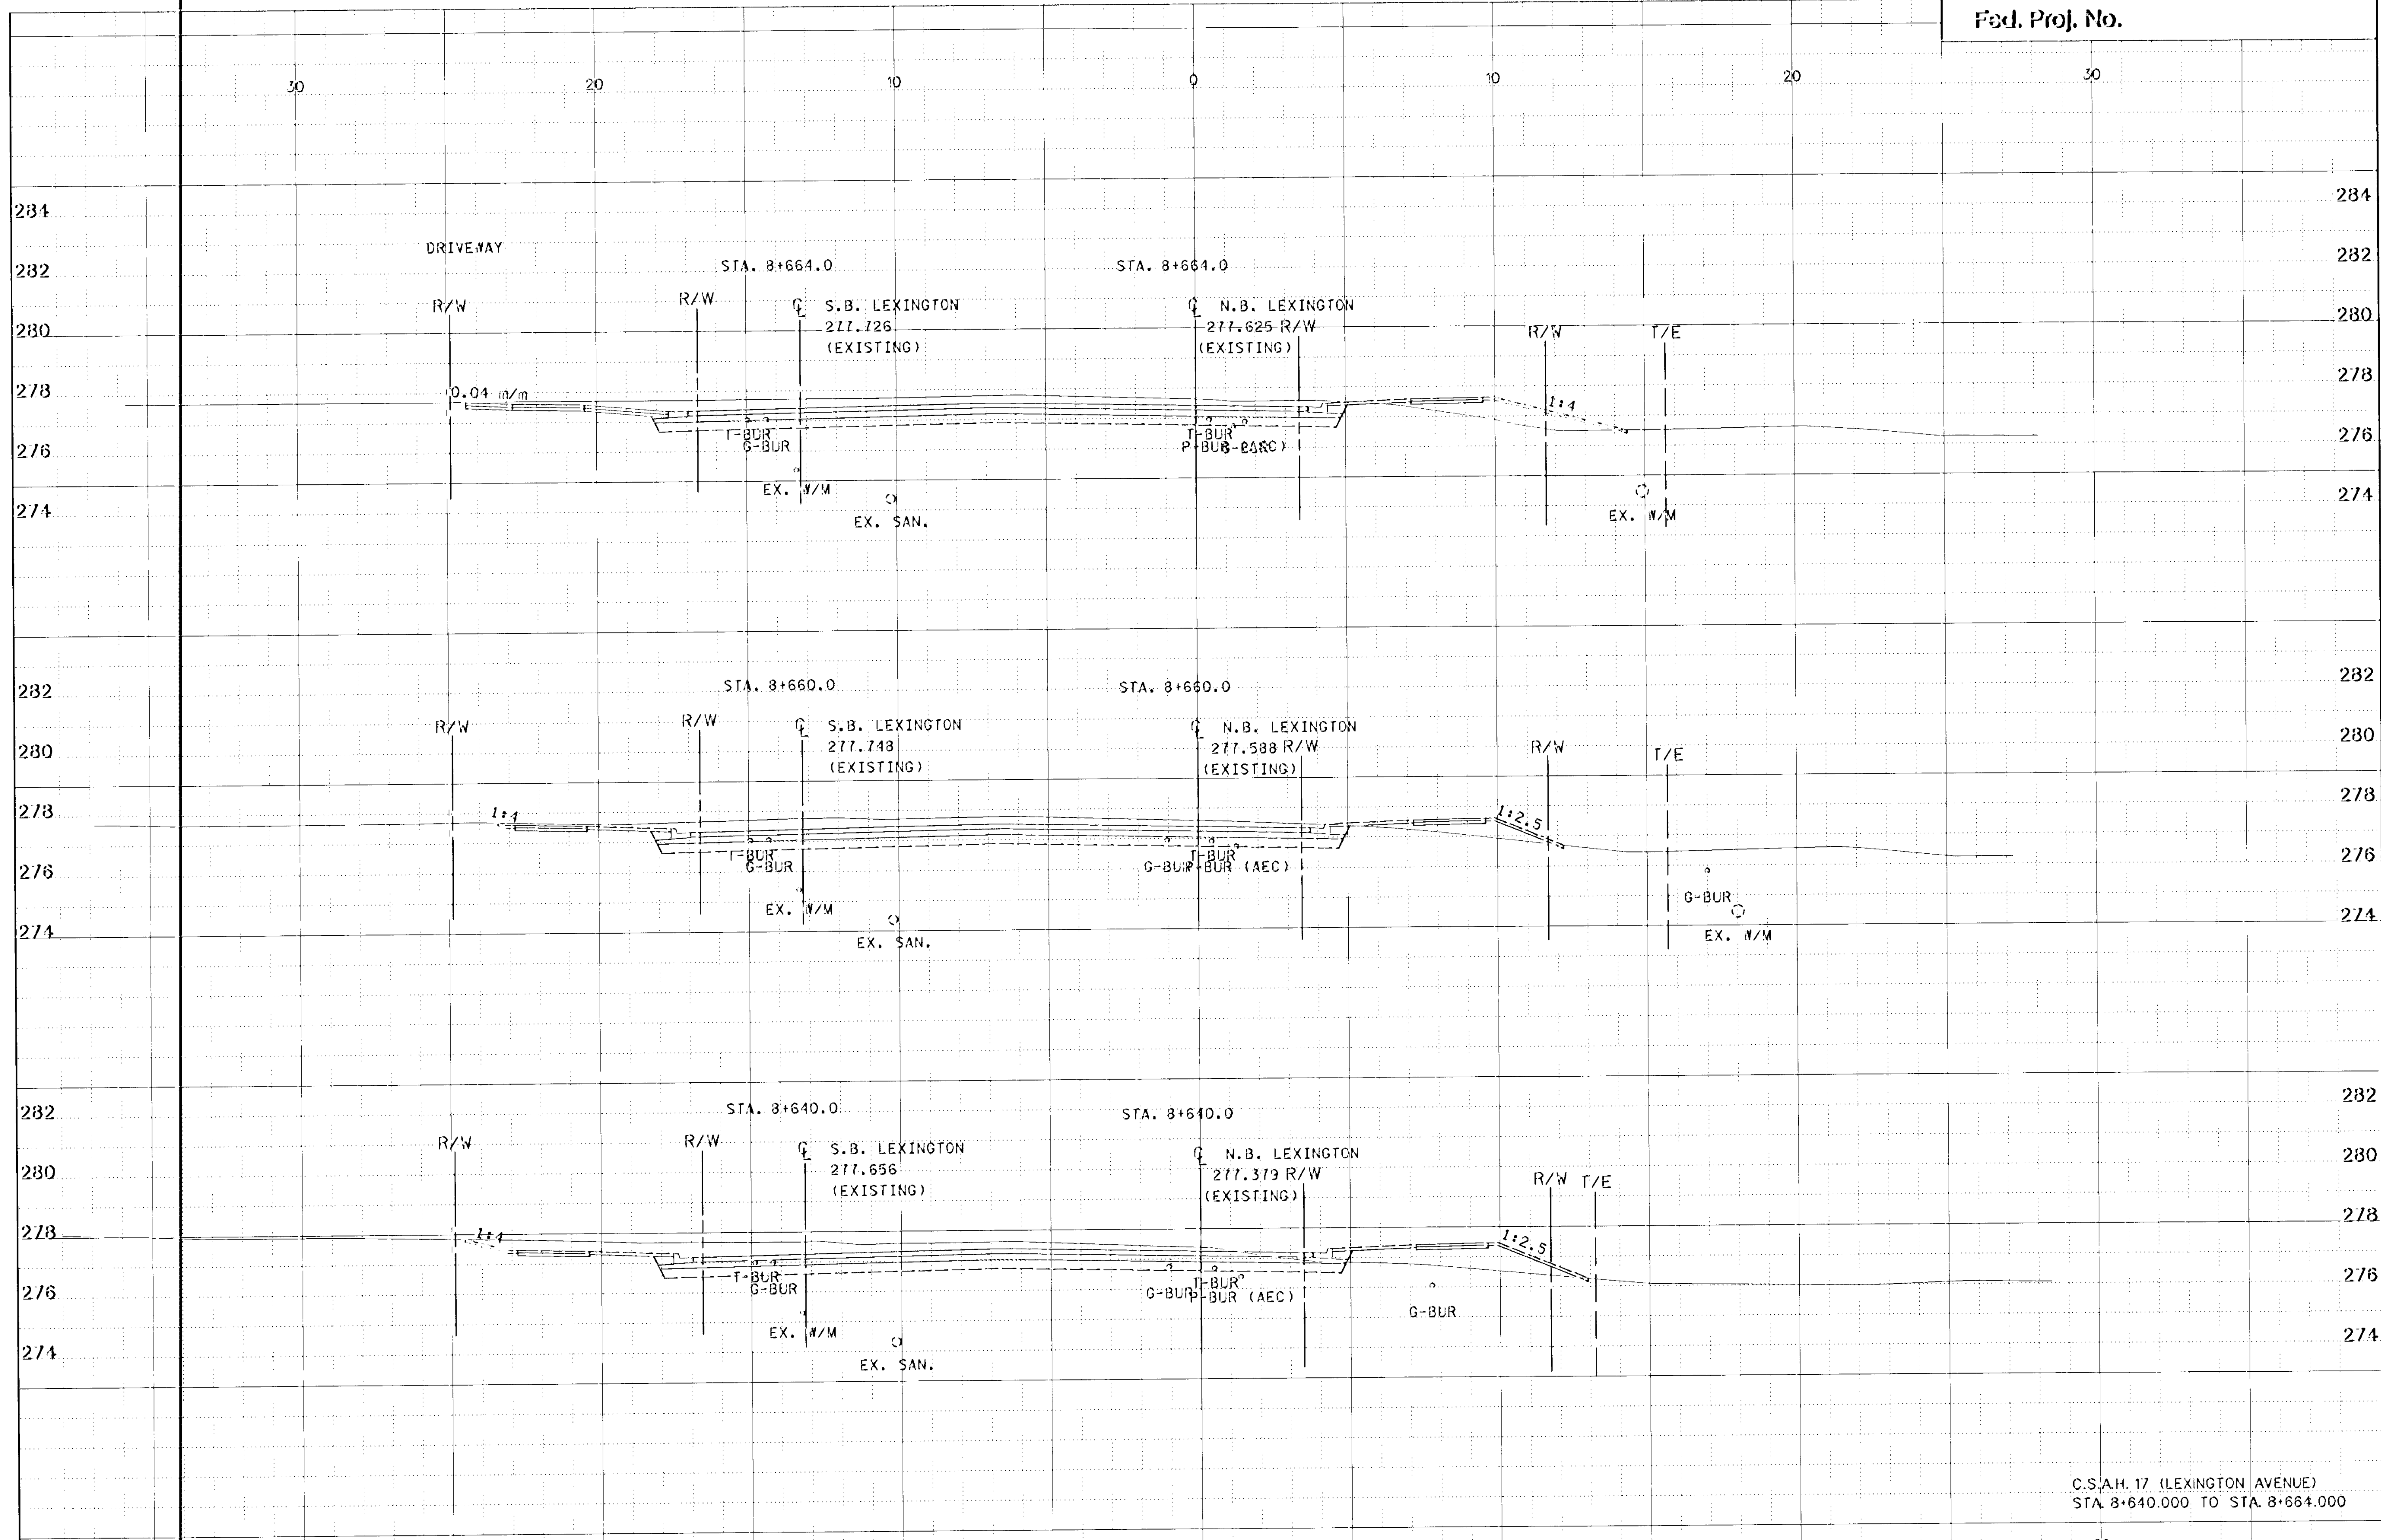


C.S.A.H. 17 (LEXINGTON AVENUE)
STA. 8+640.000 TO STA. 8+664.000

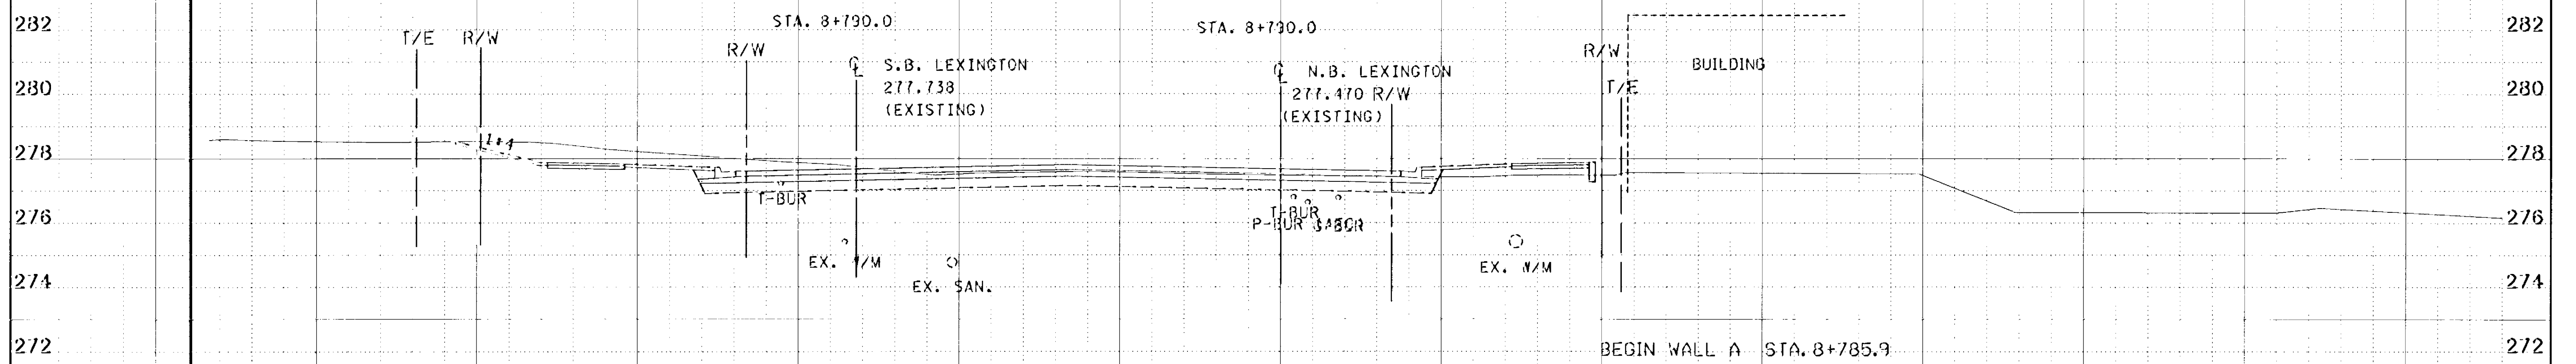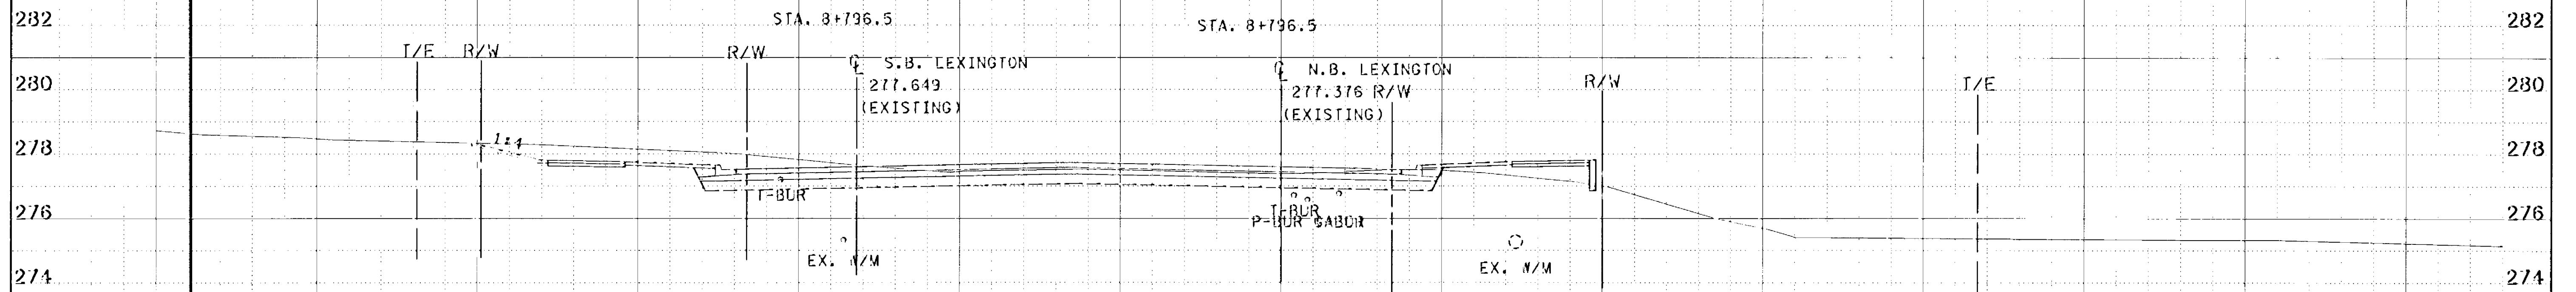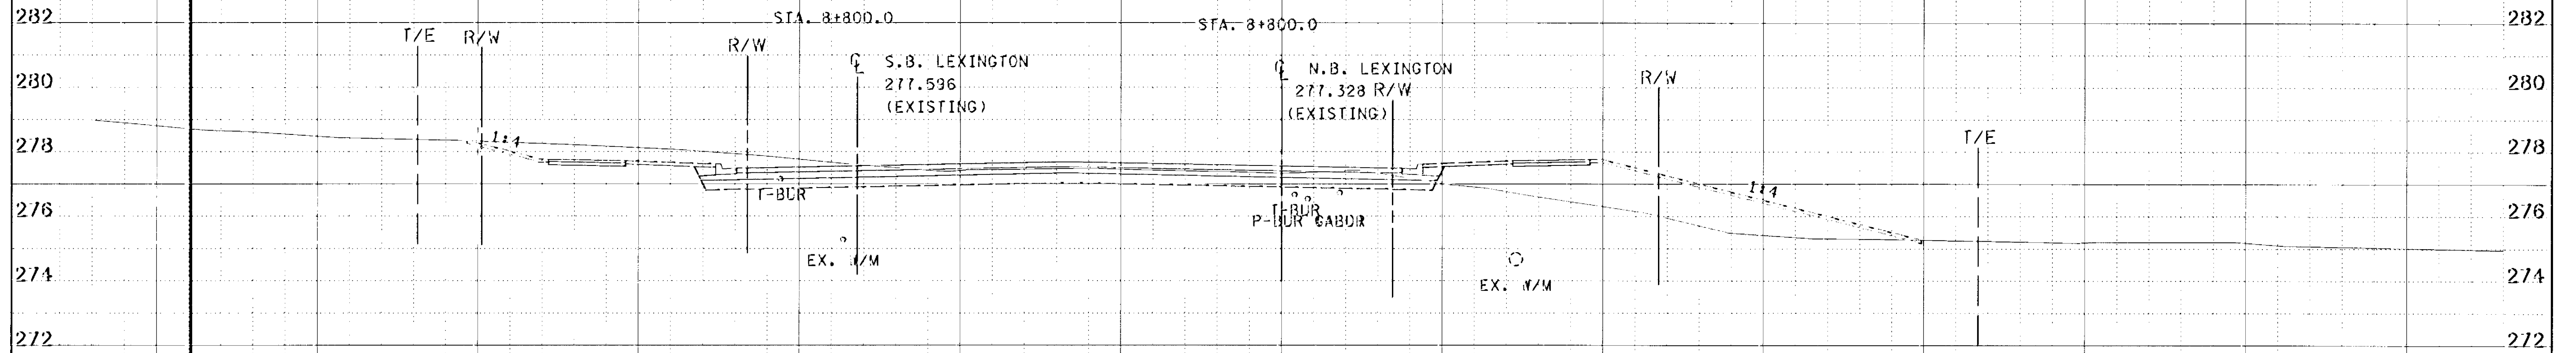

C.S.A.H. 17 (LEXINGTON AVENUE)
STA. 8+790.000 TO STA. 8+800.000

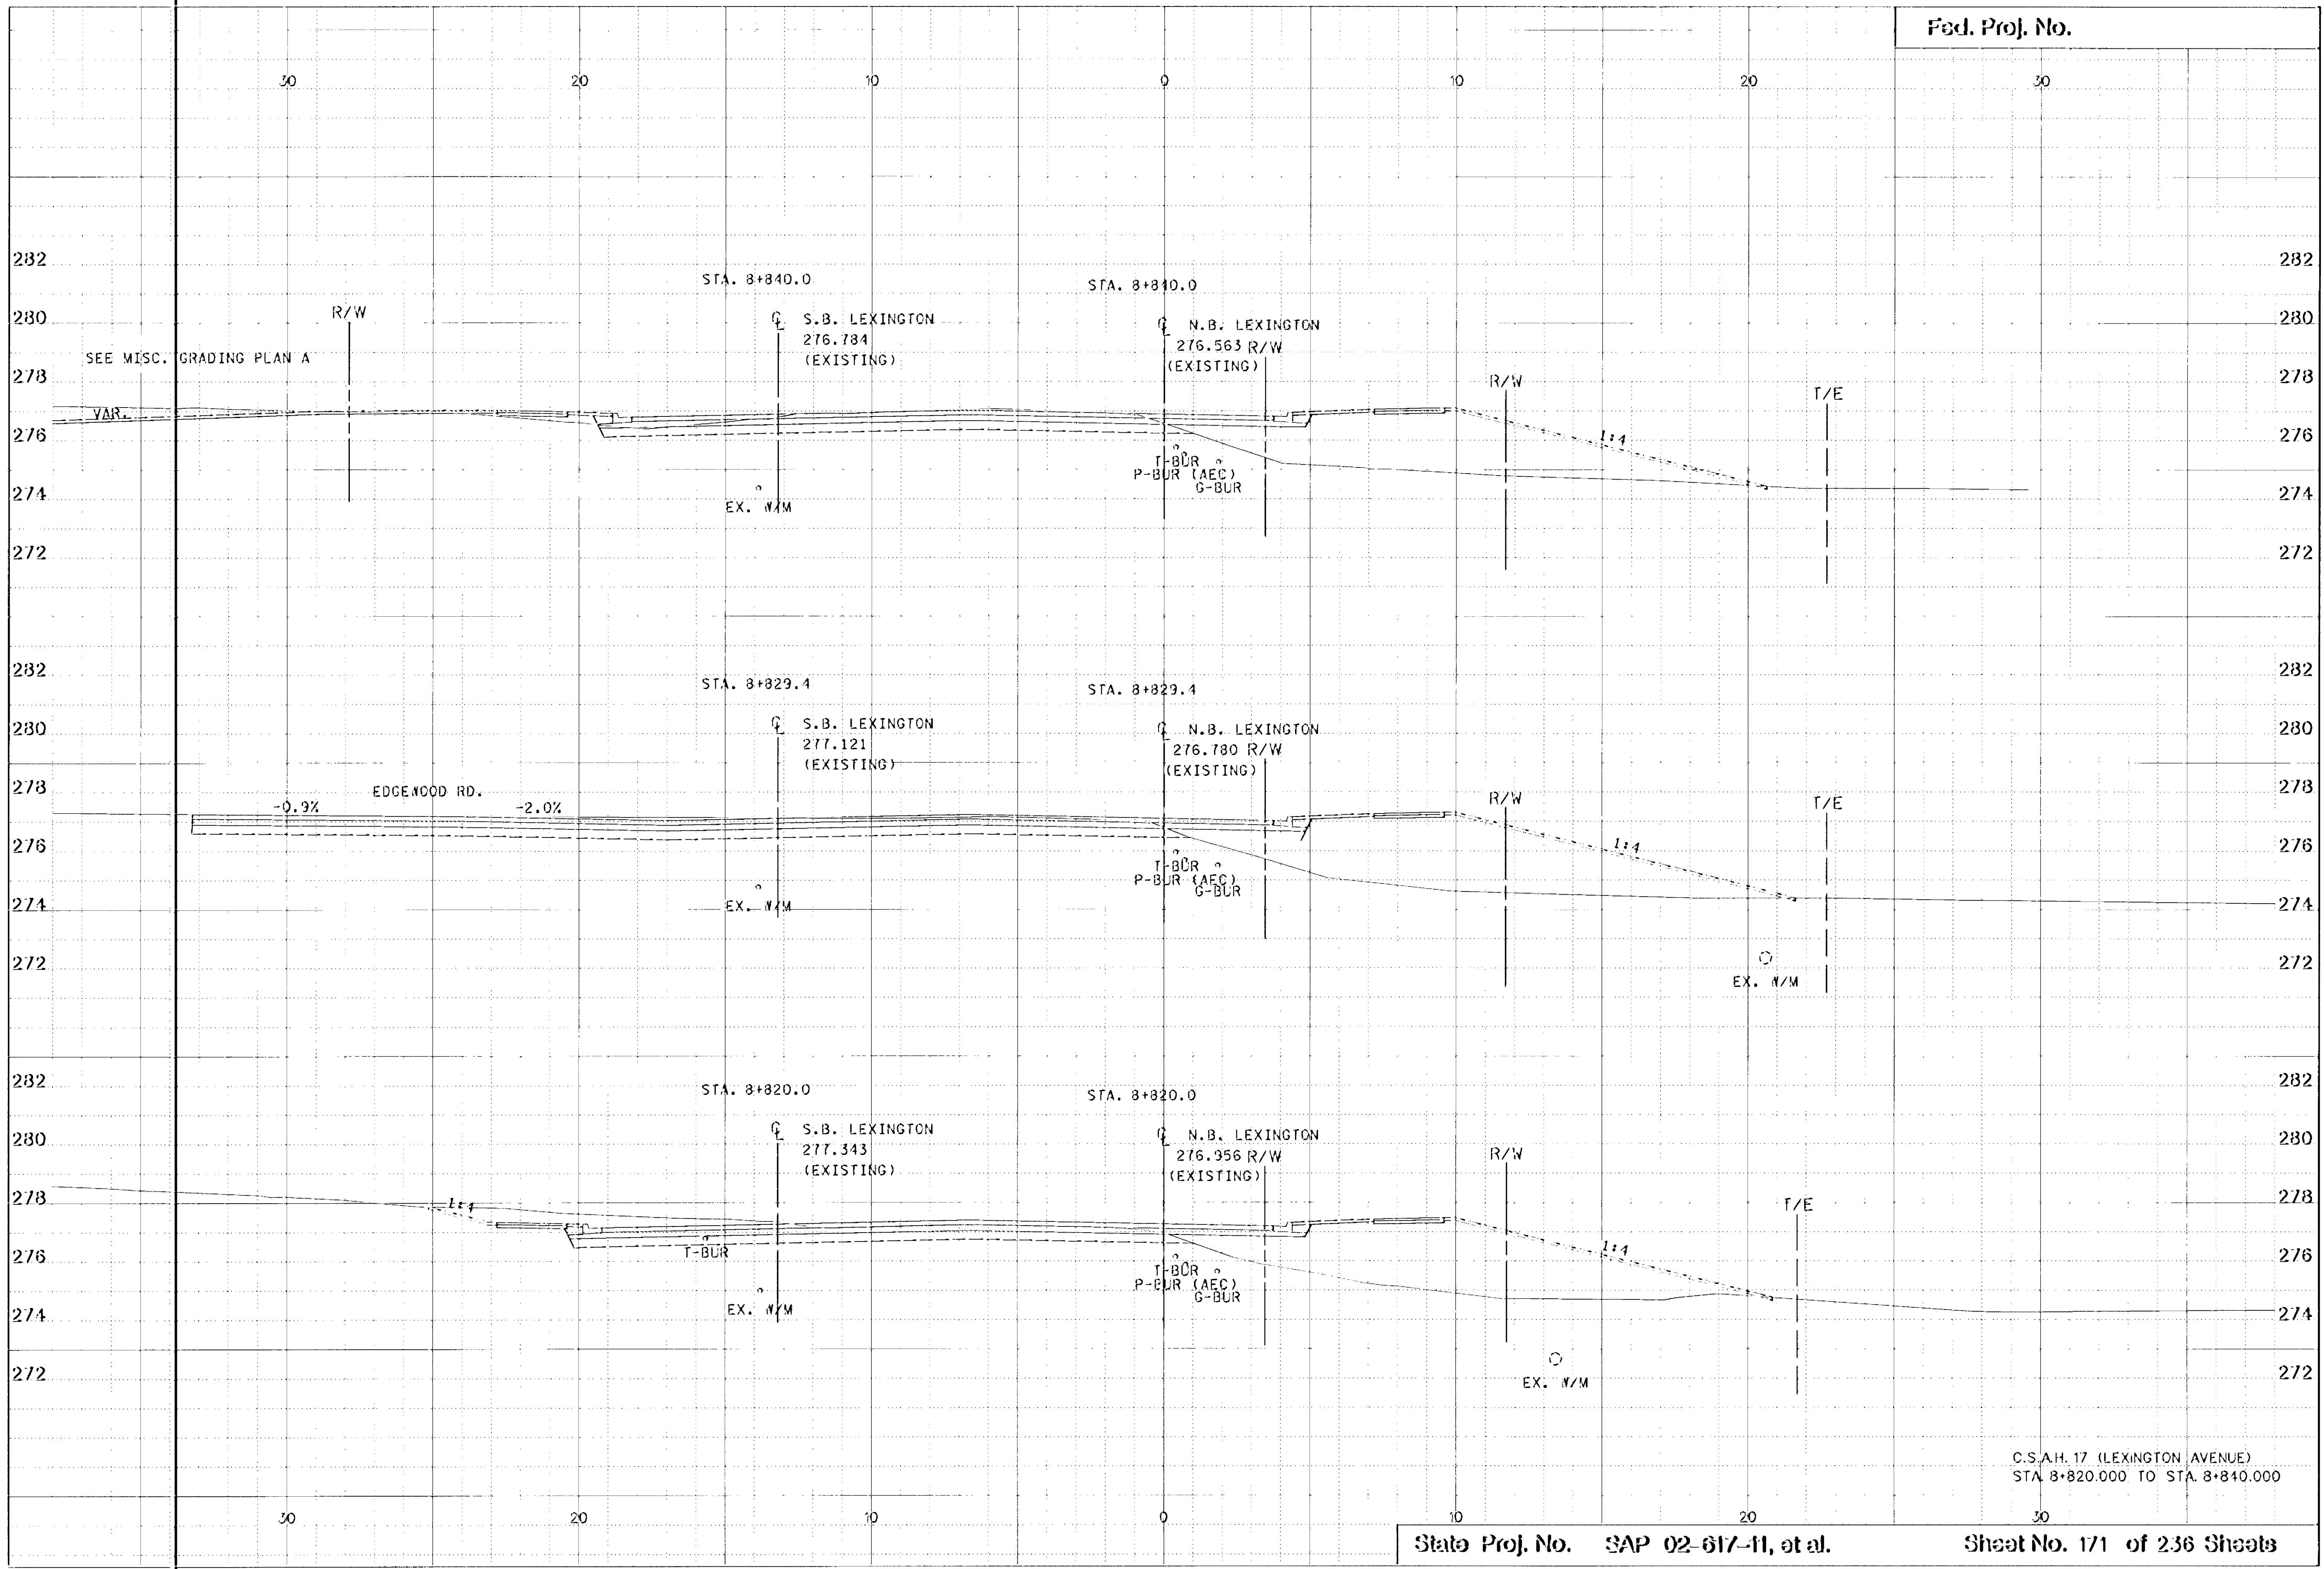


C.S.A.H. 17 (LEXINGTON AVENUE)
STA 8+820.000 TO STA 8+840.000

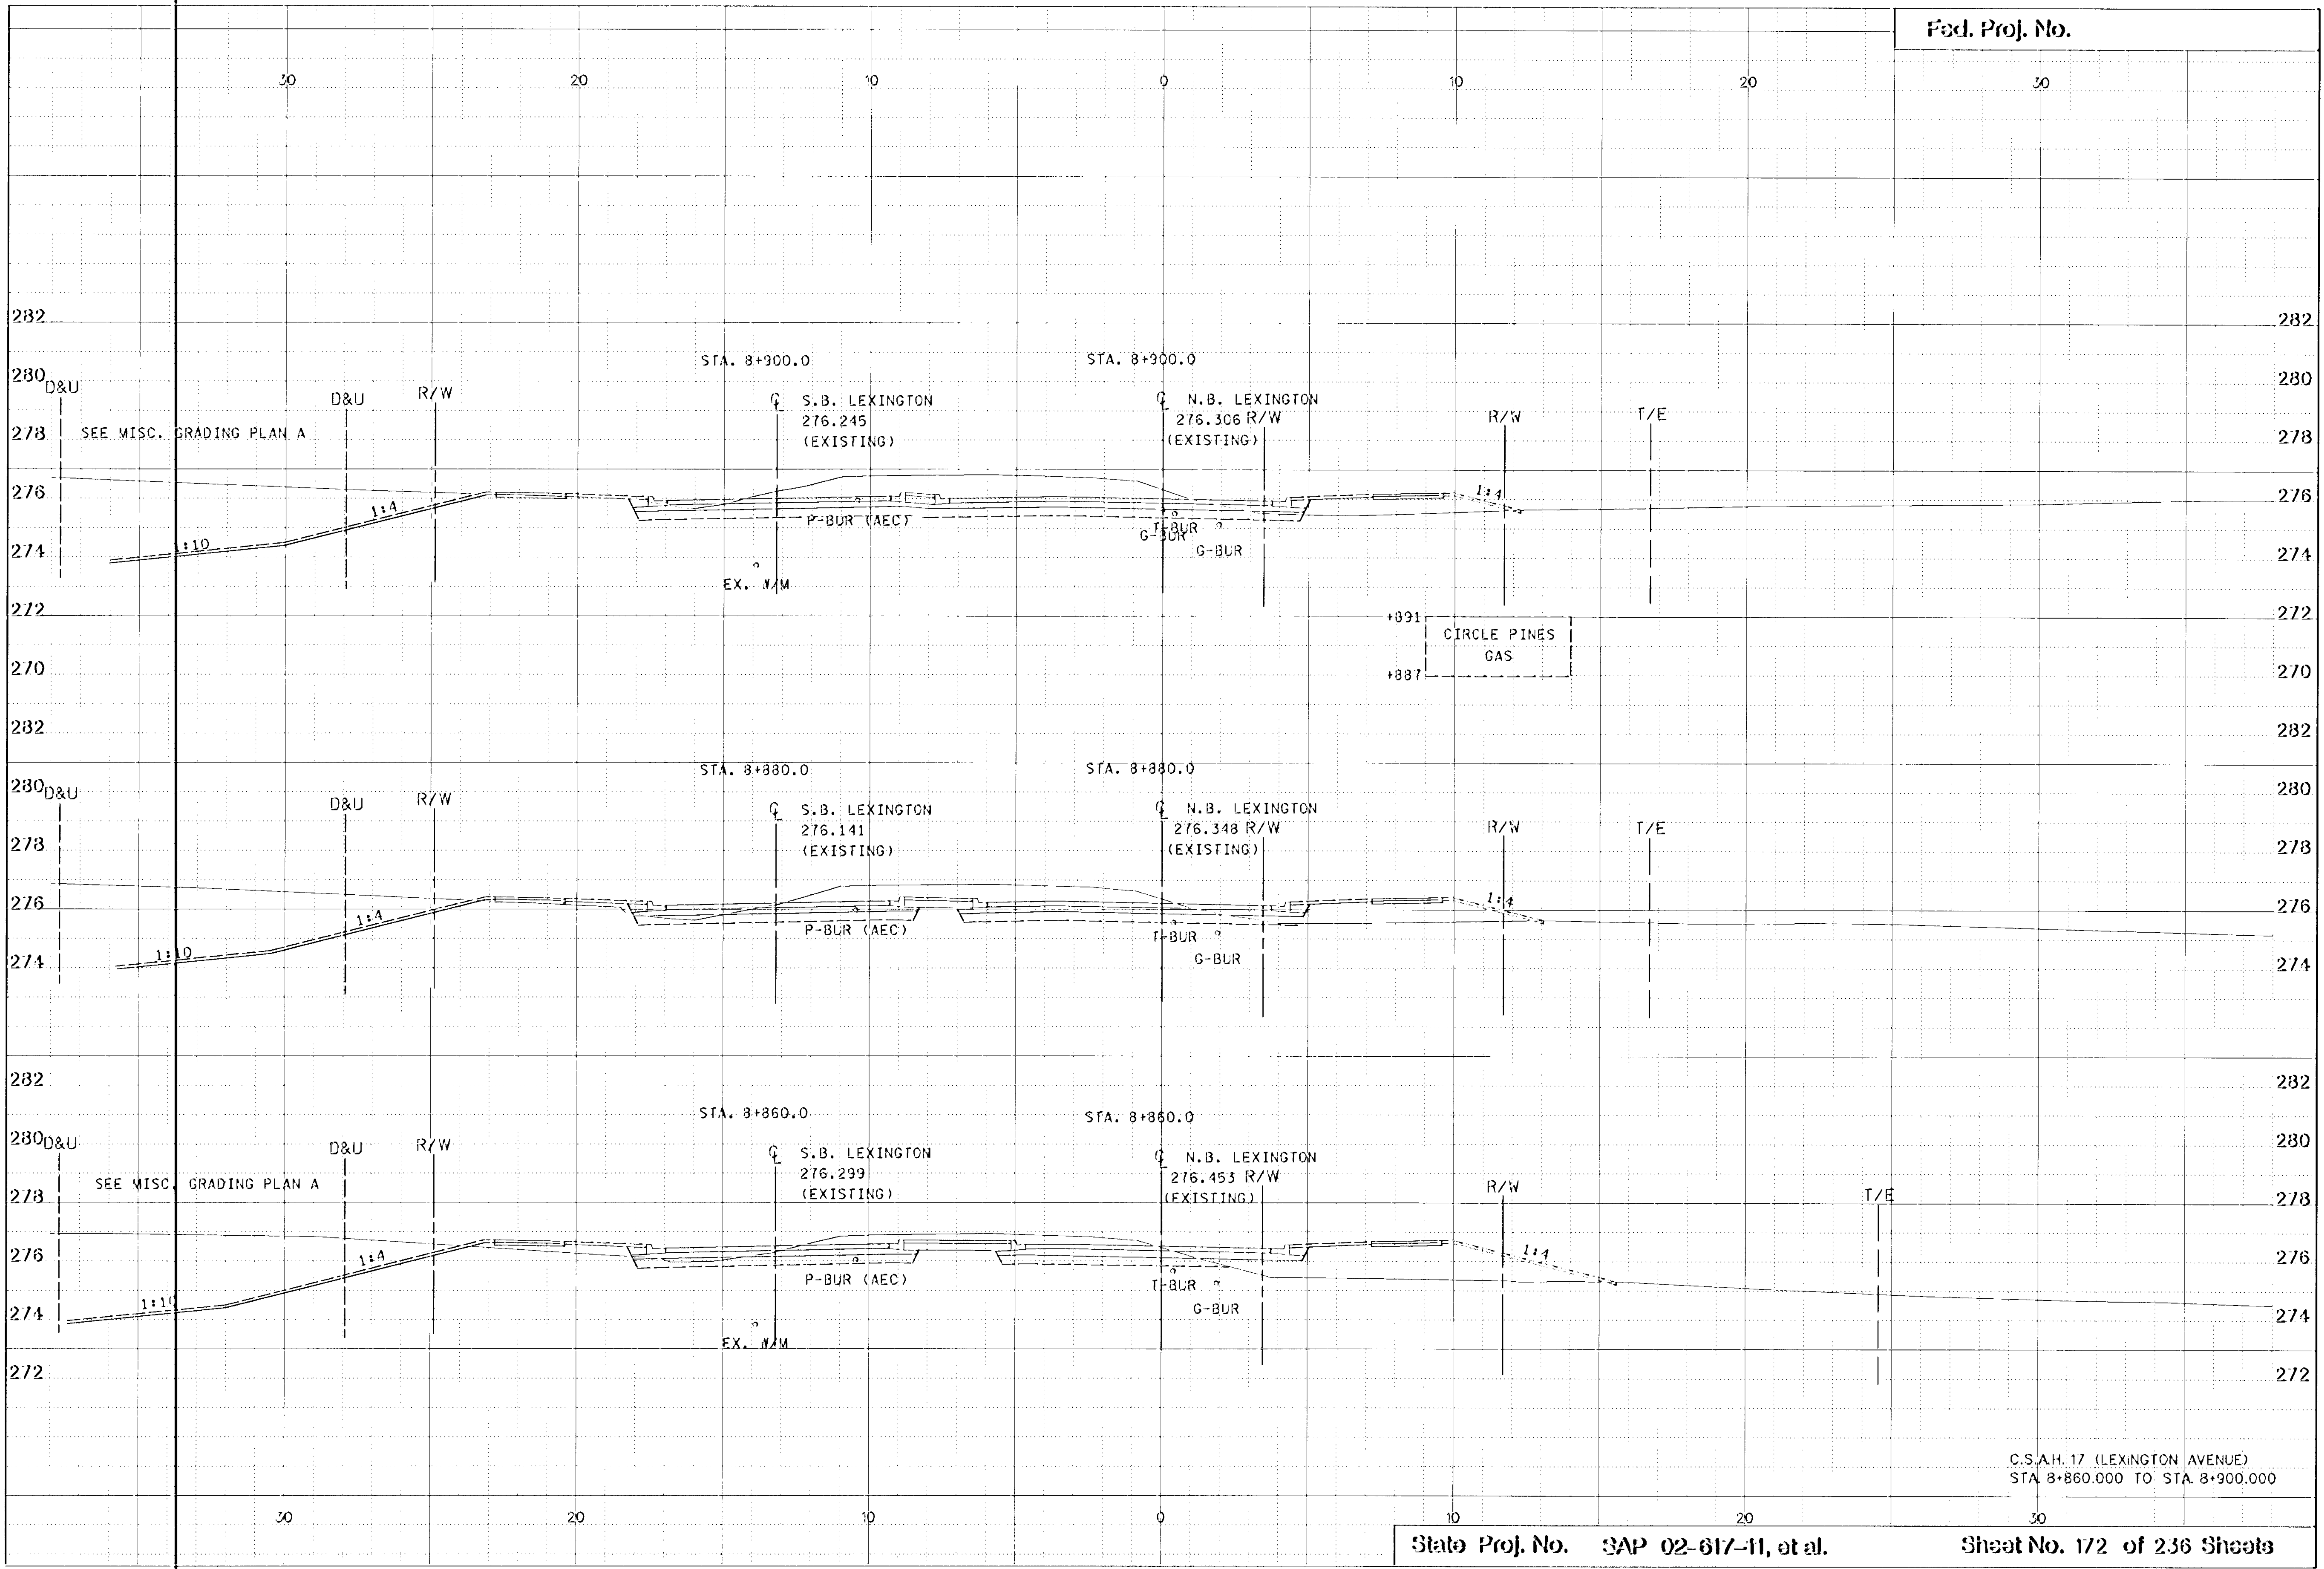


C.S.A.H. 17 (LEXINGTON AVENUE)
STA 8+860.000 TO STA 8+900.000


30 20 10 0 10 20 30

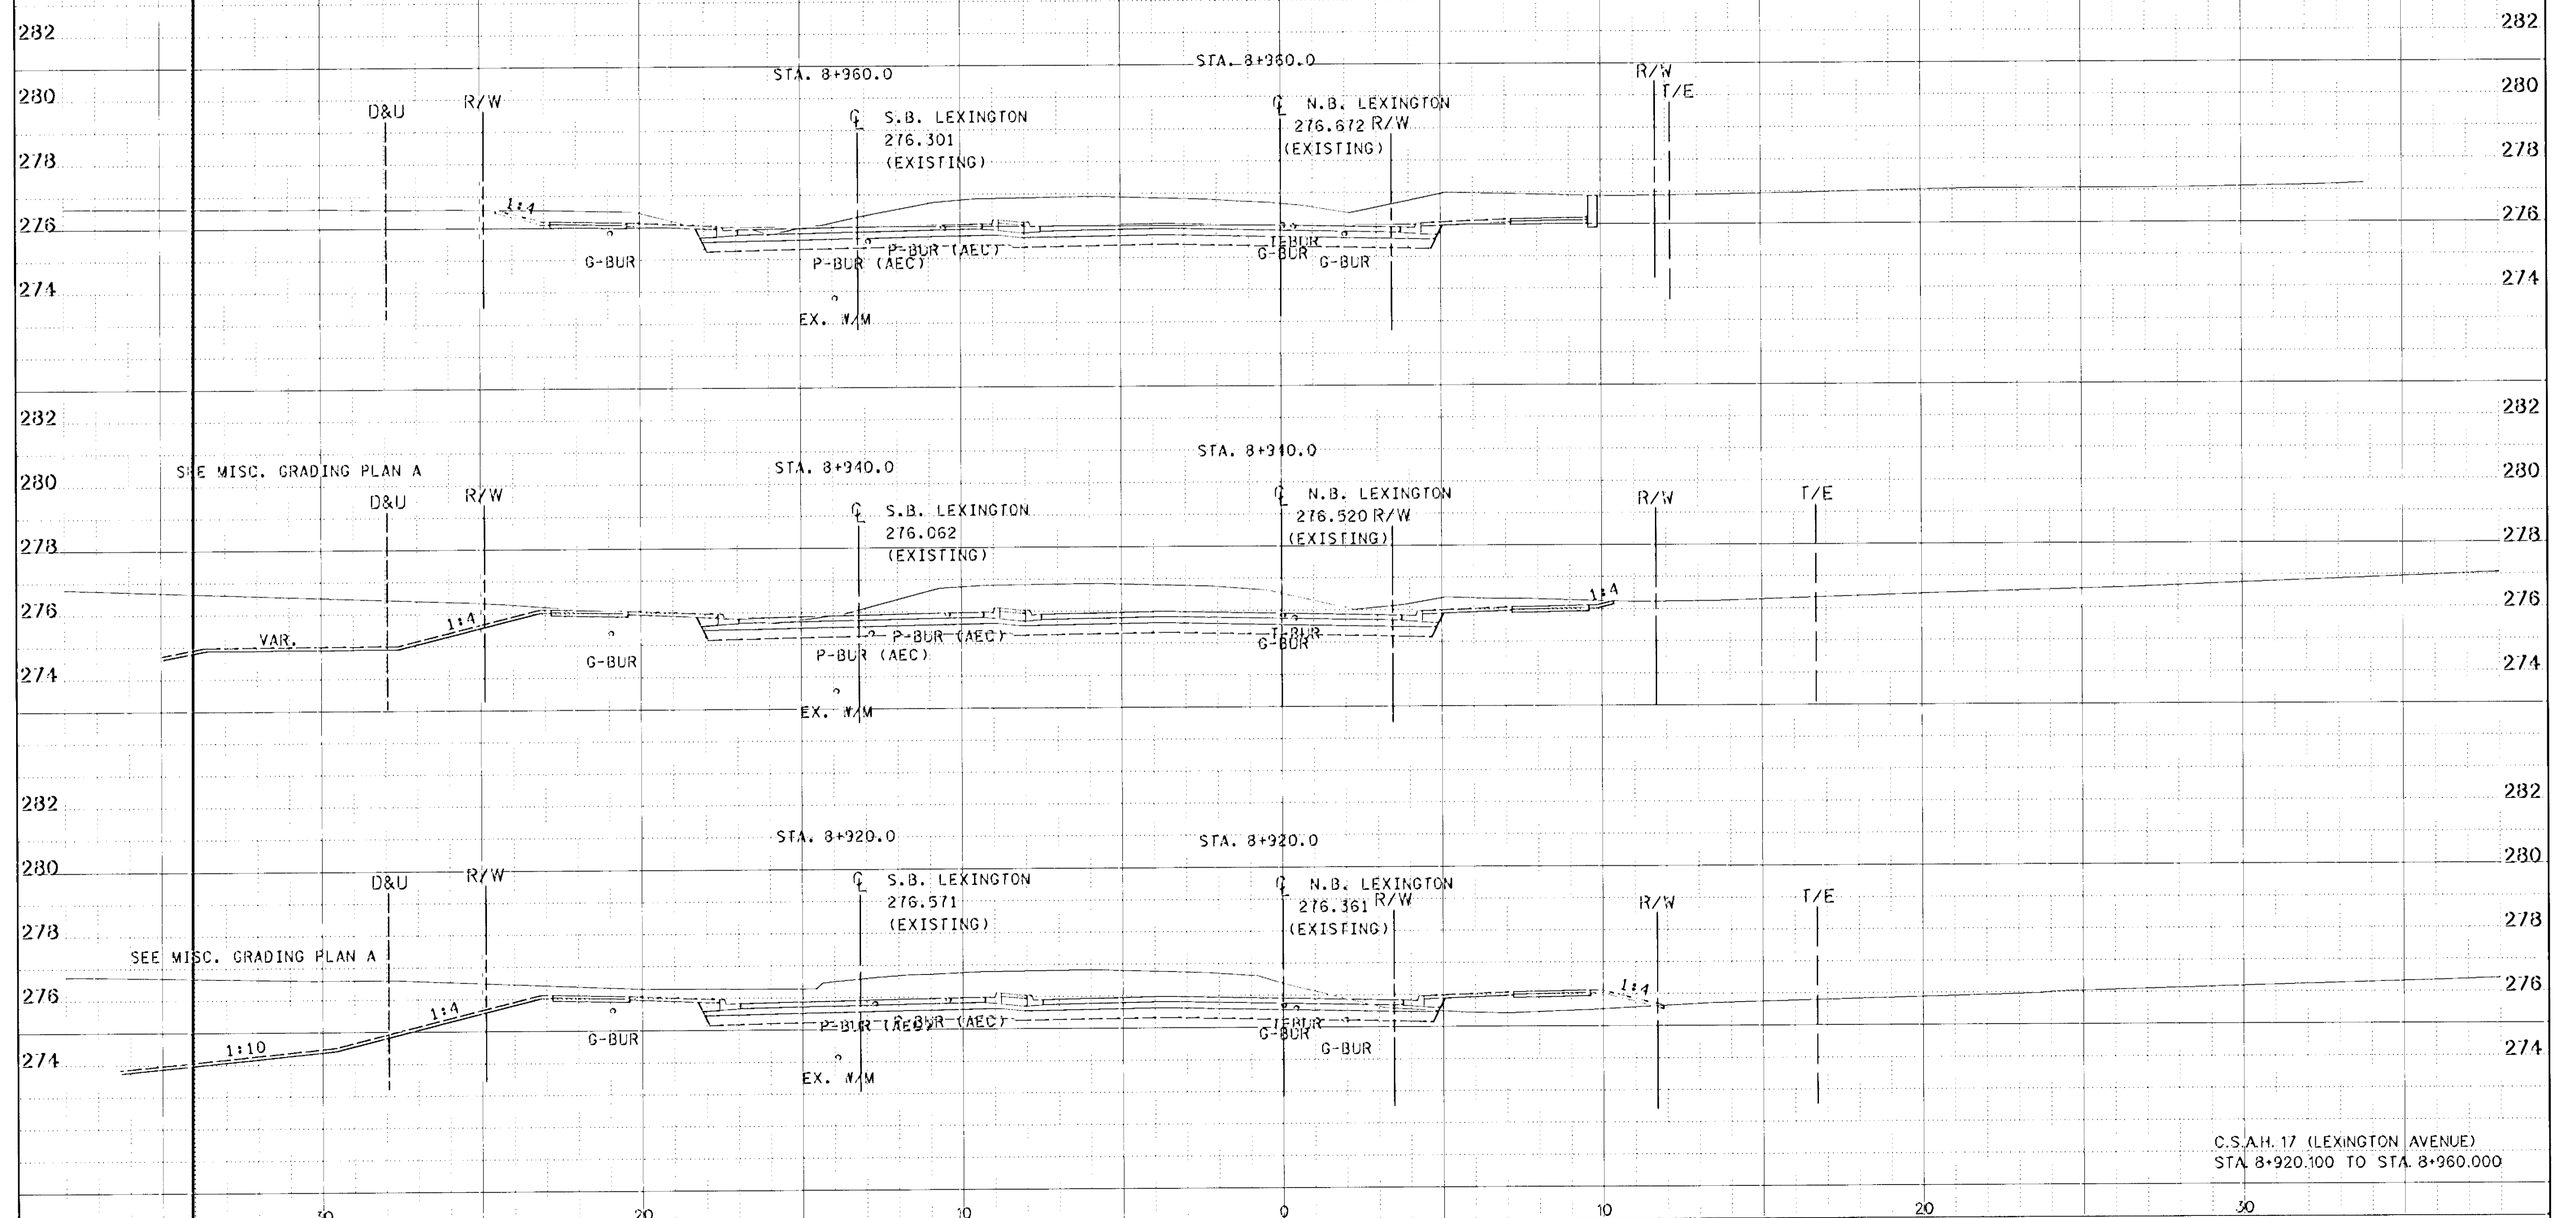


C.S.A.H. 17 (LEXINGTON AVENUE)
STA 8+920.100 TO STA. 8+960.000

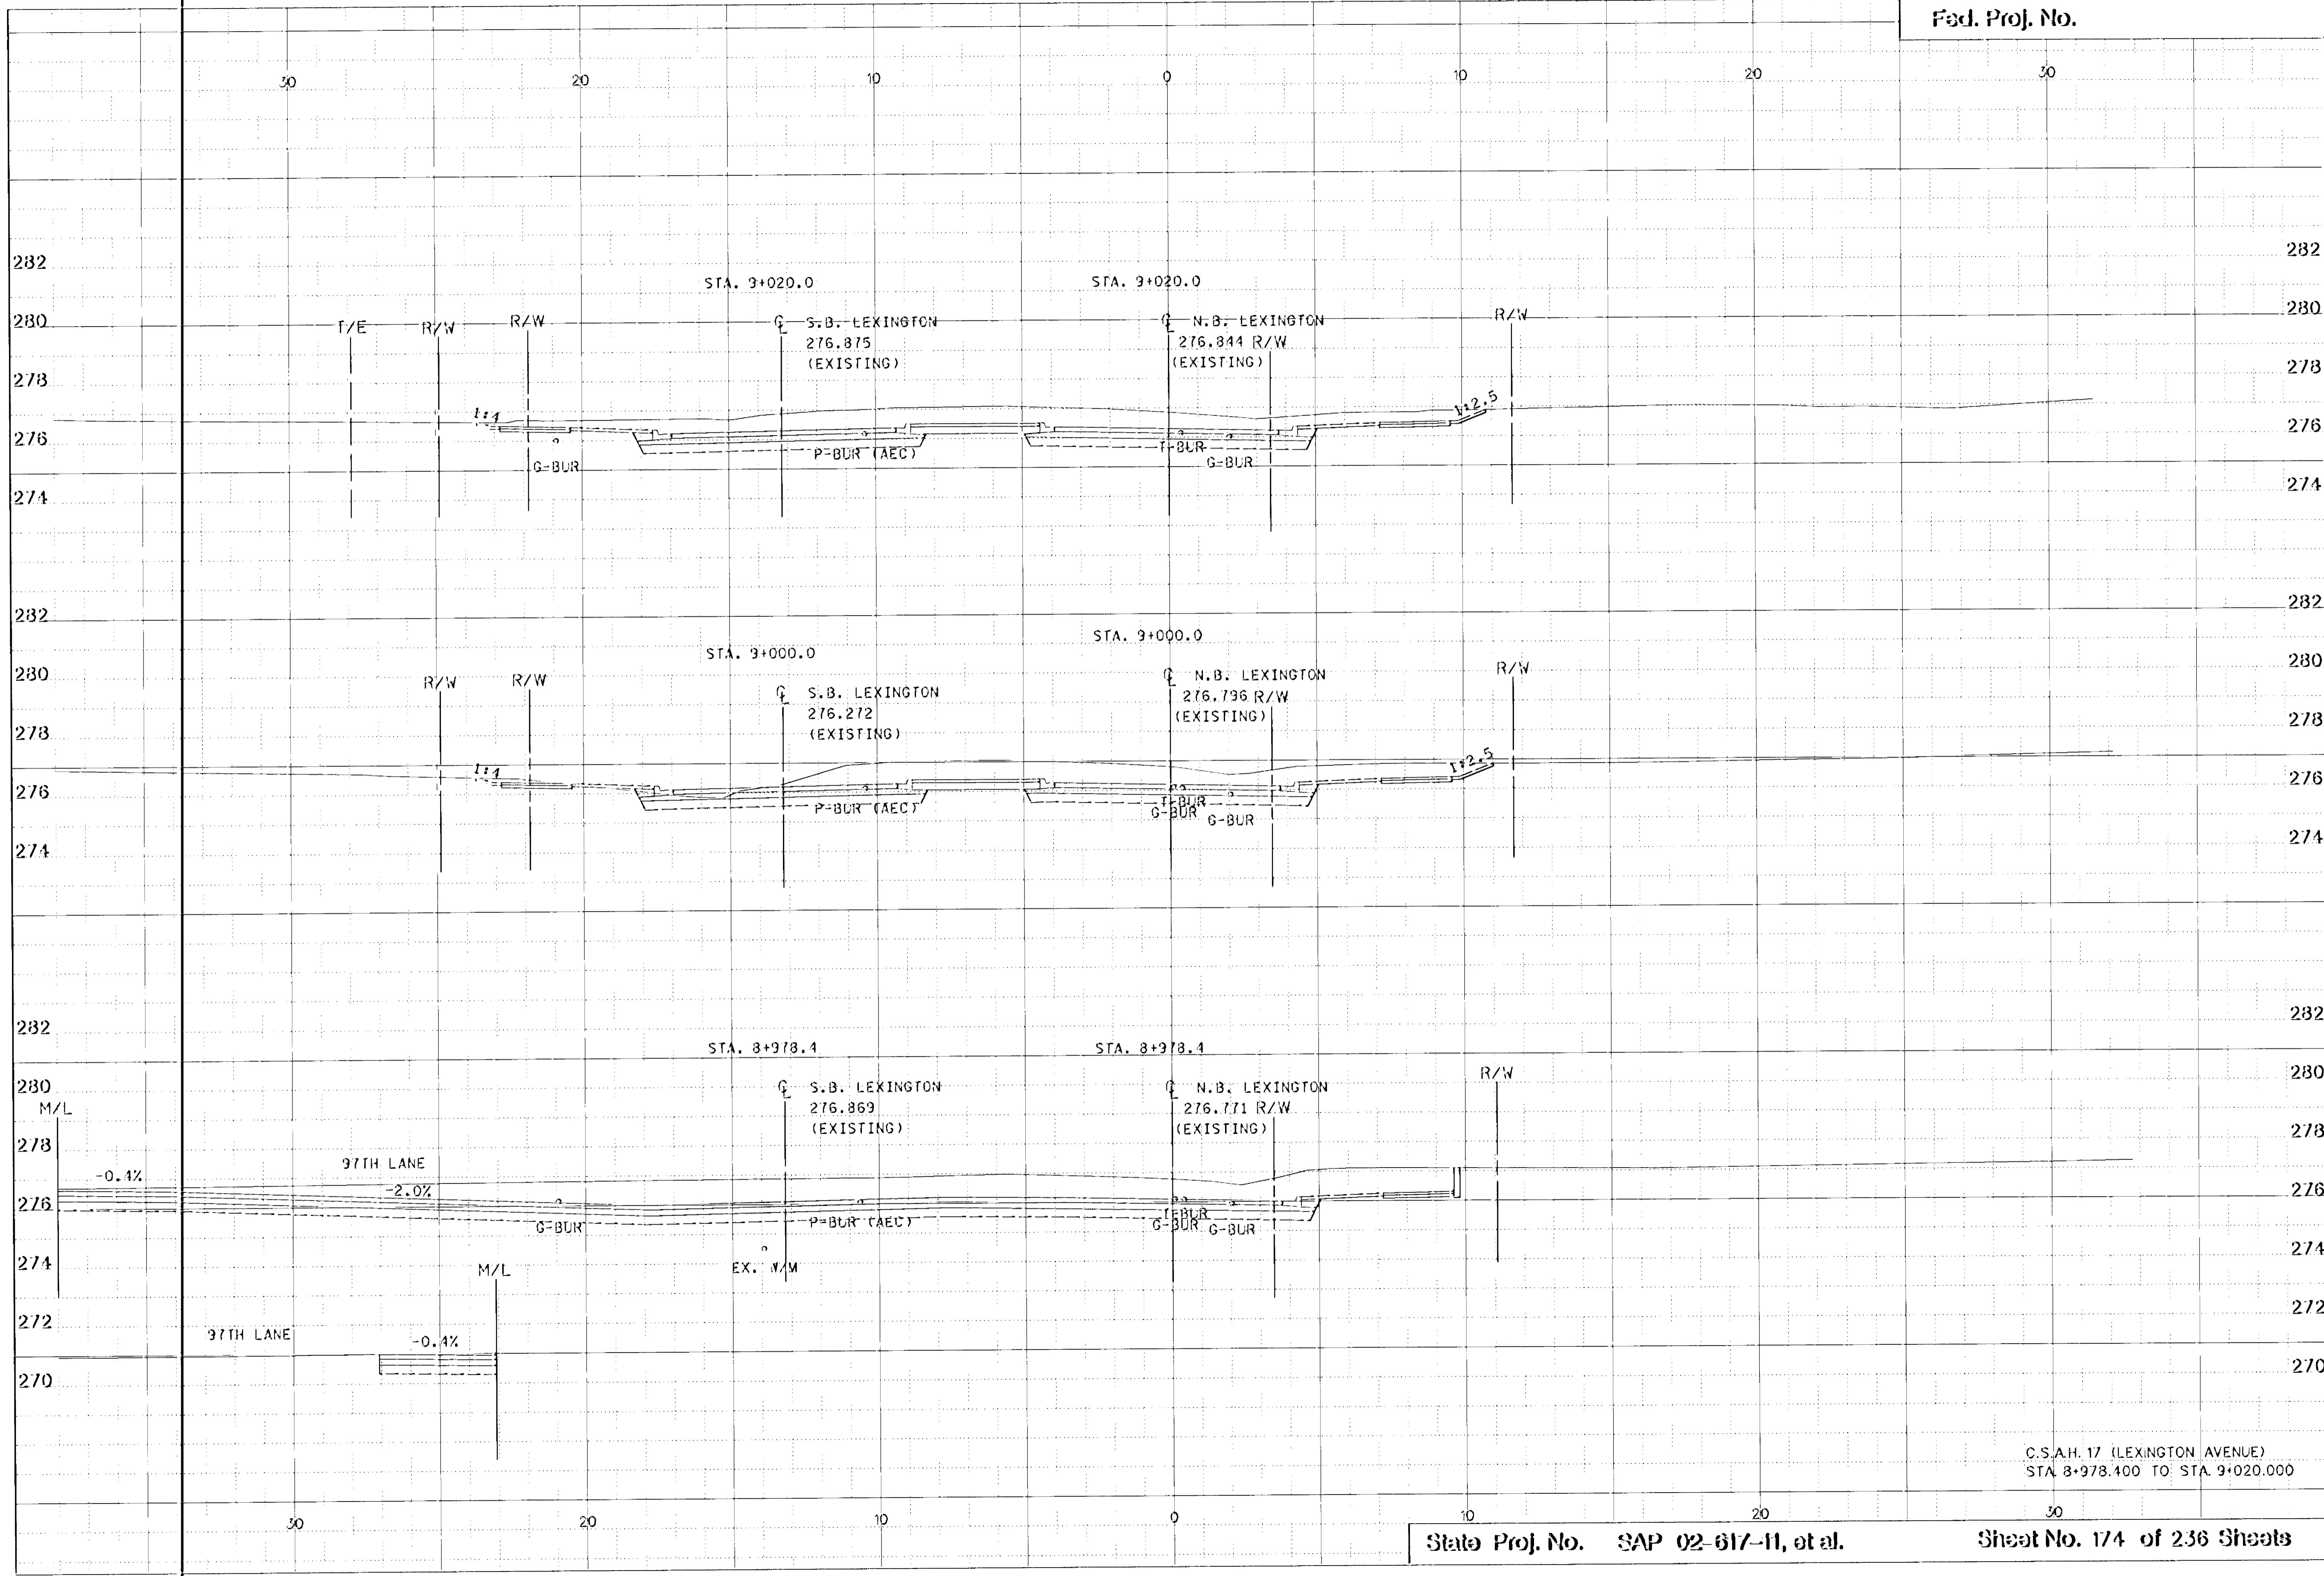


C.S.A.H. 17 (LEXINGTON AVENUE)
STA. 8+978.400 TO STA. 9+020.000

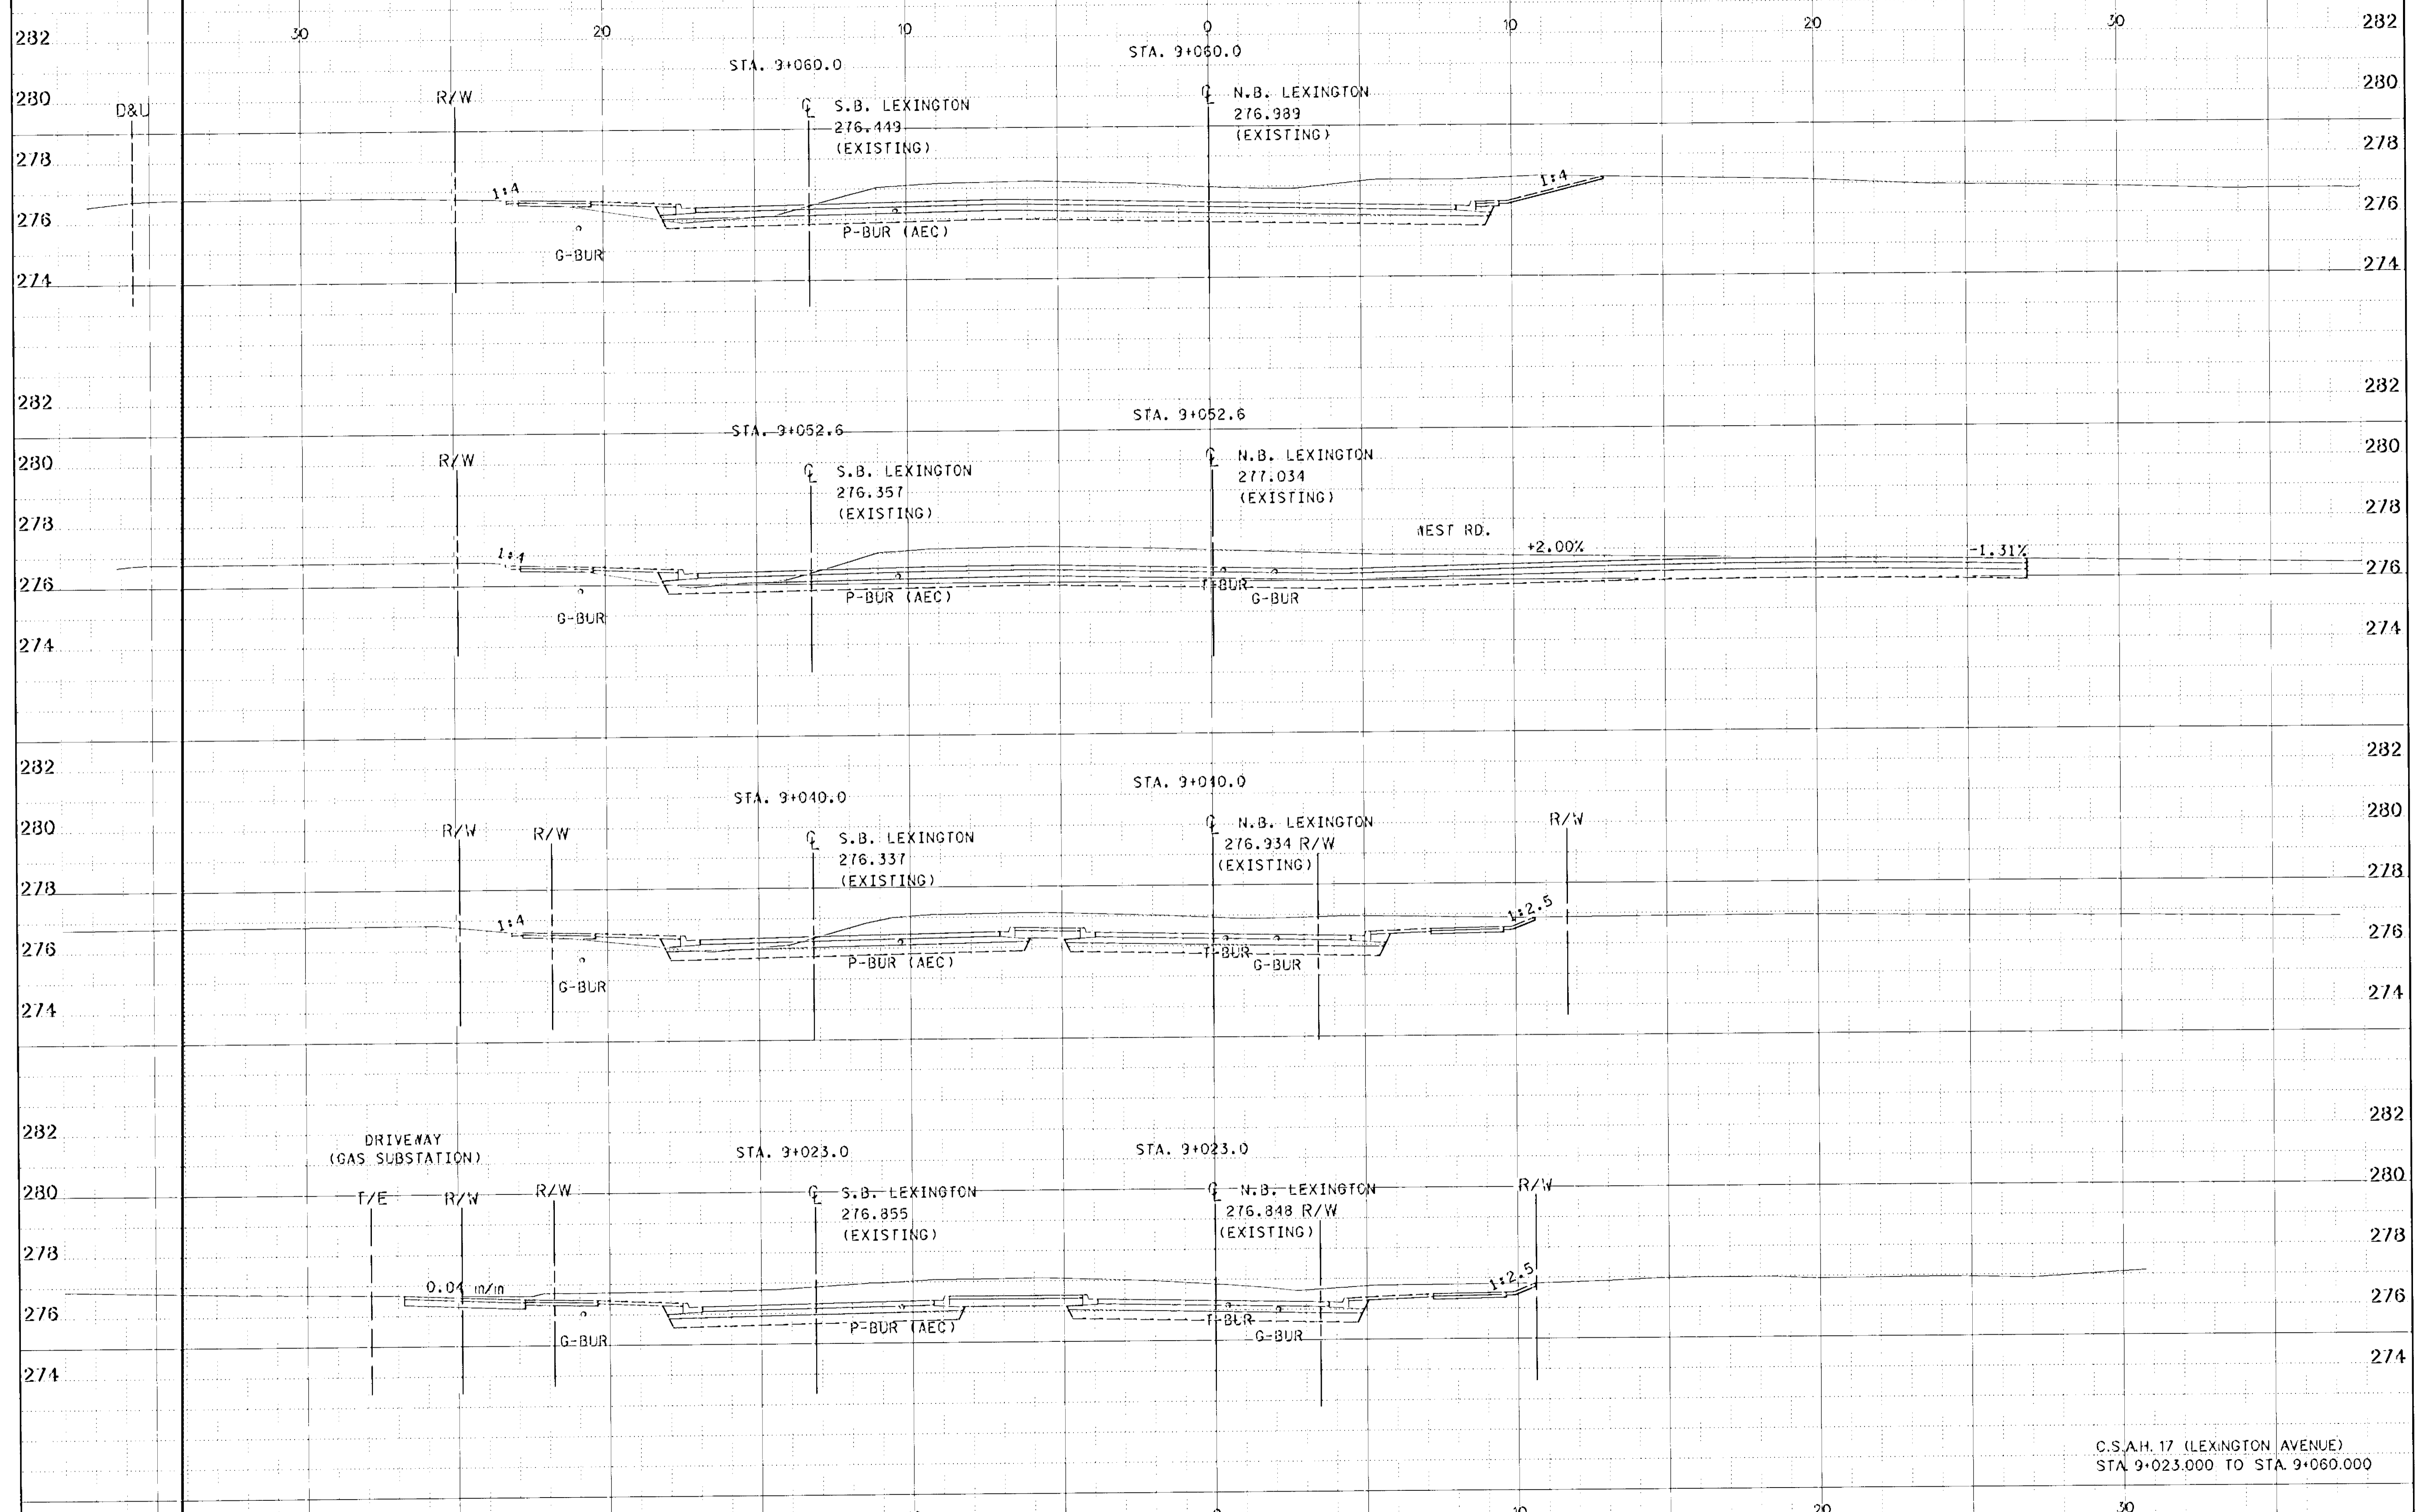


C.S.A.H. 17 (LEXINGTON AVENUE)
STA. 9+023.000 TO STA. 9+060.000

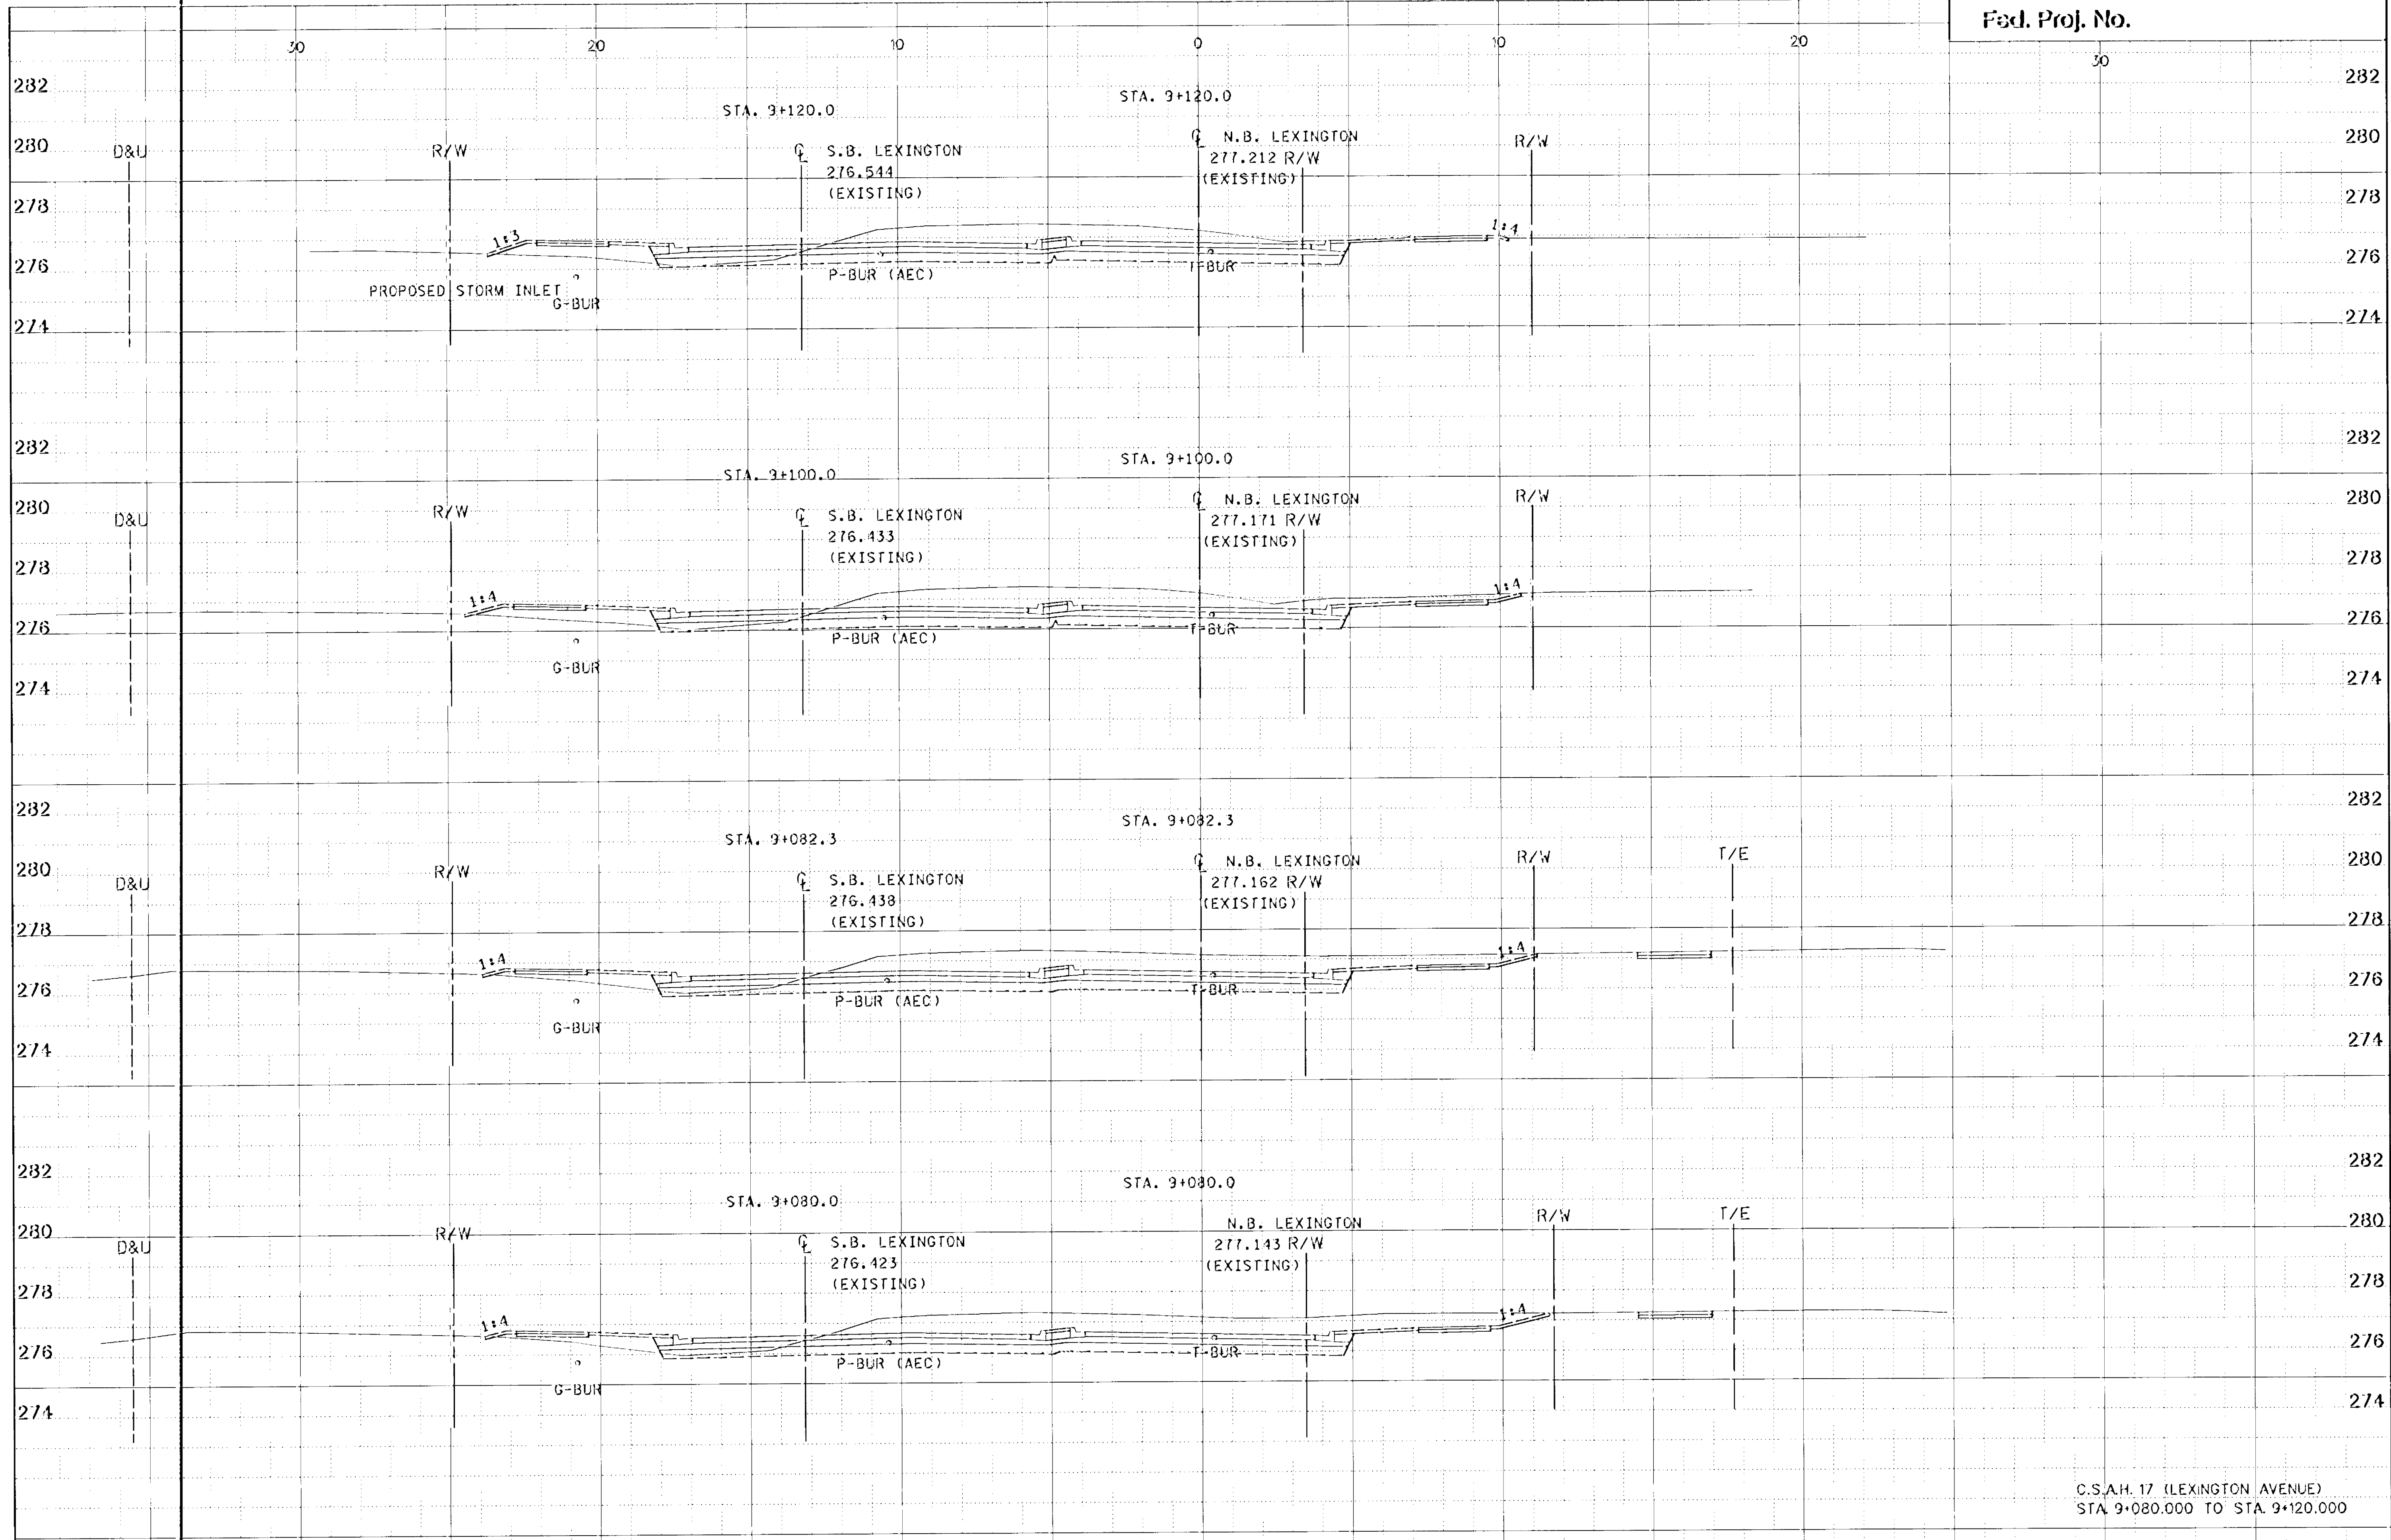

C.S.A.H. 17 (LEXINGTON AVENUE)
STA 9+080.000 TO STA 9+120.000

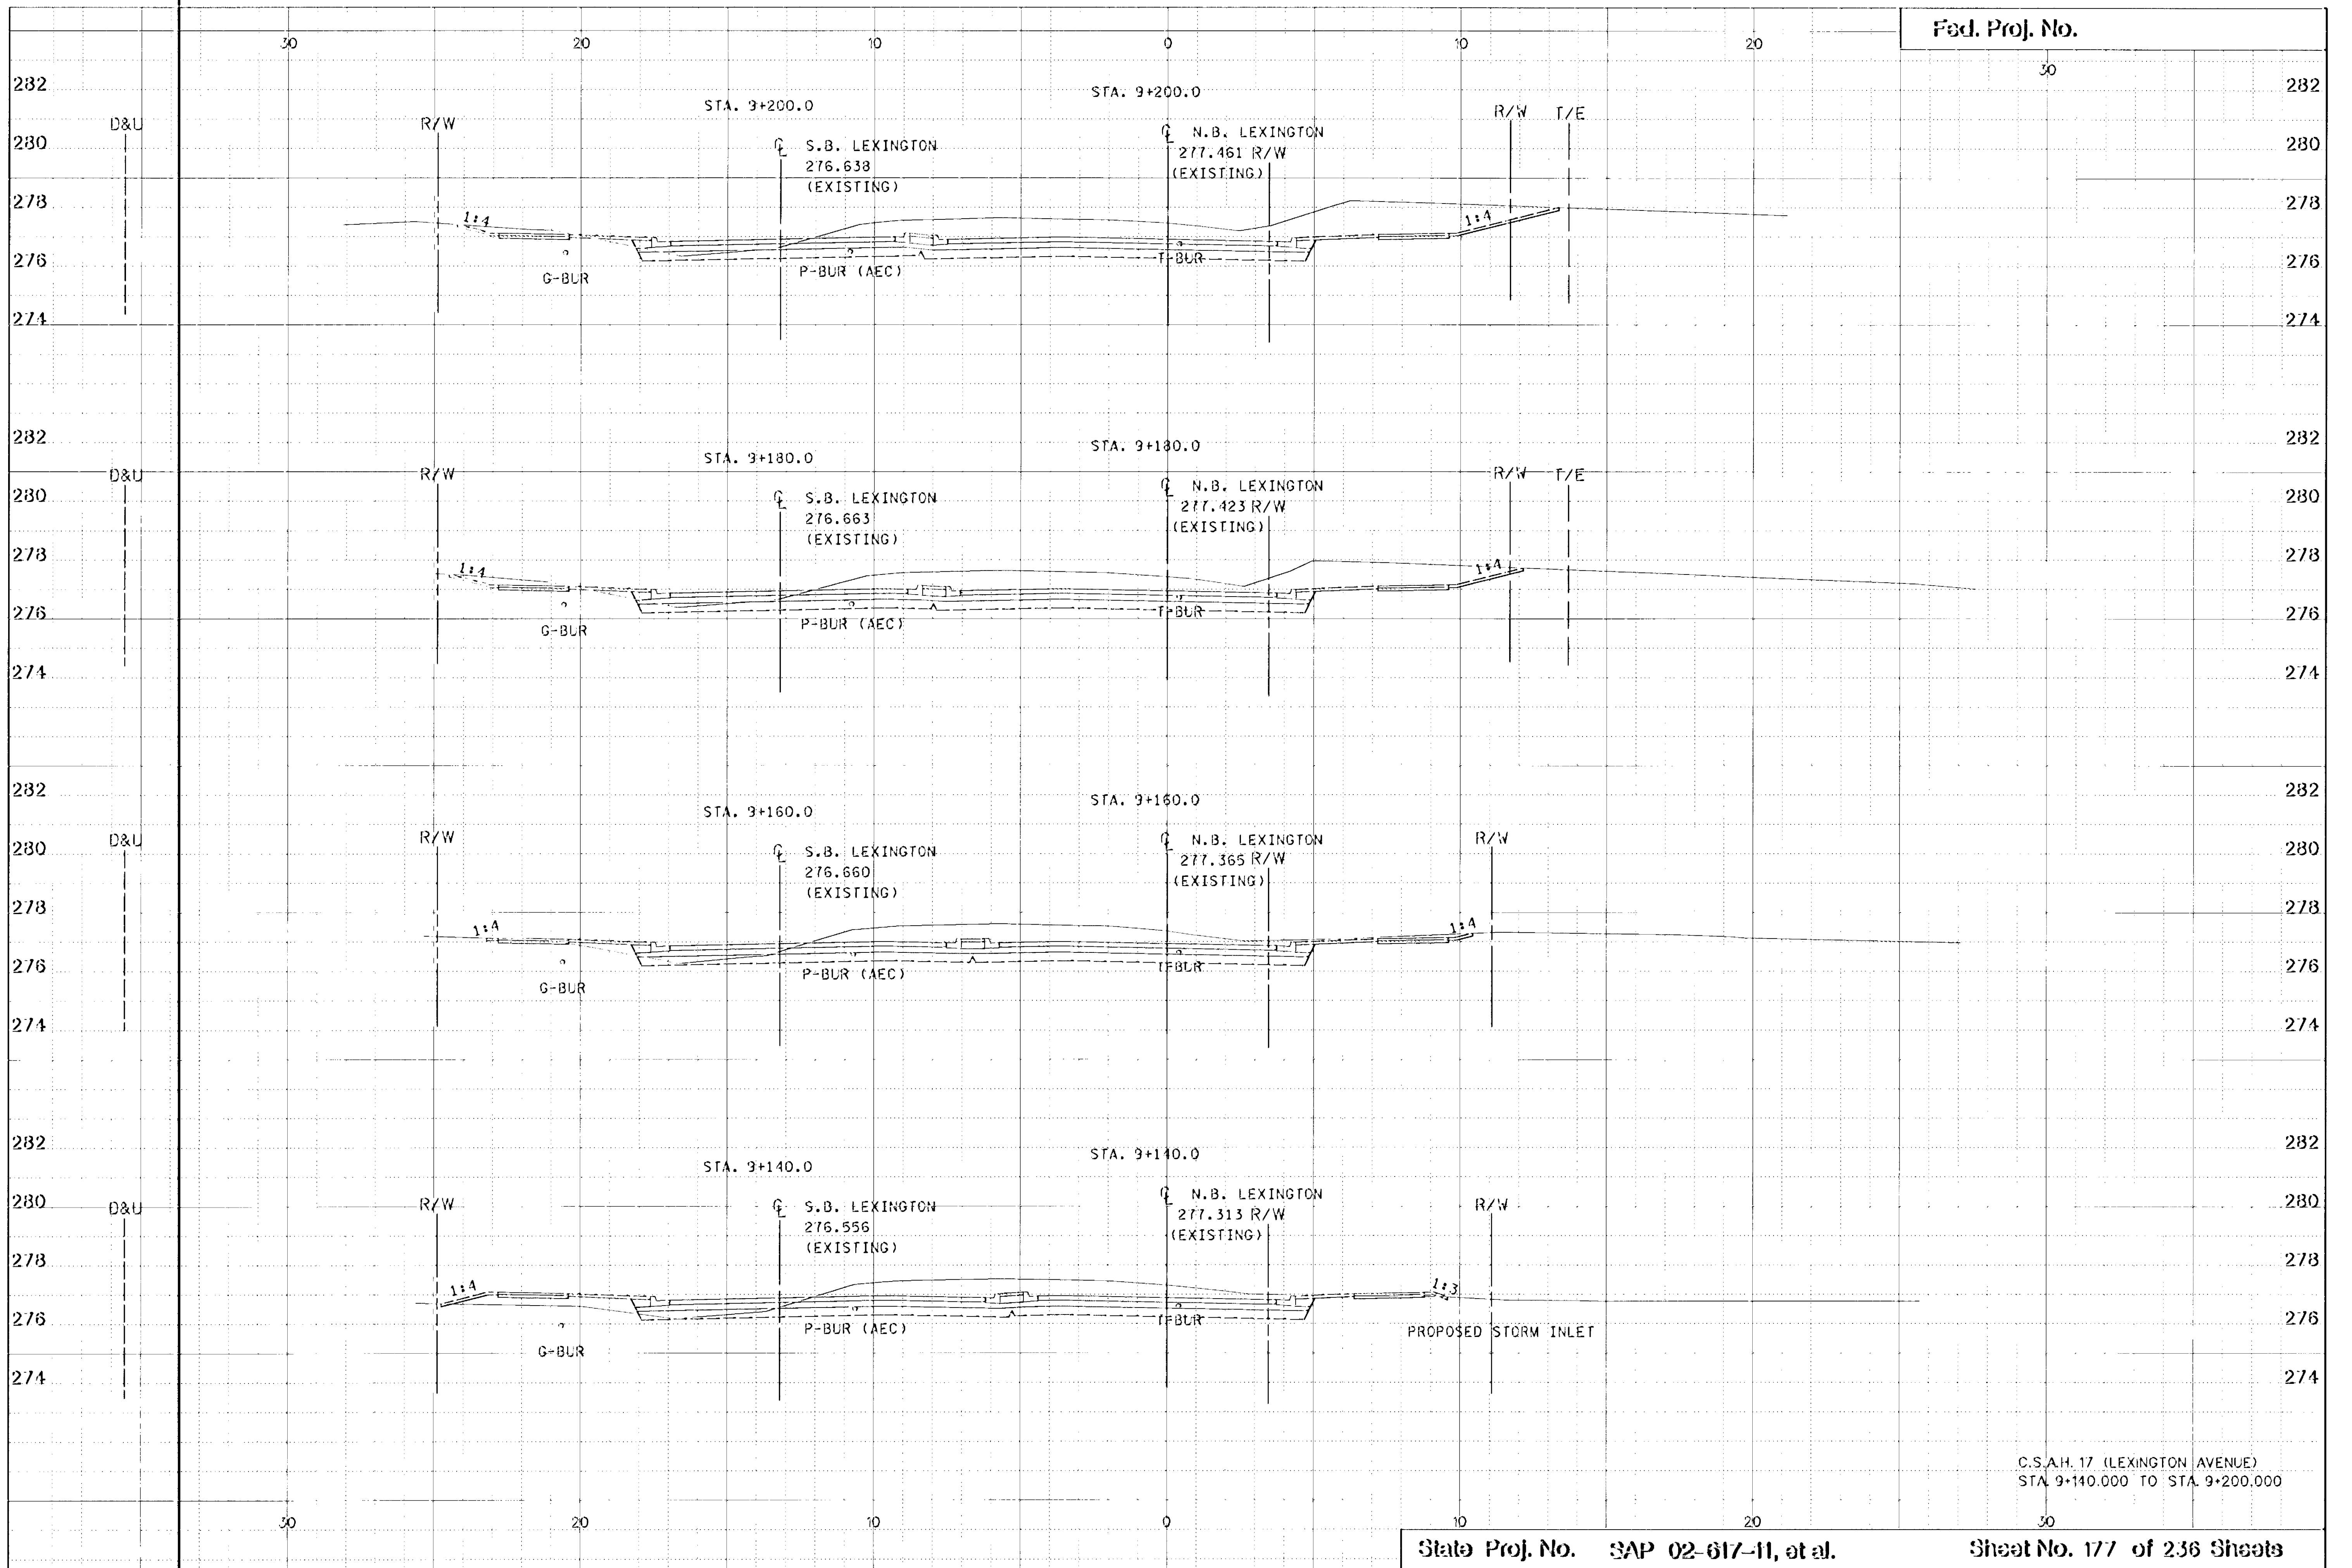


C.S.A.H. 17 (LEXINGTON AVENUE)
STA 9+140.000 TO STA. 9+200.000

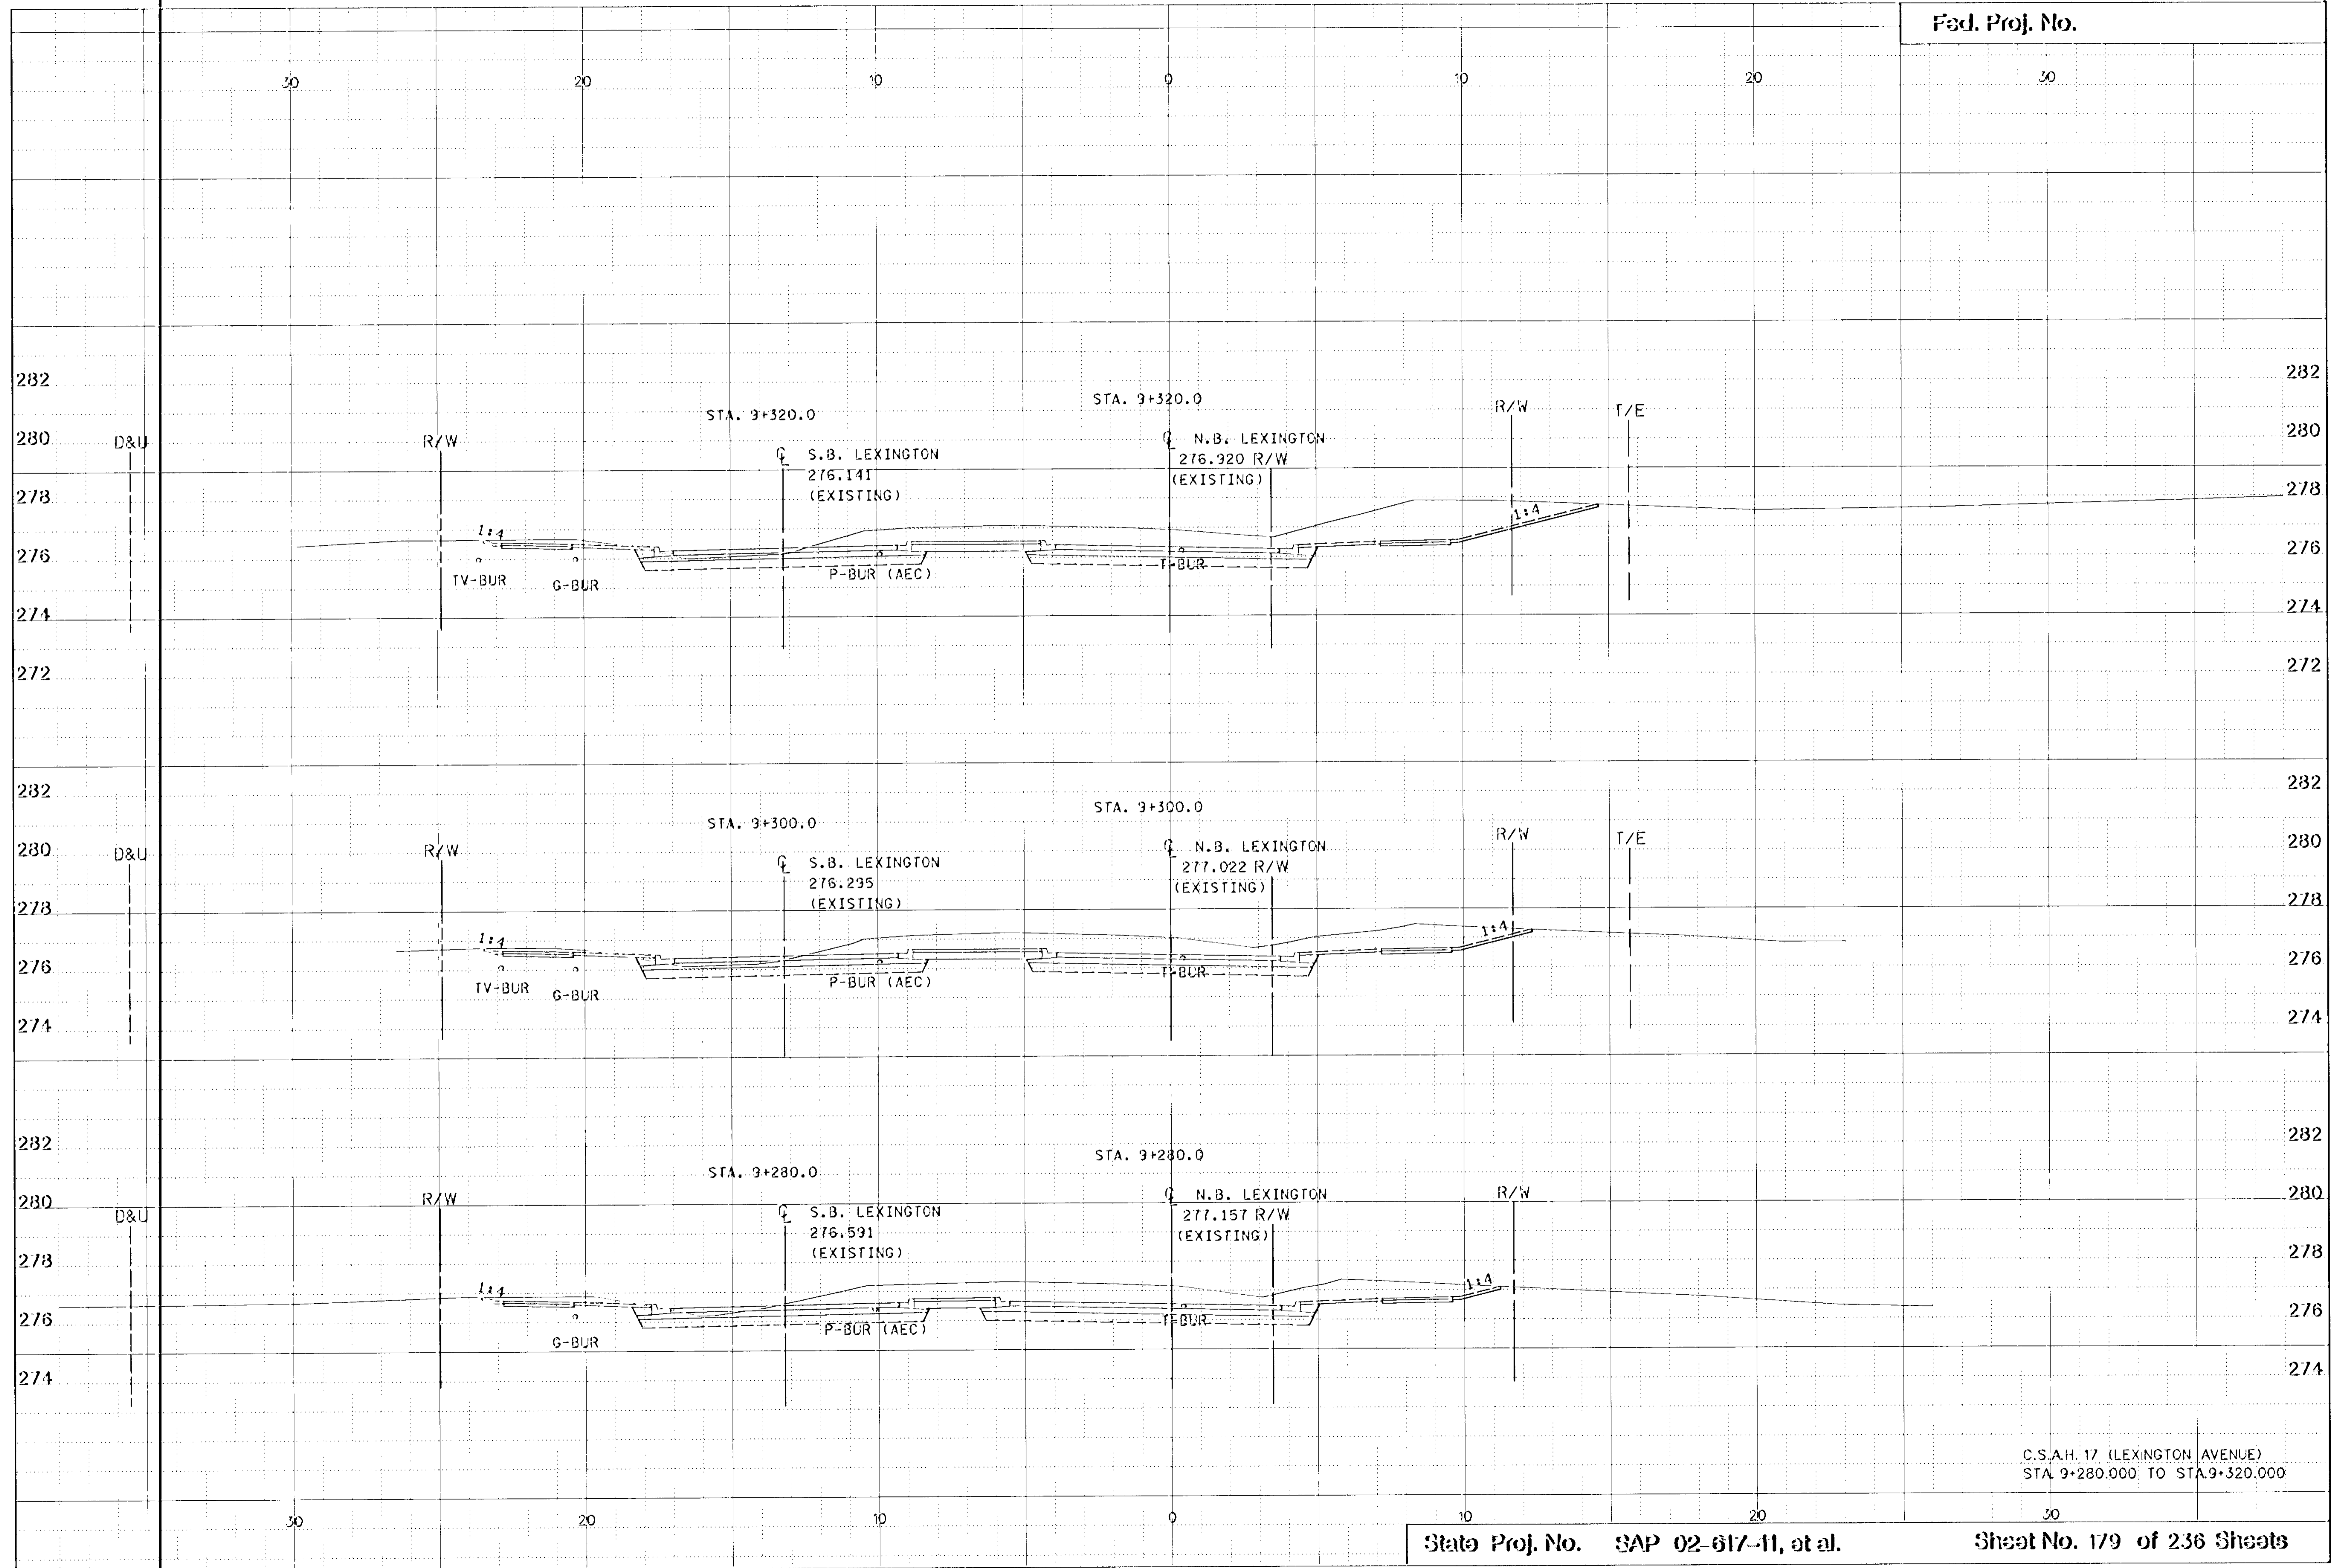


C.S.A.H. 17 (LEXINGTON AVENUE)
STA. 9+280.000 TO STA. 9+320.000


282 30 20 10 0 10 20 30 282

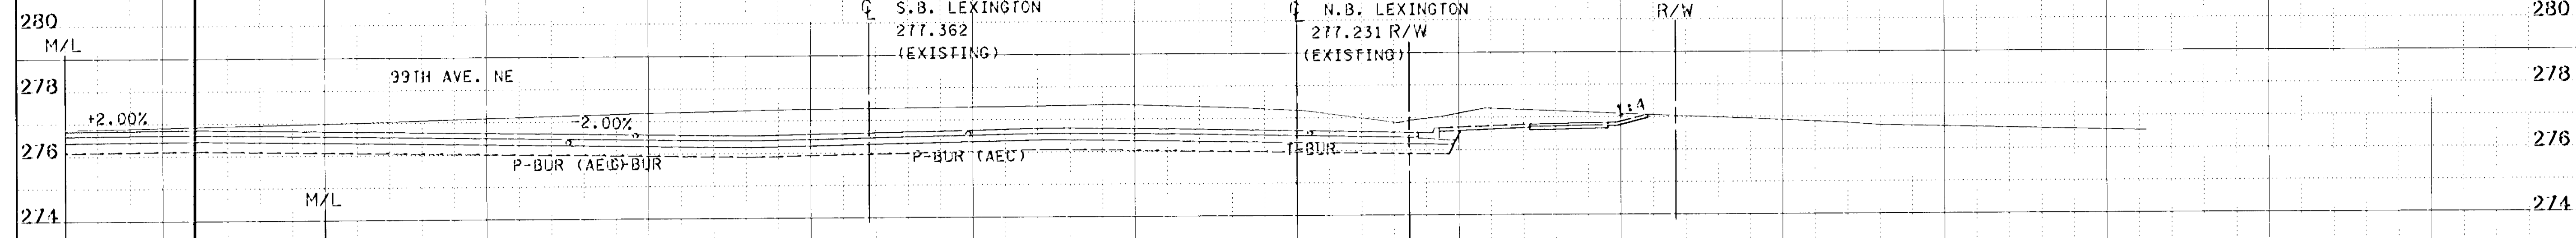


282 30 20 10 0 10 20 30 282

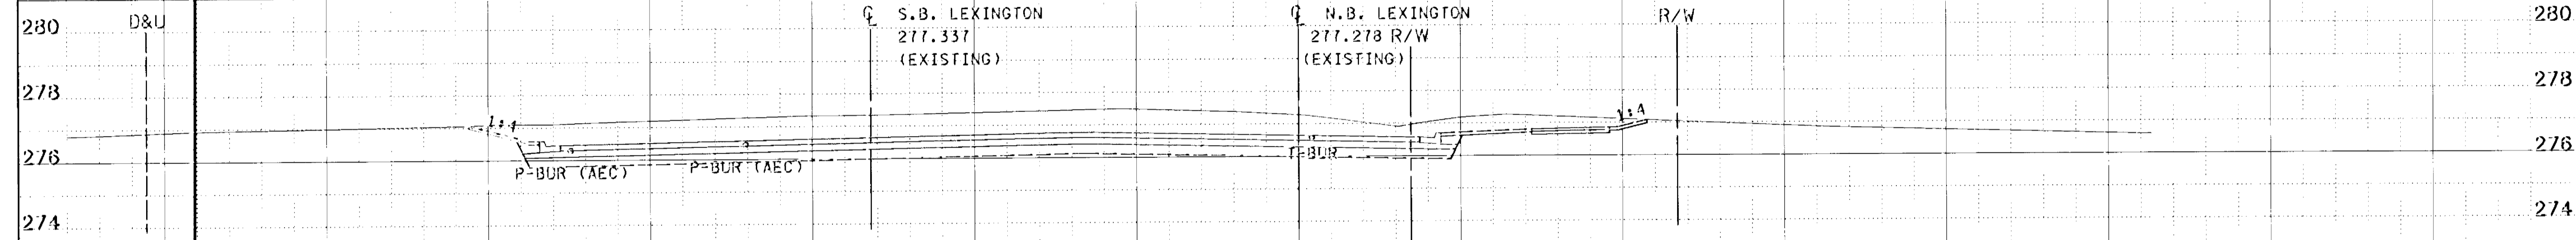


282 30 20 10 0 10 20 30 282

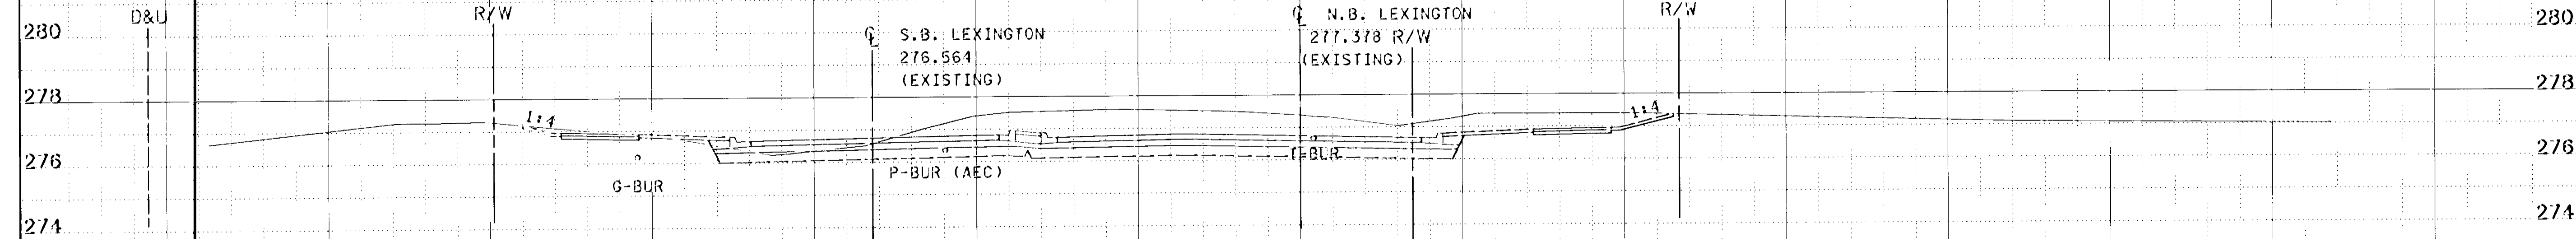


282 30 20 10 0 10 20 30 282

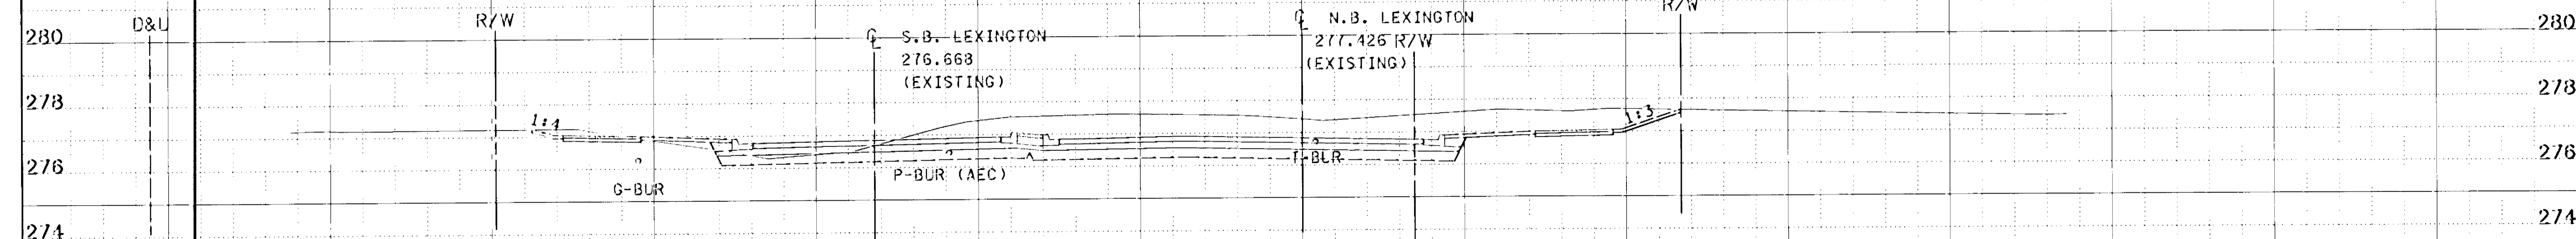


C.S.A.H. 17 (LEXINGTON AVENUE)
STA. 9+220.000 TO STA. 9+265.900

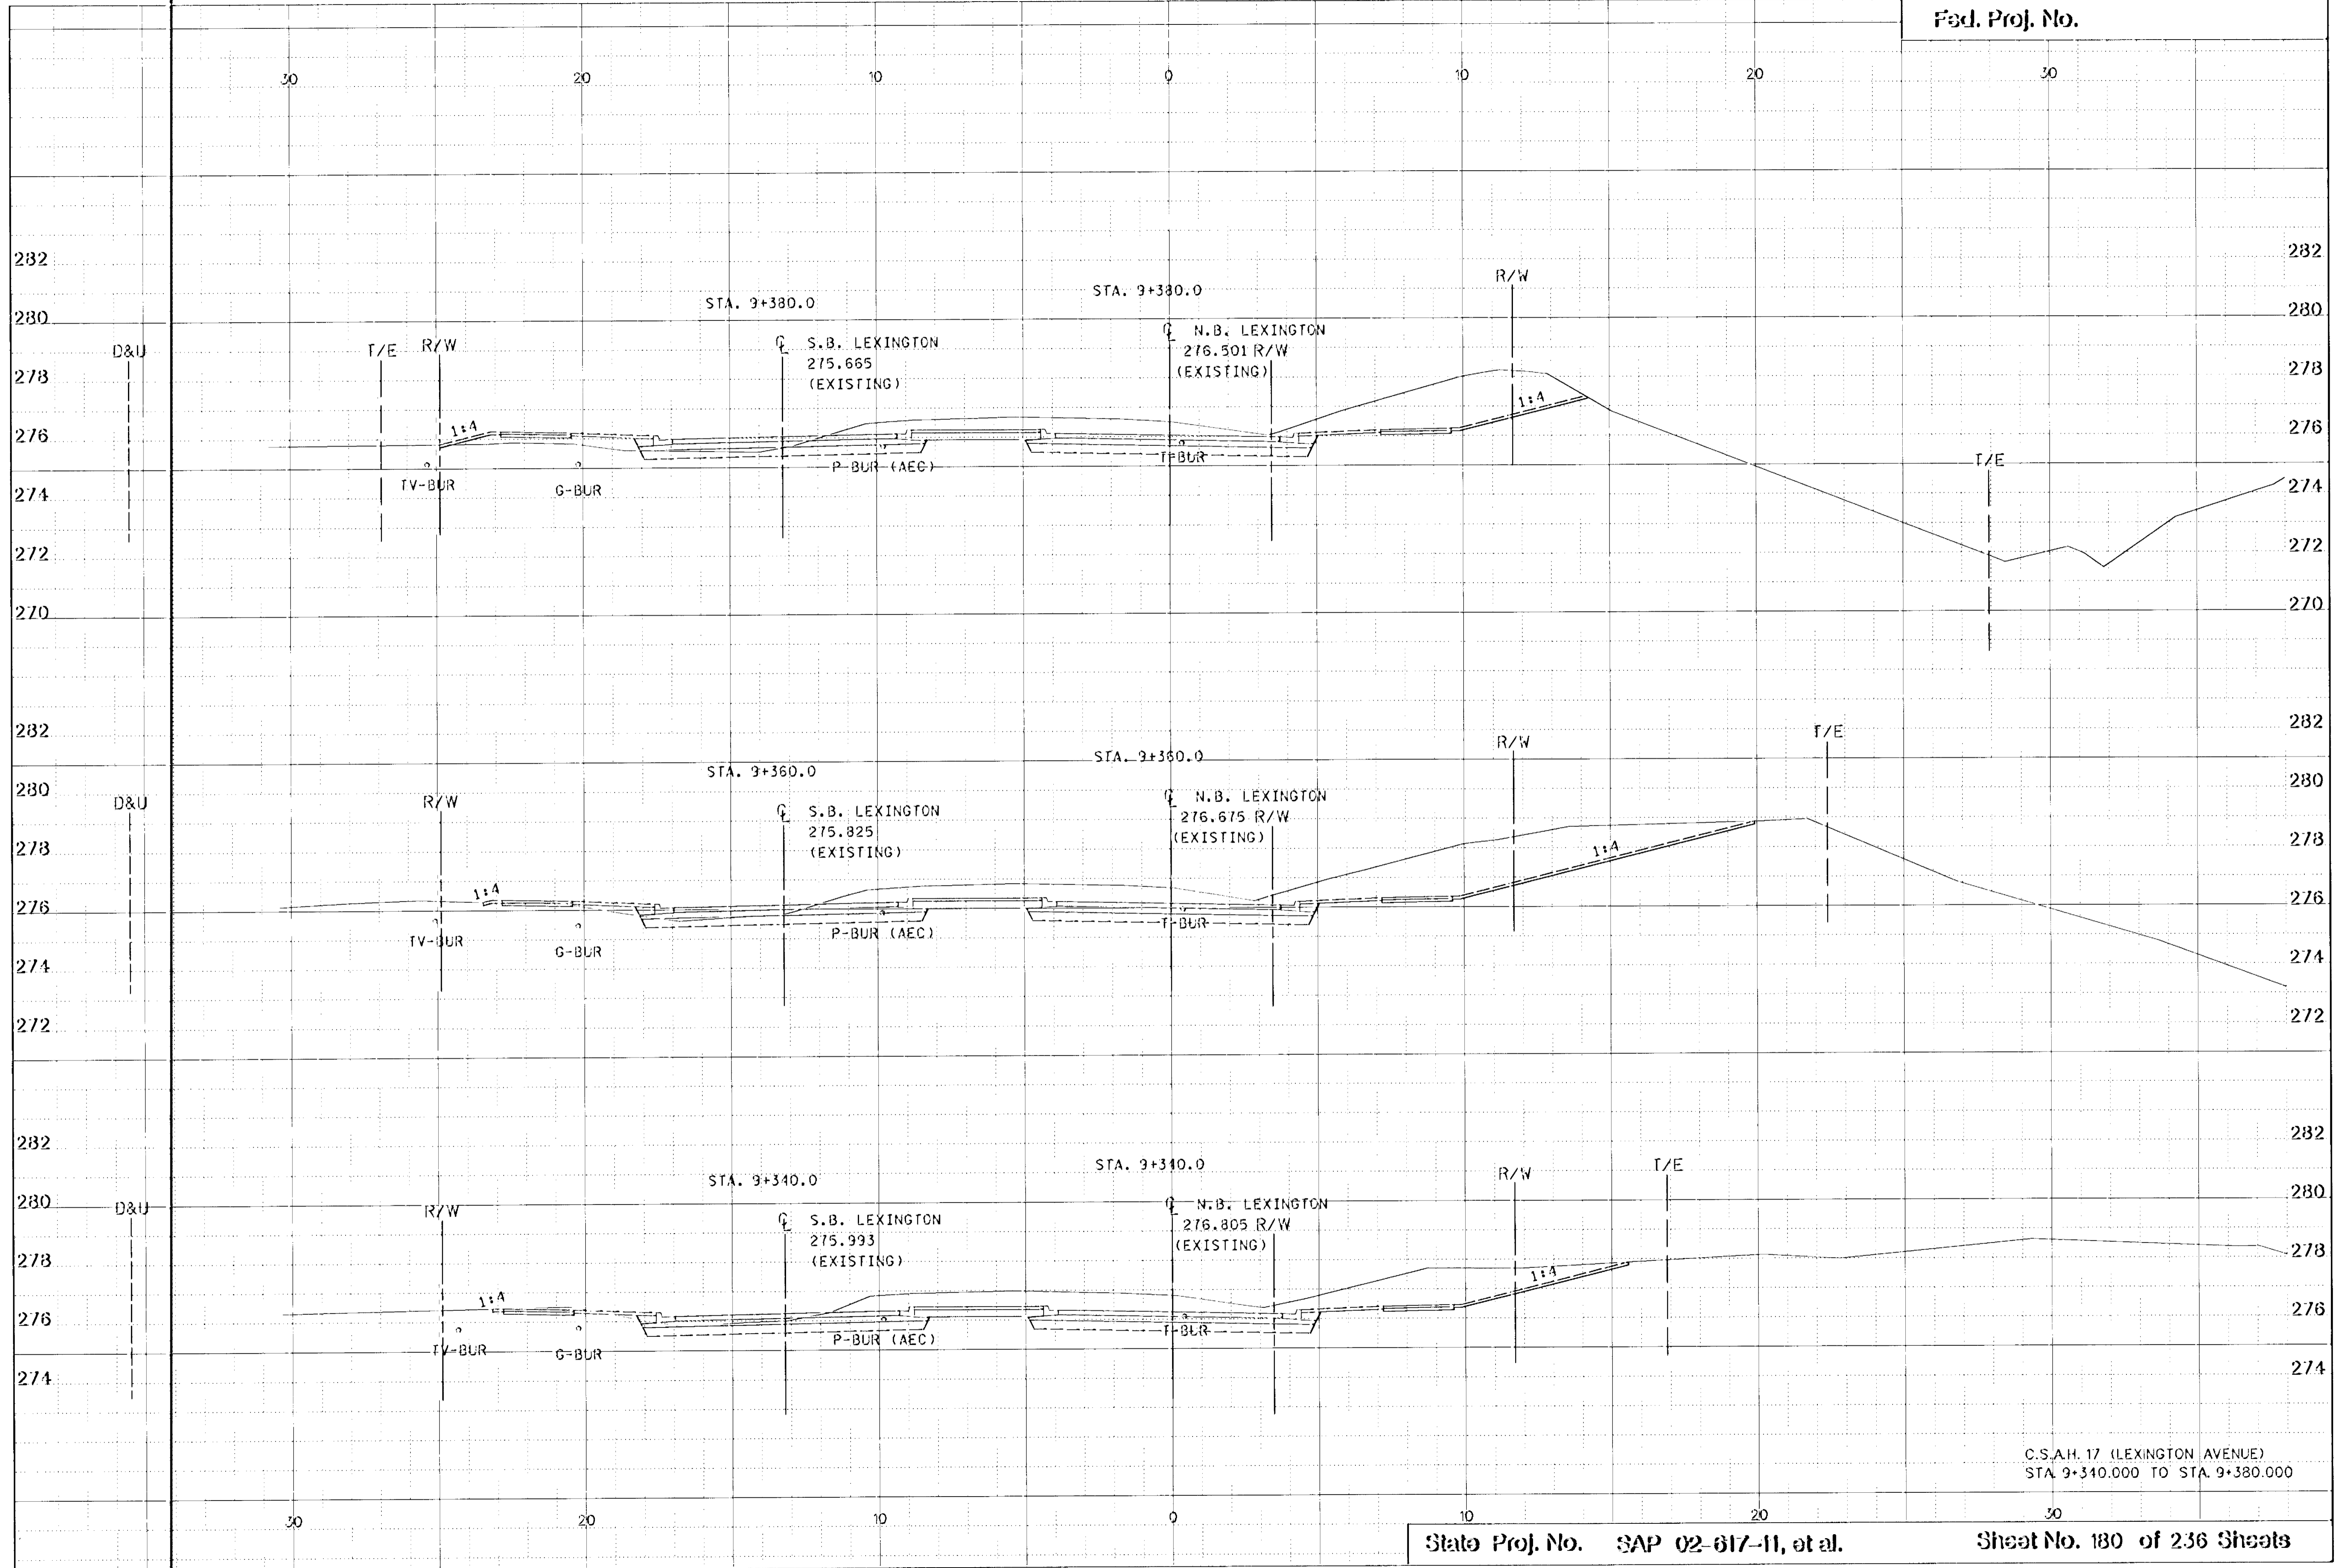


C.S.A.H. 17 (LEXINGTON AVENUE)
STA 9+340.000 TO STA 9+380.000

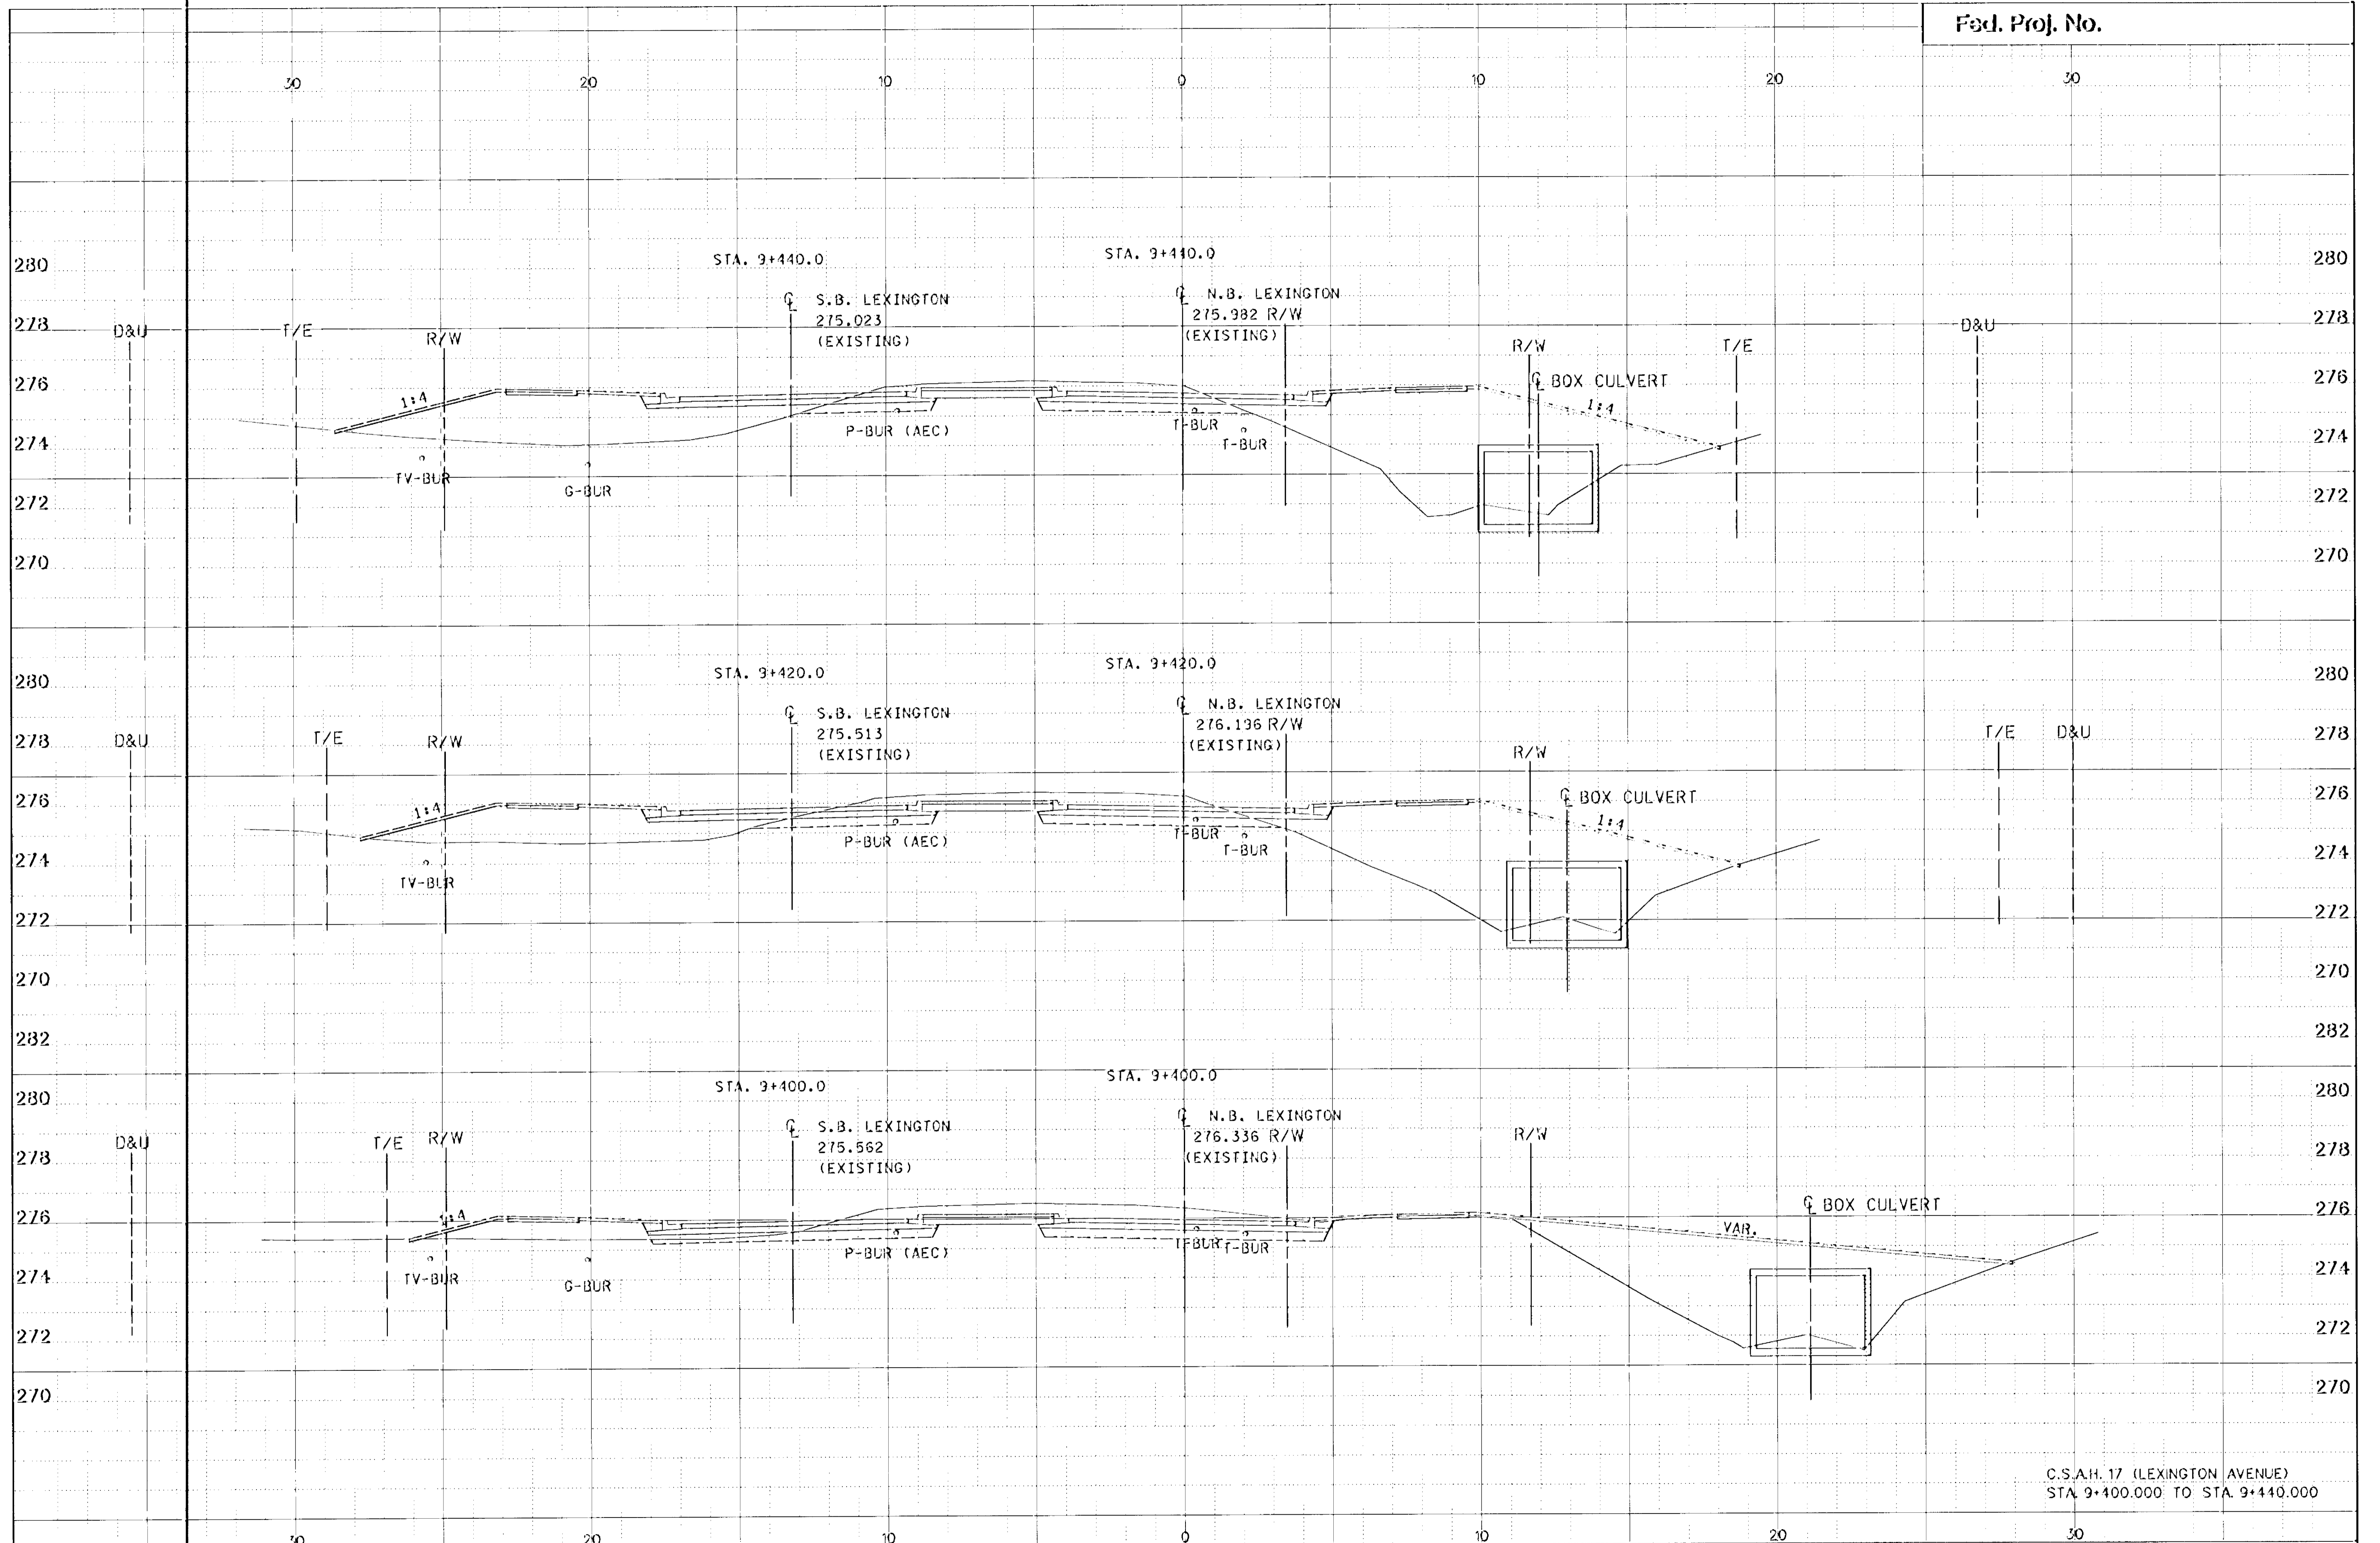


C.S.A.H. 17 (LEXINGTON AVENUE)
STA. 9+400.000 TO STA. 9+440.000

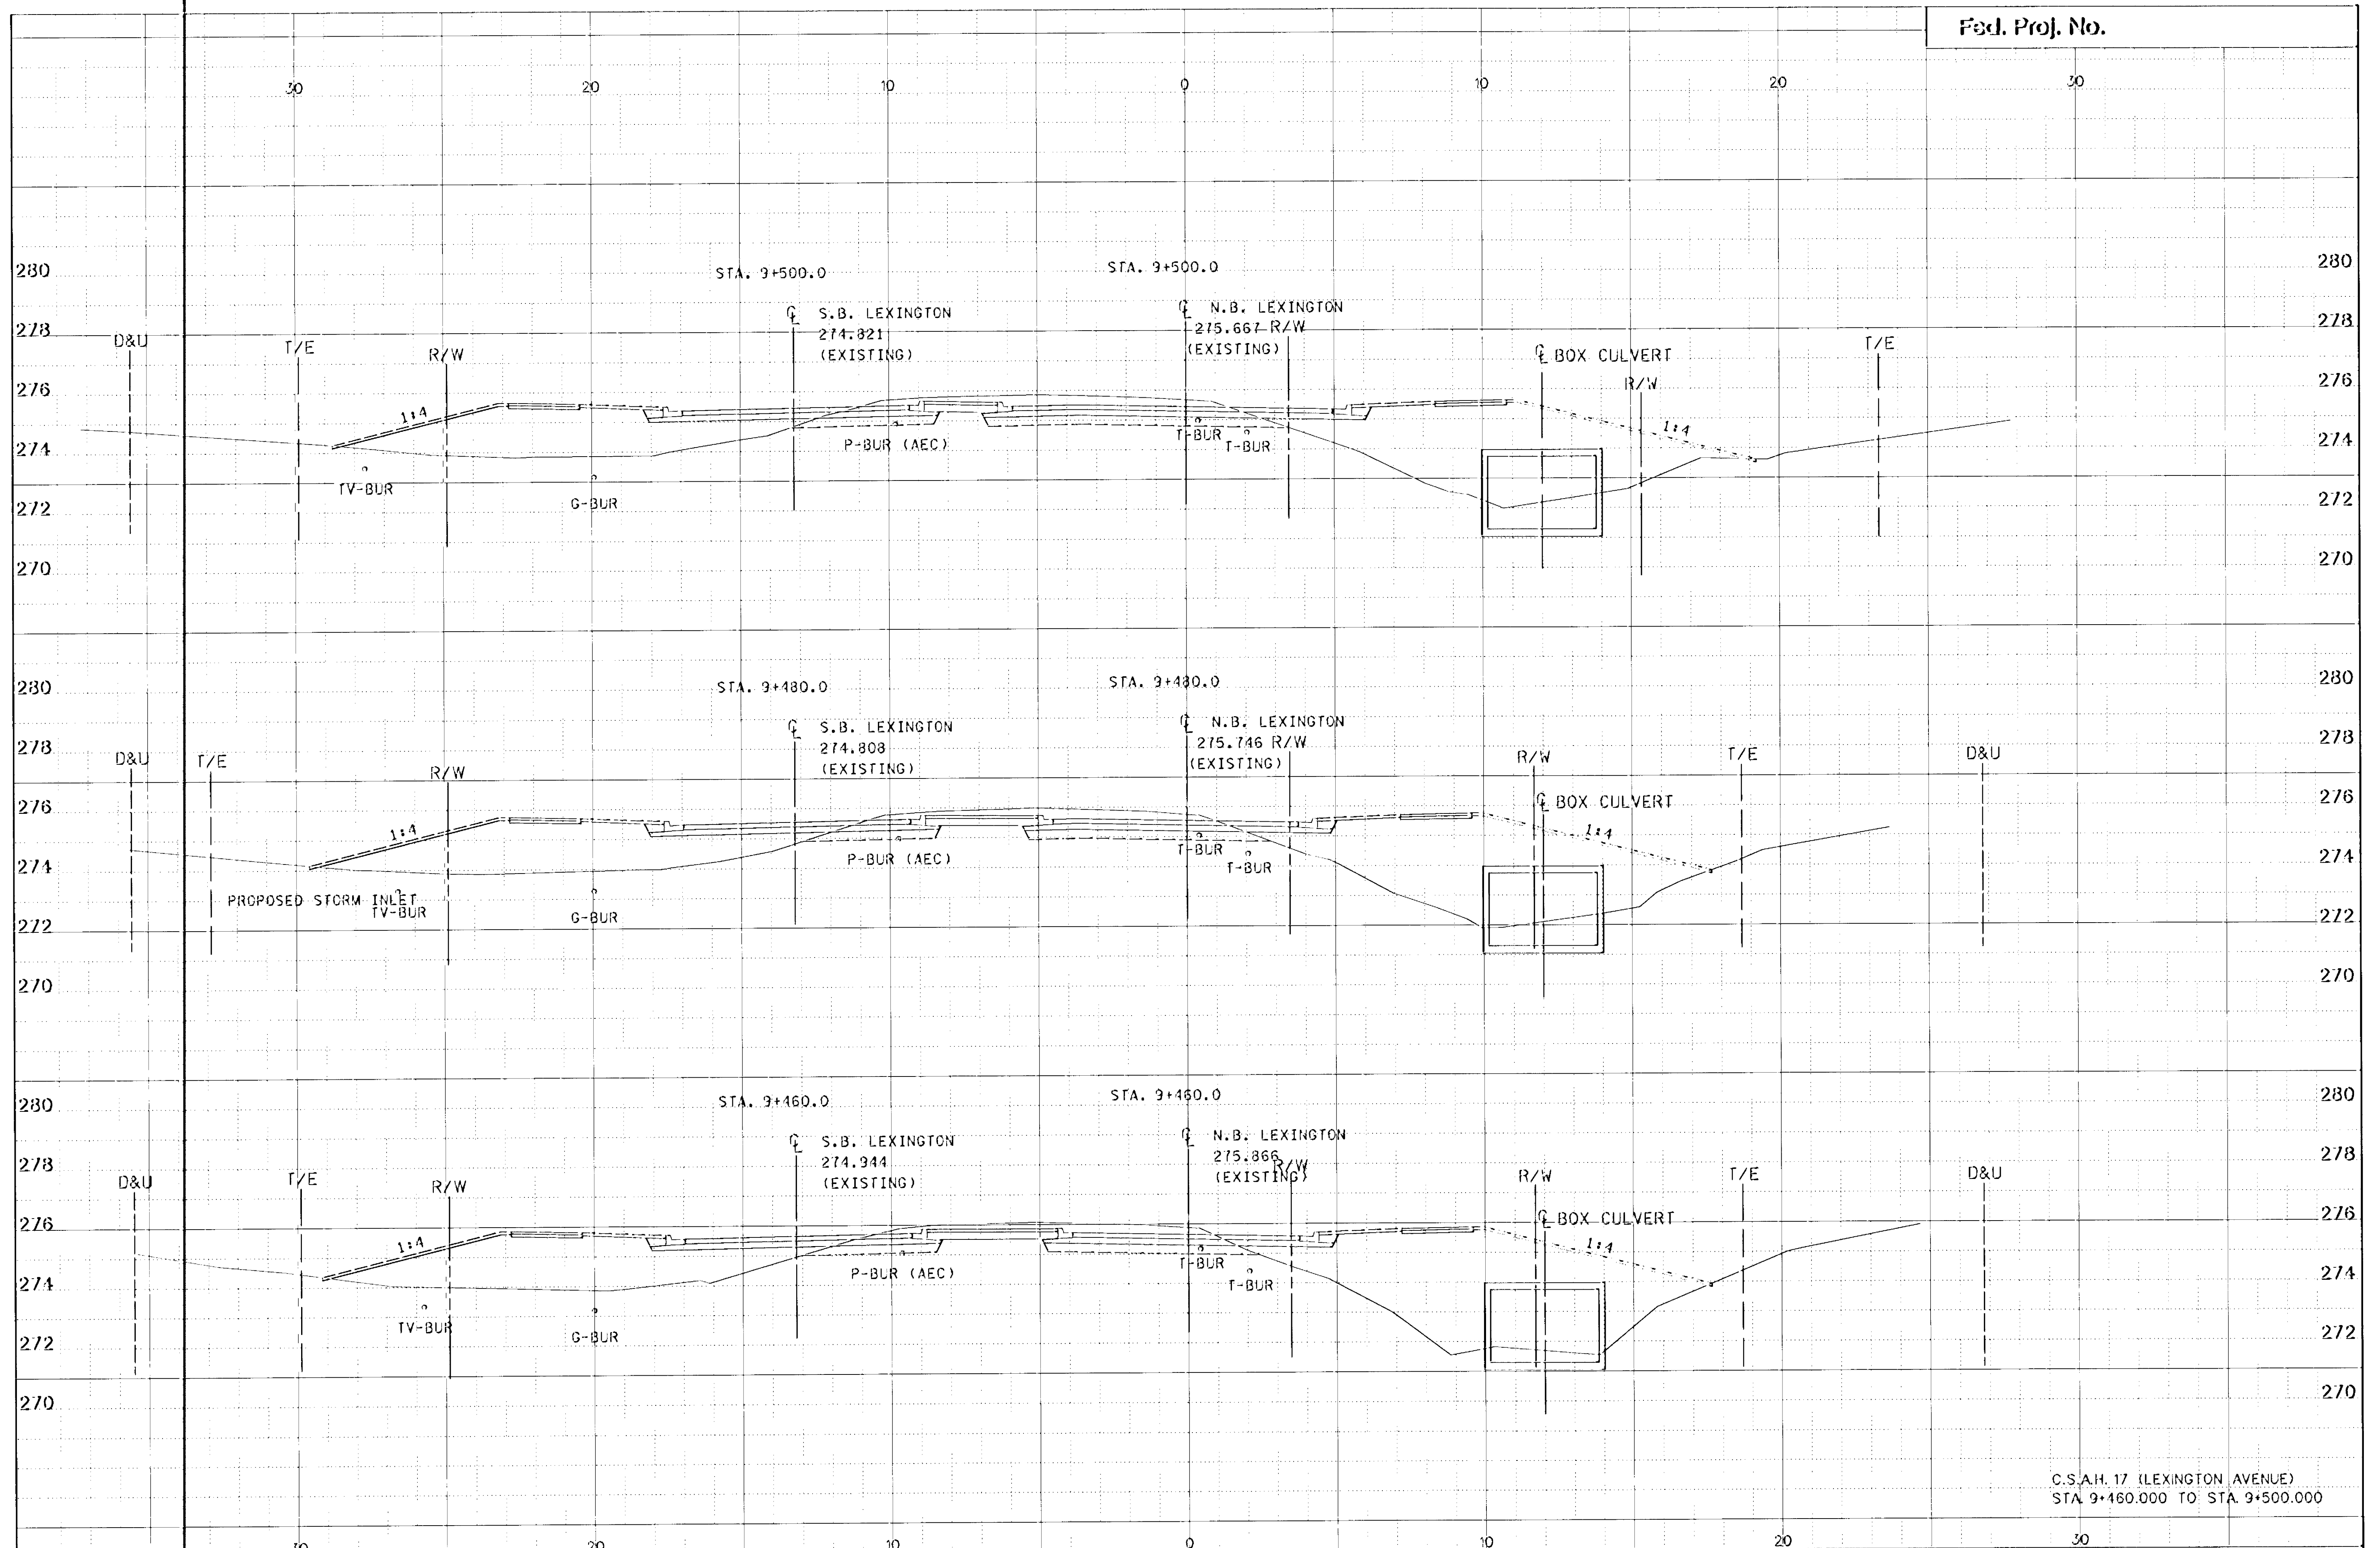




C.S.A.H. 17 (LEXINGTON AVENUE)
STA 9+460.000 TO STA. 9+500.000

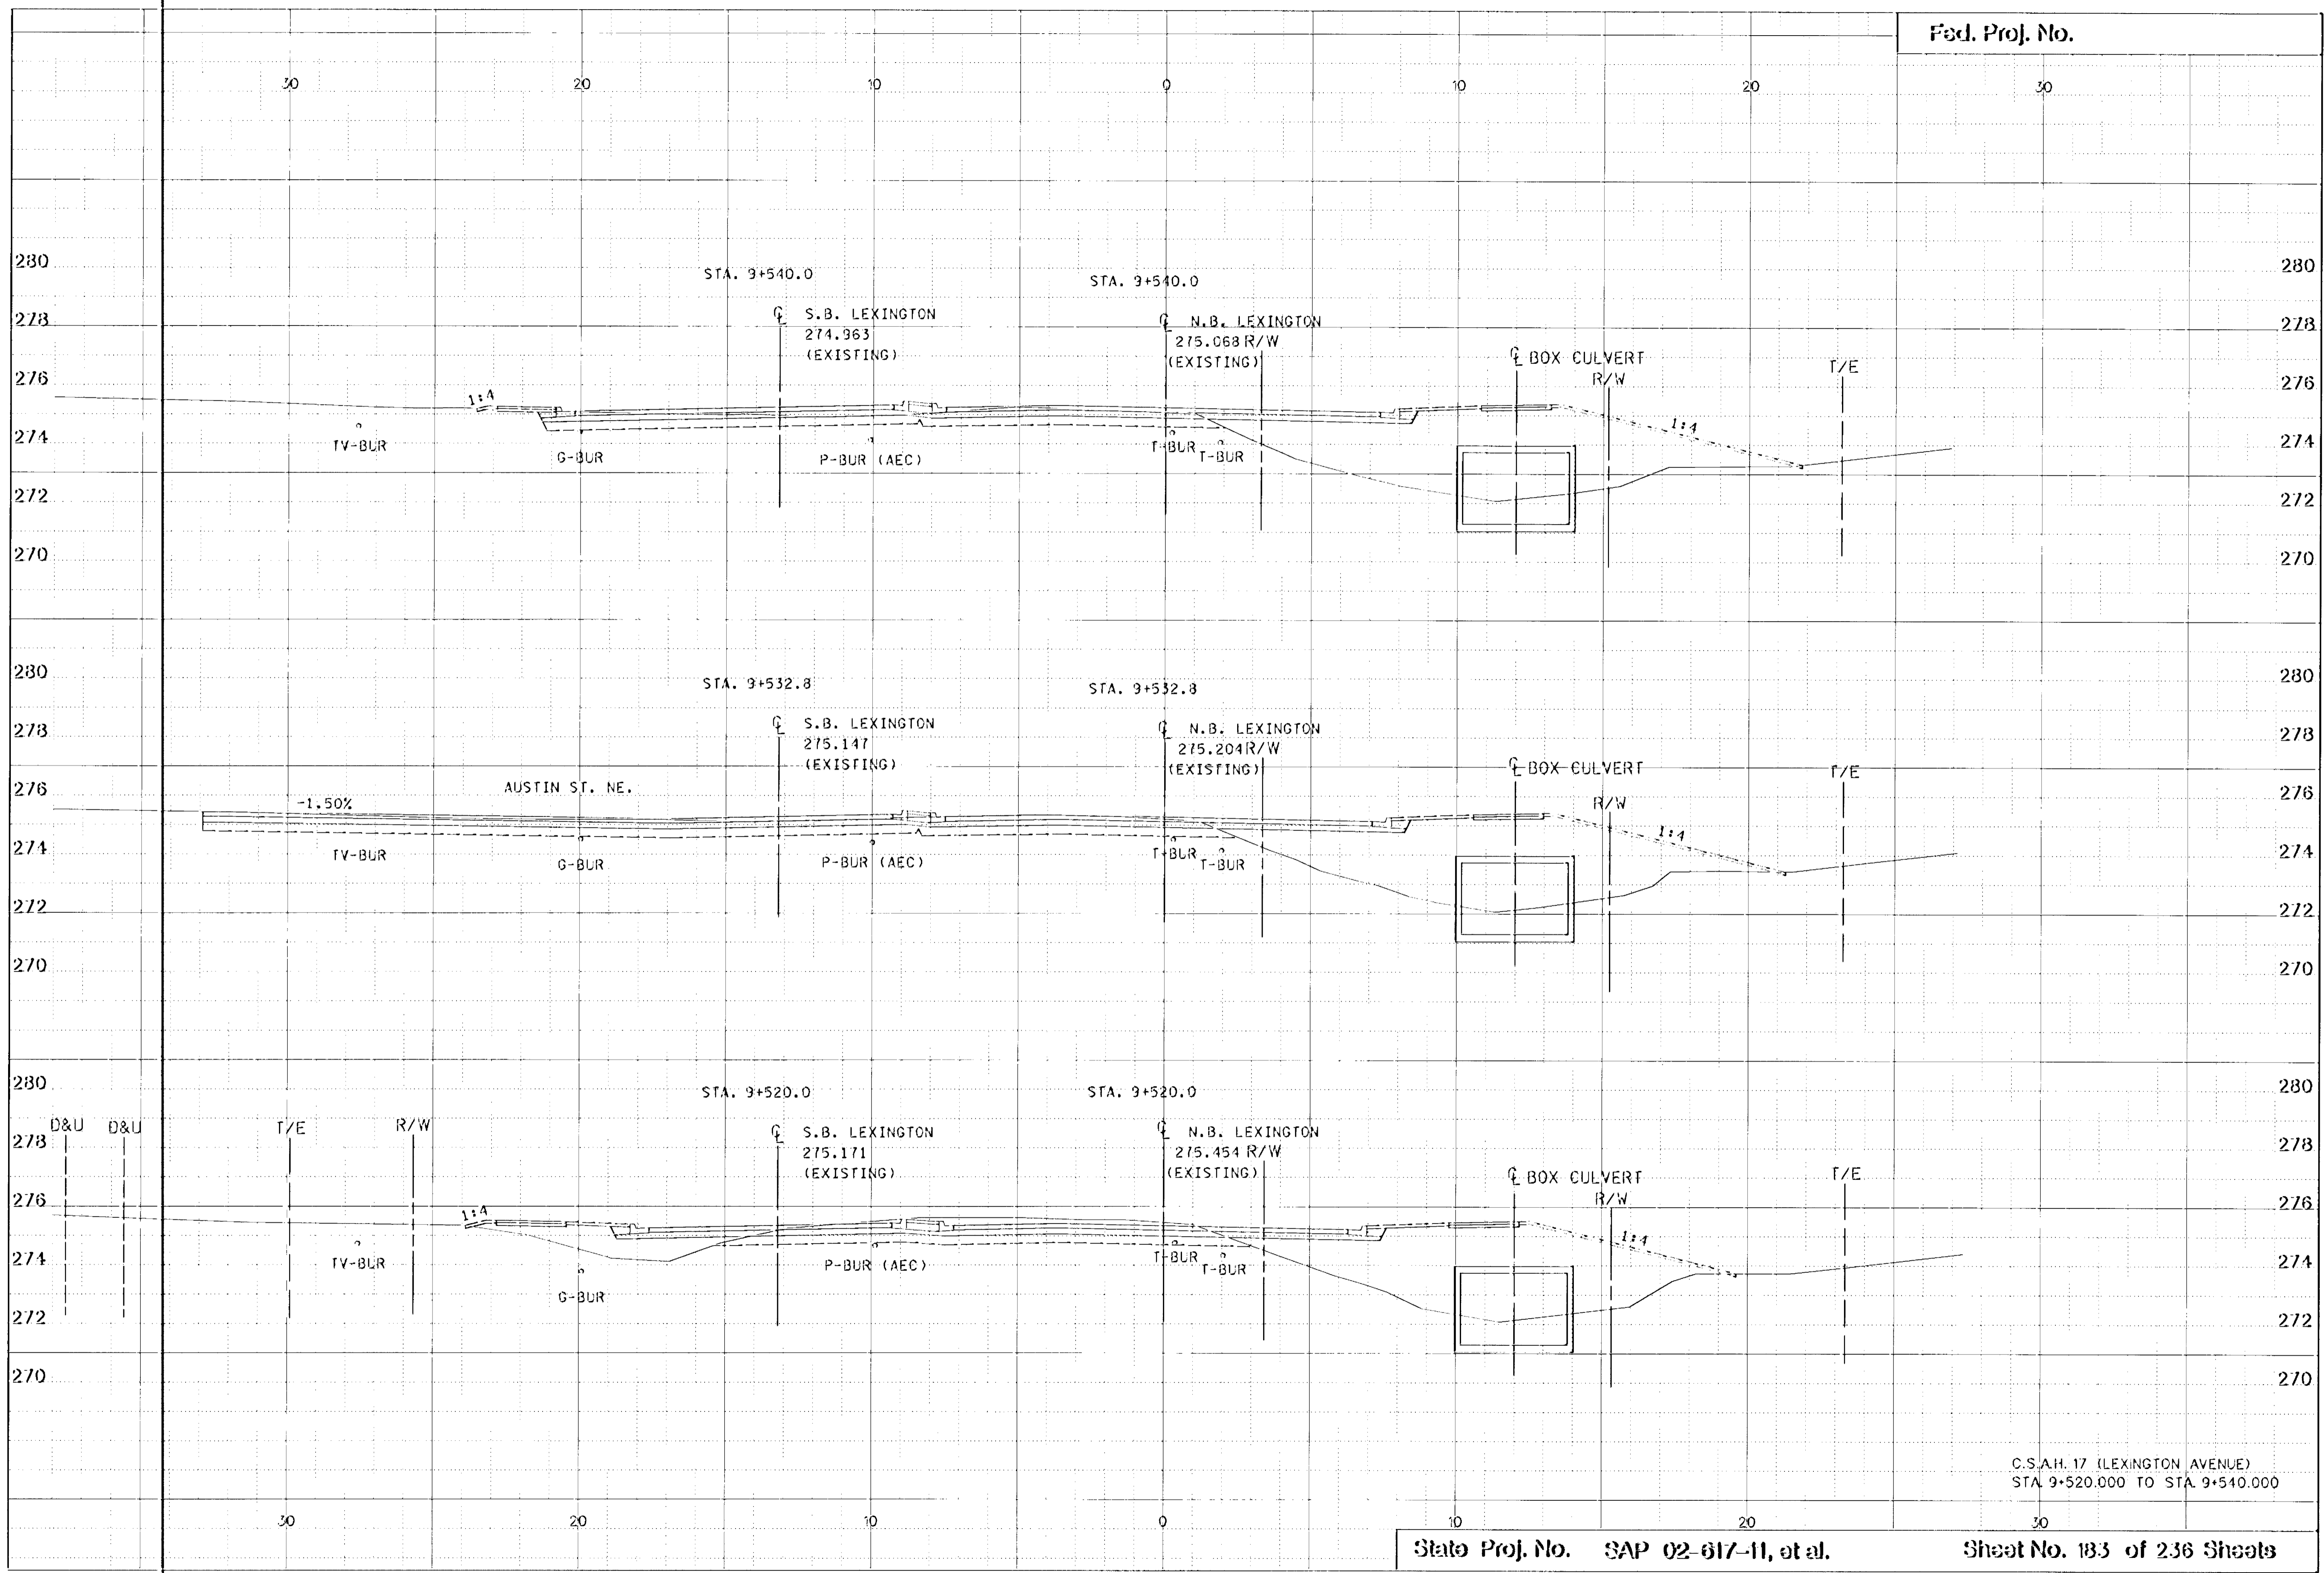


C.S.A.H. 17 (LEXINGTON AVENUE)
STA 9+520.000 TO STA 9+540.000

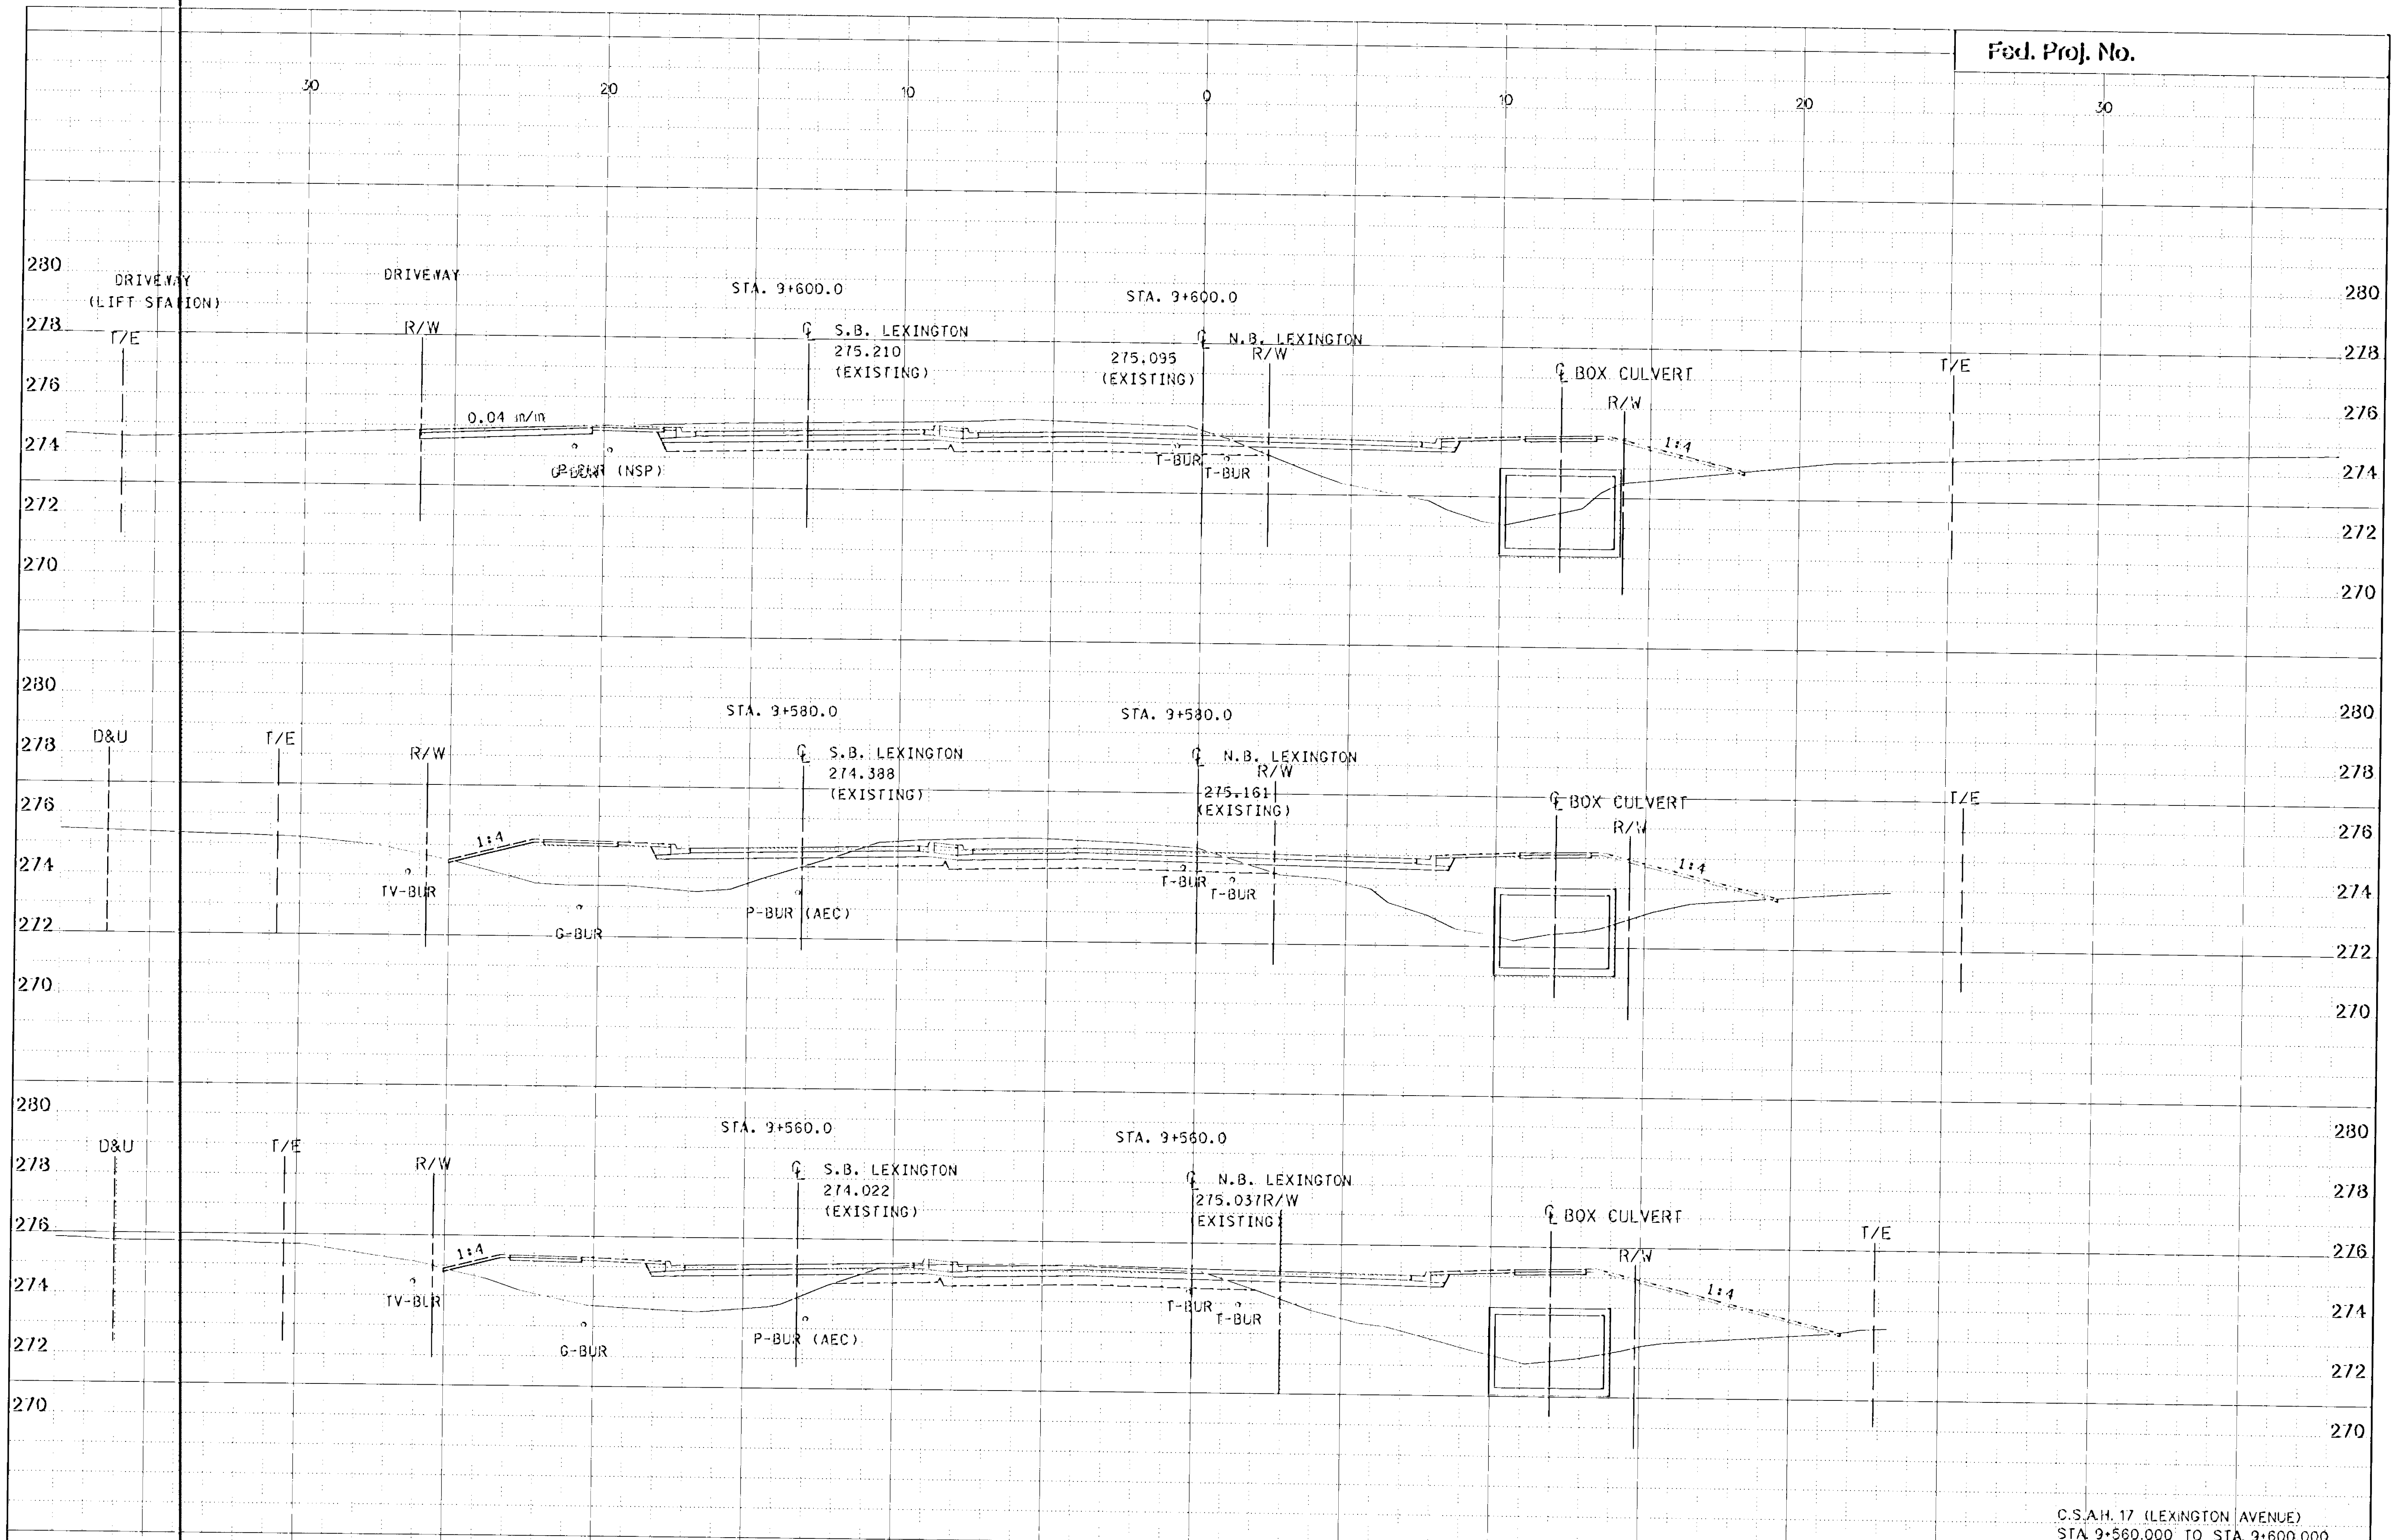


C.S.A.H. 17 (LEXINGTON AVENUE)
STA 9+560.000 TO STA 9+600.000

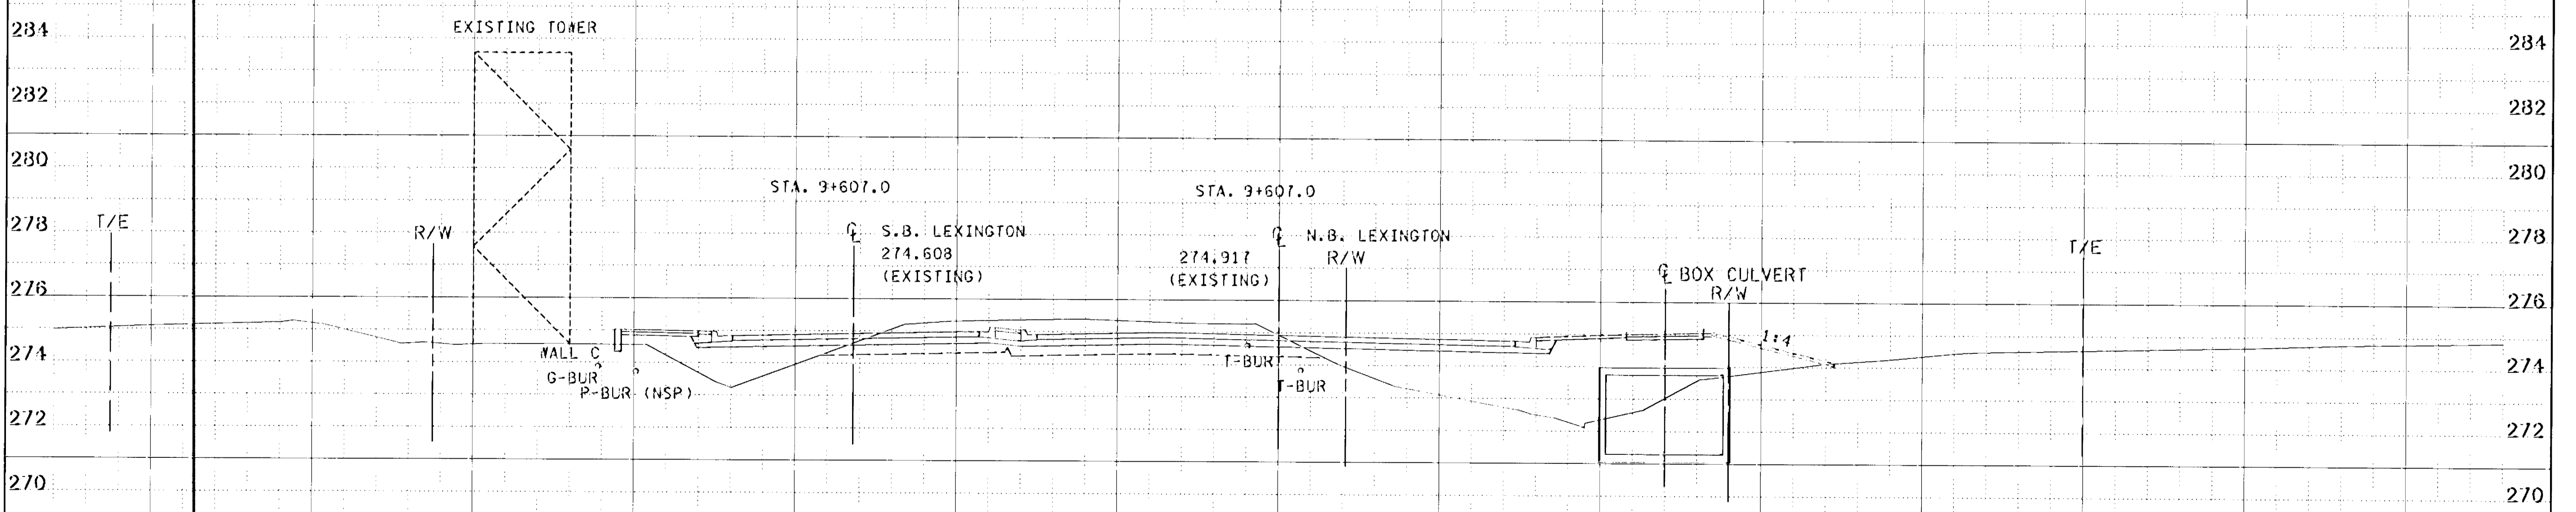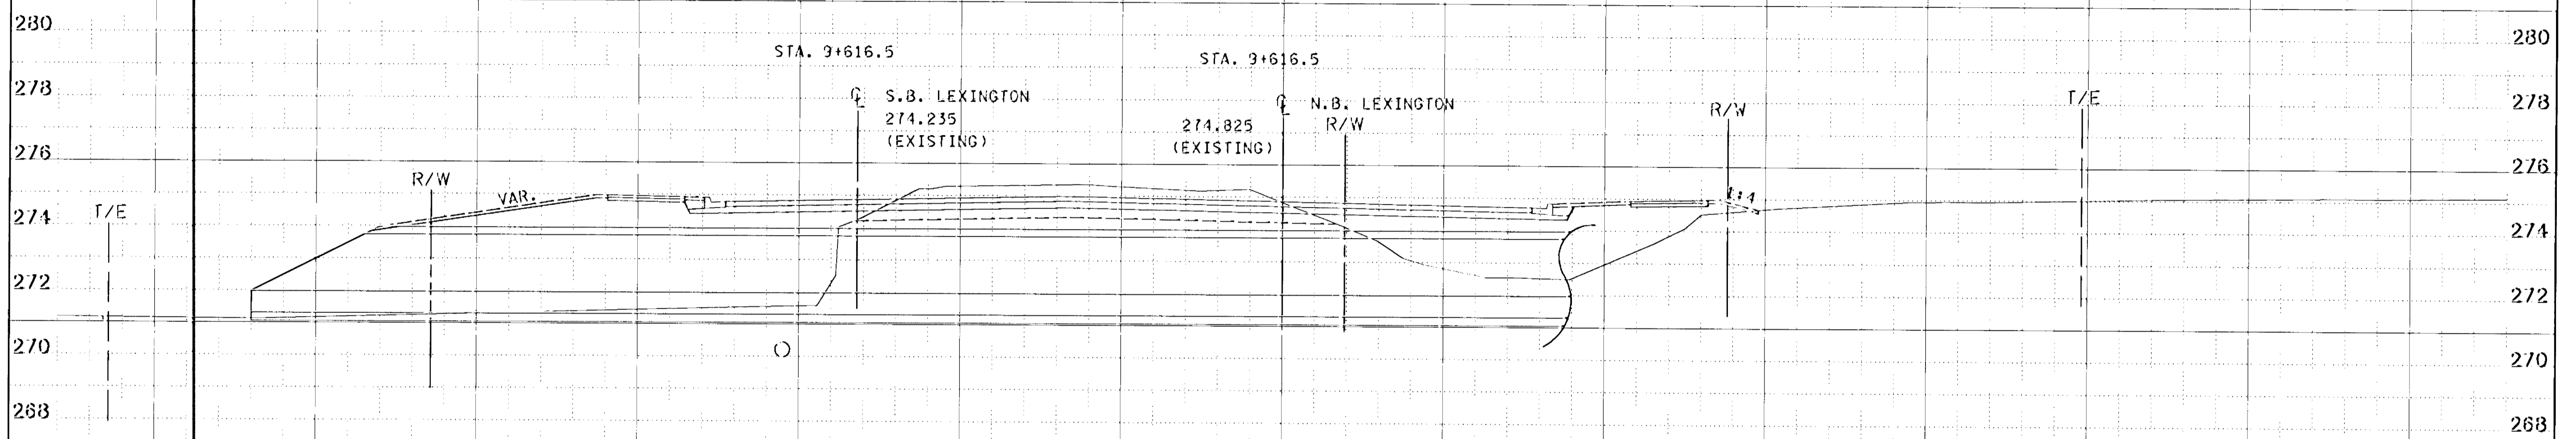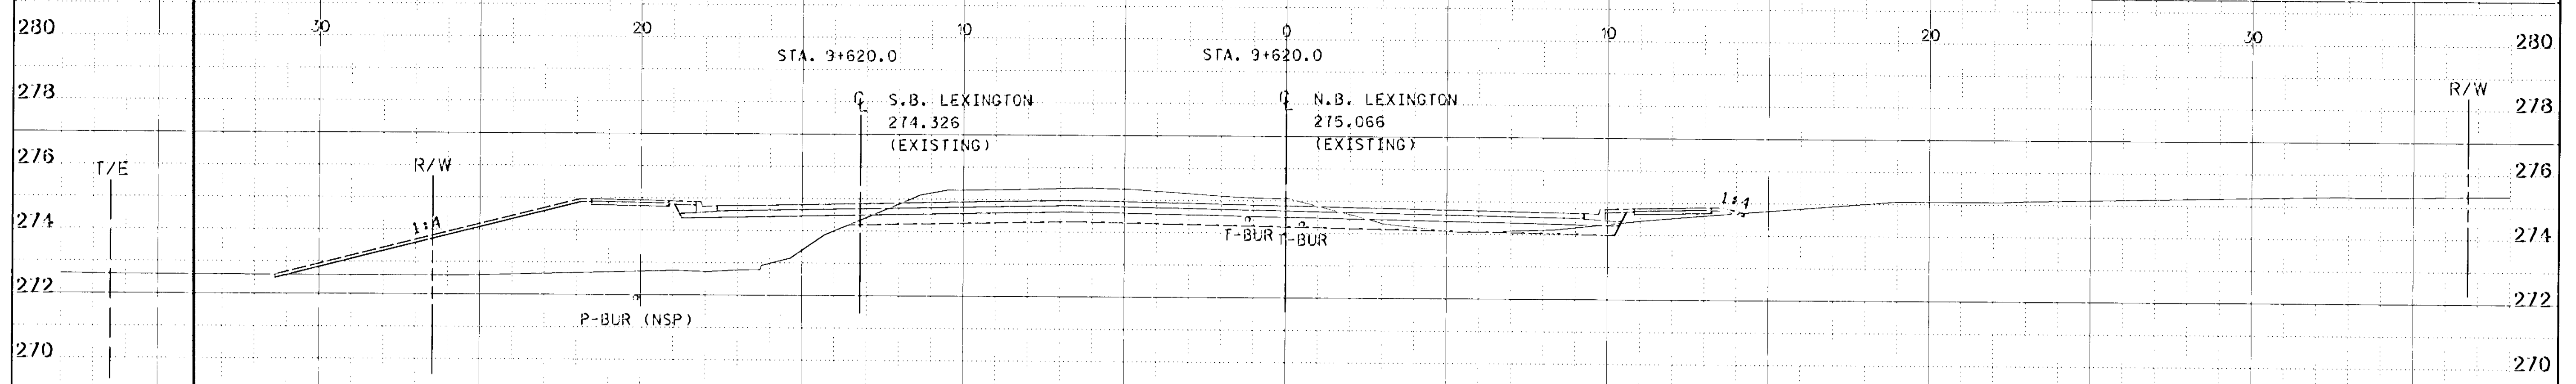


C.S.A.H. 17 (LEXINGTON AVENUE)
STA. 9+607.000 TO STA. 9+620.000

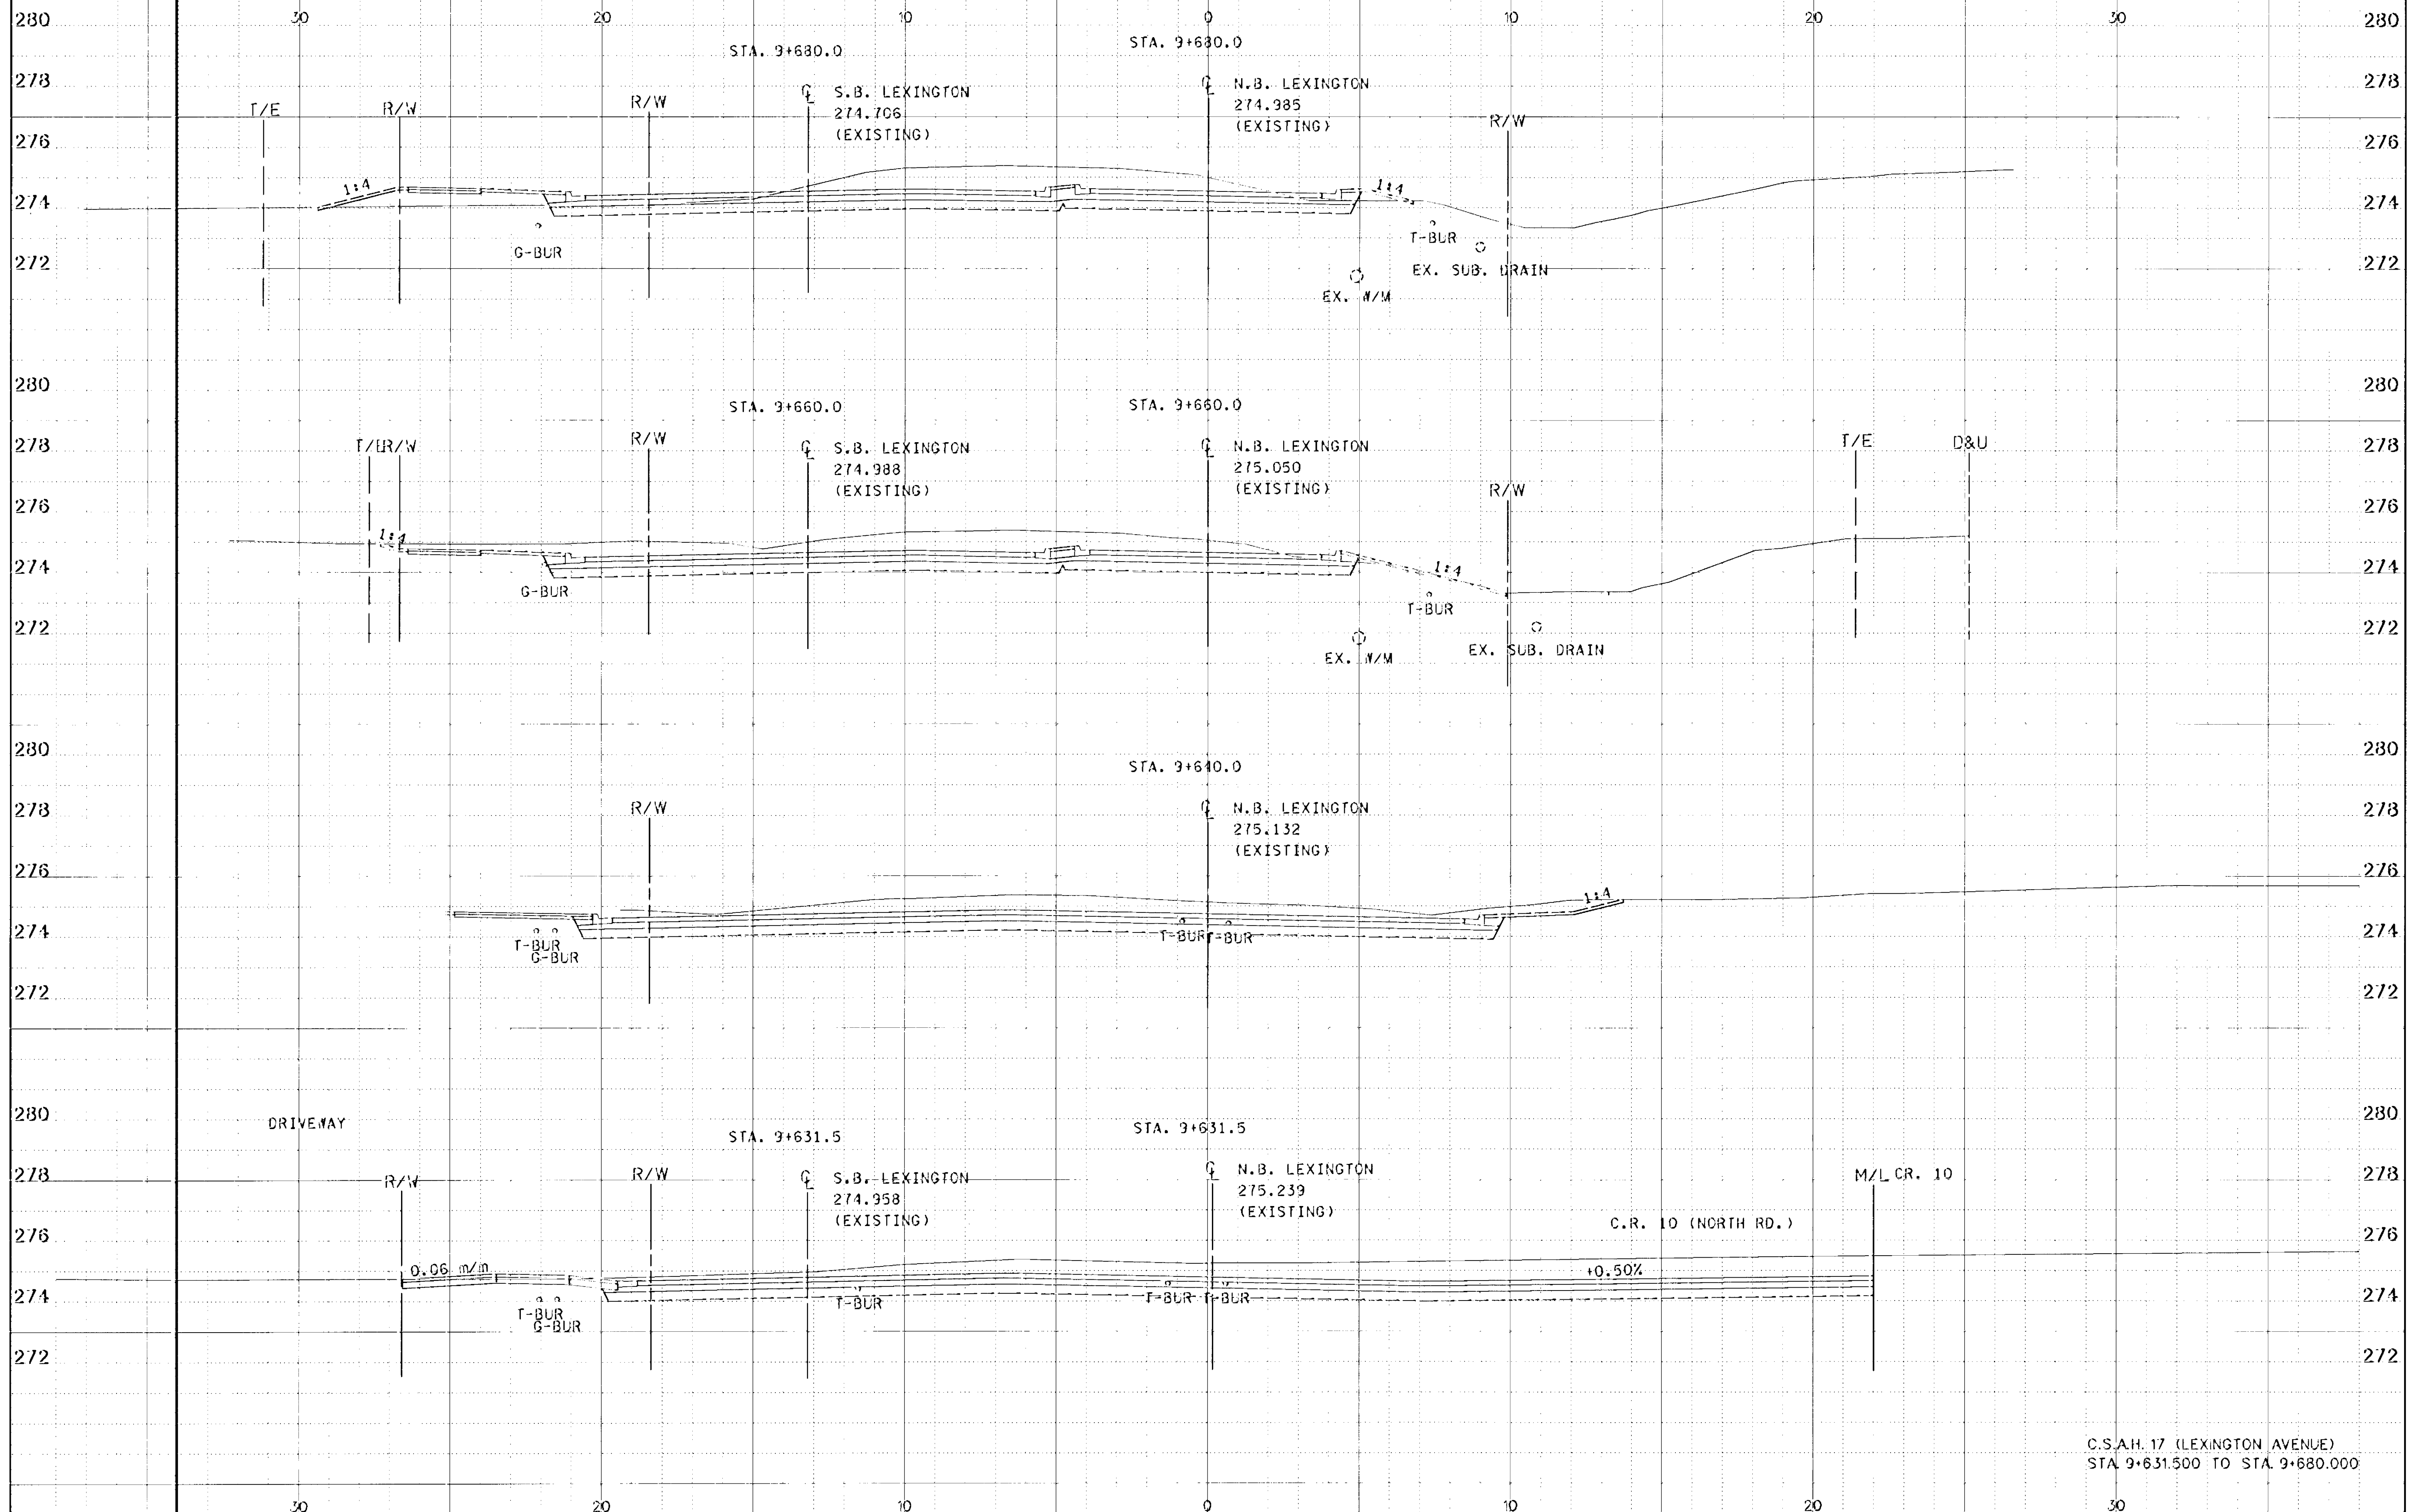


C.S.A.H. 17 (LEXINGTON AVENUE)
STA. 9+631.500 TO STA. 9+680.000

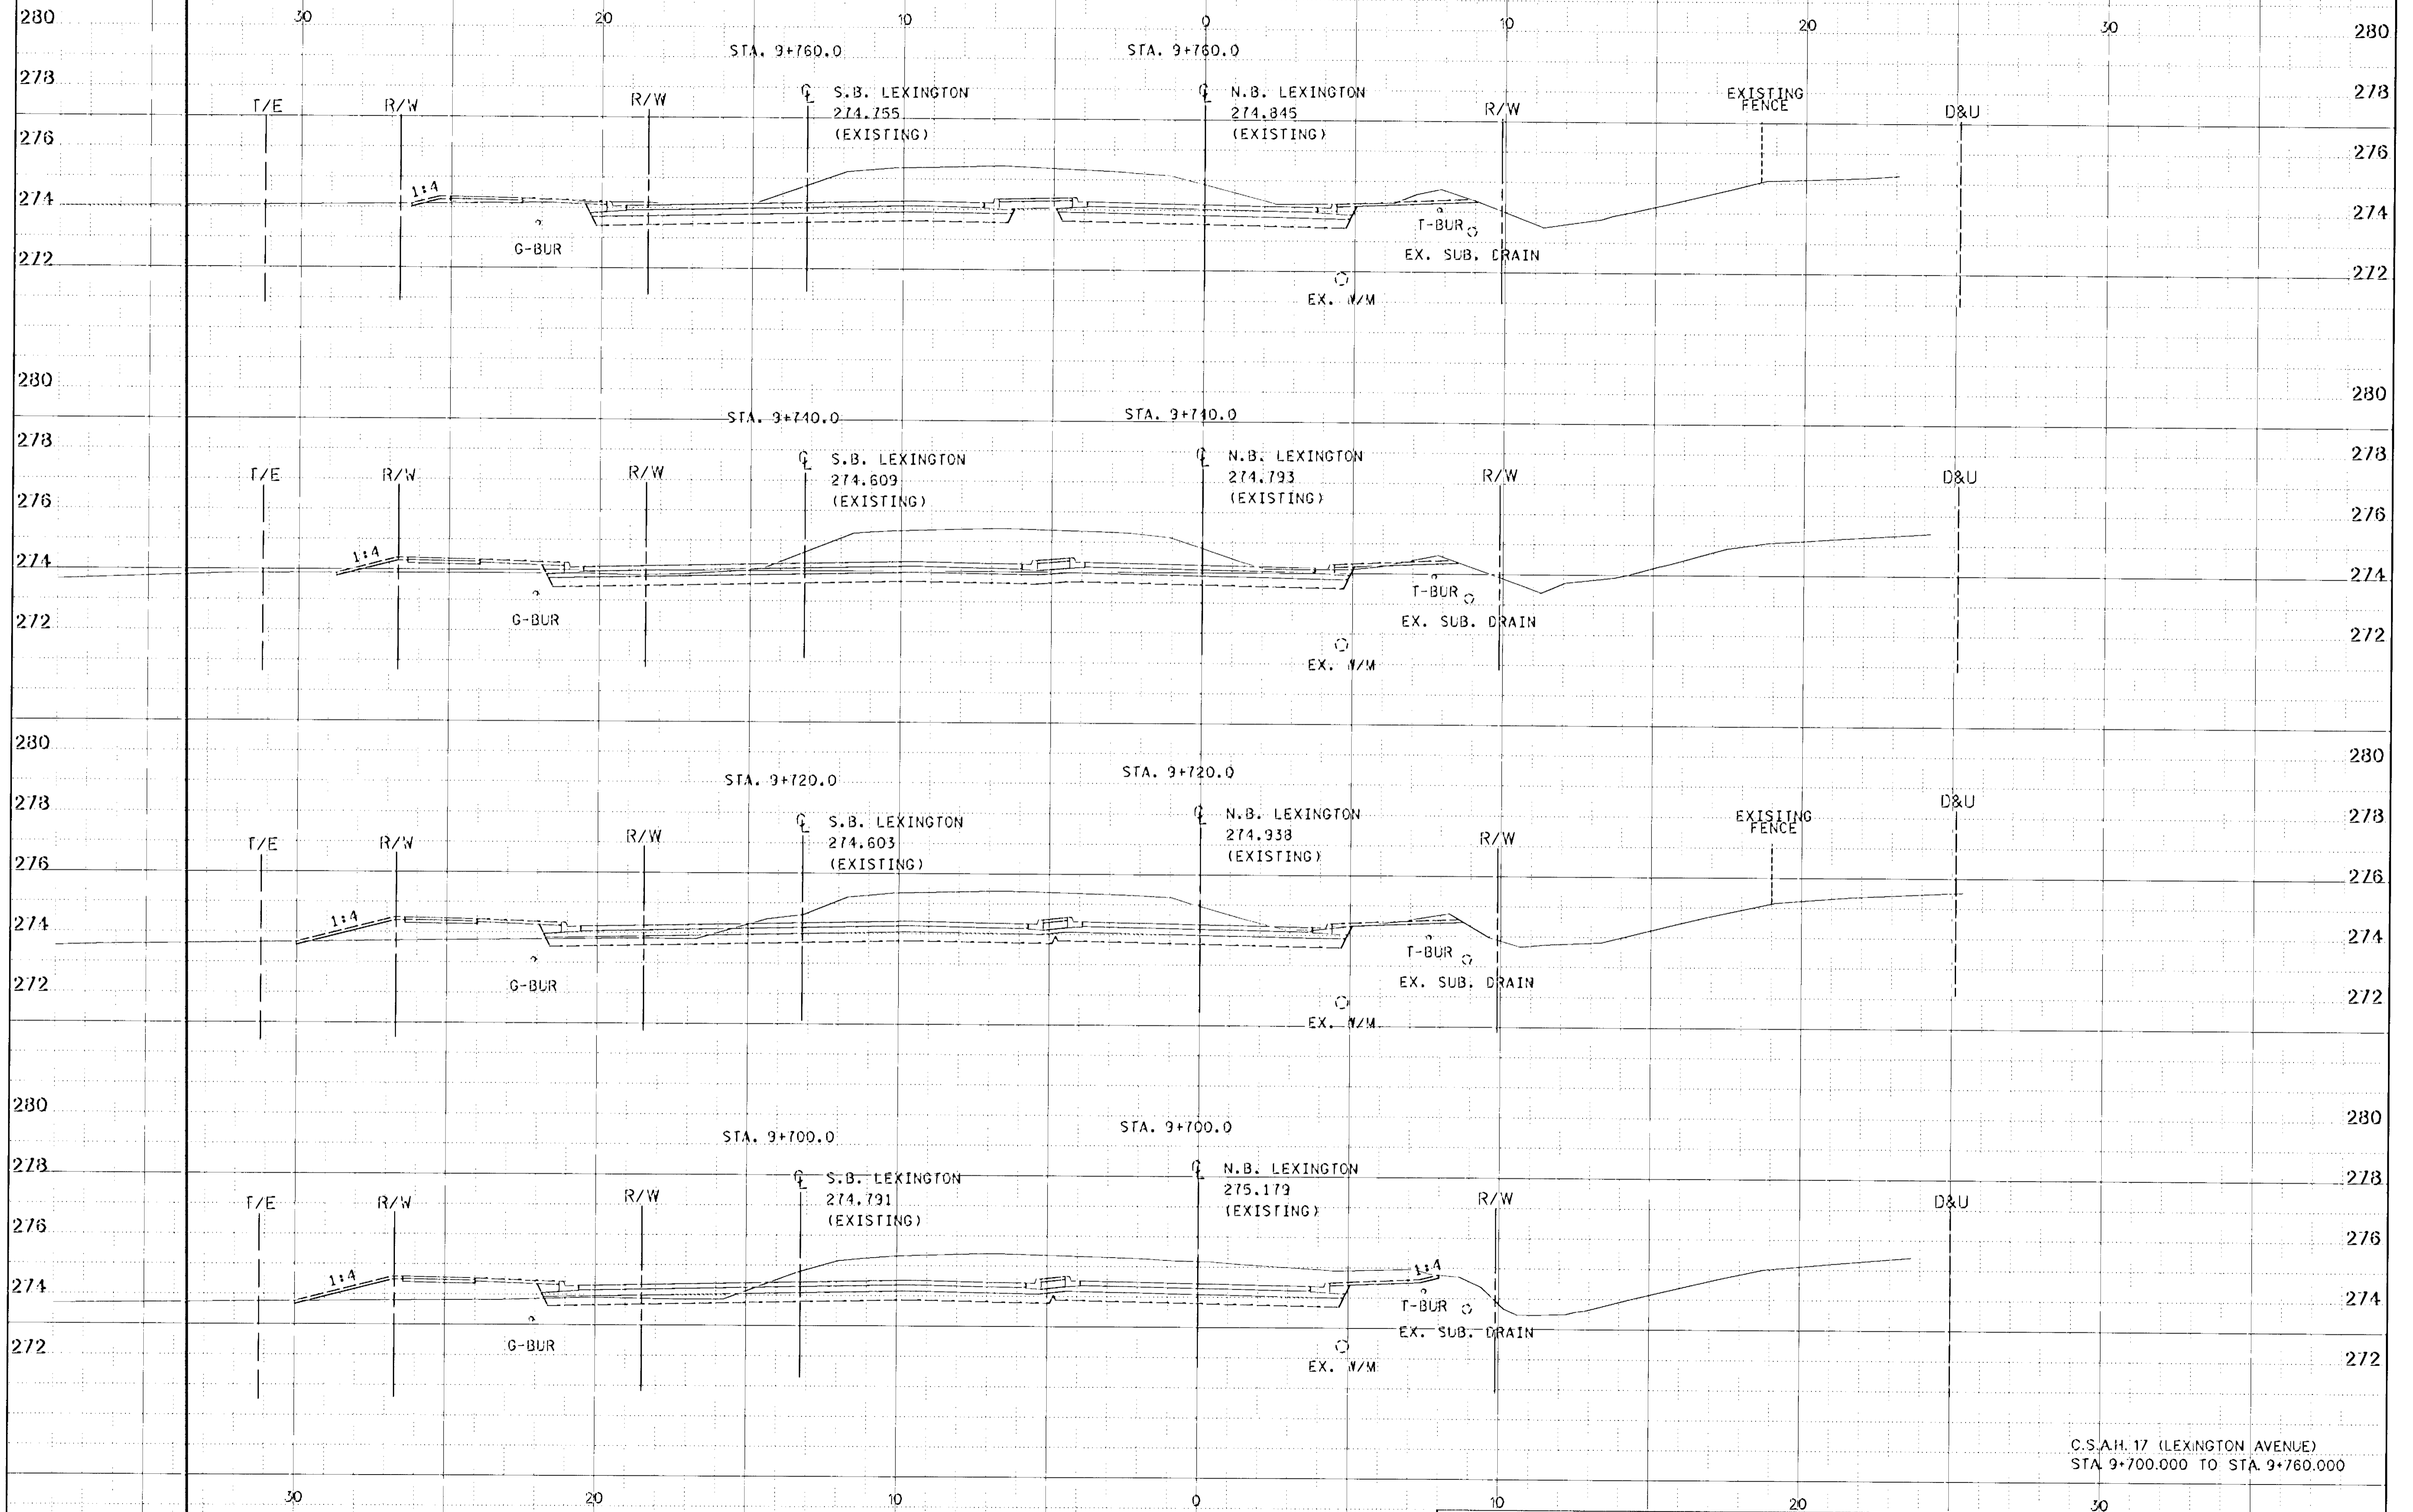





C.S.A.H. 17 (LEXINGTON AVENUE)
STA 9+700.000 TO STA 9+760.000

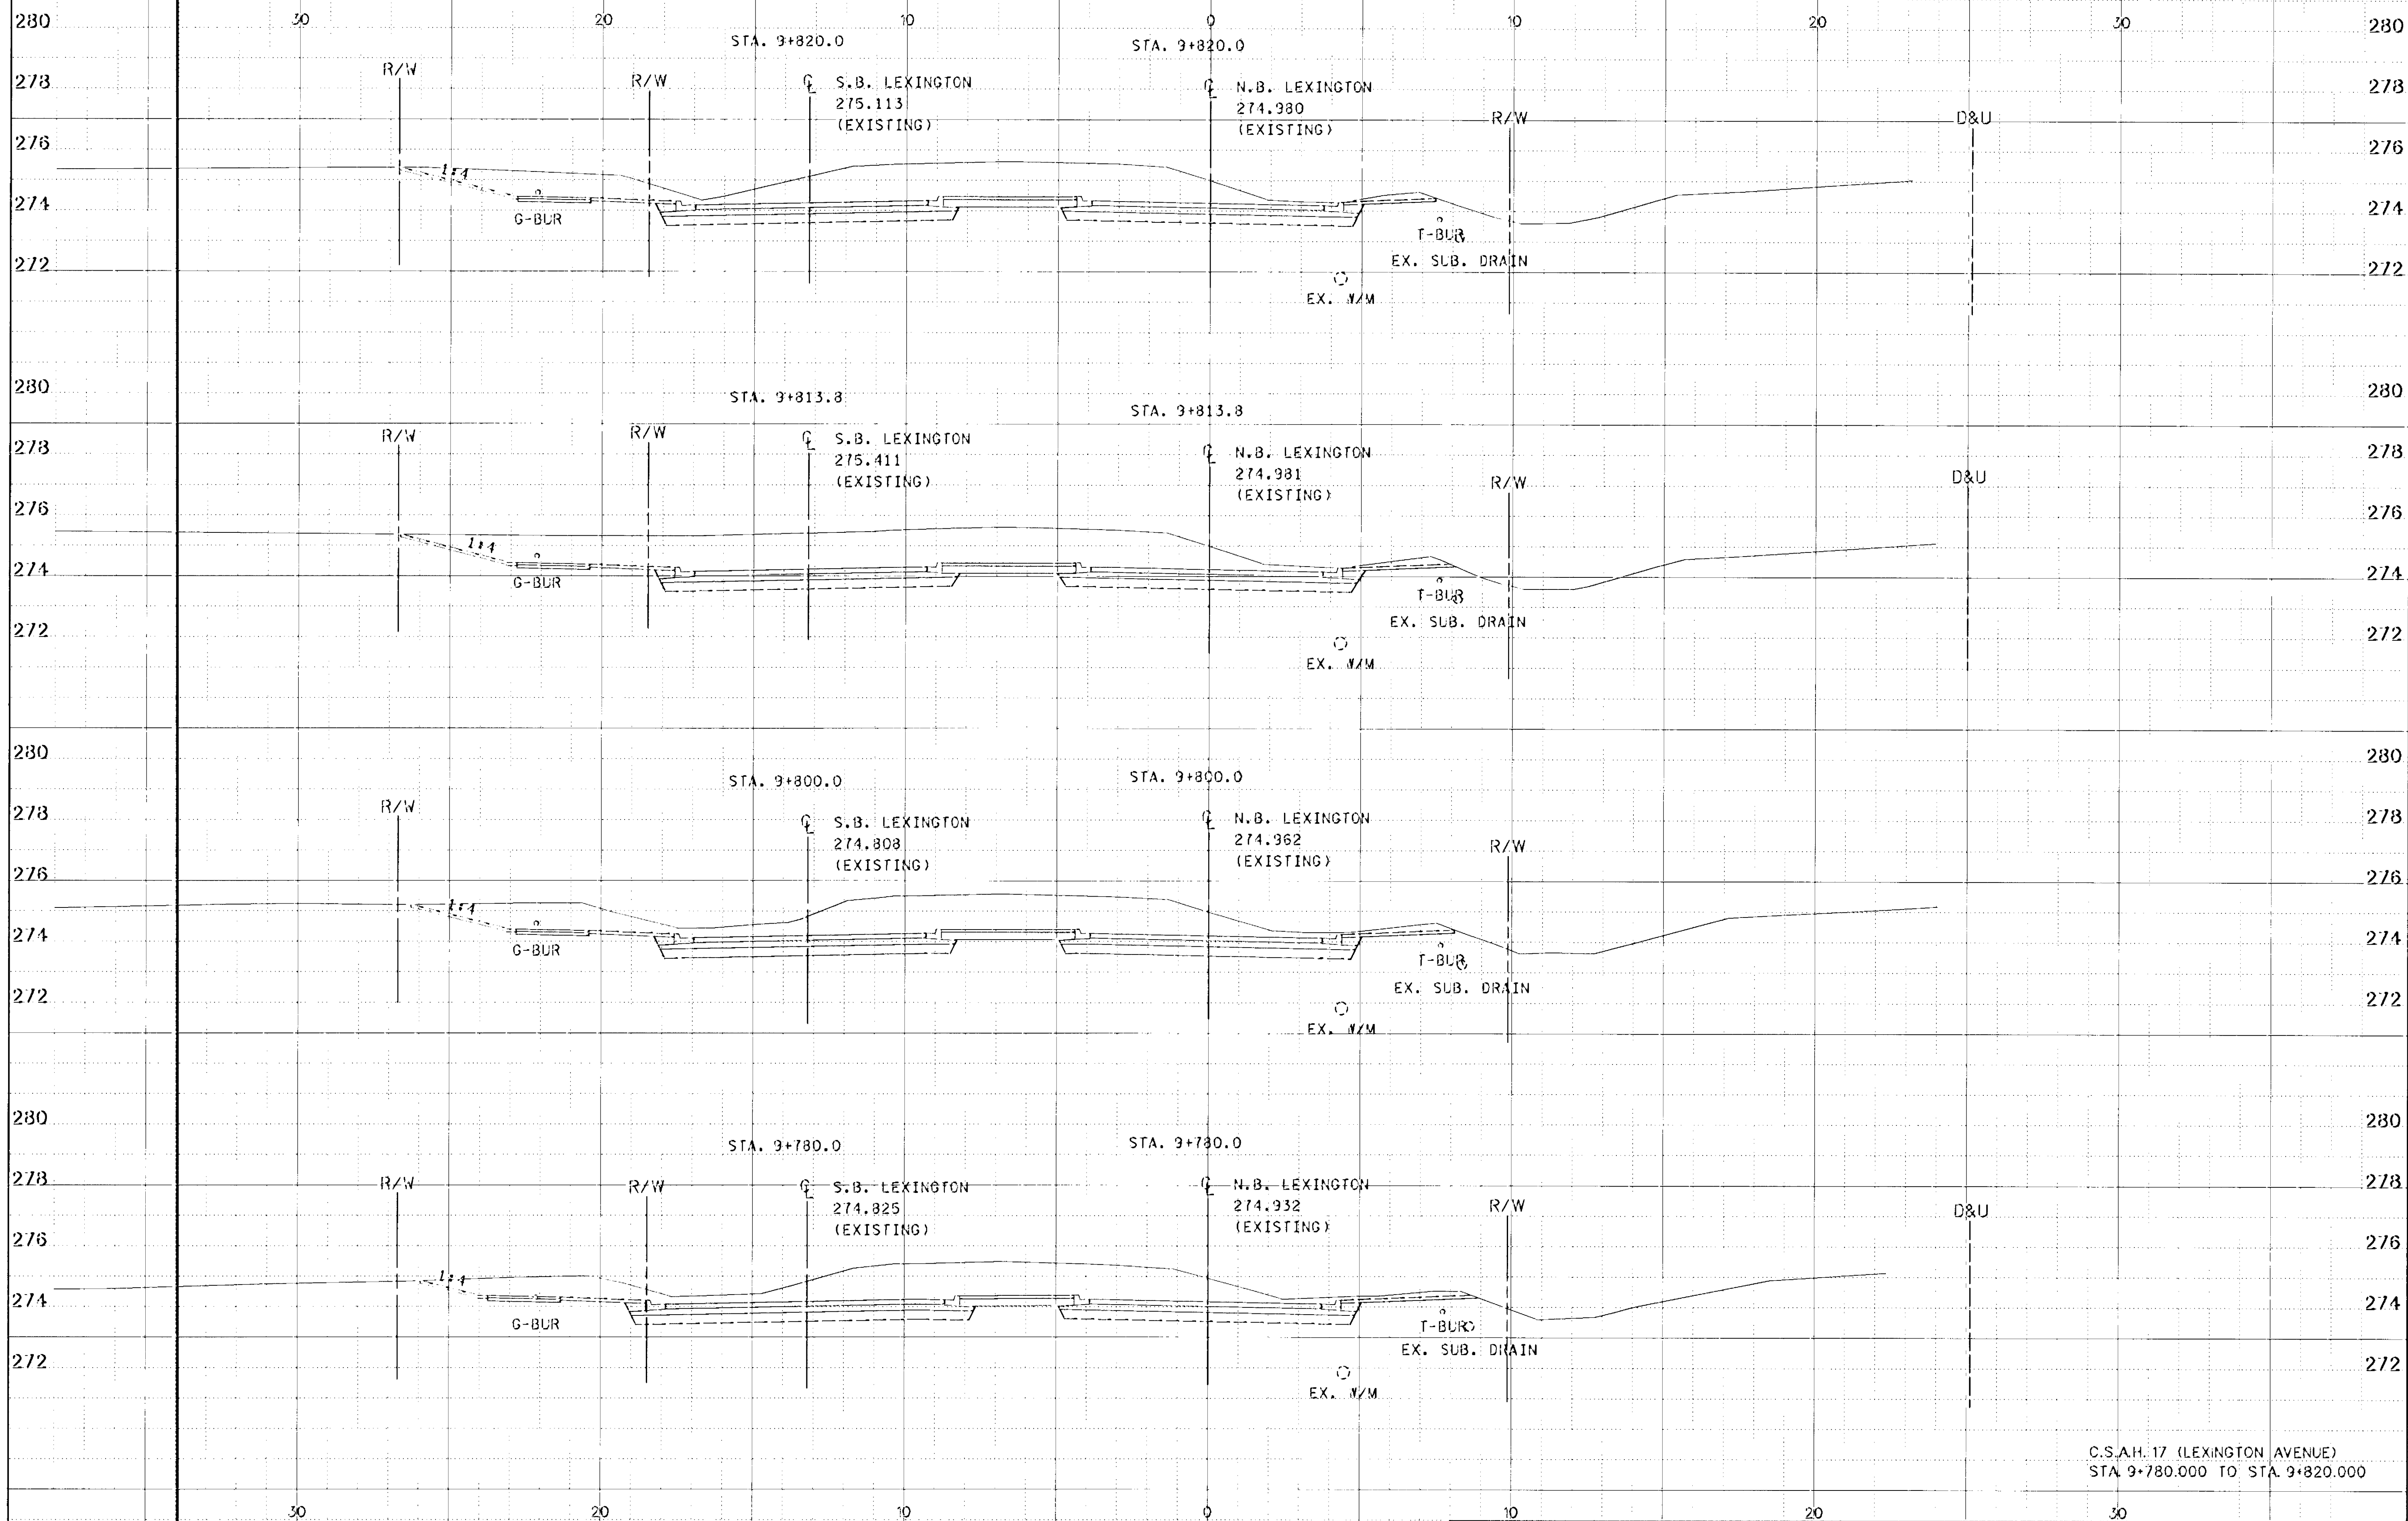



C.S.A.H. 17 (LEXINGTON AVENUE)
STA. 9+780.000 TO STA. 9+820.000

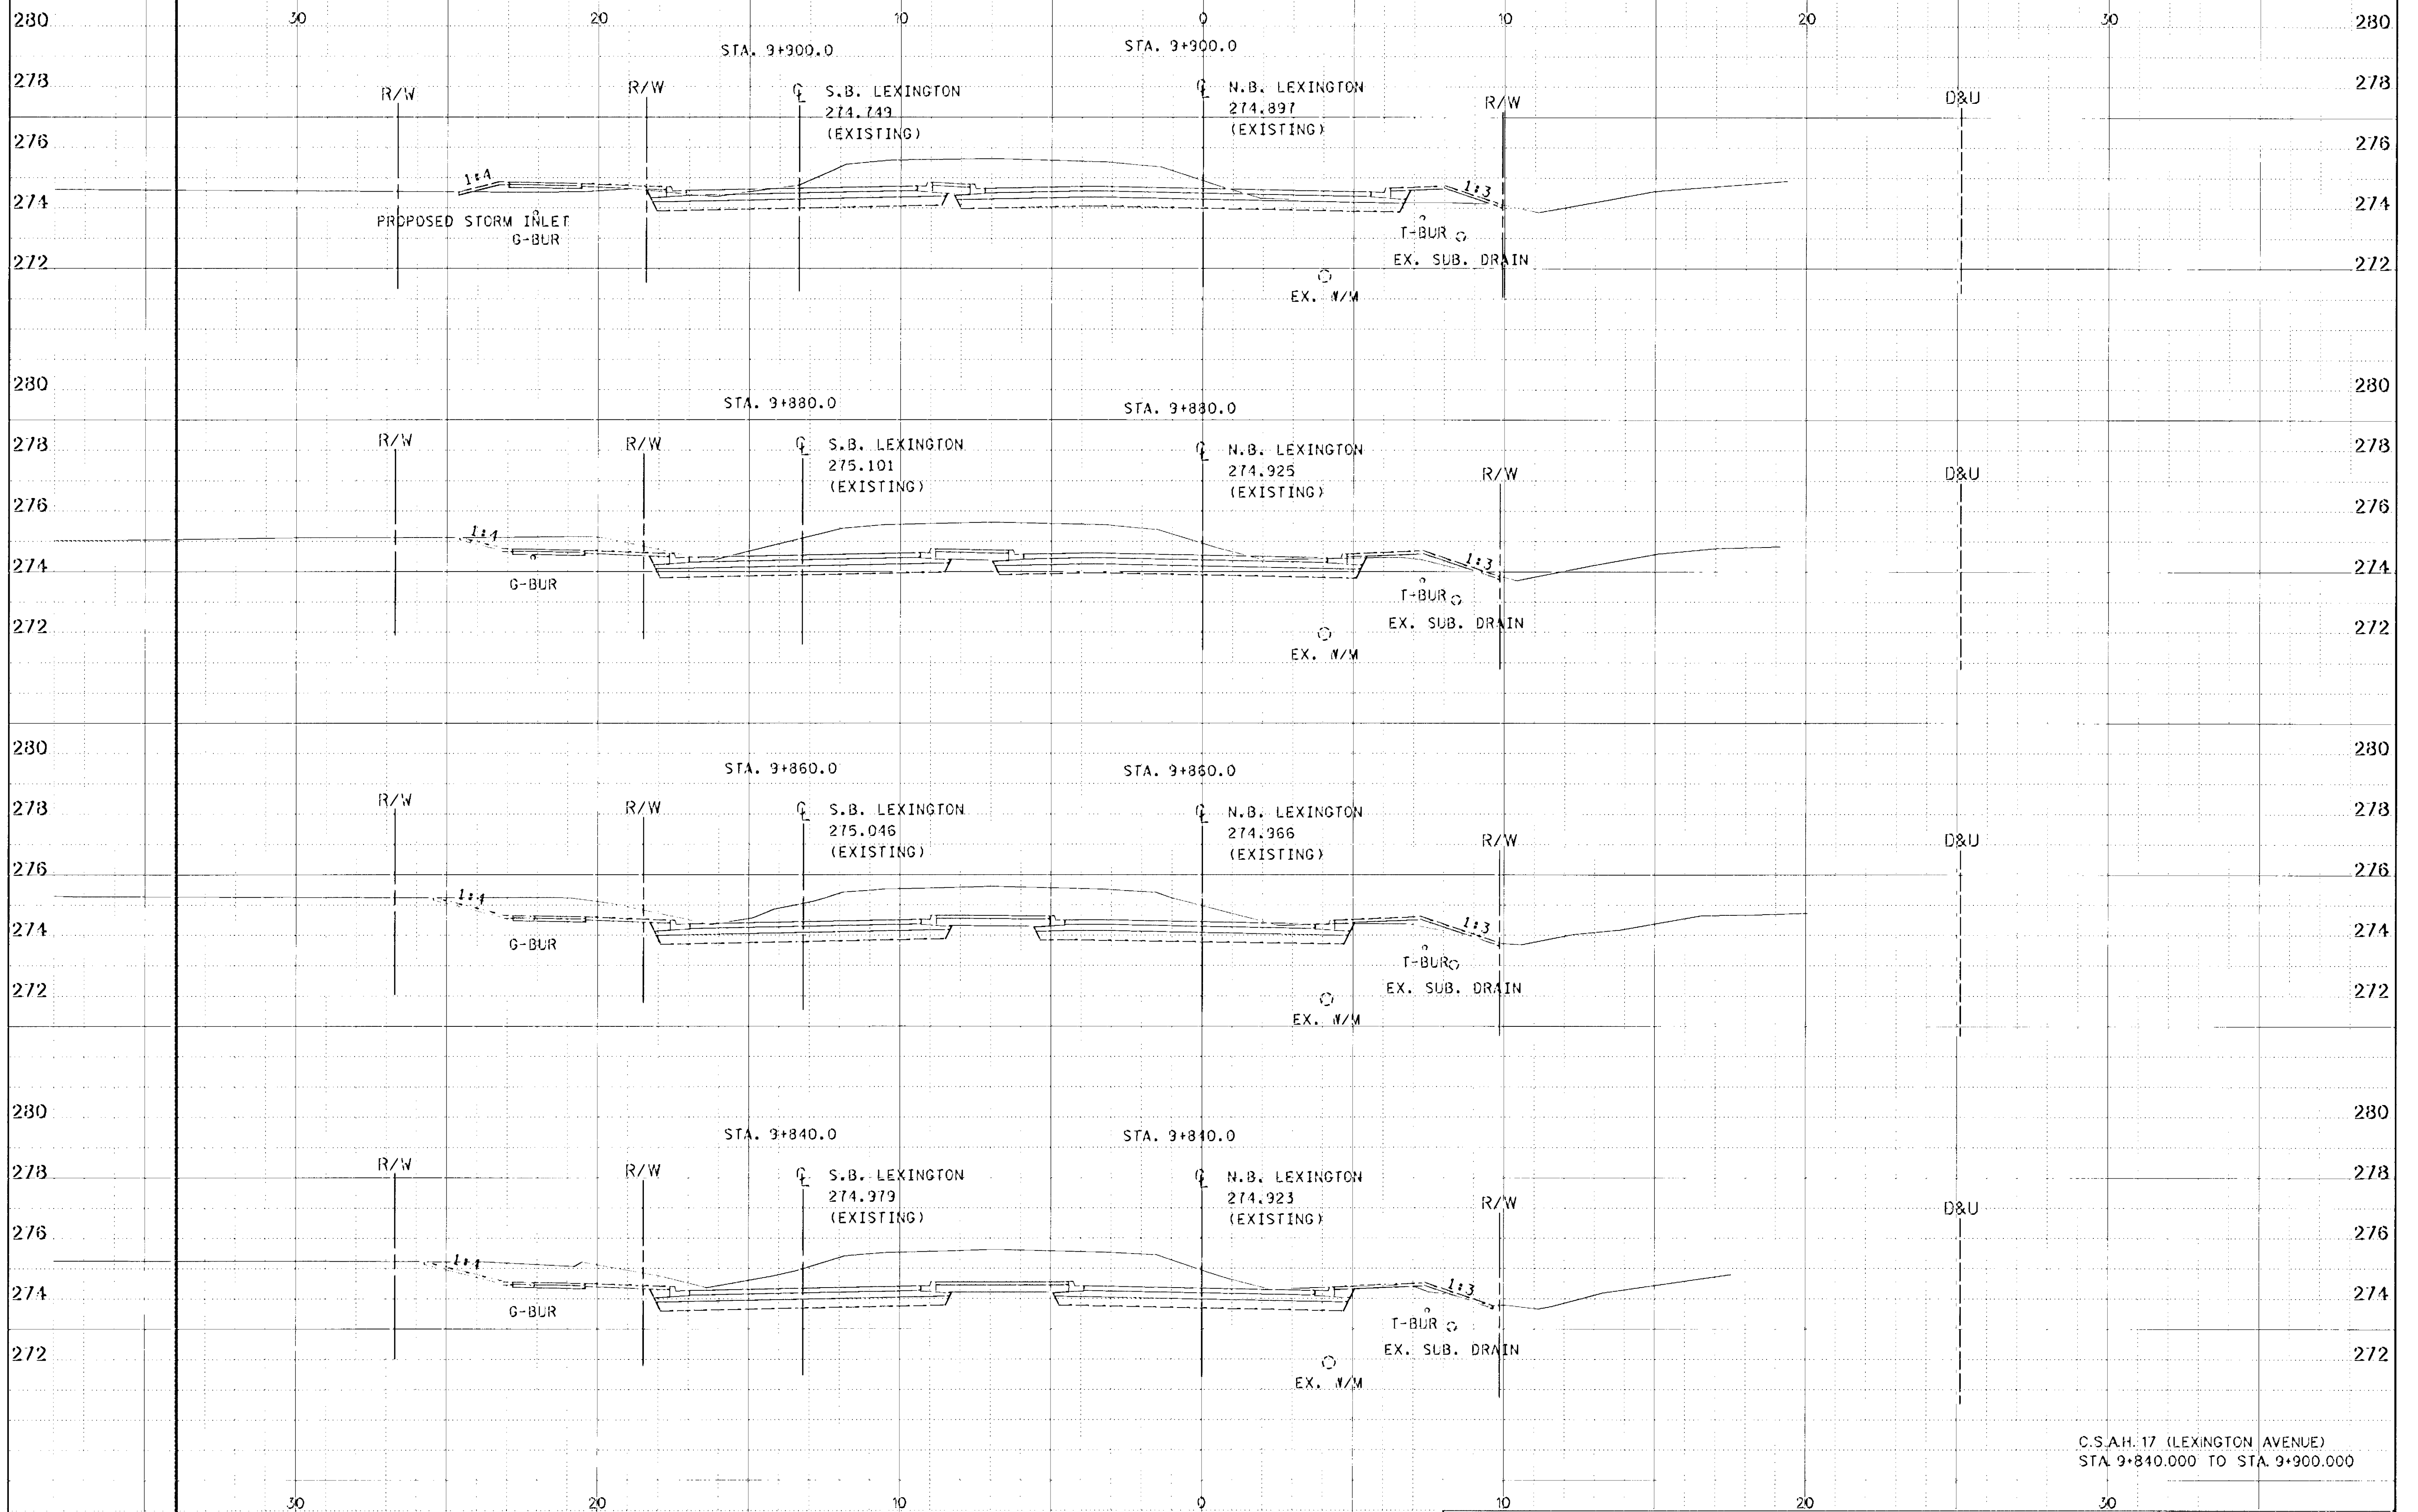


C.S.A.H. 17 (LEXINGTON AVENUE)
STA. 9+840.000 TO STA. 9+900.000

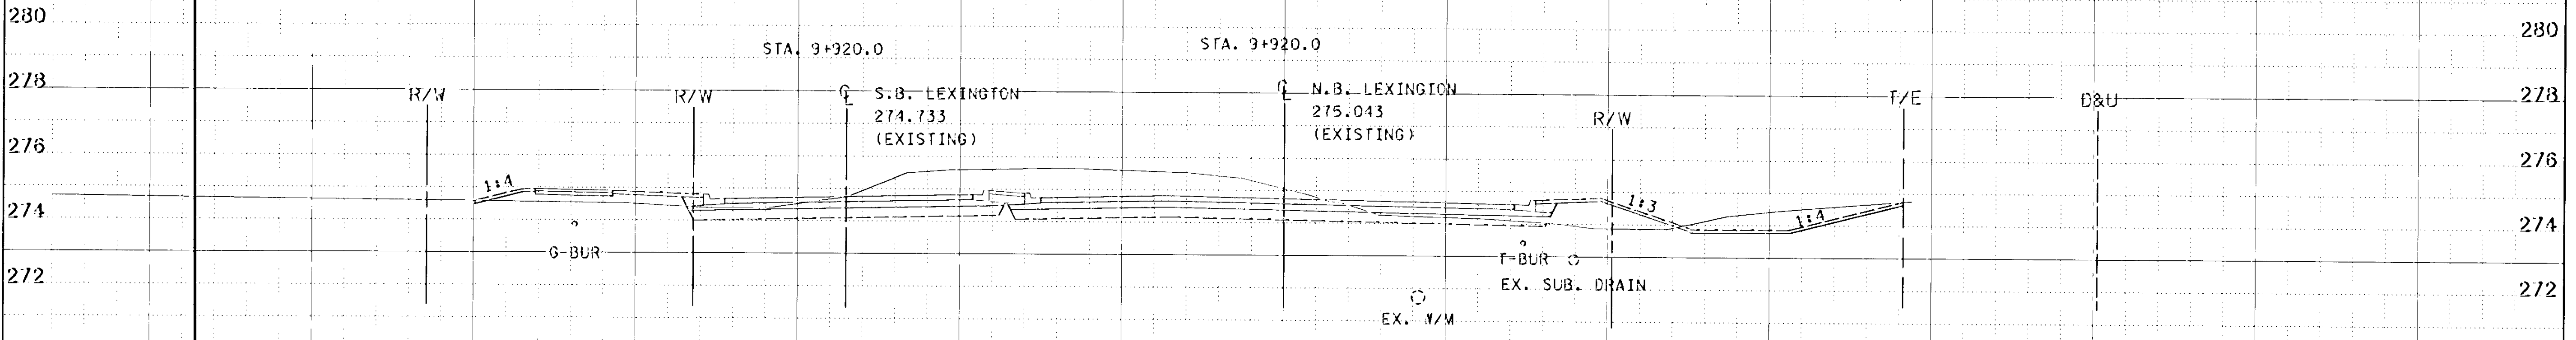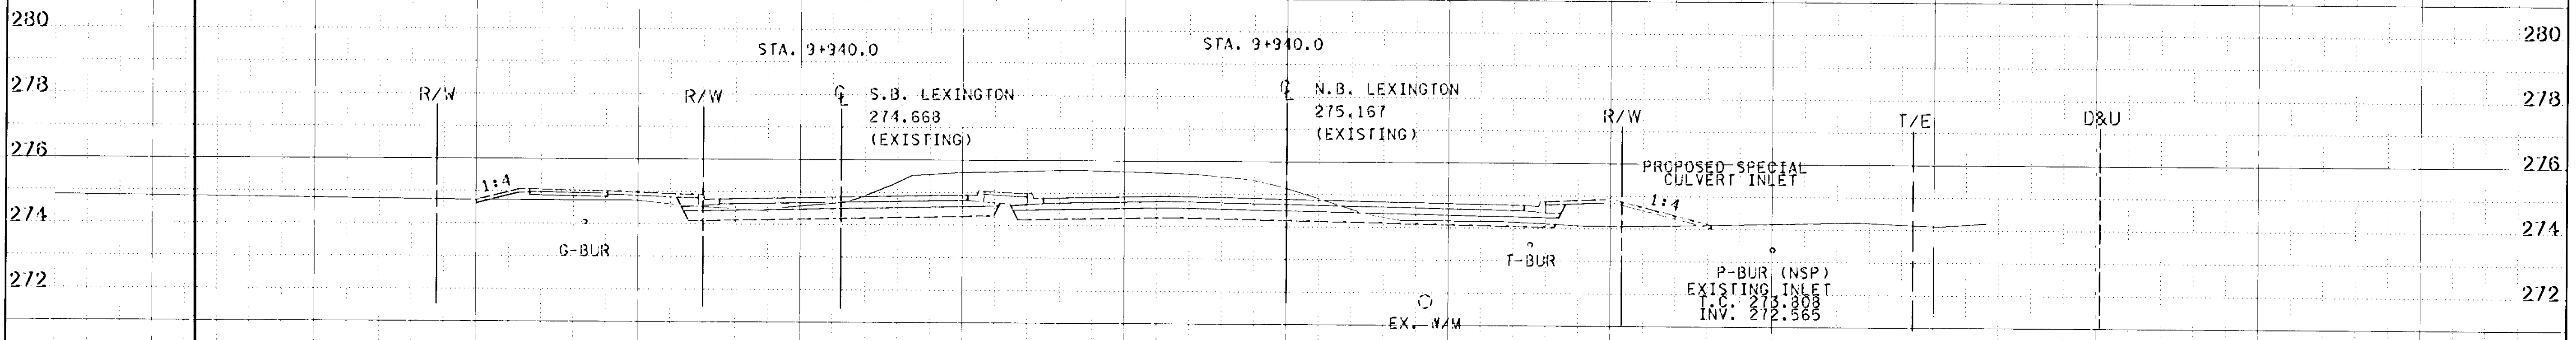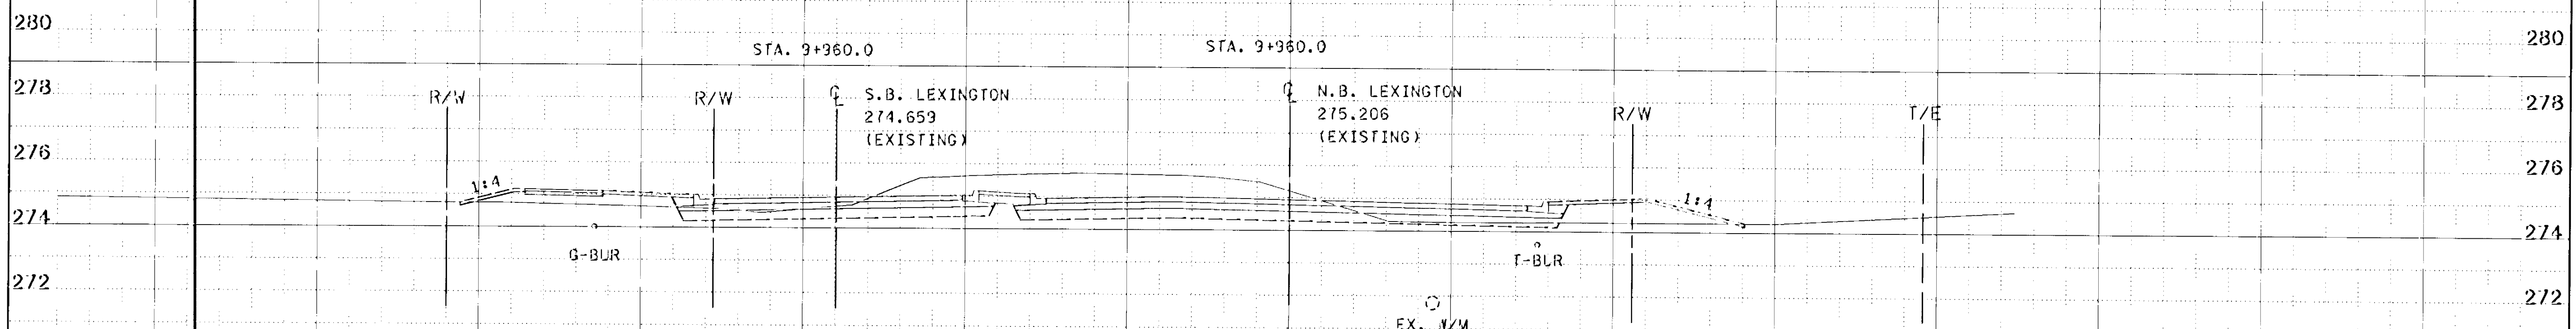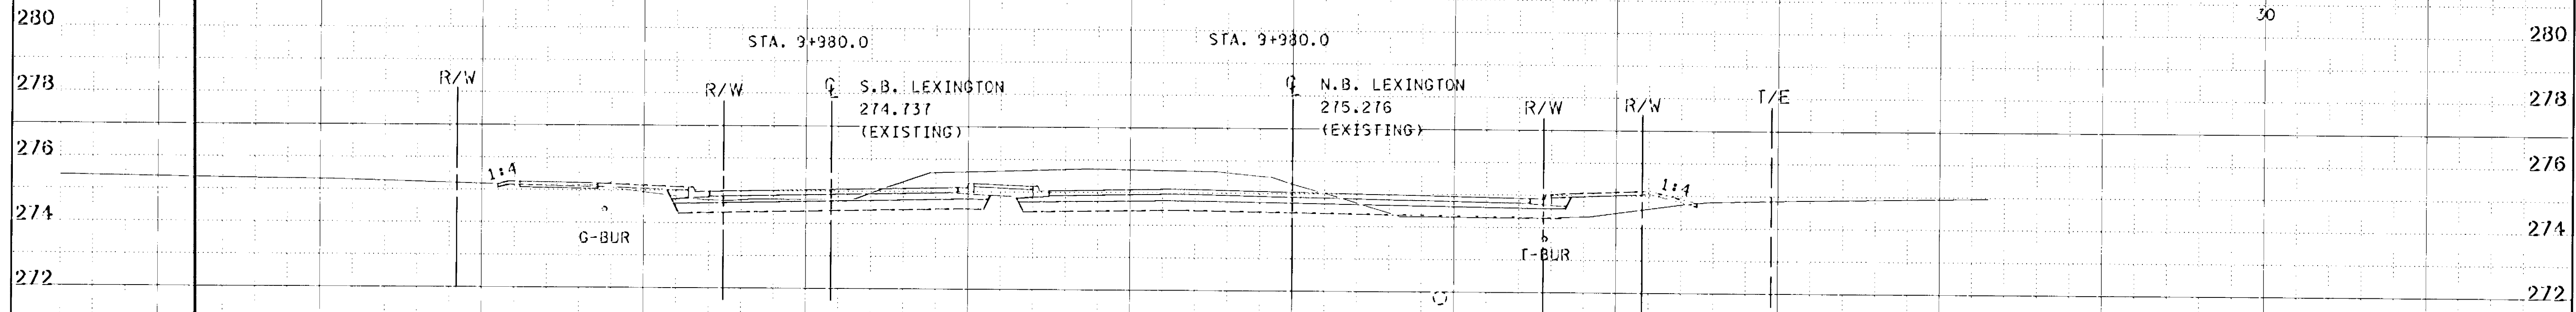



C.S.A.H. 17 (LEXINGTON AVENUE)
STA. 9+920.000 TO STA. 9+980.000

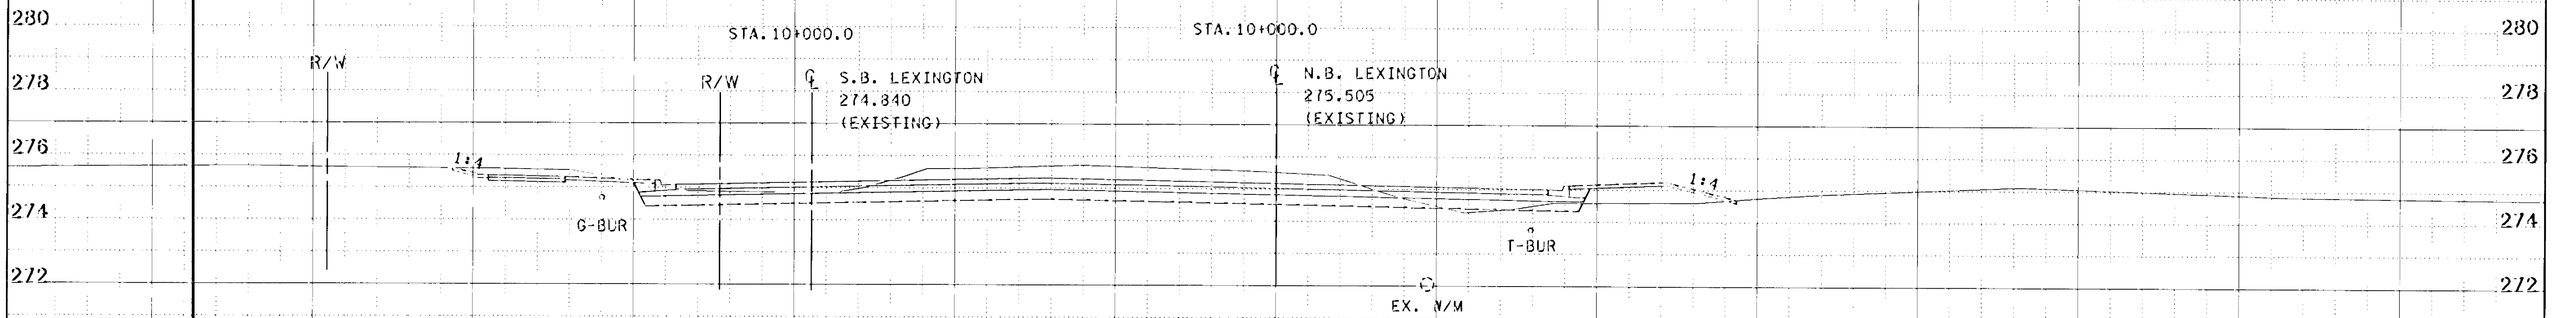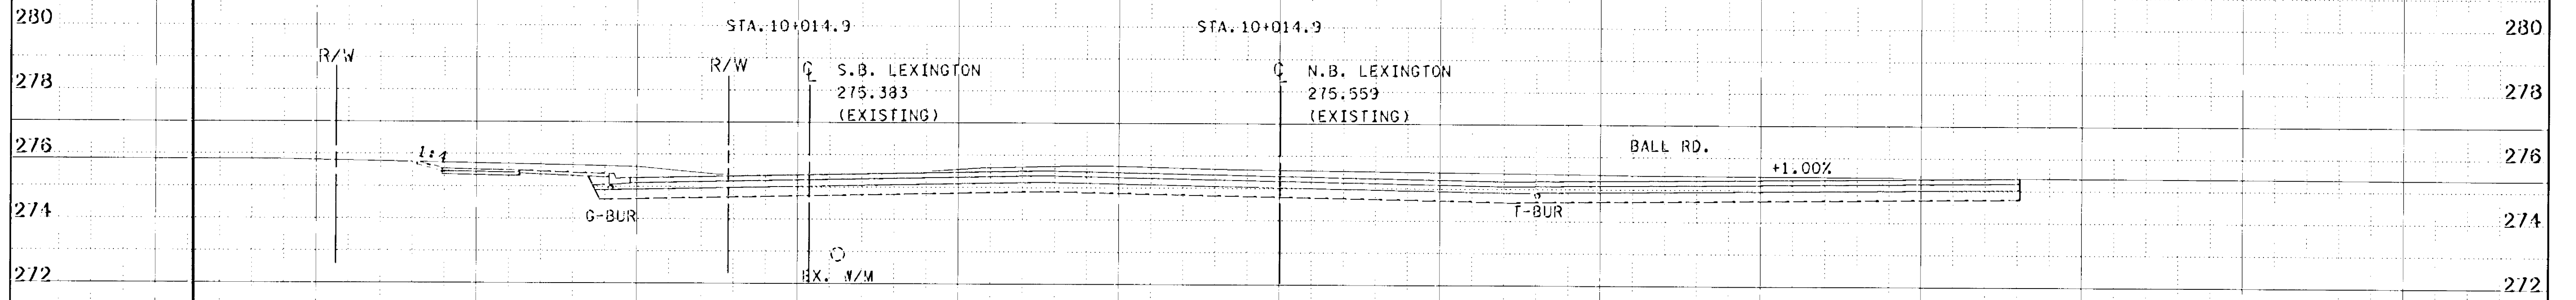


C.S.A.H. 17 (LEXINGTON AVENUE)
STA. 10+000.000 TO STA. 10+014.900

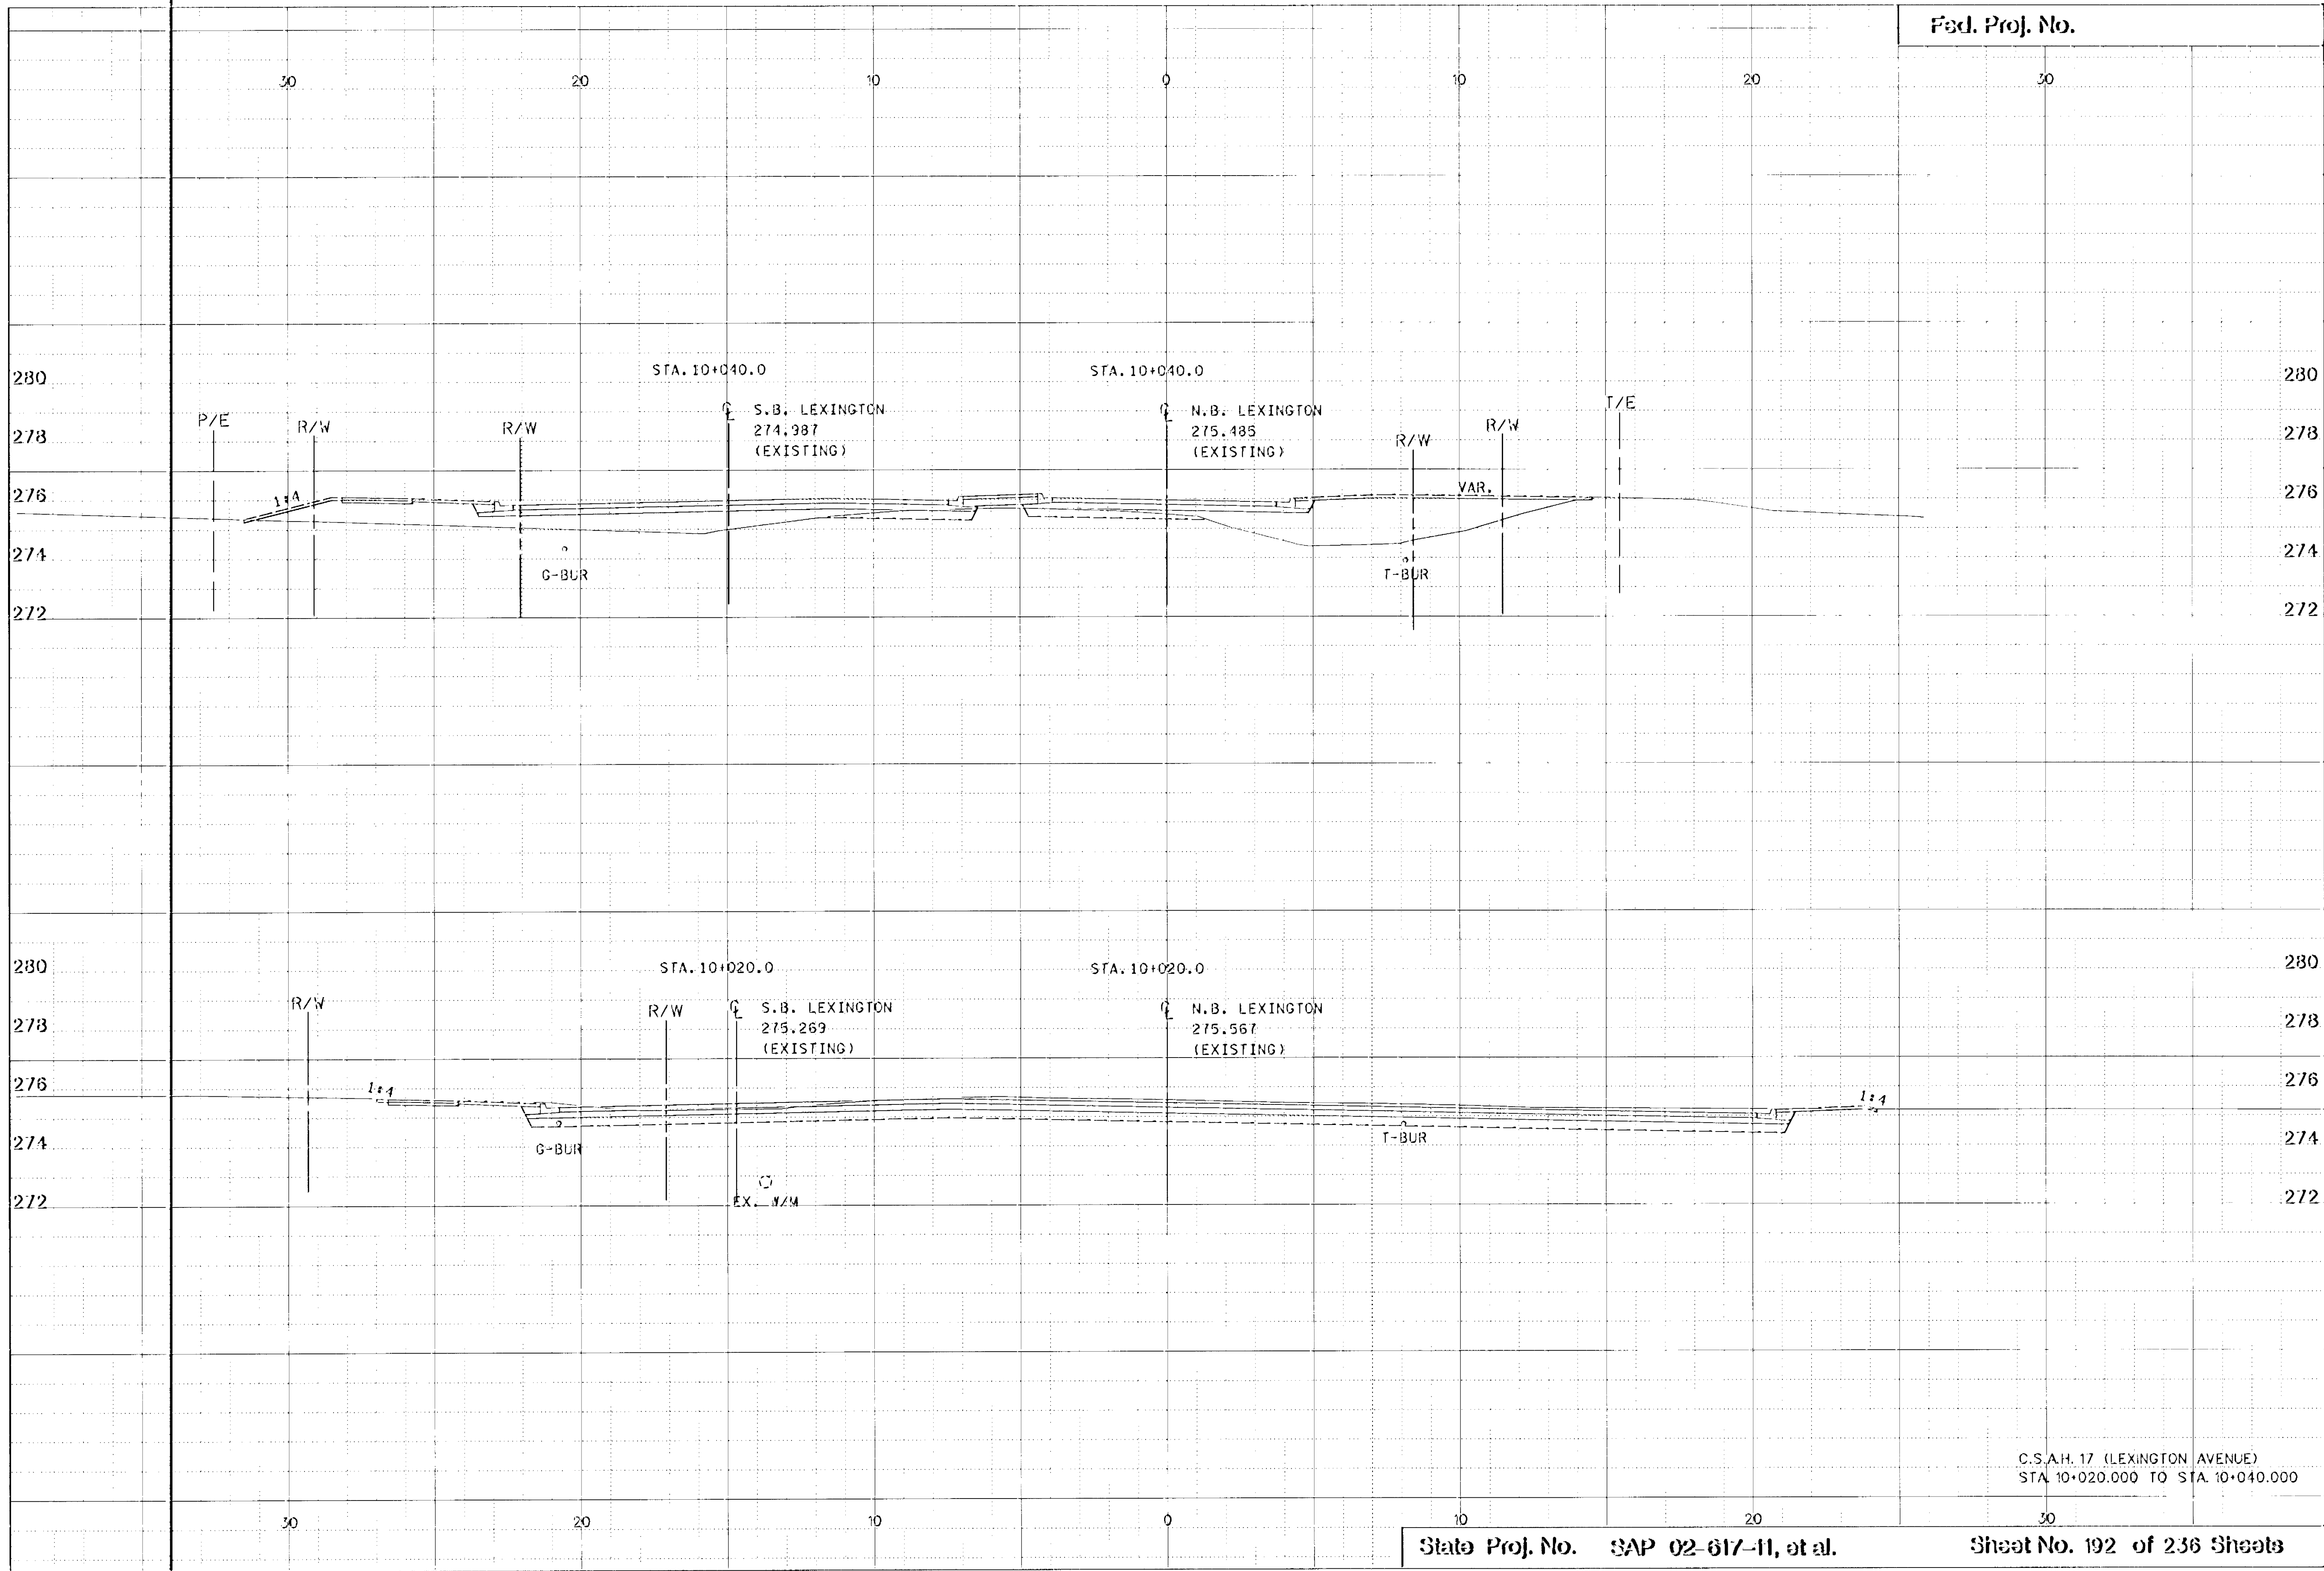

C.S.A.H. 17 (LEXINGTON AVENUE)
STA 10+020.000 TO STA 10+040.000

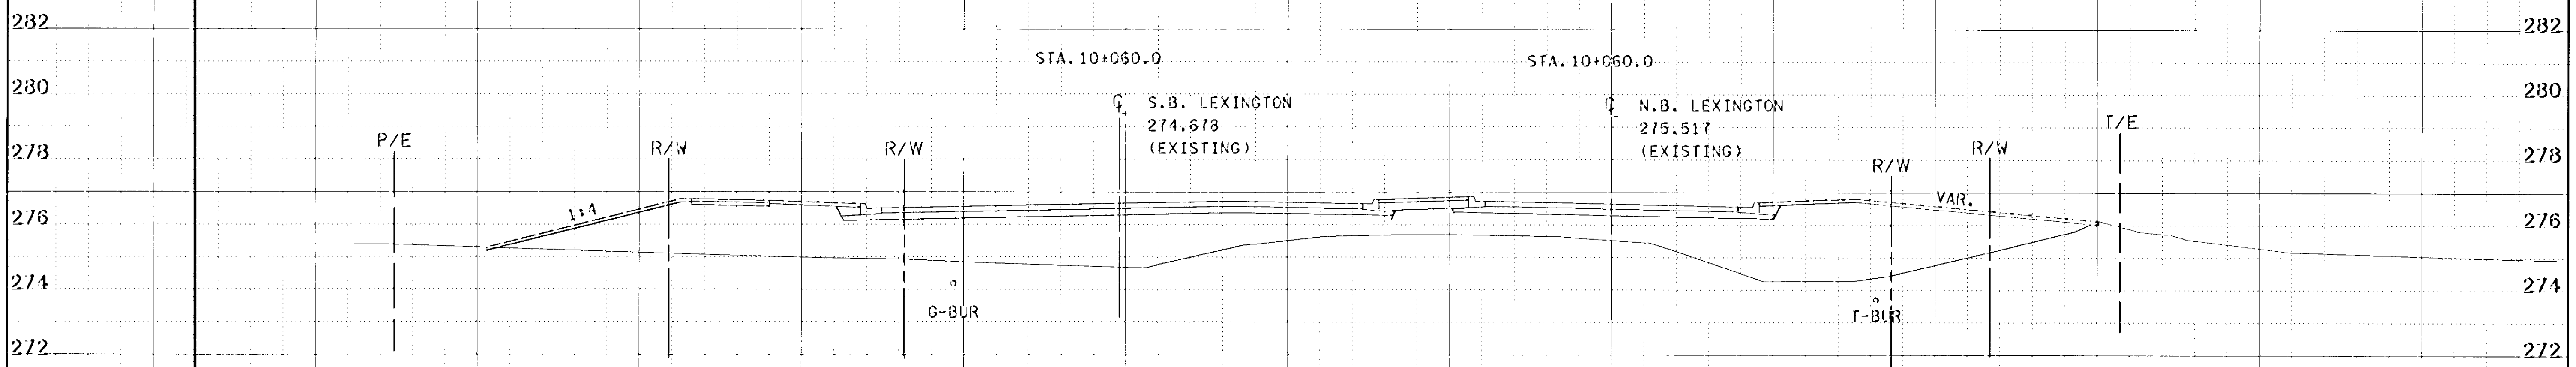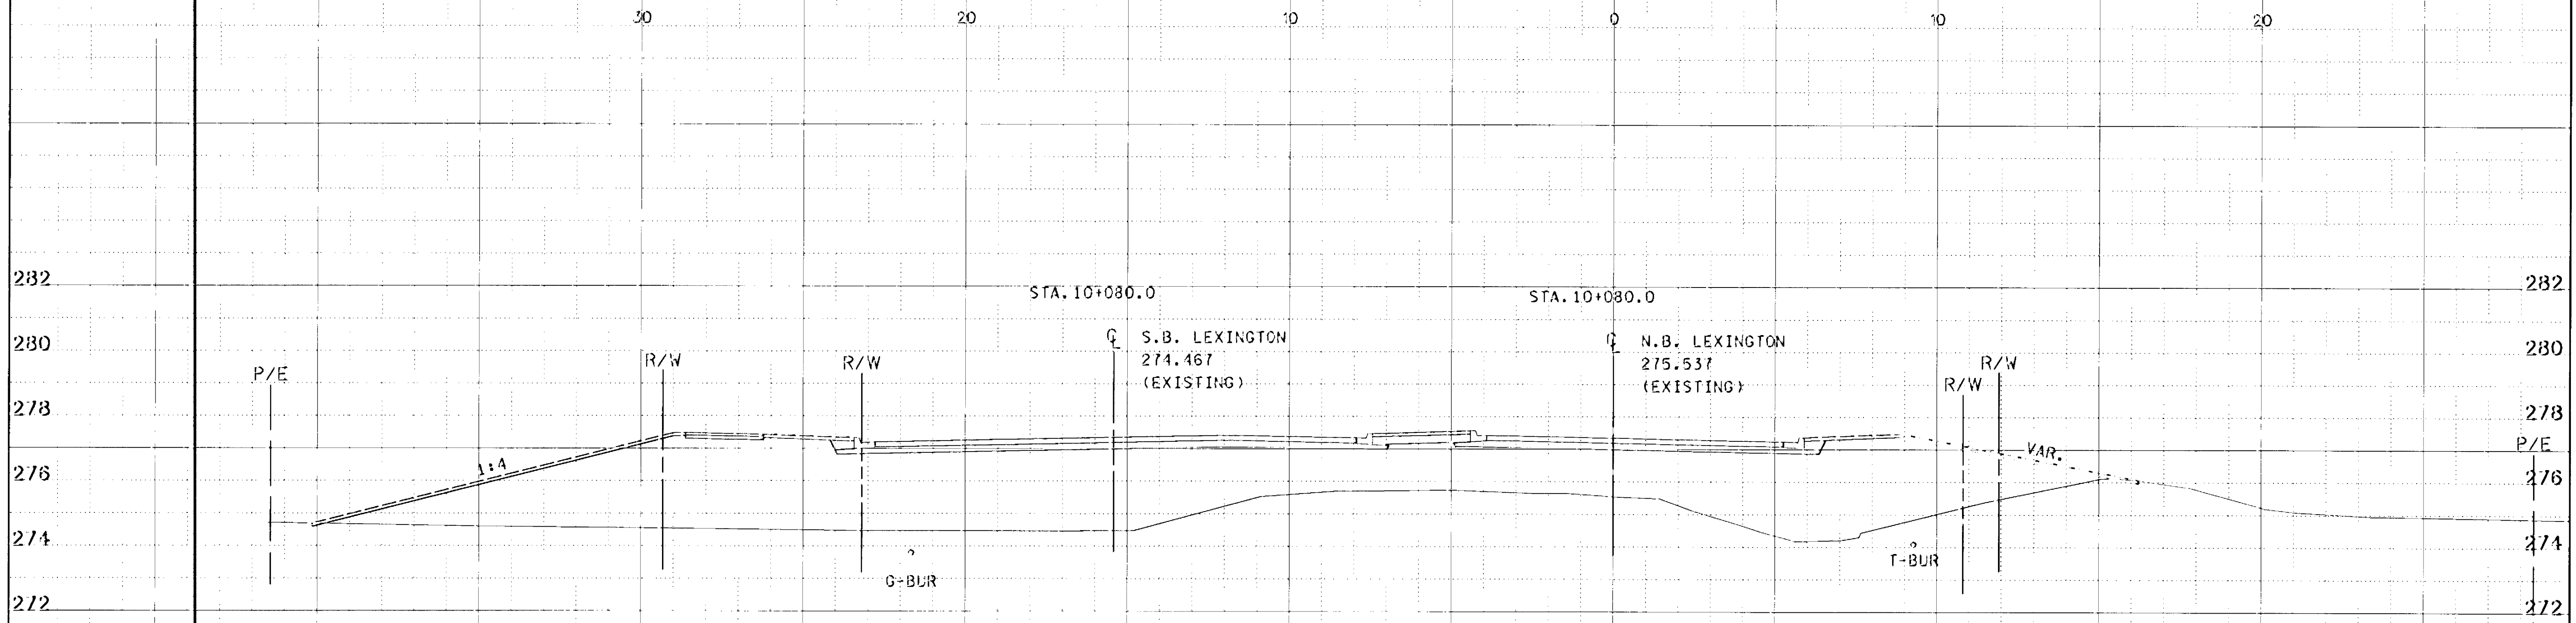

C.S.A.H. 17 (LEXINGTON AVENUE)
STA. 10+060.000 TO STA. 10+080.000

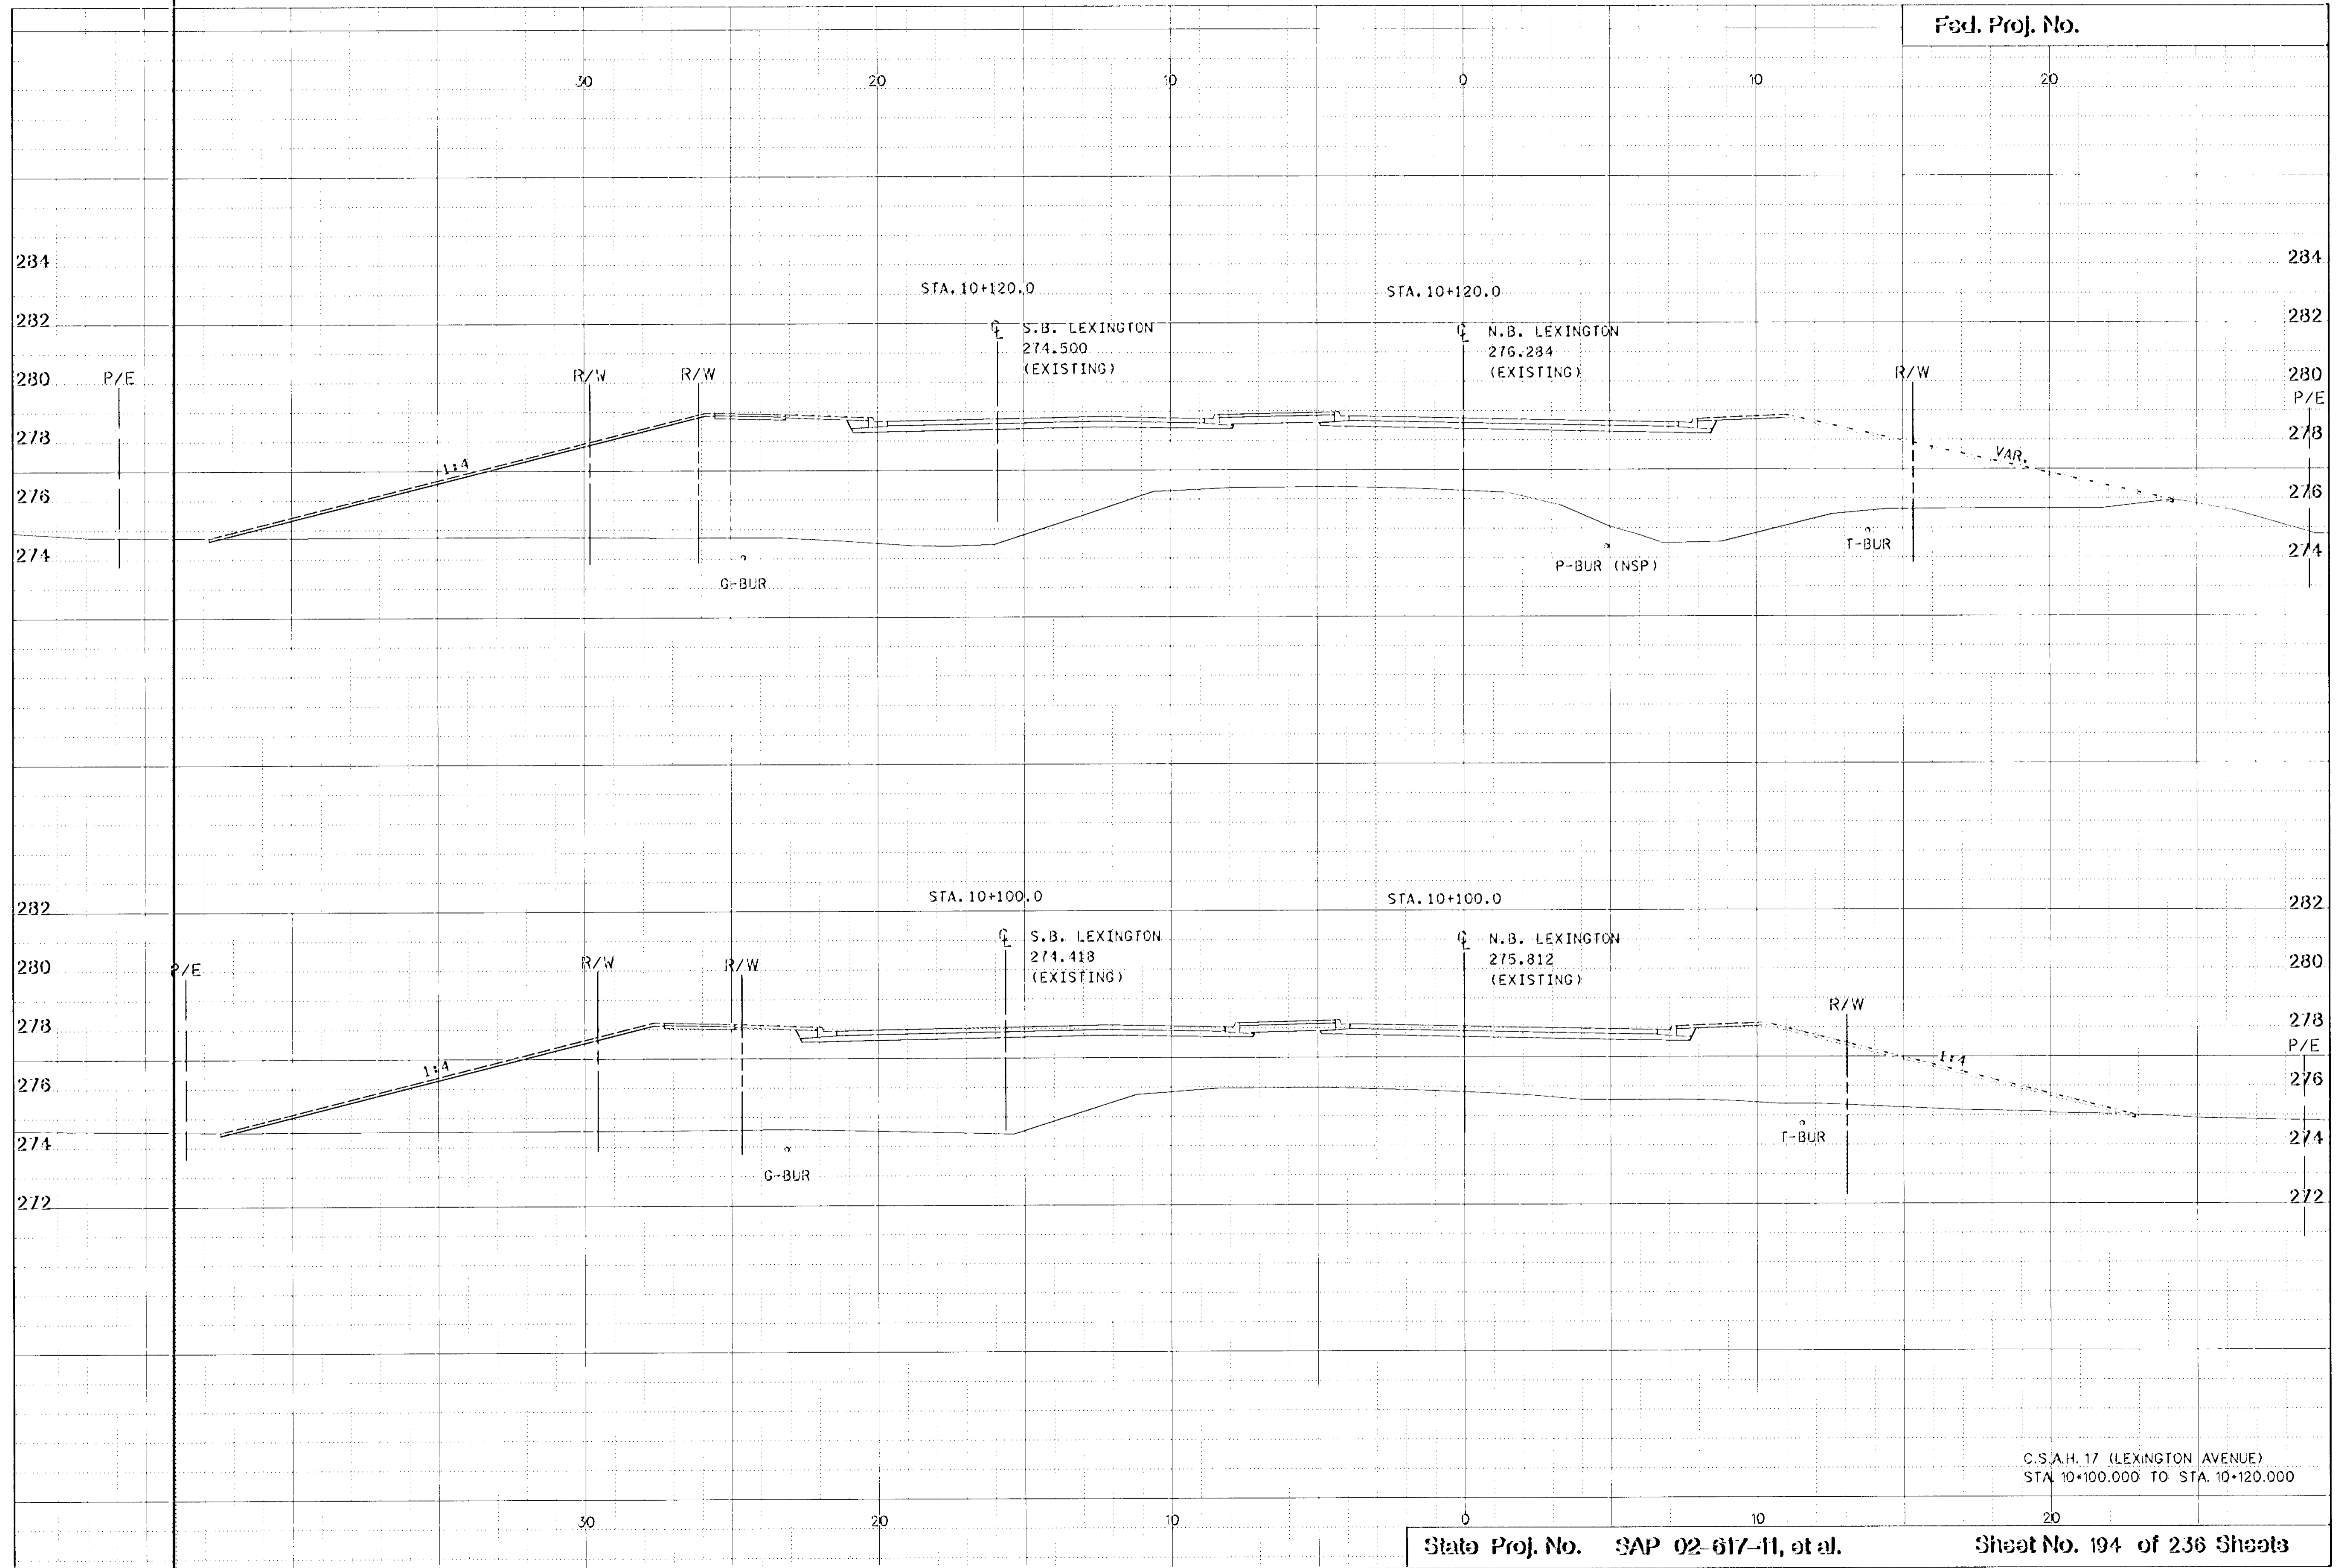


STA. 10+120.0
S.B. LEXINGTON
274.500
(EXISTING)

STA. 10+120.0
N.B. LEXINGTON
276.284
(EXISTING)


STA. 10+100.0
S.B. LEXINGTON
274.418
(EXISTING)


STA. 10+100.0
N.B. LEXINGTON
275.812
(EXISTING)

C.S.A.H. 17 (LEXINGTON AVENUE)
STA 10+100.000 TO STA 10+120.000

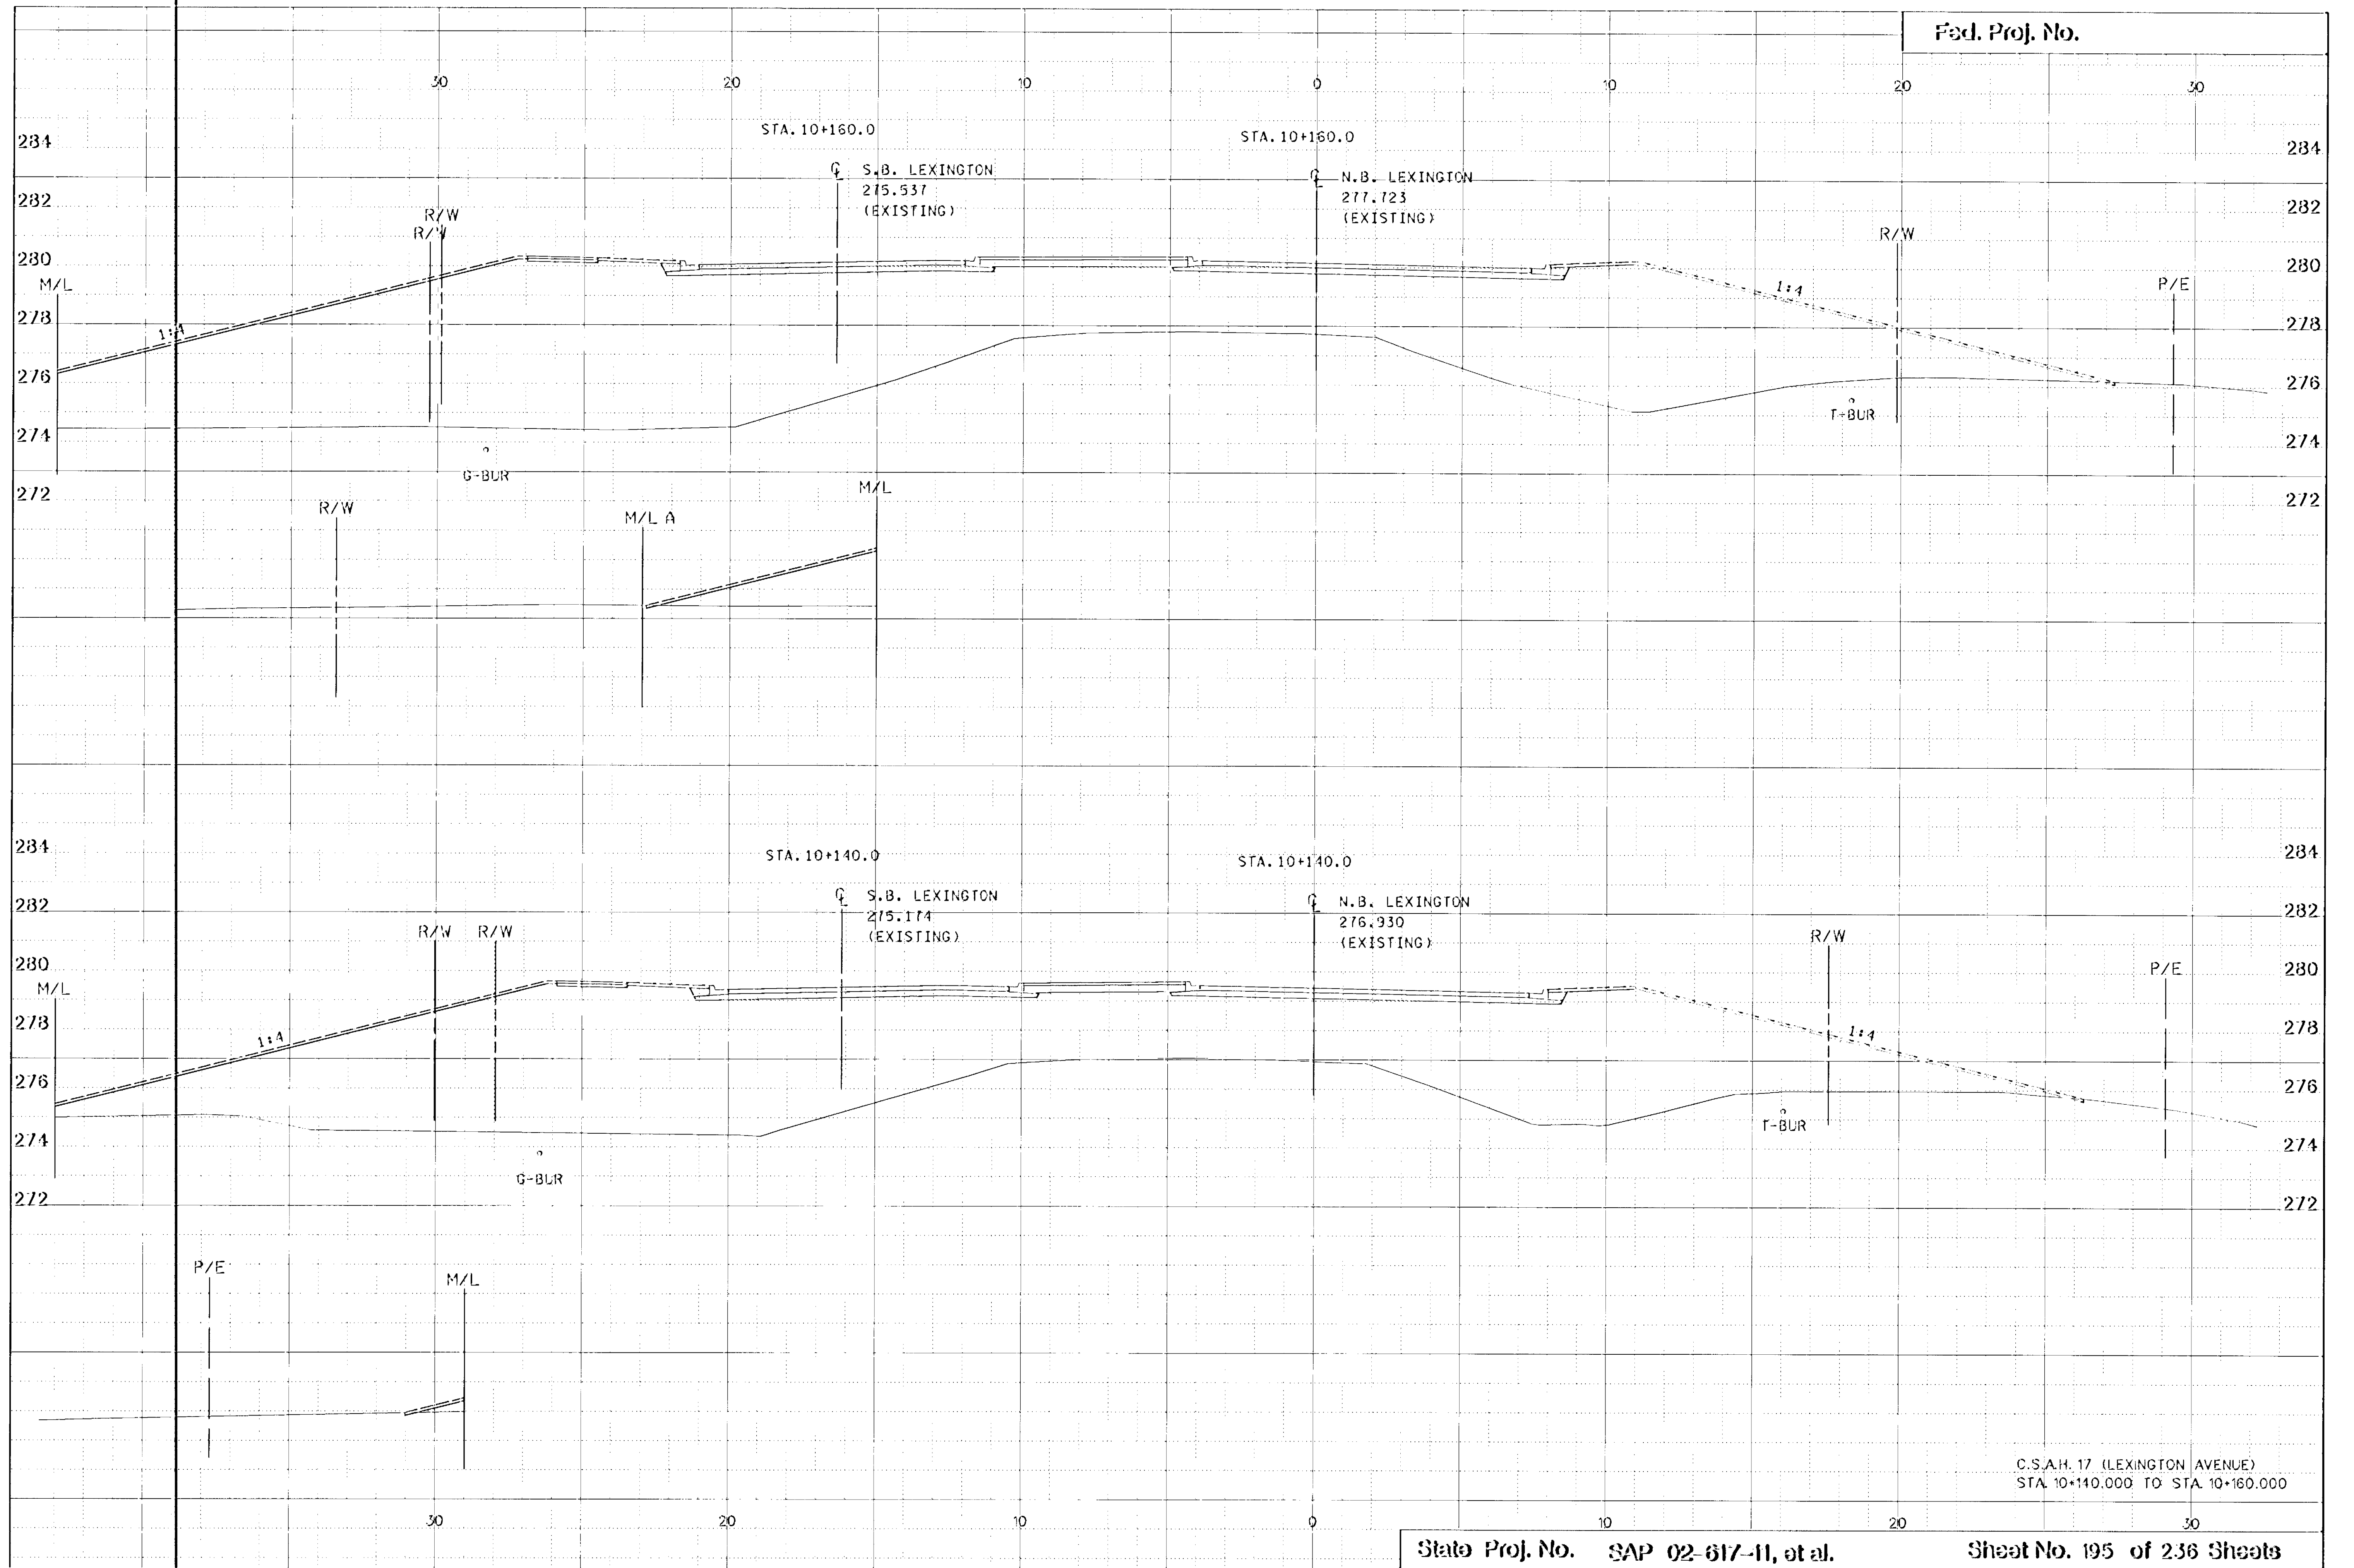


C.S.A.H. 17 (LEXINGTON AVENUE)
STA 10+140.000 TO STA 10+160.000

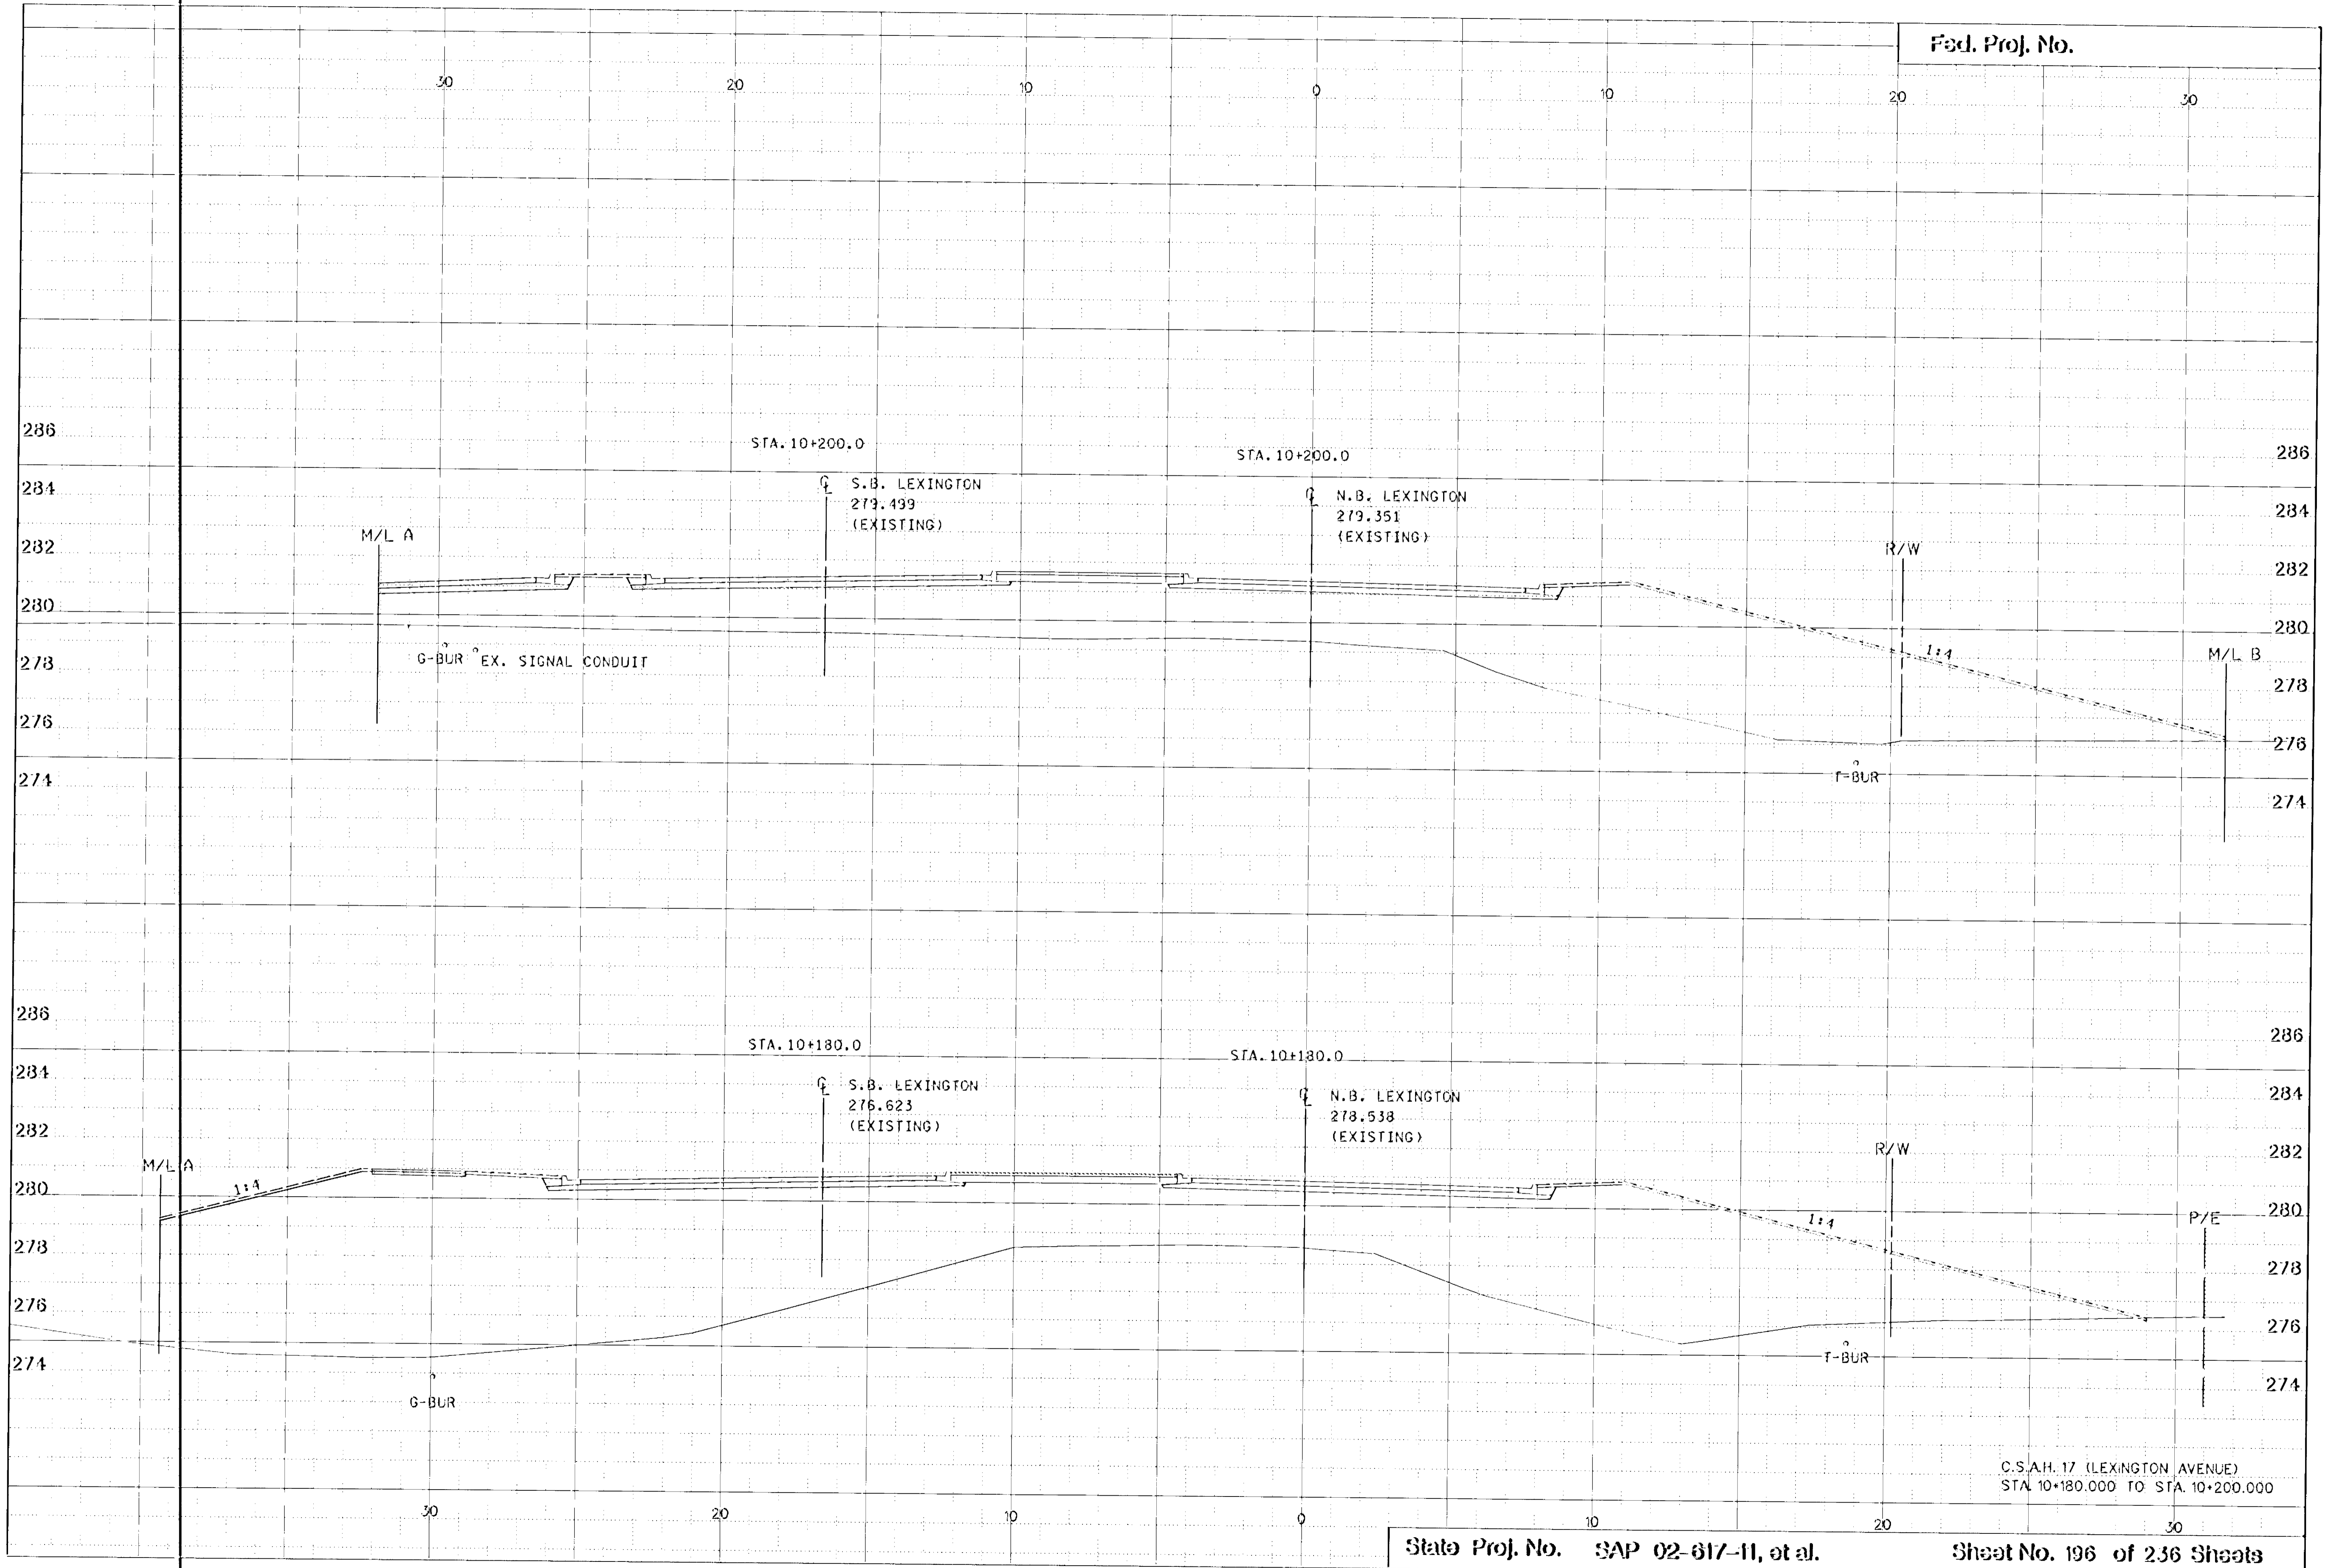


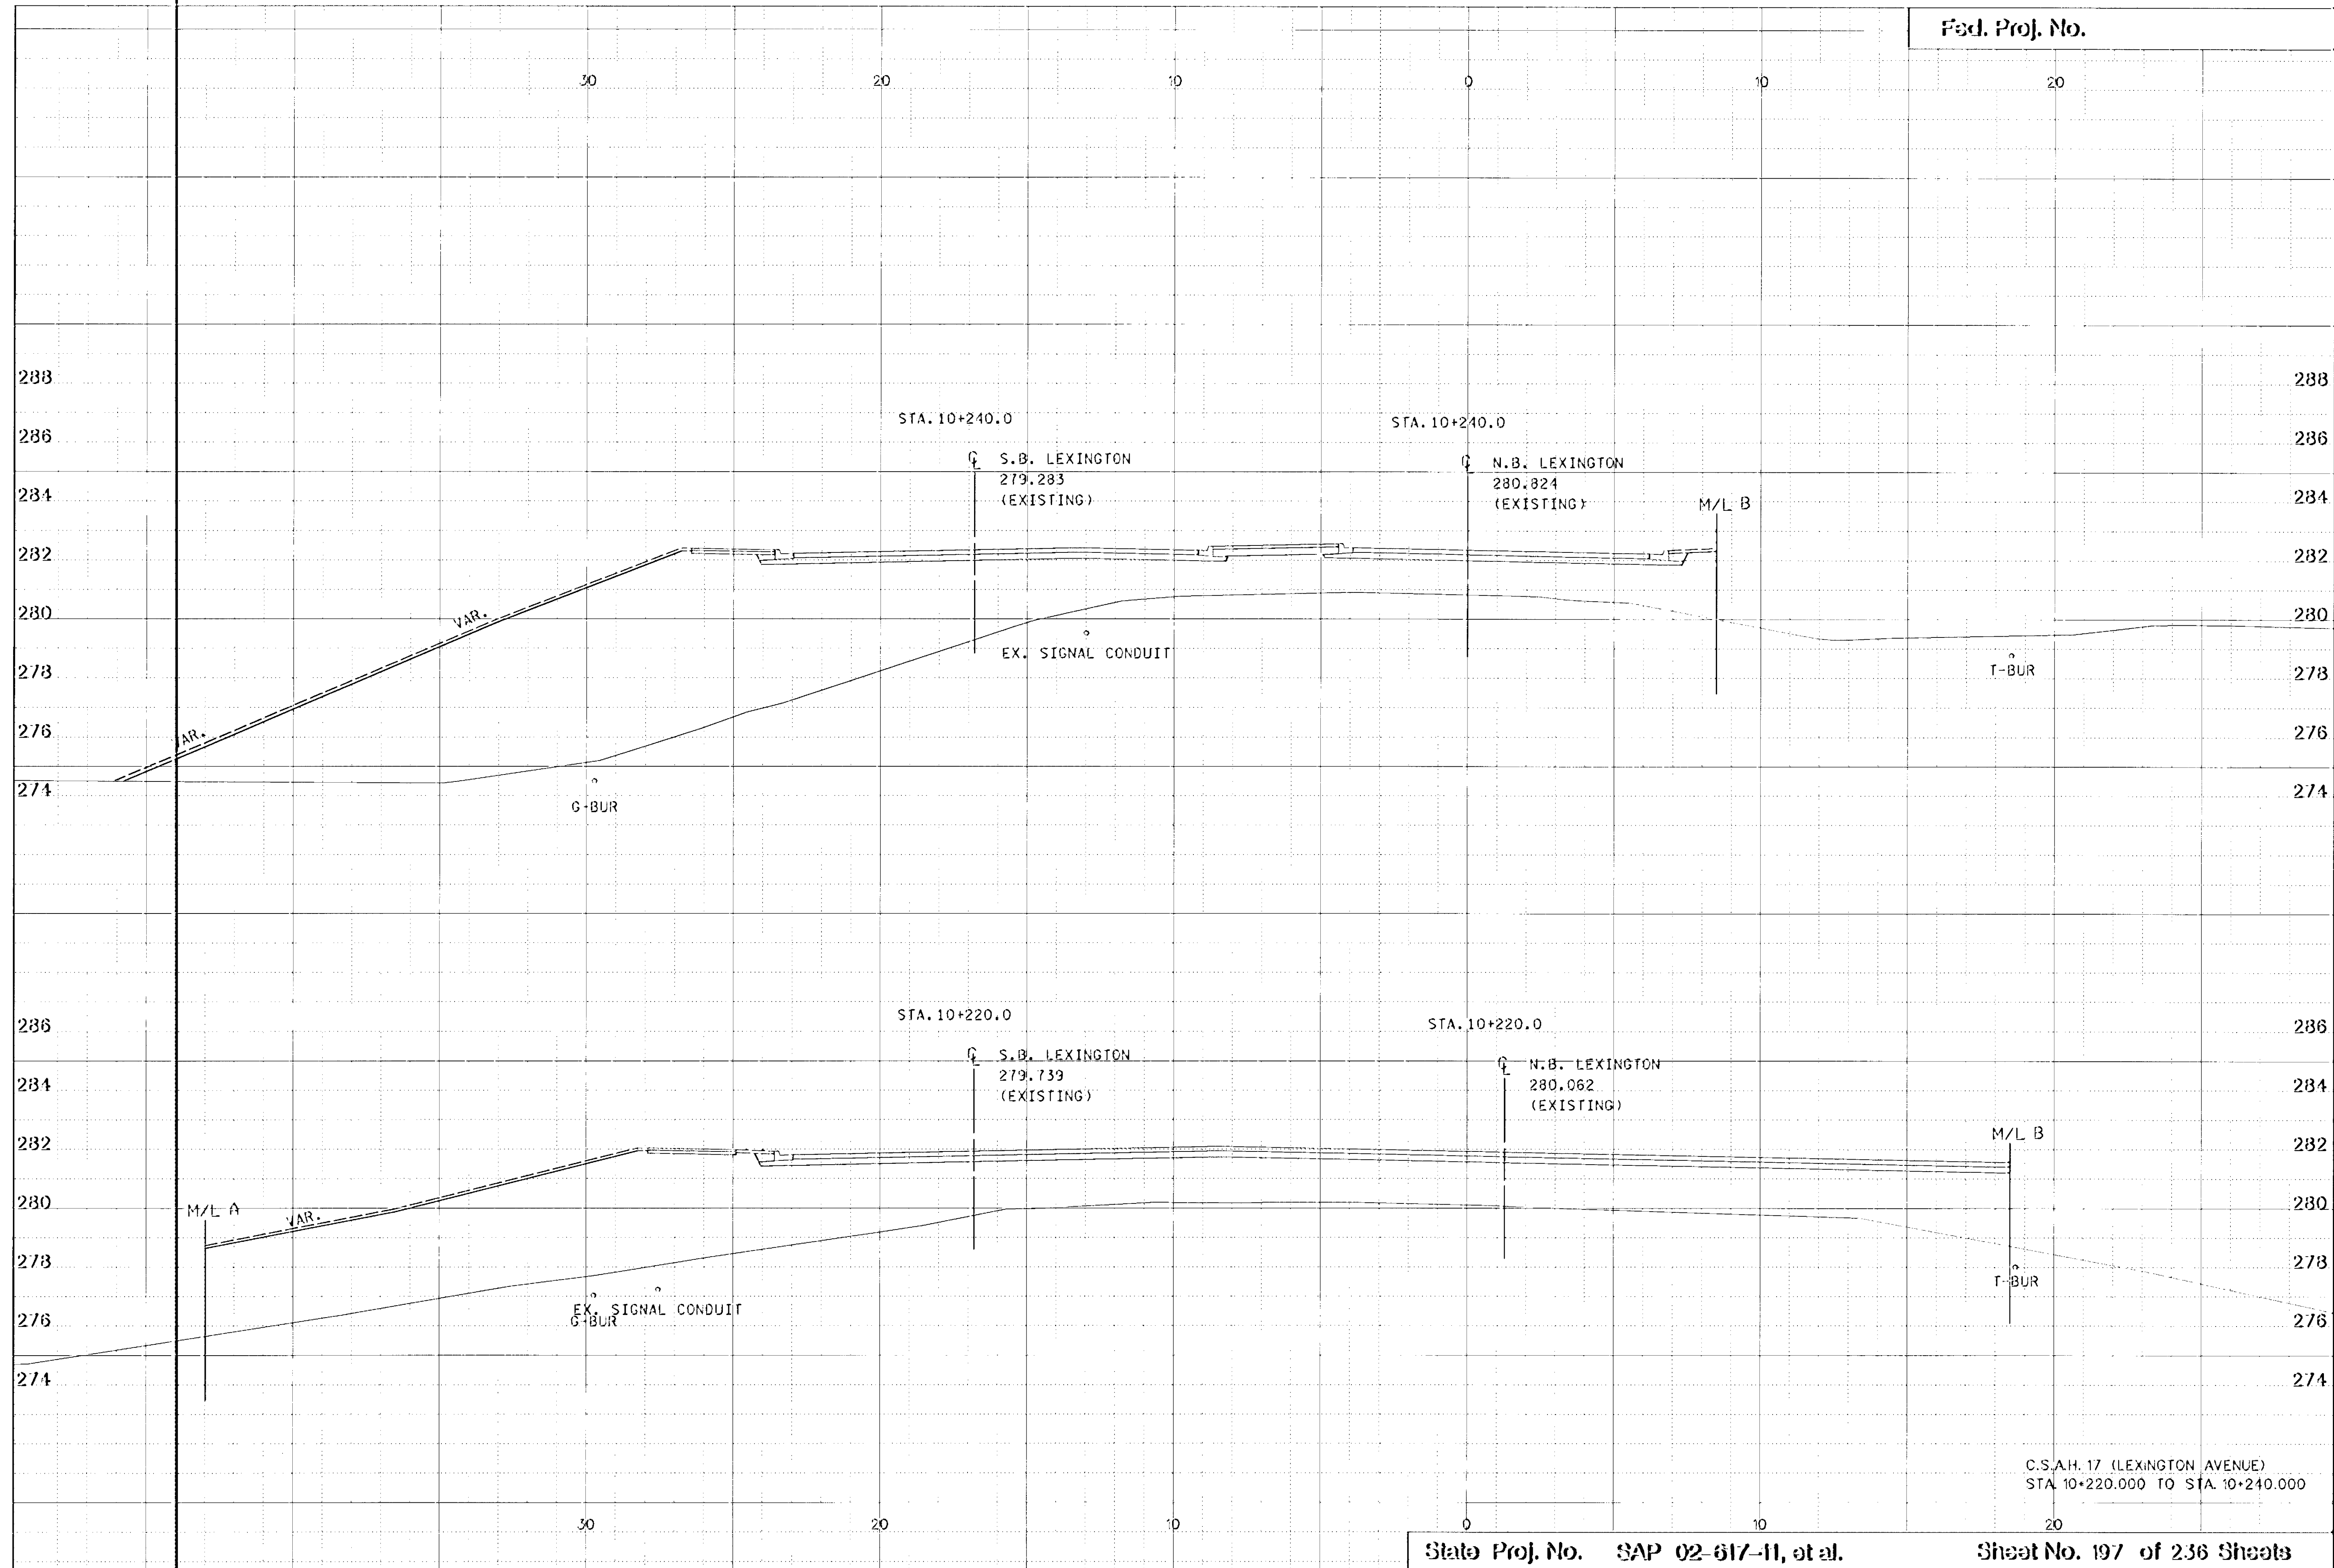


C.S.A.H. 17 (LEXINGTON AVENUE)
STA. 10+220.000 TO STA. 10+240.000

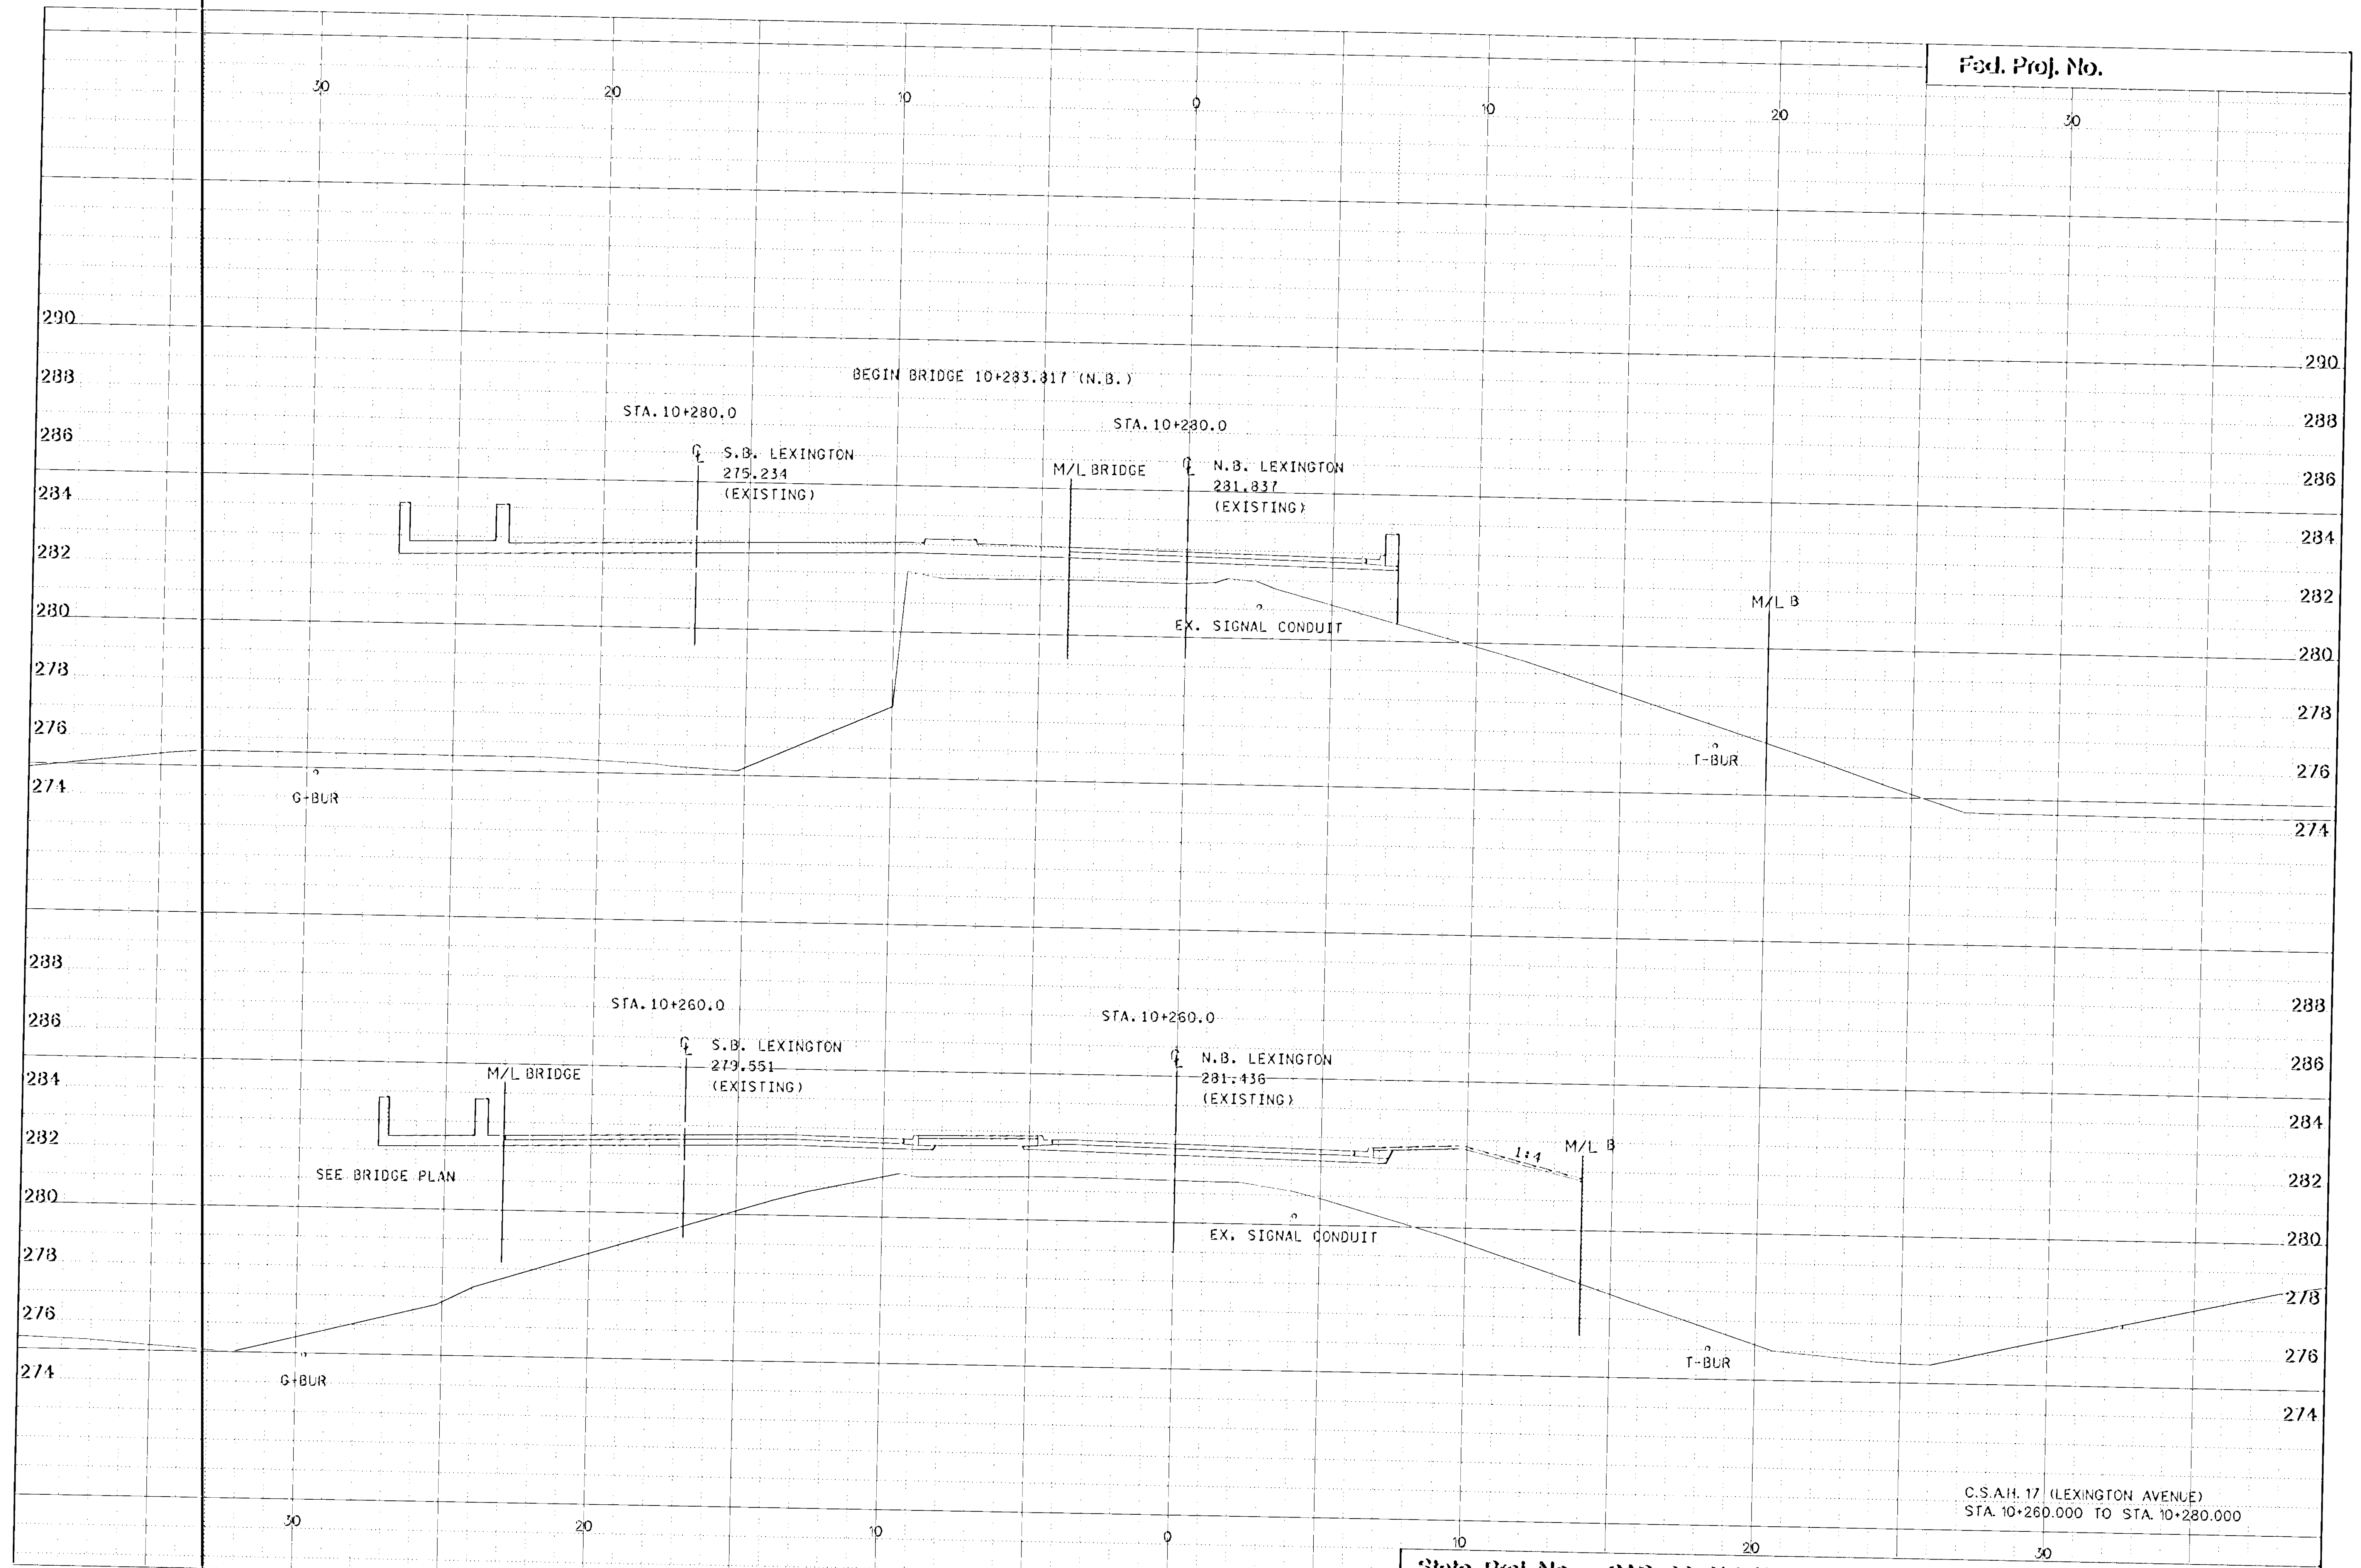



C.S.A.H. 17 (LEXINGTON AVENUE)
STA. 10+260.000 TO STA. 10+280.000

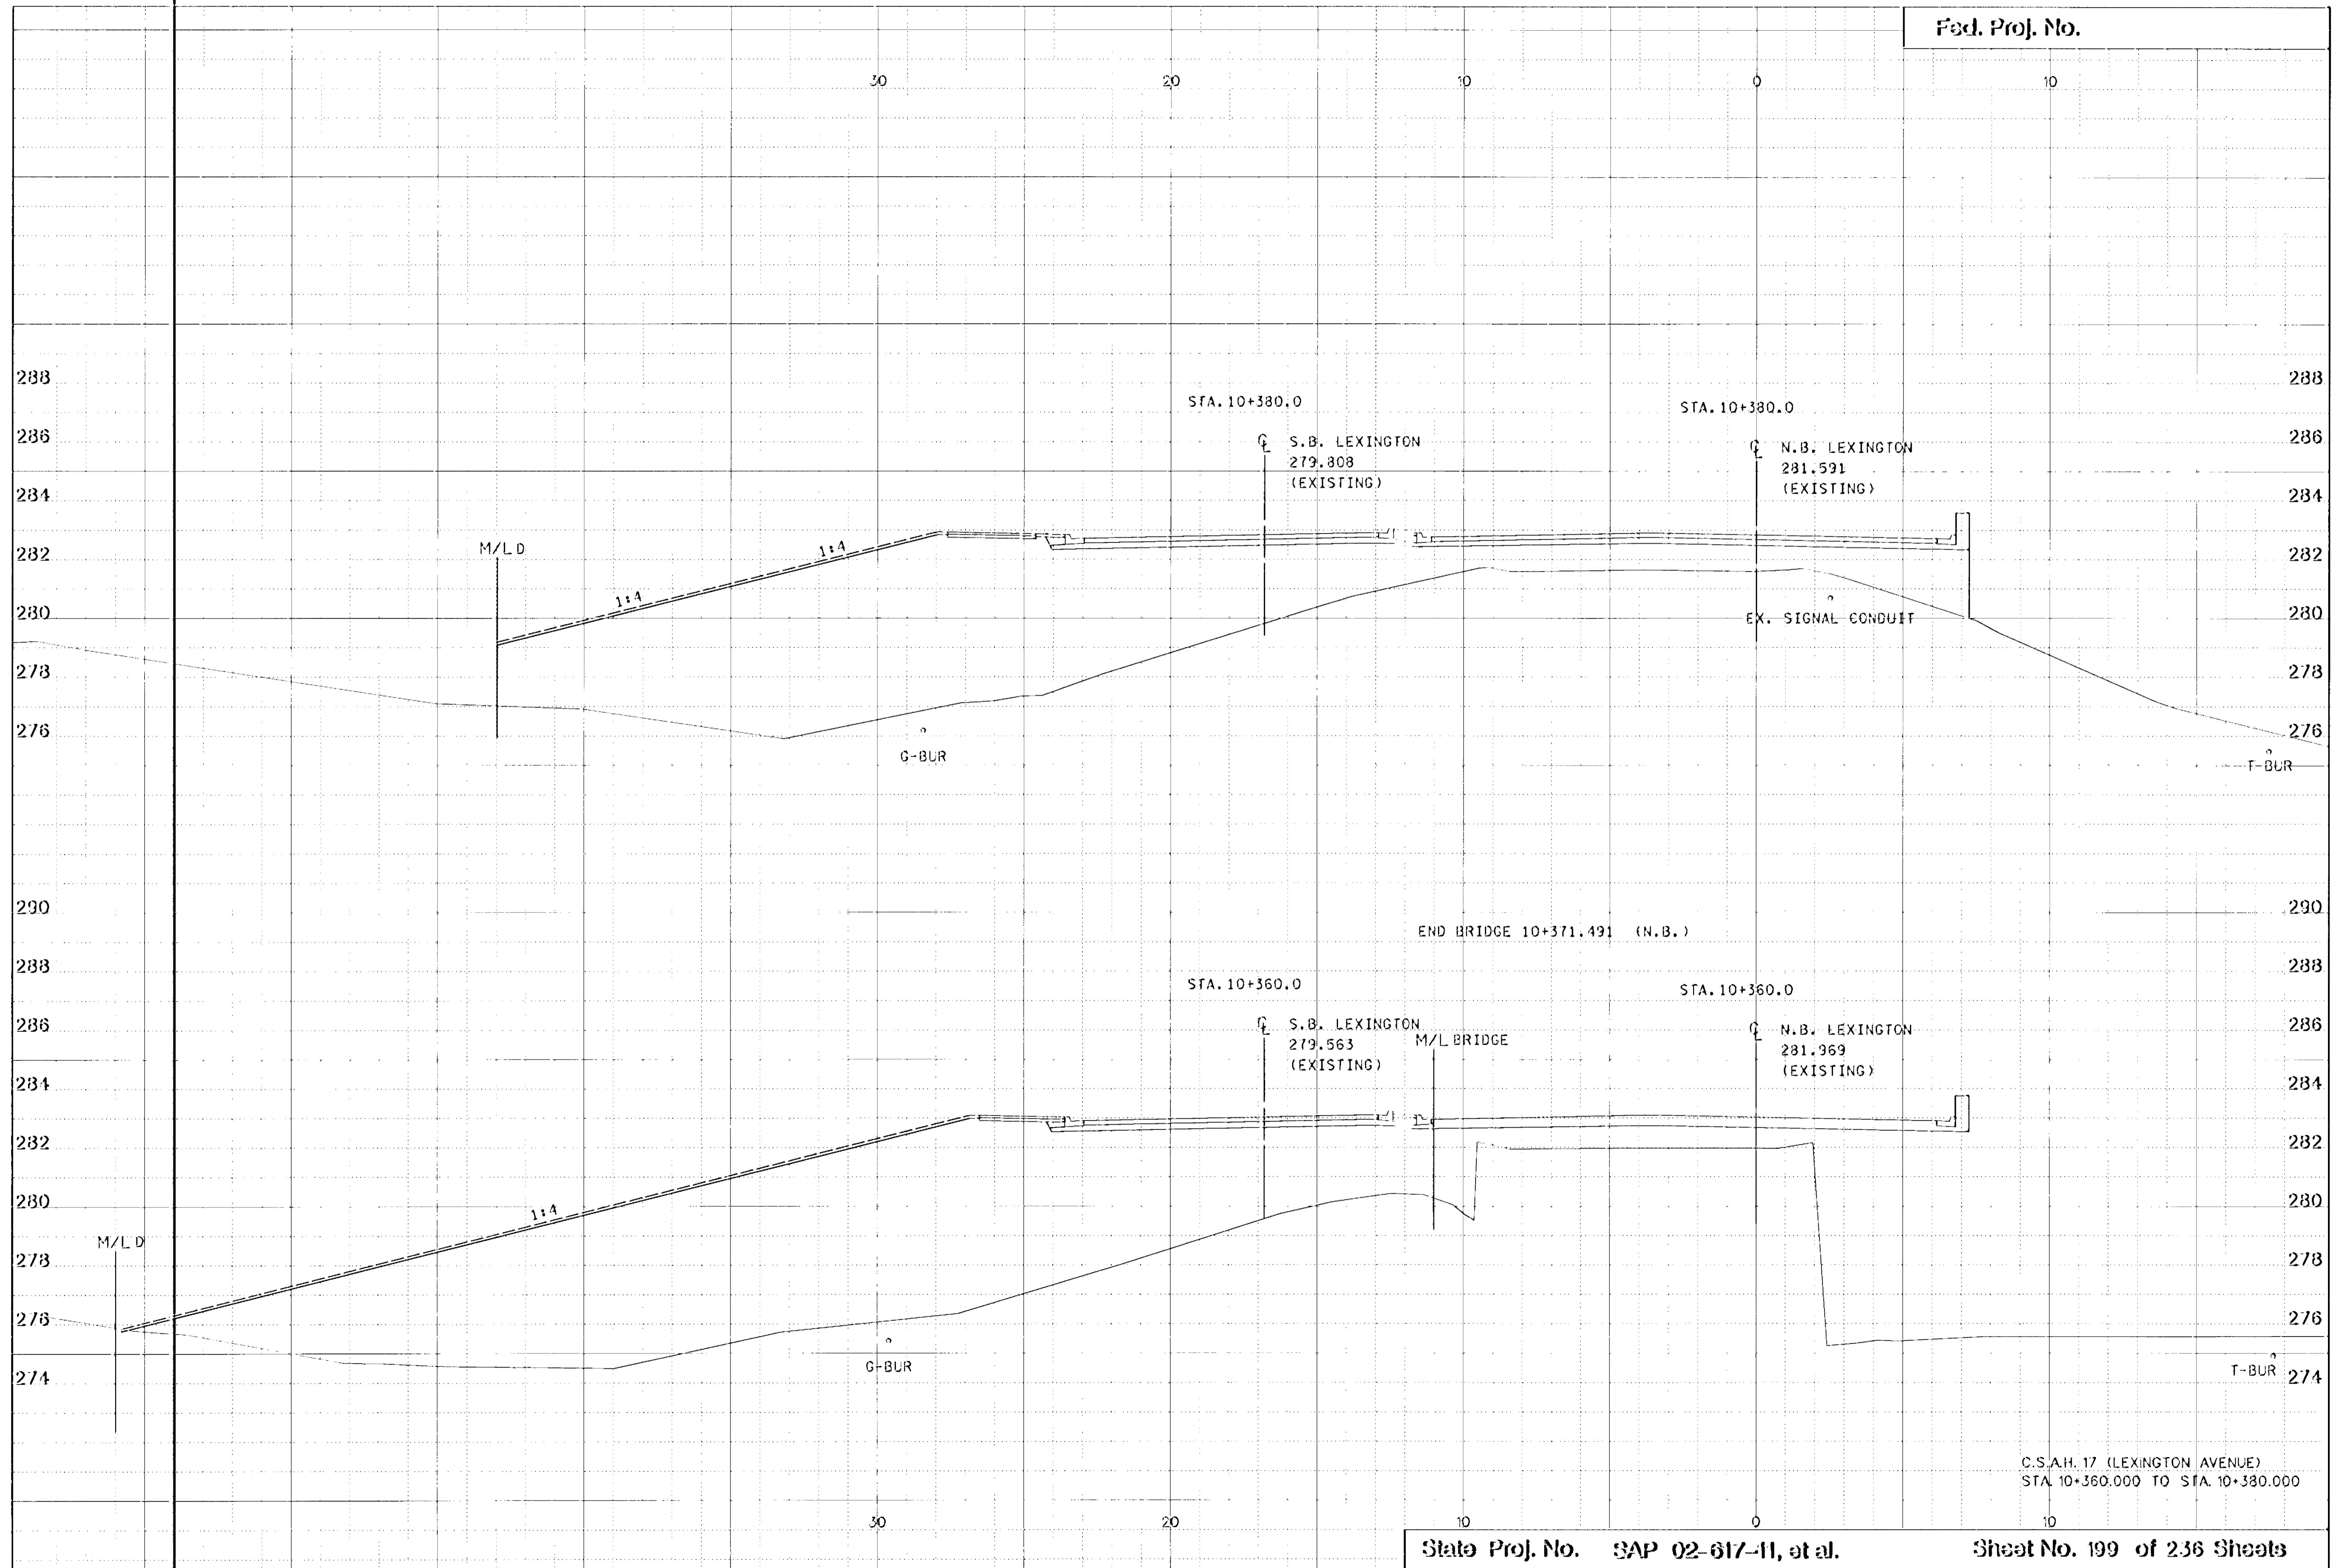


C.S.A.H. 17 (LEXINGTON AVENUE)
STA 10+360.000 TO STA 10+380.000

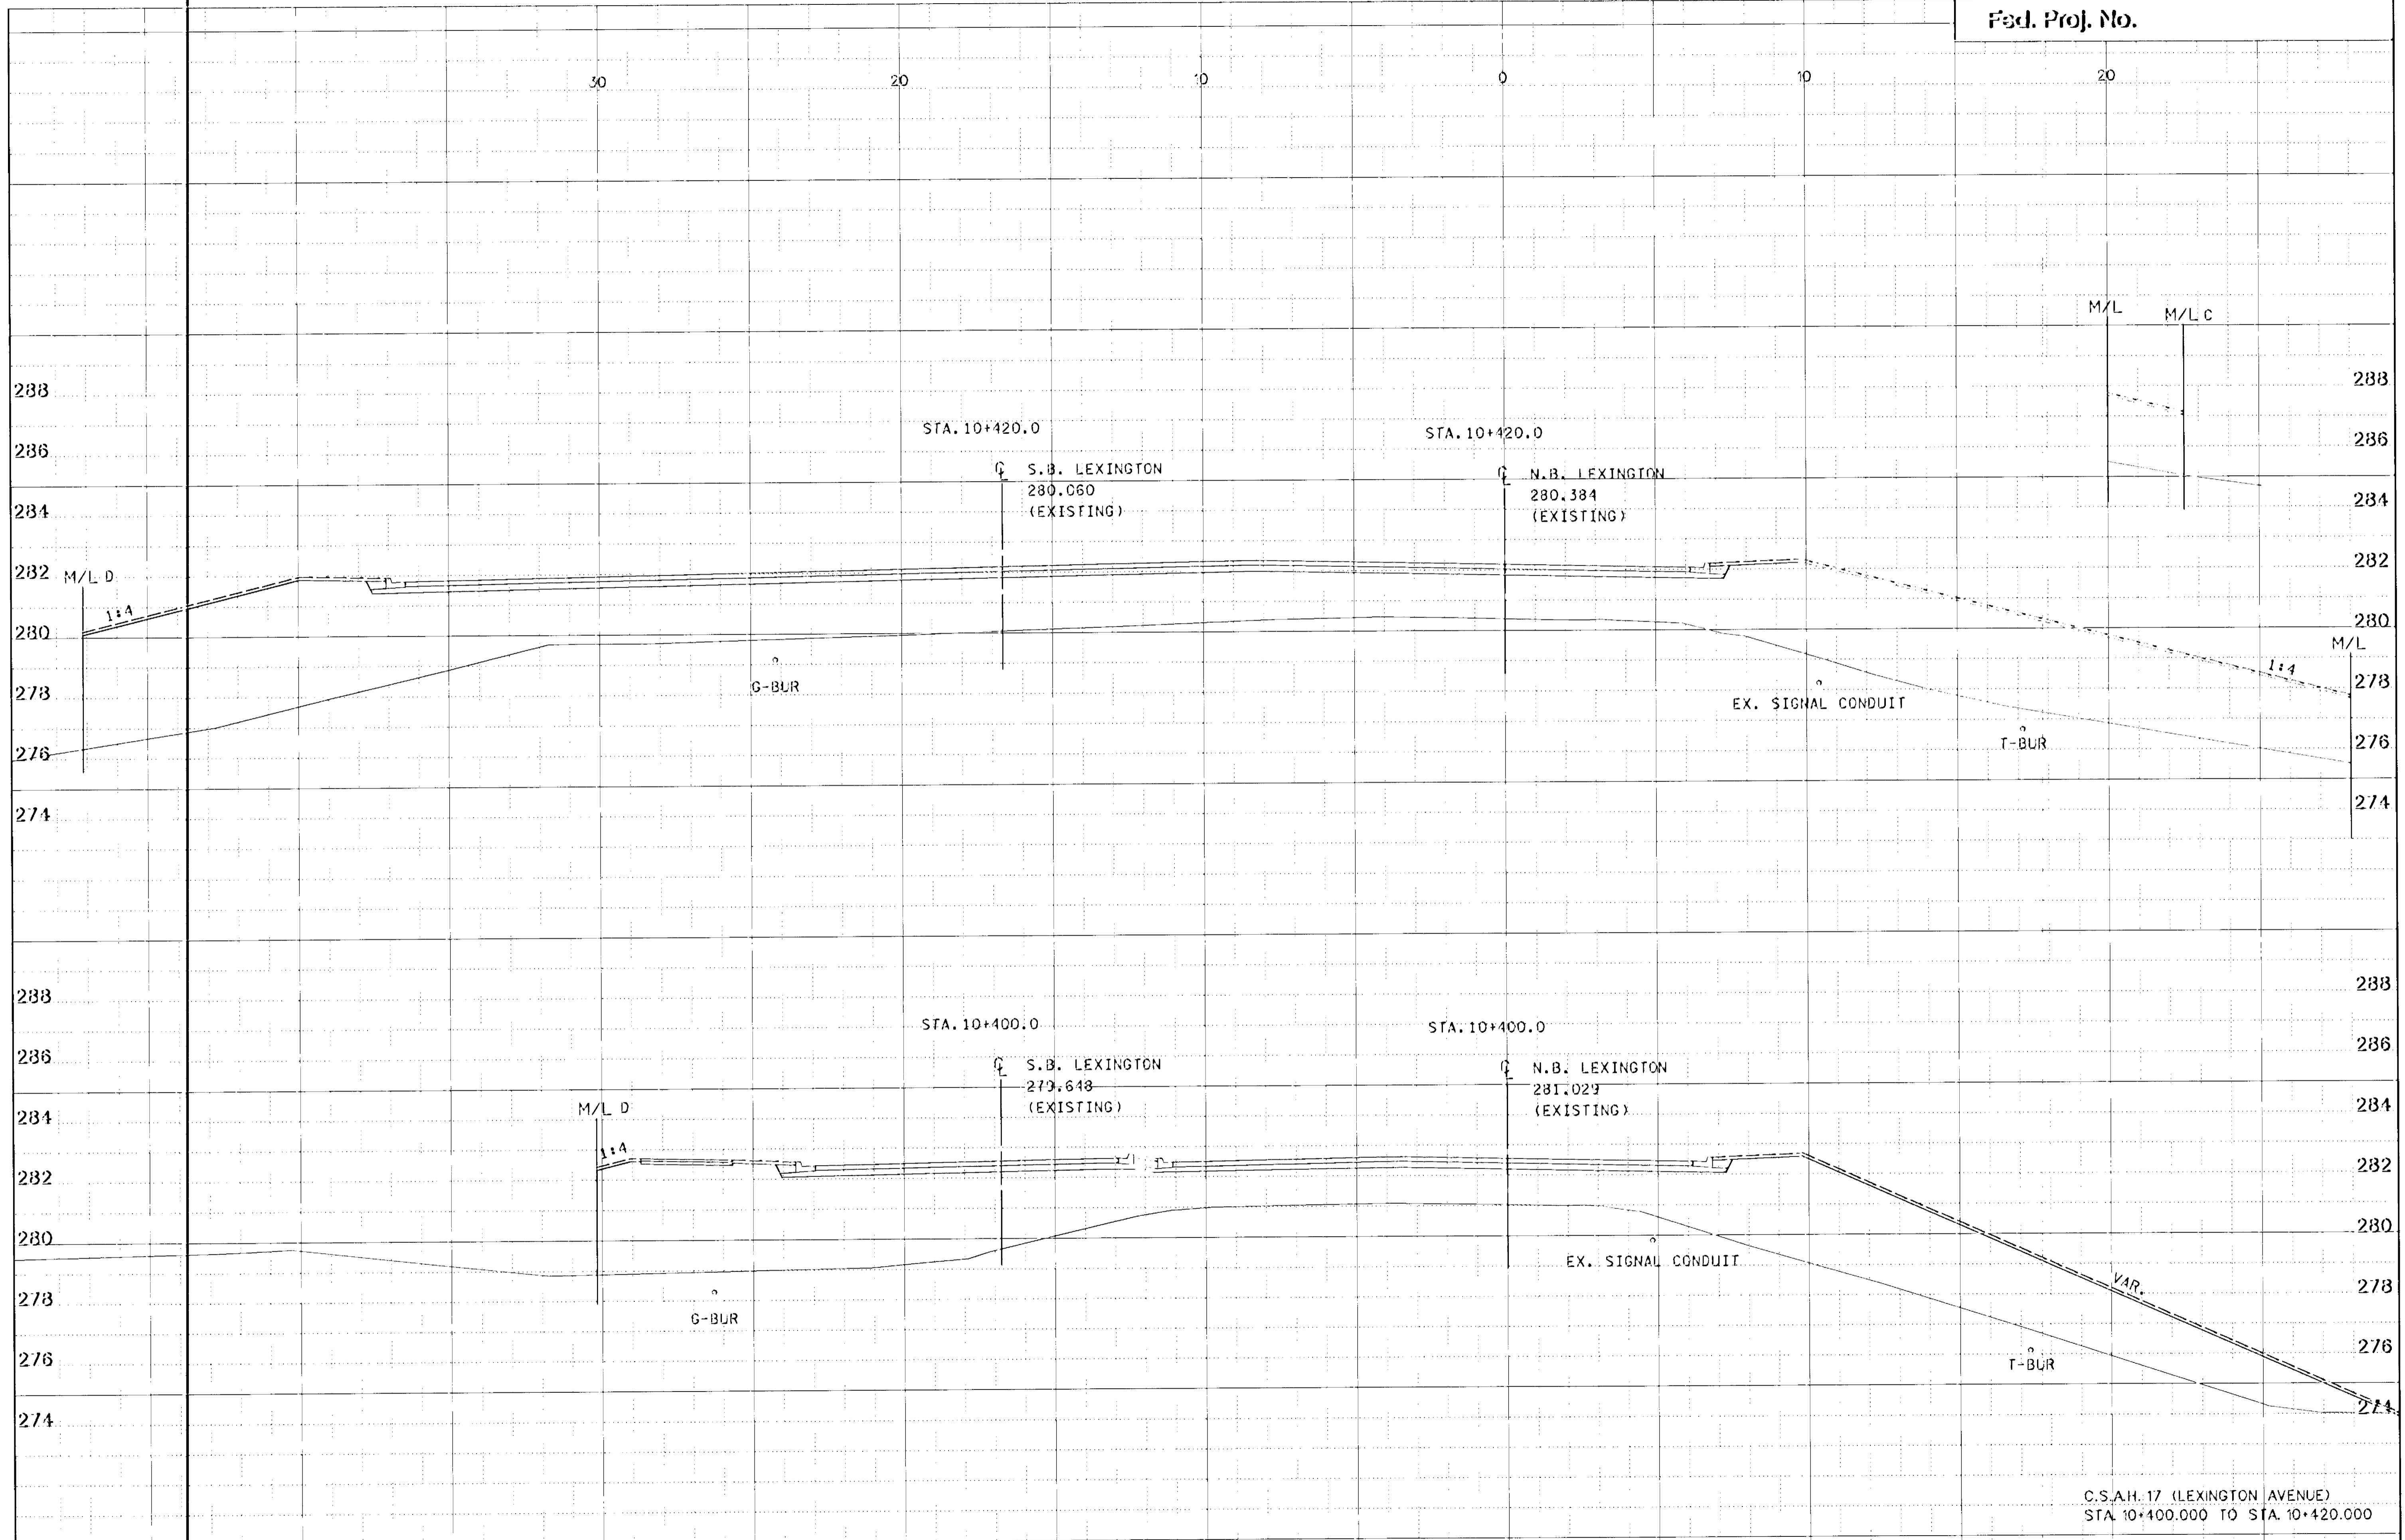


C.S.A.H. 17 (LEXINGTON AVENUE)
STA. 10+400.000 TO STA. 10+420.000

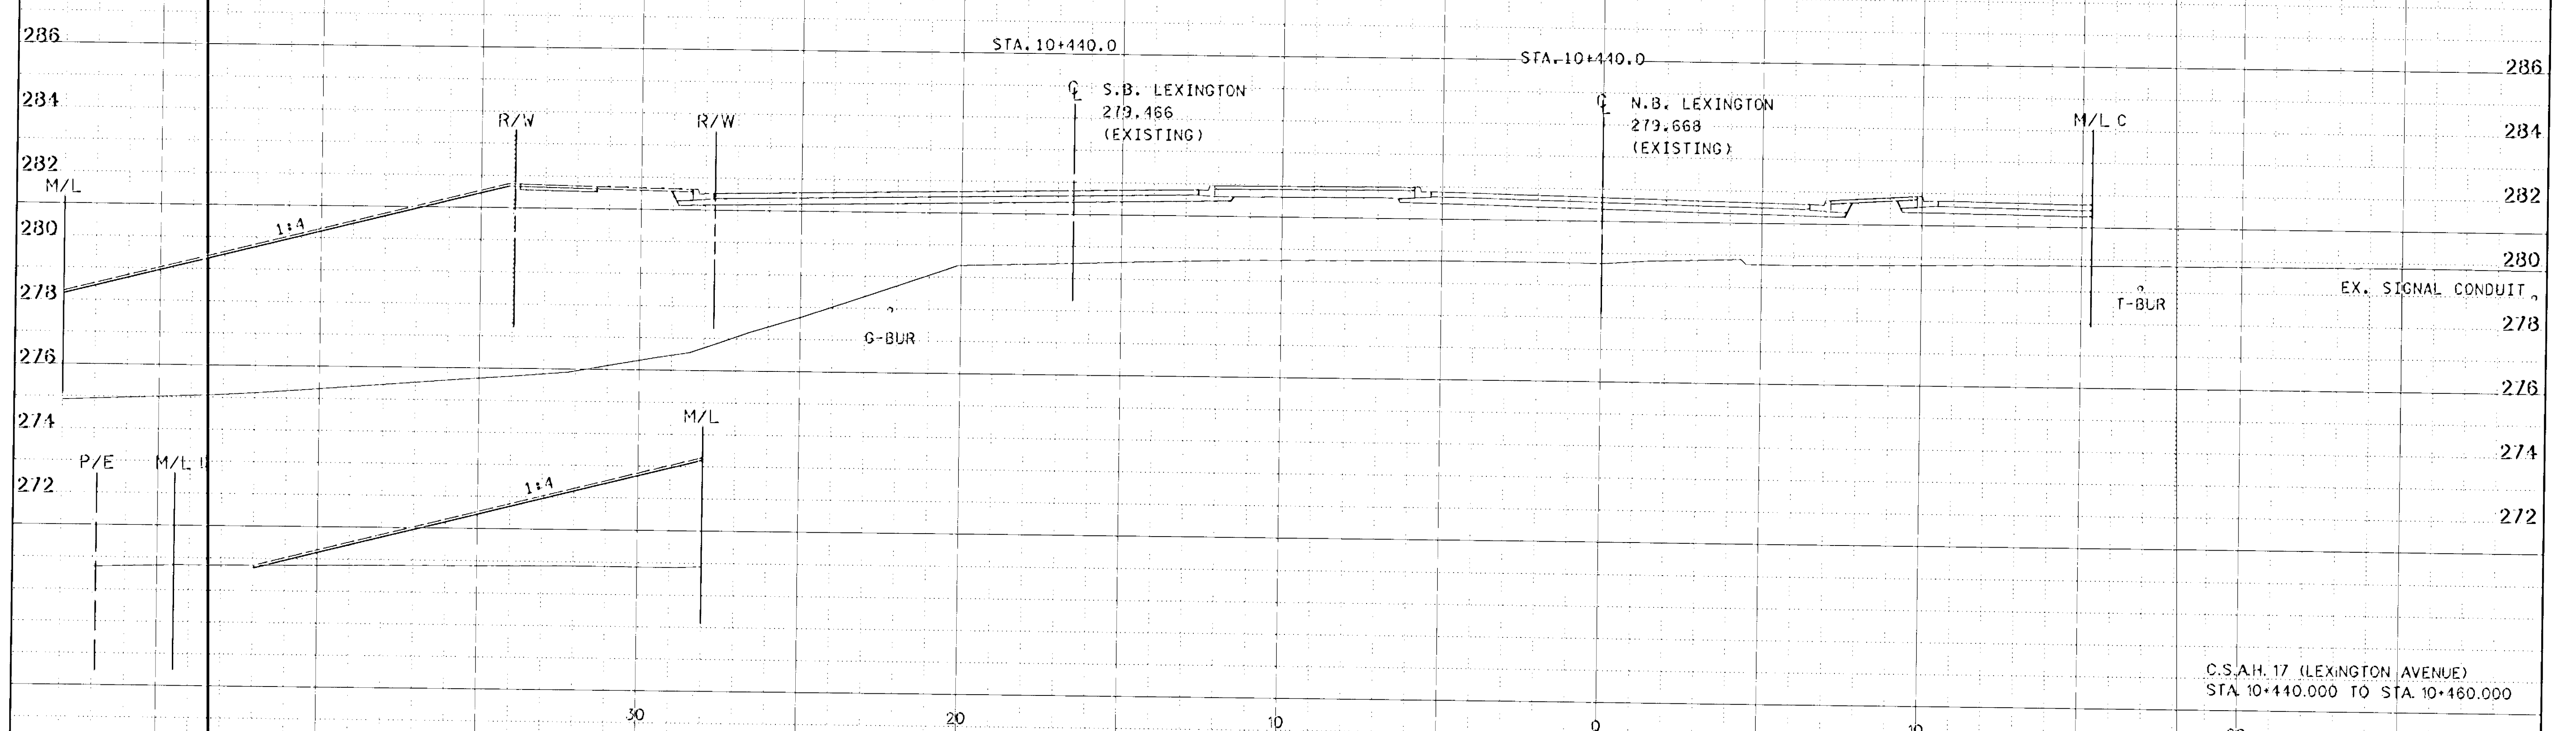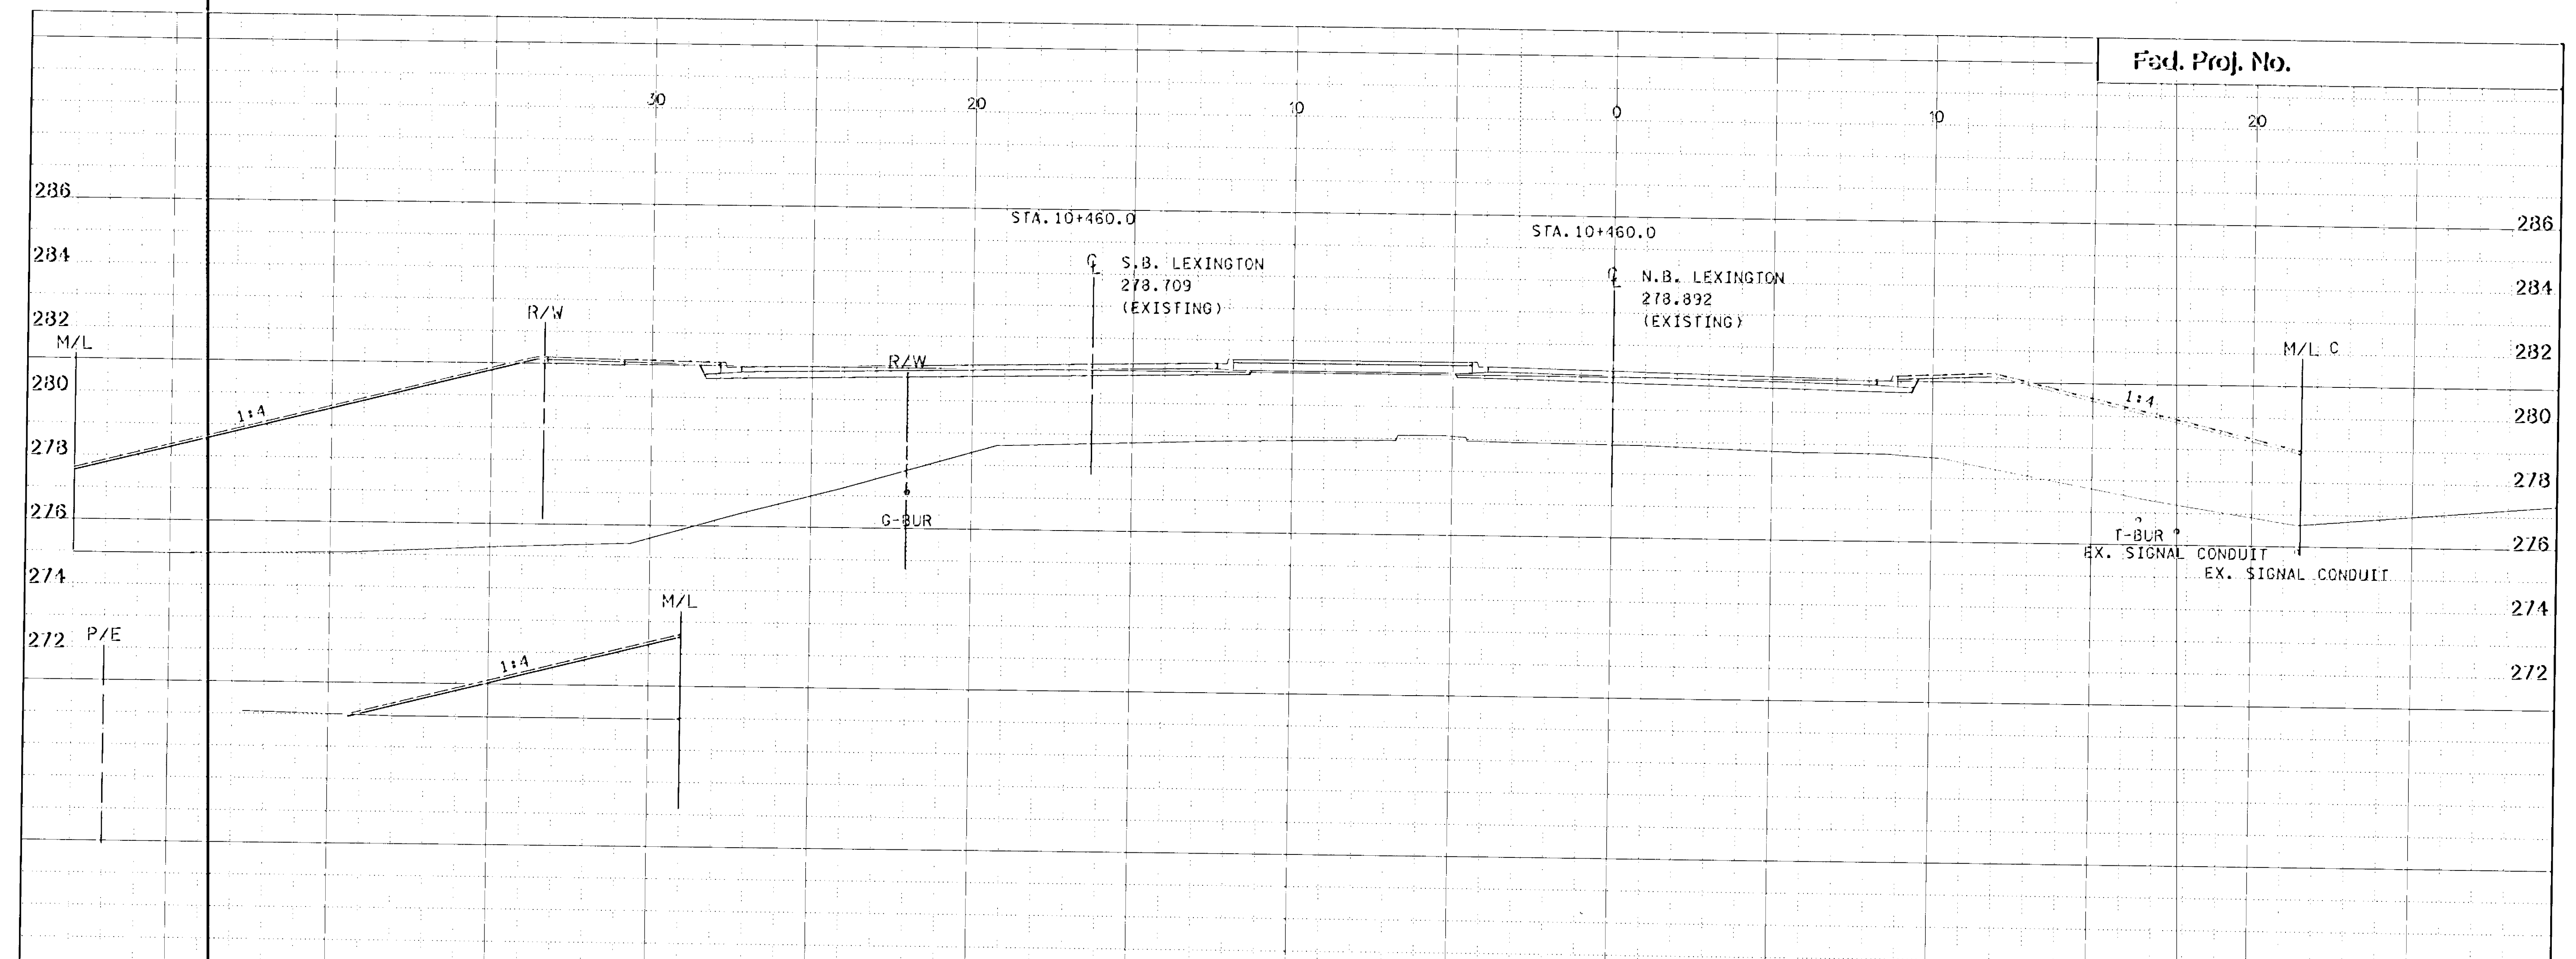


C.S.A.H. 17 (LEXINGTON AVENUE)
STA. 10+440.000 TO STA. 10+460.000

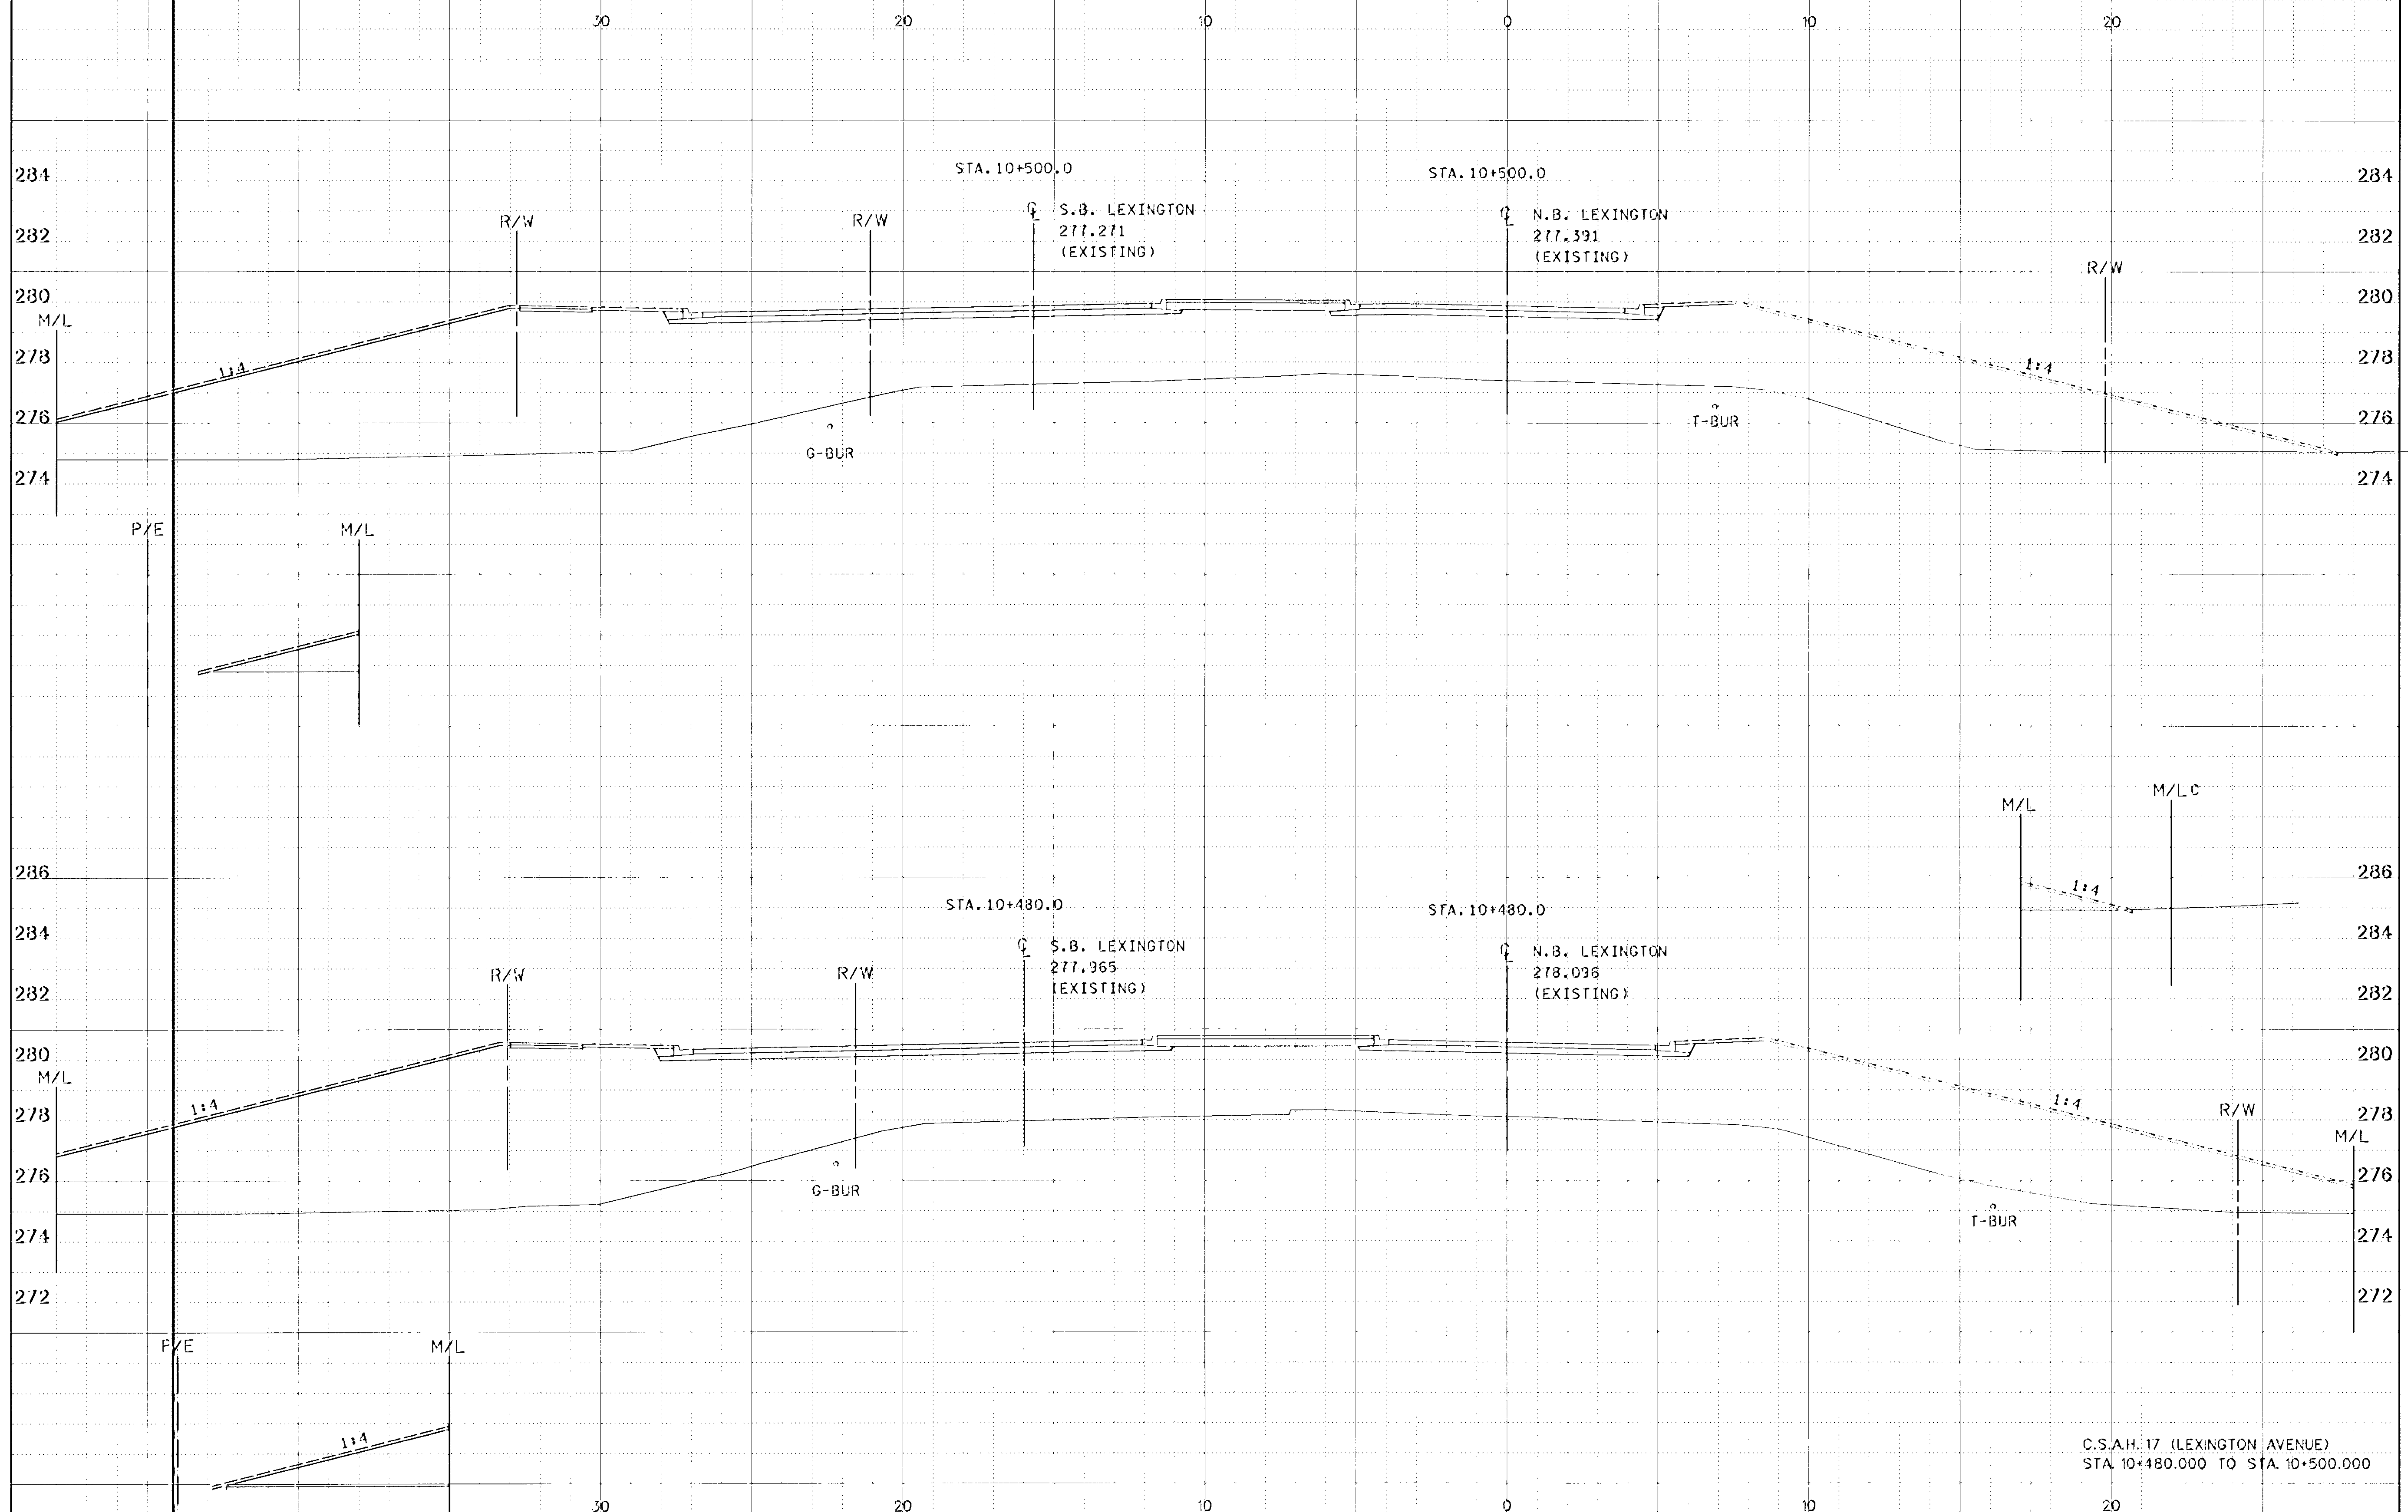

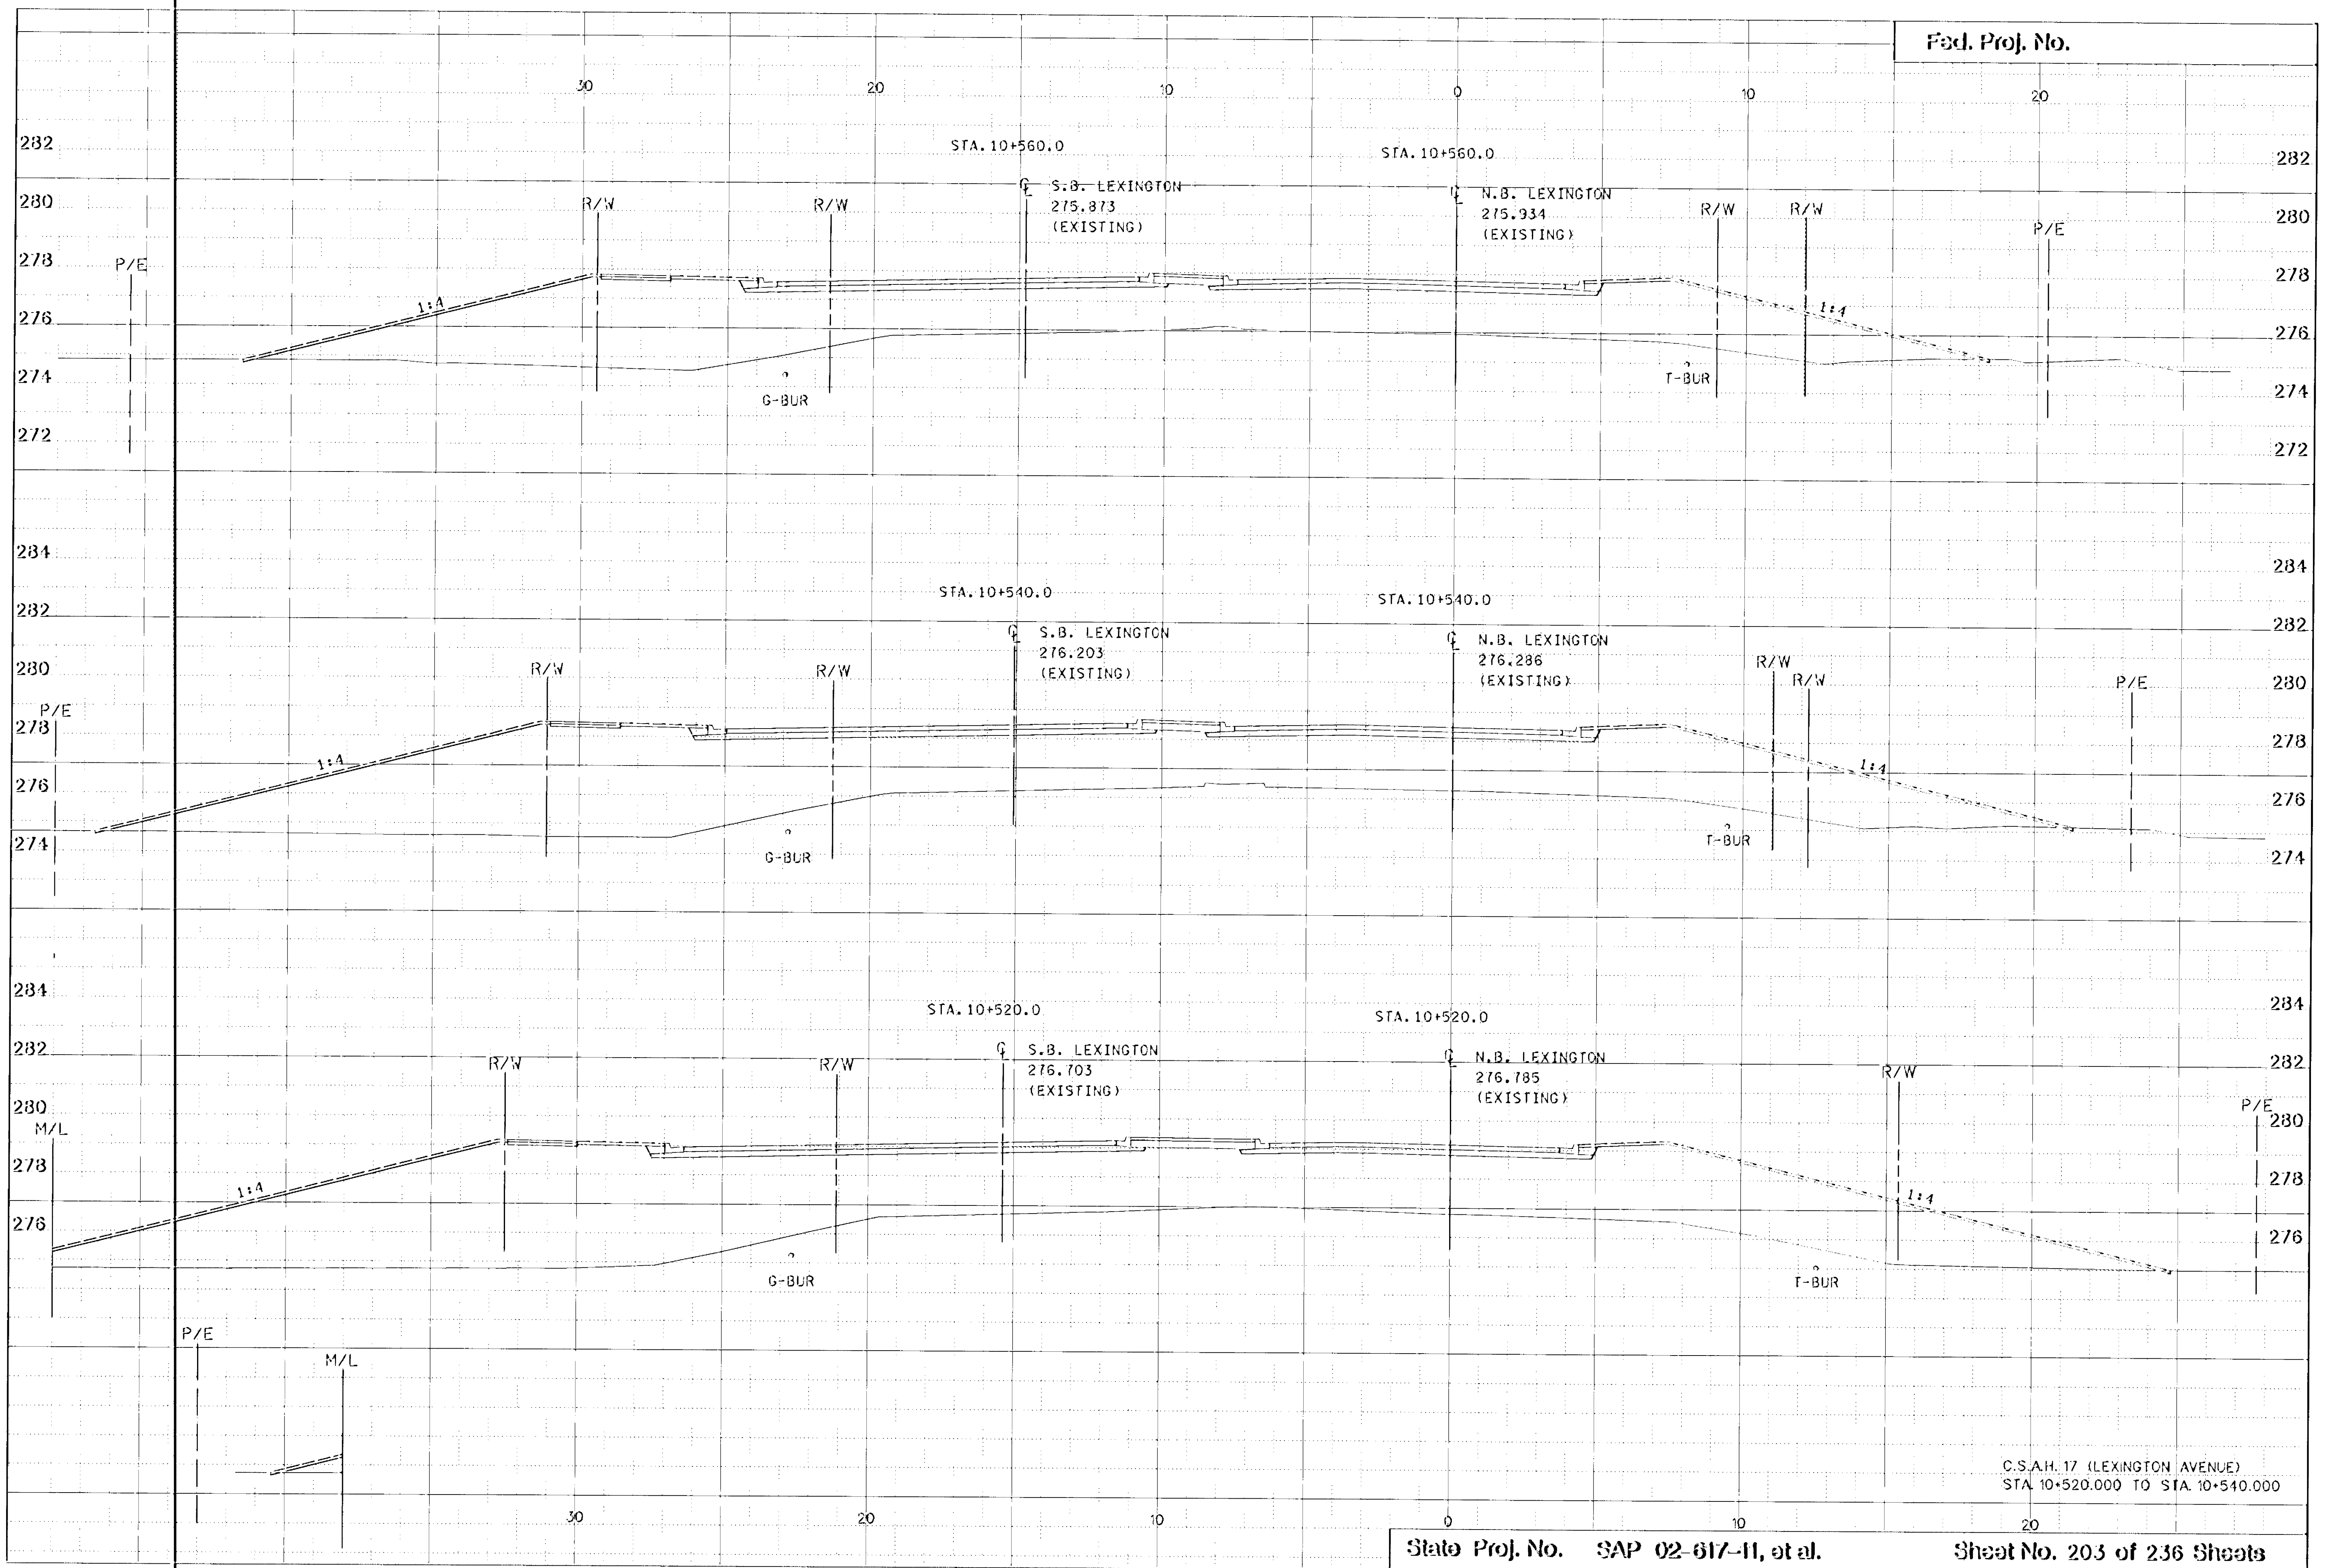

C.S.A.H. 17 (LEXINGTON AVENUE)
STA. 10+520.000 TO STA. 10+540.000

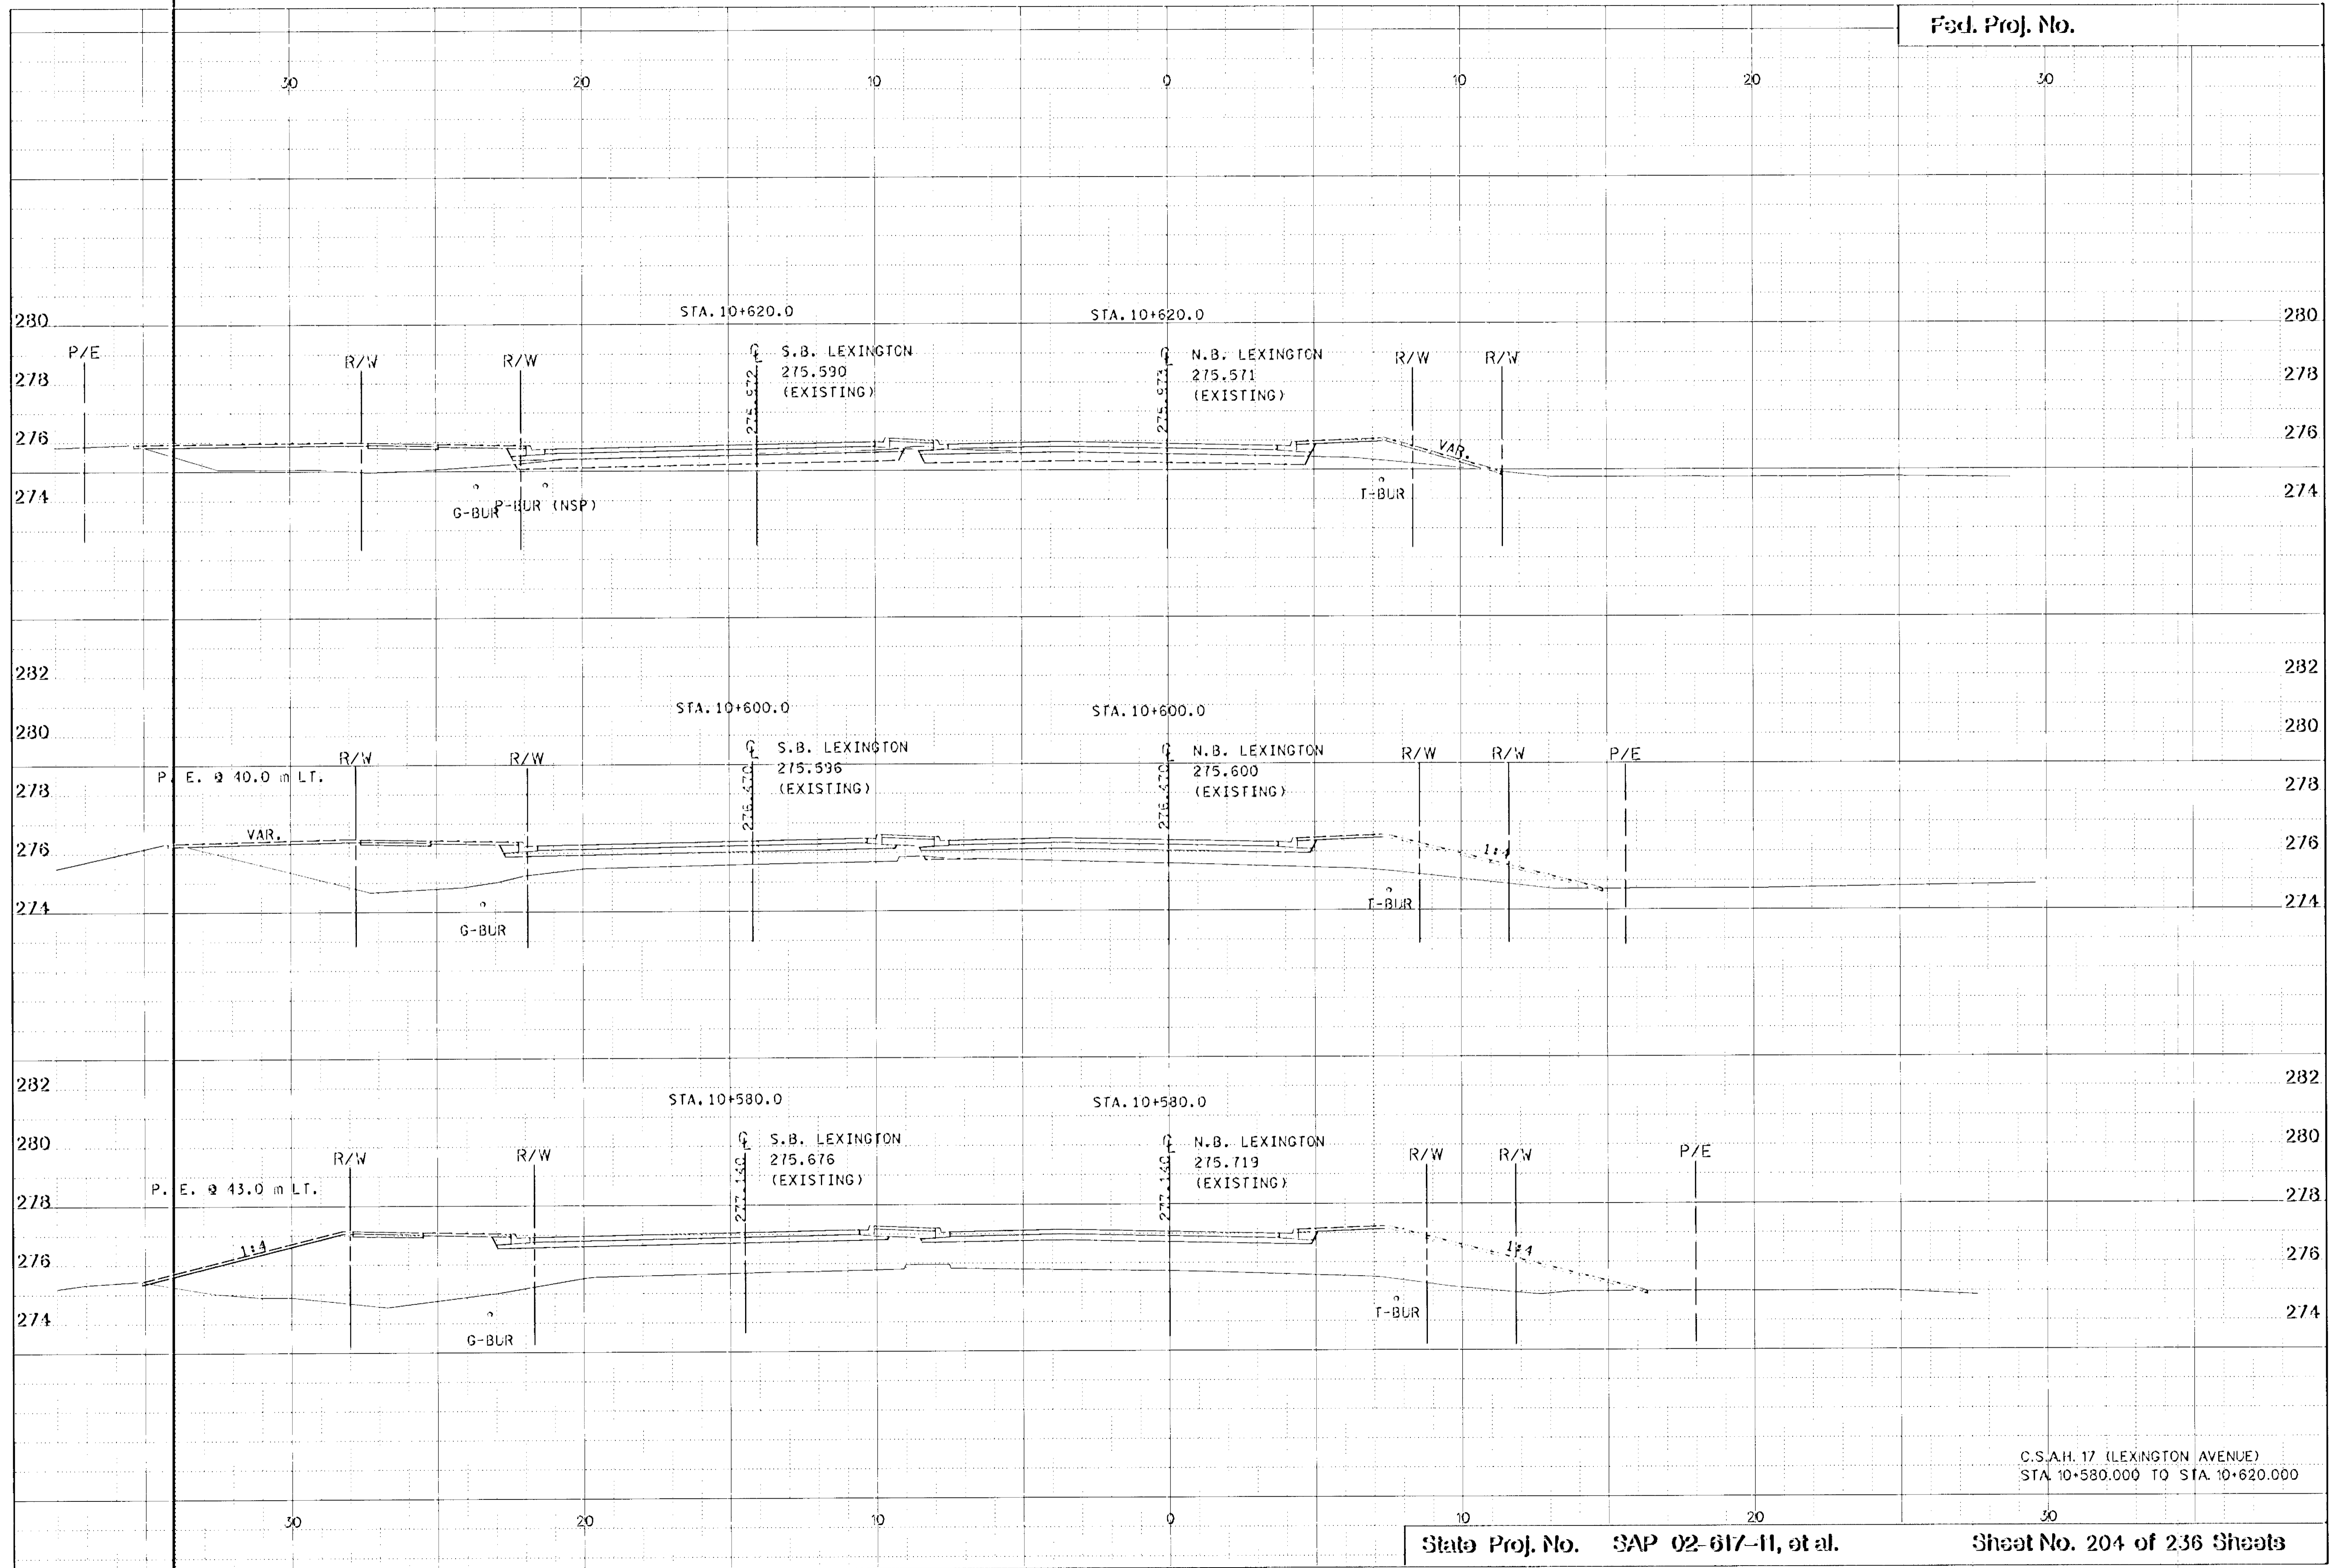

C.S.A.H. 17 (LEXINGTON AVENUE)
STA. 10+580.000 TO STA. 10+620.000

30 20 10 0 10 20 30

282 END CONSTRUCTION 10+660.0 282

280 STA. 10+660.0 STA. 10+660.0 280

278 S.B. LEXINGTON 275.564 (EXISTING) N.B. LEXINGTON 275.552 (EXISTING) R/W R/W 278

276 1:1 G-BUR T-BUR 276

G-BUR 274 274

272 272

280 STA. 10+653.4 STA. 10+653.4 280

278 S.B. LEXINGTON 275.544 (EXISTING) N.B. LEXINGTON 275.562 (EXISTING) R/W R/W 278

276 2.3% EX. SIGNAL CONDUIT G-BUR T-BUR 276

G-BUR 274 274

280 STA. 10+639.2 STA. 10+639.2 280

278 S.B. LEXINGTON 275.560 (EXISTING) N.B. LEXINGTON 275.570 (EXISTING) R/W R/W 278


276 EX. SIGNAL CONDUIT G-BUR T-BUR 276




G-BUR 274 274

EX. M/M

C.S.A.H. 17 (LEXINGTON AVENUE)
STA. 10+639.2.000 TO STA. 10+660.000

30 20 10 0 10 20 30

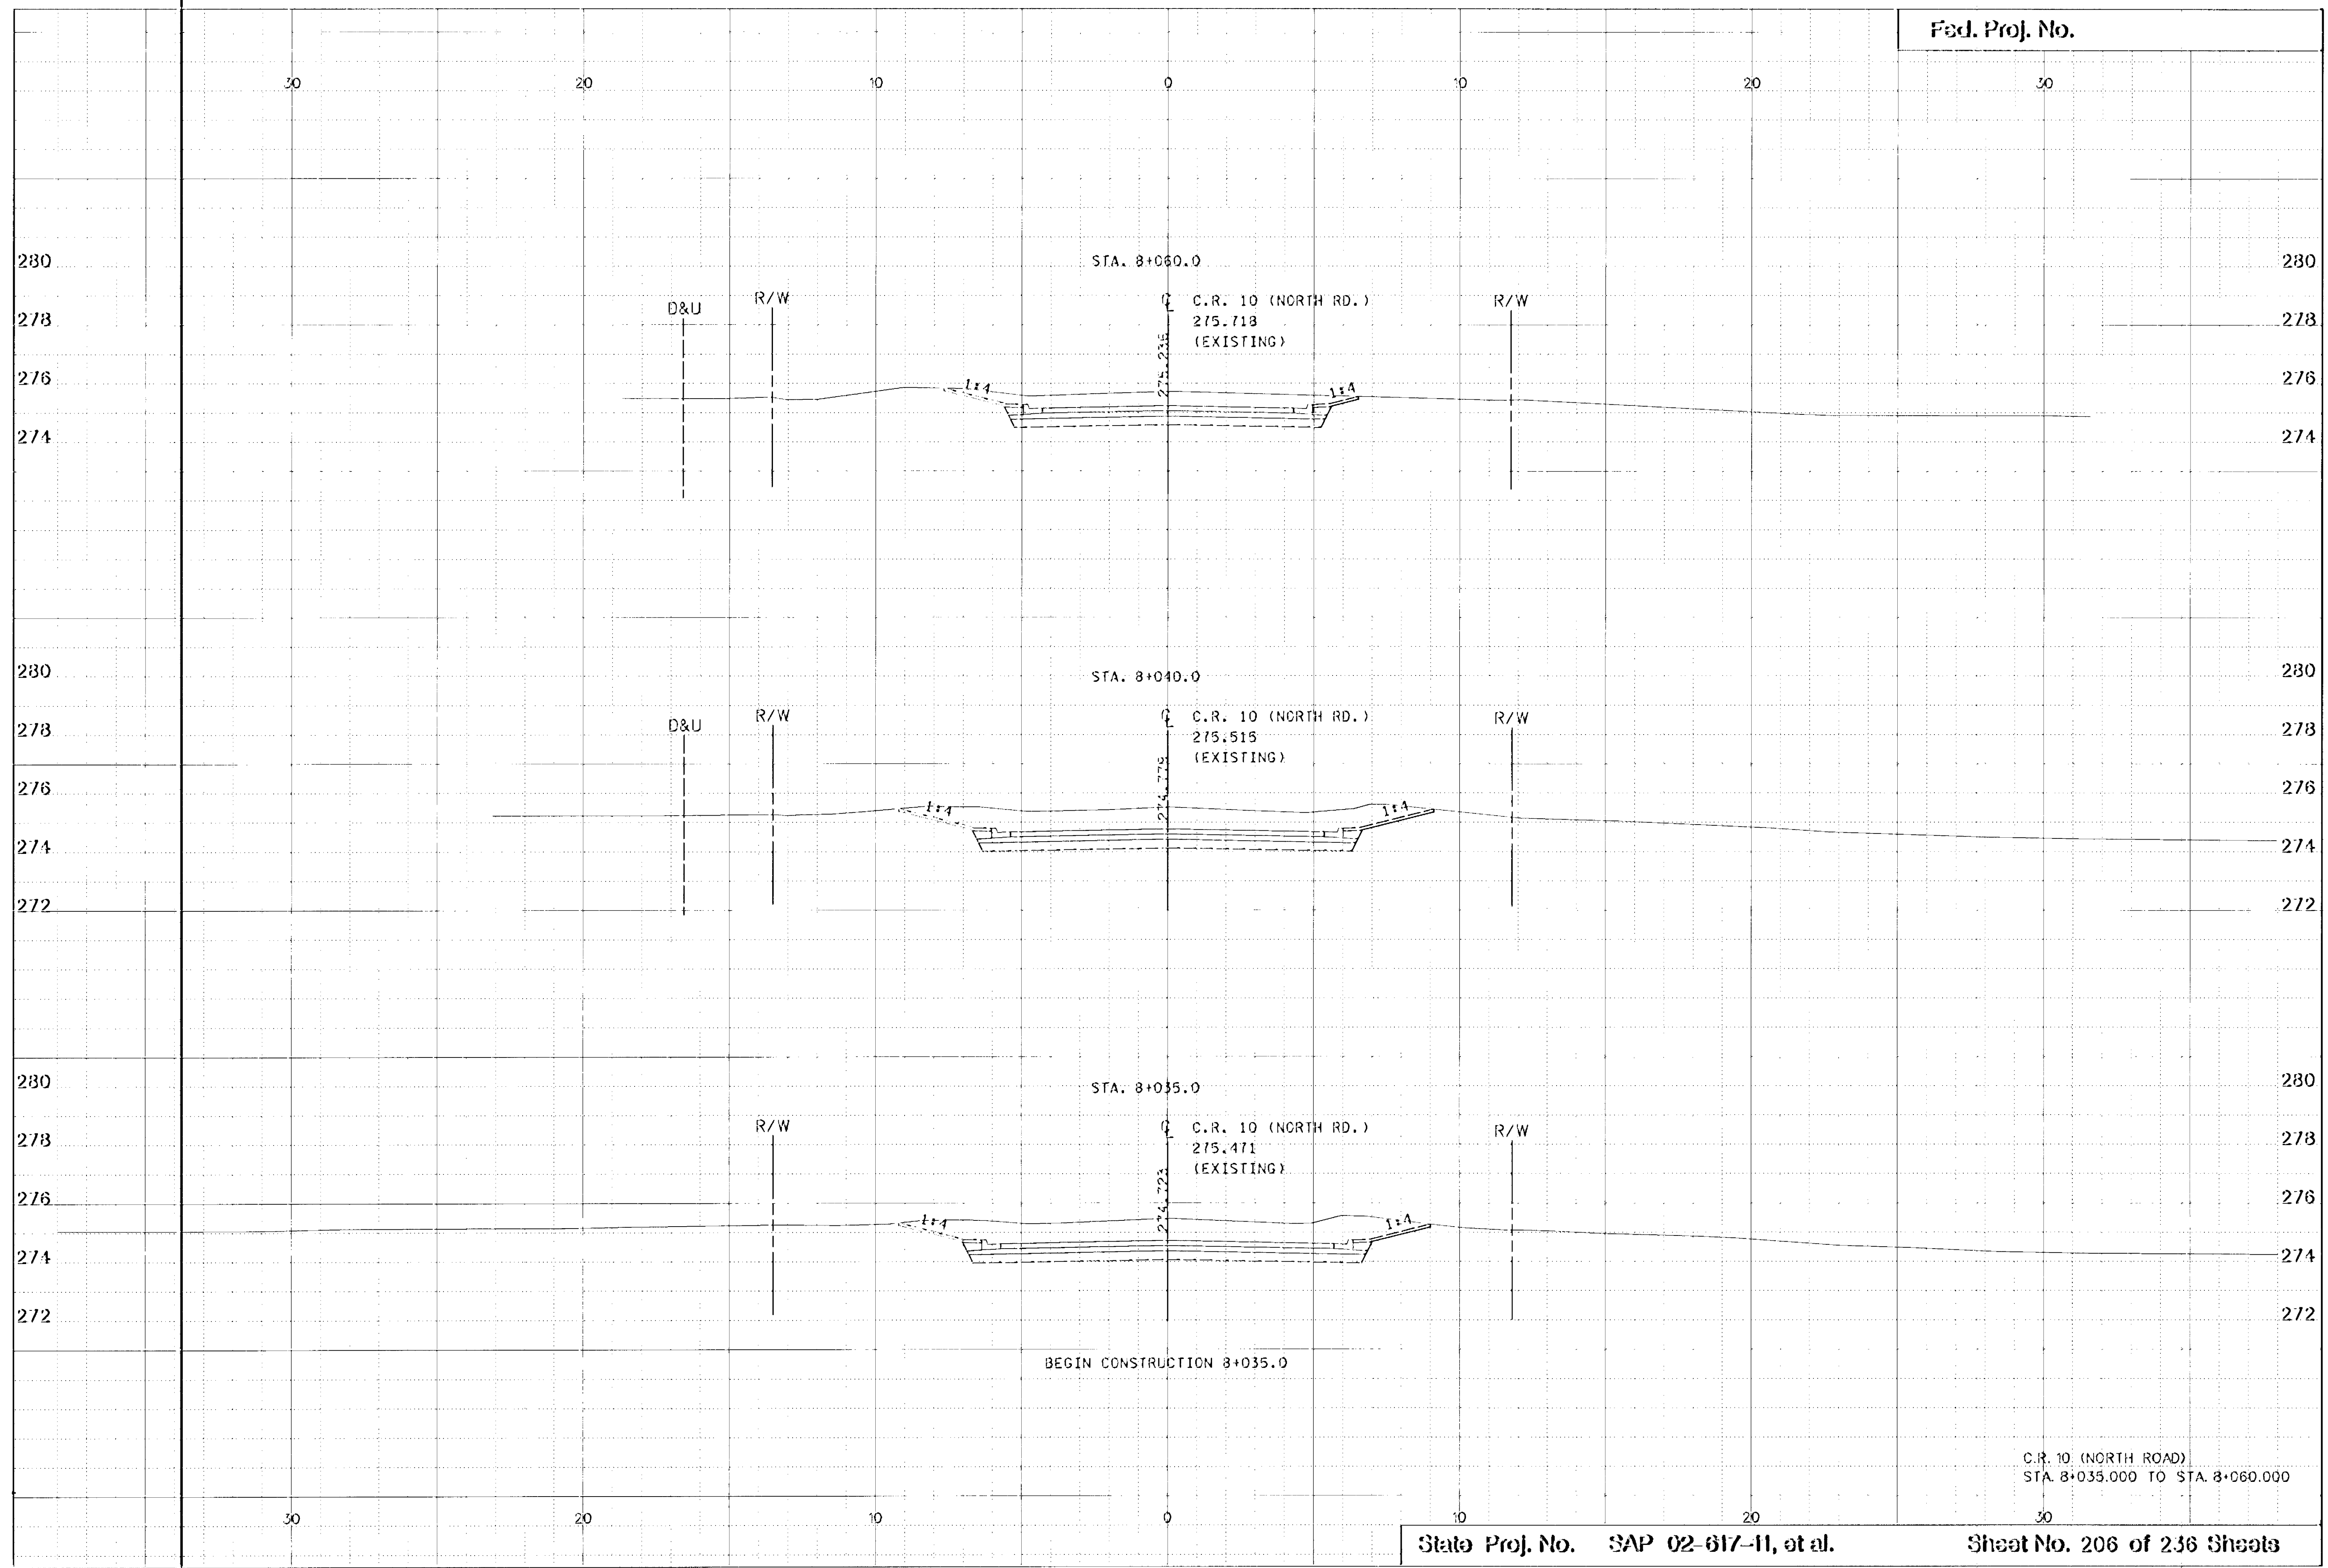

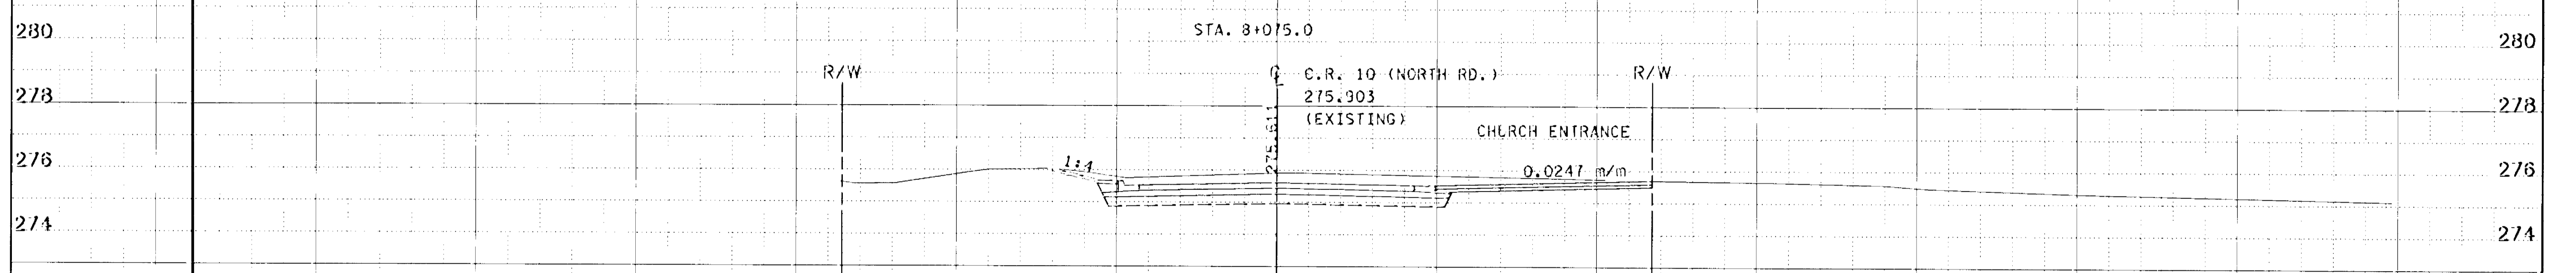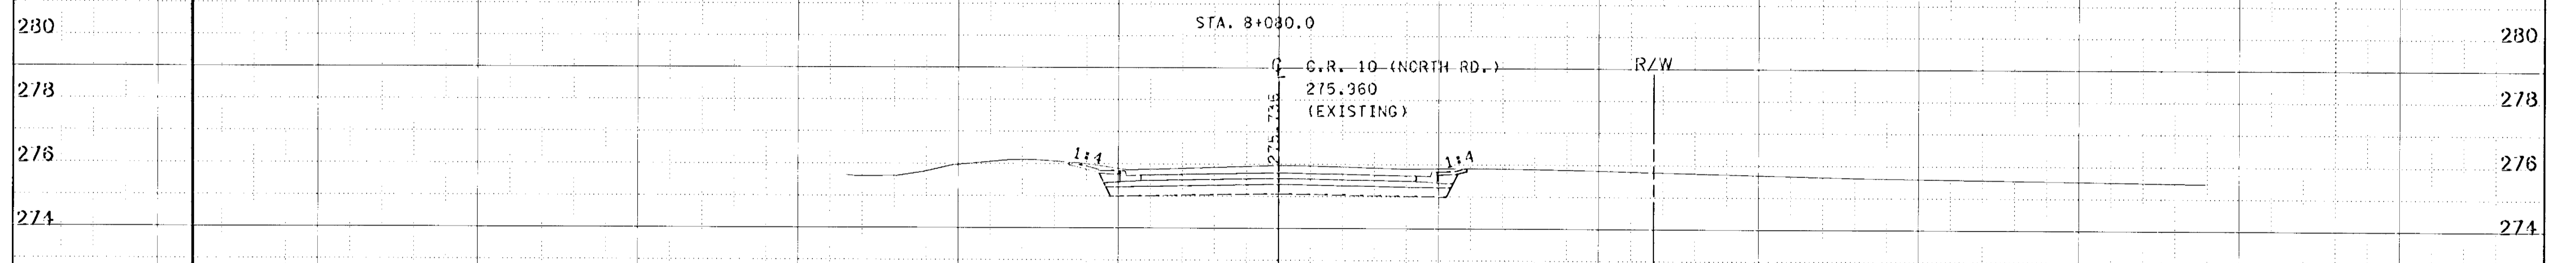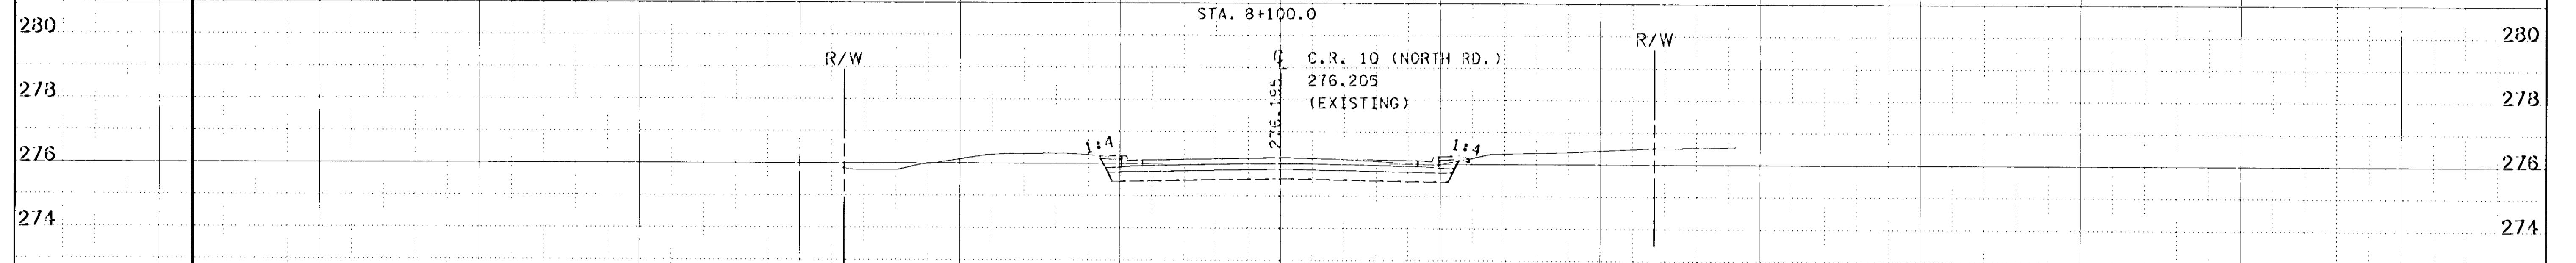

C.R. 10 (NORTH ROAD)
STA. 8+075.000 TO STA. 8+100.000

30

20

10

0

10

20

30

284

284

282

282

280

280

278

278

276

276

274

274

END CONSTRUCTION 8+105.0

STA. 8+105.0

R/W

R/W

C.R. 10 (NORTH RD.)
276.269
(EXISTING)

1:4

1:4

C.R. 10 (NORTH ROAD)
STA. 8+105.00

30

20


10

0

10


20

30

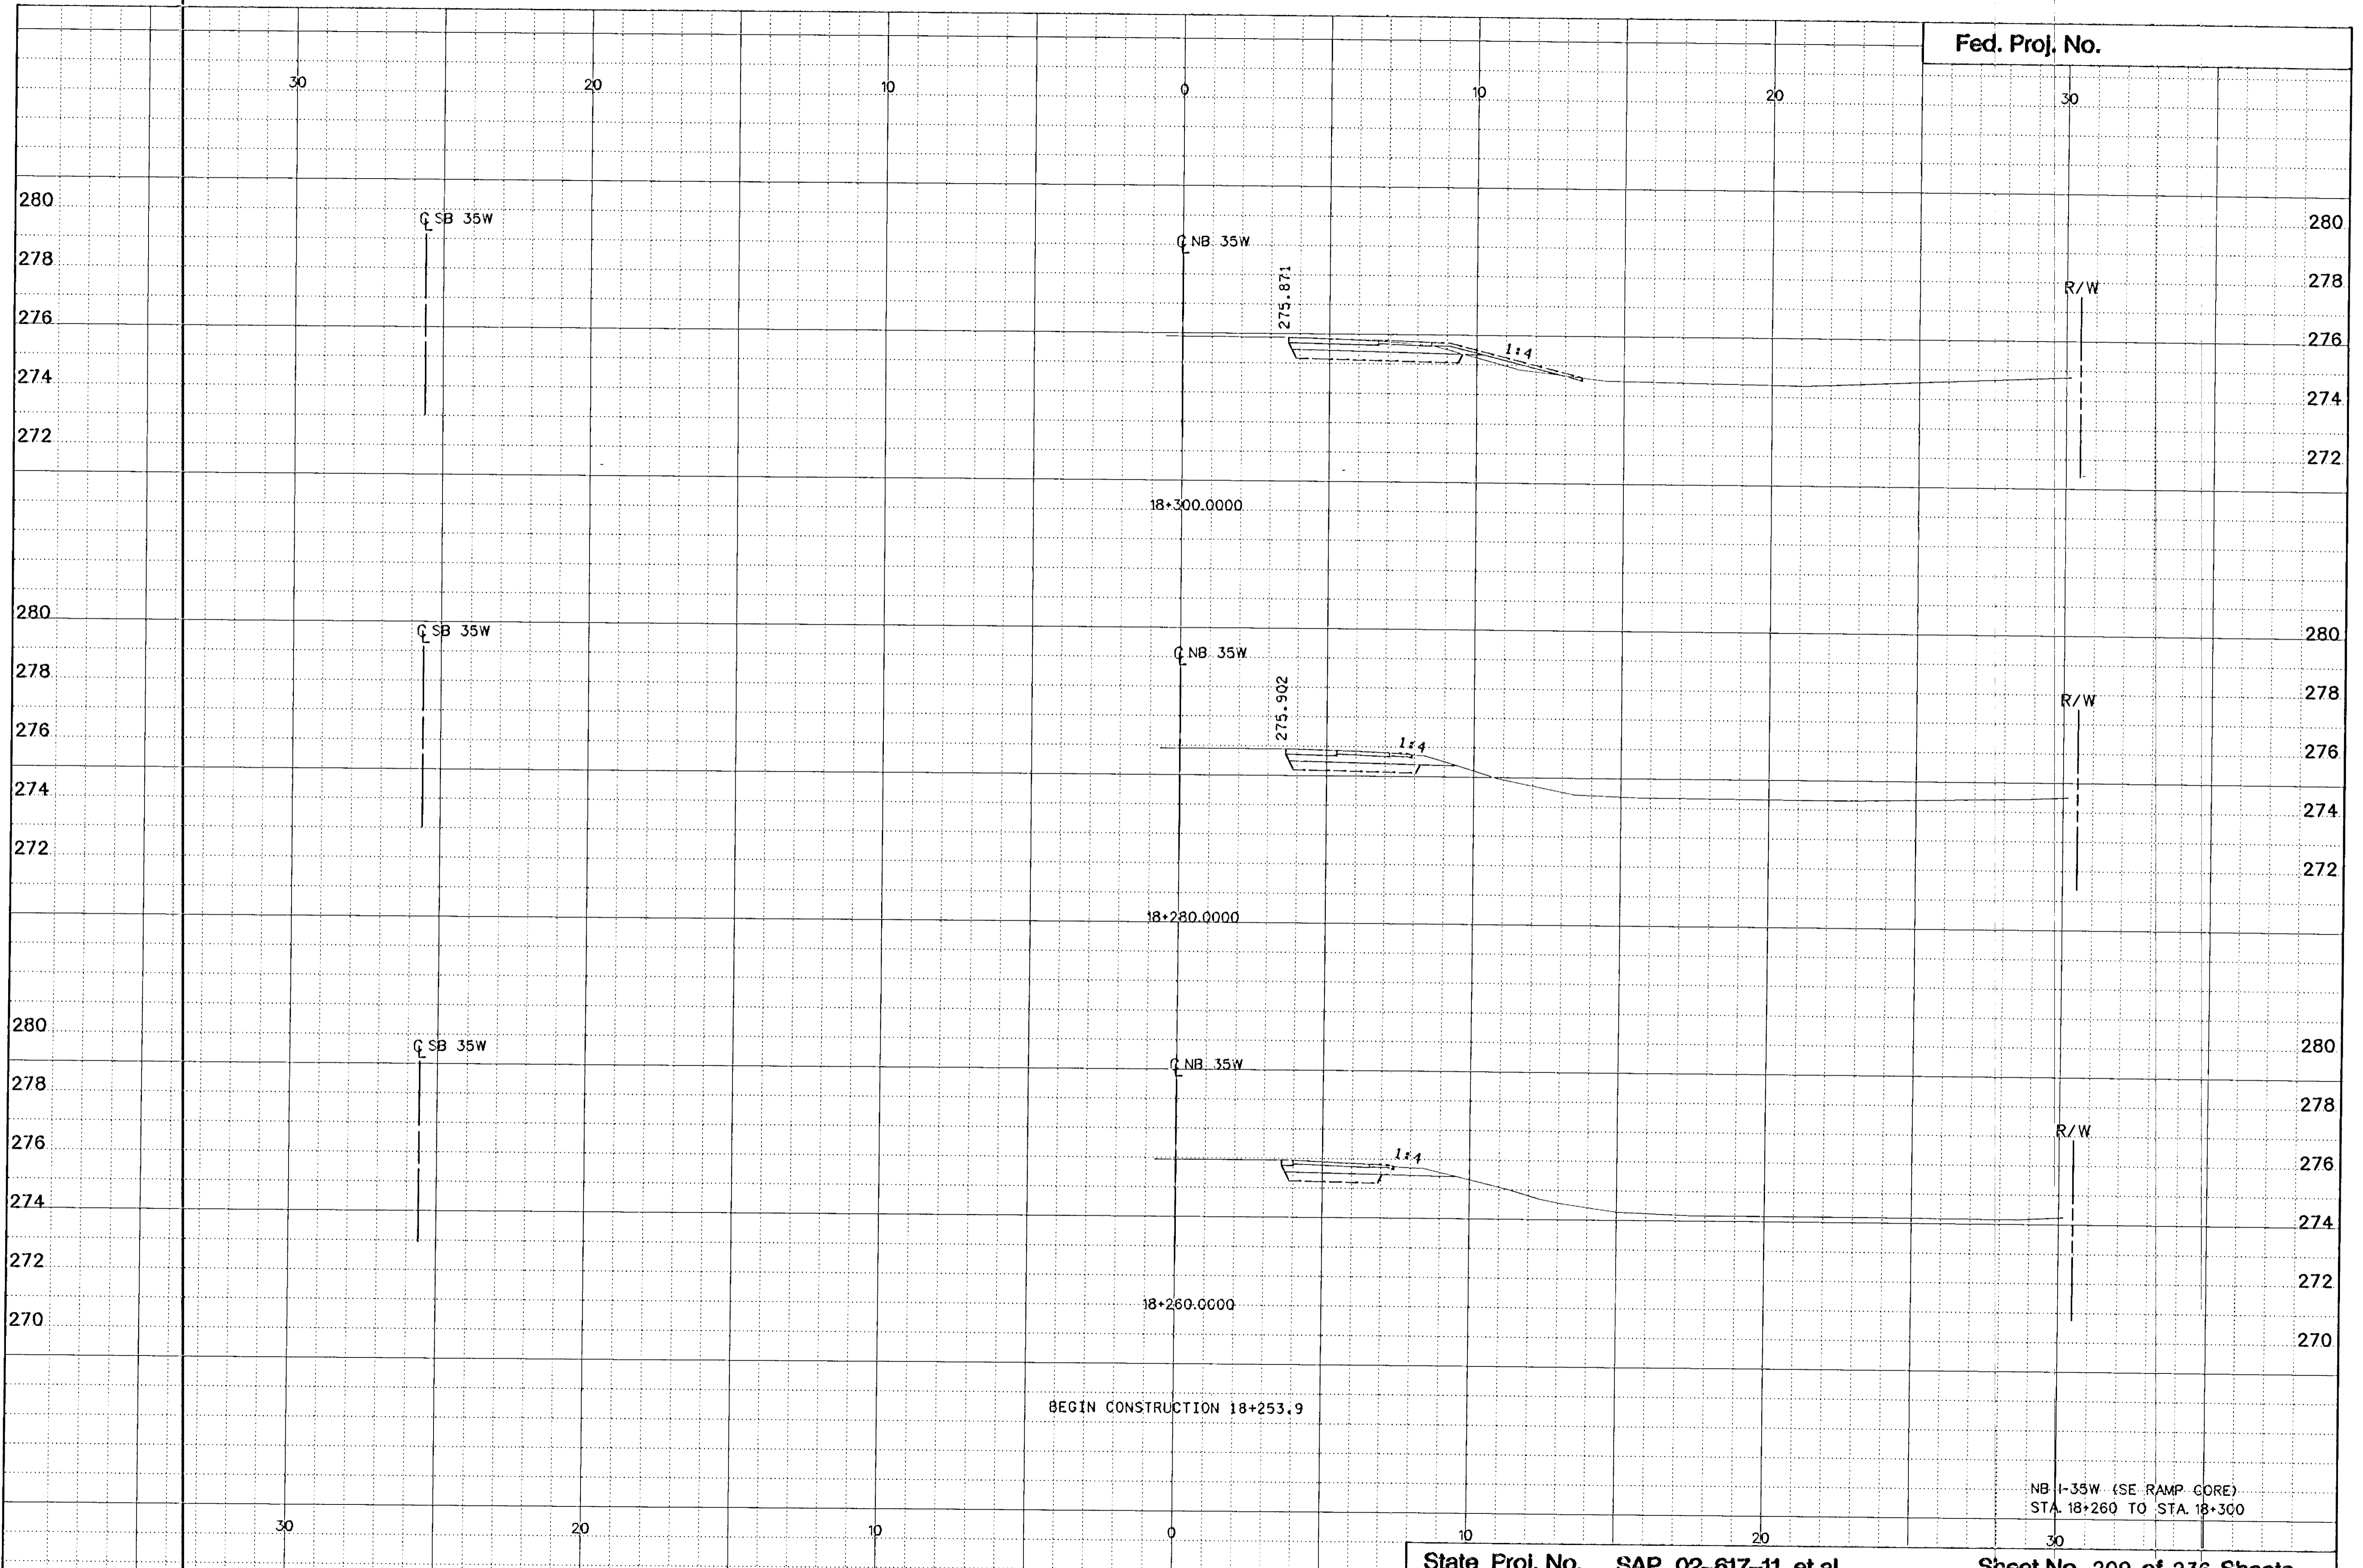


BEGIN CONSTRUCTION 18+253.9


NB I-35W (SE RAMP CORE)
STA. 18+260 TO STA. 18+300

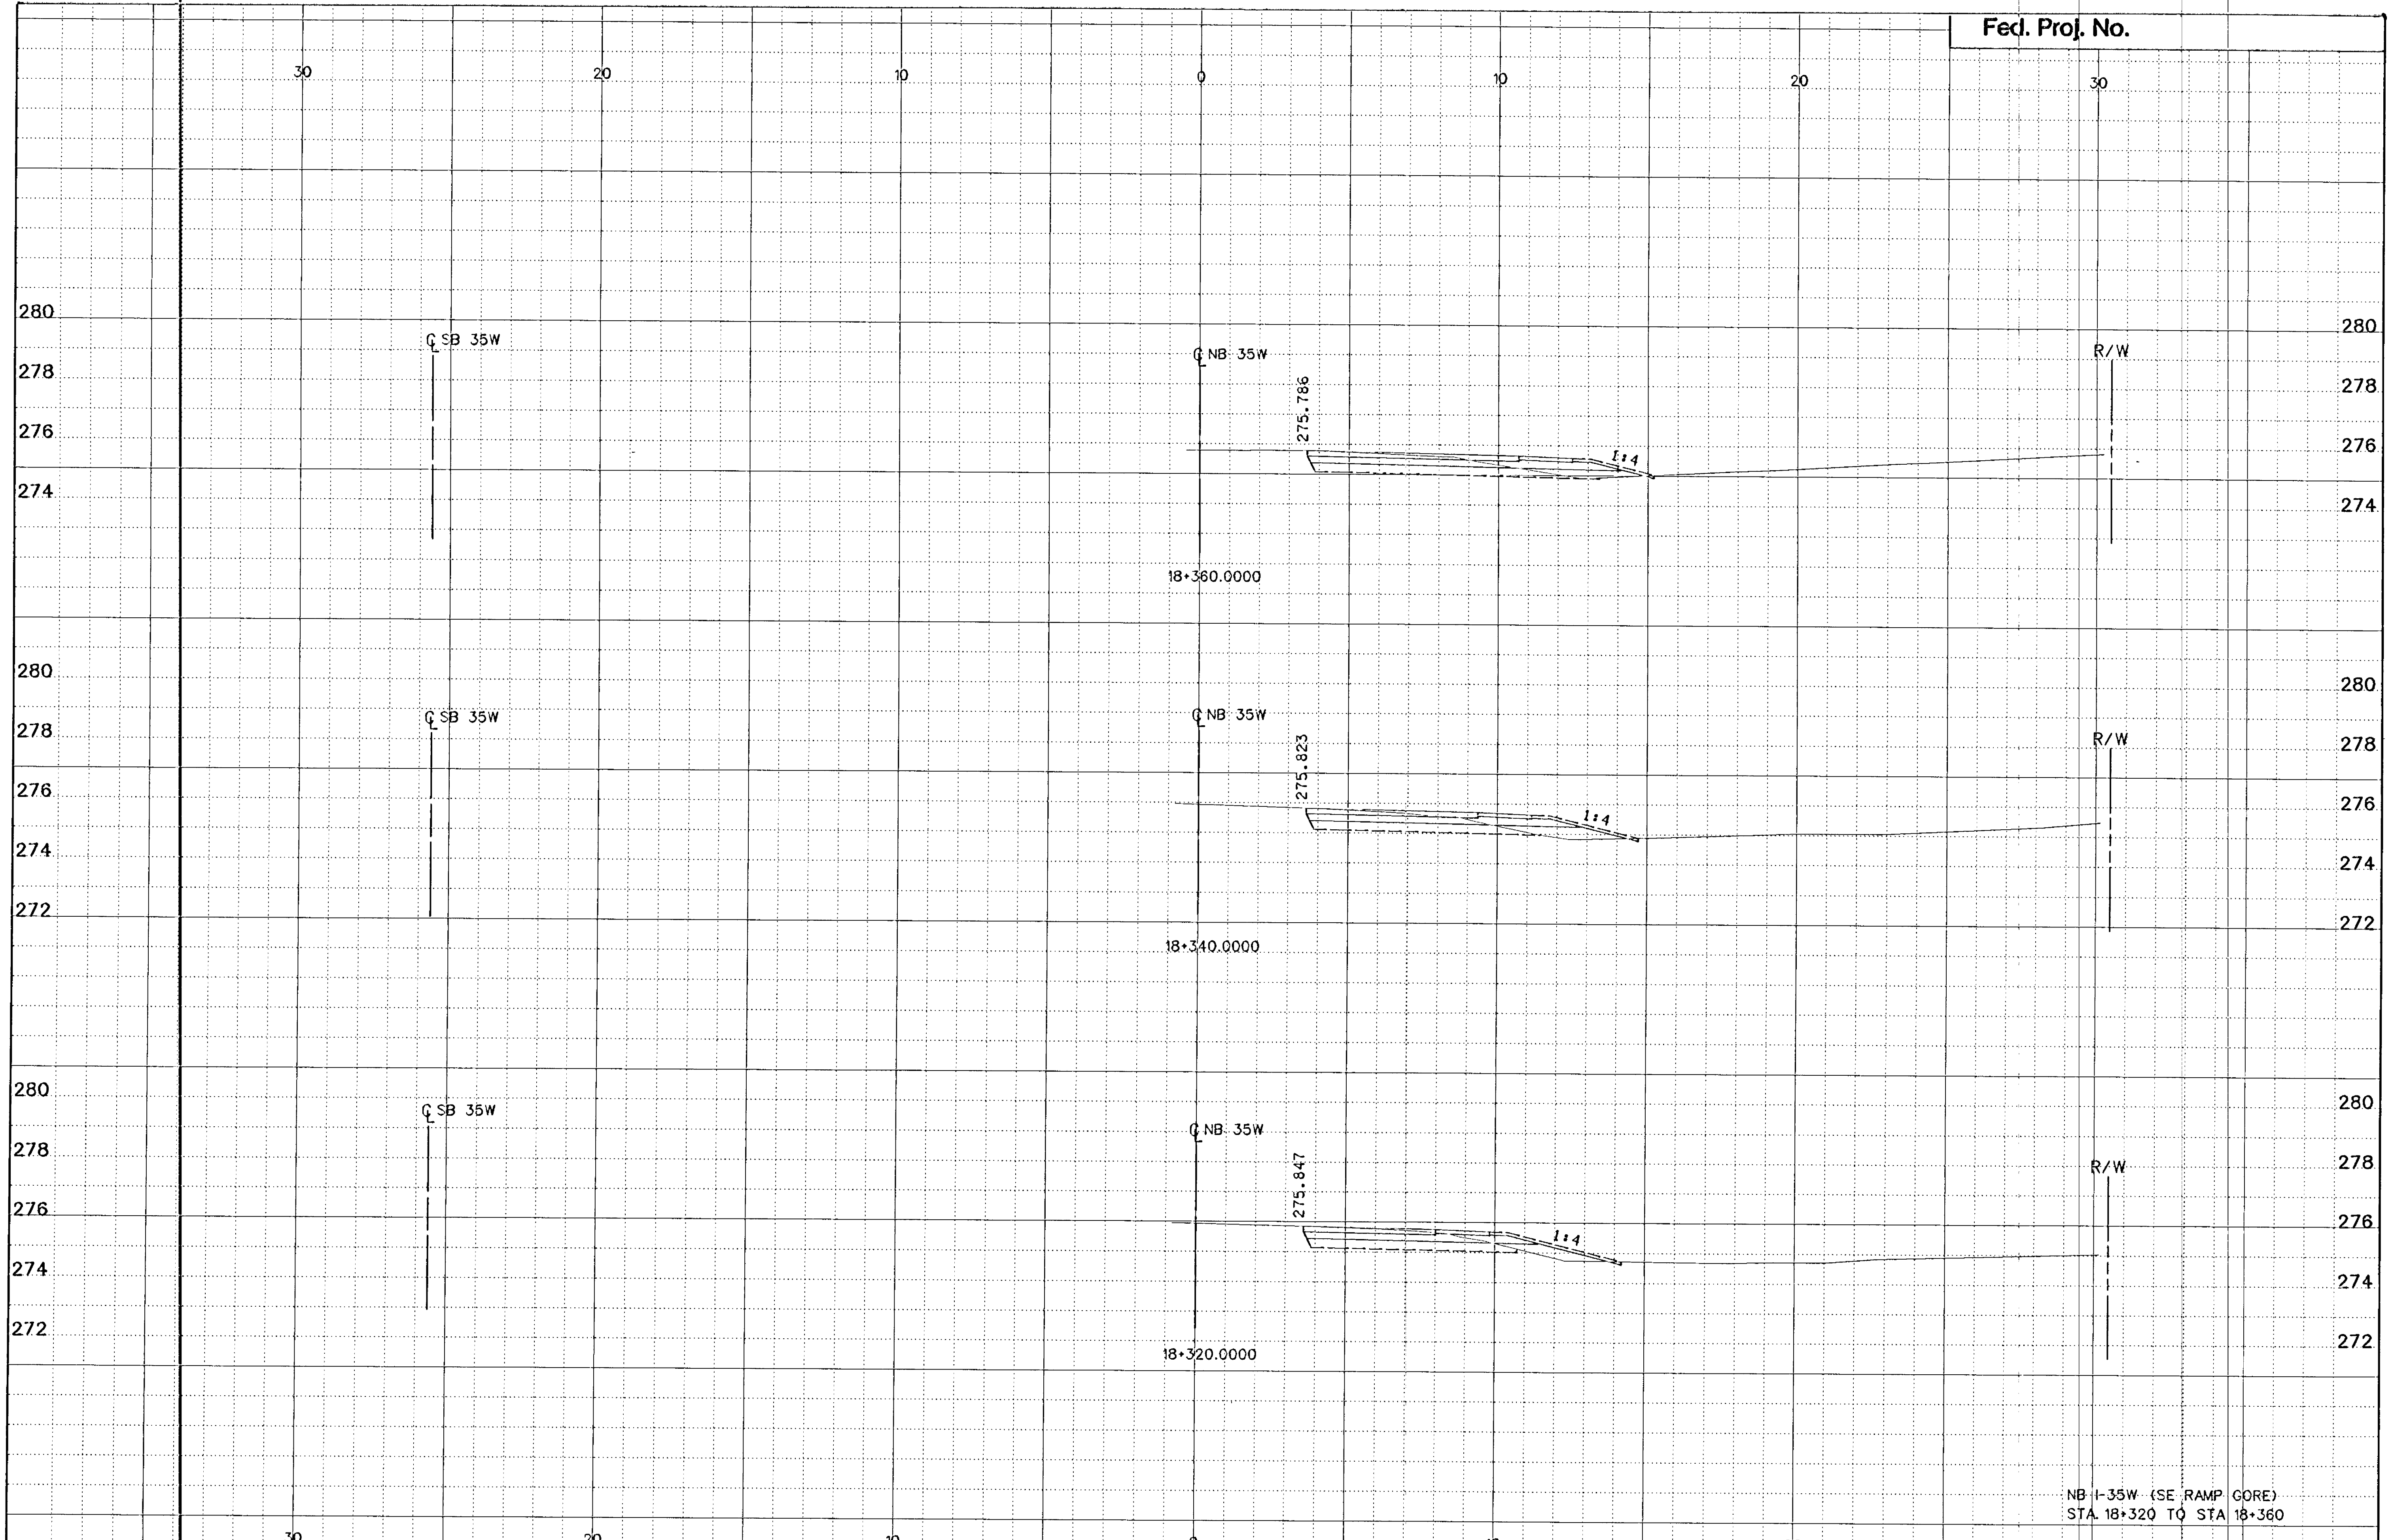


NB I-35W (SE RAMP GORE)
STA 18+320 TO STA 18+360

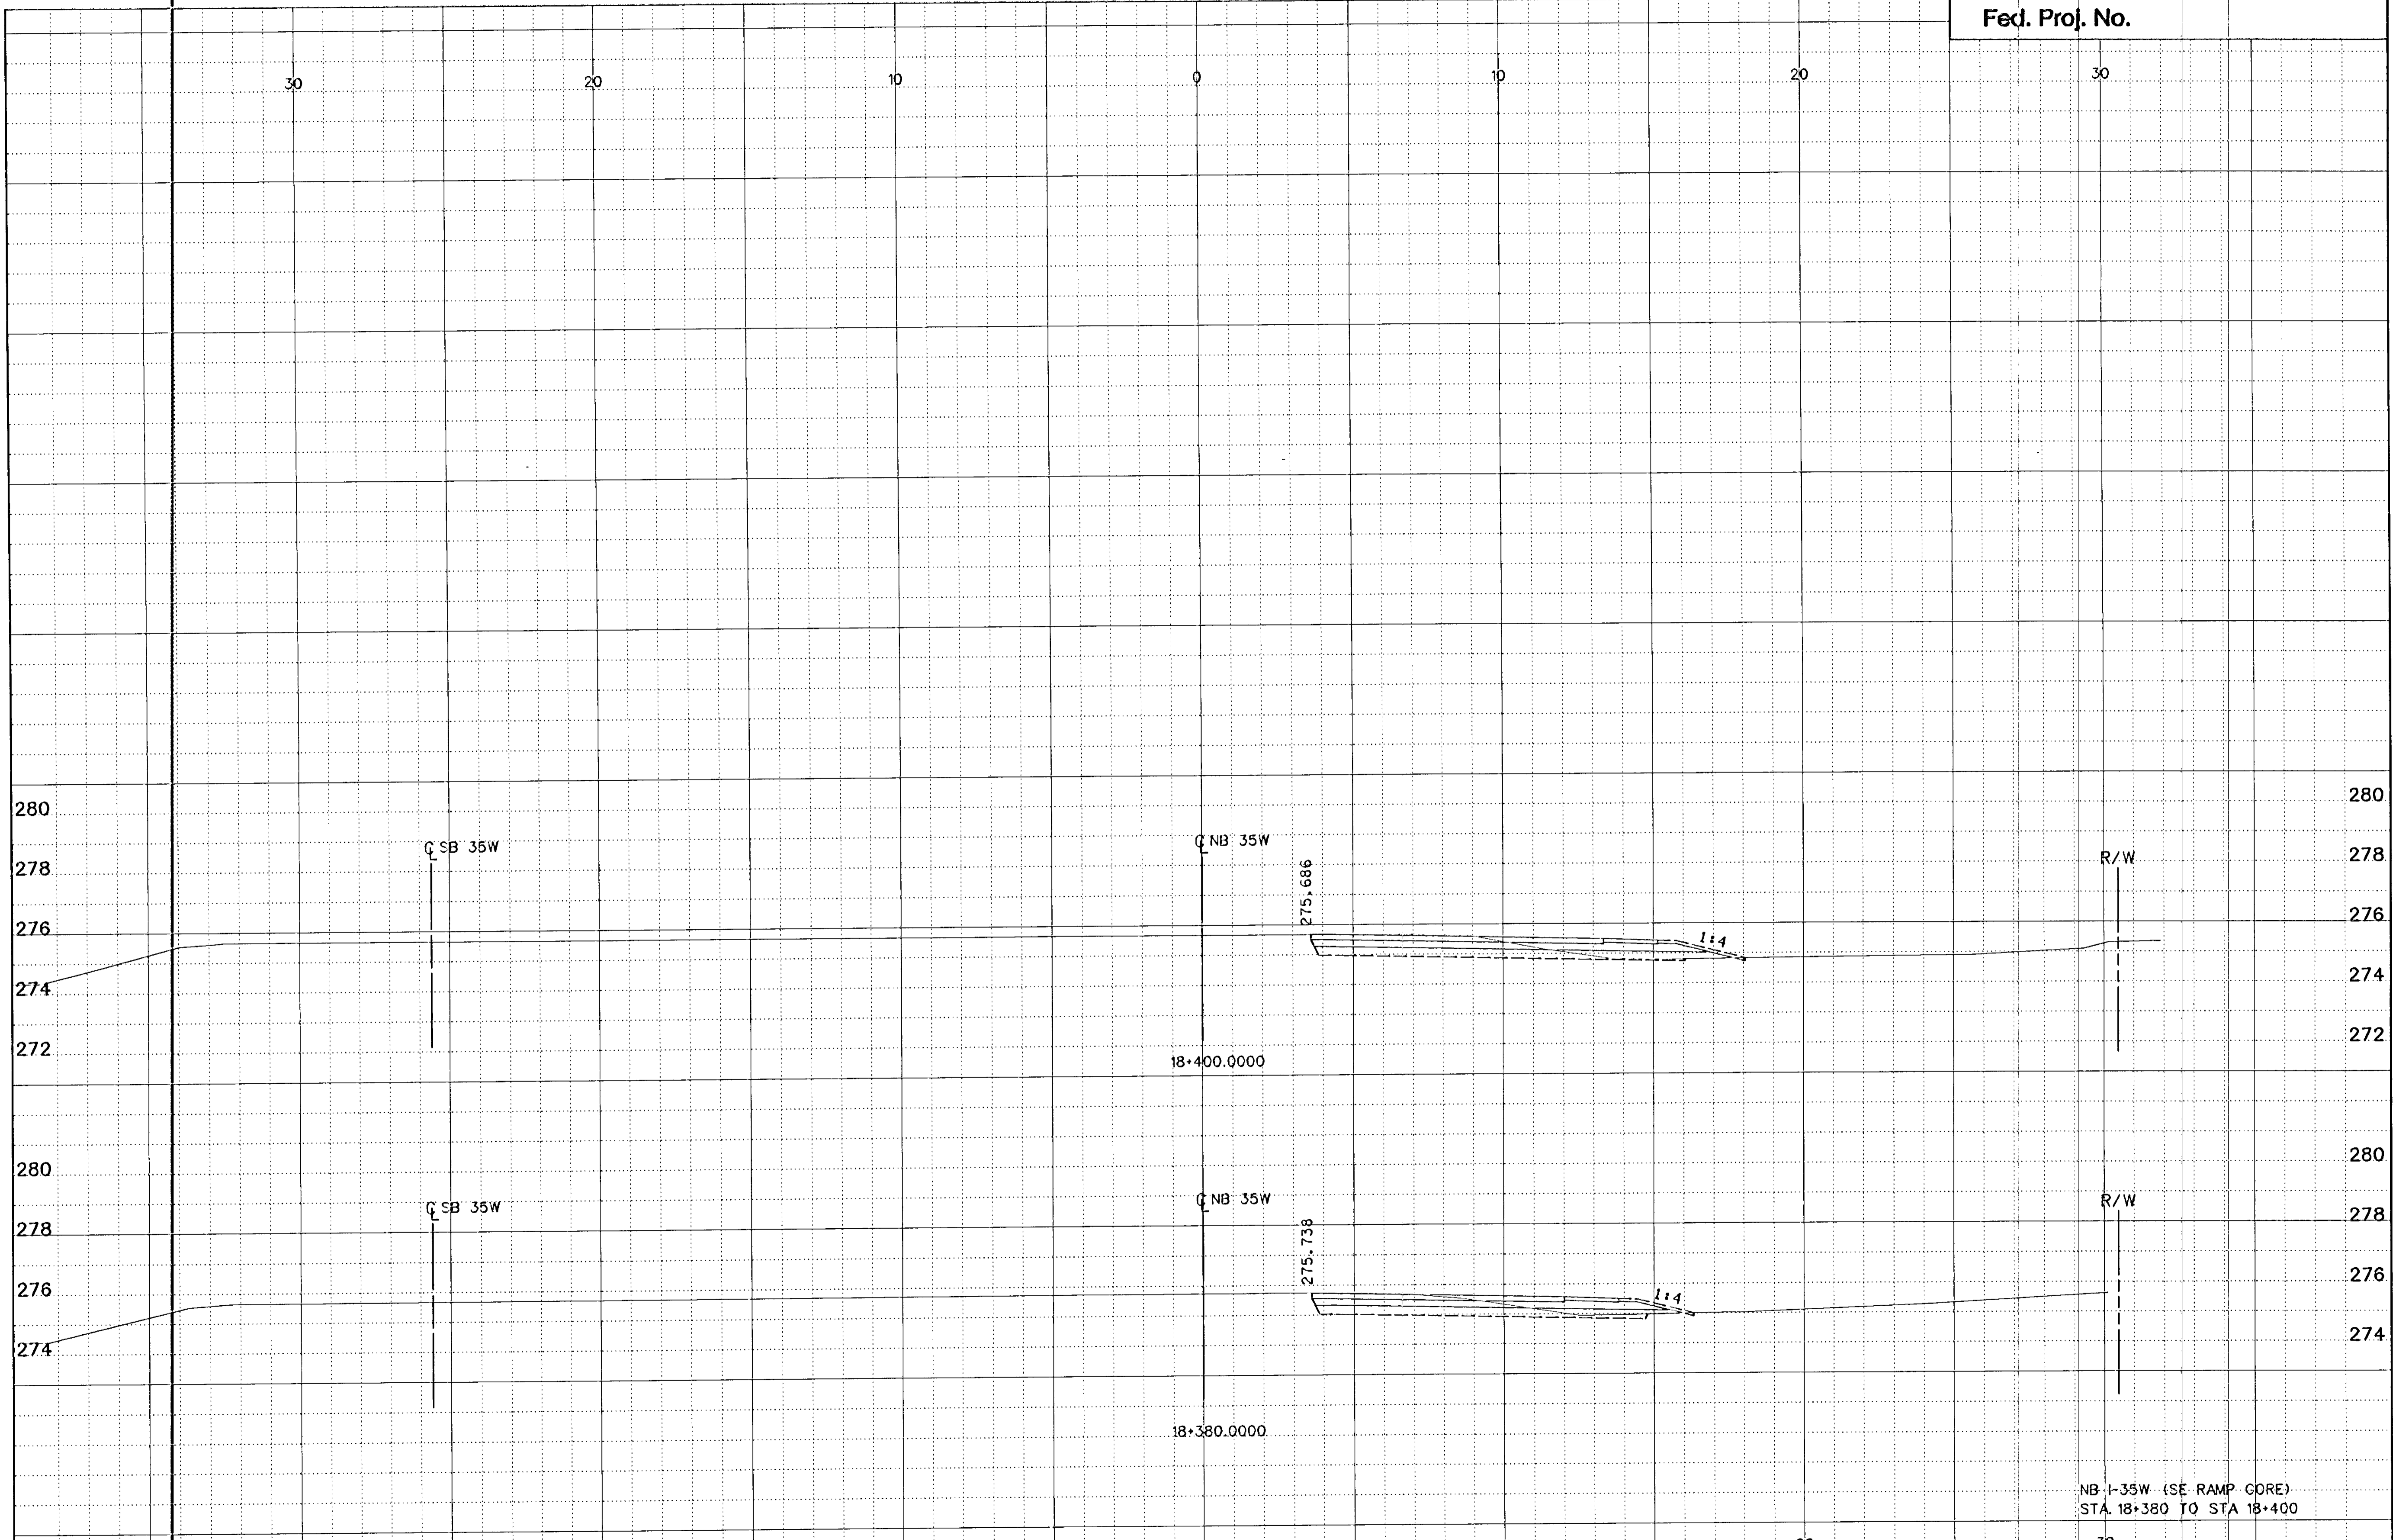


NB I-35W - (SE RAMP CORE)
STA 18+380 TO STA 18+400

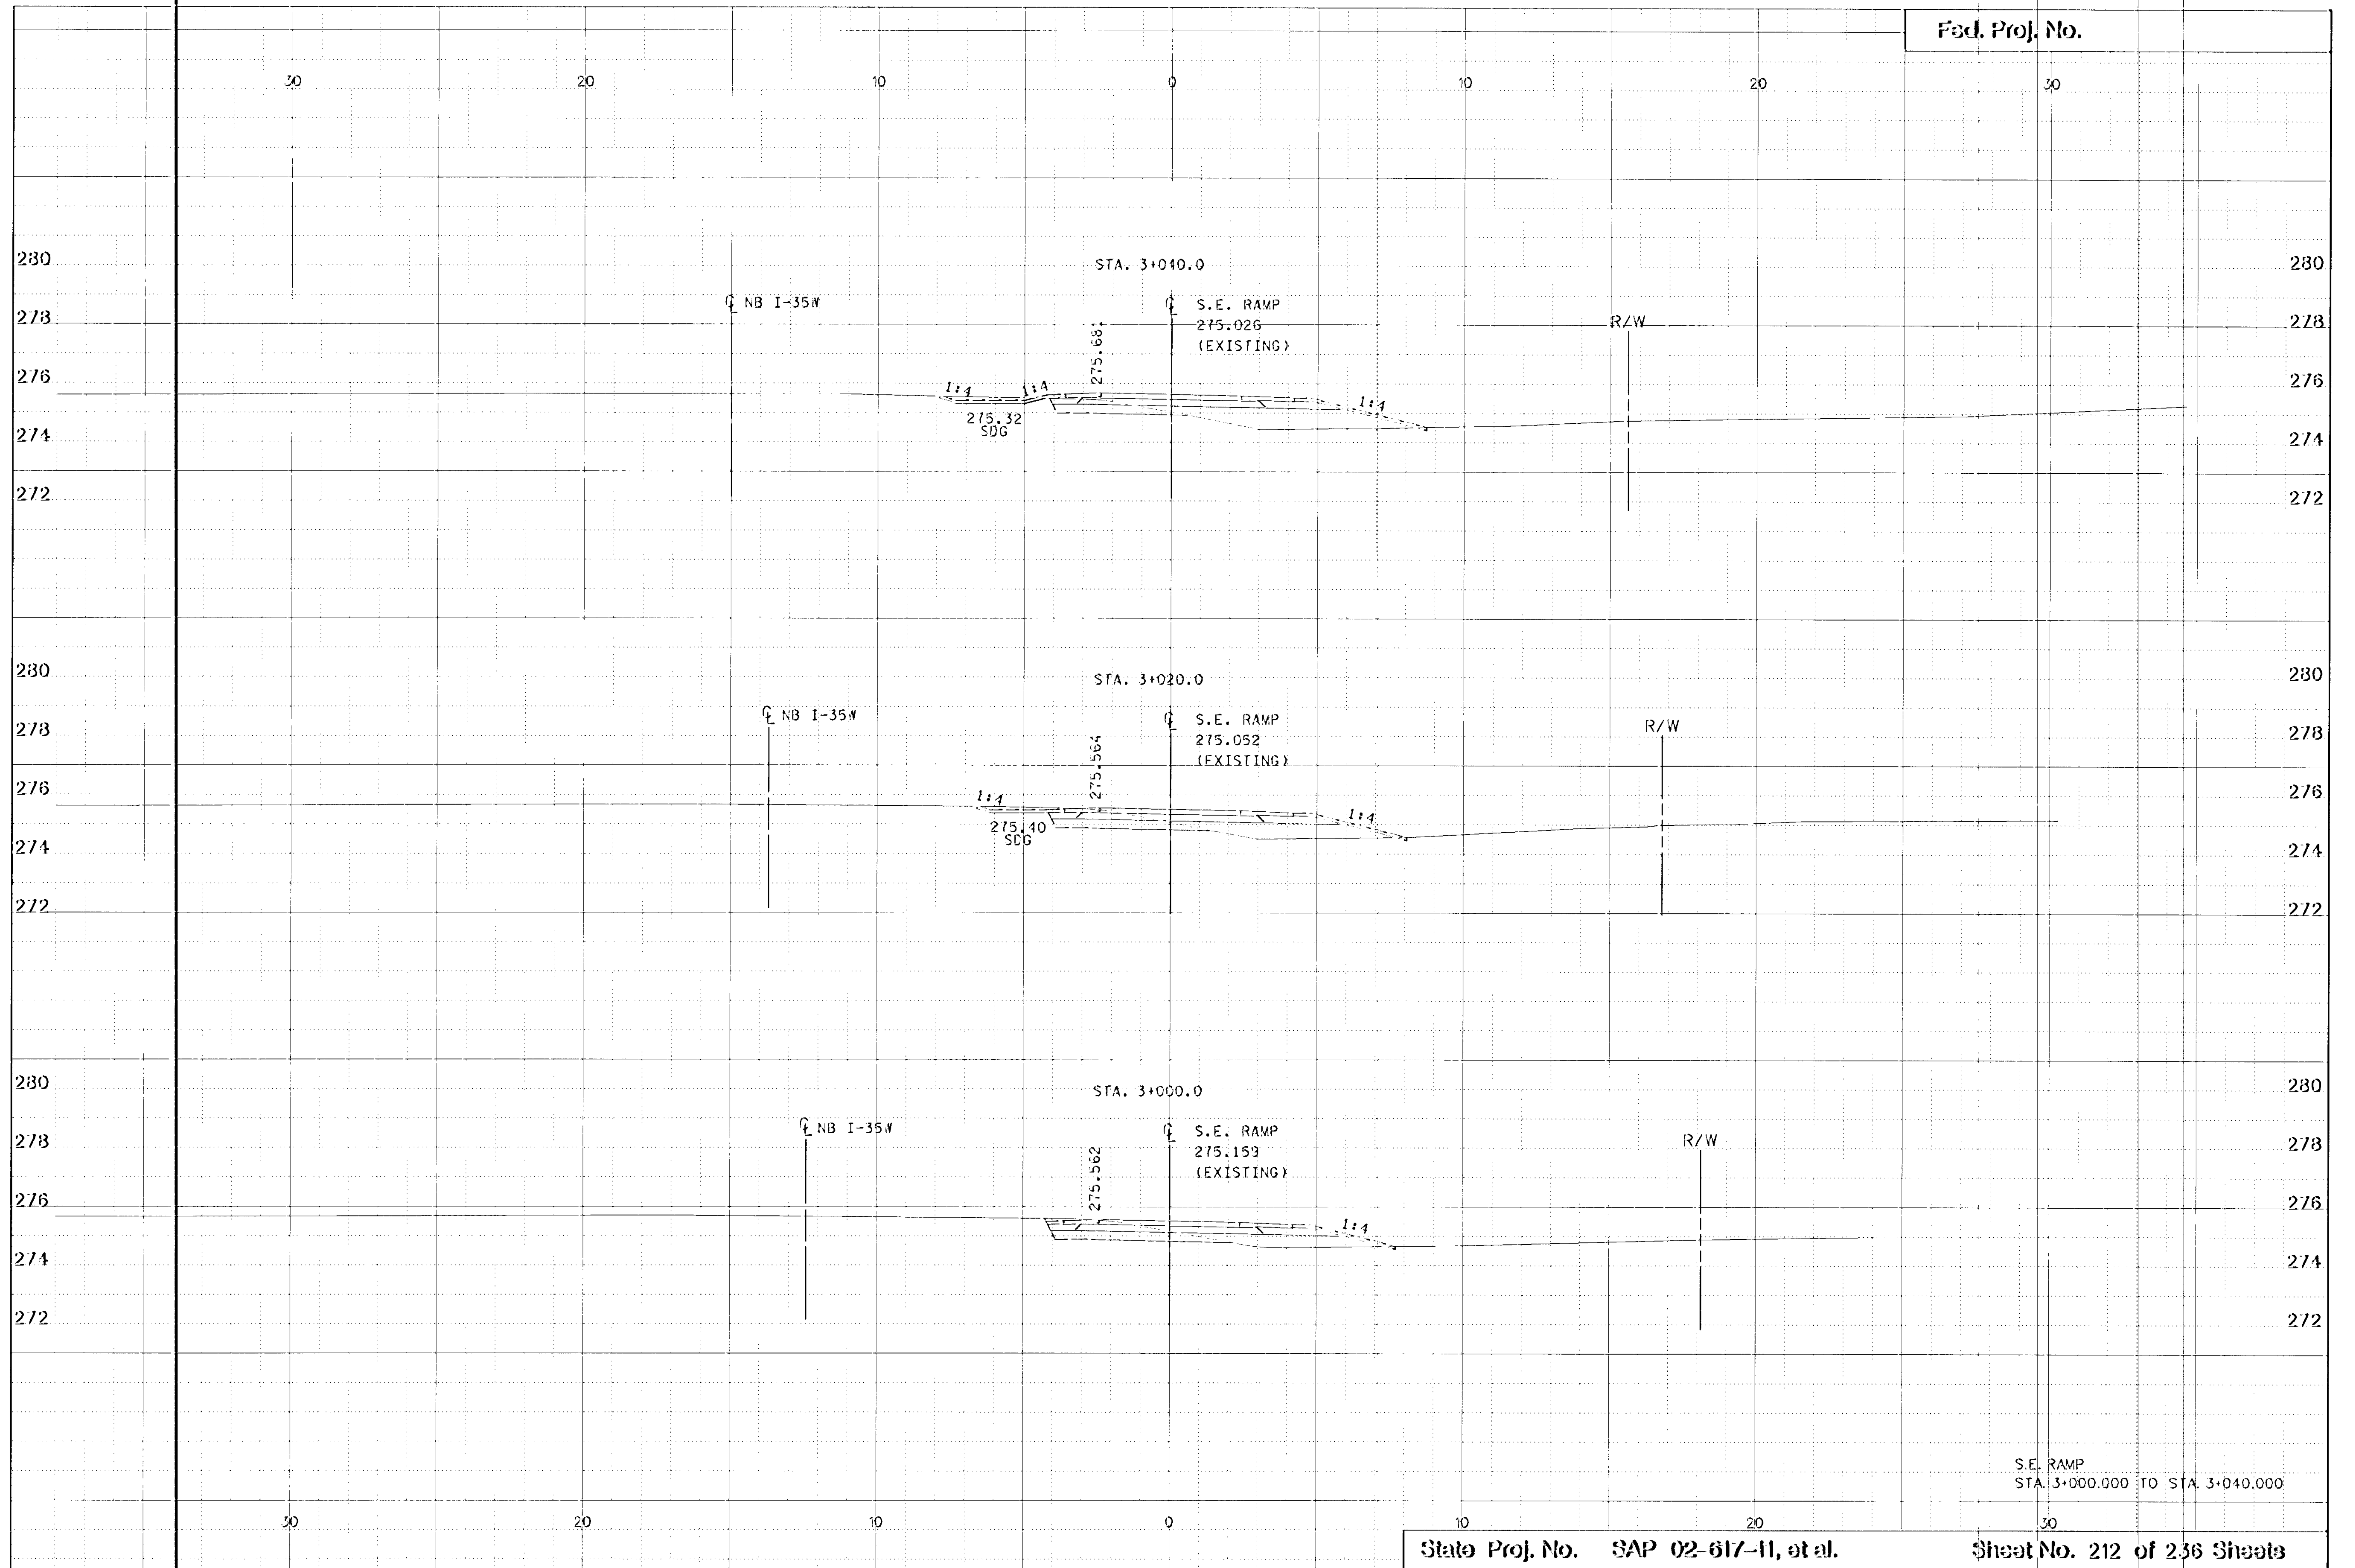


S.E. RAMP
STA. 3+000.000 TO STA. 3+040.000


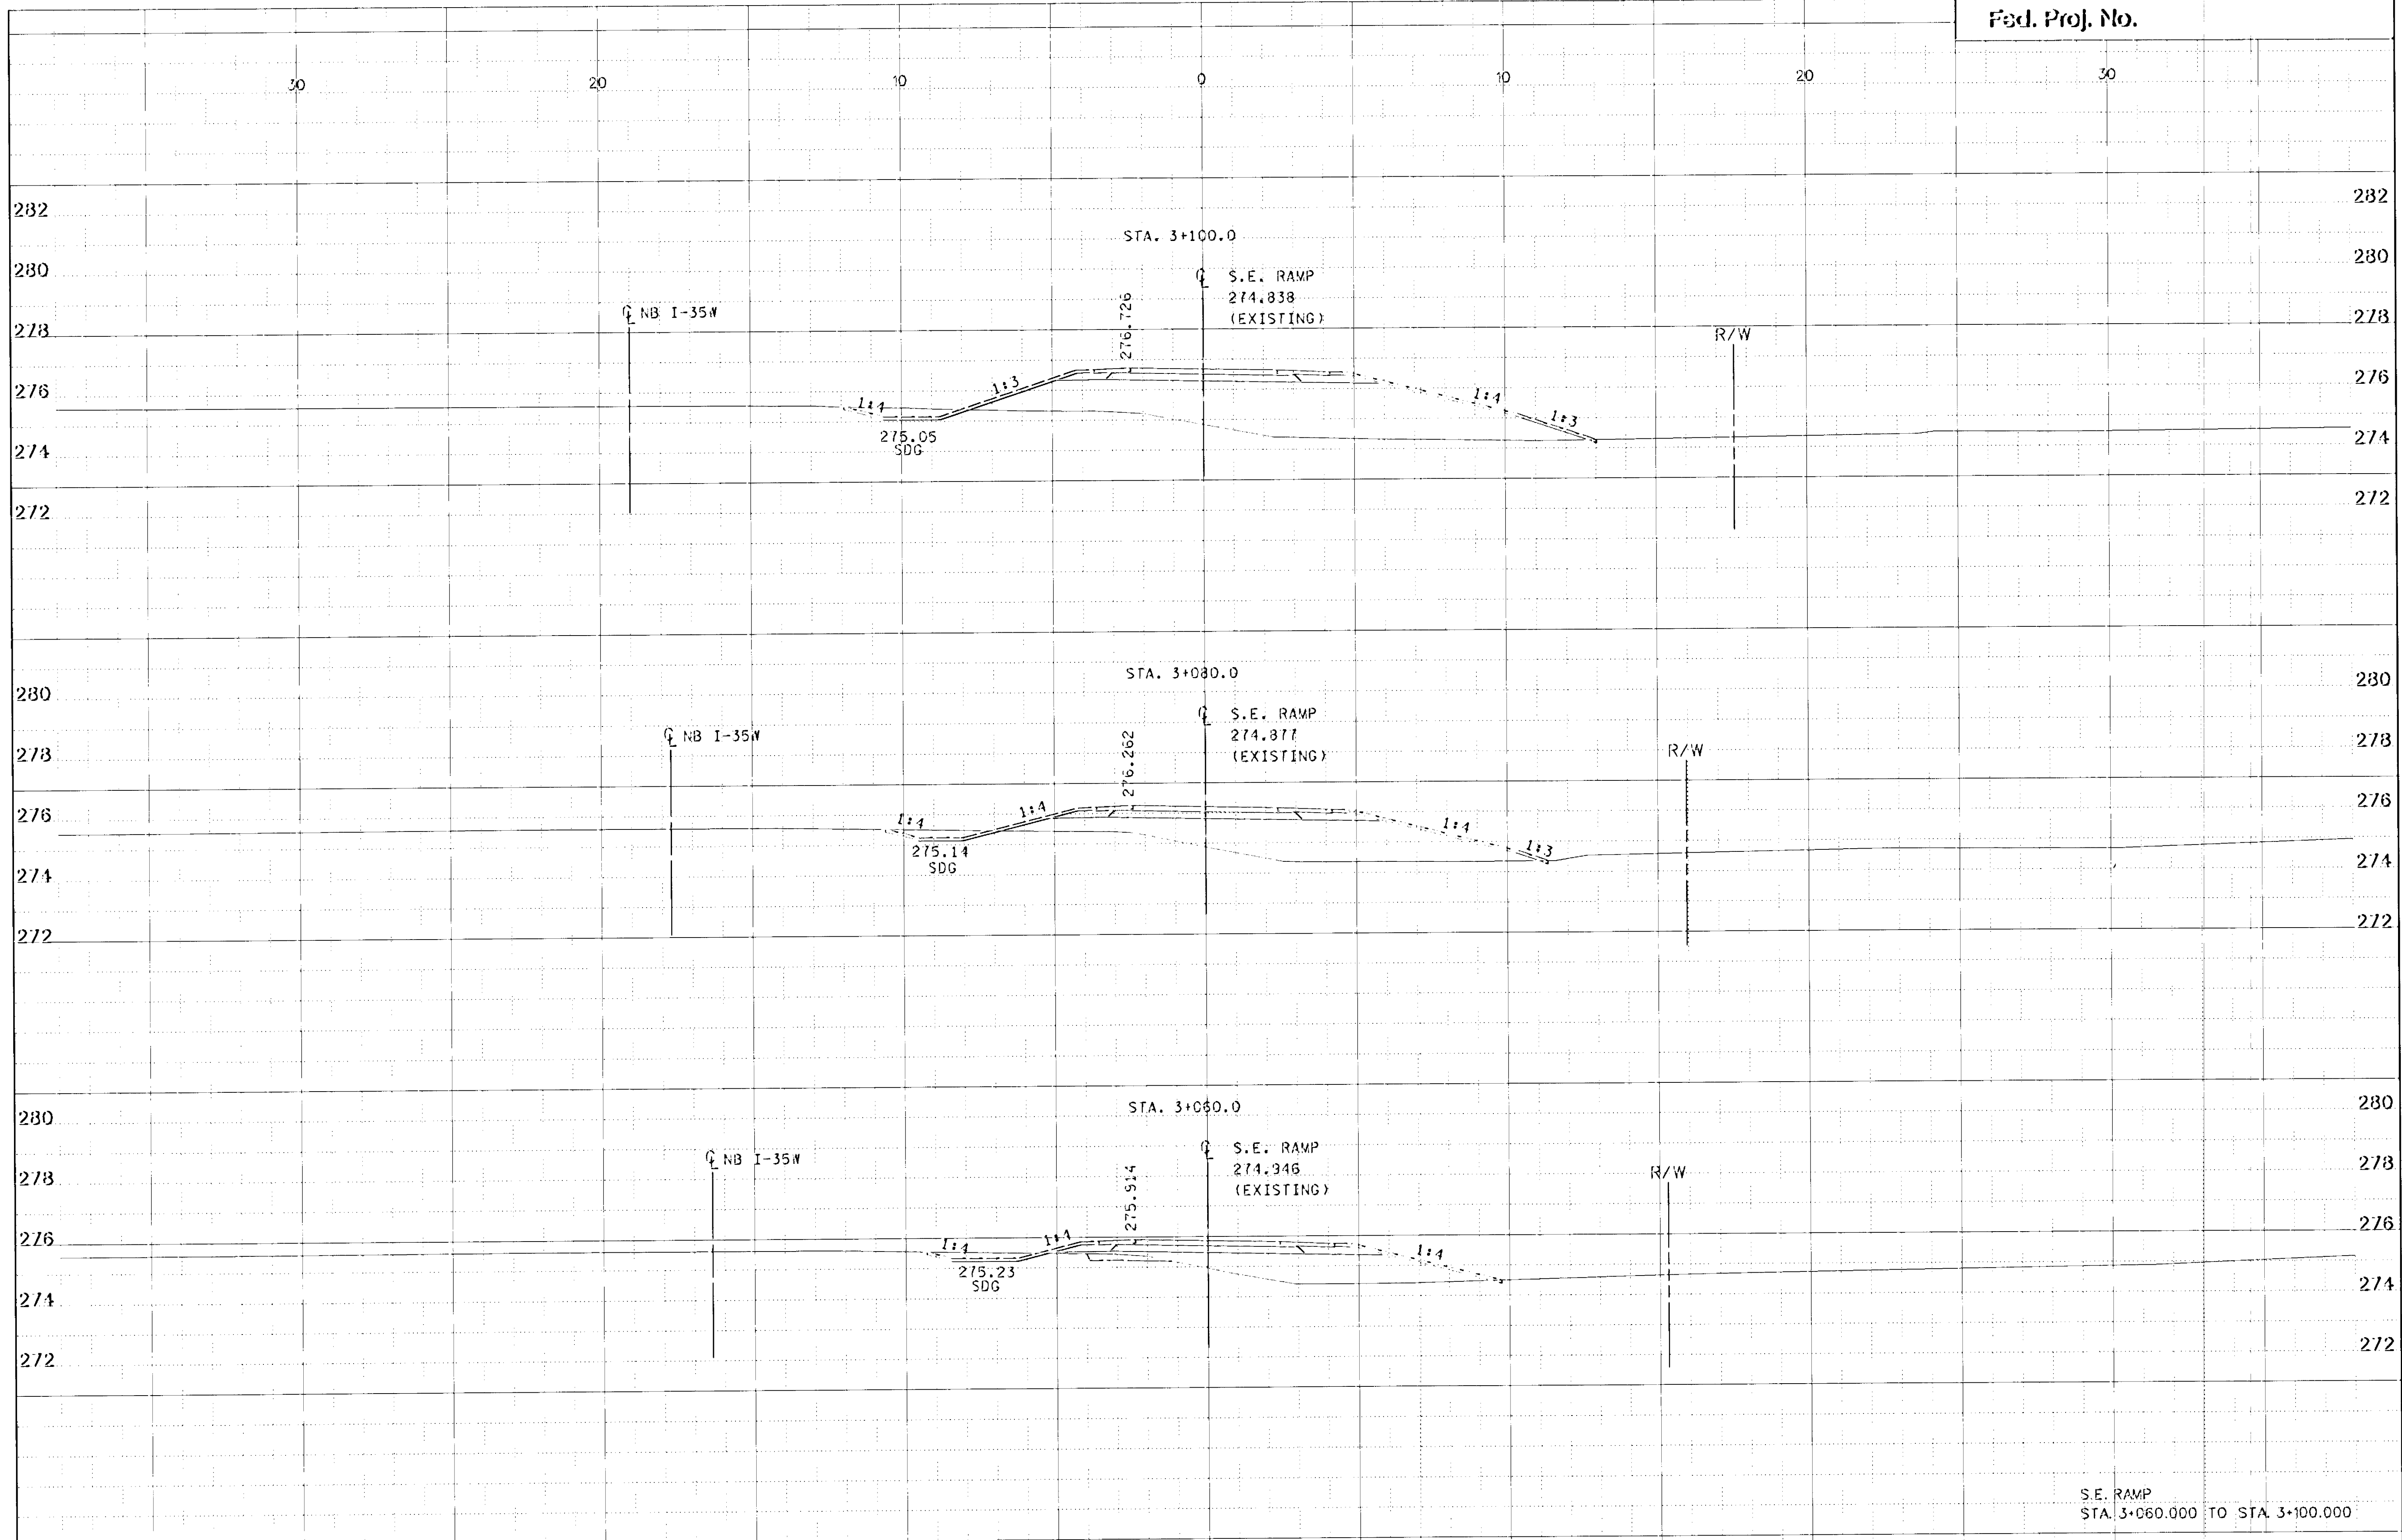


S.E. RAMP
STA. 3+060.000 TO STA. 3+100.000


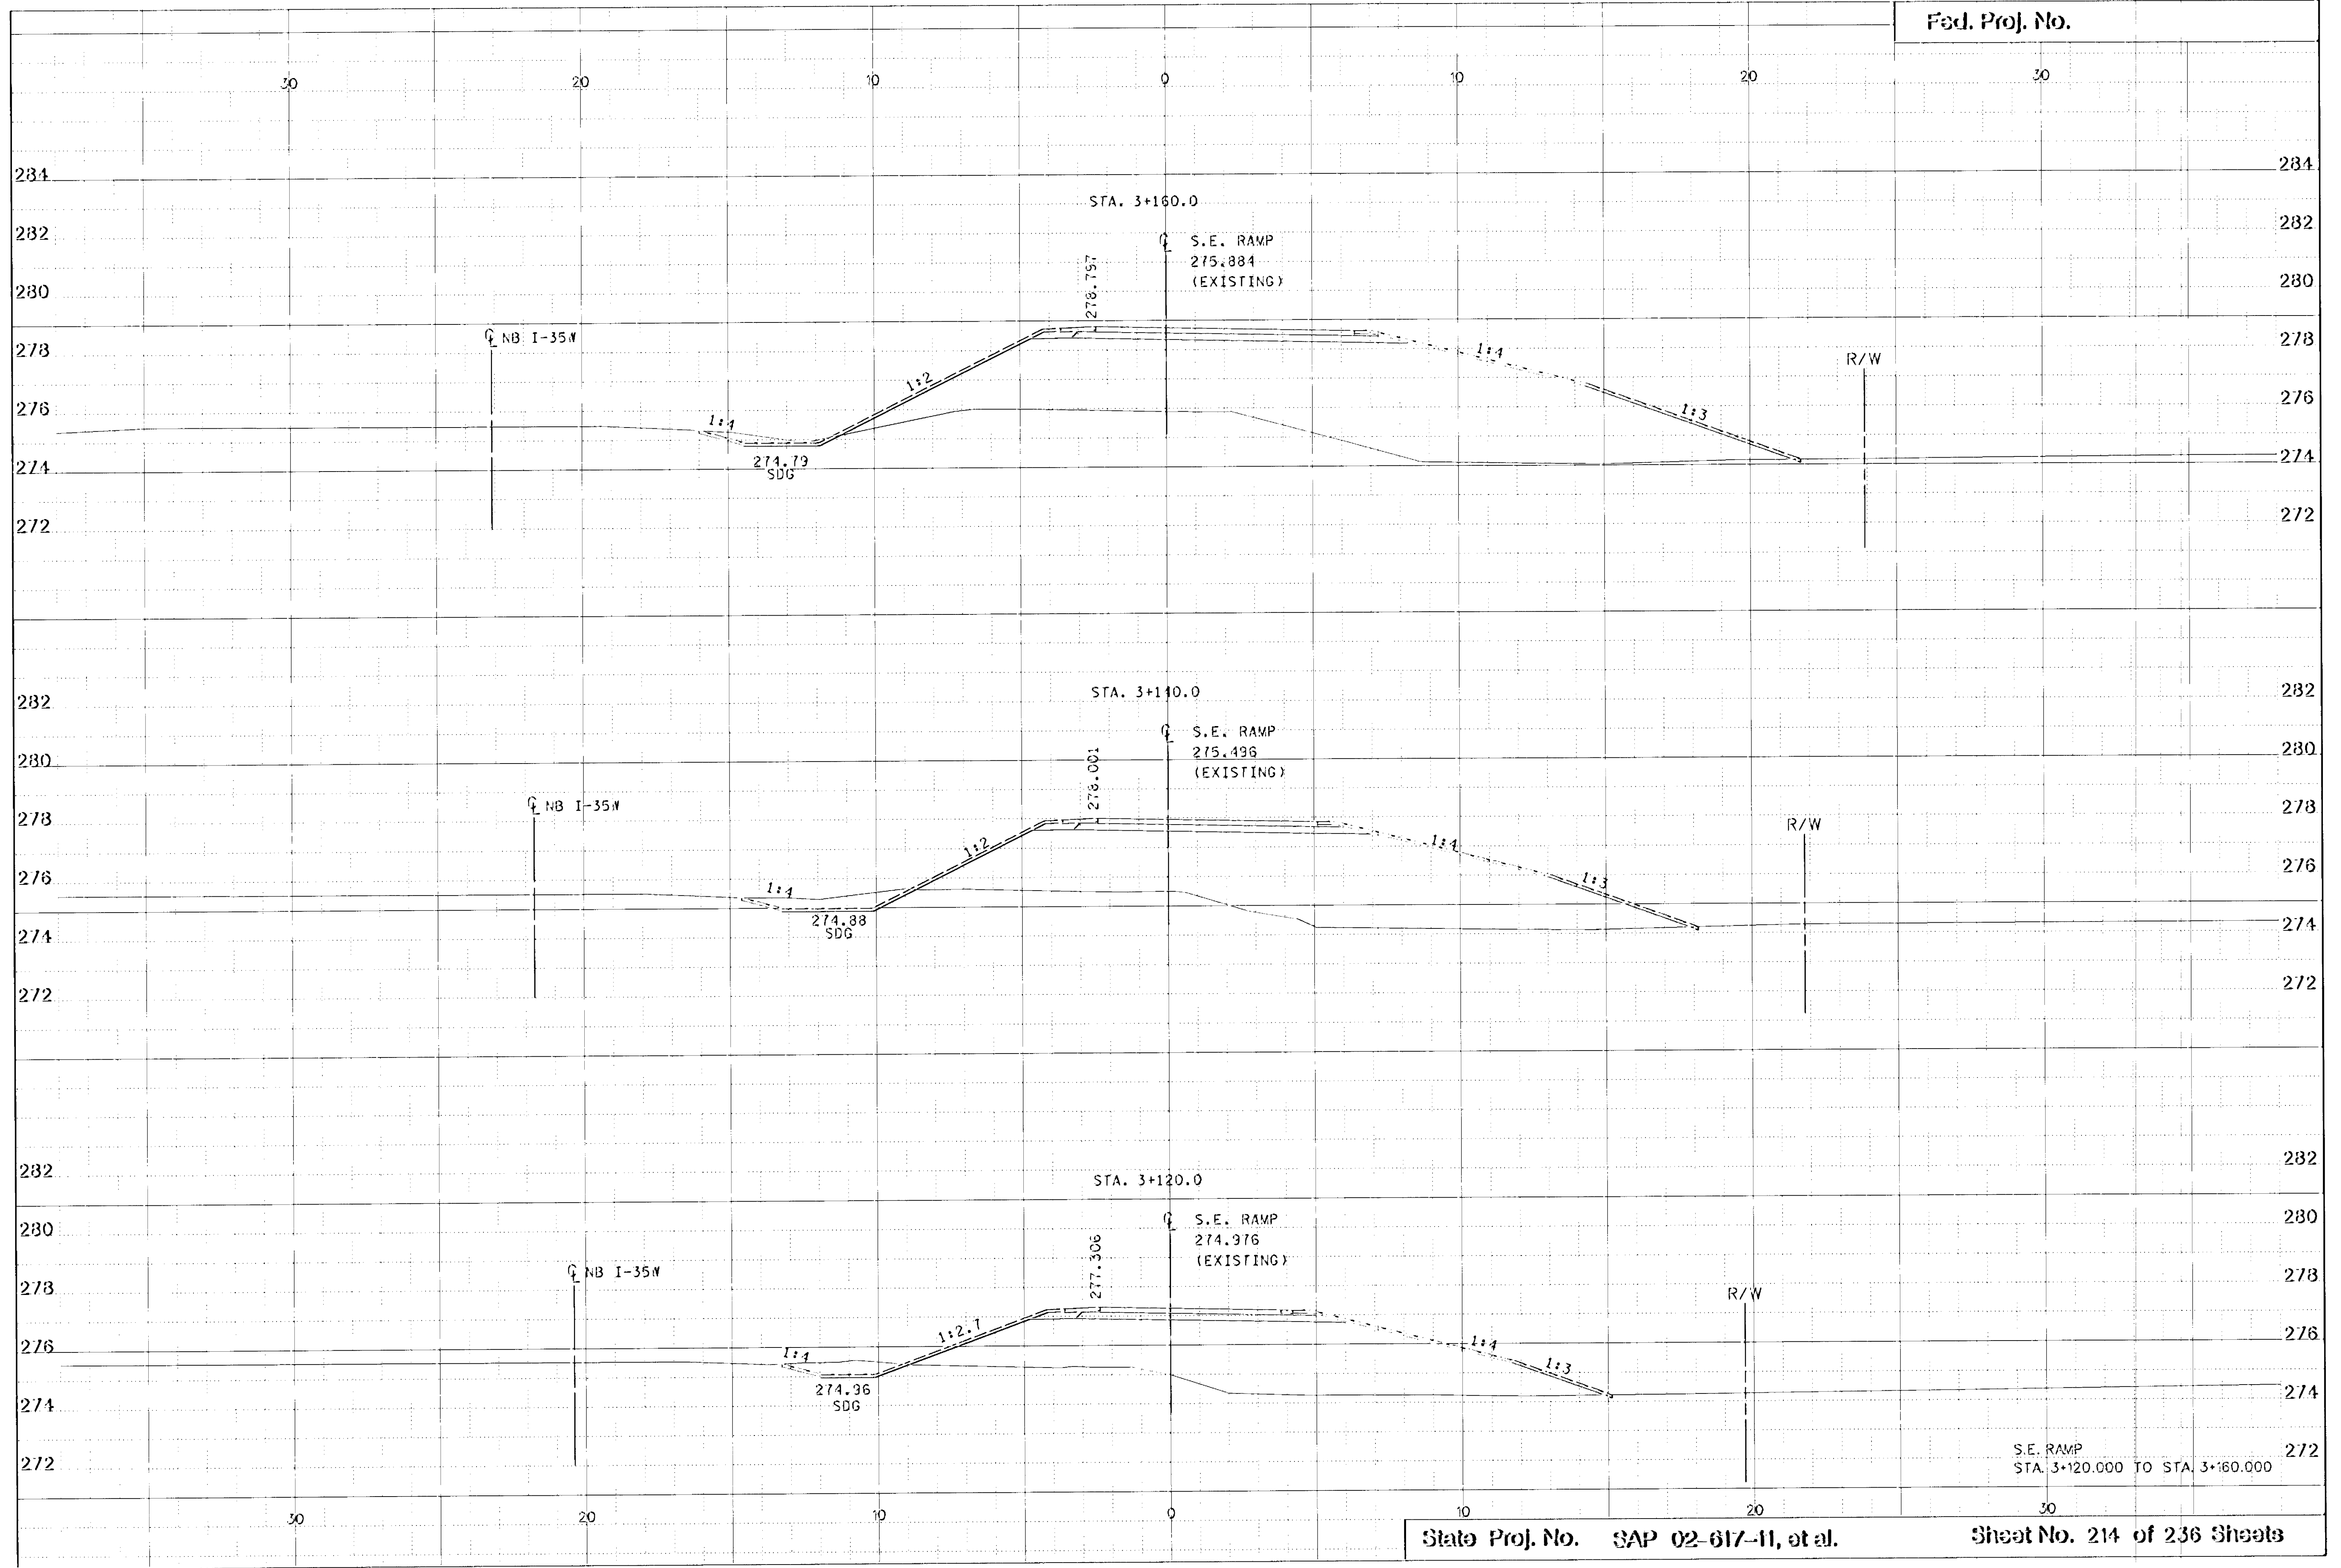


S.E. RAMP
STA. 3+120.000 TO STA. 3+160.000

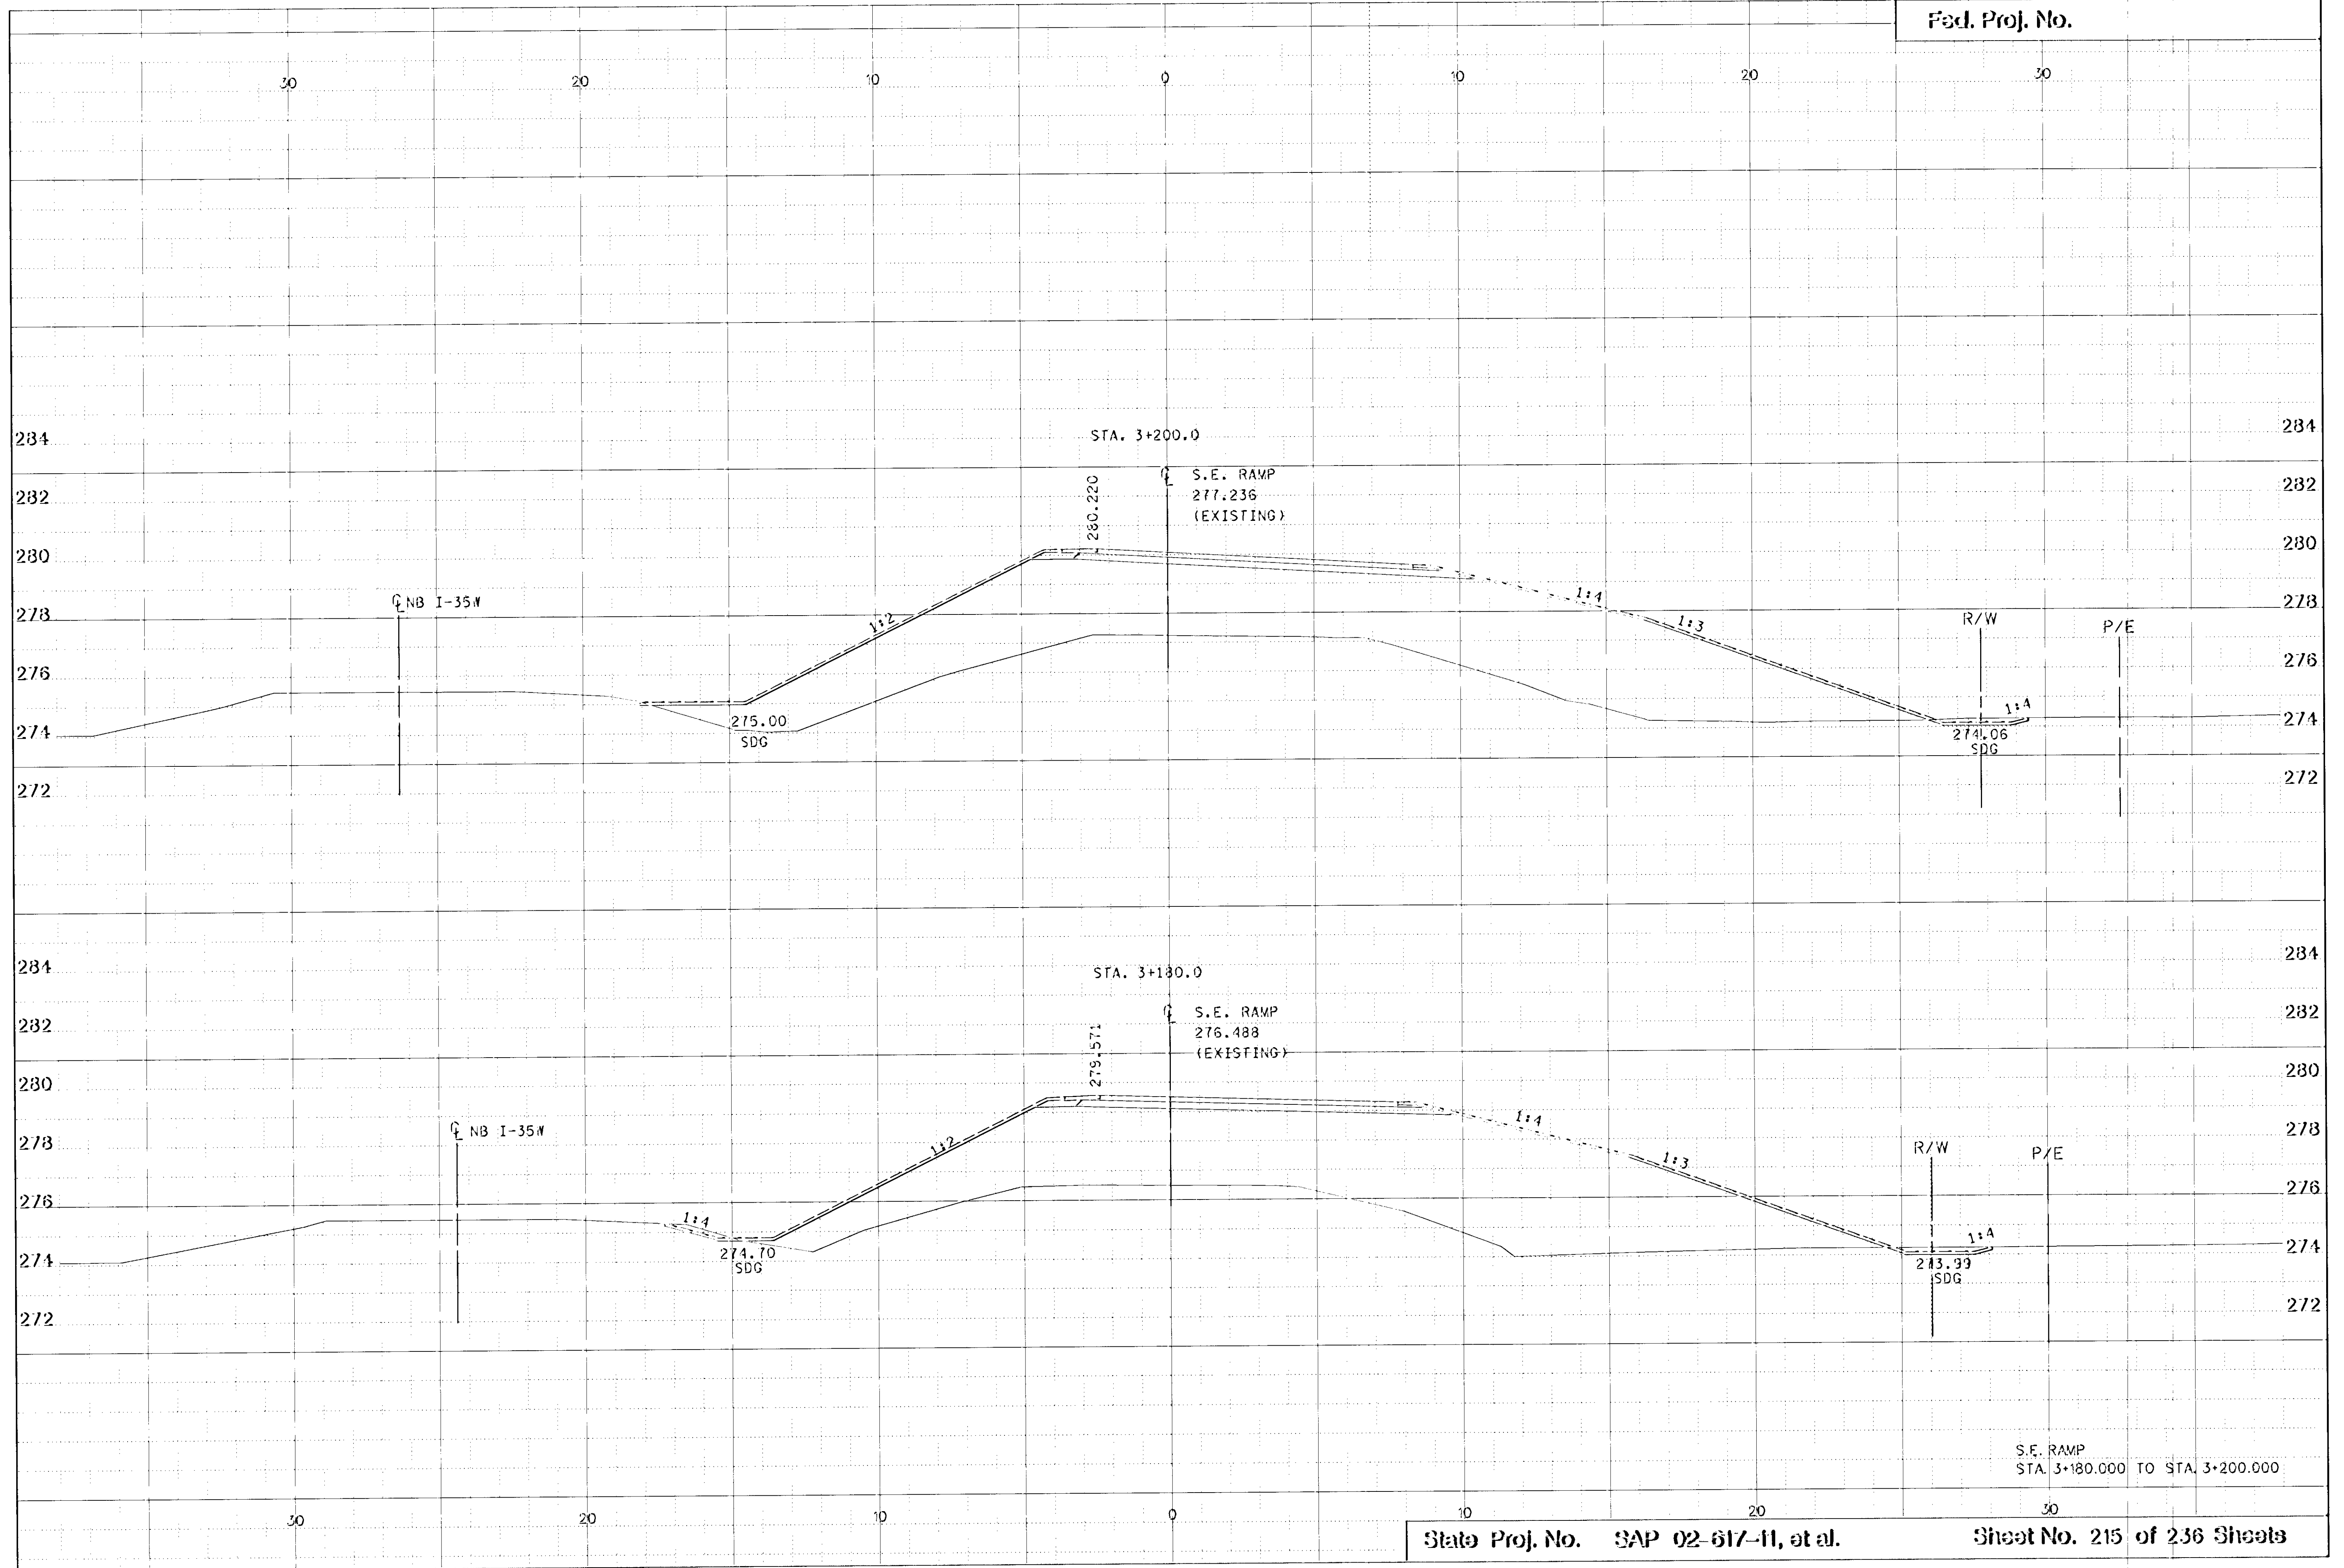


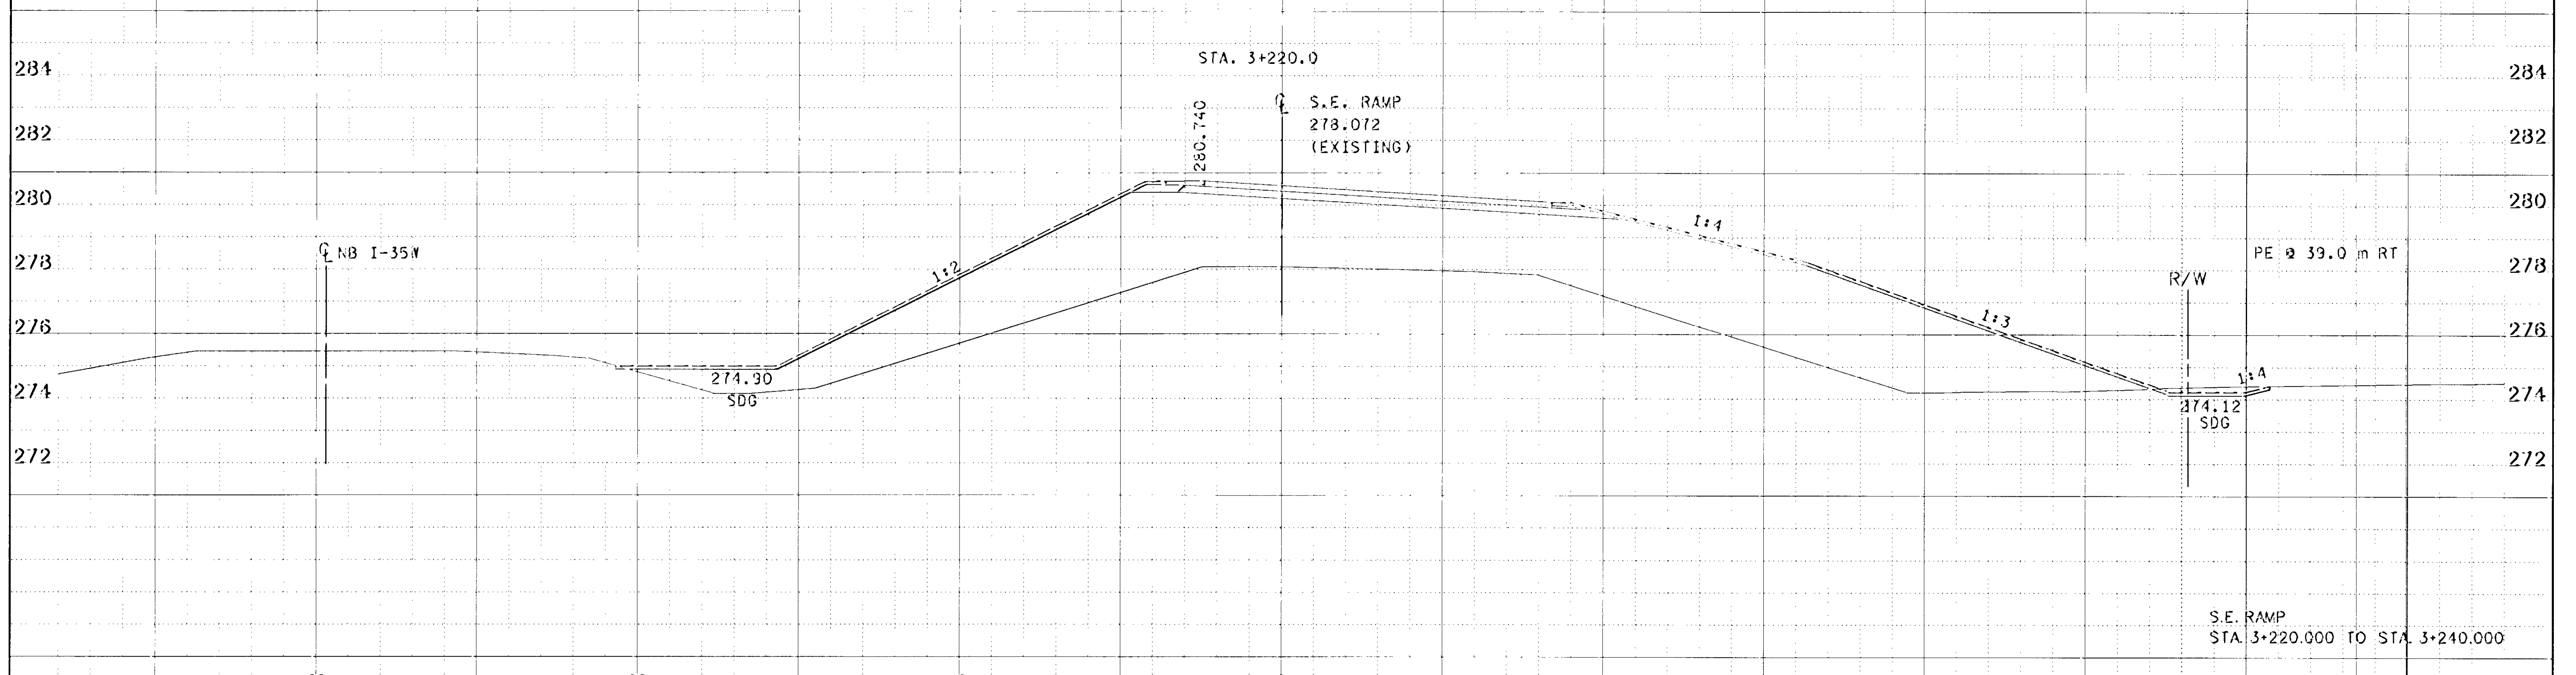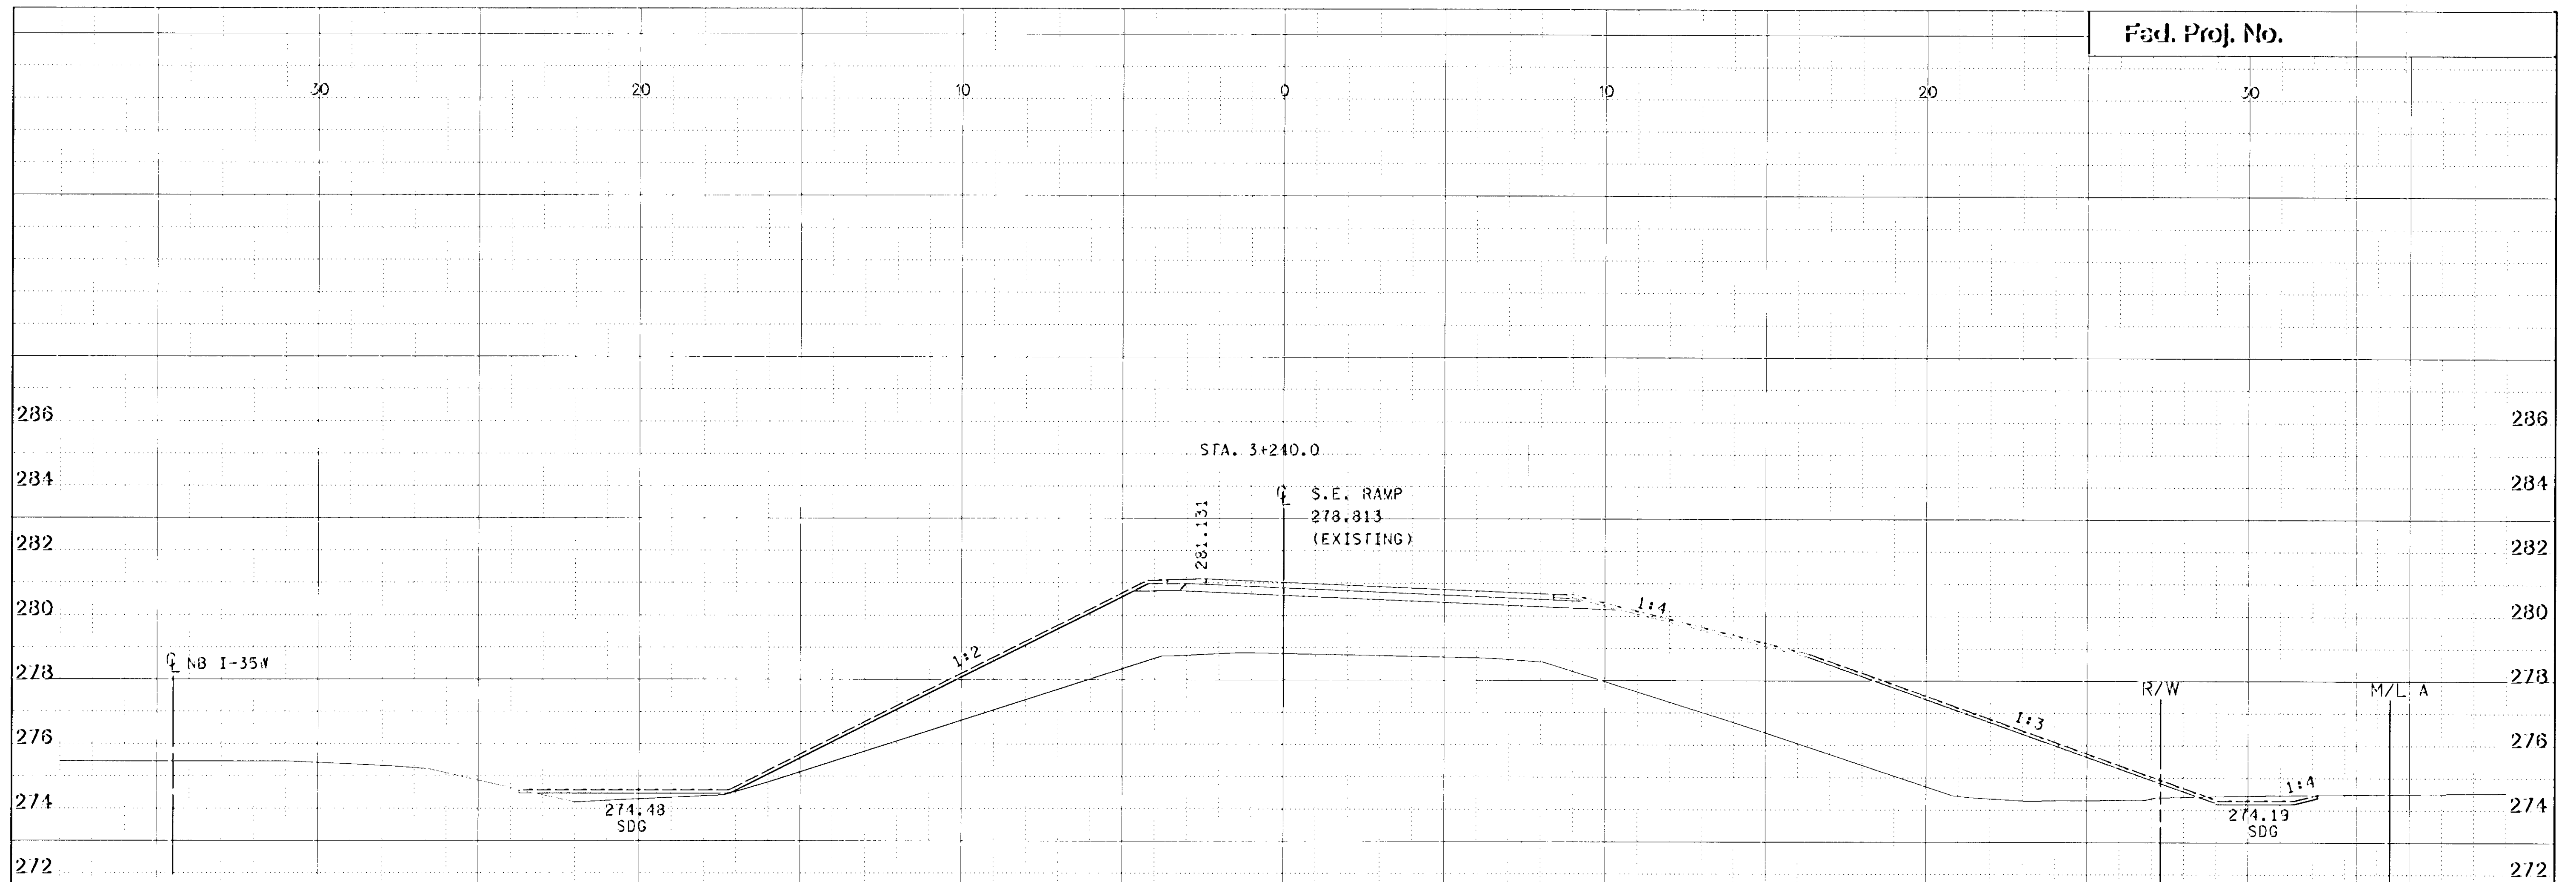


30 20 10 0 10 20 30

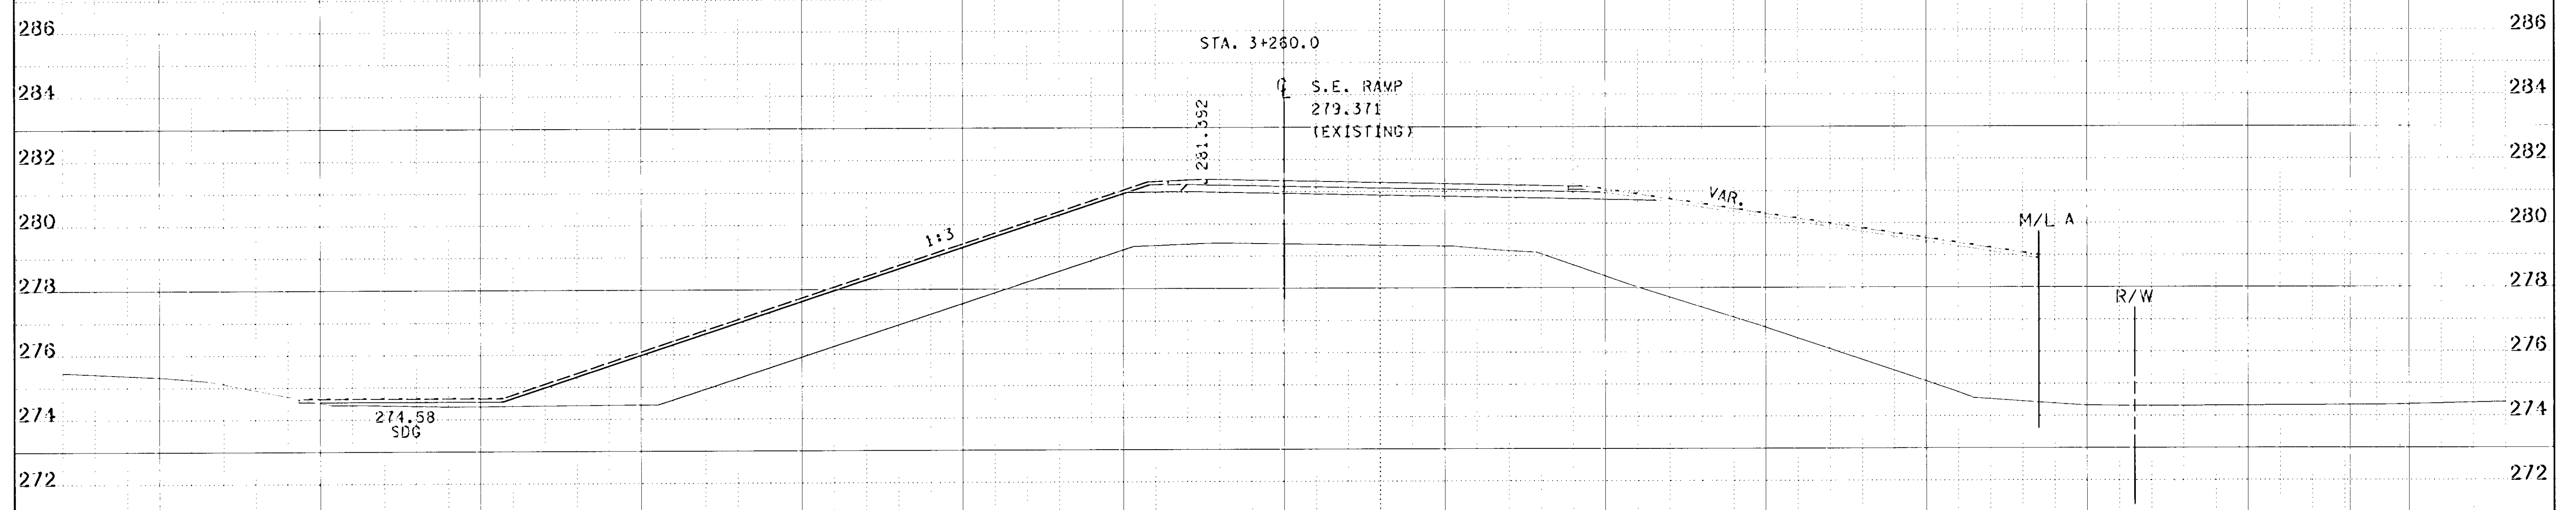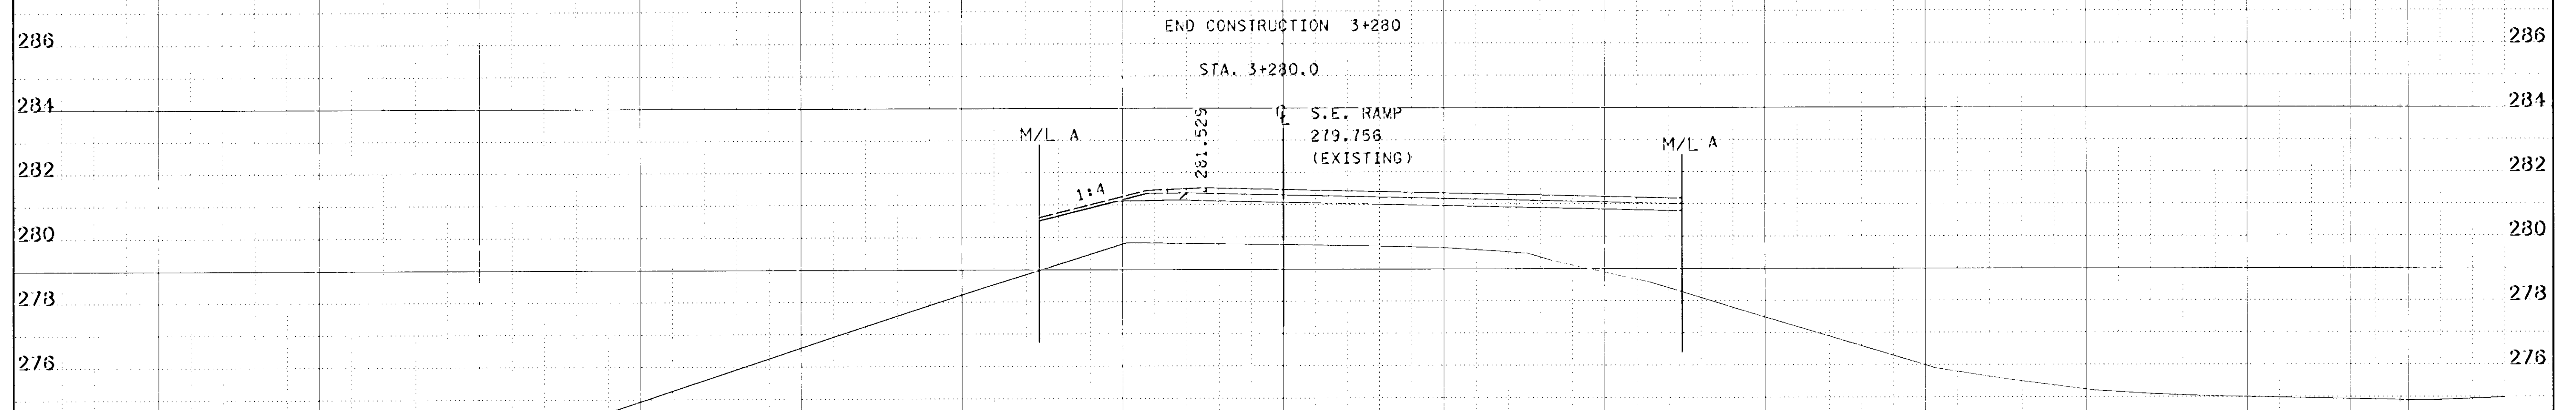

S.E. RAMP
STA. 3+260.000 TO STA. 3+280.000

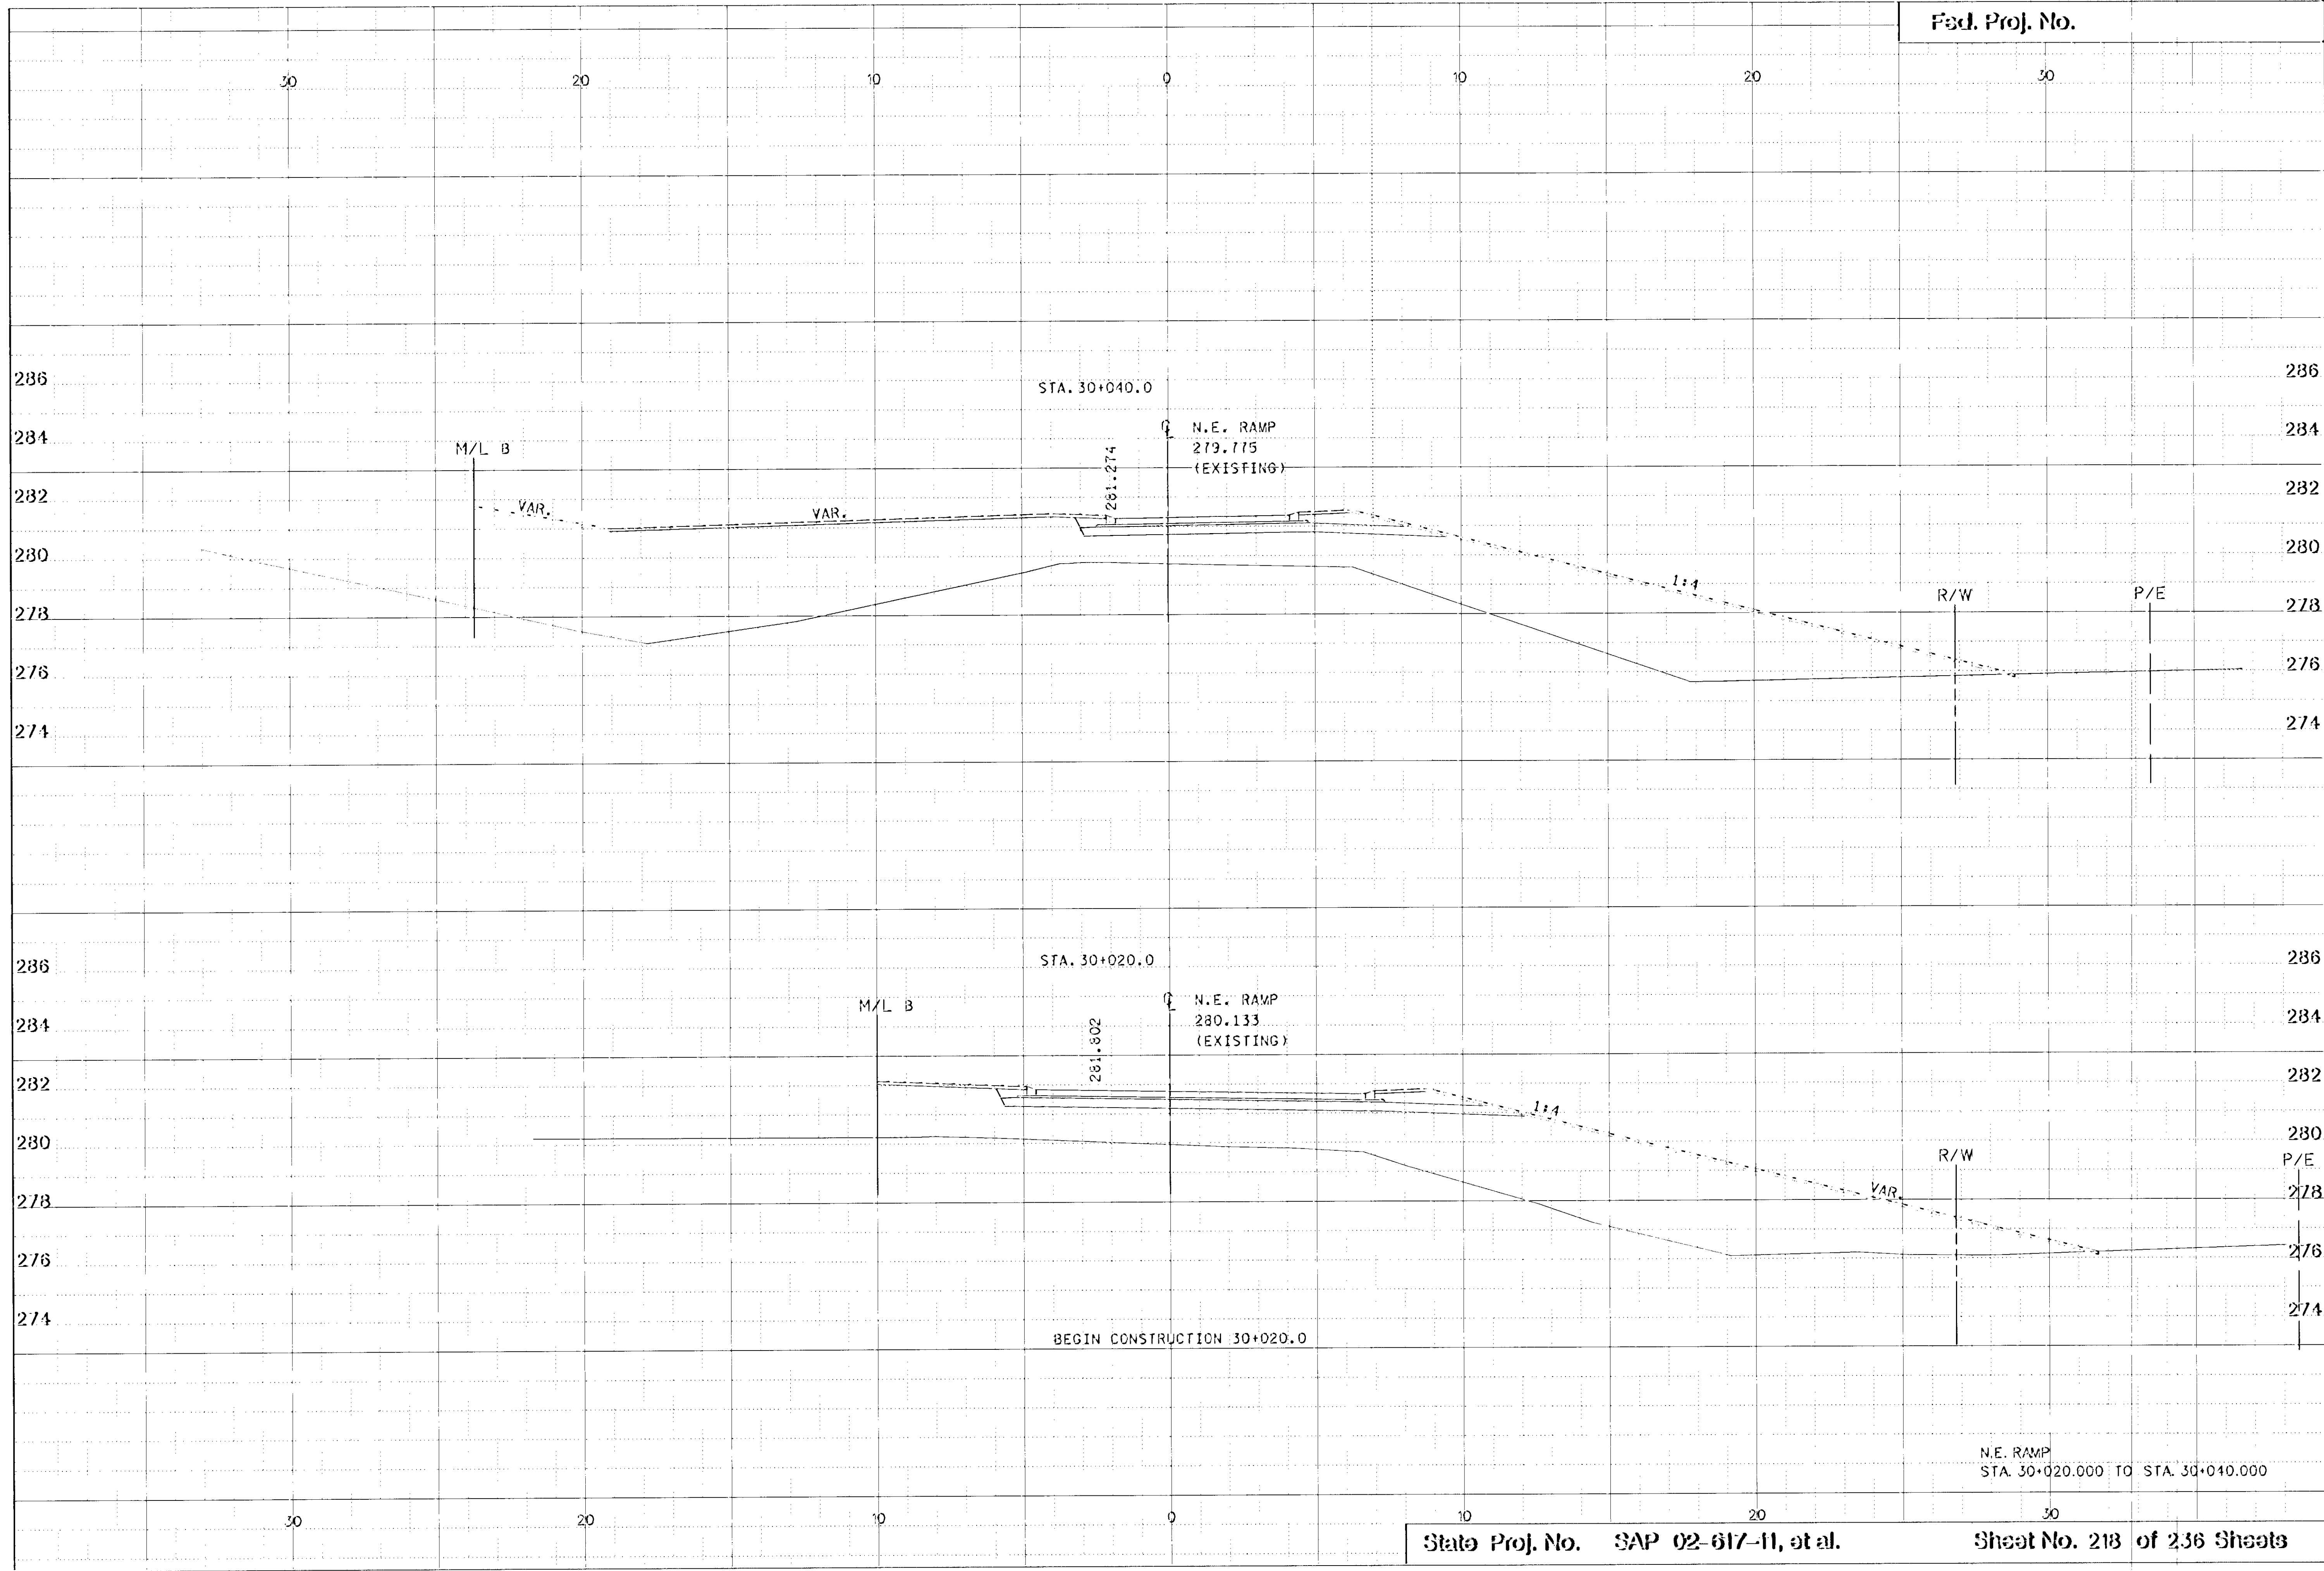

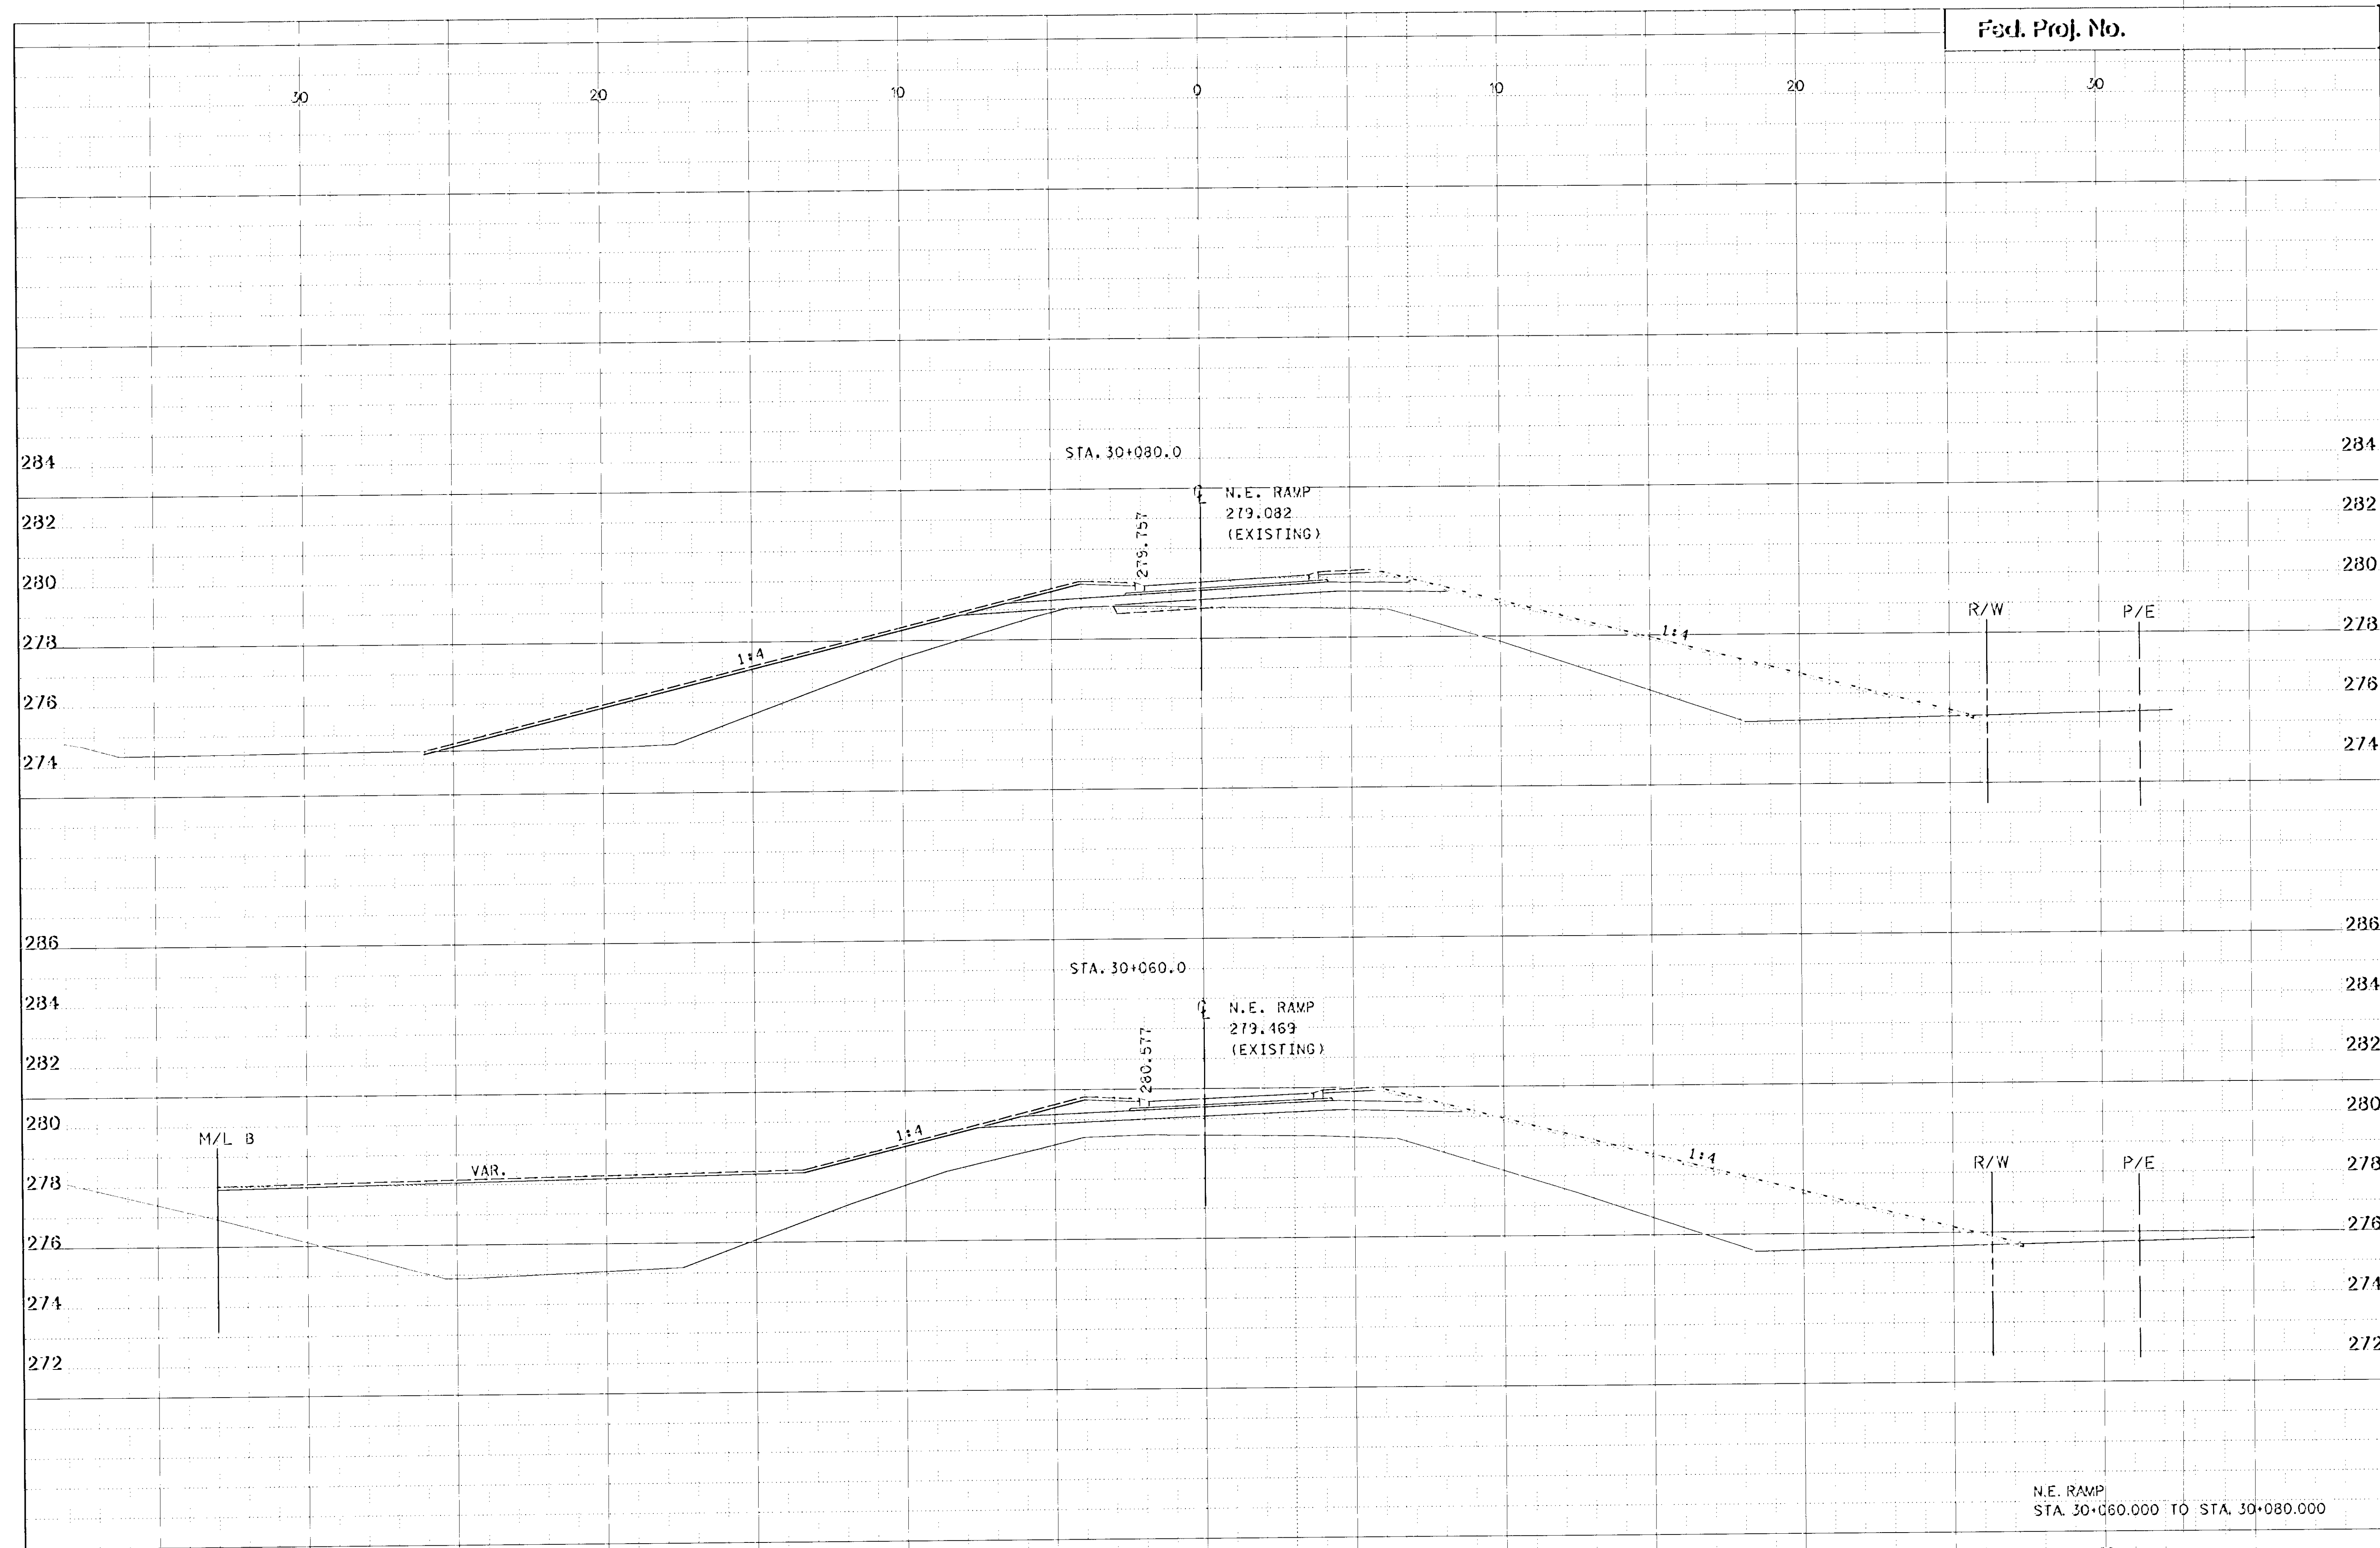

N.E. RAMP
STA. 30+060.000 TO STA. 30+080.000

30

20

10

0

10

20

30

282

280

278

276

274

272

282

280

278

276

274

272

STA. 30+120.0

N.E. RAMP
278.123
(EXISTING)

278.177

1:4

1:4

R/W

284

282

280

278

276

274

272

284

282

280

278

276

274

272

STA. 30+100.0

N.E. RAMP
278.593
(EXISTING)

278.932

1:4

1:4

R/W

P/E

N.E. RAMP
STA. 30+100.000 TO STA. 30+120.000

30

20


10


0

10


20

30

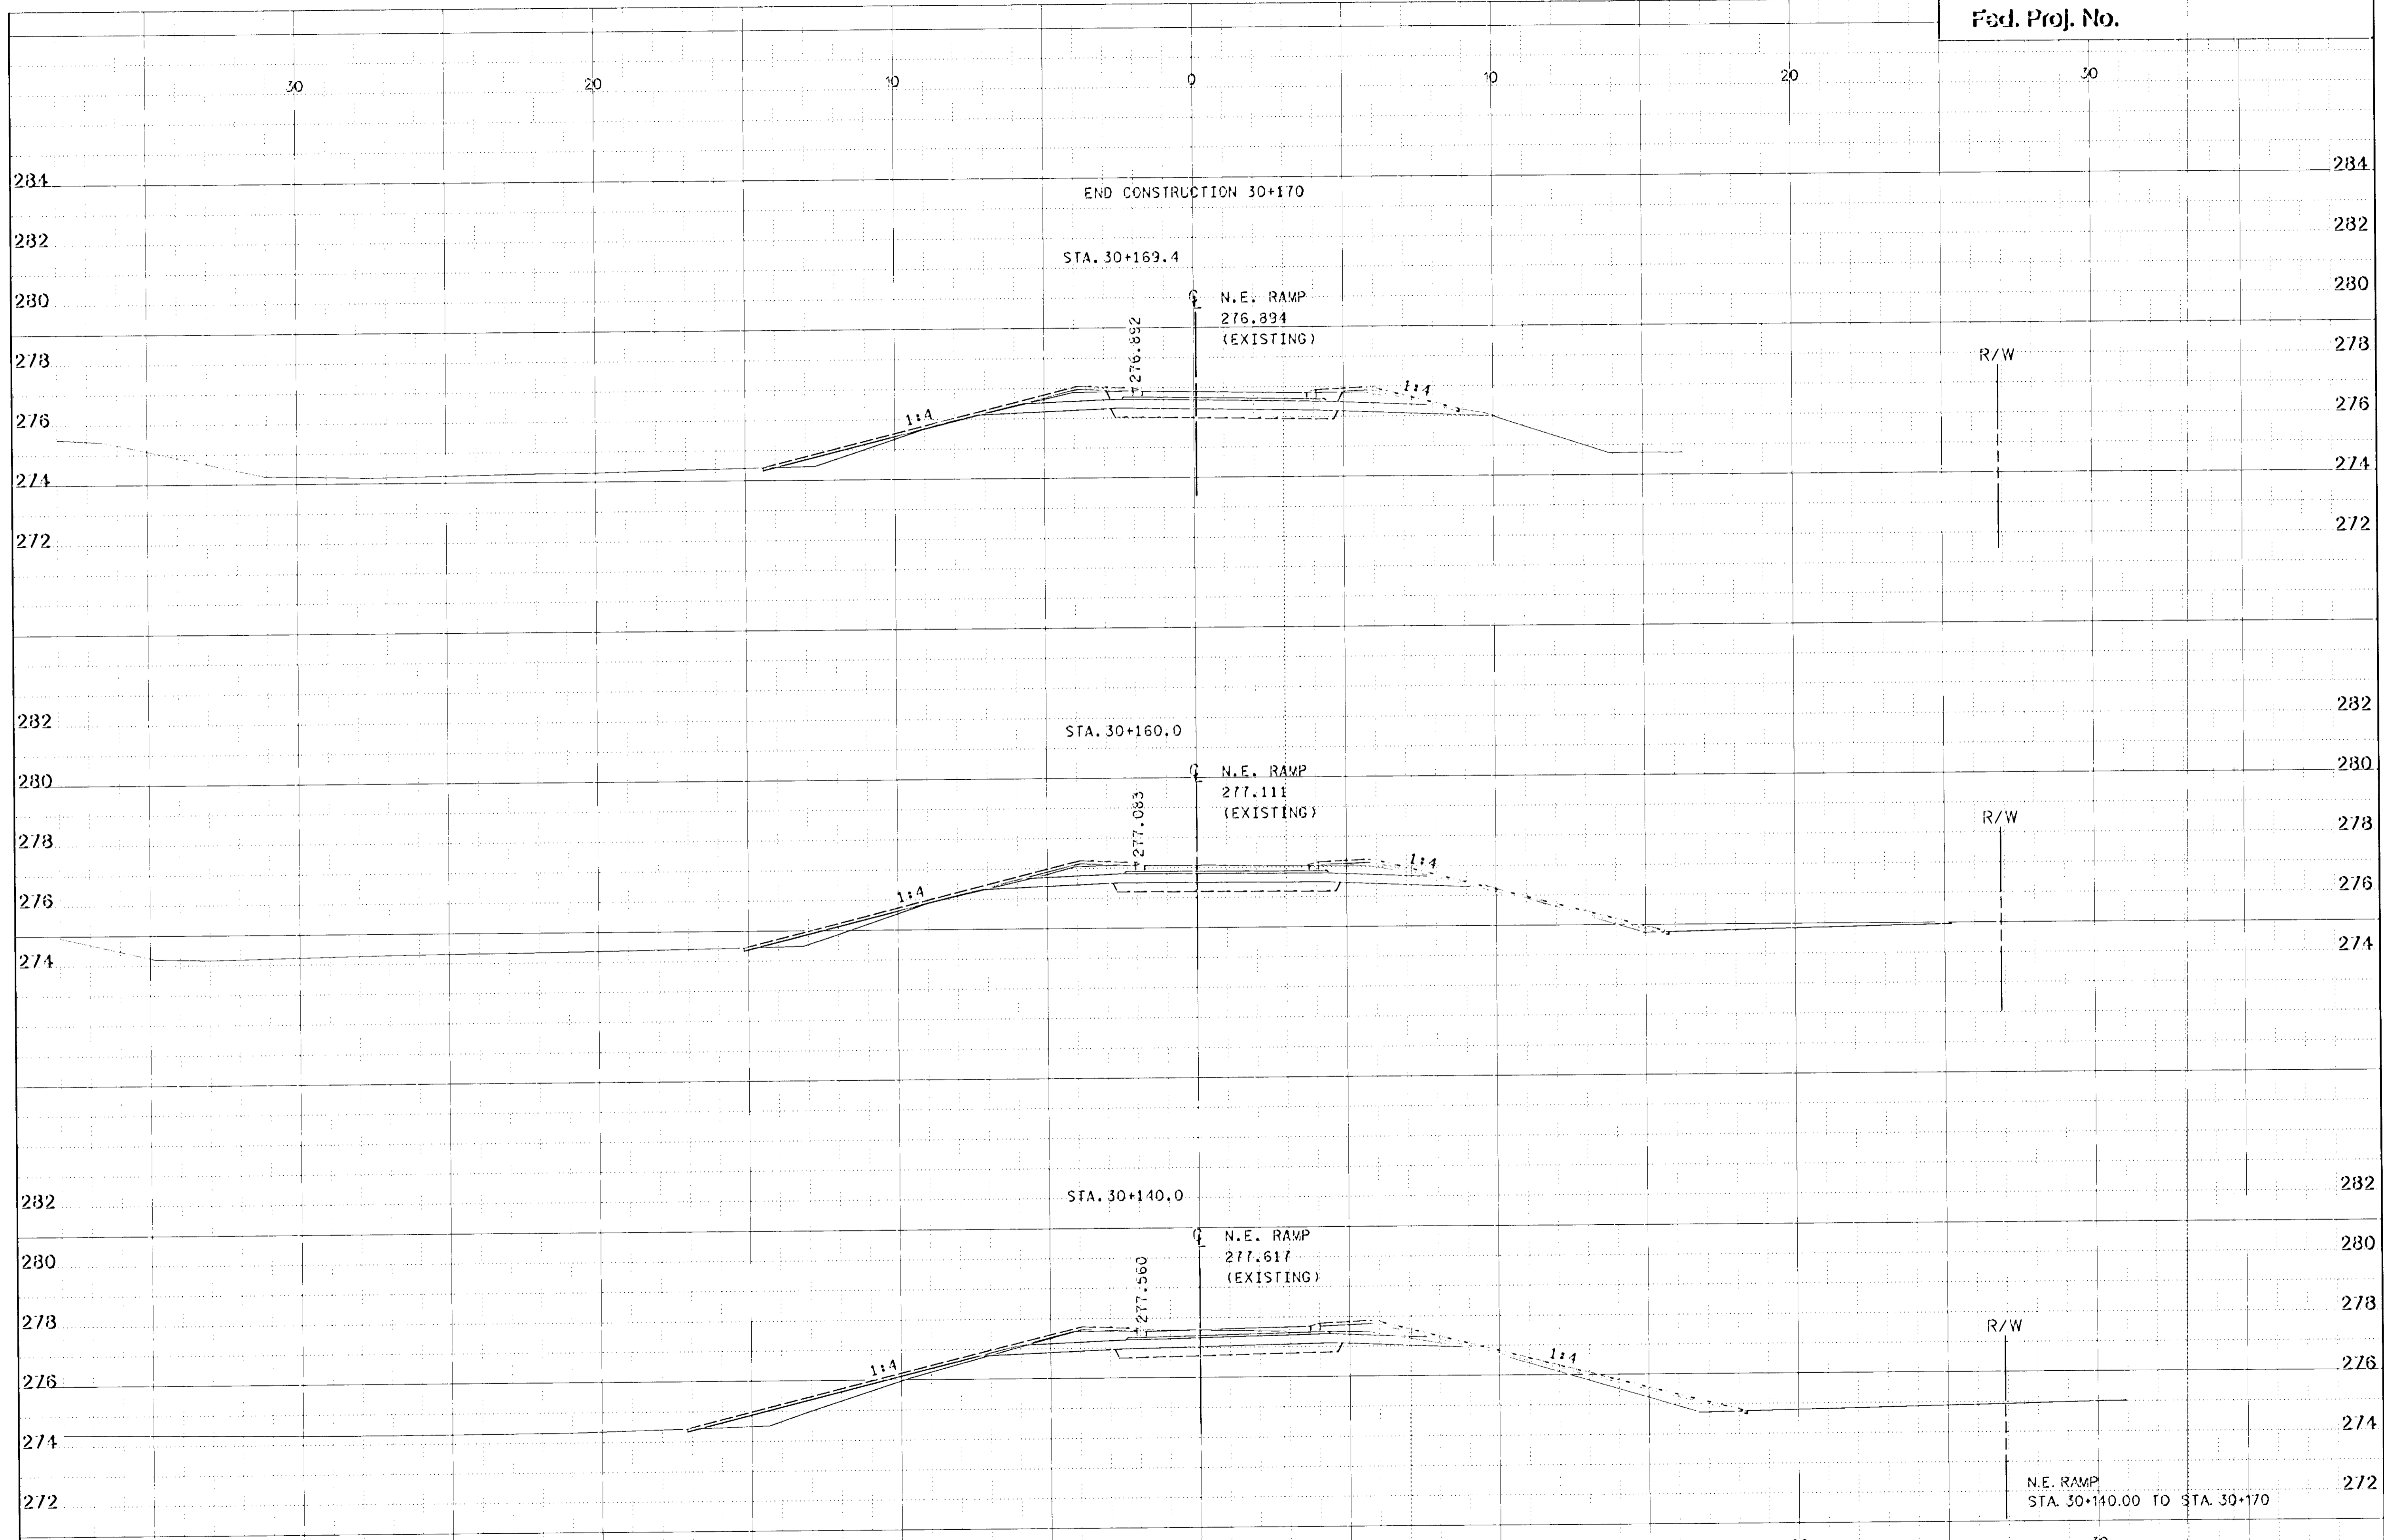


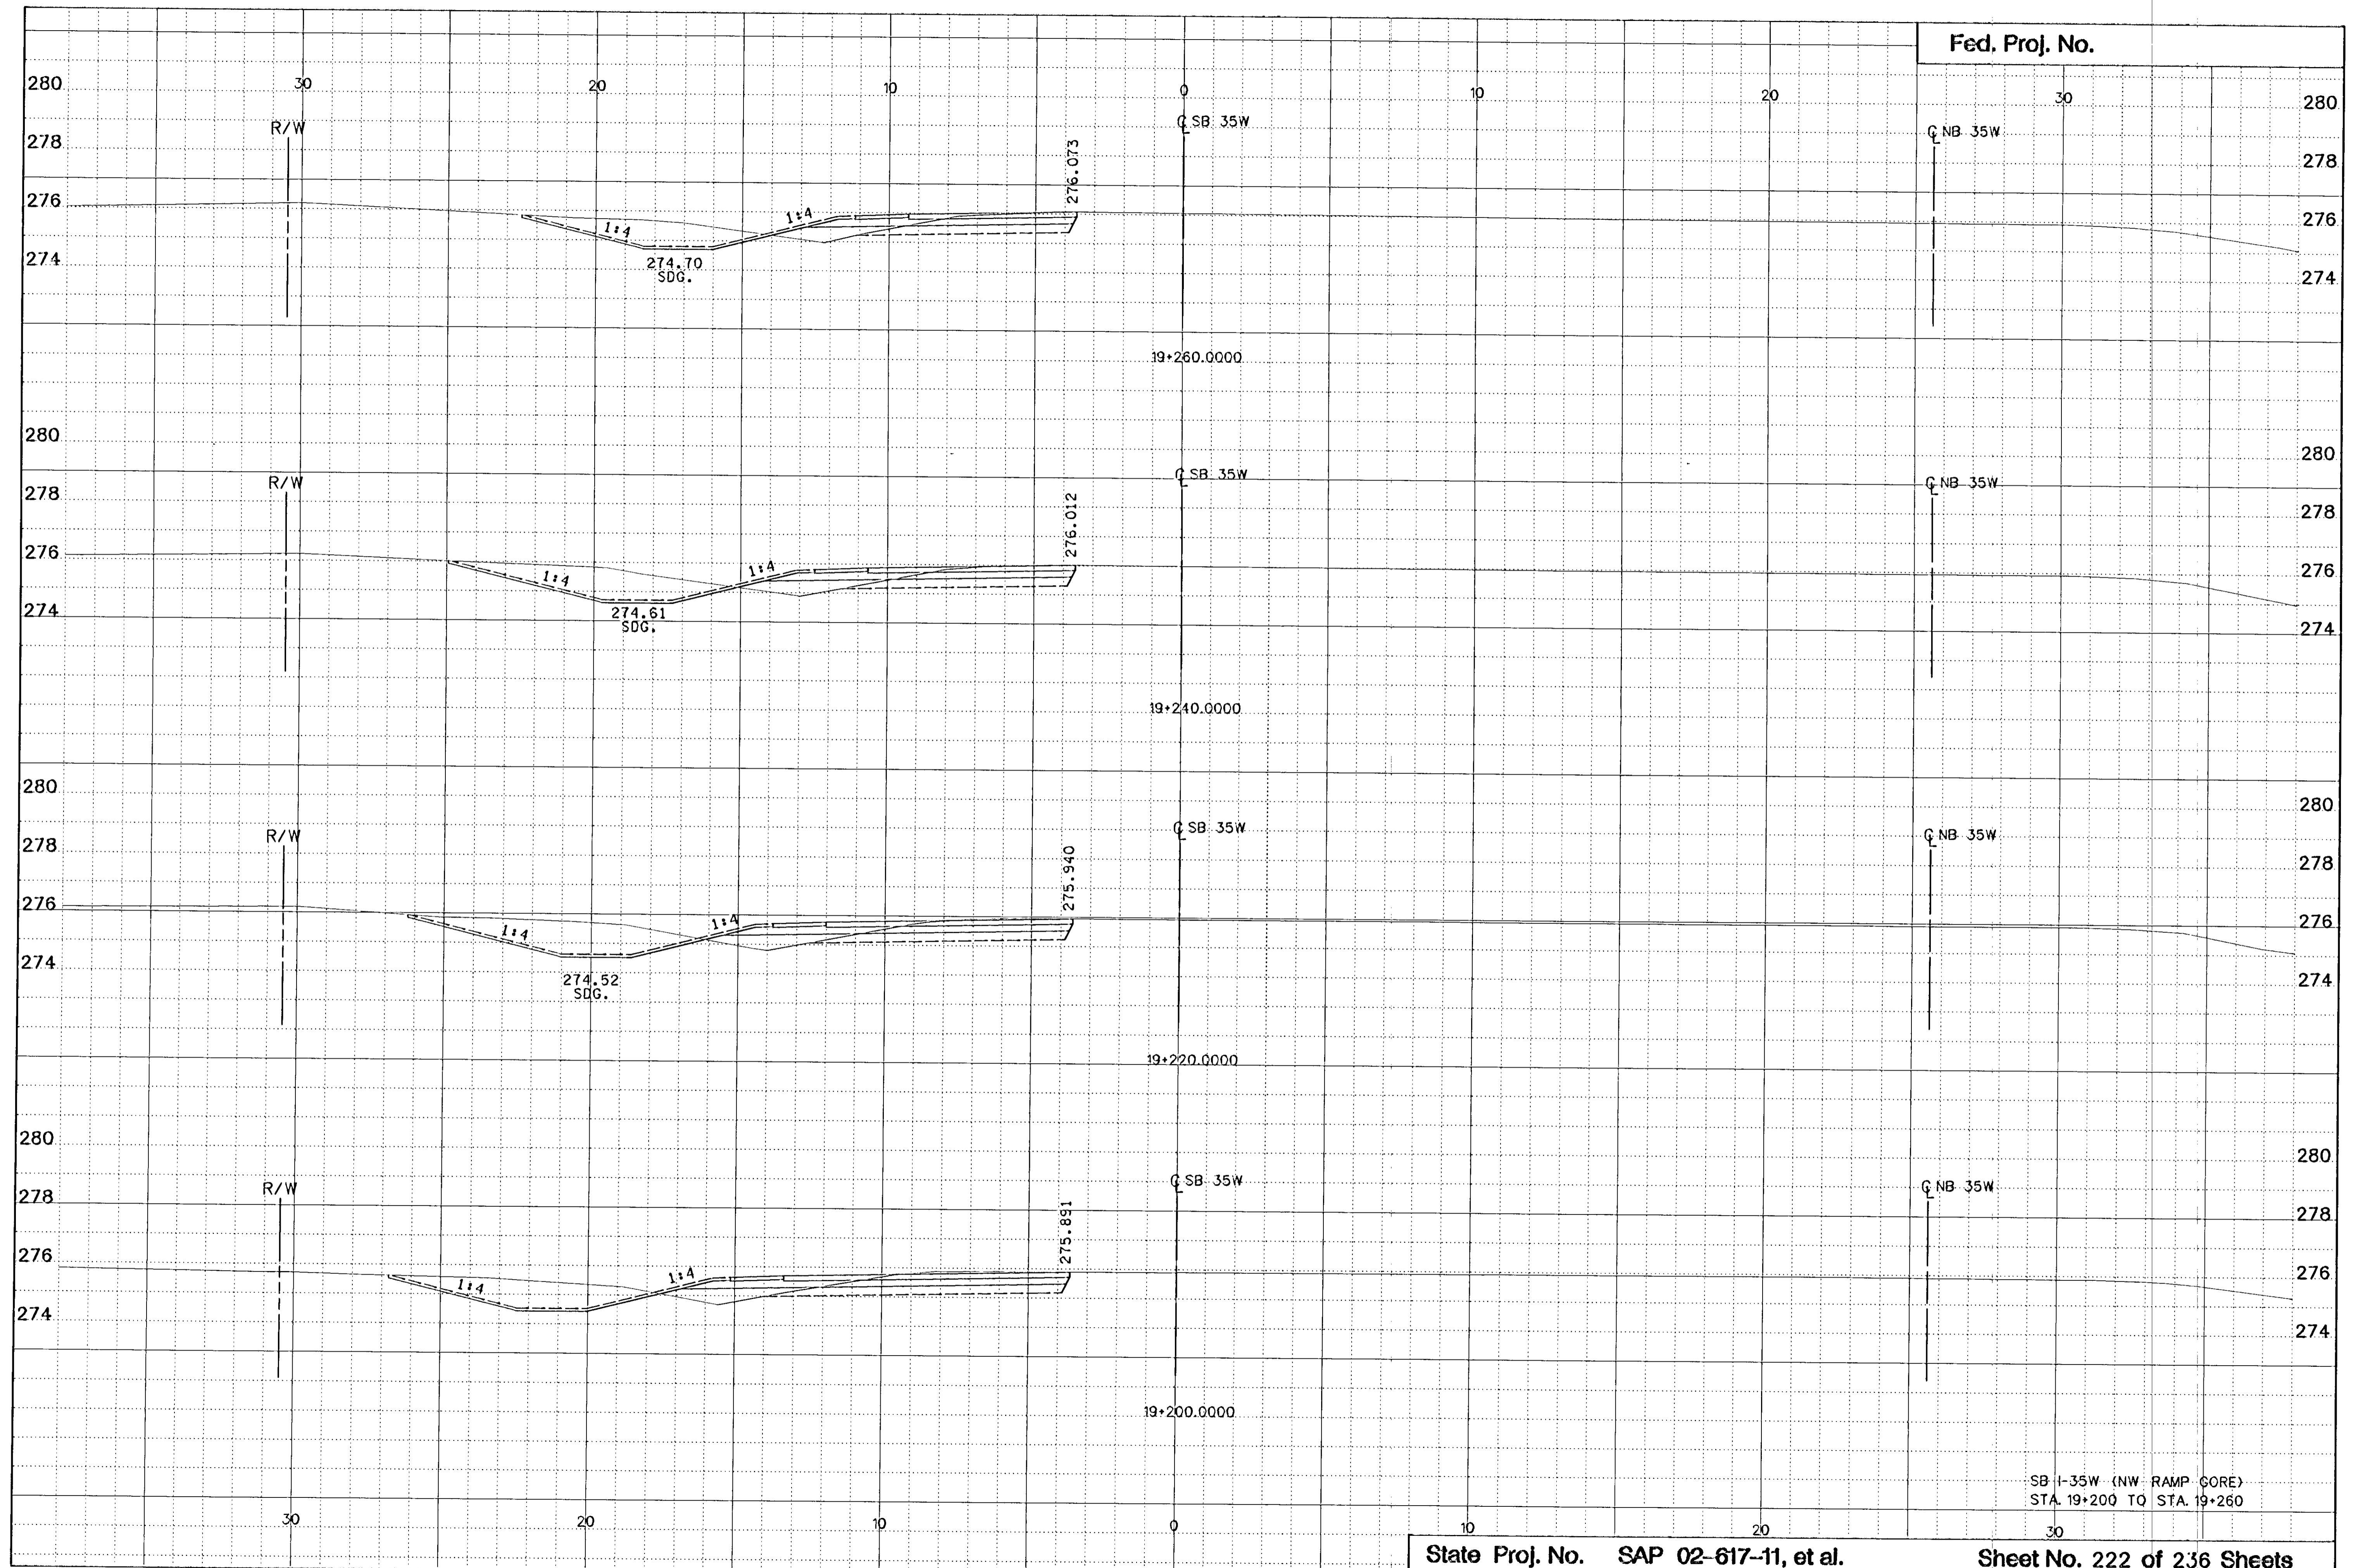

SB I-35W (NW RAMP CORE)
STA. 19+200 TO STA. 19+260

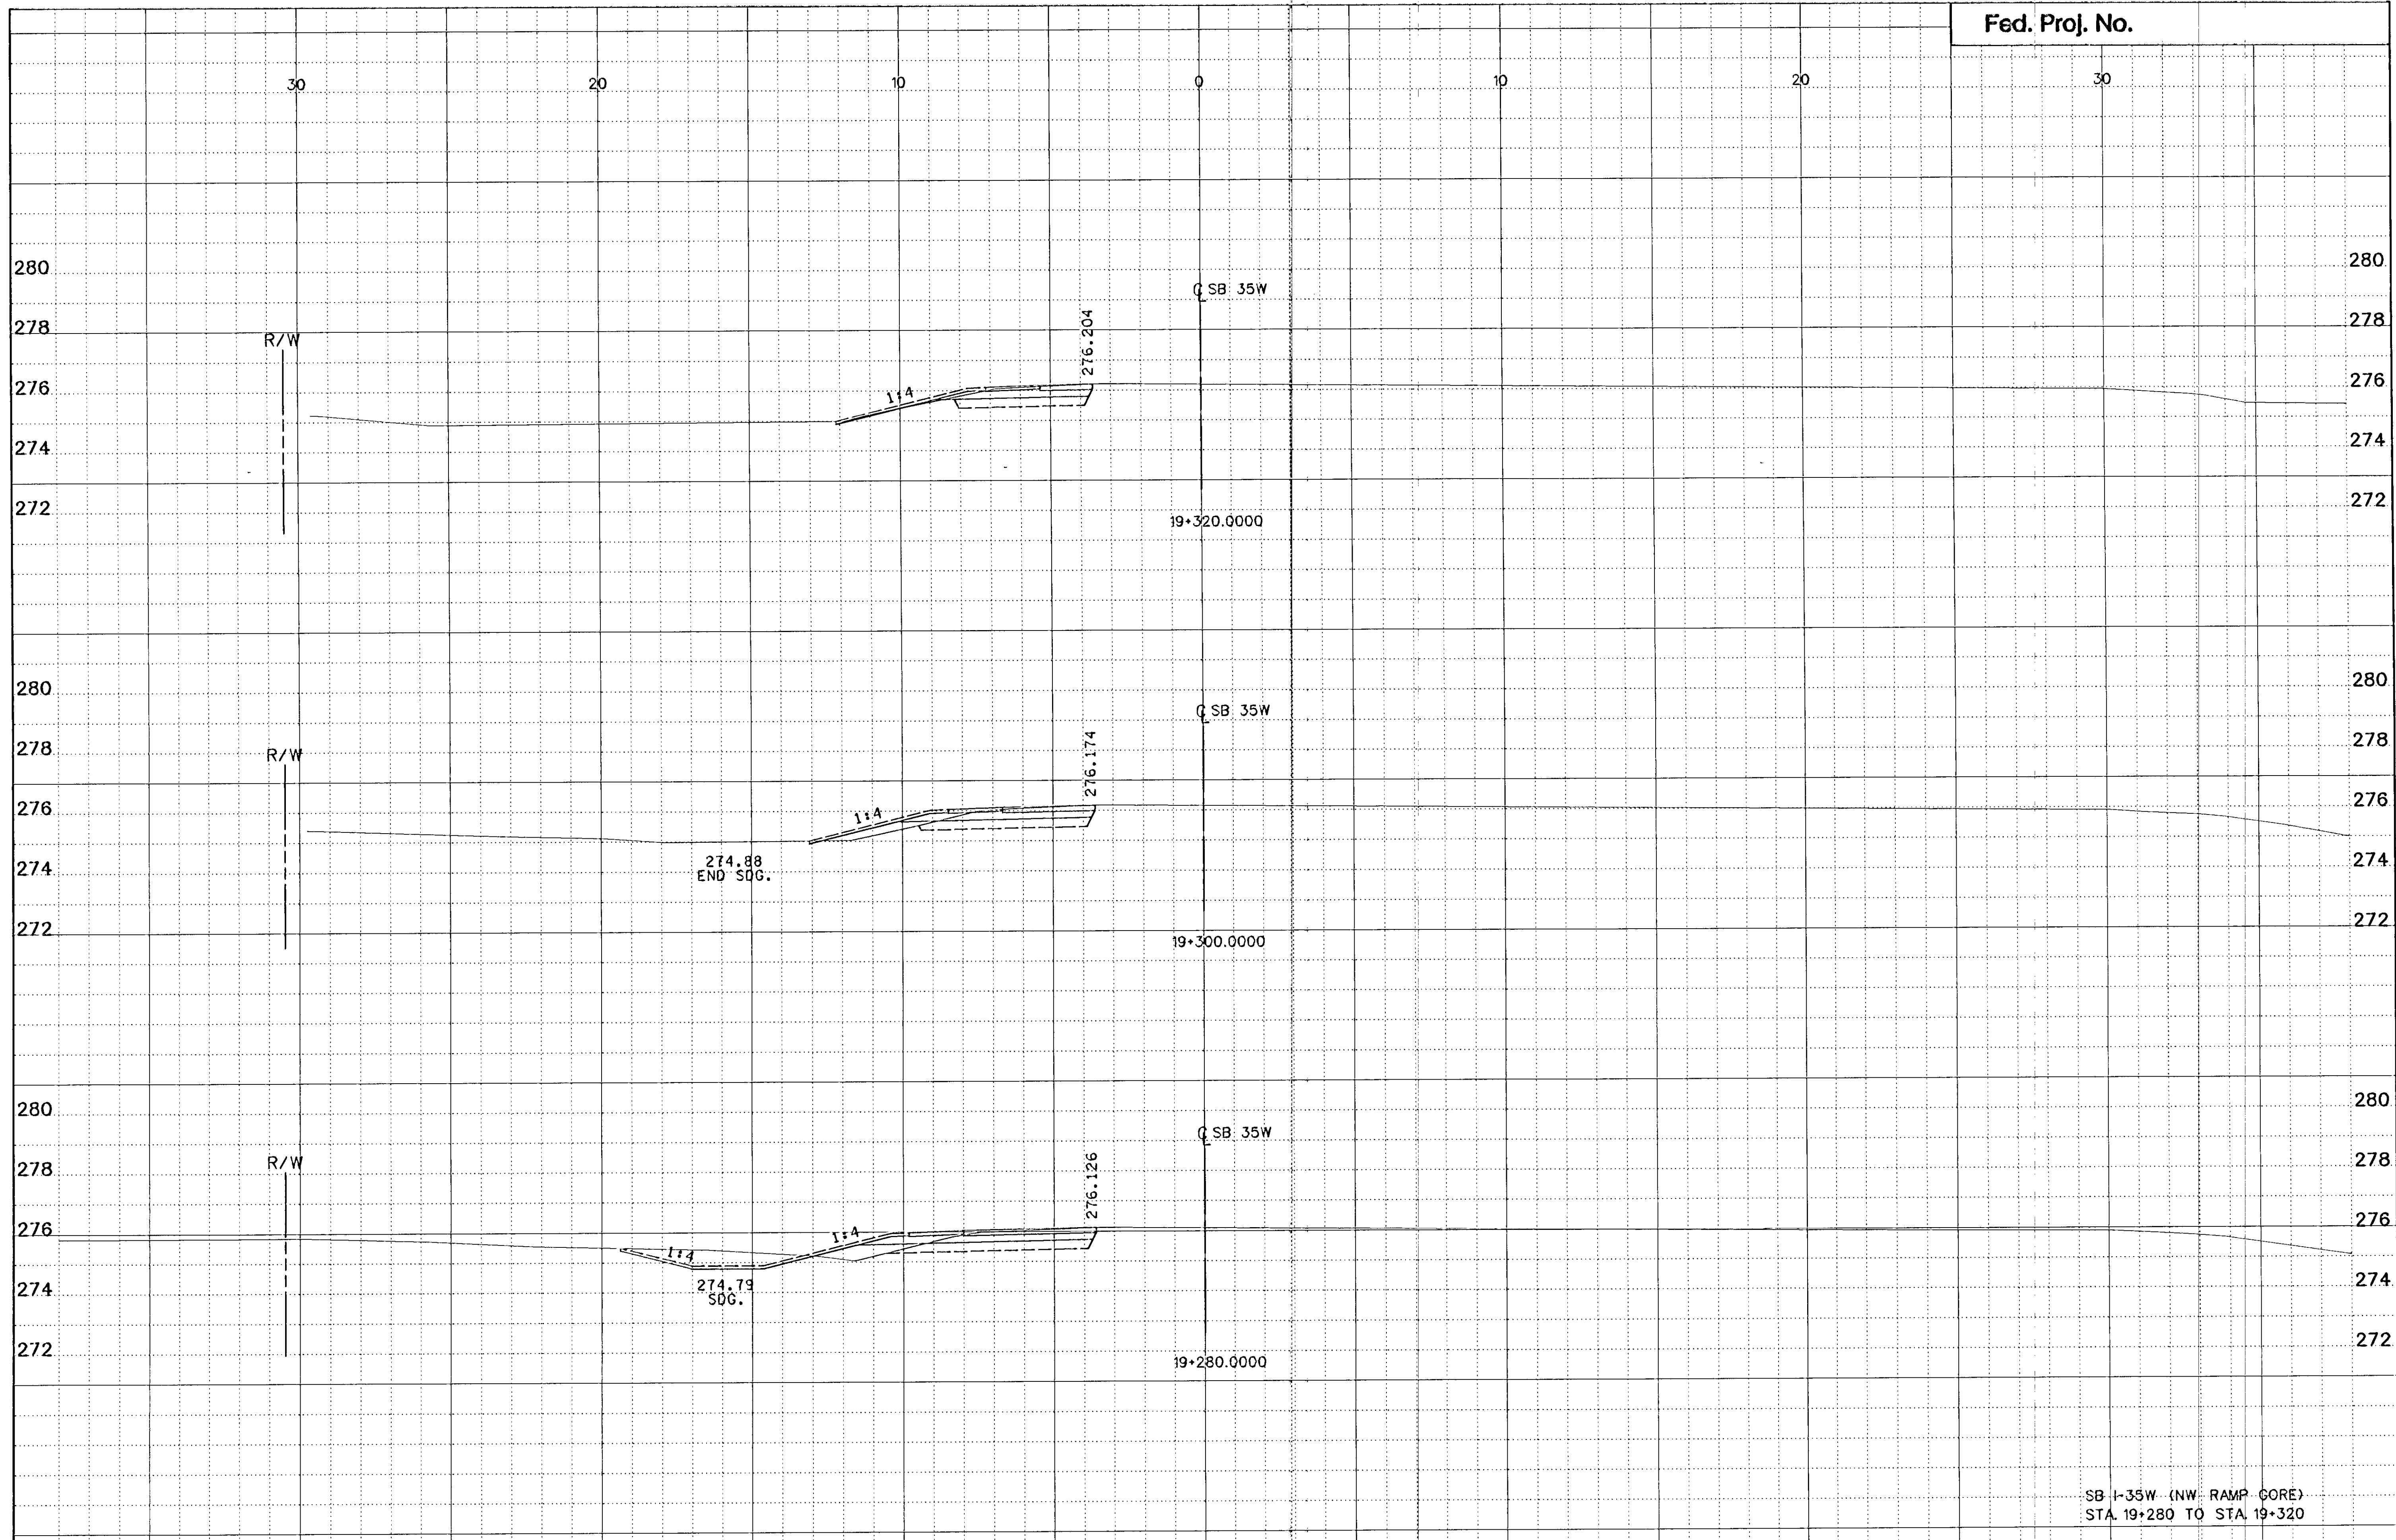

SB I-35W (NW RAMP CORE)
STA. 19+280 TO STA. 19+320

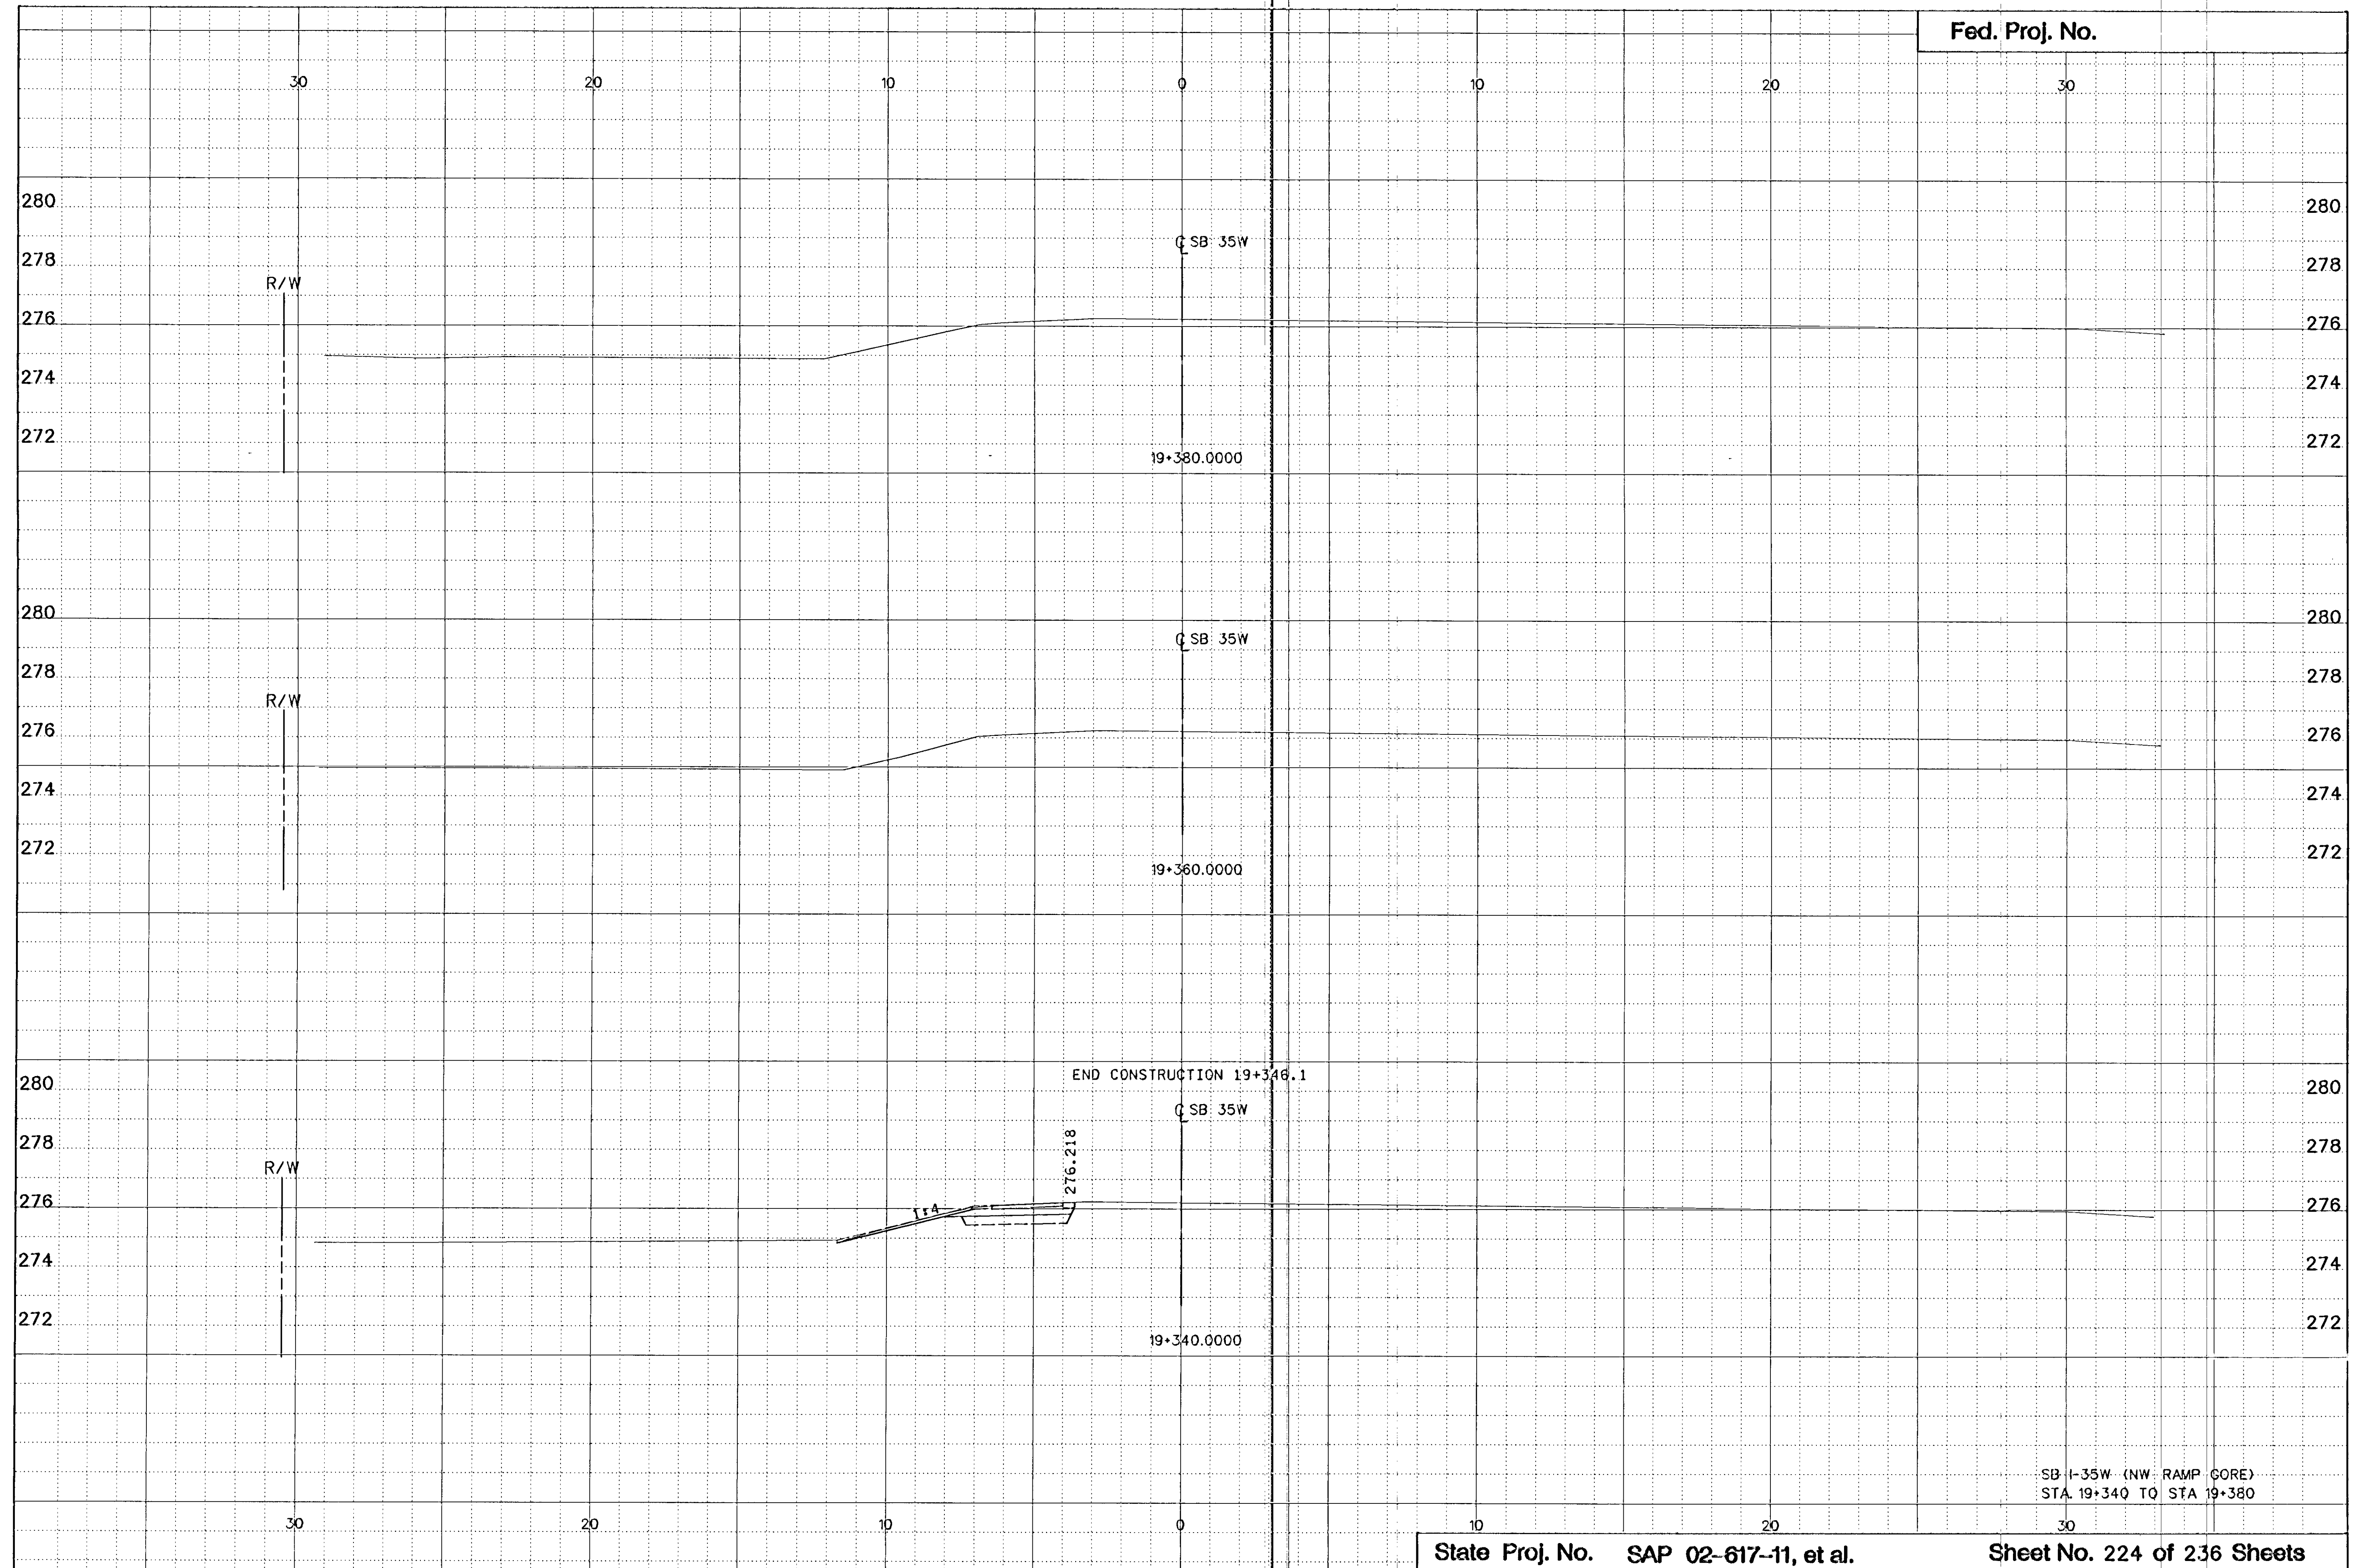

SB-1-35W (NW RAMP CORE)
STA. 19+340 TO STA 19+380

280 STA. 5+040.0 280

278 N.W. RAMP 275.353 (EXISTING) R/W 278

276 1:4 1:4 1:4 276

274 274.53 SDG 275.920 274.32 SDG 274

280 STA. 5+020.0 280

278 N.W. RAMP 275.417 (EXISTING) R/W 278

276 1:4 1:4 1:4 276

274 275.6 SDG 275.822 274.34 SDG 274


280 STA. 5+000.0 280

278 N.W. RAMP 275.448 (EXISTING) R/W 278




276 1:4 1:4 1:4 276

274 275.832 274.36 SDG 274


N.W. RAMP
STA. 5+000.000 TO STA. 5+040.000

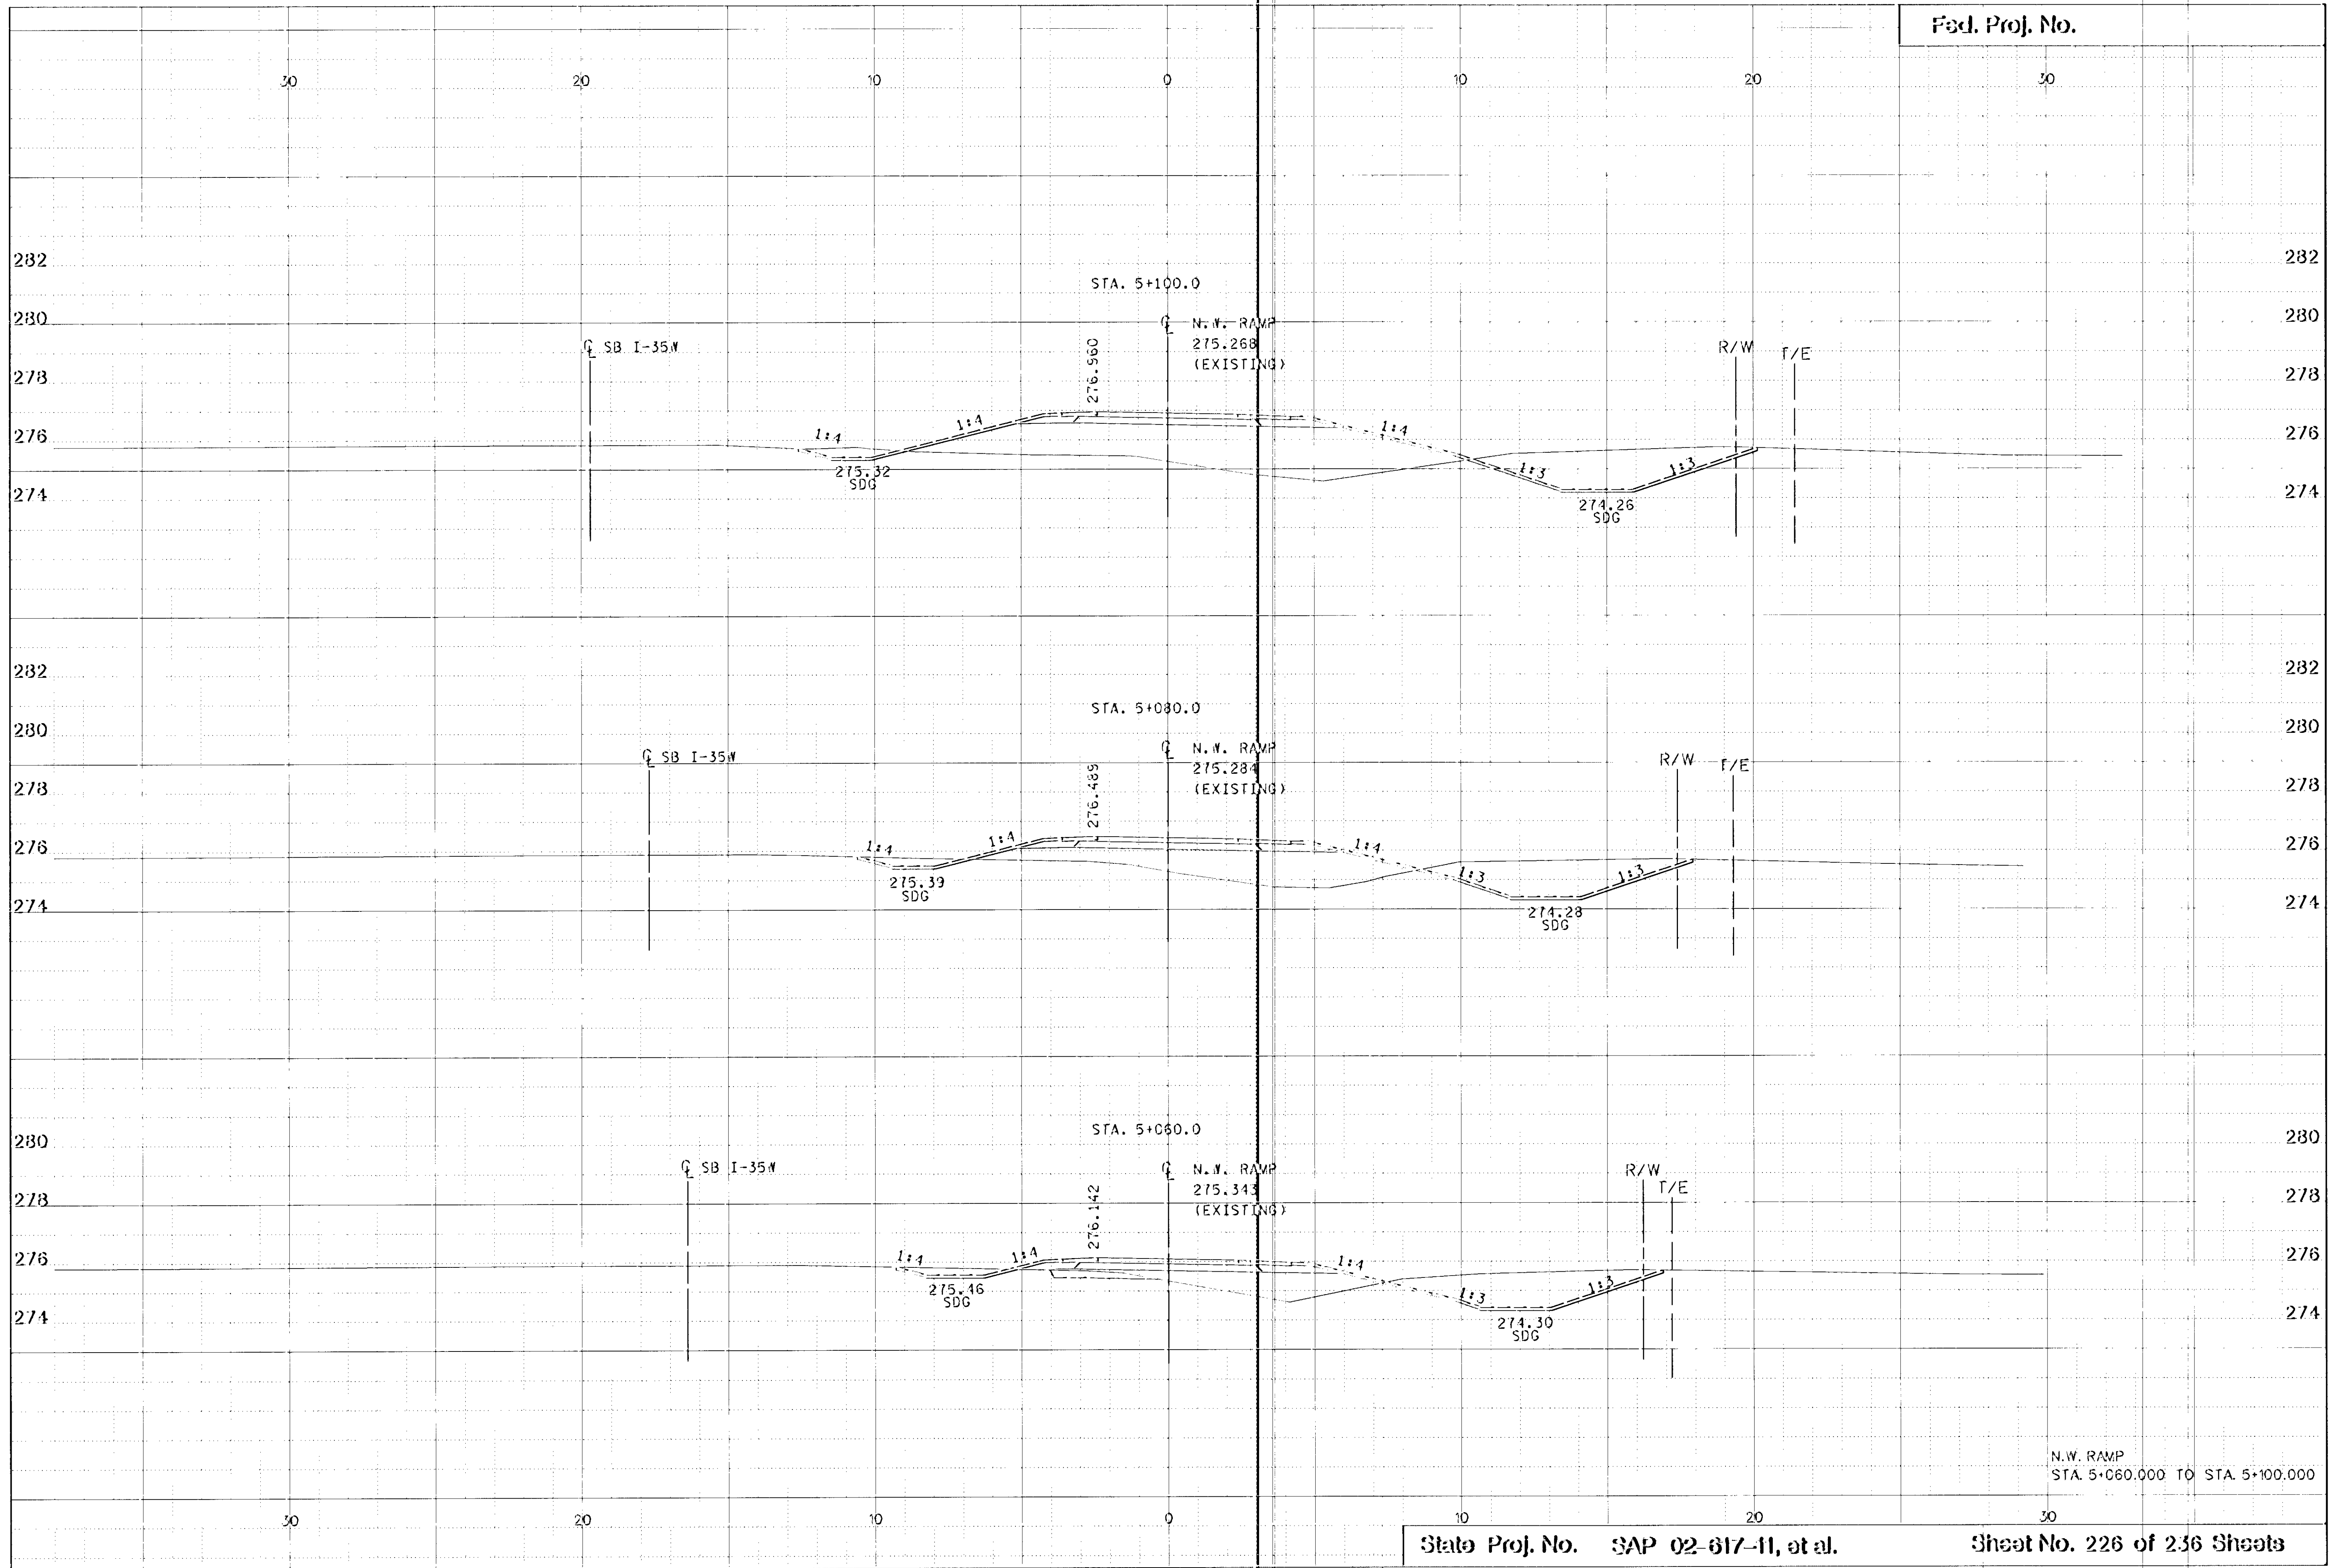


N.W. RAMP
STA. 5+060.000 TO STA. 5+100.000

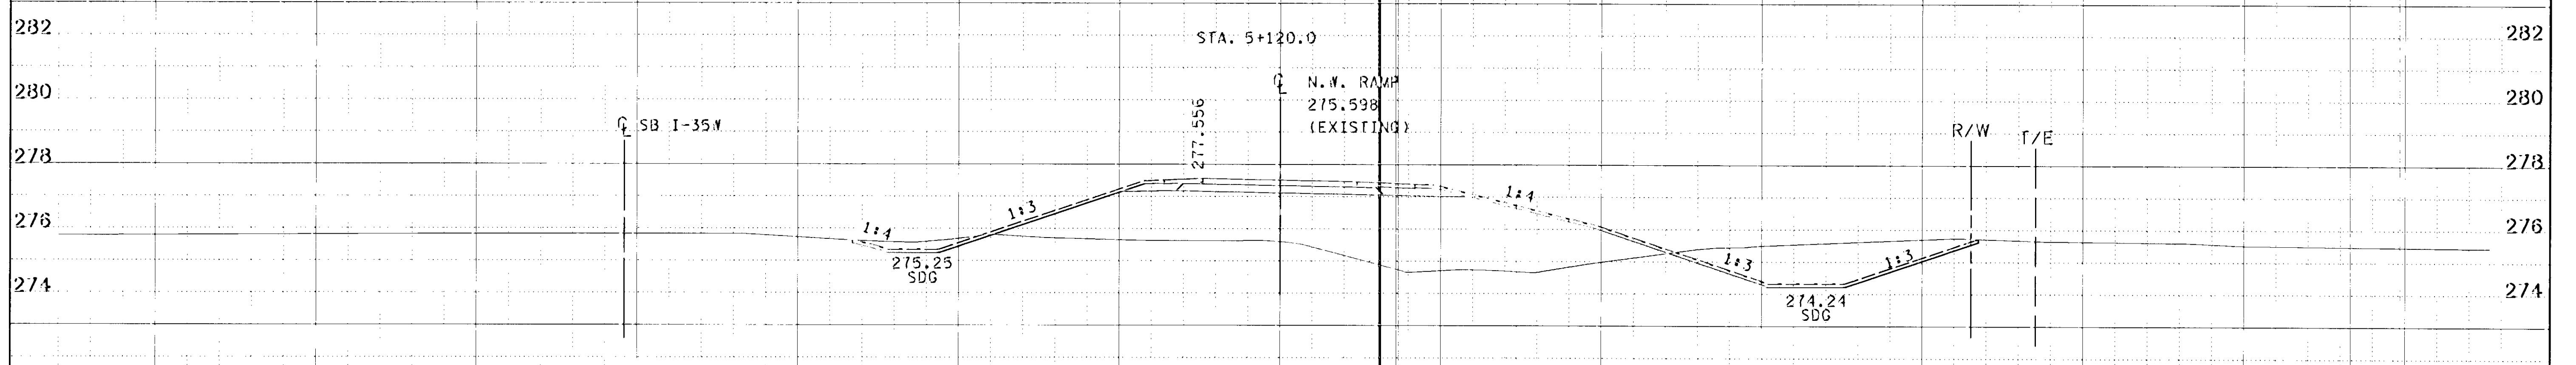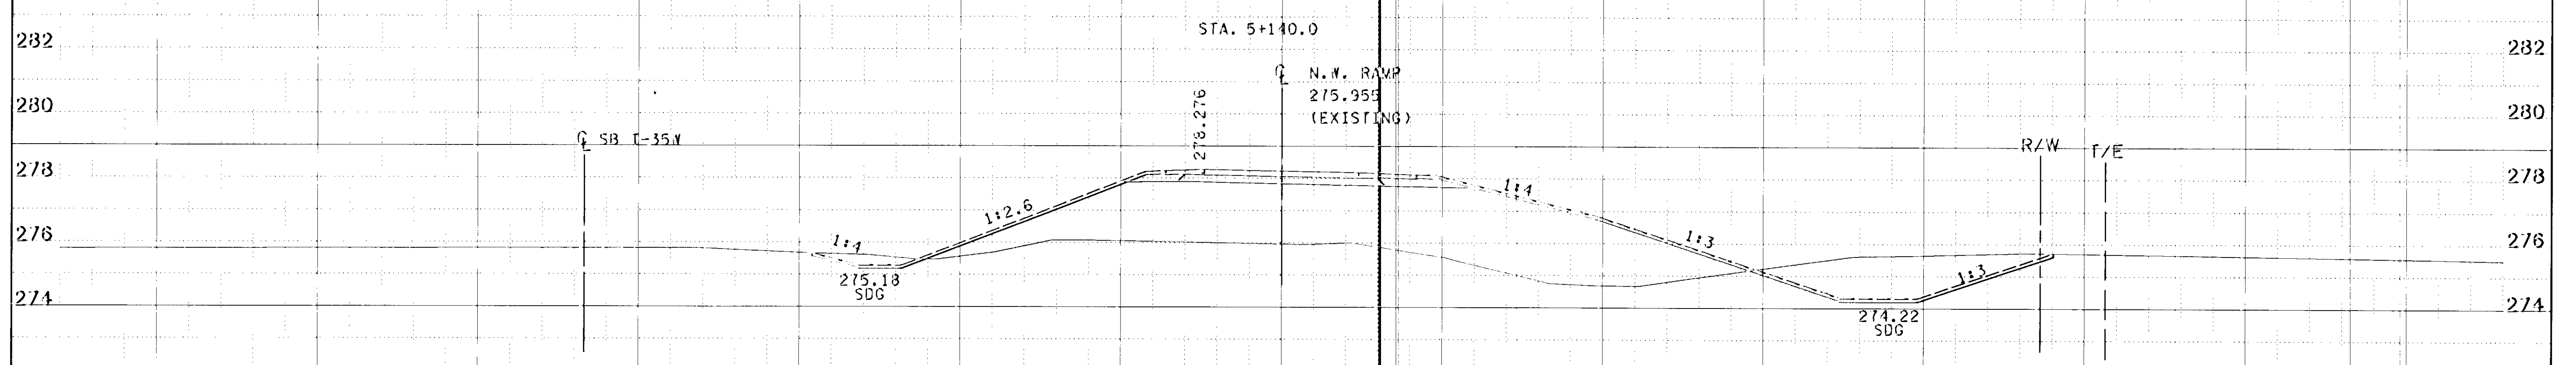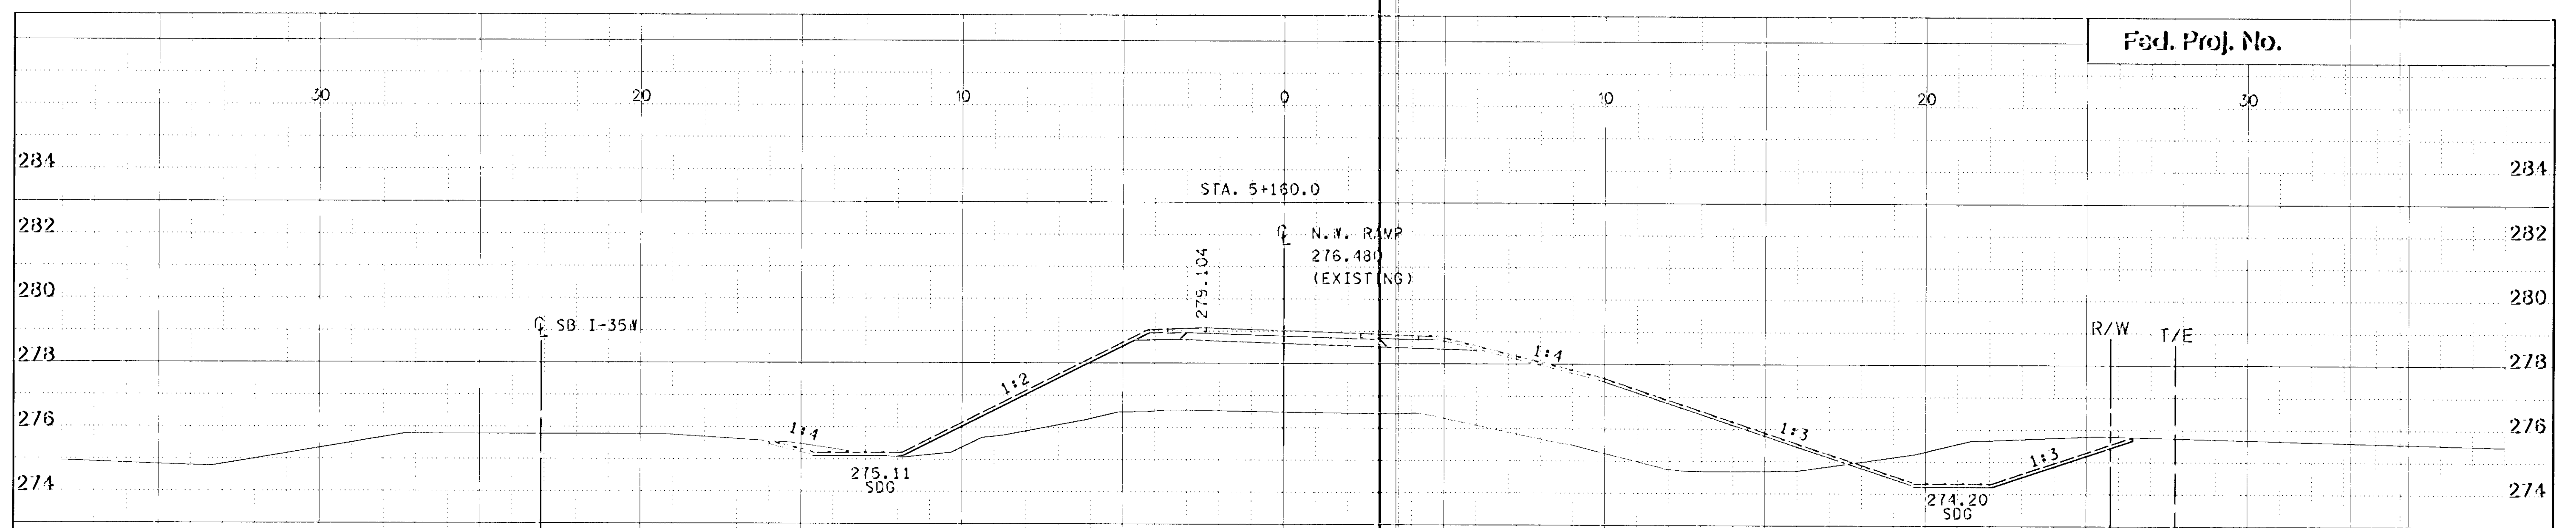


N.W. RAMP
STA. 5+120.000 TO STA. 5+160.000

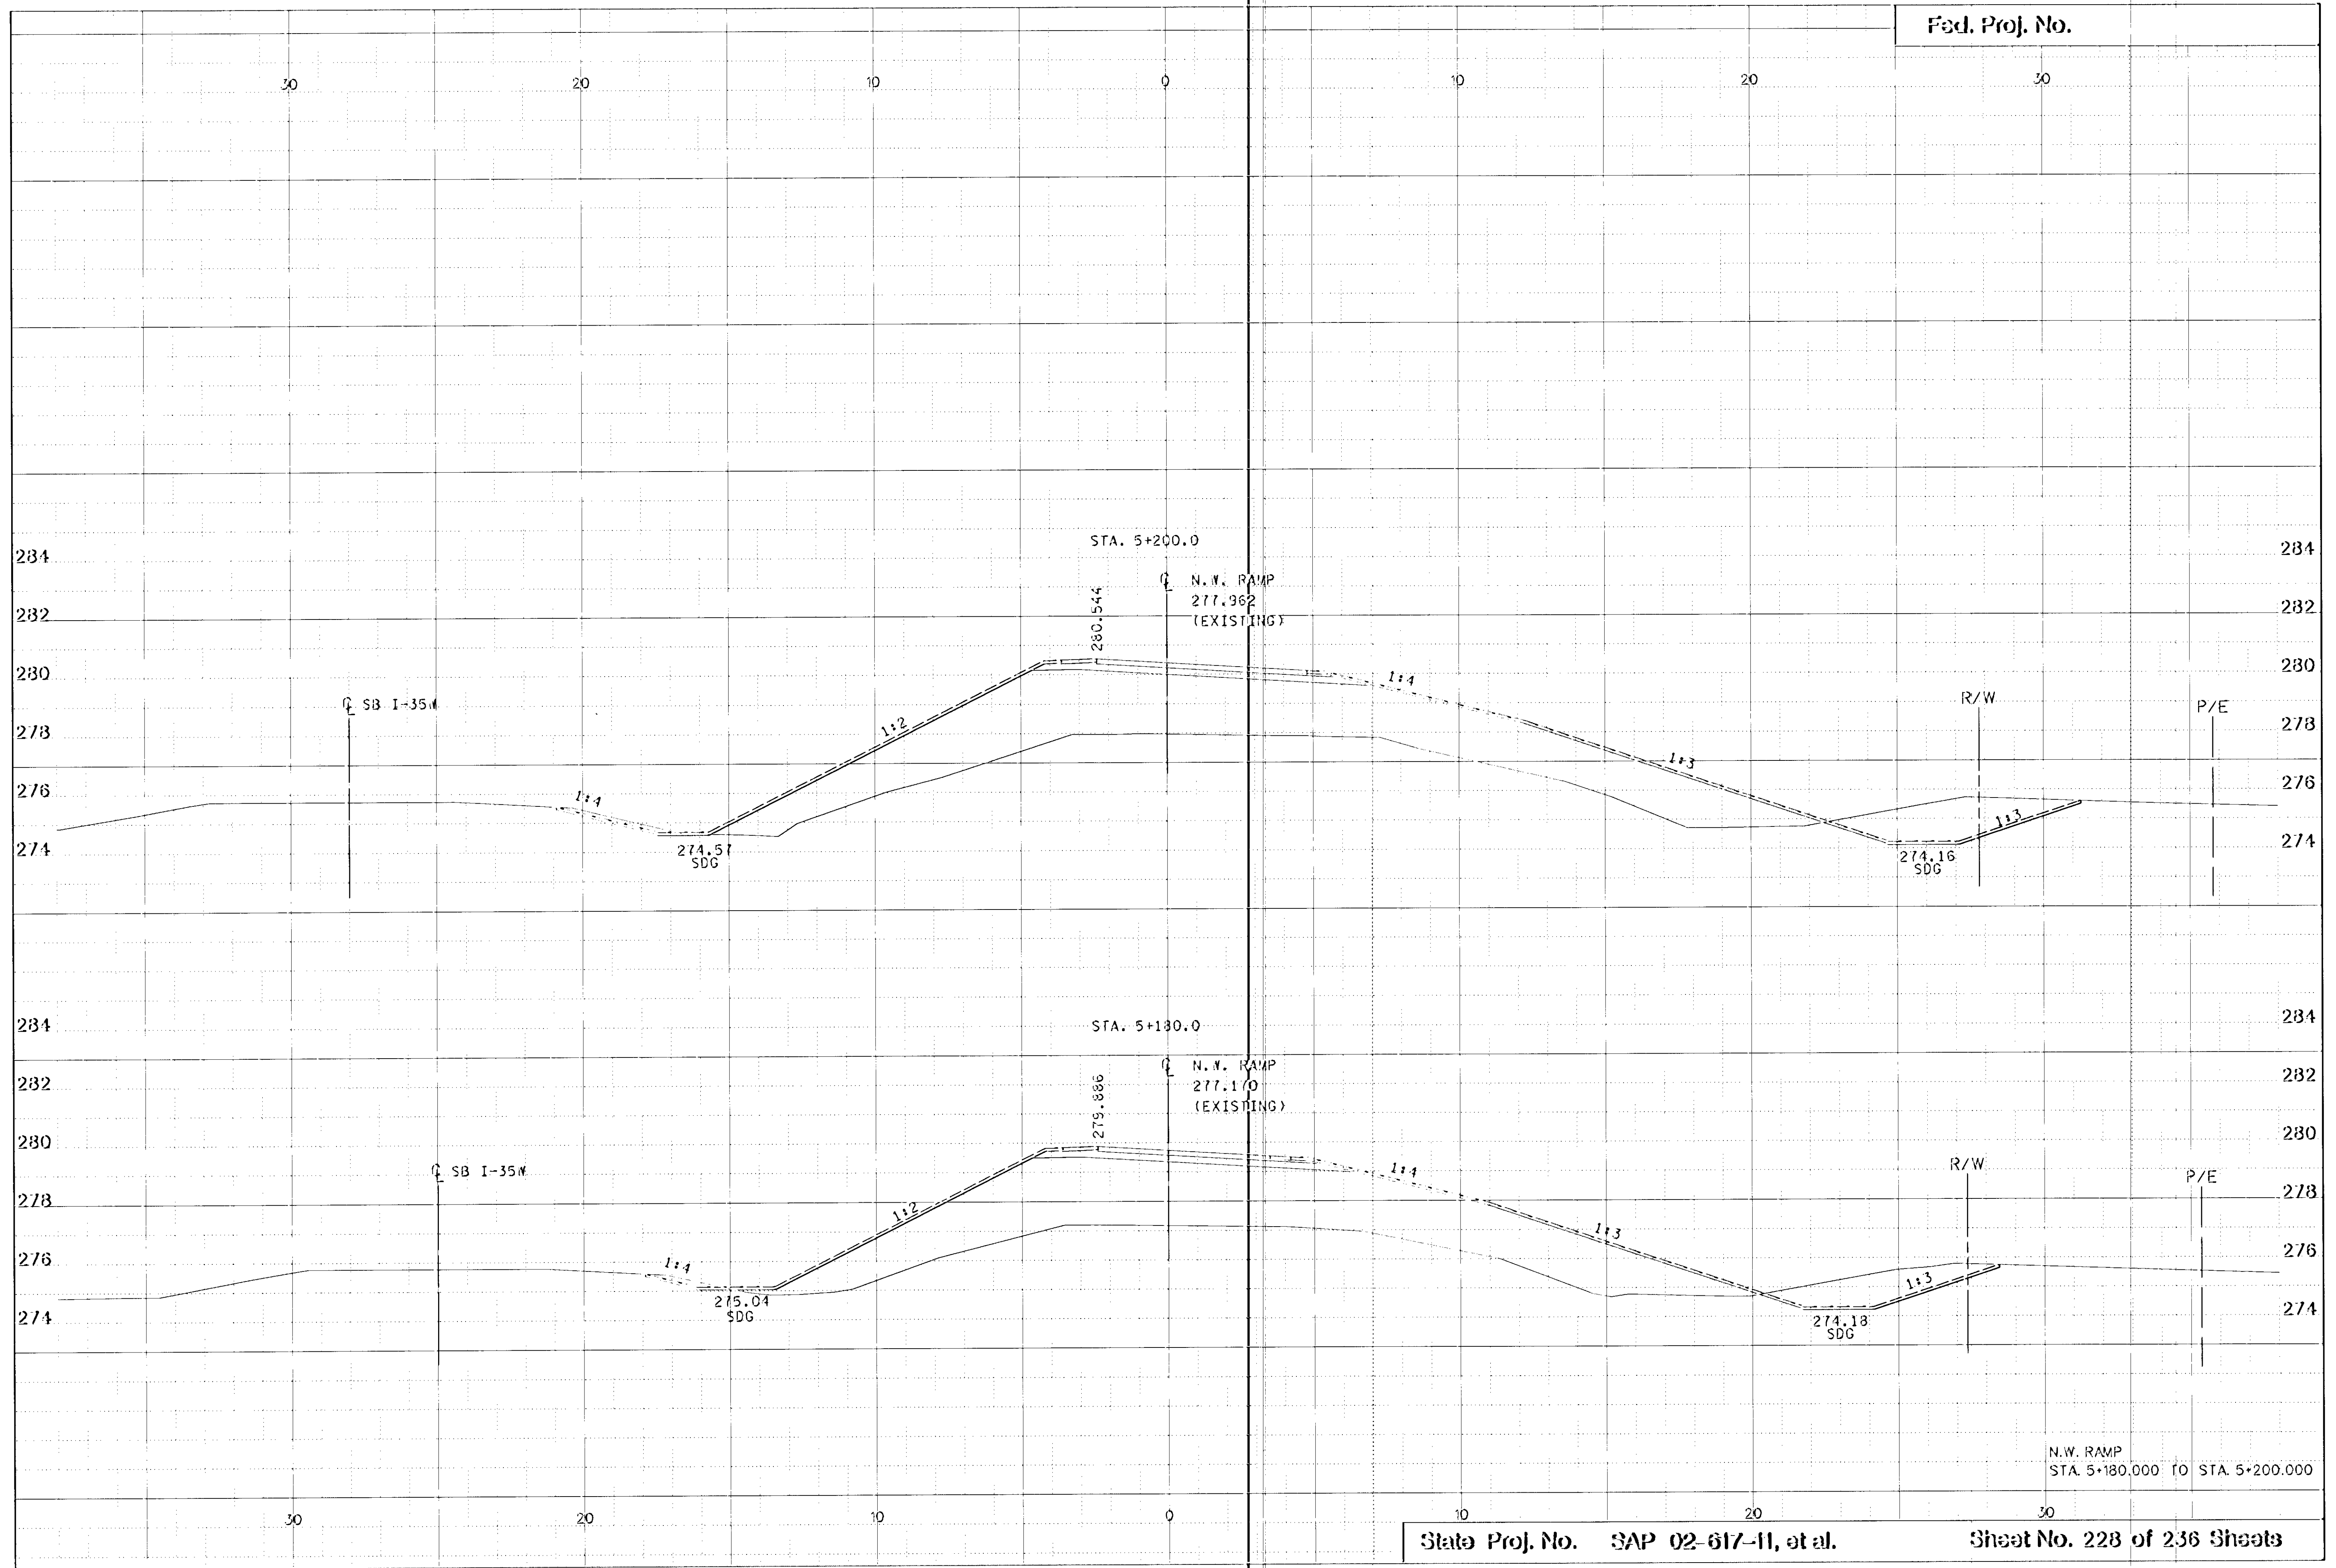

N.W. RAMP
STA. 5+180.000 TO STA. 5+200.000

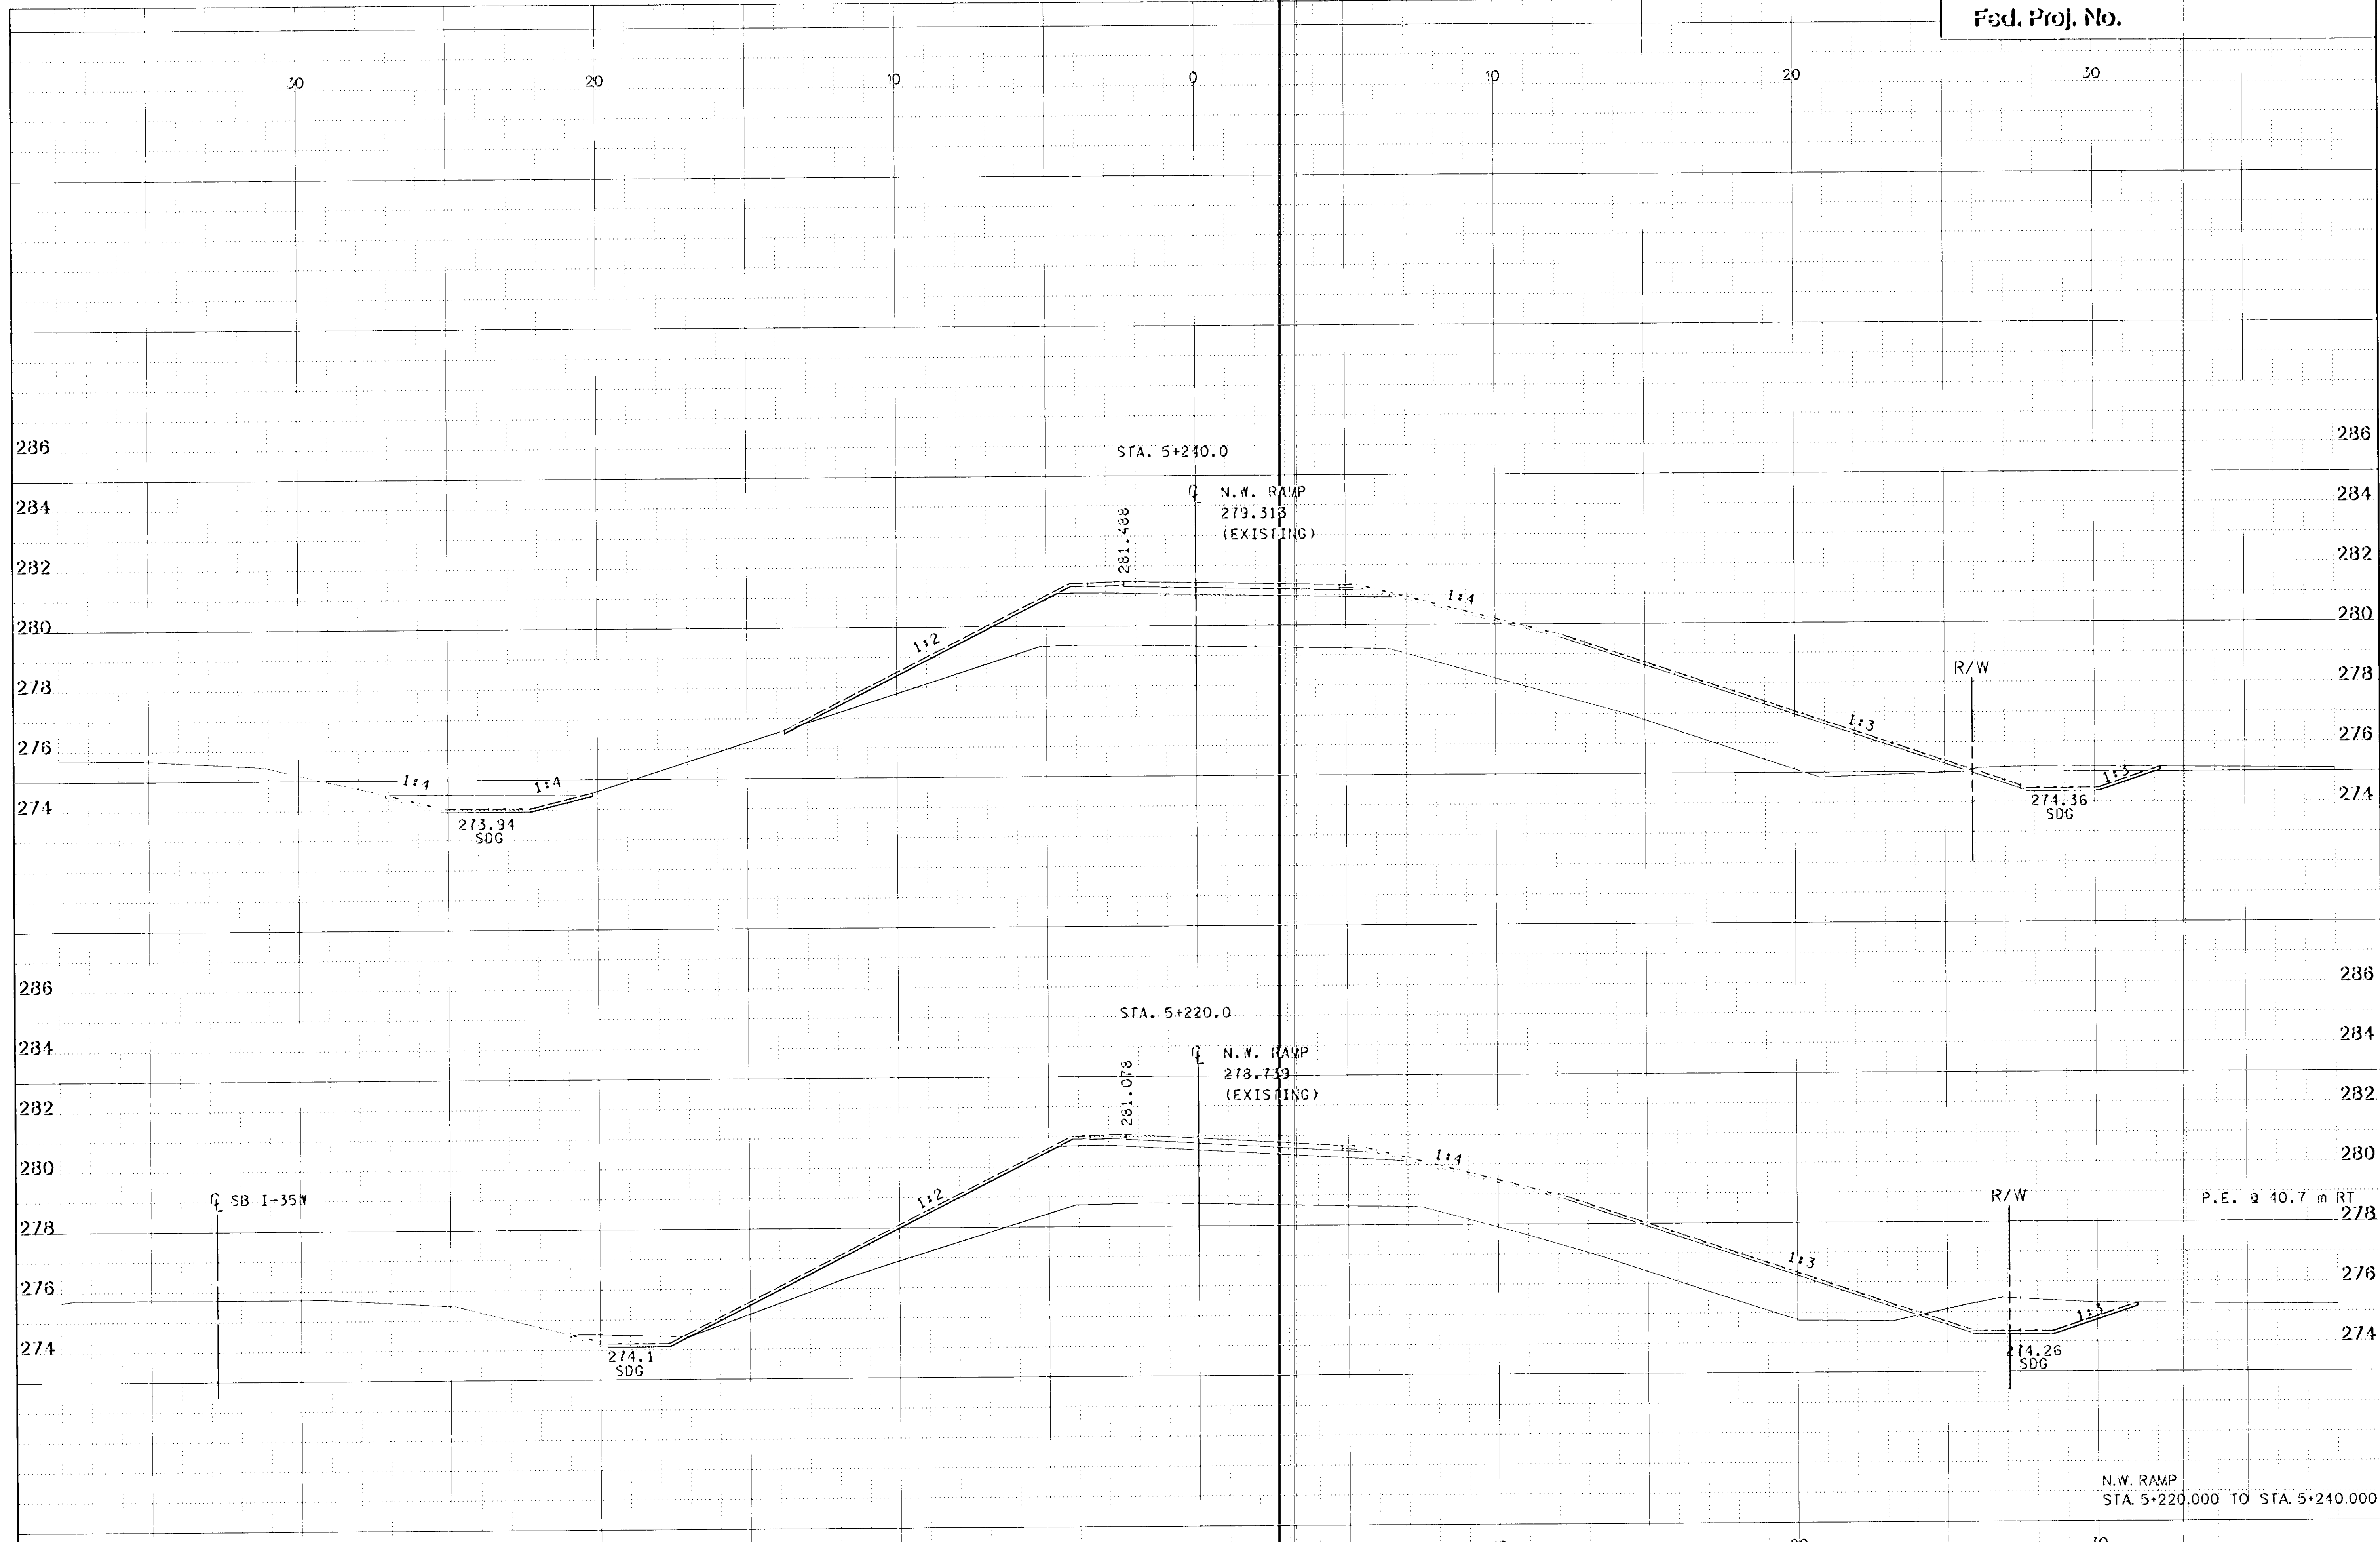

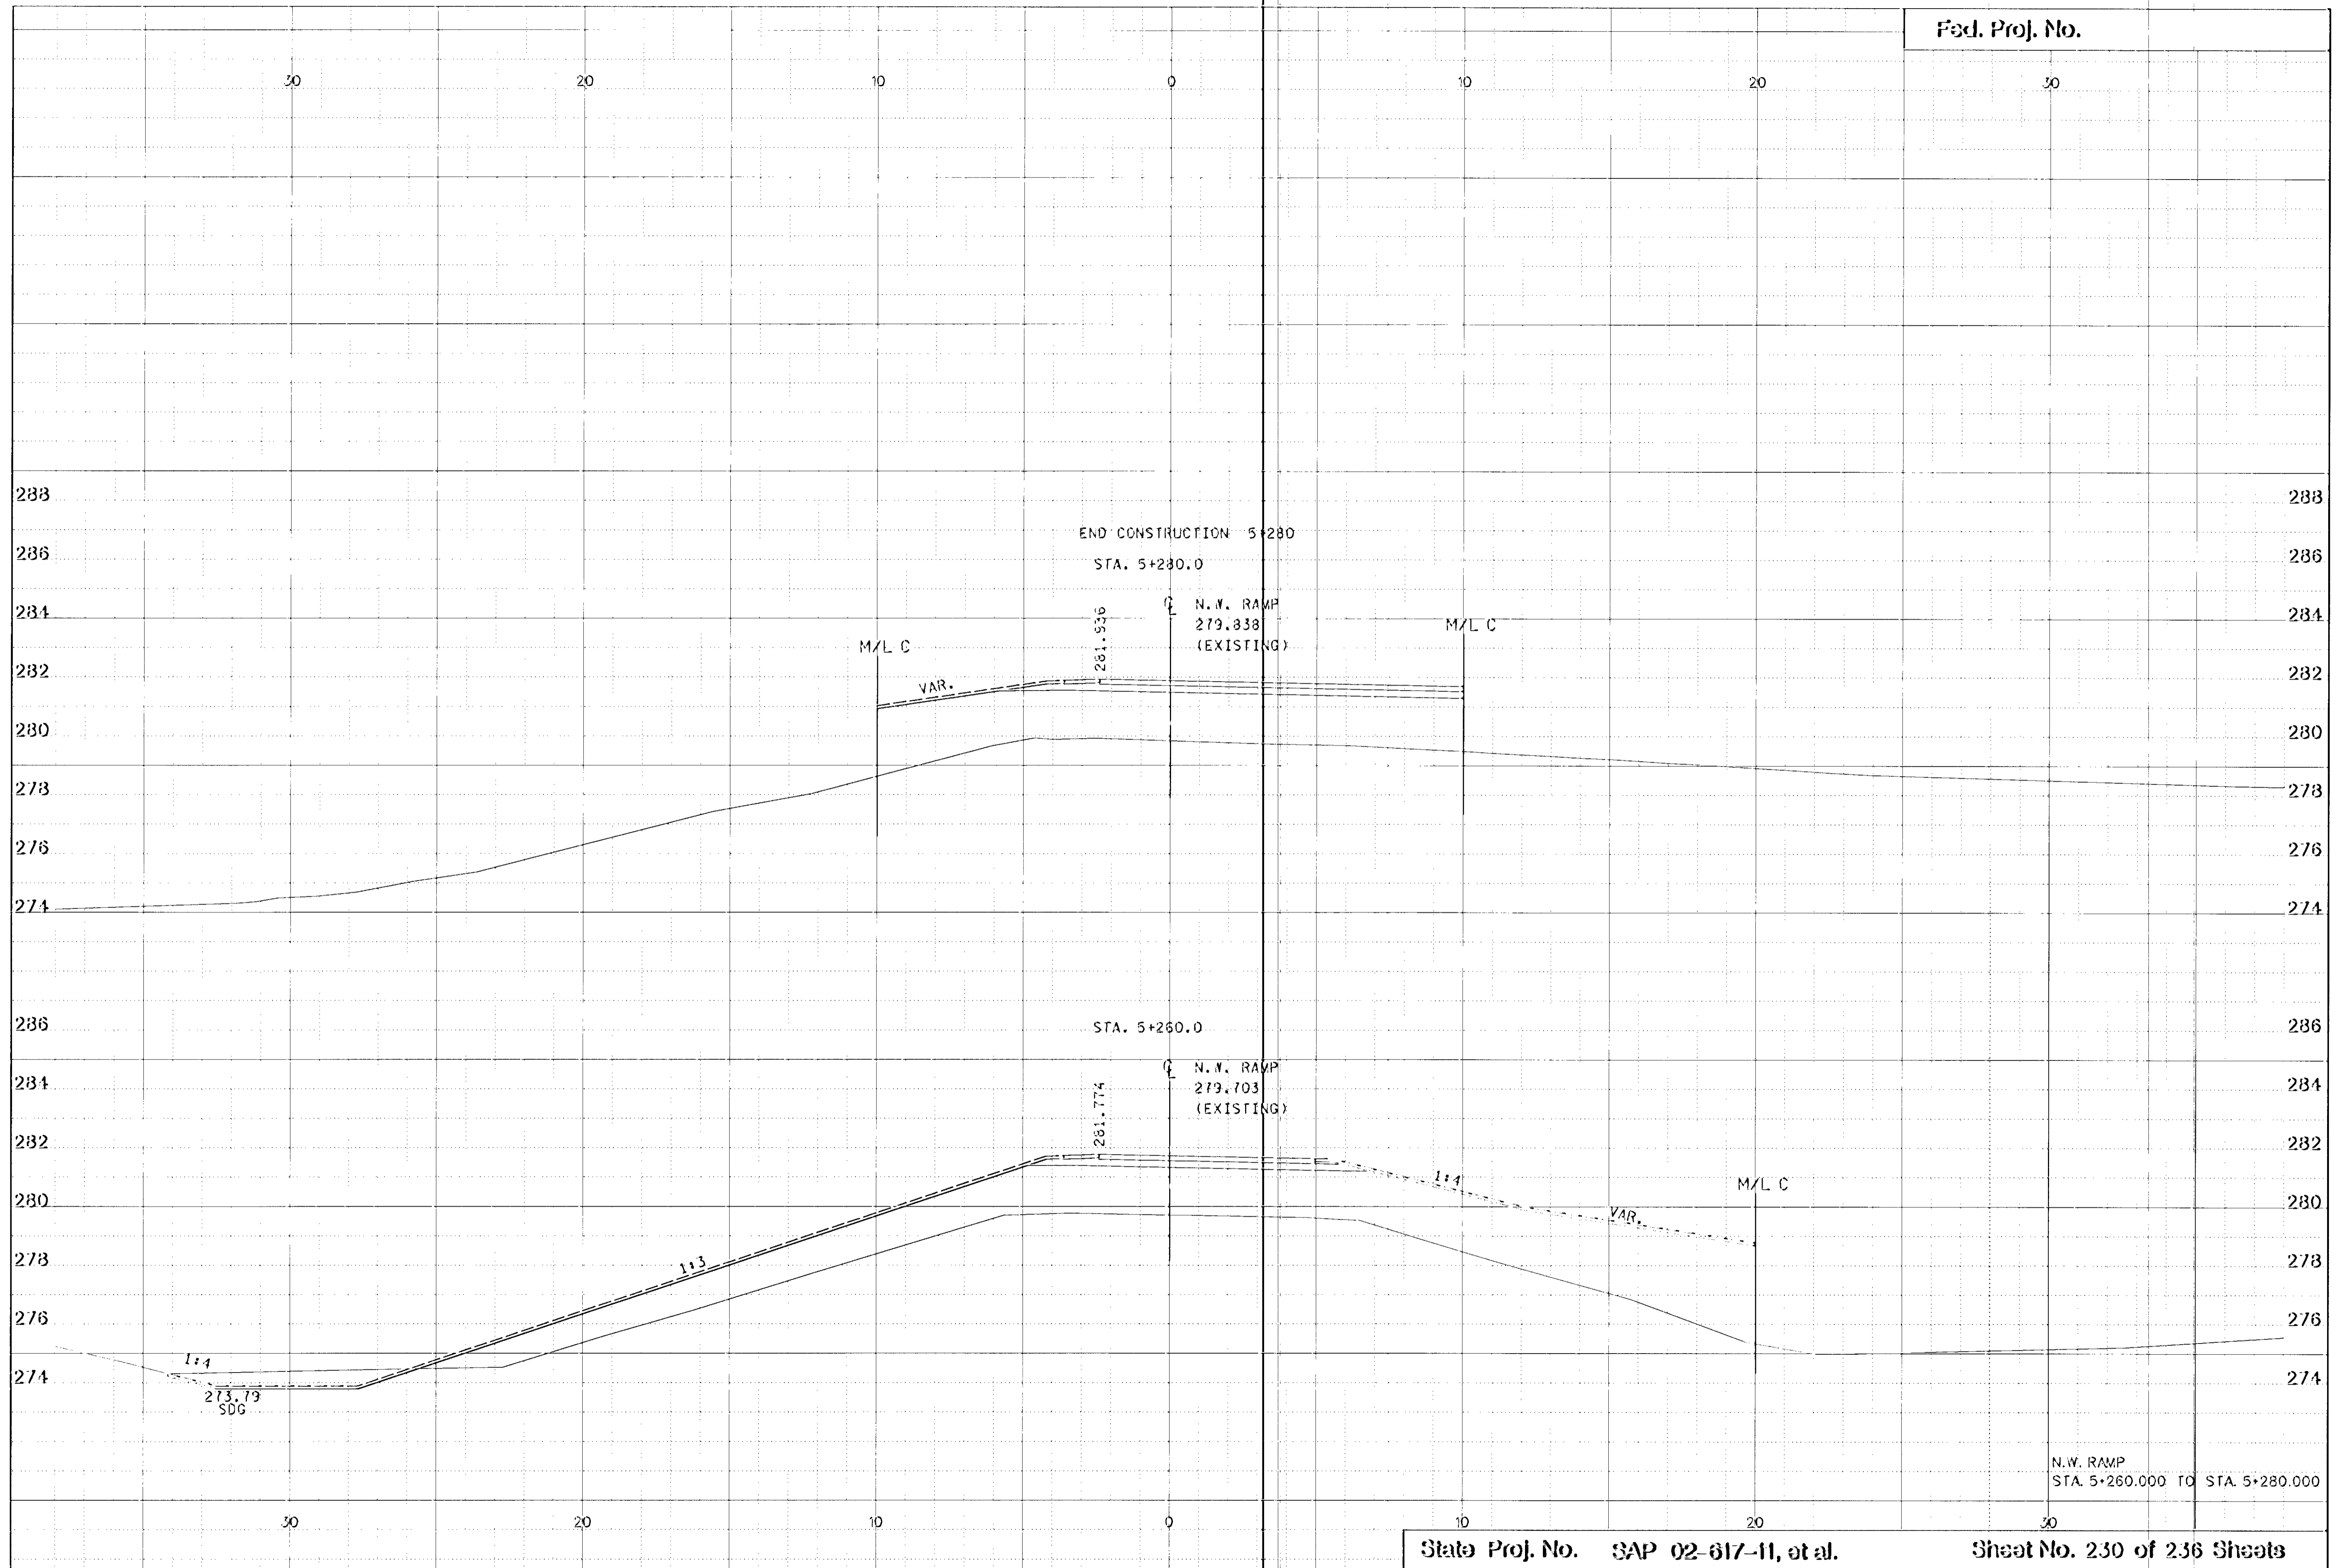

END CONSTRUCTION 5+280
STA. 5+280.0

N.W. RAMP
279.838
(EXISTING)

M/L C

M/L C

VAR.

281.536

STA. 5+260.0

N.W. RAMP
279.703
(EXISTING)

281.774

M/L C

1:3


1:4



VAR.

1:4


273.79
SDG

N.W. RAMP
STA. 5+260.000 TO STA. 5+280.000

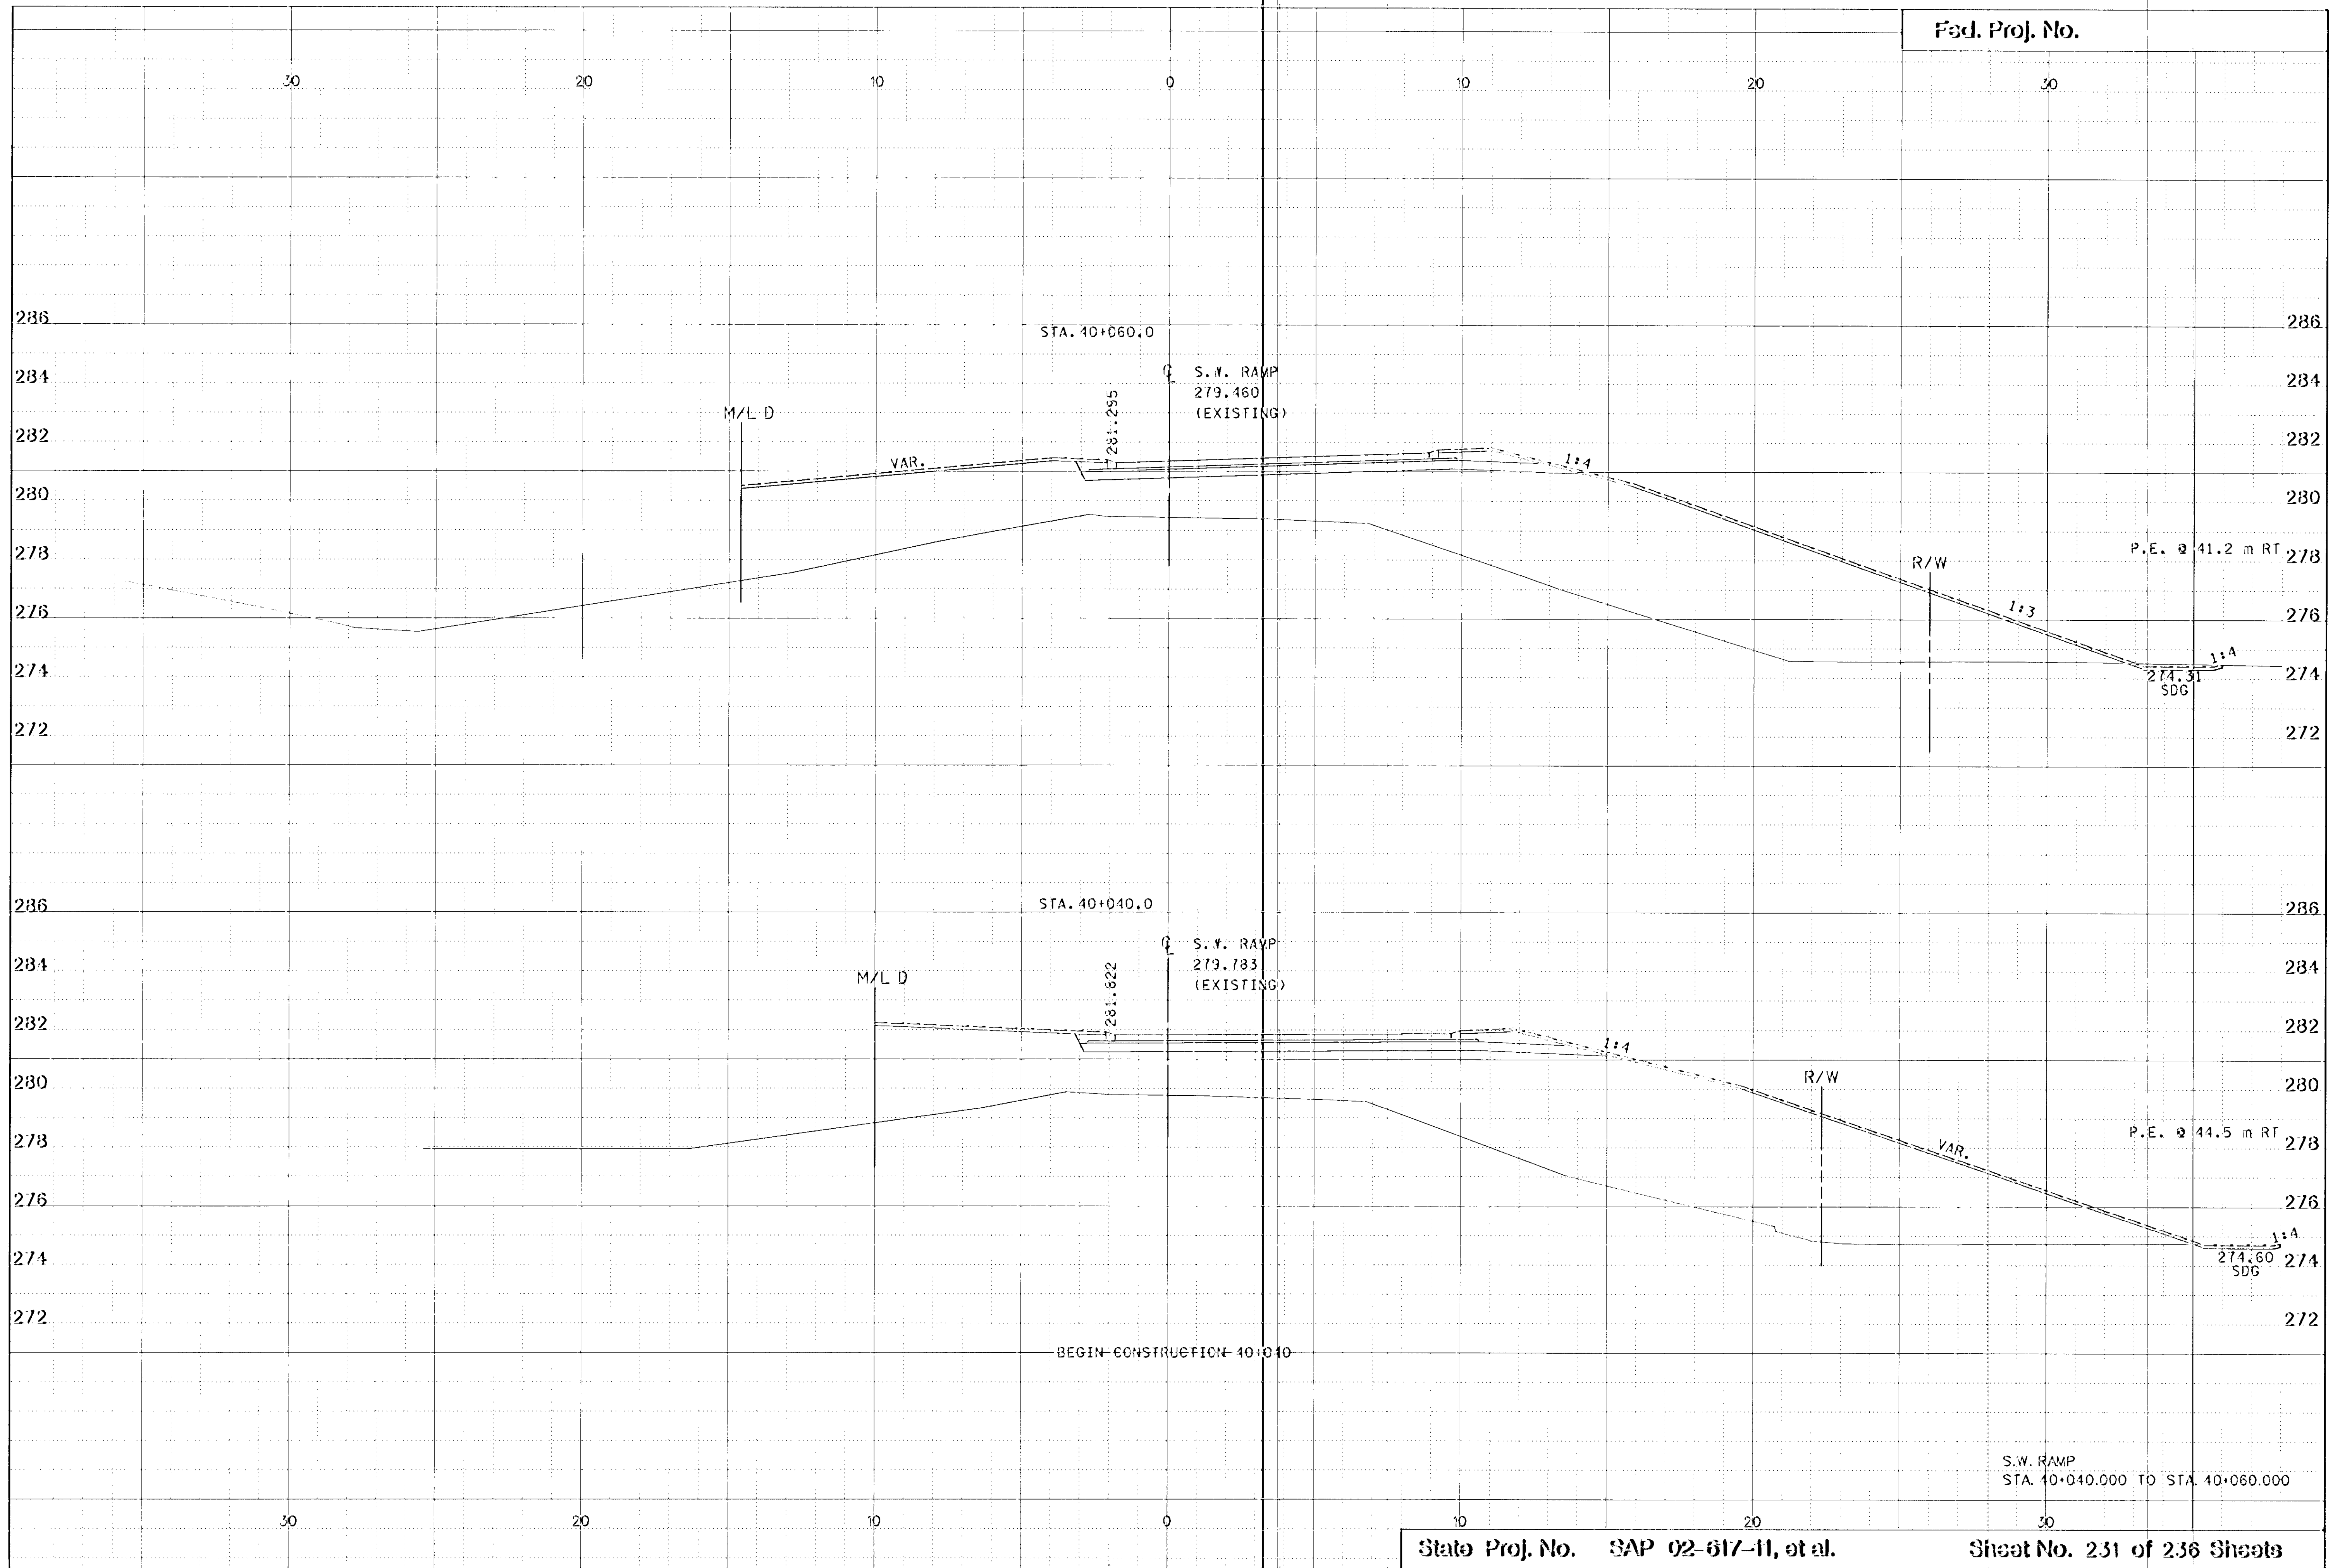

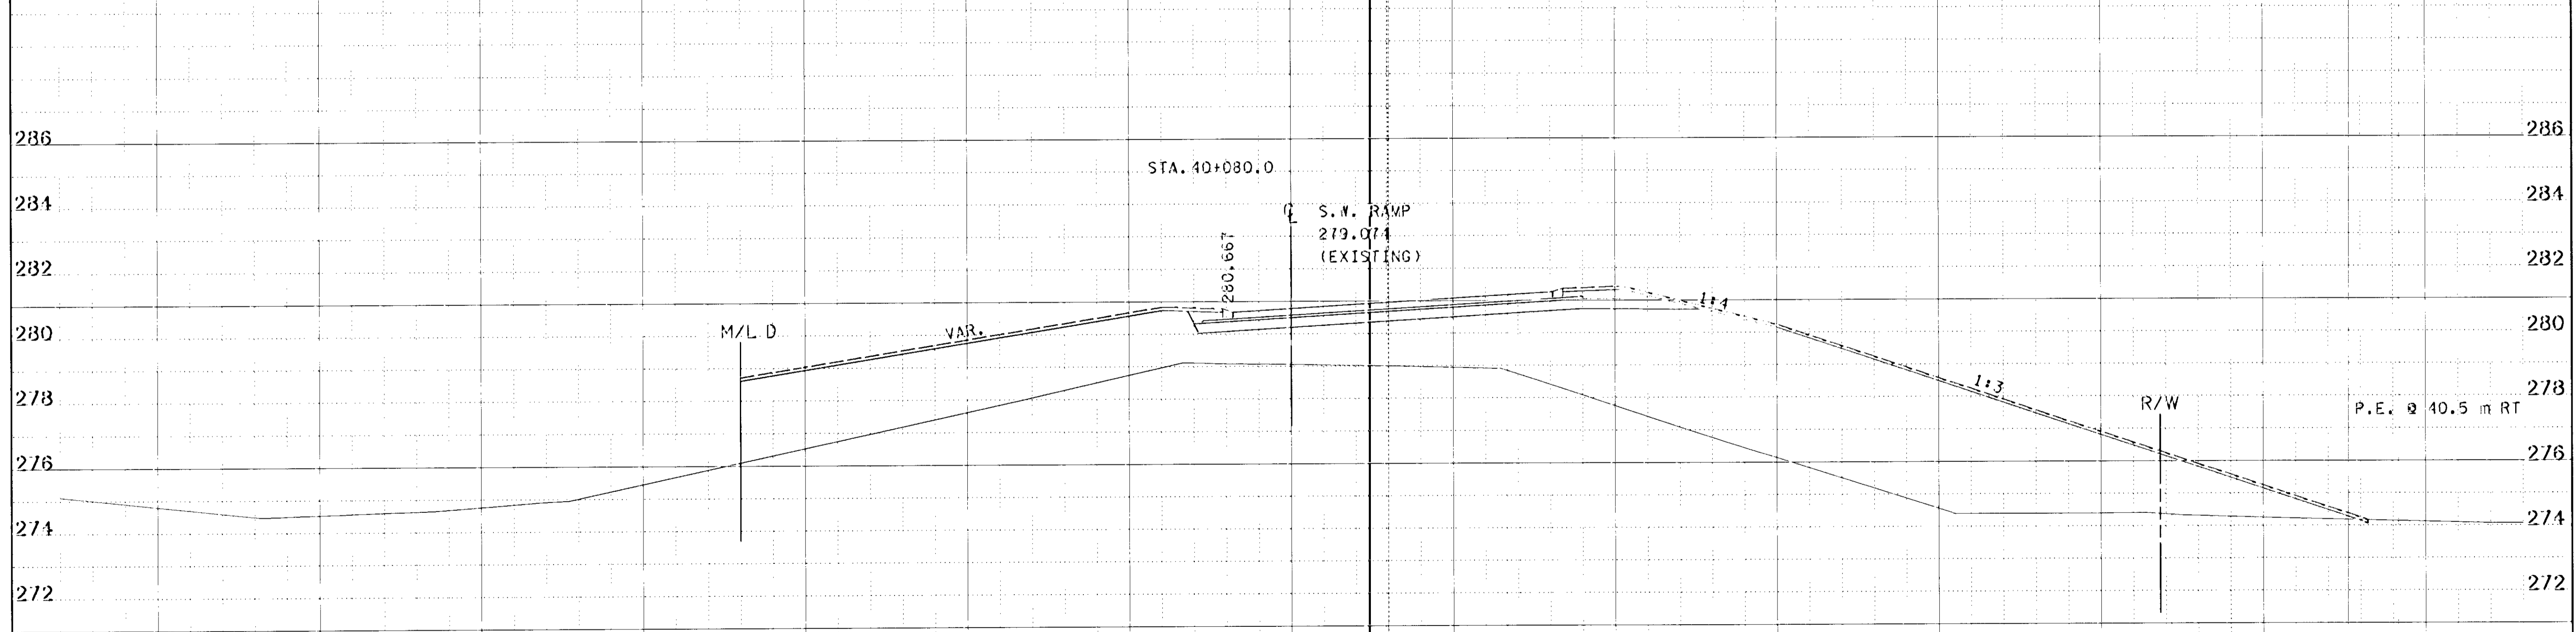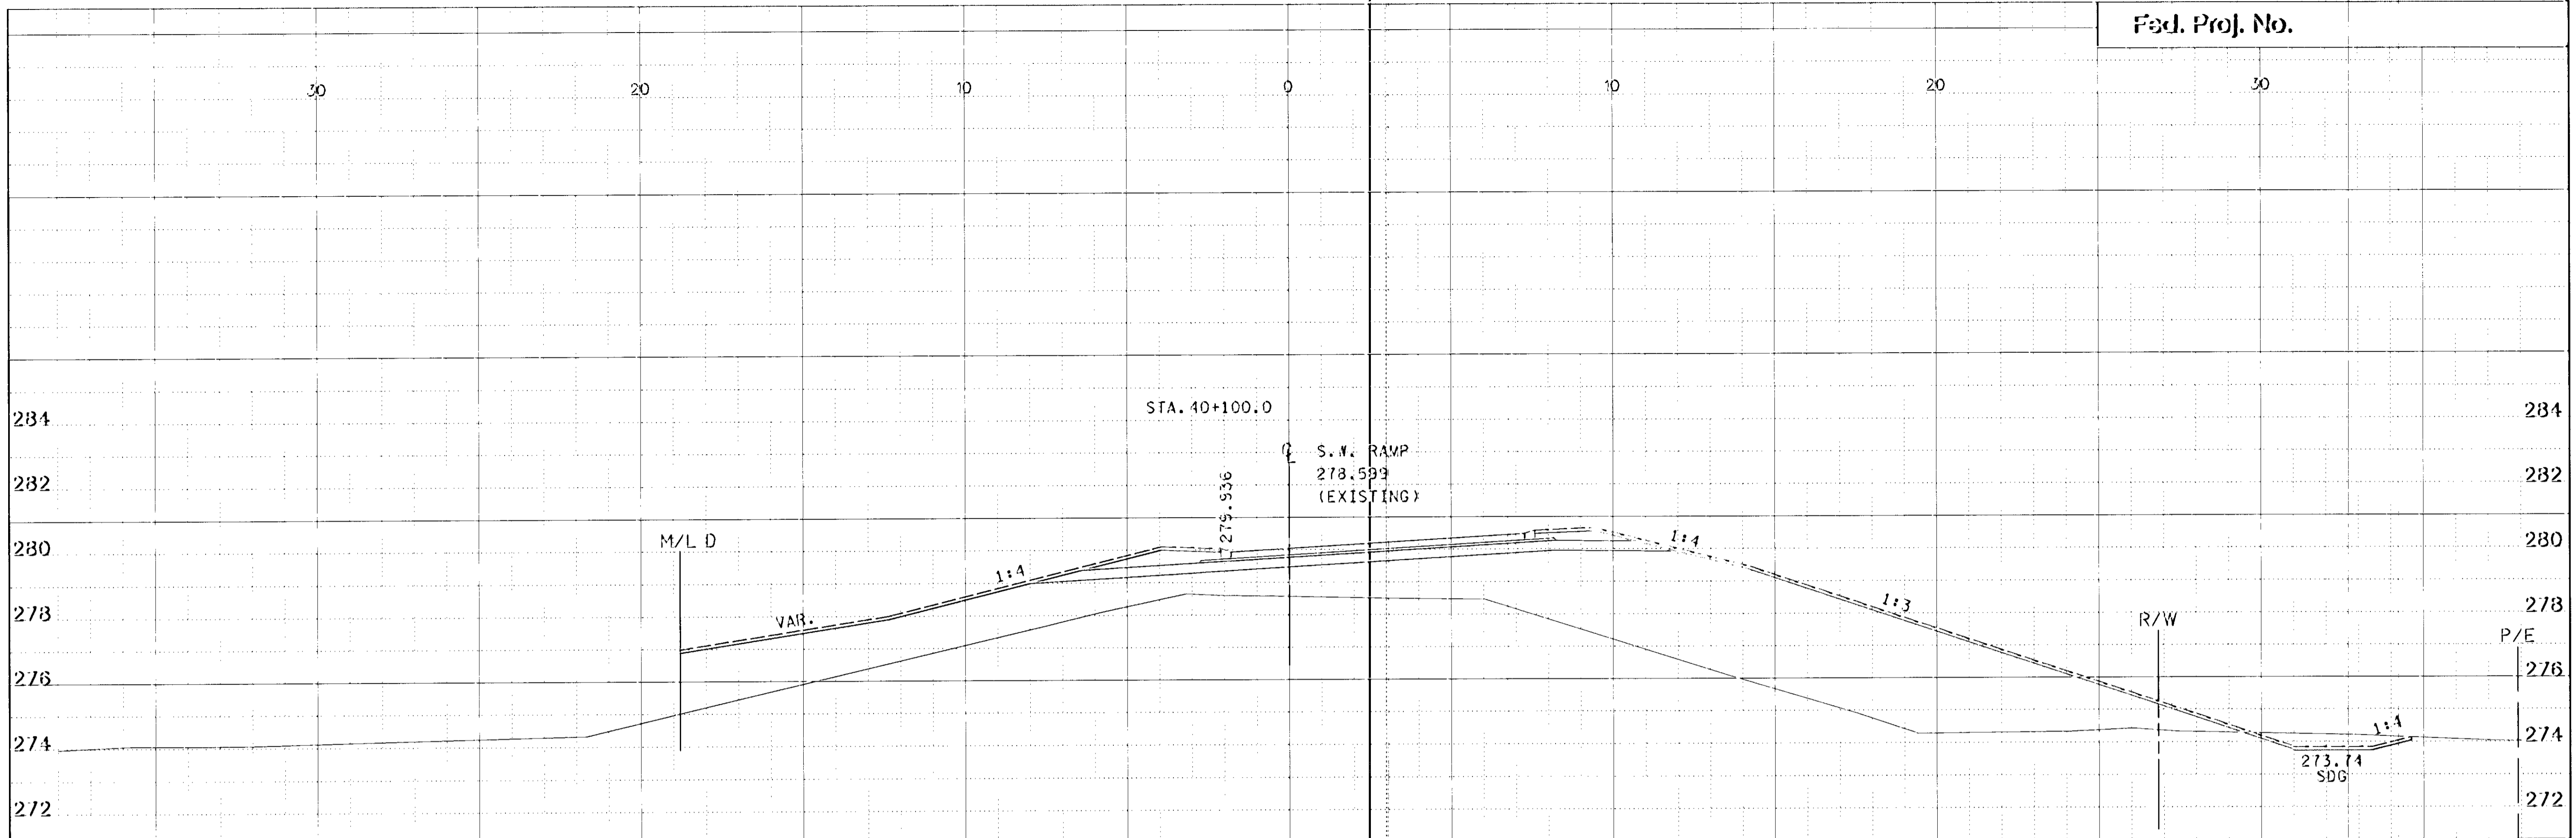

S.W. RAMP
STA. 40+080.000 TO STA. 40+100.000

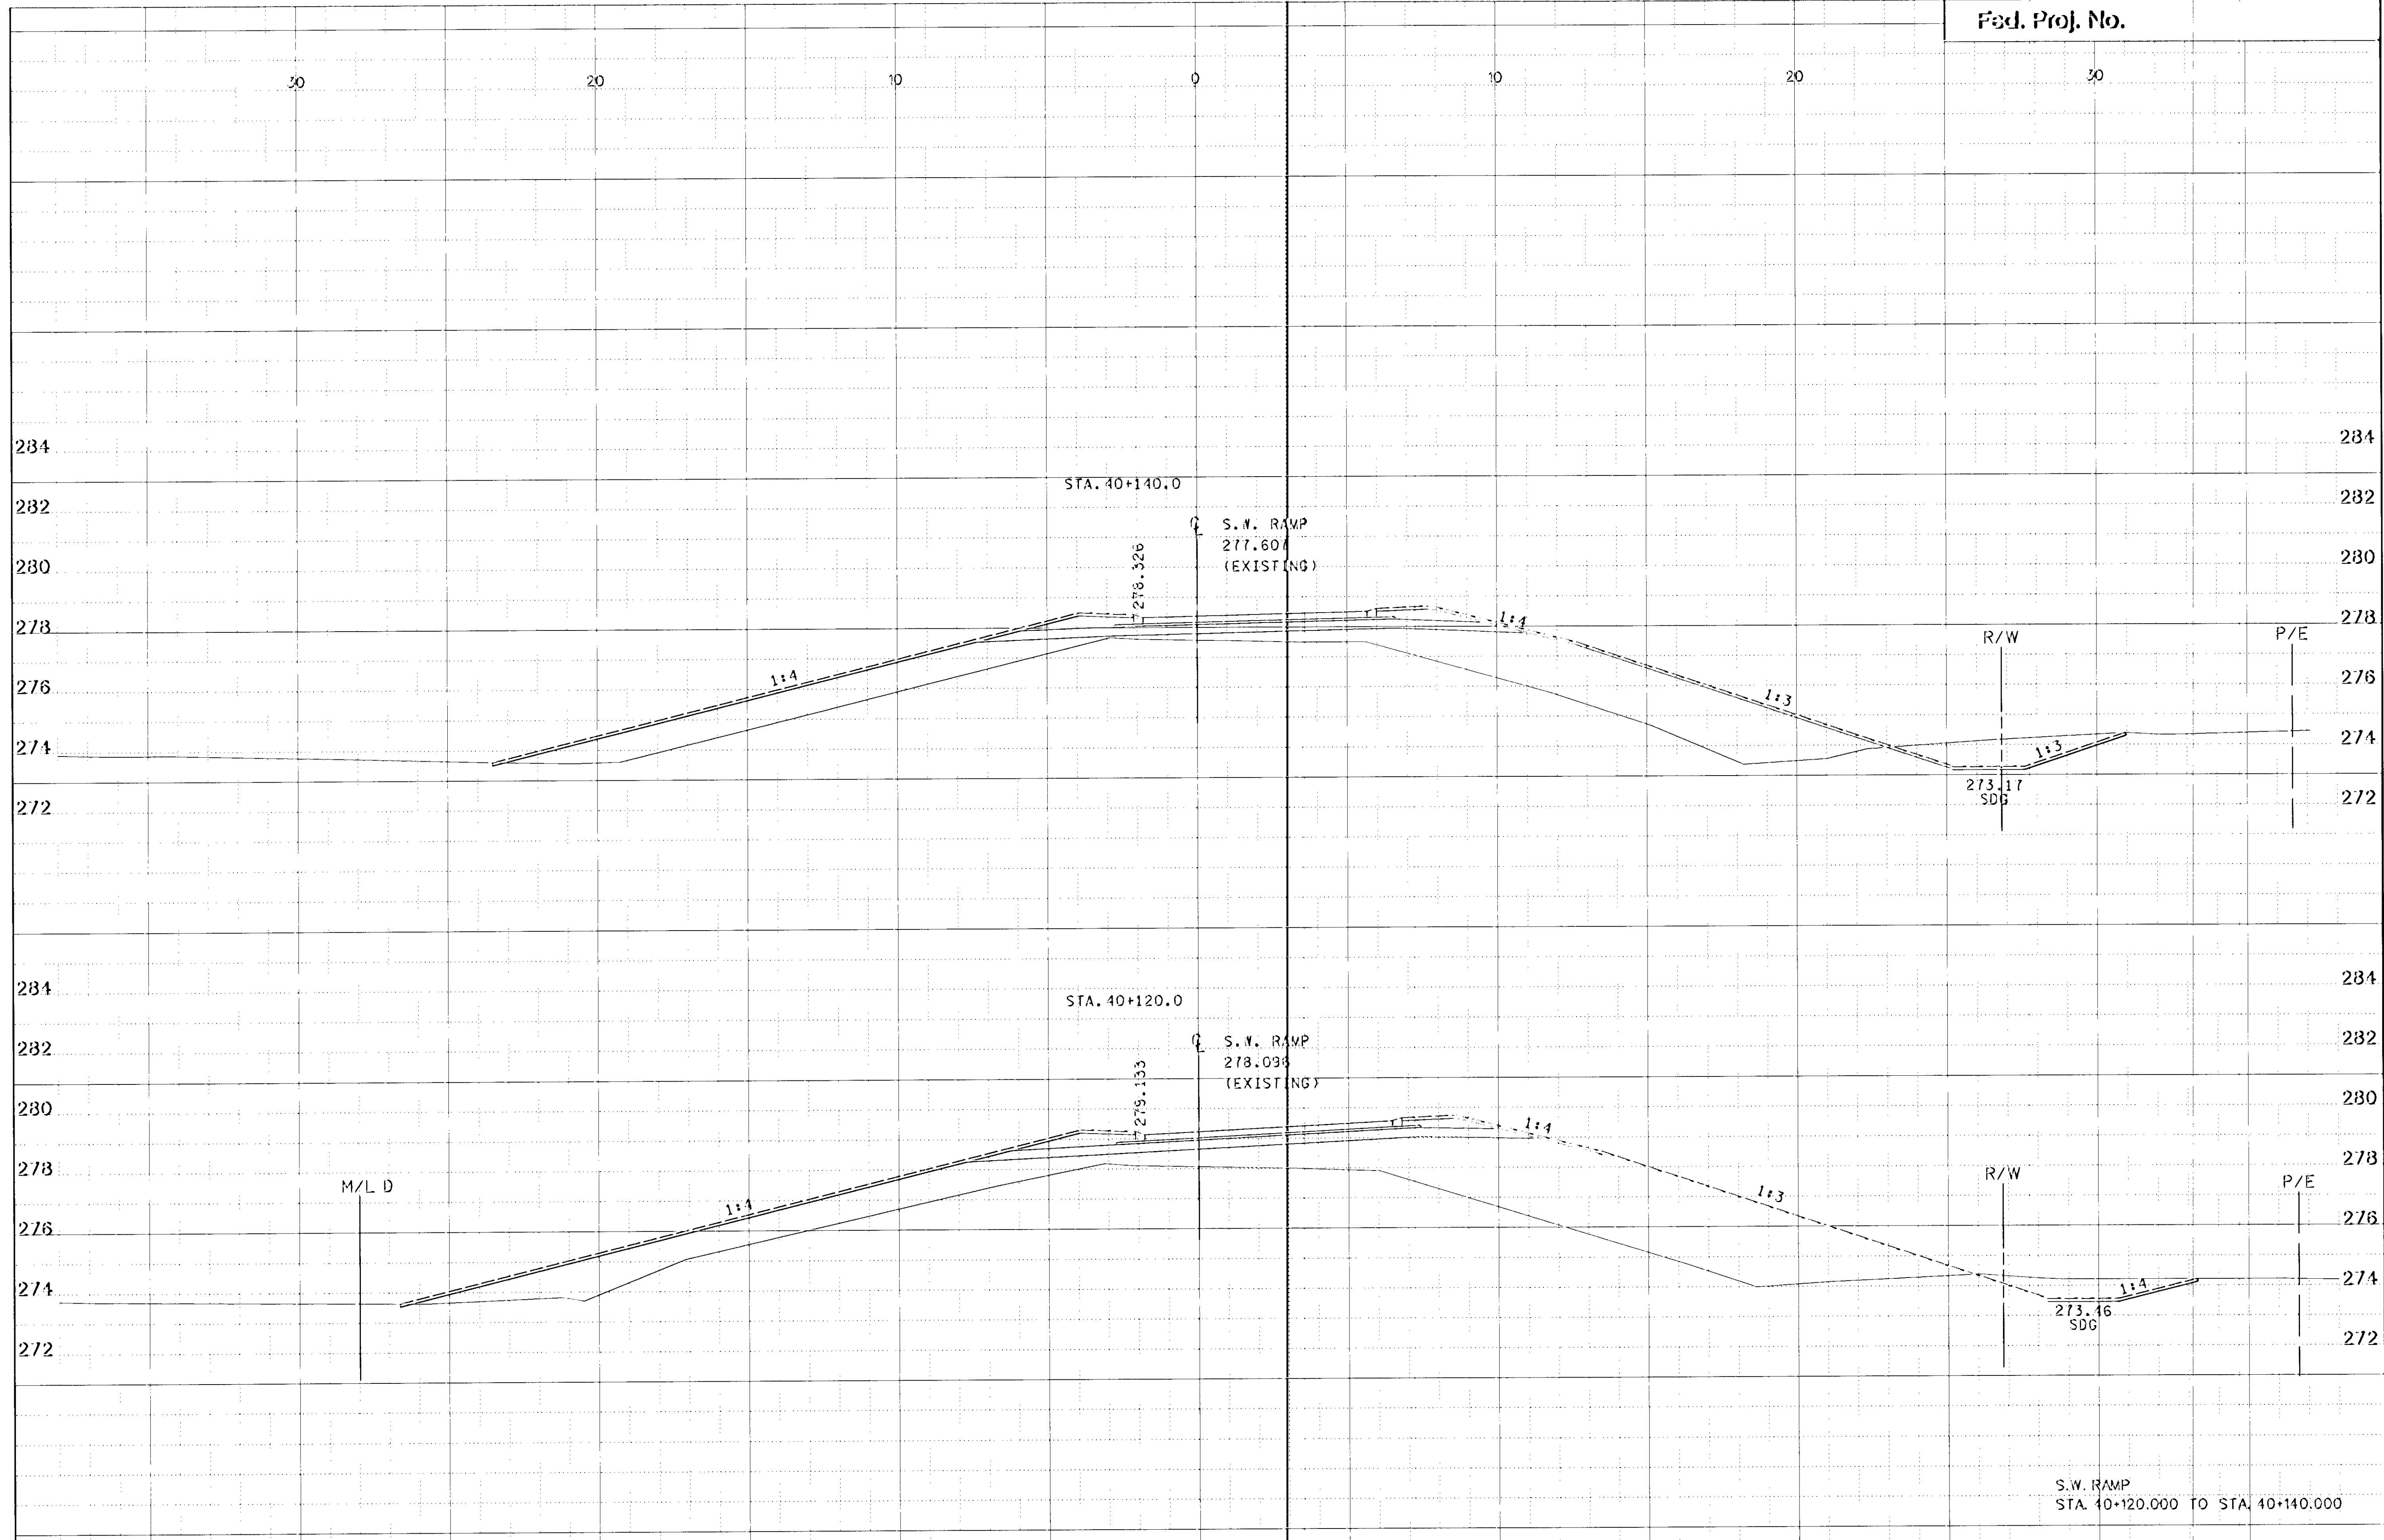

S.W. RAMP
STA. 40+120.000 TO STA. 40+140.000