


PROJECT LOCATION

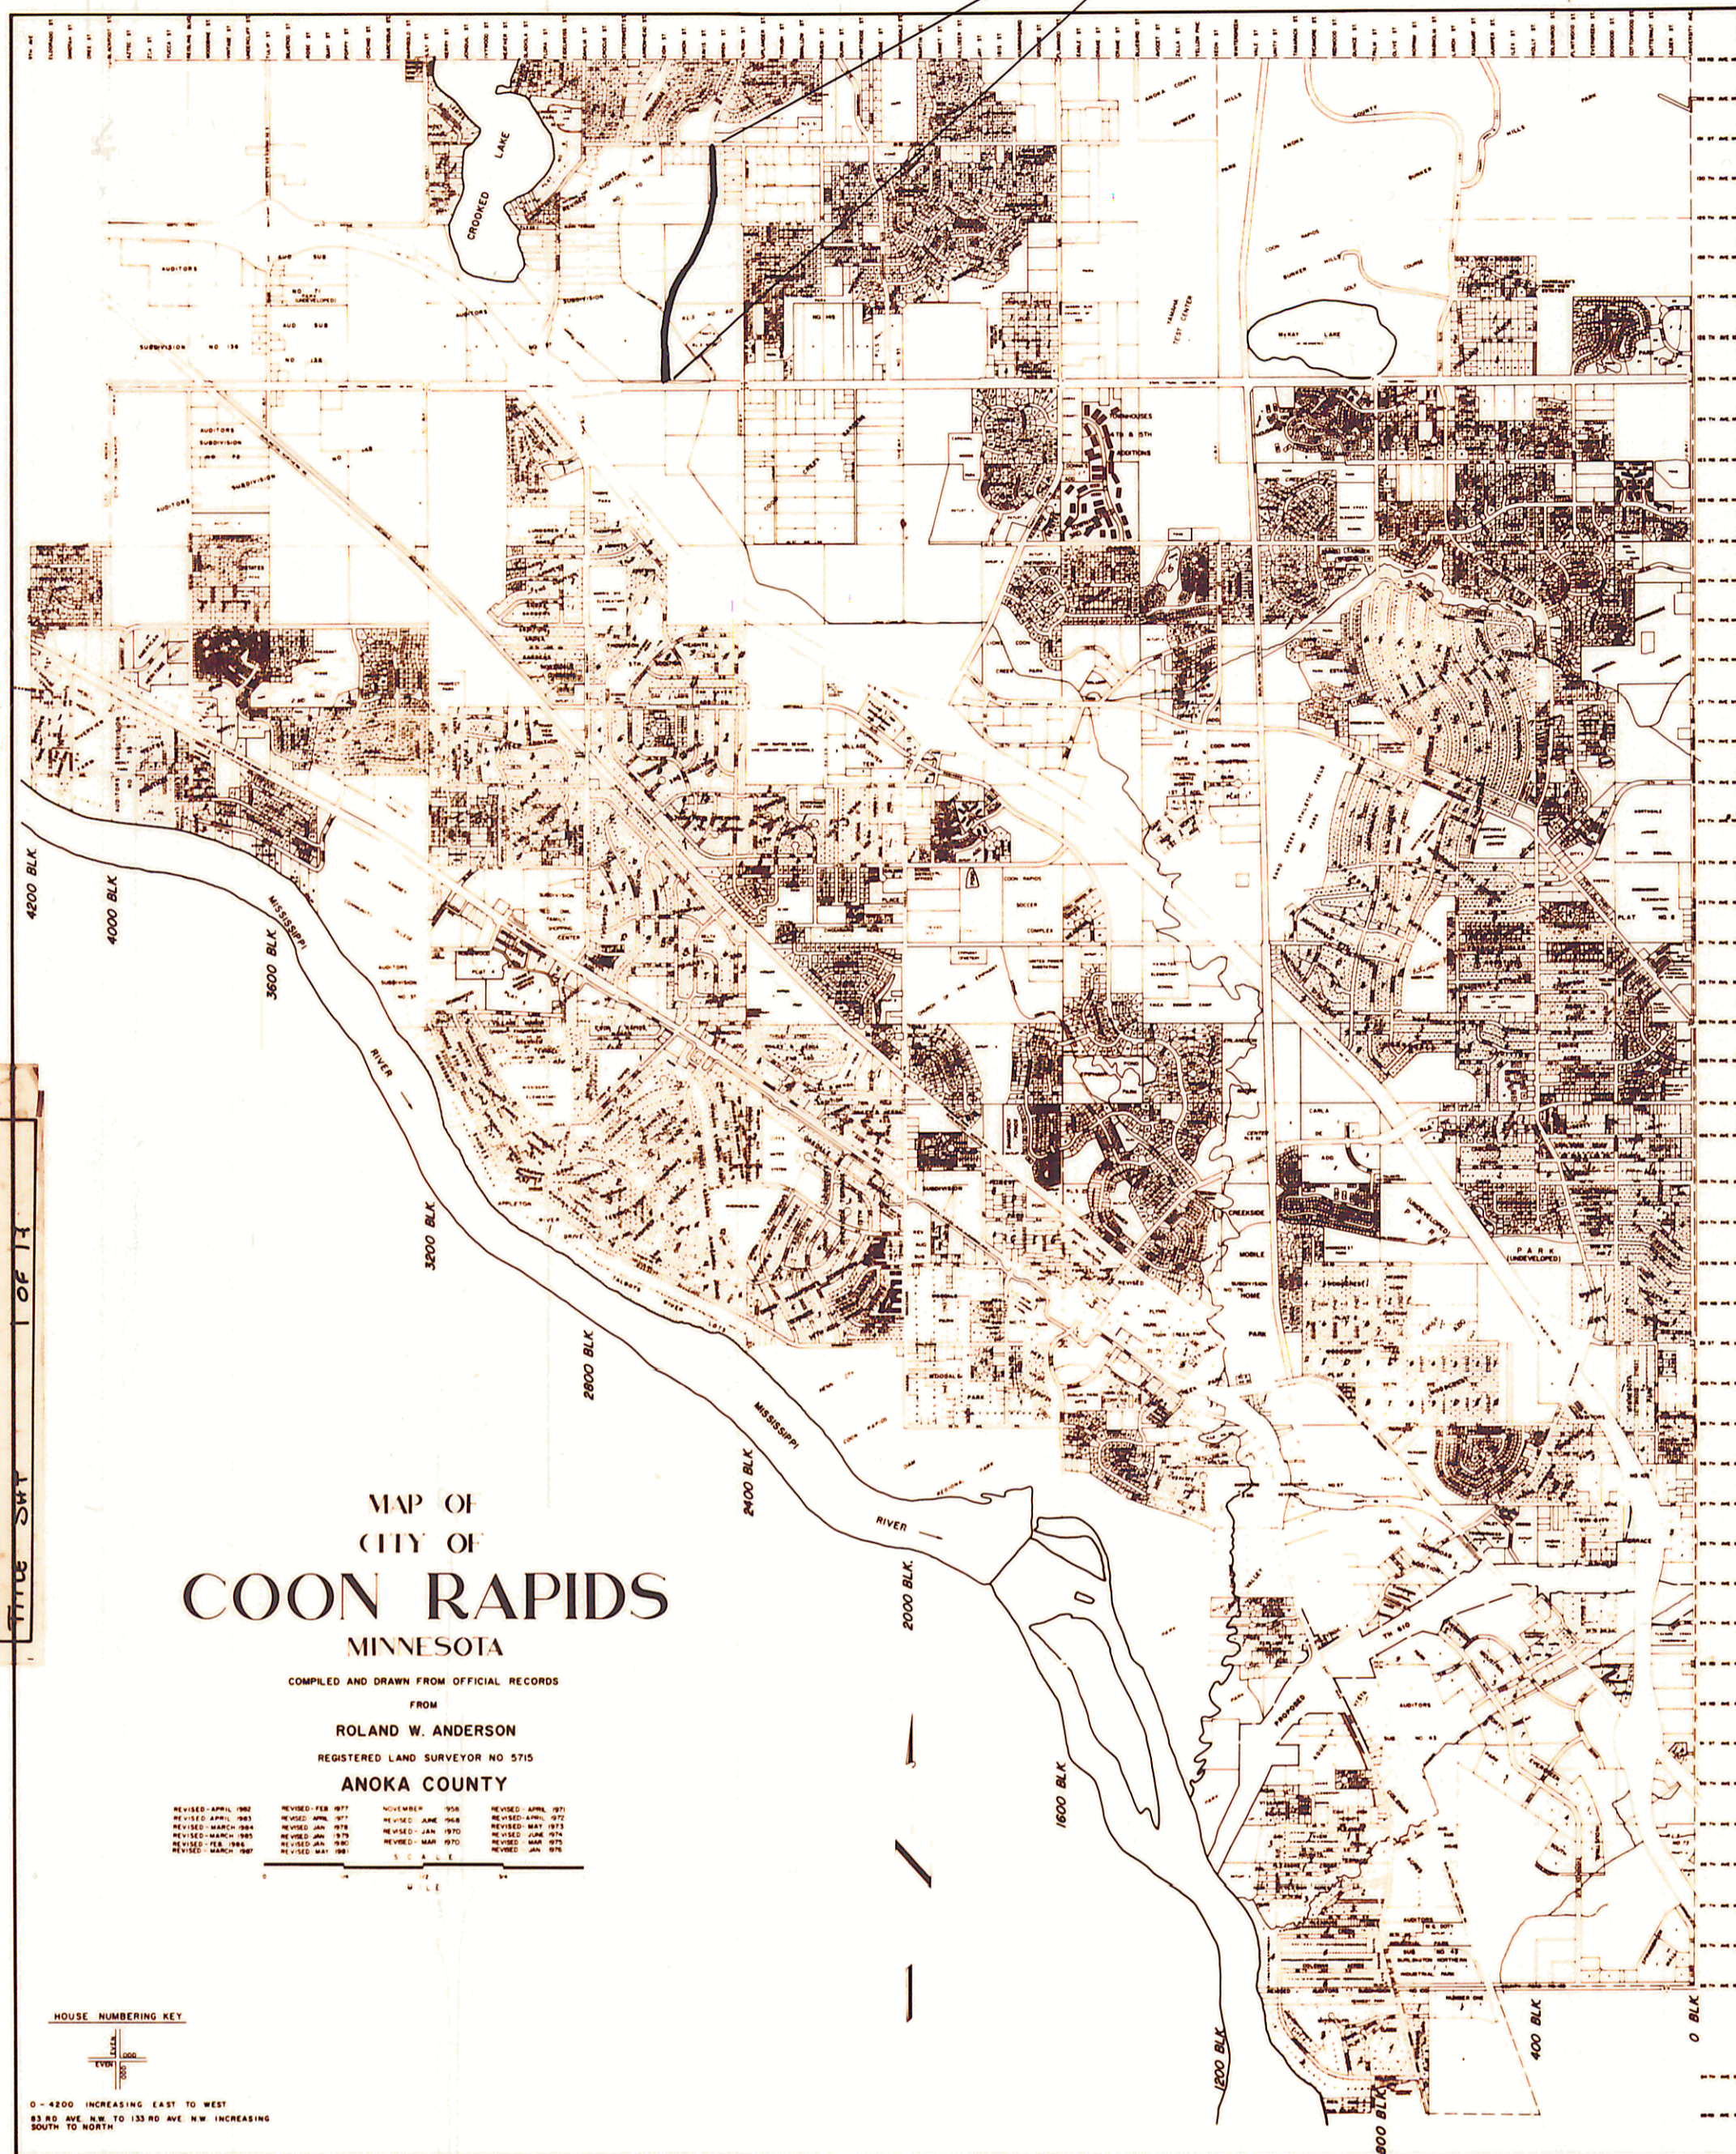

# IMPROVEMENT PROJECT 86-22

## COON CREEK BOULEVARD (COUNTY ROAD 18)

### BRIDGE NO. 02549

INDEX


SHEET NO.	DESCRIPTION
1	TITLE SHEET
2-3	TYPICAL SECTIONS
4-8	PLAN SHEETS
9-10	SIGNING & STRIPING
11-17	CROSS SECTIONS
1-11	BRIDGE PLANS

REVISION	DATE	SHEETS REVISED
①	4/15/88	3,5,6,8,9 (BRIDGE SHEETS)
△	4/21/88	2,7,8,10,14 (STREET SHEETS)
△	5/13/88	5,7 (STREET SHEETS)
△	5/27/88	6,7,10,13 (STREET SHEETS)
②	5/26/88	1-6,8,10,11 (BRIDGE SHEETS)
△	6/6/89	6,7,13 (STREET SHEETS)

PREPARED BY

**bennett ringrose wolsfeld jarvis gardner inc.**

THRESHER SQUARE, 700 THIRD STREET SOUTH, MINNEAPOLIS, MN. 55415

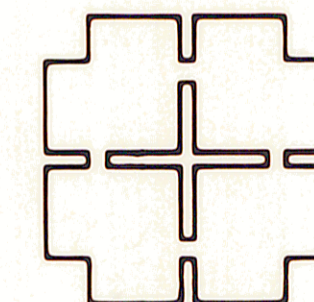


REF: ACHD 02-618-20  
MD 2/12/97

**NOVEMBER, 1987**

I hereby certify that this plan, specification, or report was prepared by me or under my direct supervision and that I am a duly Registered Professional Engineer under State of Minn. Statutes Sections 326.02 to 326.16 Terry L. Herman Date 2/2/88 Minn. Reg. No. 12699




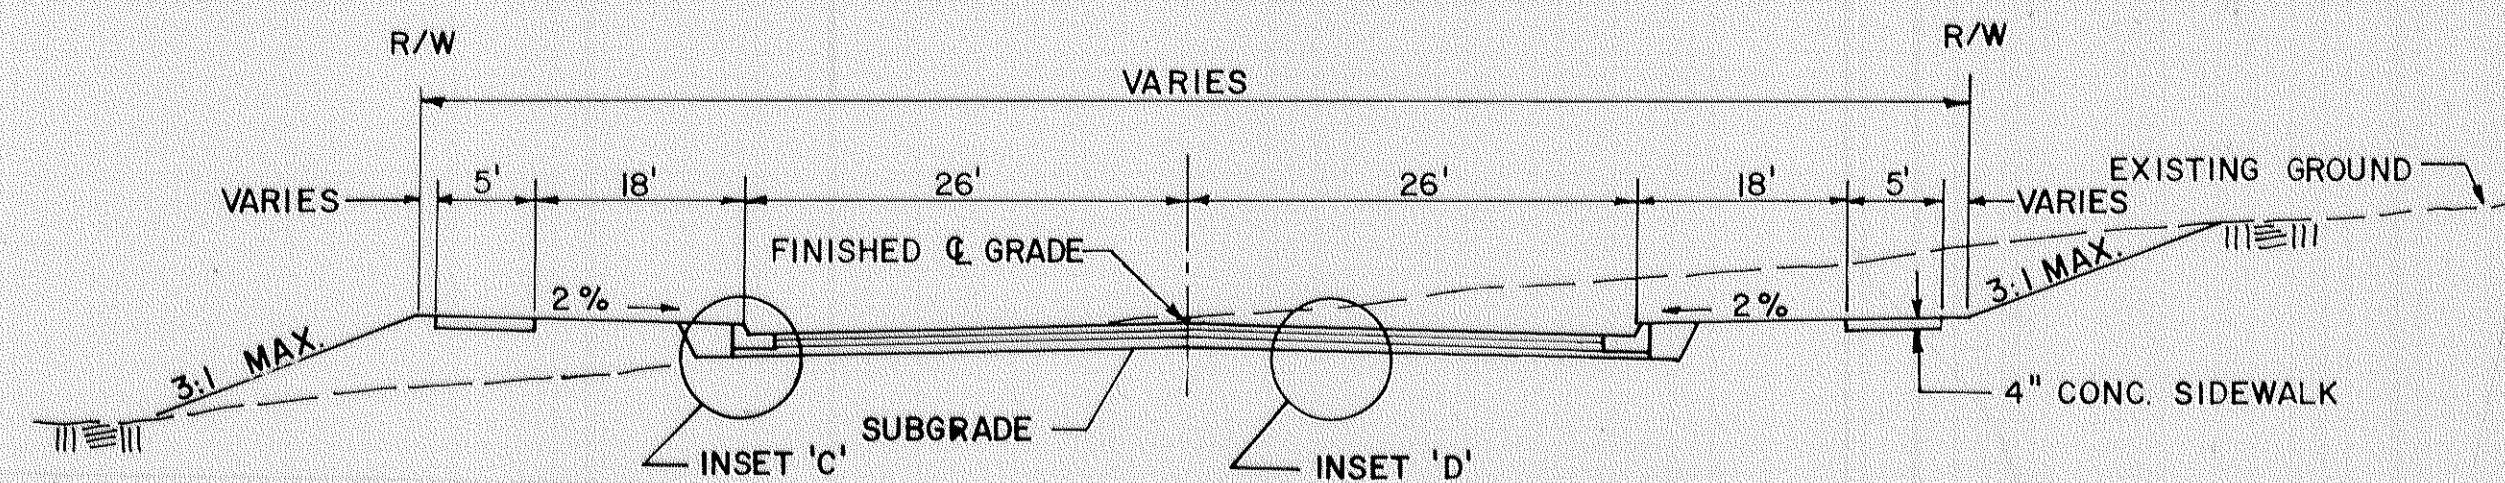

**COON CREEK BOULEVARD URBAN SECTION**

STA. 0+00 TO STA. 16+00


NOTE: FINISHED C ELEVATIONS =  
TOP OF CURB ELEVATIONS

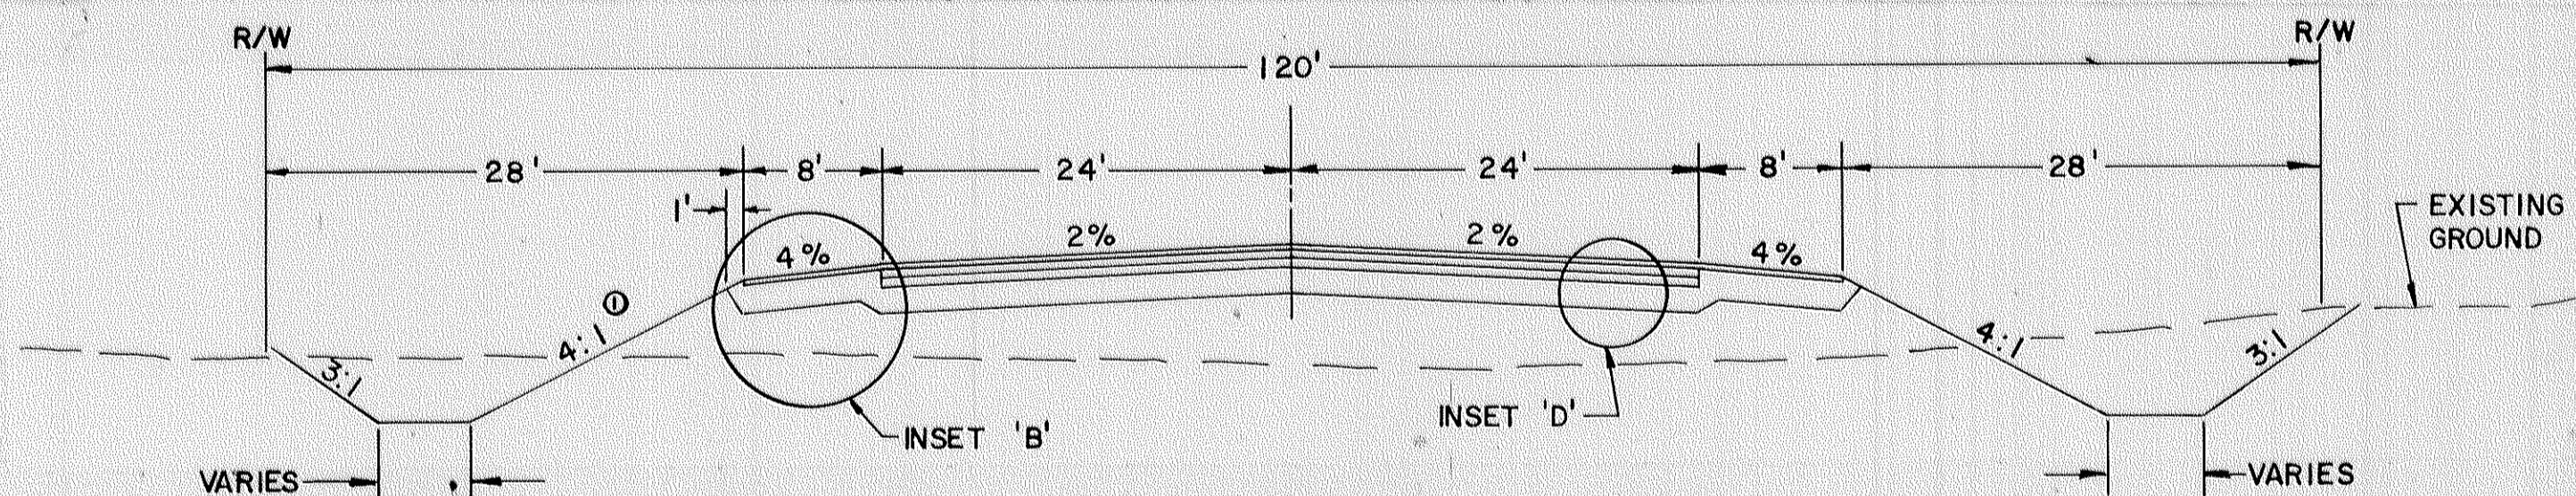

**COON CREEK BOULEVARD RURAL SECTION**

STA. 18+00 TO STA. 29+50


Ⓢ NOTE: WHERE DITCH SLOPE IS GREATER THAN  
4:1 GUARDRAIL WILL BE PROVIDED

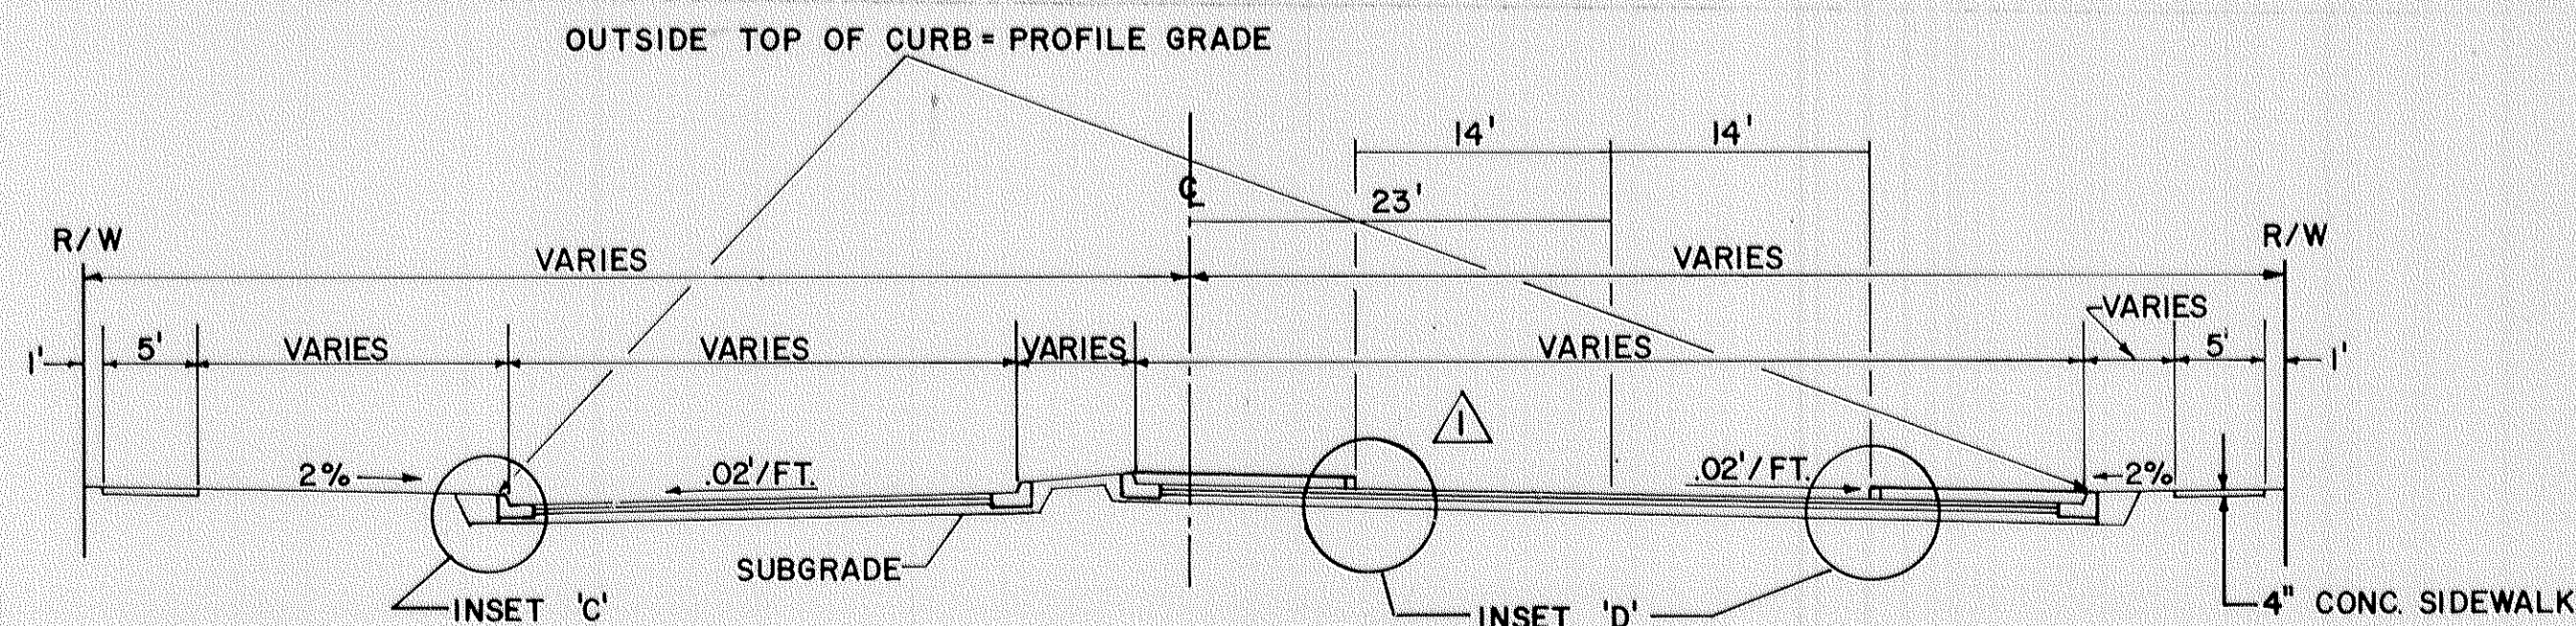

**COON CREEK BOULEVARD URBAN SECTION**


STA. 31+00 TO STA. 42+50

NOTE: SEE PLAN SHEETS FOR AREAS OF TRANSITION

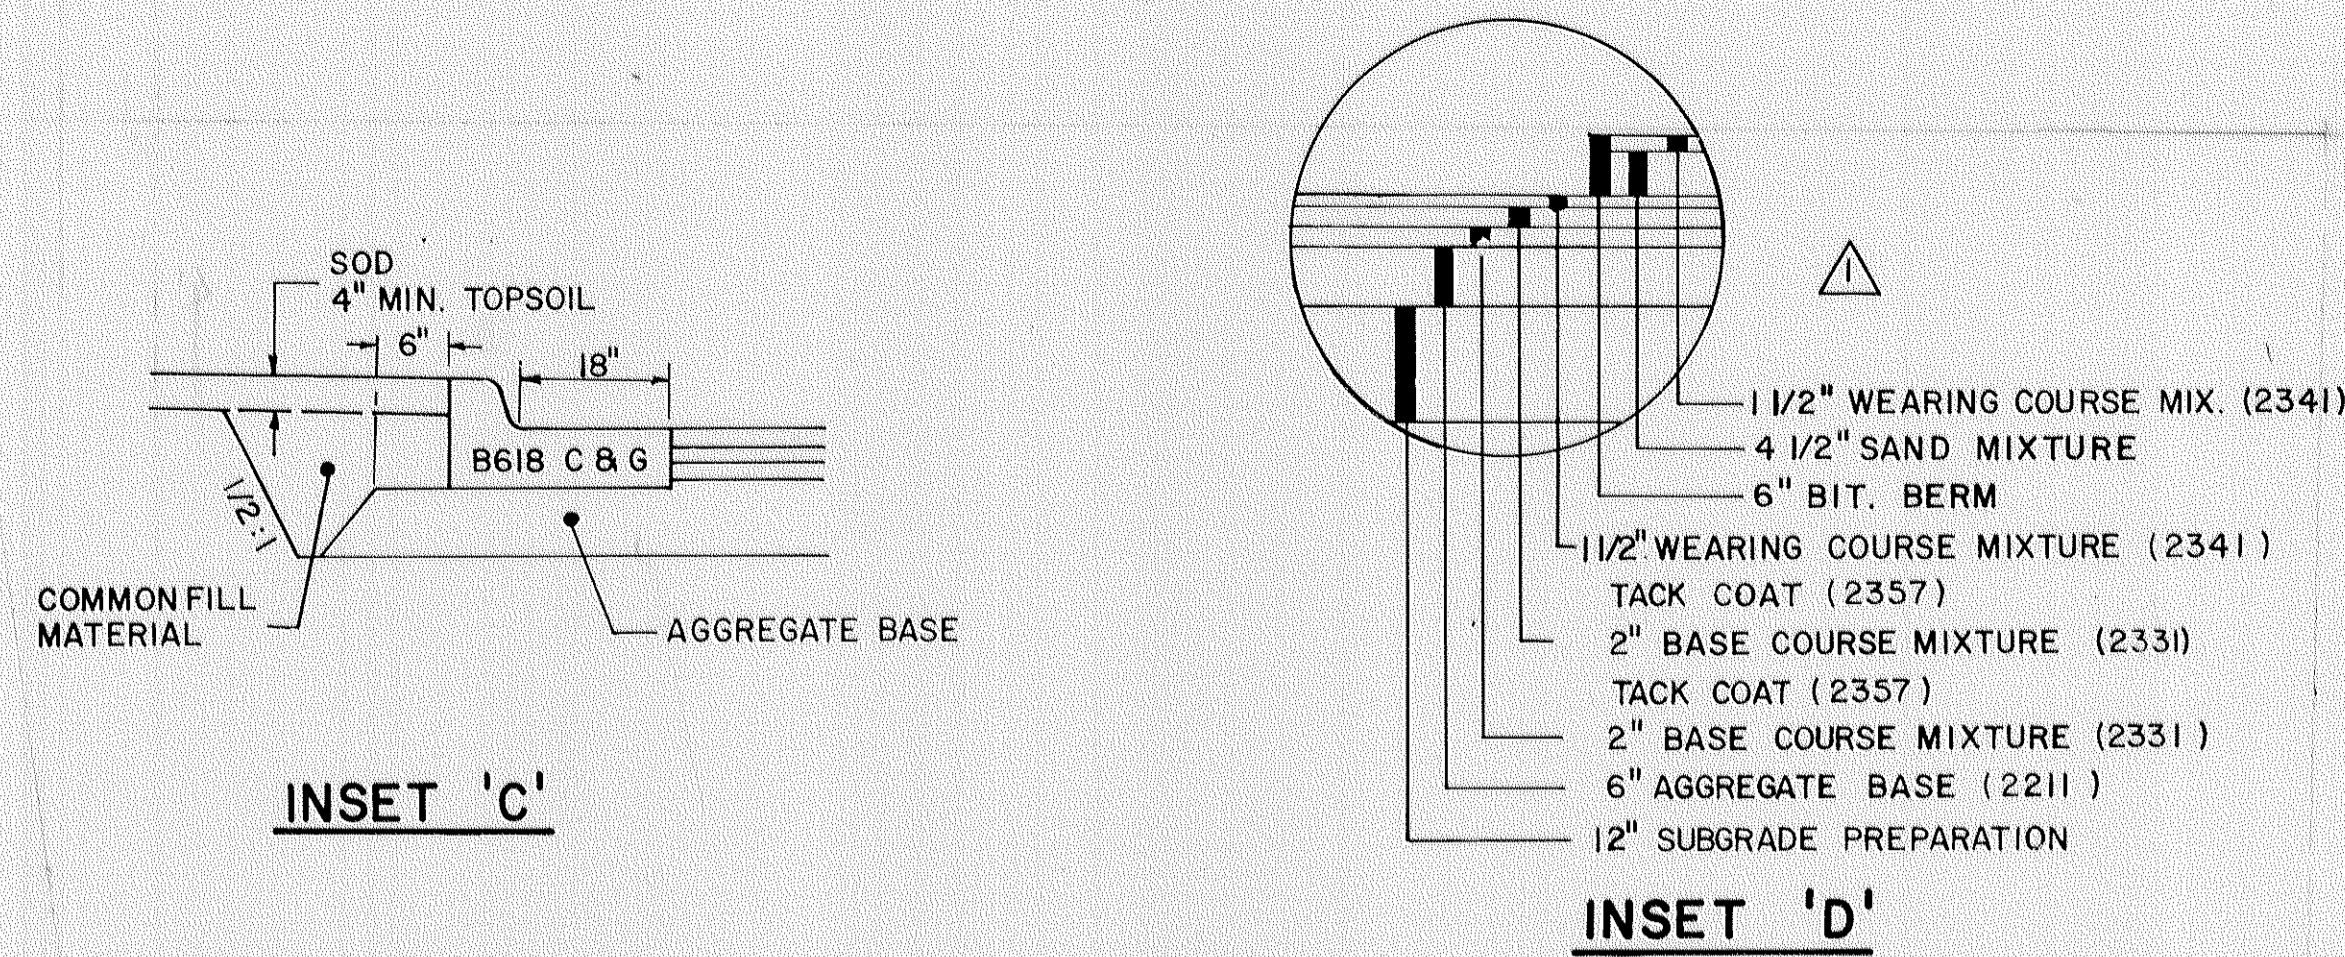


**INSET 'C'**


**INSET 'D'**

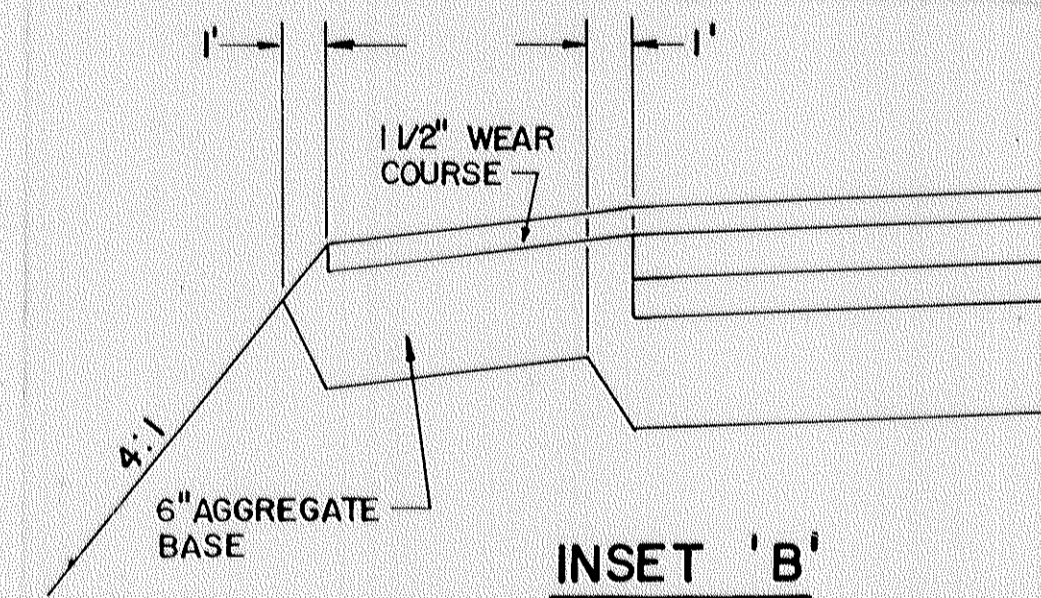

**INSET 'B'**

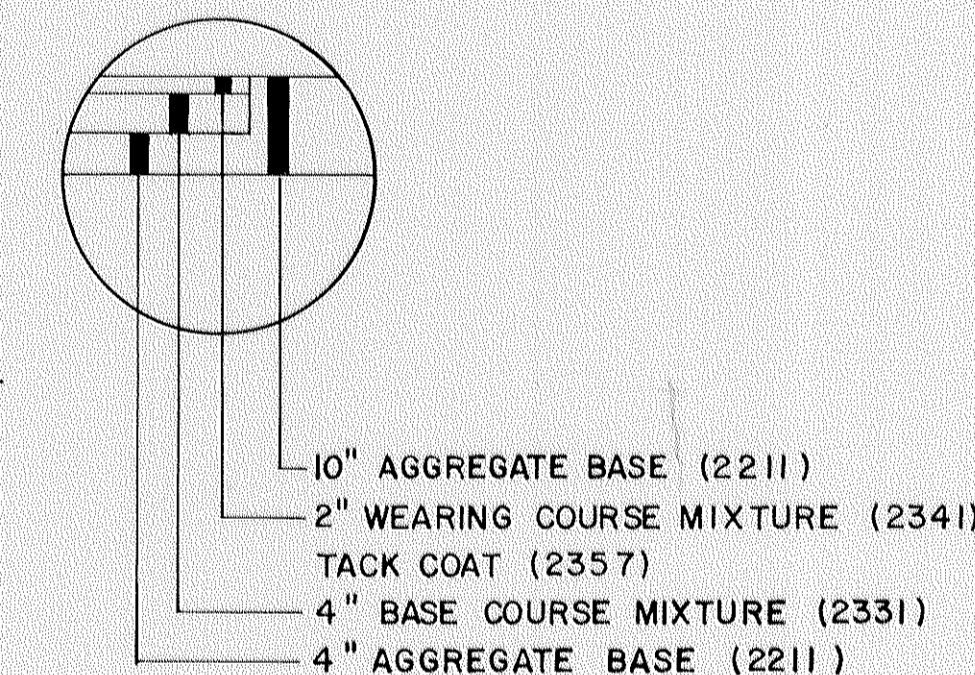

**INSET 'A'**

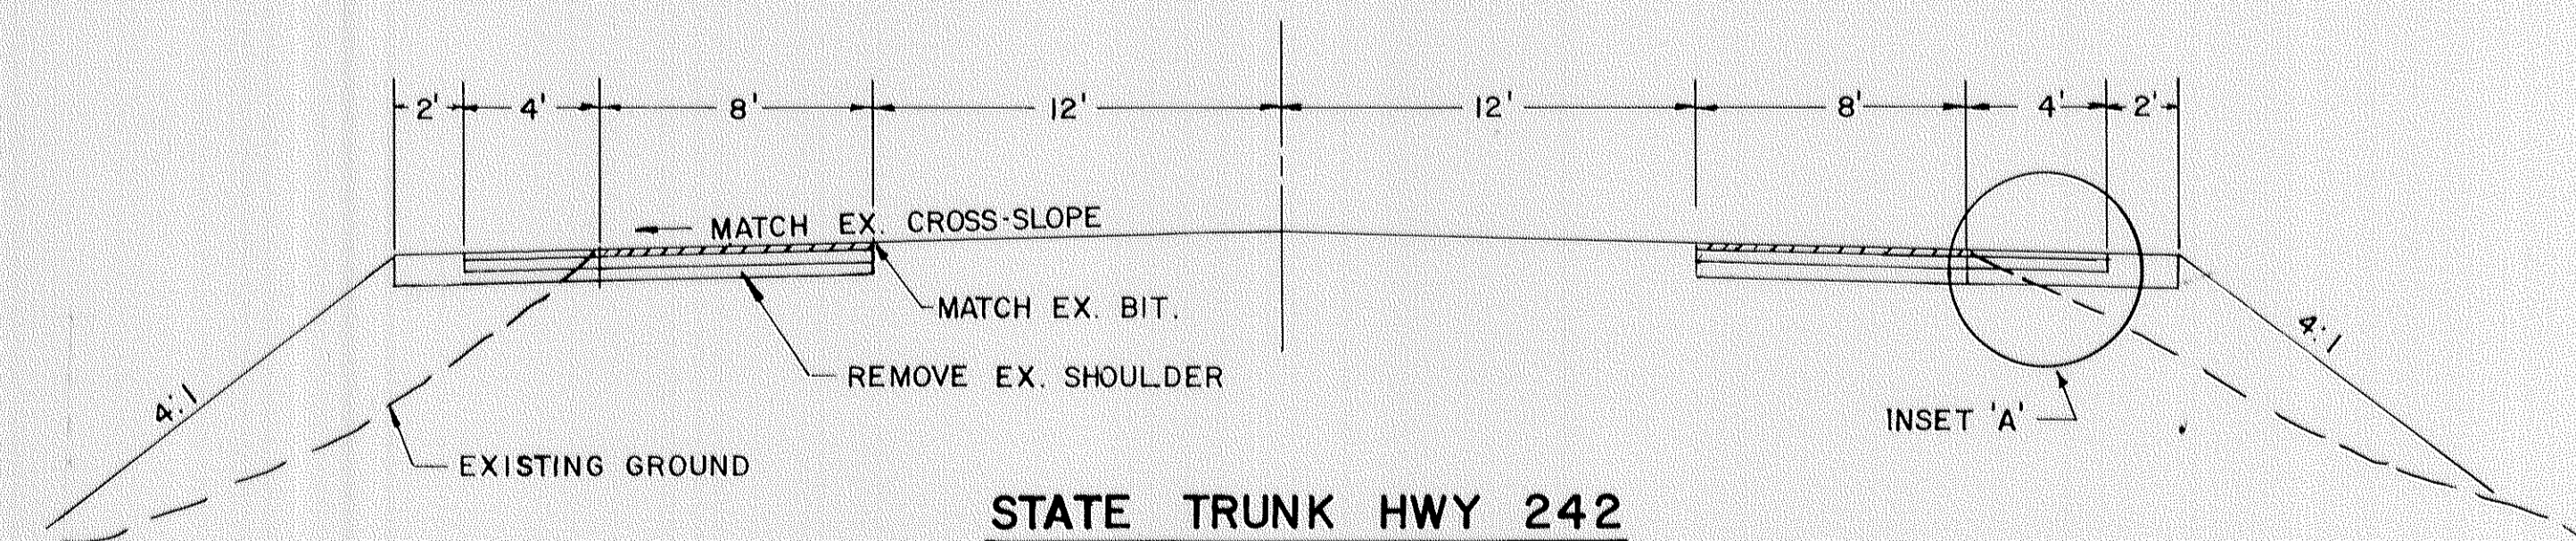

**STATE TRUNK HWY 242  
TURNING & BYPASS LANES**

I hereby certify that this plan, specification or report was prepared by me or under my direct supervision and that I am a duly Registered Professional Engineer under the State of Minn. Statutes Sections 326.02 to 326.16.

*Ray L. Herman*  
Date 2/12/88 Minn. Reg. No. 12699



DESIGN BY: TLH  
DRAWN BY: SAC

ORIGINAL DATE: 2/2/88  
REVISIONS:  
4/21/88 REVISE  
TYPICAL & INSET D  
SURVEY BK. NO.  
8226, 8242

**CITY OF COON RAPIDS  
IMPROVEMENT PROJECT 86-22  
COON CREEK BLVD.  
(COUNTY ROAD 18)  
TYPICAL SECTIONS**


S.A.P. NO. 02-618-20

SHEET 2 OF 17

DESIGN FILE  
No. 16-8725

CLIENT: Coon Rapids  
 AS BUILT DATE: 3/10/89  
 TYPE & LOCATION: Typical Sections 2 of 17



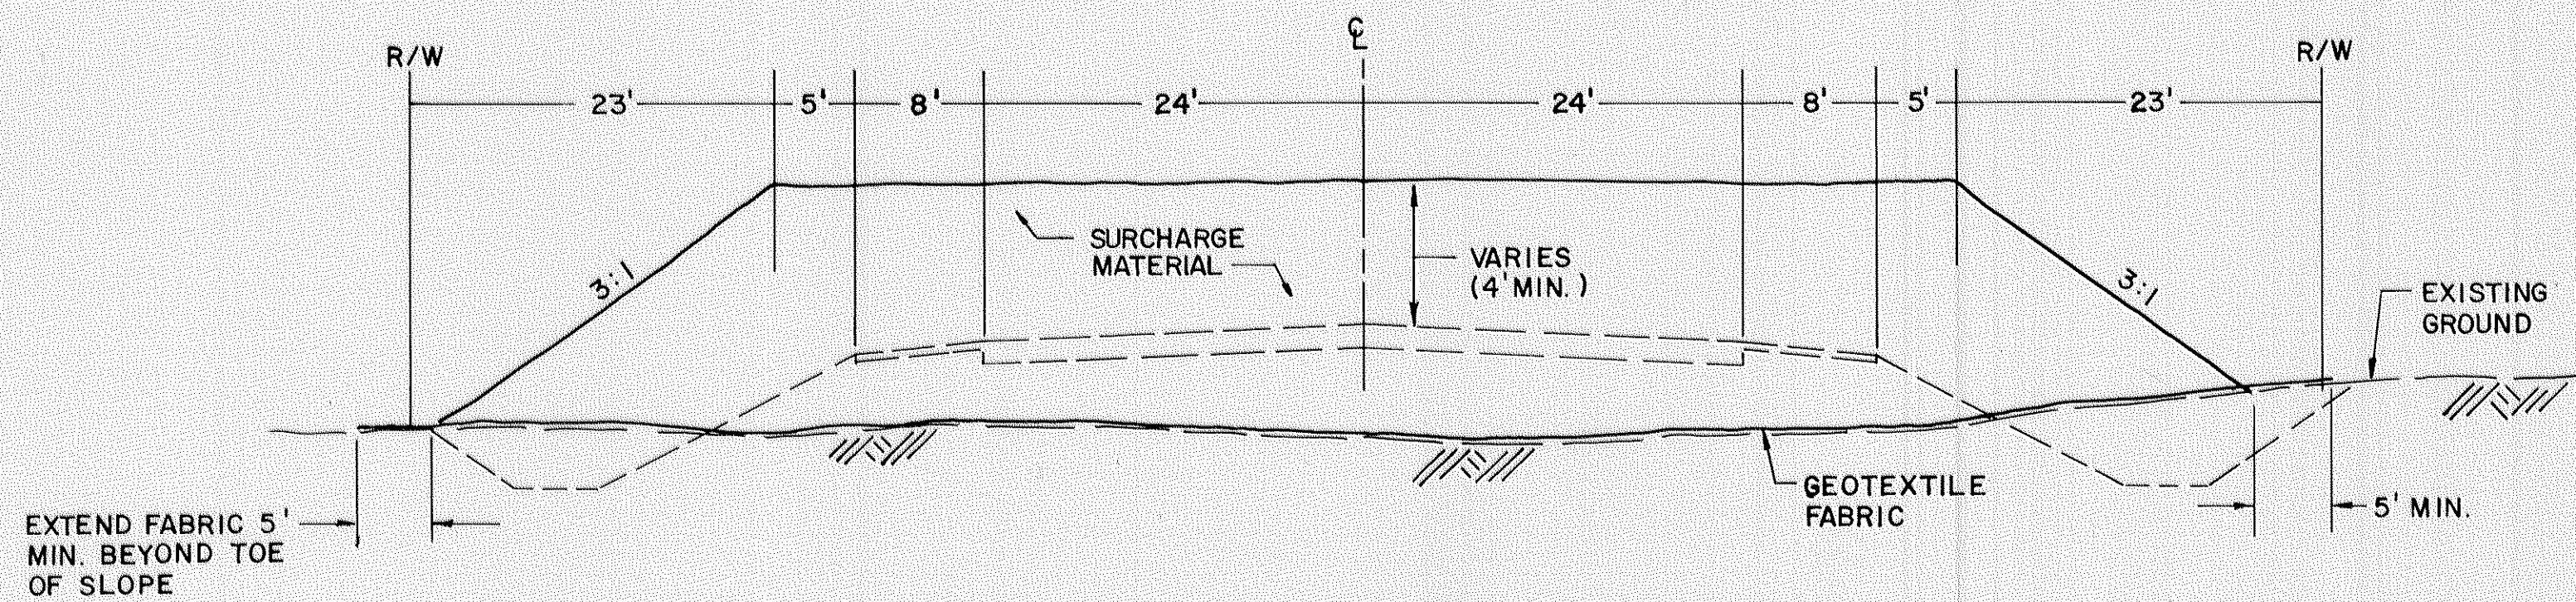


**COON CREEK BOULEVARD SURCHARGE SECTION**

STA. 18+50 TO 29+50  
STA. 31+00 TO 32+00

NOTE: STA. 31+00 TO 32+00 PROVIDE SURCHARGE MATERIAL 5' BEHIND BACK OF CURB, THEN PROVIDE 3:1 SLOPE TO EXISTING GROUND.  
STA. 26+25 TO 26+90 WIDEN SURCHARGE TO 50' LEFT & RIGHT BEFORE BEGINNING 3:1 SLOPE.

EXTEND FABRIC 5' MIN. BEYOND TOE OF SLOPE

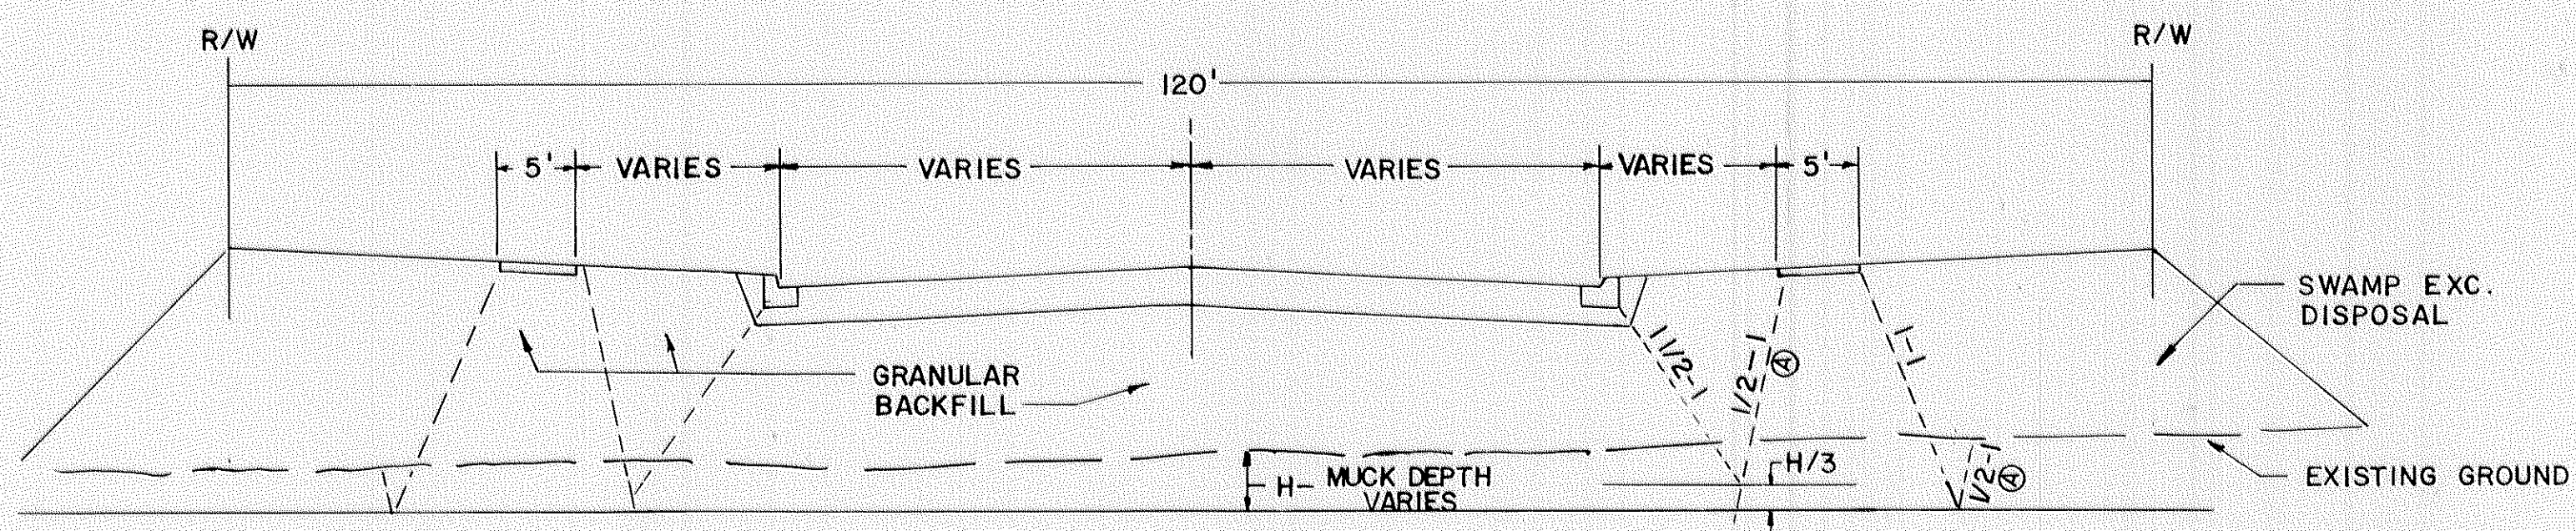

**TYPICAL SWAMP EXCAVATION**

STA. 17+50 TO 18+50  
STA. 32+00 TO 36+50

NOTE: DEPENDING ON PEAT DEPTH ENCOUNTERED PROVIDE EXCAVATION BACKSLOPE (A) WHICH PROVIDES GREATER WIDTH.

COON CREEK BOULEVARD SURCHARGE SECTION  
 STA. 18+50 TO 29+50  
 STA. 31+00 TO 32+00  
 TYPICAL SWAMP EXCAVATION  
 STA. 17+50 TO 18+50  
 STA. 32+00 TO 36+50

I hereby certify that this plan, specification or report was prepared by me or under my direct supervision and that I am a duly Registered Professional Engineer under the State of Minn. Statutes Sections 326.02 to 326.16.

*Terry S. Herman*

Date 2/2/88 Minn. Reg. No. 12699

**BRW**  
Brenett, Ringross, Wolfeld, Jarvis, Gardner  
612-370-0700  
Minneapolis, Minnesota

DESIGN BY: TLH  
DRAWN BY: SAC

ORIGINAL DATE: 2/2/88  
REVISIONS:

SURVEY BK. NO.  
8226, 8242

**CITY OF COON RAPIDS**  
**IMPROVEMENT PROJECT 86-22**  
**COON CREEK BLVD.**  
**(COUNTY ROAD 18)**  
**TYPICAL SECTIONS**


S.A.P. NO.

SHEET 3 OF 17


DESIGN FILE No. 16-8725



# COON CREEK BLVD. (COUNTY ROAD 18)

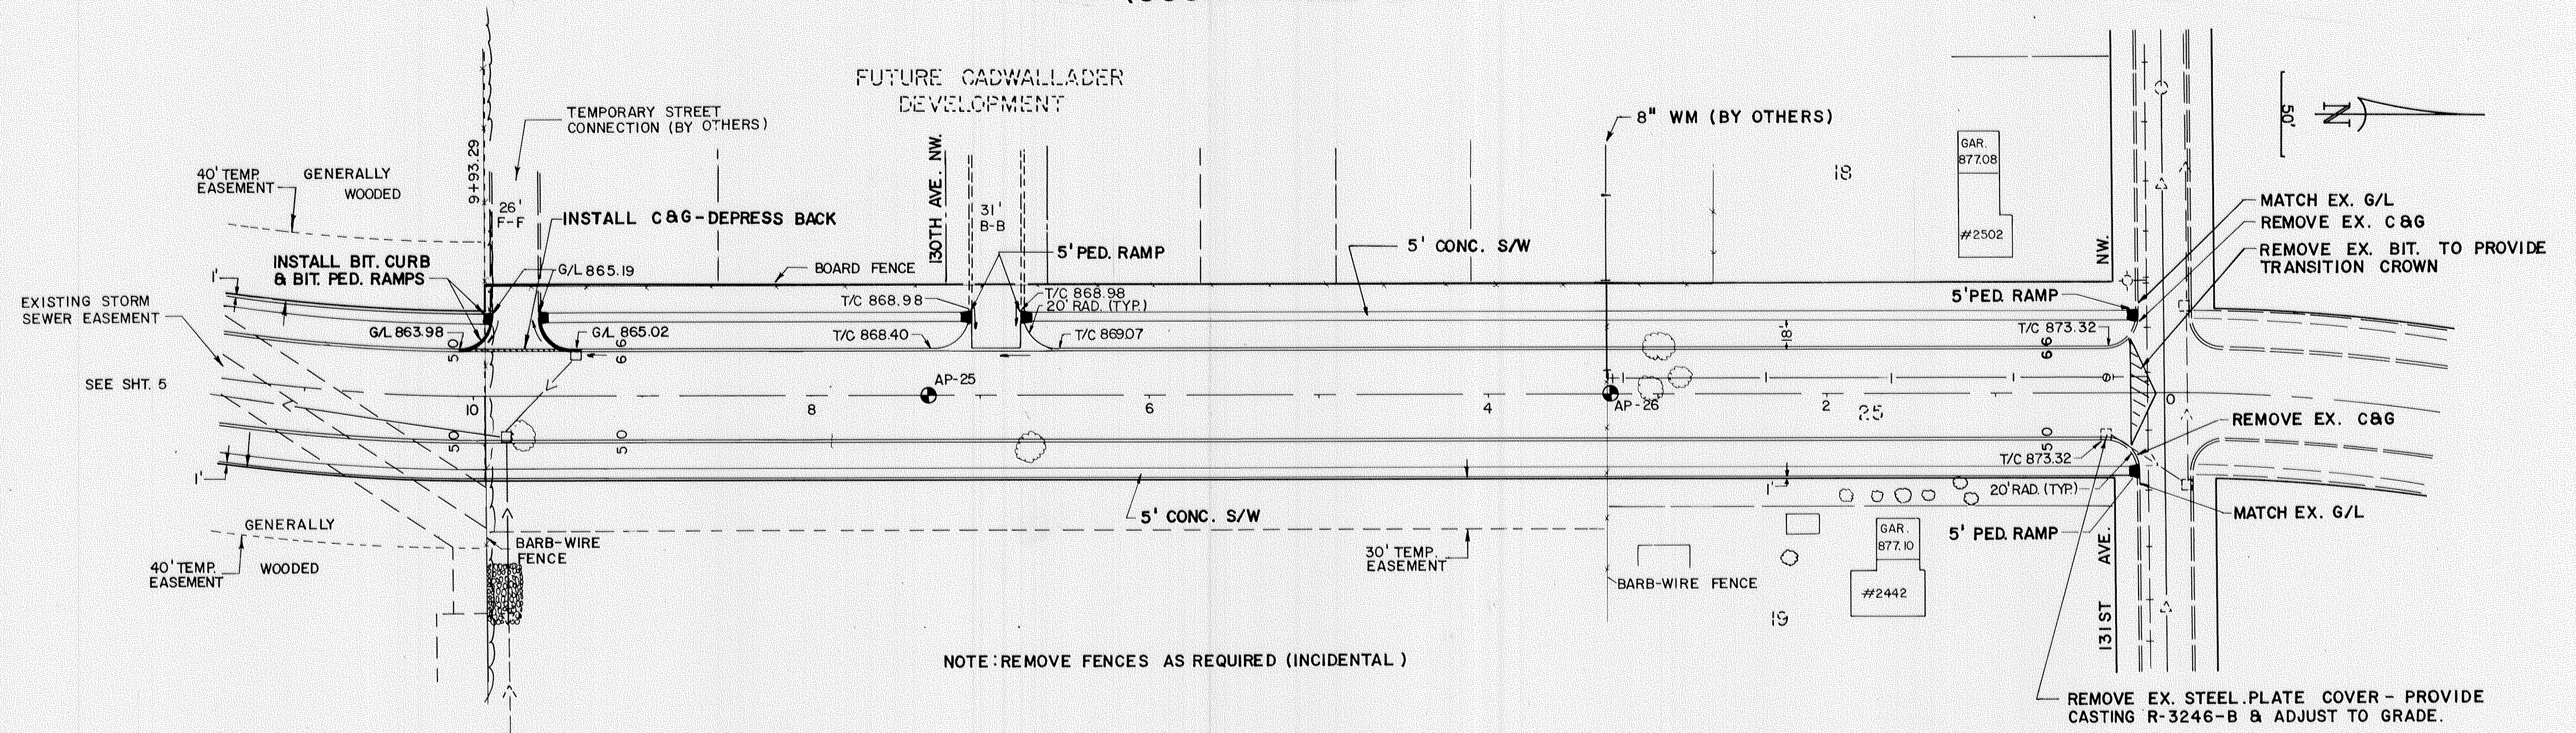

NOTE: REMOVE FENCES AS REQUIRED (INCIDENTAL)

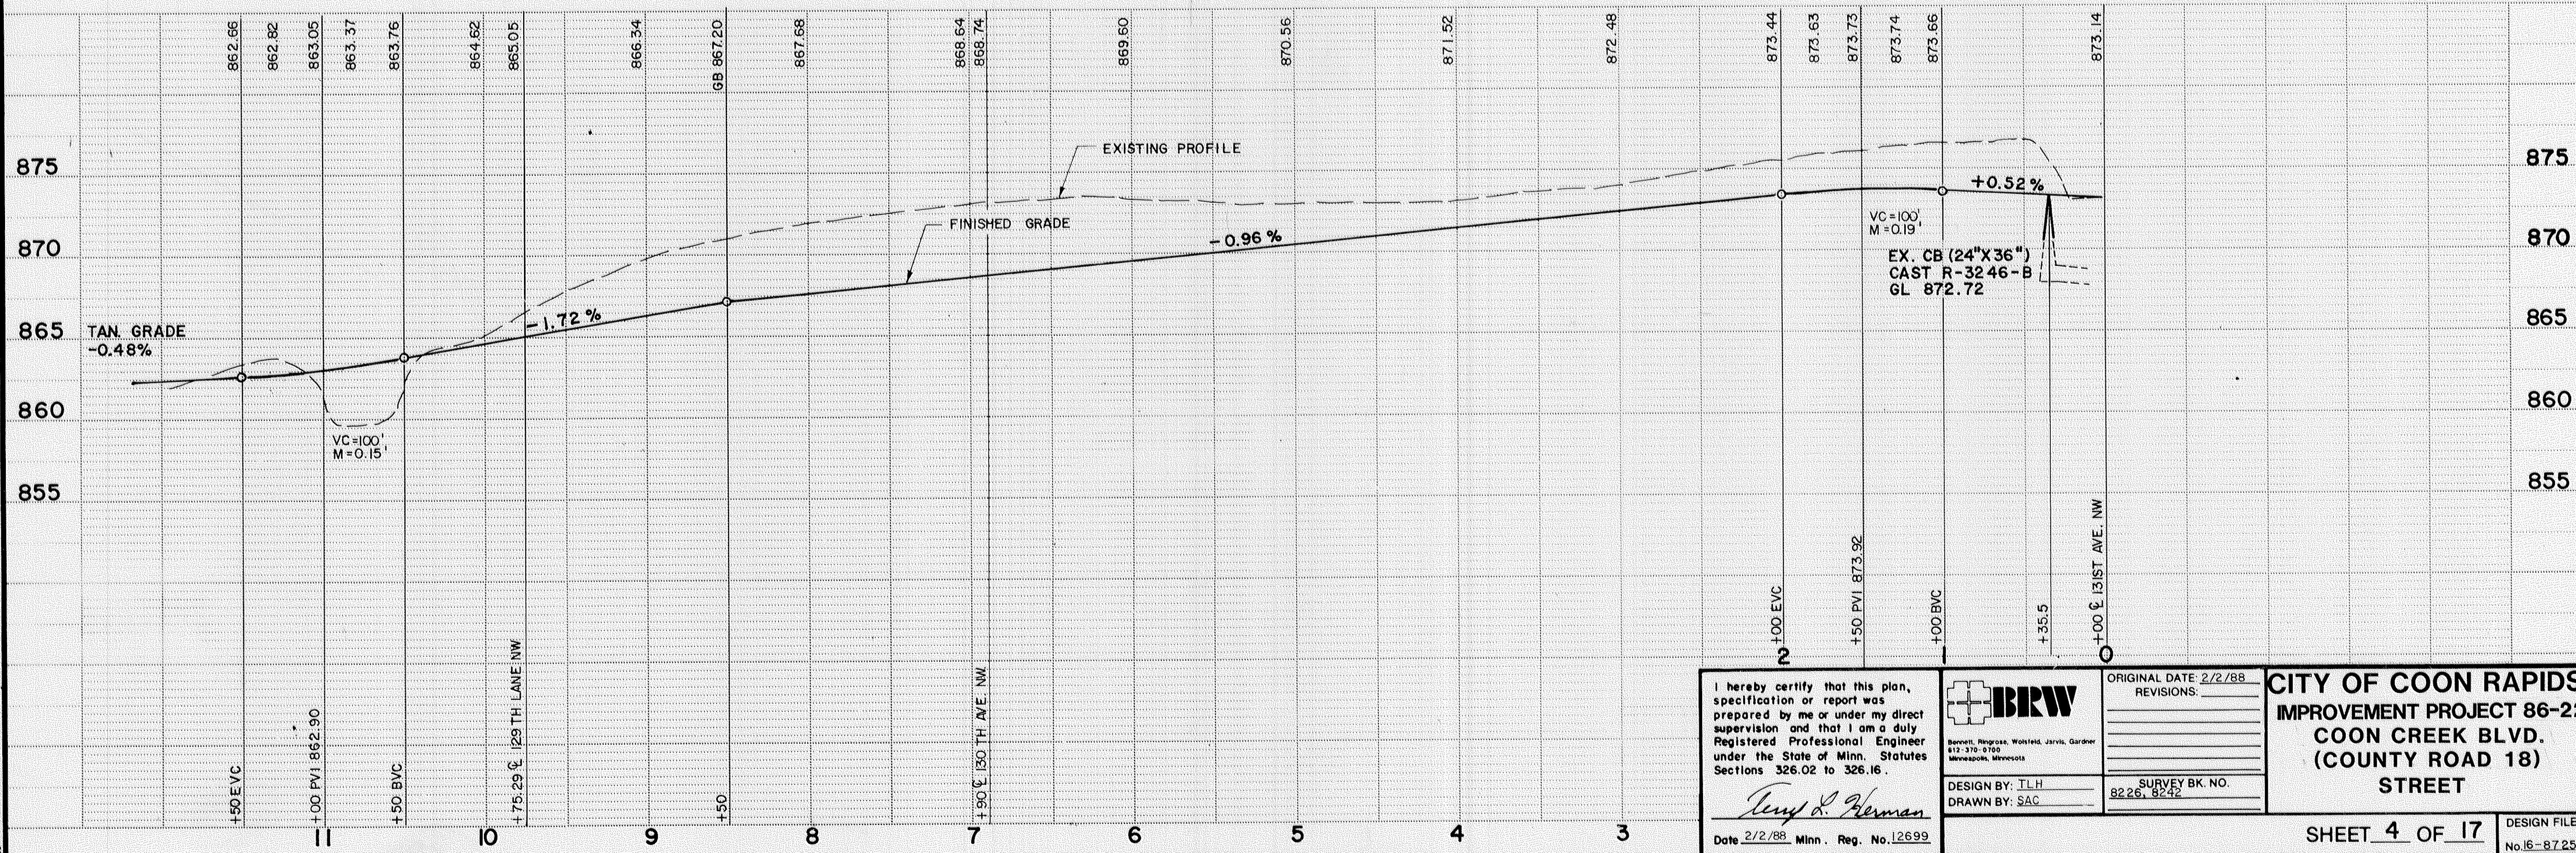


<p>I hereby certify that this plan, specification or report was prepared by me or under my direct supervision and that I am a duly Registered Professional Engineer under the State of Minn. Statutes Sections 326.02 to 326.16.</p> <p style="text-align: center;"><i>Terry D. Herman</i></p> <p>Date 2/2/88 Minn. Reg. No. 12699</p>	<p><b>BRW</b> Borvick, Ringrose, Wolfeld, Jarvis, Gardner 817-370-0100 Minneapolis, Minnesota</p>	<p>ORIGINAL DATE: 2/2/88 REVISIONS:</p> <hr/> <p>SURVEY BK. NO. 8226, 8242</p>	<p><b>CITY OF COON RAPIDS</b> IMPROVEMENT PROJECT 86-22 <b>COON CREEK BLVD.</b> (COUNTY ROAD 18) <b>STREET</b></p>
<p>SHEET <u>4</u> OF <u>17</u></p>			<p>DESIGN FILE No. 16-87.25</p>


PLAN SHEET  
 COON CREEK BLVD.  
 COUNTY ROAD 18  
 SHEET 4 OF 17



# COON CREEK BLVD. (COUNTY ROAD 18)

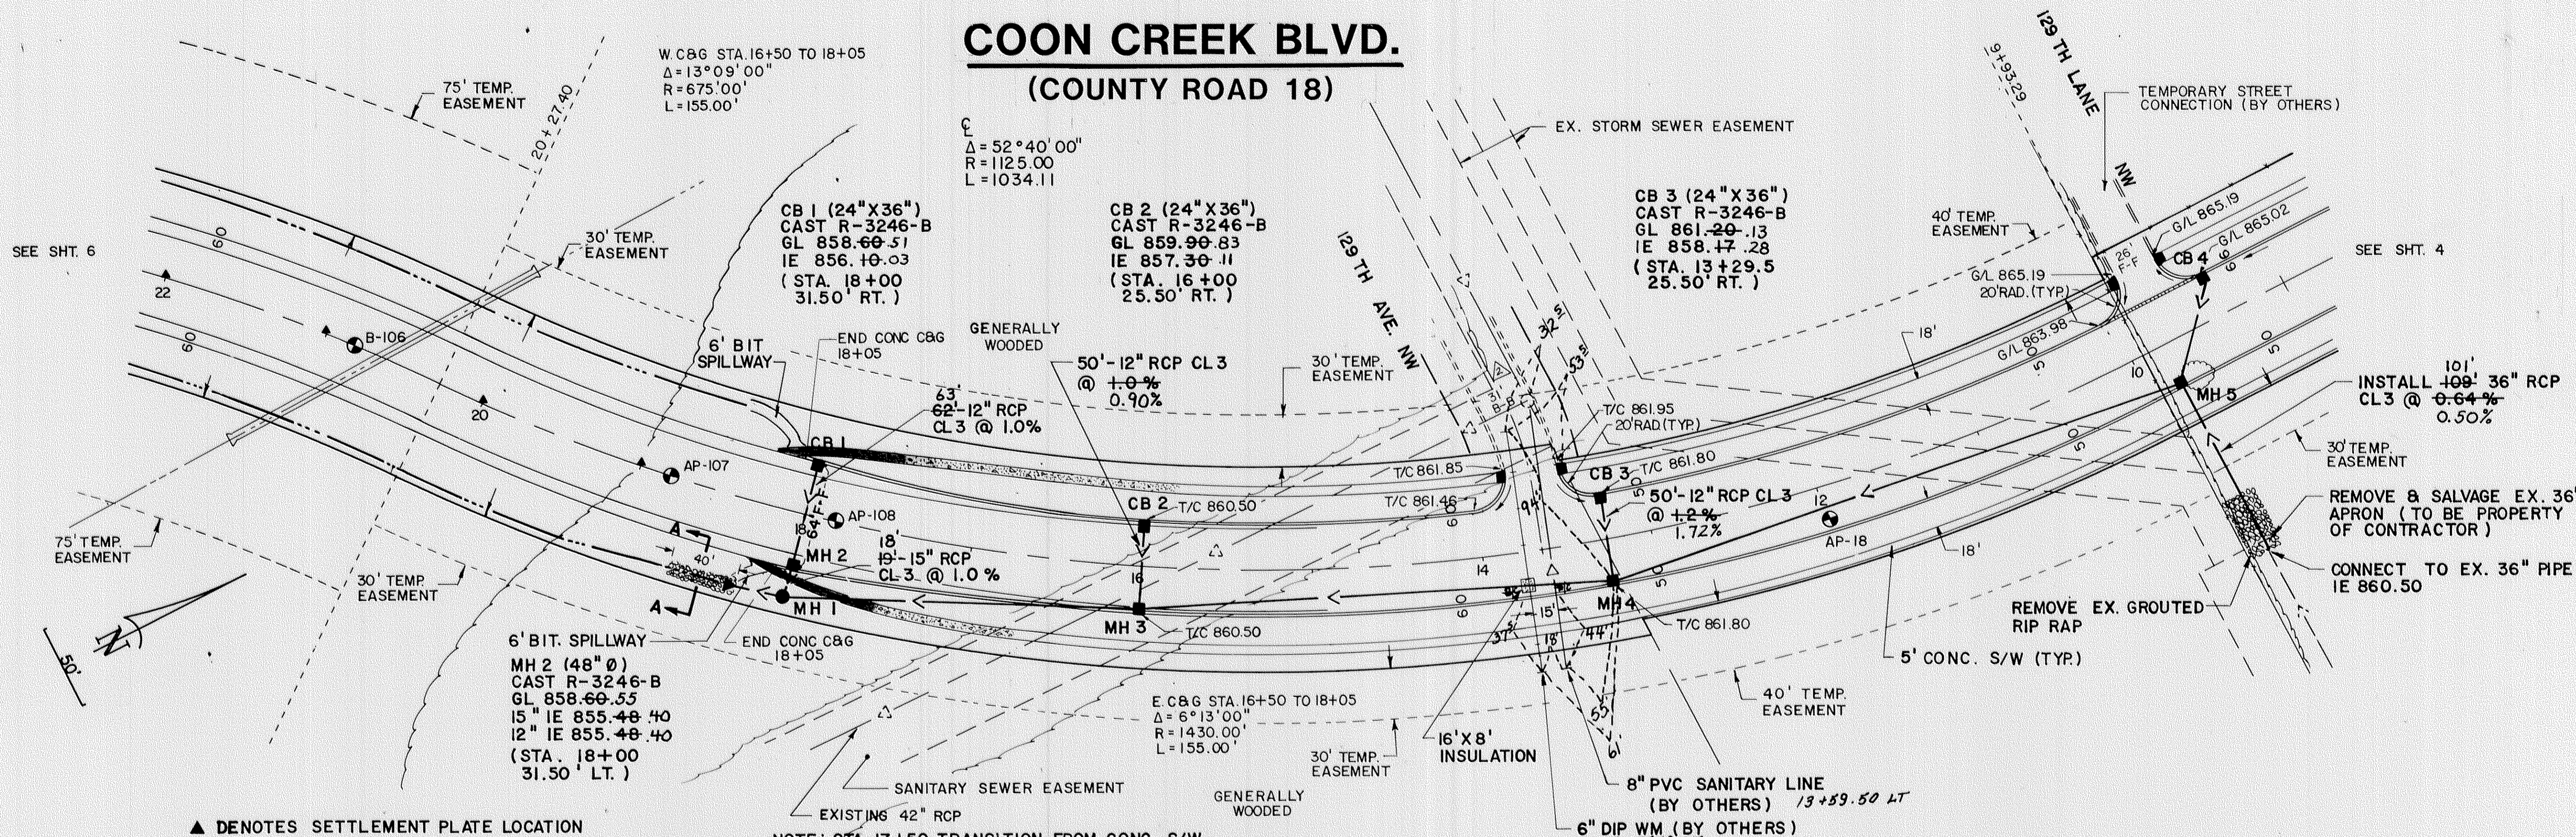

SECTION A-A

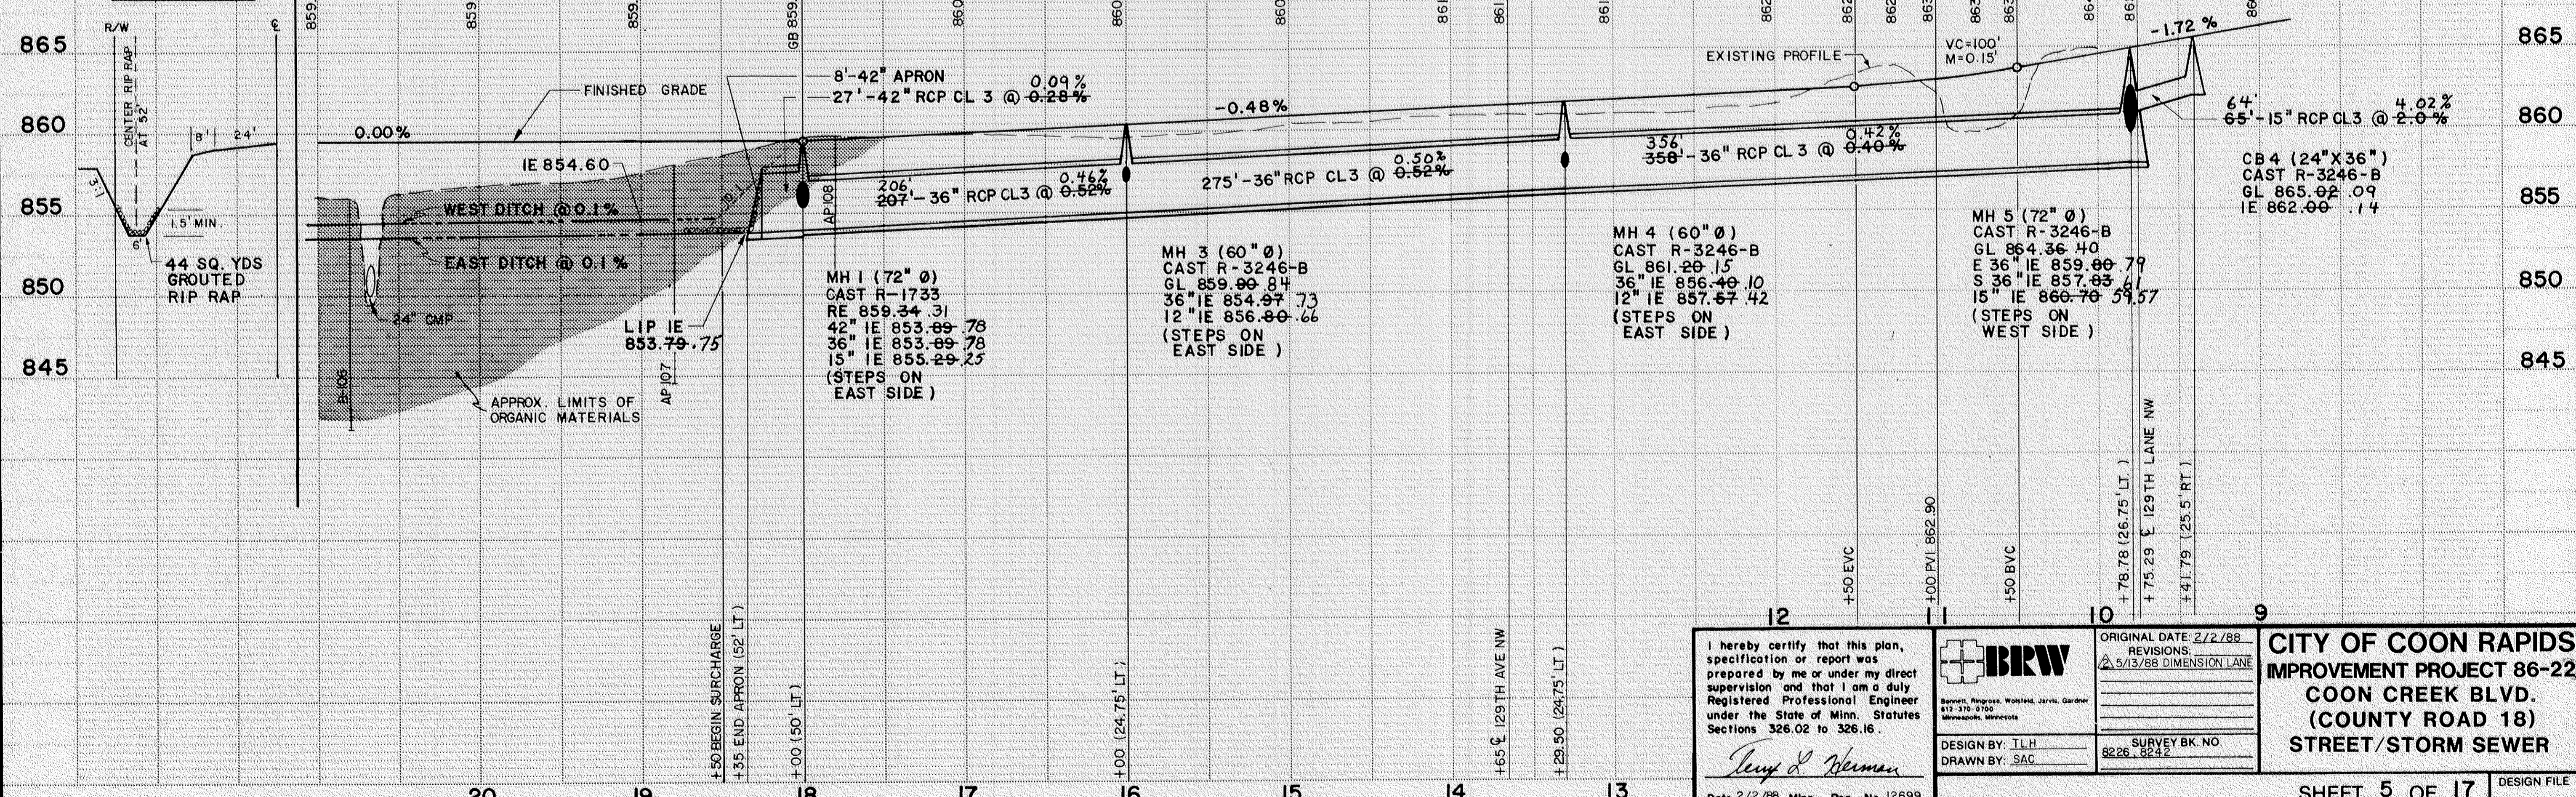

I hereby certify that this plan, specification or report was prepared by me or under my direct supervision and that I am a duly Registered Professional Engineer under the State of Minn. Statutes Sections 326.02 to 326.16.

*Tony A. Herman*

Date 2/2/88, Minn. Reg. No. 12699.

**BRW**  
 Bennett, Ringross, Wolfeld, Jarvis, Gardner  
 812-370-0700  
 Minneapolis, Minnesota

DESIGN BY: TLH  
 DRAWN BY: SAC

ORIGINAL DATE: 2/2/88	REVISIONS:
5/13/88 DIMENSION LANE	
SURVEY BK. NO. 8226, 8242	

**CITY OF COON RAPIDS**  
**IMPROVEMENT PROJECT 86-22**  
**COON CREEK BLVD.**  
**(COUNTY ROAD 18)**  
**STREET/STORM SEWER**


SHEET 5 OF 17  
 DESIGN FILE No. 16-8725



# COON CREEK BLVD.

(COUNTY ROAD 18)


NOTE: INSTALL E/W GUARDRAIL THRU SHOULDER SECTION - SEE CROSS SECTIONS FOR LOCATION. EXTEND PAVED SHOULDER SECTION TO EDGE OF SIDEWALK.

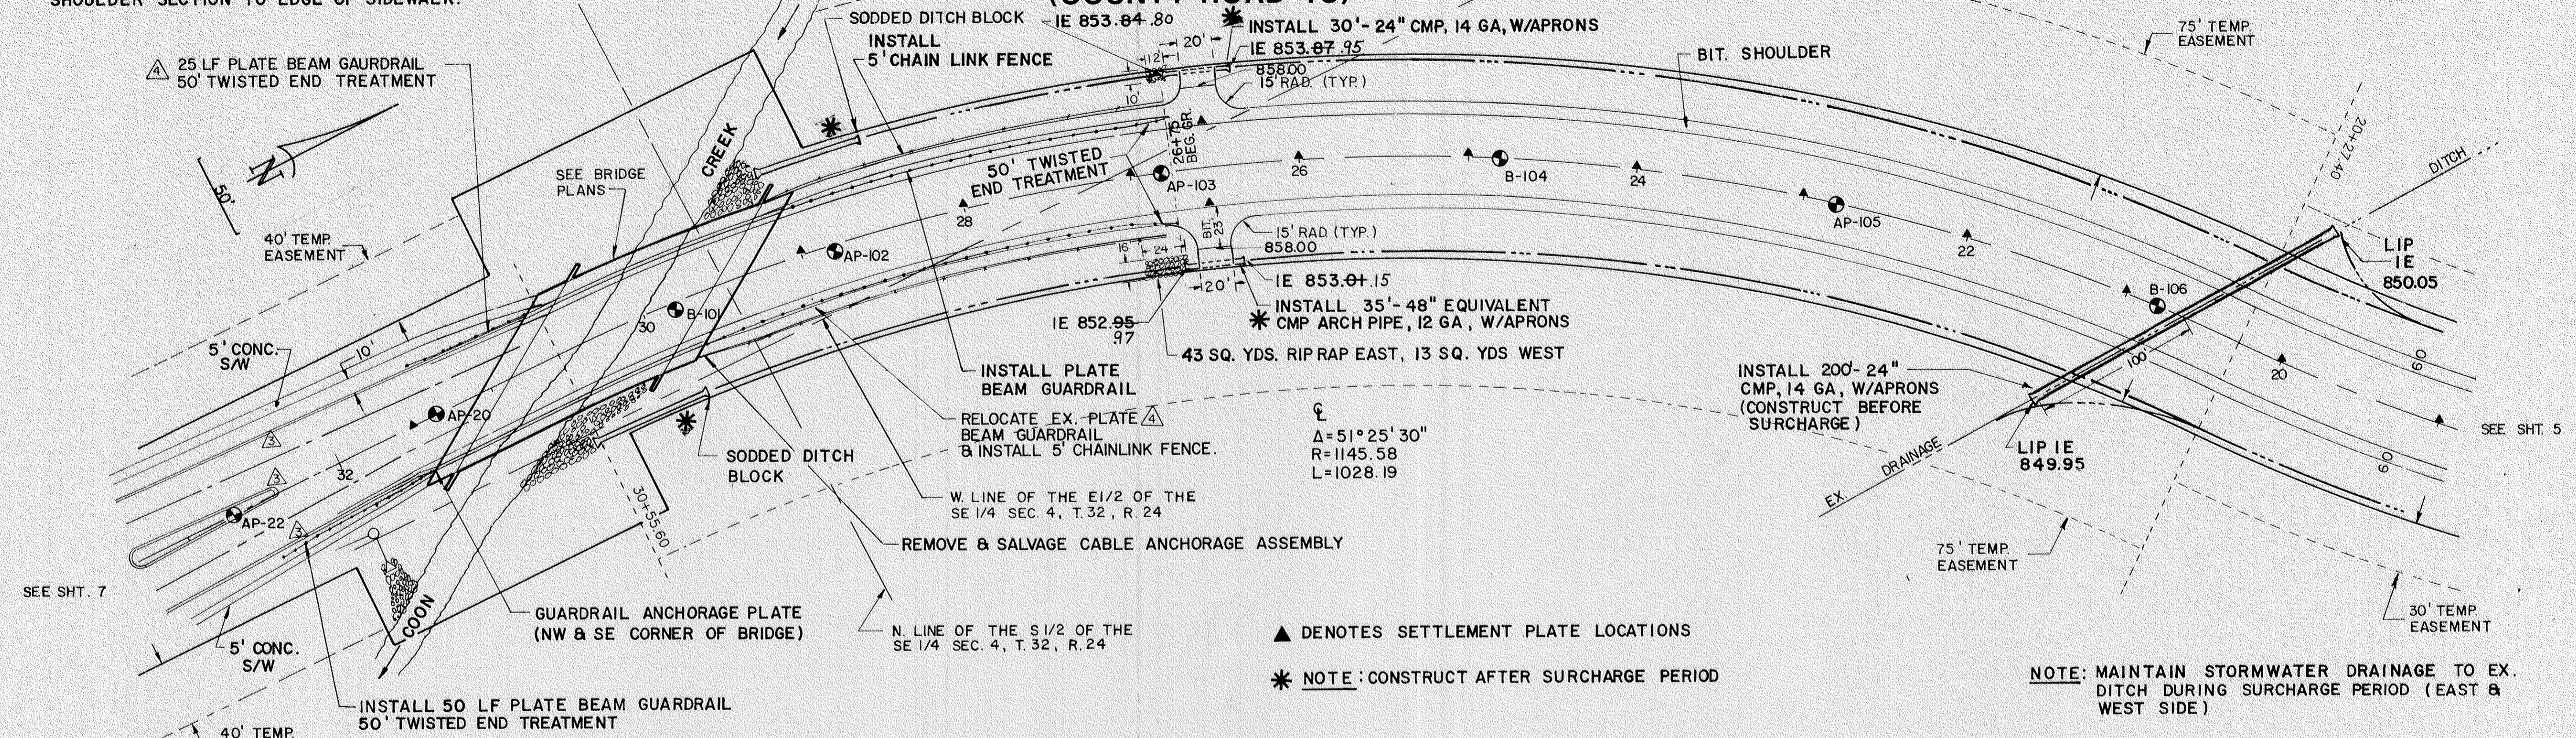

▲ DENOTES SETTLEMENT PLATE LOCATIONS

\* NOTE: CONSTRUCT AFTER SURCHARGE PERIOD

NOTE: MAINTAIN STORMWATER DRAINAGE TO EX. DITCH DURING SURCHARGE PERIOD (EAST & WEST SIDE)

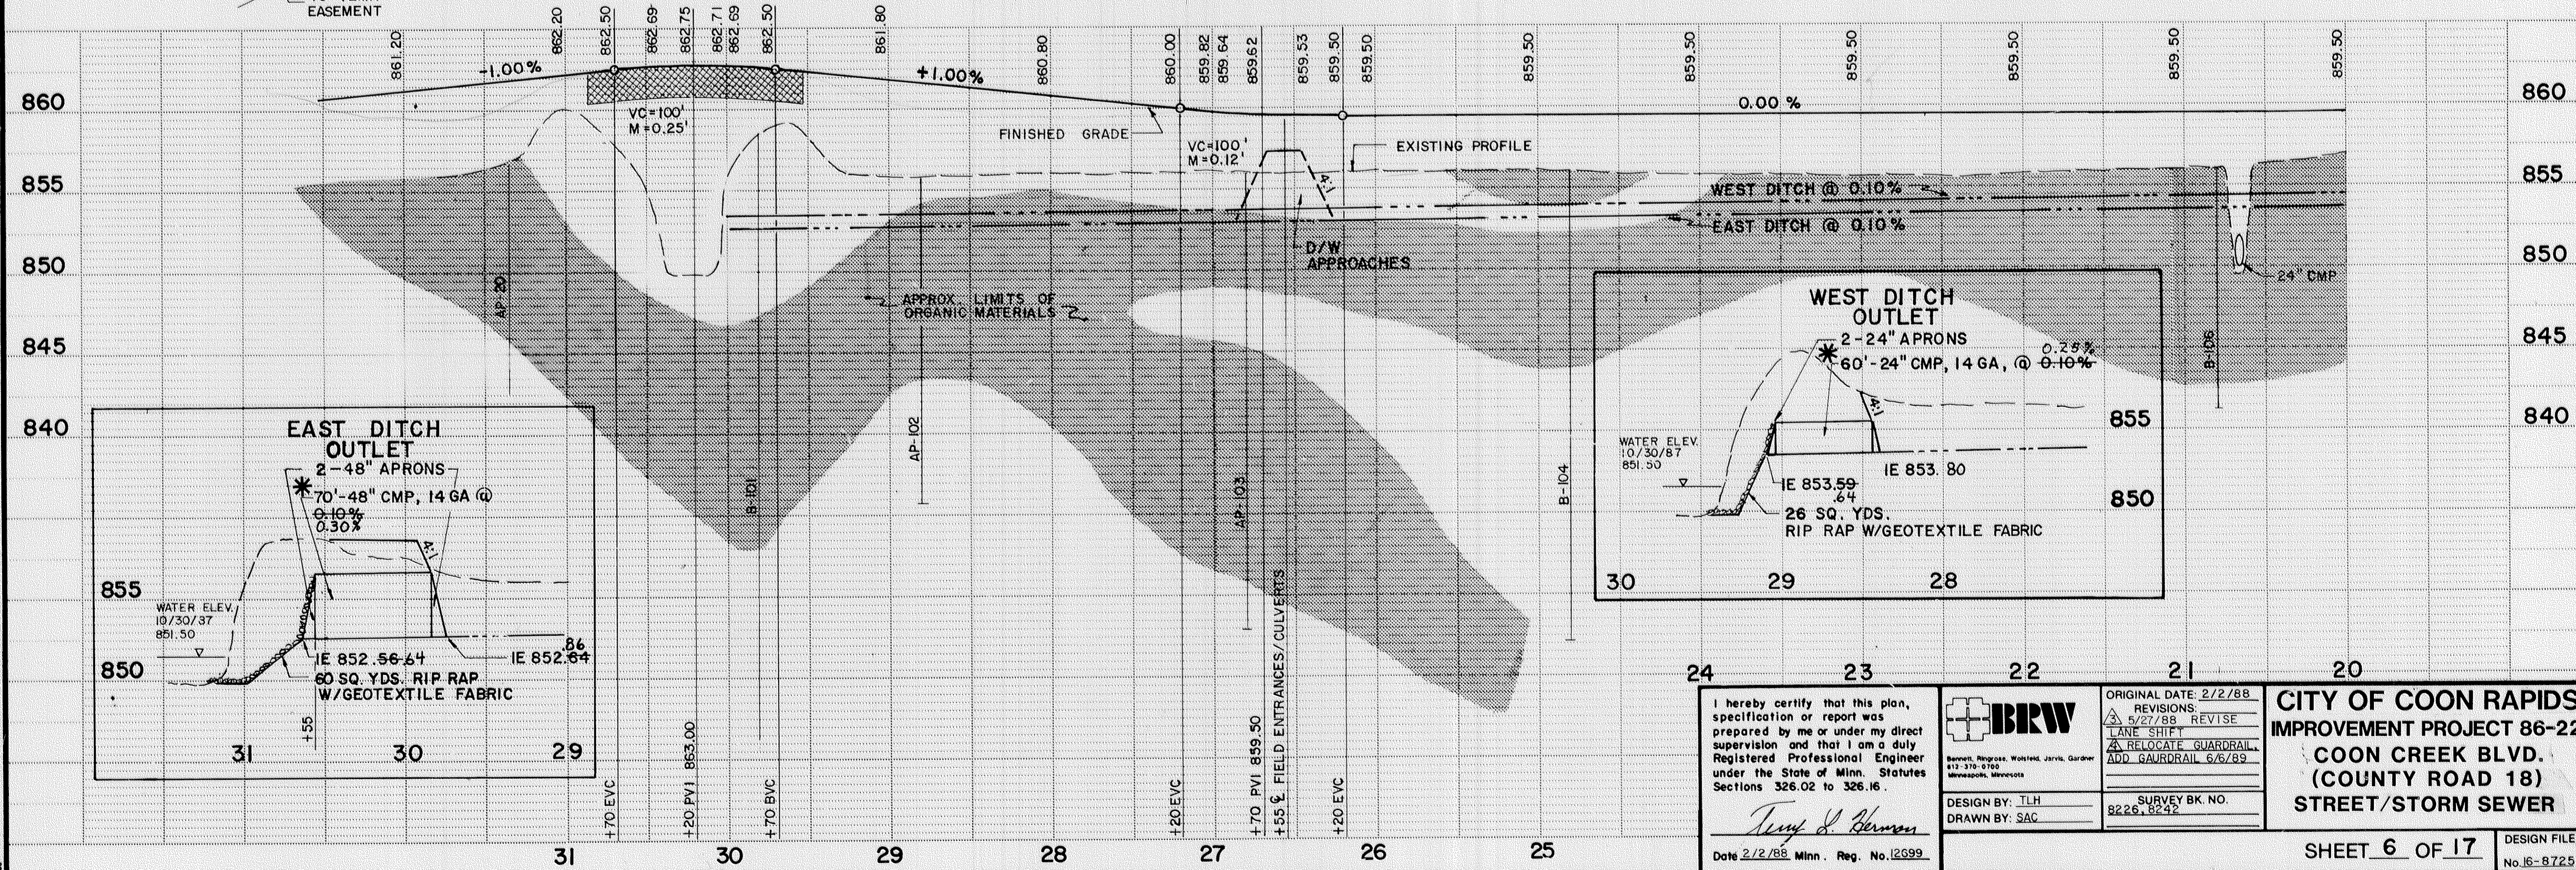

<p>I hereby certify that this plan, specification or report was prepared by me or under my direct supervision and that I am a duly Registered Professional Engineer under the State of Minn. Statutes Sections 326.02 to 326.16.</p> <p><i>Timothy J. Herman</i></p> <p>Date 2/2/88 Minn. Reg. No. 12699</p>	<p><b>BRW</b></p> <p>BRW Engineering, Inc. 112 3rd St. S. Mankato, Minnesota</p>	<p>ORIGINAL DATE: 2/2/88</p> <p>REVISIONS:</p> <p>5/27/88 REVISION</p> <p>LANE SHIFT</p> <p>RELOCATE GUARDRAIL</p> <p>ADD GUARDRAIL 6/6/89</p>	<p><b>CITY OF COON RAPIDS</b></p> <p><b>IMPROVEMENT PROJECT 86-22</b></p> <p><b>COON CREEK BLVD.</b></p> <p><b>(COUNTY ROAD 18)</b></p> <p><b>STREET/STORM SEWER</b></p>	
		<p>DESIGN BY: TLH</p> <p>DRAWN BY: SAC</p>		<p>SURVEY BK. NO.</p> <p>8226, 8242</p>
		<p>SHEET <b>6</b> OF <b>17</b></p>		

COON CREEK BLVD. IMPROVEMENT PROJECT  
 PLAN SHEET 6 OF 17  
 DATE 2/2/88



# COON CREEK BLVD. (COUNTY ROAD 18)

CB 5 (24" X 36")  
CAST R-3246-B  
GL 859.11 58.87  
IE 856.04 55.94  
(65.0' RT.)

CB 6 (48" Ø)  
CAST R-3246-B  
GL 859.03  
IE 852.67


MH 8 (48" Ø)  
CAST R-3246-B  
GL 859.11 58.87  
15" IE 855.25 .14  
12" IE 855.75 .59  
(65.0' LT.)

INSTALL 140 LF-20" DIP CL 52 W/PLUGS FOR FUTURE WM (8.5' MIN. COVER)

FILL WITH 4.5" SAND & 1.5" WEAR COURSE


REVERSE GUTTER (SEE DETAIL)

STATE TRUNK HWY. NO. 242  
SEE SHT. 8



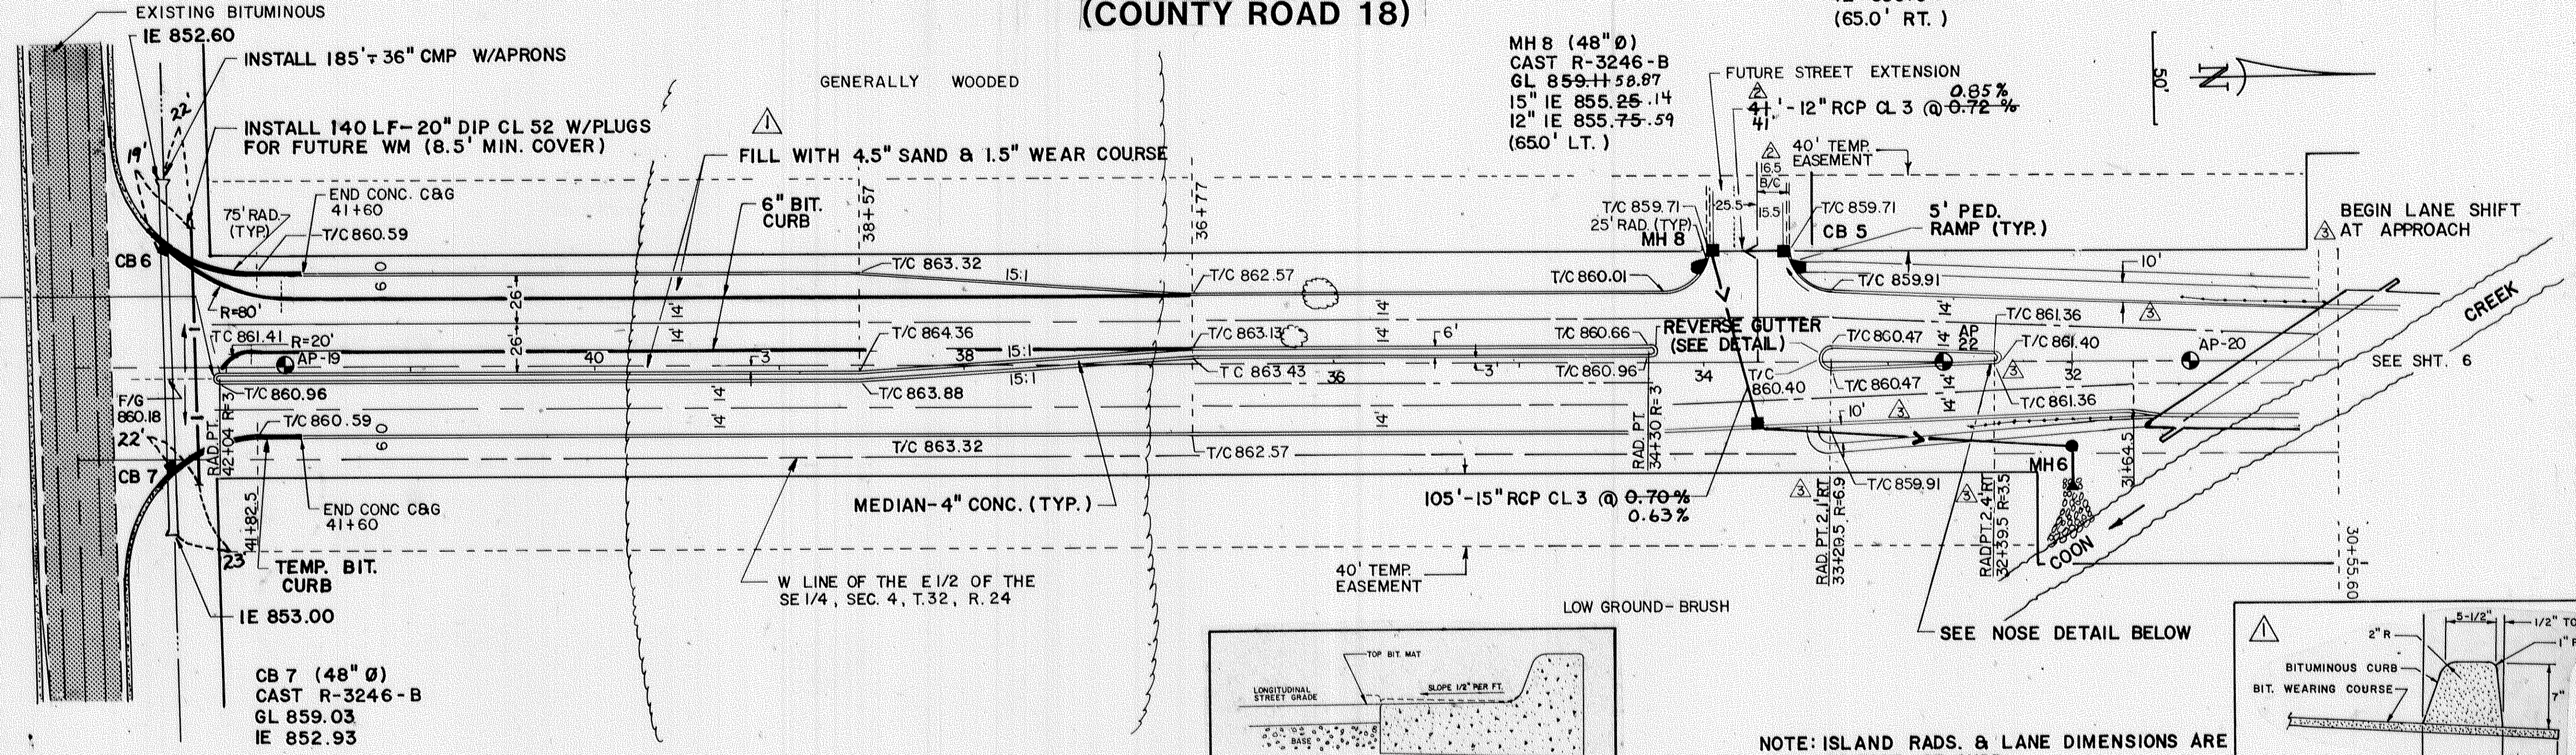


NOTE: CONSTRUCT CB 6 & CB 7 1' FROM BACK OF CURB, CENTERED OVER CULVERT.

NOTE: PROFILE ELEVATIONS EQUAL OUTSIDE TOP OF CURB ELEVATIONS - SEE TYPICAL SECTIONS

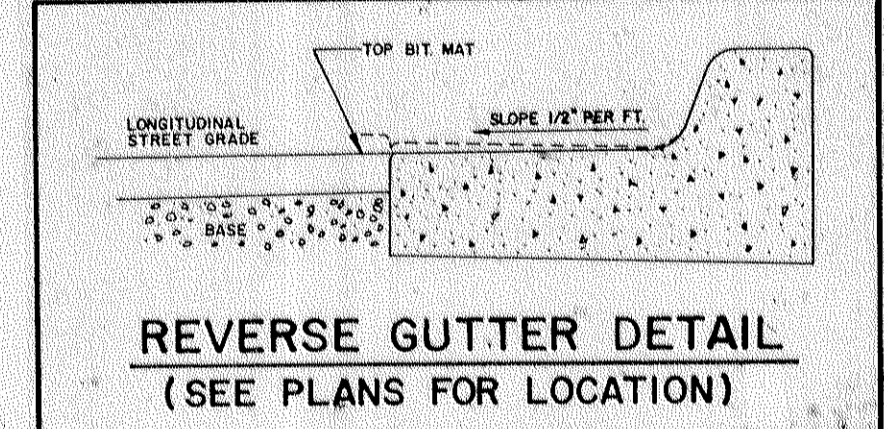

NOTE: ISLAND RAD. & LANE DIMENSIONS ARE TO FACE OF CURB

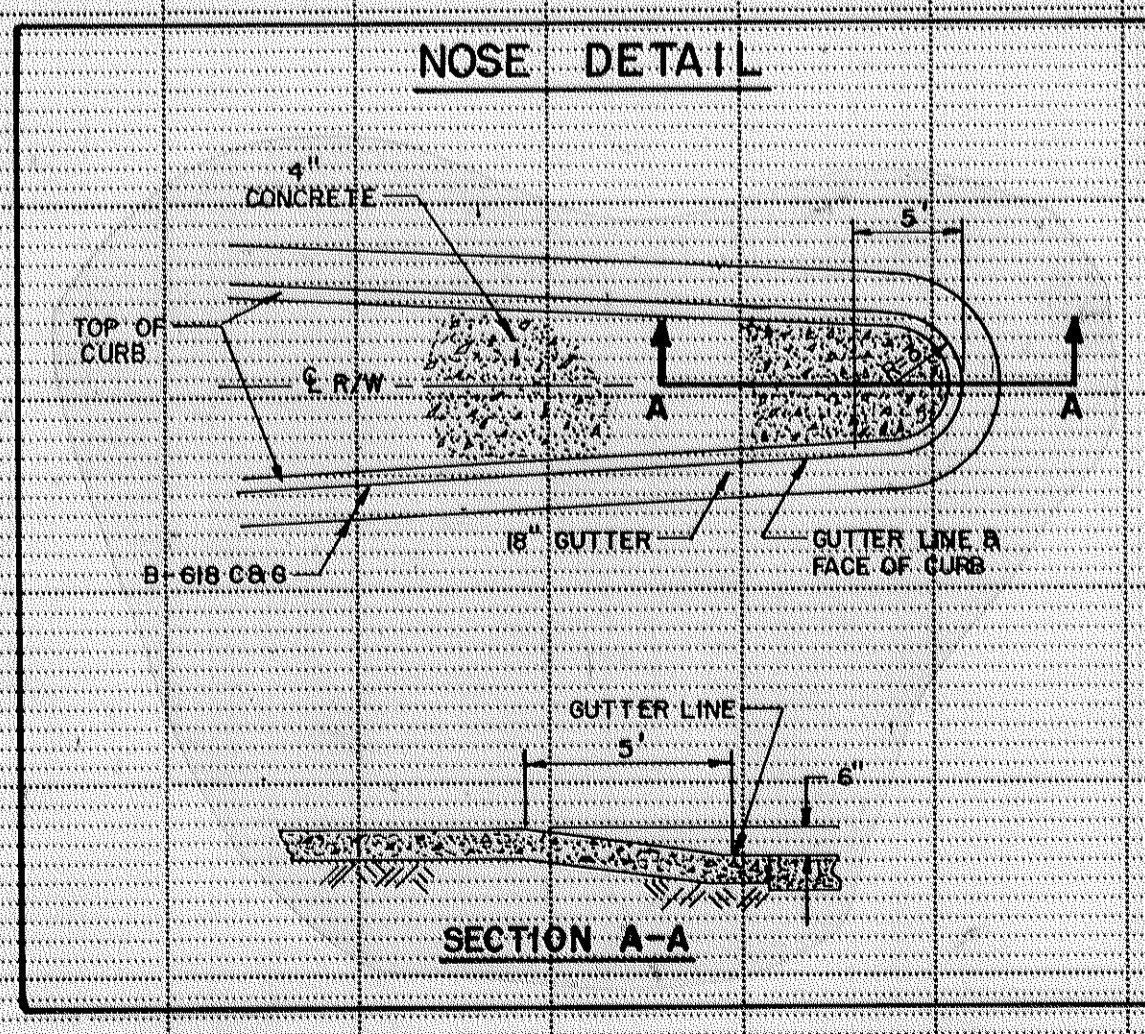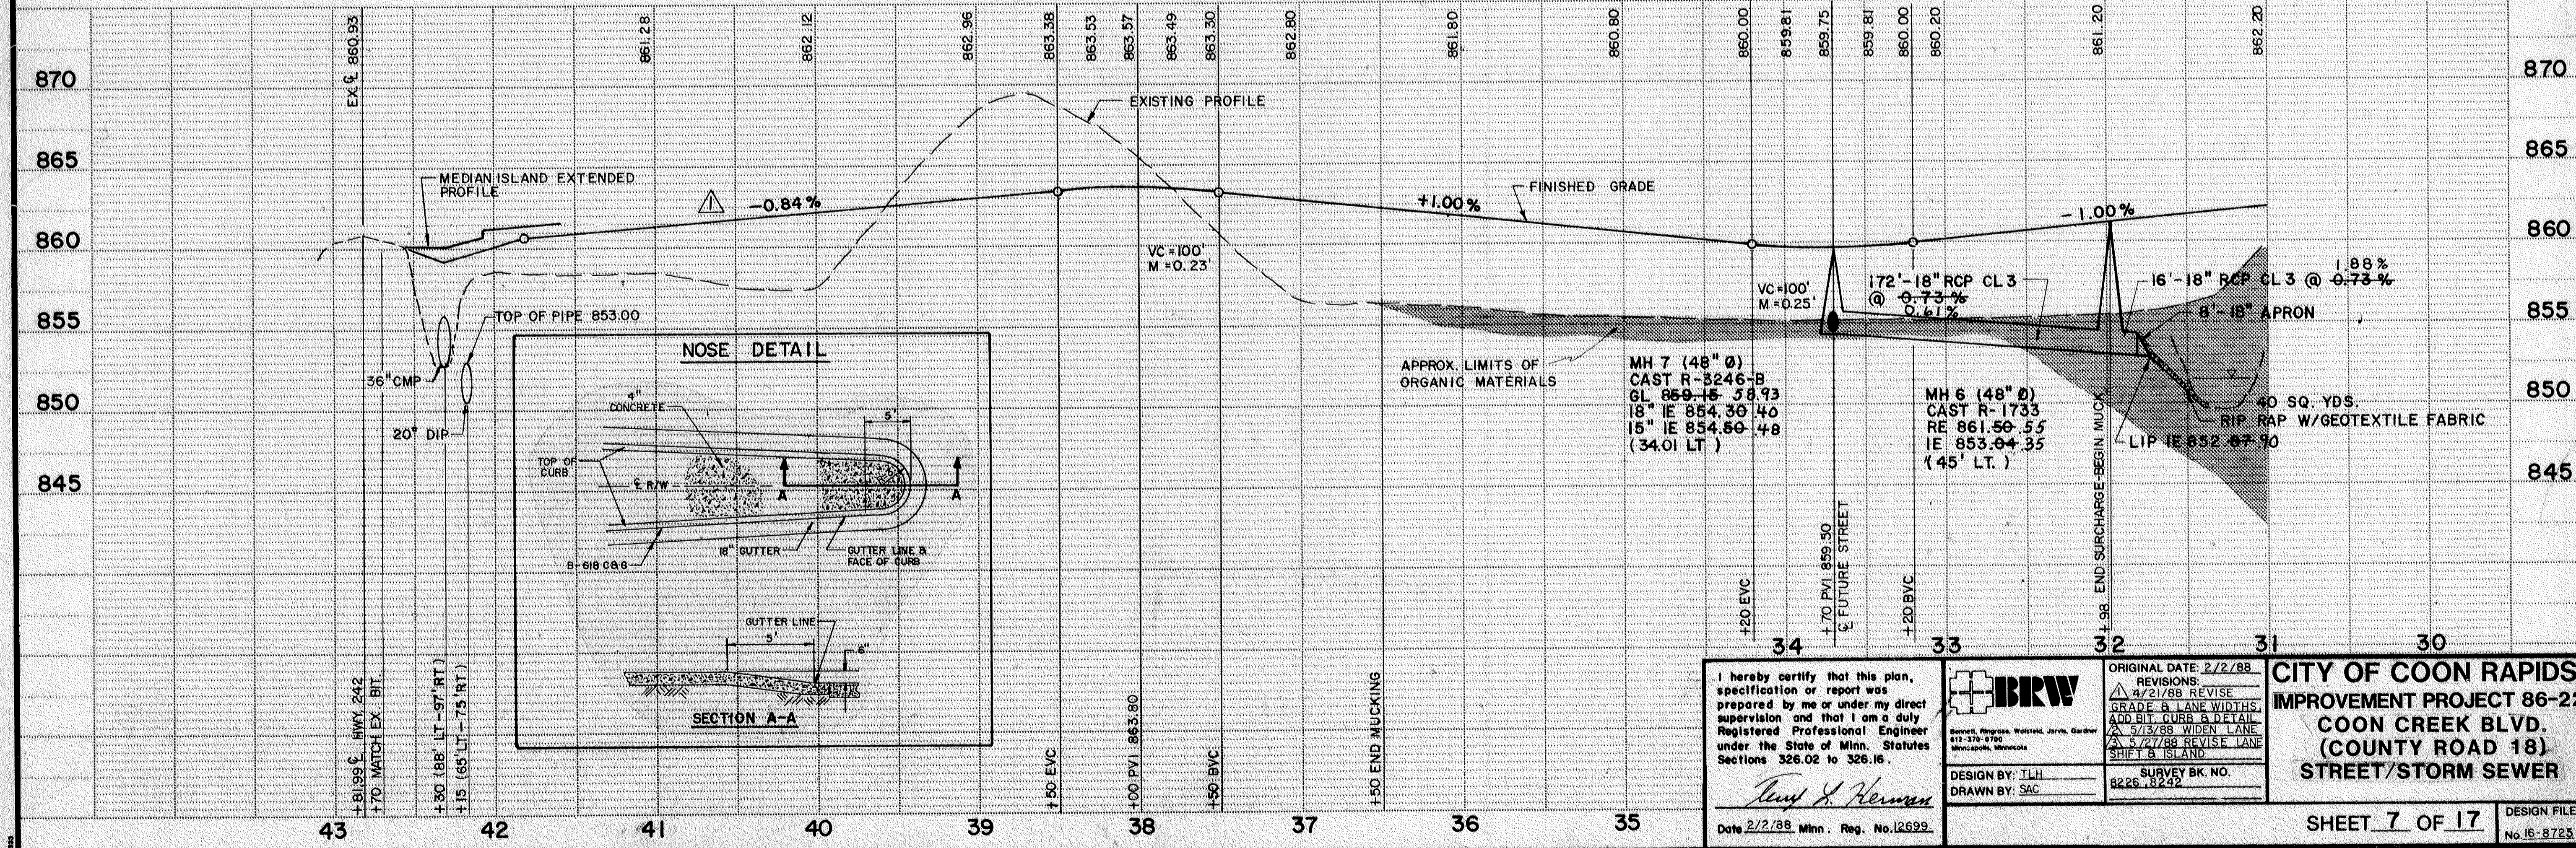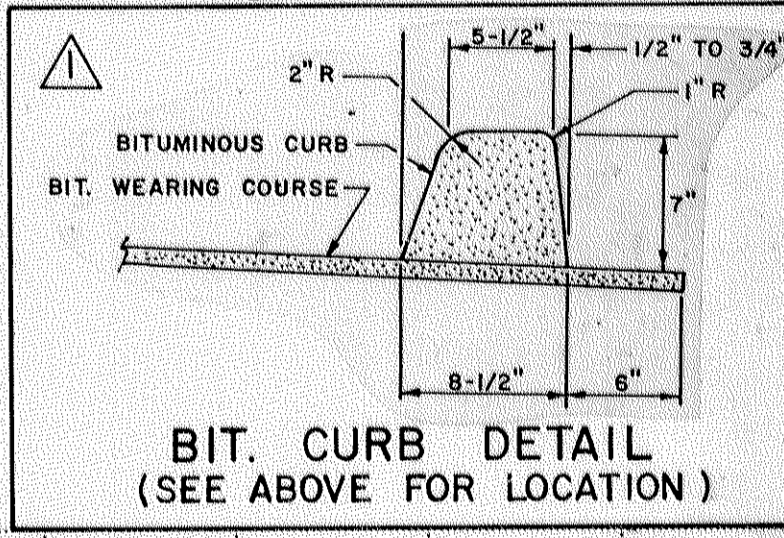

I hereby certify that this plan, specification or report was prepared by me or under my direct supervision and that I am a duly Registered Professional Engineer under the State of Minn. Statutes Sections 326.02 to 326.16.

*Ray S. Herman*  
Date 2/2/88 Minn. Reg. No. 12699

**BRW**  
Bennett, Bergquist, Wohlford, Jarvis, Gardner  
812 370 4700  
Minneapolis, Minnesota

DESIGN BY: TLH  
DRAWN BY: SAC

ORIGINAL DATE: 2/2/88  
REVISIONS:  
4/21/88 REVISE GRADE & LANE WIDTHS, ADD BIT CURB & DETAIL  
5/13/88 WIDEN LANE  
5/27/88 REVISE LANE SHIFT & ISLAND

SURVEY BK. NO. 8226, 18242


**CITY OF COON RAPIDS**  
IMPROVEMENT PROJECT 86-22  
COON CREEK BLVD.  
(COUNTY ROAD 18)  
STREET/STORM SEWER

SHEET 7 OF 17


DESIGN FILE No. 16-8725



# STATE TRUNK HWY. NO. 242

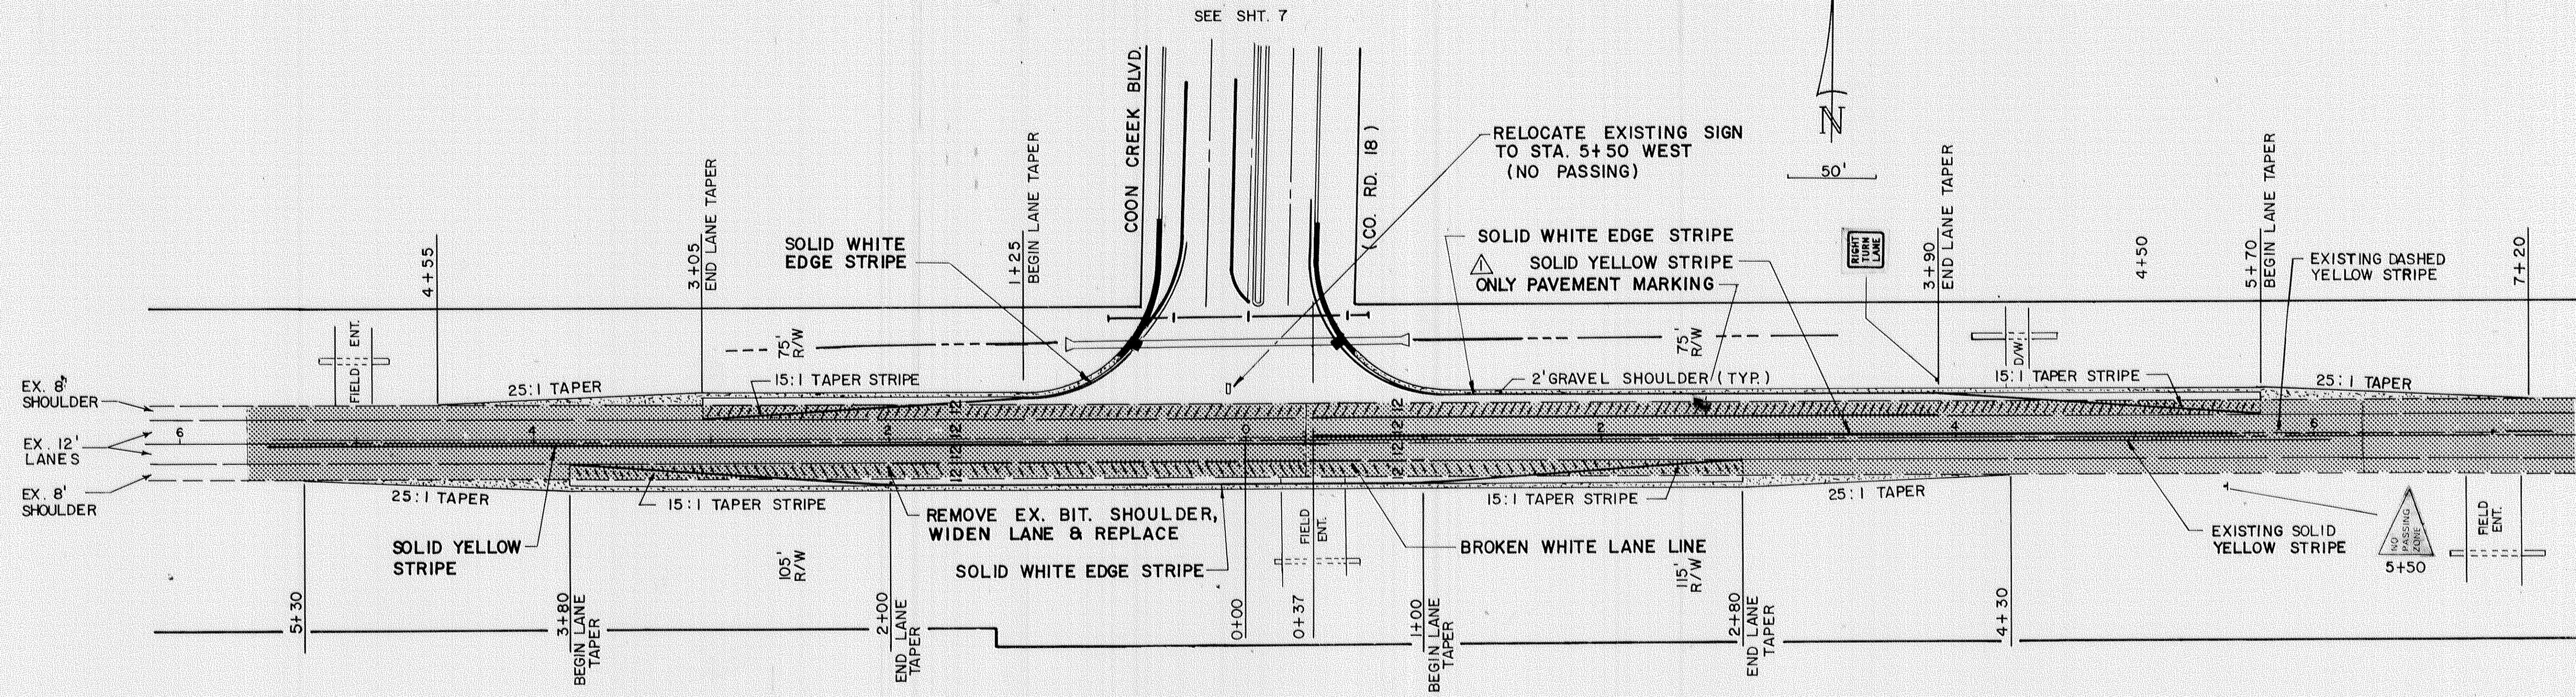

NOTE: CONTRACTOR SHALL BLACK OUT ALL EXISTING STRIPING WHICH IS NOT IN CONFORMANCE WITH THIS LAYOUT.

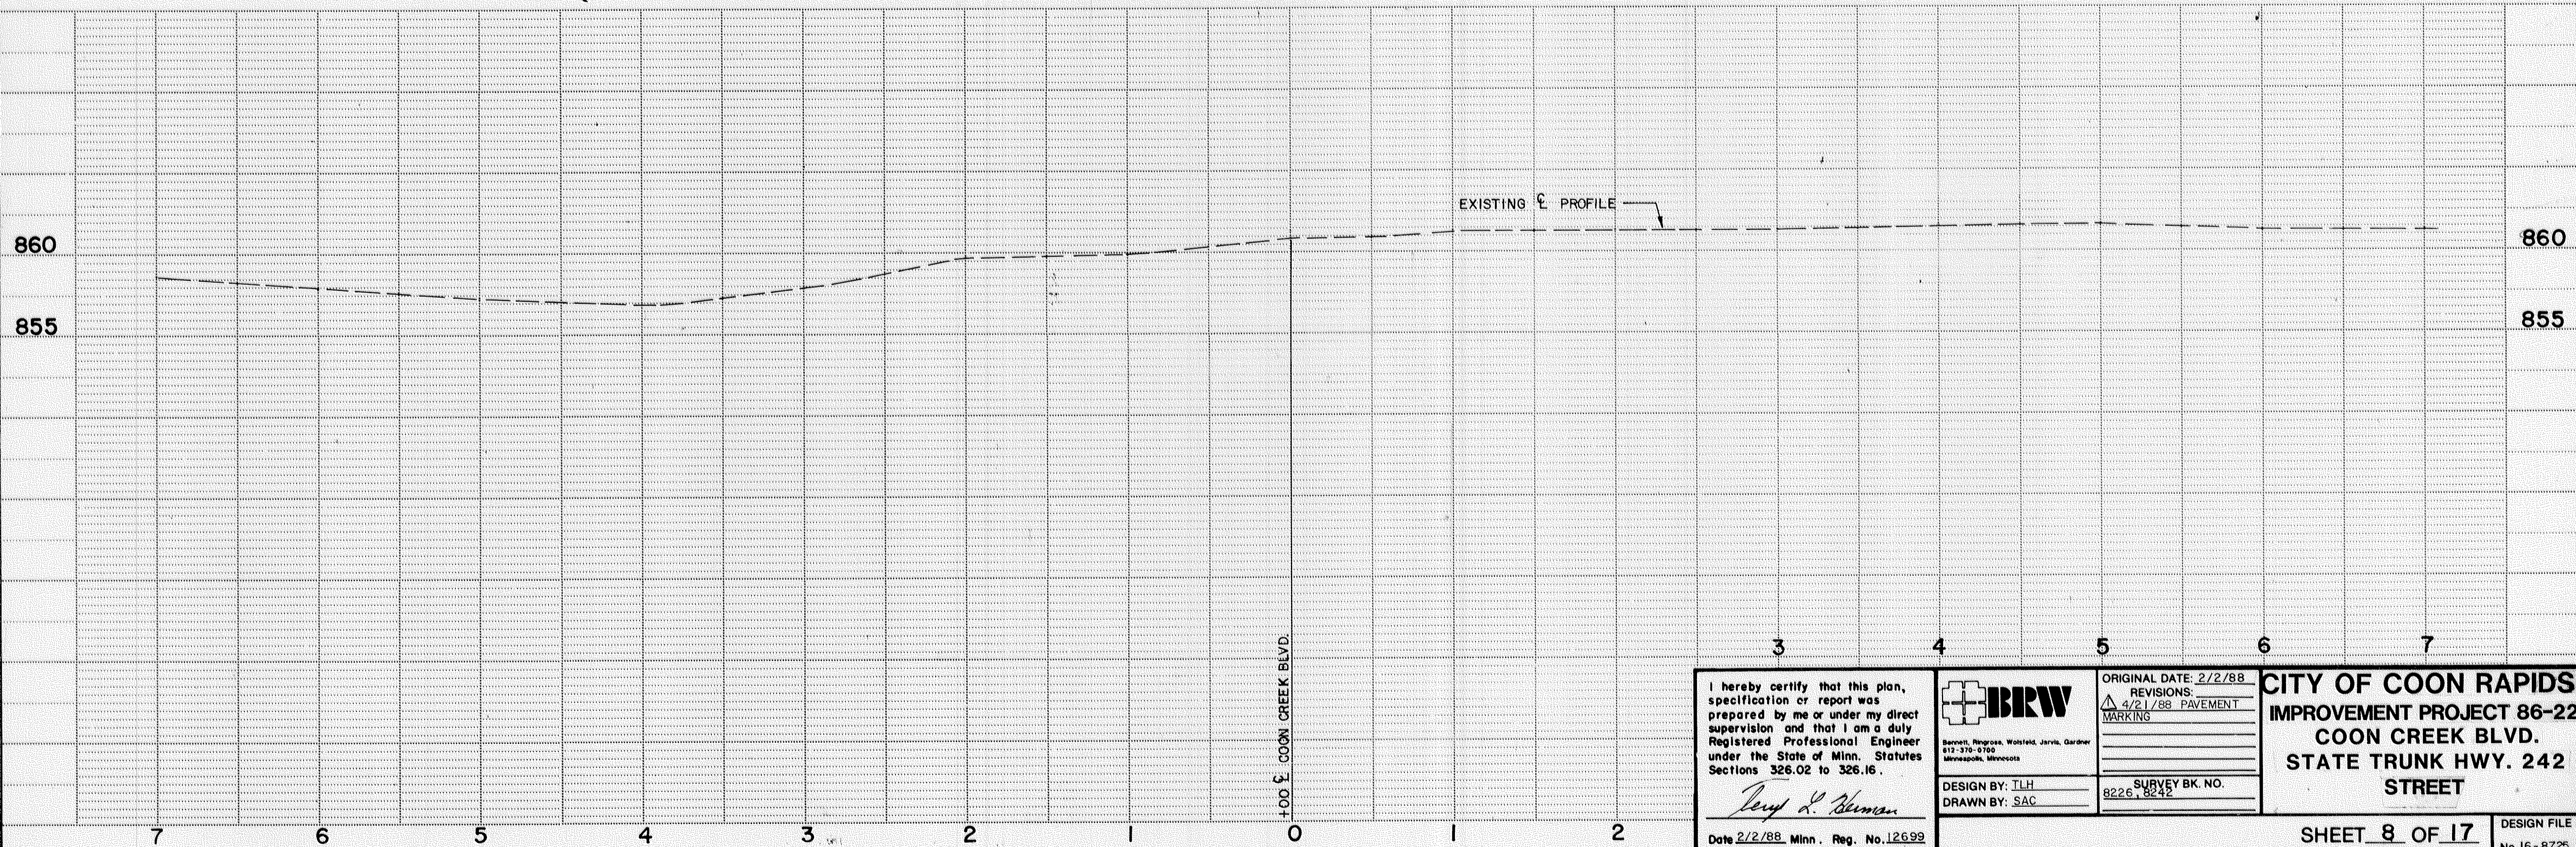

I hereby certify that this plan, specification or report was prepared by me or under my direct supervision and that I am a duly Registered Professional Engineer under the State of Minn. Statutes Sections 326.02 to 326.16.

*Ray L. Skuman*

Date 2/2/88, Minn. Reg. No. 12699

**BRW**

Barnett, Ringrose, Wolford, Jarvis, Gardner  
817-378-0788  
Minneapolis, Minnesota

DESIGN BY: TLH  
DRAWN BY: SAC

ORIGINAL DATE: 2/2/88
REVISIONS:
4/21/88 PAVEMENT MARKING
SURVEY BK. NO. 8226, 8242




**CITY OF COON RAPIDS**  
IMPROVEMENT PROJECT 86-22  
COON CREEK BLVD.  
STATE TRUNK HWY. 242  
STREET

SHEET 8 OF 17

DESIGN FILE No. 16-8725




COON RAPIDS  
 DESIGNING & STRIPING 2 of 17

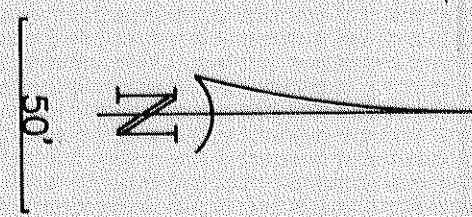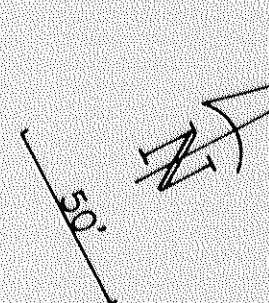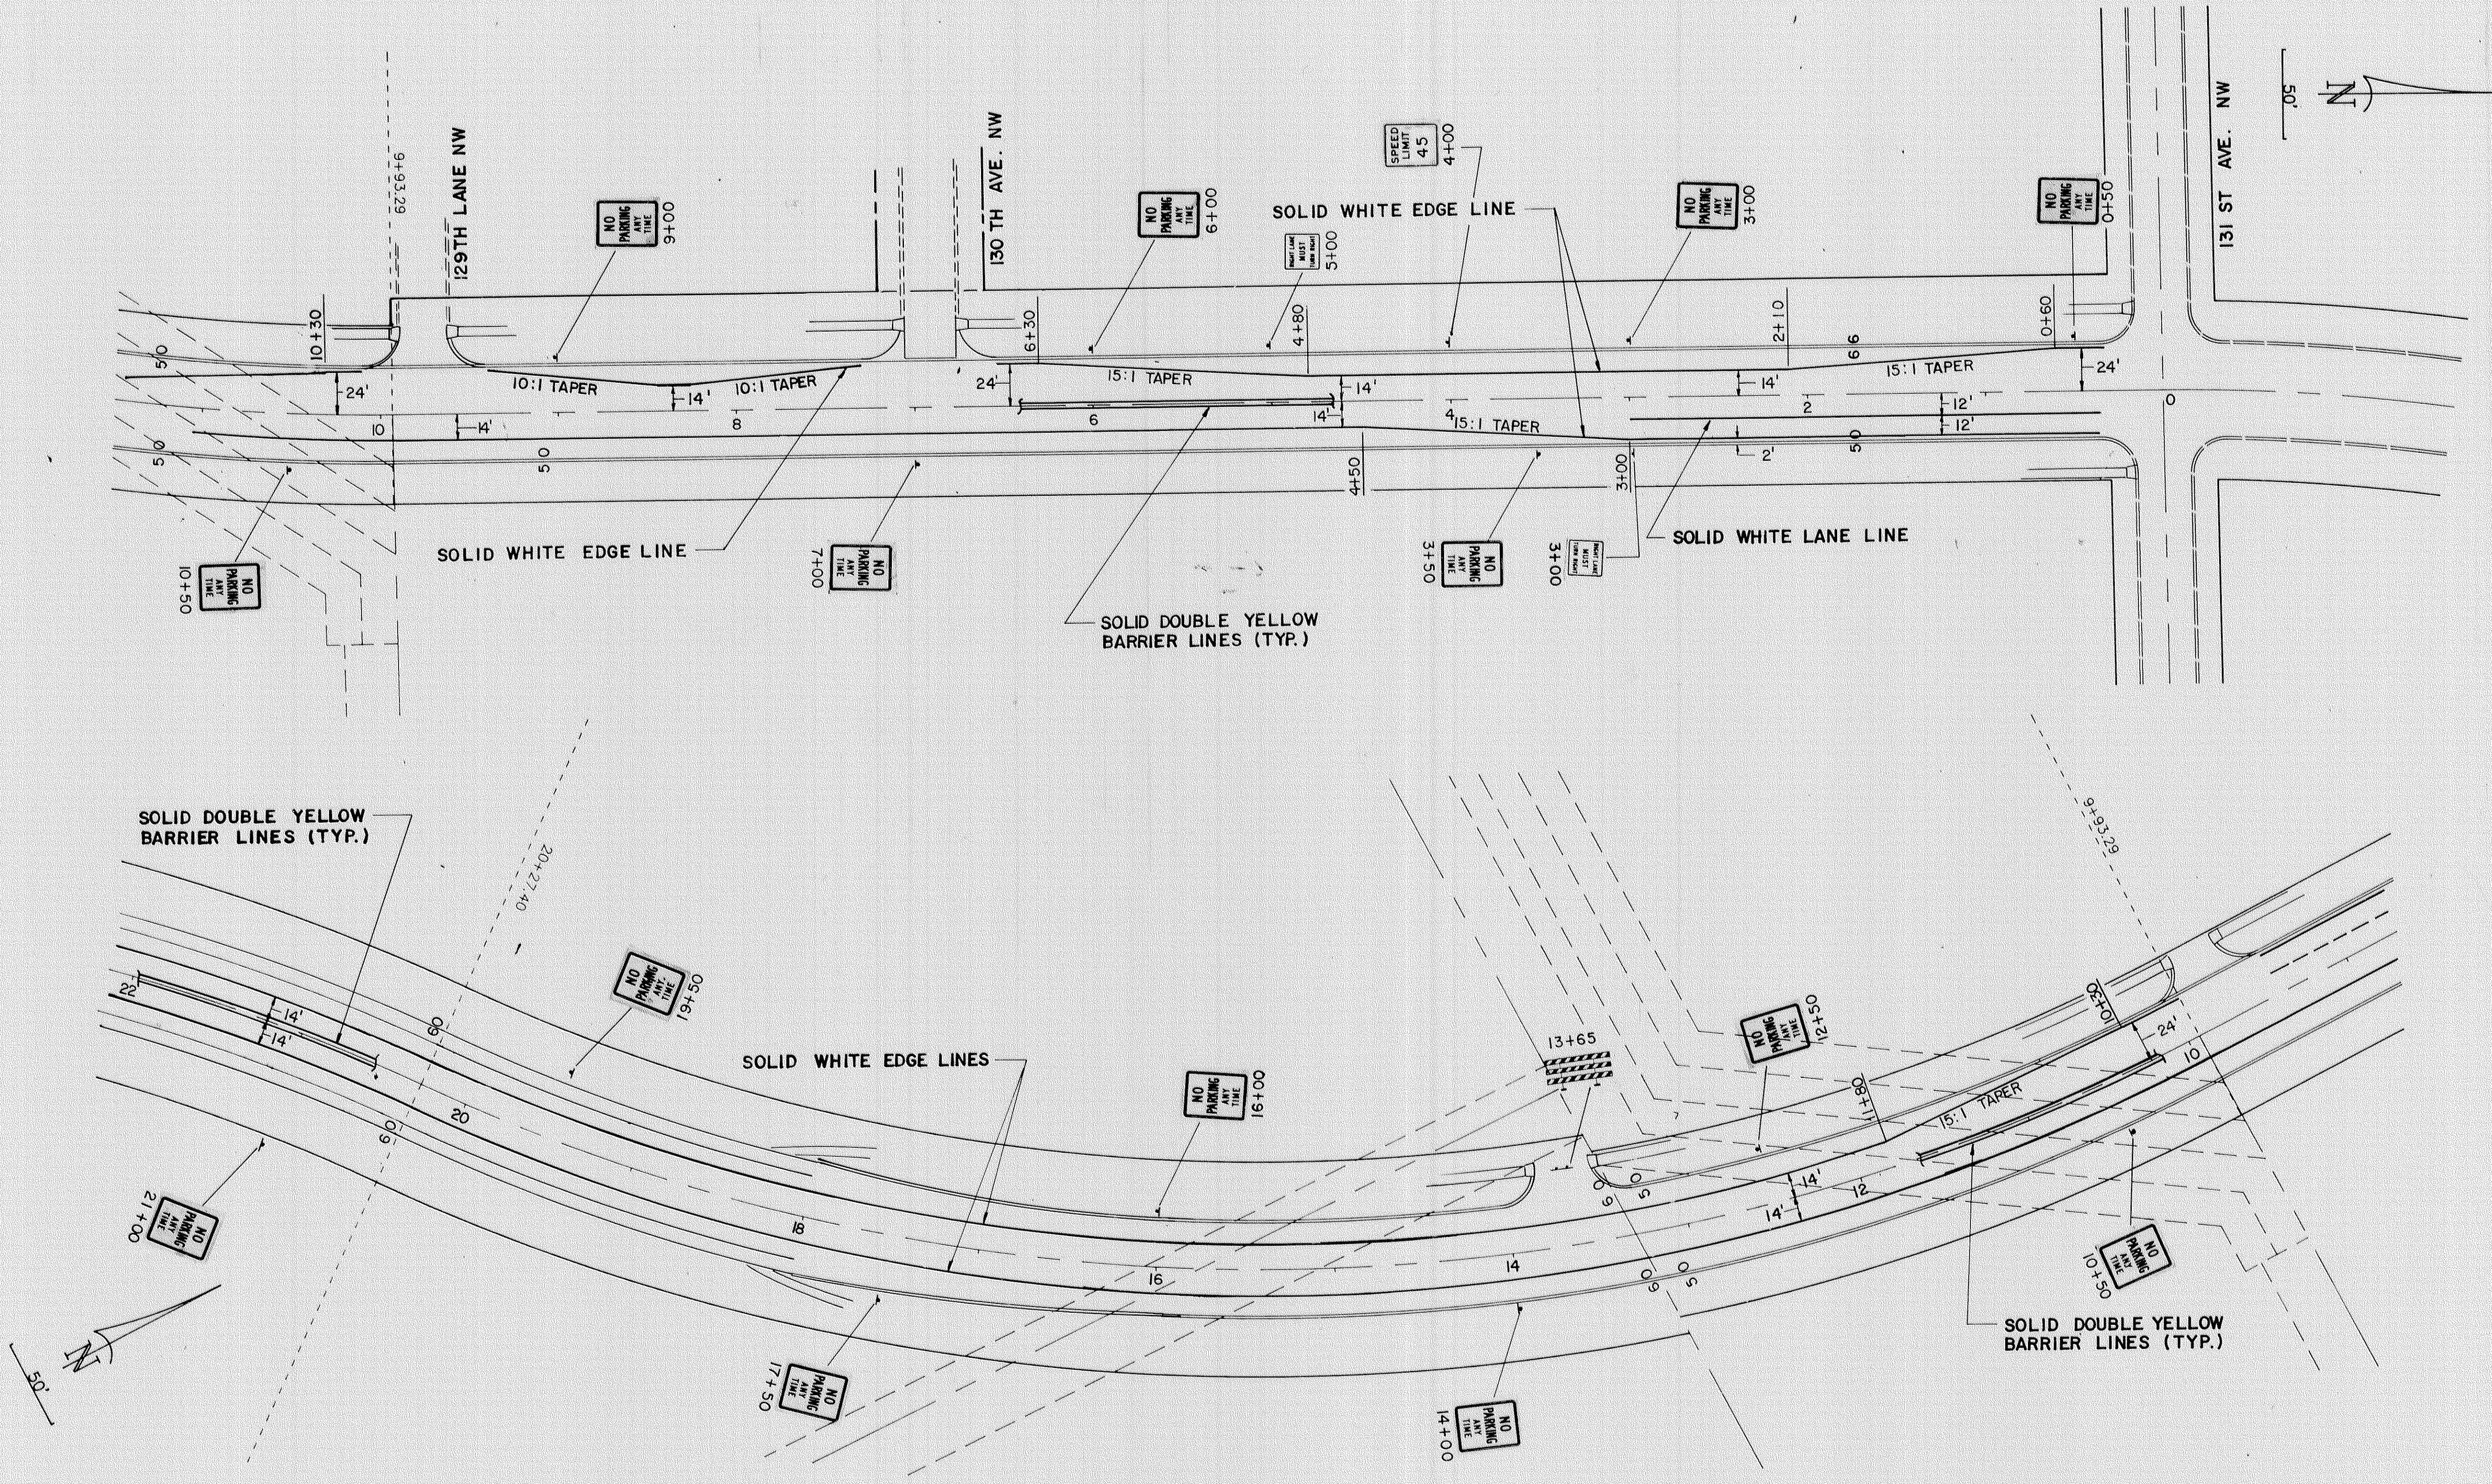

I hereby certify that this plan, specification or report was prepared by me or under my direct supervision and that I am a duly Registered Professional Engineer under the State of Minn. Statutes Sections 326.02 to 326.16.  <i>Terry L. Herman</i> Date 2/2/88 Minn. Reg. No. 12699		ORIGINAL DATE 2/2/88 REVISIONS _____	<b>CITY OF COON RAPIDS</b> <b>IMPROVEMENT PROJECT 86-22</b> <b>COON CREEK BLVD.</b> <b>(COUNTY ROAD 18)</b> <b>SIGNING &amp; STRIPING</b>
		DESIGN BY: TLH DRAWN BY: SAC CHECKED BY: _____	
S.A.P. NO. _____		SHEET 9 OF 17	
		DESIGN FILE No. 16-8725	



ROADWAY SIGNING & STRIPING NO. OF 14  
 DATE 8/10/89

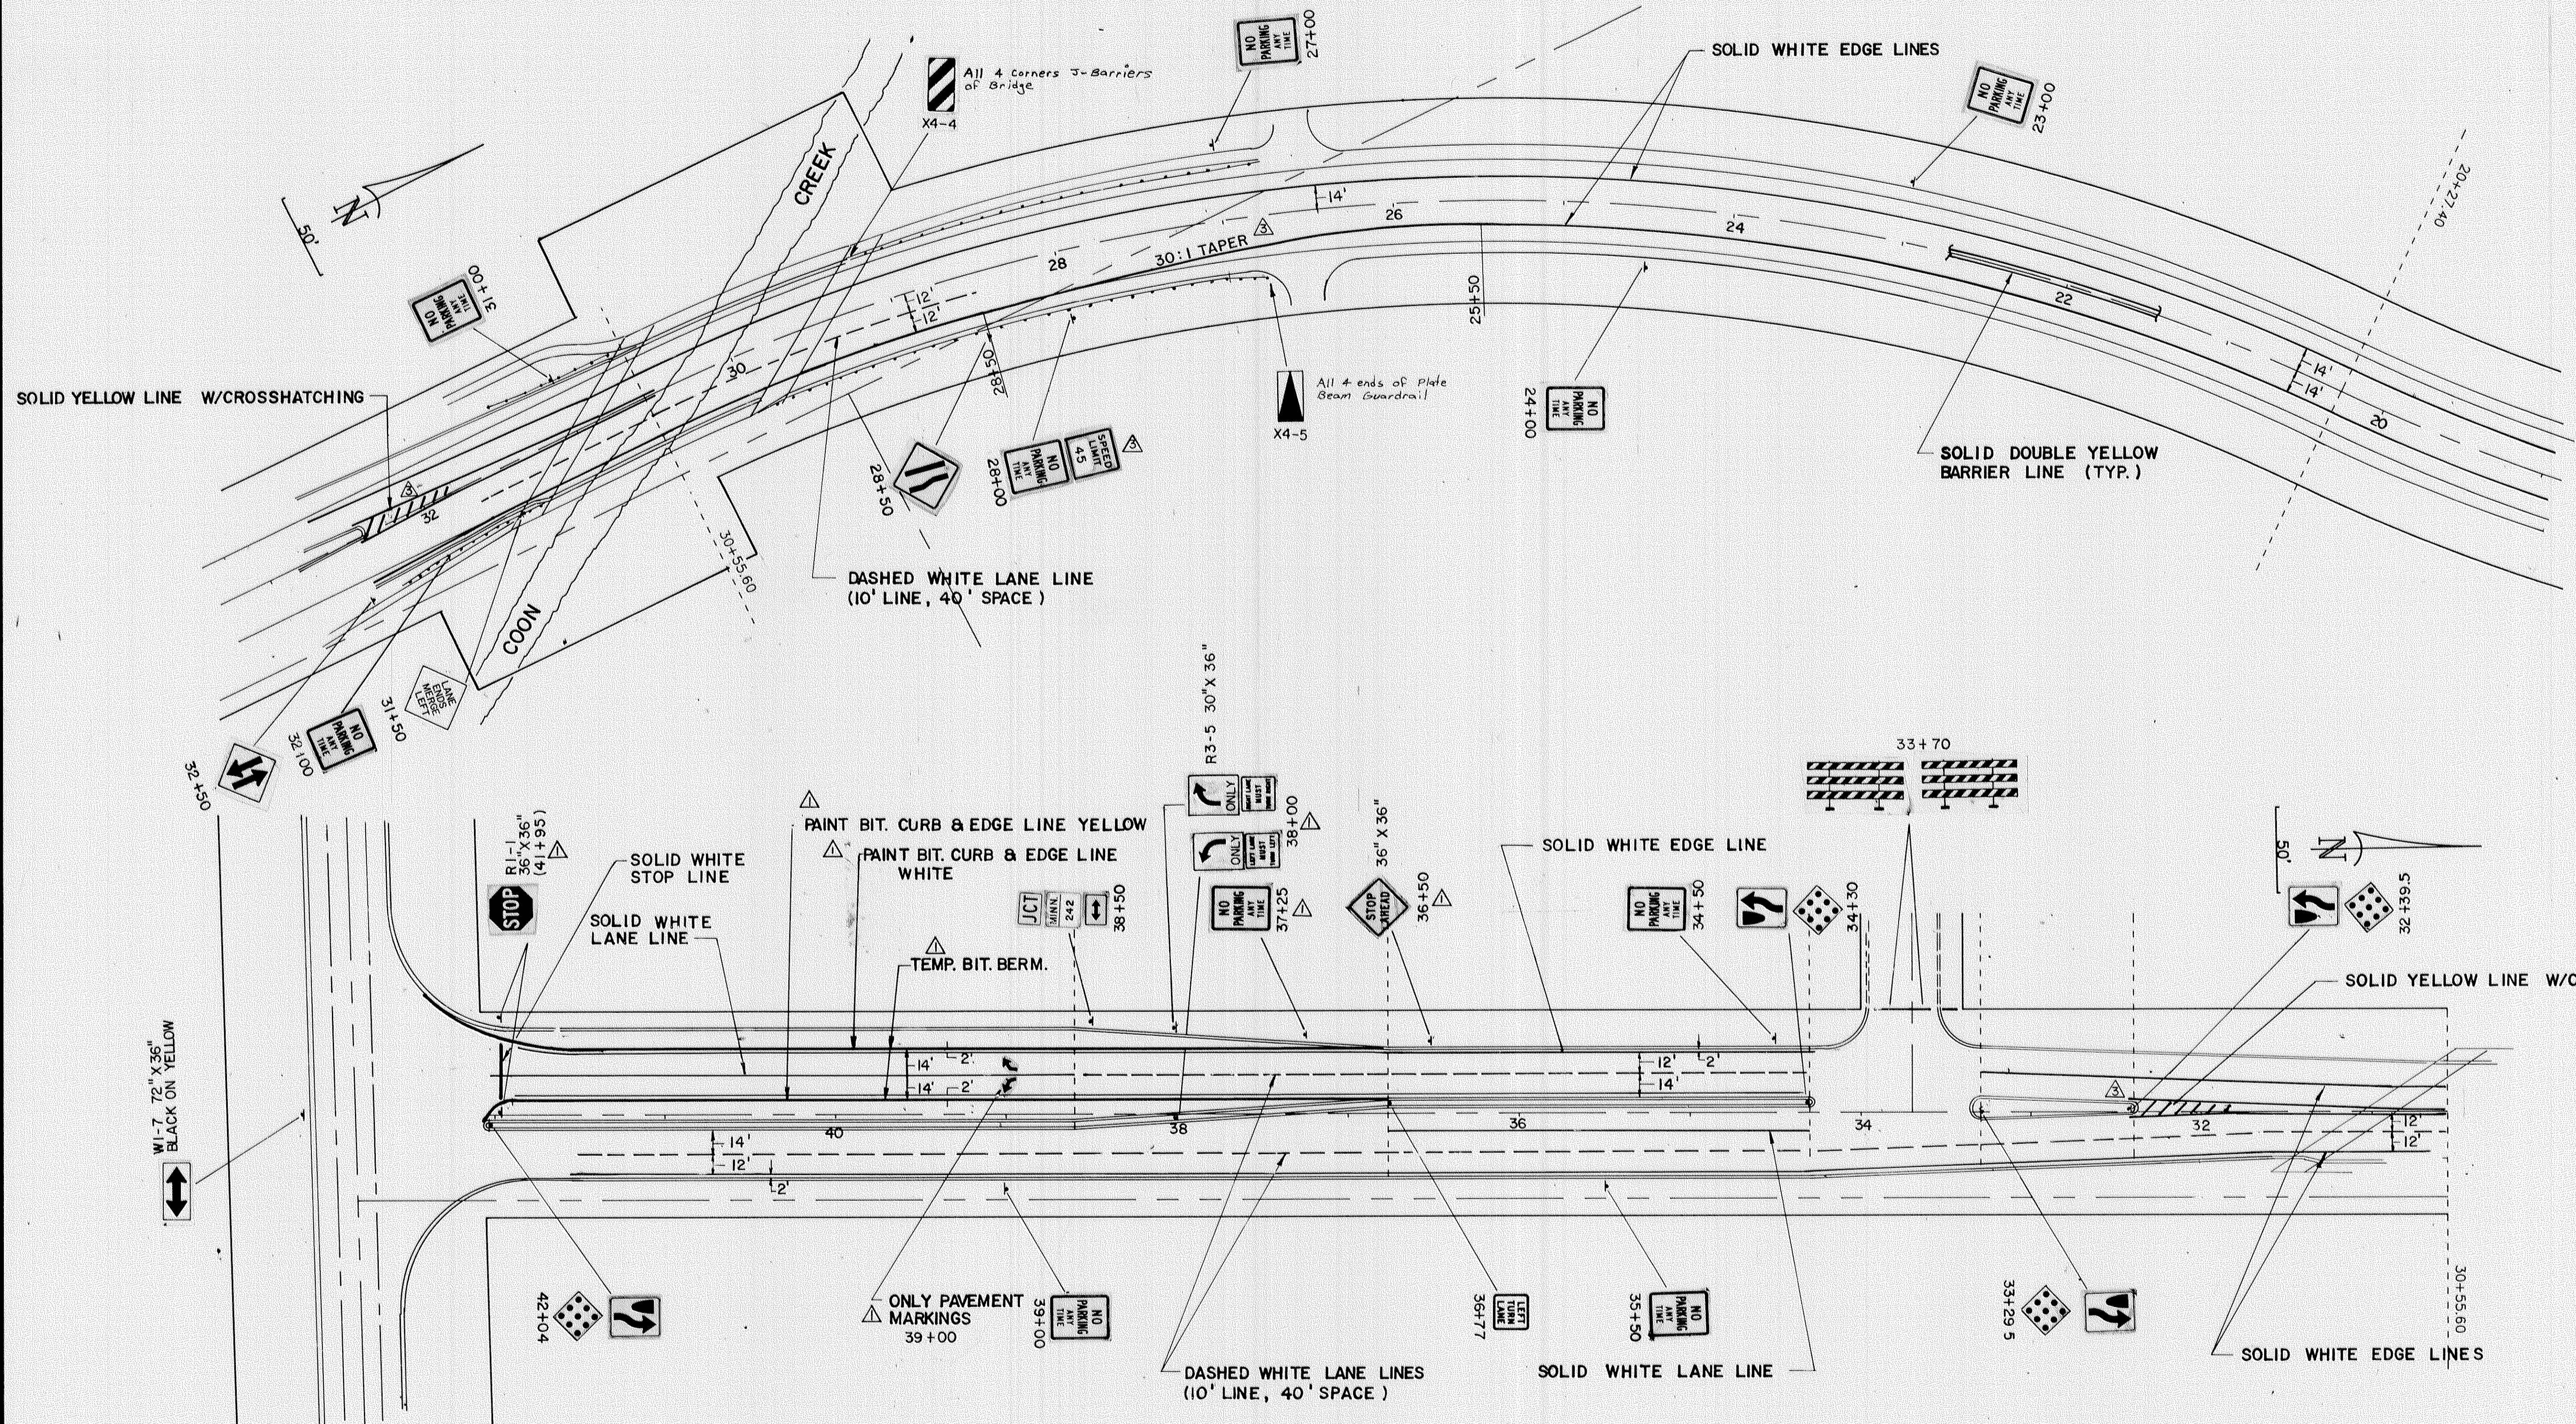


I hereby certify that this plan, specification or report was prepared by me or under my direct supervision and that I am a duly Registered Professional Engineer under the State of Minn. Statutes Sections 326.02 to 326.16.  <i>Tony J. Herman</i> Date: 2/2/88 Minn. Reg. No. 12699	BRW <small>Bennett, Ringrose, Wolfeld, Jarvis, Gardner 612-370-0700 Minneapolis, Minnesota</small>	ORIGINAL DATE 2/2/88 REVISIONS 1. 4/2/88 SIGNING B 2. 5/27/88 REVISE LANE TAPER, RELOCATE SIGN	<b>CITY OF COON RAPIDS</b> <b>IMPROVEMENT PROJECT 86-22</b> <b>COON CREEK BLVD.</b> <b>(COUNTY ROAD 18)</b> <b>SIGNING &amp; STRIPING</b>
		DESIGN BY: TLH DRAWN BY: SAC CHECKED BY:	
S.A.P. NO.		SHEET 10 OF 17	
Date: 2/2/88 Minn. Reg. No. 12699		DESIGN FILE No. 16-8725	

12/12/89 SAC



CLIENT: City of Coon Rapids  
 PROJECT: Coon Rapids  
 DATE BUILT: 2/10/89  
 SHEET: 11 of 17  
 CROSS SECTIONS

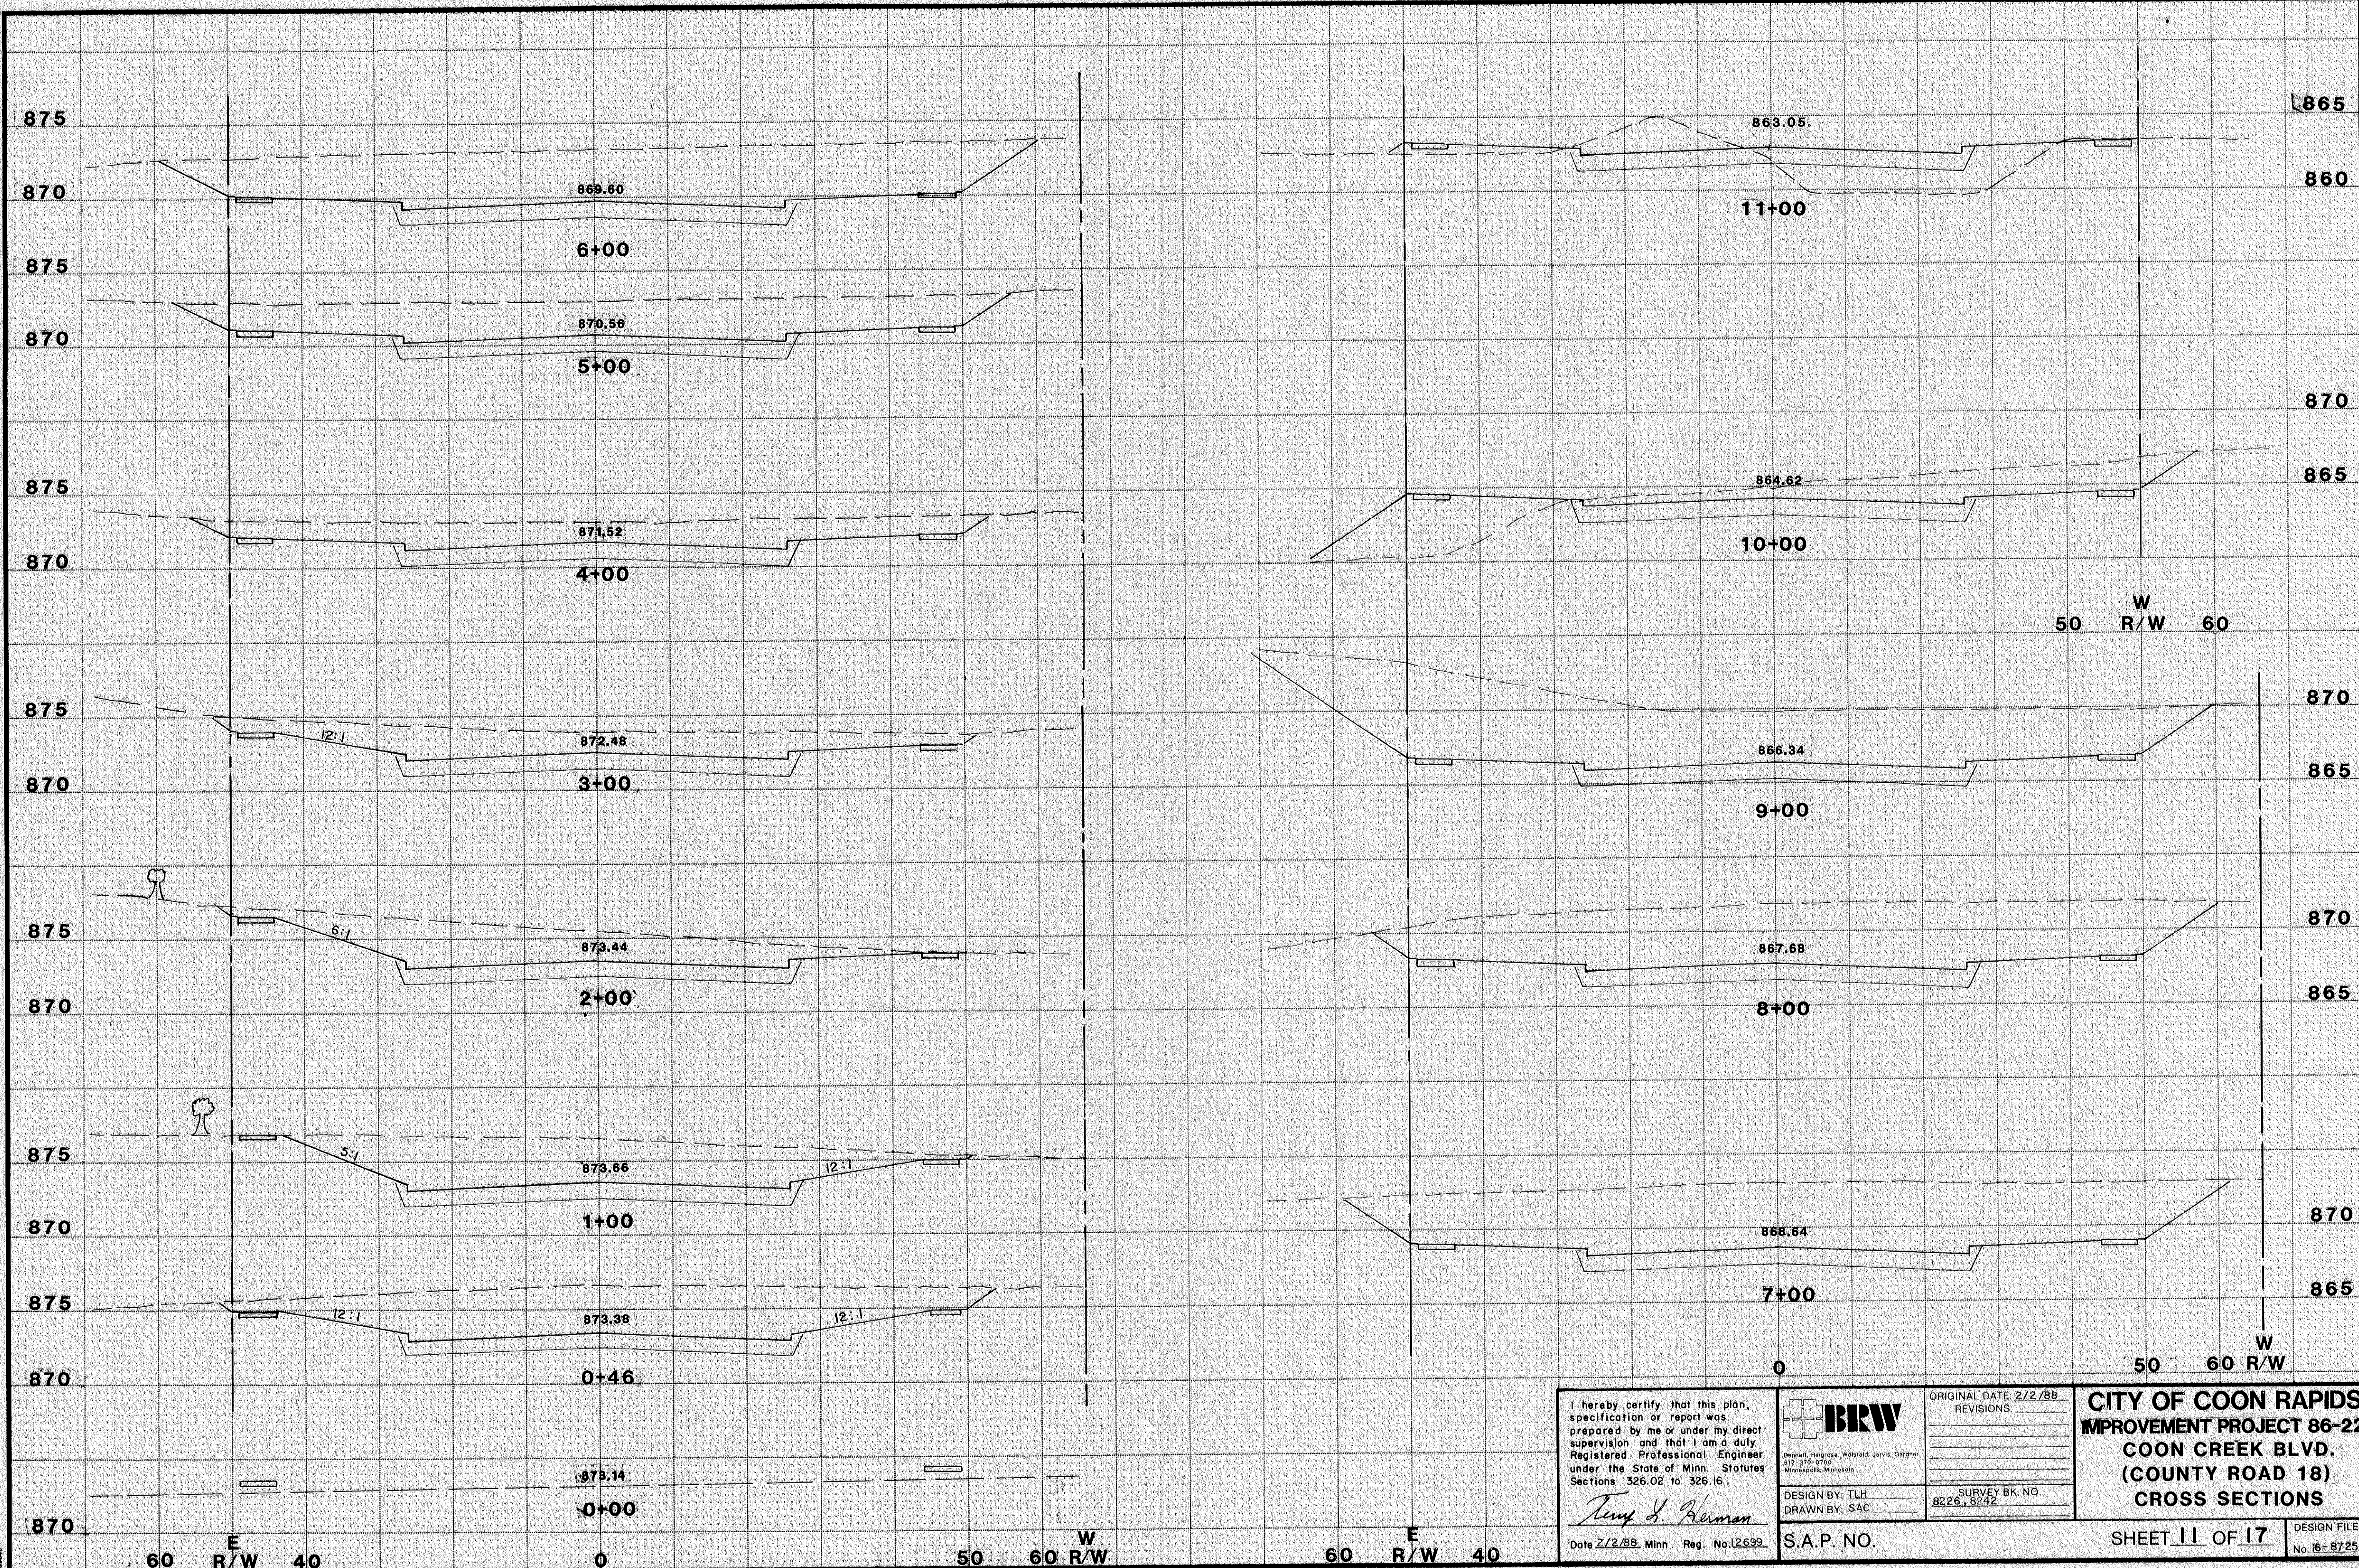

I hereby certify that this plan, specification or report was prepared by me or under my direct supervision and that I am a duly Registered Professional Engineer under the State of Minn. Statutes Sections 326.02 to 326.16.  
*Thom J. Herman*  
 Date 2/12/88 Minn. Reg. No. 126399


**BRW**  
 Bennett, Ringrose, Wolfeld, Jarvis, Gardner  
 412-279-0740  
 Minneapolis, Minnesota  
 DESIGN BY: ILH  
 DRAWN BY: SAC

ORIGINAL DATE: 2/2/88  
 REVISIONS:  
 SURVEY BK. NO.  
 8226, 8242

**CITY OF COON RAPIDS**  
**IMPROVEMENT PROJECT 86-22**  
**COON CREEK BLVD.**  
**(COUNTY ROAD 18)**  
**CROSS SECTIONS**  
 S.A.P. NO. \_\_\_\_\_  
 SHEET 11 OF 17  
 DESIGN FILE No. 16-8725



COUNTY OF COON RAPIDS  
 ENGINEER  
 R. P. P. 202  
 2/11/88  
 C. S. S. 12 of 17

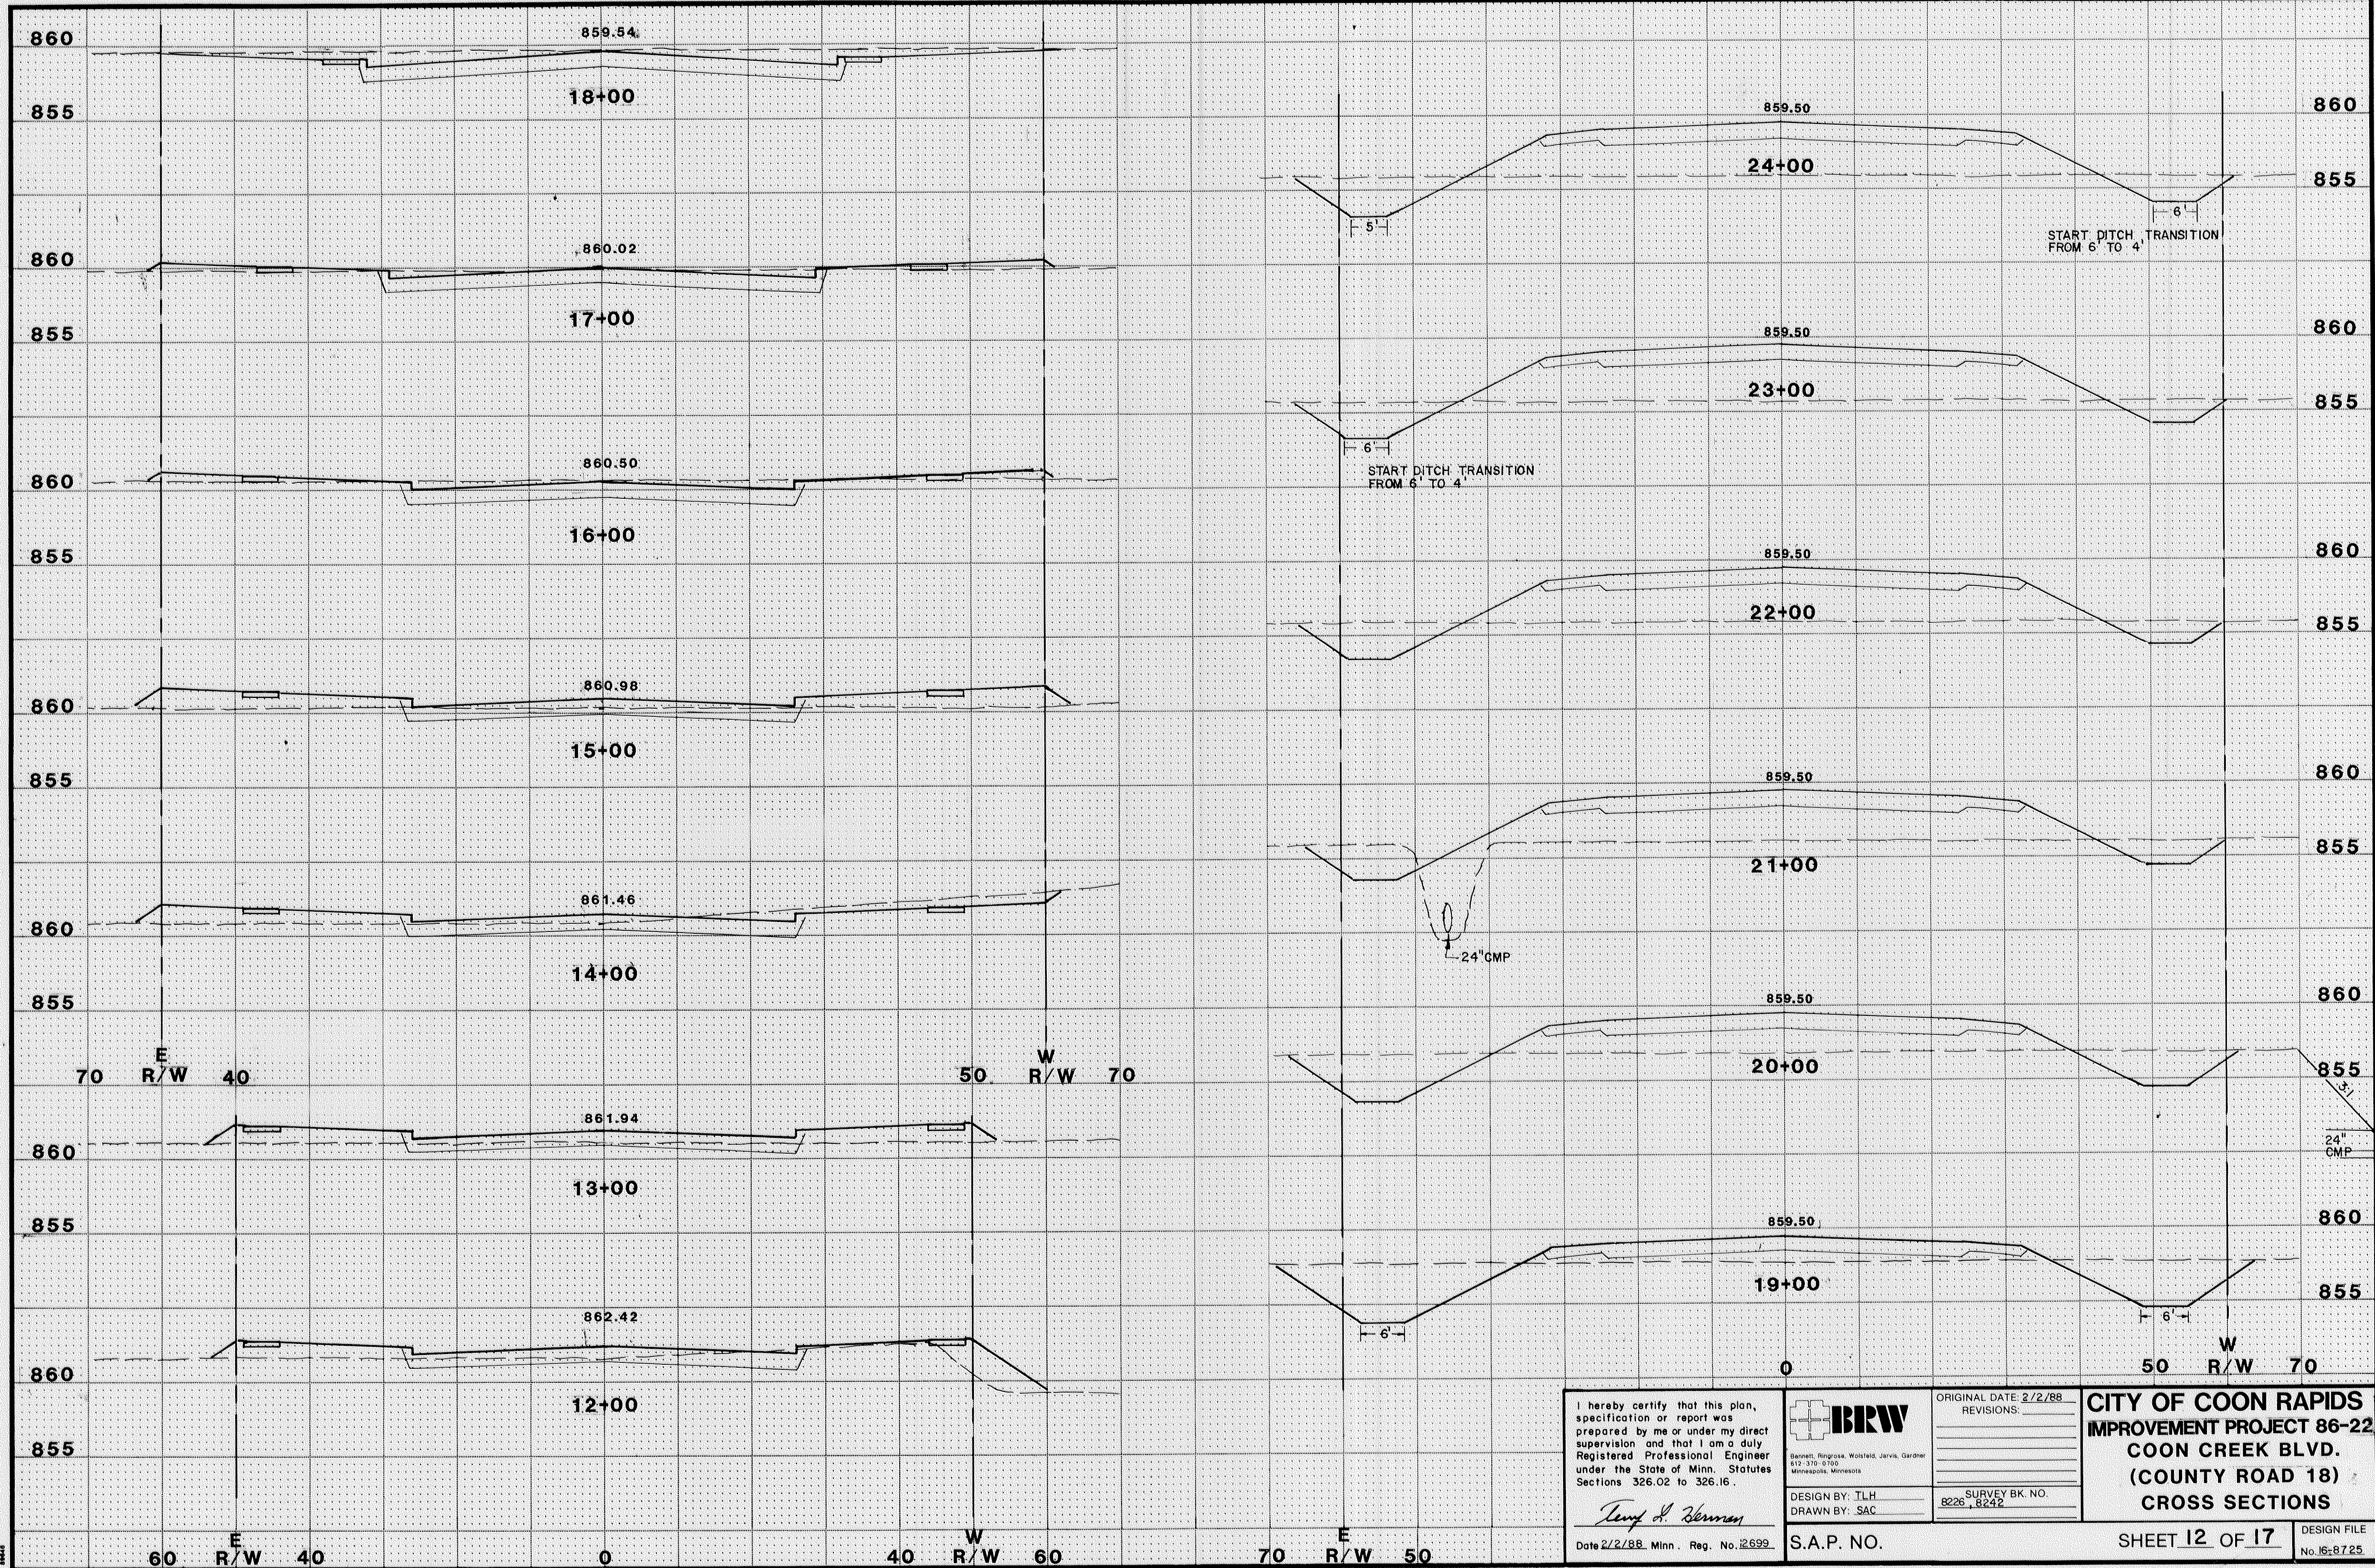

I hereby certify that this plan, specification or report was prepared by me or under my direct supervision and that I am a duly Registered Professional Engineer under the State of Minn. Statutes Sections 326.02 to 326.16.  
*Deaf A. Skerman*  
 Date 2/22/88, Minn. Reg. No. 2699

**BRW**  
 Bennett, Ringross, Weisfeld, Jarvis, Gardner  
 619-376-0700  
 Minneapolis, Minnesota


ORIGINAL DATE: 2/2/88  
 REVISIONS:  
 SURVEY BK. NO. 8226, 8242

**CITY OF COON RAPIDS**  
**IMPROVEMENT PROJECT 86-22**  
**COON CREEK BLVD.**  
**(COUNTY ROAD 18)**  
**CROSS SECTIONS**  
 SHEET 12 OF 17  
 DESIGN FILE No. 16-8725

DESIGN BY: ILH  
 DRAWN BY: SAC  
 S.A.P. NO.



CLIENT: City of Coon Rapids  
 PROJECT: Coon Creek Blvd. Improvement Project  
 SHEET: 13 OF 17

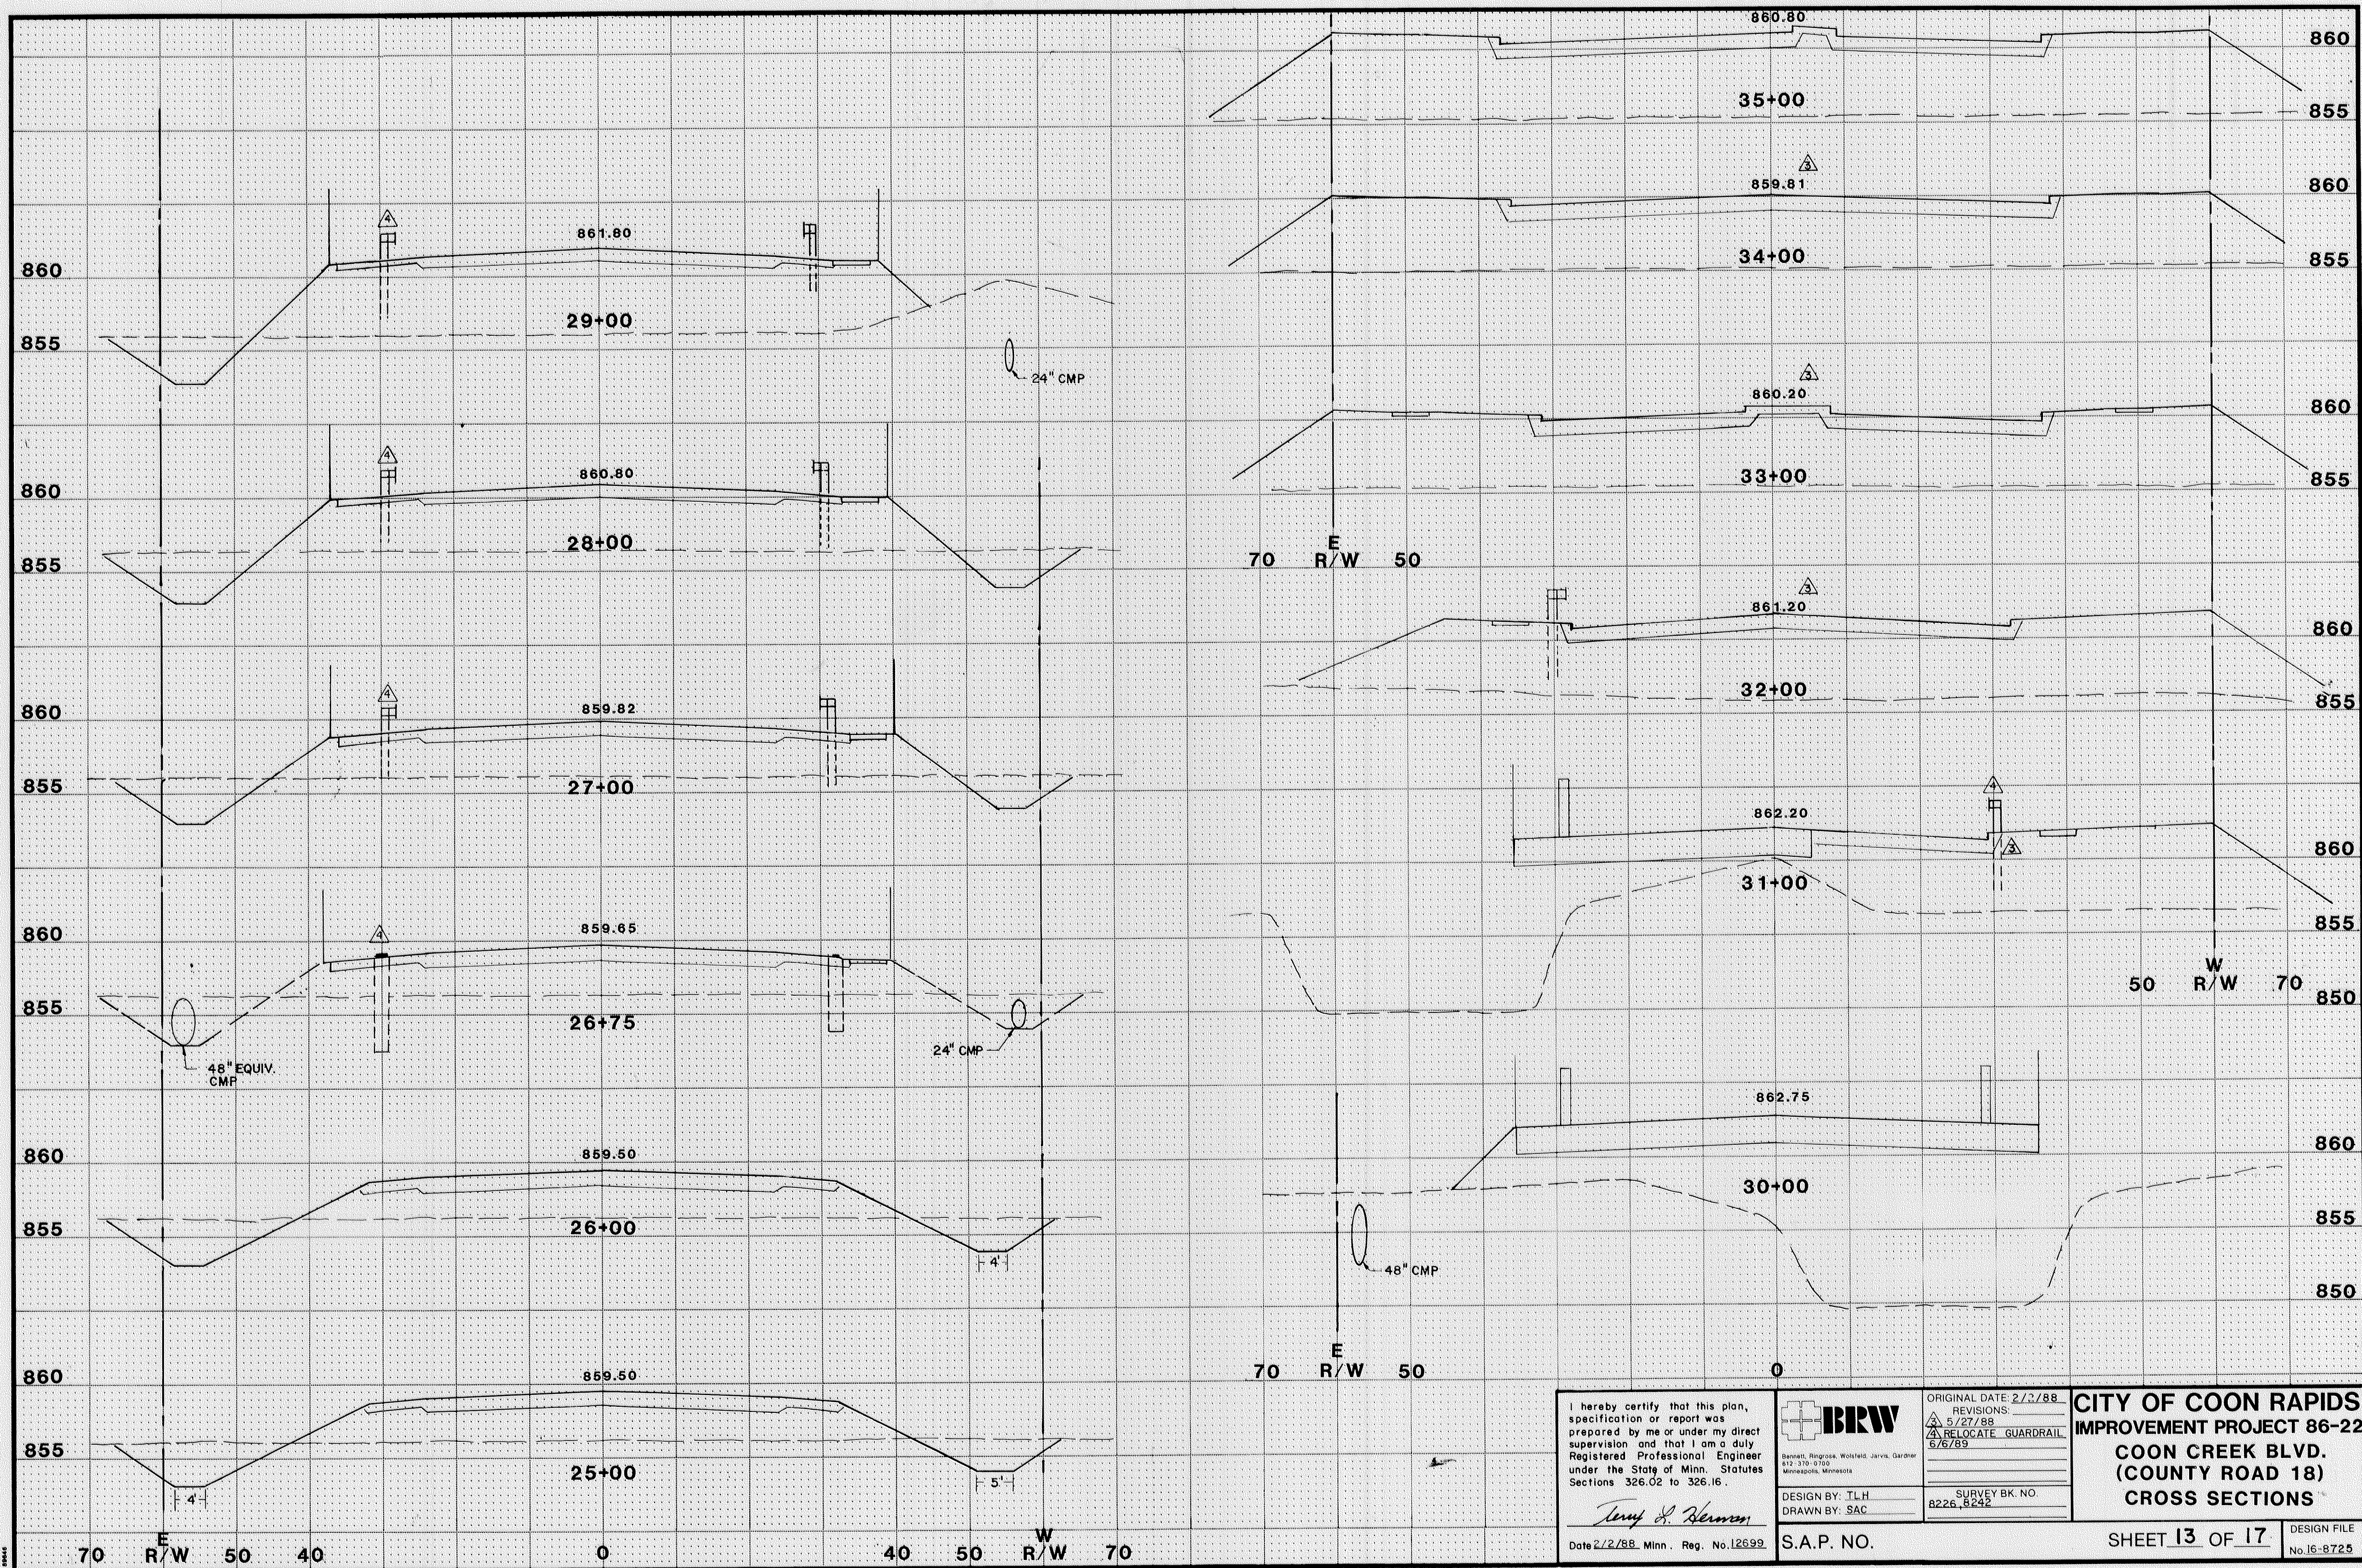

I hereby certify that this plan, specification or report was prepared by me or under my direct supervision and that I am a duly Registered Professional Engineer under the State of Minn. Statutes Sections 326.02 to 326.16.

*Terry J. Henneman*  
 Date 2/2/88 Minn. Reg. No. 12699

**BRW**  
 Barnett, Ringross, Wolfeld, Jarvis, Gardner  
 812-370-0100  
 Minneapolis, Minnesota

DESIGN BY: JLH  
 DRAWN BY: SAC

ORIGINAL DATE: 2/3/88  
 REVISIONS:  
 5/27/88  
 RELOCATE GUARDRAIL  
 6/6/89

SURVEY BK. NO.  
 8226, 8242


**CITY OF COON RAPIDS**  
**IMPROVEMENT PROJECT 86-22**  
**COON CREEK BLVD.**  
**(COUNTY ROAD 18)**  
**CROSS SECTIONS**

SHEET 13 OF 17

DESIGN FILE  
 No. 16-8725



COON RAPIDS  
 TYPE & LOCATION  
 CROSS SECTIONS 1A OF 17

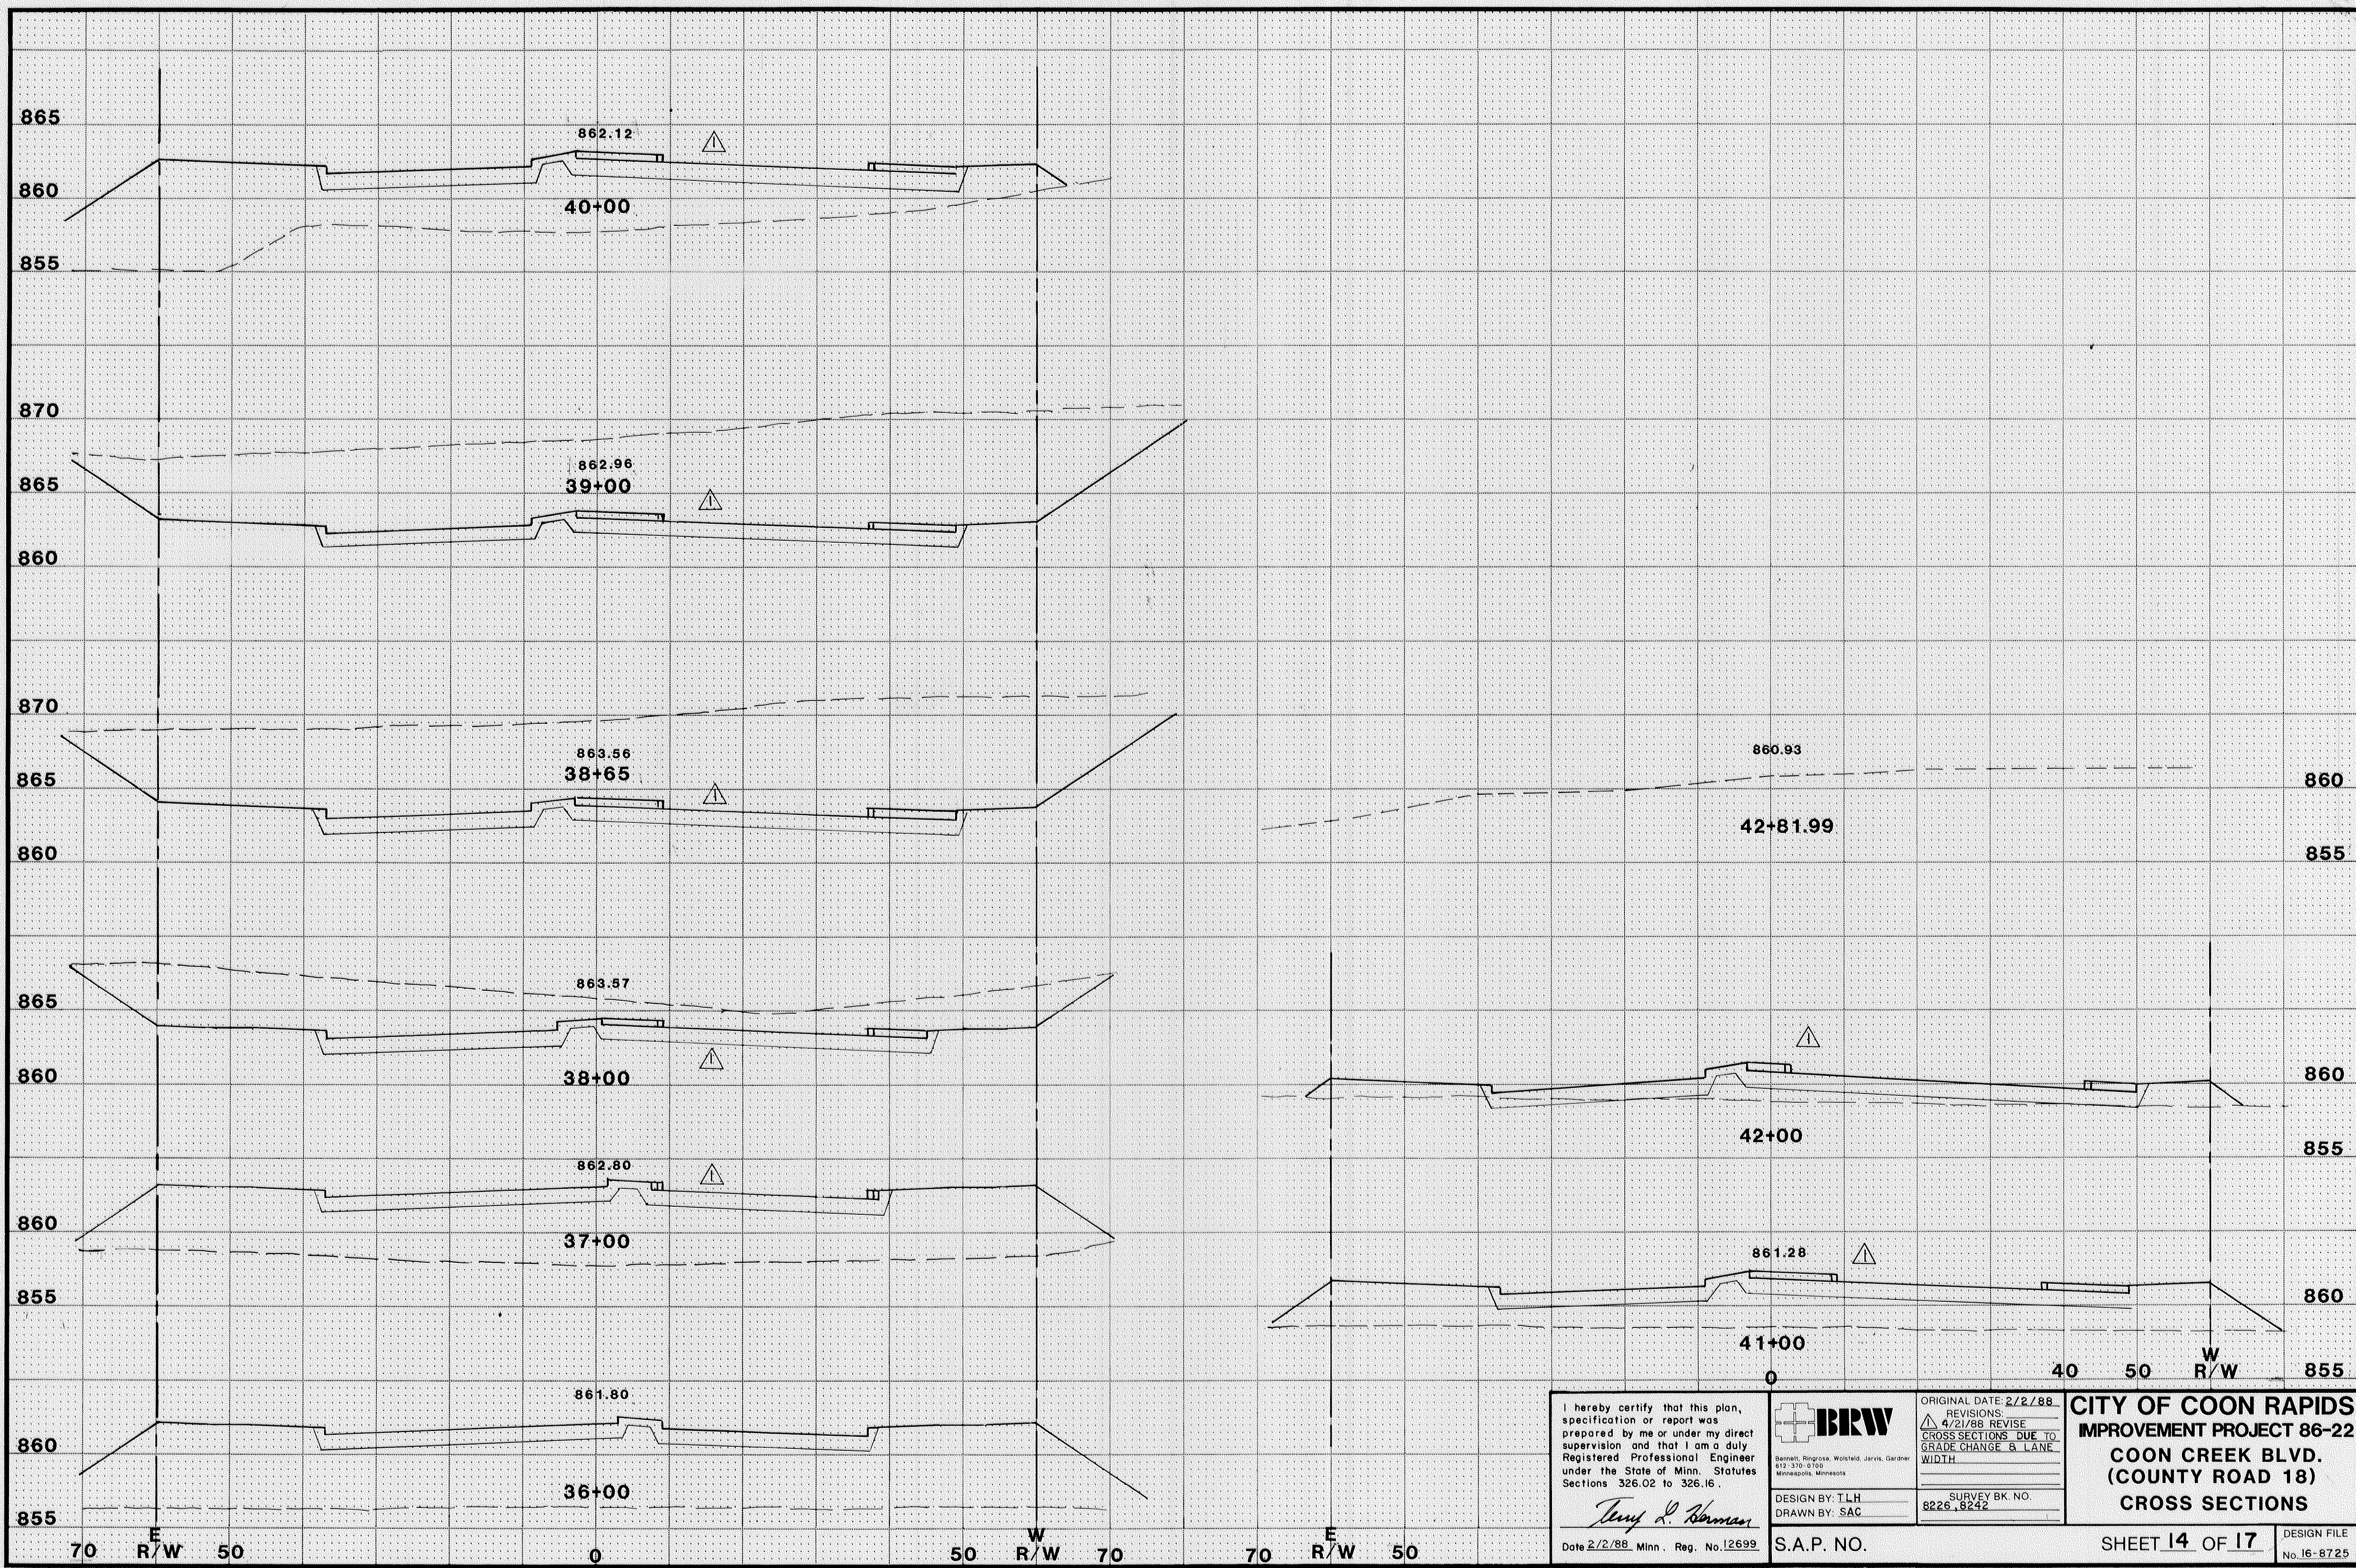

I hereby certify that this plan, specification or report was prepared by me or under my direct supervision and that I am a duly Registered Professional Engineer under the State of Minn. Statutes Sections 326.02 to 326.16.

*Tony L. Hoffman*  
 Date 2/2/88 Minn. Reg. No. 12699



ORIGINAL DATE: 2/2/88  
 REVISIONS:  
 4/21/88 REVISE CROSS SECTIONS DUE TO GRADE CHANGE & LANE WIDTH


DESIGN BY: TLH  
 DRAWN BY: SAC

SURVEY BK. NO. 8226, 8242

**CITY OF COON RAPIDS**  
**IMPROVEMENT PROJECT 86-22**  
**COON CREEK BLVD.**  
**(COUNTY ROAD 18)**  
**CROSS SECTIONS**



PROJECT NO. 88-010  
 LOCATION  
 CROSS SECTIONS  
 SHEET 15 OF 17

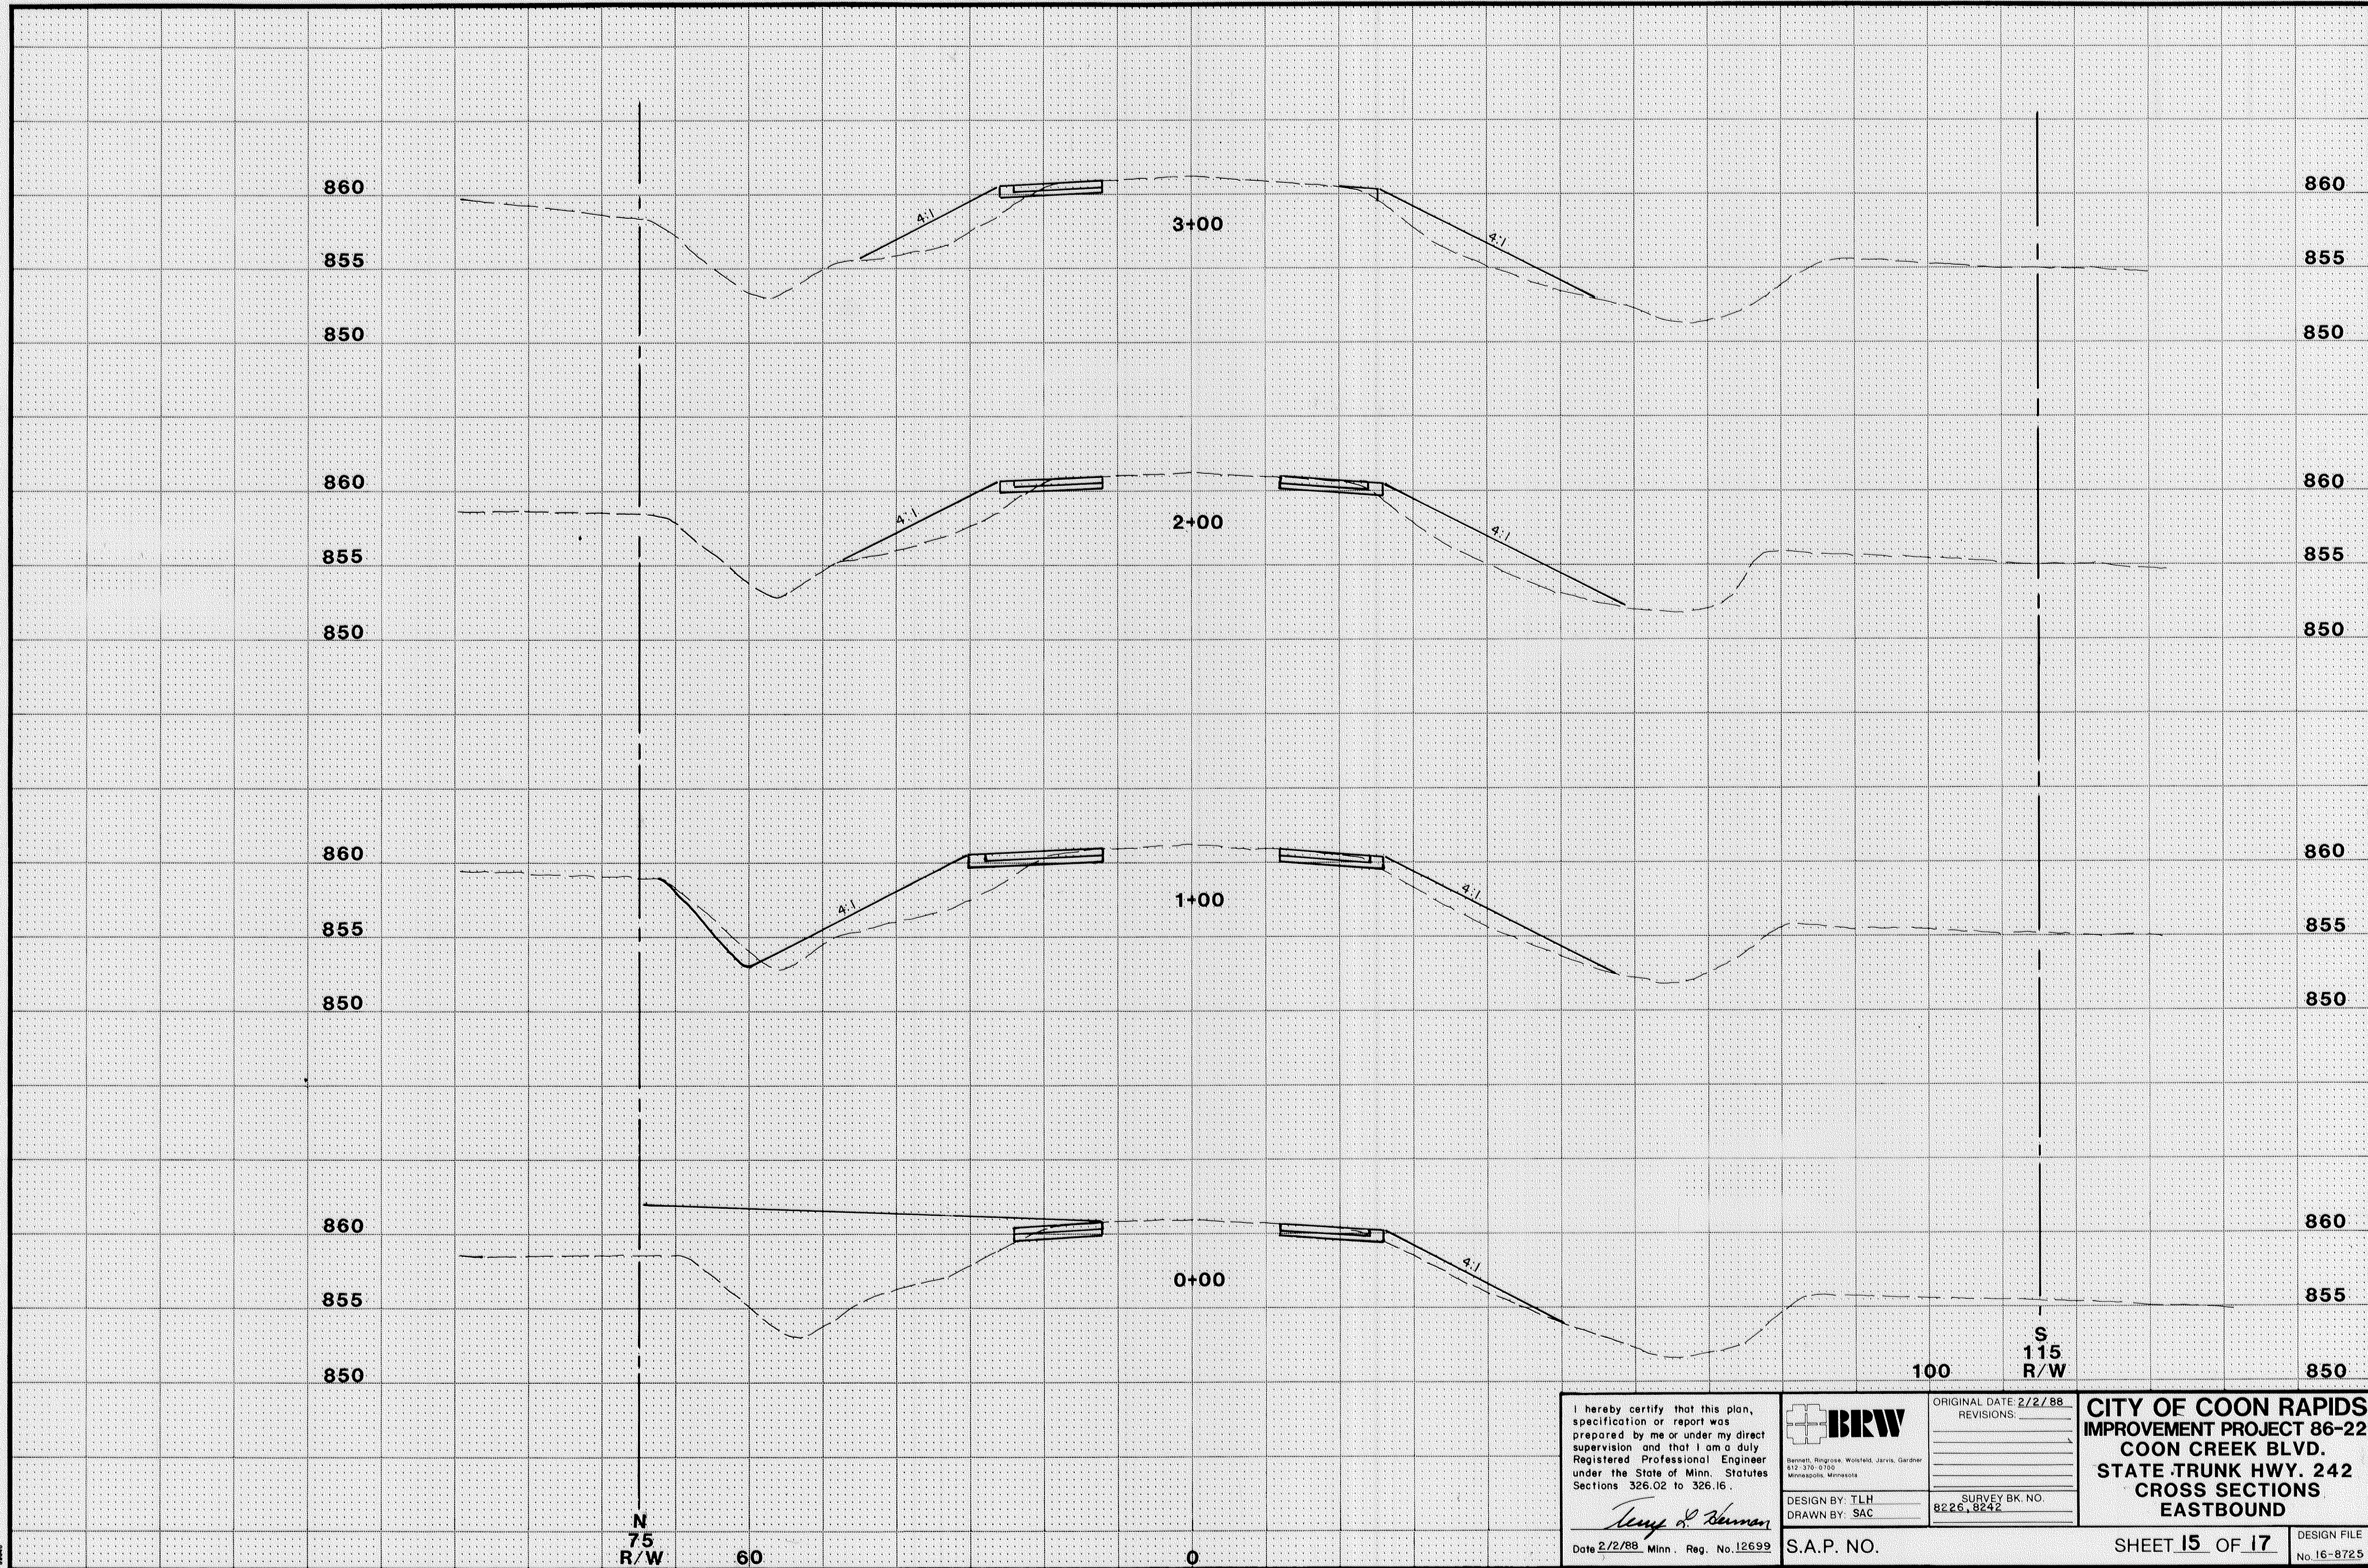

I hereby certify that this plan, specification or report was prepared by me or under my direct supervision and that I am a duly Registered Professional Engineer under the State of Minn. Statutes Sections 326.02 to 326.16.  
*Tony J. Herman*  
 Date 2/2/88 Minn. Reg. No. 12699

**BRW**  
 Bennett, Ringrose, Wolfeld, Jarvis, Gardner  
 412 330-0700  
 Minneapolis, Minnesota  
 DESIGN BY: TLH  
 DRAWN BY: SAC


ORIGINAL DATE: 2/2/88  
 REVISIONS:  
 SURVEY BK. NO. 8226, 8242

**CITY OF COON RAPIDS**  
**IMPROVEMENT PROJECT 86-22**  
**COON CREEK BLVD.**  
**STATE TRUNK HWY. 242**  
**CROSS SECTIONS**  
**EASTBOUND**  
 SHEET 15 OF 17  
 DESIGN FILE No. 16-8725

S.A.P. NO.



PROJECT NO. 86-22  
 CLIENT City of Coon Rapids  
 DATE 2/19/88  
 SHEET 16 OF 17  
 CROSS SECTIONS

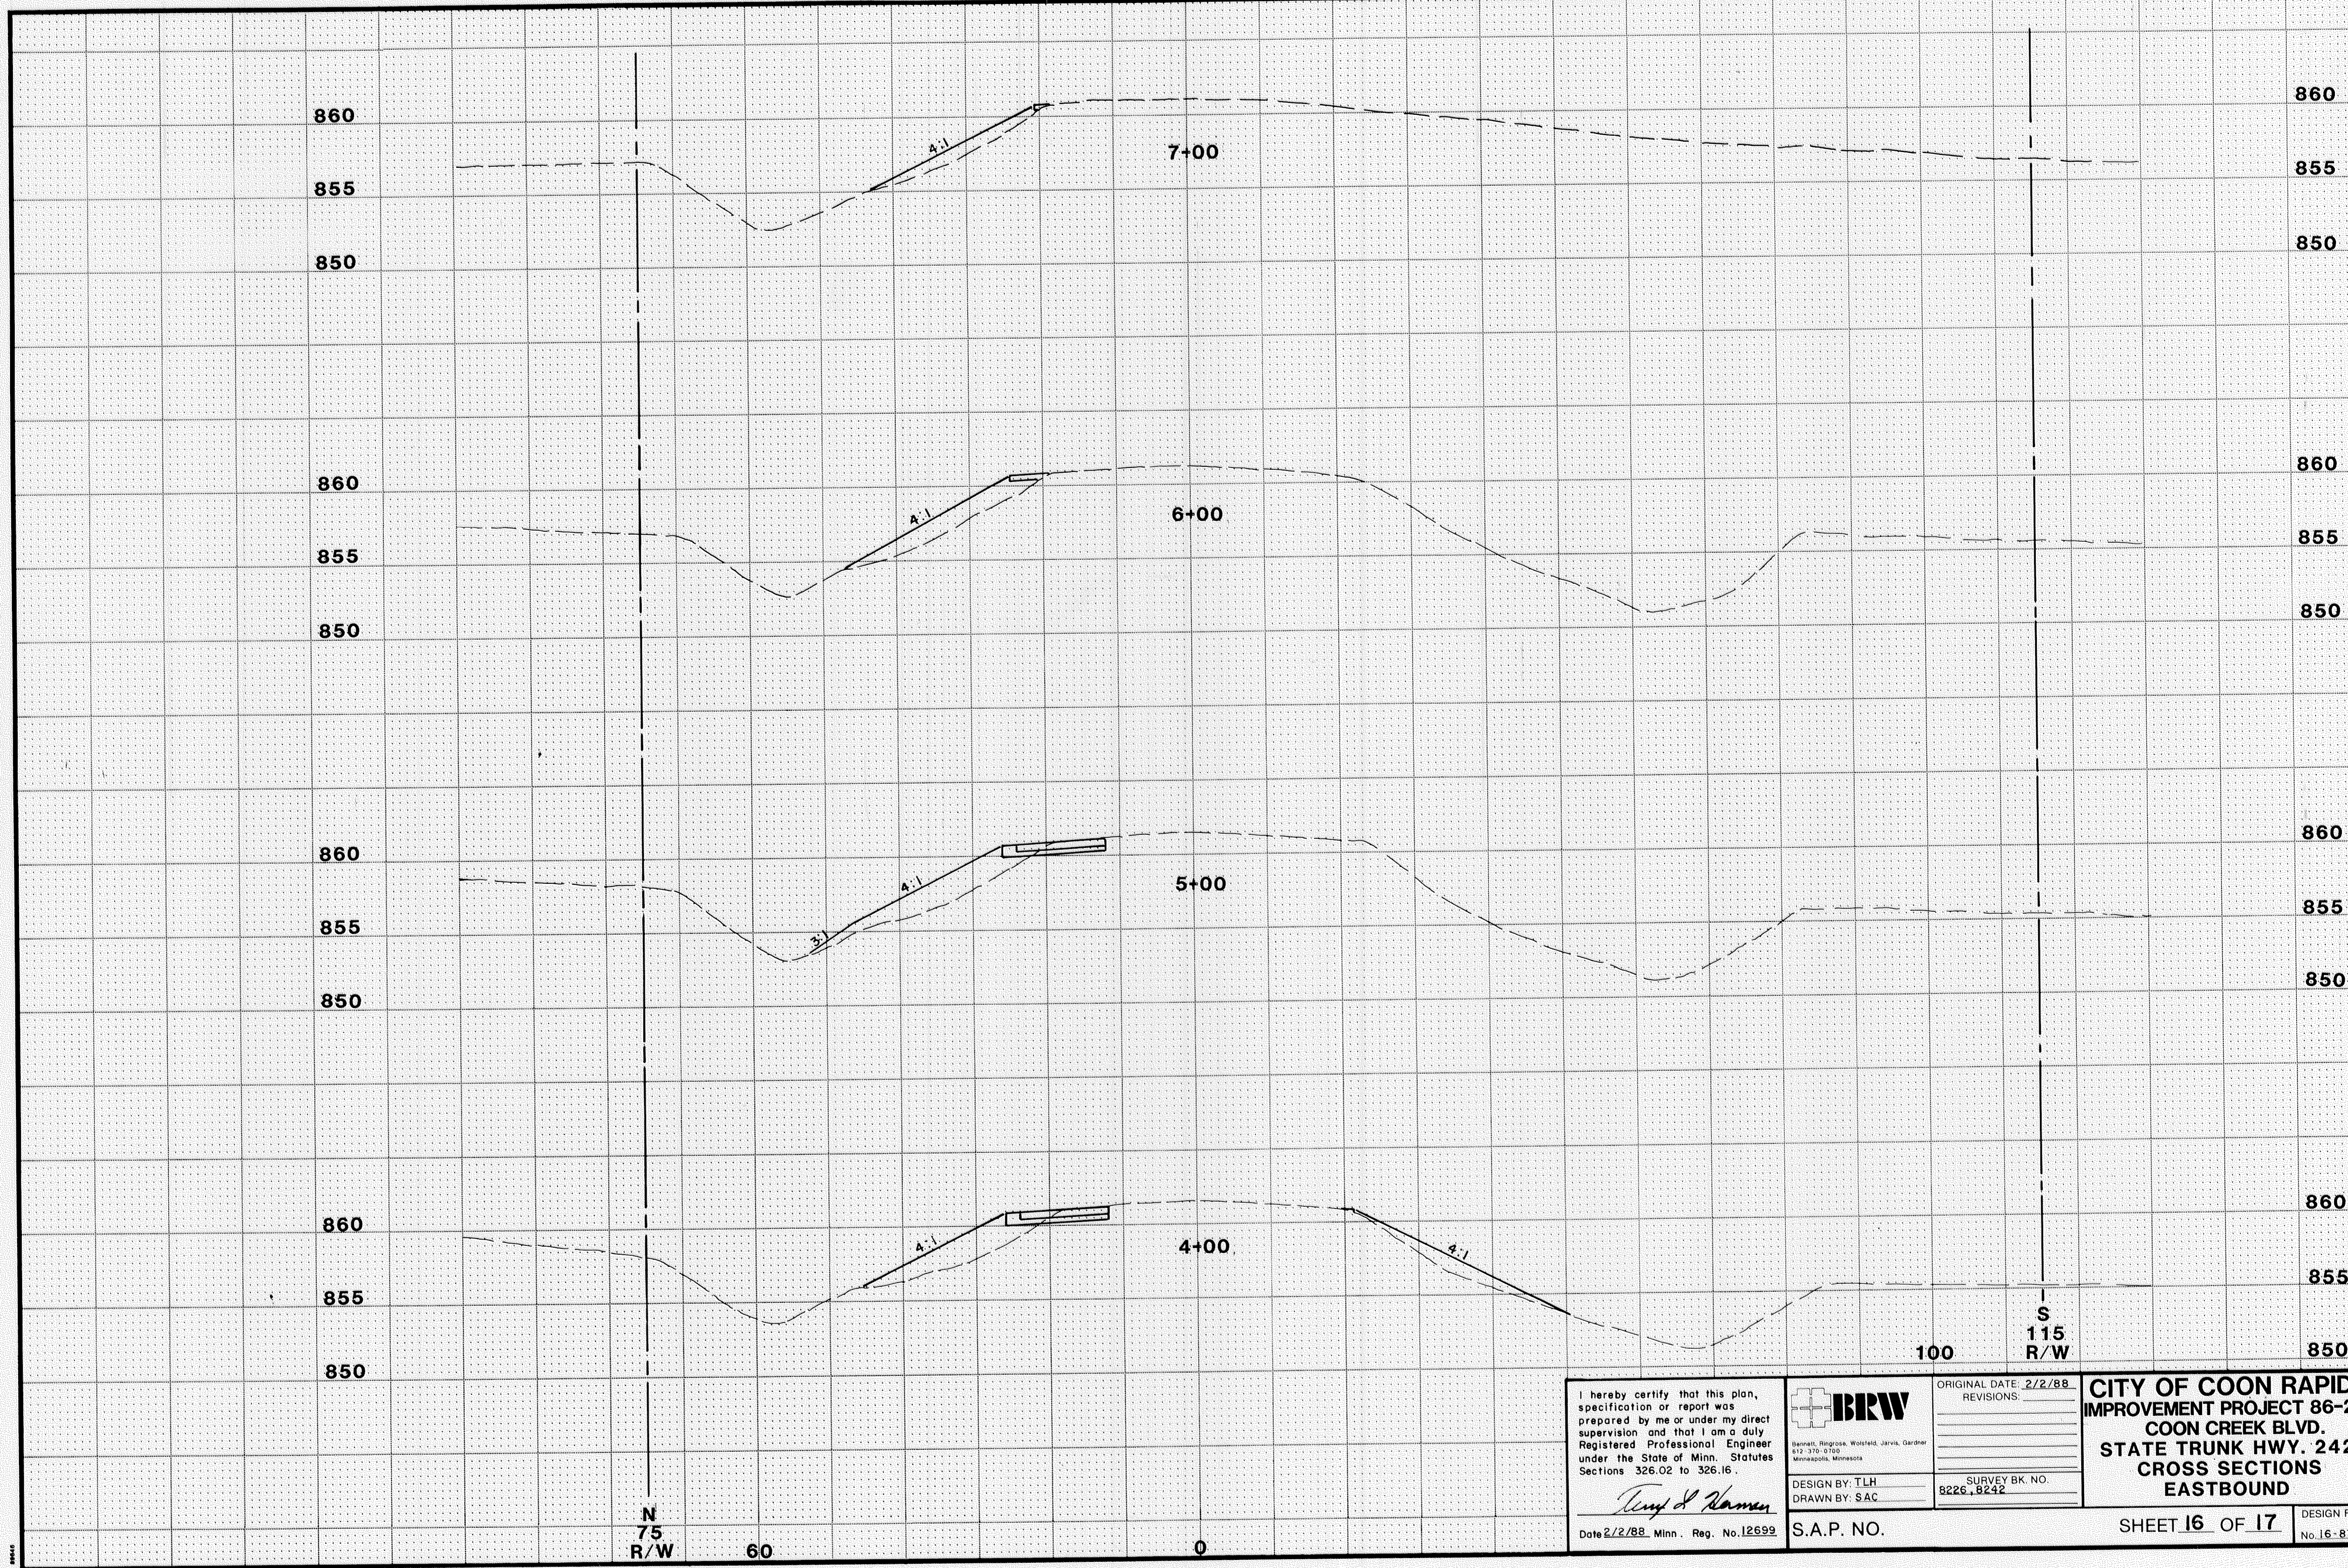

I hereby certify that this plan, specification or report was prepared by me or under my direct supervision and that I am a duly Registered Professional Engineer under the State of Minn. Statutes Sections 326.02 to 326.16.

*Tony J. Hansen*

Date 2/2/88, Minn. Reg. No. 12699

**BRW**  
 Bennett, Ringrose, Wolford, Jarvis, Gardner  
 612-370-0700  
 Minneapolis, Minnesota

DESIGN BY: TLH  
 DRAWN BY: SAC

ORIGINAL DATE: 2/2/88  
 REVISIONS:

SURVEY BK. NO.  
 8226, 8242

**CITY OF COON RAPIDS**  
**IMPROVEMENT PROJECT 86-22**  
**COON CREEK BLVD.**  
**STATE TRUNK HWY. 242**  
**CROSS SECTIONS**  
**EASTBOUND**


SHEET 16 OF 17

DESIGN FILE No. 16-872

S.A.P. NO.



CLIENT: CITY OF COON RAPIDS  
 PROJECT: COON RAPIDS  
 TYPE & LOCATION: CROSS SECTIONS  
 DATE: 2/10/88  
 SHEET: 17 OF 17

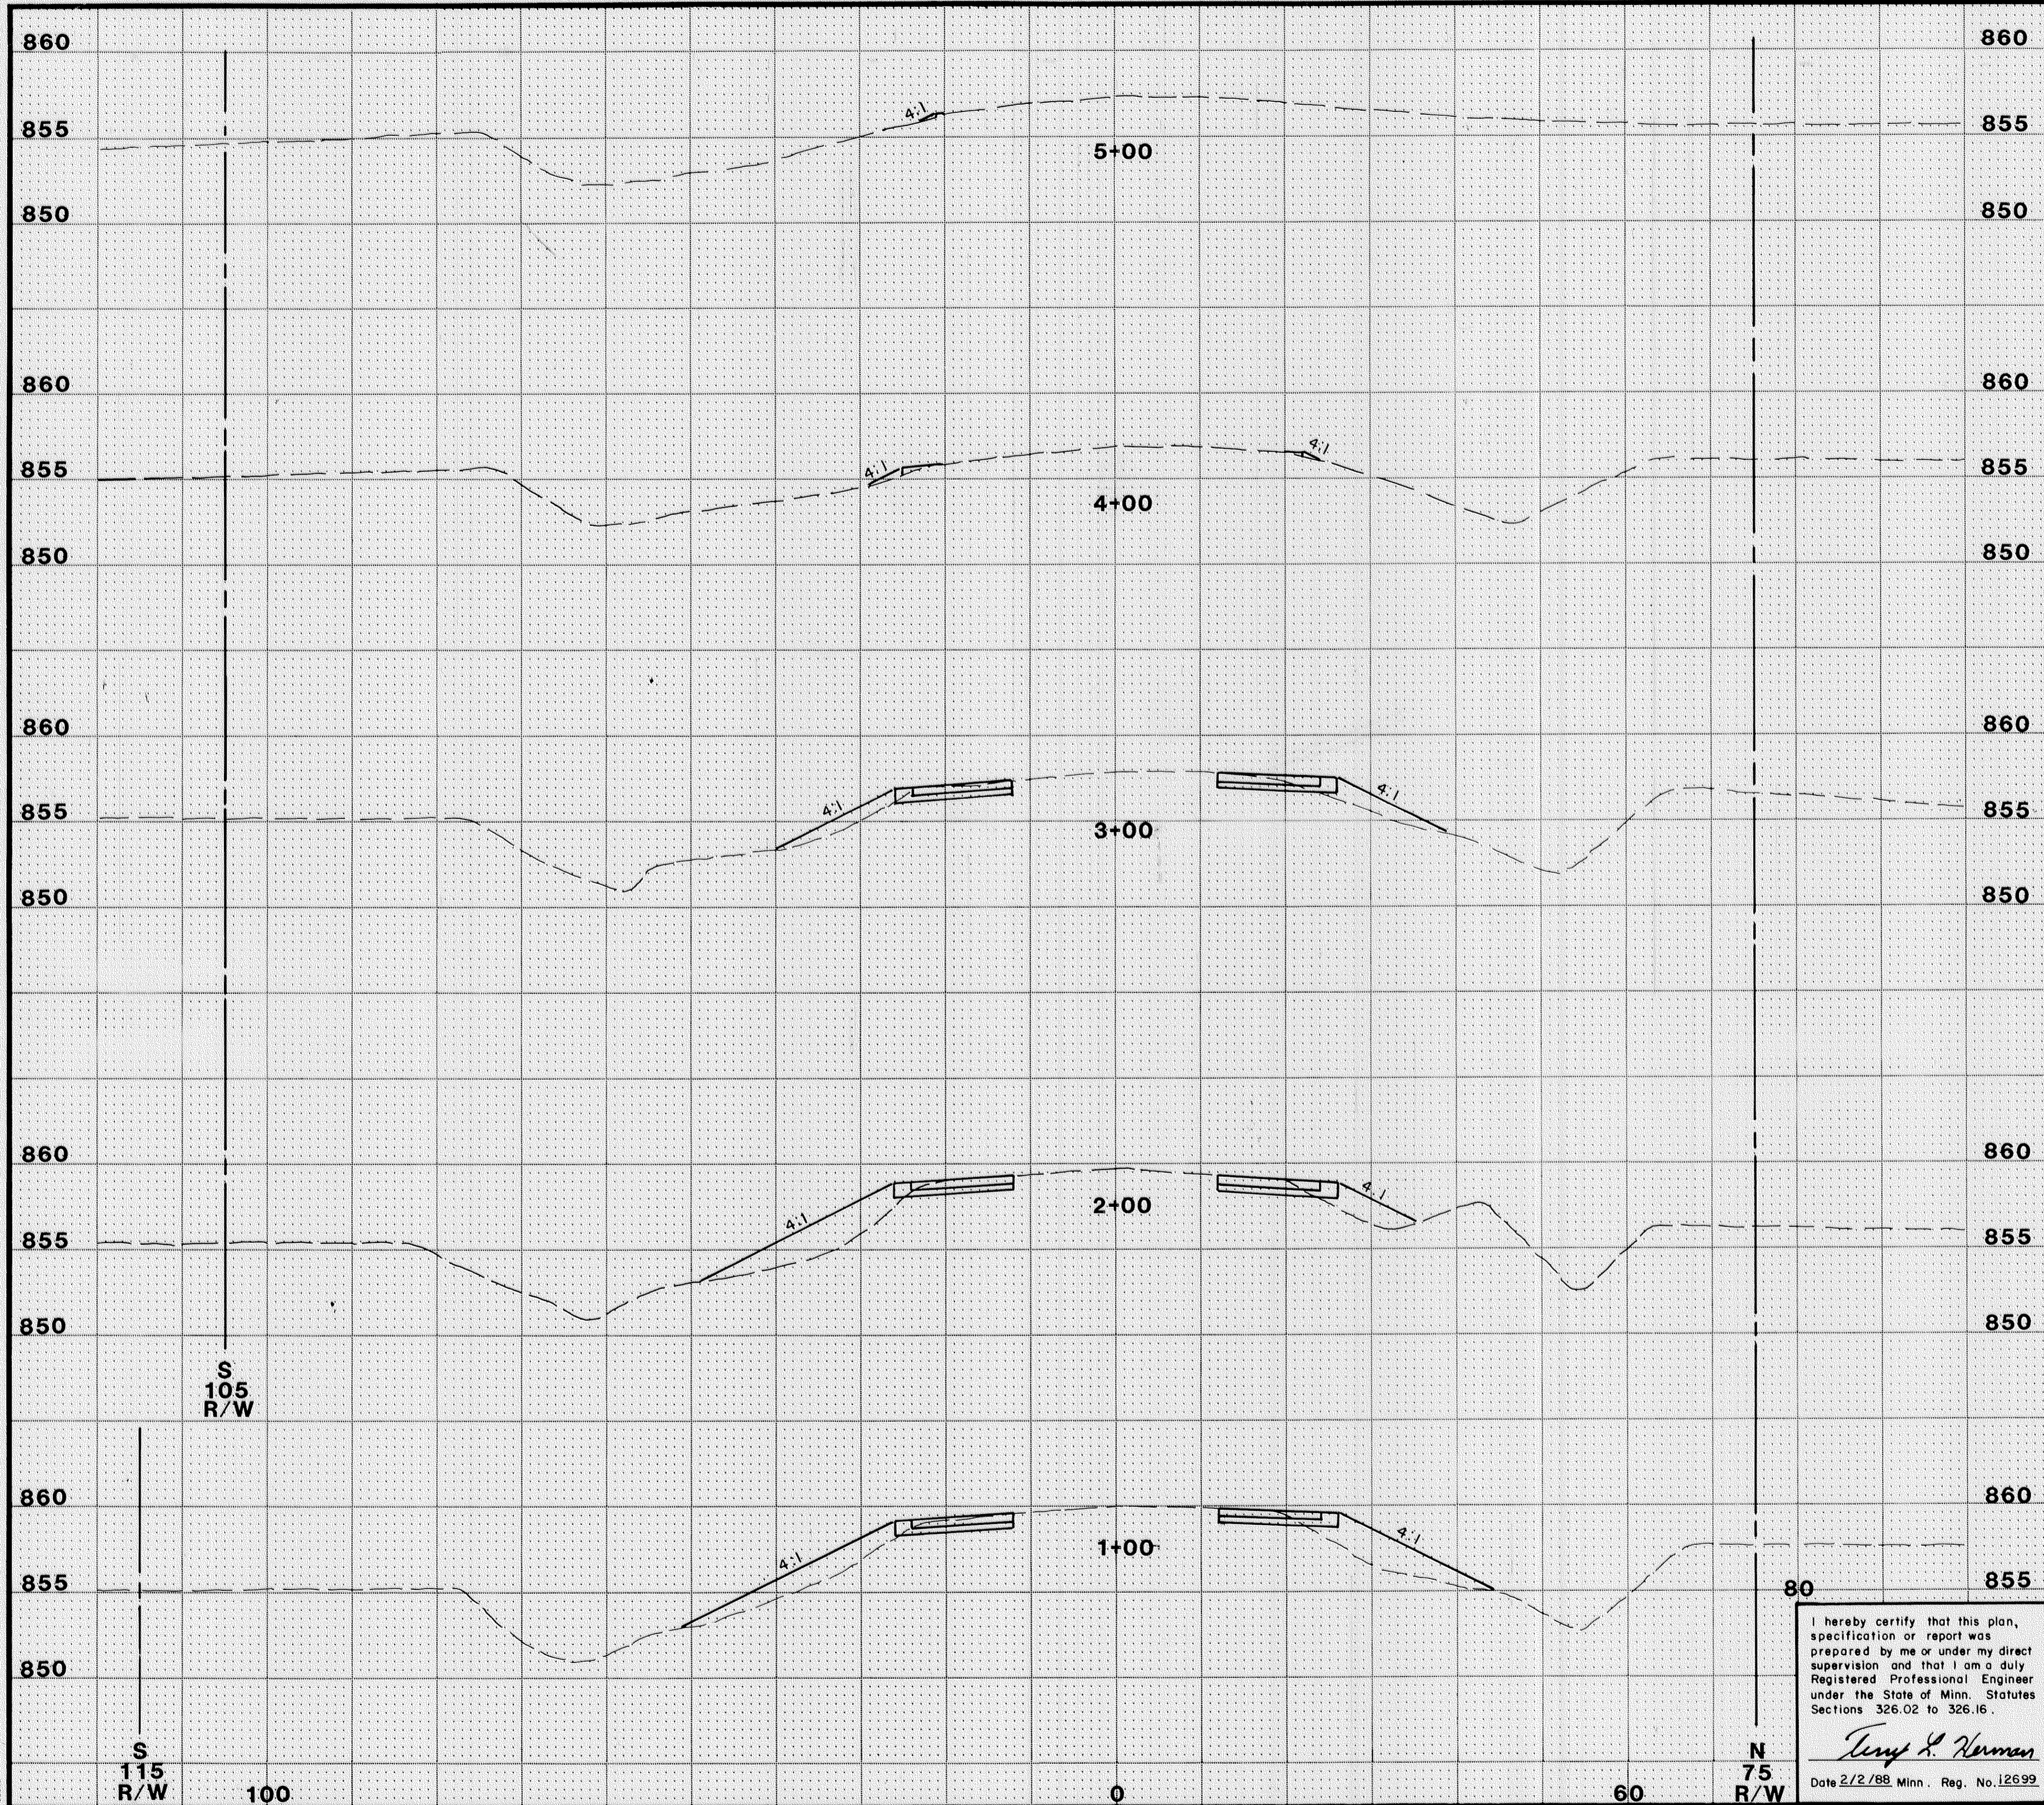

I hereby certify that this plan, specification or report was prepared by me or under my direct supervision and that I am a duly Registered Professional Engineer under the State of Minn. Statutes Sections 326.02 to 326.16.

*Terry L. Norman*  
 Date 2/2/88, Minn. Reg. No. 12699

**BRW**  
 Bennett, Ringrose, Wiestfeld, Jarvis, Gardner  
 612-370-0700  
 Minneapolis, Minnesota

DESIGN BY: TLH  
 DRAWN BY: SAC


ORIGINAL DATE: 2/2/88  
 REVISIONS:

SURVEY BK. NO.  
 8226, 8242

**CITY OF COON RAPIDS**  
**IMPROVEMENT PROJECT 86-2**  
**COON CREEK BLVD.**  
**STATE TRUNK HWY. 242**  
**CROSS SECTIONS**  
**WESTBOUND**

S.A.P. NO.



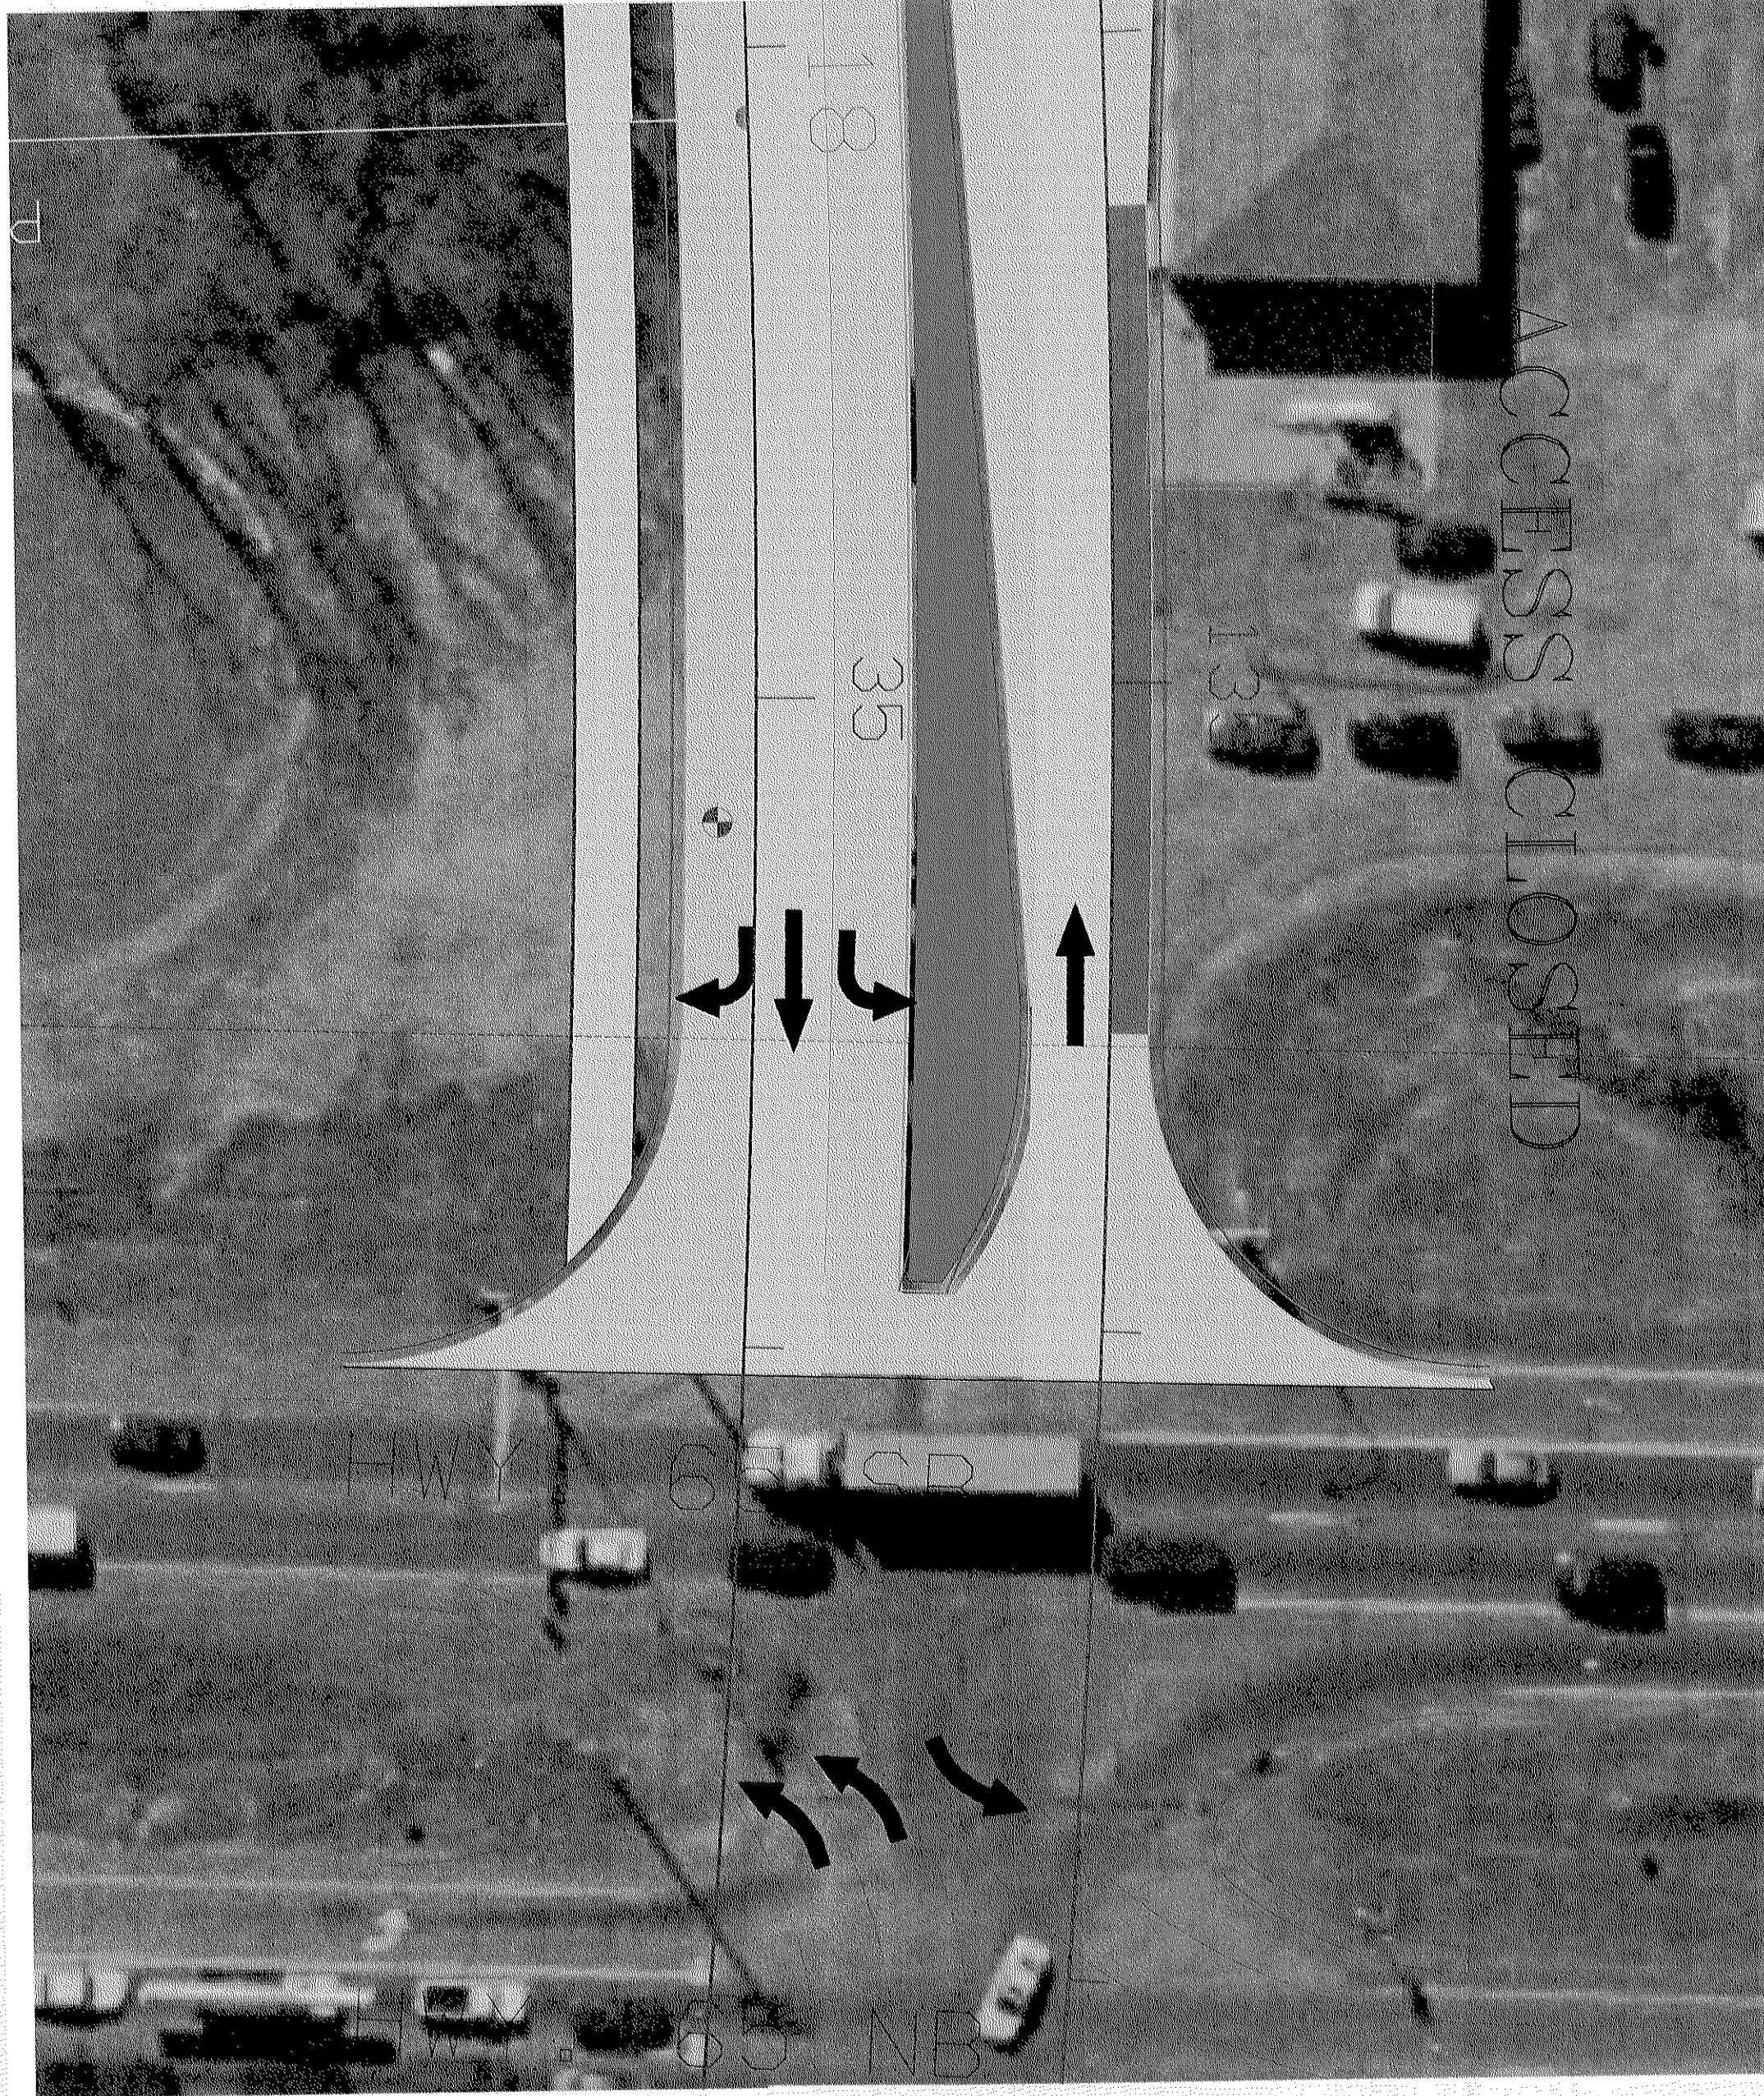



ACCESS CLOSED

35


D

HWY 66 CD

30 NB

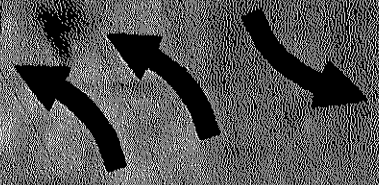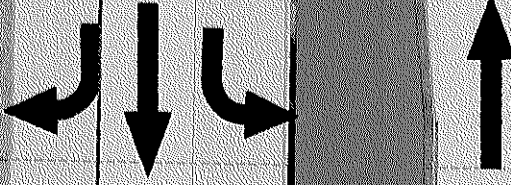




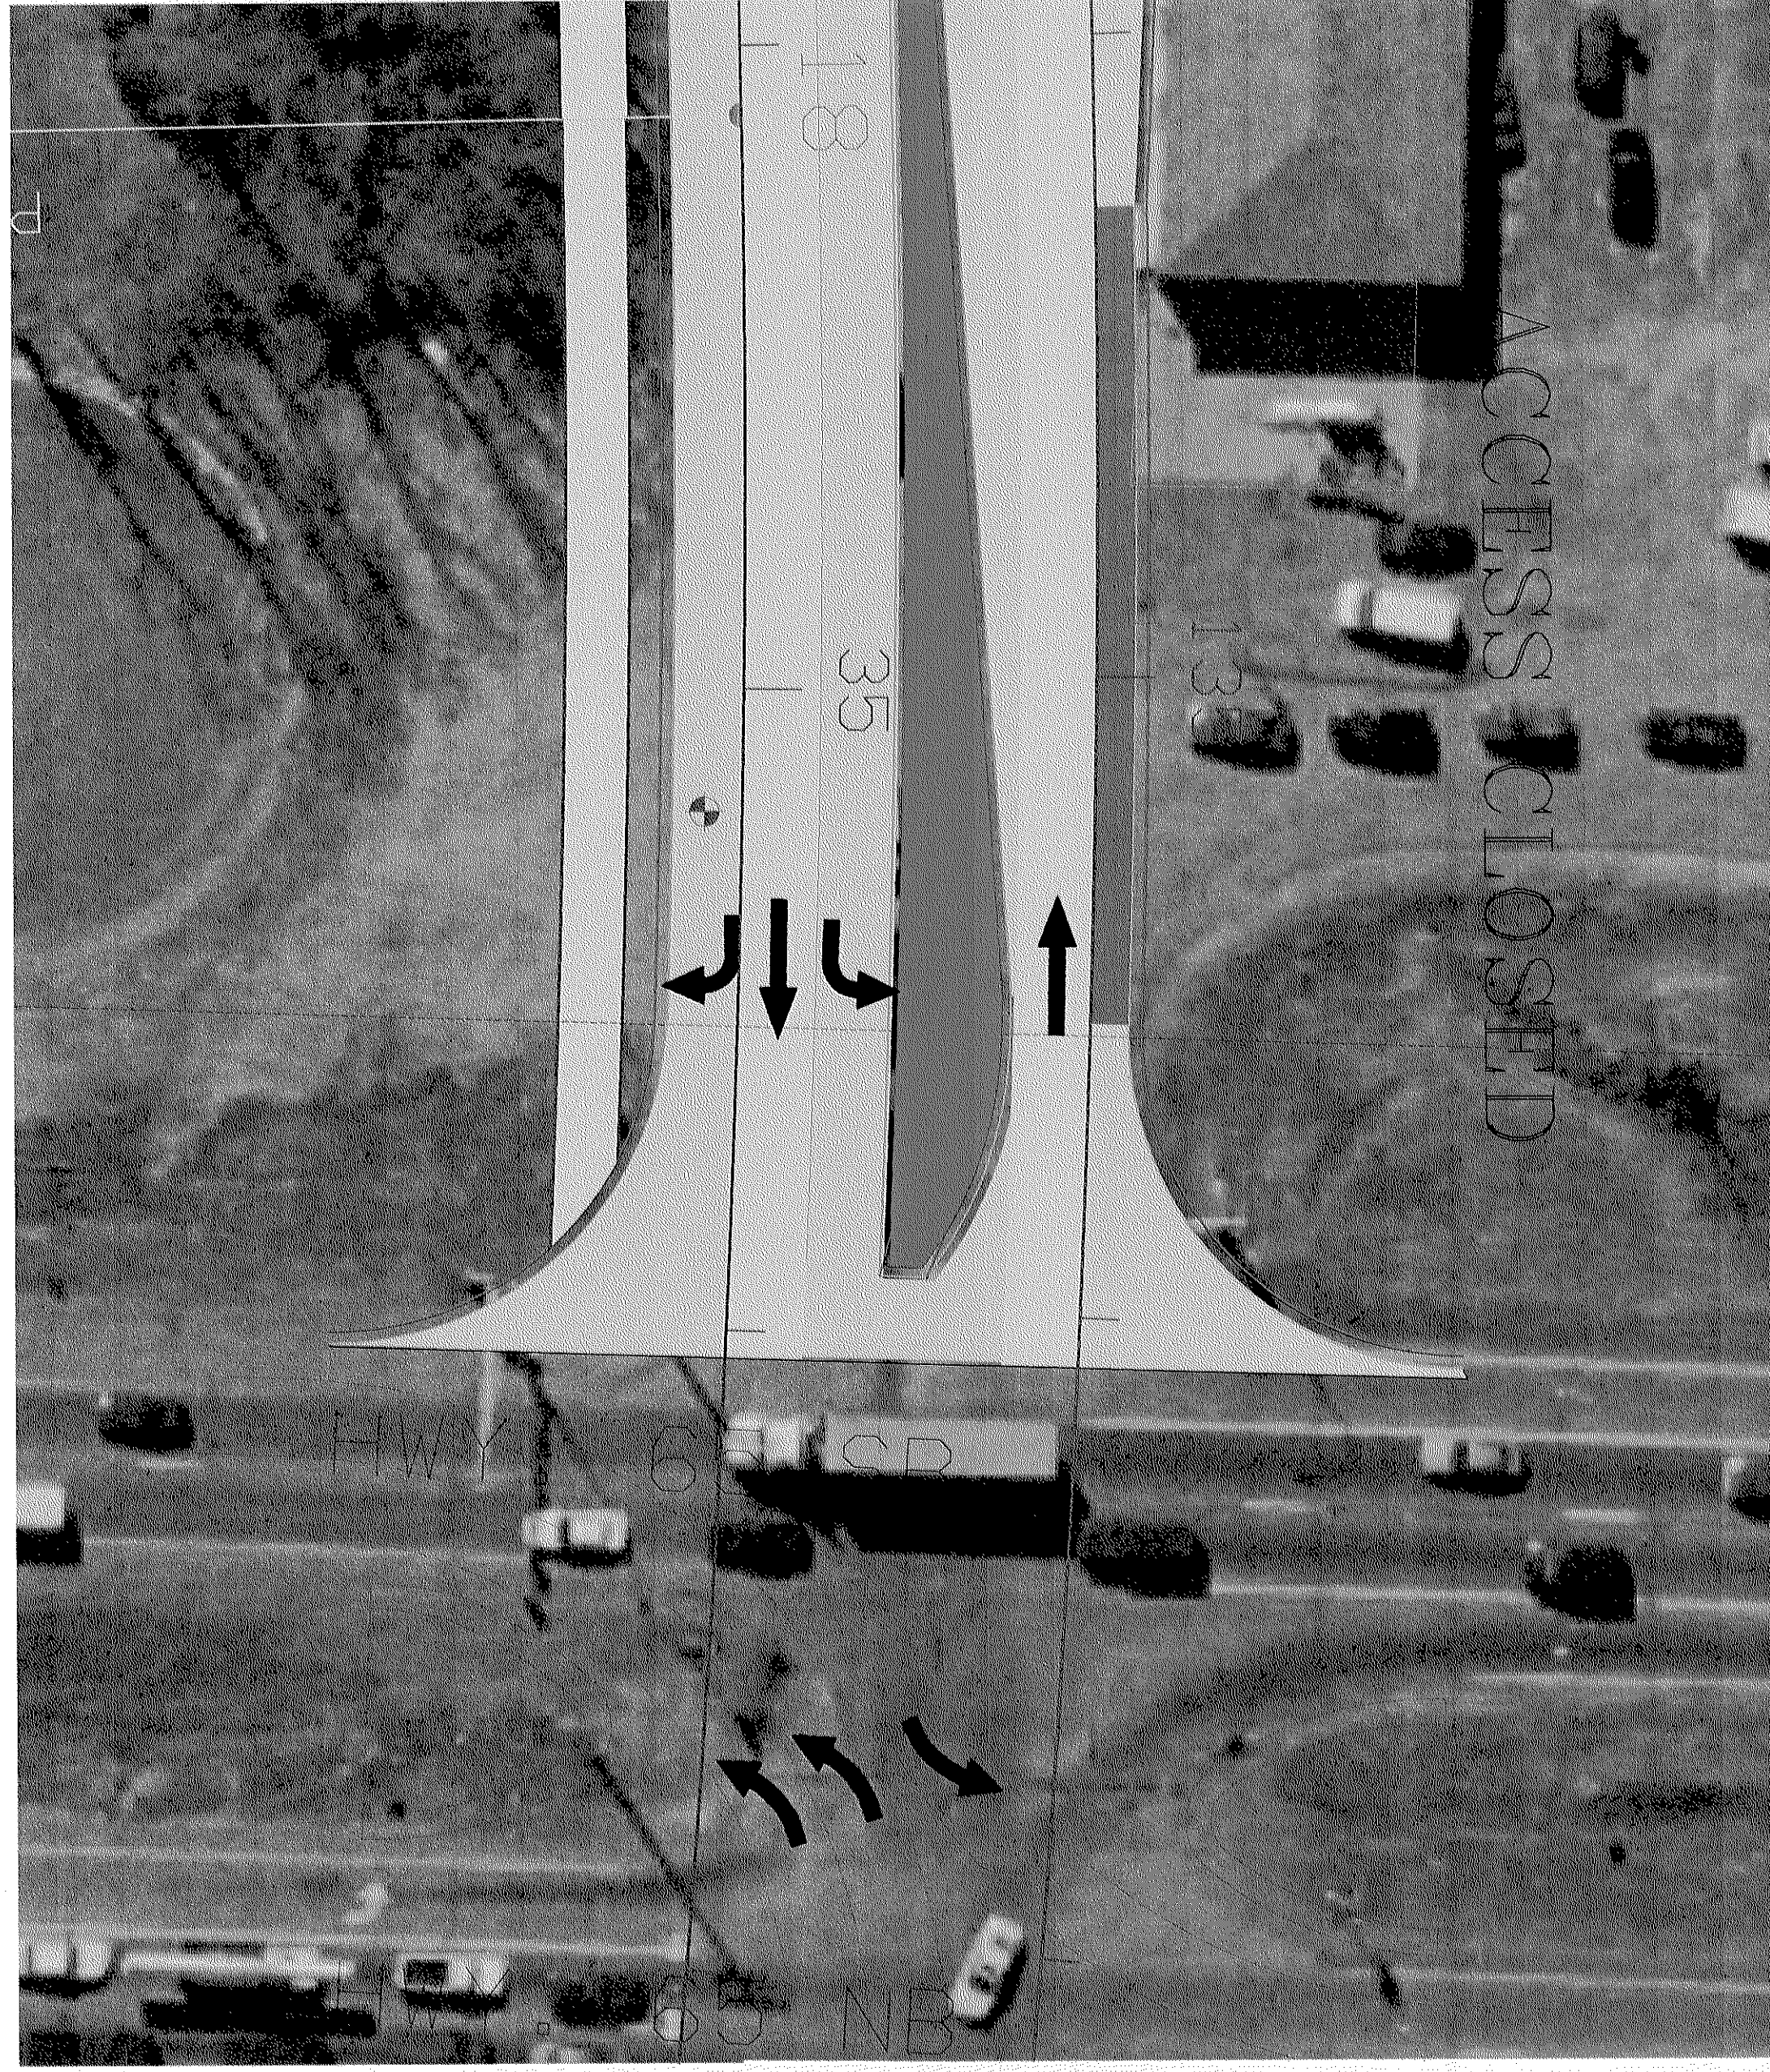

ACCESS CLOSED

35

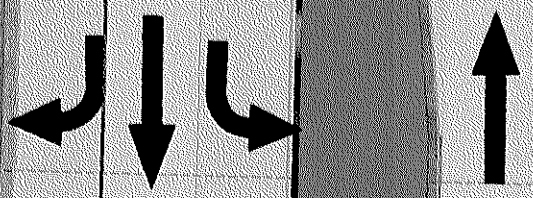


HWY


65 RD

N




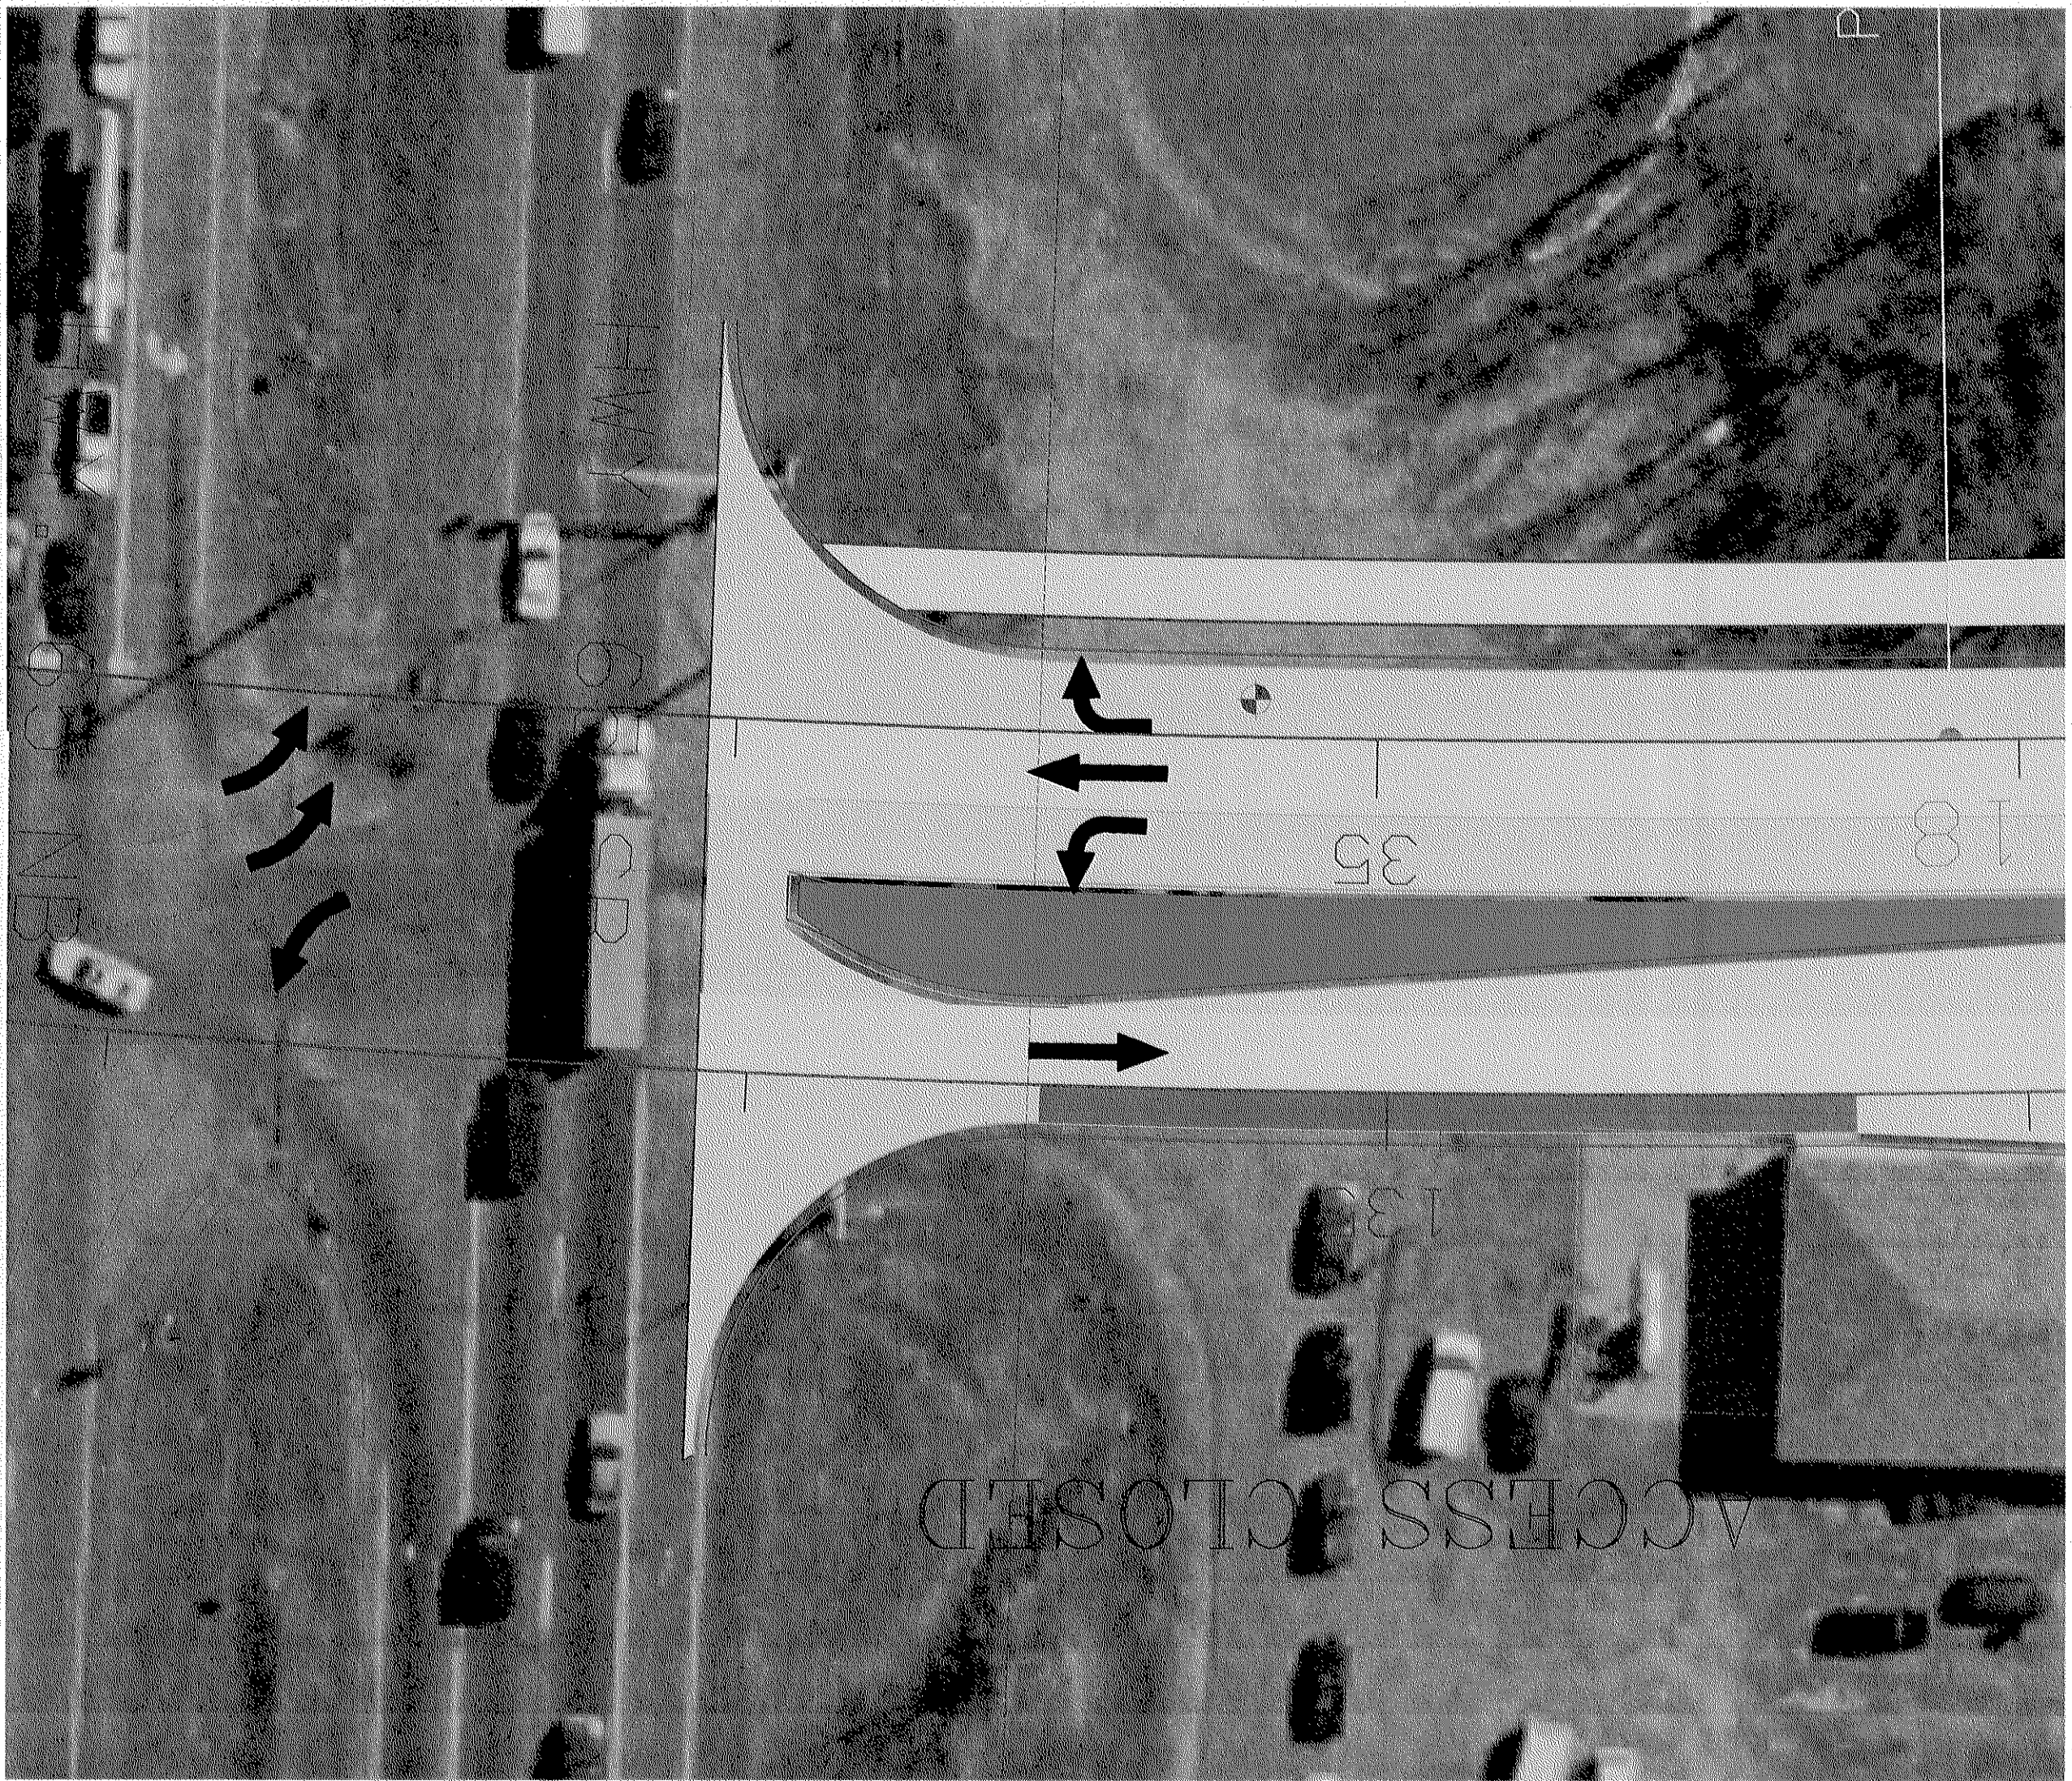



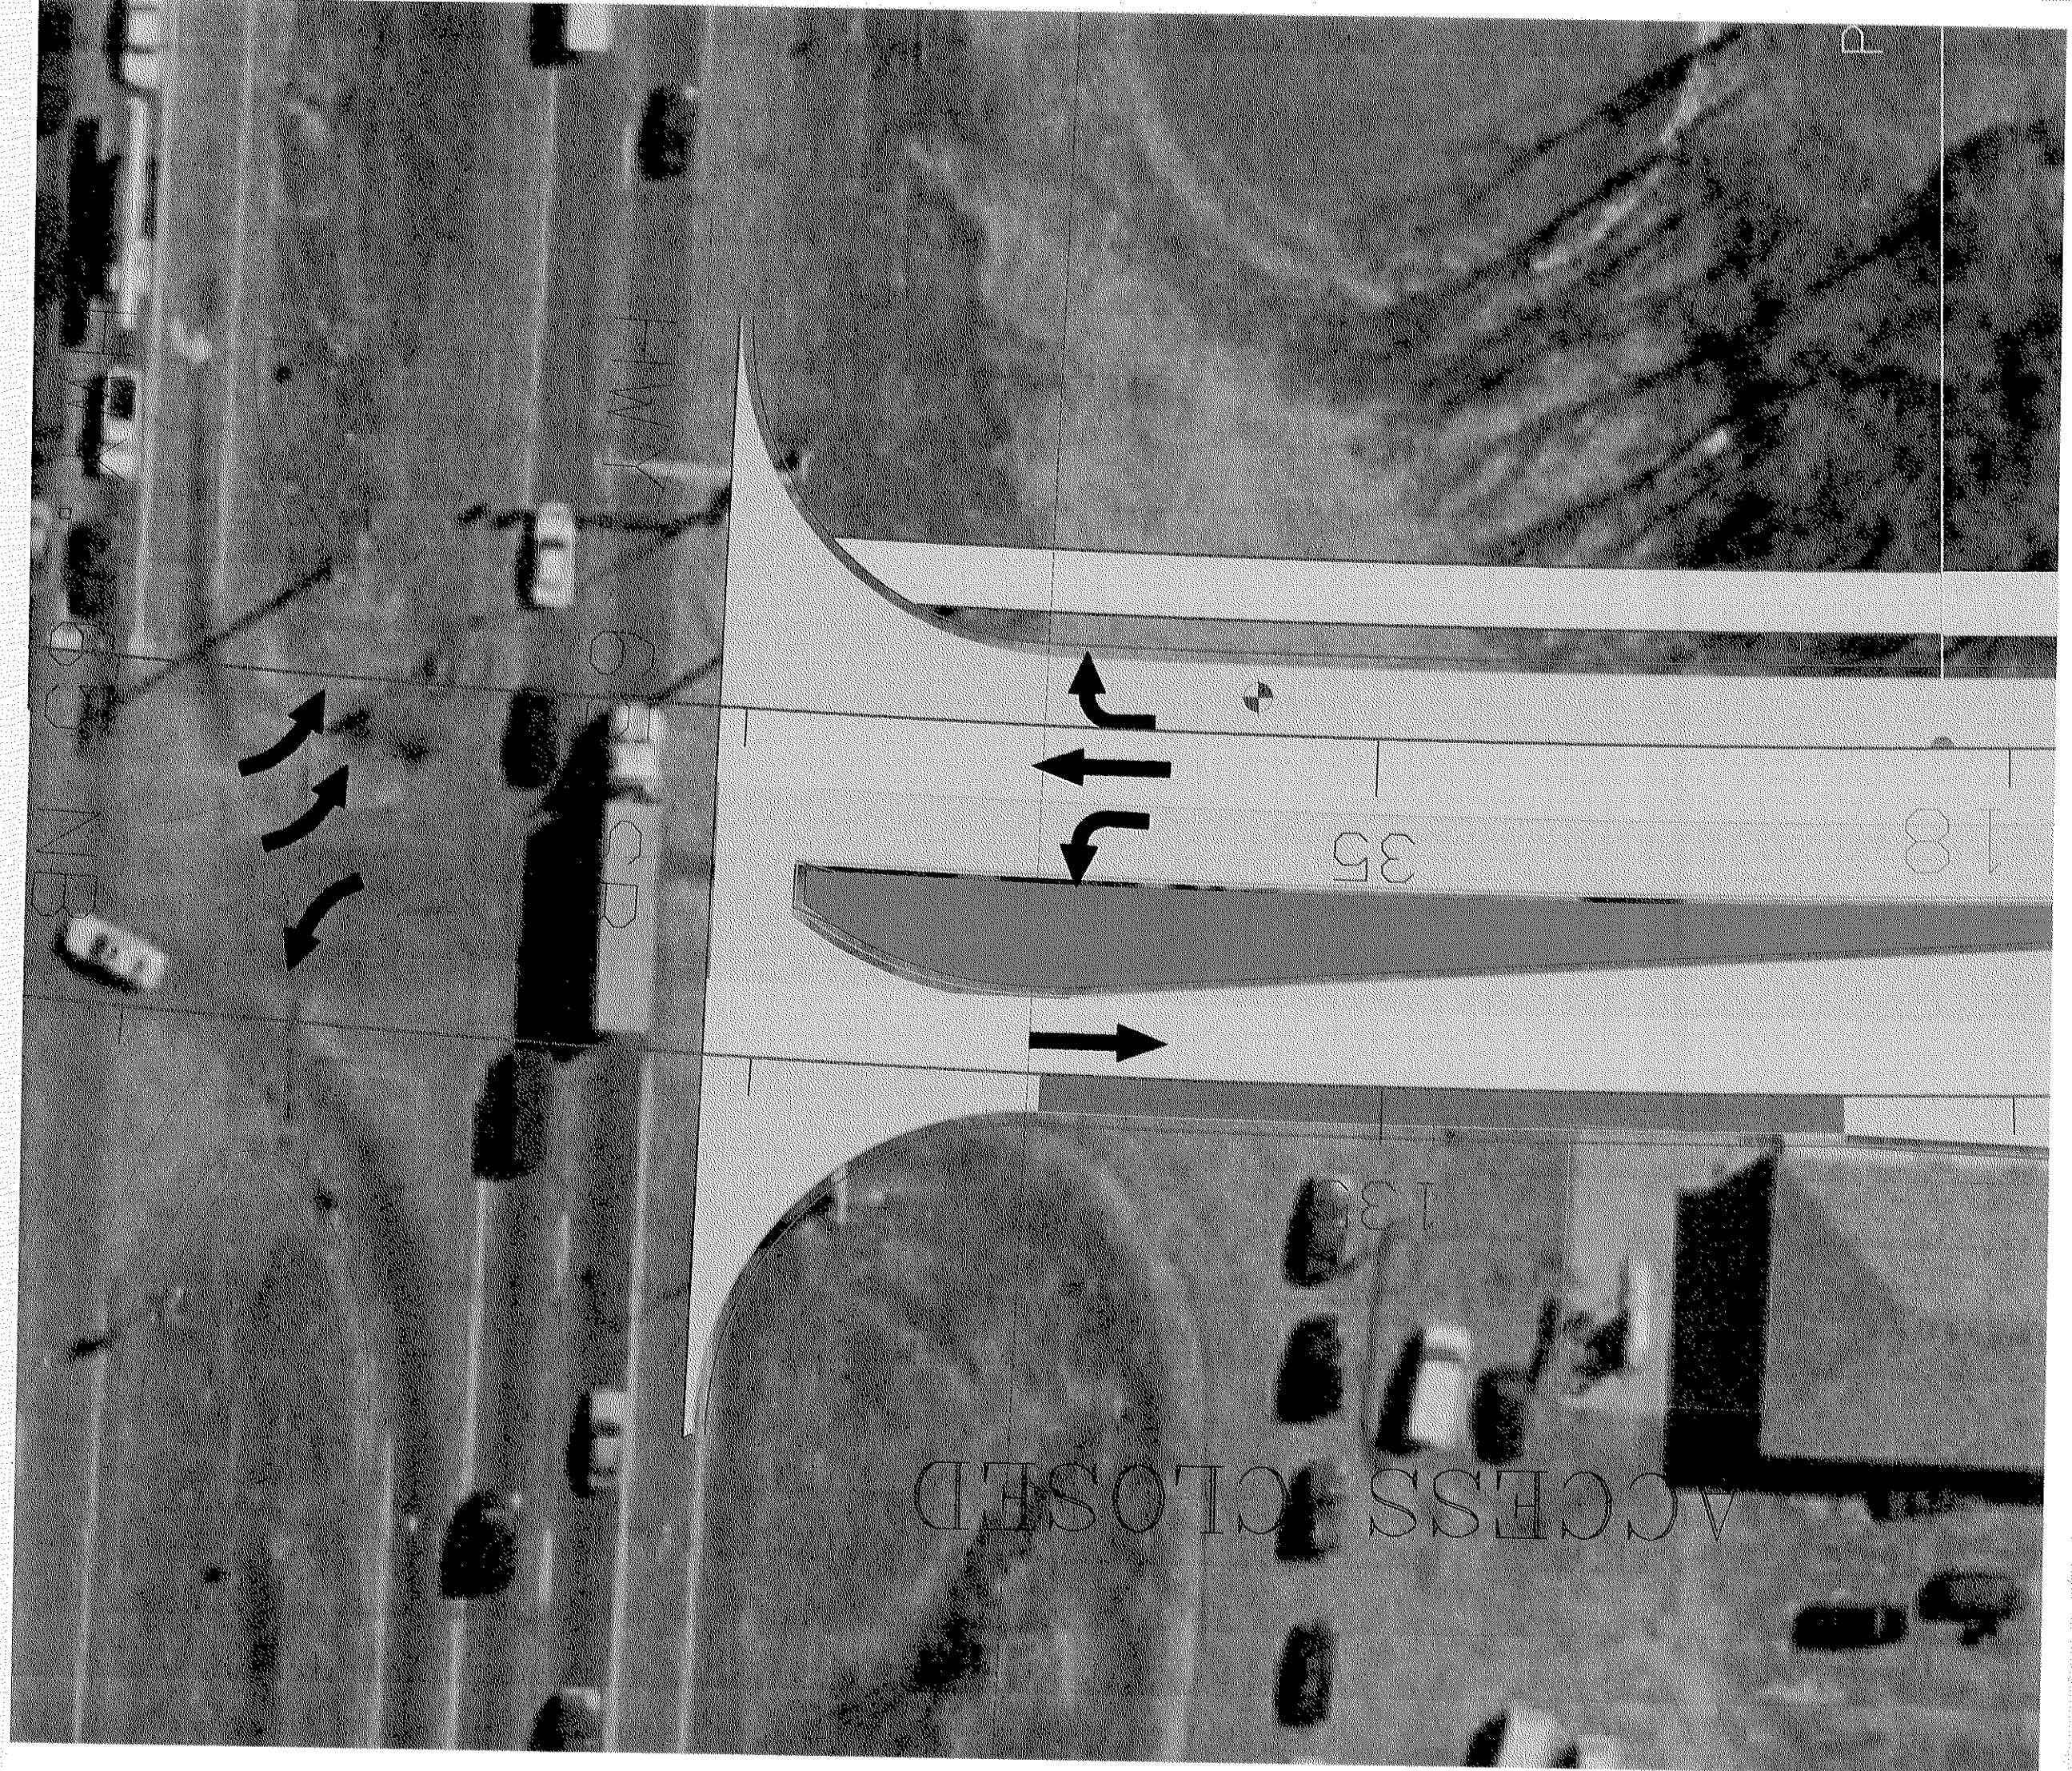




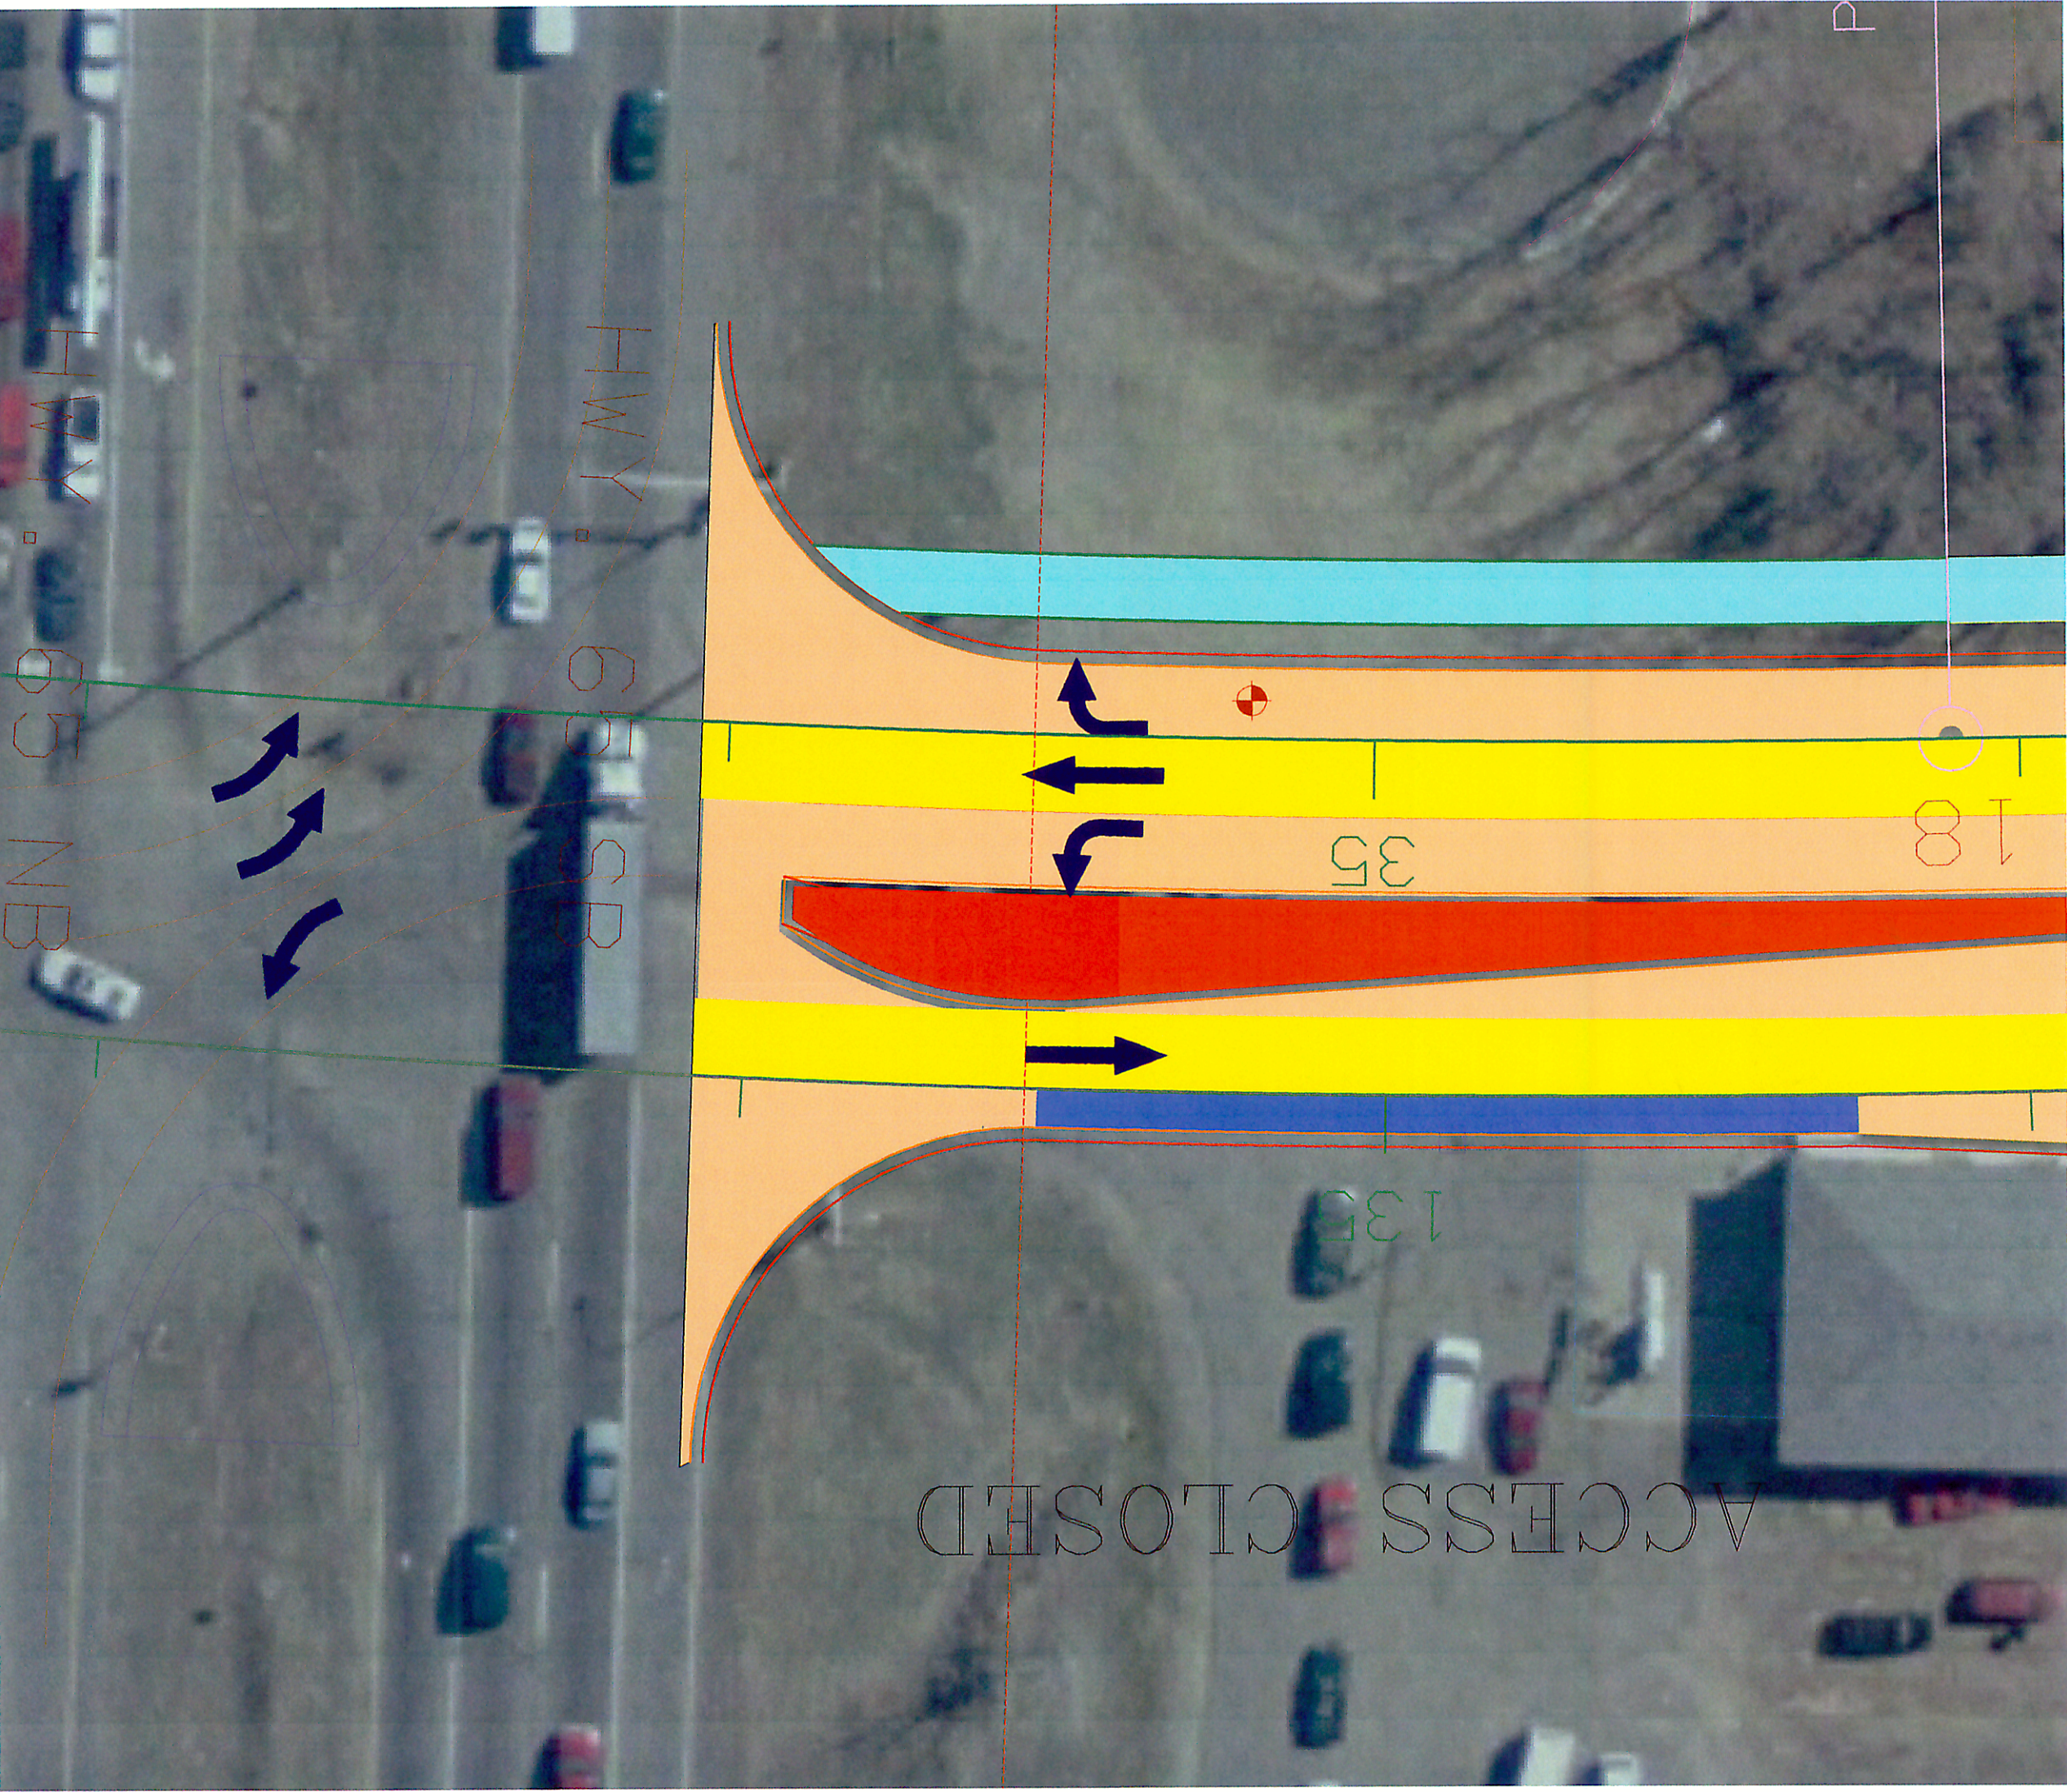

HWY 65 NB

HWY 65 SB

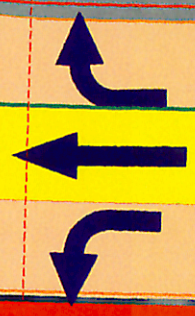


35

18


135

ACCESS CLOSED




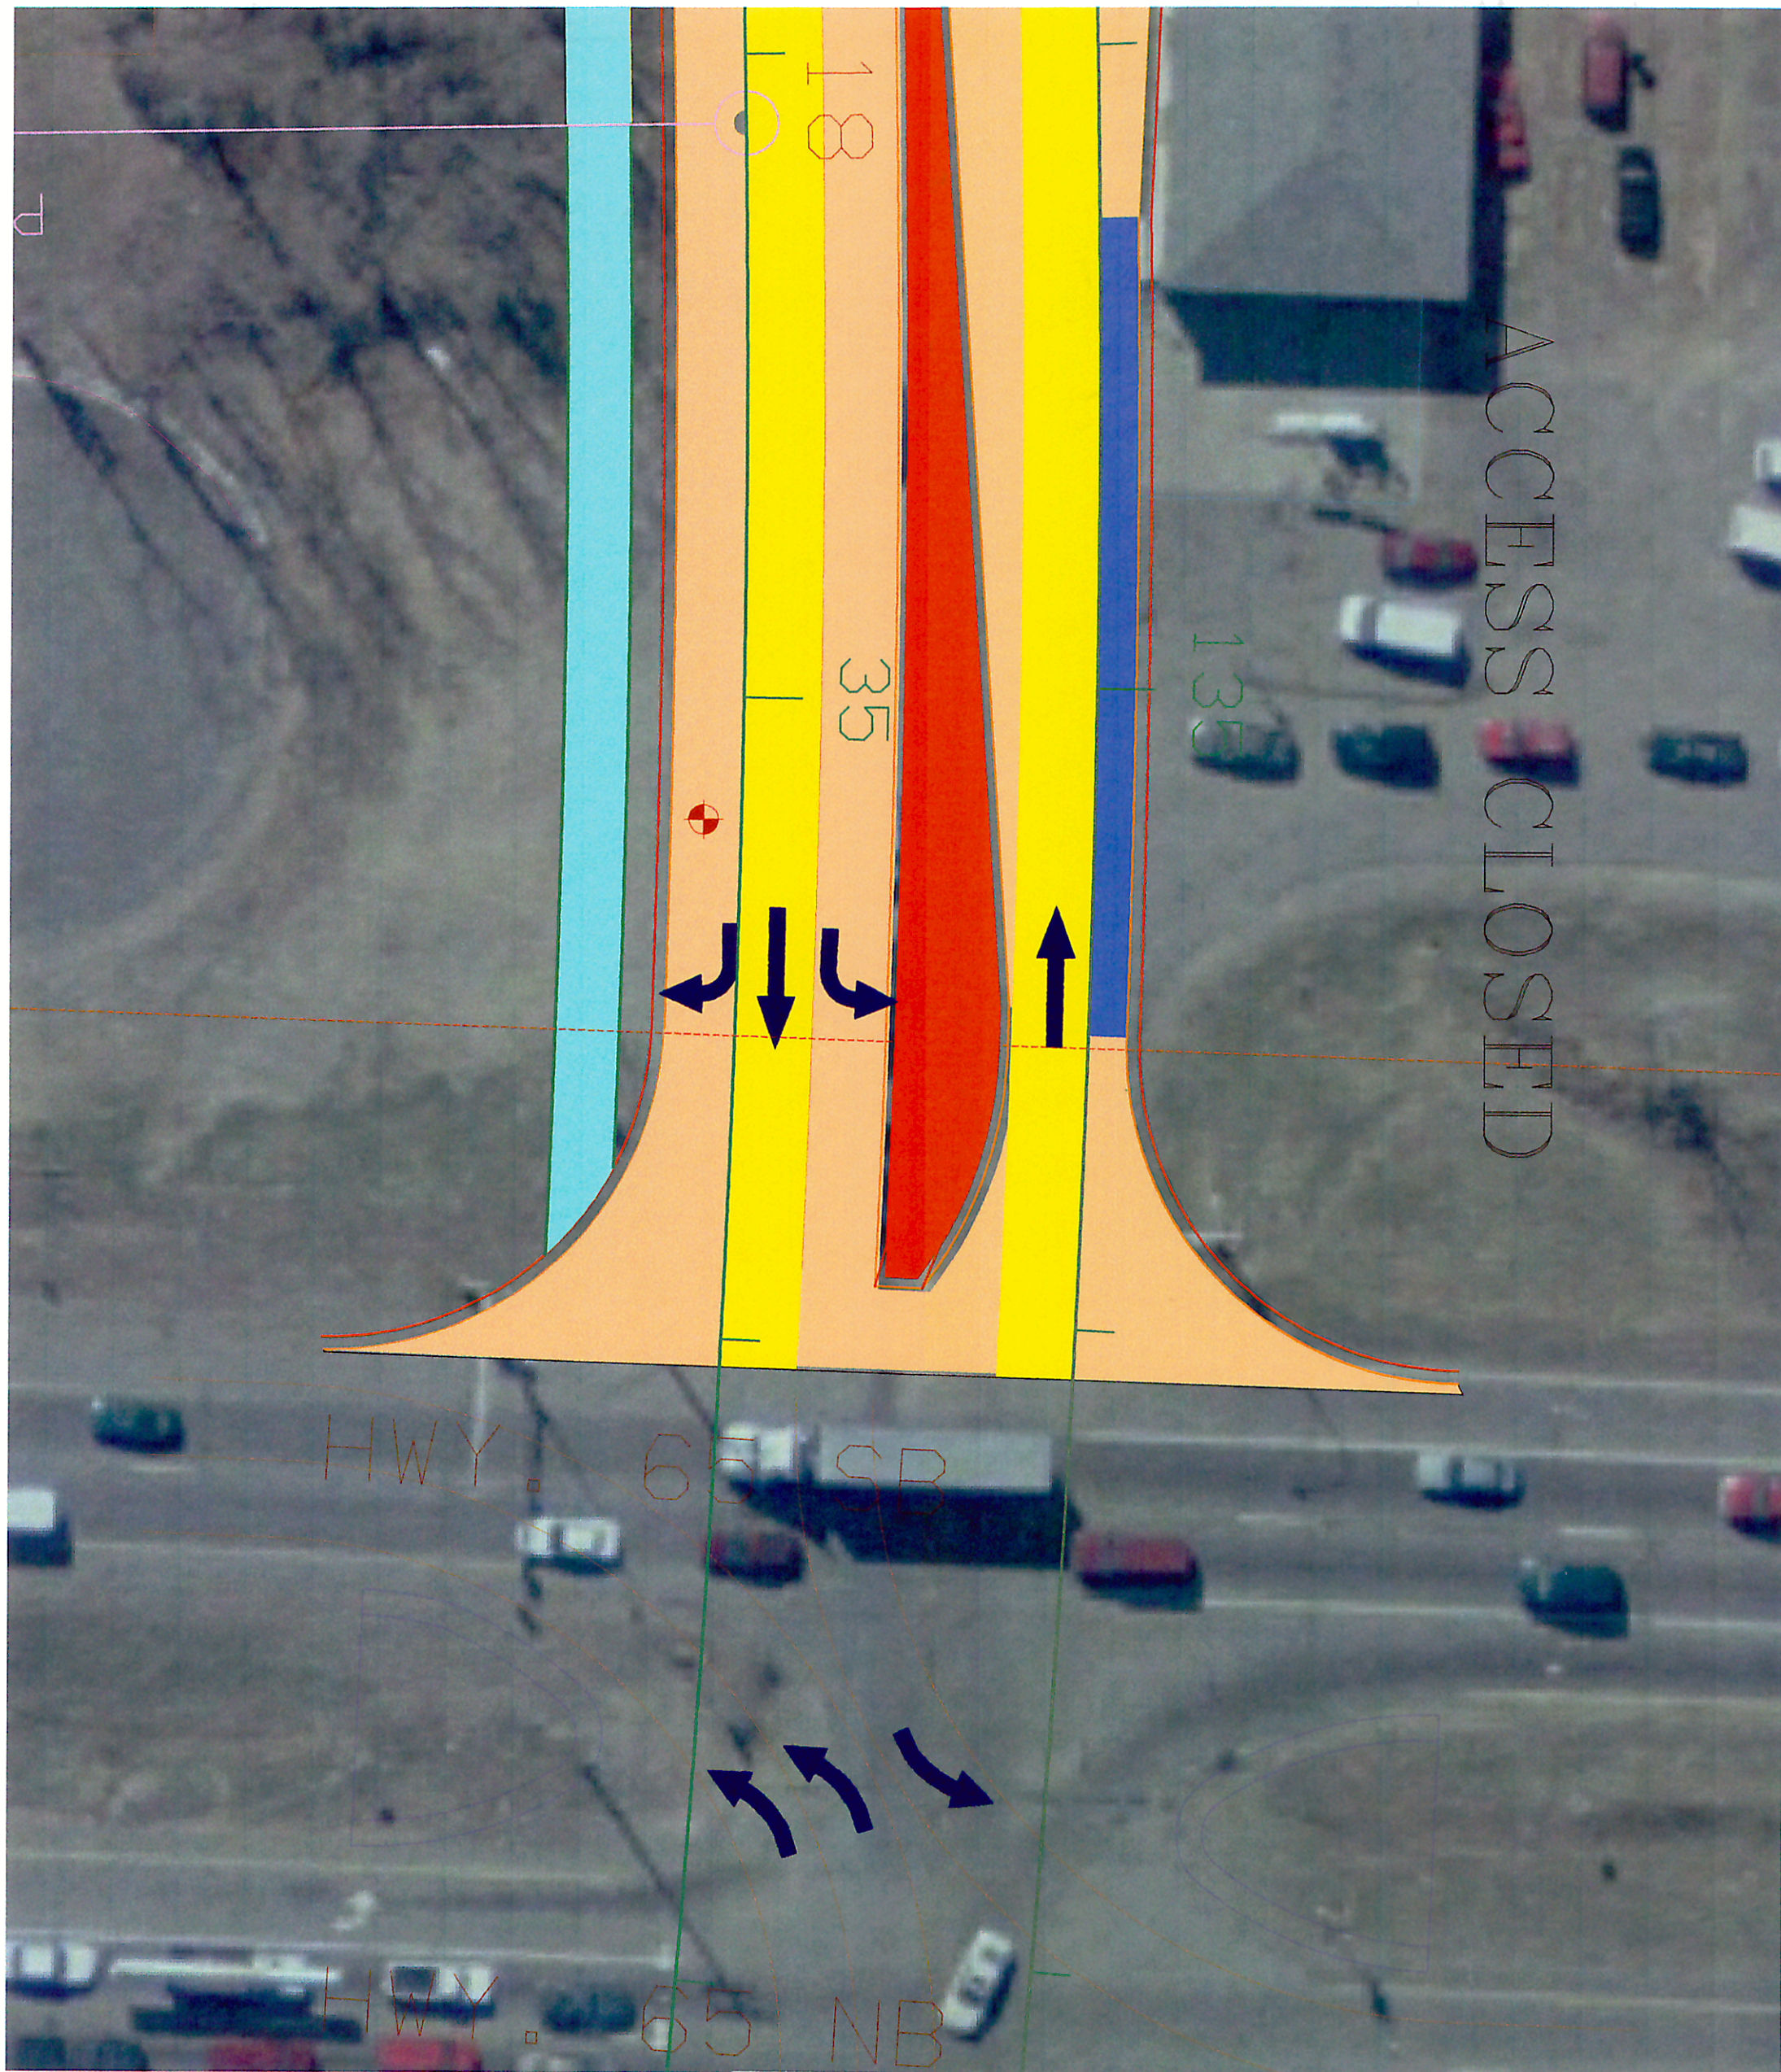



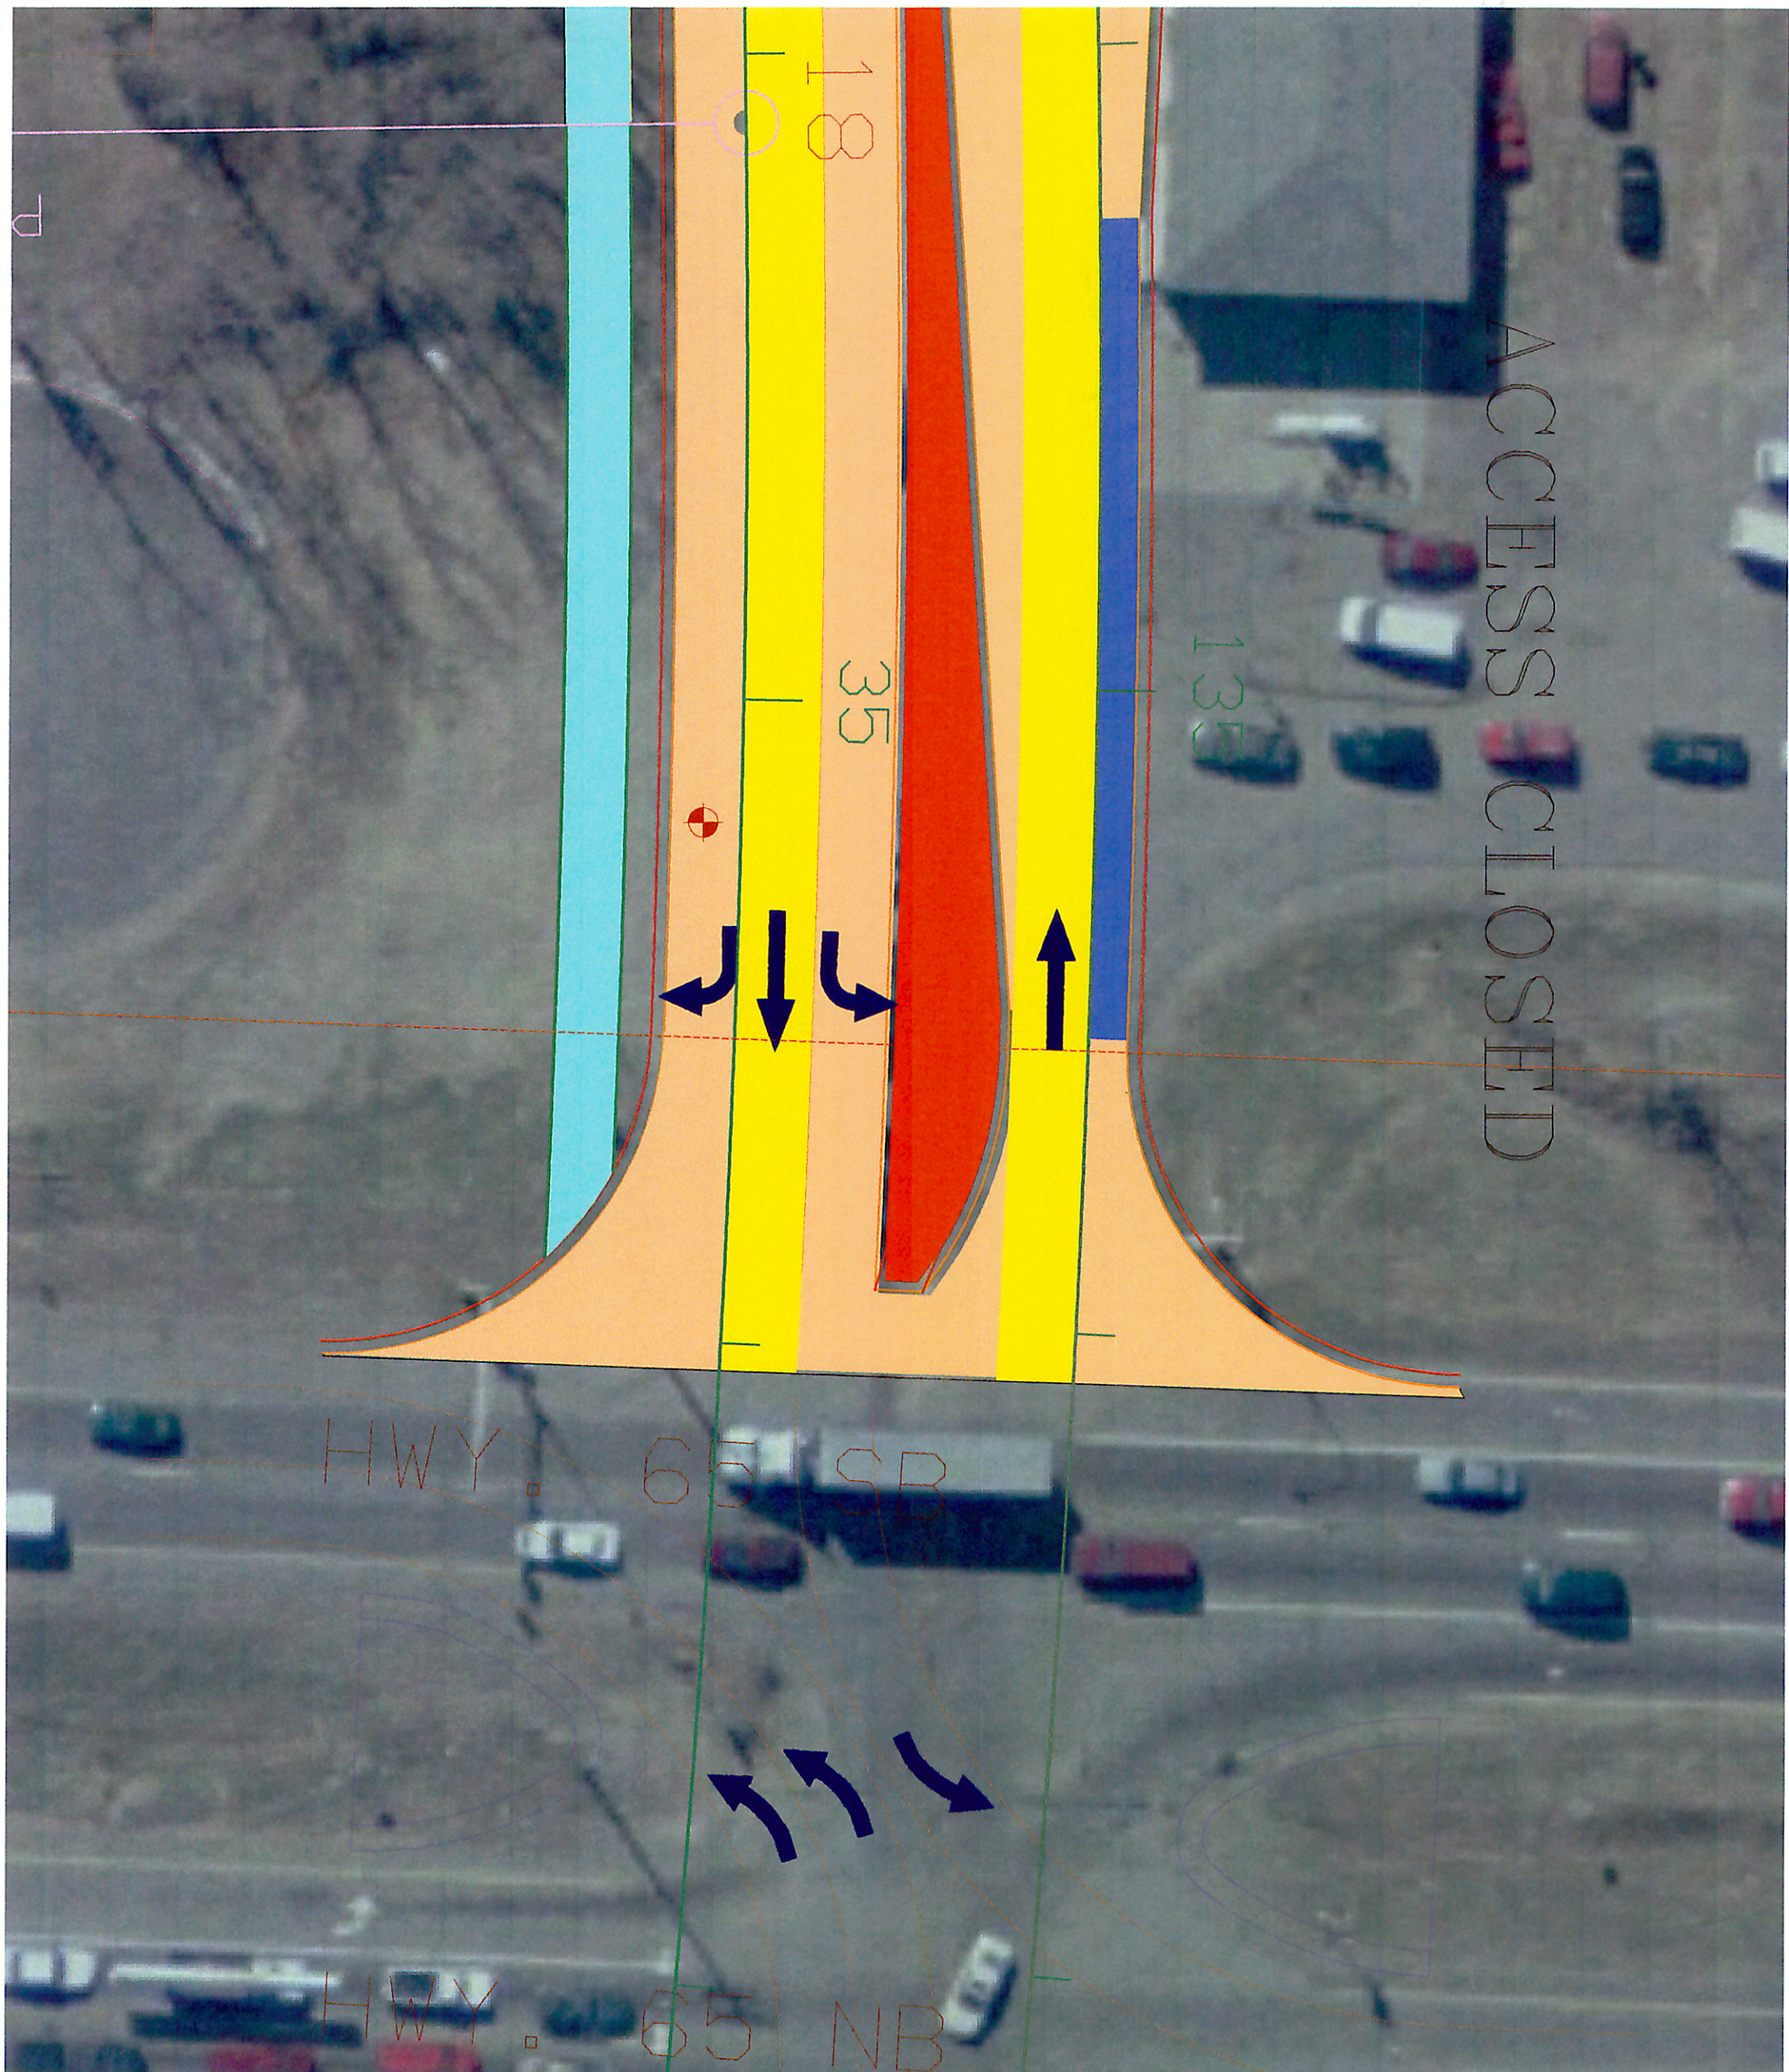



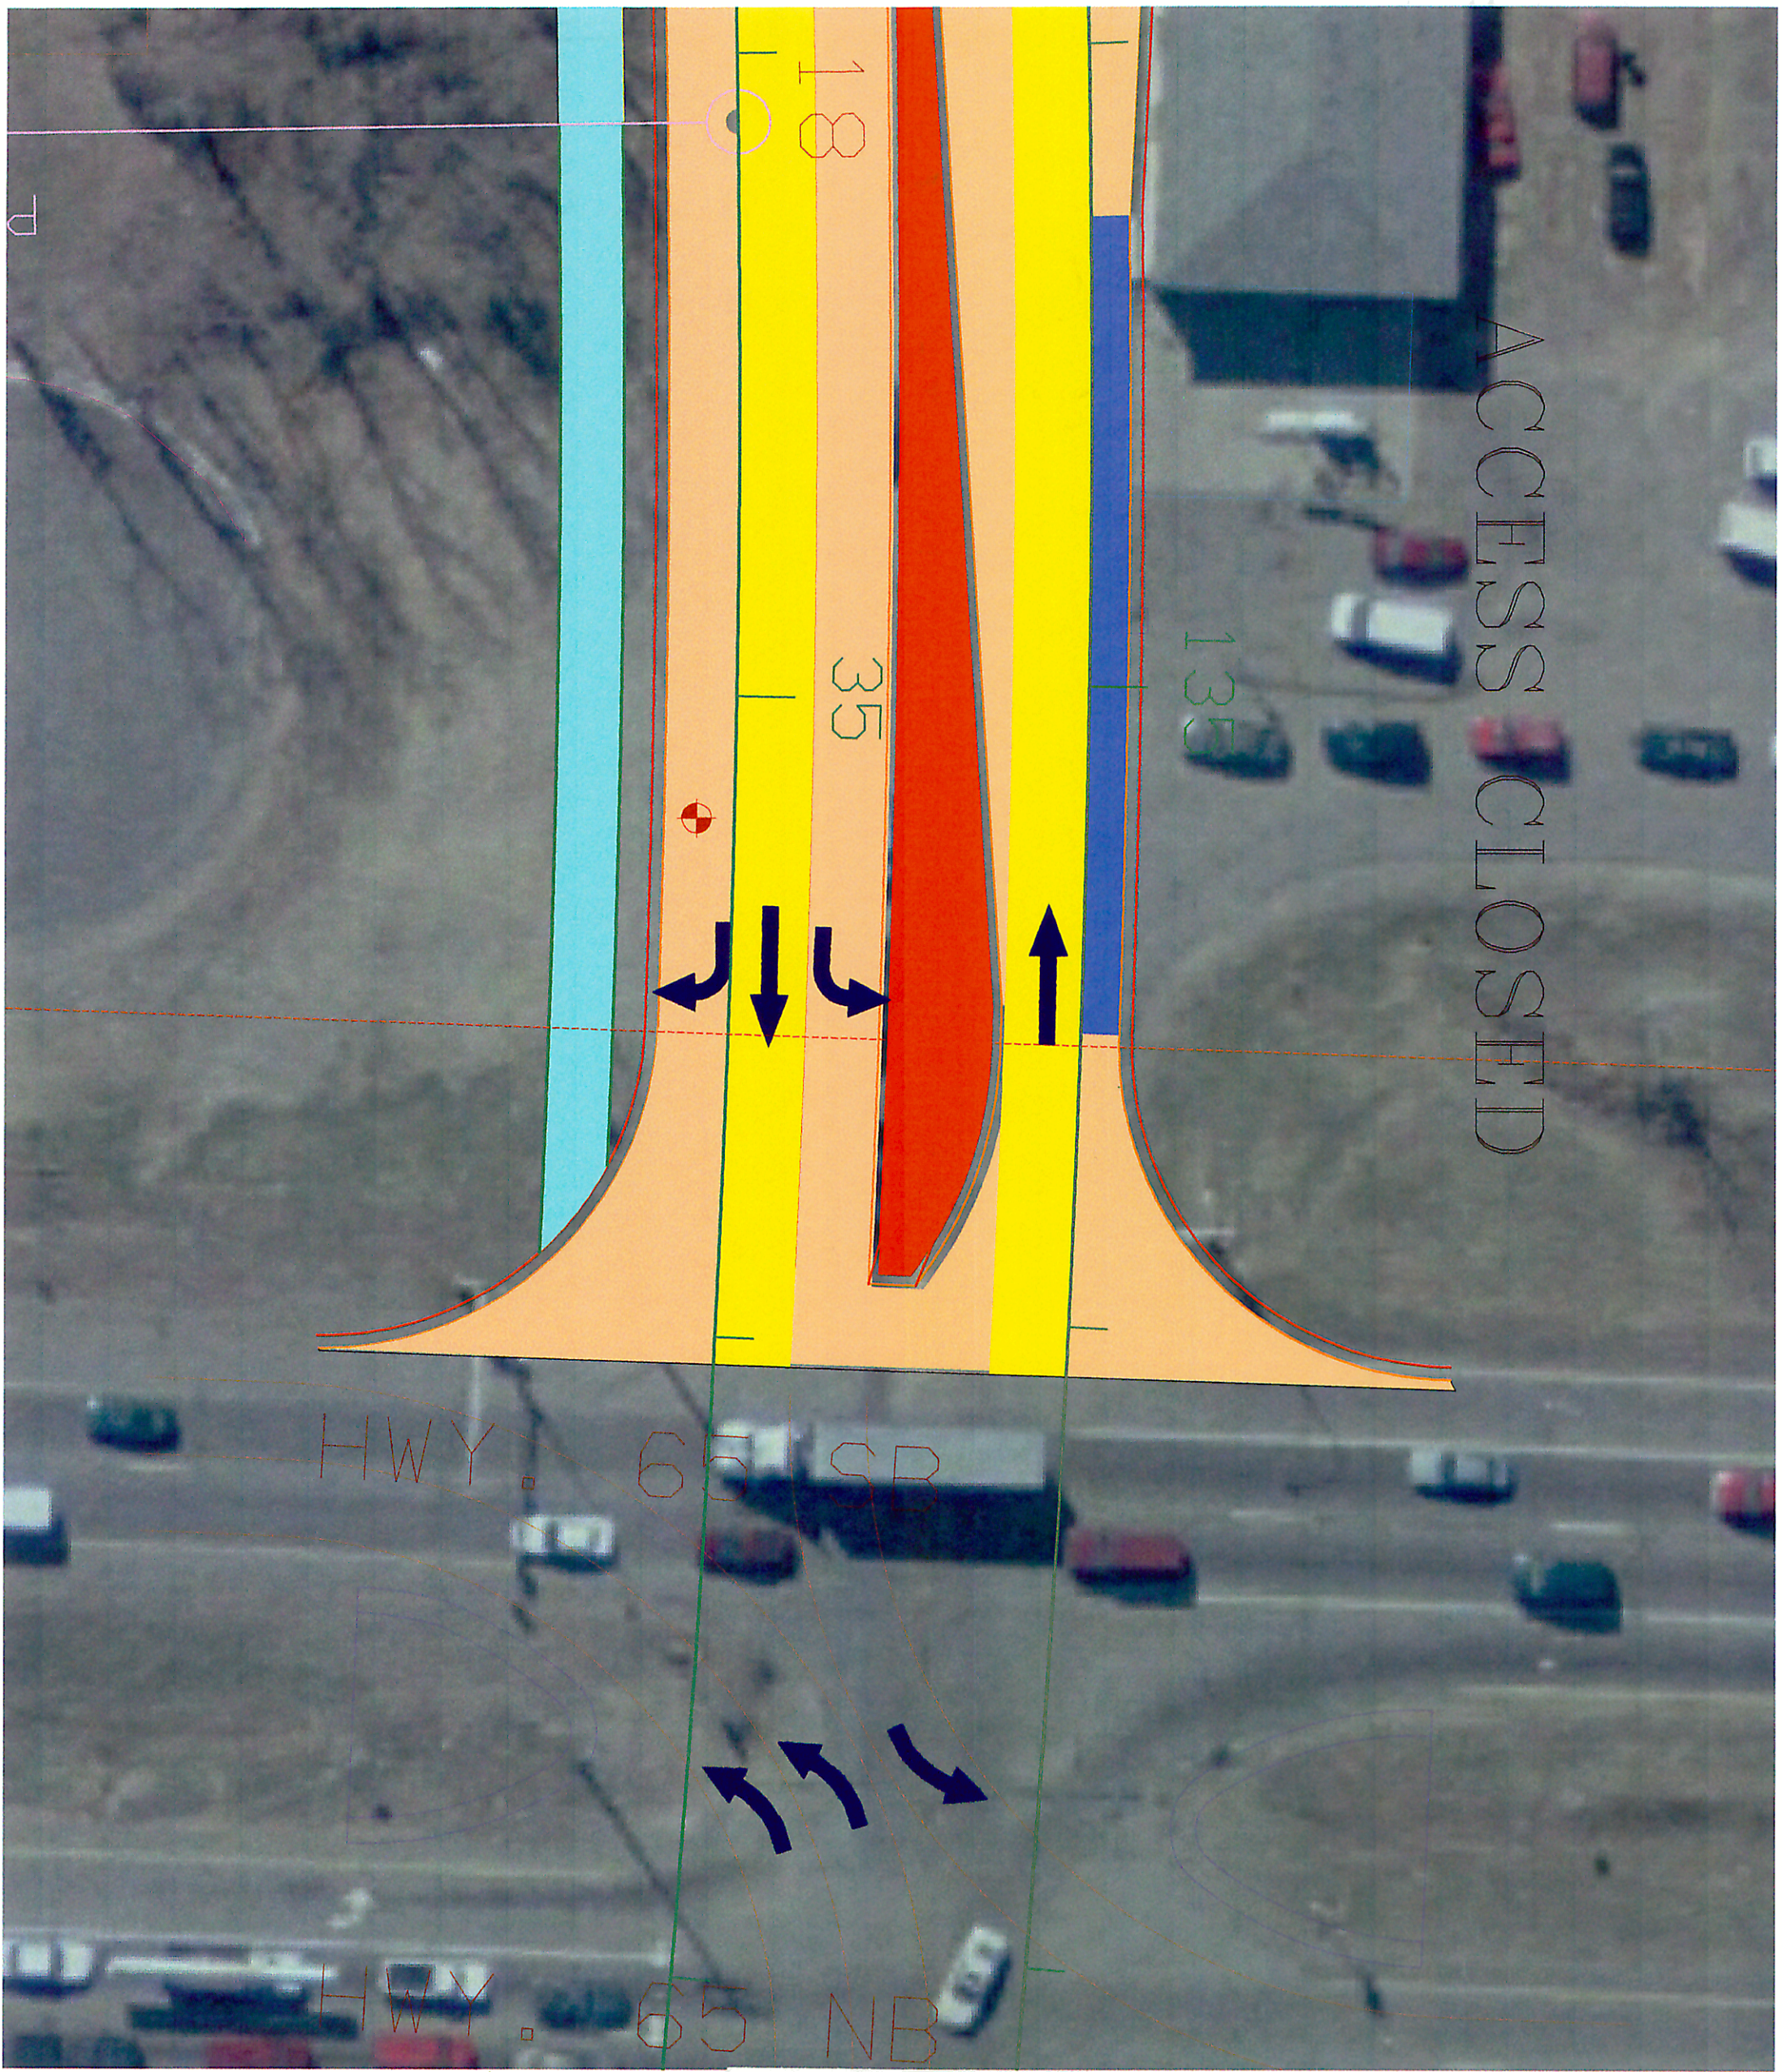

ACCESS CLOSED

135

35

18

HWY. 65 SB

HWY. 65 NB





STATE AID CLAIMS

P-YEAR	RD NUM	PROJ NUM	DESCRIPTION	TYPE	ELIGIBLE COST	CLAIMED COSTS																
						Total	Abatement	ROW ATF Needs	1994	1995	1996	1997	1998	1999	2000	2001	2002					
1996	1	02-601-35	EAST RIVER RD From TH 610 To JANEVILLE ST. (RECONSTRUCTION)	R	Eng (28X)	\$309,294.22	\$31,844,452.29	Abatement														
					ROW (28X)	\$1,094,832.06	\$20,021,999.61	ROW ATF Needs														
					Cont (20-27X)		\$31,341,561.06	C/FLE														
1996	3	02-600-11	TRANSIT HUB AT NORTHOWN MALL (PARK & RIDE LOT)	NO BRC	Eng (28X)	na		Abatement														
					ROW (28X)	na		Abatement														
					Cont (20-27X)			Abatement														
1996	6	02-606-09	MISSISSIPPI ST AT HOLLY CENTER (CHANNELIZATION)	NO BRC	Eng (28X)	na	\$14,200.00	Misc ATF Needs														
					ROW (28X)	na		Abatement														
					Cont (20-27X)			Abatement														
1996	8	02-606-08	OSAGE RD @ TH 47 (CHANNELIZATION)	Eng (28X)	na	\$8,917.00	Misc ATF Needs															
					ROW (28X)	na		Abatement														
					Cont (20-27X)			Abatement														
1996	9	02-609-04	ROUND LAKE BLVD AT CEDAR CREEK (BRIDGE REPLACEMENT)	R	Eng (28X)	na		Abatement														
					ROW (28X)	na	\$30.00	ROW ATF Needs														
					Cont (20-27X)		\$246,597.17	Abatement														
1996	23	02-623-07	LAKE DR AT NORTHWOODSON (RECONSTRUCTION)	TB	Eng (28X)	na		Abatement														
					ROW (28X)	na	\$628,207.63	ROW ATF Needs														
					Cont (20-27X)		\$75,000.00	Misc ATF Needs														
1996	79	96-71-79	Signal at GSH#178 and 11298	TB	Eng (28X)	na		Abatement														
					ROW (28X)	na		Abatement														
					Cont (20-27X)		\$628,207.63	Abatement														
1997	17	02-617-08	LEXINGTON AVE From NORTH RD. To PHEASANT RIDGE RD. (RECONSTRUCTION BRIDGE) Includes EA from GSH# 23 to CR 18	R	Eng (28X)	na	\$1,108,432.63	Abatement														
					ROW (28X)	\$1,108,432.63	ROW ATF Needs															
					Cont (20-27X)			Abatement														
1997	17	02-617-11	LEXINGTON AVE From NORTH RD. To PHEASANT RIDGE RD. (RECONSTRUCTION BRIDGE)	R	Eng (28X)	na		Abatement														
					ROW (28X)	\$620,835.34	ROW ATF Needs															
					Cont (20-27X)		\$7,187,083.01	Abatement														
1997	116	02-716-01	BLUNKER LAKE BLVD AT TH#7 (CHANNELIZATION)	Eng (28X)	na		Abatement															
					ROW (28X)	na		Abatement														
					Cont (20-27X)		\$188,911	ROW ATF Needs														



STATE AID CLAIMS

P YEAR	RD NUM	PROJ NUM	DESCRIPTION	TYPE	ELIGIBLE COST	TOTAL	CLAIMED COSTS	1984	1985	1986	1987	1988	1989	1990	1991	1992		
1996	1	02-601-35	EAST RIVER RD From TH 610 To JANEVILLE ST. (RECONSTRUCTION)	R	Eng (28X) \$309,294.22 RW (28X) \$1,094,932.06 Cont (20-27X)	\$31,341,991.05 \$309,294.22 \$1,094,932.06 \$798,488.69	Abolment ROW ATF Needs Abolment ROW ATF Needs											
1996	3	02-600-11	TRANSPORT HUB AT NORTHOWN MALL (PARK & RIDE LOT)		NO BRC Eng (28X) RW (28X) Cont (20-27X)	na na na	Abolment ROW ATF Needs Abolment											
1996	6	02-600-09	MISSISSIPPI ST. AT HOLLY CENTER (CHANNELIZATION)		NO BRC Eng (28X) RW (28X) Cont (20-27X)	na na na	Abolment ROW ATF Needs Abolment											
1996	8	02-600-08	OSBORN RD @ TH 47 (CHANNELIZATION)		Eng (28X) RW (28X) Cont (20-27X)	na na na	Abolment ROW ATF Needs Abolment											
1996	9	02-600-04	ROUND LAKE BLVD AT CEDAR CREEK (BRIDGE REPLACEMENT)	R	Eng (28X) RW (28X) Cont (20-27X)	na na na	Abolment ROW ATF Needs Abolment											
1996	23	02-623-07	LAKE DR AT WOODSON (RECONSTRUCTION)	TB	Eng (28X) RW (28X) Cont (20-27X)	na na na	Abolment ROW ATF Needs Abolment											
1996	79	99-77-79	Signal at CSAH 79 and TH 88		Eng (28X) RW (28X) Cont (20-27X)	na na na	Abolment ROW ATF Needs Abolment											
1997	17	02-617-08	LEXINGTON AVE From NORTH RD To PHEASANT RIDGE (RECONSTRUCTION BRIDGE) (PHEASANT RIDGE EXIST 2310 ON 18)	R	Eng (28X) RW (28X) Cont (20-27X)	na \$1,164,881.72 na	Abolment ROW ATF Needs Abolment											
1997	17	02-617-11	LEXINGTON AVE From NORTH RD To PHEASANT RIDGE (RECONSTRUCTION BRIDGE)	R	Eng (28X) RW (28X) Cont (20-27X)	na \$820,633.34 na	Abolment ROW ATF Needs Abolment											
1997	118	02-716-01	BUNGER LAKE BLVD AT TH 47 (CHANNELIZATION)		Eng (28X) RW (28X) Cont (20-27X)	na na na	Abolment ROW ATF Needs Abolment											



STATE AID CLAIMS

RED: Amount initially claimed  
 GREEN: Amount made and amount  
 BLUE: Patent Form (relief withheld)  
 BLACK: FINAL PAYMENT

P YEAR	RID NUM	PROJ NUM	DESCRIPTION	TYPE	ELIGIBLE COST	TOTAL COST TO DATE	TOTAL COST TO DATE	1984	1985	1986							\$0	\$0																										
1996	1	02-601-36	EAST RIVER RD. FROM TH 610 TO JAMESVILLE SQ (RECONSTRUCTION)	R	Eng (28X) RW (28X) Cont (03-27X)	\$309,284.22 \$1,094,932.00 \$799,448.89	na na na																										
1996	3	02-603-11	TRANSPORTATION AT RIVER LOT	R	Eng (28X) RW (28X) Cont (03-27X)	na na na	na na na																										
1996	6	02-603-09	ROBERTSON ST. AT HULLY MEYER (CHANNELIZATION)	R	Eng (28X) RW (28X) Cont (03-27X)	na na na	na na na																										
1996	8	02-603-08	GEORGE RD. AT TH 417 (CHANNELIZATION)	R	Eng (28X) RW (28X) Cont (03-27X)	na na na	na na na																										
1996	23	02-603-07	LAKE DR. AT WOODSON (RECONSTRUCTION)	R	Eng (28X) RW (28X) Cont (03-27X)	na na na	na na na																										
1996	79	06-71-79	Segment at CSAY 75 and TH 288	TB	Eng (28X) RW (28X) Cont (03-27X)	na na na	na na na																										
1997	17	02-617-08	LEXINGTON AVE. From NORTH RD. to PHEASANT RIDGE RD. (BIDGES) Includes EA from CSAY 23 to CR 18	R	Eng (28X) RW (28X) Cont (03-27X)	na \$1,164,981.72 na	na na na																										
1997	17	02-617-11	LEXINGTON AVE. From NORTH RD. to PHEASANT RIDGE (RECONSTRUCTION)	R	Eng (28X) RW (28X) Cont (03-27X)	na \$620,833.34 na	na na na																										
1997	118	02-718-01	BUNKER LAKE BND. AT TH 97 (CHANNELIZATION)	R	Eng (28X) RW (28X) Cont (03-27X)	na na na	na na na																										



N 1/2

