

ANOKA COUNTY HIGHWAY DEPARTMENT
 1440 BUNKER LAKE BLVD. N.W.
 ANDOVER, MN 55304
 PHONE (763) 862-4200

APPLICATION FOR PERMIT FOR INSTALLATION OF UTILITIES OR FOR PLACING OBSTRUCTIONS ON COUNTY HIGHWAY SYSTEM

OFFICE USE ONLY	
Permit Number	23-190
CSAH/C.R.	1
License/Permit Bond Required \$	on file

Permit Fee \$ 150.00

Name of applicant:	<u>CITY OF ANOKA Electric Dept</u>	Telephone:	
Address (street, city, state, zip code):	<u>501 Pierce St Anoka MN 55303</u>		
Name of individual/company performing work:	<u>Metro General (Date) 612-369-1069</u>		
Nature of work:	<u>Manholes Cover + Lid repair</u>	Method of installation/construction:	<u>Open cut, traffic control</u>
Address of work site:	<u>5th + Adams St Anoka MN</u>	In the city/township of:	<u>Anoka</u>
Surface to be disturbed:	<input type="checkbox"/> Ditch <input type="checkbox"/> Gravel <input checked="" type="checkbox"/> Bituminous <input type="checkbox"/> Concrete <input type="checkbox"/> None	Is the shoulder to be disturbed?	<input type="checkbox"/> Yes <input checked="" type="checkbox"/> No
Number and size of excavations:	<u>4x4 cut for frame + cover repair</u>	Will traffic be obstructed in any way?	<input checked="" type="checkbox"/> Yes <input type="checkbox"/> No
Size and kind of pipe/cable:	<u>—</u>	Depth from surface:	<u>12"</u>
Work to start on or after:	<u>4-28-23</u>	Work to be completed by:	<u>6-1-23</u>
Restrictions: <u>manhole is located in the right south bound lane of 5th rd.</u> <u>Right South Bound Lane Closure Lane closure 9AM-3pm only, layout 42</u>			

GENERAL INFORMATION

One permit must be approved for each County Road on which work will be performed prior to any work within the right-of-way by any utility/contractor. Emergency conditions which threaten the safety of the public and require immediate repair are exceptions to this rule. The utility/contractor, under these conditions, is permitted to begin and/or complete the necessary repairs. A written permit is to be completed at the earliest possible date.

A license-permit bond is generally required of the contractor, the amount of which will be determined by the nature of the utility work.

A sketch or drawing shall accompany each permit application which will show the location of the proposed utility with reference to the county highway center line and right-of-way line. A complete set of plans is required for all sewer/water projects.

It shall be the responsibility of the applicant to determine which of the special conditions (listed on the reverse side of this form) apply to each permit.

The Anoka County Highway Department (ACHD) reserves the right to revoke any utility permit and halt work if, upon inspection of any job site, the special conditions listed on the reverse side of this form are not met and/or a hazard exists for the applicant or public safety is threatened.

The applicant shall notify ACHD immediately upon completion of project so that the ACHD can inspect the site to determine whether or not restoration has been satisfactorily completed.

I, We, the undersigned, herewith accept the terms and conditions of the regulations as laid down by the County of Anoka and agree to fully comply therewith to the satisfaction of the ACHD. The County of Anoka, its officials and employees shall be held harmless, by the permittee, from any demands, claims or suits arising out of the granting of the permit.

Date 4/26/23 Applicant's Signature Del Vanera City of Anoka Elec Dept

AUTHORIZATION OF PERMIT dvaneura@CI.ANOKA.MN.US

In consideration of the applicant's agreement to comply in all respects with the regulations of the ACHD covering such operations, permission is hereby granted for the work to be done as described in the above application. Said work to be done in accordance with the general conditions listed above and the special conditions required as hereby stated: (SEE REVERSE SIDE OF THIS FORM FOR SPECIAL CONDITIONS).

It is expressly understood that this permit is conditioned upon replacement or restoration of the County Highway and its right of way to their original or to a satisfactory condition. It is further understood that this permit is issued subject to the approval of local city or township authorities having joint supervision over said street or highway.

ANOKA COUNTY HIGHWAY DEPARTMENT

Approved by Andrew M. Burgmeier Issued by LB Date 4/26/2023
ASSOCIATE TRAFFIC TECH
 Distribution: White-Applicant Yellow-Highway Department Permit Office

DETACH AND RETURN THIS STUB

Permit Number _____


Date Completed / /

Name Of Applicant _____

Send to: Permit Section
 Anoka County Highway Department
 1440 Bunker Lake Blvd. N.W.
 Andover, MN 55304



Find address or place

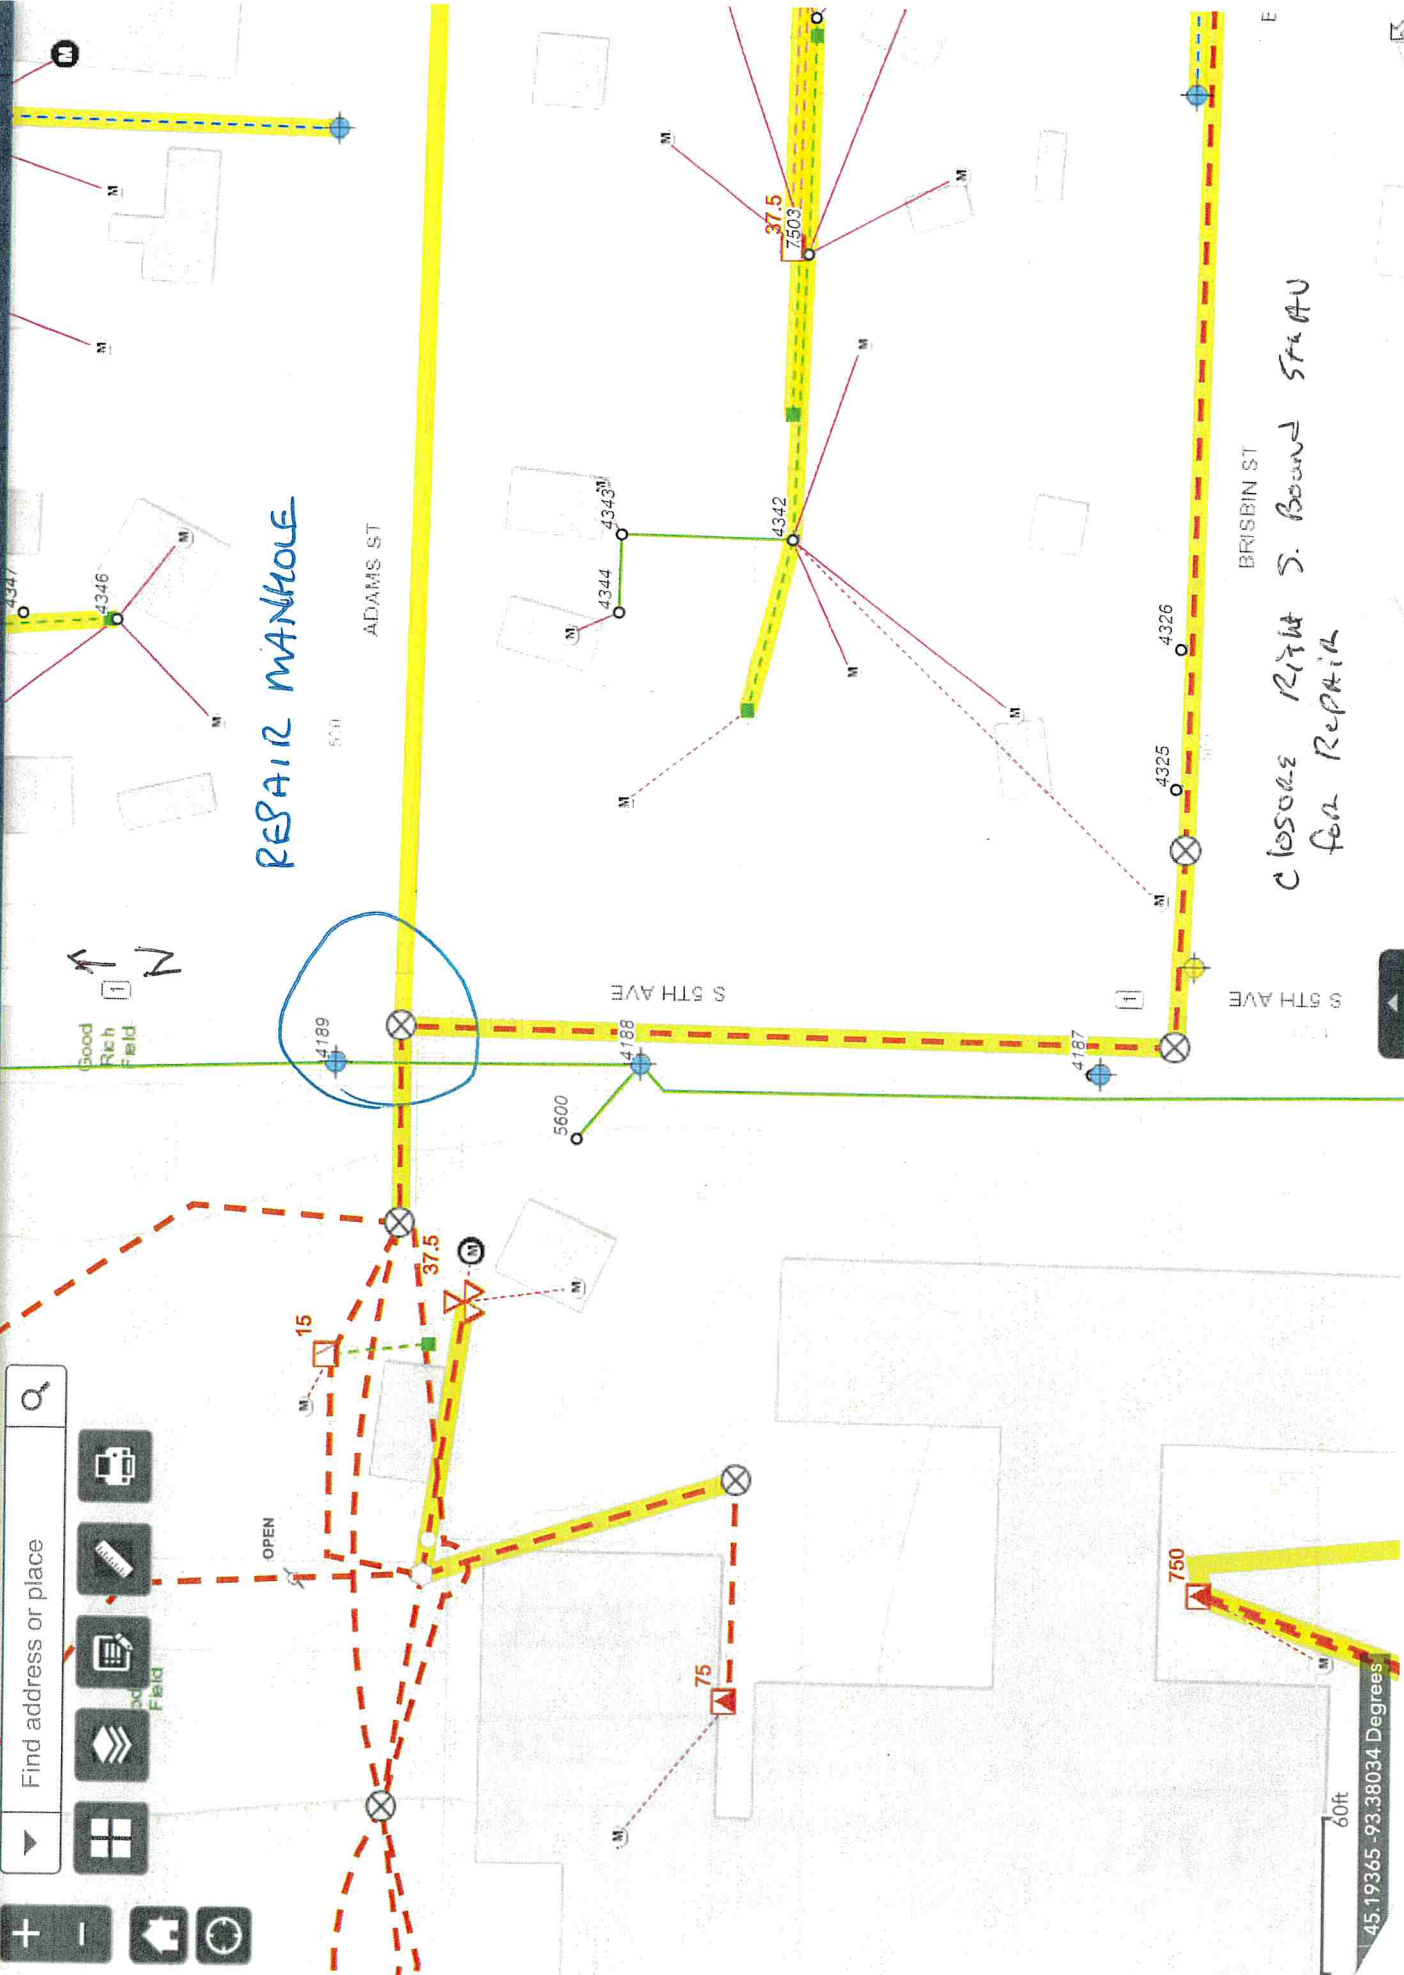

REPAIR MANHOLE

CLOSE R/W S. Bound ST. AU
for Repair