CIC NUMBER 10 PARKSHIRE, A COMMON INTEREST COMMUNITY SECOND SUPPLEMENTAL CIC PLAT

This Second Supplemental CIC Plat is part of the declaration recorded as Doc. No. _____ day of _____, 1996.


CITY OF COON RAPIDS COUNTY OF ANOKA

SITE PLAN

STREET AS BUILT STAFET Benchmark NI INI IV. VY. R=485.87 Δ=3°59′03" L=33.79 N89° 28′ 02" E 628. 86 ------177.36 154.76 147.22 149.52 COMMON PARKSHIRE 64.0 [1] ORIGINAL CIC PLAT SUPPLEMENTAL FIRST UNITS CIC 21 - 26 BLOOK ELEMENT ----- 225. 93 ----- S89°2/′58"W 625.15--AUDITOR'S SUBDIVISION NO. 74 L=37.91 Δ=7°35′52" -=1---R=285.87 Benchmark - Rim of sanitary sewer O Denotes iron monument found manhole. Elev. = 871.32 Ft. (N. G. V. D. - 1929) I, Jeffrey D. Lindgren, hereby certify that I have prepared this Second Supplemental CIC plat of CIC NUMBER 10, PARKSHIRE, being located upon: I, Randall C. Hedlund, a licensed professional engineer licensed in the State of Minnesota, pursuant to Minnesota Statutes Section 515B. 2-101(c), do hereby Denotes 1/2 inch by 14 inch iron certify that all structural components and mechanical systems of all buildings monument marked by Registration Doc# 1244689 containing or comprising any units hereby created are substantially completed consistent with the Second Supplemental CIC Plat for CIC NUMBER 10, PARKSHIRE. Lots 4, Block 1, PARKSHIRE, Anoka County, Minnesota. No. 14376. And the additional real estate that may be subsequently added, described as - OFFICE OF COUNTY RELEASER For the purposes of this plat, the STATE OF MINNESOTA, COUNTY OF ANDRA Dated this 3RD day of OCTOBER , 1996. I will the east line of Lot 1A, Block 1, PARKSHIRE, DELIMENT TARES OF THE LABOR OFFEERINGS None. Randall C. Hedlund WITHIR ARE PAID AND THE TRANSPER IS is assumed to bear S. 00°38′24" W. ne 740 04 000 1946 EDWARD H. TRESKA which fully and accurately depicts all information required by Minn. Statutes 11:15_o'clock A.M., and was duly recurded Section 515B. 2-110. DRAINAGE AND UTILITY EASEMENTS in book 3 of page 2 ARE SHOWN THUS PER PLAT OF PARKSHIRE. Dated this 3RP day of OCTOBER , 1996 Licensed Professional Engineer Minnesota License No. 19576 SAL S Rei Educard M. Treeva OFFIT PROPERTY THE SMALL PROPERTY. Jeffrey D./ L)ndgren Licensed Professional Land Surveyor STATE OF MINNESOTA 10.00 COUNTY OF HENNEPIN The foregoing certificate was acknowledged before me this 3RP day of OCTOBER 1996, by Randall C. Hedlund, a licensed professional engineer, Minnesota License No. 19576. Minnesota License No. 14376 ATTEN HOMELLE F. MOLINE MOTARY PUBLIC - MINNESOTA My Commission Express Jan. 31, 7000 STATE OF MINNESOTA COUNTY OF HENNEPIN Komelle F. Mdus Being 10 feet in width and adjoining The foregoing certificate was acknowledged before me this <u>3RD</u> day of <u>OCTOBER</u>, 1996, by Jeffrey D. Lindgren, a licensed professional land surveyor, Minnesota License No. 14376. lot lines, unless otherwise shown and Romelle_F. Moline 10 feet in width and adjoining street Notary Public, Minnesota lines as shown on this plat. My Commission Expires 1-31-2000 Romelle F. Moline
Notany Bublic Mi ROMELLE F. MOLINE
MOTARY PUBLIC - MINNESONA
IN COMMISSION EXPLICIT CALL 31, 2001 This First Supplemental CIC plat has been checked and approved this _____day of _____, 1996. Notary Public, Minnesota FEET SCALE My Commission Expires 1-31-2000 1 INCH = 30 FEET Planning Engineering Surveying Anoka County Surveyor

(3)


CIC NUMBER 10 PARKSHIRE, COMMON INTEREST COMMUNITY SECOND SUPPLEMENTAL CIC PLAT

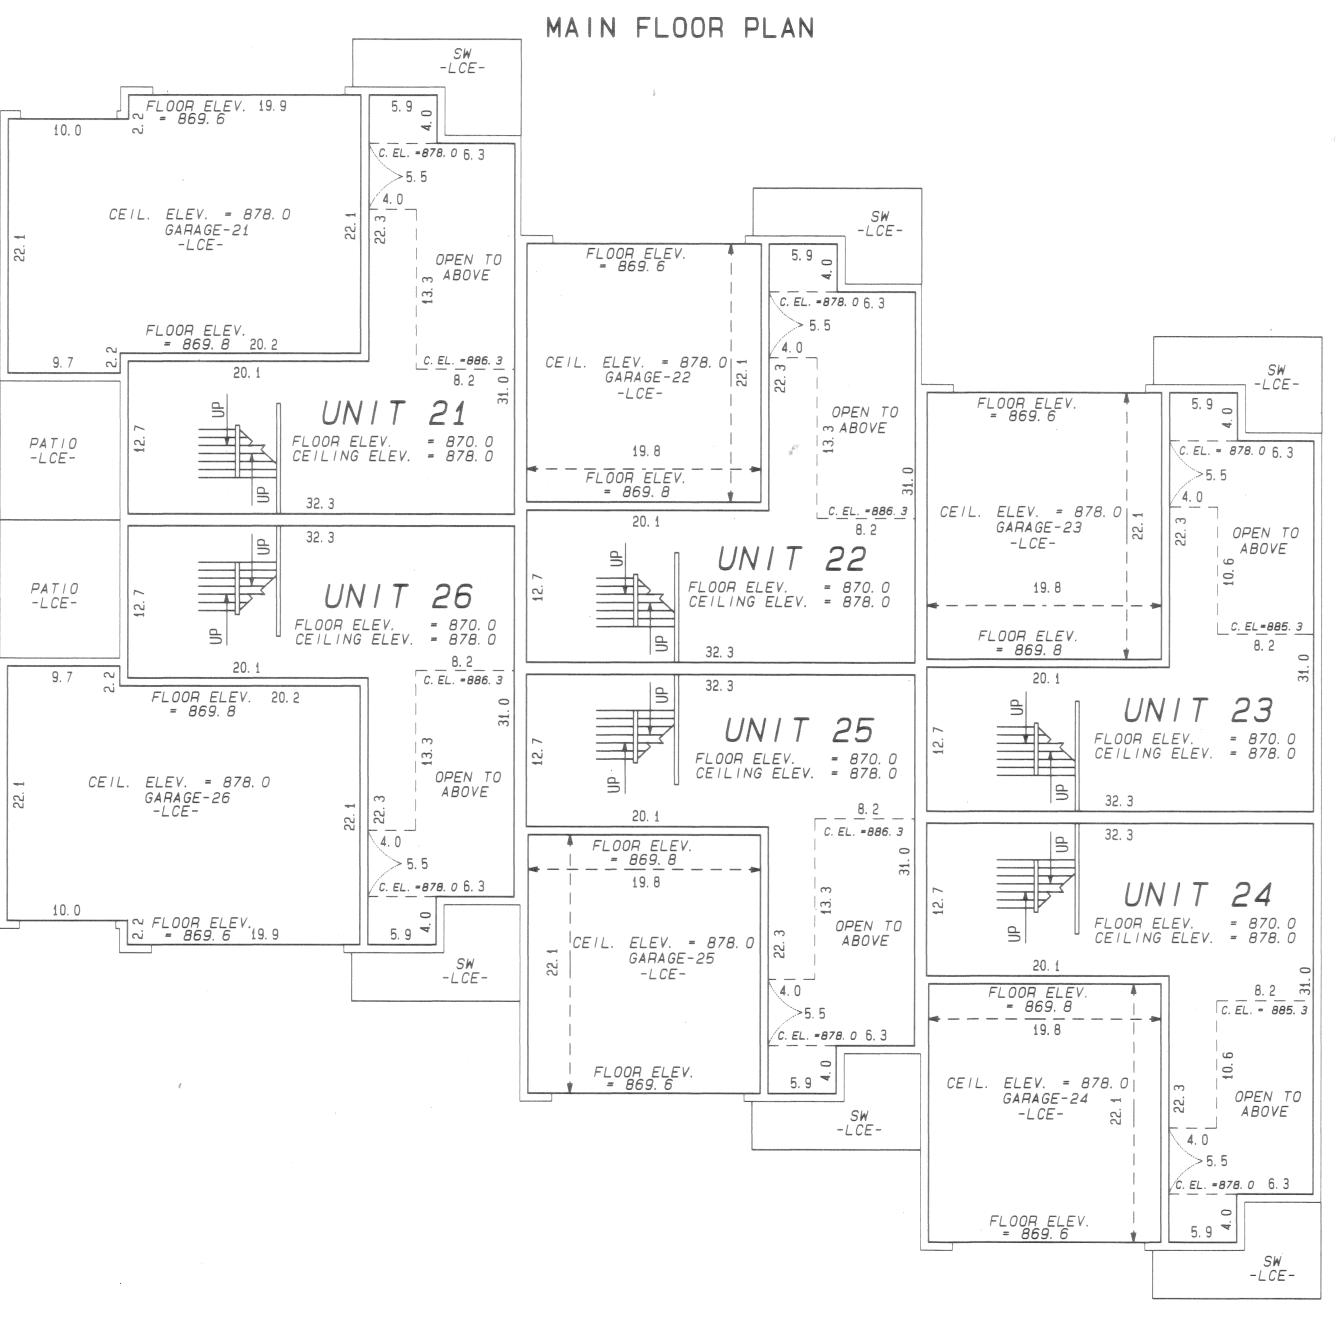


UNIT AREAS (S.F.)

	MAIN FLOOR	2ND FLOOR	GARAGE	TOTAL
21	657	857	660	2174
22	657	857	438	1952
23	657	715	438	1810
24	657	715	438	1810
25	657	857	438	1952
26	657	857	660	2174



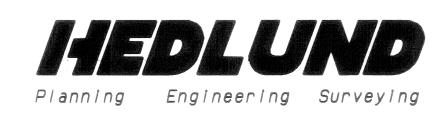


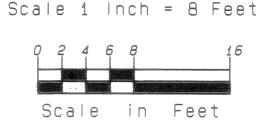

- * All Patios are LIMITED COMMON ELEMENTS assigned to the UNIT adjoining thereto (unless otherwise noted).
- × L.C.E. Denotes Limited Common Element
- * Elevations shown are referenced to a bench mark as denoted on Sheet 1 of 3 Sheets, and are shown in feet and tenths of a foot.
- * Interior dimensions shown are measured to the unfinished surface of the walls, floors and ceilings and are shown in feet and tenths of a foot.
- × SW Denotes Side Walk
- × C.EL. Denotes Ceiling Elevation

CIC NUMBER 10 PARKSHIRE, COMMON INTEREST COMMUNITY SECOND SUPPLEMENTAL CIC PLAT


2ND FLOOR PLAN

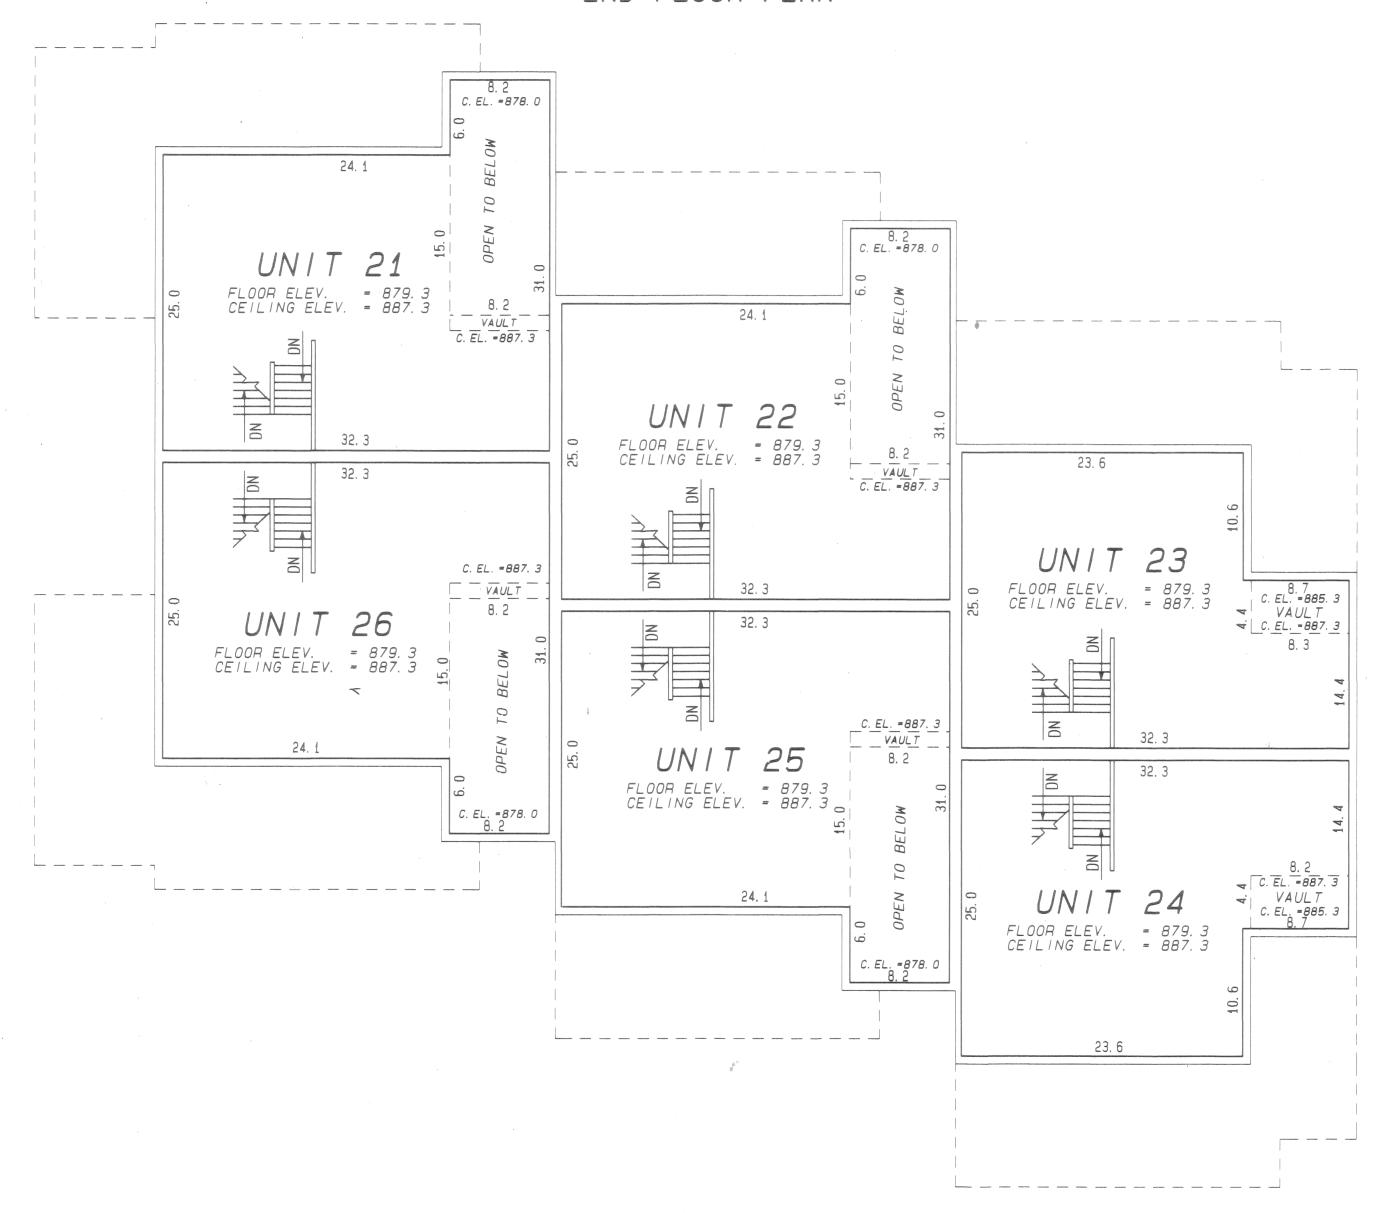

UNIT AREAS (S.F.)

	MAIN FLOOR	2ND FLOOR	GARAGE	TOTAL		
21	657	857	660	2174		
22	657	857	438	1952		
23	657	715	438	1810		
24	657	715	438	1810		
25	657	857	438	1952		
26	657	857	660	2174		
	A STATE OF THE PARTY OF THE PAR		William Committee of the Committee of th			



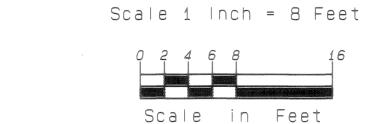



- * All Patios are LIMITED COMMON ELEMENTS assigned to the UNIT adjoining thereto (unless otherwise noted).
- ★ L. C. E. Denotes Limited Common Element
- * Elevations shown are referenced to a bench mark as denoted on Sheet 1 of 3 Sheets, and are shown in feet and tenths of a foot.
- * Interior dimensions shown are measured to the unfinished surface of the walls, floors and ceilings and are shown in feet and tenths of a foot.
- * SW Denotes Side Walk
- * C. EL. Denotes Ceiling Elevation

