BK bofcic, pg 43 This Third Supplemental Condominium Plat is part of the Declaration recorded as Document COMMON INTEREST COMMUNITY NUMBER 129 OFFICIAL PLAT No. 461934 on this 23rd day of March . 2004. BIRCH HILL LODGES, A CONDOMINIUM CIC Book <u>b</u> page <u>43</u> THIRD SUPPLEMENTAL CIC PLAT CITY OF RAMSEY COUNTY OF ANOKA SEC. 25, T. 32, R. 25 I Harold C. Peterson do hereby certify that the work was undertaken by or reviewed and approved by me for this THIRD SUPPLEMENTAL CIC PLAT of COMMON INTEREST COMMUNITY NUMBER 129, BIRCH HILL LODGES. A CONDOMINIUM being located upon: Lot 4, Block 2, BIRCH HILL LODGES, according to the plat of record thereof, Anoka County, Minnesota Lots 1, 2 and 3, Block 1, and Lot 5, Block 2, BIRCH HILL LODGES, according to the plat of record thereof, Anoka County, Minnesota. 306.57 DRAINAGE AND UTILITY -EASEMENT PER PLAT -STATE OF MINNESOTA
COUNTY OF ______ The foregoing instrument was acknowledged before me this 12th day of february by Harold C. Peterson, a Licensed Surveyor. VICKI J. LAIR DRAINAGE AND UTILITY EASEMENT PER PLAT OF BIRCH HILL LODGES NOTARY PUBLIC - MINNESOTA Notary Public County, Minnesota My Commission Expires Jan. 31, 2005 I, Joel G. Cooper pursuant to Minnesota Statutes, Section 515B.2-101, Subd. C, do hereby certify that all structural _NORTH_LINE_OF_LOT_1, BLOCK_1 BIRCH_HILL_LODGES DRAINAGE AND UTILITY OF BIRCH HILL LODGES Med in this office on March 23 2004 4:15 o dock P M STATE OF MINNESOTA COUNTY OF ______ The foregoing instrument was acknowledged before me this 1244 day of february by Joel G. Cooper, a Registered Engineer. ADDITIONAL REAL ESTATE VICKI J. LAIR VICKI J. LAIR

NOTARY PUBLIC - MINNESOTA

My Commission Expires Jan. 31, 2005 _S89°46<u>'25</u>"E 257.72 S89°46'25"E Notary Public County, Minnesota My Commission Expires January 31, 2005 I HEREBY CERTIFY THAT THE CLERENT AND Checked and approved this 3 RD day of MARCH, 2004. ENTER! MAY, 23 200 ADDITIONAL REAL ESTATE SEE SHEET 2 OF 3 SHEETS FOR BUILDING LOCATION AND SITE **IMPROVEMENTS** DECUTY OF SPECIFF THE ADMINISTRATOR SITE PLAN Δ=01°36′15" \ Δ=08°20'30" FOR THE PURPOSES OF THIS CIC PLAT THE NORTH LINE OF LOT 1, BLOCK 1, BIRCH HILL LODGES IS Δ=13°01'53" ∆=19°46'08" ASSUMED TO BEAR S 89°46'25" E PARK SEE SHEET 2 OF 3 SHEETS FOR BUILDING LOCATION AND SITE IMPROVEMENTS. 3 ADDITIONAL BENCH MARK: ADDITIONAL REAL ESTATE REAL ESTATE TOP NUT OF HYDRANT SOUTHWEST OF LOT 1, BLOCK 2, BRICH HILL LODGES. ELEVATION = 877.51 FEET (N.G.V.D.-1929) DRAINAGE AND UTILITY EASEMENT DRAINAGE AND UTILITY EASEMENT . PER PLAT OF BIRCH HILL LODGES SCALE IN FEET

331.07 N89°46'25"W

⁽ S89°46'25"E

243.22 N89°46'25"W

50

JAMES R. HILL, INC.

DENOTES 1/2 INCH x 14 INCH IRON PIPE FOUND

TO THE STATE OF MINNESOTA AS SHOWN ON THE PLAT OF BIRCH HILL LODGES

2004046278 \$415.00

AND MARKÉD BY R.L.S. NO. 12294.

 $---\Delta$ DENOTES RIGHT OF ACCESS DEDICATED

120

1 INCH = 60 FEET

OFFICIAL PLAT

COMMON INTEREST COMMUNITY NUMBER 129 BIRCH HILL LODGES, A CONDOMINIUM THIRD SUPPLEMENTAL CIC PLAT

BK 6 of cic, pg 43

C.R. DOC. NO. 461934


CITY OF RAMSEY COUNTY OF ANOKA SEC. 25, T. 32, R. 25

SITE PLAN
(AS BUILT)

SEE SHEET 1 OF 3 SHEETS FOR LOCATION OF BENCH MARK

● DENOTES 1/2 INCH X 14 INCH IRON PIPE FOUND AND MARKED BY R.L.S. NO. 12294.

SEE SHEET 3 OF 3 SHEETS FOR UNIT DIMENSIONS

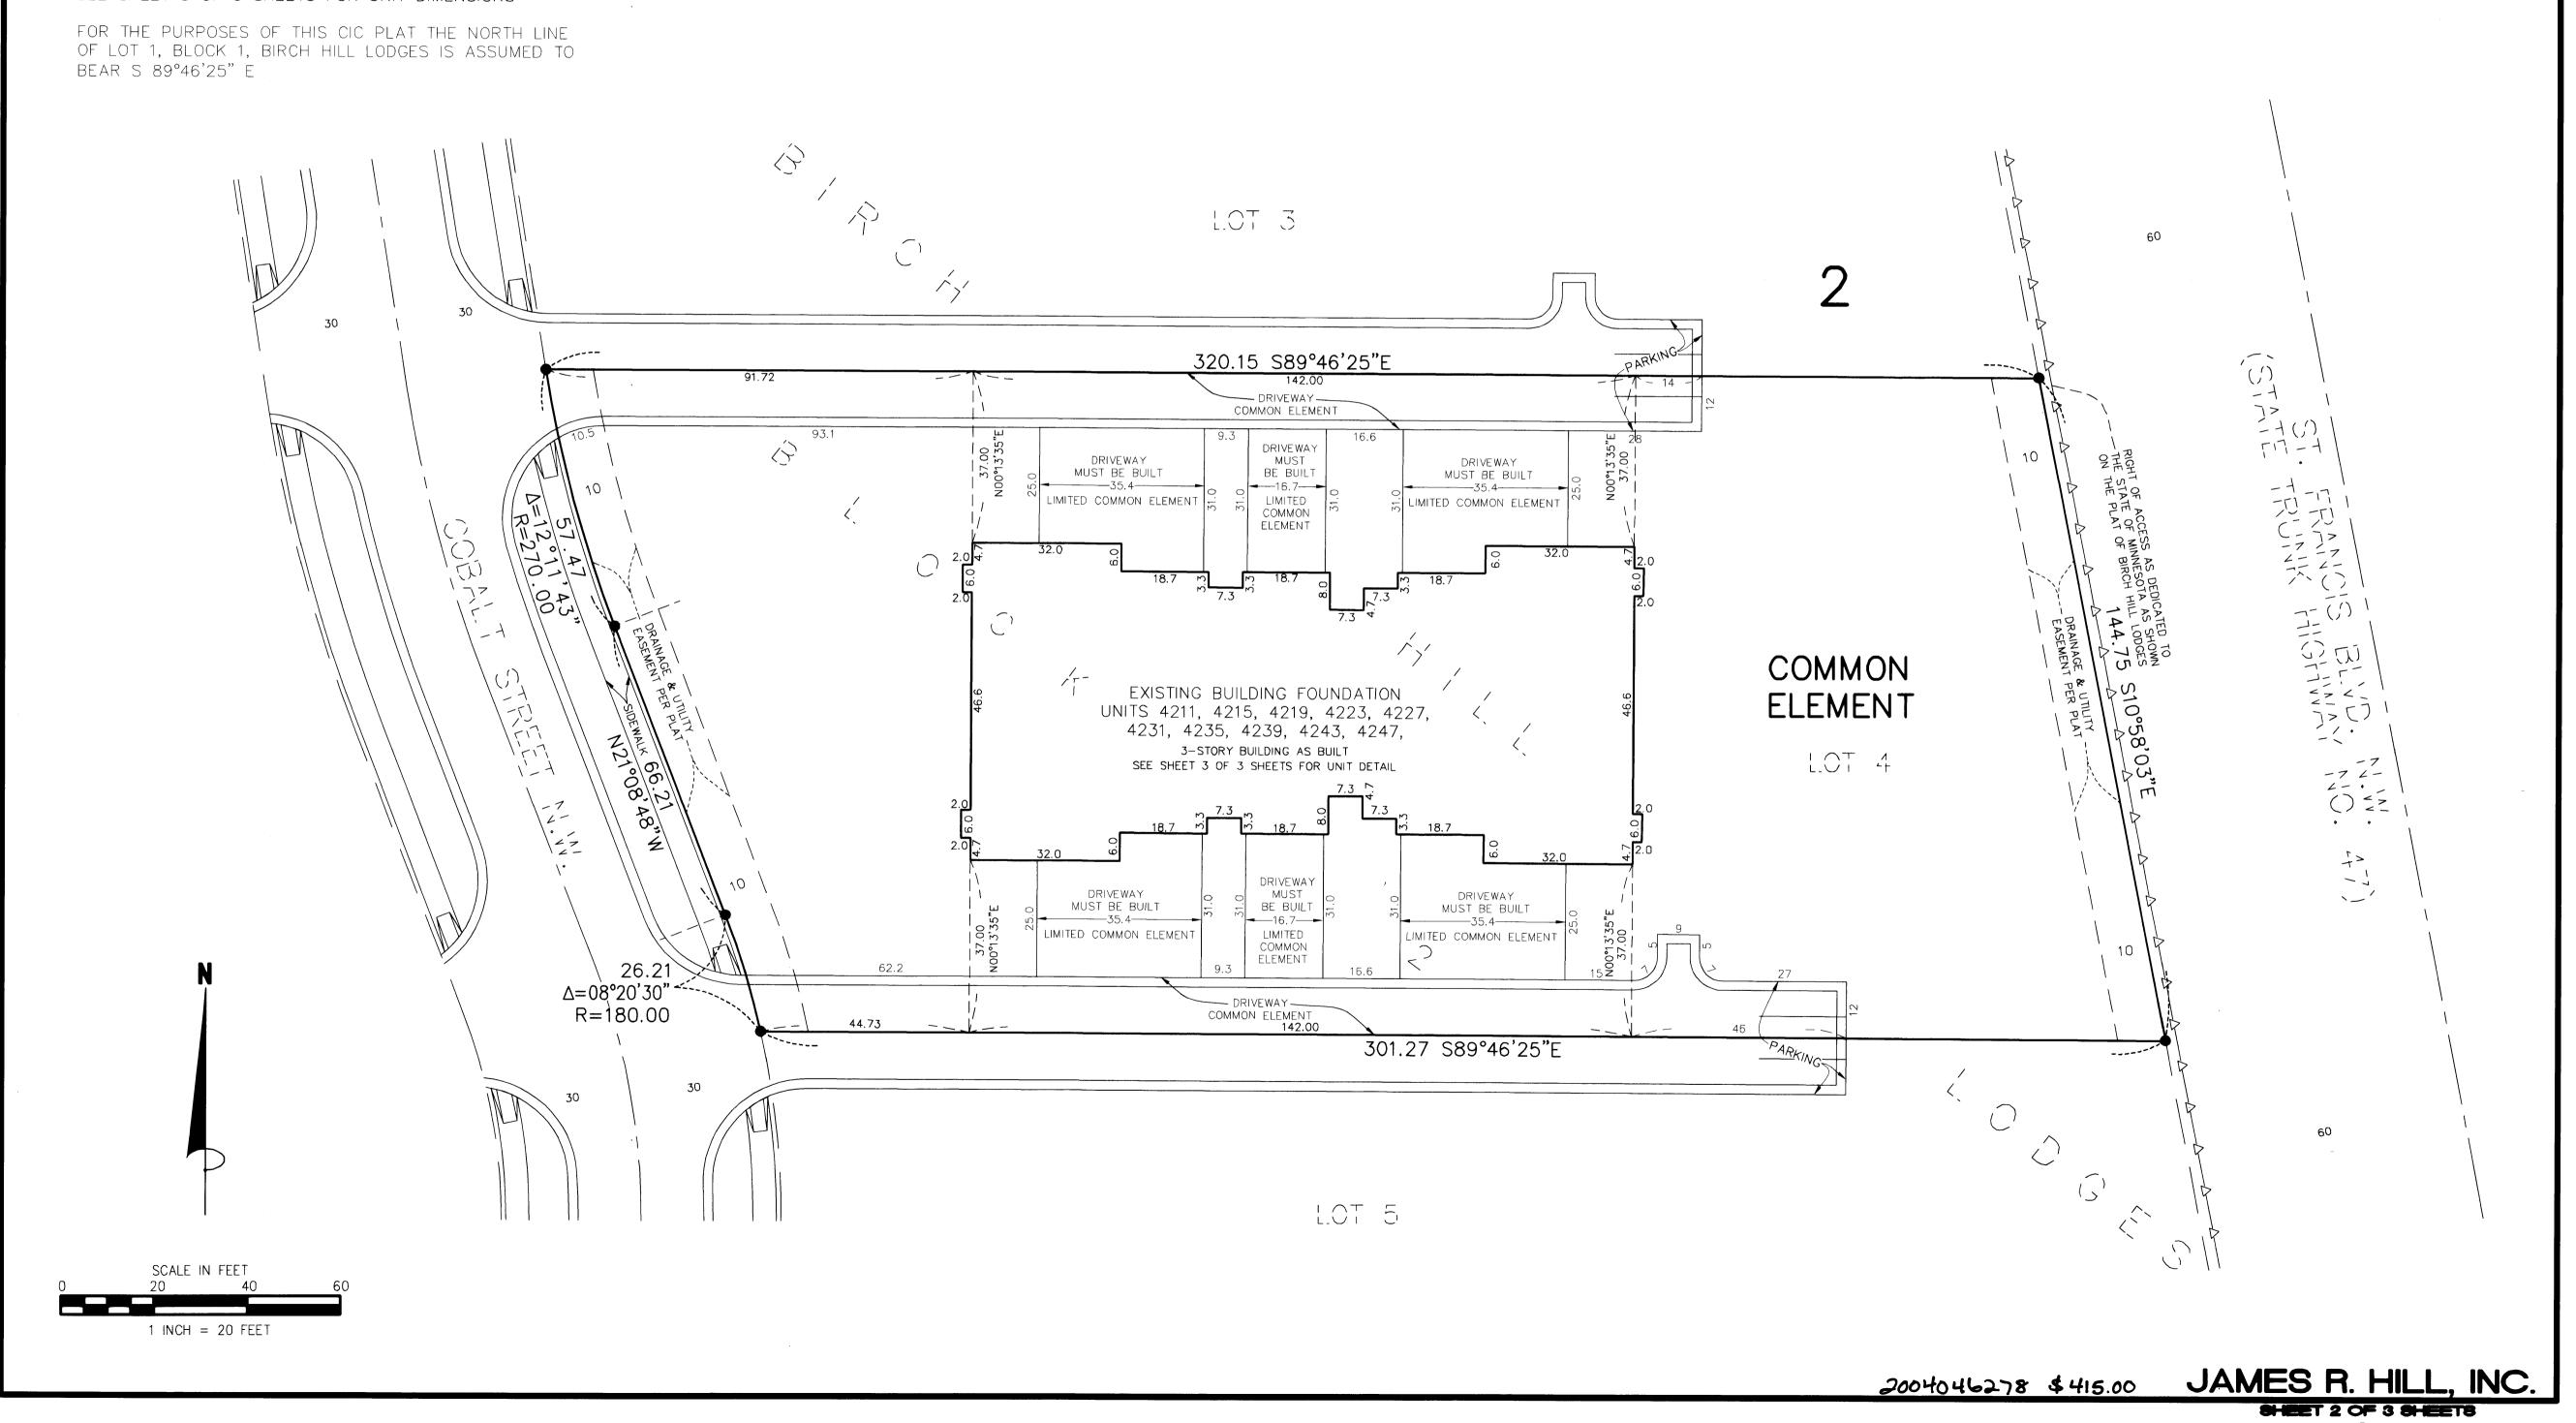

OFFICIAL PLAT


COMMON INTEREST COMMUNITY NUMBER 129


BIRCH HILL LODGES, A CONDOMINIUM THIRD SUPPLEMENTAL CIC PLAT

BK 6 of CIC, pg 43

C.R. DOC. NO. 461934

CITY OF RAMSEY COUNTY OF ANOKA SEC. 25, T. 32, R. 25

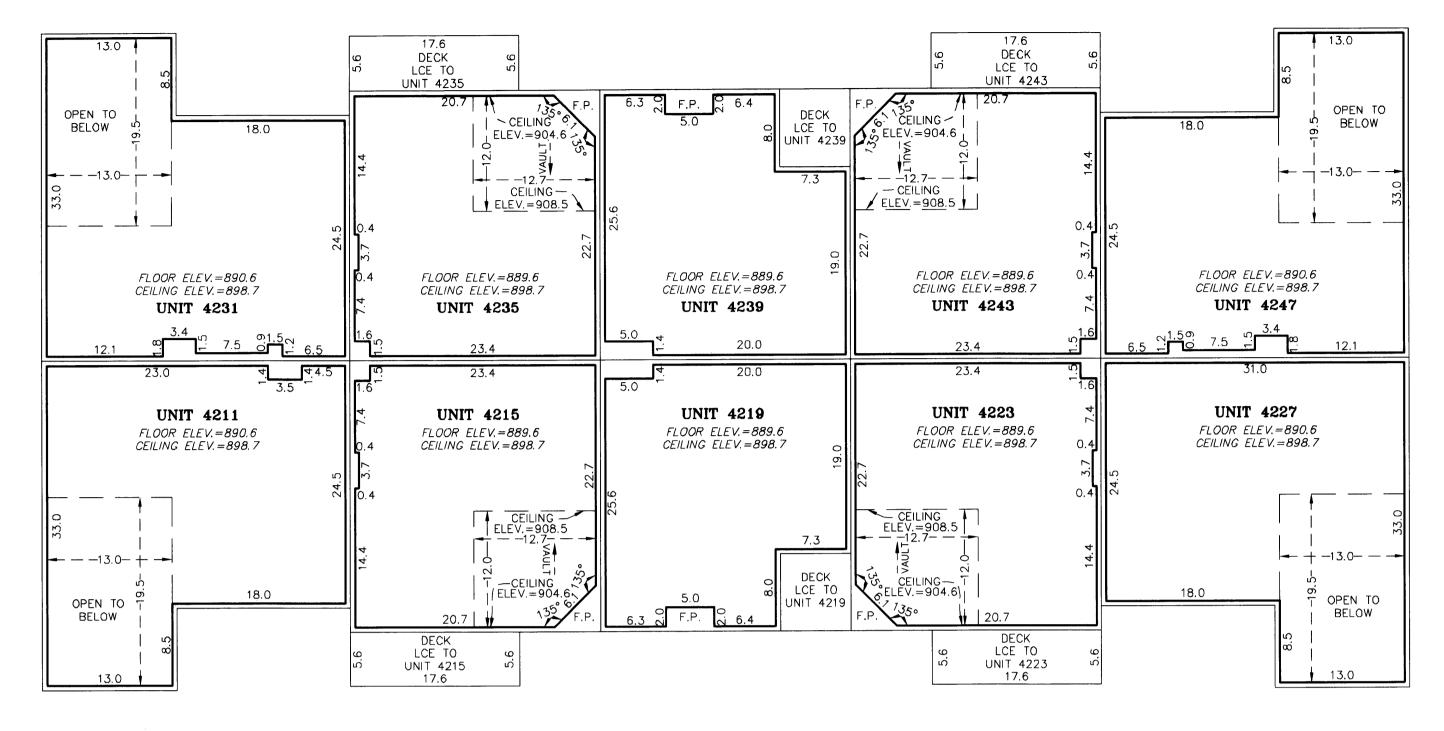

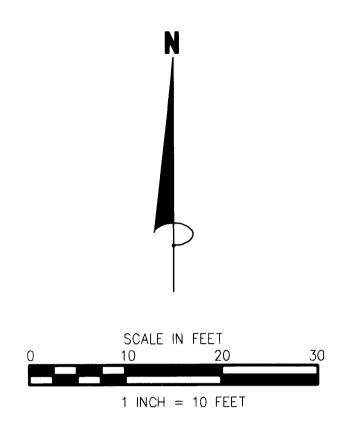

FLOOR PLAN

DECKS, PATIOS AND SIDEWALKS ARE LIMITED COMMON ELEMENTS — MUST BE BUILT


LCE = LIMITED COMMON ELEMENT


ELEVATIONS ARE REFERRED TO A BENCHMARK AS NOTED ON SHEET 1 OF 3 SHEETS AND ARE SHOWN IN FEET AND TENTHS OF A FOOT

INTERIOR DIMENSIONS SHOWN ARE TO UNFINISHED PERIMETER WALLS, FLOORS AND CEILINGS

F.P. DENOTES FIREPLACE, A LIMITED COMMON ELEMENT ASSIGNED TO ADJOINING UNIT

SECOND FLOOR

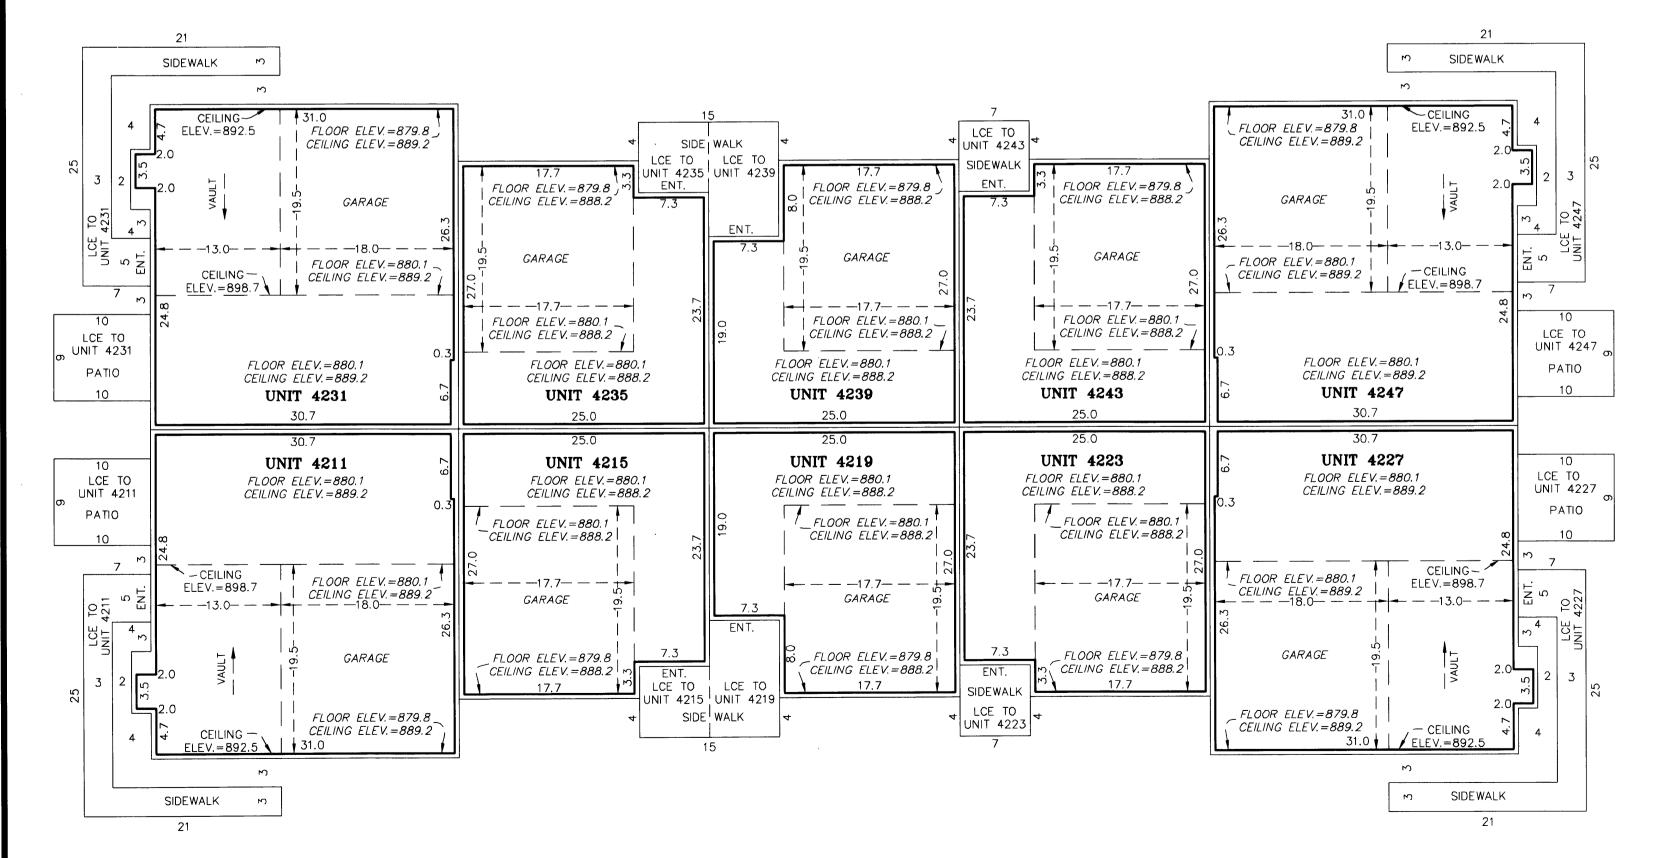

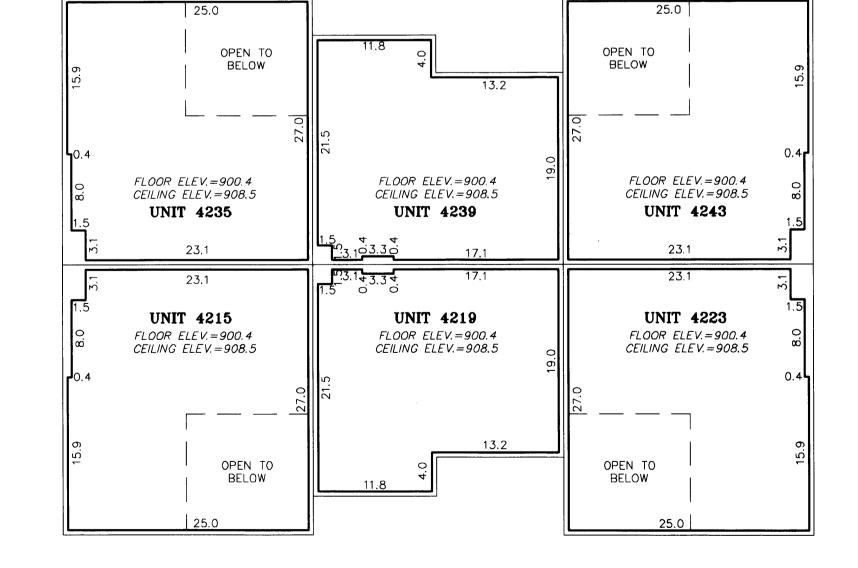

THIRD FLOOR

FIRST FLOOR

2004046278 \$415.00 JAMES R. HILL, INC.