

BK9 CEC PJ 9 CIC NUMBER 171 SITE PLAN (AS-BUILT) C.R. DOC. NO. COTTAGES AT CLUB WEST CITY OF BLAINE COUNTY OF ANOKA SEC. 17, TWP. 31, RGE. 23 A CONDOMINIUM TWELFTH SUPPLEMENTAL CIC PLAT C.E. = Common Element L.C.E. = Limited Common Element GRAPHIC SCALE O Denotes 1/2 inch by 14 inch iron monument set and marked with license number 20595. For the purposes of this CIC the southerly line of Lot 25, Block 1, CLUB WEST TWELFTH ADDITION, is assumed to have a bearing of North 89 degrees 49 minutes 20 seconds East. PI NEER engineering (IN FEET) 1 inch = 10 feet

SHEET 2 OF 5 SHEETS

BK9 CIC PS 9 CIC NUMBER 171 SITE PLAN (AS-BUILT) C.R. DOC. NO. COTTAGES AT CLUB WEST CITY OF BLAINE COUNTY OF ANOKA SEC. 17, TWP. 31, RGE. 23 A CONDOMINIUM TWELFTH SUPPLEMENTAL CIC PLAT

GRAPHIC SCALE

(IN FEET)
1 inch = 10 feet

C.E. = Common Element
L.C.E. = Limited Common Element

O Denotes 1/2 inch by 14 inch iron monument set and marked with license number 20595.

For the purposes of this CIC the southerly line of Lot 25, Block 1, CLUB WEST TWELFTH ADDITION, is assumed to have a bearing of North 89 degrees 49 minutes 20 seconds East.

PI**2**NEER engineering

UNIT DETAIL (AS-BUILT)

CIC NUMBER 171

COTTAGES AT CLUB WEST

A CONDOMINIUM


TWELFTH SUPPLEMENTAL

CIC PLAT

BK9 CIC pg 9

C.R. DOC. NO____

CITY OF BLAINE COUNTY OF ANOKA SEC. 17, TWP. 31, RGE. 23

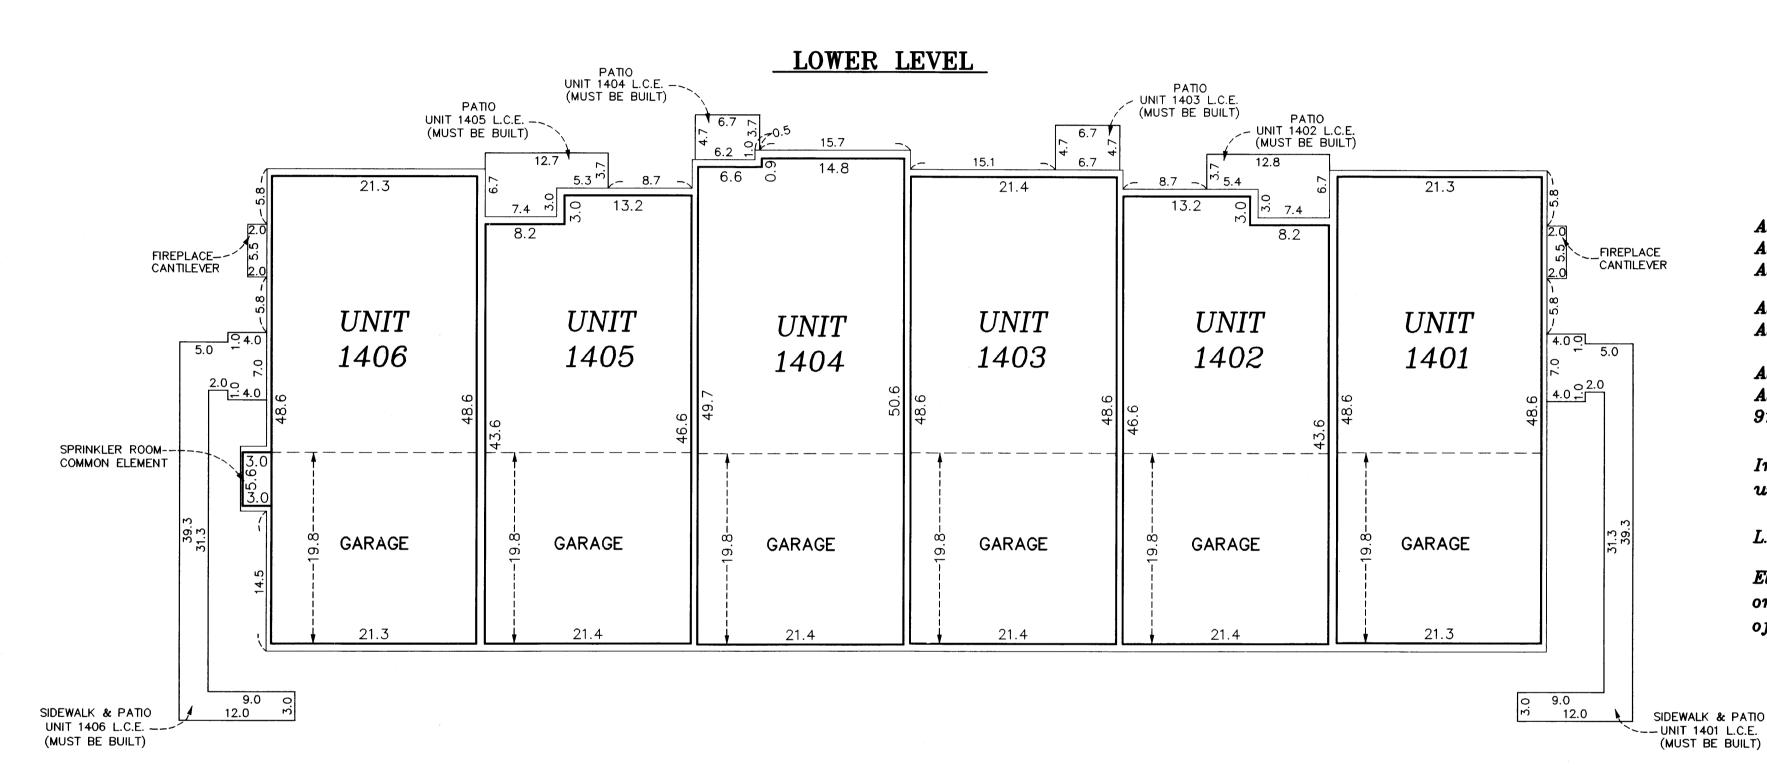

All units garage floor elevation at the garage door = 899.9 feet All units garage floor elevation at back of garage= 900.2 feet All units garage ceiling elevations = 909.5 feet

All units lower level floor elevations = 900.4 feet All units lower level ceiling elevation = 909.5 feet


All units upper level floor elevation = 911.1 feet All units upper level ceiling elevation varies from 919.2 feet to 921.2 feet


Interior Dimensions shown are measured to the unfinished surface of the walls, floors and ceilings.


L.C.E. Denotes Limited Common Element

Elevations are referenced to Benchmark as noted on sheet 1 of 5 sheets and are shown in feet and tenths of a foot.

UPPER LEVEL

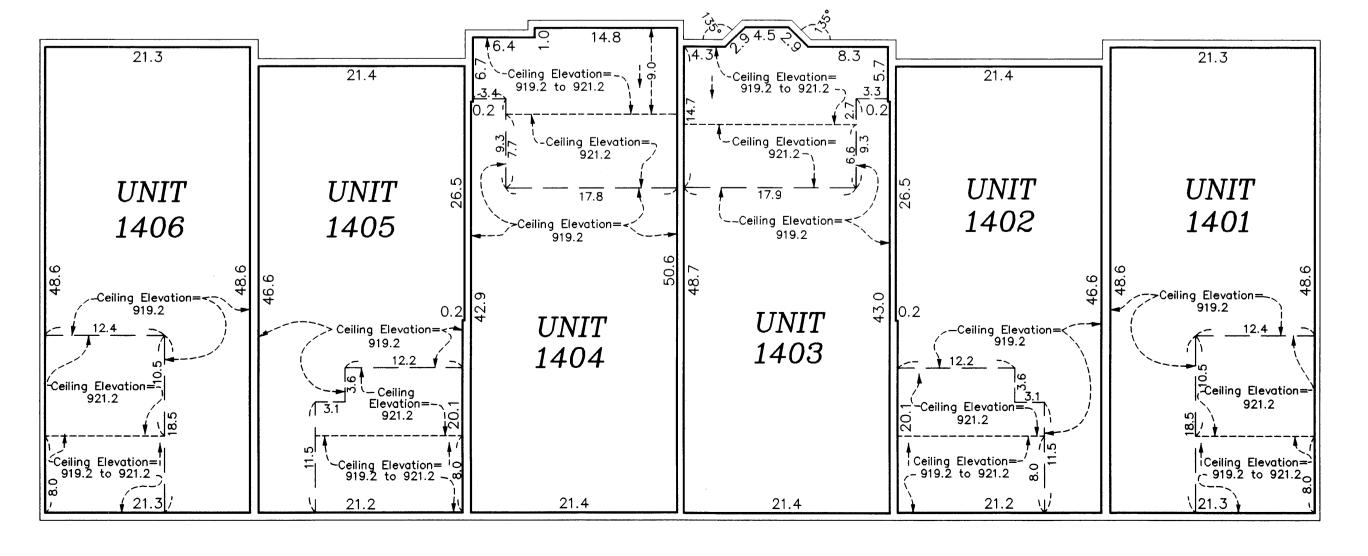

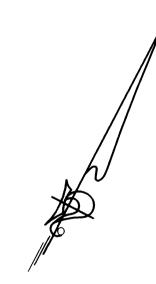

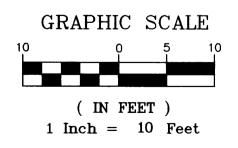



BK9 CIC py 9.

UNIT DETAIL
(AS-BUILT)

CIC NUMBER 171

COTTAGES AT CLUB WEST


A CONDOMINIUM

TWELFTH SUPPLEMENTAL

CIC PLAT

C.R. DOC. NO_____

CITY OF BLAINE COUNTY OF ANOKA SEC. 17, TWP. 31, RGE. 23

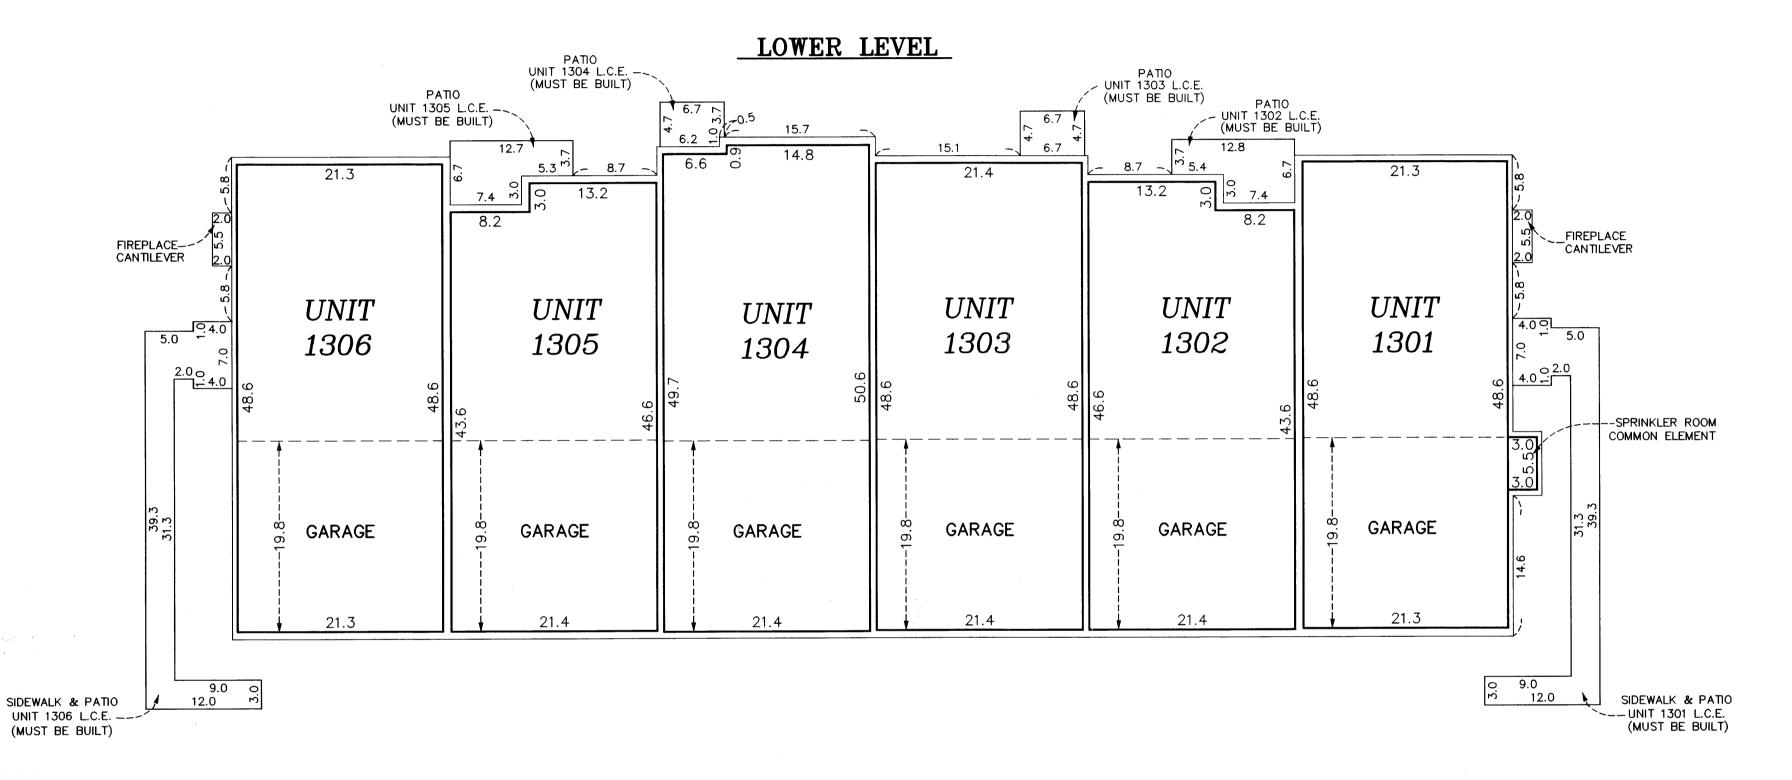

All units garage floor elevation at the garage door = 899.7 feet All units garage floor elevation at back of garage= 900.0 feet All units garage ceiling elevations = 909.3 feet


All units lower level floor elevations = 900.2 feet
All units lower level ceiling elevation = 909.3 feet


All units upper level floor elevation = 910.9 feet All units upper level ceiling elevation varies from 919.0 feet to 921.0 feet

Interior Dimensions shown are measured to the unfinished surface of the walls, floors and ceilings.

L.C.E. Denotes Limited Common Element

Elevations are referenced to Benchmark as noted on sheet 1 of 5 sheets and are shown in feet and tenths of a foot.

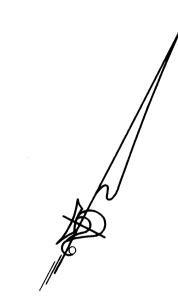

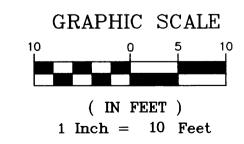



UPPER LEVEL

