

OFFICIAL PLAT

SITE PLAN (AS-BUILT)


BK. 9 of CIC Pg. 20

CIC NUMBER 171

COTTAGES AT CLUB WEST, A CONDOMINIUM FIFTEENTH SUPPLEMENTAL CIC PLAT

C.R. DOC. NO.____


CITY OF BLAINE COUNTY OF ANOKA SEC. 17, TWP. 31, RGE. 23

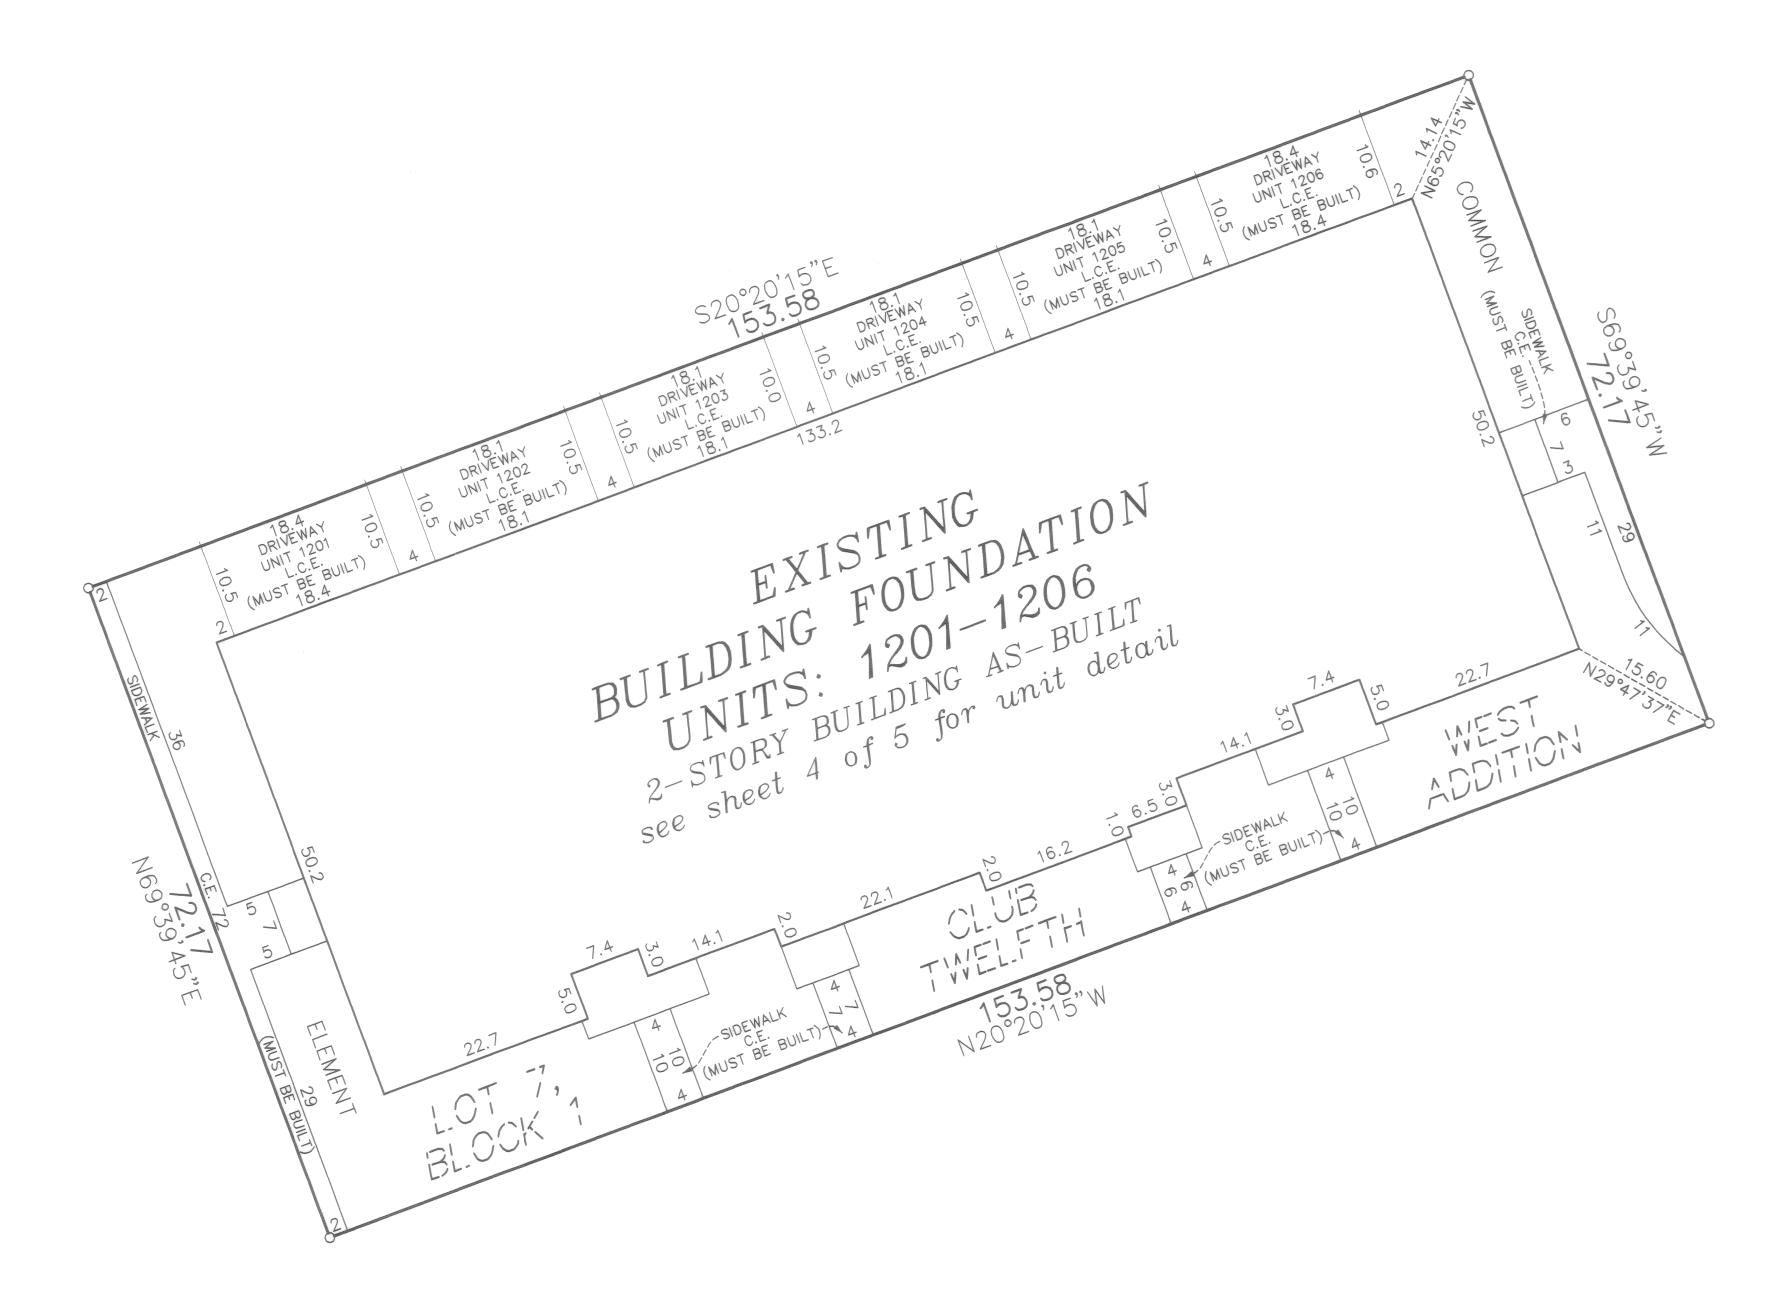

C.E. = Common Element
L.C.E. = Limited Common Element

O Denotes 1/2 inch by 14 inch iron monument set and marked with license number 20595.

For the purposes of this CIC the southerly line of Lot 25, Block 1, CLUB WEST TWELFTH ADDITION, is assumed to have a bearing of North 89 degrees 49 minutes 20 seconds East.

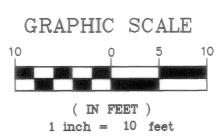





OFFICIAL PLAT

SITE PLAN (AS-BUILT)


BK. 9 of CIC pg. 20

CIC NUMBER 171

COTTAGES AT CLUB WEST, A CONDOMINIUM FIFTEENTH SUPPLEMENTAL CIC PLAT

C.R. DOC. NO._____


CITY OF BLAINE COUNTY OF ANOKA SEC. 17, TWP. 31, RGE. 23

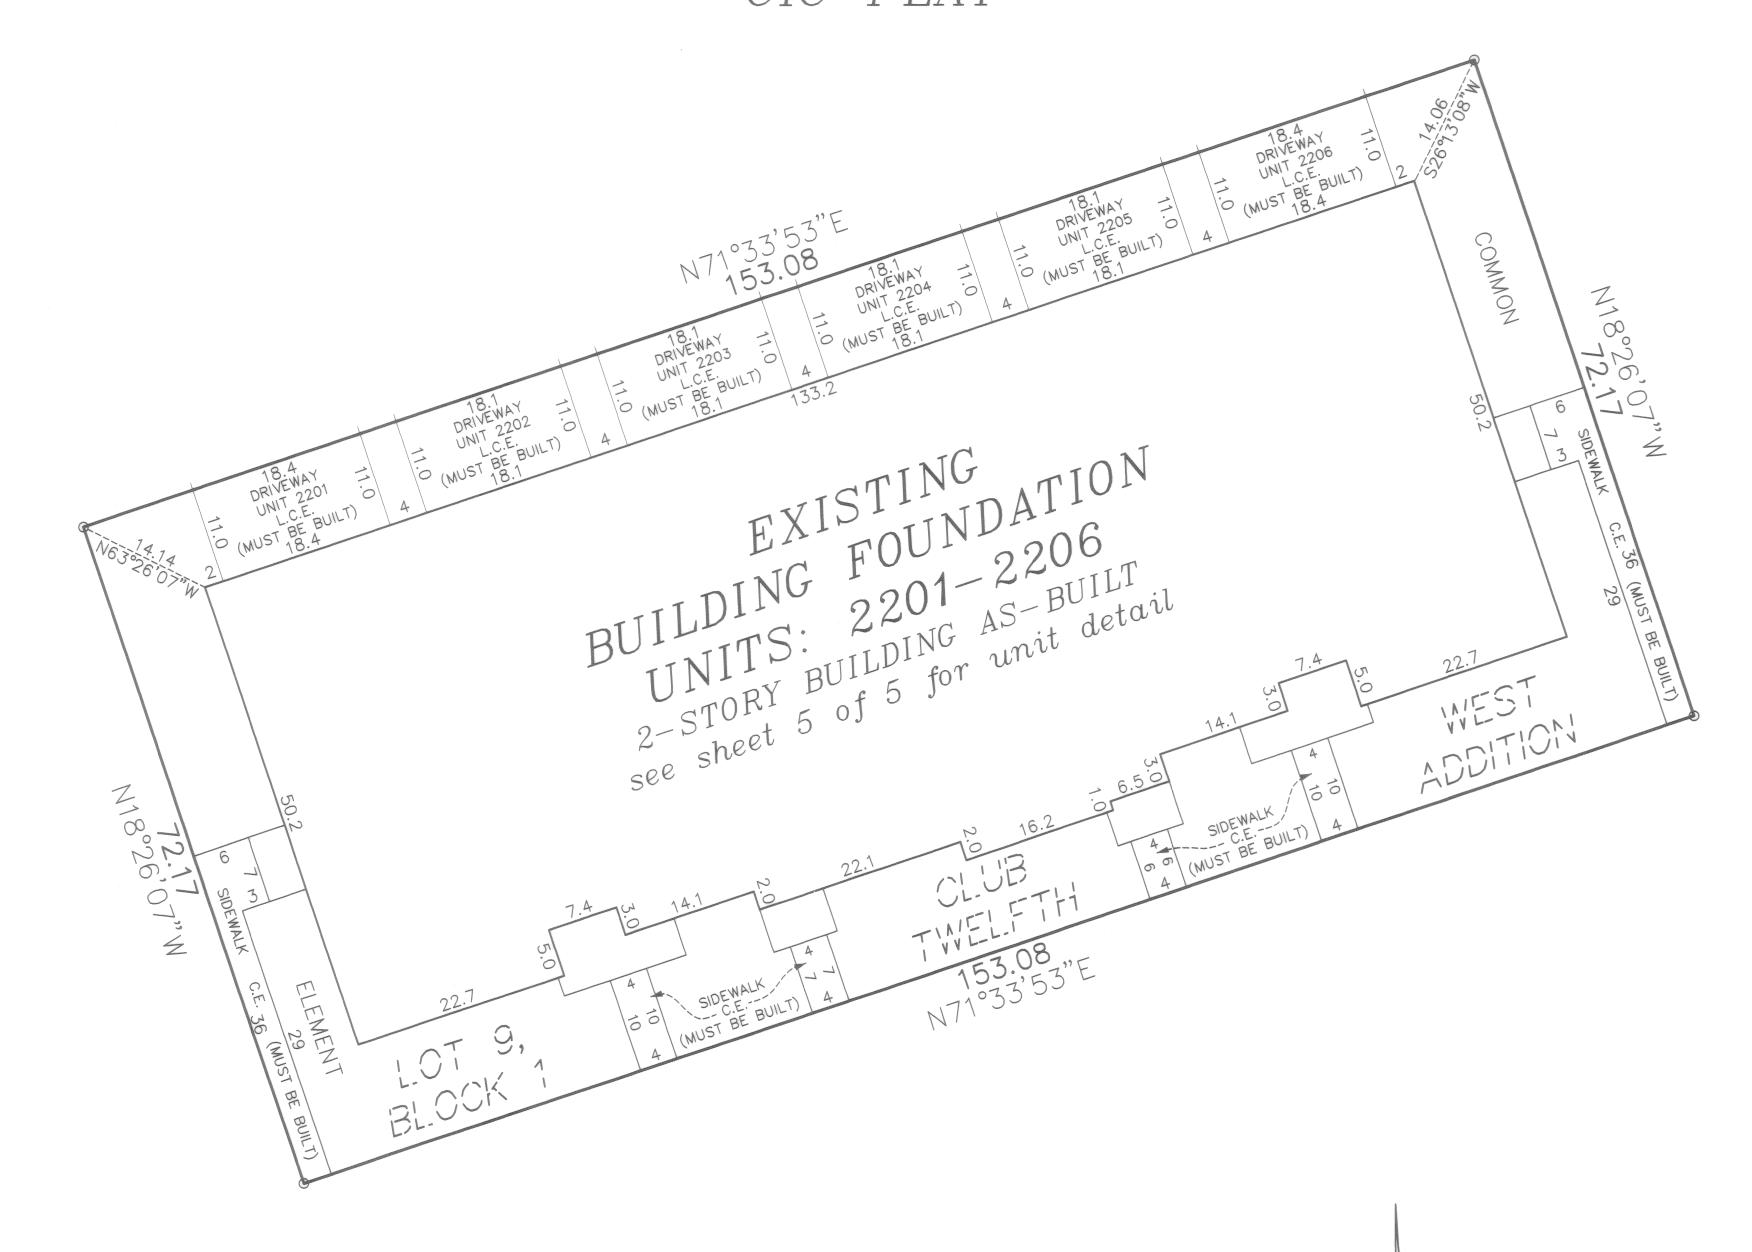

C.E. = Common Element
L.C.E. = Limited Common Element

O Denotes 1/2 inch by 14 inch iron monument set and marked with license number 20595.

For the purposes of this CIC the southerly line of Lot 25, Block 1, CLUB WEST TWELFTH ADDITION, is assumed to have a bearing of North 89 degrees 49 minutes 20 seconds East.

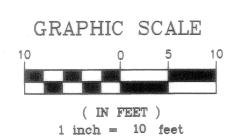



OFFICIAL PLAT

UNIT DETAIL (AS-BUILT)


BK. 9 of CIC pg. 20

CIC NUMBER 171


COTTAGES AT CLUB WEST, A CONDOMINIUM
FIFTEENTH SUPPLEMENTAL
CIC PLAT

C.R. DOC. NO.

CITY OF BLAINE COUNTY OF ANOKA SEC. 17, TWP. 31, RGE. 23

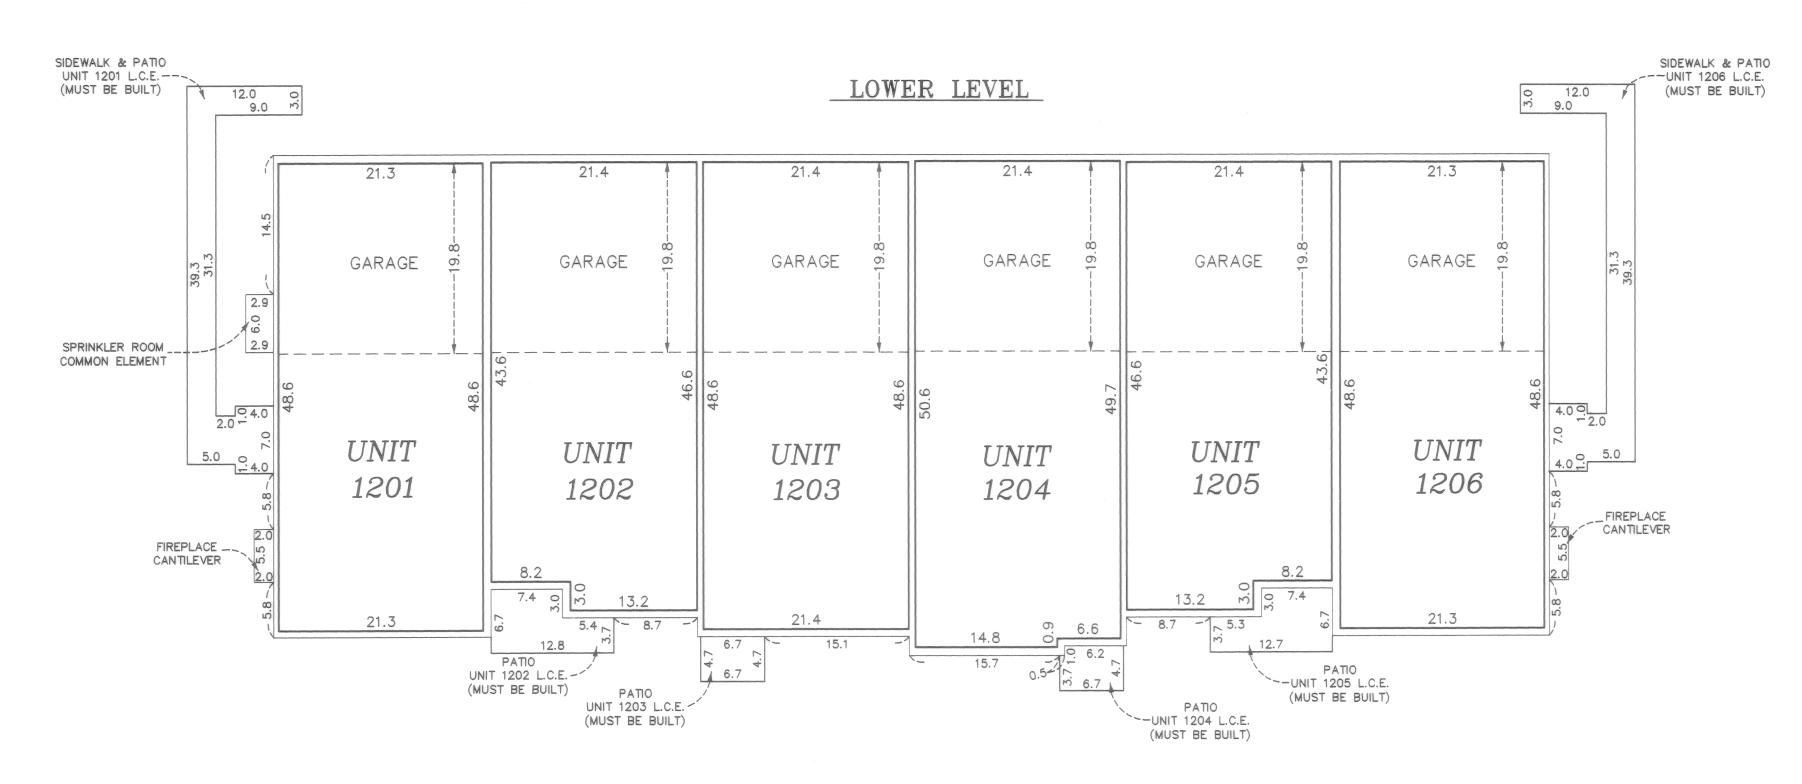

UPPER LEVEL

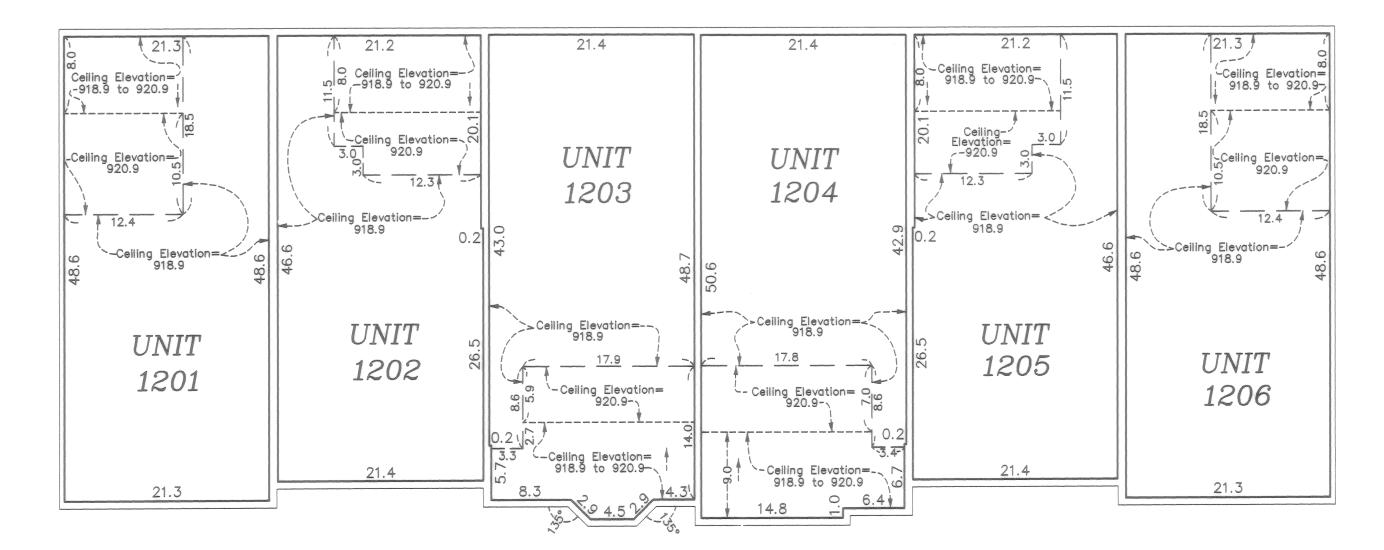

All units garage floor elevation at the garage door = 899.6 feet
All units garage floor elevation at back of garage= 899.9 feet
All units garage ceiling elevations = 909.2 feet

All units lower level floor elevations = 900.1 feet
All units lower level ceiling elevation = 909.2 feet

All units upper level floor elevation = 910.8 feet
All units upper level ceiling elevation varies from


Interior Dimensions shown are measured to the unfinished surface of the walls, floors and ceilings.

L.C.E. Denotes Limited Common Element

918.9 feet to 920.9 feet

Elevations are referenced to Benchmark as noted on sheet 1 of 5 sheets and are shown in feet and tenths of a foot.



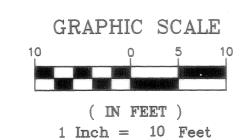



OFFICIAL PLAT

UNIT DETAIL

(AS-BUILT)


BK. 9 of CIC Pg. 20

CIC NUMBER 171


COTTAGES AT CLUB WEST, A CONDOMINIUM
FIFTEENTH SUPPLEMENTAL
CIC PLAT

C.R. DOC. NO.

CITY OF BLAINE COUNTY OF ANOKA SEC. 17, TWP. 31, RGE. 23

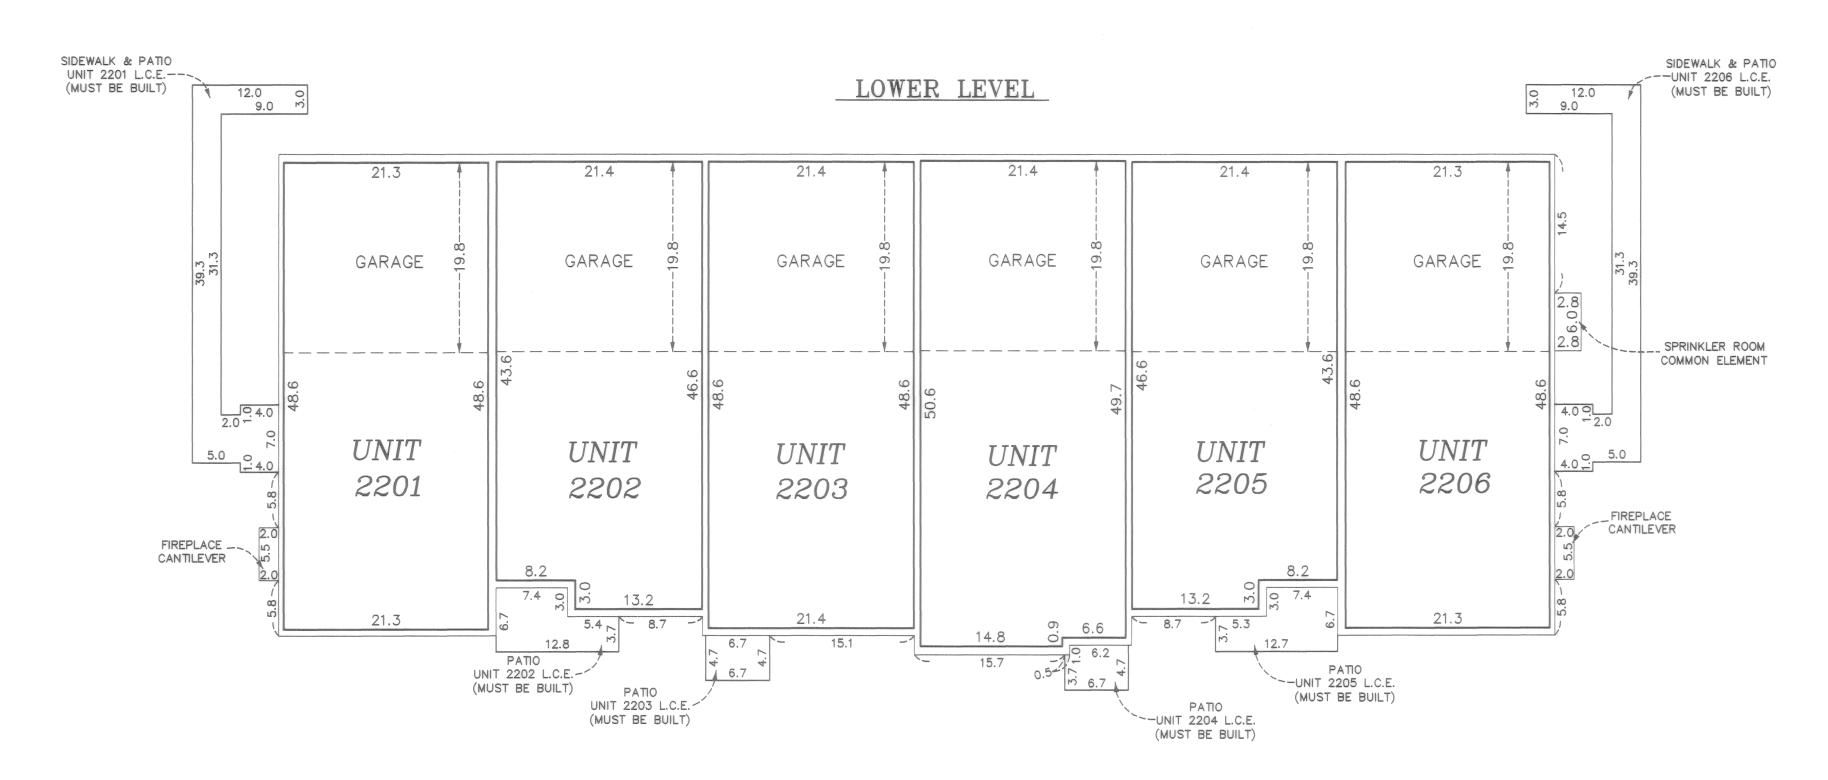

UPPER LEVEL

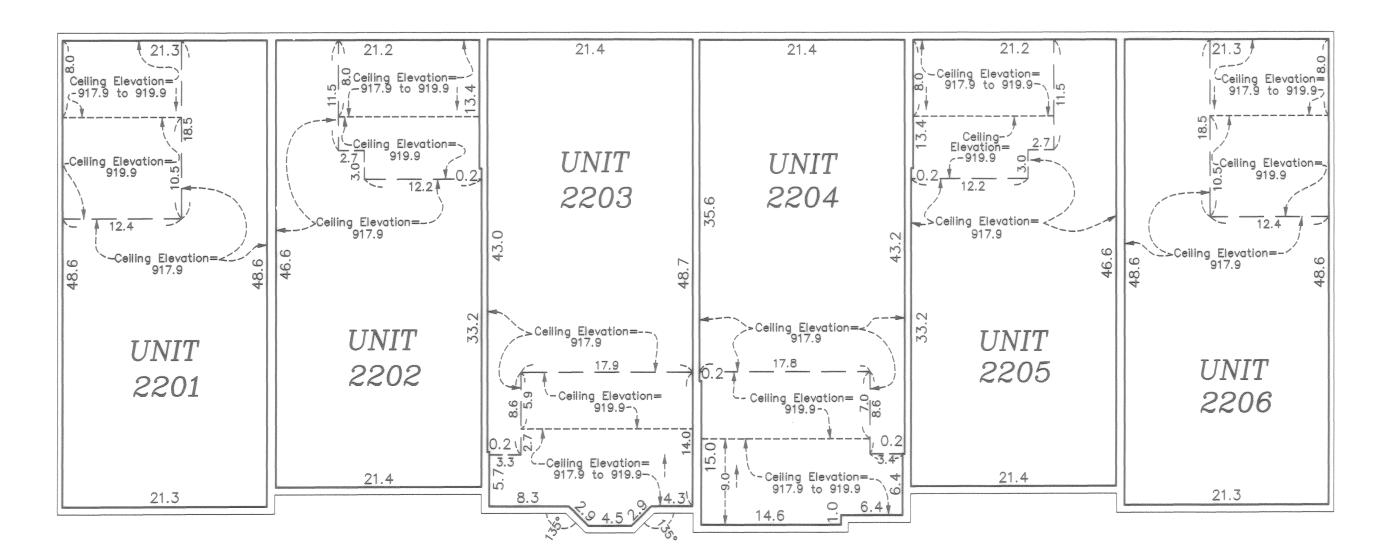

All units garage floor elevation at the garage door = 898.6 feet
All units garage floor elevation at back of garage= 898.9 feet
All units garage ceiling elevations = 908.2 feet

All units lower level floor elevations = 899.1 feet
All units lower level ceiling elevation = 908.2 feet

All units upper level floor elevation = 909.8 feet All units upper level ceiling elevation varies from 917.9 feet to 919.9 feet

Interior Dimensions shown are measured to the unfinished surface of the walls, floors and ceilings.

L.C.E. Denotes Limited Common Element

Elevations are referenced to Benchmark as noted on sheet 1 of 5 sheets and are shown in feet and tenths of a foot.



GRAPHIC SCALE

10 0 5 10

(IN FEET)

1 Inch = 10 Feet

