

SITE PLAN (AS-BUILT)


CIC NUMBER 171

COTTAGES AT CLUB WEST, A CONDOMINIUM SECOND SUPPLEMENTAL CIC PLAT

C.R. DOC. NO._____

BK7 of CIC pg 48

CITY OF BLAINE COUNTY OF ANOKA SEC. 17, TWP. 31, RGE. 23

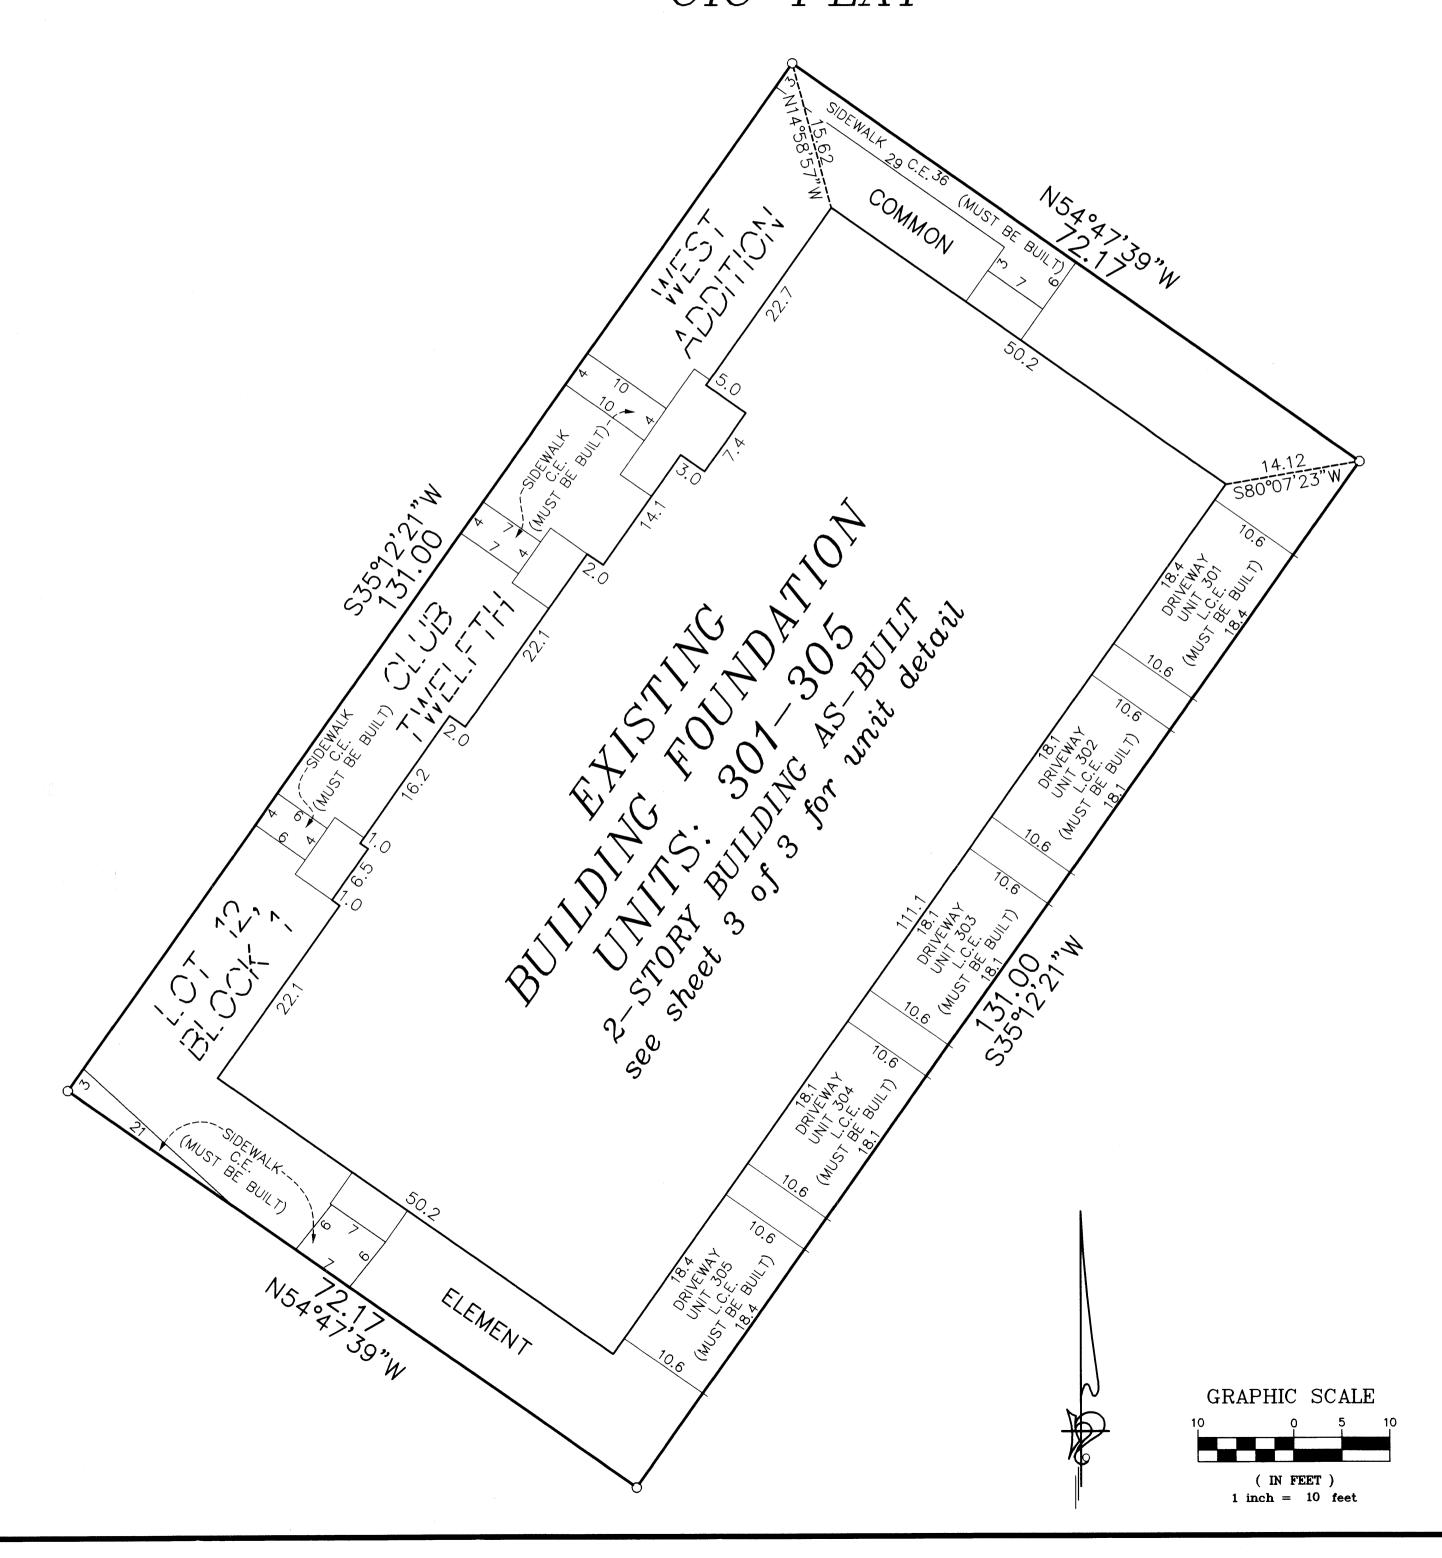

C.E. = Commont Element
L.C.E. = Limited Common Element

O Denotes 1/2 inch by 14 inch iron monument set and marked with license number 20595.

For the purposes of this CIC the southerly line of Lot 25, Block 1, CLUB WEST TWELFTH ADDITION, is assumed to have a bearing of North 89 degrees 49 minutes 20 seconds East.

LAND SURVEYORS • CIVIL ENGINEERS

LAND PLANNERS • LANDSCAPE ARCHITECTS

OFFICIAL PLAT

UNIT DETAIL

(AS-BUILT)


CIC NUMBER 171
COTTAGES AT CLUB WEST,

A CONDOMINIUM
SECOND SUPPLEMENTAL
CIC PLAT

C.R. DOC. NO._____

CITY OF BLAINE COUNTY OF ANOKA SEC. 17, TWP. 31, RGE. 23

LOWER LEVEL

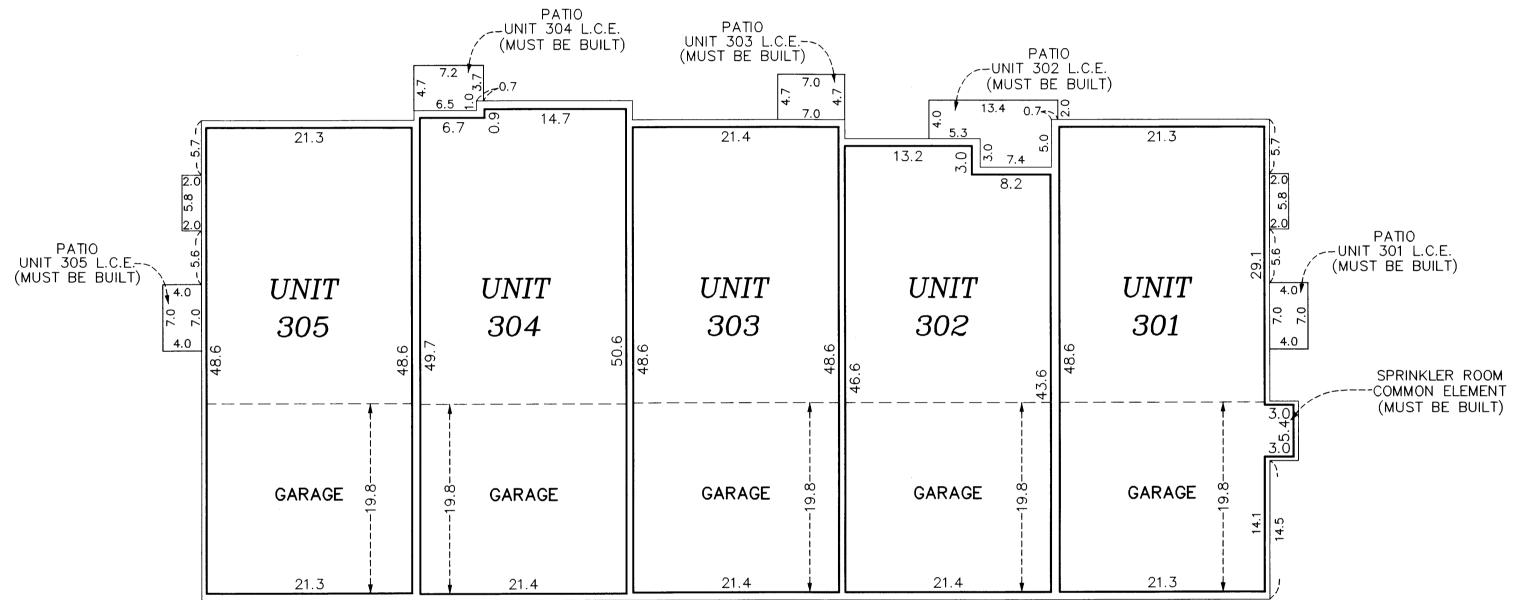

of a fo

L.C.E. Denotes Limited Common Element

C.E. = Common Element

917.5 feet to 919.5 feet

BK7 of CICP948

Elevations are referenced to Benchmark as noted on sheet 1 of 3 sheets and are shown in feet and tenths of a foot.

All units garage floor elevation at the garage door = 898.2 feet

All units garage floor elevation at back of garage= 898.5 feet

All units garage ceiling elevations = 907.8 feet

All units lower level floor elevations = 898.7 feet
All units lower level ceiling elevation = 907.8 feet


All units upper level floor elevation = 909.4 feet


Interior Dimensions shown are measured to the


unfinished surface of the walls, floors and ceilings.

All units upper level ceiling elevation varies from

UPPER LEVEL

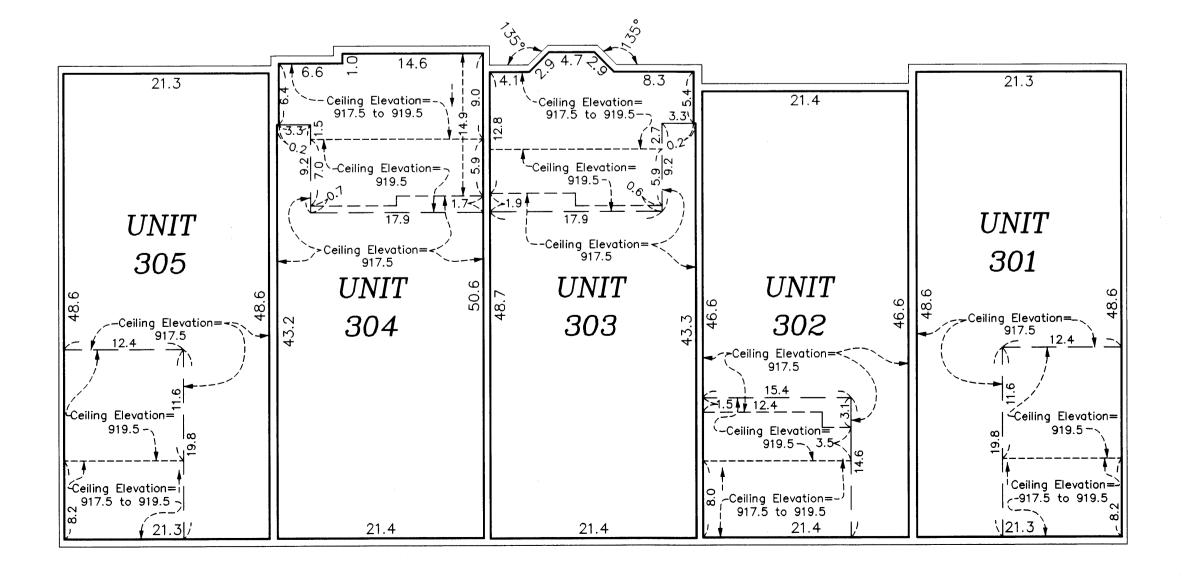

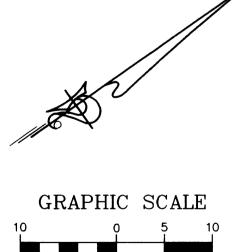

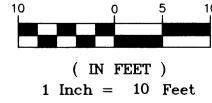



LAND SURVEYORS • CIVIL ENGINEERS

LAND PLANNERS • LANDSCAPE ARCHITECTS