

COMMON INTEREST COMMUNITY NUMBER 211






A CONDOMINIUM

THE SYMPHONY AT TOWN CENTER

FIRST SUPPLEMENTAL COMMON INTEREST COMMUNITY PLAT

This First Supplemental Common Interest Community Plat is part of the First Supplemental Declaration recorded as Document No. 1985761.001 on this 16th day of July, 2006.

Book 9 of C.I.C. CITY OF RAMSEY
Page 26 COUNTY OF ANOKA
SEC. 28, TWP. 32, RGE. 25

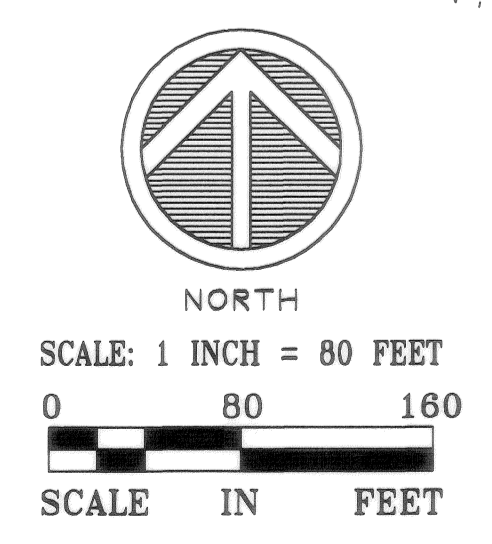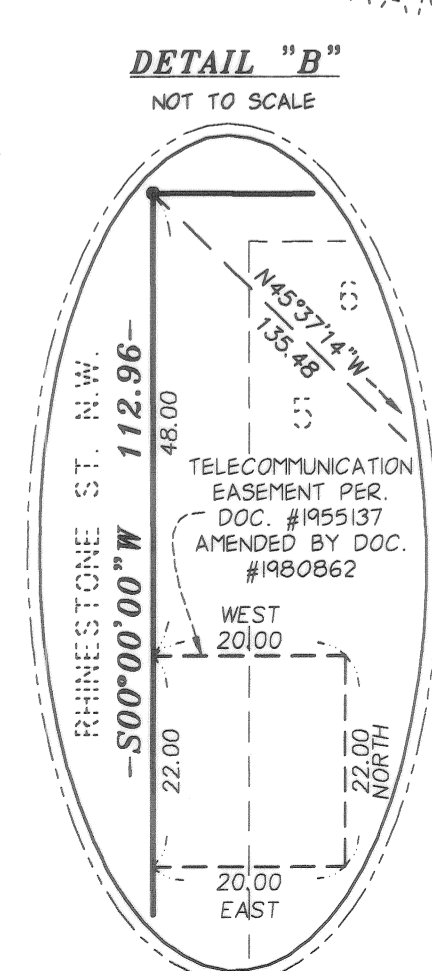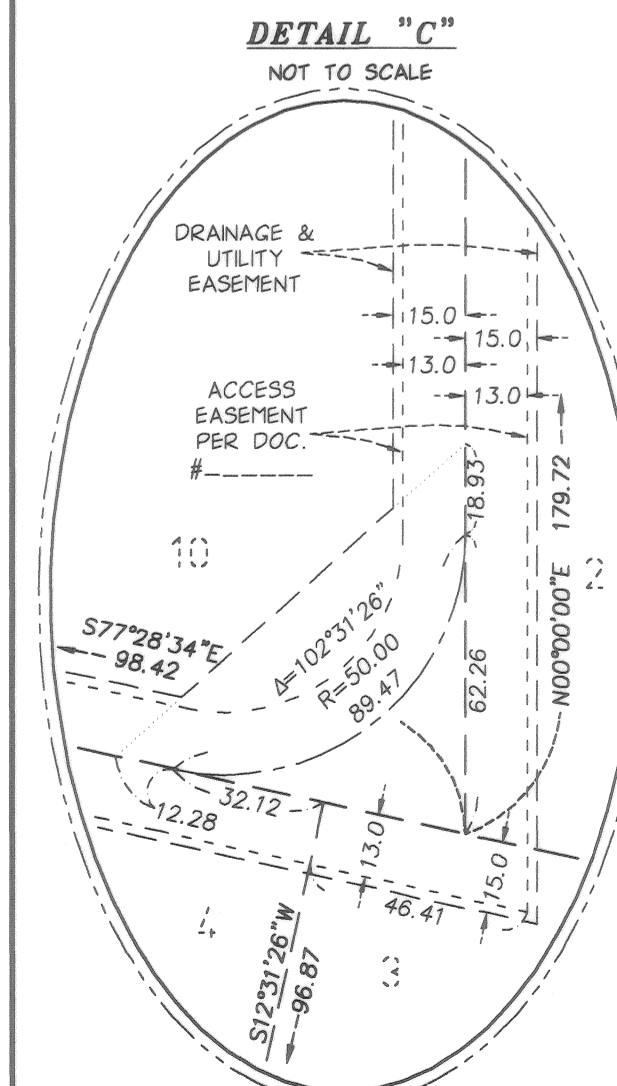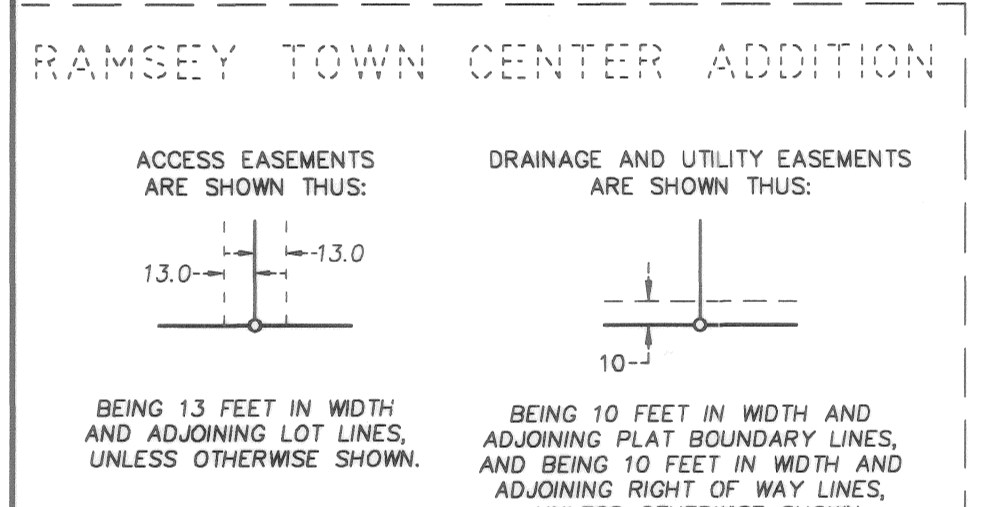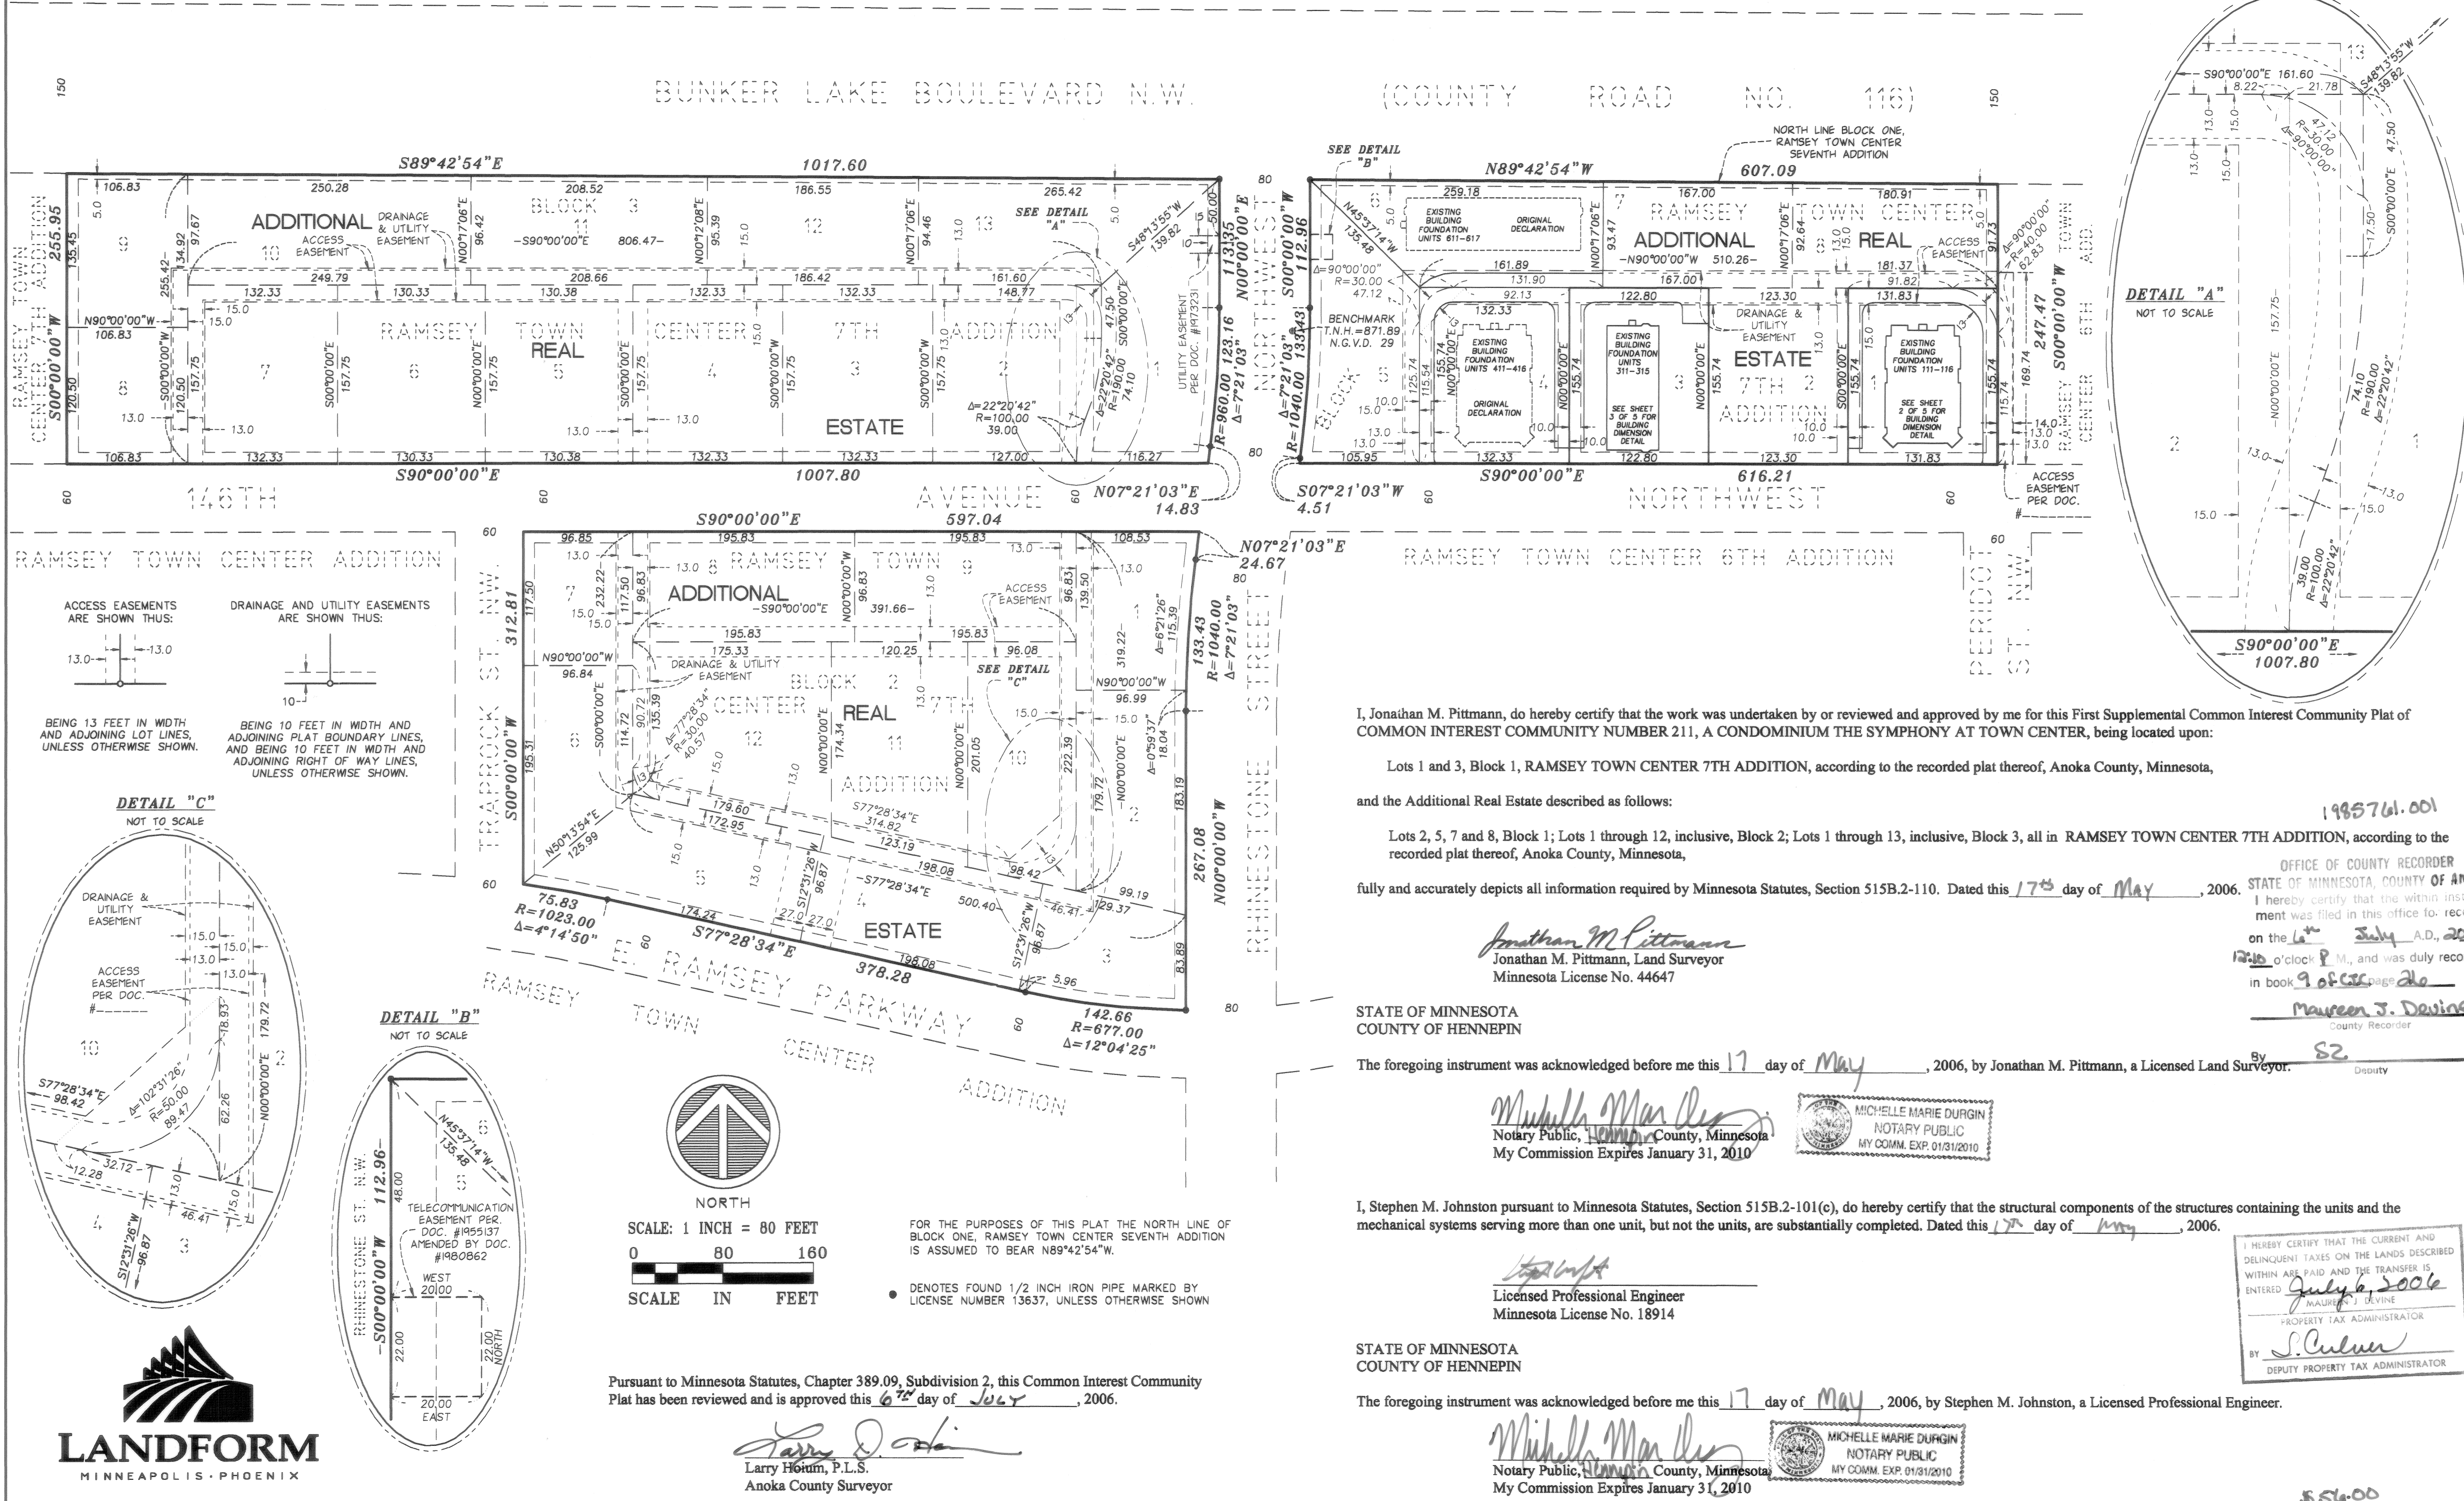

FOR THE PURPOSES OF THIS PLAT THE NORTH LINE OF BLOCK ONE, RAMSEY TOWN CENTER SEVENTH ADDITION IS ASSUMED TO BEAR N89°42'54"W.

• DENOTES FOUND 1/2 INCH IRON PIPE MARKED BY LICENSE NUMBER 13637, UNLESS OTHERWISE SHOWN

Pursuant to Minnesota Statutes, Chapter 389.09, Subdivision 2, this Common Interest Community Plat has been reviewed and is approved this 6th day of July, 2006.

Larry Hoitum
Larry Hoitum, P.L.S.
Anoka County Surveyor

I, Jonathan M. Pittmann, do hereby certify that the work was undertaken by or reviewed and approved by me for this First Supplemental Common Interest Community Plat of COMMON INTEREST COMMUNITY NUMBER 211, A CONDOMINIUM THE SYMPHONY AT TOWN CENTER, being located upon:

Lots 1 and 3, Block 1, RAMSEY TOWN CENTER 7TH ADDITION, according to the recorded plat thereof, Anoka County, Minnesota, and the Additional Real Estate described as follows:
Lots 2, 5, 7 and 8, Block 1; Lots 1 through 12, inclusive, Block 2; Lots 1 through 13, inclusive, Block 3, all in RAMSEY TOWN CENTER 7TH ADDITION, according to the recorded plat thereof, Anoka County, Minnesota,

fully and accurately depicts all information required by Minnesota Statutes, Section 515B.2-110. Dated this 17th day of May, 2006.

Jonathan M. Pittmann
Jonathan M. Pittmann, Land Surveyor
Minnesota License No. 44647

STATE OF MINNESOTA
COUNTY OF HENNEPIN

The foregoing instrument was acknowledged before me this 17 day of May, 2006, by Jonathan M. Pittmann, a Licensed Land Surveyor.

Michelle Marie Durgin
Notary Public, Hennepin County, Minnesota
My Commission Expires January 31, 2010




I, Stephen M. Johnston pursuant to Minnesota Statutes, Section 515B.2-101(c), do hereby certify that the structural components of the structures containing the units and the mechanical systems serving more than one unit, but not the units, are substantially completed. Dated this 17th day of May, 2006.

Stephen M. Johnston
Licensed Professional Engineer
Minnesota License No. 18914

STATE OF MINNESOTA
COUNTY OF HENNEPIN

The foregoing instrument was acknowledged before me this 17 day of May, 2006, by Stephen M. Johnston, a Licensed Professional Engineer.

Michelle Marie Durgin
Notary Public, Hennepin County, Minnesota
My Commission Expires January 31, 2010

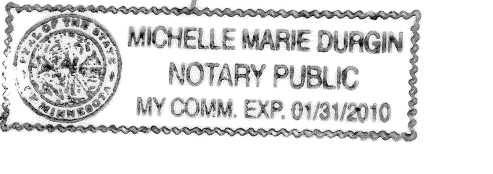

I HEREBY CERTIFY THAT THE CURRENT AND DELINQUENT TAXES ON THE LANDS DESCRIBED WITHIN ARE PAID AND THE TRANSFER IS ENTERED
July 6, 2006
MAUREEN J. DEVINE
PROPERTY TAX ADMINISTRATOR



SITE PLAN AND
BUILDING DIMENSION
DETAIL

COMMON INTEREST COMMUNITY NUMBER 211


A CONDOMINIUM

THE SYMPHONY AT TOWN CENTER


FIRST SUPPLEMENTAL COMMON INTEREST COMMUNITY PLAT

C.R. DOC. NO.

Book 9 of C.I.C.
Page 24
CITY OF RAMSEY
COUNTY OF ANOKA
SEC. 28, TWP. 32, RGE. 25

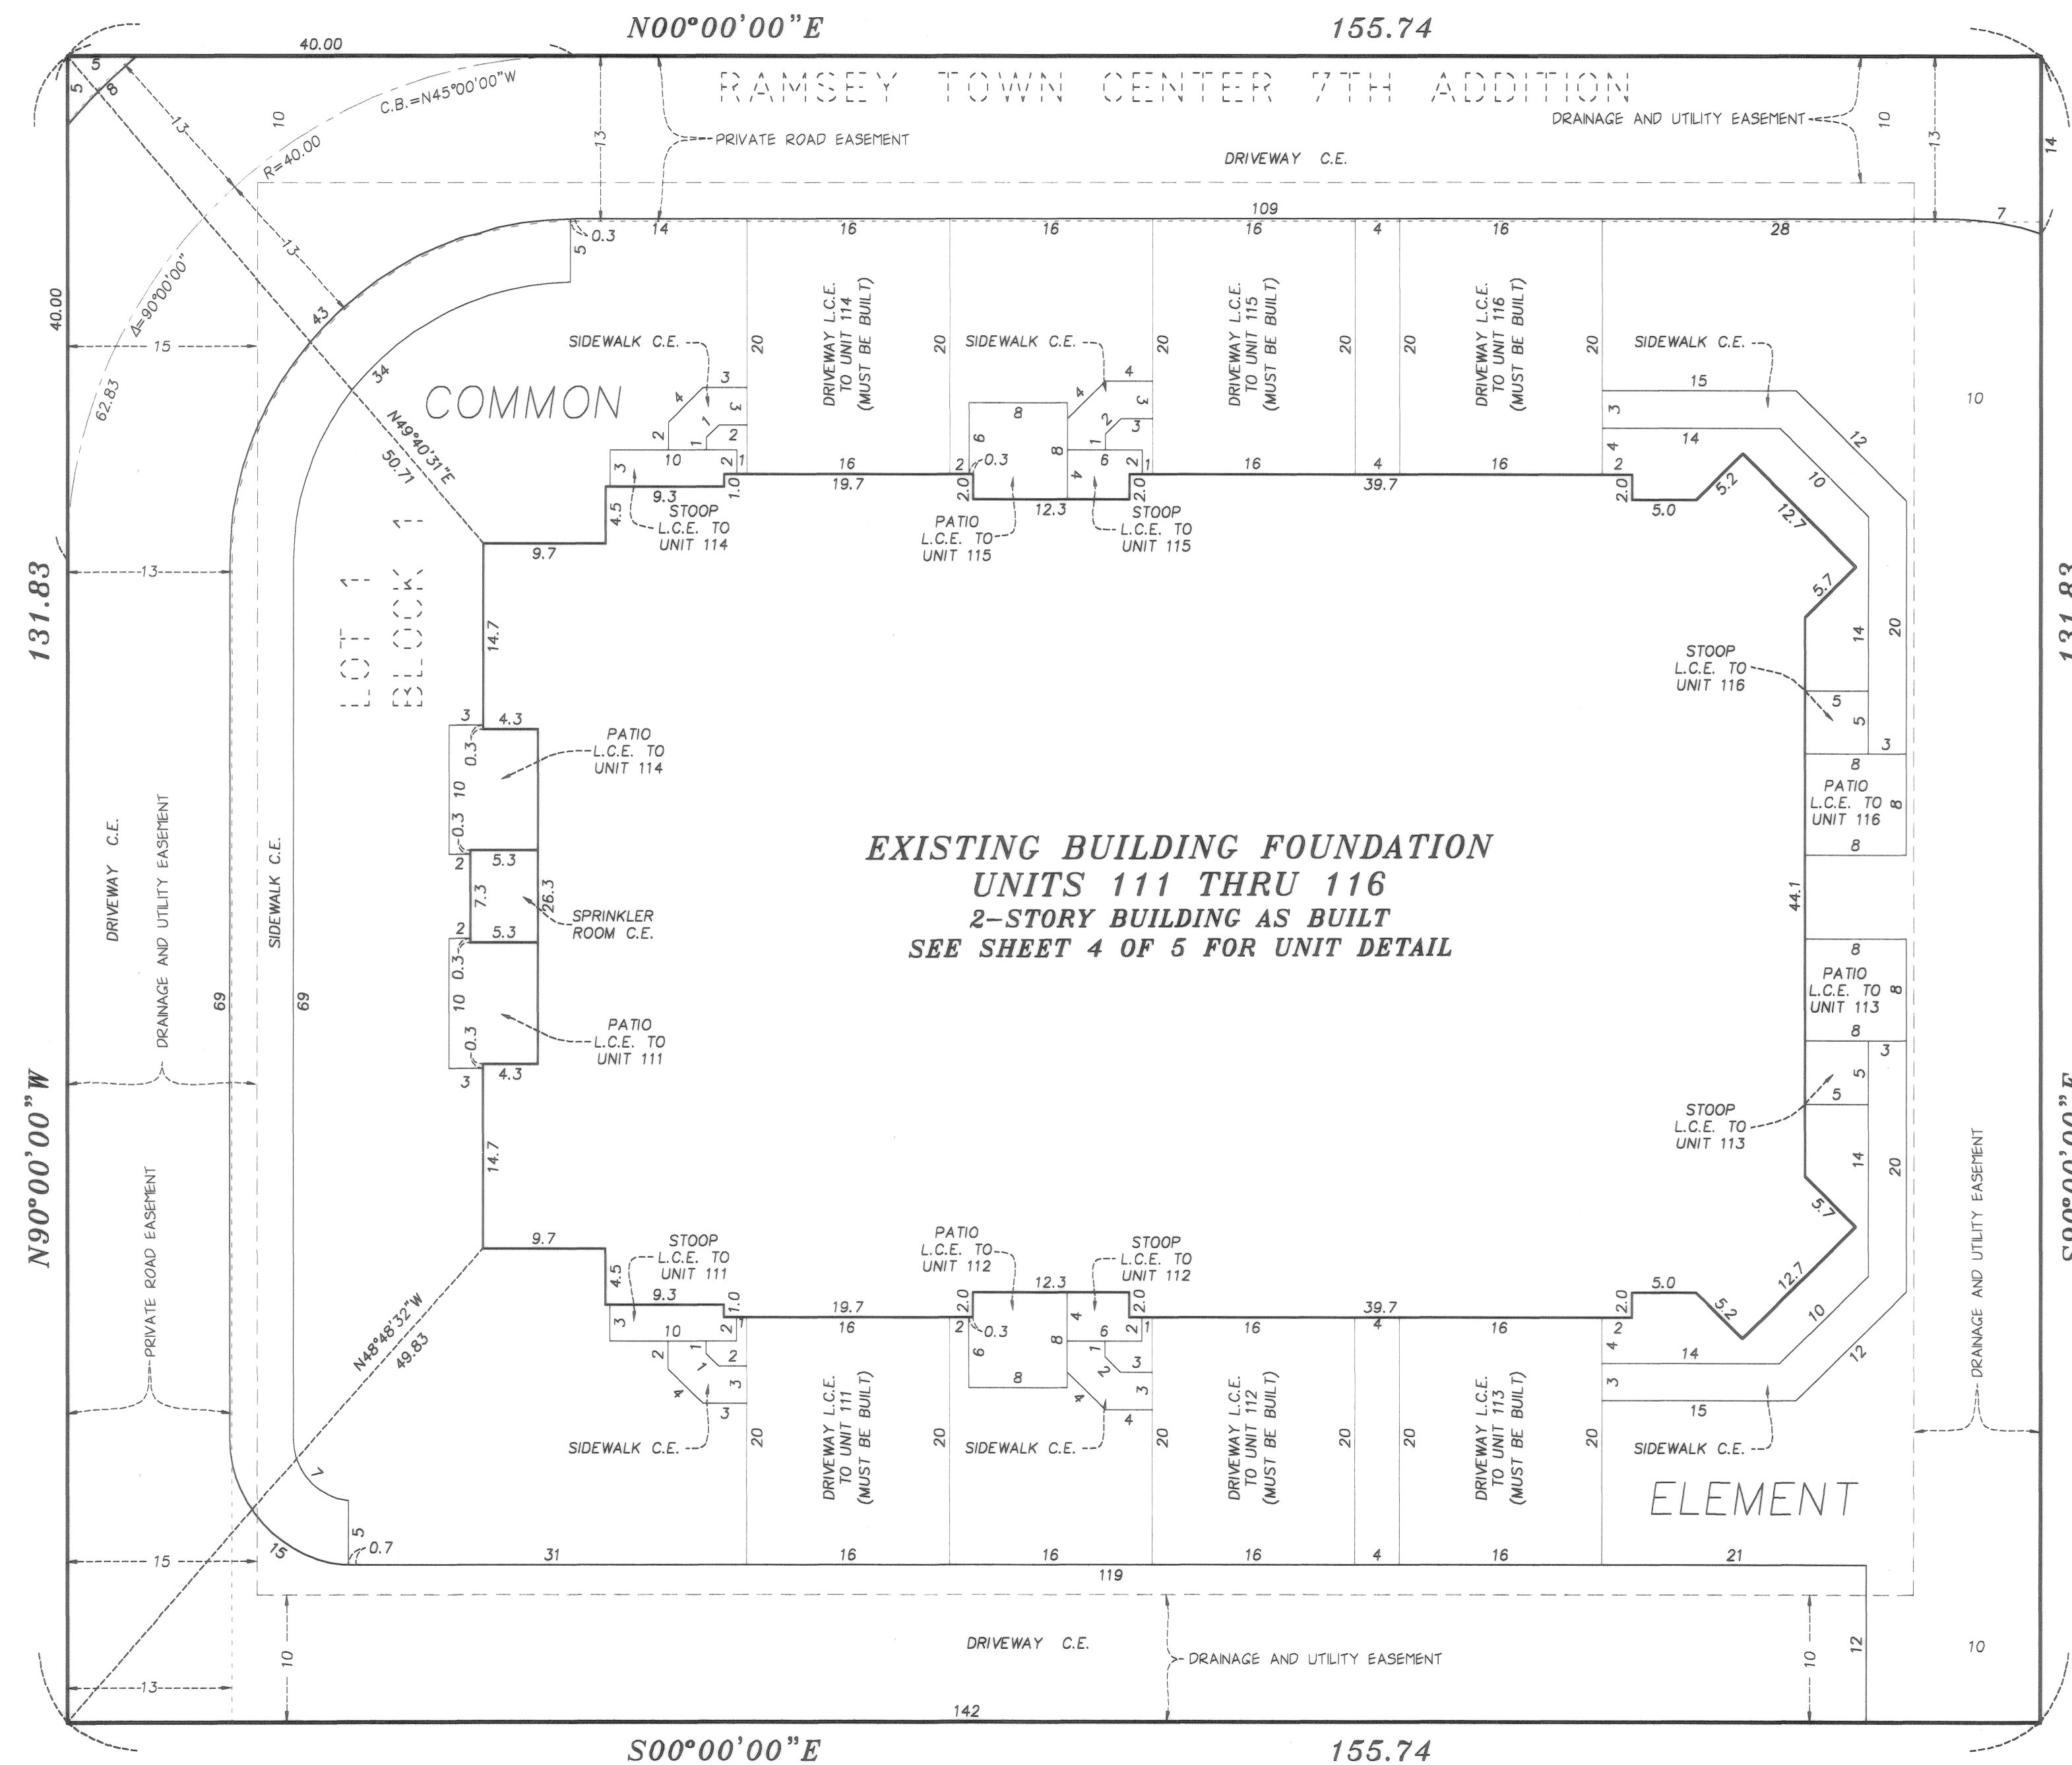


**EXISTING BUILDING FOUNDATION
UNITS 111 THRU 116
2-STORY BUILDING AS BUILT
SEE SHEET 4 OF 5 FOR UNIT DETAIL**

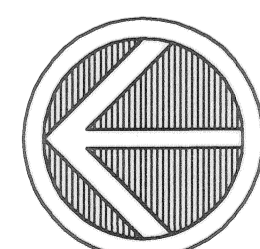

NORTH

SCALE: 1 INCH = 10 FEET

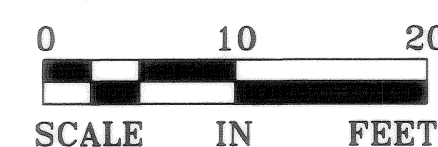

NOTE: ALL DRIVEWAYS, STOOPS, AND SIDEWALKS
MUST BE BUILT.

C.E. - DENOTES COMMON ELEMENT

L.C.E. - DENOTES LIMITED COMMON ELEMENT

BENCH MARK:

TOP NUT OF HYDRANT LOCATED ON THE EAST SIDE OF
RHINESTONE ST. N.W. AND 226 FEET SOUTH OF THE
CENTERLINE OF COUNTY ROAD 116 (BUNKER LAKE BLVD.)

ELEVATION = 871.89 FEET (NGVD 1929 DATUM)



SITE PLAN AND
BUILDING DIMENSION
DETAIL

COMMON INTEREST COMMUNITY NUMBER 211



A CONDOMINIUM

THE SYMPHONY AT TOWN CENTER

FIRST SUPPLEMENTAL COMMON INTEREST COMMUNITY PLAT


C.R. DOC. NO.

Book 9 of C.C.
Page 210 CITY OF RAMSEY
COUNTY OF ANOKA
SEC. 28, TWP. 32, RGE. 25

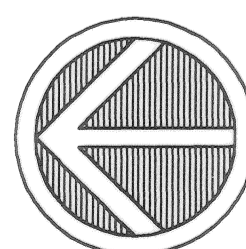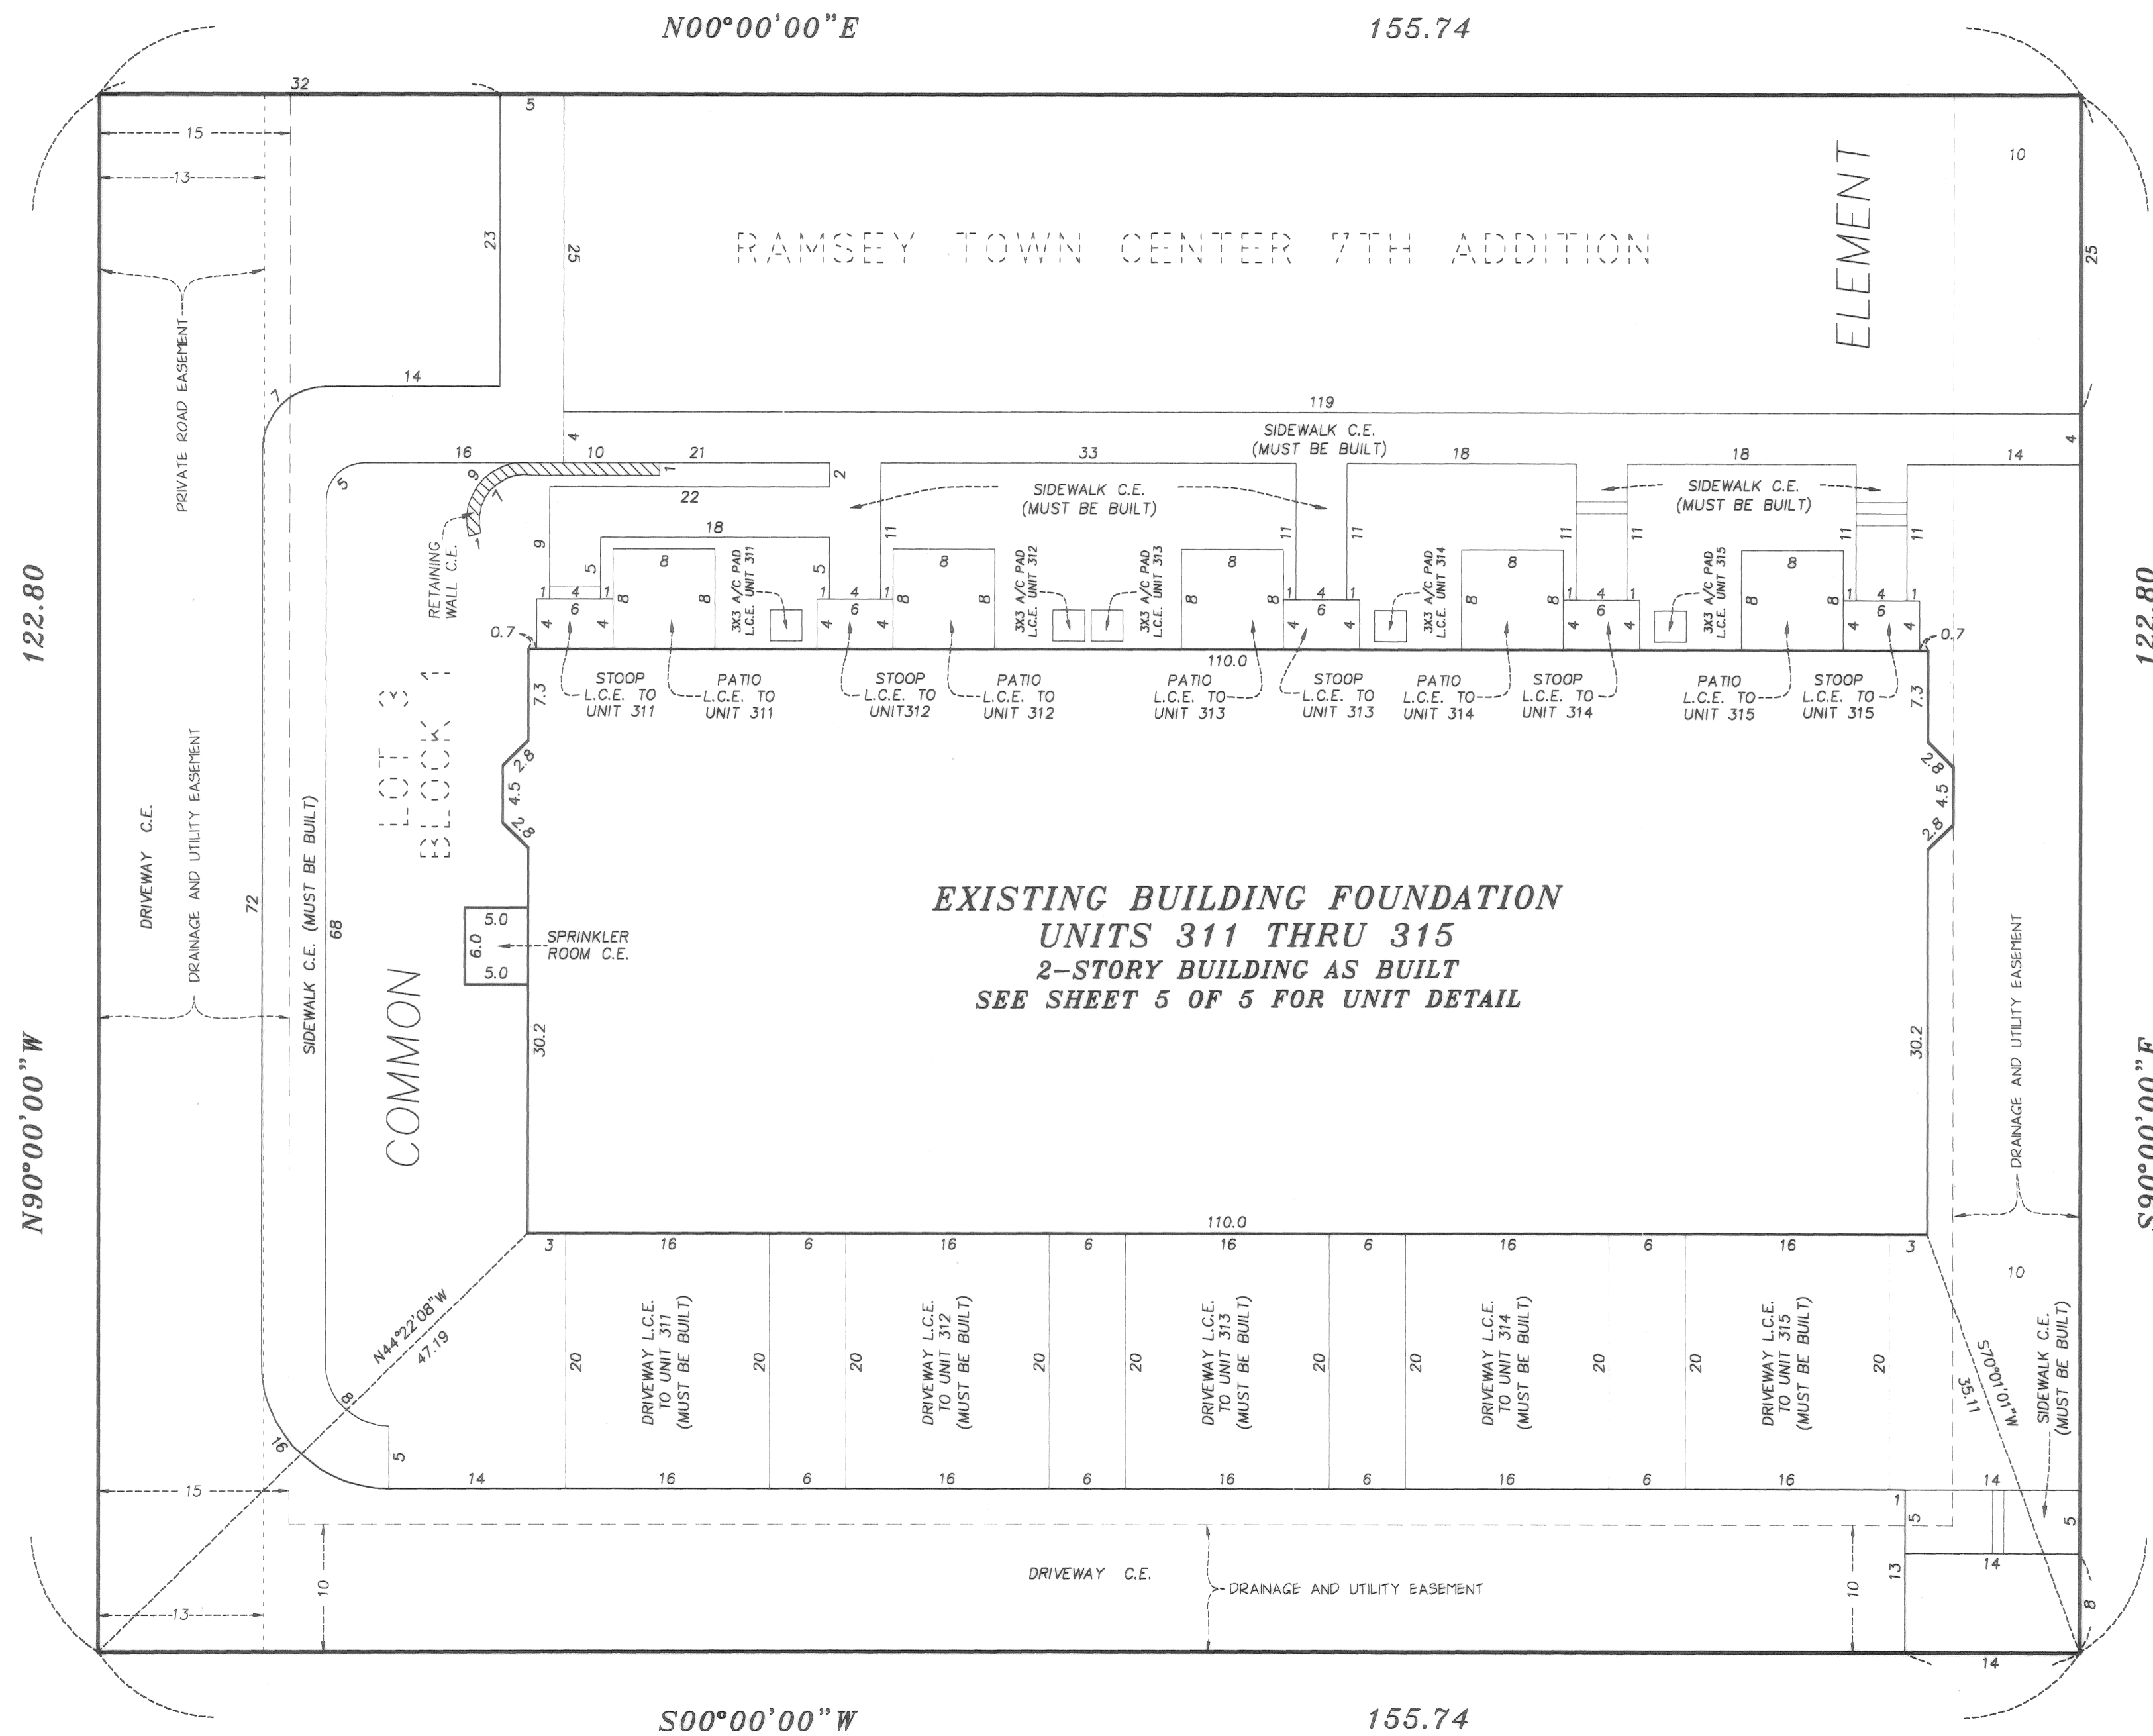

NORTH

SCALE: 1 INCH = 10 FEET

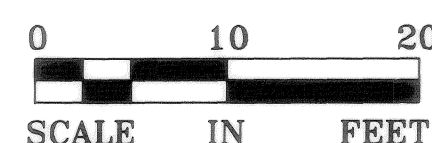

NOTE: ALL DRIVEWAYS AND SIDEWALKS
MUST BE BUILT.


C.E. - DENOTES COMMON ELEMENT

L.C.E. - DENOTES LIMITED COMMON ELEMENT

BENCH MARK:

TOP NUT OF HYDRANT LOCATED ON THE EAST SIDE OF
RHINESTONE ST. N.W. AND 226 FEET SOUTH OF THE
CENTERLINE OF COUNTY ROAD 116 (BUNKER LAKE BLVD.)

ELEVATION = 871.89 FEET (NGVD 1929 DATUM)

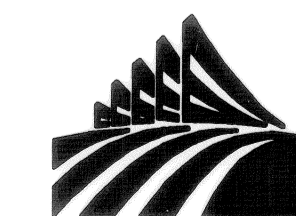

LANDFORM
MINNEAPOLIS · PHOENIX

UNIT DETAIL
AS BUILT

COMMON INTEREST COMMUNITY NUMBER 211

A CONDOMINIUM



THE SYMPHONY AT TOWN CENTER

FIRST SUPPLEMENTAL COMMON INTEREST COMMUNITY PLAT

C.R. DOC. NO.


Book 9 of C.R.
Page 216
CITY OF RAMSEY
COUNTY OF ANOKA
SEC. 28, TWP. 32, RGE. 25

UPPER LEVEL -

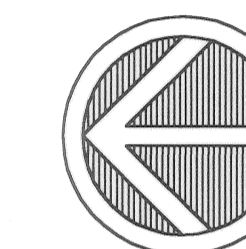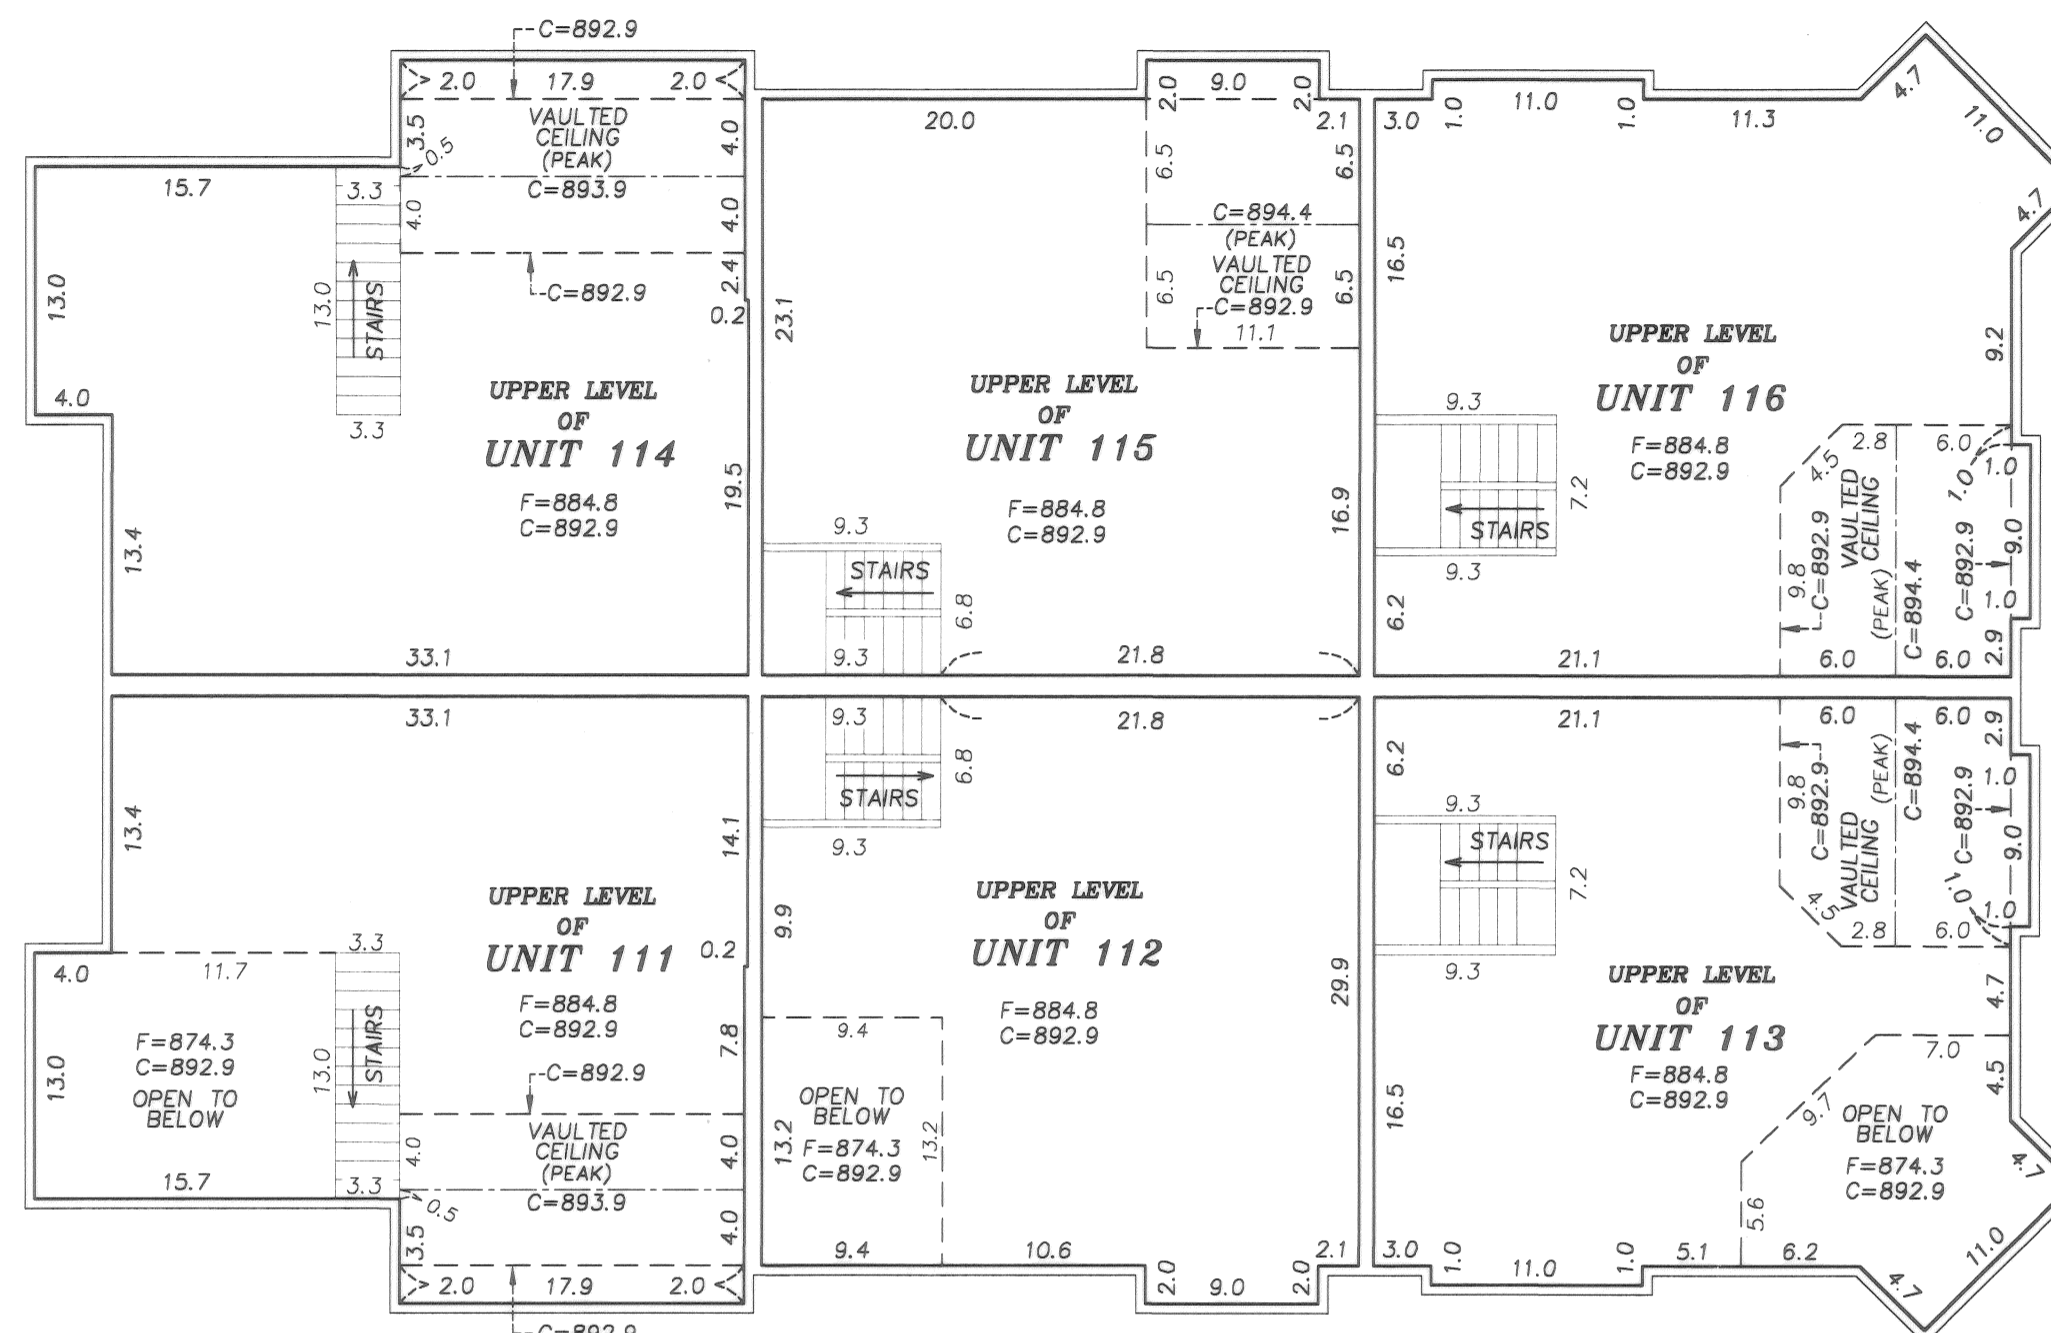

NORTH

SCALE: 1 INCH = 10 FEET

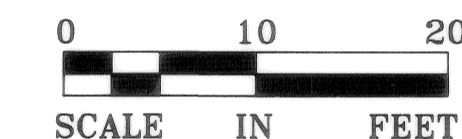


C.E. - DENOTES COMMON ELEMENT
 C - DENOTES CEILING ELEVATION
 F - DENOTES FLOOR ELEVATION

INTERIOR DIMENSIONS SHOWN ARE MEASURED TO THE UNFINISHED SURFACE OF THE WALLS, FLOORS AND CEILINGS.

ELEVATIONS ARE REFERENCED TO A BENCH MARK AS NOTED ON SHEET 2 OF 5 SHEETS AND ARE SHOWN IN FEET AND TENTHS OF A FOOT.

LOWER LEVEL -

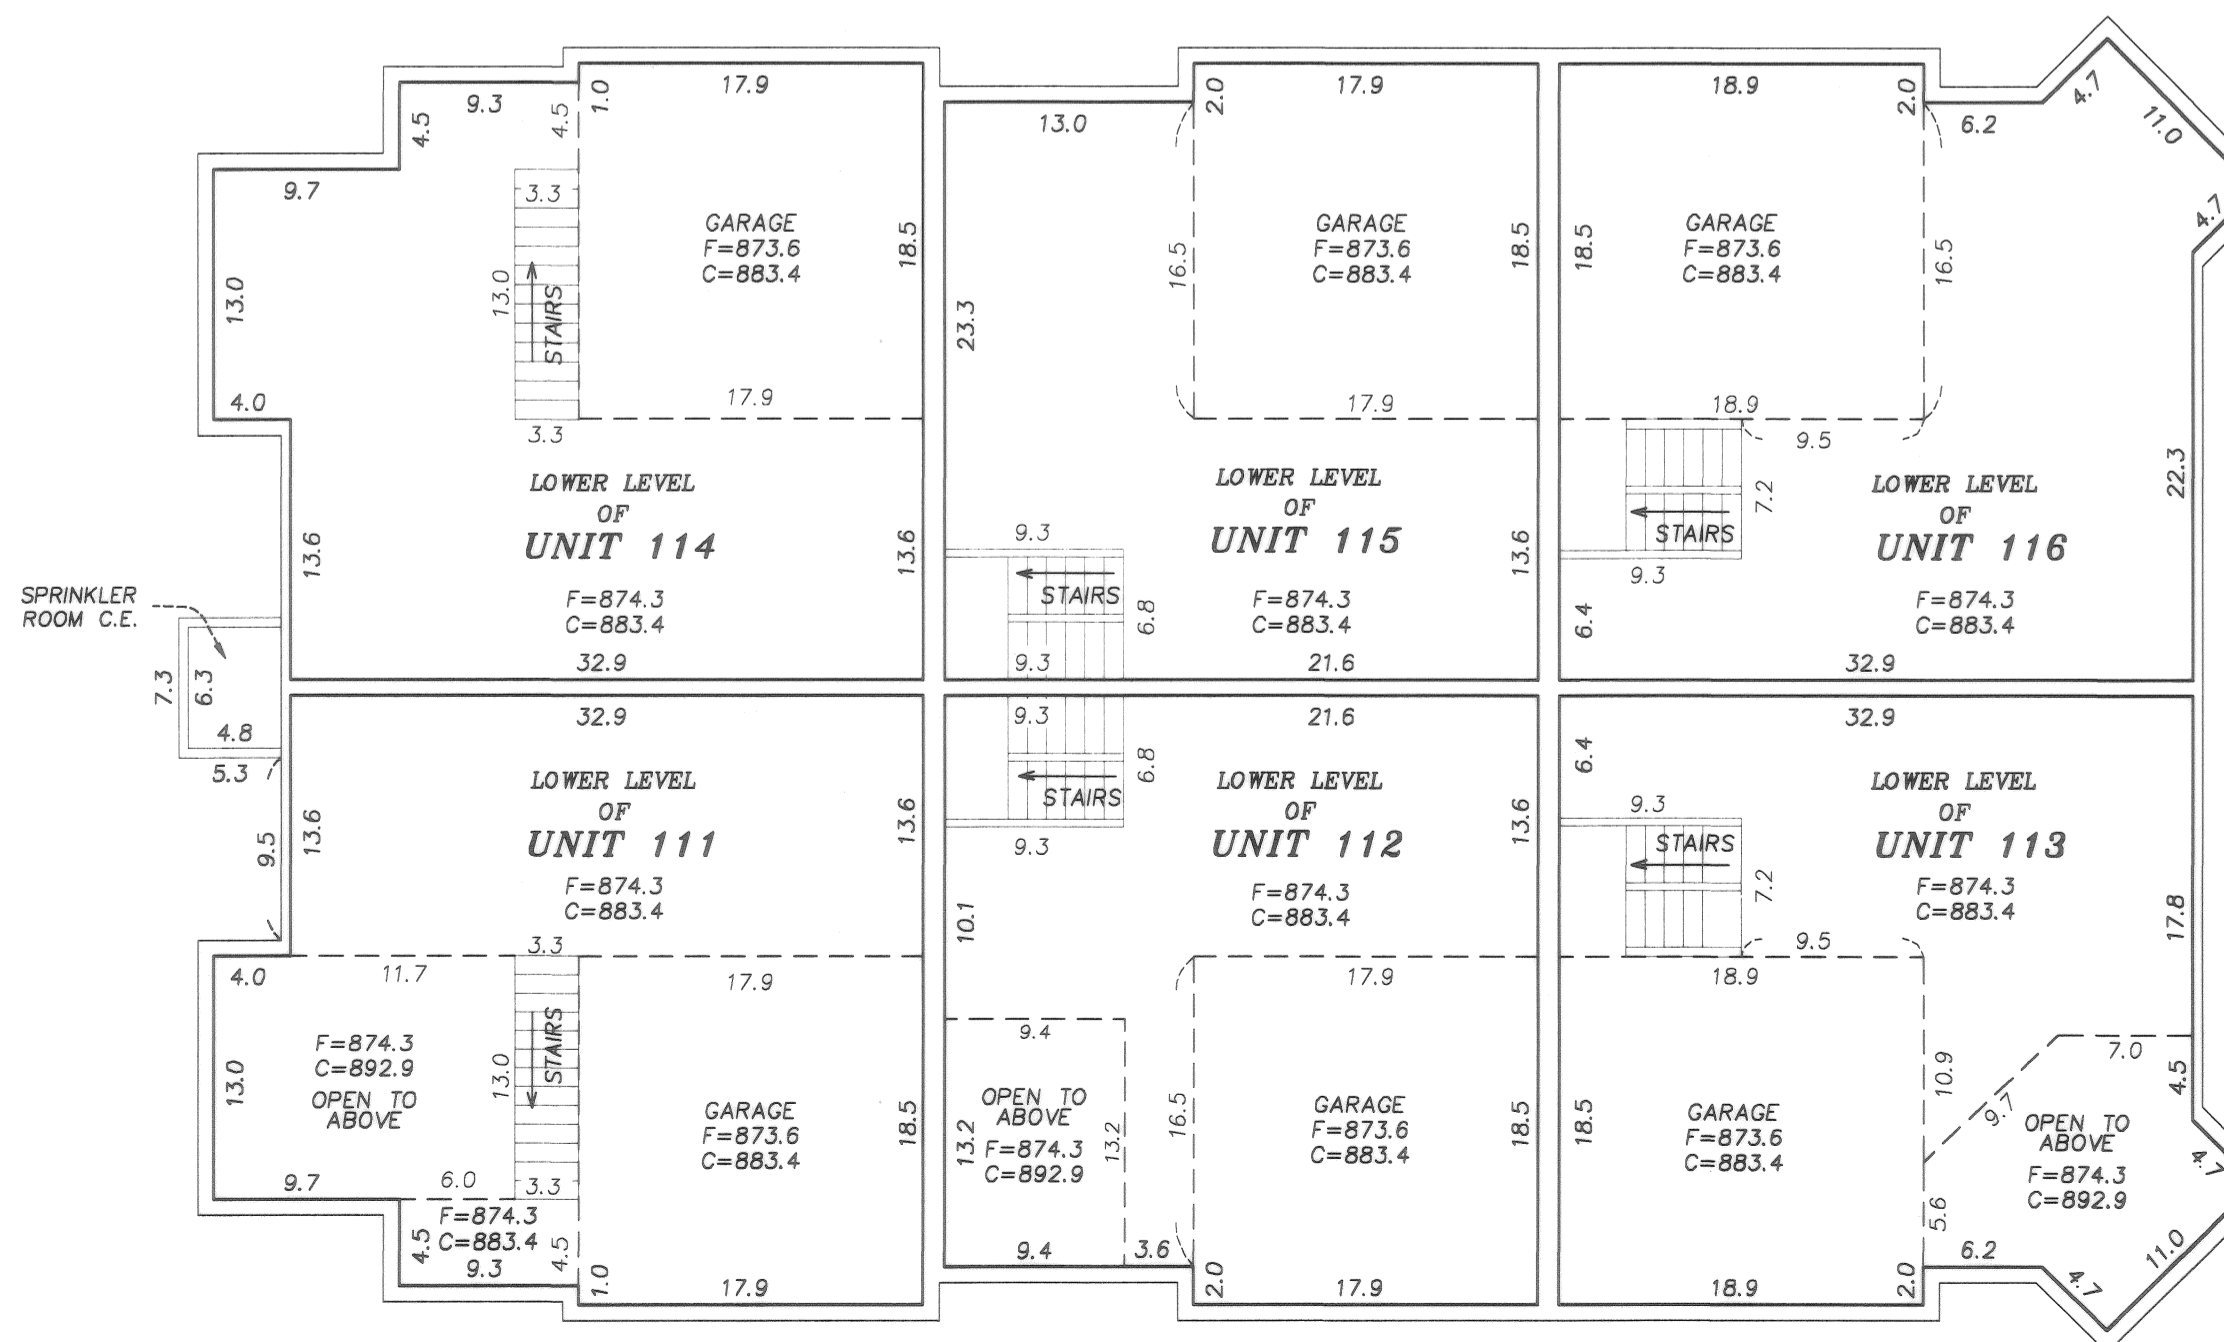

UNIT DETAIL
AS BUILT

COMMON INTEREST COMMUNITY NUMBER 211

A CONDOMINIUM



THE SYMPHONY AT TOWN CENTER

FIRST SUPPLEMENTAL COMMON INTEREST COMMUNITY PLAT

C.R. DOC. NO.

Book 9 of CIC
Page 26
CITY OF RAMSEY
COUNTY OF ANOKA
SEC. 28, TWP. 32, RGE. 25

UPPER LEVEL -

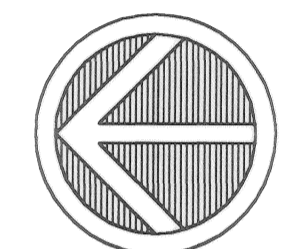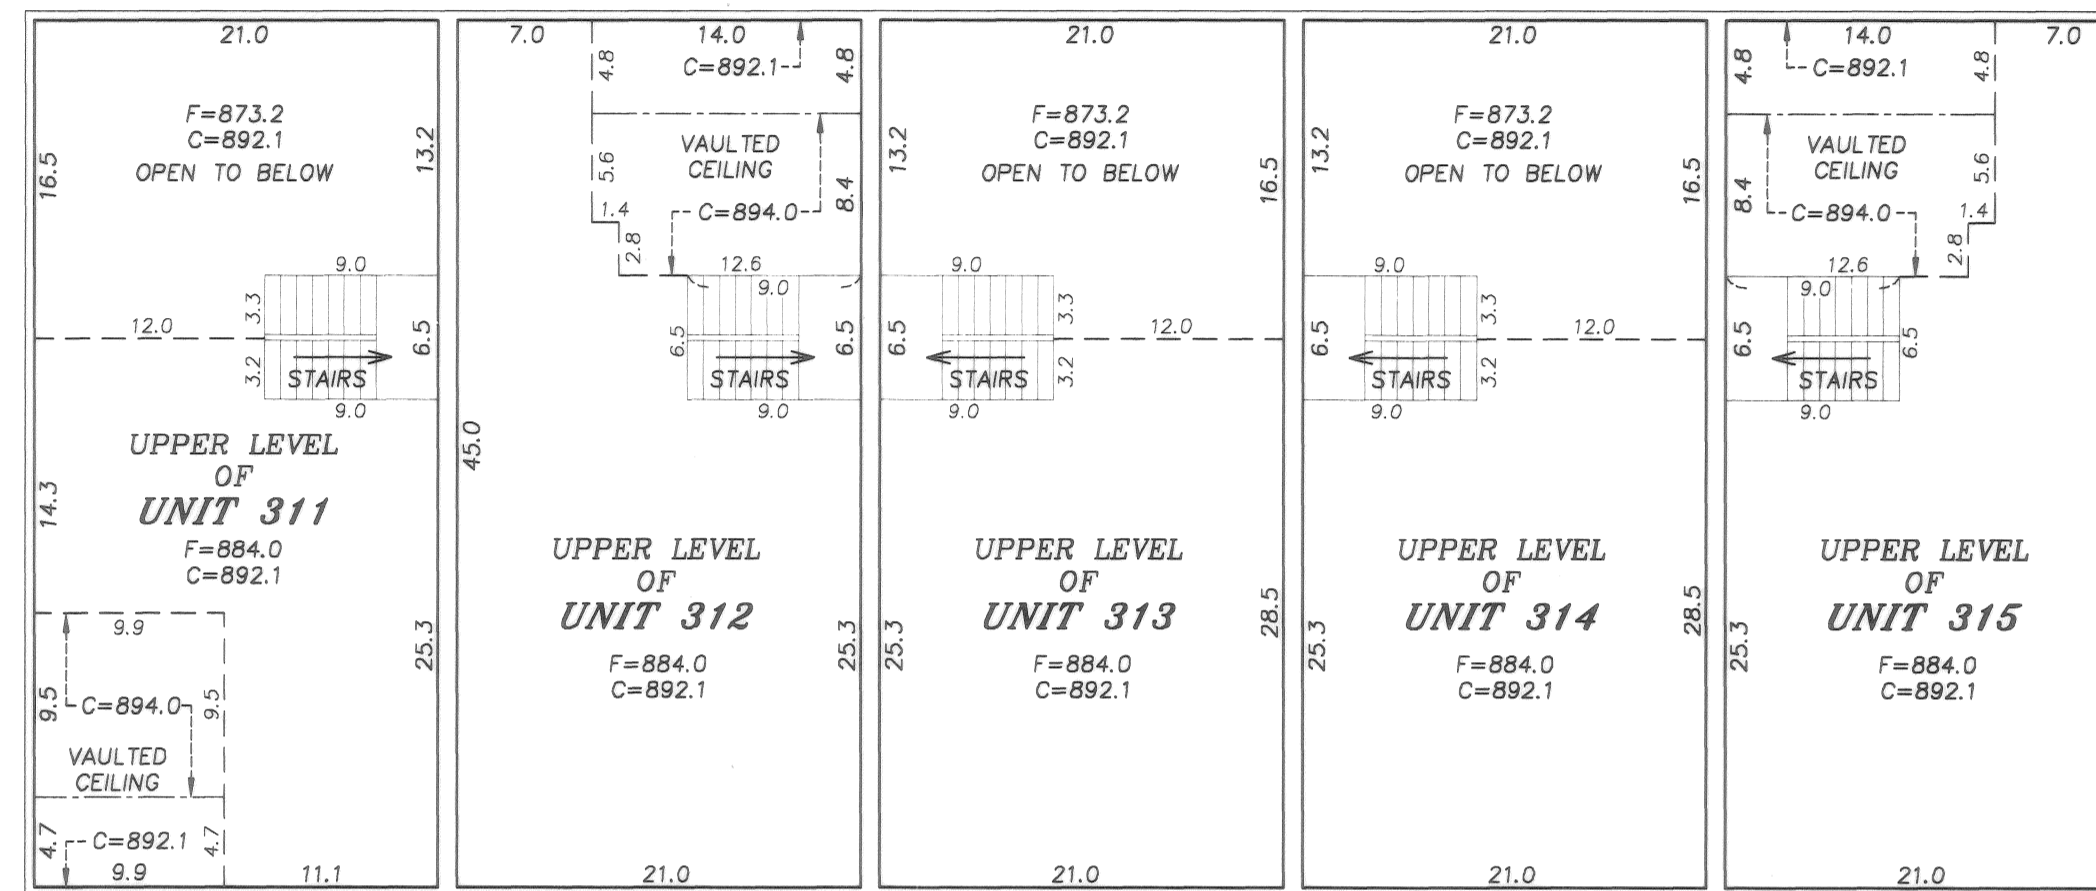

NORTH

SCALE: 1 INCH = 10 FEET
 0 10 20
 SCALE IN FEET

C.E. - DENOTES COMMON ELEMENT
 C - DENOTES CEILING ELEVATION
 F - DENOTES FLOOR ELEVATION

INTERIOR DIMENSIONS SHOWN ARE MEASURED TO THE UNFINISHED SURFACE OF THE WALLS, FLOORS AND CEILINGS.

ELEVATIONS ARE REFERENCED TO A BENCH MARK AS NOTED ON SHEET 2 OF 5 SHEETS AND ARE SHOWN IN FEET AND TENTHS OF A FOOT.

LOWER LEVEL -

