1989274.001 COMMON INTEREST COMMUNITY NUMBER 211 the Second Supplemental Declaration recorded as Document No. HEREBY CERTIFY THAT THE CURRENT AND 1989274.001 on this 27m day of November A CONDOMINIUM STATE OF MINNESOTA, COUNTY OF ANOKA BOOK 9 OF CIC PAGE 42 I hereby certify that the within instru-PROPERTY TAX ADMINISTRATOR ment was filed in this office for record THE SYMPHONY AT TOWN CENTER CITY OF RAMSEY COUNTY OF ANOKA SEC. 28, TWP. 32, RGE. 25 on the 21 A.D., 2006 Mo'clock PM., and was duly recorded SECOND SUPPLEMENTAL COMMON INTEREST COMMUNITY PLAT DEPUTY PROPERTY TAX ADMINISTRATOR NORTH LINE BLOCK ONE, -- RAMSEY TOWN CENTER SEE DETAIL S89°42'54"E 1017.60 N89°42'54"W 208.52 EASEMENT N90°00'00"W---106.83 ≥ R = 100.00S90°00'00"E 616.21 ACCESS 597.04 EASEMENT 14.83 DRAINAGE AND UTILITY EASEMENTS ACCESS EASEMENTS ARE SHOWN THUS: S90°00'00"E 13.0---1007.80 I, Jonathan M. Pittmann, do hereby certify that the work was undertaken by or reviewed and approved by me for this Second Supplemental Common Interest Community Plat of BEING 13 FEET IN WIDTH AND ADJOINING LOT LINES, COMMON INTEREST COMMUNITY NUMBER 211, A CONDOMINIUM, THE SYMPHONY AT TOWN CENTER, being located upon: ADJOINING PLAT BOUNDARY LINES, UNLESS OTHERWISE SHOWN. AND BEING 10 FEET IN WIDTH AND ADJOINING RIGHT OF WAY LINES. Lot 2, Block 1, RAMSEY TOWN CENTER 7TH ADDITION, according to the recorded plat thereof, Anoka County, Minnesota, UNLESS OTHERWISE SHOWN. and the Additional Real Estate described as follows: DETAIL "C" Lots 5, 7 and 8, Block 1; Lots 1 through 12, inclusive, Block 2; Lots 1 through 13, inclusive, Block 3, all in RAMSEY TOWN CENTER 7TH ADDITION, according to the recorded plat thereof, Anoka County, Minnesota, 500.40 \$ 46.41 \$129.37 fully and accurately depicts all information required by Minnesota Statutes, Section 515B.2-110. Dated this 13TH day of November, 2006. DRAINAGE & UTILITY 75.83 R=1023.00 Δ=4°14'50" [- 8 EASEMENT **ESTATE** -- 15.0 115.0 RAMSEY **ACCESS** Minnesota License No. 44647 EASEMENT PER DOC. STATE OF MINNESOTA 142.66 DETAIL "B" COUNTY OF HENNEPIN R=677.00Δ=12°04'25" The foregoing instrument was acknowledged before me this 13 day of Naxwor, 2006, by Jonathan M. Pittmann, a Licensed Land Surveyor. MICHELLE MARIE CHAPMAN
NOTARY PUBLIC
MINNESOTA
My Commission: Expires Jan. 81, 8619 My Commission Expires January 31, 2010 I, Stephen M. Johnston, pursuant to Minnesota Statutes, Section 515B.2-101(c), do hereby certify that the structural components of the structures containing the units and the mechanical systems serving more than one unit, but not the units, are substantially completed. Dated this _22 day of _\(\text{November}\) day of _\(\text{November}\). TELEĊOMMUNICATION' EASEMENT PER. FOR THE PURPOSES OF THIS PLAT THE NORTH LINE OF BLOCK ONE, RAMSEY TOWN CENTER SEVENTH ADDITION SCALE: 1 INCH = 80 FEET DOC. #1955137 AMENDED BY DOC IS ASSUMED TO BEAR N89°42'54"W. #1980862 DENOTES FOUND 1/2 INCH IRON PIPE MARKED BY LICENSE NUMBER 13637, UNLESS OTHERWISE SHOWN Minnesota License No. 18914 STATE OF MINNESOTA COUNTY OF HENNEPIN Pursuant to Minnesota Statutes, Chapter 389.09, Subdivision 2, this Common Interest Community Plat has been reviewed and is approved this 27 day of November, 2006. ALLAN RICHARD HOLMSTEN NOTARY PUBLIC - MINNESOTA MY COMMISSION EXPIRES 01/81/201 Notary Public, Dok of a County, Minnesota Anoka County Surveyor My Commission Expires January 31, 2011 \$56.00

SITE PLAN AND BUILDING DIMENSION OF CALPLAT DETAIL


COMMON INTEREST COMMUNITY NUMBER 211


Book 9 of CIC Page 42 C.R. DOC. NO. 1989274.661

> CITY OF RAMSEY COUNTY OF ANOKA SEC. 28, TWP. 32, RGE. 25

A CONDOMINIUM

THE SYMPHONY AT TOWN CENTER SECOND SUPPLEMENTAL COMMON INTEREST COMMUNITY PLAT

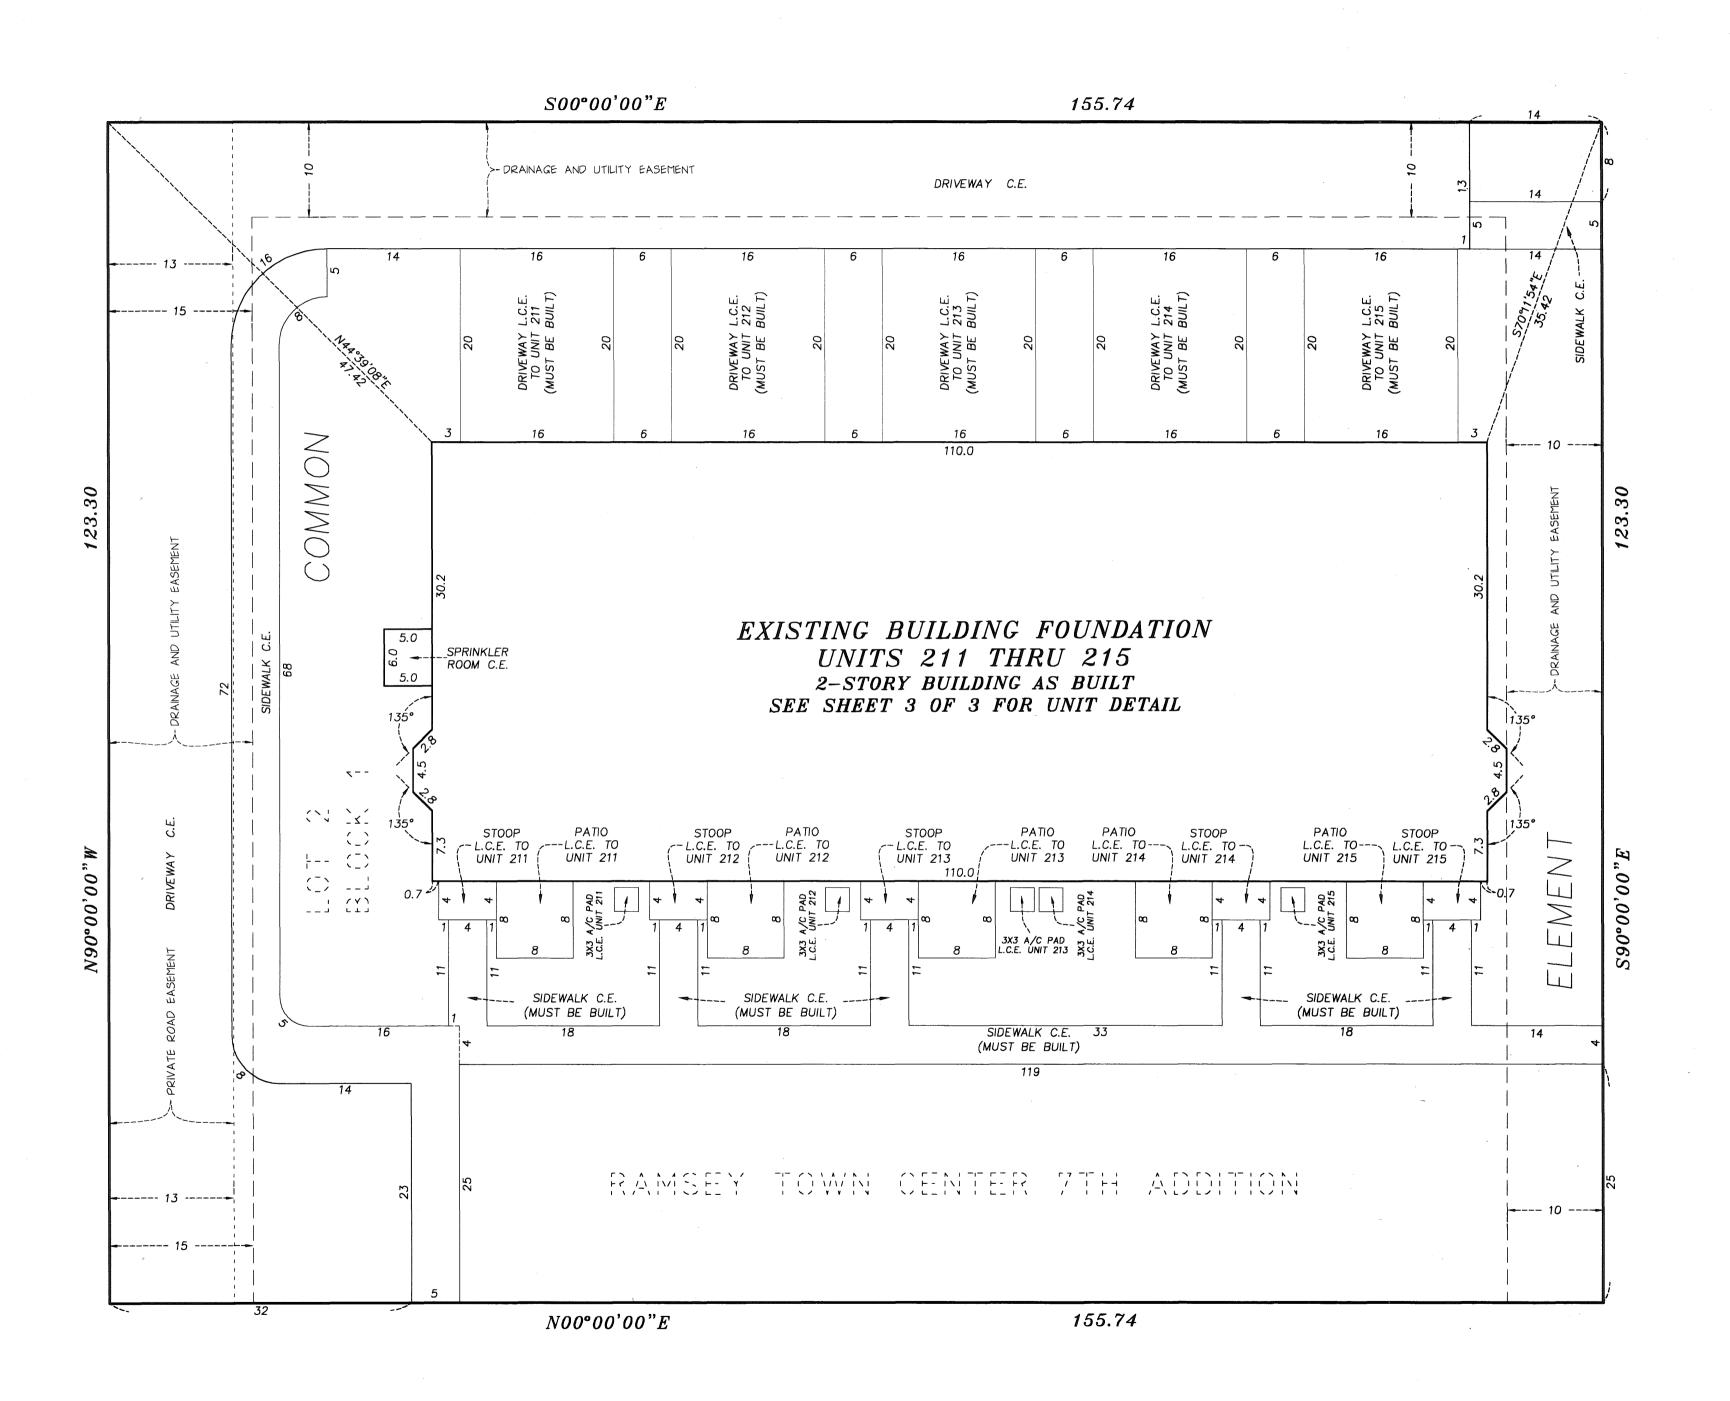

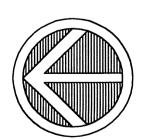

NORTH

SCALE: 1 INCH = 10 FEETSCALE IN FEET

NOTE: ALL PATIOS AND A/C PADS MUST BE BUILT.

C.E. - DENOTES COMMON ELEMENT

L.C.E. - DENOTES LIMITED COMMON ELEMENT

BENCH MARK: TOP NUT OF HYDRANT LOCATED ON THE EAST SIDE OF RHINESTONE ST. N.W. AND 226 FEET SOUTH OF THE CENTERLINE OF COUNTY ROAD 116 (BUNKER LAKE BLVD.)

ELEVATION = 871.89 FEET (NGVD 1929 DATUM)



UNIT DETAIL AS BUILT

COMMON INTEREST COMMUNITY NUMBER 211

A CONDOMINIUM

THE SYMPHONY AT TOWN CENTER SECOND SUPPLEMENTAL COMMON INTEREST COMMUNITY PLAT

+ C=893.3-1 4 ♦ VAULTED CEILING S C=895.27 S F=885.2 C=893.3 F=885.2 C=893.3 F=885.2 C=893.3 F=885.2 C=893.3 UPPER LEVEL UPPER LEVEL UPPER LEVEL UPPER LEVEL F=885.2 C=893.3 **UNIT 212 UNIT 213** UNIT 214 **UNIT 211** UPPER LEVEL OF**UNIT 215** STAIRS 5.9.0

VAULTED CEILING

C=893.3-7

OPEN TO BELOW F=874.4

C = 893.3

-- C=895.2-

VAULTED CEILING

C=893.3--


└- C=895.2-¬ ·

VAULTED CEILING

C=893.3--


UPPER LEVEL -

LOWER LEVEL -

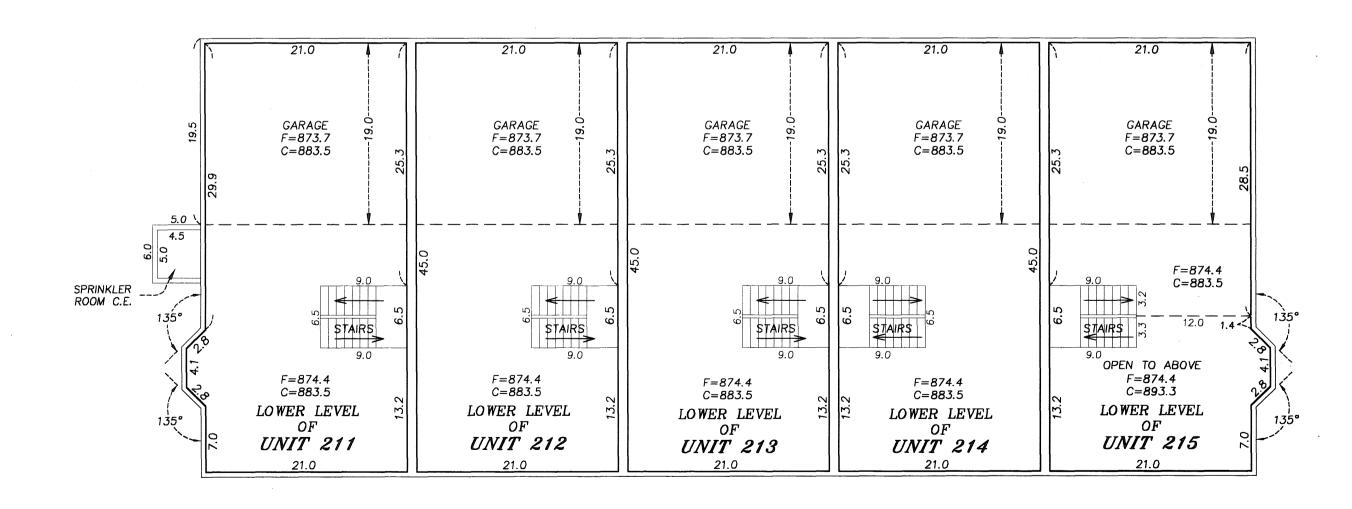

Book 9 of CIC Page 42 C.R. DOC. NO. 1989274.001

> CITY OF RAMSEY COUNTY OF ANOKA SEC. 28, TWP. 32, RGE. 25

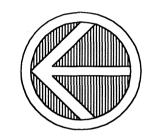

NORTH

C.E. - DENOTES COMMON ELEMENT

C - DENOTES CEILING ELEVATION

F - DENOTES FLOOR ELEVATION

_ DENOTES DIRECTION TO HIGHEST ELEVATION OF STAIRS

INTERIOR DIMENSIONS SHOWN ARE MEASURED TO THE UNFINISHED SURFACE OF THE WALLS, FLOORS AND CEILINGS.

ELEVATIONS ARE REFERENCED TO A BENCH MARK AS NOTED ON SHEET 2 OF 3 SHEETS AND ARE SHOWN IN FEET AND TENTHS OF A FOOT.

