







I HEREBY CERTIFY THAT THE CURRENT AND DELINQUENT TAXES ON THE LANDS DESCRIBED WITHIN ARE PAID AND THE TRANSFER IS ENTERED July 9 2007 MAUREEN J. DEVINE PROPERTY TAX ADMINISTRATOR

1994303.001 OFFICE OF COUNTY RECORDER STATE OF MINNESOTA, COUNTY OF ANOKA I hereby certify that the within instrument was filed in this office for record on the 9th July A.D., 2007 at 5:19 o'clock P.M., and was duly recorded in book 10 page 7 Maureen J. Devine County Recorder

COMMON INTEREST COMMUNITY NUMBER 211 A CONDOMINIUM THE SYMPHONY AT TOWN CENTER SIXTH SUPPLEMENTAL COMMON INTEREST COMMUNITY PLAT

This Sixth Supplemental Common Interest Community Plat is part of the Sixth Supplemental Declaration recorded as Document No. 1994303.001 on this 9th day of JULY 2007.

CITY OF RAMSEY COUNTY OF ANOKA SEC. 28, TWP. 32, RGE. 25

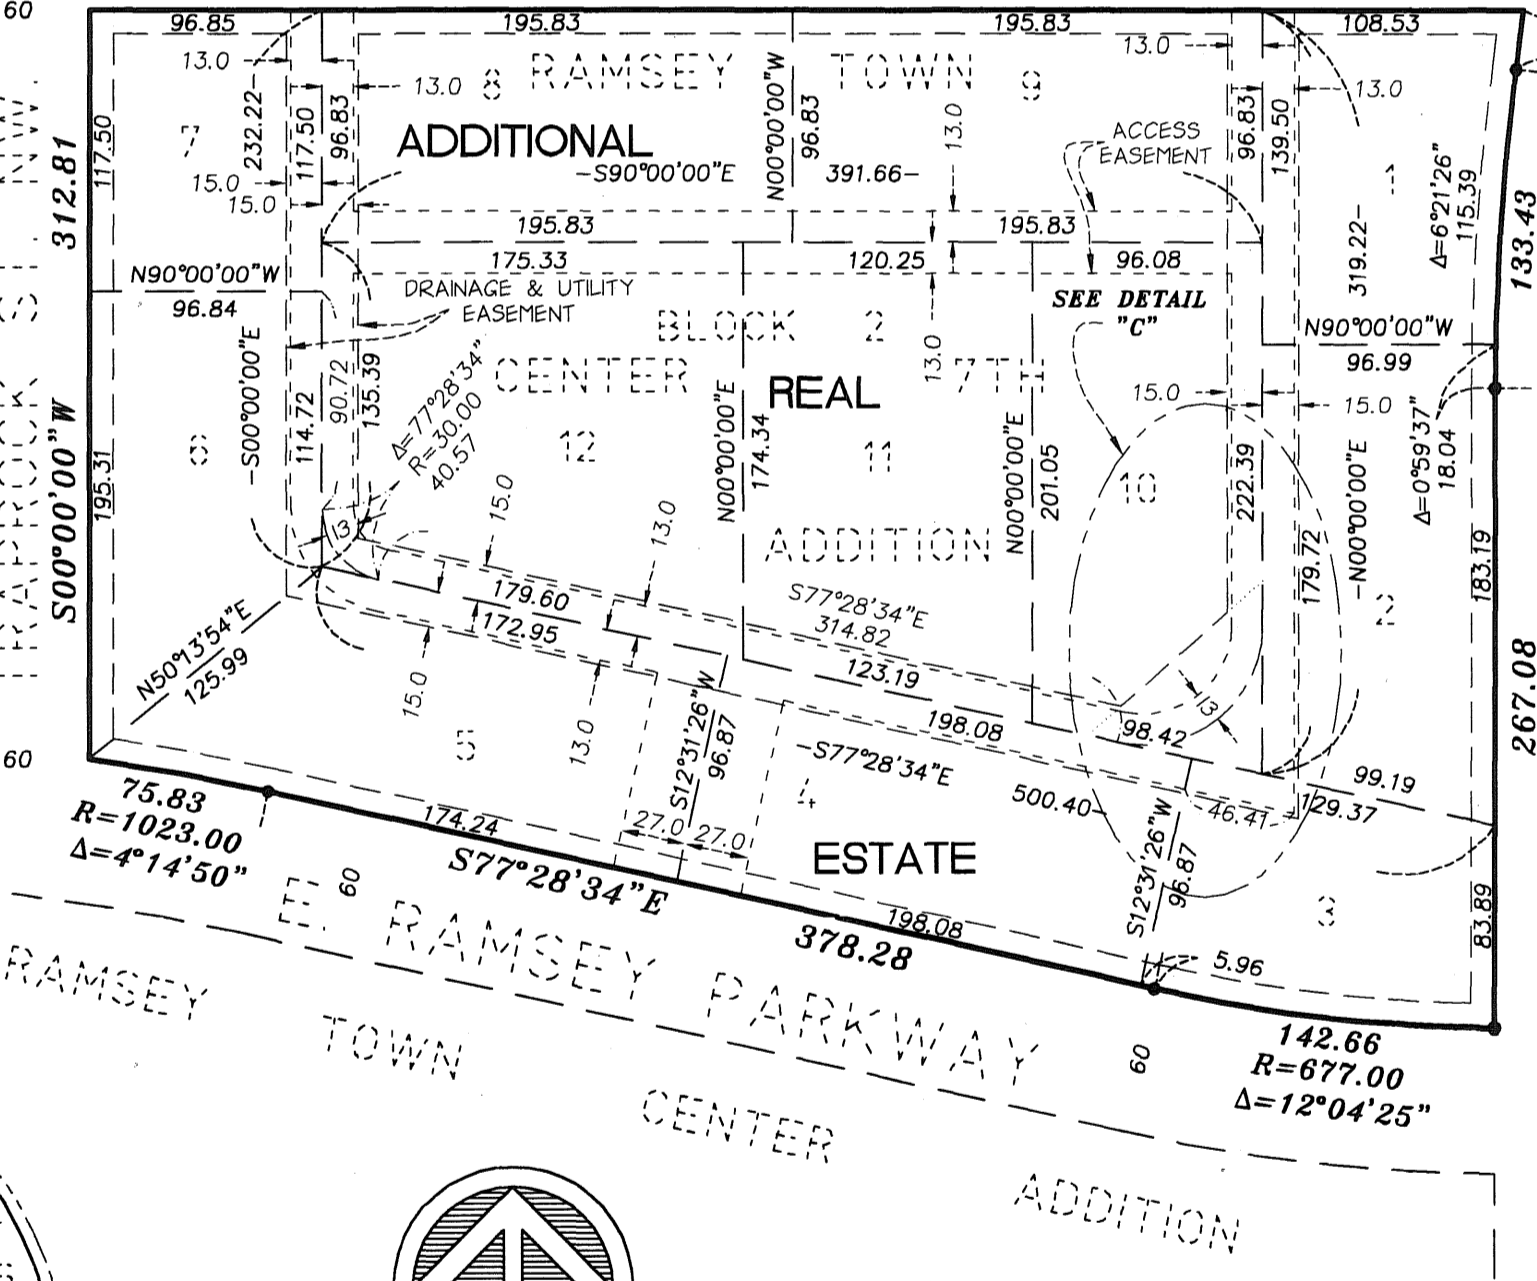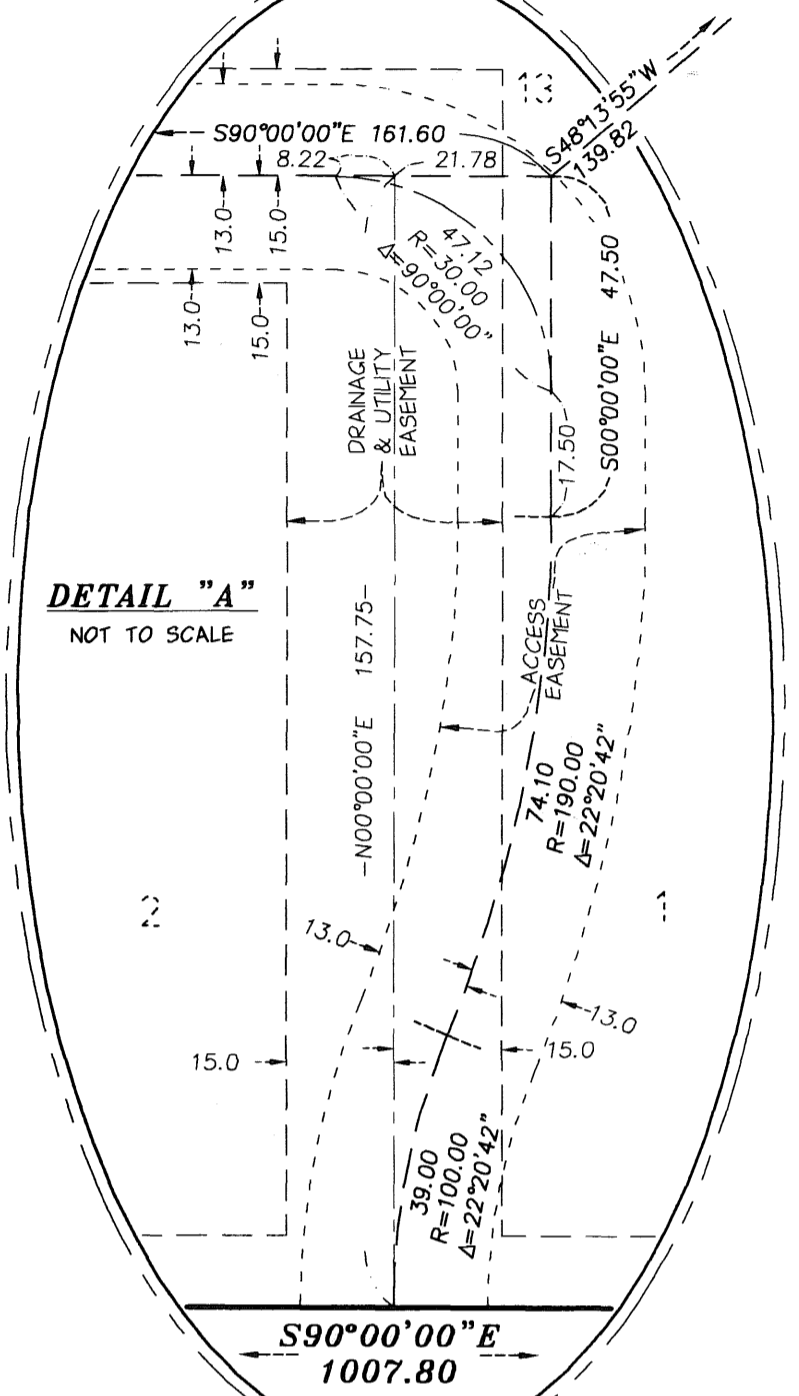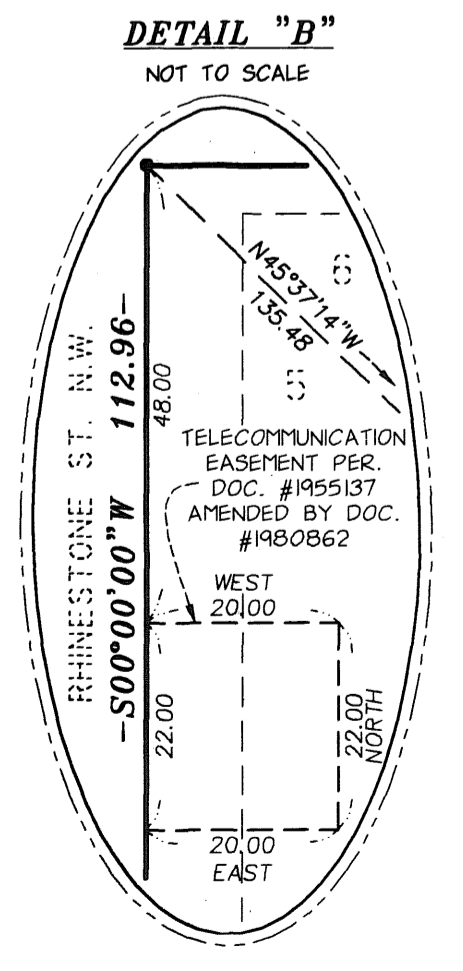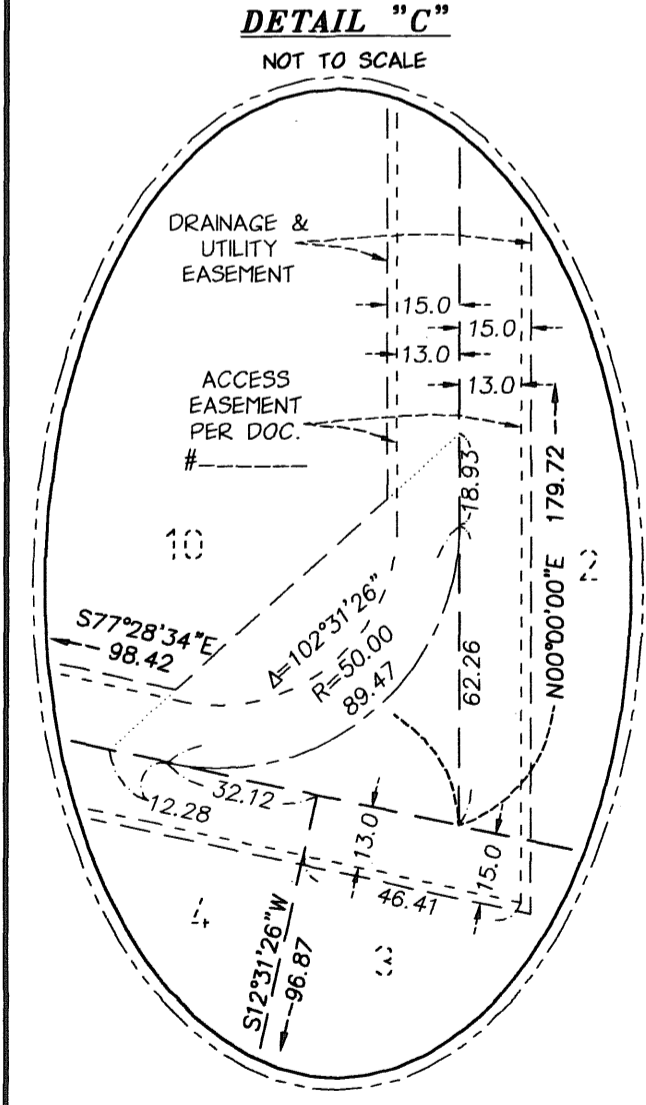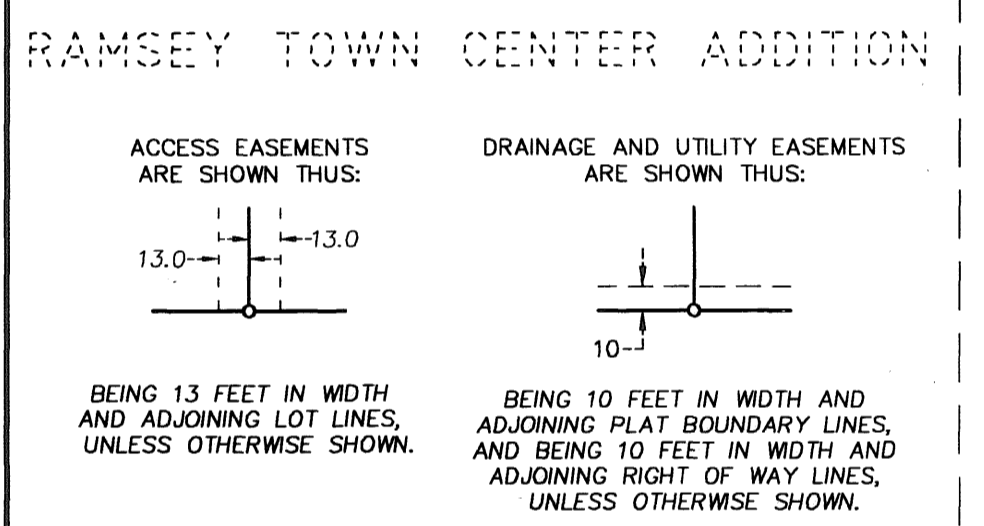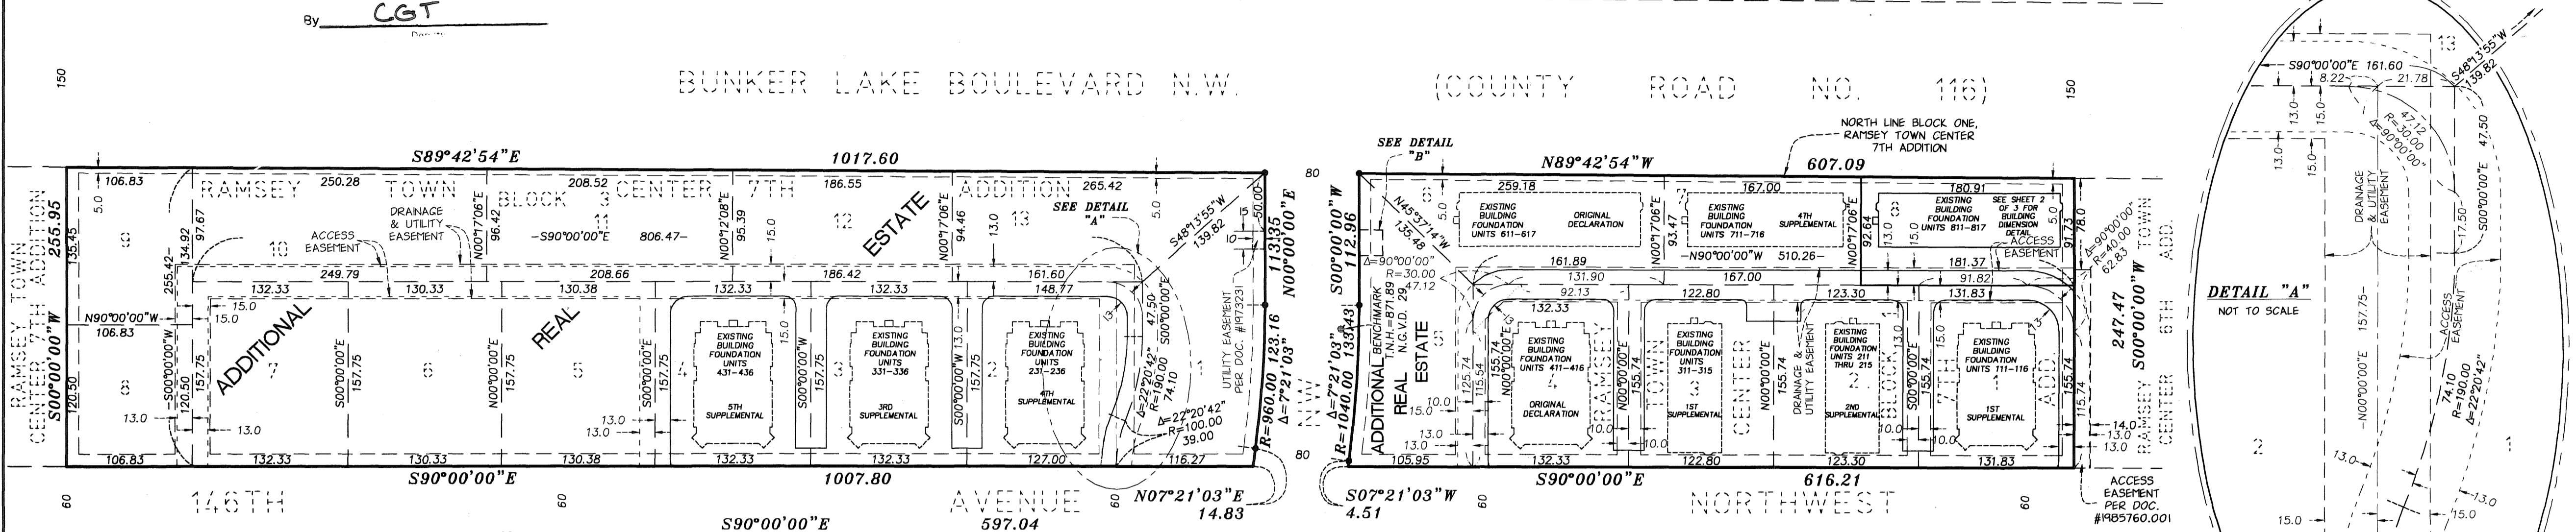


I, Jonathan M. Pittmann, do hereby certify that the work was undertaken by or reviewed and approved by me for this Sixth Supplemental Common Interest Community Plat of COMMON INTEREST COMMUNITY NUMBER 211, A CONDOMINIUM, THE SYMPHONY AT TOWN CENTER, being located upon: Lot 8, Block 1, RAMSEY TOWN CENTER 7TH ADDITION, according to the recorded plat thereof, Anoka County, Minnesota, and the Additional Real Estate described as follows: Lot 5, Block 1; Lots 1 through 12, inclusive, Block 2; Lots 1, 5, 6, 7, 8, 9, 10, 11, 12, and 13, Block 3, all in RAMSEY TOWN CENTER 7TH ADDITION, according to the recorded plat thereof, Anoka County, Minnesota, fully and accurately depicts all information required by Minnesota Statutes, Section 515B.2-110. Dated this 18th day of JUNE, 2007.

Jonathan M. Pittmann Jonathan M. Pittmann, Land Surveyor Minnesota License No. 44647

STATE OF MINNESOTA COUNTY OF HENNEPIN

The foregoing instrument was acknowledged before me this 18th day of June, 2007, by Jonathan M. Pittmann, a Licensed Land Surveyor.

Allan R. Holmsten Notary Public, Hennepin County, Minnesota My Commission Expires January 31, 2010

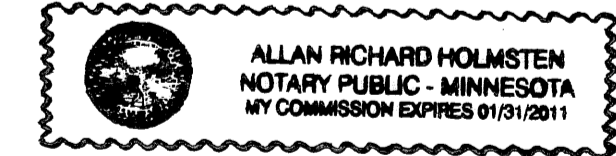



I, Stephen M. Johnston, pursuant to Minnesota Statutes, Section 515B.2-101(c), do hereby certify that the structural components of the structures containing the units and the mechanical systems serving more than one unit, but not the units, are substantially completed. Dated this 18th day of June, 2007.

Stephen M. Johnston Licensed Professional Engineer Minnesota License No. 18914

STATE OF MINNESOTA COUNTY OF HENNEPIN

The foregoing instrument was acknowledged before me this 18th day of June, 2007, by Stephen M. Johnston, a Licensed Professional Engineer.

Allan R. Holmsten Notary Public, Hennepin County, Minnesota My Commission Expires January 31, 2010

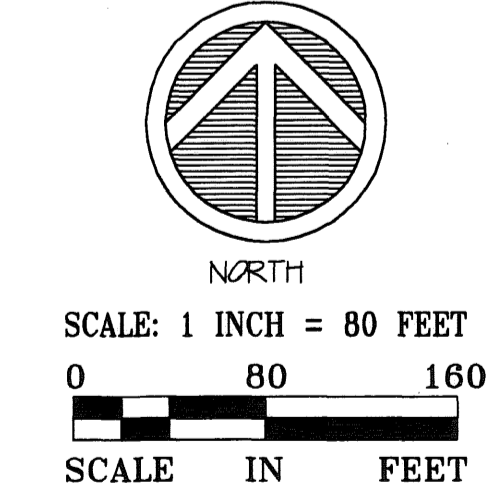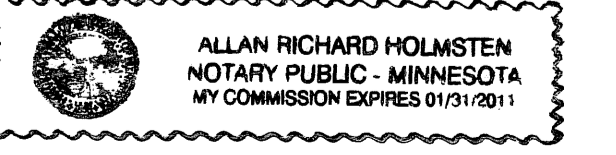

FOR THE PURPOSES OF THIS PLAT THE NORTH LINE OF BLOCK ONE, RAMSEY TOWN CENTER 7TH ADDITION IS ASSUMED TO BEAR N89°42'54\"/>

Pursuant to Minnesota Statutes, Chapter 389.09, Subdivision 2, this Common Interest Community Plat has been reviewed and is approved this 9th day of JULY, 2007.

Larry Holm, P.L.S. Anoka County Surveyor

\$56.00

SITE PLAN AND BUILDING DIMENSION DETAIL

COMMON INTEREST COMMUNITY NUMBER 211



A CONDOMINIUM

THE SYMPHONY AT TOWN CENTER

SIXTH SUPPLEMENTAL COMMON INTEREST COMMUNITY PLAT


C.R. DOC. NO.

CITY OF RAMSEY
COUNTY OF ANOKA
SEC. 28, TWP. 32, RGE. 25

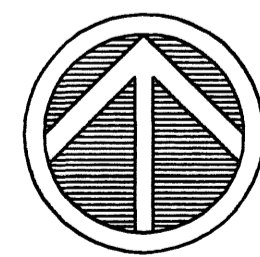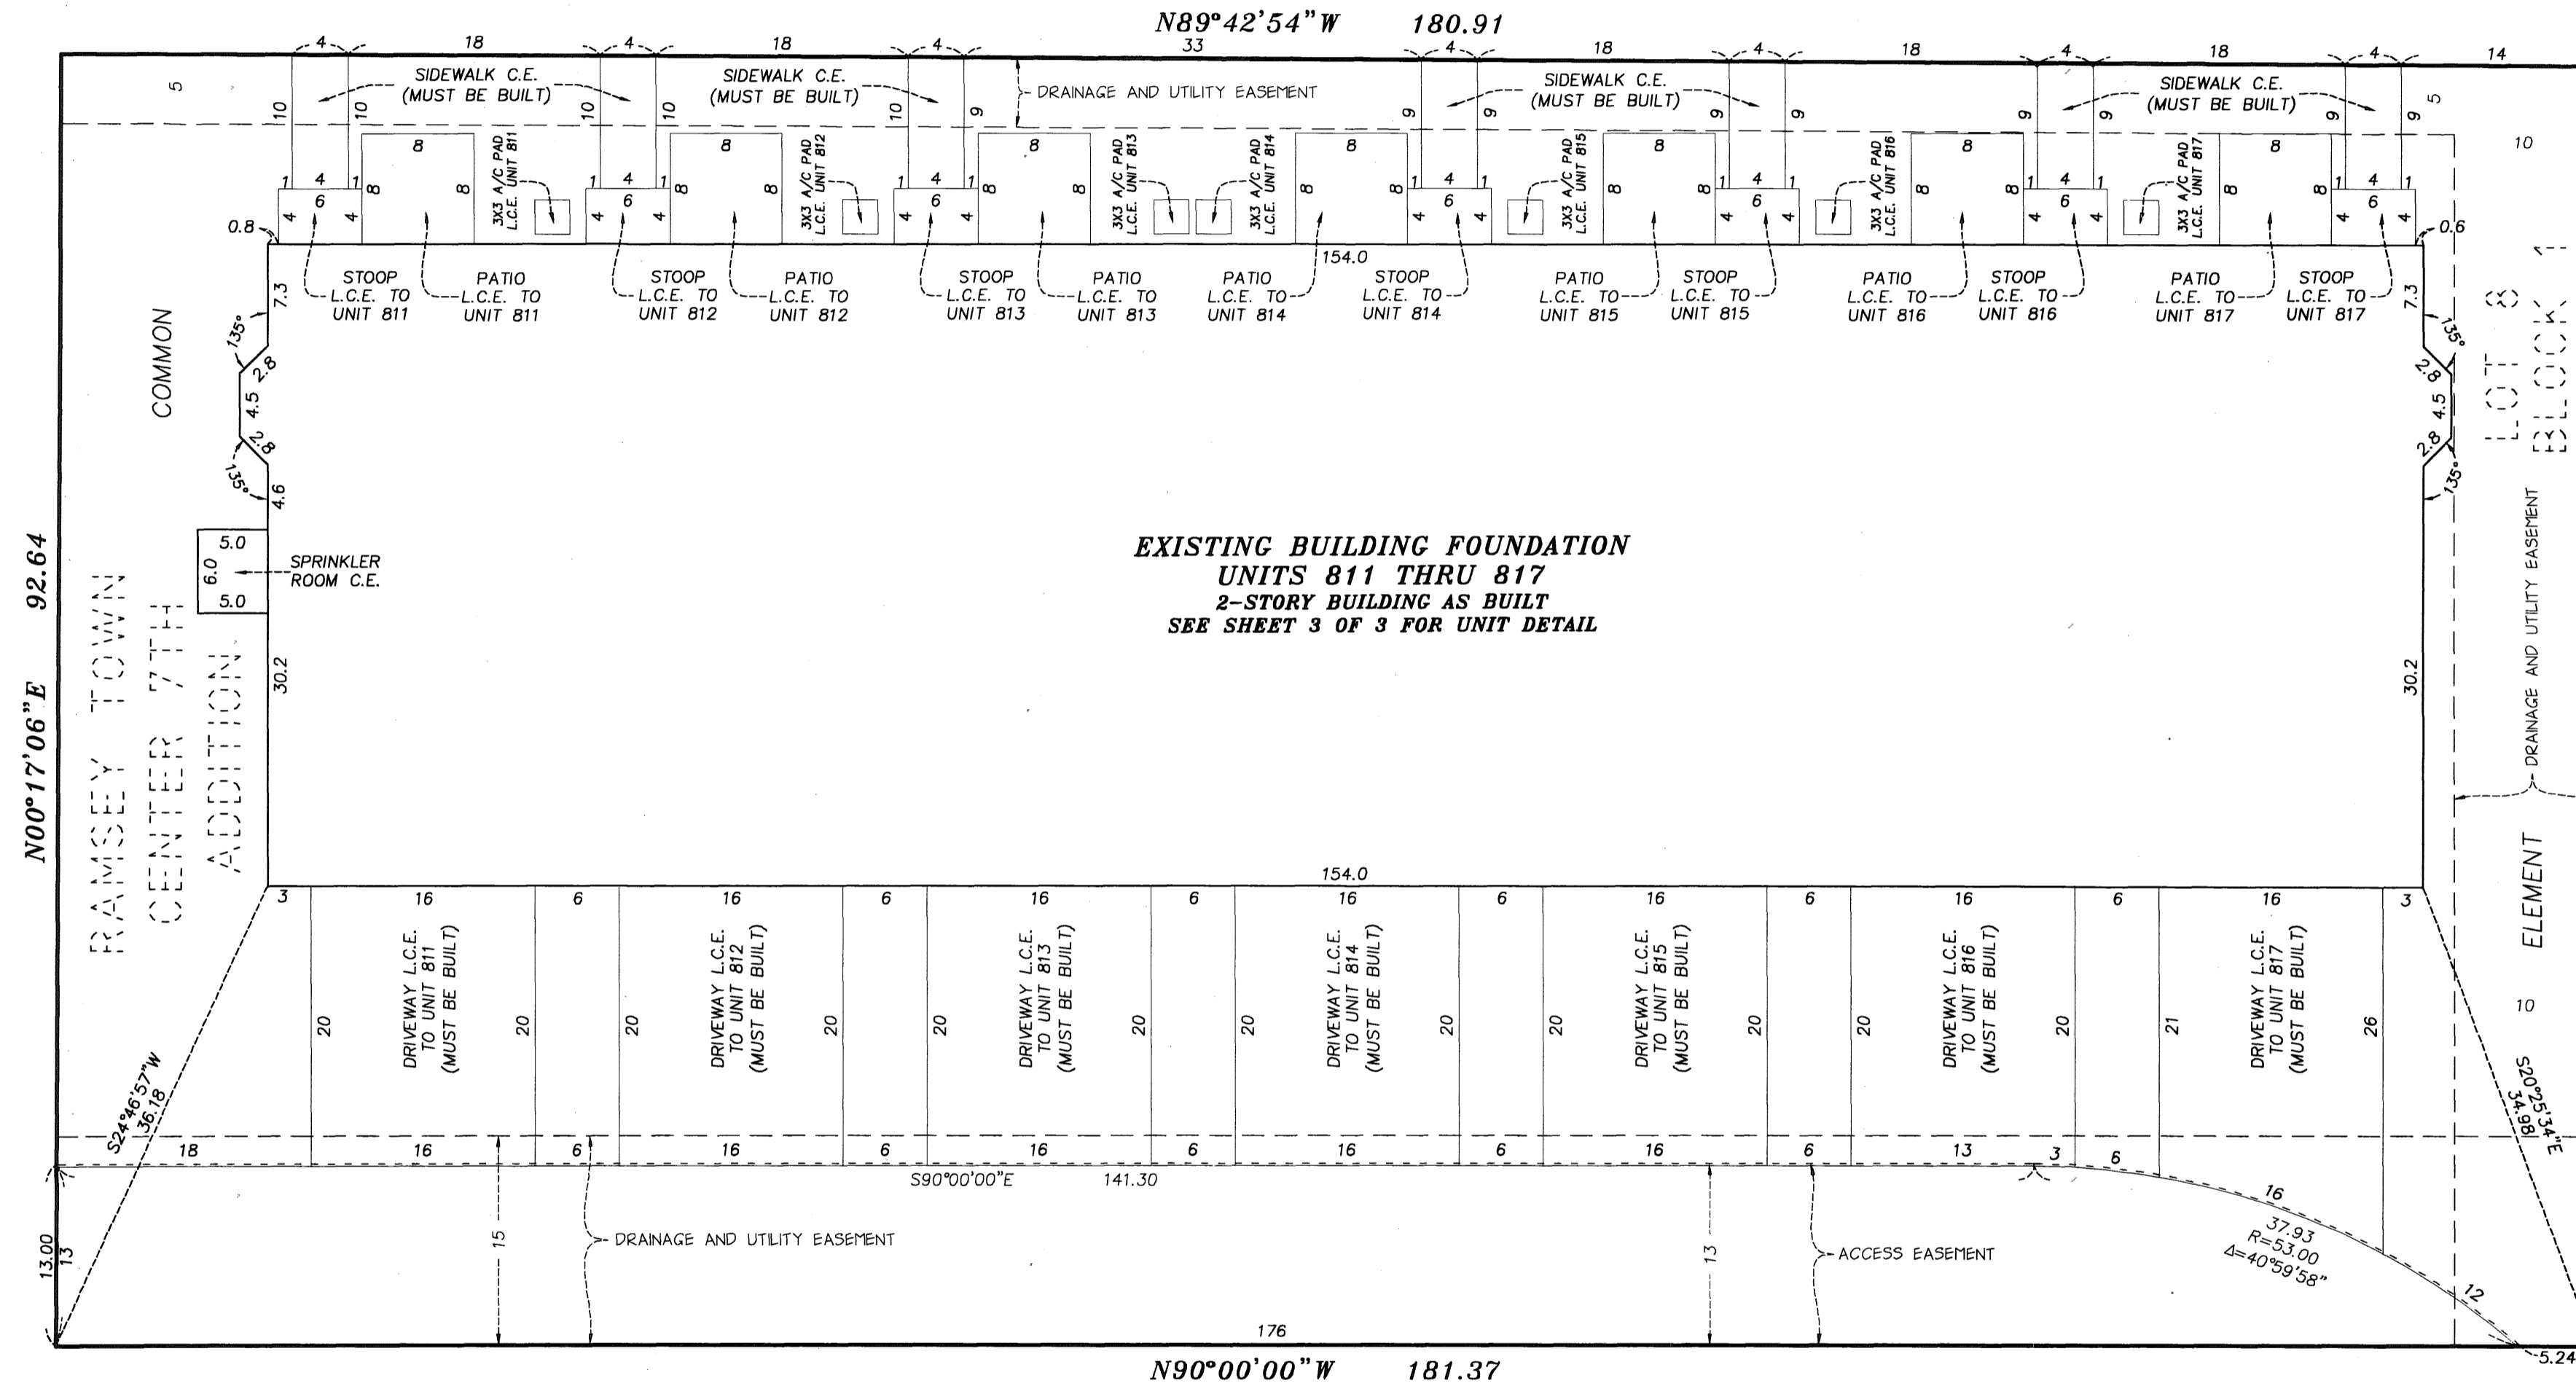

NORTH

SCALE: 1 INCH = 10 FEET

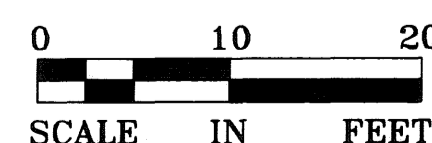

NOTE: ALL PATIOS MUST BE BUILT.
 C.E. - DENOTES COMMON ELEMENT
 L.C.E. - DENOTES LIMITED COMMON ELEMENT

BENCH MARK:

TOP NUT OF HYDRANT LOCATED ON THE EAST SIDE OF
 RHINESTONE ST. N.W. AND 226 FEET SOUTH OF THE
 CENTERLINE OF COUNTY ROAD 116 (BUNKER LAKE BLVD.)
 ELEVATION = 871.89 FEET (NGVD 1929 DATUM)



UNIT DETAIL
AS BUILT

COMMON INTEREST COMMUNITY NUMBER 211

A CONDOMINIUM



THE SYMPHONY AT TOWN CENTER

SIXTH SUPPLEMENTAL COMMON INTEREST COMMUNITY PLAT

C.R. DOC. NO.


CITY OF RAMSEY
COUNTY OF ANOKA
SEC. 28, TWP. 32, RGE. 25

UPPER LEVEL -

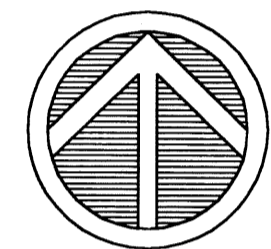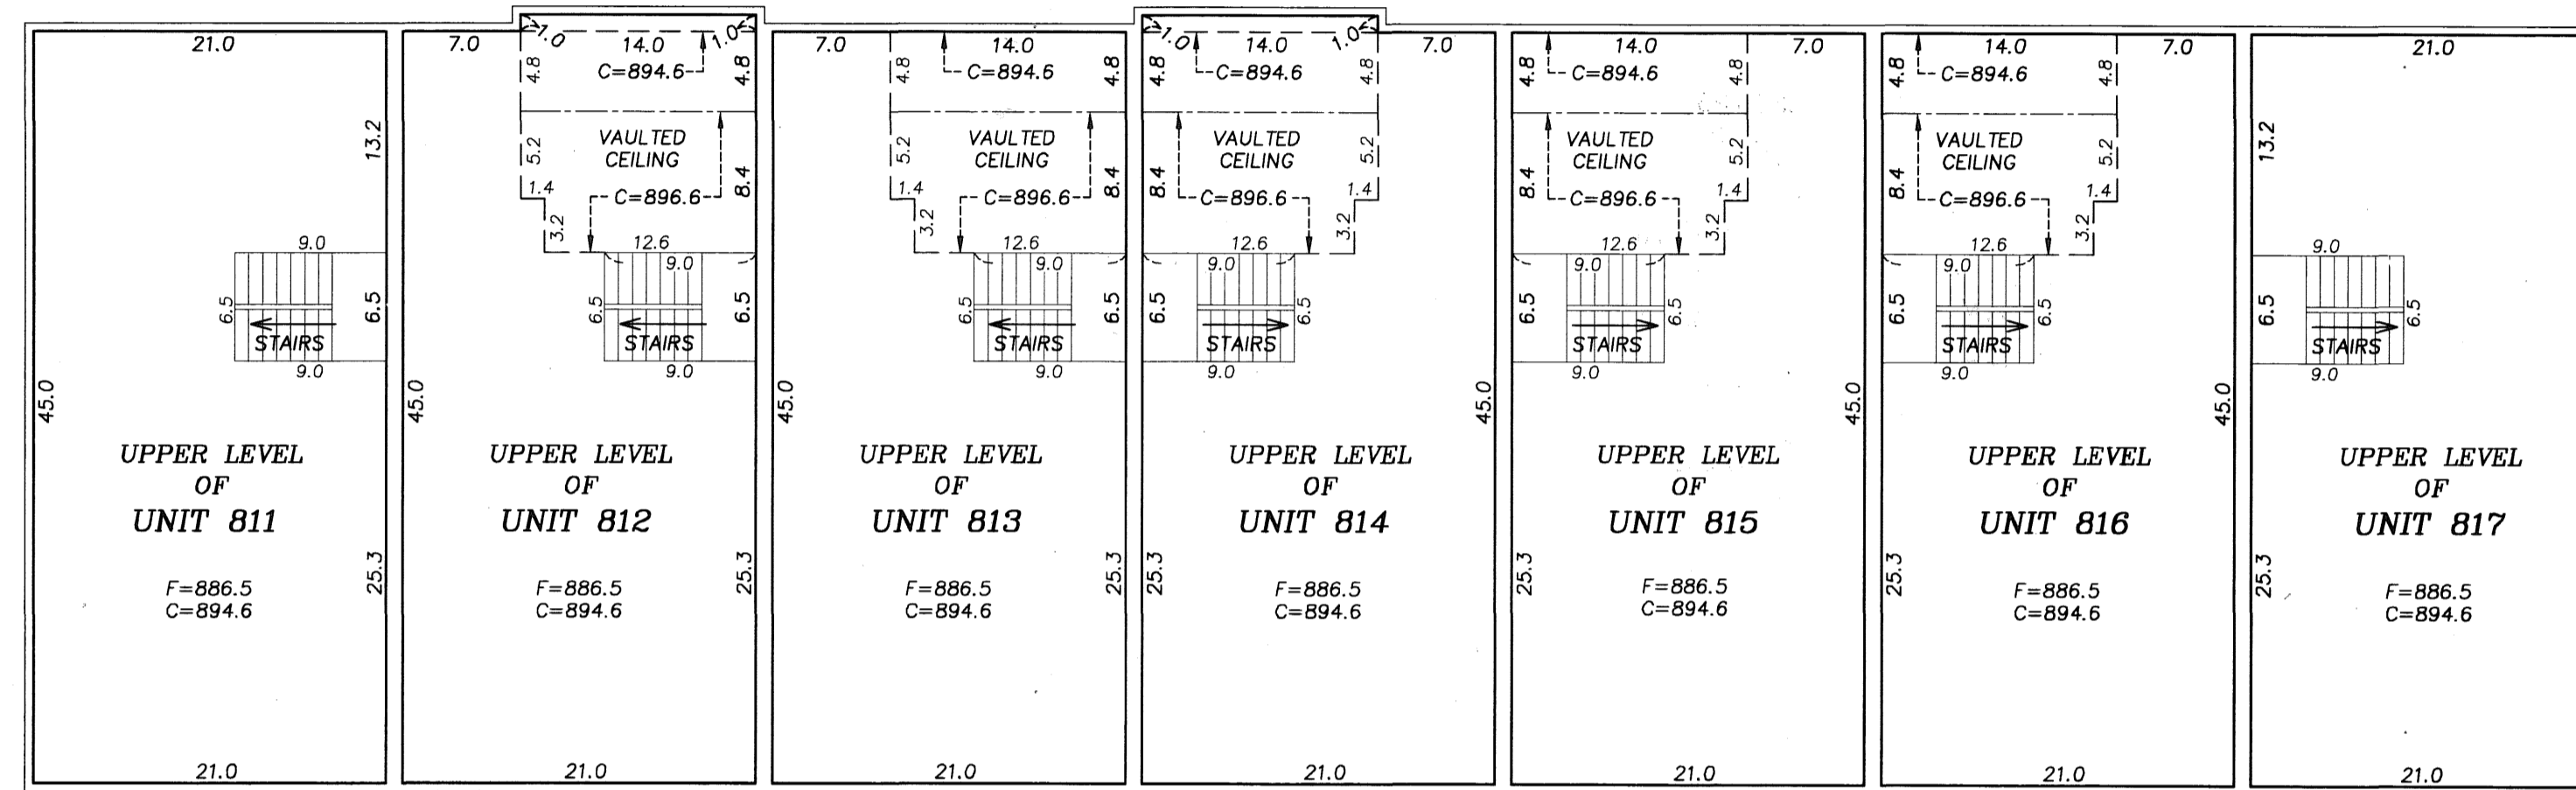

NORTH

SCALE: 1 INCH = 10 FEET

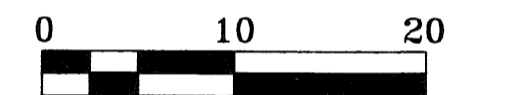

SCALE IN FEET

- C.E. - DENOTES COMMON ELEMENT
- C - DENOTES CEILING ELEVATION
- F - DENOTES FLOOR ELEVATION
- - DENOTES DIRECTION TO HIGHER ELEVATION

INTERIOR DIMENSIONS SHOWN ARE MEASURED TO THE UNFINISHED SURFACE OF THE WALLS, FLOORS AND CEILINGS.

ELEVATIONS ARE REFERENCED TO A BENCH MARK AS NOTED ON SHEET 2 OF 3 SHEETS AND ARE SHOWN IN FEET AND TENTHS OF A FOOT.

LOWER LEVEL -

