This Seventh Supplemental CIC plat is part CIC NUMBER 26 of the Seventh Amendment to the Declaration recorded as Document No. <u>1366996</u> l, Robert B. Sikich, hereby certify that the work was undertaken by or reviewed and approved by me for this Seventh Supplemental CIC Plat of CIC Number 26, CARLA DE 3RD TOWNHOMES being located upon on this although of August, 1998. CARLA DE 3RD TOWNHOMES Lot 2, Block 1, CARLA DE THIRD ADDITION, Anoka County, Minnesota SEVENTH SUPPLEMENTAL CONDOMINIUM PLAT and the additional real estate is located upon the following described property designated as: SITE PLAN Lot 1, Block 1, CARLA DE THIRD ADDITION, Anoka County, Minnesota Denotes found iron monument Fully and accurately depicts all information required by Minnesota Statutes, Section 515 B. 2-110. Dated this **20TH**day of August, 1998. The west line of Outlot A, Carla De Third Addition has an assumed bearing of S00°16'46"W Minnesota License No. 14891 STATE OF MINNESOTA All drainage and utility easements shown were COUNTY OF ANOKA dedicated in the plat of Carla De Third Addition The forgoing certificate was acknowledged before me this 20th day of 1998, by Robert B. Sikich, a Licensed Professional Land Surveyor. Notary Public, Chisago County, Minnesota My Commission Expires January 31, 2000 BENCH MARK Top nut of the hydrant on the east side of GRAPHIC SCALE I, Leon P. Opatz , pursuant to Minnesota Statutes, Section 515B.2-101(c), do Quince Street and South of 107th Avenue NW hereby certify that all the units and all structural components and mechanical systems of all buildings containing or comprising any units hereby created, are substantially completed Elevation = 871.87 feet (NGVD 1929) Dated this 20 day of AUGUST STATE OF MINNESOTA COUNTY OF ANOKA The forgoing certificate was acknowledged before me this 20th day of August S84°57'36"W 93.50 1998, by Leon P. Opatz, a Licensed Professional Engineer. Charge R. Schmost SHT COMMISSION SITTES BALLARY IL SESS Notary Public, ________ _____ County, Minnesota My commission Expires January 31, 2000 Checked and approved this **27**thday of **AU605**, 1998. S89*39'53"E **257.18** --- 139.99 1LITY EASEMENT 96.97 ELENGUENT TAXES ON THE LANDS DESCRESSED UNITS 1 - 4 117.29 **675.62** S89**'**47'21**"**E -30 J UNITS 5&6 107TH AVENUE V 1/ V /

THIN ARE PAID AND THE TRANSFER IS ENTERED Que 27 1
EDWARD M. TRESKA S. Culver DEPUTY PROPERTY TAX ADMINISTRATOR

* * * * * PIONEER

engineering

2422 Enterprise Drive Mendota Heights, MN 55120 (612) 681-1914 FAX: 681-9488 LAND SURVEYORS . CIVIL ENGINEERS

(612) 783–1880 FAX: 783–1883

3 of CIC

1366996

Edward M. Treska

GKE

282.46

11.75 11.92

465.13 S89'47'21"E

L.C.E. UNIT 31

MAIN ENTRY

CONCRETE STOOP

(MUST BE BUILT)

(UNITS 31 THRU 33) ONE STORY BUILDING AS-BUILT 2.5 x 2.5 Air Conditioner Pads (MUST BE BUILT) UNIT 32 UNIT 31 UNIT 33 CEILING ELEV. — = 875.8 ft. 12.0 GARAGE S € GARAGE GARAGE

L.C.E. UNIT 32-

MAIN ENTRY

CONCRÉTE STOOP

(MUST BE BUILT)

L.C.E. UNIT 33— MAIN ENTRY

CONCRETE STOOP

(MUST BE BUILT)

CIC NUMBER 26 CARLA DE 3RD TOWNHOMES

SEVENTH SUPPLEMENTAL CONDOMINIUM PLAT

All privacy walls are Common Elements and must be built


Interior Dimensions shown are measured to the unfinished surface of the walls, floors and ceilings

L.C.E. Denotes Limited Common Element

Elevations are referred to a benchmark as noted on site plan and are shown in feet and tenths of a foot

All garage floor elevations = 867.0 feet
All units main level floor elevations = 867.8 feet
All units main level ceiling elevations vary from 875.8 feet to 877.8 feet



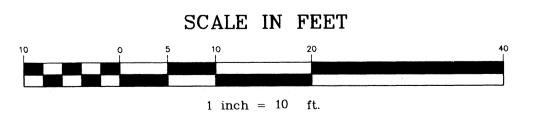



LAND SURVEYORS • CIVIL ENGINEERS

LAND PLANNERS • LANDSCAPE ARCHITECTS