CIC NUMBER 26

CARLA DE 3RD TOWNHOMES

EIGHTH SUPPLEMENTAL CONDOMINIUM PLAT

SITE PLAN

 Denotes found iron monument The west line of Outlot A, Carla De Third Addition has an assumed bearing of S00°16'46"W

> All drainage and utility easements shown were dedicated in the plat of Carla De Third Addition

> > BENCH MARK

This Eighth Supplemental CIC plat is part

of the Eighth Amendment to the Declaration

recorded as Document No. <u>1375280</u> on this <u>2nd</u> day of <u>October</u>, 1998.

Top nut of the hydrant on the east side of Quince Street and South of 107th Avenue NW

GRAPHIC SCALE Elevation = 871.87 feet (NGVD 1929) S84*57'36"W DRAINAGE & UTILITY 12 344.30 UNITS 1 - 4 UNITS 5&6 AVENUE V 1 / V 1 282.46 **465.13** S89'47'21"E

I, Robert B. Sikich, hereby certify that the work was undertaken by or reviewed and approved by me for this Eighth Supplemental CIC Plat of CIC Number 26, CARLA DE 3RD TOWNHOMES being located upon Lot 1, Block 1, CARLA DE THIRD ADDITION, Anoka County, Minnesota Fully and accurately depicts all information required by Minnesota Statutes, Section 515 B. 2-110. Dated this 23 day of 1998. STATE OF MINNESOTA COUNTY OF ANOKA The forgoing certificate was acknowledged before me this 2 day of SEPTEMISEE 1998, by Robert B. Sikich, a Licensed Professional Land Surveyor RD W. ROGERS
UNIVESOTA
URNE COULTY
J. EXP. 01/31/2000

Notary Public, Sherburne County, Minnesota
My Commission Expires January 31, 2000

I, Leon P. Opatz, pursuant to Minnesota Statutes, Section 515B.2—101(c), do hereby certify that all the units and all structural components and mechanical systems of all buildings containing or comprising any units hereby created, are substantially completed

Dated this 28 day of SEPTEMBEK

icensed Professional Engineer Minnesota License No. 21810

STATE OF MINNESOTA COUNTY OF ANOKA

* * * * * PIONEER


engineering

The forgoing certificate was acknowledged before me this 25 day of SEPTEMBER. 1998, by Leon P. Opatz, a Licensed Professional Engineer

Notary Public, Sherburne County, Minnesota My commission Expires January 31, 2000

LAND SURVEYORS . CIVIL ENGINEERS

Checked and approved this $2^{\frac{NP}{2}}$ day of $\frac{O_{CTOBER}}{}$, 1998.

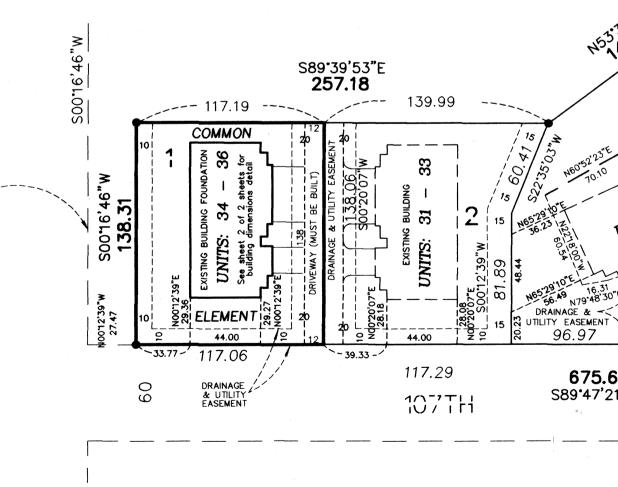


2422 Enterprise Drive Mendota Heights, MN 55120 (612) 681-1914 FAX: 681-9488 625 Highway 10 N.E. Blaine, MN 55434 (612) 783–1880 FAX: 783–1883

1375 280 OFFICE OF COUNTY SECRETARY STATE OF MINNESOTA, COURSE OF AMERICA I hereby certify that the within wisk w on the 2nd Oct AD 1998
2:50 o'clock P. M., and was duly recorded in book 3 CIC page 40

675.62

S89'47'21"E

ONE STORY BUILDING AS-BUILT (UNITS 34 THRU 36)

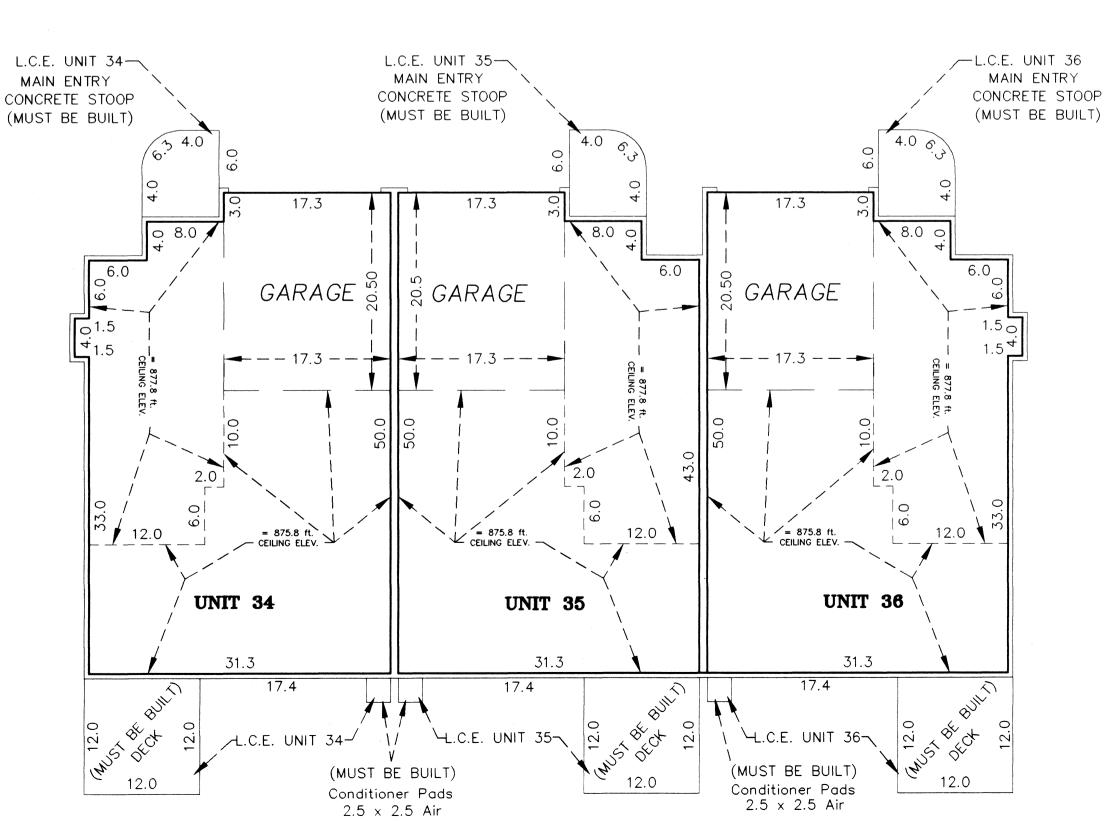

CIC NUMBER 26 CARLA DE 3RD TOWNHOMES

EIGHTH SUPPLEMENTAL CONDOMINIUM PLAT

All privacy walls are Common Elements and must be built


Interior Dimensions shown are measured to the unfinished surface of the walls, floors and ceilings

L.C.E. Denotes Limited Common Element

Elevations are referred to a benchmark as noted on site plan and are shown in feet and tenths of a foot

All garage floor elevations = 867.0 feet
All units main level floor elevations = 867.8 feet
All units main level ceiling elevations vary from 875.8 feet to 877.8 feet



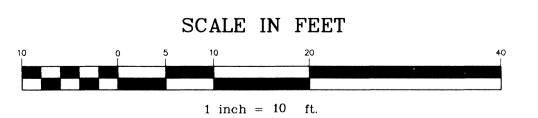

Cot a secion



LAND SURVEYORS • CIVIL ENGINEERS

LAND PLANNERS • LANDSCAPE ARCHITECTS