


# CIC NUMBER 34 APOLLO MEADOWS TOWNHOMES COMMON INTEREST COMMUNITY FIRST SUPPLEMENTAL CONDOMINIUM PLAT

SITE PLAN (AS BUILT)

SUNSET OAKS

This First Supplemental CIC plat is part of the Declaration recorded as Document No. 1333165 on this 8<sup>th</sup> day of APRIL, 1998.

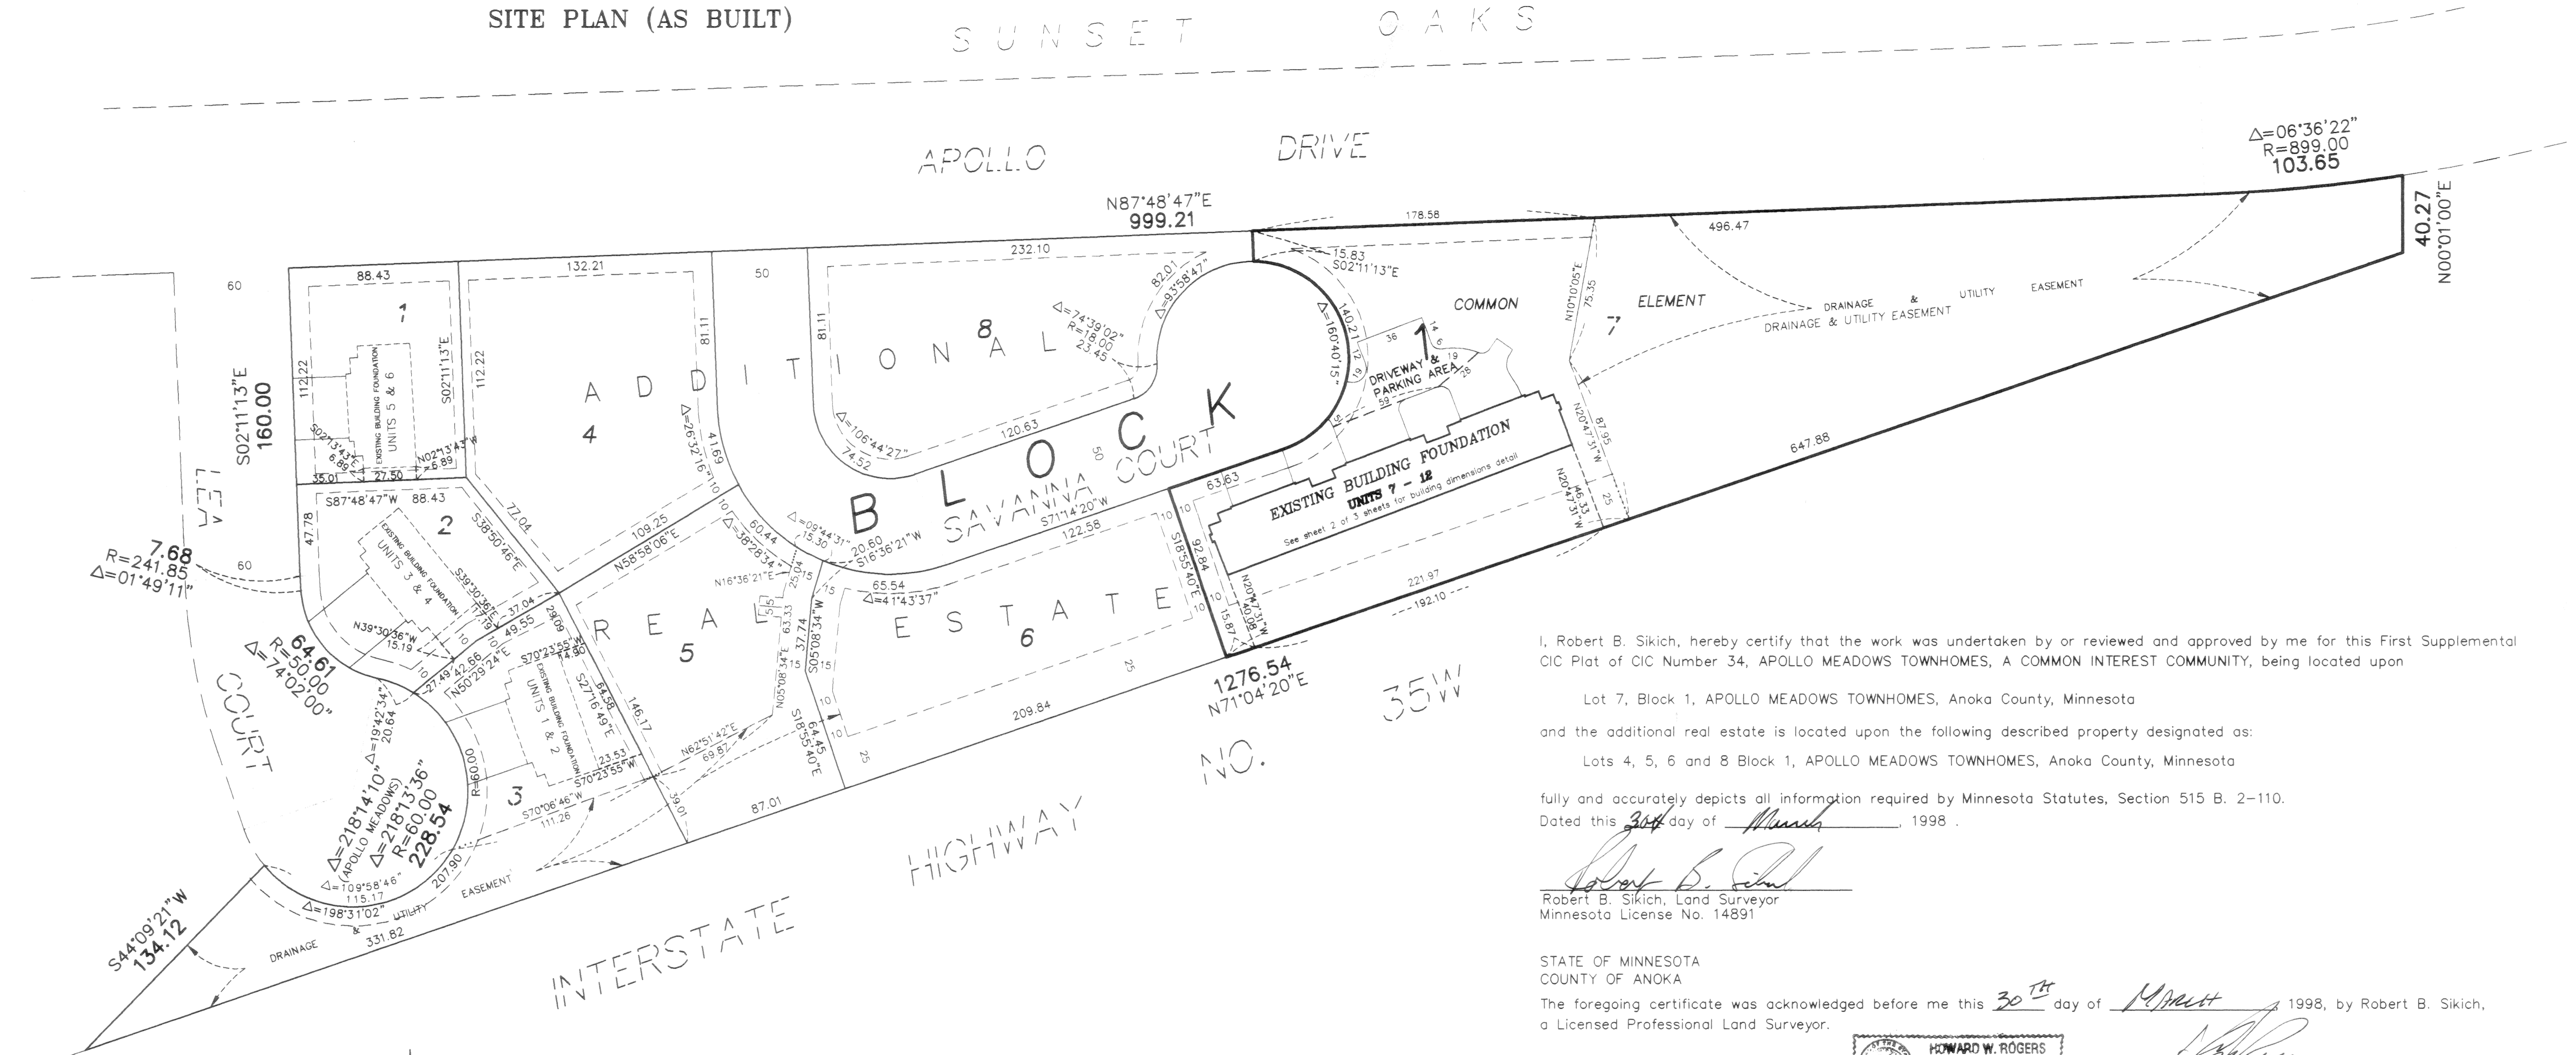

I, Robert B. Sikich, hereby certify that the work was undertaken by or reviewed and approved by me for this First Supplemental CIC Plat of CIC Number 34, APOLLO MEADOWS TOWNHOMES, A COMMON INTEREST COMMUNITY, being located upon


Lot 7, Block 1, APOLLO MEADOWS TOWNHOMES, Anoka County, Minnesota  
and the additional real estate is located upon the following described property designated as:  
Lots 4, 5, 6 and 8 Block 1, APOLLO MEADOWS TOWNHOMES, Anoka County, Minnesota

fully and accurately depicts all information required by Minnesota Statutes, Section 515 B. 2-110.  
Dated this 30<sup>th</sup> day of March, 1998.

*Robert B. Sikich*  
Robert B. Sikich, Land Surveyor  
Minnesota License No. 14891

STATE OF MINNESOTA  
COUNTY OF ANOKA

The foregoing certificate was acknowledged before me this 30<sup>th</sup> day of March, 1998, by Robert B. Sikich, a Licensed Professional Land Surveyor.

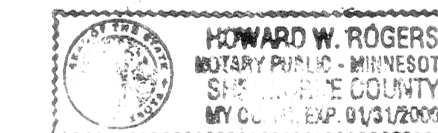


*Howard W. Rogers*  
Notary Public, Sherburne County, Minnesota  
My Commission Expires Jan. 31, 2000

I, Robert B. Sikich, pursuant to Minnesota Statutes, Section 515B.2-101(c), do hereby certify that all the units and all structural components and mechanical systems of all buildings containing or comprising any units hereby created, are substantially completed.

Dated this 2nd day of April, 1998.

STATE OF MINNESOTA  
COUNTY OF Washington

The foregoing certificate was acknowledged before me this 2nd day of April, 1998, by Robert B. Sikich, a Registered Professional Architect.

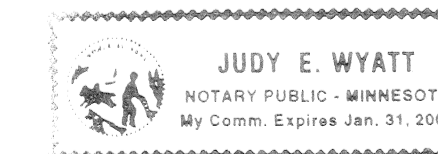

*Judy E. Wyatt*  
Notary Public, Washington County, Minnesota  
My Commission Expires Jan. 31, 2000

Checked and approved this 8<sup>th</sup> day of APRIL, 1998.

*Larry D. Hain* deputy  
Anoka County Surveyor

1333165.0  
OFFICE OF COUNTY RECORDER  
STATE OF MINNESOTA, COUNTY OF ANOKA  
I hereby certify that the within instrument was filed in this office for record on the APR 8 A.D., 1998 at 10 o'clock A. M., and was duly recorded in book 323165 page 25.  
By Edward M. Treska  
County Recorder  
DKD  
Deputy

I HEREBY CERTIFY THAT THE CORRECT AND DELINQUENT TAXES ON THE LAND DESCRIBED WITHIN ARE PAID AND THE TRANSFER IS  
ENTERED April 8 1998  
EDWARD M. TRESKA  
PROPERTY TAX ADMINISTRATOR  
BY Jerry S. Remington  
DEPUTY PROPERTY TAX ADMINISTRATOR



### BENCH MARK

Top nut of the hydrant at the southerly end of Lea Court.  
Elevation = 909.51 feet (NGVD 1929)

• Denotes iron monument found.

All drainage and utility easements shown were dedicated in the plat of APOLLO MEADOWS TOWNHOMES.

For the purpose of this plat, the north line of Outlot E, Apollo Meadows has an assumed bearing of N87°48'47"E.

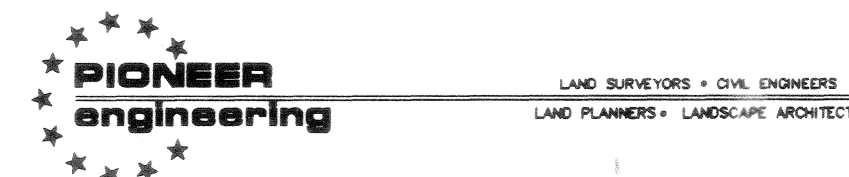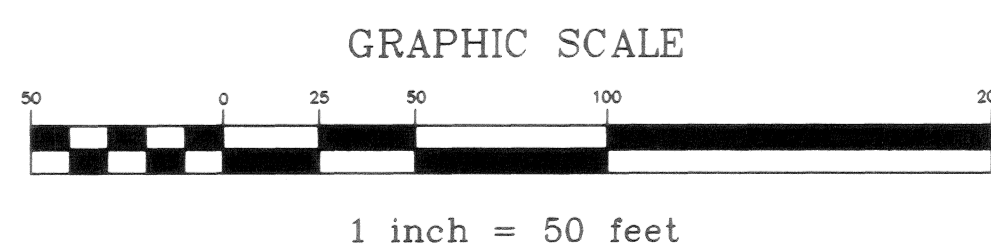

2422 Enterprise Drive  
Mendota Heights, MN 55120  
(612) 681-1914 FAX: 681-9488  
625 Highway 10 N.E.  
Blaine, MN 55434  
(612) 783-1880 FAX: 783-1883


Receipt No. 78037063 \$ 275.00

# CIC NUMBER 34


## APOLLO MEADOWS TOWNHOMES COMMON INTEREST COMMUNITY

### FIRST SUPPLEMENTAL CONDOMINIUM PLAT



COMMON

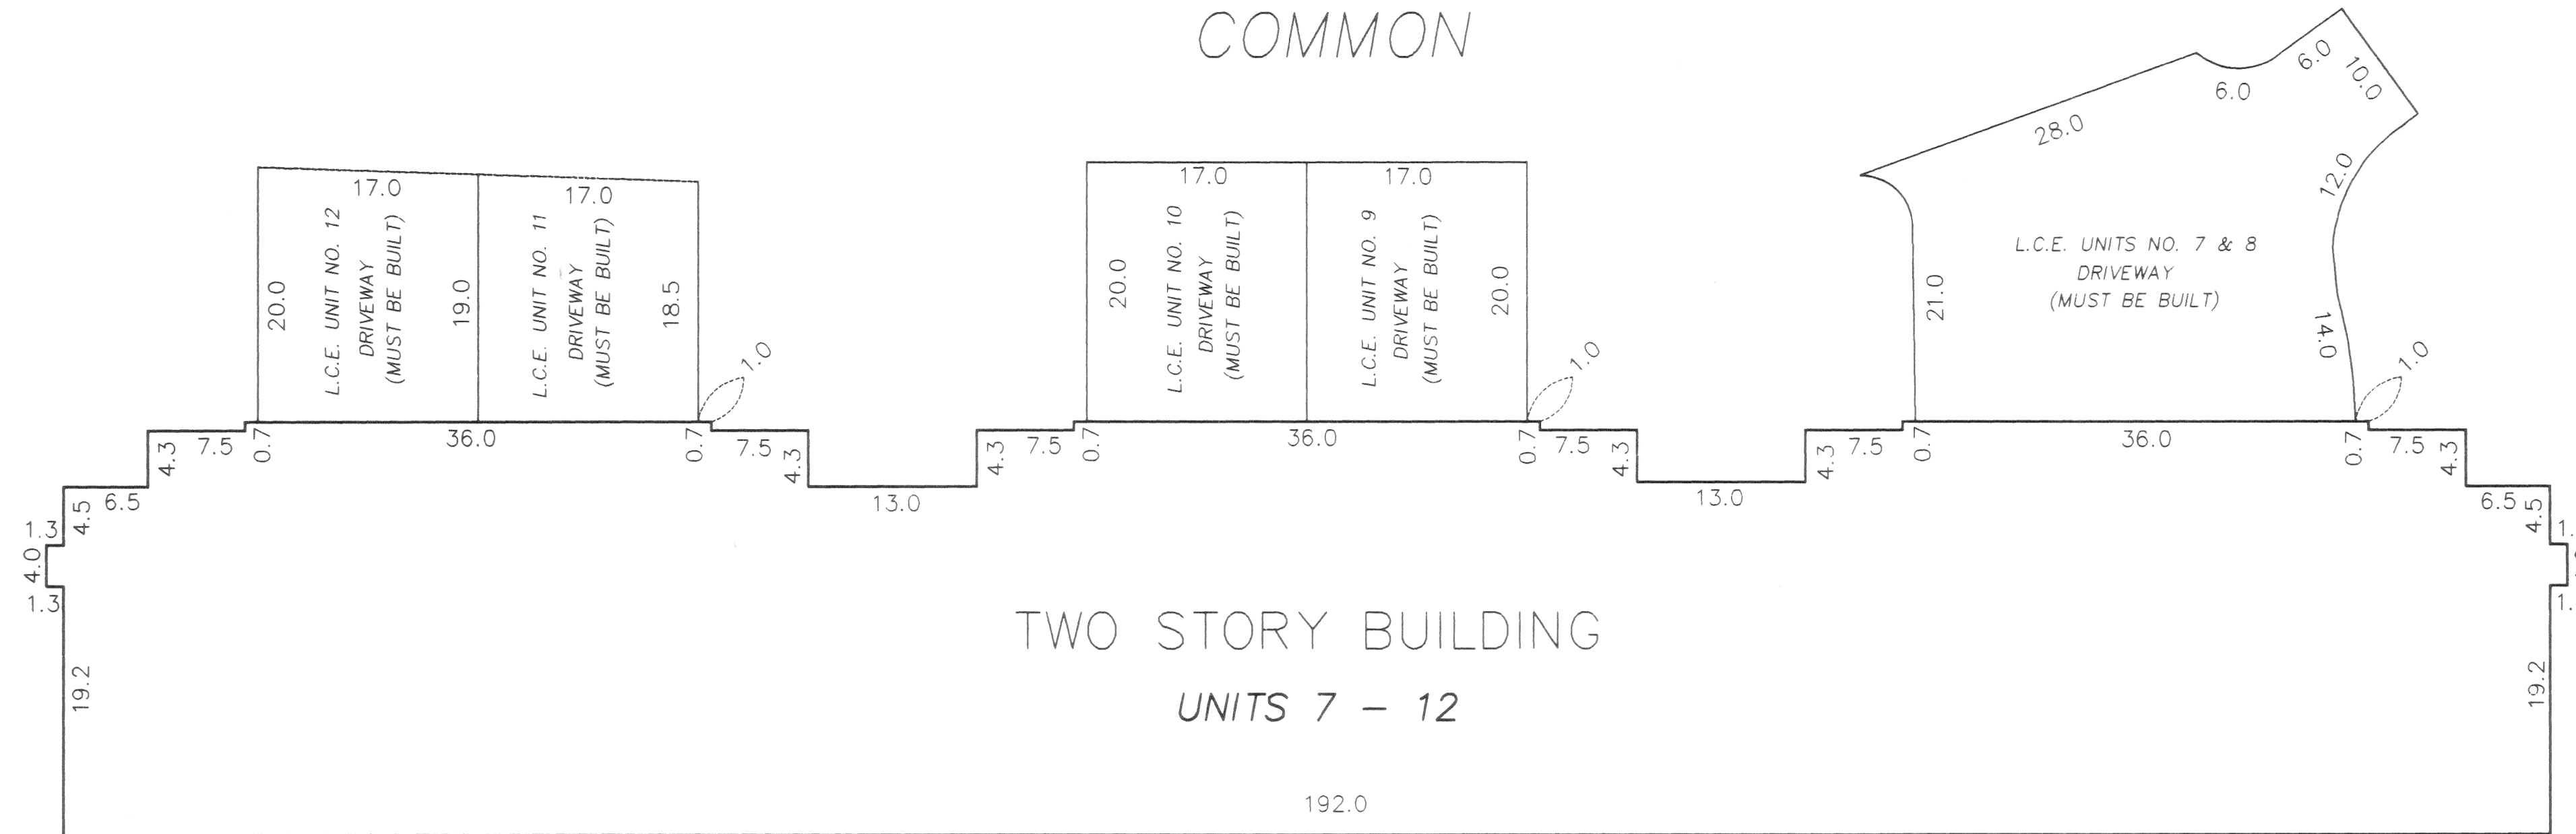

ELEMENT

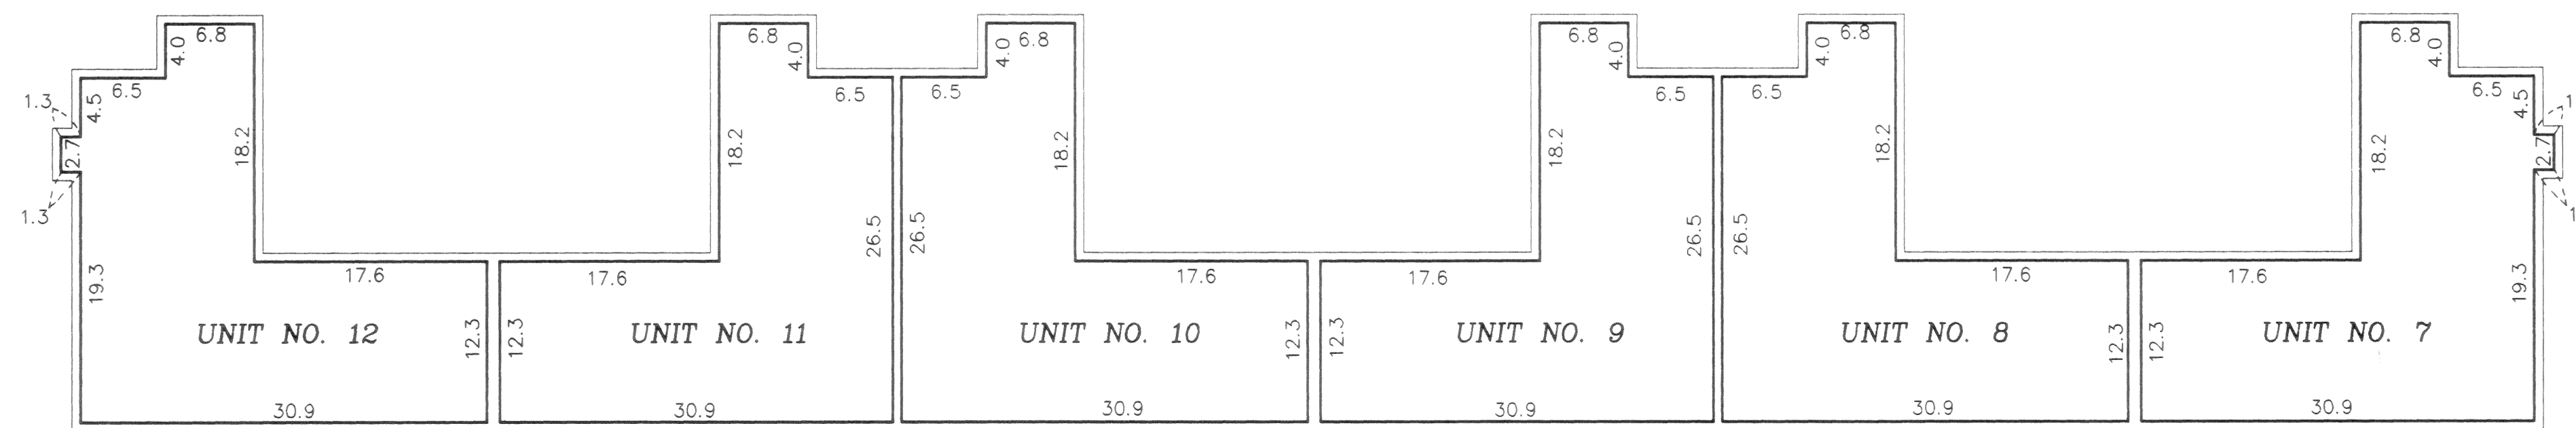

BASEMENT LEVEL

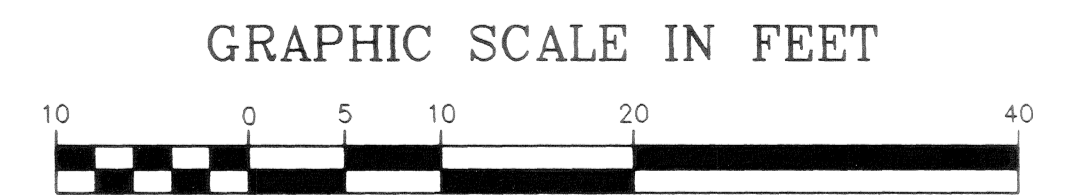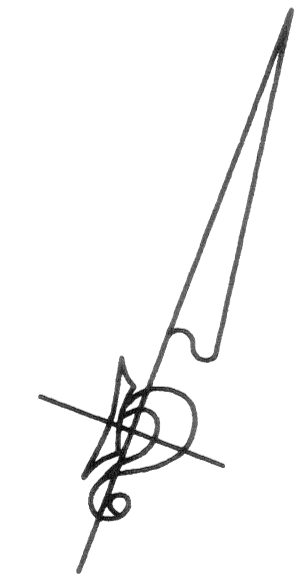

Scale: 1 inch = 10 feet

