N00°12'53"W

## CIC NUMBER 99 A CONDOMINIUM, DURHAM GREEN FIFTEENTH SUPPLEMENTAL CIC PLAT

FIFTEENTH SUPPLEMENTAL CIC PLAT

I, Terrence E. Rothenbacher, hereby certify that the work was undertaken by or reviewed and approved by me for this FIFTEENTH SUPPLEMENTAL CIC Plat of CIC Number 99, A CONDOMINIUM, DURHAM GREEN, being located upon

Lot 3, Block 1, CLUB WEST FOURTH ADDITION, Anoka County, Minnesota, according to the recorded plat thereof; and the additional real estate is located upon the following described property designated as:

That Part of Lot 1, Block 1, CLUB WEST, according to the recorded plat thereof, Anoka County, Minnesota, lying westerly of a line drawn from a point on the south line of said Lot 1 distant 87.57 feet easterly from the southwest corner of said Lot 1 to a point on the north line of said Lot 1 distant 92.93 feet easterly from the northwest corner of said Lot 1 and said line there terminating.

Lots 4 and 5, Block 1; and Lots 2 through 6, inclusive, Block 2; CLUB WEST FOURTH ADDITION, Anoka County, Minnesota.

and the CIC Plat fully and accurately depicts all information required by Minnesota Statutes, Section 515B.2—110.

Dated this **21st** day of **August**, 2003.

Terrence E. Rothenbacher, Land Surveyor
Minnesota License No. 20595

STATE OF MINNESOTA COUNTY OF ANOKA

The foregoing certificate was acknowledged before me this 215<sup>7</sup> day of AUGUST, 2003, by Terrence E. Rothenbacher, a Licensed Professional Land Surveyor.

al Land Surveyor.

CHRISTOPHER E SHARP
NOTARY PUBLIC
MY COMM. EXP. 01/31/2005

Notary Public, Anoka County, Minnesota
My Commission Expires January 31, 2005

I, Brian J. KrysToFiak pursuant to Minnesota Statutes, Section 515B.2—101(c), do hereby certify that all the units and all structural components and mechanical systems of all buildings containing or comprising any units hereby created, are substantially completed.

Dated this 212 day of August 2003

Registered Professional Engineer
Minnesota Registration No. 25043

BENCH MARK

Top nut hydrant ± 400' (FT.) West of Intersection of 113th Avenue NE. & Arnold Palmer Drive on North side of Street.

Elevation= 905.59 (NGVD 1929)

O Denotes 1/2 inch by 14 inch iron monument set and marked with license number 20595

For the purposes of this plat, the west line of Lot 4, Block 2, CLUB WEST is assumed to have a bearing of North 16°09'23" West

\_\_\_\_\_

GRAPHIC SCALE

80 0 40 8

( IN FEET )
1 inch = 80 feet

\* PIONEER

engineering

I HEREBY CERTIFY THAT THE CURRENT AND
DELINQUENT TAXES ON THE LANDS DESCRIBED
WITHIN ARE PAID AND THE TRANSFER IS
ENTERED
MAUREEN J DEVINE

TROPPERTY TAX ADMINISTRATOR

BY
DEPUTY PROPERTY TAX ADMINISTRATOR

LAND SURVEYORS • CIVIL ENGINEERS

LAND PLANNERS • LANDSCAPE ARCHITECTS

STATE OF MINNESOTA
COUNTY OF ANOKA

The foregoing certificate was acknowledged before me this 21 day of a Registered Professional Engineer.

CHRISTOPHER E SHARP
Notary Public, Anoka County, Minnesota
My Commission Expires January 31, 2005

Checked and approved this 3 RD day of SEPTEMBER, 2003.

Anoka County Surveyor


on this 18th day of September, 2003.

ANOKA COUNTY RECORDER


This FIFTEENTH SUPPLEMENTAL CIC PLAT is part of

CITY OF BLAINE COUNTY OF ANOKA SEC. 17, TWP. 31, RGE. 23

DRAINAGE AND UTILITY EASEMENTS
ARE PER PLAT OF CLUB WEST
AND ARE SHOWN AS THUS:
(NOT TO SCALE)

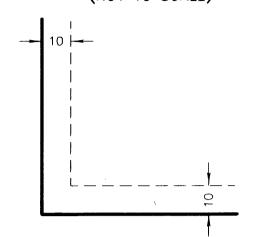

Being 10 feet in width and adjoining right—of—way lines unless otherwise shown.

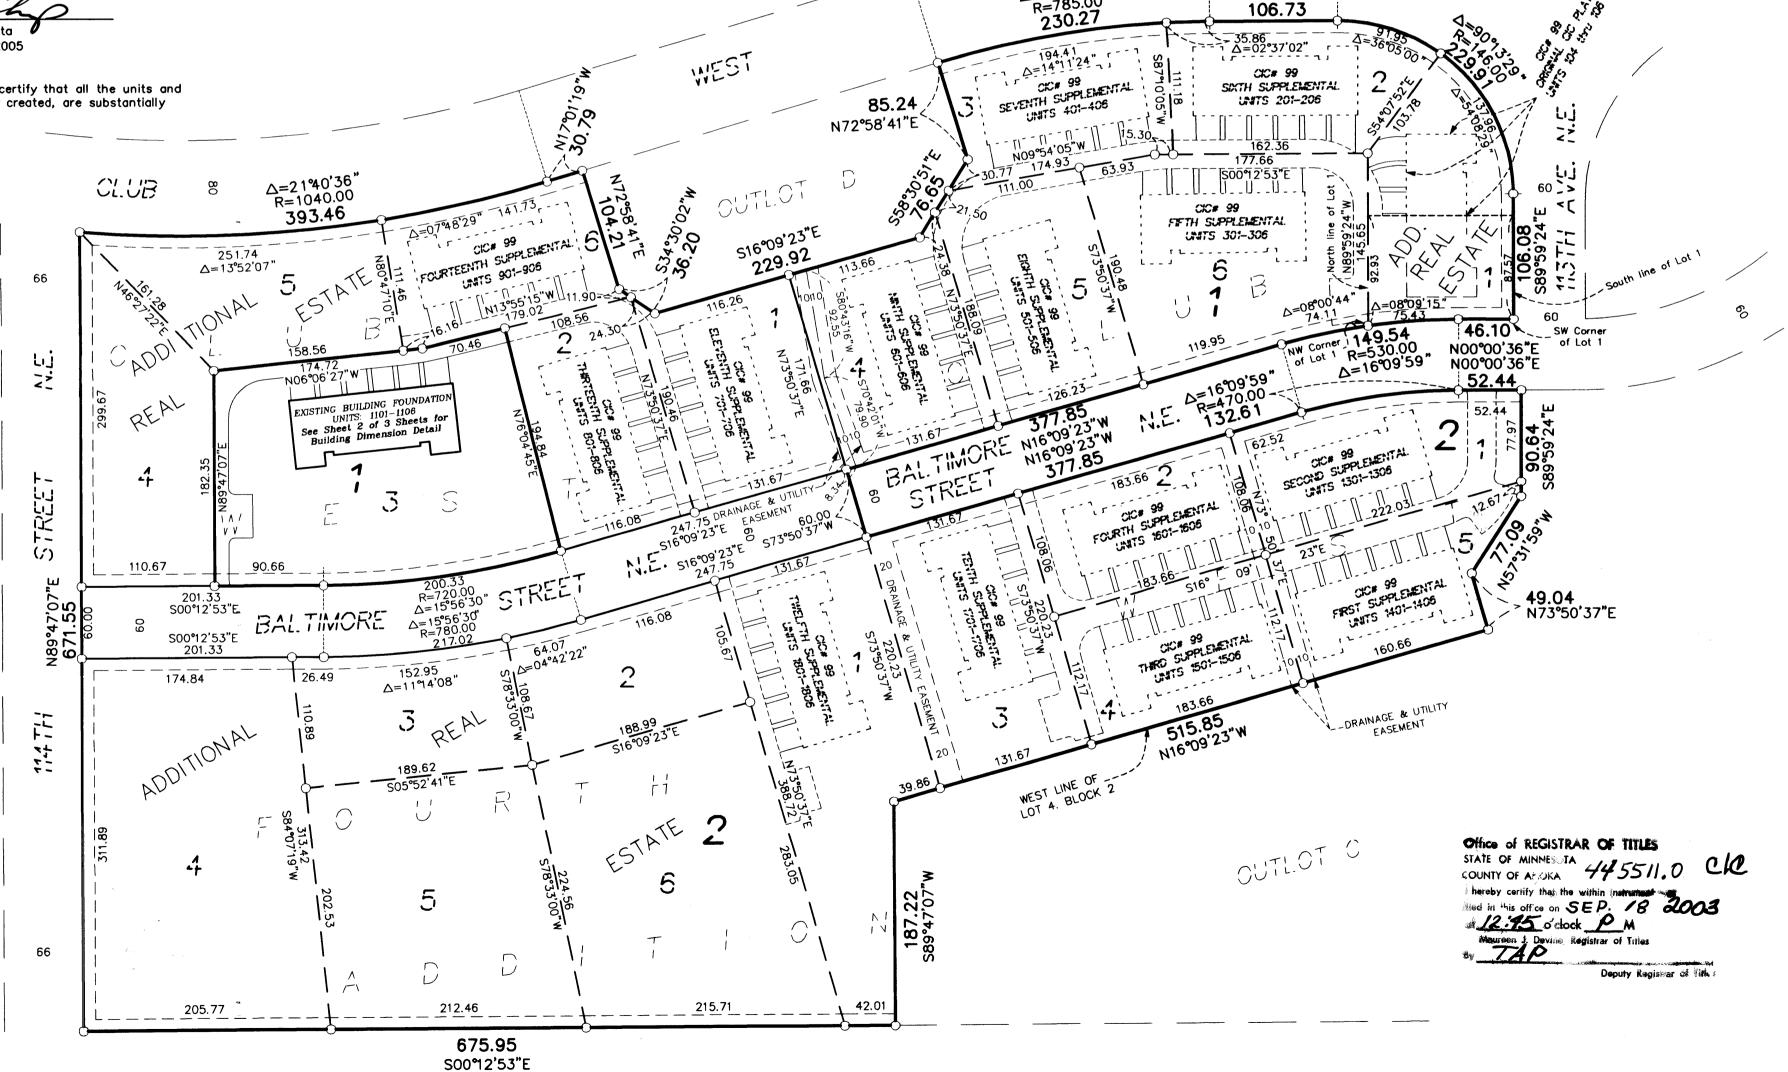

2003129226 \$ 315.00

OFFICIAL PLAT


SITE PLAN (AS-BUILT)

# CIC NUMBER 99 A CONDOMINIUM, DURHAM GREEN FIFTEENTH SUPPLEMENTAL, CIC PLAT


C.R. DOC. NO. 445511

BK.6 PG.10 CIC

CITY OF BLAINE COUNTY OF ANOKA SEC. 17, TWP. 31, RGE. 23

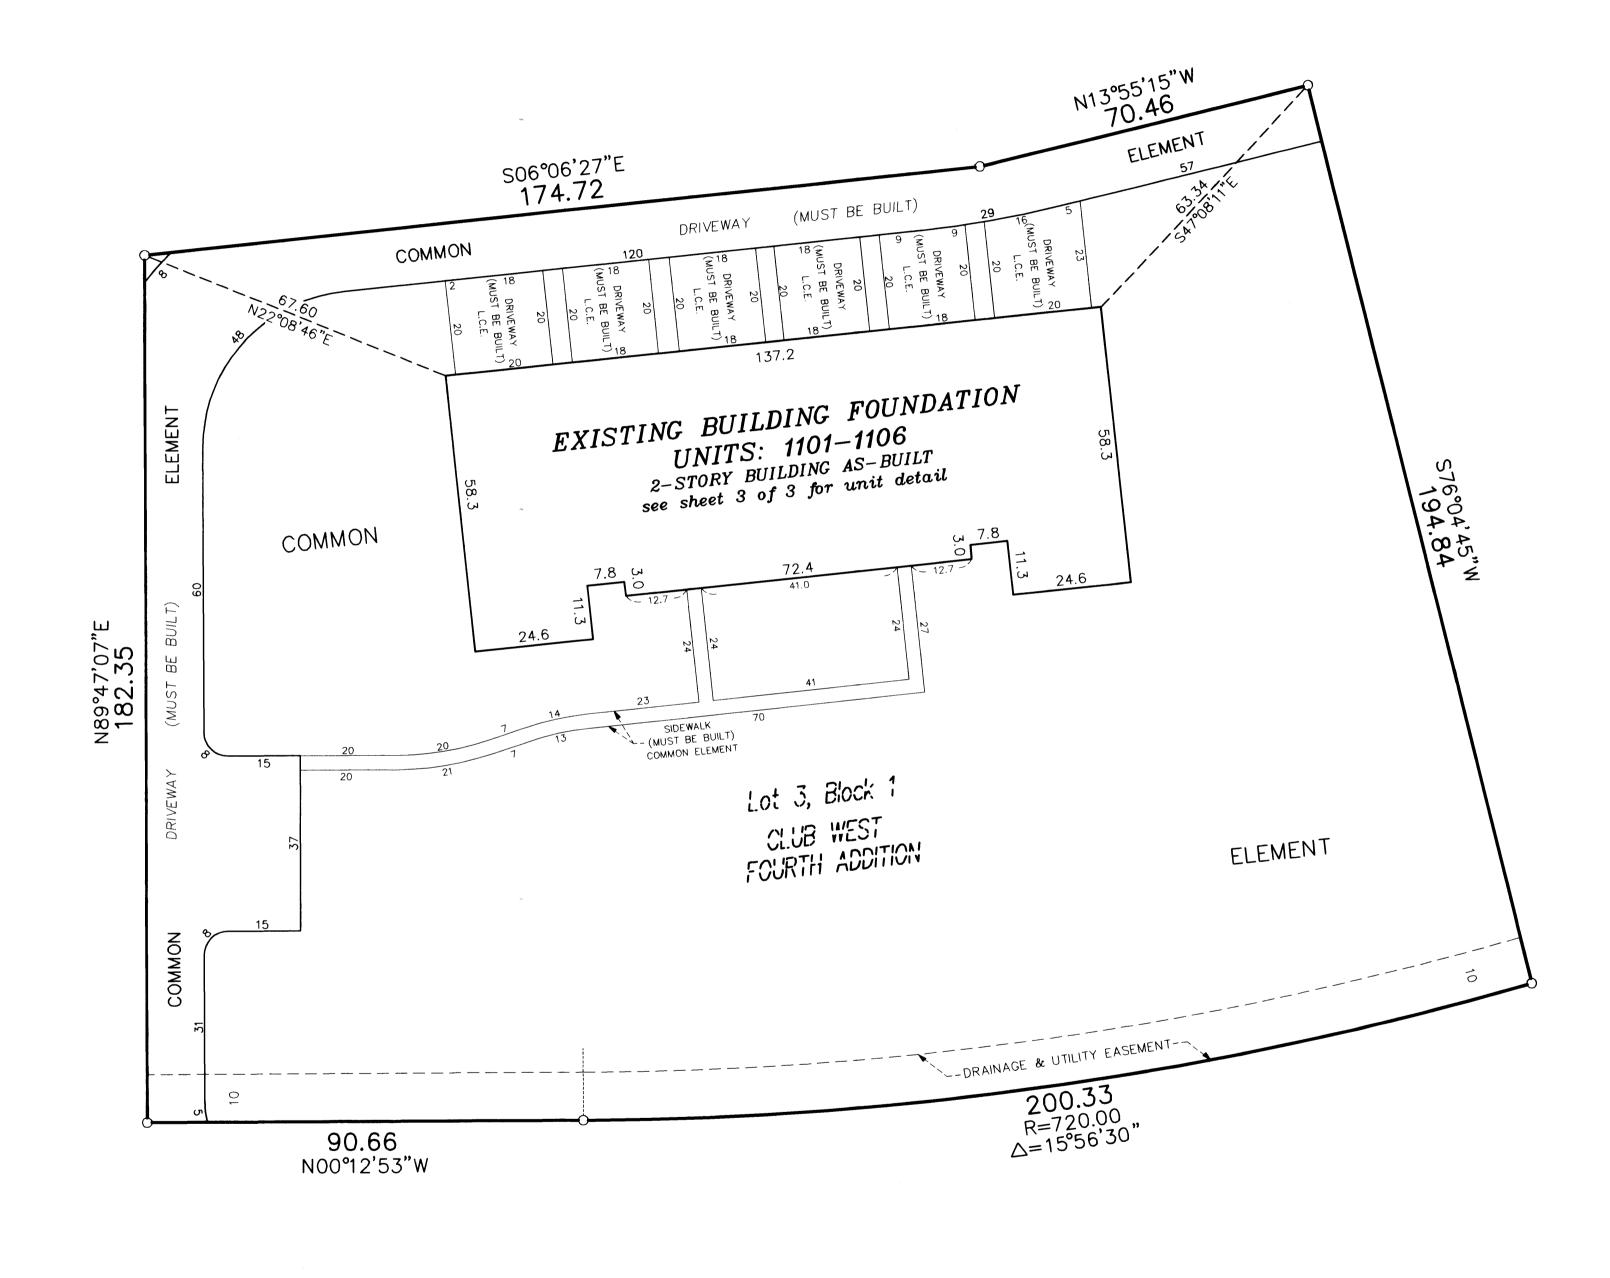

DRAINAGE AND UTILITY EASEMENTS
ARE PER PLAT OF CLUB WEST
AND ARE SHOWN AS THUS:
(NOT TO SCALE)

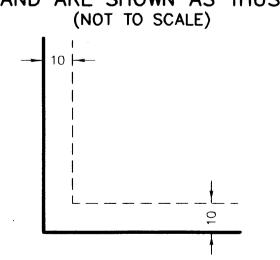

Being 10 feet in width and adjoining right—of—way lines unless otherwise shown.

Denotes 1/2 inch by 14 inch iron monument set and marked with license number 20595.

For the purposes of this plat, the west line of Lot 4, Block 2, CLUB WEST is assumed to have a bearing of North 16°09'23" West



GRAPHIC SCALE

20 0 10 20

(IN FEET)

1 inch = 20 feet

\* PIONEER

\* engineering

\* \* \* \*

LAND SURVEYORS • CIML ENGINEERS

LAND PLANNERS • LANDSCAPE ARCHITECTS

2003129226 \$315.00

OFFICIAL PLAT


UNIT DETAIL (AS-BUILT)

## CIC NUMBER 99 DURHAM GREEN, A CONDOMINIUM FIFTEENTH SUPPLEMENTAL CIC PLAT


CR DOC. NO. 445511

CITY OF BLAINE COUNTY OF ANOKA SEC. 17, TWP. 31, RGE. 23

### LOWER LEVEL

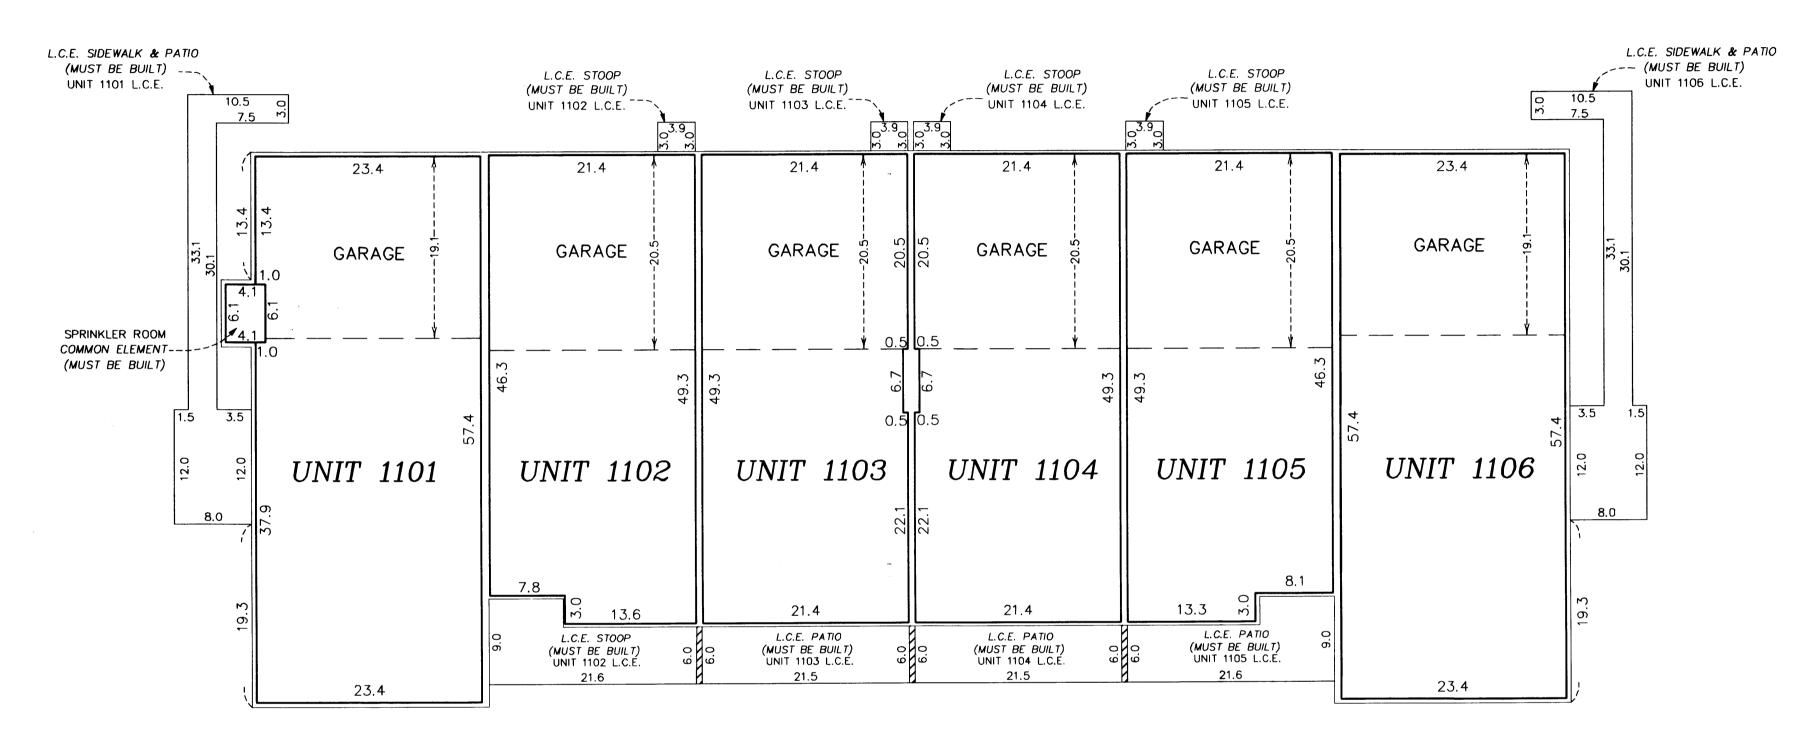

## UPPER LEVEL

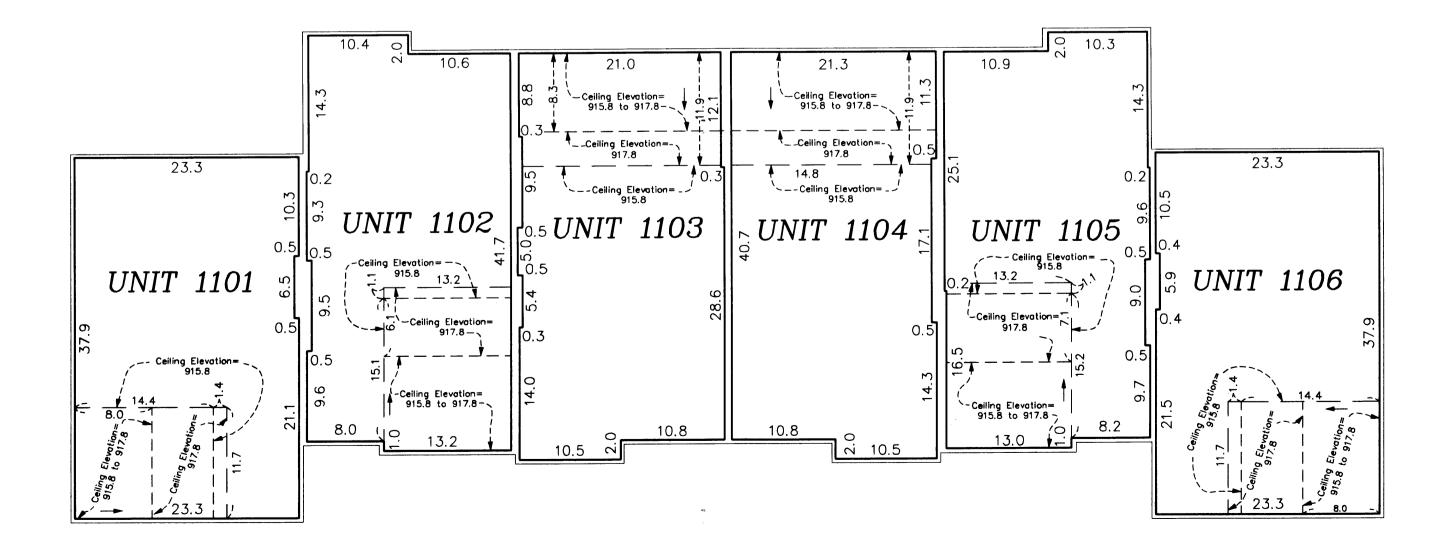

### Lower Level Elevations

- All units garage floor elevation = 896.7 feet
- All units garage ceiling elevations = 906.2 feet
- All units main level floor elevations = 897.1 feet
- All units main level ceiling elevation = 906.2 feet

### Second Level Elevations


- All units upper level floor elevation = 907.7 feet
- All units upper level ceiling elevation varies from 915.8 feet to 917.8


Elevations are referred to a benchmark as noted on the site plan on Sheet 1 of 3 Sheets and are shown in feet and tenths of a foot.

L.C.E. = Limited Common Element

C.E. = Common Element

Interior dimensions shown are measured to the unfinished surface of the walls, floors and ceiling.

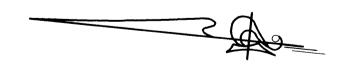

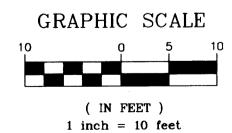

\* PIONEER

\* engineering

\* \* \* \*

LAND SURVEYORS • CIVIL ENGINEERS

LAND PLANNERS • LANDSCAPE ARCHITECTS

2003129226 \$315.00