GEEGAL PLAT

## CIC NUMBER 99

## A CONDOMINIUM, DURHAM GREEN NINTEENTH SUPPLEMENTAL

I, Terrence E. Rothenbacher, hereby certify that the work was undertaken by or reviewed and approved by me for this NINTEENTH SUPPLEMENTAL CIC Plat of CIC Number 99, A CONDOMINIUM, DURHAM GREEN, being located upon

Lot 2, Block 2, CLUB WEST FOURTH ADDITION, according to the recorded plat thereof, Anoka County, Minnesota;

and the additional real estate is located upon the following described property designated as:

Lots 3 through 5, inclusive, Block 2; CLUB WEST FOURTH ADDITION, Anoka County, Minnesota.

and the CIC Plat fully and accurately depicts all information required by Minnesota Statutes, Section 515B.2—110.

Dated this 23rd day of January 2004.

Terrence E. Rothenbacher, Land Surveyor Minnesota License No. 20595

STATE OF MINNESOTA COUNTY OF ANOKA

CHRISTOPHER E SHARP

NOTARY PUBLIC

MY COMM. EXP. 01/31/2005

Notary Public, Anoka County, Minnesota My Commission Expires January 31, 2005

I, Bear J. Keysto Fiak pursuant to Minnesota Statutes, Section 515B.2—101(c), do hereby certify that all the units and all structural components and mechanical systems of all buildings containing or comprising any units hereby created, are substantially completed.

Dated this 23rd day of January , 200 4.

Registered Professional Engineer
Minnesota Registration No. 25063

### BENCH MARK


Top nut hydrant ± 400' (FT.) West of Intersection of 113th Avenue NE. & Arnold Palmer Drive on North side of Street.

Elevation= 905.59 (NGVD 1929)

O Denotes 1/2 inch by 14 inch iron monument set and marked with license number 20595

For the purposes of this plat, the west line of Lot 4, Block 2, CLUB WEST is assumed to have a bearing of North 16°09'23" West



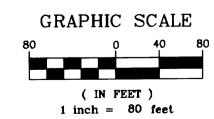

Office of RECOSTRAL OF TITLES

STATE OF ANDRA 459310.0

I hereby tertify that the within instrument was filled in this office on February 17, 2004 at 4:15 o'clock P M Maureen 1 Devine, Registrar of Titles

By Deputy Registrar of Titles

\* PIONEER engineering

LAND SURVEYORS • CIVIL ENGINEERS

LAND PLANNERS • LANDSCAPE ARCHITECTS

## CIC PLAT

STATE OF MINNESOTA COUNTY OF ANOKA

The foregoing certificate was acknowledged before me this 23rd day of 5wory, 2004, by Brian J. KRYSTOFIAK, a Registered Professional Engineer.

CHRISTOPHER E SHARP

NOTARY PUBLIC

MY COMM. EXP. 01/31/2005

Notary Public, Anoka County, Minnesota My Commission Expires January 31, 2005

BK 6 of CIC, pg 38

Checked and approved this  $30^{TH}$  day of JANUARY, 2004

Anoka County Surveyor


the Declaration filed as Document No. 469310 on this 17th day of February 2004.

Mir Whele Deputy

ANOKA COUNTY RECORDER

CITY OF BLAINE COUNTY OF ANOKA SEC. 17, TWP. 31, RGE. 23

DRAINAGE AND UTILITY EASEMENTS
ARE PER PLAT OF CLUB WEST
AND ARE SHOWN AS THUS:
(NOT TO SCALE)

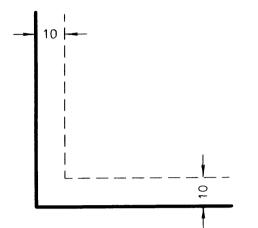


Being 10 feet in width and adjoining right-of-way

lines unless otherwise shown.

PARKWAY

N00°12'53"W

106.73

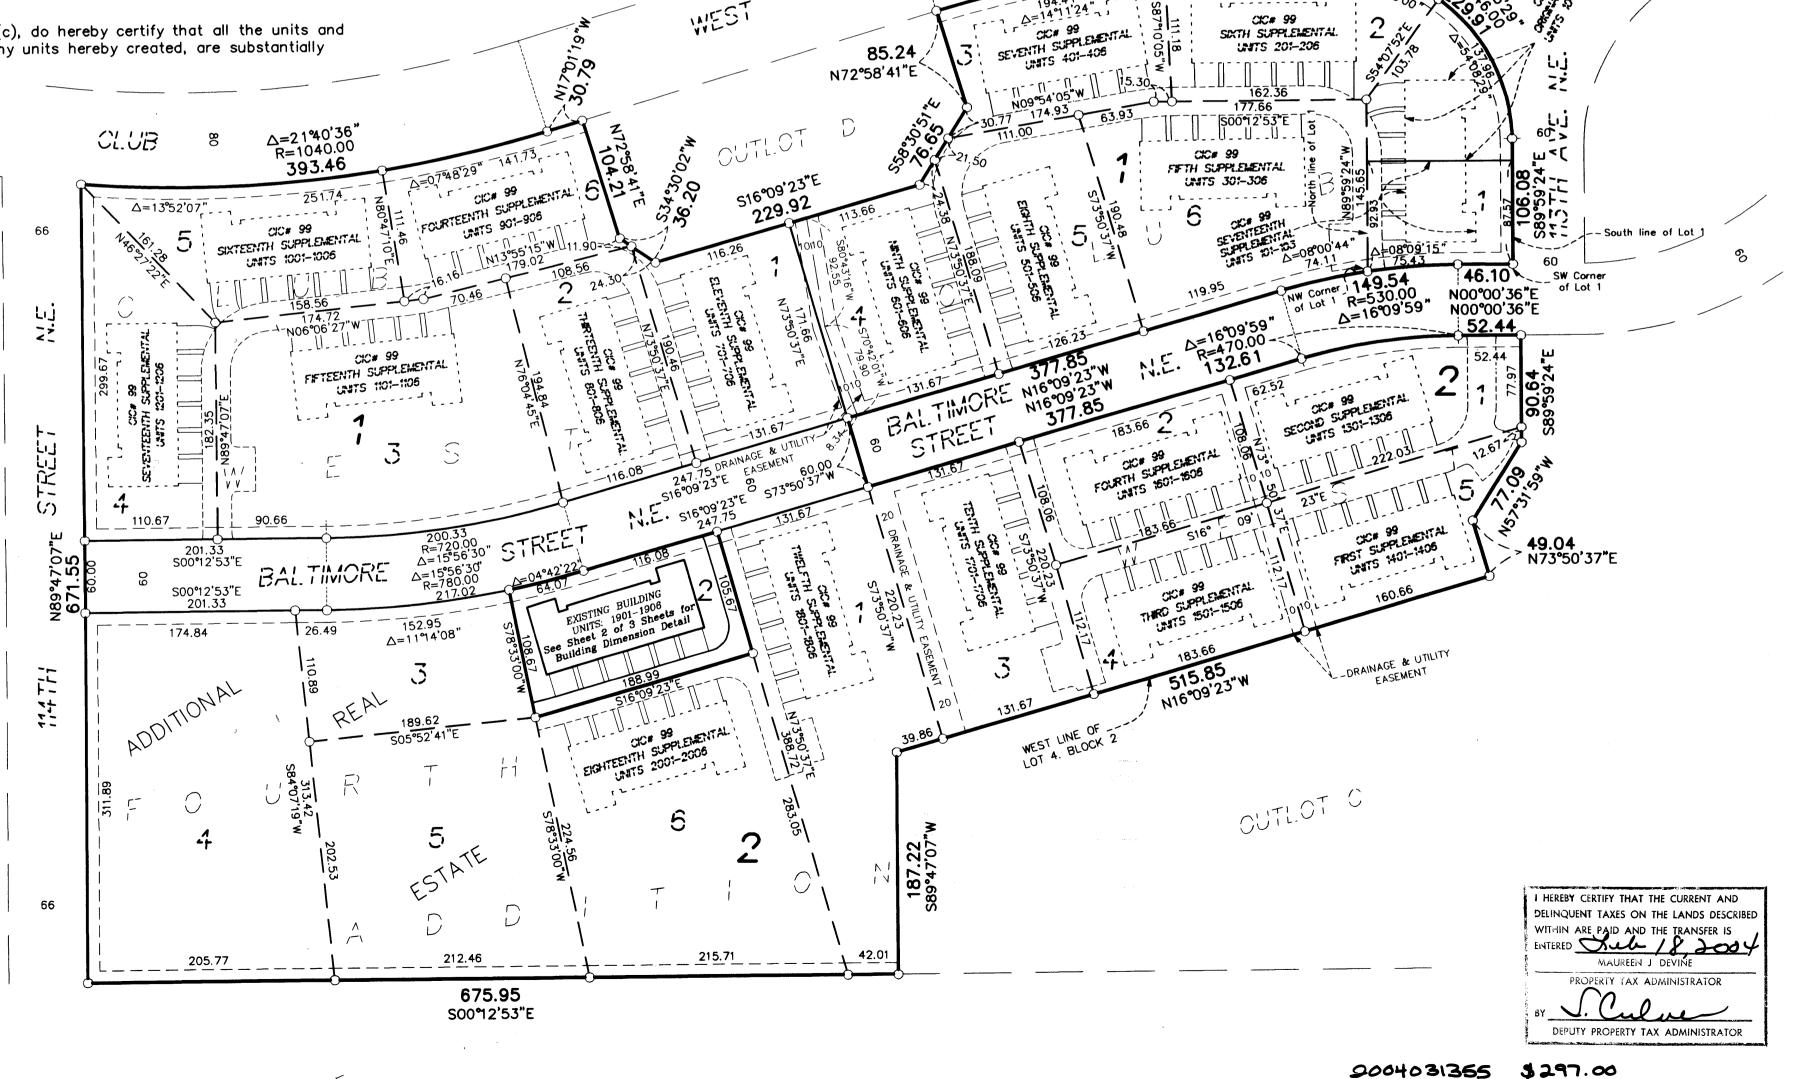


SITE PLAN (AS-BUILT)


# CIC NUMBER 99 A CONDOMINIUM, DURHAM GREEN NINTEENTH SUPPLEMENTAL CIC PLAT

C.R. DOC. NO. 459310

CITY OF BLAINE COUNTY OF ANOKA SEC. 17, TWP. 31, RGE. 23

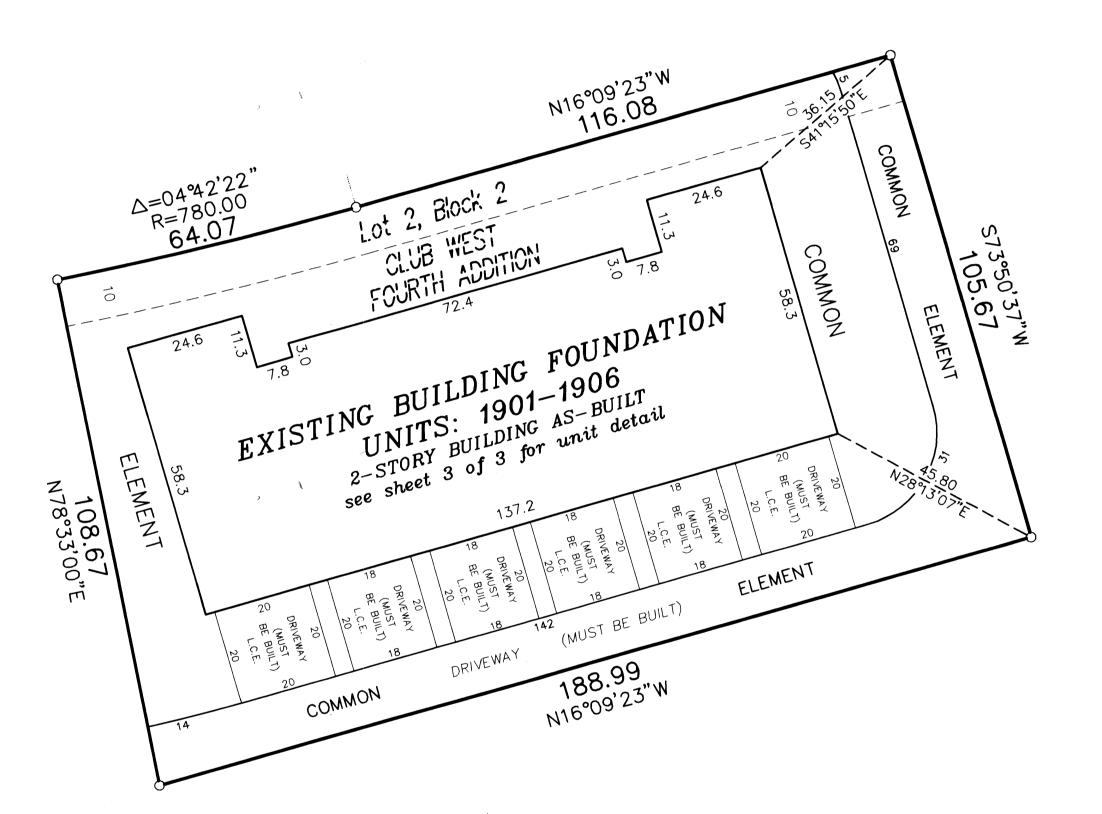


DRAINAGE AND UTILITY EASEMENTS
ARE PER PLAT OF CLUB WEST
AND ARE SHOWN AS THUS:
(NOT TO SCALE)

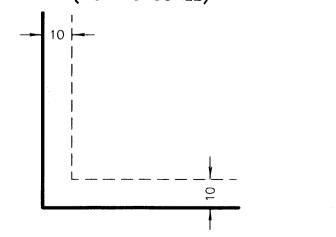


Being 10 feet in width and adjoining right—of—way lines unless otherwise shown.

Denotes 1/2 inch by 14 inch iron monument set and marked with license number 20595.

For the purposes of this plat, the west line of Lot 4, Block 2, CLUB WEST is assumed to have a bearing of North 16°09'23" West

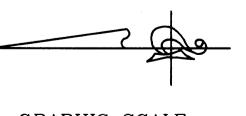

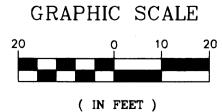

1 inch = 20 feet



LAND SURVEYORS • CIVIL ENGINEERS

LAND PLANNERS • LANDSCAPE ARCHITECTS

2664631355 \$ 297.00

OFFICIAL PLAT UNIT DETAIL

(AS-BUILT)


BK 6 of Cic, pg 38

# CIC NUMBER 99 DURHAM GREEN, A CONDOMINIUM NINTEENTH SUPPLEMENTAL CIC PLAT

CR DOC. NO. 459310

CITY OF BLAINE COUNTY OF ANOKA SEC. 17, TWP. 31, RGE. 23

LOWER LEVEL

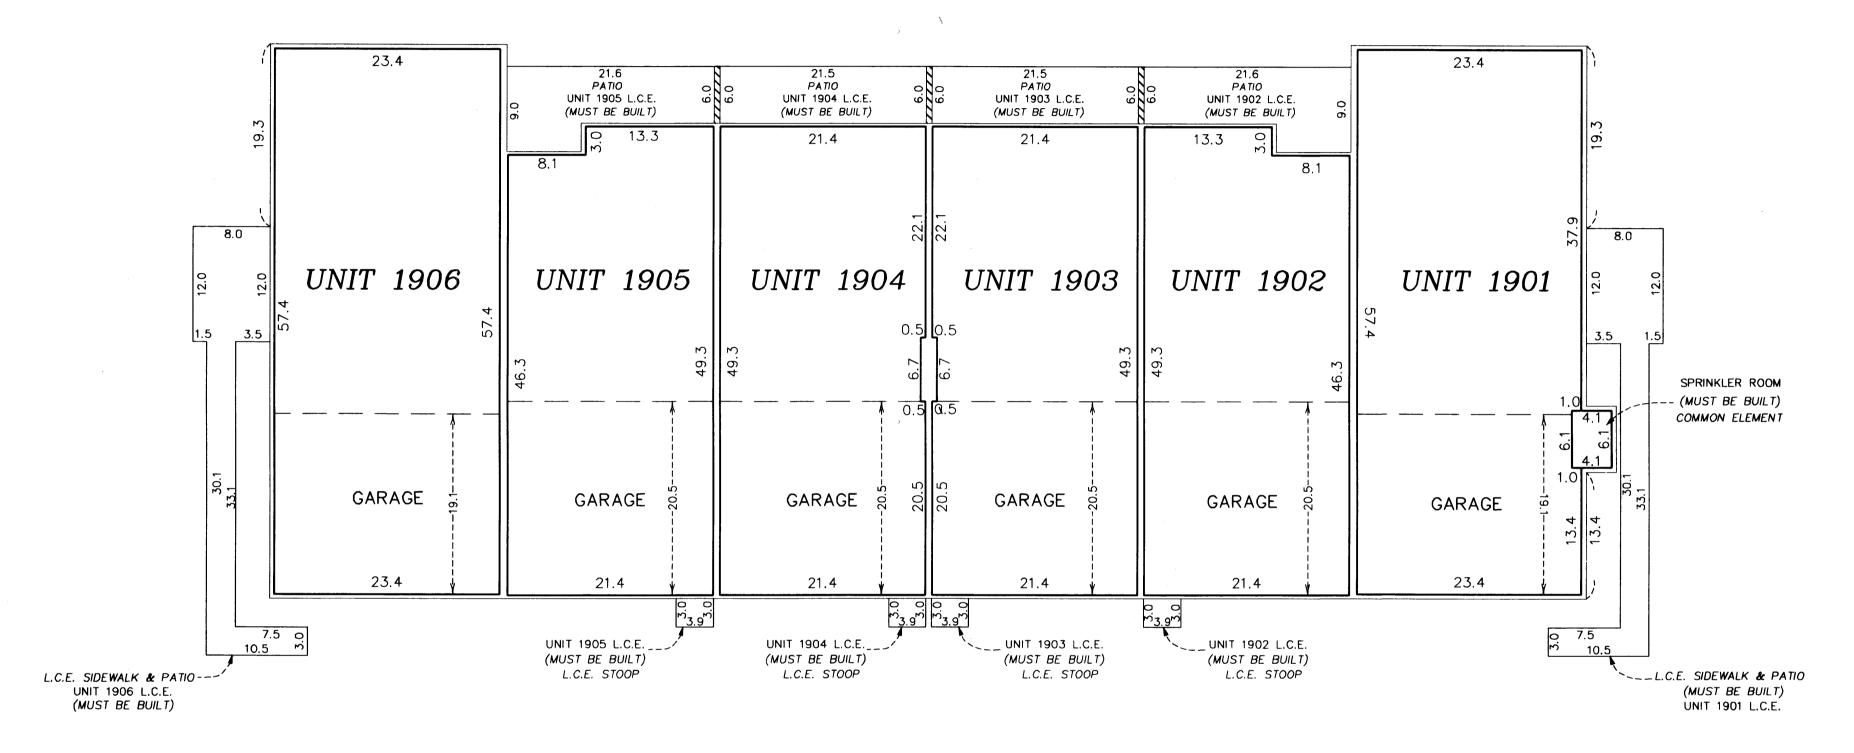

### Lower Level Elevations

- All units garage floor elevation = 896.8 feet
- All units garage ceiling elevations = 906.3 feet
- All units main level floor elevations = 897.2 feet All units main level ceiling elevation = 906.3 feet

## Second Level Elevations

- All units upper level floor elevation = 907.8 feet
- All units upper level ceiling elevation varies from 915.9 feet to 917.9


Elevations are referred to a benchmark as noted on the site plan on Sheet 1 of 3 Sheets and are shown in feet and tenths of a foot.


L.C.E. = Limited Common Element

C.E. = Common Element

Interior dimensions shown are measured to the unfinished surface of the walls, floors and ceiling.

## UPPER LEVEL

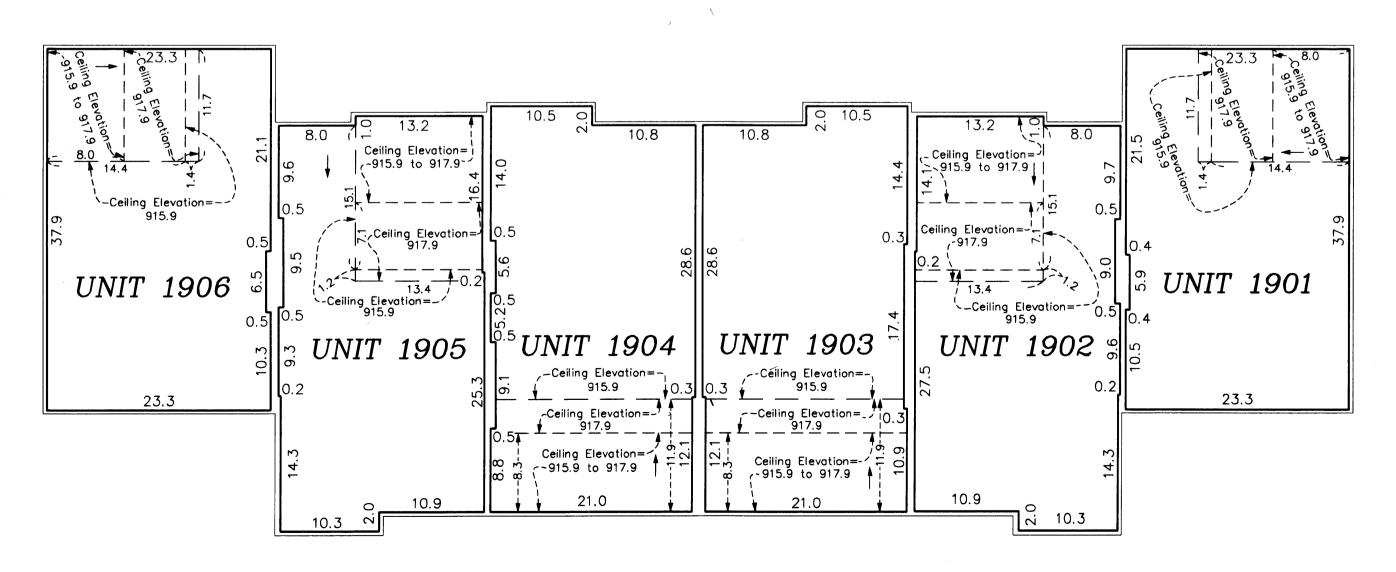

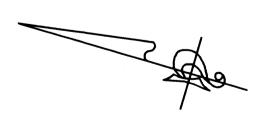

GRAPHIC SCALE

10 0 5 1

(IN FEET)

1 inch = 10 feet



LAND SURVEYORS • CIVIL ENGINEERS

LAND PLANNERS • LANDSCAPE ARCHITECTS

2004031355 \$297.00