

OFFICIAL PLAT I, Terrence E. Rothenbacher, hereby certify that the work was undertaken by or reviewed and approved by me for this TWENTIETH SUPPLEMENTAL CIC Plat of CIC Number 99, A CONDOMINIUM, DURHAM GREEN, being located upon Lot 5, Block 2, CLUB WEST FOURTH ADDITION, according to the recorded plat thereof, Anoka County, Minnesota; and the additional real estate is located upon the following described property designated as: Lots 3 and 4, Block 2; CLUB WEST FOURTH ADDITION, Anoka County, Minnesota. and that the CIC Plat fully and accurately depicts all information required by Minnesota Statutes, Section 515B.2—110. Dated this 12th day of March , 2004. Terrence E. Rothenbacher, Land Surveyor Minnesota License No. 20595 STATE OF MINNESOTA COUNTY OF ANOKA The foregoing certificate was acknowledged before me this 12th day of march, 2004, by Terrence E. Rothenbacher, a Licensed Professional Land Surveyor. the E.Sh CHRISTOPHER E SHARP NOTARY PUBLIC Notary Public, Anoka County, Minnesota MY COMM. EXP. 01/31/2005 My Commission Expires January 31, 2005 1, BRIAN J. KRYSTOFIAK ____ pursuant to Minnesota Statutes, Section 515B.2—101(c), do hereby certify that all the units and all structural components and mechanical systems of all buildings containing or comprising any units hereby created, are substantially completed. Dated this 12th day of March, 2004. K: 1 Registered Professional Engineer Minnesota Registration No. 25003 **BENCH MARK** Top nut hydrant \pm 400' (FT.) West of Intersection of 113th Avenue NE. & Arnold Palmer Drive on North side of Street. Elevation= 905.59 (NGVD 1929) O Denotes 1/2 inch by 14 inch iron monument set and marked with license number 20595 For the purposes of this plat, the west line of Lot 4, Block 2, CLUB WEST is assumed to have a bearing of North 16°09'23" West GRAPHIC SCALE (IN FEET) 1 inch = 80 feetPIONEER LAND SURVEYORS . CIVIL ENGINEERS LAND PLANNERS . LANDSCAPE ARCHITECTS engineering * ***

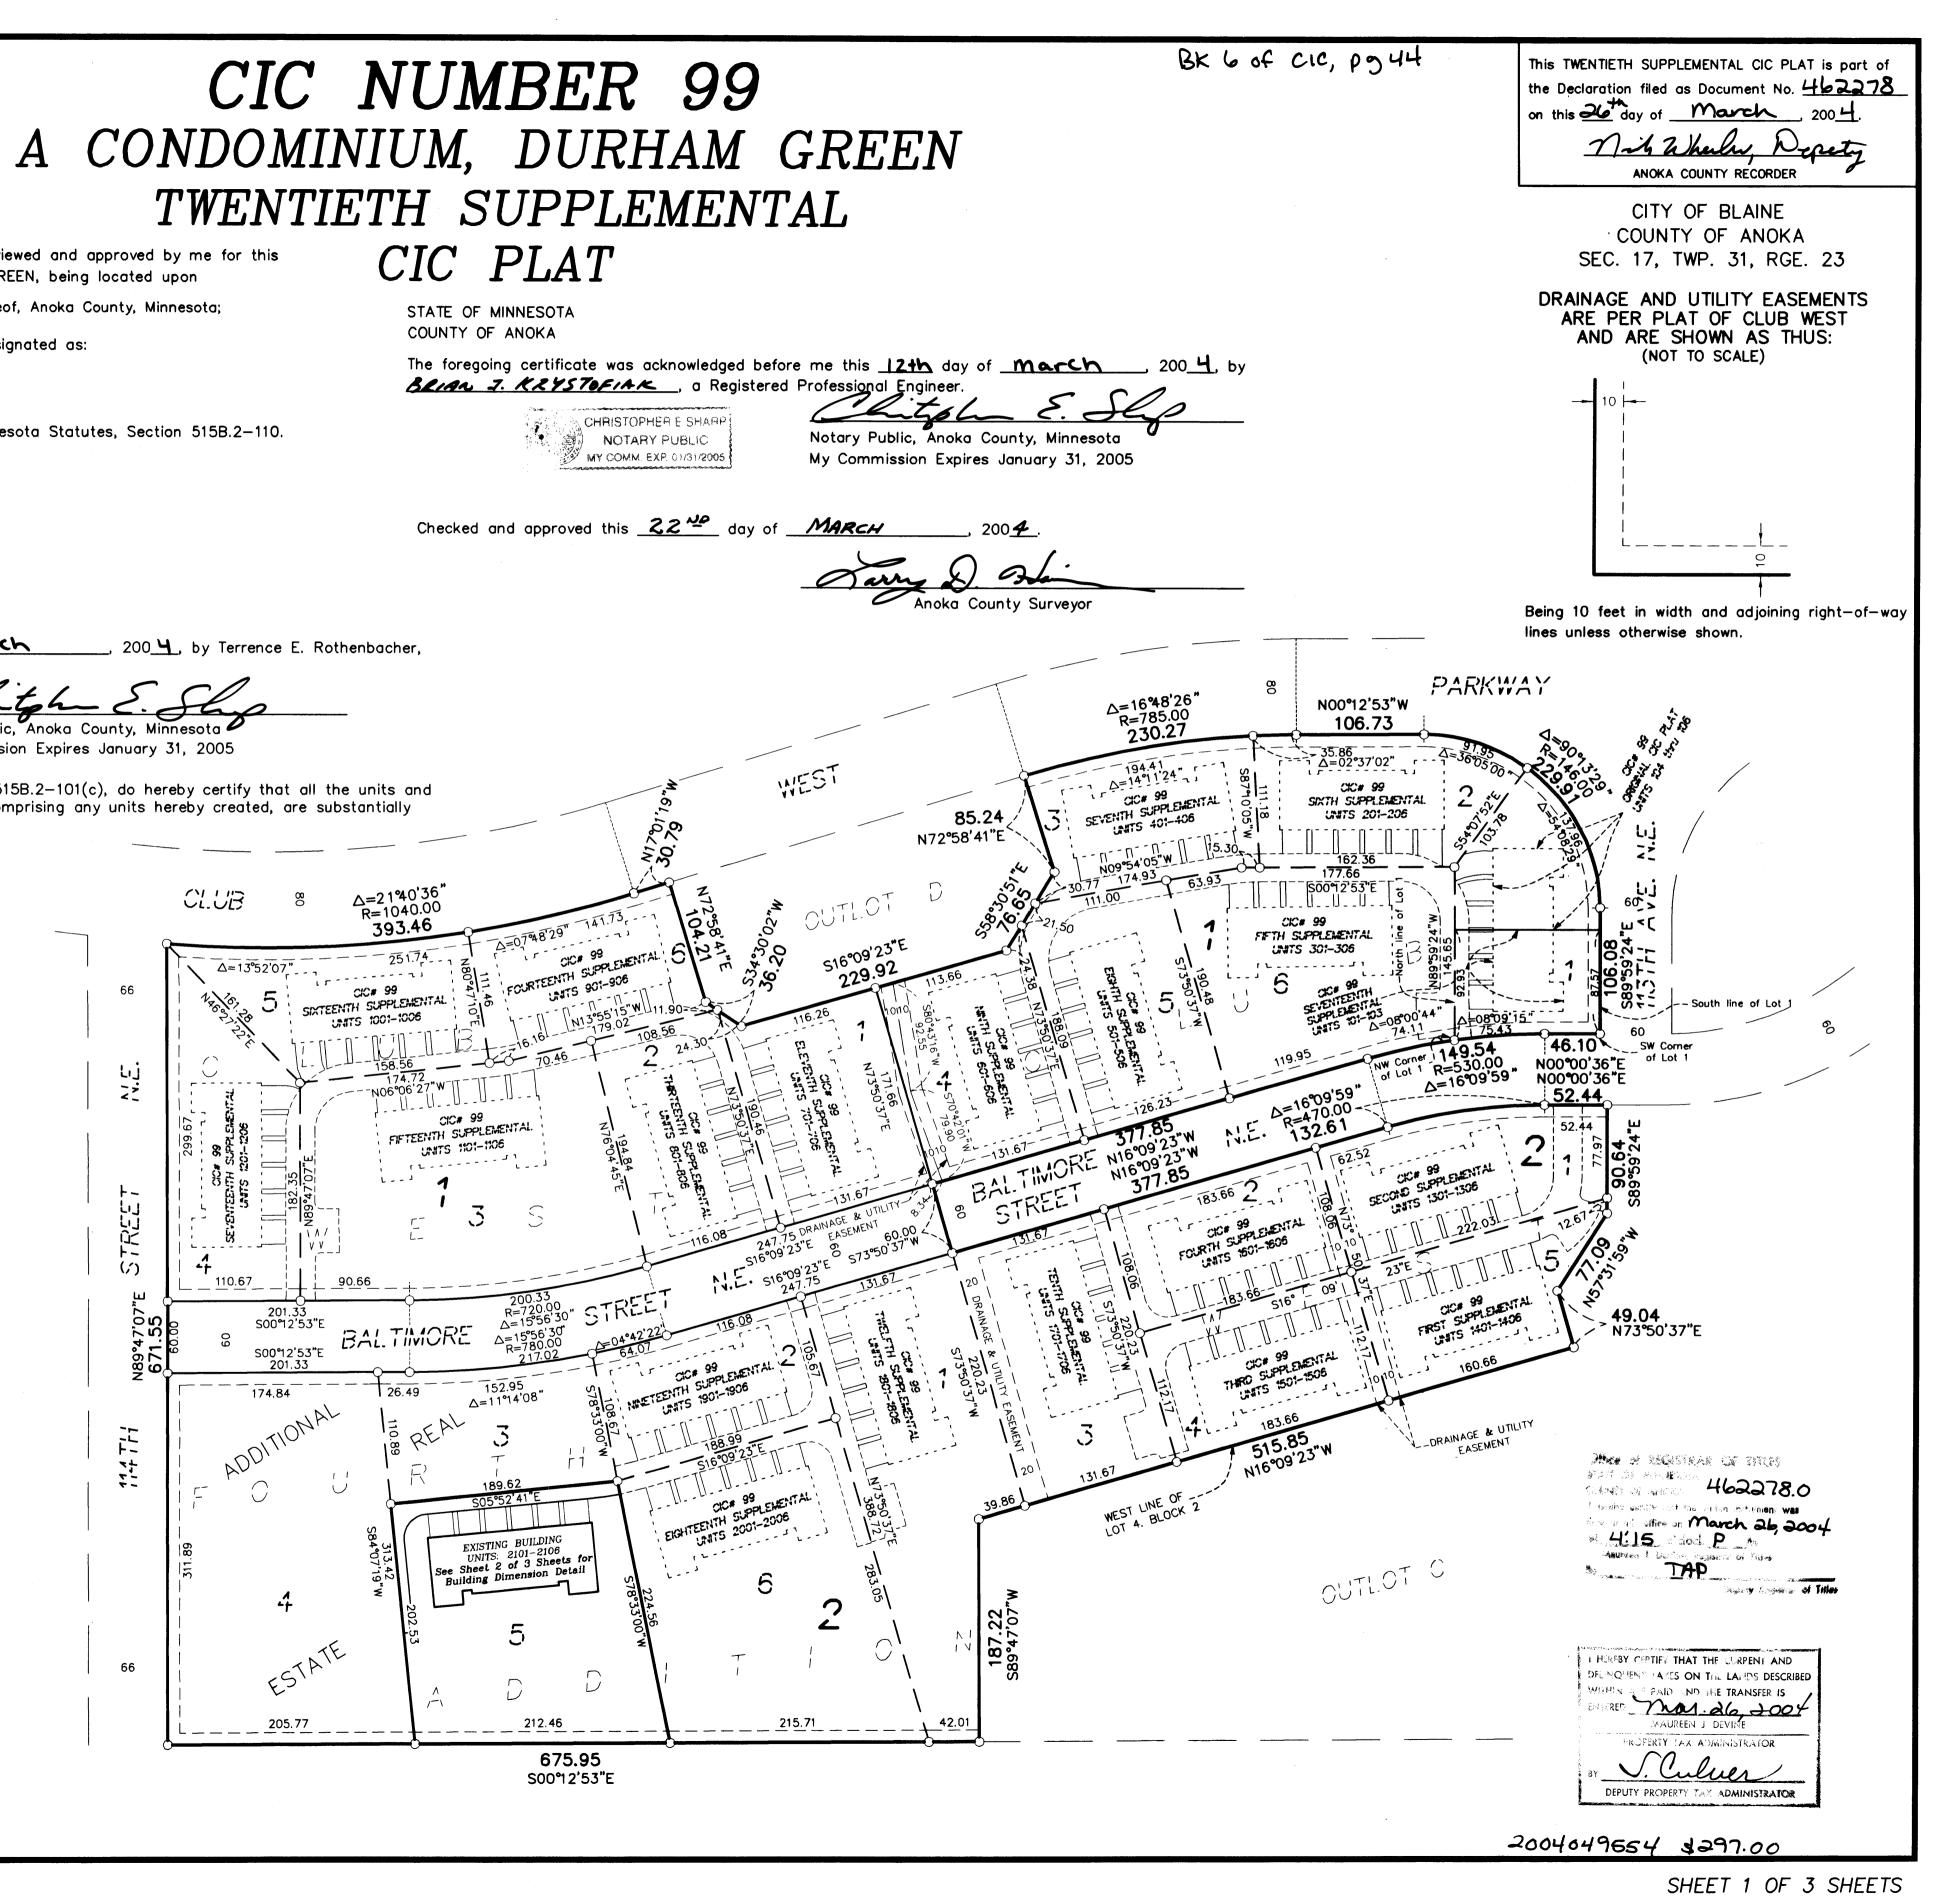

OFFICIAL PLAT

SITE PLAN (AS-BUILT)

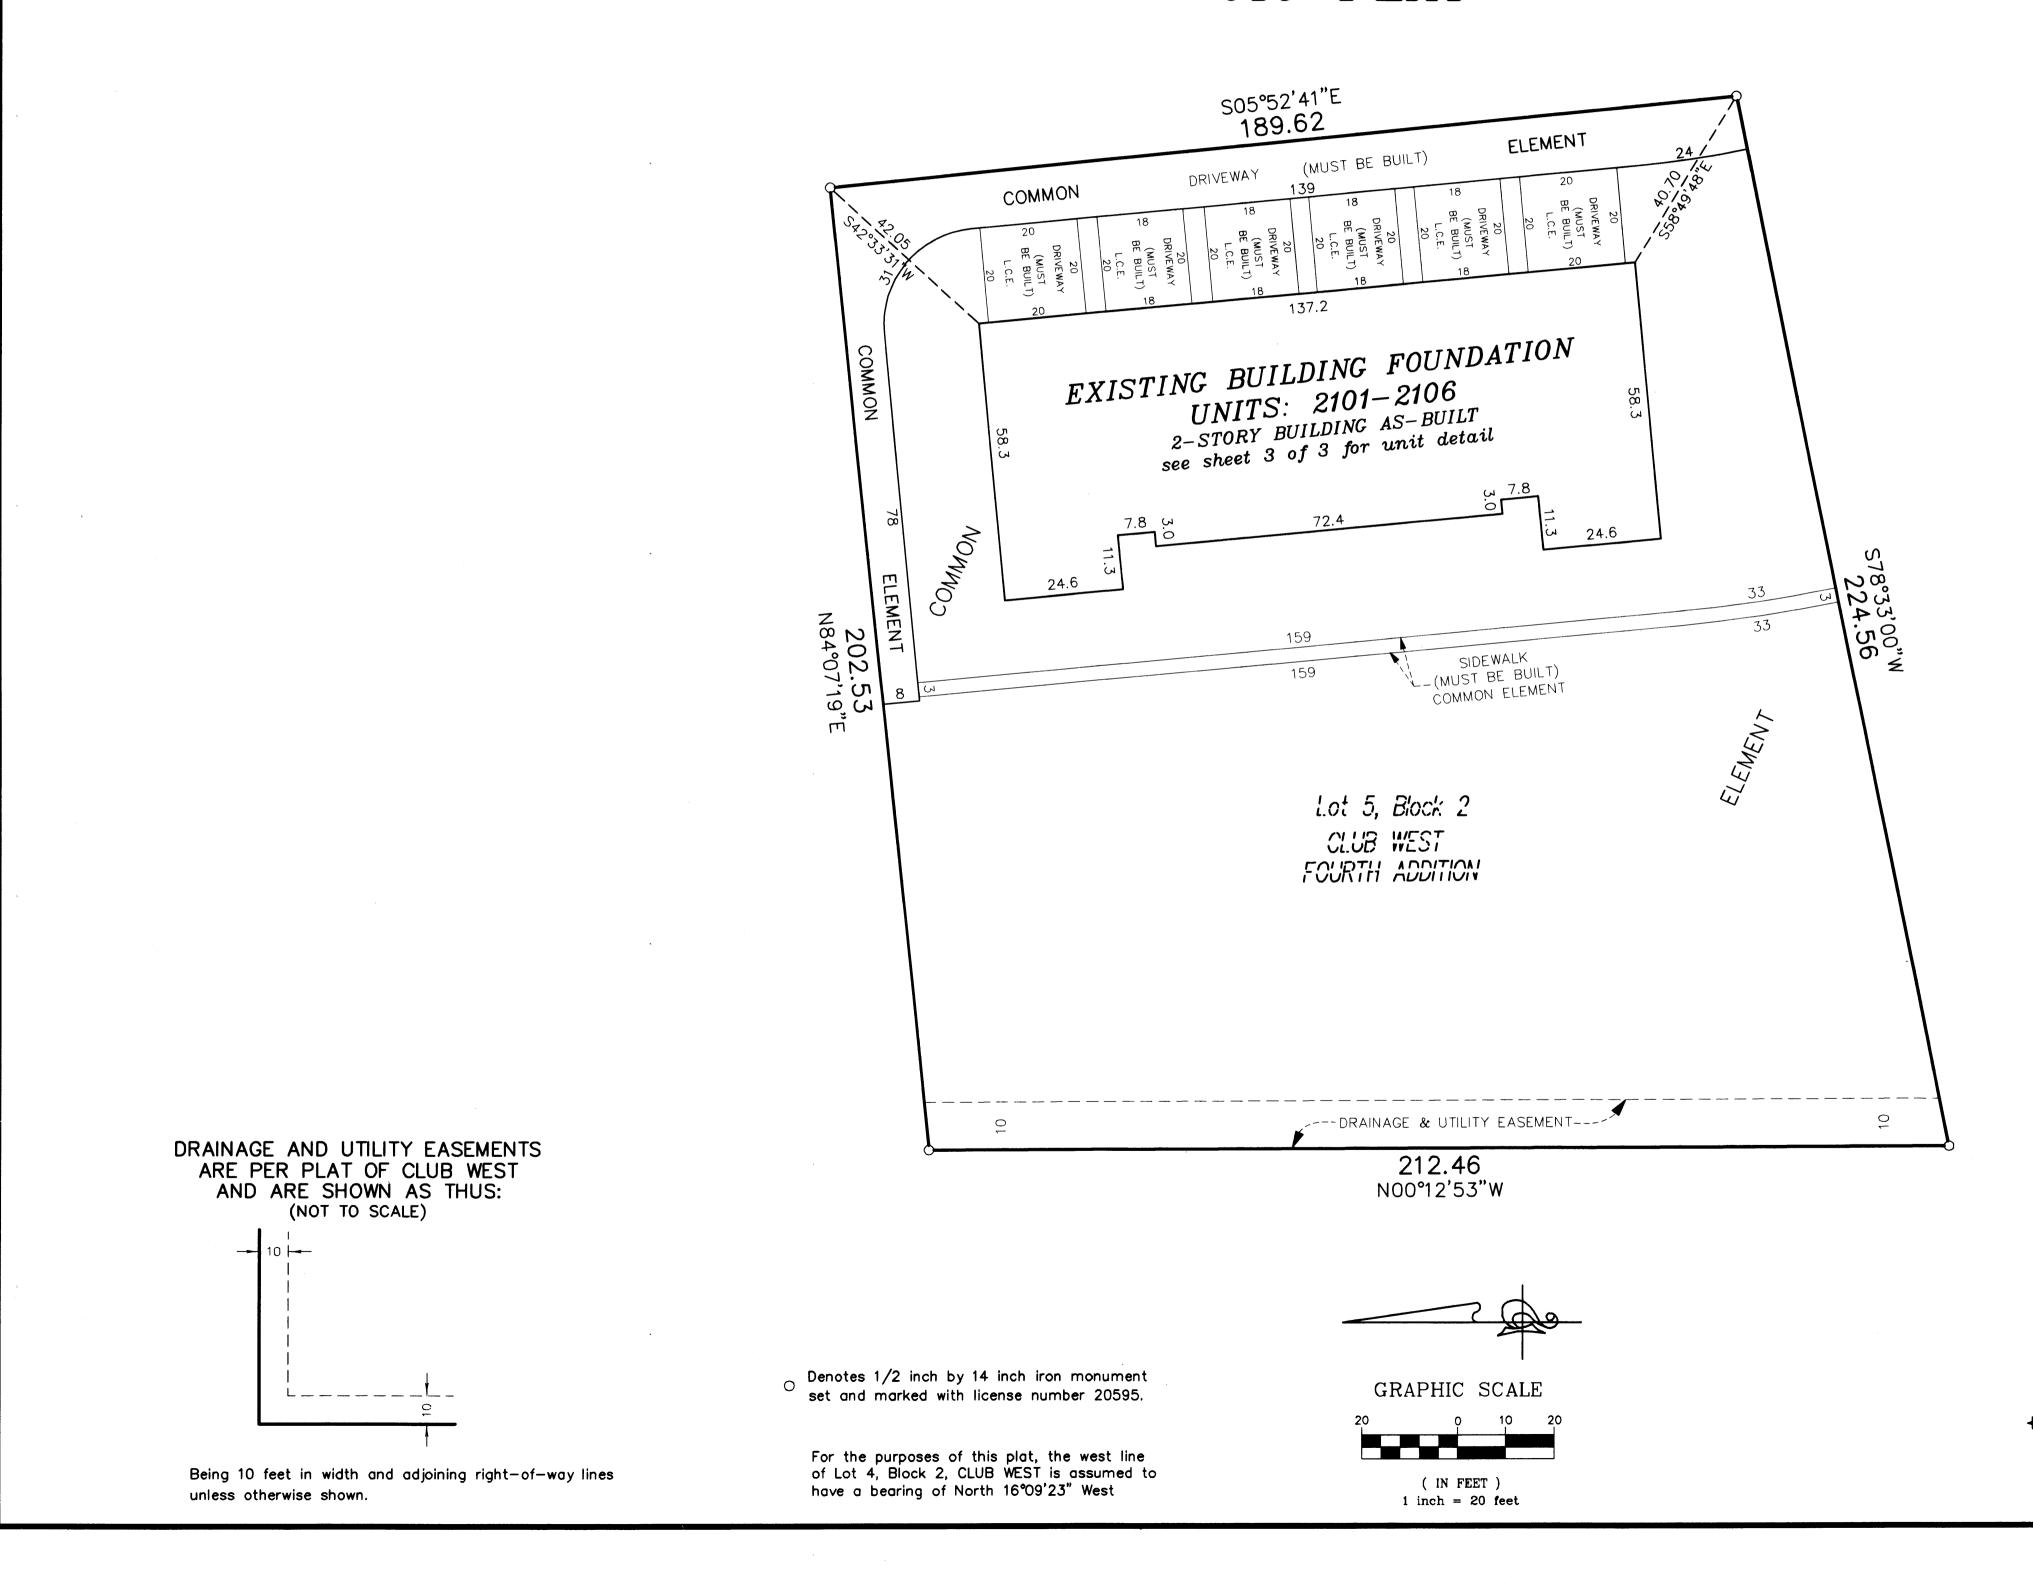

CIC NUMBER 99 A CONDOMINIUM, DURHAM GREEN TWENTIETH SUPPLEMENTAL CIC PLAT


C.R. DOC. NO 462278

CITY OF BLAINE COUNTY OF ANOKA SEC. 17, TWP. 31, RGE. 23

PIONEE	R
enginee	ring
***	_

LAND SURVEYORS . CIVIL ENGINEERS LAND PLANNERS . LANDSCAPE ARCHITECTS

2004049554 \$297.00

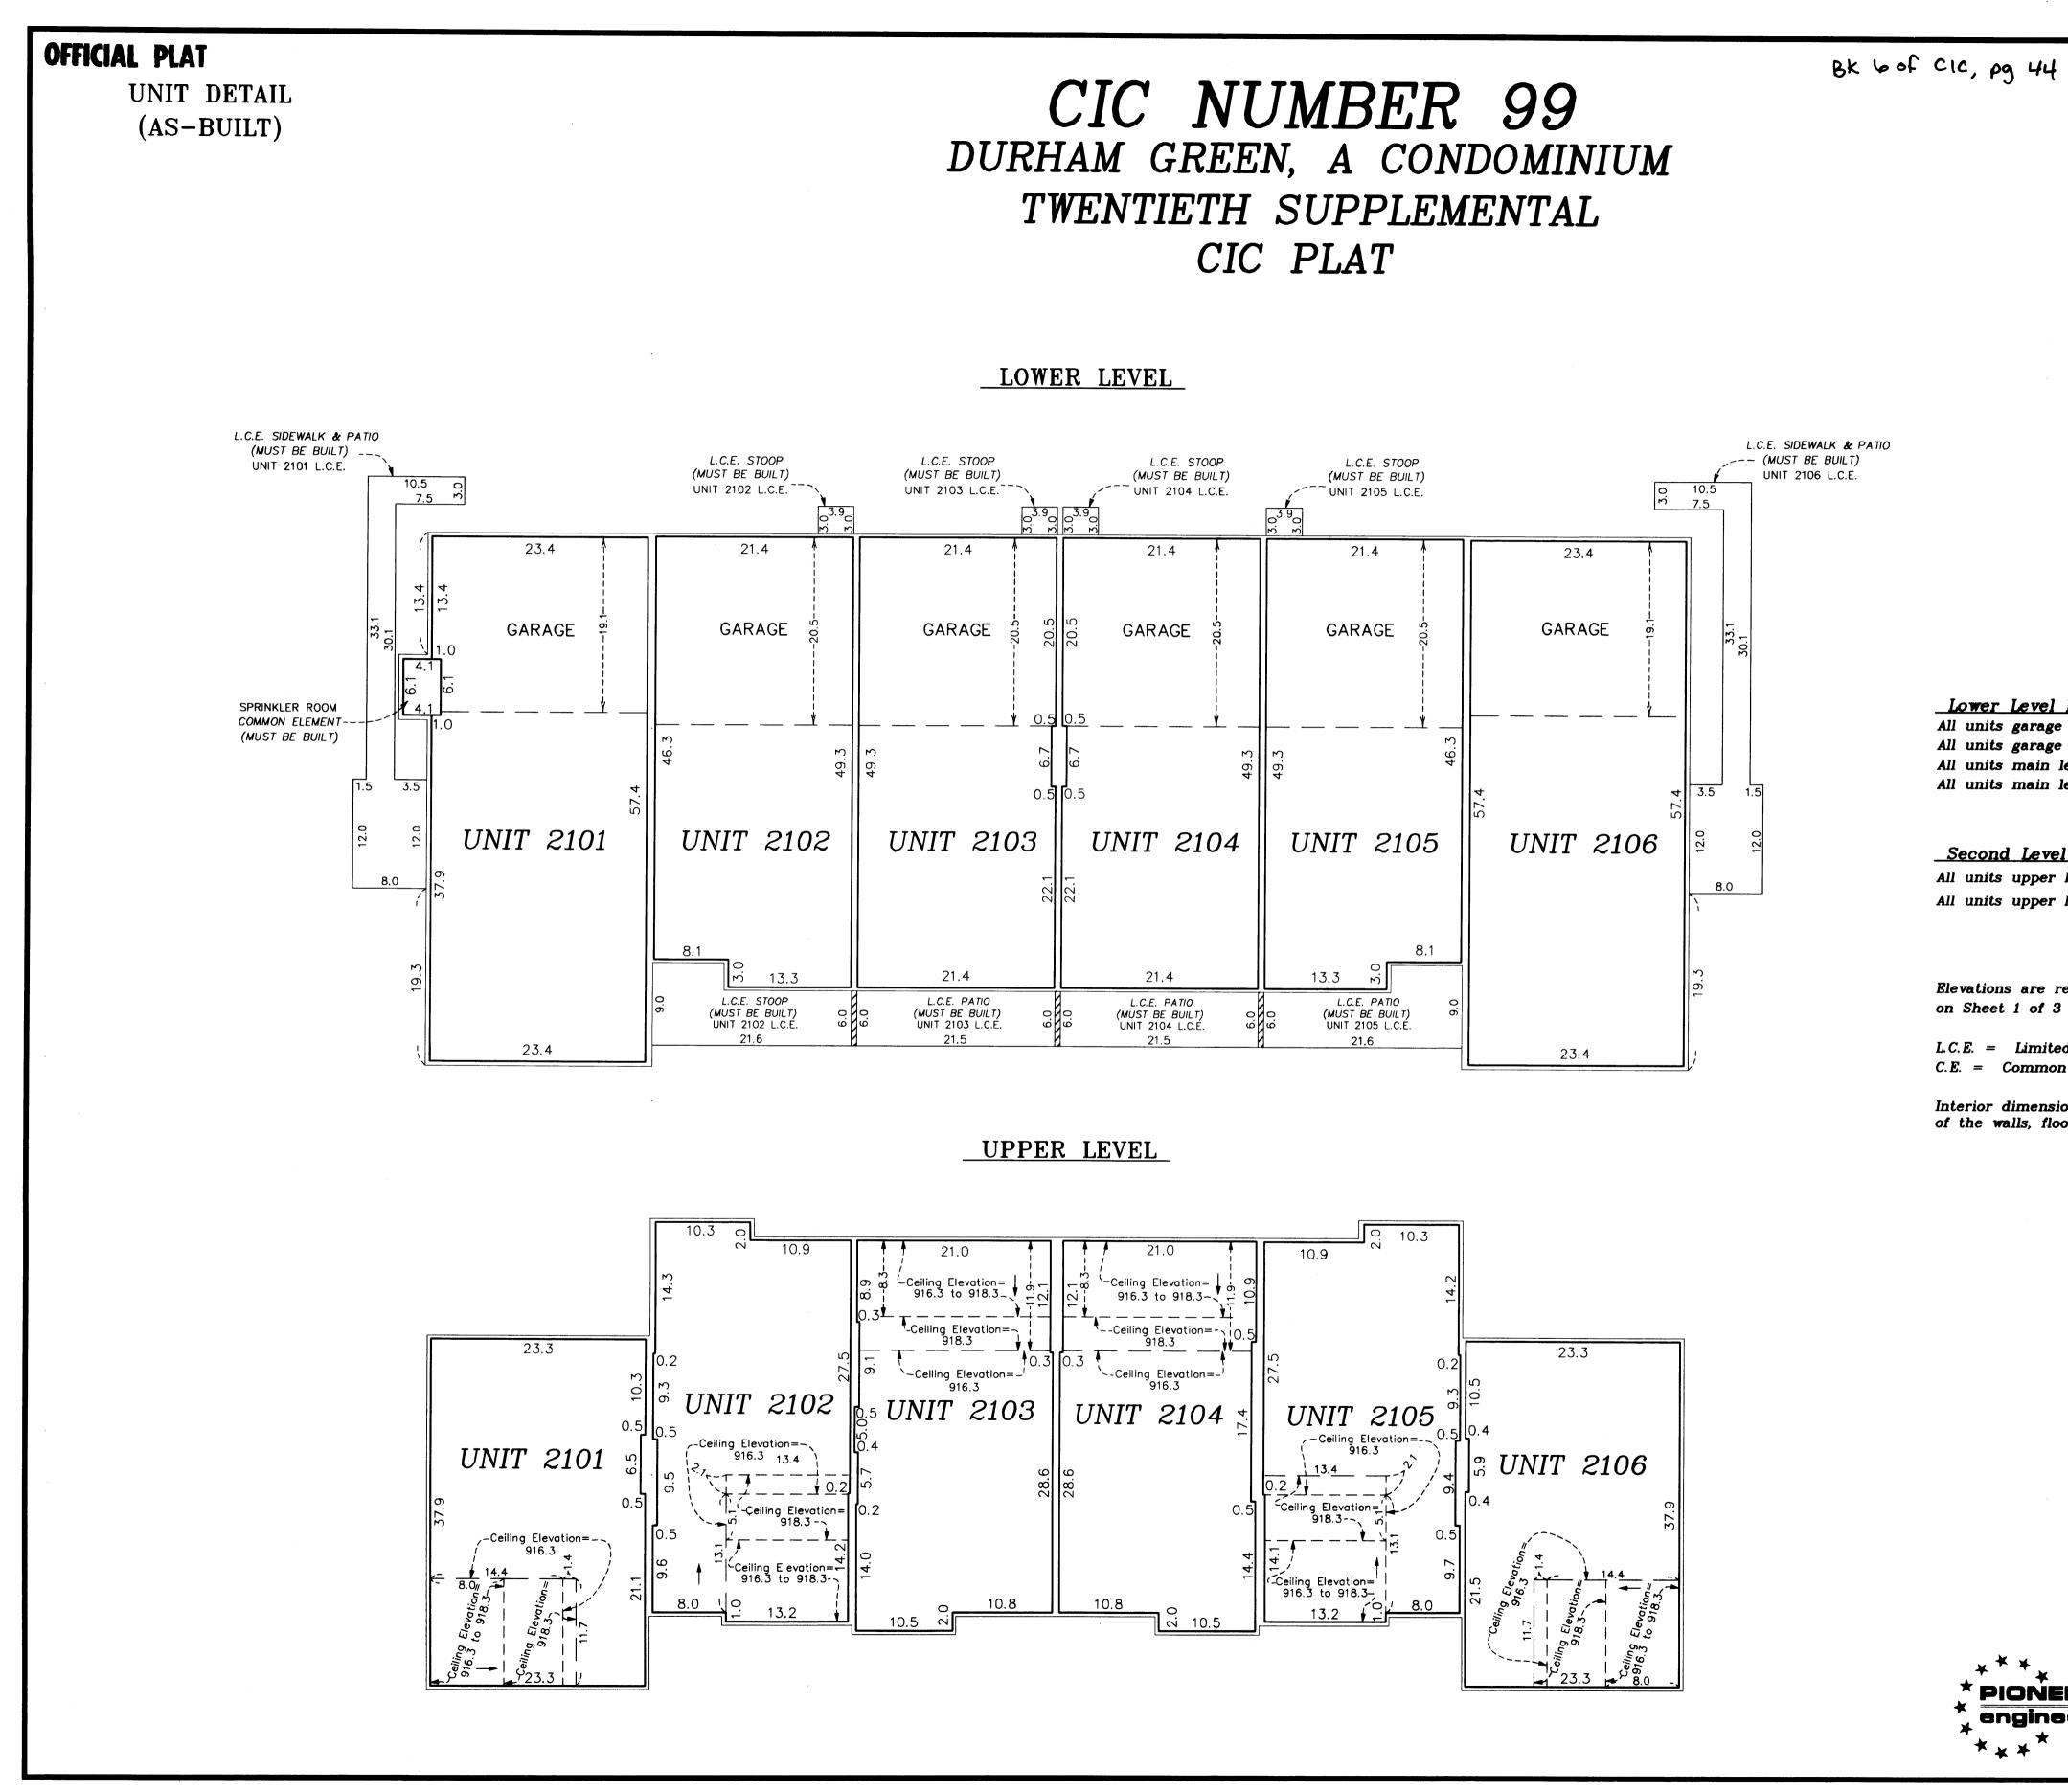

CR DOC. NO. 462278

CITY OF BLAINE COUNTY OF ANOKA SEC. 17, TWP. 31, RGE. 23


Lower Level Elevations All units garage floor elevation = 897.2 feet All units garage ceiling elevations = 906.7 feet All units main level floor elevations = 897.6 feet All units main level ceiling elevation = 906.7 feet

Second Level Elevations All units upper level floor elevation = 908.2 feet All units upper level ceiling elevation varies from 916.3 feet to 918.3 feet

Elevations are referred to a benchmark as noted on the site plan on Sheet 1 of 3 Sheets and are shown in feet and tenths of a foot.

L.C.E. = Limited Common Element C.E. = Common Element

Interior dimensions shown are measured to the unfinished surface of the walls, floors and ceiling

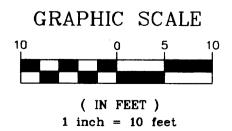

PIONEER engineering ****

LAND SURVEYORS . CIVIL ENGINEERS LAND PLANNERS . LANDSCAPE ARCHITECTS

2004049554 \$297.00

SHEET 3 OF 3 SHEETS