

1989900,001 UFFICE OF CUUNTY RECORDER STATE OF MINNESCTA, COUNTY OF ANOKA I hereby certify that the within instrument was filed in this office for record on the 21 December A.D., 2006 SITE PLAN 11:59 o'clock AM., and was duly recorded in book 7 Cond page 6 Maureen Q. Dervine County Recorder LBS I, Terrence E. Rothenbacher, hereby certify that the work was undertaken by or reviewed and approved by me for this First Amended Condominium Plat of Condominium Number 42, MOORE LAKE OFFICE PARK, being located upon: Office Units 101 through 106, inclusive, Condominium Number 42, MOORE LAKE OFFICE PARK, Anoka County, Minnesota. That, except for the naming and numbering conventions adopted by Anoka County for condominiums under Minnesota Statutes, Chapter 515A and for common interest communities under Minnesota Statutes, Chapter 515B, this First Amended Condominium Plat is an Amended C.I.C. Plat for all legal purposes; That this First Amended Condominium Plat does not affect the First Supplemental Condominium Plat nor the Second Supplemental Condominium Plat of Condominium Number 42, MOORE LAKE OFFICE PARK; and that this First Amended Condominium Plat fully and accurately depicts all information required by Minnesota Statutes, Section 515B.2-110. I HERESY CERTIFY THAT THE CURRENT AND Dated this 28th day of February 200 🕒 . DELINQUENT TAXES ON THE LANDS DESCRIEED WITHIN ARE PAID AND THE TRANSFER IS ENTERED Dec 21, 2006 MAUREEN J DEVINE Terrence E. Rothenbacher, Land Surveyor PROPERTY TAX ADMINISTRATOR Minnesota License No. 20595 Culuer DEPUTY PROPERTY TAX ADMINISTRATOR STATE OF MINNESOTA COUNTY OF ANOKA The foregoing certificate was acknowledged before me this _28th day of ______ Rothenbacher, a Licensed Professional Land Surveyor. CHRISTOPHER E SHARP NOTARY PUBLIC MY COMM. EXP. 01/31/2010 Notary Public, Anoka County, Minnesota 🖌 MY COMM. EXP. 01/31/2010 My Commission Expires January 31, 2010 245.60 ٢, () 14 Ĵ. <-٦> 2> $\langle \rangle$ LJ $\hat{\mathbf{x}}$ 22 \mathbf{O} \mathbb{C} NOR. () 22 -------22 ٦> <u>n</u>_ 245.60 N89°23'27"W LEGEND - Denotes existing powerpole Denotes existing hydrant BENCHMARK ----- Denotes existing wood fence Top nut of hydrant at Northwesterly • Denotes found capped iron monument **PI NEE** *Rengineering* end of Lot 1, Block 1, HERWAL 2ND marked with cap number 9051. ADDITION. O Denotes 1/2 inch by 14 inch iron monument set and marked with license number 20595. CIVIL ENGINEERS LAND PLANNERS LAND SURVEYORS LANDSCAPE ARCHITECTS Elevation= 888.0 (NGVD 1929)

Ô	C				DF	A T	
. 26	30	i internet	(원 등이 전	3 Ber	- E - E.	<i>i</i> ~3	

MOORE LAKE OFFICE PARK

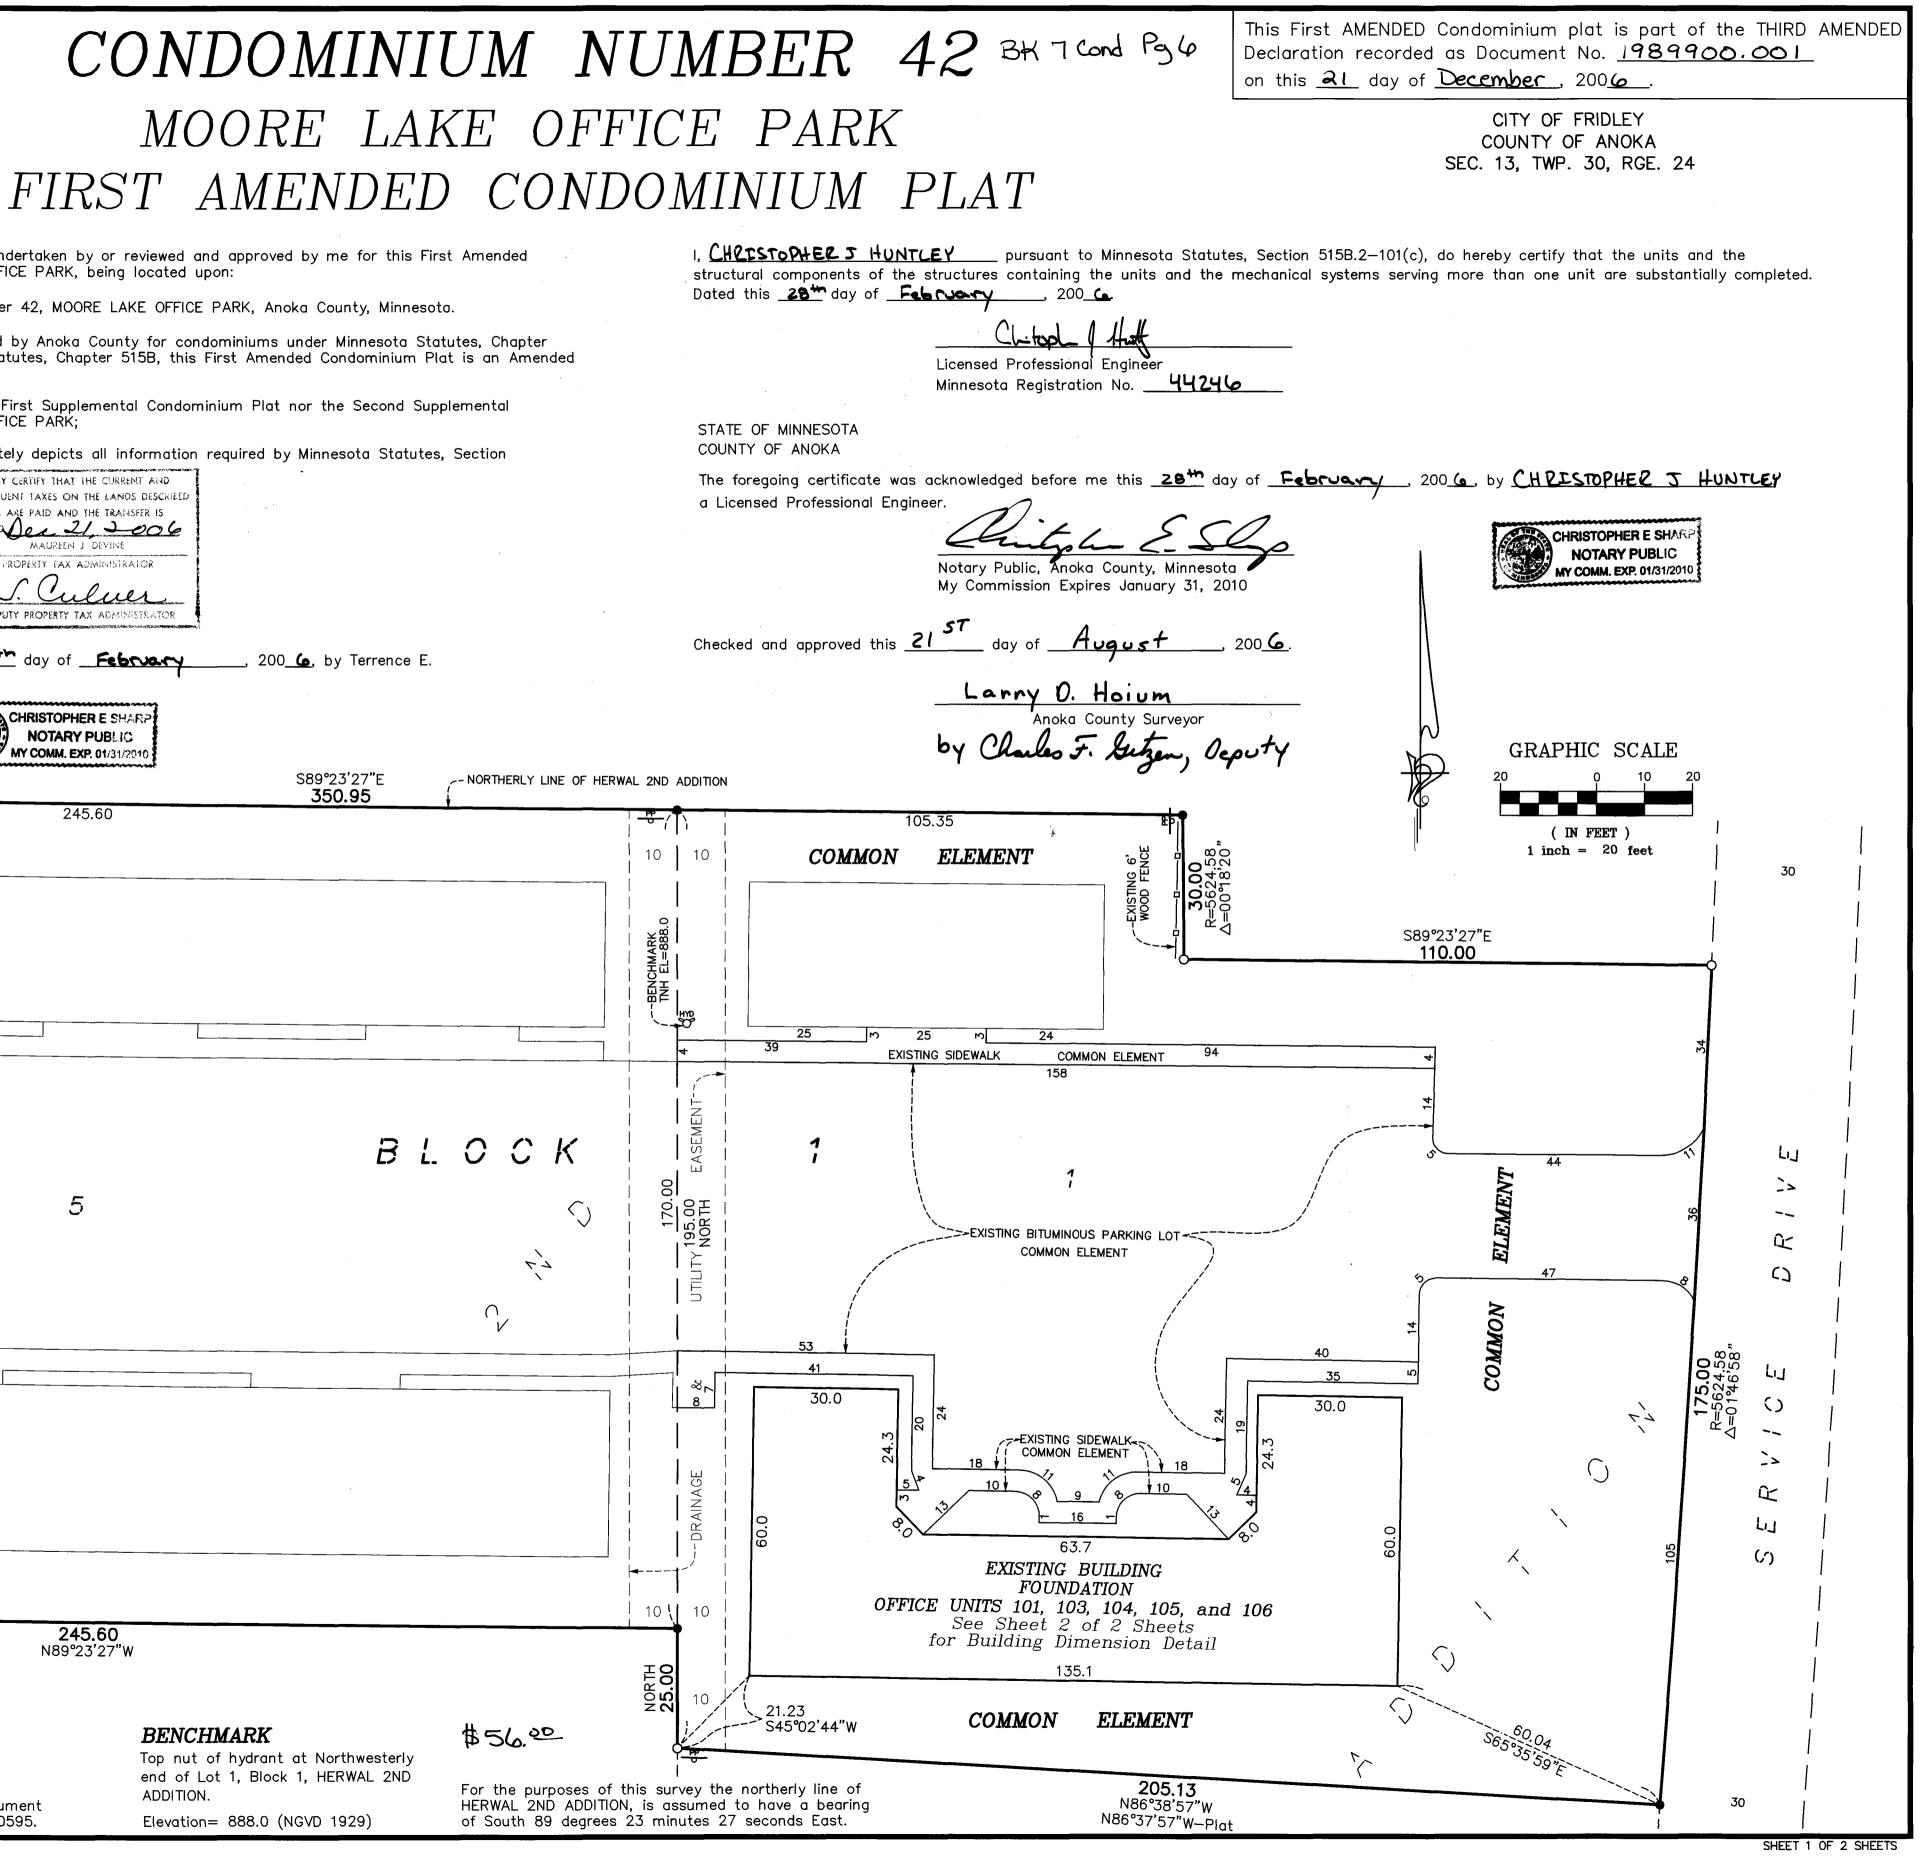

UNIT DETAIL (AS-BUILT)

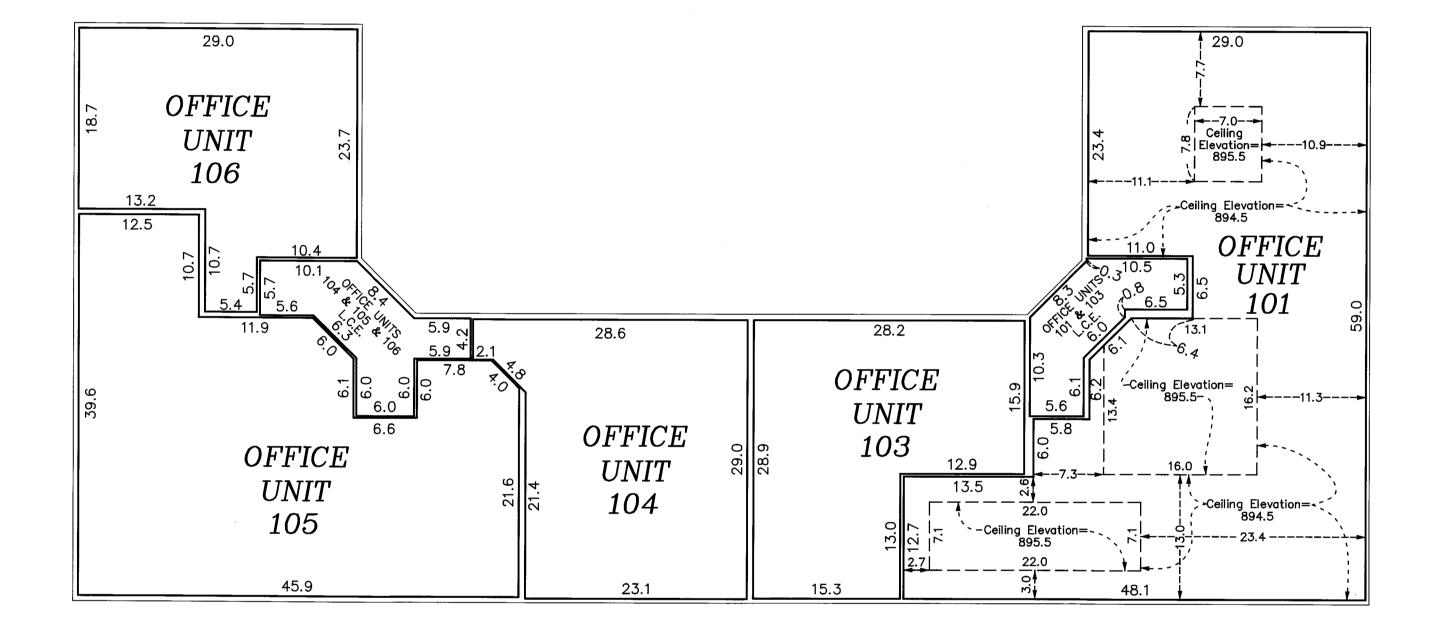

Interior Dimensions shown are measured to the unfinished surface of the walls, floors and ceilings.


L.C.E. Denotes Limited Common Element

Elevations are referenced to Benchmark as noted on sheet 1 of 2 sheets and are shown in feet and tenths of a foot.

Office Units 101, 103, 104, 105, and 106 floor elevations = 886.4 feet Office Unit 101 ceiling elevation varies from 894.5 feet to 895.5 feet as shown Office Units 103 thru 106 ceiling elevation = 894.5 feet



CONDOMINIUM NUMBER 42 MOORE LAKE OFFICE PARK FIRST AMENDED CONDOMINIUM PLAT

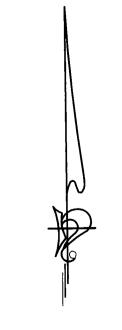

GRAPHIC SCALE (IN FEET) 1 Inch = 10 Feet

BK7 Cond Pale

CITY OF FRIDLEY COUNTY OF ANOKA SEC. 13, TWP. 30, RGE. 24