

CERTIFICATE OF LOCATION OF GOVERNMENT CORNER

County of Anoka

State of Minnesota



North 1/4 Corner of Sec. 6 Township 31 Range 24

On the 25th day of February, 1960, the described corner was evidenced by a 6"X6" granite monument

and to perpetuate the location of said corner, at the exact location thereof, a permanent marker was placed consisting of a position on a manhole cover with punch marks on the manhole rim to the North, South, East and West

AND on the 18th day of February, 2011, said permanent marker was not found. The manhole cover and rim appeared to have been replaced. Position was reestablished and ties were updated.

Updated reference ties are as shown below.

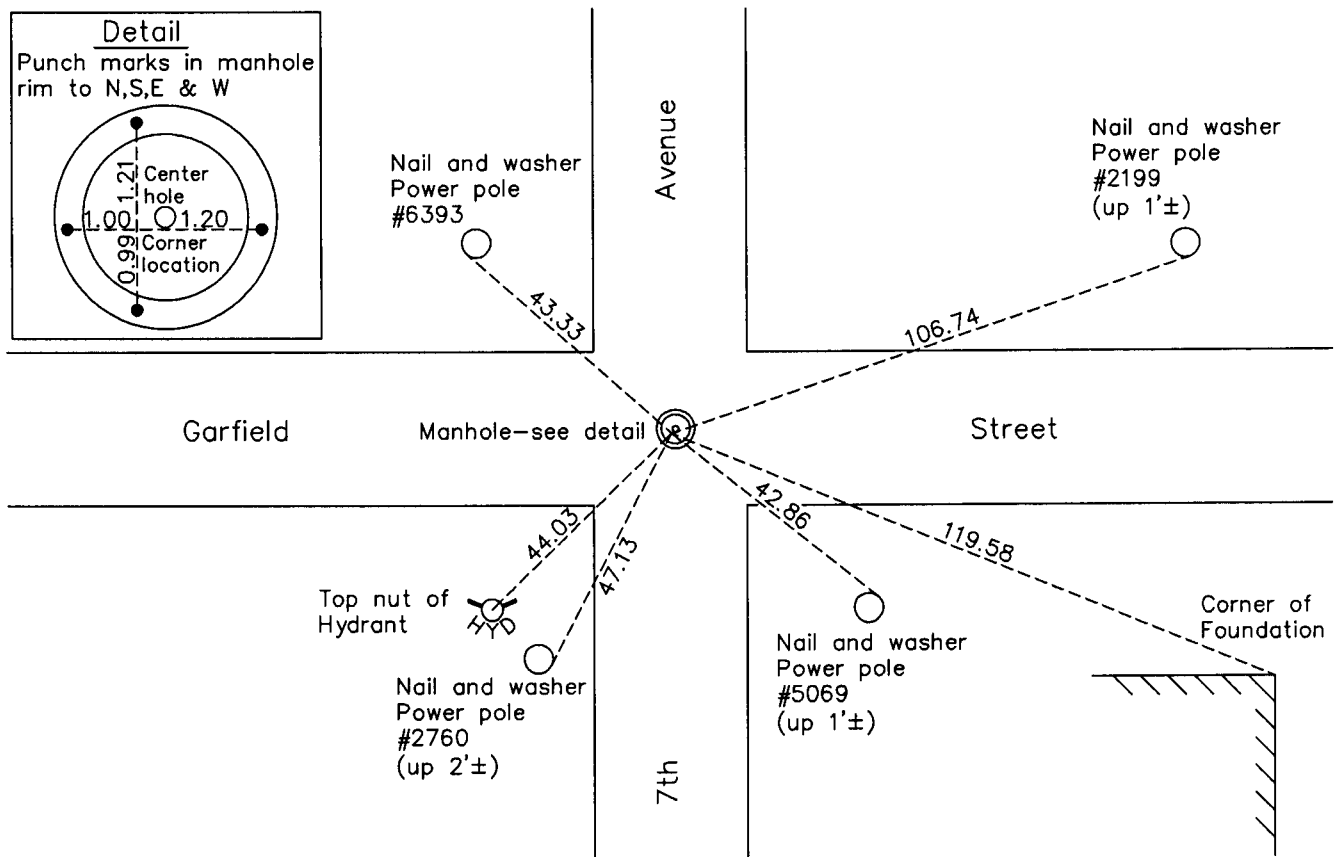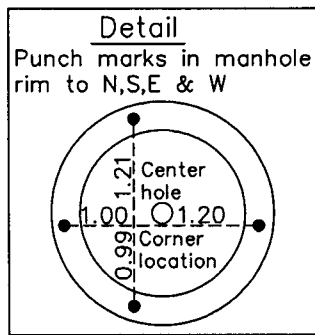

ANOKA COUNTY SURVEYOR

Revision Date 3/07/11

N.A.D. 1983 Coordinates
(1996 Adjustment)

County Project Coordinates	
Northing	164602.6481
Easting	471333.2348
Date	11/22/00

I hereby certify that this United States public land survey monument record is correct and complete to the best of my knowledge and belief.

Larry D. Hoium Date 3/07/11

Larry D. Hoium, Anoka County Surveyor
Minnesota License Number 18165

HISTORY OF GOVERNMENT CORNER

Page No. 12

County of Anoka

State of Minnesota

North 1/4 Corner of Sec. 6 Township 31 Range 24

CORNER HISTORY:

April 10, 1943 - Cartwright found 6"X6" granite monument down 14". Established ties to monument.

May 18, 1956 - W.J. Lundstrom found granite monument and updated ties.

February 17, 1960 - Found pinched iron pipe and updated ties.

February 25, 1960 - Found 6"X6" granite monument down 14" with a 3/4" iron pipe directly over center of monument. Updated ties.

November 28, 1960 - Updated ties and removed granite monument prior to sewer construction.

July 26, 1966 - Set location of corner on manhole after construction using ties. Set P.K. nails to the North, South, East and West and filed notches in rim of manhole. Updated ties.

August 17, 1967 - Found P.K. nails North, South, East and West and found that the file notches in rim were incorrect. Updated ties.

August 6, 1970 - Found P.K. nails North, South, East and West and updated ties.

July 5, 1974 - Found P.K. nails North, South, East and West and updated ties.

June 15, 1977 - Found P.K. nails North, South, East and West and updated ties.

July 14, 1980 - Found P.K. nails North, South, East and West and updated ties.

June 16, 1986 - Found P.K. nails North, South, East and West and updated ties.

October 28, 1988 - Found P.K. nails North, South, East and West and updated ties.

August 20, 1990 - Found P.K. nails North, South, East and West and updated ties.

August 22, 1994 - Found P.K. nails North, South, East and West and updated ties.

January 2, 1998 - Found evidence corner location missing. Reset position of corner on manhole and set punch marks in rim of manhole using resurvey. Updated ties.

November 22, 2000 - Found punch marks in rim of manhole and established NAD 1983 (1996 Adjustment) Anoka County Project Coordinates by Static GPS methods. Updated ties.

March 29, 2010 - Found evidence of corner location missing. Manhole cover and rim appeared to have been replaced. Position to be remarked.

February 18, 2011 - Reestablished corner location on manhole cover and updated ties. Verified location of corner by Static GPS methods.