

CERTIFICATE OF LOCATION OF GOVERNMENT CORNER

County of Anoka

State of Minnesota



South 1/4 Corner of Sec. 22 Township 31 Range 24

On the 26th day of July, 1960, the described corner was evidenced by a 3/8" hole in manhole cover

and to perpetuate the location of said corner, at the exact location thereof, a permanent marker was placed consisting of a position on a manhole cover with P.K. nails 2.0' South and West

AND on the 31st day of January, 2011, said permanent marker was not found. The manhole cover and rim appeared to have been turned. Position was reestablished and ties were updated.

Updated reference ties are as shown below.

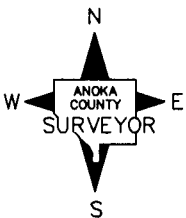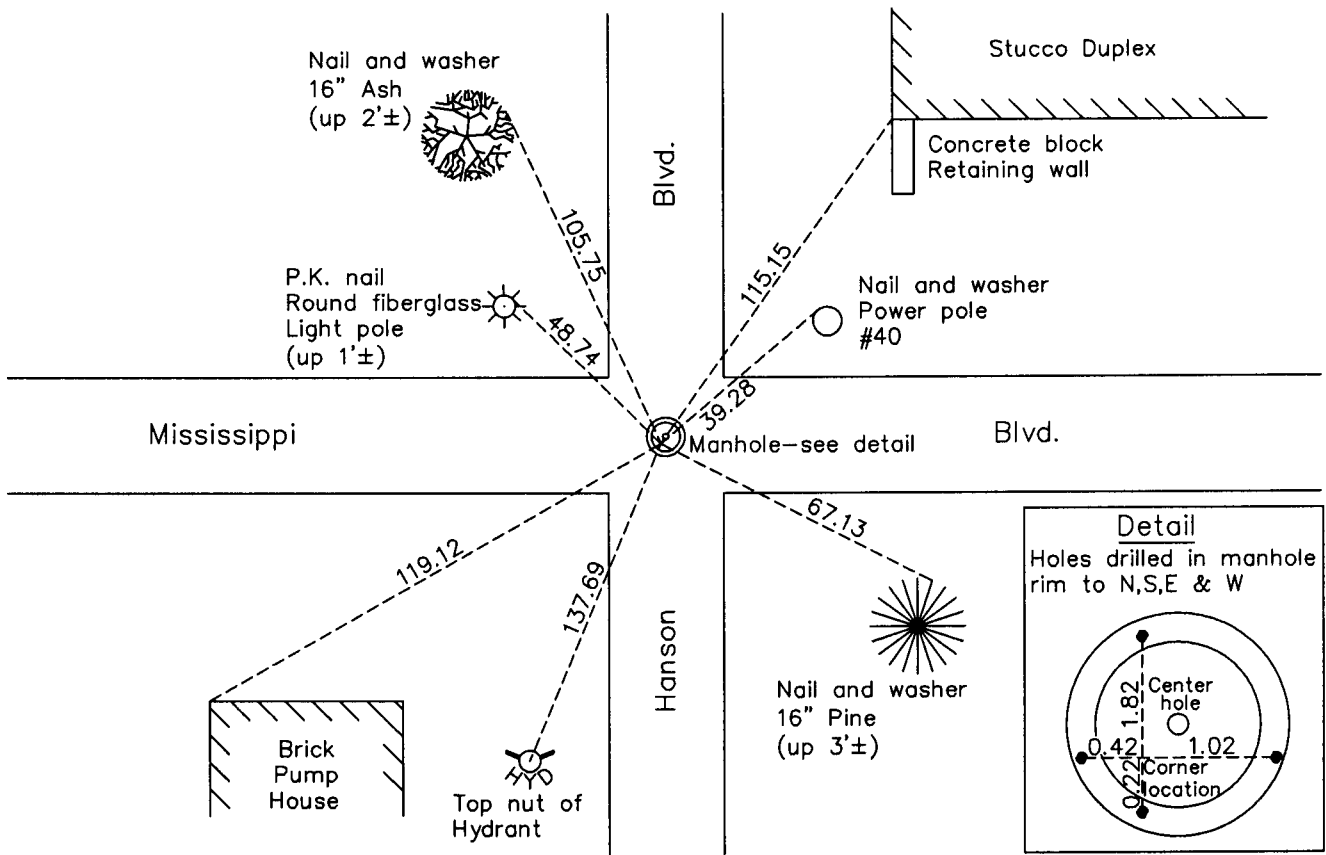

Revision Date

3/07/11

N.A.D. 1983 Coordinates
(1996 Adjustment)

County Project Coordinates	
Northing	143186.1974
Easting	486730.1055
Date	8/23/01

I hereby certify that this United States public land survey monument record is correct and complete to the best of my knowledge and belief.

Larry D. Hoium Date 3/07/11

Larry D. Hoium, Anoka County Surveyor

Minnesota License Number 18165

HISTORY OF GOVERNMENT CORNER

Page No. 83

County of Anoka

State of Minnesota

South 1/4 Corner of Sec. 22 Township 31 Range 24

CORNER HISTORY:

November 7, 1944 - H.A. Cartwright found concrete monument. Established ties to monument.

July 26, 1960 - Found iron pipe flush with the surface over the center of concrete monument down 12" with an iron pipe on north side flush with monument. Updated ties.

June 4, 1964 - Found iron pipe and concrete monument. Updated ties.

August 21, 1967 - Found iron pipe and concrete monument. Updated ties.

July 31, 1970 - Corner located at 3/8" hole drilled in manhole cover with P.K. nails set 2.00' north and west.

July 16, 1974 - Found location of corner on manhole cover and updated ties.

July 3, 1980 - Found location of corner on manhole cover and updated ties.

June 17, 1986 - Found location of corner on manhole cover and updated ties.

August 15, 1994 - Found location of corner on manhole cover and updated ties.

September 10, 1997 - Set construction ties prior to road construction.

October 10, 1997 - Reset position of corner on manhole cover after construction and set P.K. nails south and west. Updated ties.

August 23, 2001 - Reset position of corner on manhole cover and established NAD 1983 (1996 Adjustment) Anoka County Project Coordinates by Static GPS methods. Updated ties.

January 31, 2011 - Reset position of corner on manhole cover and updated ties.