

CERTIFICATE OF LOCATION OF GOVERNMENT CORNER

County of Anoka

State of Minnesota



West 1/4 Corner of Sec. 34 Township 31 Range 23

On the 13th day of November, 1964, the described corner was evidenced by area resurvey

and to perpetuate the location of said corner, at the exact location thereof, a permanent marker was placed consisting of a 'V' notch in the rim of a manhole with P.K. nails to the north and east

AND on the 8th day of July, 2014, said permanent marker was was not found, appears new manhole rim was installed. Replaced w/ a 1/2"X6" iron pipe w/ 'Anoka Co.' cap. Updated ties.

Updated reference ties are as shown below.

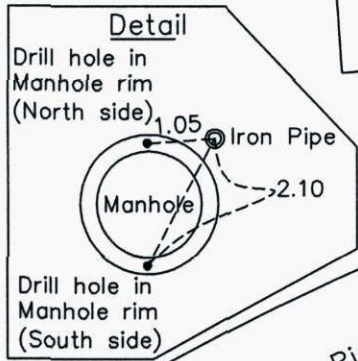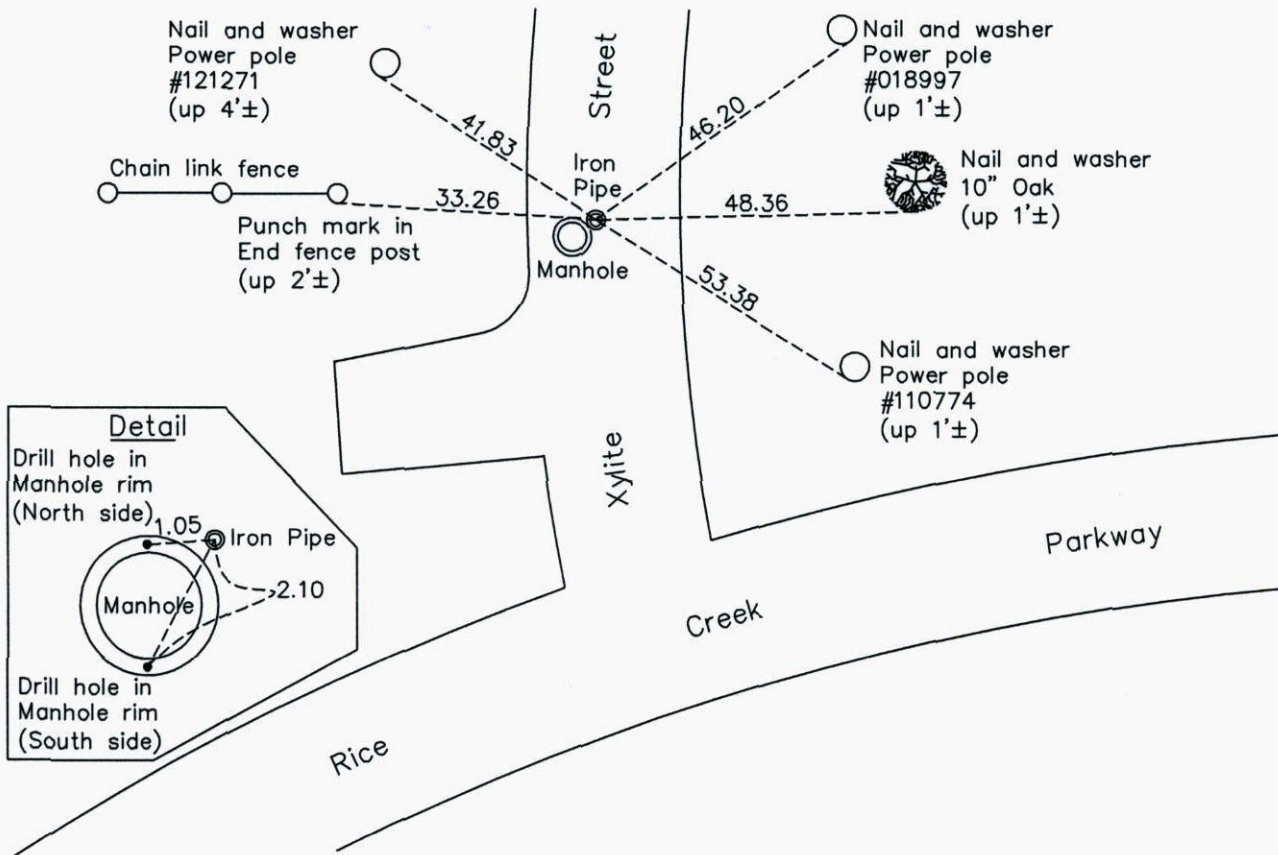

Revision Date
10/02/14

N.A.D. 1983 Coordinates
(1996 Adjustment)

County Project Coordinates	
Northing	<u>135166.4671</u>
Easting	<u>515961.0892</u>
Date	<u>7/29/99</u>

I hereby certify that this United States public land survey monument record is correct and complete to the best of my knowledge and belief.

Larry D. Hoium Date 10/02/14

Larry D. Hoium, Anoka County Surveyor
Minnesota License Number 18165