

CERTIFICATE OF LOCATION OF GOVERNMENT CORNER

County of Anoka

State of Minnesota



East 1/4 Corner of Sec. 27 Township 30 Range 24

On the ____ day of May, 1959, the described corner was evidenced by ties from
Suburban Engineering, Inc.

and to perpetuate the location of said corner, at the exact location thereof, a permanent marker was placed consisting of a position on a manhole cover with holes drilled in rim of manhole to
the North, South, East and West

AND on the 27th day of October, 2014, said permanent marker was found and the ties
were updated

Updated reference ties are as shown below.

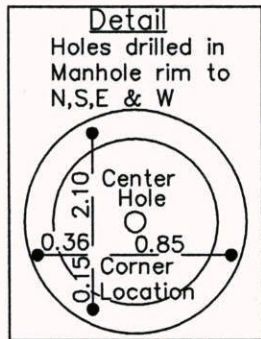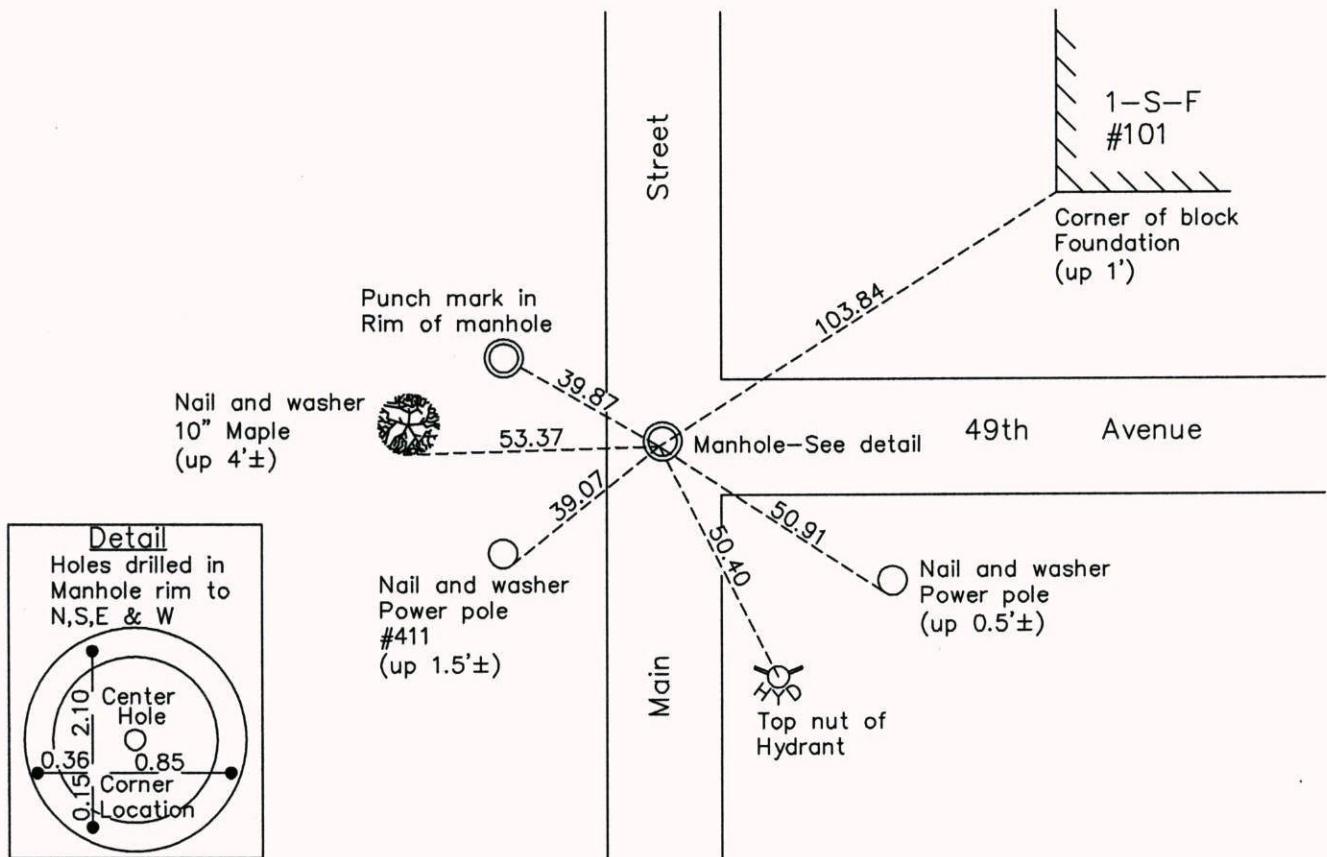

Revision Date
3/30/15

N.A.D. 1983 Coordinates
 (1996 Adjustment)

County Project Coordinates	
Northing	108005.9731
Easting	499651.7857
Date	7/15/04

I hereby certify that this United States public land survey monument record is correct and complete to the best of my knowledge and belief.

Larry D. Hoium Date 3/30/15

Larry D. Hoium, Anoka County Surveyor
 Minnesota License Number 18165