
	Page No. 87
CERTIFICATE OF LOCATION OF GOVERNMEN County of Anoka State of Minnesota	IT CORNER
East 1/4 Corner of Sec. <u>19</u> Township <u>32</u>	Range <u>25</u>
On the <u>8th</u> day of <u>January</u> , <u>1968</u> , the described corner was evidenced using area resurvey	by <u>a spike set</u>
and to perpetuate the location of said corner, at the exact location thereof, a was placed consisting of <u>a cast iron monument</u>	a permanent marker
AND on the <u>13th</u> day of <u>October</u> , <u>2015</u> , said permanent marker was <u>foun</u> the ties were updated	nd down 0.5' and
Updated reference ties are as shown below.	
Nail and washer Power pole #97114	Nail and washer Power pole #97115
(up 6.5'±) Path (bit)	(up 2.5'±)
-216.82 153rd 136.89 Avenue	(Alpine Dr)
Nail and washer 30" Boxelder Nail and washer Nail and washer	
(up 4'±)	

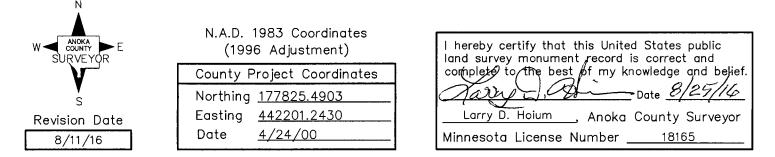

HISTORY OF GOVERNMENT CORNER

County of Anoka State of Minnesota

<u>East 1/4</u> Corner of Sec. <u>19</u> Township <u>32</u> Range <u>25</u>

CORNER HISTORY:

January 8, 1968 - Set spike using area resurvey and established ties to monument.

June 13, 1968 - Replaced spike with a cast iron monument and updated ties.

June 16, 1969 - Found cast iron monument and updated ties.

August 1, 1972 - Found cast iron monument and updated ties.

July 12, 1976 - Found cast iron monument and updated ties.

June 25, 1979 - Found cast iron monument and updated ties.

August 12, 1982 - Found cast iron monument and updated ties.

September 16, 1986 - Found cast iron monument and updated ties.

January 20, 1988 - Set construction ties and removed cast iron monument prior to road construction.

June 13, 1988 - Set cast iron monument after road construction using construction ties.

August 11, 1993 - Found cast iron monument and updated ties.

April 24, 2000 - Found cast iron monument and established NAD 1983 (1996 Adjustment) Anoka County Project Coordinates by Static GPS methods. Updated ties.

April 13, 2010 - Found cast iron monument down 0.5'± and updated ties.

October 13, 2015 - Found cast iron monument down 0.5'± and updated ties.