

CERTIFICATE OF LOCATION OF GOVERNMENT CORNER

County of Anoka

State of Minnesota


South 1/4 Corner of Sec. 22 Township 32 Range 23

On the 23rd day of August, 1966, the described corner was evidenced by area resurvey

and to perpetuate the location of said corner, at the exact location thereof, a permanent marker was placed consisting of a cast iron monument with a sign and post on the north side of monument.

AND on the 6th day of April, 2021, said permanent marker was found down 2'± and the ties were updated.

Updated reference ties are as shown below.

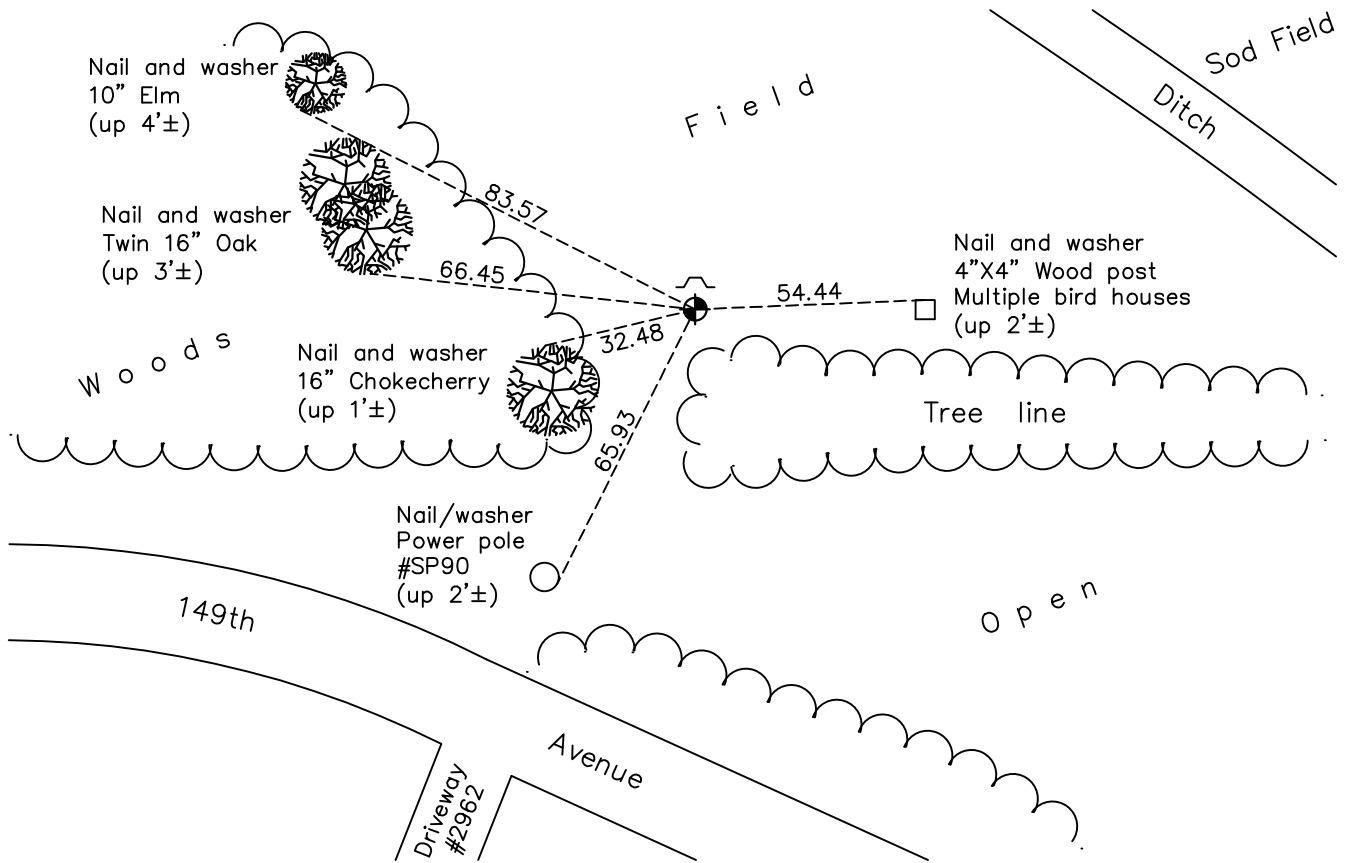

Revision Date
7/23/2021

N.A.D. 1983 Coordinates
(1996 Adjustment)

County Project Coordinates	
Northing	<u>174787.3126</u>
Easting	<u>518815.4426</u>
Date	<u>2/11/02</u>

I hereby certify that this United States public land survey monument record is correct and complete to the best of my knowledge and belief.

David Zieglmeier Date 7/21/22

David Zieglmeier Anoka County Surveyor
Minnesota License Number 46179

HISTORY OF GOVERNMENT CORNER

Page No. 94

County of Anoka

State of Minnesota

South 1/4 Corner of Sec. 22 Township 32 Range 23

CORNER HISTORY:

February 1855 - This corner was established by Hiram Taylor, Deputy Surveyor. Taylor marked the position by "Set quarter section post" with one bearing tree marked as an accessory.

August 23, 1966 - Set cast iron monument down 0.2'± using area resurvey. Established ties to monument.

May 5, 1971 - Found cast iron monument and updated ties.

June 23, 1975 - Found cast iron monument and updated ties.

June 16, 1978 - Found cast iron monument and updated ties.

July 13, 1984 - Found cast iron monument down 1.2'± and updated ties.

August 6, 1993 - Reset cast iron monument down 2'± using area resurvey and power pole tie. Updated ties.

August 22, 1996 - Found cast iron monument and updated ties.

February 11, 2002 - Found cast iron monument down 2'± and updated ties. Established NAD 1983 (1996 adj.) Anoka County project coordinates by static GPS methods.

March 21, 2011 - Found cast iron monument down 2'± and updated ties. Set sign and post on the north side.

March 22, 2017 - Found cast iron monument down 2'± and updated ties.

April 6, 2021 - Found cast iron monument down 2'± and updated ties.