
CERTIFICATE OF LOCATION OF GOVERNMENT CORNER County of Anoka State of Minnesota
South 1/4 Corner of Sec. <u>34</u> Township <u>31</u> Range <u>22</u>
On the <u>6th</u> day of <u>February</u> , <u>1964</u> , the described corner was evidenced by <u>a 3/4" iron</u>
and to perpetuate the location of said corner, at the exact location thereof, a permanent marker was placed consisting of <u>a cast iron monument with a sign and post on the southeast side</u>
AND on the <u>1st</u> day of <u>June</u> , <u>2021</u> , said permanent marker was <u>found and the ties</u> were updated
Updated reference ties are as shown below.
County Lift Station w/ concrete pad

INDEX 941

Page No. 144

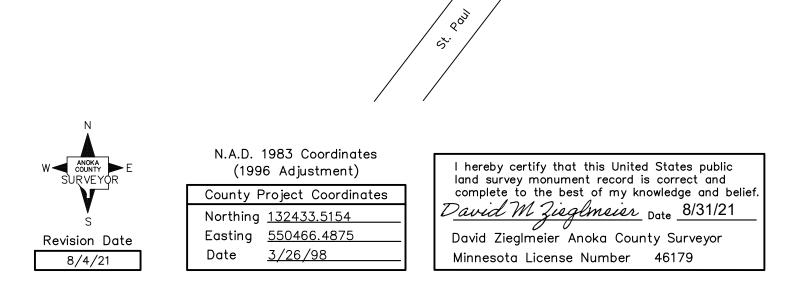

1/2" Drill Hole in concrete culvert

Page No. 144

HISTORY OF GOVERNMENT CORNER

County of Anoka

State of Minnesota

<u>South 1/4</u>Corner of Sec. <u>34</u>Township <u>31</u>Range <u>22</u>

CORNER HISTORY:

Date Unknown - Milner W. Carley established ties to monument.

February 6, 1964 - Found 3/4" Iron Pipe flush with the surface using Carley's one remaining tie. The M.C. 67.67 west was not found. Updated ties.

June 16, 1965 - Found Iron Pipe and updated ties.

August 29, 1969 - Found Iron Pipe and updated ties.

July 3, 1973 - Found Iron Pipe and updated ties.

June 8, 1977 - Found Iron Pipe and updated ties.

July 9, 1986 — Found Cast Iron Monument with sign and post on the southeast side of monument and updated ties.

October 22, 1991 - Found Cast Iron Monument and updated ties.

June 25, 1996 - Found Cast Iron Monument and updated ties.

March 26, 1998 — Found Cast Iron Monument and established NAD 1983 (1996 Adjustment) Anoka County Project Coordinates by Static GPS methods. Updated ties.

June 25, 1996 - Found Cast Iron Monument and updated ties.

March 26, 1998 - Found Cast Iron Monument and updated ties.

August 12, 2010 - Dug down $3'\pm$. Was unable to find cast iron monument.

March 24, 2011 — Found Cast Iron Monument and updated ties. Verified location of corner by Static GPS methods.

April 5, 2011 - Found Cast Iron Monument down $4.5'\pm$ with sign and post on the southeast side up $2'\pm$. Set additional Cast Iron Monument on top of lower Cast Iron Monument and updated ties. Verified location of corner by VRS GPS methods.

December 19, 2016 — Found Cast Iron Monument and updated ties. Verified location of corner by VRS GPS methods. Sign and post were missing.

June 1, 2021 — Found Cast Iron Monument and updated ties. Verified location of corner by VRS GPS methods. Replaced sign and post on SE. side.