

# CERTIFICATE OF LOCATION OF GOVERNMENT CORNER

County of Anoka

State of Minnesota



## West 1/4 Corner of Sec. 10 Township 33 Range 24

On the 23rd day of August, 1960, the described corner was evidenced by a concrete monument

and to perpetuate the location of said corner, at the exact location thereof, a permanent marker was placed consisting of a red and white iron pipe with a sign attached

AND on the 10th day of November, 2011, said permanent marker was found and the ties were updated

Updated reference ties are as shown below.

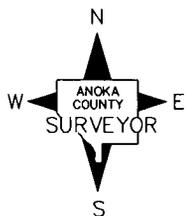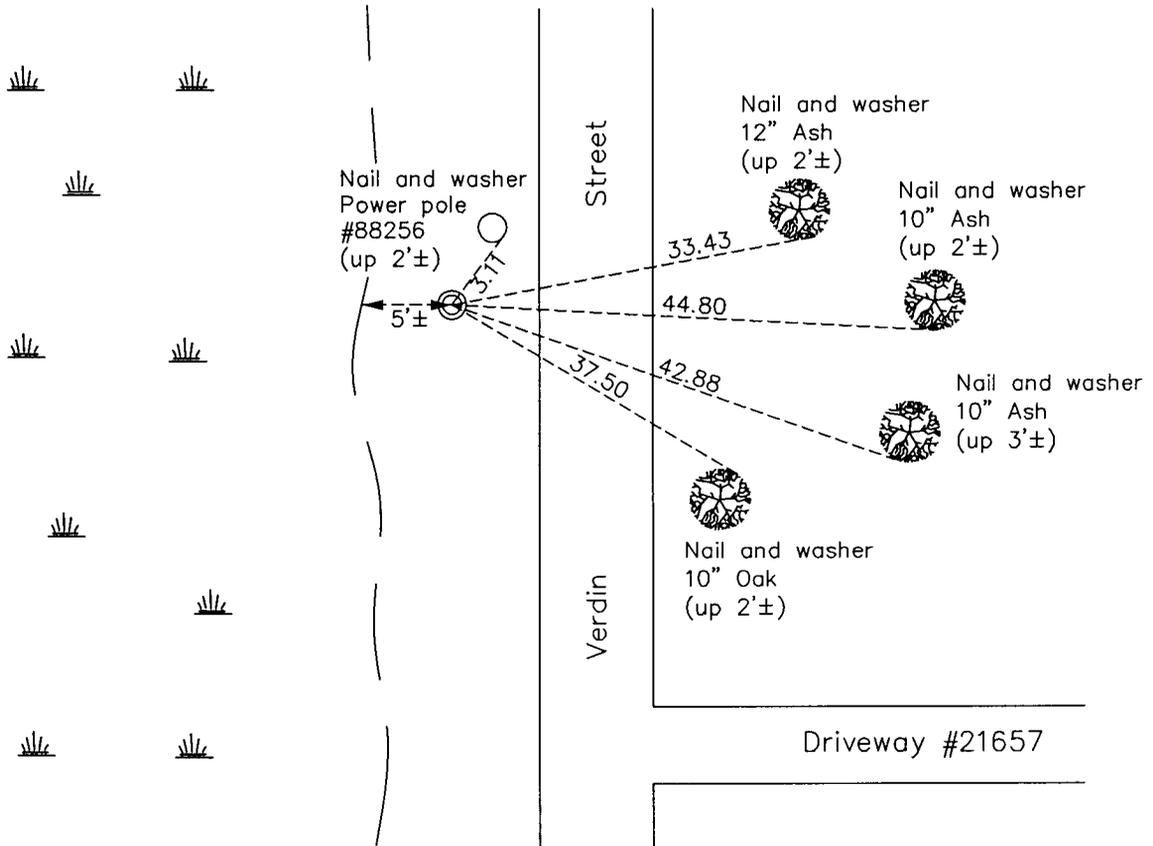

N.A.D. 1983 Coordinates  
(1996 Adjustment)

County Project Coordinates	
Northing	<u>219548.7001</u>
Easting	<u>484448.2449</u>
Date	<u>5/10/01</u>

Revision Date  
6/08/12

I hereby certify that this United States public land survey monument record is correct and complete to the best of my knowledge and belief.

*Larry D. Hoium* Date 6/08/12

Larry D. Hoium, Anoka County Surveyor  
 Minnesota License Number 18165