

CERTIFICATE OF LOCATION OF GOVERNMENT CORNER

County of Anoka

State of Minnesota



Meander Corner of Sec. 10 Township 33 Range 24
 (on south line of SW1/4)

On the 3rd day of December, 1963, the described corner was evidenced by a concrete
monument

and to perpetuate the location of said corner, at the exact location thereof, a permanent marker
 was placed consisting of a cast iron monument

AND on the 12th day of September, 2011, said permanent marker was found and the ties
were updated. On April 6, 2012 a sign and post was set on the north side.

Updated reference ties are as shown below.

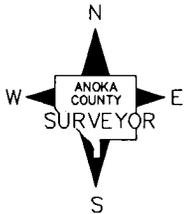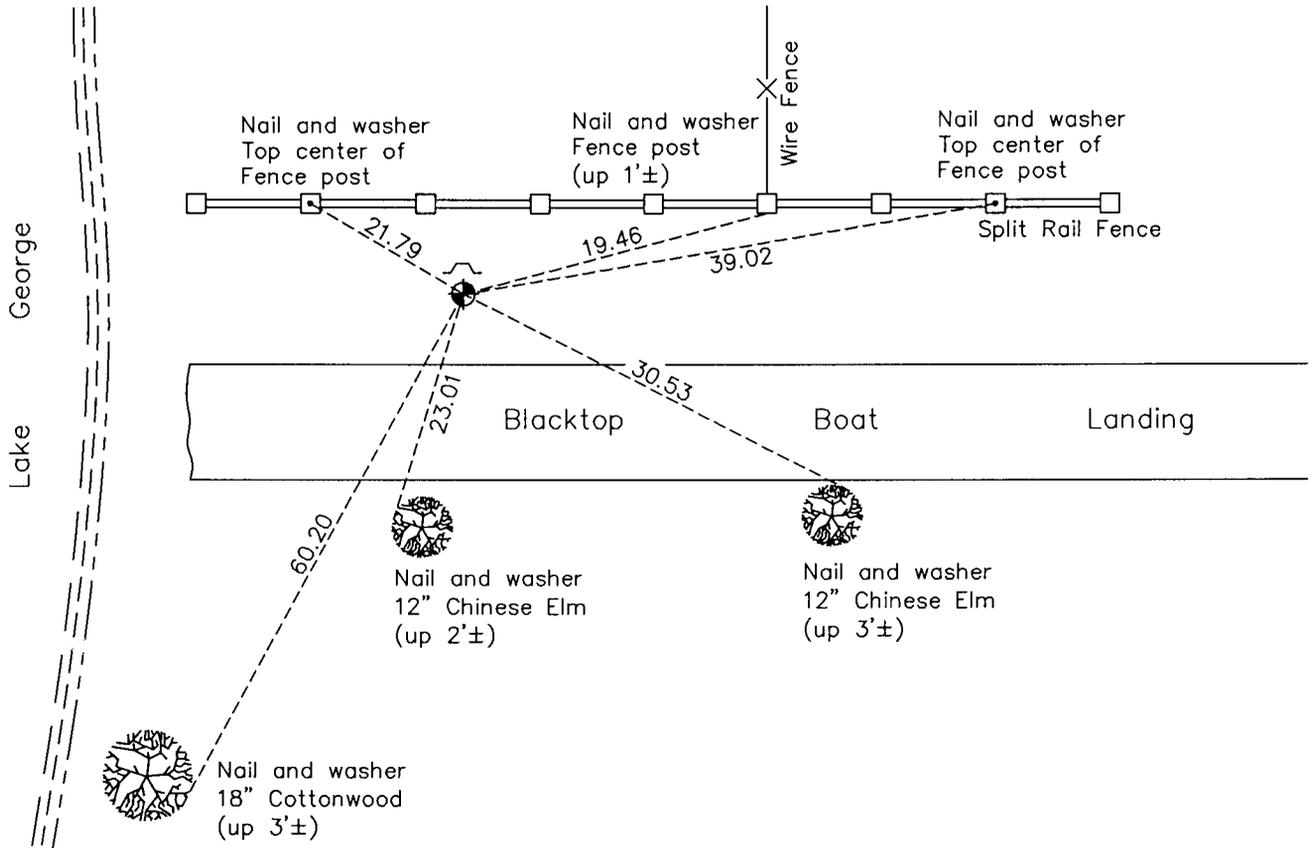

Revision Date
 6/11/12

N.A.D. 1983 Coordinates
 (1996 Adjustment)

County Project Coordinates	
Northing	216904.4114
Easting	484936.9887
Date	5/14/01

I hereby certify that this United States public land survey monument record is correct and complete to the best of my knowledge and belief.
Larry D. Hoium Date 6/11/12
 Larry D. Hoium, Anoka County Surveyor
 Minnesota License Number 18165