

# CERTIFICATE OF LOCATION OF GOVERNMENT CORNER

County of Anoka

State of Minnesota



## East 1/4 Corner of Sec. 1 Township 33 Range 23

On the 27th day of March, 1974, the described corner was evidenced by area resurvey

and to perpetuate the location of said corner, at the exact location thereof, a permanent marker was placed consisting of a cast iron monument with a sign and post on the north side

AND on the 14th day of January, 2013, said permanent marker was found and the ties were updated

Updated reference ties are as shown below.

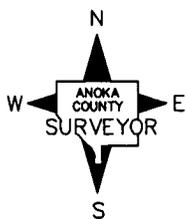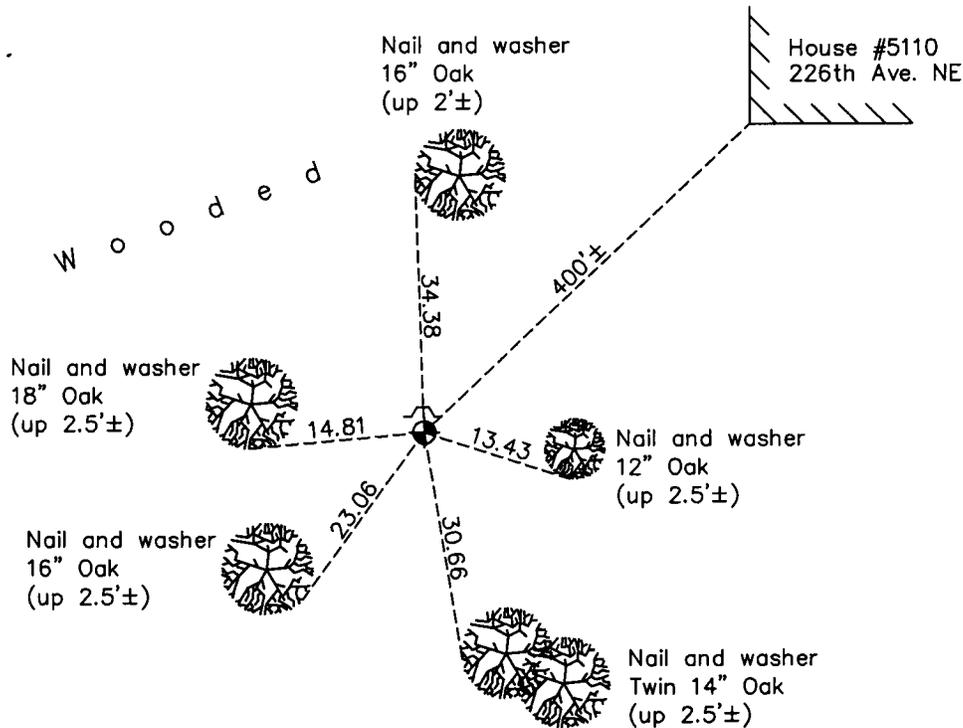

Revision Date

4/17/13

N.A.D. 1983 Coordinates  
(1996 Adjustment)

County Project Coordinates

Northing 224691.5182

Easting 531757.6353

Date 3/03/03

I hereby certify that this United States public land survey monument record is correct and complete to the best of my knowledge and belief.

*Larry D. Hoium* Date 4/17/13

Larry D. Hoium, Anoka County Surveyor

Minnesota License Number 18165