

CERTIFICATE OF LOCATION OF GOVERNMENT CORNER

County of Anoka

State of Minnesota



South 1/4 Corner of Sec. 29 Township 33 Range 23

On the 15th day of April, 1963, the described corner was evidenced by a P.K. nail

and to perpetuate the location of said corner, at the exact location thereof, a permanent marker was placed consisting of a cast iron monument

AND on the 14th day of September, 2006, said permanent marker was found broken and replaced with a new cast iron monument and the ties were updated

Updated reference ties are as shown below.

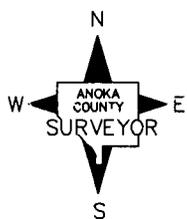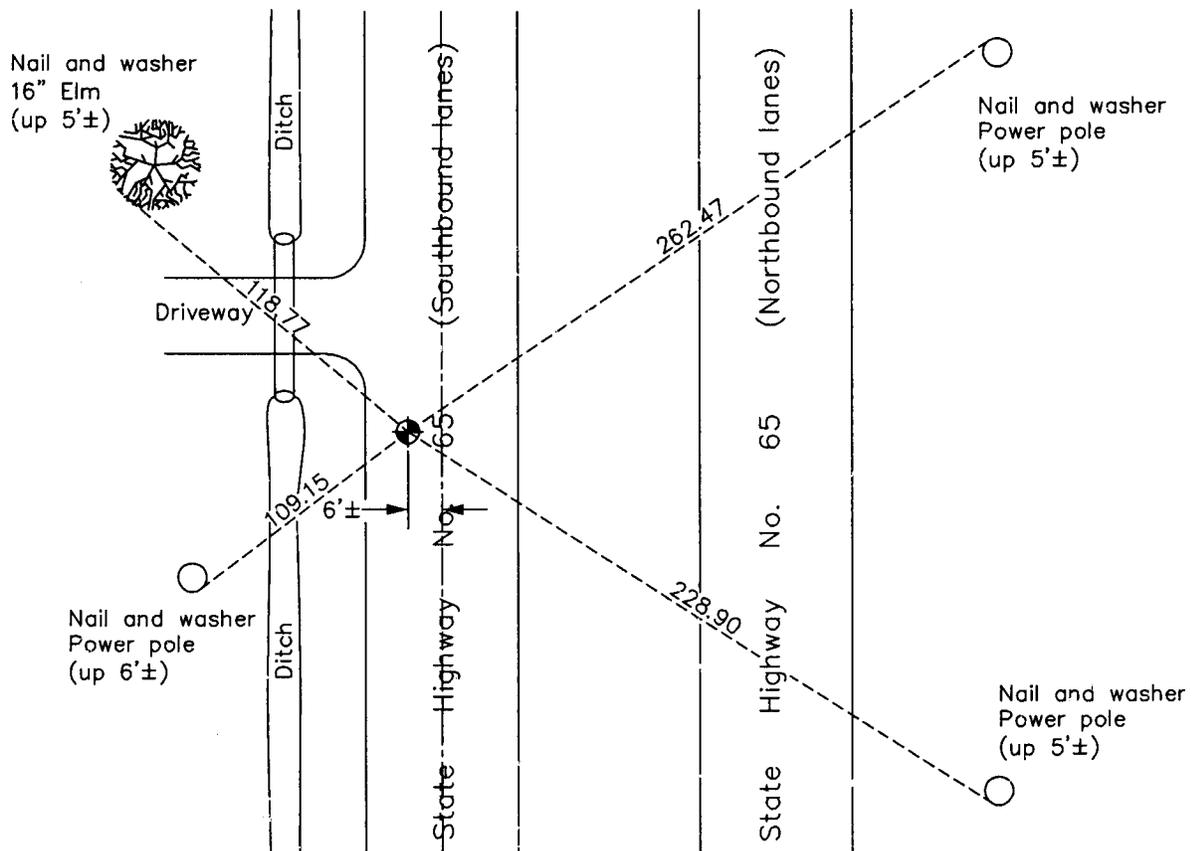

Revision Date

9/09/13

N.A.D. 1983 Coordinates
(1996 Adjustment)

County Project Coordinates

Northing 201054.3959

Easting 507925.9308

Date 9/14/06

I hereby certify that this United States public land survey monument record is correct and complete to the best of my knowledge and belief.

Larry D. Hoium Date 9/09/13

Larry D. Hoium, Anoka County Surveyor

Minnesota License Number 18165