

# CERTIFICATE OF LOCATION OF GOVERNMENT CORNER

County of Anoka

State of Minnesota



## North $\frac{1}{4}$ Corner of Sec. 27 Township 34 Range 23

On the 16th day of December, 1976, the described corner was evidenced by area resurvey

and to perpetuate the location of said corner, at the exact location thereof, a permanent marker was placed consisting of a cast iron monument with a sign and post on the north side

AND on the 26th day of December, 2012, said permanent marker was found and the ties  
were updated

Updated reference ties are as shown below.

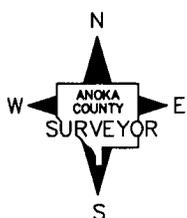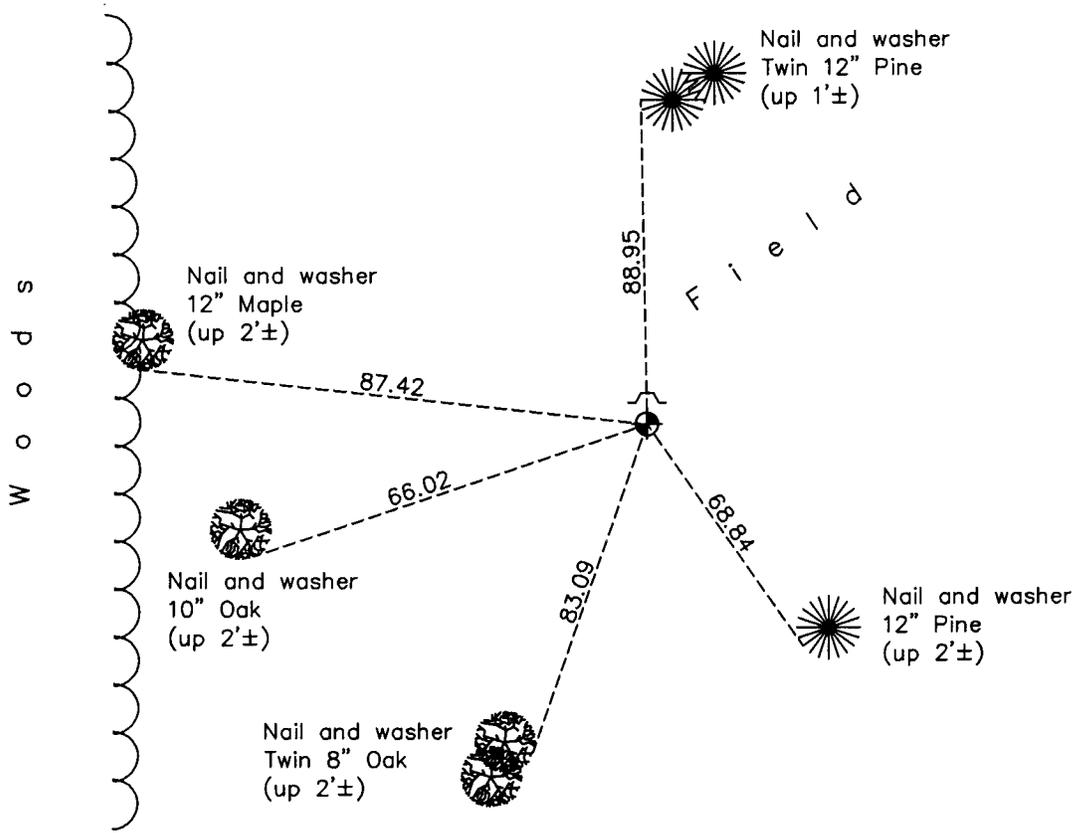

Revision Date

3/14/13

N.A.D. 1983 Coordinates  
(1996 Adjustment)

County Project Coordinates	
Northing	238177.5884
Easting	518699.5976
Date	4/03/03

I hereby certify that this United States public land survey monument record is correct and complete to the best of my knowledge and belief.

*Larry D. Hoium* Date 3/14/13

Larry D. Hoium, Anoka County Surveyor

Minnesota License Number 18165