

CERTIFICATE OF LOCATION OF GOVERNMENT CORNER

County of Anoka State of Minnesota


Northwest Corner of Sec. 28 Township 34 Range 23

On the 15th day of April, 1976, the described corner was evidenced by a concrete monument with an iron pipe on the north side

and to perpetuate the location of said corner, at the exact location thereof, a permanent marker was placed consisting of a cast iron monument

AND on the 26th day of October, 2012, said permanent marker was found down 0.2'± and the ties were updated

Updated reference ties are as shown below.

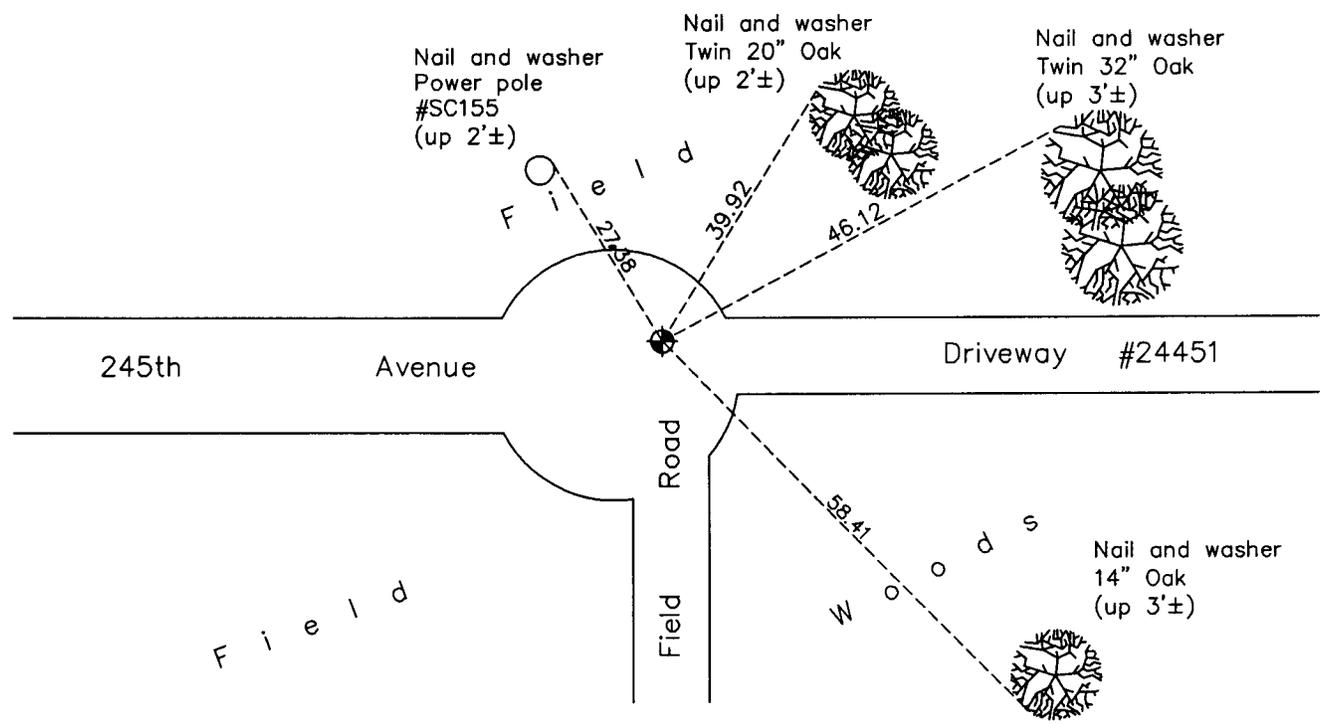

N
W ANOKA COUNTY SURVEYOR E
S

Revision Date
3/19/13

N.A.D. 1983 Coordinates
(1996 Adjustment)

County Project Coordinates	
Northing	<u>238033.6752</u>
Easting	<u>510743.3627</u>
Date	<u>3/27/03</u>

I hereby certify that this United States public land survey monument record is correct and complete to the best of my knowledge and belief.

Larry D. Hoium Date 3/19/13
 Larry D. Hoium, Anoka County Surveyor
 Minnesota License Number 18165