

CERTIFICATE OF LOCATION OF GOVERNMENT CORNER

County of Anoka

State of Minnesota


Northwest Corner of Sec. 30 Township 34 Range 23

On the 27th day of December, 1966, the described corner was evidenced by area resurvey

and to perpetuate the location of said corner, at the exact location thereof, a permanent marker was placed consisting of a cast iron monument with a sign and post on the south side

AND on the 7th day of December, 2012, said permanent marker was found up 0.3'± and the ties were updated

Updated reference ties are as shown below.

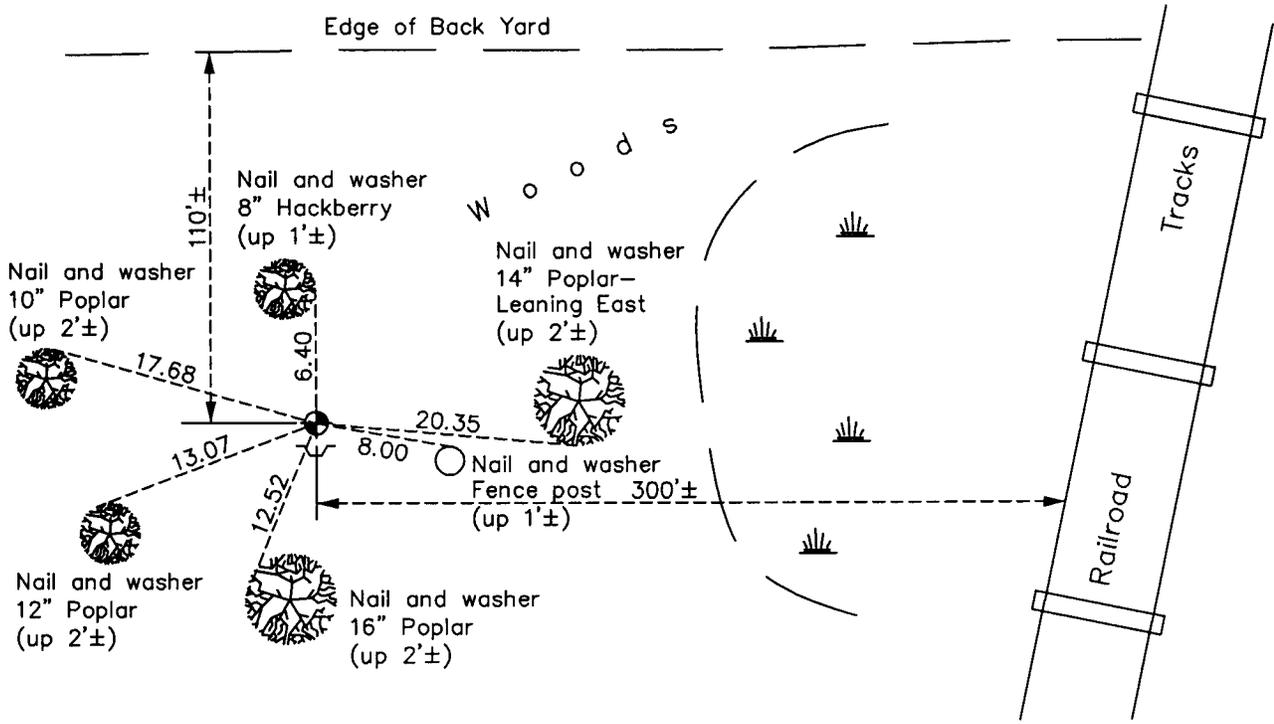

N

S

W ANOKA COUNTY SURVEYOR E

Revision Date

3/19/13

N.A.D. 1983 Coordinates
(1996 Adjustment)

County Project Coordinates	
Northing	237979.8104
Easting	500330.8591
Date	5/20/02

I hereby certify that this United States public land survey monument record is correct and complete to the best of my knowledge and belief.

Larry D. Hoium Date 3/19/13

Larry D. Hoium, Anoka County Surveyor

Minnesota License Number 18165