

CERTIFICATE OF LOCATION OF GOVERNMENT CORNER

County of Anoka

State of Minnesota



South 1/4 Corner of Sec. 27 Township 34 Range 23

On the 30th day of August, 1976, the described corner was evidenced by a 3/4" iron pipe

and to perpetuate the location of said corner, at the exact location thereof, a permanent marker was placed consisting of a red and white iron pipe

AND on the 26th day of October, 2012, said permanent marker was found up 2'± and with a sign attached facing South. Ties were updated.

Updated reference ties are as shown below.

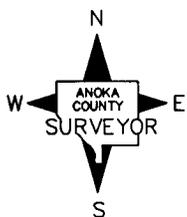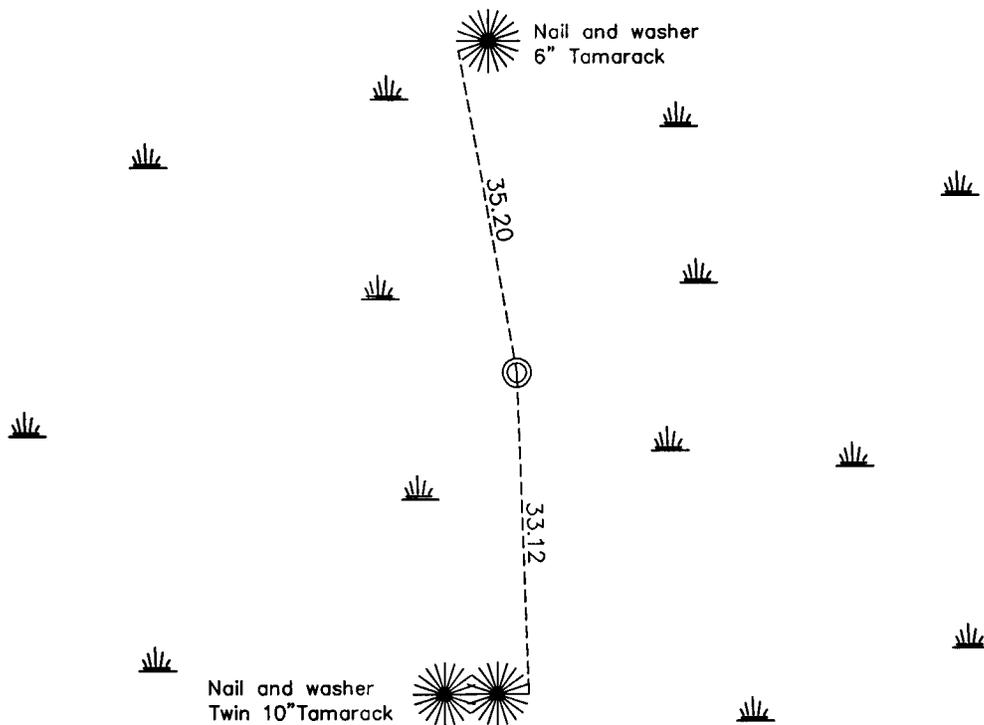

Revision Date
3/21/13

N.A.D. 1983 Coordinates
(1996 Adjustment)

County Project Coordinates	
Northing	<u>232887.2107</u>
Easting	<u>518781.3579</u>
Date	<u>4/07/03</u>

I hereby certify that this United States public land survey monument record is correct and complete to the best of my knowledge and belief.

Larry D. Hoium Date 3/21/13

Larry D. Hoium, Anoka County Surveyor

Minnesota License Number 18165