

CERTIFICATE OF LOCATION OF GOVERNMENT CORNER

County of Anoka

State of Minnesota



West 1/4 Corner of Sec. 34 Township 34 Range 23

On the 24th day of August, 1976, the described corner was evidenced by a 3/4" iron pipe

and to perpetuate the location of said corner, at the exact location thereof, a permanent marker was placed consisting of a red and white iron pipe with sign attached facing south

AND on the 26th day of October, 2012, said permanent marker was found up 3'± and leaning West approximately 0.8'±. Ties were updated

Updated reference ties are as shown below.

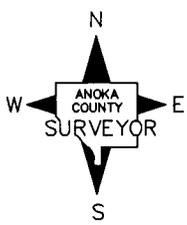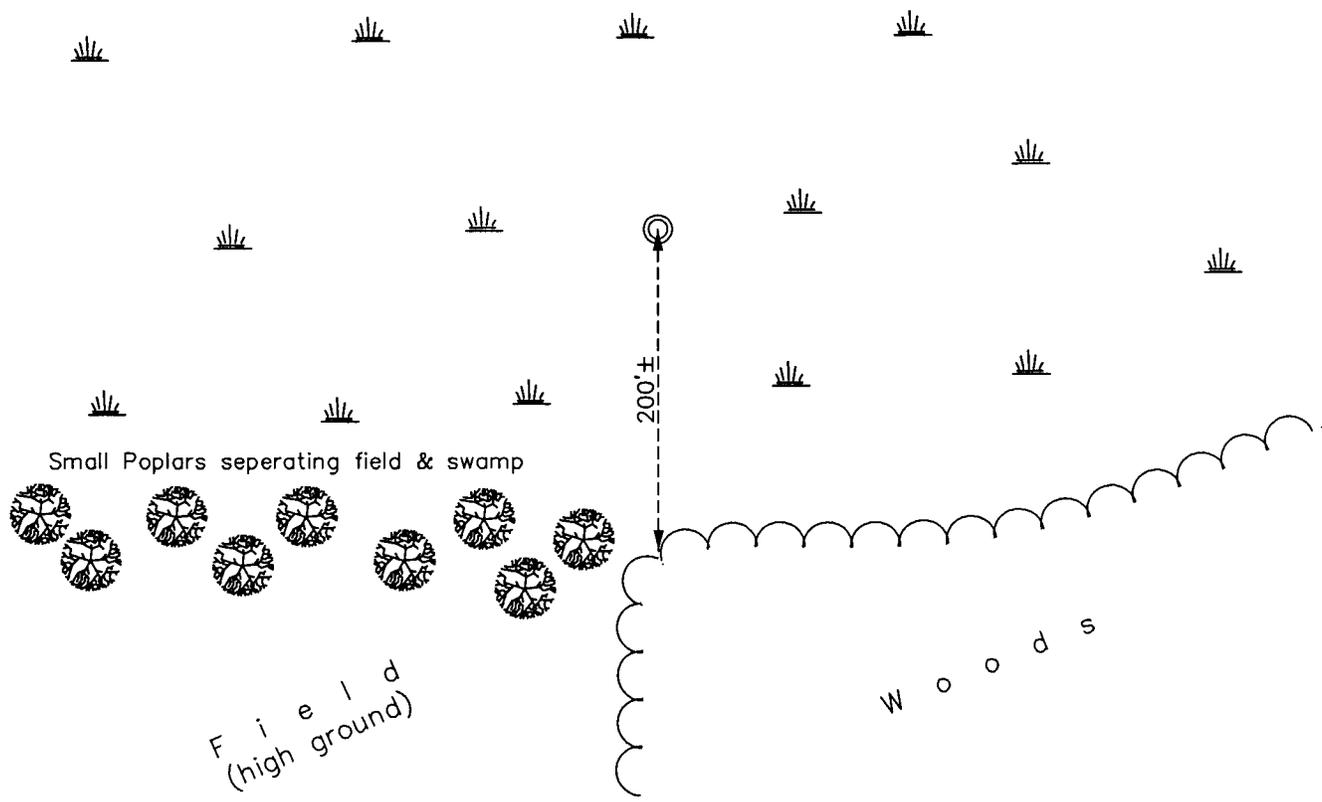

Revision Date
3/27/13

N.A.D. 1983 Coordinates
(1996 Adjustment)

County Project Coordinates	
Northing	<u>230231.8091</u>
Easting	<u>516164.6764</u>
Date	<u>4/09/03</u>

I hereby certify that this United States public land survey monument record is correct and complete to the best of my knowledge and belief.

Larry D. Hoium Date 3/27/13

Larry D. Hoium, Anoka County Surveyor
Minnesota License Number 18165