

CERTIFICATE OF LOCATION OF GOVERNMENT CORNER

County of Anoka

State of Minnesota


East 1/4 Corner of Sec. 29 Township 34 Range 23

On the 8th day of December, 1976, the described corner was evidenced by area resurvey

and to perpetuate the location of said corner, at the exact location thereof, a permanent marker was placed consisting of a cast iron monument down 2'±

AND on the 29th day of October, 2012, said permanent marker was found down 2'±. Set new cast iron monument down 0.5'± on top of existing mon't. and updated ties on April 10, 2013.

Updated reference ties are as shown below.

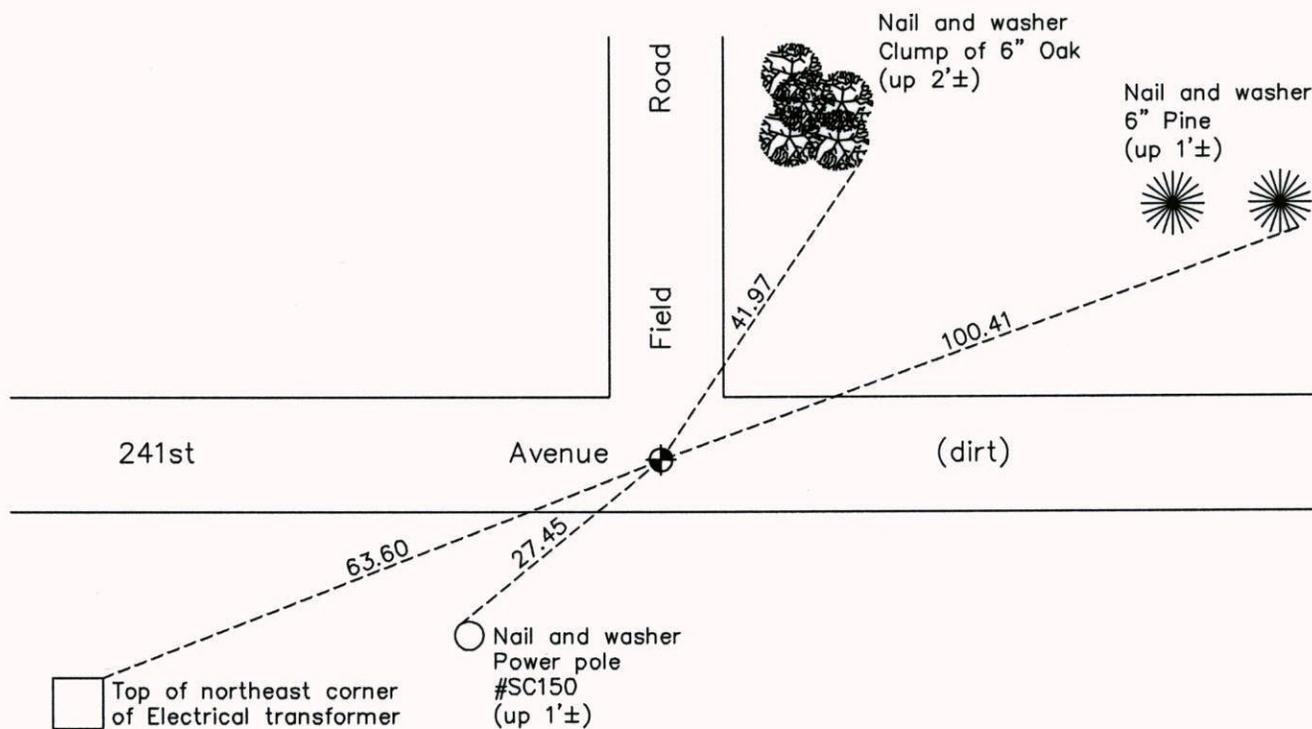

Revision Date
8/18/14

N.A.D. 1983 Coordinates
(1996 Adjustment)

County Project Coordinates	
Northing	<u>235399.2289</u>
Easting	<u>510800.5155</u>
Date	<u>5/15/02</u>

I hereby certify that this United States public land survey monument record is correct and complete to the best of my knowledge and belief.

Larry D. Hoium Date 8/18/14

Larry D. Hoium, Anoka County Surveyor
Minnesota License Number 18165