

CERTIFICATE OF LOCATION OF GOVERNMENT CORNER

County of Anoka

State of Minnesota



Southeast Corner of Sec. 22 Township 32 Range 22

On the 6th day of December, 1963, the described corner was evidenced by a 1" axle shaft

and to perpetuate the location of said corner, at the exact location thereof, a permanent marker was placed consisting of a cast iron monument

AND on the 27th day of October, 2014, said permanent marker was found down 1'± and was raised to the surface. The ties were updated.

Updated reference ties are as shown below.

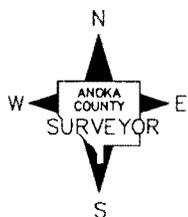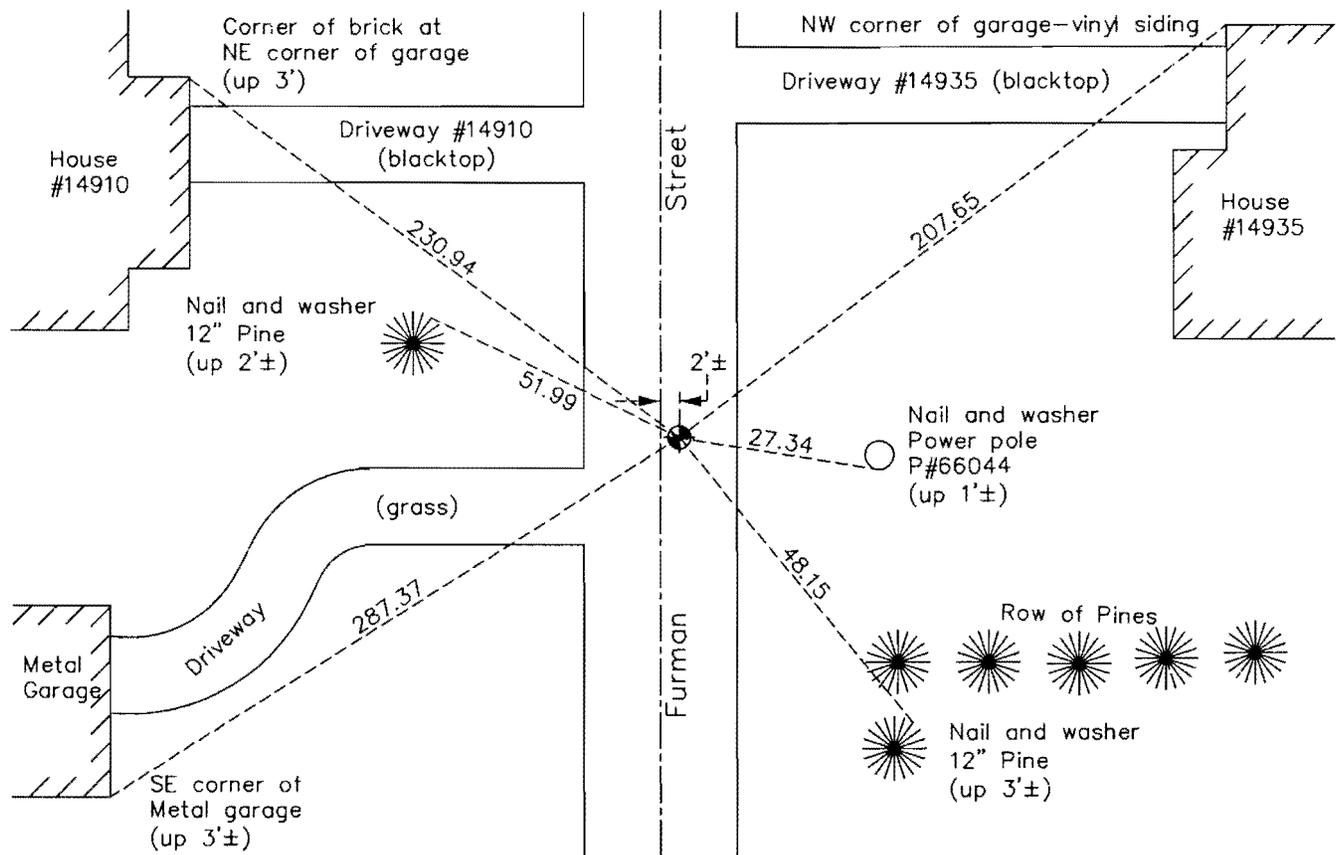

Revision Date
2/05/16

N.A.D. 1983 Coordinates
(1996 Adjustment)

| County Project Coordinates | |
|----------------------------|--------------------|
| Northing | <u>174727.6212</u> |
| Easting | <u>553196.0997</u> |
| Date | <u>6/25/03</u> |

I hereby certify that this United States public land survey monument record is correct and complete to the best of my knowledge and belief.

Larry D. Hoium Date 2/05/16

Larry D. Hoium, Anoka County Surveyor

Minnesota License Number 18165