

CERTIFICATE OF LOCATION OF GOVERNMENT CORNER

County of Anoka

State of Minnesota



East 1/4 Corner of Sec. 29 Township 32 Range 22

On the 18th day of September, 1964, the described corner was evidenced by a broken off concrete monument

and to perpetuate the location of said corner, at the exact location thereof, a permanent marker was placed consisting of a cast iron monument down 1.5'±

AND on the 27th day of October, 2014, said permanent marker was found down 1'± and was raised to the surface. The ties were updated.

Updated reference ties are as shown below.

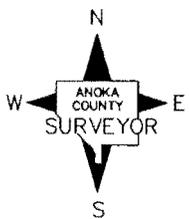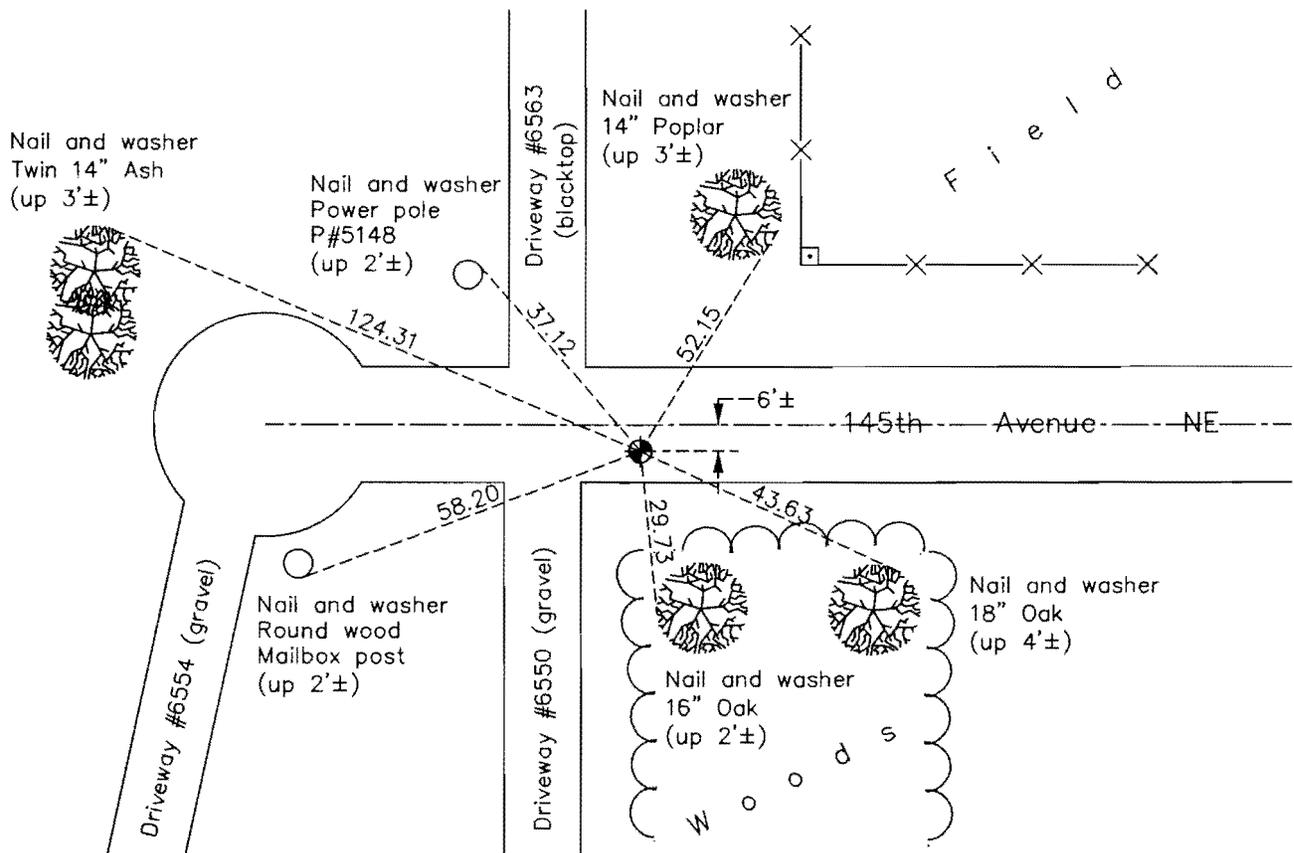

Revision Date

2/05/16

N.A.D. 1983 Coordinates
(1996 Adjustment)

County Project Coordinates	
Northing	<u>172025.9123</u>
Easting	<u>542668.6580</u>
Date	<u>6/24/03</u>

I hereby certify that this United States public land survey monument record is correct and complete to the best of my knowledge and belief.

Larry D. Hoium Date 2/05/16

Larry D. Hoium, Anoka County Surveyor
Minnesota License Number 18165