

CERTIFICATE OF LOCATION OF GOVERNMENT CORNER

County of Anoka

State of Minnesota


Witness Corner of Sec. 28 Township 32 Range 22
 (on south line of SE1/4)

On the 1st day of January, 1998, the described corner was evidenced by area resurvey

and to perpetuate the location of said corner, at the exact location thereof, a permanent marker was placed consisting of a 1/2" iron pipe with a sign and post on the north side (1'± S. OF SIGN & POST) (w/ A.C. CAP)

AND on the ___ day of _____, _____, said permanent marker was _____

Updated reference ties are as shown below.

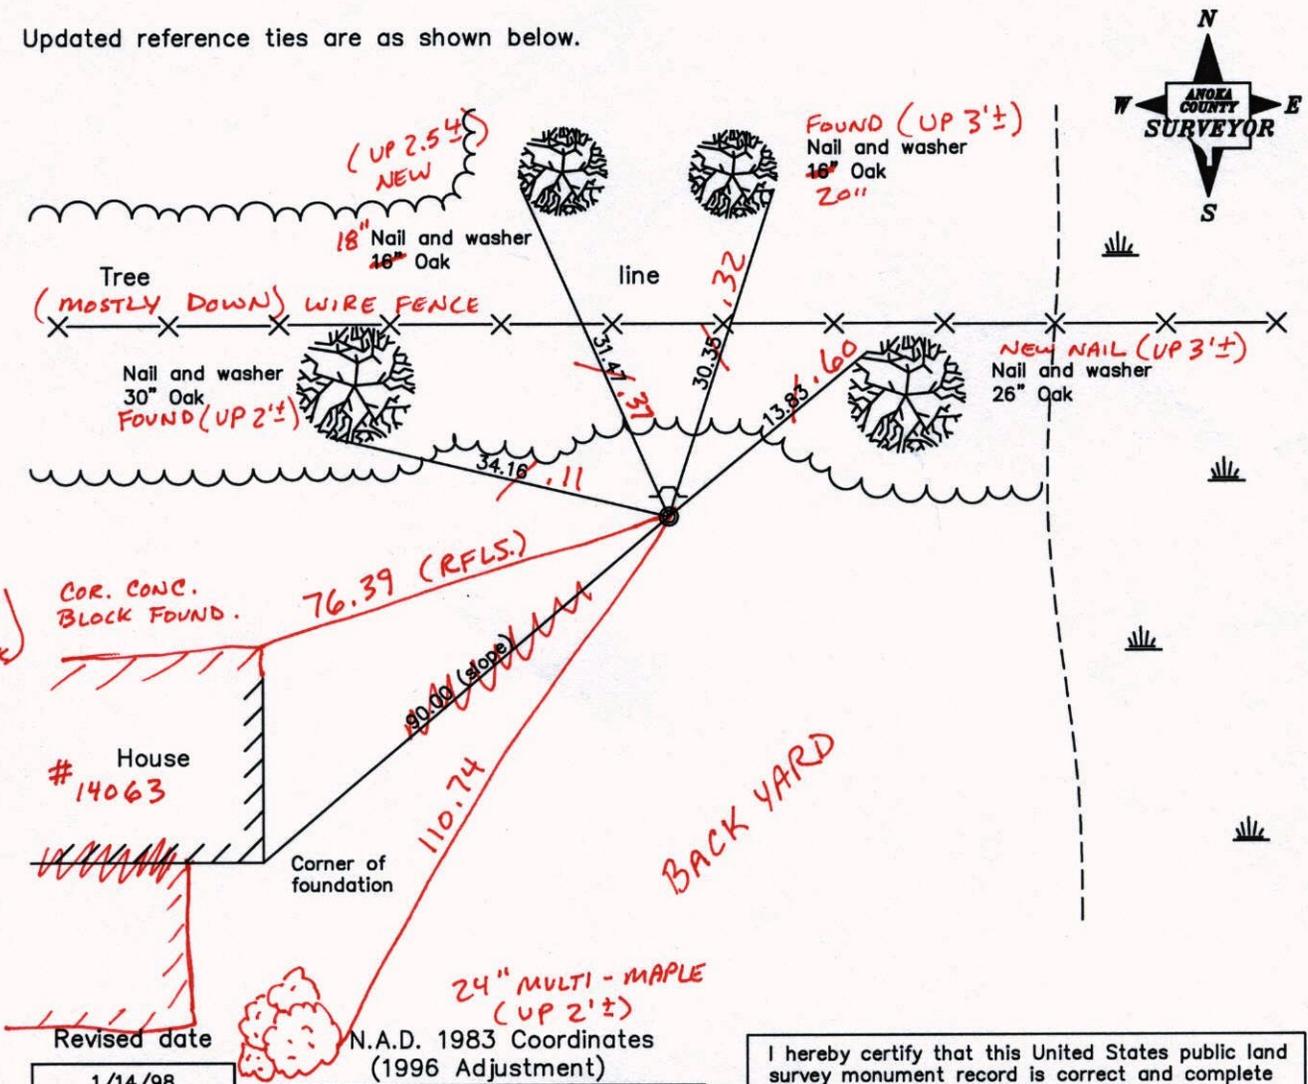

Revised date	1/14/98

N.A.D. 1983 Coordinates (1996 Adjustment)	
County Project Coordinates	
Northing	169392.9109
Easting	546411.9966
Date	5/18/04

I hereby certify that this United States public land survey monument record is correct and complete to the best of my knowledge and belief.

_____, Anoka County Surveyor

Minnesota License Number _____

9-24-14
 BK-55
 TOTAL STATION

CERTIFICATE OF LOCATION OF GOVERNMENT CORNER

County of Anoka

State of Minnesota


Witness Corner of Sec. 28 Township 32 Range 22
(on south line of SE1/4)

On the 1st day of January, 1998, the described corner was evidenced by area resurvey

and to perpetuate the location of said corner, at the exact location thereof, a permanent marker was placed consisting of a 1/2" iron pipe with a sign and post on the north side

AND on the ___ day of _____, _____, said permanent marker was _____

Updated reference ties are as shown below.

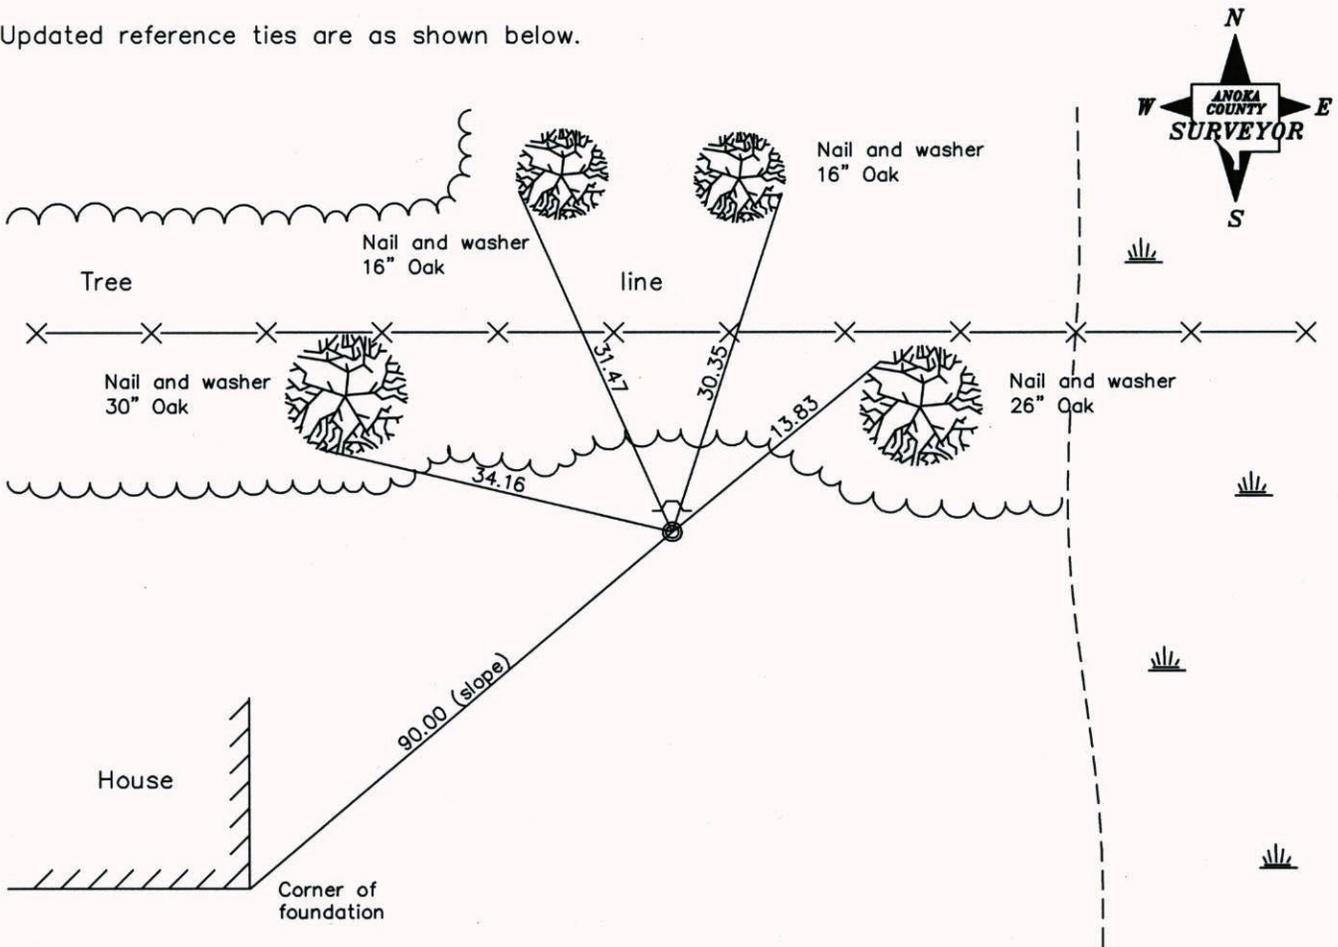

Revised date

1/14/98

N.A.D. 1983 Coordinates
(1996 Adjustment)

County Project Coordinates
Northing <u>169392.9109</u>
Easting <u>546411.9966</u>
Date <u>5/18/04</u>

I hereby certify that this United States public land survey monument record is correct and complete to the best of my knowledge and belief.

_____ Date _____
 _____, Anoka County Surveyor
 Minnesota License Number _____

CERTIFICATE OF LOCATION OF GOVERNMENT CORNER

County of Anoka

State of Minnesota


WITNESS Corner of Sec. 28 Township 32 Range 22
 ON SOUTHW LINE OF SE 1/4

I hereby certify that on the 1ST day of JAN., 1998, I found the described corner which was evidenced by AREA RESURVEY


and I further certify that to perpetuate the location of said corner, I did, at the exact location thereof, place a permanent marker consisting of 1/2" IRON PIPE

SIGN AND POST ON NORTH SIDE

which reference or witness monuments are located in the manner following:

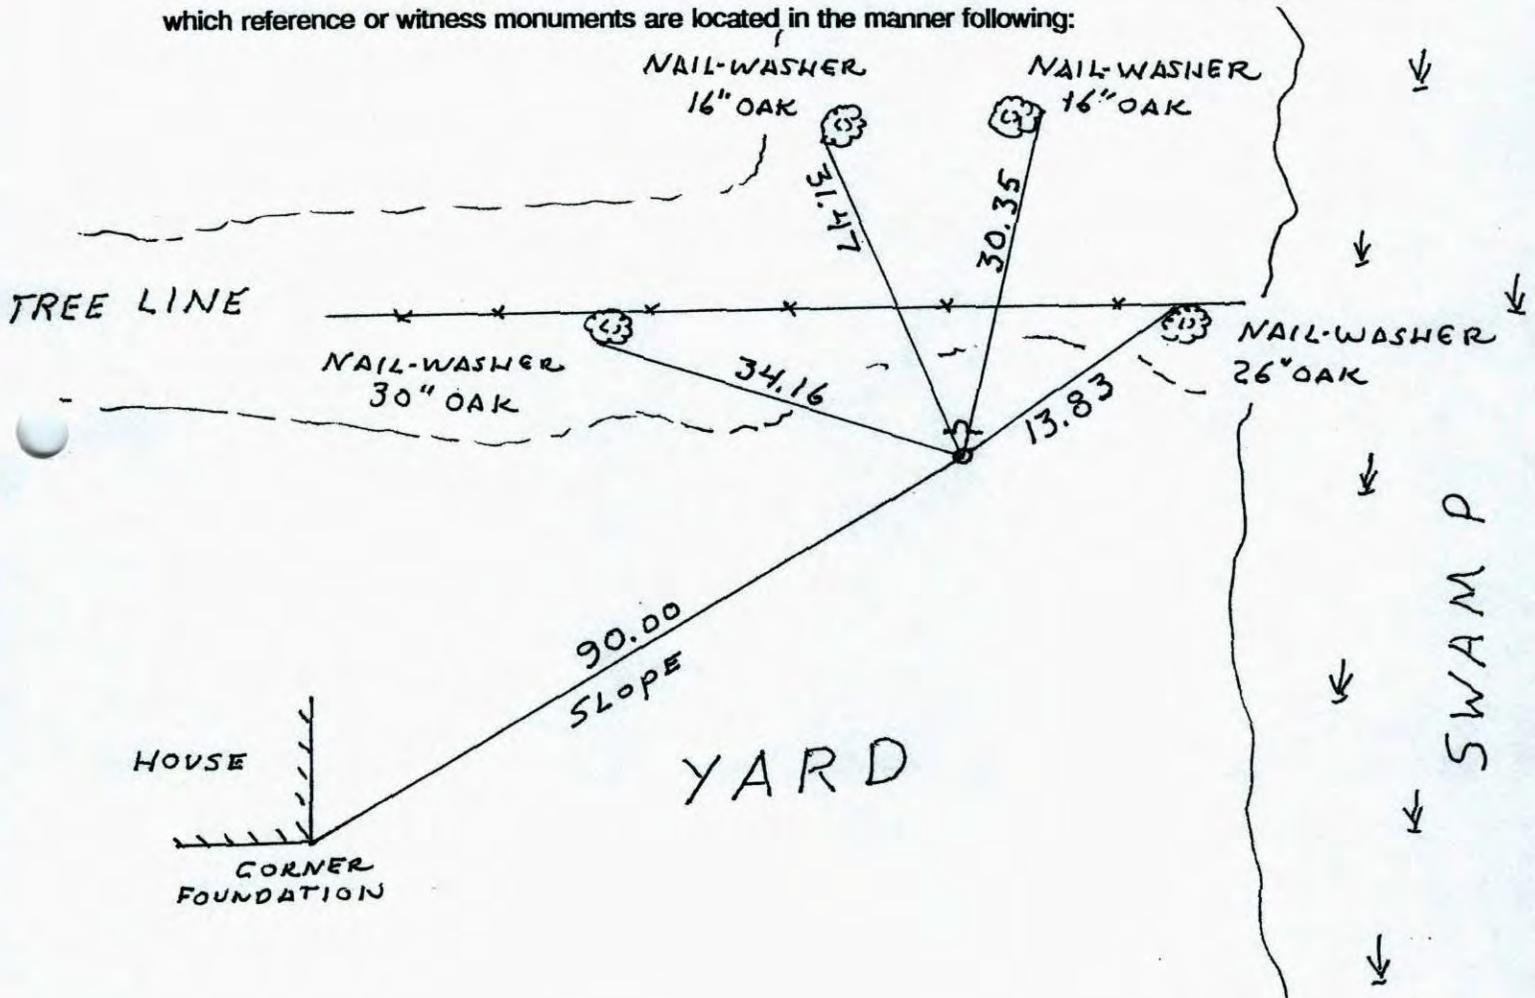

Revised date	Revised date	Revised date
1-14-98 ^W		

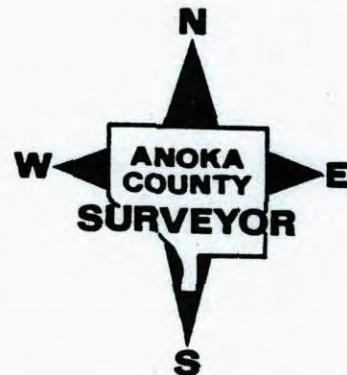

CERTIFICATE OF LOCATION OF GOVERNMENT CORNER

County of Anoka


State of Minnesota

WITNESS Corner of Sec. 28 Township 32 Range 22
 ON SOUTH LINE OF SE 1/4


I hereby certify that on the 1st day of JAN., 1998, I found the described corner which was evidenced by AREA RESURVEY

and I further certify that to perpetuate the location of said corner, I did, at the exact location thereof, place a permanent marker consisting of 1/2" IRON PIPE
SIGN AND POST ON NORTH SIDE

which reference or witness monuments are located in the manner following:

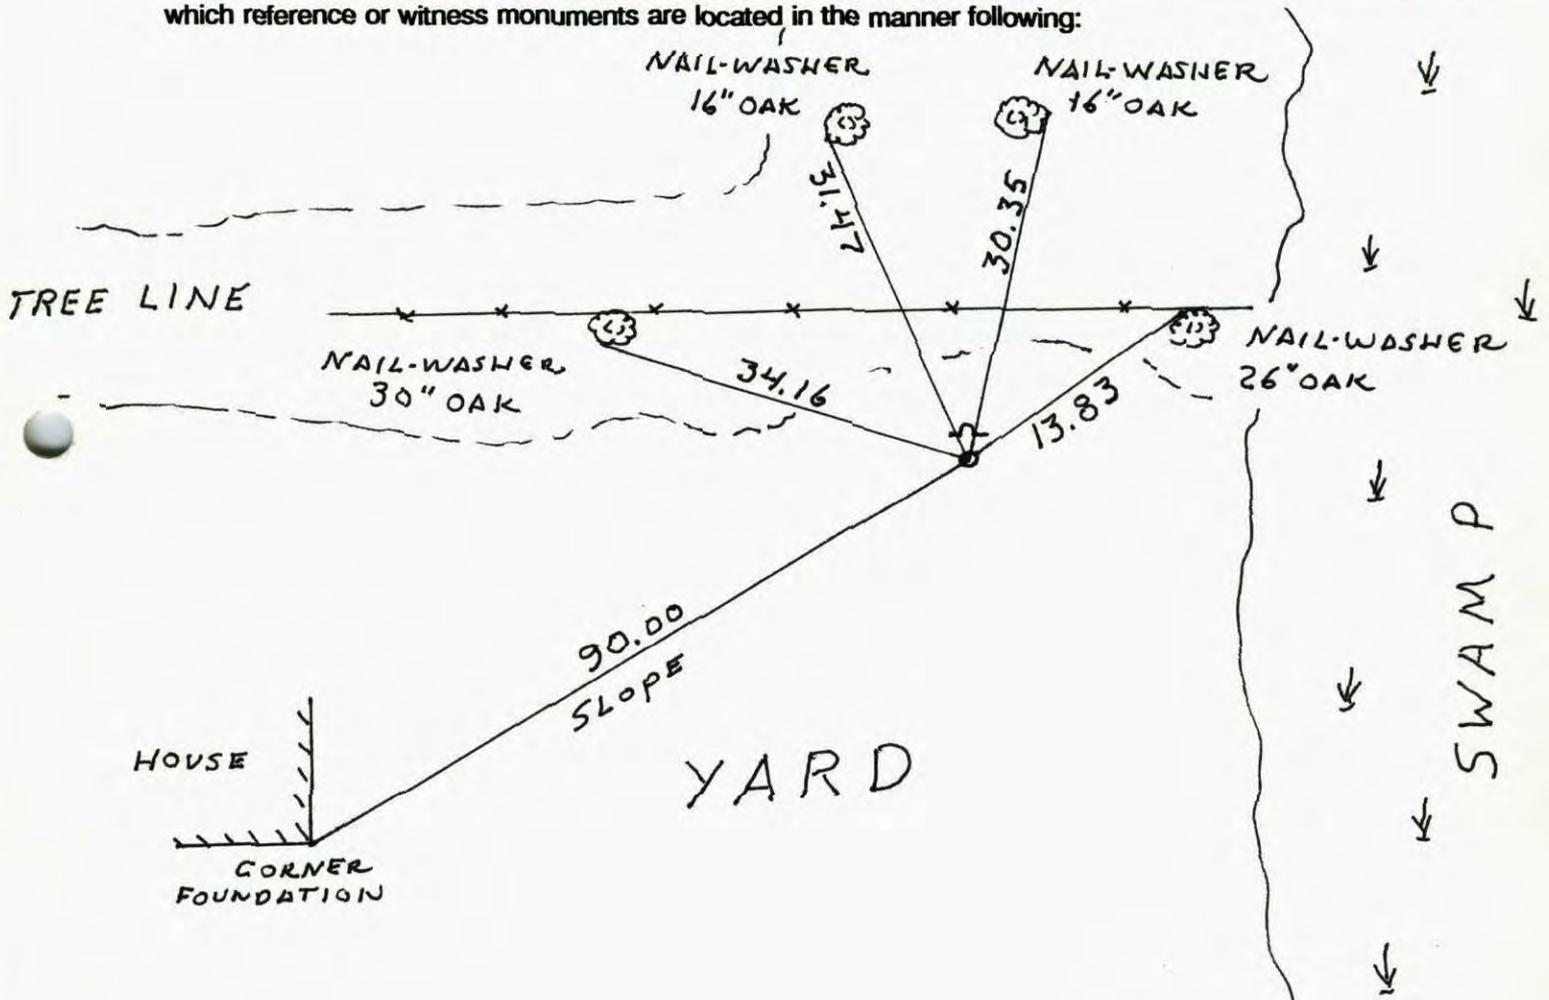

Revised date	Revised date	Revised date
1-14-98 w		

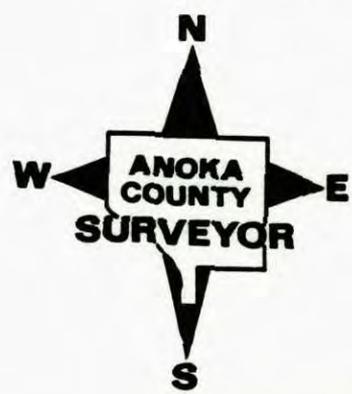

W.C. ON SOUTH LINE OF SE 1/4 OF
SEC. 28 T32 R22

SET 1/2" IRON PIPE FROM AREA
RESURVEY SIGN & POST ON NORTH
SIDE

