

CERTIFICATE OF LOCATION OF GOVERNMENT CORNER

County of Anoka State of Minnesota


Southwest Corner of Sec. 2 Township 32 Range 22

On the 23rd day of September, 1969, the described corner was evidenced by a railroad spike

and to perpetuate the location of said corner, at the exact location thereof, a permanent marker was placed consisting of a cast iron monument (4' +/- W. OF E)

AND on the 17th day of August, 2004, said permanent marker was found down 1' and the ties were updated

Updated reference ties are as shown below.

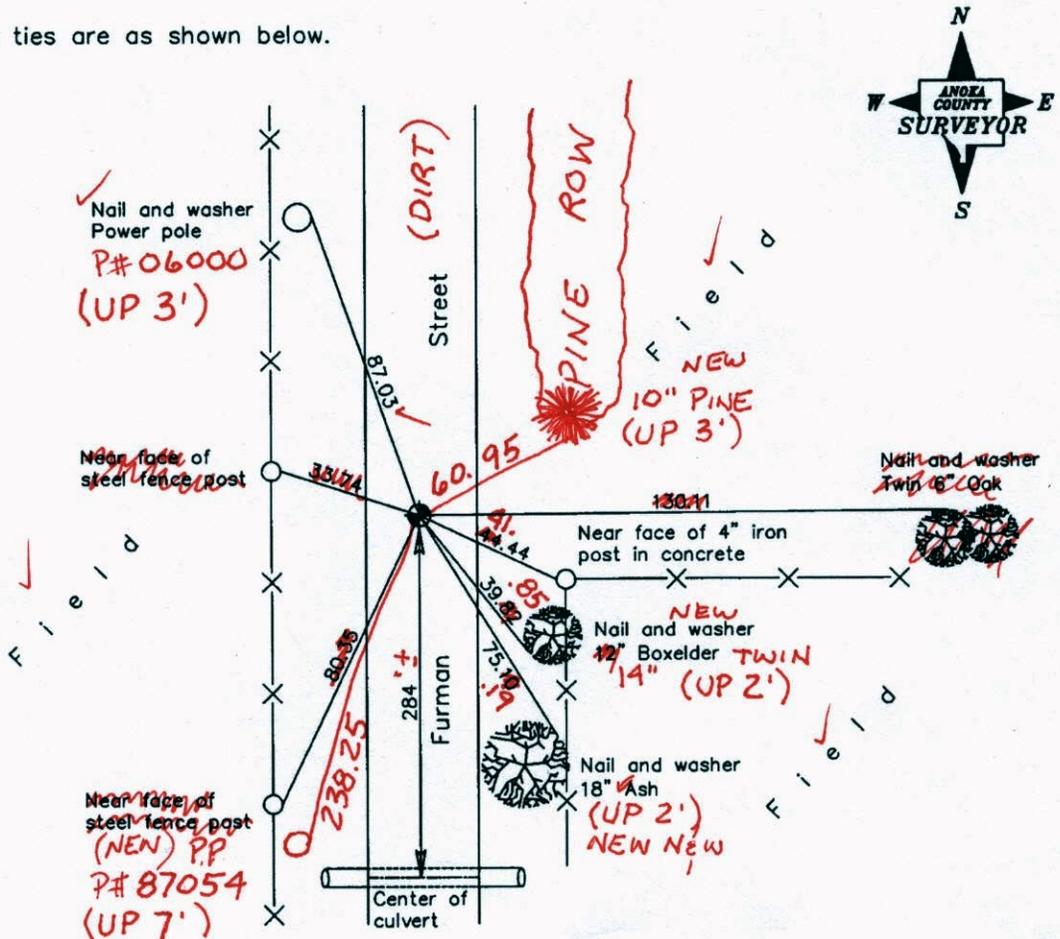

9-16-14
BK-SS
TOTAL STA.

Revised date
8/15/89
8/15/95
8/17/04

N.A.D. 1983 Coordinates (1996 Adjustment)	
County Project Coordinates	
Northing	190424.1537
Easting	553124.8869
Date	6/17/03

I hereby certify that this United States public land survey monument record is correct and complete to the best of my knowledge and belief.

Larry D. Hoium Date 8/17/04

Larry D. Hoium, Anoka County Surveyor

Minnesota License Number 18165

CERTIFICATE OF LOCATION OF GOVERNMENT CORNER

County of Anoka

State of Minnesota


Southwest Corner of Sec. 2 Township 32 Range 22

On the 23rd day of September, 1969, the described corner was evidenced by a railroad spike

and to perpetuate the location of said corner, at the exact location thereof, a permanent marker was placed consisting of a cast iron monument

AND on the 17th day of August, 2004, said permanent marker was found down 1' and the ties were updated

Updated reference ties are as shown below.

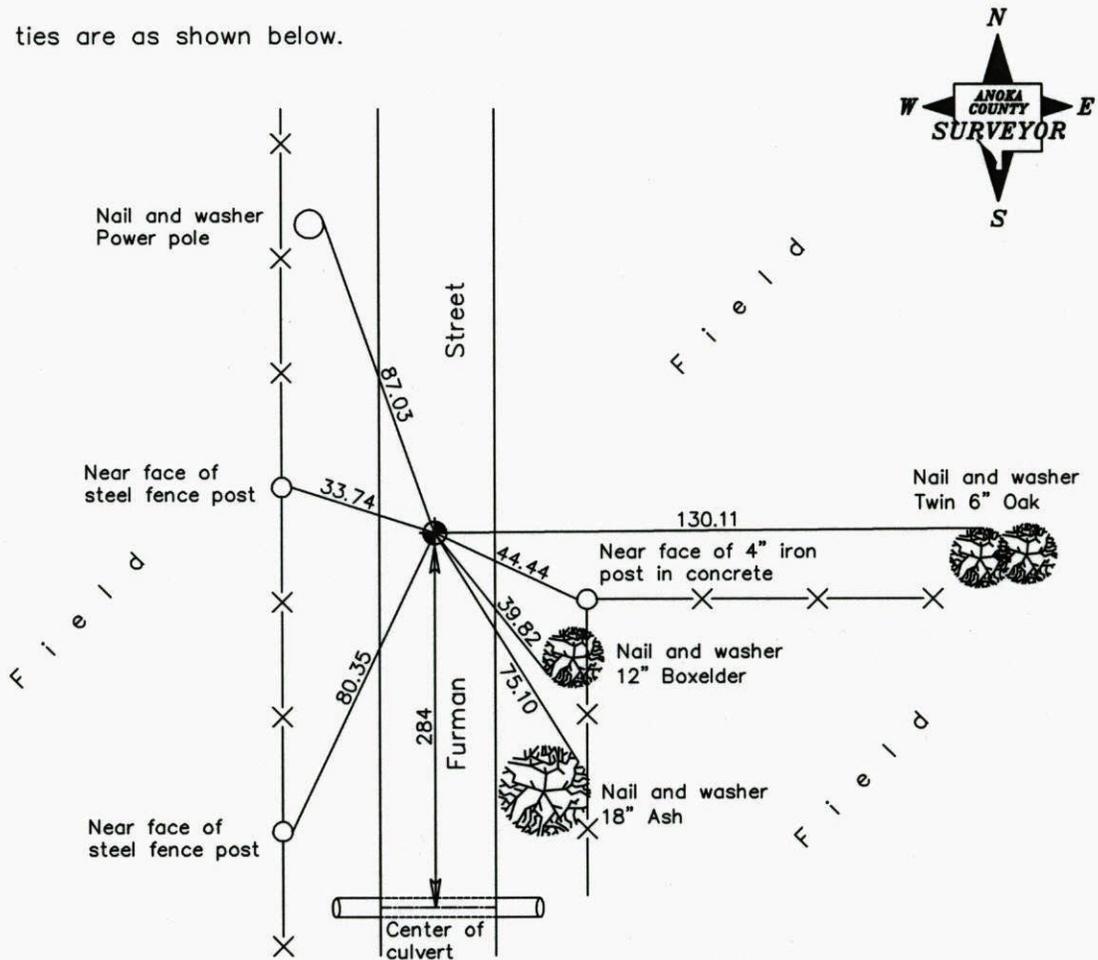

Revised date
8/15/89
8/15/95
8/17/04

N.A.D. 1983 Coordinates (1996 Adjustment)	
County Project Coordinates	
Northing	<u>190424.1537</u>
Easting	<u>553124.8869</u>
Date	<u>6/17/03</u>

I hereby certify that this United States public land survey monument record is correct and complete to the best of my knowledge and belief.

Larry D. Hoium Date 8/17/04

Larry D. Hoium, Anoka County Surveyor

Minnesota License Number 18165

SHOT GPS 6.17.03

CERTIFICATE OF LOCATION OF GOVERNMENT CORNER

County of Anoka


State of Minnesota

SOUTH WEST Corner of Sec. 2 Township 32 Range 22

I hereby certify that on the 23 day of SEPT, 1969, I found the described corner which was evidenced by RAILROAD SPIKE

and I further certify that to perpetuate the location of said corner, I did, at the exact location thereof, place a permanent marker consisting of CAST IRON MONUMENT
DOWN 1'

which reference or witness monuments are located in the manner following:

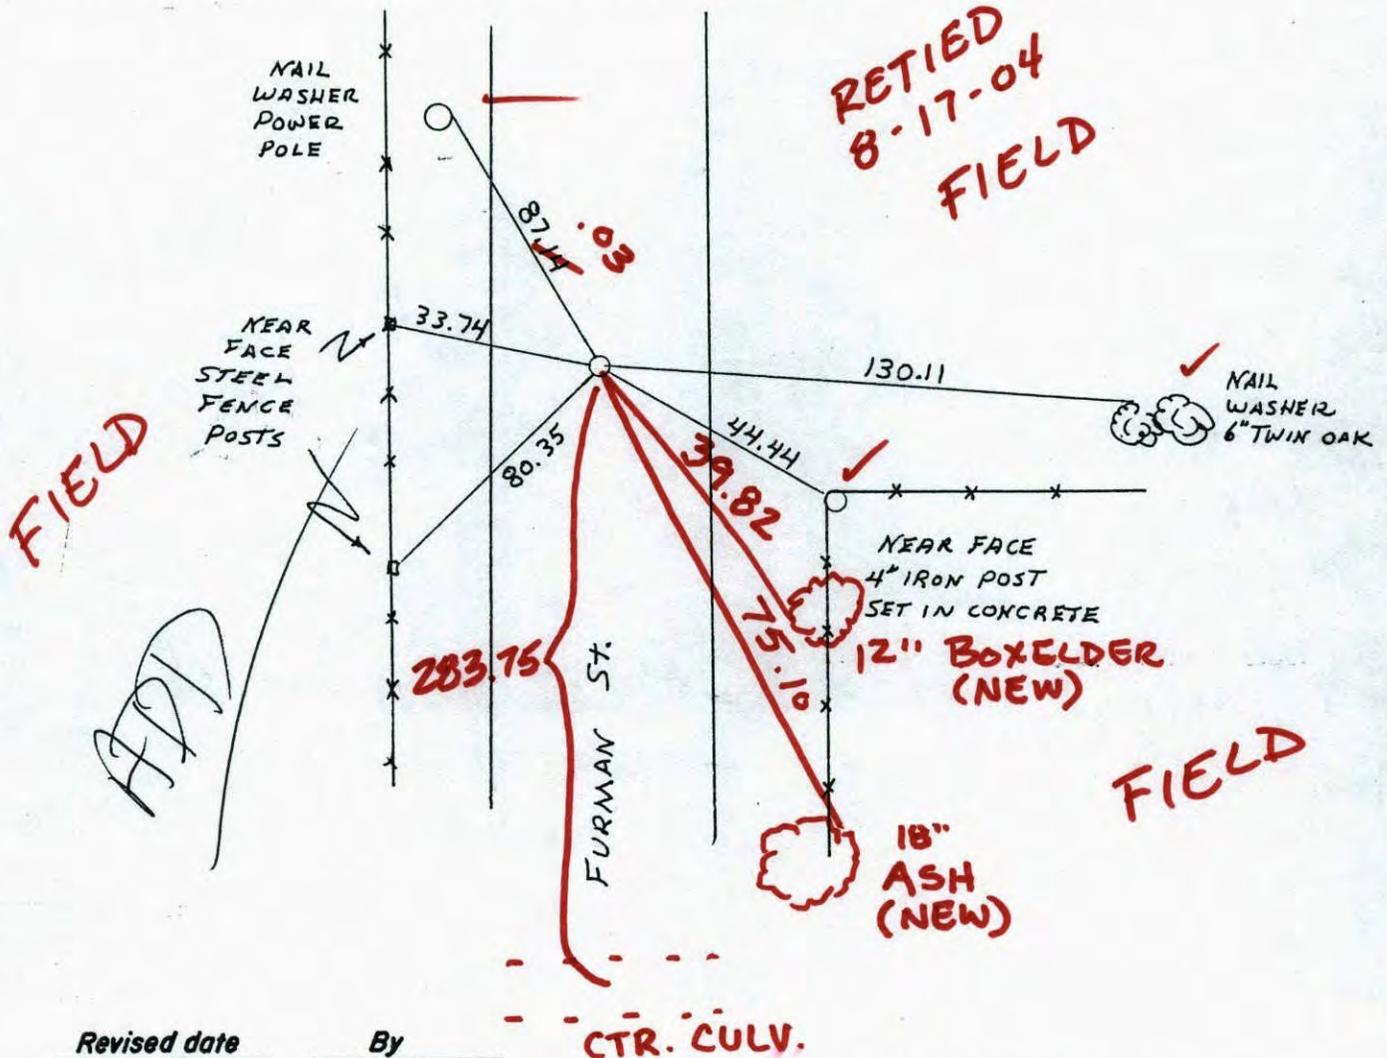

Revised date
8-9-85
REDRAWN 2-10-88
8-15-89
8-15-95

By
D. ROSS
H. LARSON

CTR. CULV.
IN ROAD Minnesota State Plane Coordinates
South Zone

Y _____ X _____

County Surveyor Date
Registered Land Surveyor No. _____

CERTIFICATE OF LOCATION OF GOVERNMENT CORNER

County of Anoka


State of Minnesota

SOUTH WEST Corner of Sec. 2 Township 32 Range 22

I hereby certify that on the 23 day of SEPT., 1969, I found the described corner which was evidenced by RAILROAD SPIKE

and I further certify that to perpetuate the location of said corner, I did, at the exact location thereof, place a permanent marker consisting of CAST IRON MONUMENT

which reference or witness monuments are located in the manner following:

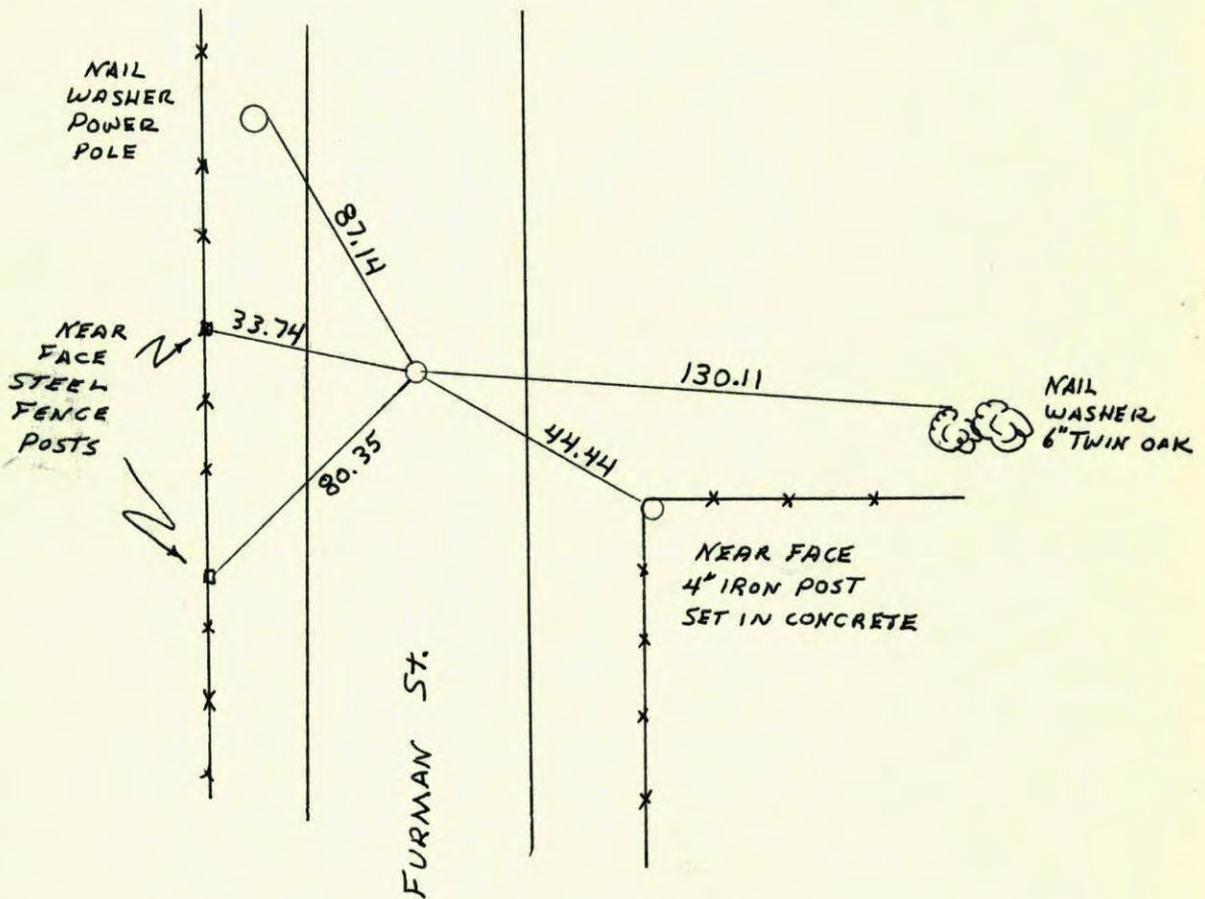

Revised date
8-9-85
REDRAWN 2-10-88
8-15-89
8-15-95

By
D. ROSS
H. LARSON

Minnesota State Plane Coordinates
South Zone

Y _____ X _____

_____,
County Surveyor Date

Registered Land Surveyor No. _____

