

CERTIFICATE OF LOCATION OF GOVERNMENT CORNER

County of Anoka

State of Minnesota


South 1/4 Corner of Sec. 4 Township 32 Range 22

On the 12th day of February, 1974, the described corner was evidenced by a concrete monument

and to perpetuate the location of said corner, at the exact location thereof, a permanent marker was placed consisting of the same concrete monument (UP 0.1'± ABOVE ICE)

AND on the ___ day of _____, _____, said permanent marker was _____

Updated reference ties are as shown below.

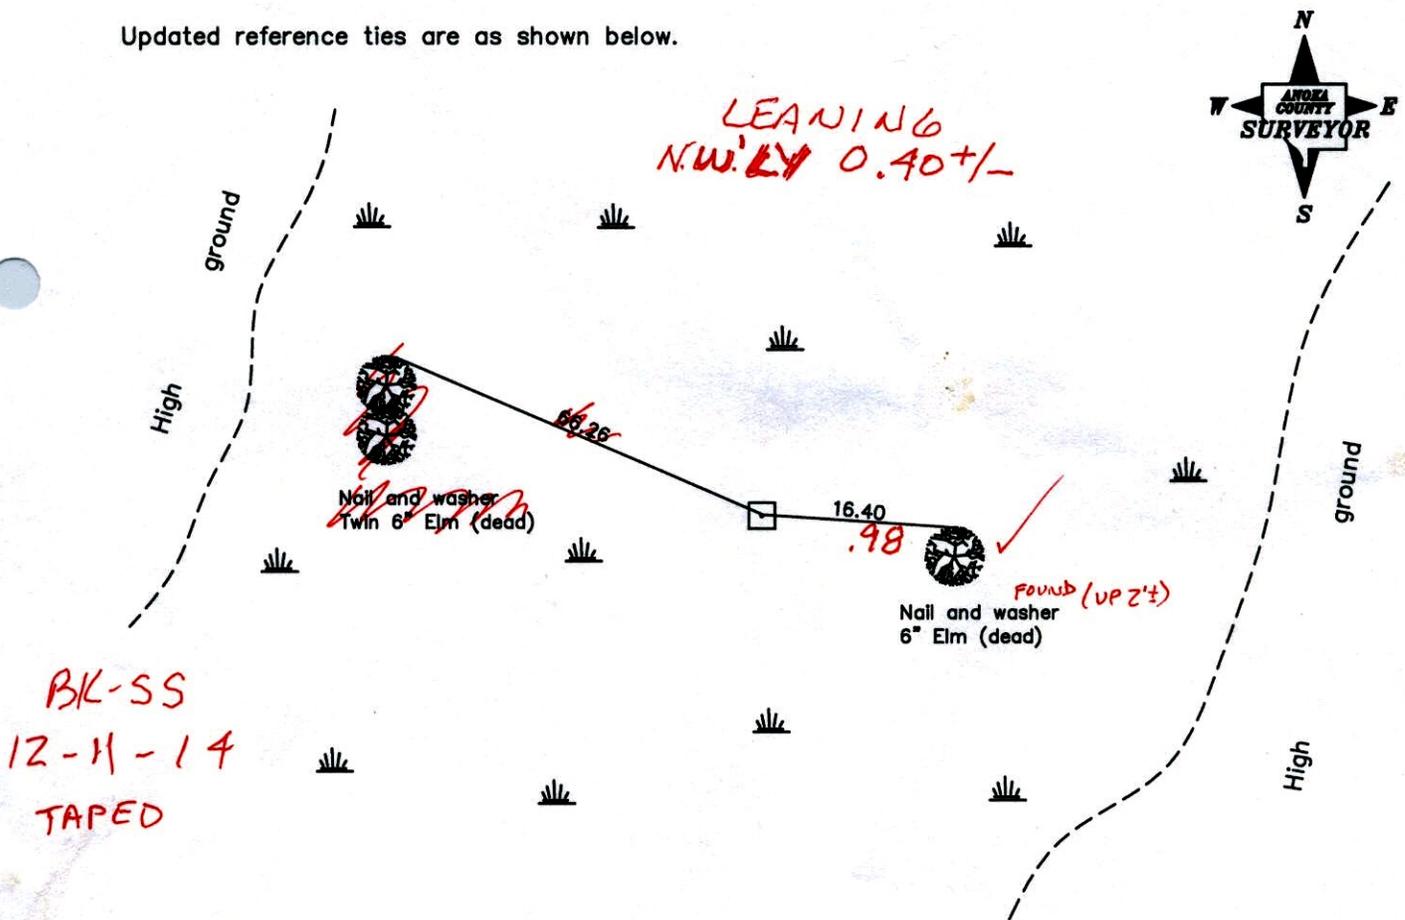

Revised date
4/28/89
8/17/95
3/11/97

N.A.D. 1983 Coordinates (1996 Adjustment)	
County Project Coordinates	
Northing	190457.2984
Easting	545302.6315
Date	5/04/05

I hereby certify that this United States public land survey monument record is correct and complete to the best of my knowledge and belief.

_____, Anoka County Surveyor

Minnesota License Number _____

3D = 0.04

N = 190457.6772

E = 545302.2324

CERTIFICATE OF LOCATION OF GOVERNMENT CORNER

County of Anoka

State of Minnesota


South 1/4 Corner of Sec. 4 Township 32 Range 22

On the 12th day of February, 1974, the described corner was evidenced by a concrete monument

and to perpetuate the location of said corner, at the exact location thereof, a permanent marker was placed consisting of the same concrete monument

AND on the ___ day of _____, _____, said permanent marker was _____

Updated reference ties are as shown below.

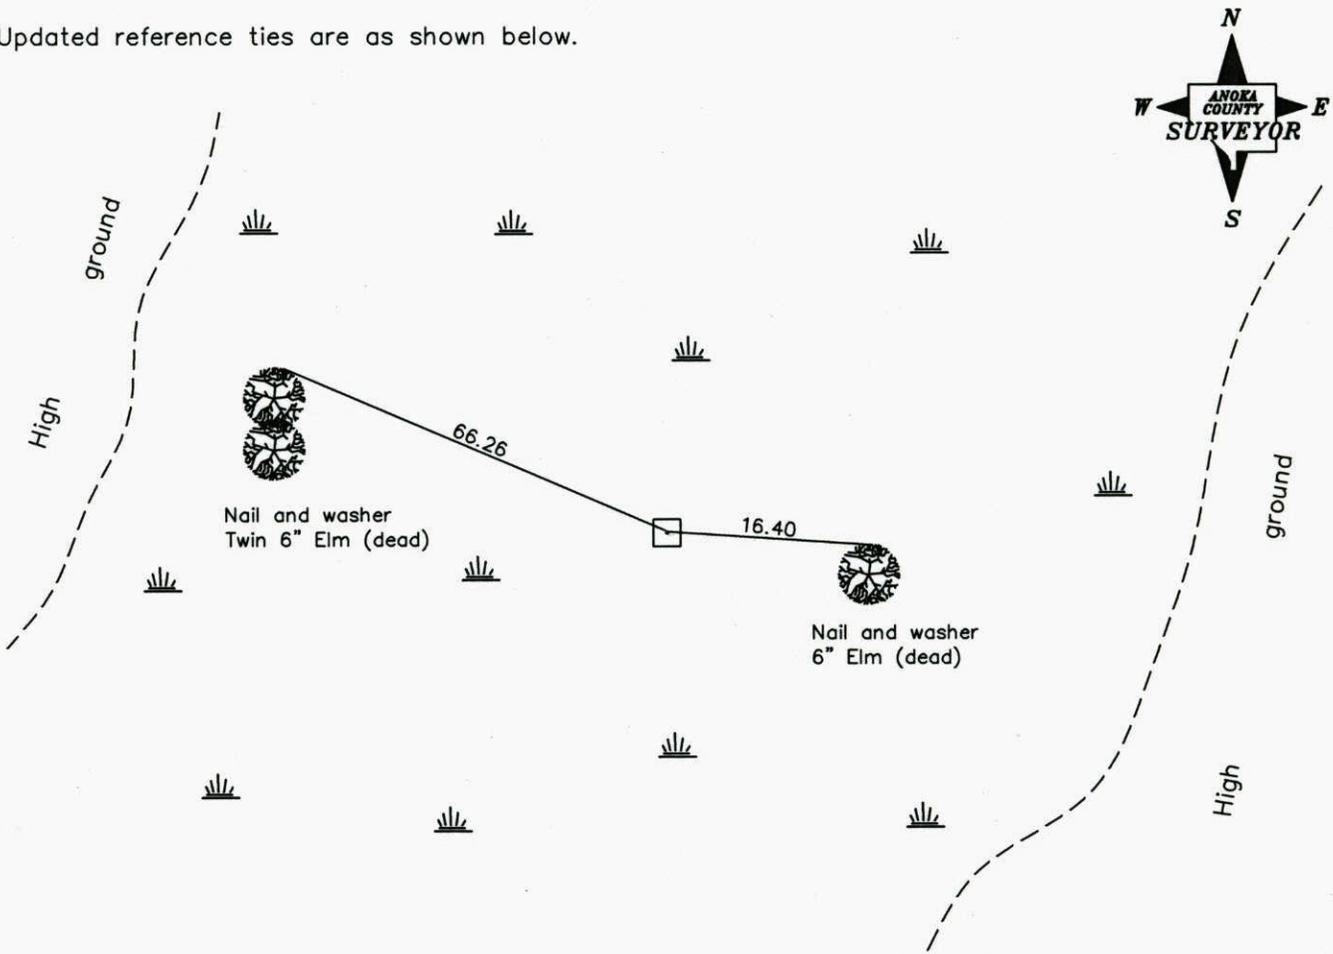

Revised date
4/28/89
8/17/95
3/11/97

N.A.D. 1983 Coordinates (1996 Adjustment)	
County Project Coordinates	
Northing	<u>190457.2984</u>
Easting	<u>545302.6315</u>
Date	<u>5/04/05</u>

I hereby certify that this United States public land survey monument record is correct and complete to the best of my knowledge and belief.

_____ Date _____

_____, Anoka County Surveyor

Minnesota License Number _____

CERTIFICATE OF LOCATION OF GOVERNMENT CORNER

County of Anoka


State of Minnesota

SOUTH 1/4 Corner of Sec. 4 Township 32 Range 22


I hereby certify that on the 12TH day of FEBRUARY, 19 74, I found the described corner which was evidenced by CONCRETE MONUMENT

and I further certify that to perpetuate the location of said corner, I did, at the exact location thereof, place a permanent marker consisting of CONCRETE MONUMENT
~~SIGN & POST ON NORTH SIDE~~

which reference or witness monuments are located in the manner following:

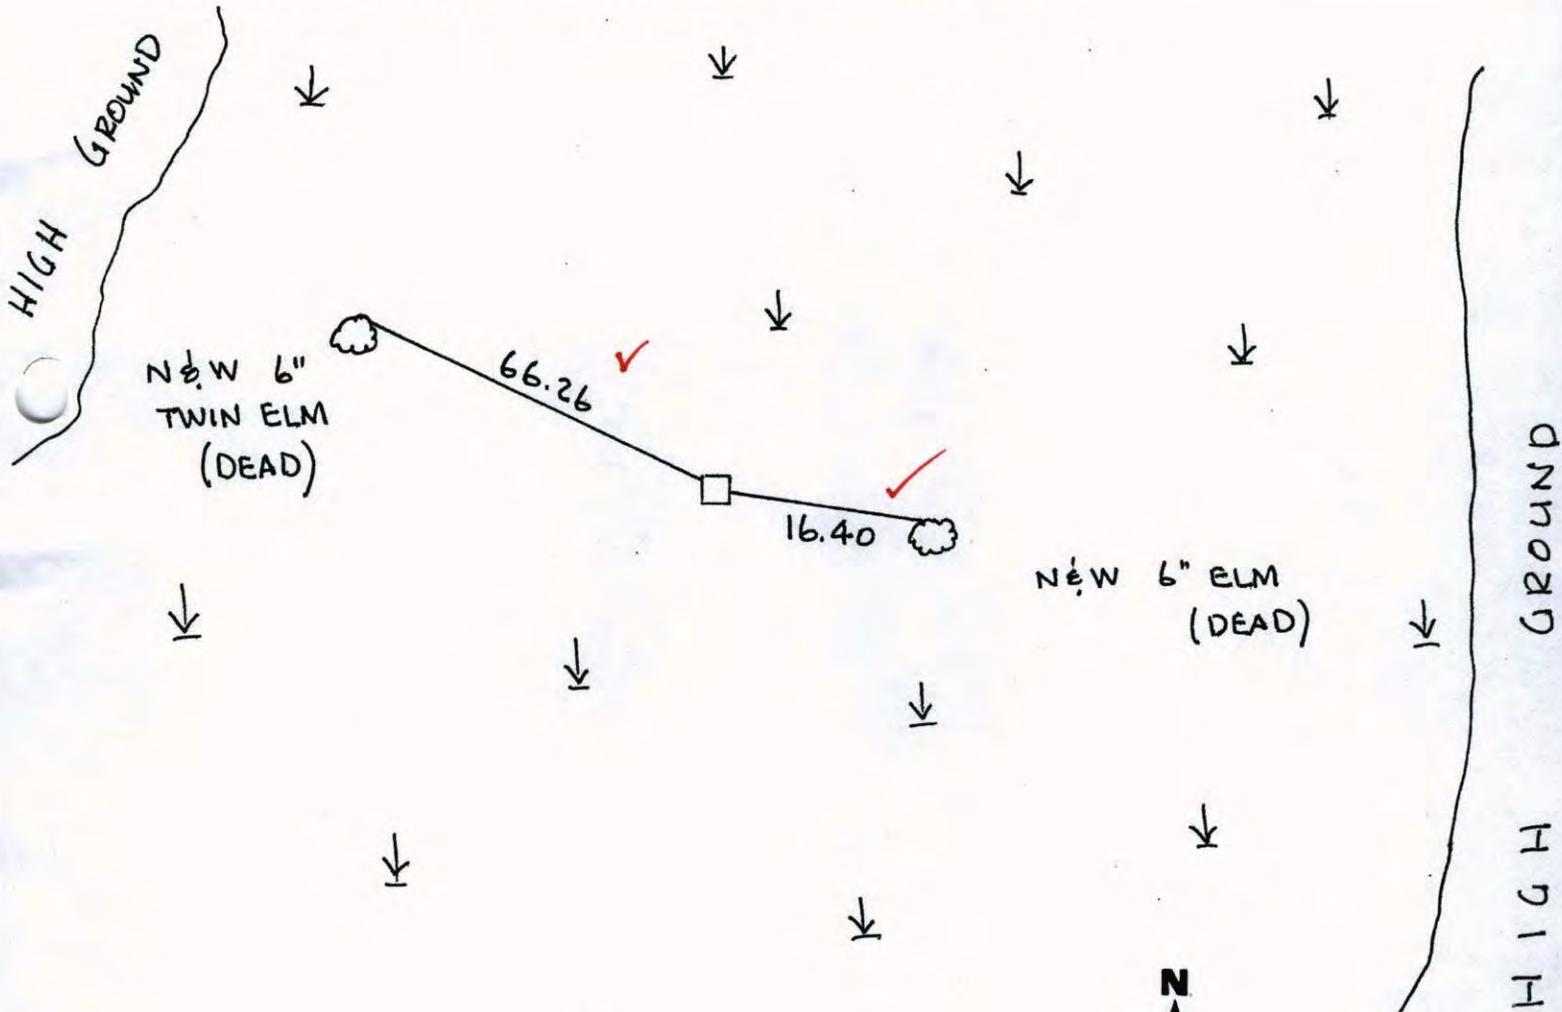

Revised date	Revised date	Revised date
8-6-76		
REDRAWN 4-28-89		
8-17-95		
REDRAWN 3-11-97		

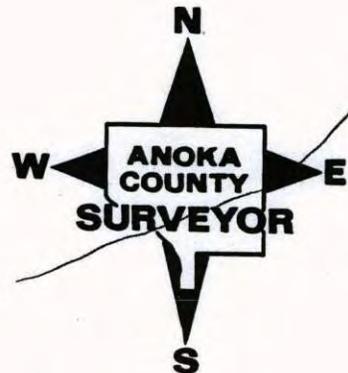

35
S 1/4 Cor. Sec. 4, T32 R22


Found and tied concrete monument

(up .5').

Feb. 12, 1974

H. Larson
J. Boettcher
D. Farmer

TIE CHECK
8-6-76
S. BRIEN
J. STEPHENS

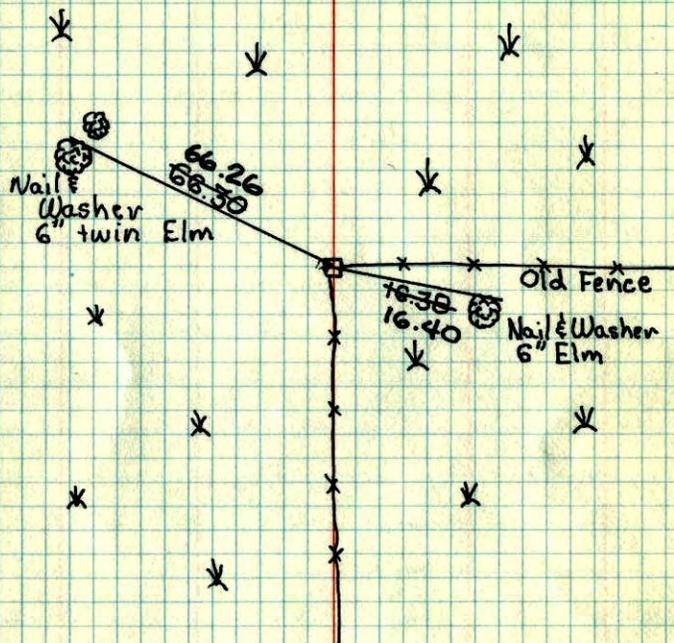

ROLAND W. ANDERSON
COUNTY SURVEYOR
ANOKA COUNTY, MINNESOTA

TEMPERATURE CORRECTED
AND HORIZONTALLY
TAPED MEASUREMENTS

S 1/4 Cor. Sec. 4-T32-R22

Found Conc. Mon. in dry Swamp.
Conc. Mon. up 2'± from ground level



Aug. 20, 1976


M.O. Anderson
P.W. Jertelson
M.J. Anne

TRY TO MAKE FIELD NOTES NEAT

S 1/4 Cor. Sec. 4 T32 R22

Found and tied concrete mon.

con. up .5'±

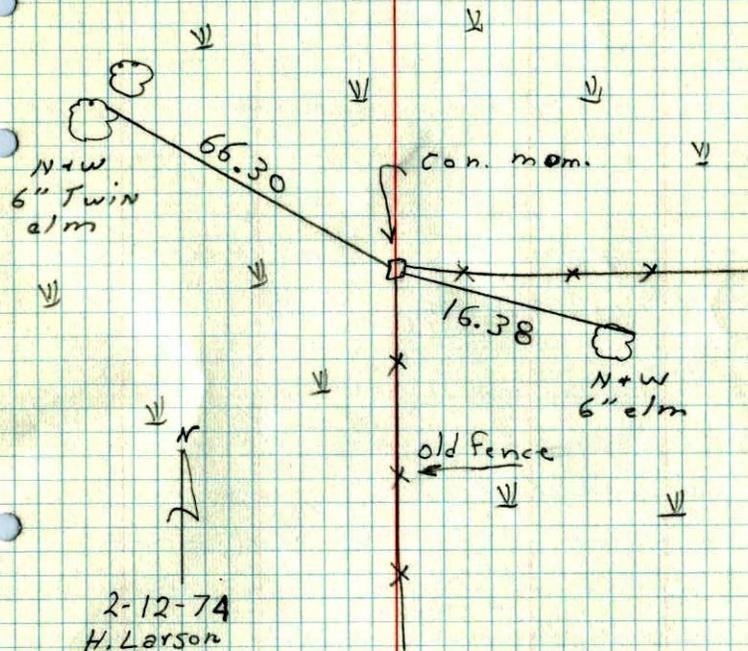

2-12-74

H. Larson
S. Beutcher
D. Farmer