

# CERTIFICATE OF LOCATION OF GOVERNMENT CORNER

County of Anoka

State of Minnesota



West 1/4 Corner of Sec. 8 Township 32 Range 22

On the 25th day of February, 1980, the described corner was evidenced by area resurvey

and to perpetuate the location of said corner, at the exact location thereof, a permanent marker was placed consisting of a red and white Telspar up 1.5'± with sign attached

AND on the 2nd day of February, 2006, said permanent marker was found and the ties were updated

Updated reference ties are as shown below.

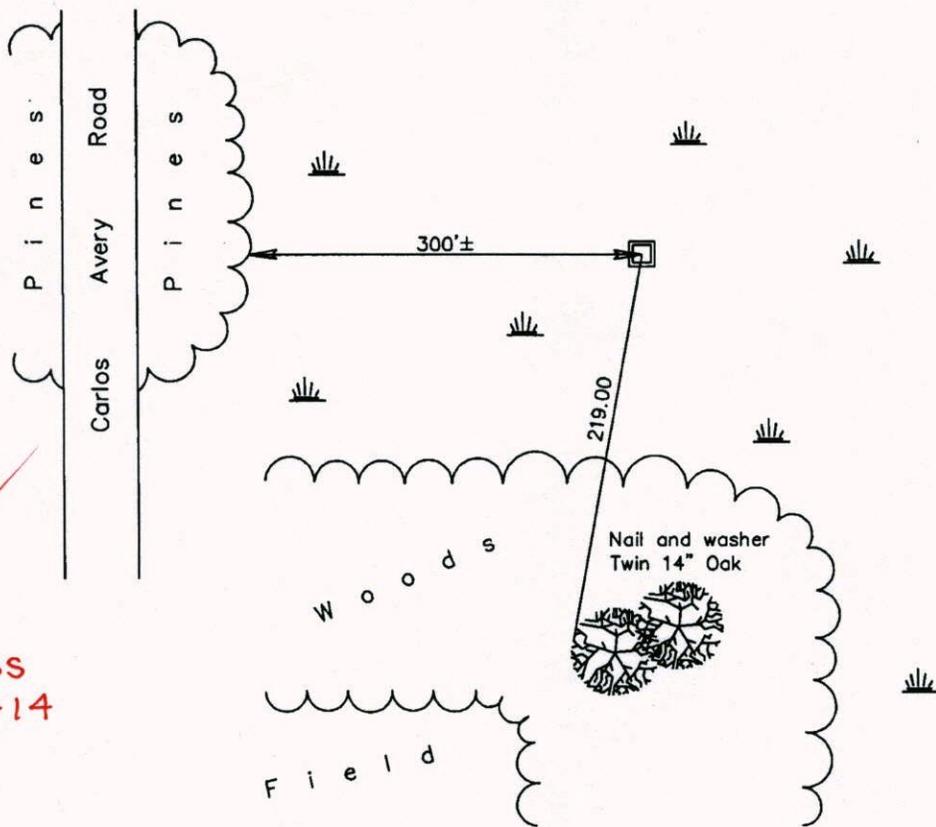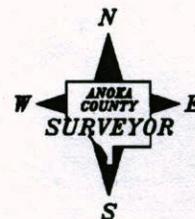

BK-SS  
12-3-14

Revised date

8/17/95
3/11/97
2/02/06

N.A.D. 1983 Coordinates  
(1996 Adjustment)

County Project Coordinates	
Northing	187818.0268
Easting	537383.7012
Date	2/02/06

I hereby certify that this United States public land survey monument record is correct and complete to the best of my knowledge and belief.

*Larry D. Hoium* Date 2/02/06  
 \_\_\_\_\_, Anoka County Surveyor  
 Minnesota License Number 18165

3D = 0.06

N = 187818.0634

E = 537383.6368

# CERTIFICATE OF LOCATION OF GOVERNMENT CORNER

County of Anoka

State of Minnesota



West 1/4 Corner of Sec. 8 Township 32 Range 22

On the 25th day of February, 1980, the described corner was evidenced by area resurvey

and to perpetuate the location of said corner, at the exact location thereof, a permanent marker was placed consisting of a red and white Telspar up 1.5'± with sign attached

AND on the 2nd day of February, 2006, said permanent marker was found and the ties were updated

Updated reference ties are as shown below.

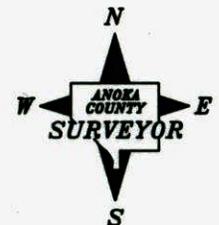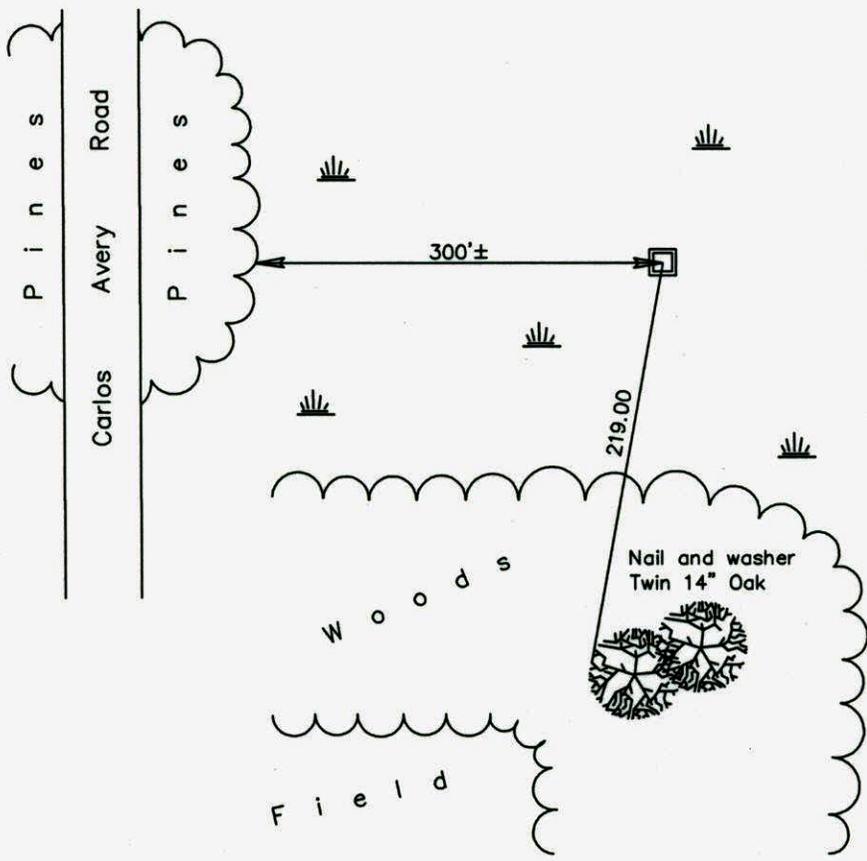

Revised date
8/17/95
3/11/97
2/02/06

N.A.D. 1983 Coordinates (1996 Adjustment)	
County Project Coordinates	
Northing	<u>187818.0268</u>
Easting	<u>537383.7012</u>
Date	<u>2/02/06</u>

I hereby certify that this United States public land survey monument record is correct and complete to the best of my knowledge and belief.

*Larry D. Hoium* Date 2/02/06

\_\_\_\_\_  
Larry D. Hoium, Anoka County Surveyor

Minnesota License Number 18165

# CERTIFICATE OF LOCATION OF GOVERNMENT CORNER

County of Anoka


State of Minnesota

WEST 1/4 Corner of Sec. 8 Township 32 Range 22


I hereby certify that on the 25<sup>TH</sup> day of FEBRUARY, 1980, I found the described corner which was evidenced by AREA RESURVEY

and I further certify that to perpetuate the location of said corner, I did, at the exact location thereof, place a permanent marker consisting of RED & WHITE ~~IRON PIPE~~ <sup>TELESCOPE</sup> WITH SIGN (I.P. UP 1.5'±)

which reference or witness monuments are located in the manner following:

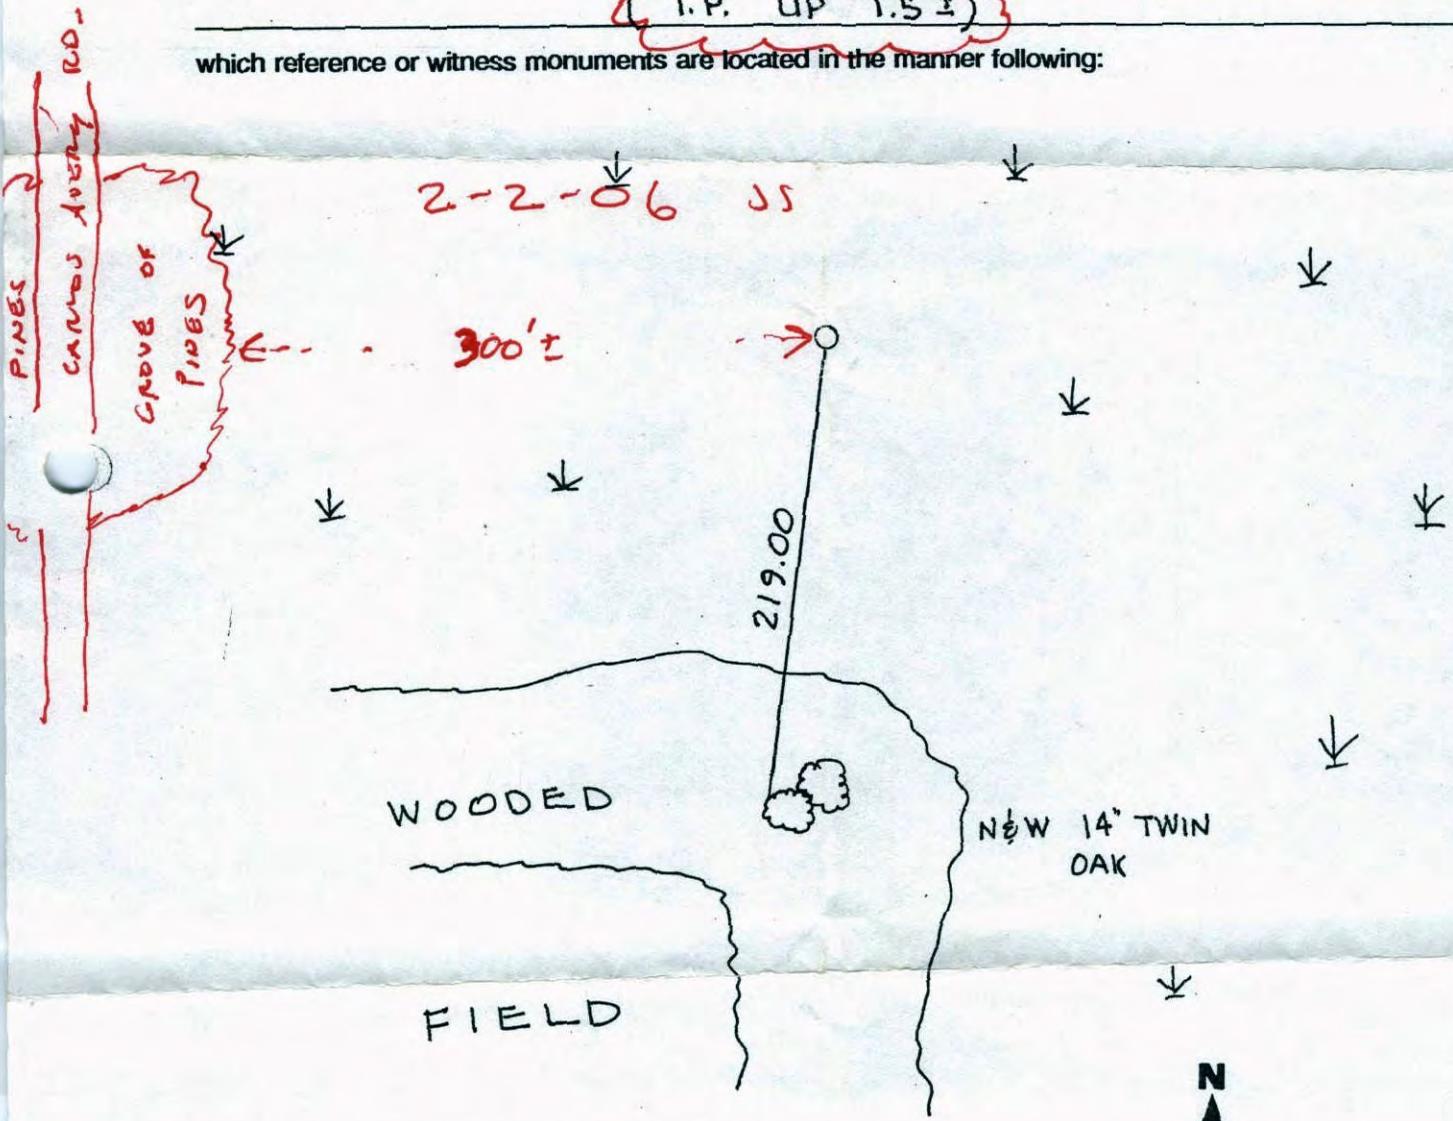

Revised date	Revised date	Revised date
8-17-95		
3-11-97		

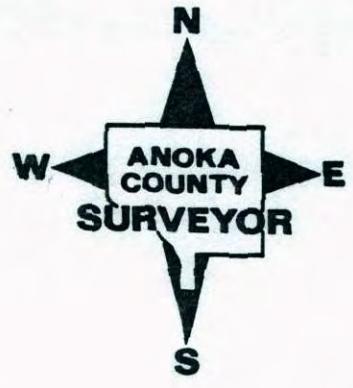

# CERTIFICATE OF LOCATION OF GOVERNMENT CORNER

County of Anoka


State of Minnesota

WEST 1/4 Corner of Sec. 8 Township 32 Range 22


I hereby certify that on the 25<sup>TH</sup>-day of FEBRUARY, 1980, I found the described corner which was evidenced by AREA RESURVEY

and I further certify that to perpetuate the location of said corner, I did, at the exact location thereof, place a permanent marker consisting of RED & WHITE IRON PIPE WITH SIGN  
( I.P. UP 1.5'± )

which reference or witness monuments are located in the manner following:

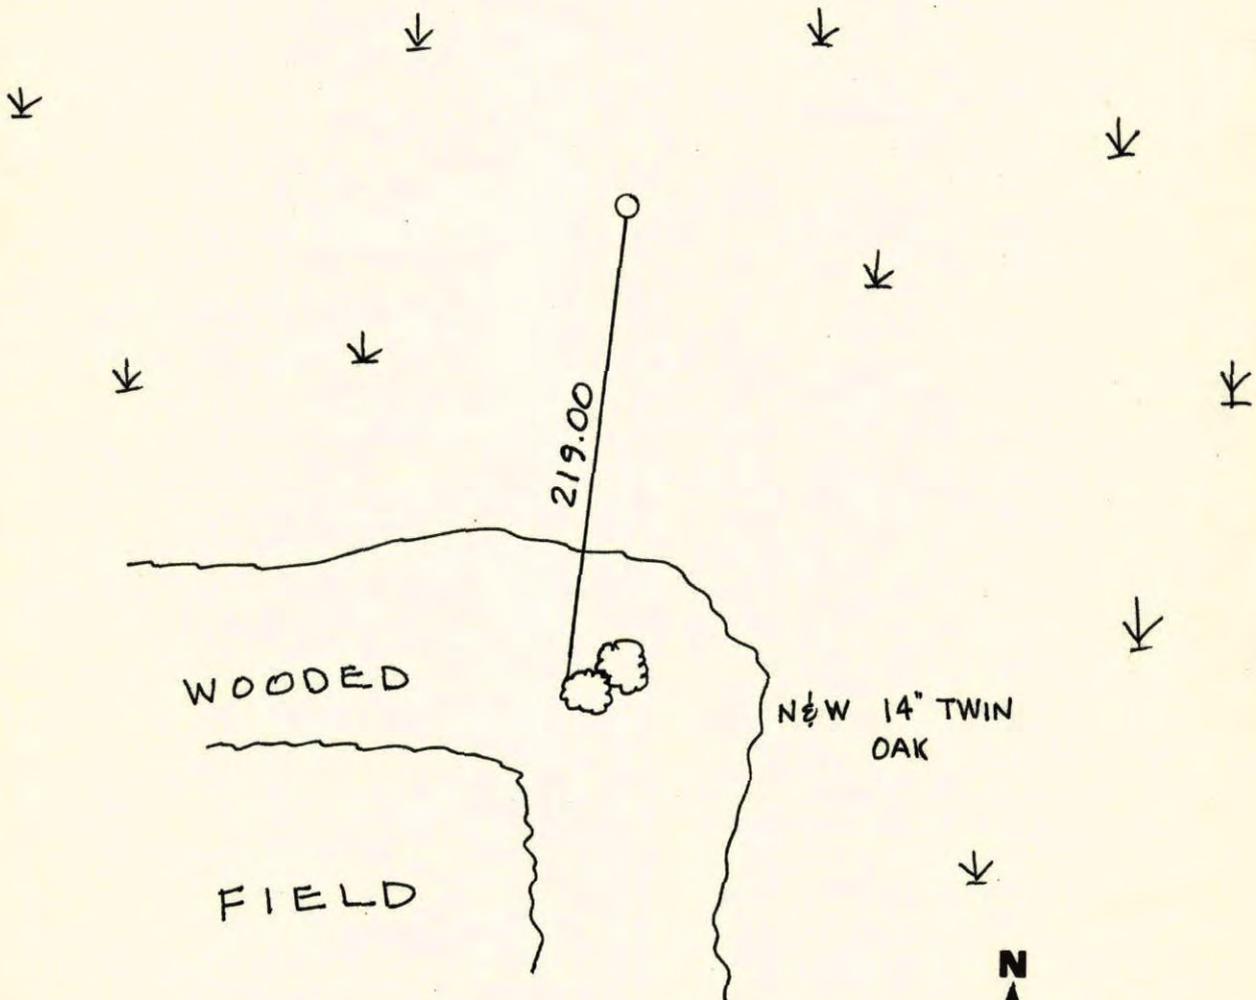


Revised date	Revised date	Revised date
8-17-95		
3-11-97		

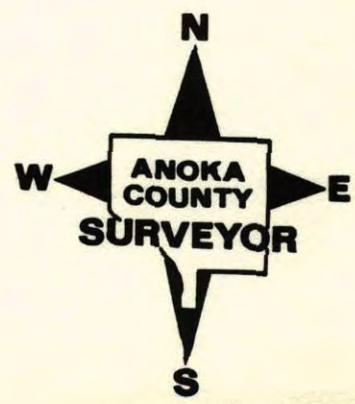


W 1/4 CORNER SECTION 8 T32 R22

RETIED RED AND WHITE IRON PIPE  
WITH SIGN

IP up 1.5' ±

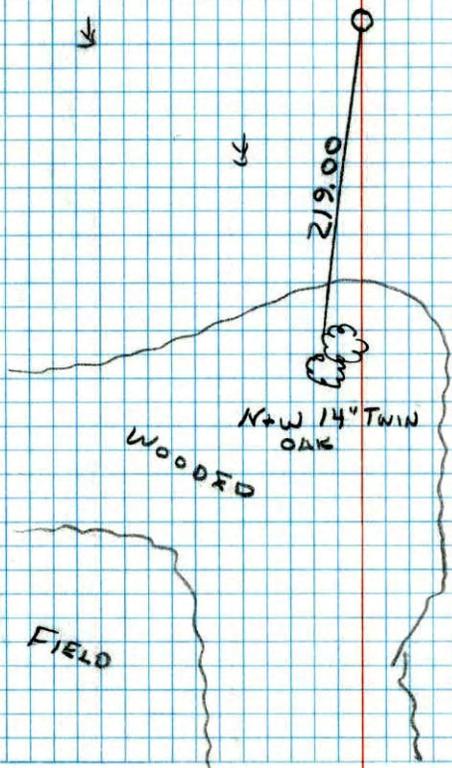3-11-97  
L. LARSON  
B. KLEMZ  
S. SIMMER

W 1/4 CORNER SECTION 8 - T32 - R22

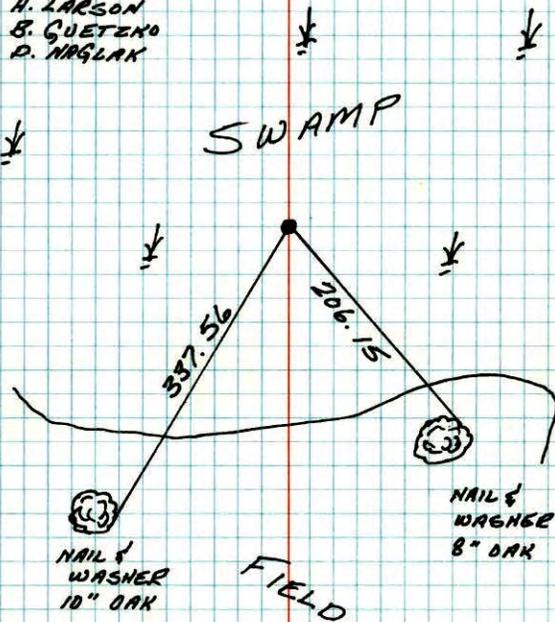SET RED AND WHITE IRON PIPE FROM AREA  
RESURVEY. IRON PIPE UP 3' ± WITH SIGN.25 FEB 80  
H. LARSON  
B. GUETZHO  
D. HAGLAKTEMPERATURE CORRECTED  
AND HORIZONTALLY  
TAPED MEASUREMENTSROLAND W. ANDERSON  
COUNTY SURVEYOR  
ANOKA COUNTY, MINNESOTA

W 1/4 CORNER SECTION 8 T32 R22

SET RED AND WHITE IRON PIPE

FROM AREA RESURVEY, 1P UP 3'±

WITH SIGN

200' 12"  
2-25-80  
H. LARSON  
B. Guetzko  
D. Naglak

SWAMP

337.113  
337.59  
337.56

209.2  
209.23  
209.15

NW  
10" OAK

NW  
8" OAK

FIELD

NO. 448

WTELETYPE