

CERTIFICATE OF LOCATION OF GOVERNMENT CORNER

County of Anoka

State of Minnesota



North $\frac{1}{4}$ Corner of Sec. 3 Township 32 Range 22

On the 23rd day of March, 1979, the described corner was evidenced by Area Resurvey

and to perpetuate the location of said corner, at the exact location thereof, a permanent marker was placed consisting of a Cast Iron Monument with a sign and post on the north side

AND on the 7th day of November, 2007, said permanent marker was found and the ties were updated.

Updated reference ties are as shown below.

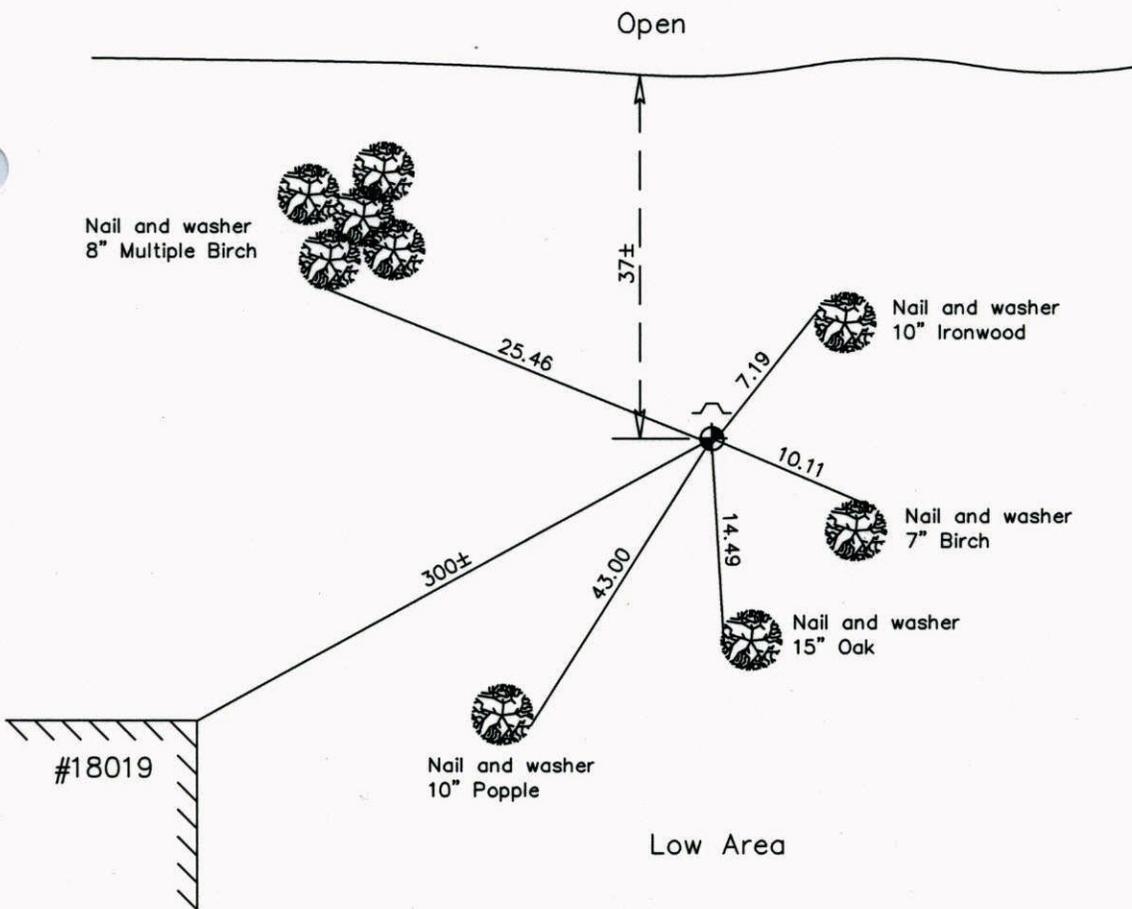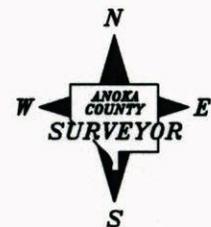

Revised date
2/3/88
6/14/90
8/14/95
11/7/07

N.A.D. 1983 Coordinates (1996 Adjustment)	
County Project Coordinates	
Northing	195499.5904
Easting	550470.7912
Date	4/28/05

I hereby certify that this United States public land survey monument record is correct and complete to the best of my knowledge and belief.

Date 11/7/07

Larry D. Hoium, Anoka County Surveyor
 Minnesota License Number 18165

CERTIFICATE OF LOCATION OF GOVERNMENT CORNER

County of Anoka

State of Minnesota


NORTH 1/4 Corner of Sec. 3 Township 32 Range 22

I hereby certify that on the 23 day of MARCH, 1979, I found the described corner which was evidenced by AREA RESURVEY

and I further certify that to perpetuate the location of said corner, I did, at the exact location thereof, place a permanent marker consisting of CAST IRON MONUMENT SIGN AND POST NORTH SIDE

which reference or witness monuments are located in the manner following:

O P E N

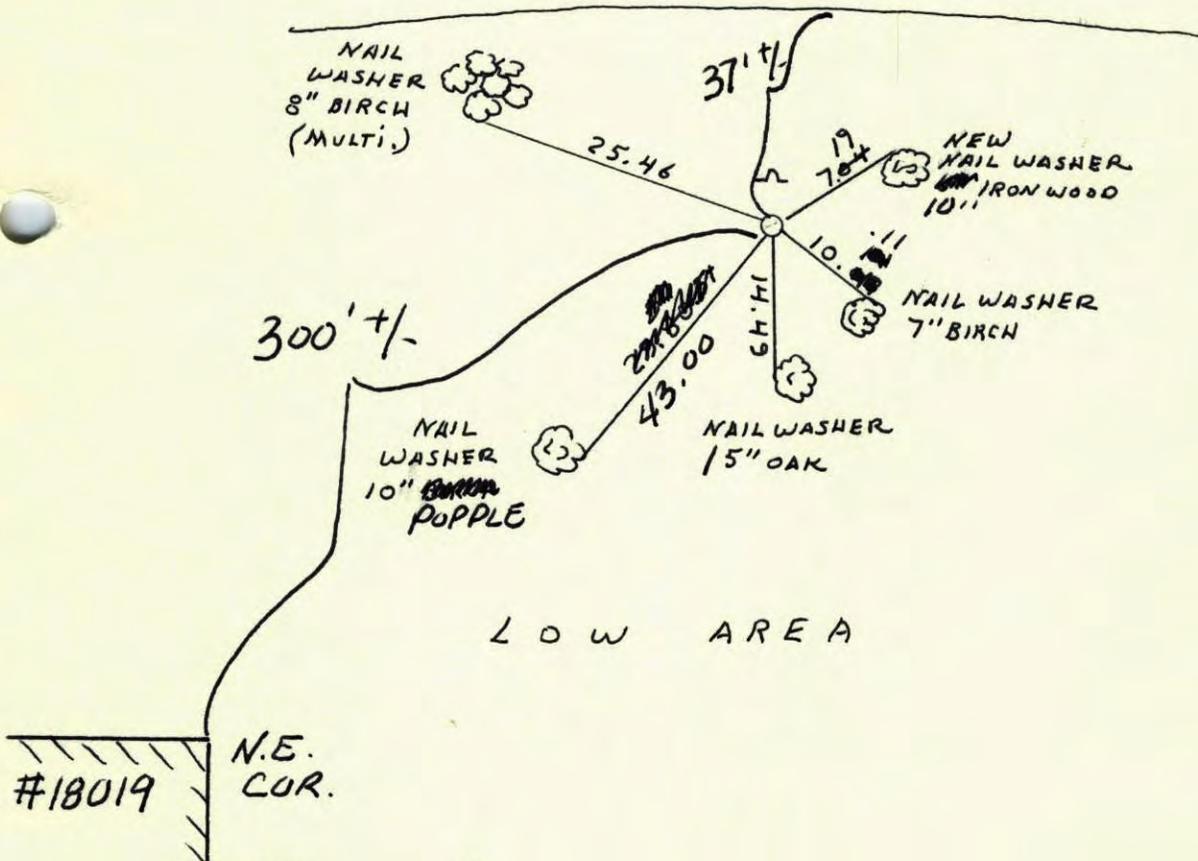

L O W A R E A

#18019 N.E. COR.

Revised date
8-13-85
REDRAWN
2-3-88
6-14-90
8-14-95
11-7-07

By
D. ROSS
H. LARSON
ZIMMERMAN

Minnesota State Plane Coordinates
South Zone

Y _____ X _____

_____,
County Surveyor Date

Registered Land Surveyor No. _____

CERTIFICATE OF LOCATION OF GOVERNMENT CORNER

County of Anoka

State of Minnesota


NORTH 1/4 Corner of Sec. 3 Township 32 Range 22

I hereby certify that on the 23 day of MARCH, 1979, I found the described corner which was evidenced by AREA RESURVEY

and I further certify that to perpetuate the location of said corner, I did, at the exact location thereof, place a permanent marker consisting of CAST IRON MONUMENT SIGN AND POST NORTH SIDE

which reference or witness monuments are located in the manner following:

O P E N

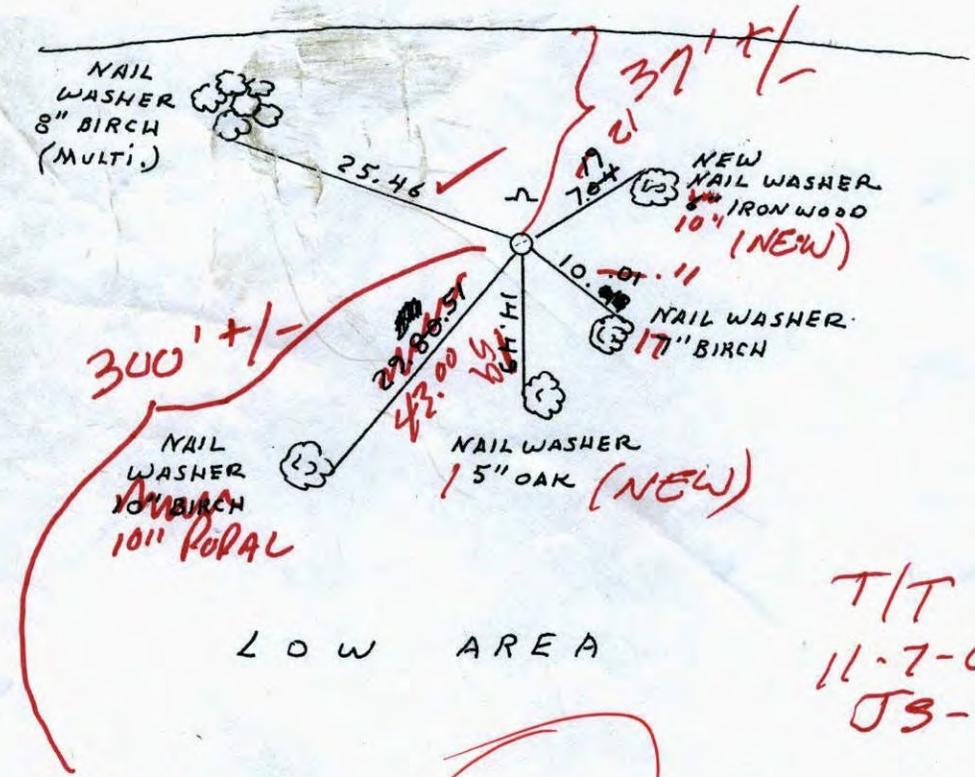

T/T
11-7-07
JS-BK

#18019
USURI ST.
N.E. COR

Revised date	By
8-13-85	D. ROSS
REDRAWN 2-3-88	H. LARSON
6-14-90	ZIMMERMAN
8-14-95	

Minnesota State Plane Coordinates
South Zone


Y _____ X _____

County Surveyor _____ Date _____

Registered Land Surveyor No. _____

North 1/4 Corner Sec. 3 T32 R22

Retied Cast Iron Monument

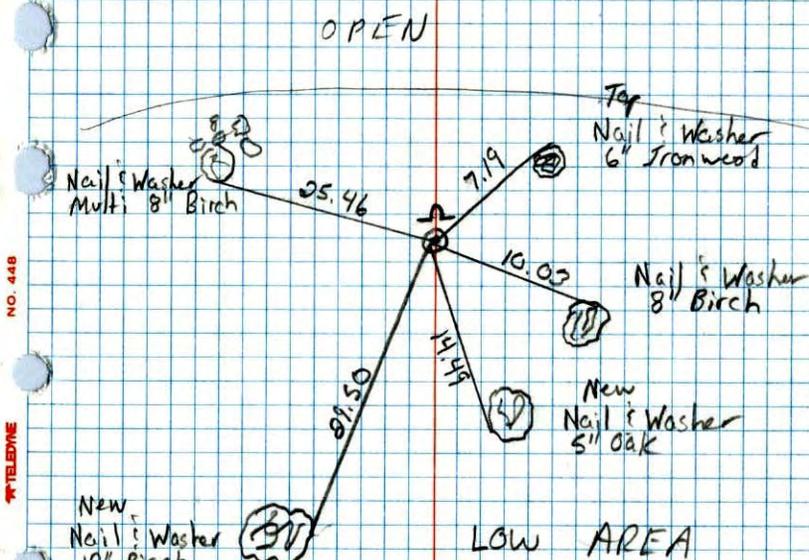

NO. 448






LOW AREA

6-14-90
M. Zimmerman
D. Klersy

N 1/4 CORNER SECTION 3 - T32 - R22

SET CAST IRON MONUMENT FROM AREA RESURVEY.
CAST IRON FLUSH WITH SIGN AND POST ON NORTH SIDE.

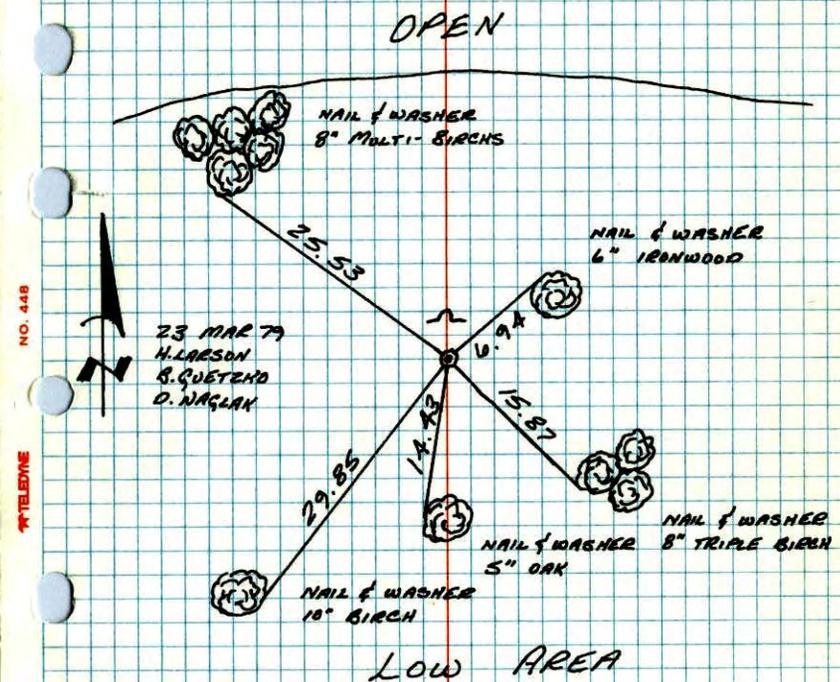

NO. 448




23 MAR 79
H. LARSON
R. QUETEND
D. WAGLAN

LOW AREA

TEMPERATURE CORRECTED
AND HORIZONTALLY
TAPED MEASUREMENTS

ROLAND W. ANDERSON
COUNTY SURVEYOR
ANOKA COUNTY, MINNESOTA

N 1/4 Cor. Section 3 T32 R22

Set cast iron monument from
area resurvey c/c. Flush with sign
and post on N. side.

3-23-79

#1 35°

H. Larson
B. Guetzko
D. Naglak

O P E N

N+W
8" multi birch



25.53

N+W
6" Ironwood



6.94



N+W
10" birch

29.85

14.43

15.87

5" OAK

N+W

8" Tripla
birch

N+W
8" Tripla
birch

LOW area