



# CERTIFICATE OF LOCATION OF GOVERNMENT CORNER

County of Anoka

State of Minnesota



North 1/4 Corner of Sec. 21 Township 32 Range 22

On the \_\_\_ day of July, 1967, the described corner was evidenced by a 1/2" iron pipe

and to perpetuate the location of said corner, at the exact location thereof, a permanent marker was placed consisting of a cast iron monument down 2'±

AND on the 14th day of November, 2007, said permanent marker was found and the ties were updated

Updated reference ties are as shown below.

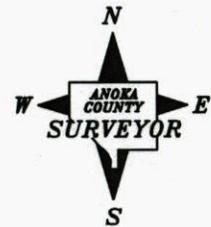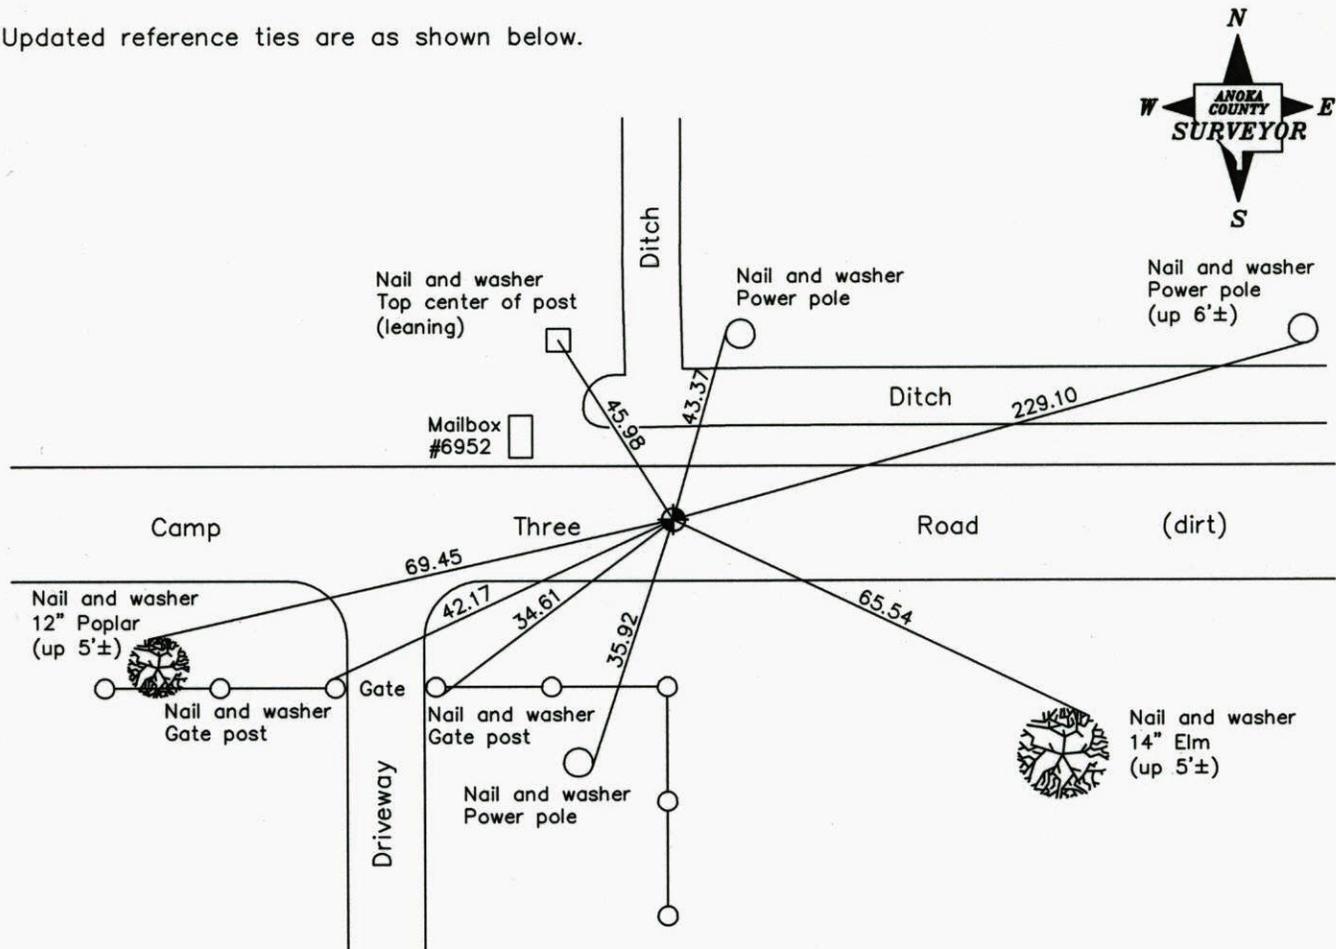

Revised date
8/11/89
12/26/95
11/14/07

N.A.D. 1983 Coordinates (1996 Adjustment)	
County Project Coordinates	
Northing	<u>179959.2901</u>
Easting	<u>545281.7544</u>
Date	<u>6/24/03</u>

I hereby certify that this United States public land survey monument record is correct and complete to the best of my knowledge and belief.

*Larry D. Hoium* Date 11/14/07

Larry D. Hoium, Anoka County Surveyor

Minnesota License Number 18165

# CERTIFICATE OF LOCATION OF GOVERNMENT CORNER

County of Anoka


State of Minnesota

NORTH 1/4 Corner of Sec. 21 Township 32 Range 22


I hereby certify that on the      day of JULY, 1967, I found the described corner which was evidenced by 1/2" IRON PIPE

and I further certify that to perpetuate the location of said corner, I did, at the exact location thereof, place a permanent marker consisting of CAST IRON MON'T. (DOWN 2' +/-)

which reference or witness monuments are located in the manner following:

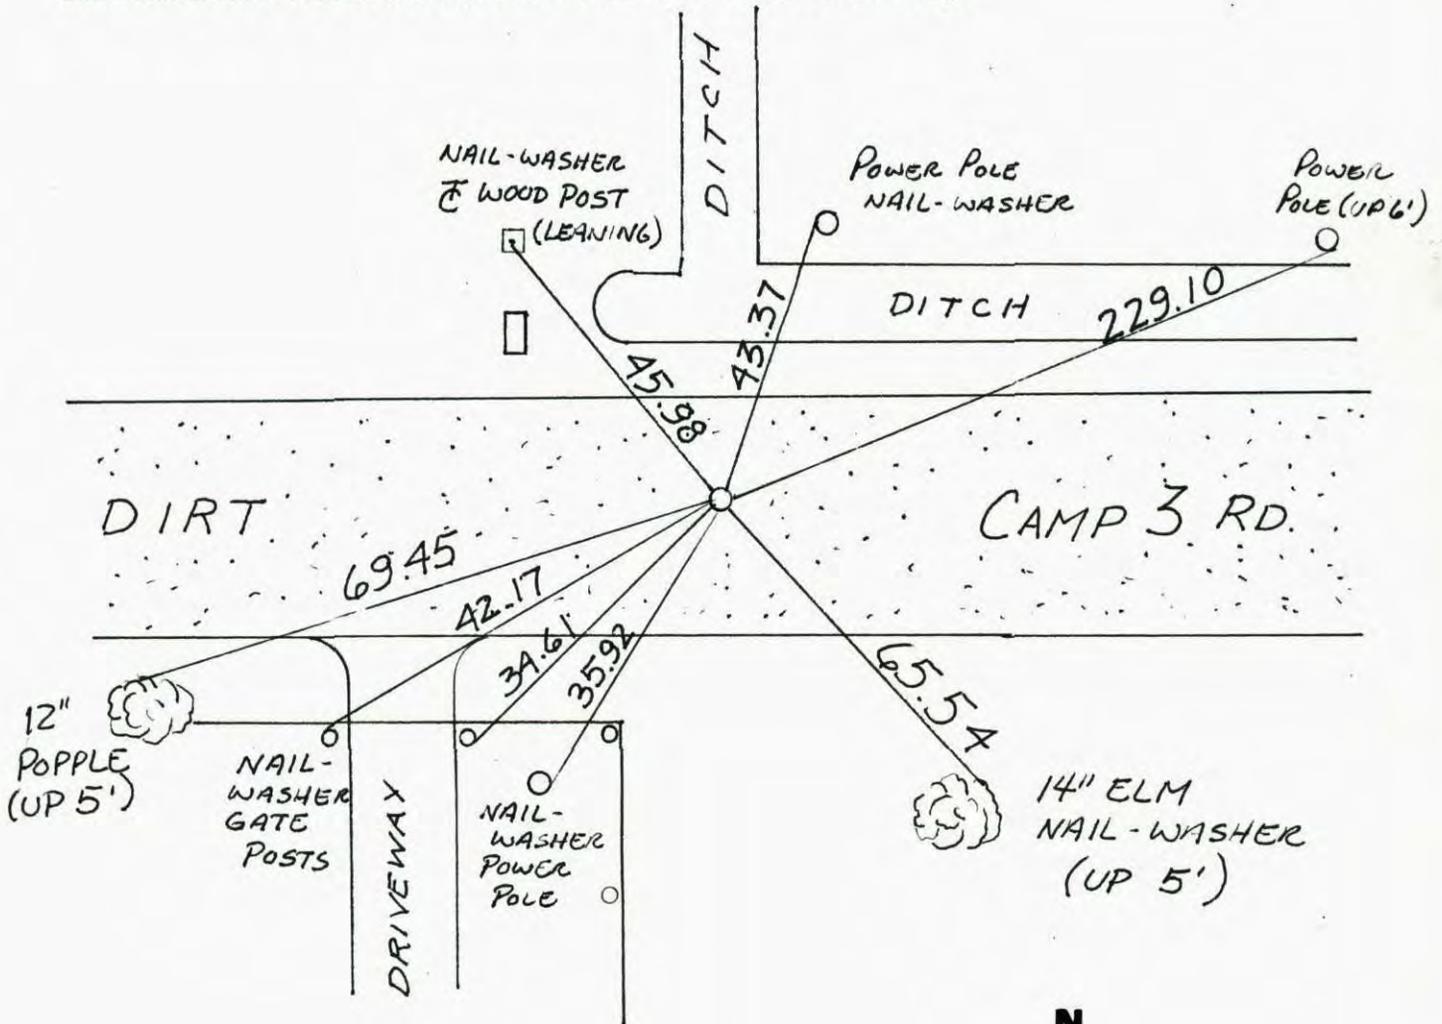

Revised date	Revised date	Revised date
6 7 73	11 14 07	
8 10 76		
8 1 79		
7 22 82		
8 6 85		
8 11 89		
12 26 95		

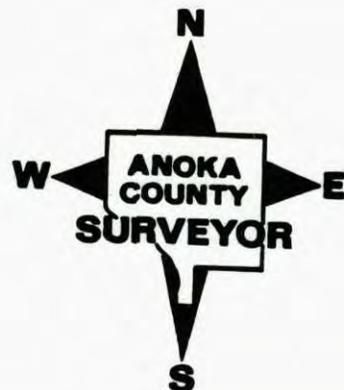

*Not Done*

# CERTIFICATE OF LOCATION OF GOVERNMENT CORNER


County of Anoka State of Minnesota

NORTH 1/4 Corner of Sec. 21 Township 32 Range 22


I hereby certify that on the      day of July, 1967, I found the described corner which was evidenced by 1/2" IRON PIPE

and I further certify that to perpetuate the location of said corner, I did, at the exact location thereof, place a permanent marker consisting of CAST IRON MONUMENT  
**DOWN 2'**


which reference or witness monuments are located in the manner following:

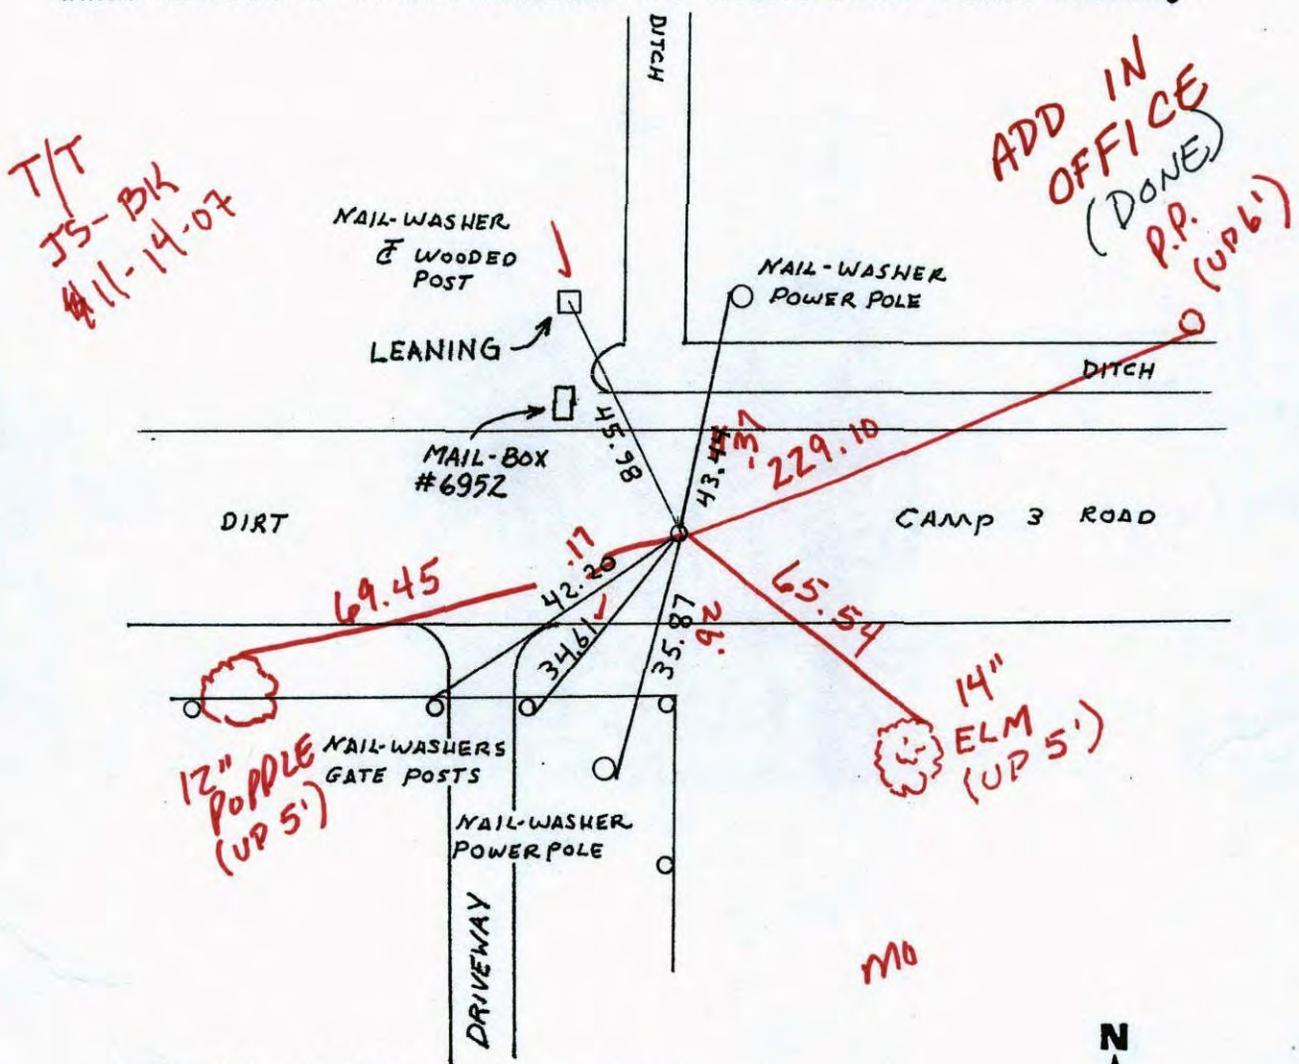


Revised date	Revised date	Revised date
7-67	12-26-95	
6-7-73		
8-10-76		
8-1-79		
7-22-82		
8-6-85		
8-11-89		

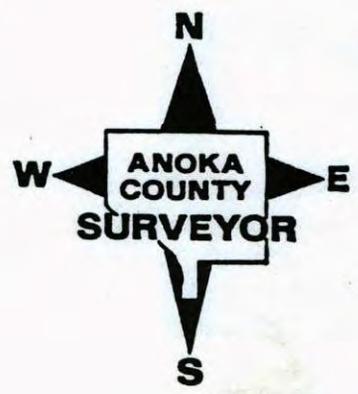

NORTH 1/4 COR. SECTION 21 T32 R22  
RETIED CAST IRON MON.

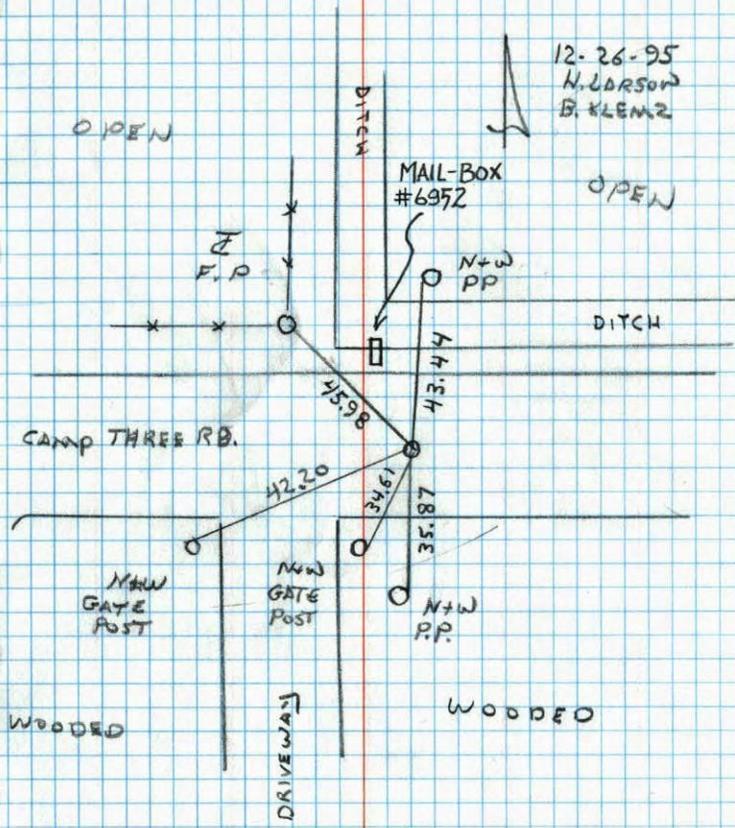


NORTH 1/4 CORNER SEC. 21 T32 R22  
RETIED CAST IRON 1/2' DOWN. ±

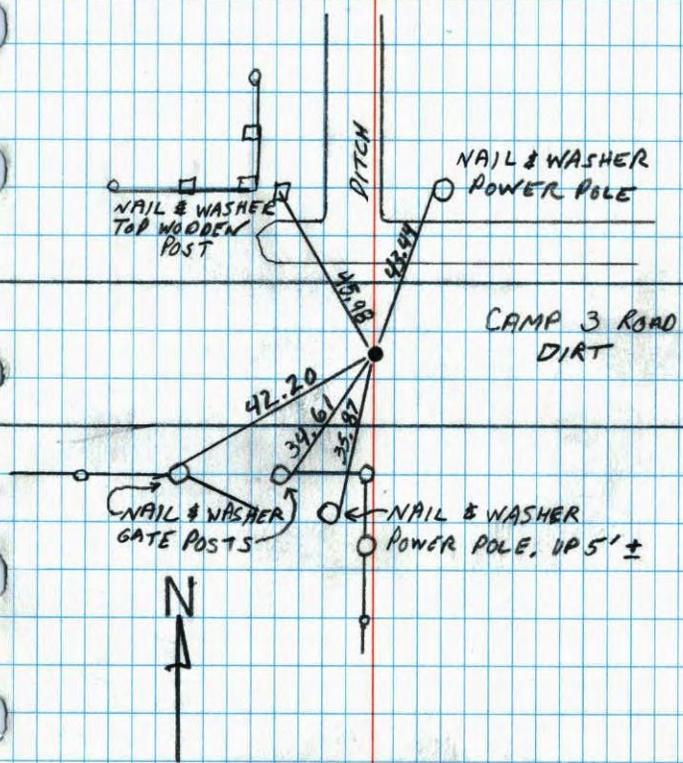

# N $\frac{1}{4}$ Cor. Sec. 21-T32-R22

$\frac{1}{2}$ " Open End Iron in centerline of gravel road.

Replaced with Cast Iron Monument down 0.6't. James L. Kurth  
July, 1967

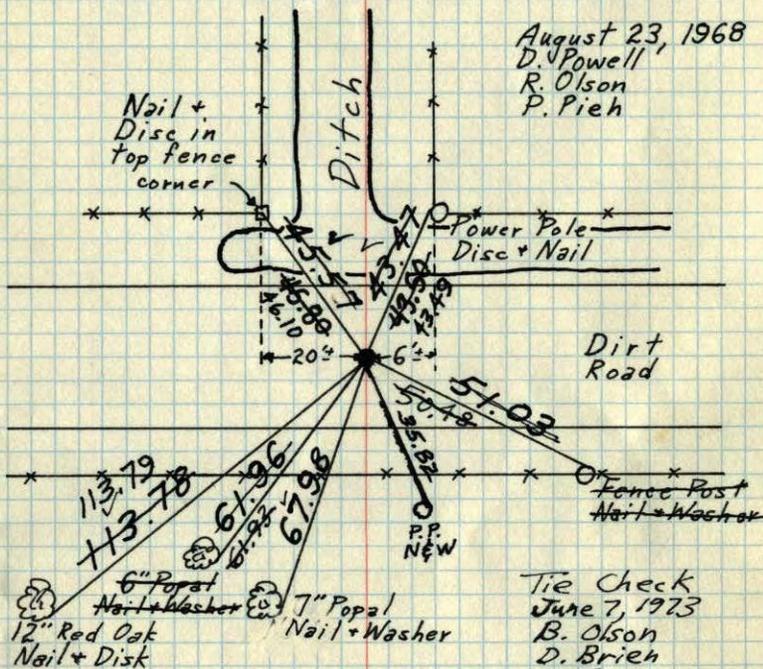

Tie Check  
June 7, 1973  
B. Olson  
D. Brien  
D. Farmer  
TIE CHECK  
8-10-76  
G. ADAMS  
S. BRIEN  
J. STEPHENS

TIE CHECK  
8-1-79  
B. STEPHENS  
D. STEPHENS  
P. ROSS  
TAPE #2 82°


TEMPERATURE CORRECTED  
AND HORIZONTALLY  
TAPED MEASUREMENTS

ROLAND W. ANDERSON  
COUNTY SURVEYOR  
ANOKA COUNTY, MINNESOTA

# N $\frac{1}{4}$ Cor. Sec. 21-T32-R22

$\frac{1}{2}$ " Open End Iron in centerline of gravel road.

Down 0.3't. James L. Kurth  
July, 1967

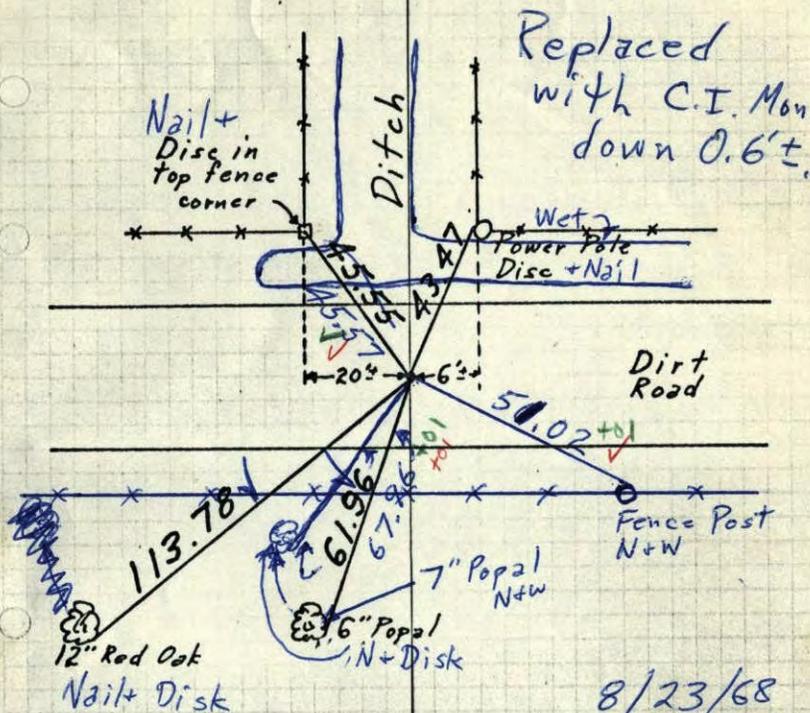

8/23/68  
#6-80°  
D. Powell  
R. Olson  
P. Pich