

# CERTIFICATE OF LOCATION OF GOVERNMENT CORNER

County of Anoka State of Minnesota


## Northeast Corner of Sec. 20 Township 32 Range 22

On the 4th day of June, 1962, the described corner was evidenced by a broken off concrete monument

and to perpetuate the location of said corner, at the exact location thereof, a permanent marker was placed consisting of a cast iron monument on top of the concrete monument down 2'±

AND on the 14th day of November, 2007, said permanent marker was found and the ties were updated

Updated reference ties are as shown below.

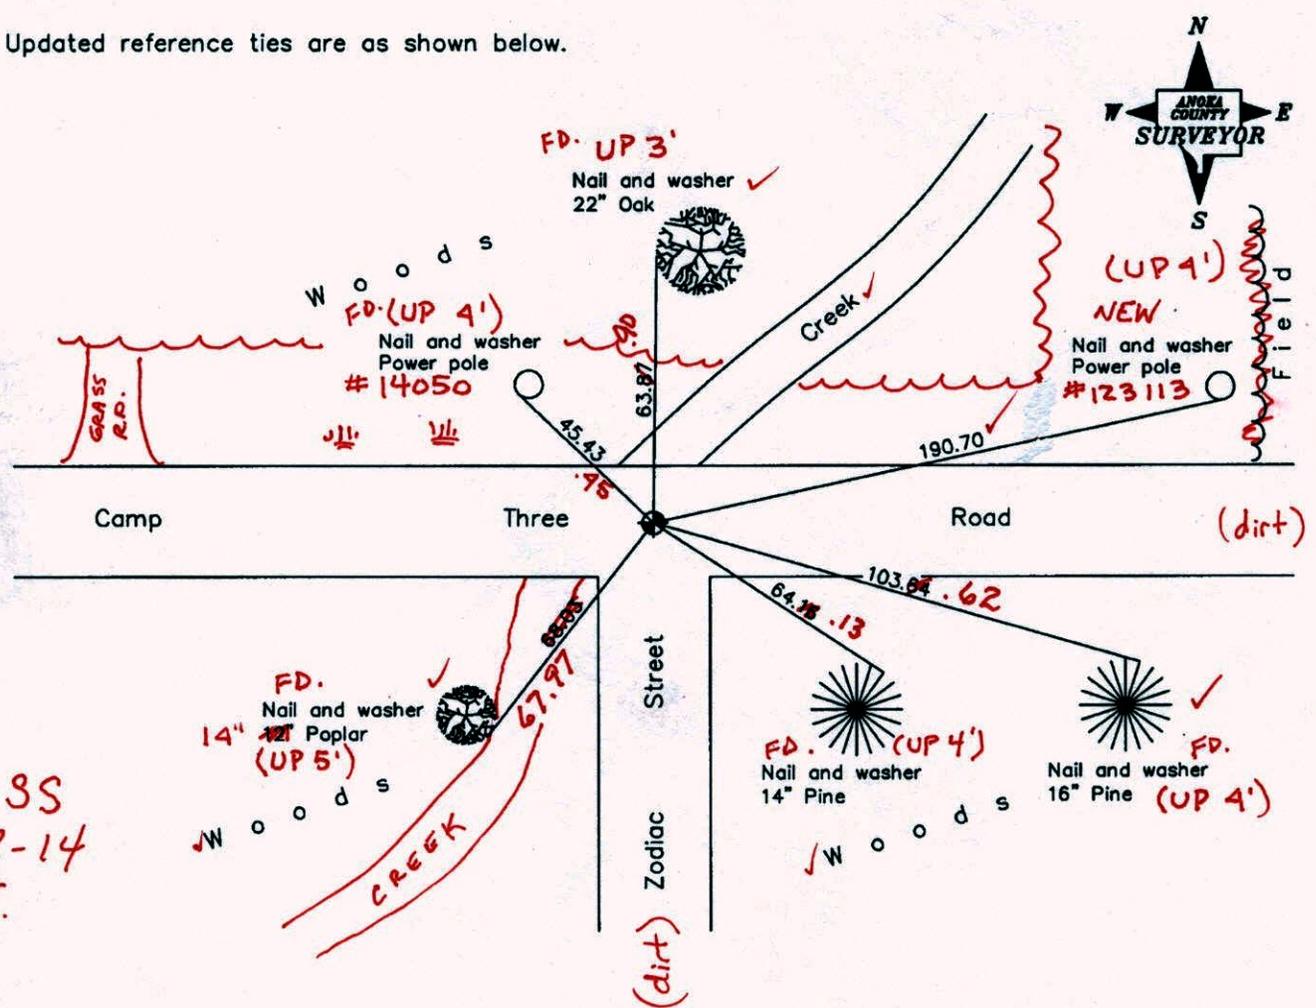

BK-SS  
9-12-14  
T./T.

Revised date
8/11/89
8/11/95
11/14/07

N.A.D. 1983 Coordinates (1996 Adjustment)	
County Project Coordinates	
Northing	179939.4957
Easting	542682.4635
Date	3/19/03

I hereby certify that this United States public land survey monument record is correct and complete to the best of my knowledge and belief.

*Larry D. Hoium* Date 11/14/07

Larry D. Hoium, Anoka County Surveyor

Minnesota License Number 18165

# CERTIFICATE OF LOCATION OF GOVERNMENT CORNER

County of Anoka

State of Minnesota


Northeast Corner of Sec. 20 Township 32 Range 22

On the 4th day of June, 1962, the described corner was evidenced by a broken off concrete monument

and to perpetuate the location of said corner, at the exact location thereof, a permanent marker was placed consisting of a cast iron monument on top of the concrete monument down 2'±

AND on the 14th day of November, 2007, said permanent marker was found and the ties were updated

Updated reference ties are as shown below.

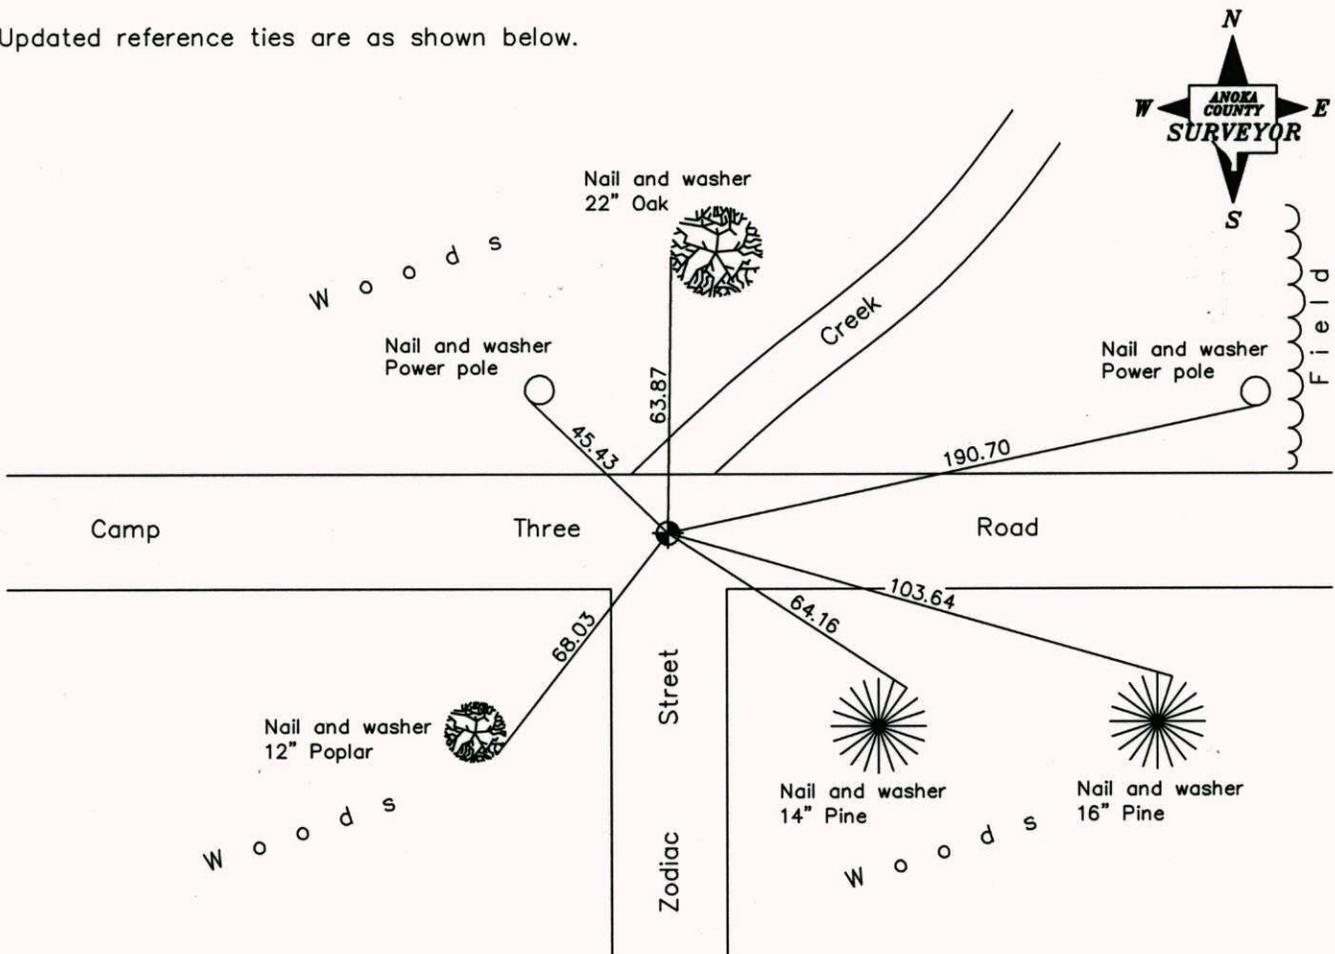

Revised date
8/11/89
8/11/95
11/14/07

N.A.D. 1983 Coordinates (1996 Adjustment)	
County Project Coordinates	
Northing	<u>179939.4957</u>
Easting	<u>542682.4635</u>
Date	<u>3/19/03</u>

I hereby certify that this United States public land survey monument record is correct and complete to the best of my knowledge and belief.

*Larry D. Hoium* Date 11/14/07

Larry D. Hoium, Anoka County Surveyor

Minnesota License Number 18165

# CERTIFICATE OF LOCATION OF GOVERNMENT CORNER

County of Anoka


State of Minnesota

NORTHEAST Corner of Sec. 20 Township 32 Range 22


I hereby certify that on the 4 day of JUNE, 1962, I found the described corner which was evidenced by A BROKEN OFF CONCRETE MONUMENT

and I further certify that to perpetuate the location of said corner, I did, at the exact location thereof, place a permanent marker consisting of CAST IRON MONUMENT ON TOP OF CONCRETE MONUMENT DOWN 2.0'±

which reference or witness monuments are located in the manner following:

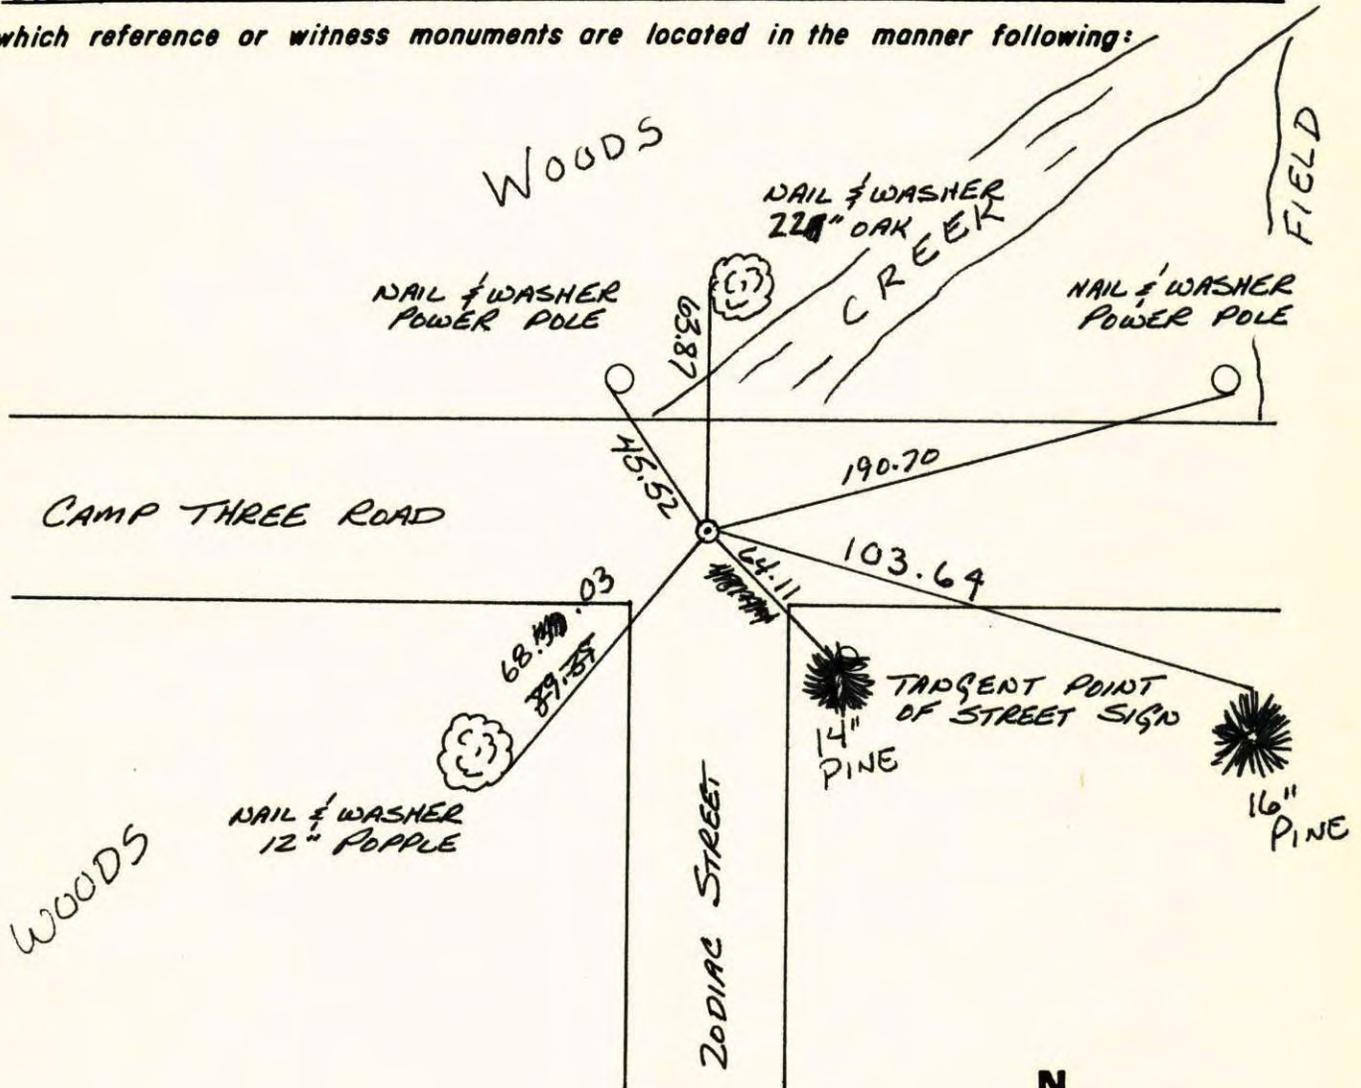

Revised date	Revised date	Revised date
8-10-76		
8-1-79		
7-14-82		
8-6-85		
8-11-89		
8-11-95		
11-14-07		

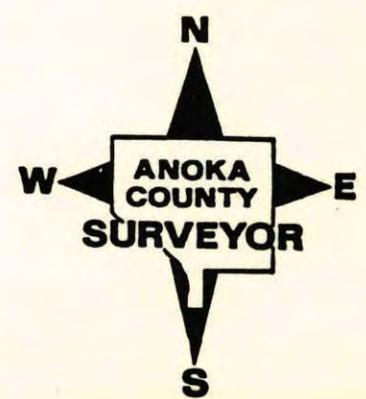

# CERTIFICATE OF LOCATION OF GOVERNMENT CORNER


County of Anoka

State of Minnesota


NORTHEAST Corner of Sec. 20 Township 32 Range 22

I hereby certify that on the 4 day of JUNE, 1962, I found the described corner which was evidenced by A BROKEN OFF CONCRETE MONUMENT

and I further certify that to perpetuate the location of said corner, I did, at the exact location thereof, place a permanent marker consisting of CAST IRON MONUMENT ON TOP OF CONCRETE MONUMENT DOWN 2.0'± which reference or witness monuments are located in the manner following:

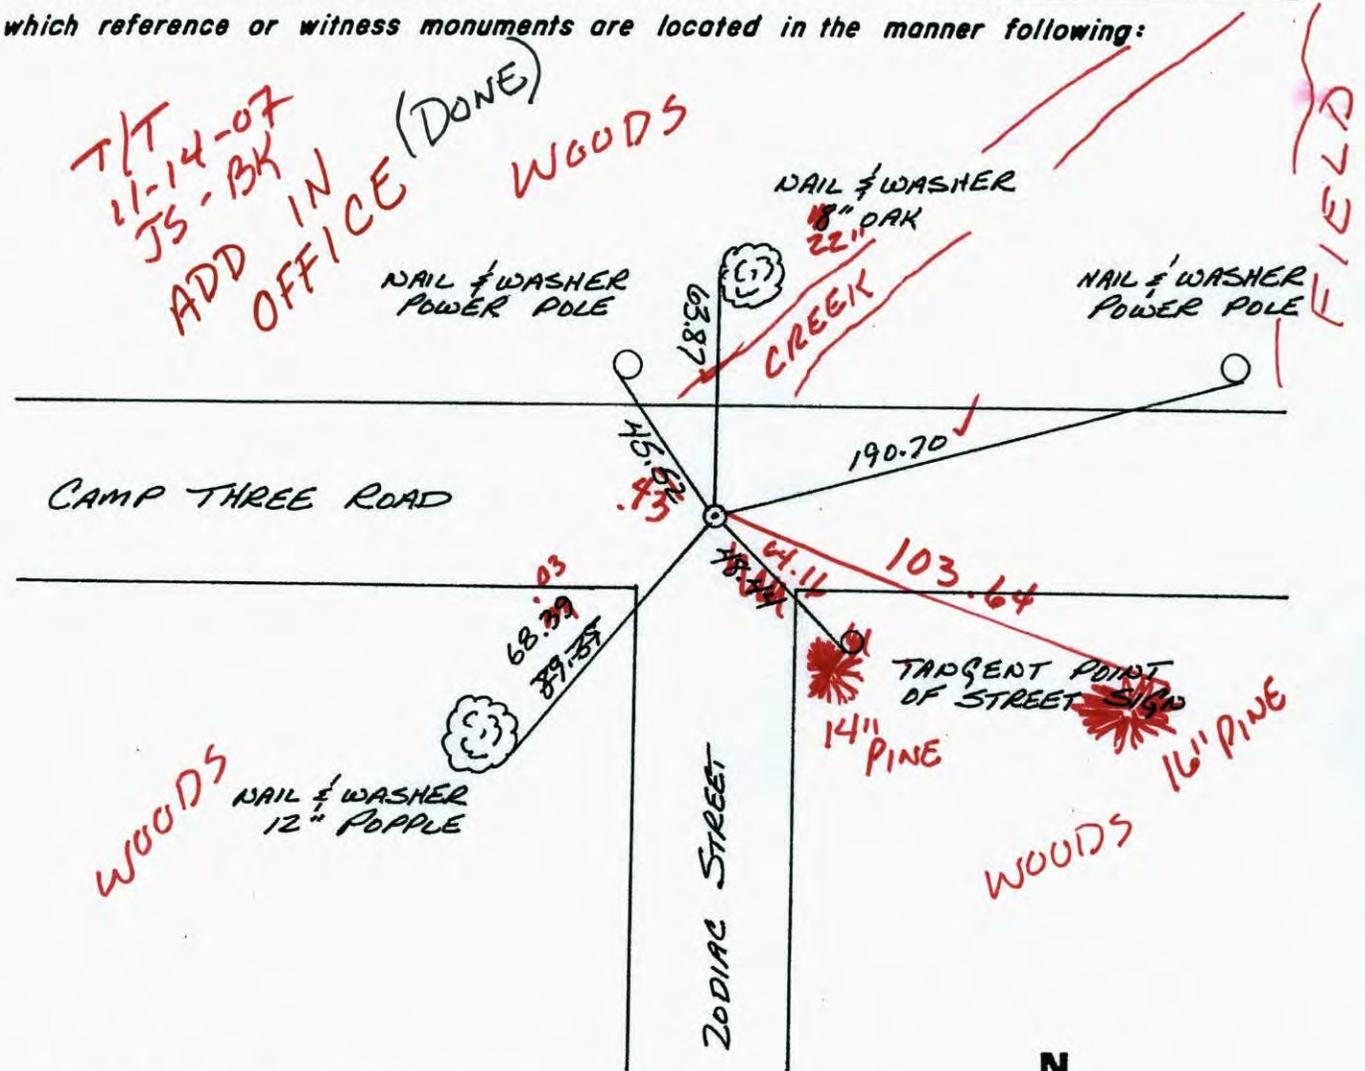


Revised date	Revised date	Revised date
8-10-76		
8-1-79		
7-14-82		
8-6-85		
8-11-89		
8-11-95		

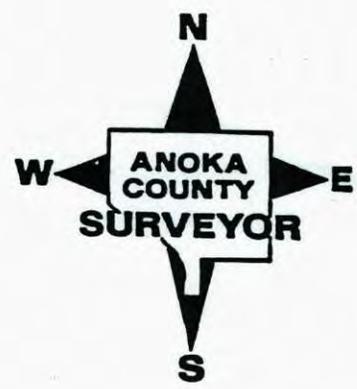

Northeast Corner Sec. 20 T32 R22


Retied Cast Iron Monument on Top of Broken Concrete Mon.

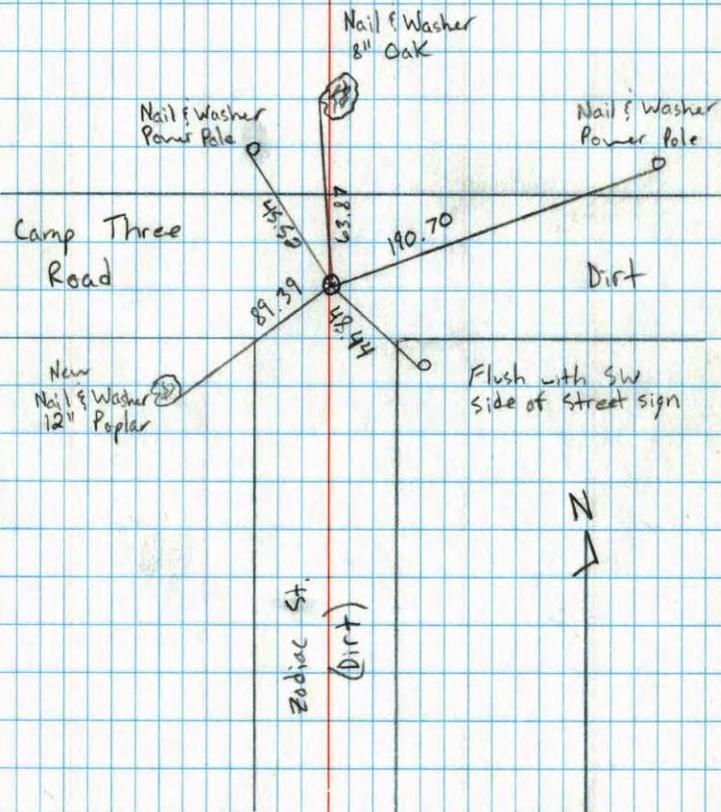

8-11-89  
M. Zimmerman  
A. Shroyer

N.E. CORNER SEC. 20 T.32 R.22

FOUND BROKEN 4" X 6" CONCRETE MONUMENT  
DOWN 2'±. SET CAST IRON MONUMENT DOWN  
0.4'± ON TOP OF BROKEN CONCRETE.

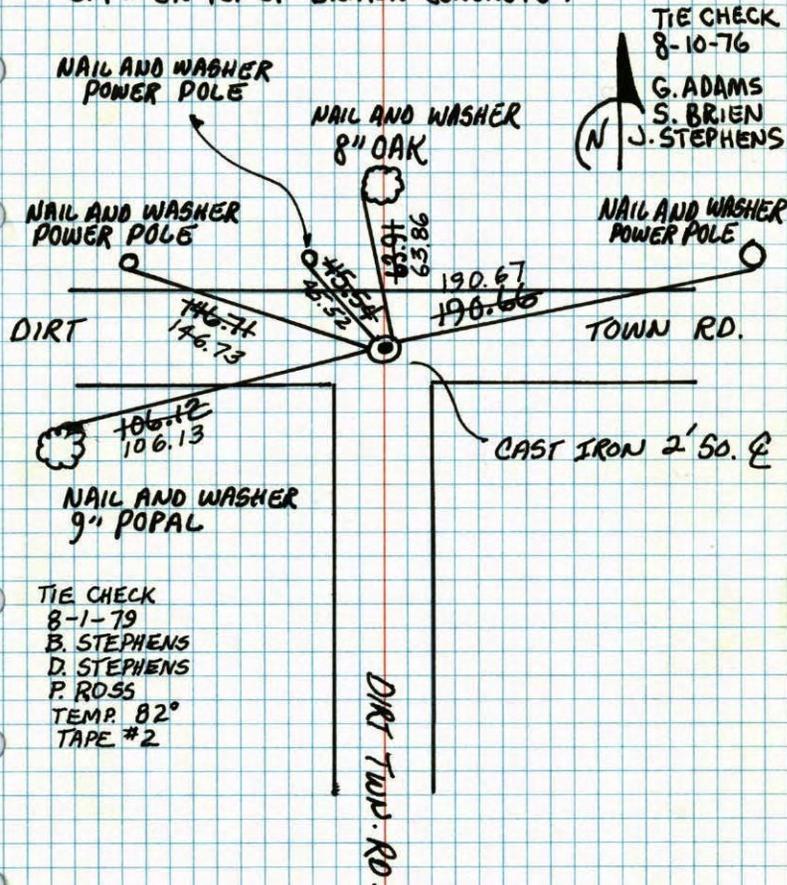

TIE CHECK  
8-10-76


G. ADAMS  
S. BRIEN  
J. STEPHENS

TIE CHECK  
8-1-79  
B. STEPHENS  
D. STEPHENS  
P. ROSS  
TEMP. 82°  
TAPE #2

TEMPERATURE CORRECTED ROLAND W. ANDERSON  
AND HORIZONTALLY COUNTY SURVEYOR  
TAPED MEASUREMENTS ANOKA COUNTY, MINNESOTA

73  
N.E. Cor. Sec. 20-32-22

found Broken off 4"x6" Concret  
monument down ~~2.0'~~ 2.0'  
Set Cast Iron Mon. down 0.4'± on top of broken  
Set 1/2" Iron pipe on North face concrete.

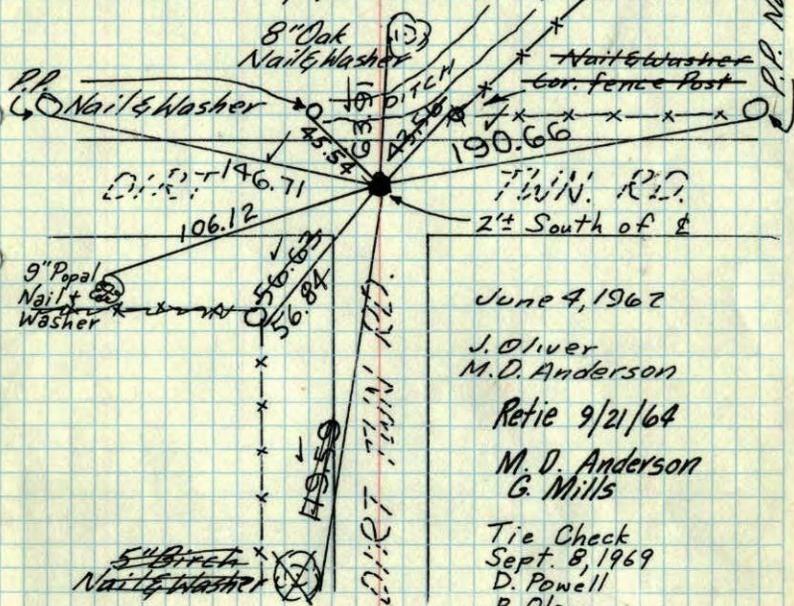

June 4, 1962

J. Oliver  
M.D. Anderson

Retie 9/21/64

M. D. Anderson  
G. Mills

Tie Check  
Sept. 8, 1969  
D. Powell  
R. Olson  
B. Olson


Tie Check  
June 7, 1973  
B. Olson  
D. Brien  
D. Farmer

SEE NEW TIES

ROLAND W. ANDERSON COUNTY SURVEYOR ANOKA COUNTY, MINNESOTA  
TEMPERATURE CORRECTED AND HORIZONTALLY TAPED MEASUREMENTS

33  
N.E. Cor. Sec. 20-32-22

found Broken off 4"x6" Concret  
monument down 0.3'  
Set C.I. Mon. down 0.4'± on top of  
Set 1/2" Iron pipe on North face broken  
Concrete.

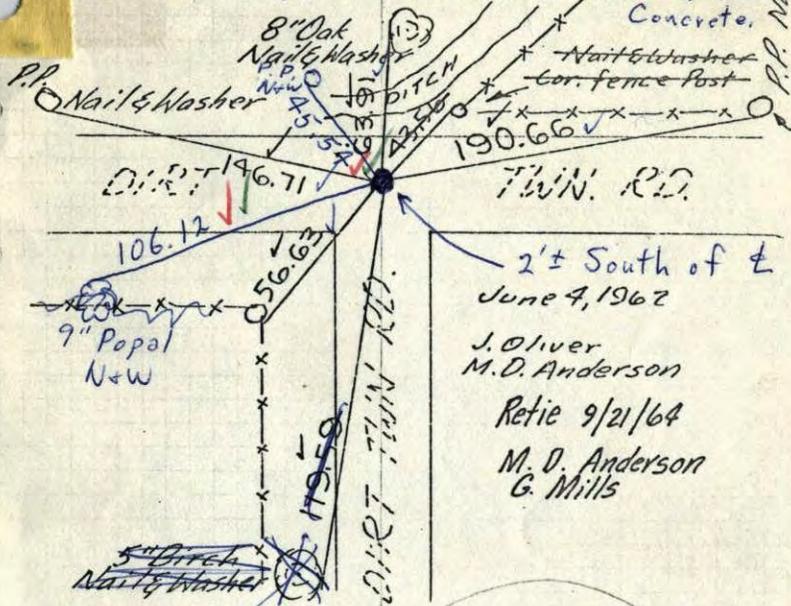

June 4, 1962

J. Oliver  
M.D. Anderson

Retie 9/21/64

M. D. Anderson  
G. Mills

9/8/69  
# 9-65  
D. Powell  
R. Olson  
B. Olson


Down 1.1'  
Jim Kurtha  
7/14/67

ROLAND W. ANDERSON COUNTY SURVEYOR ANOKA COUNTY, MINNESOTA  
TEMPERATURE CORRECTED AND HORIZONTALLY TAPED MEASUREMENTS

NE Cor Sec. 20, T32, R22


Found Broken off 4" x 6" Reinforced Conc.

Mon. down 0.3' - Set 3/4" I.P. on No. Side

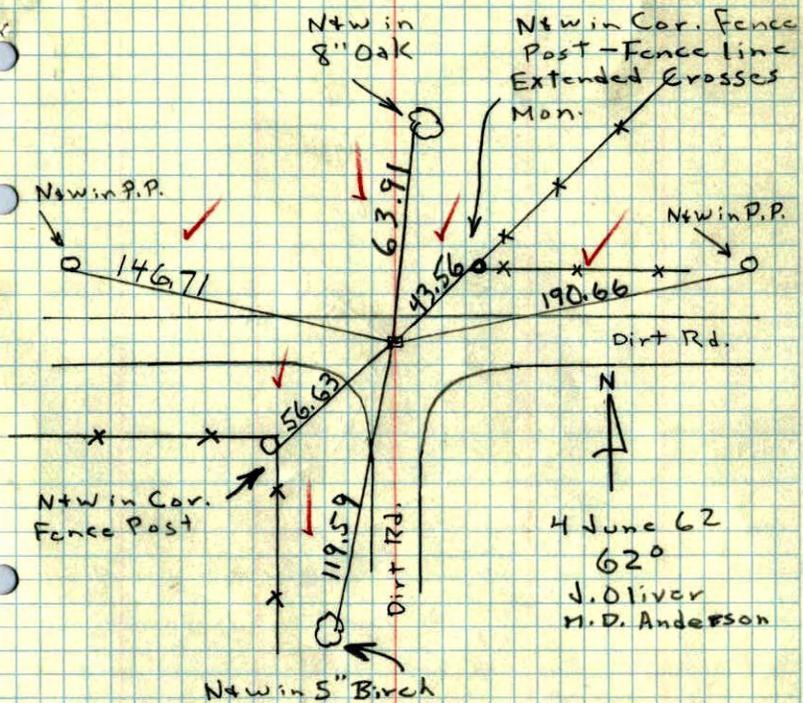

N.E. COR. SEC. 20, T32, Rg 22

CONC. MON.

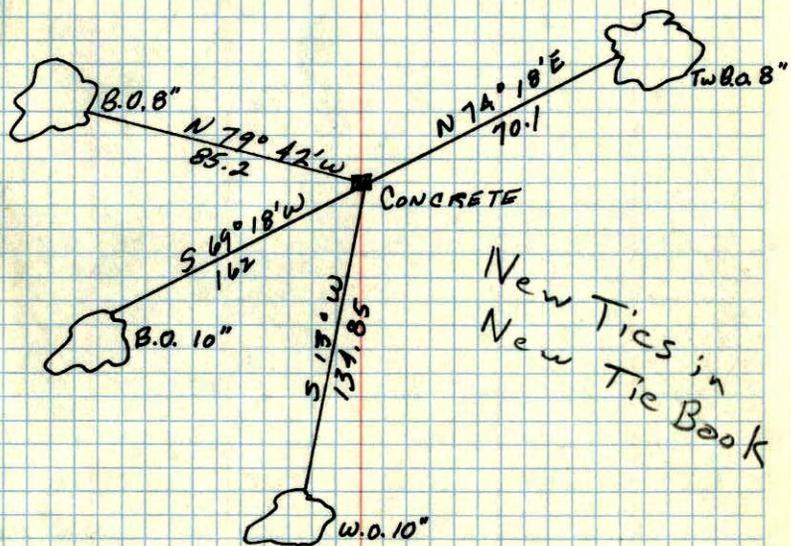JUNE 10, 1943  
CARTWRIGHT